


PLAN	SURVEYED	BY	DATE
NO.	BOOK	ALIGNED	CHECKED
		PT. OF WAY	CHECKED

PROFILE	SURVEYED	BY	DATE
NOTE	BOOK	GRADES	CHECKED
		B.M.	NOTED
		STRUCTURE	NOTING


FED. ROAD DIST. NO.	STATE	FED. AID PROJ. NO.	FISCAL YEAR	SHEET NO.	TOTAL SHEETS
HAWAII	HAW.	1-HI-1(32)-5 Unit 1	1966	5	73

Revised: Jan. 24, 1967

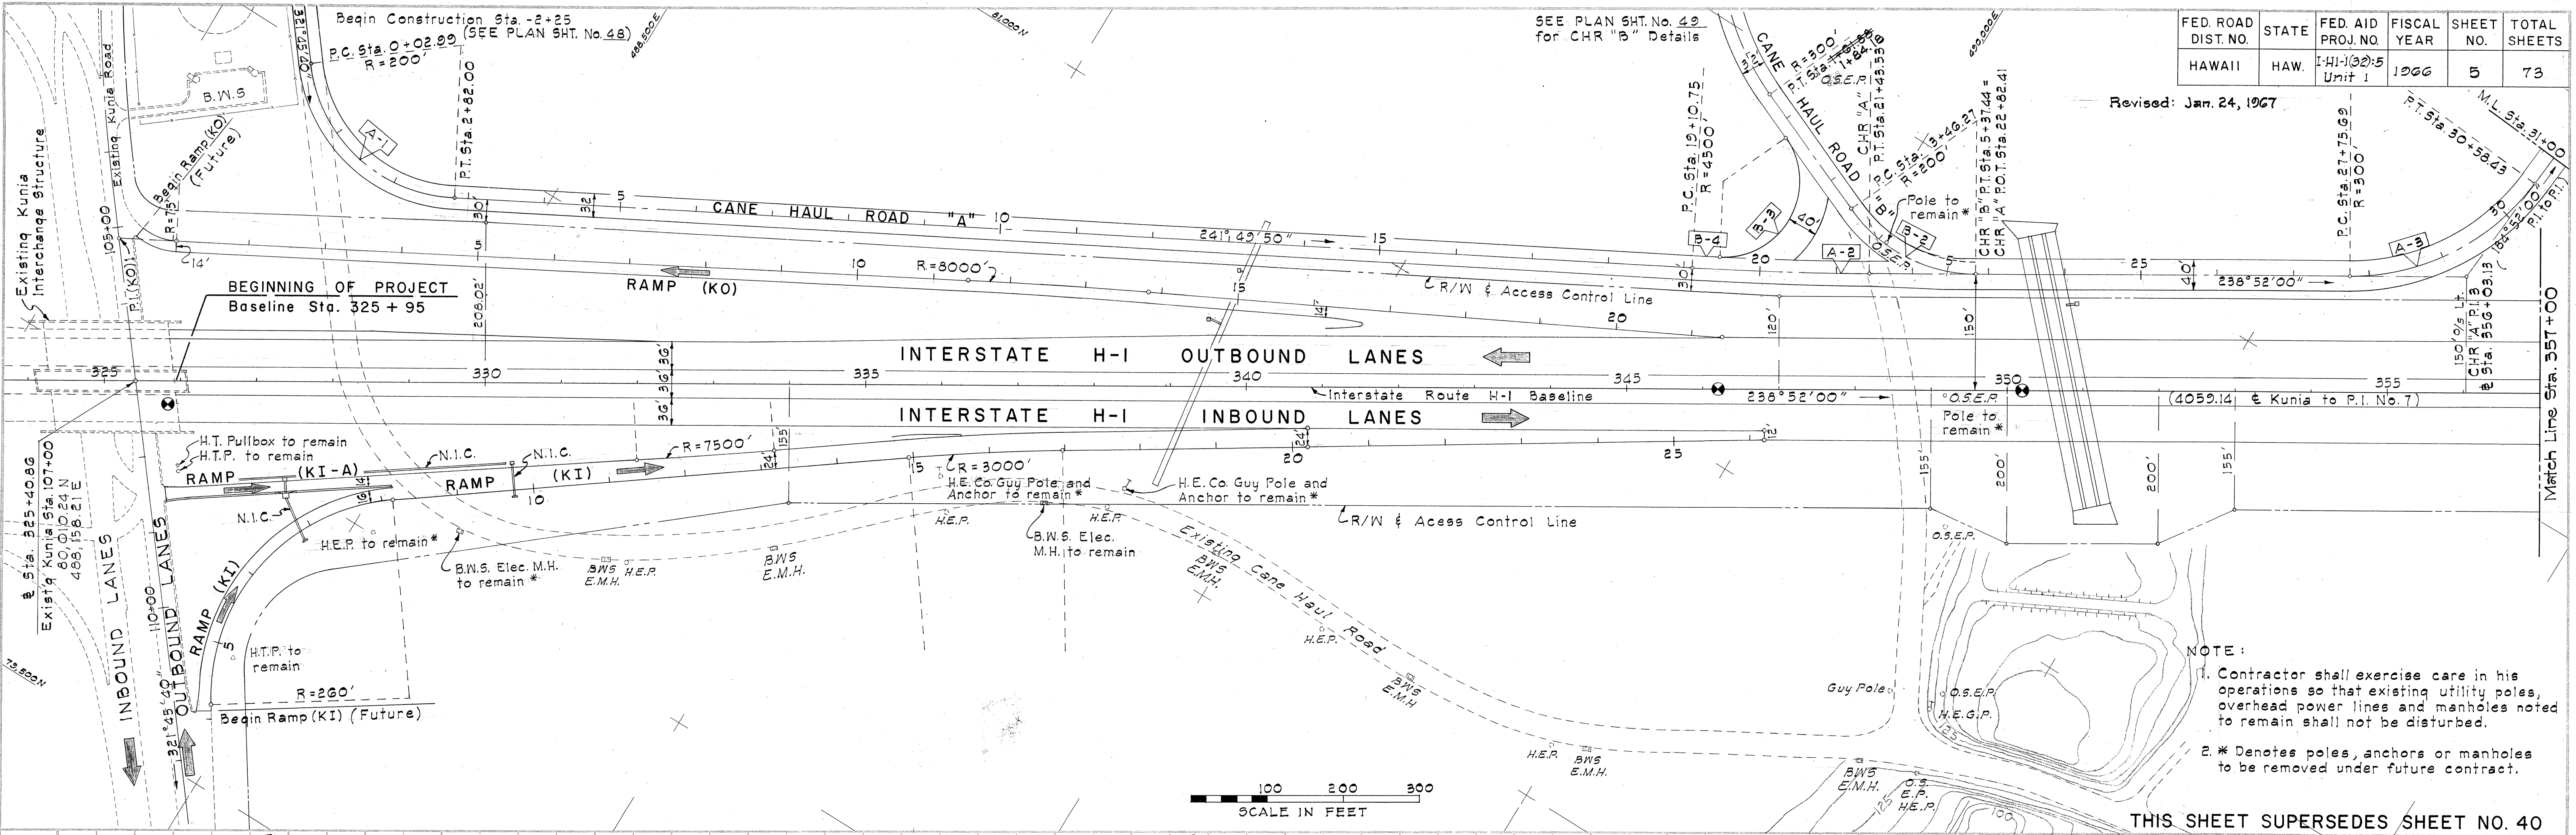

NOTE:
 1. Contractor shall exercise care in his operations so that existing utility poles, overhead power lines and manholes noted to remain shall not be disturbed.
 2. * Denotes poles, anchors or manholes to be removed under future contract.

THIS SHEET SUPERSEDES SHEET NO. 40

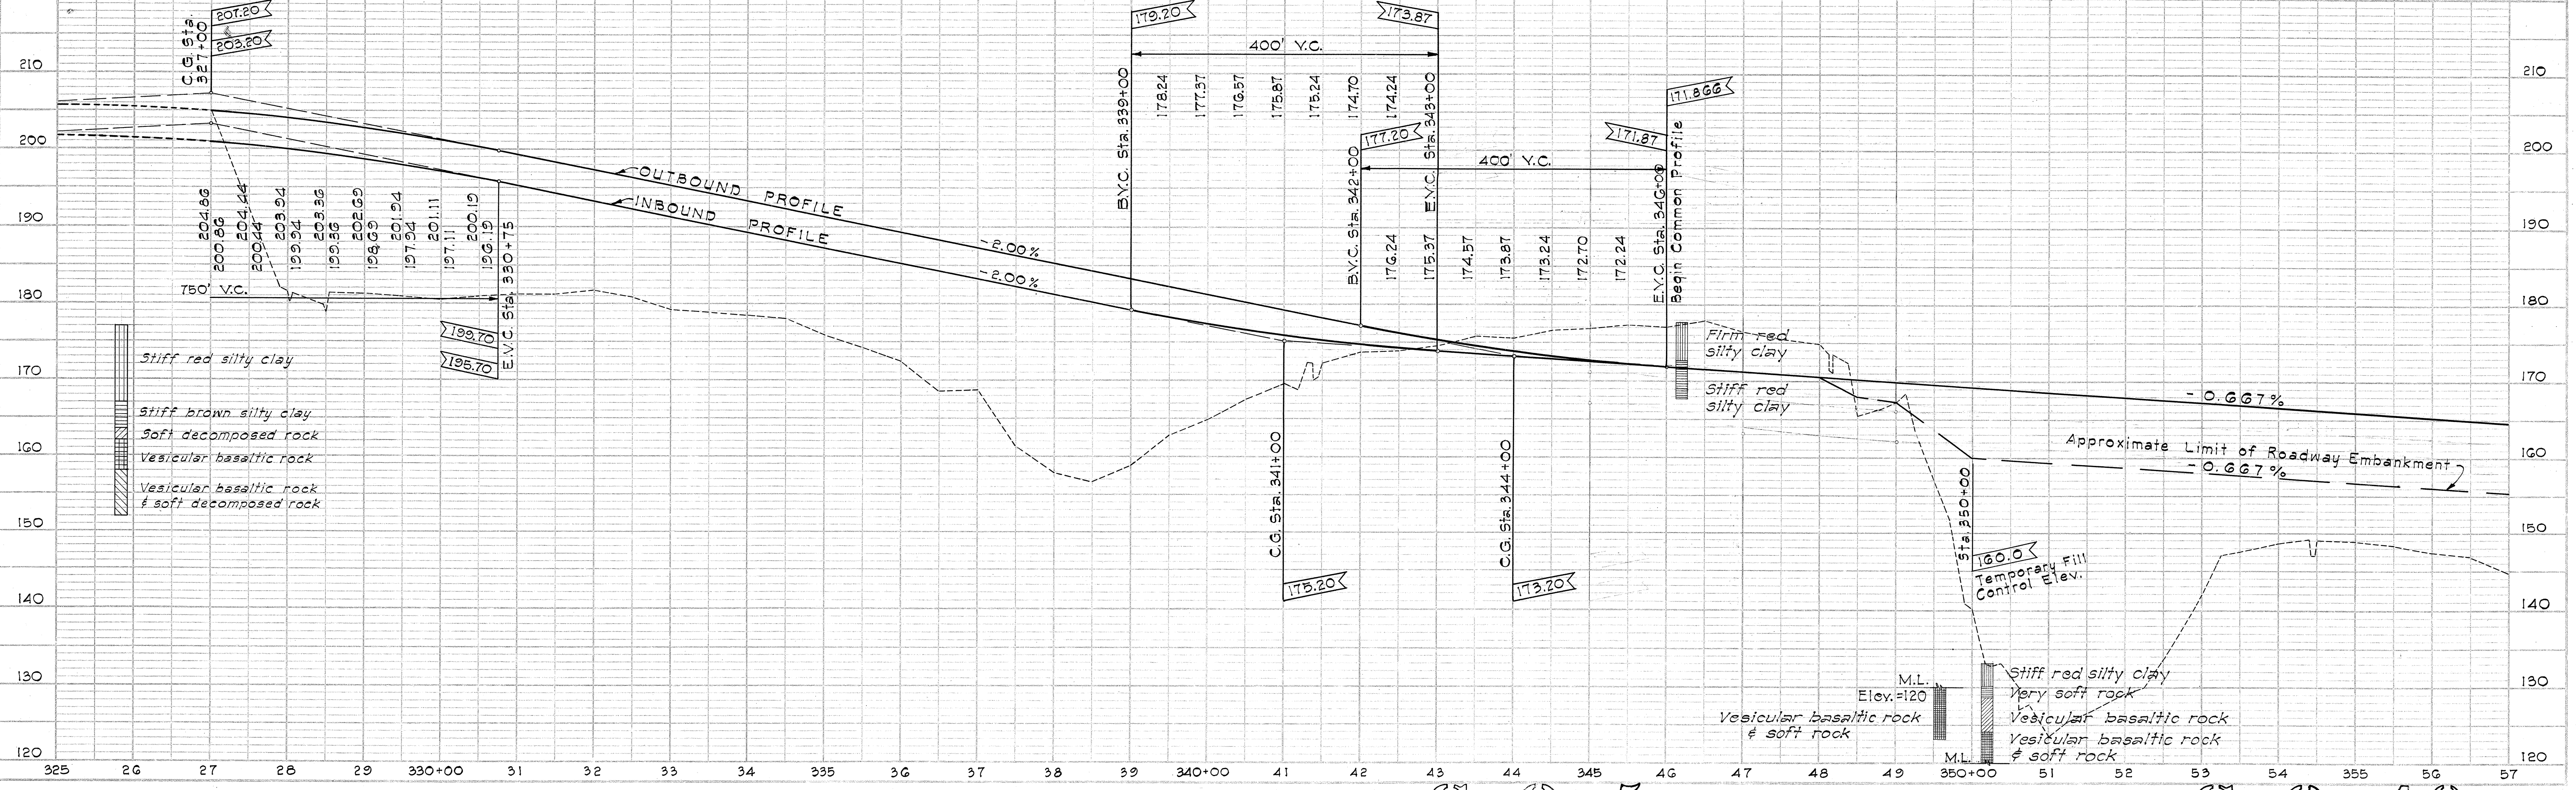

C.O.D. 5

C.O.D. 41



PLAN	SURVEYED	DATE
NO.	BY	
NOTE BOOK	PLOTTED	
NO.	BY	
NOTE BOOK	ALIGNED	
NO.	BY	
NOTE BOOK	CHECKED	
NO.	BY	
NOTE BOOK	REVIEWED	
NO.	BY	

PROFILE	SURVEYED	DATE
NO.	BY	
NOTE BOOK	PLOTTED	
NO.	BY	
NOTE BOOK	ALIGNED	
NO.	BY	
NOTE BOOK	CHECKED	
NO.	BY	
NOTE BOOK	REVIEWED	
NO.	BY	

FED. ROAD DIST. NO.	STATE	FED. AID PROJ. NO.	FISCAL YEAR	SHEET NO.	TOTAL SHEETS
HAWAII	HAW.	HI-1(32)-5 Unit 1	1966	6	73


NOTE:
Poles to be removed by the Contractor shall be considered incidental to the various contract items.

NOTE:
1. The Military Access Road Detour shall be an all-weather road and must be open to traffic at all times until the Military Access Road Grade Separation Structure can be open to traffic.

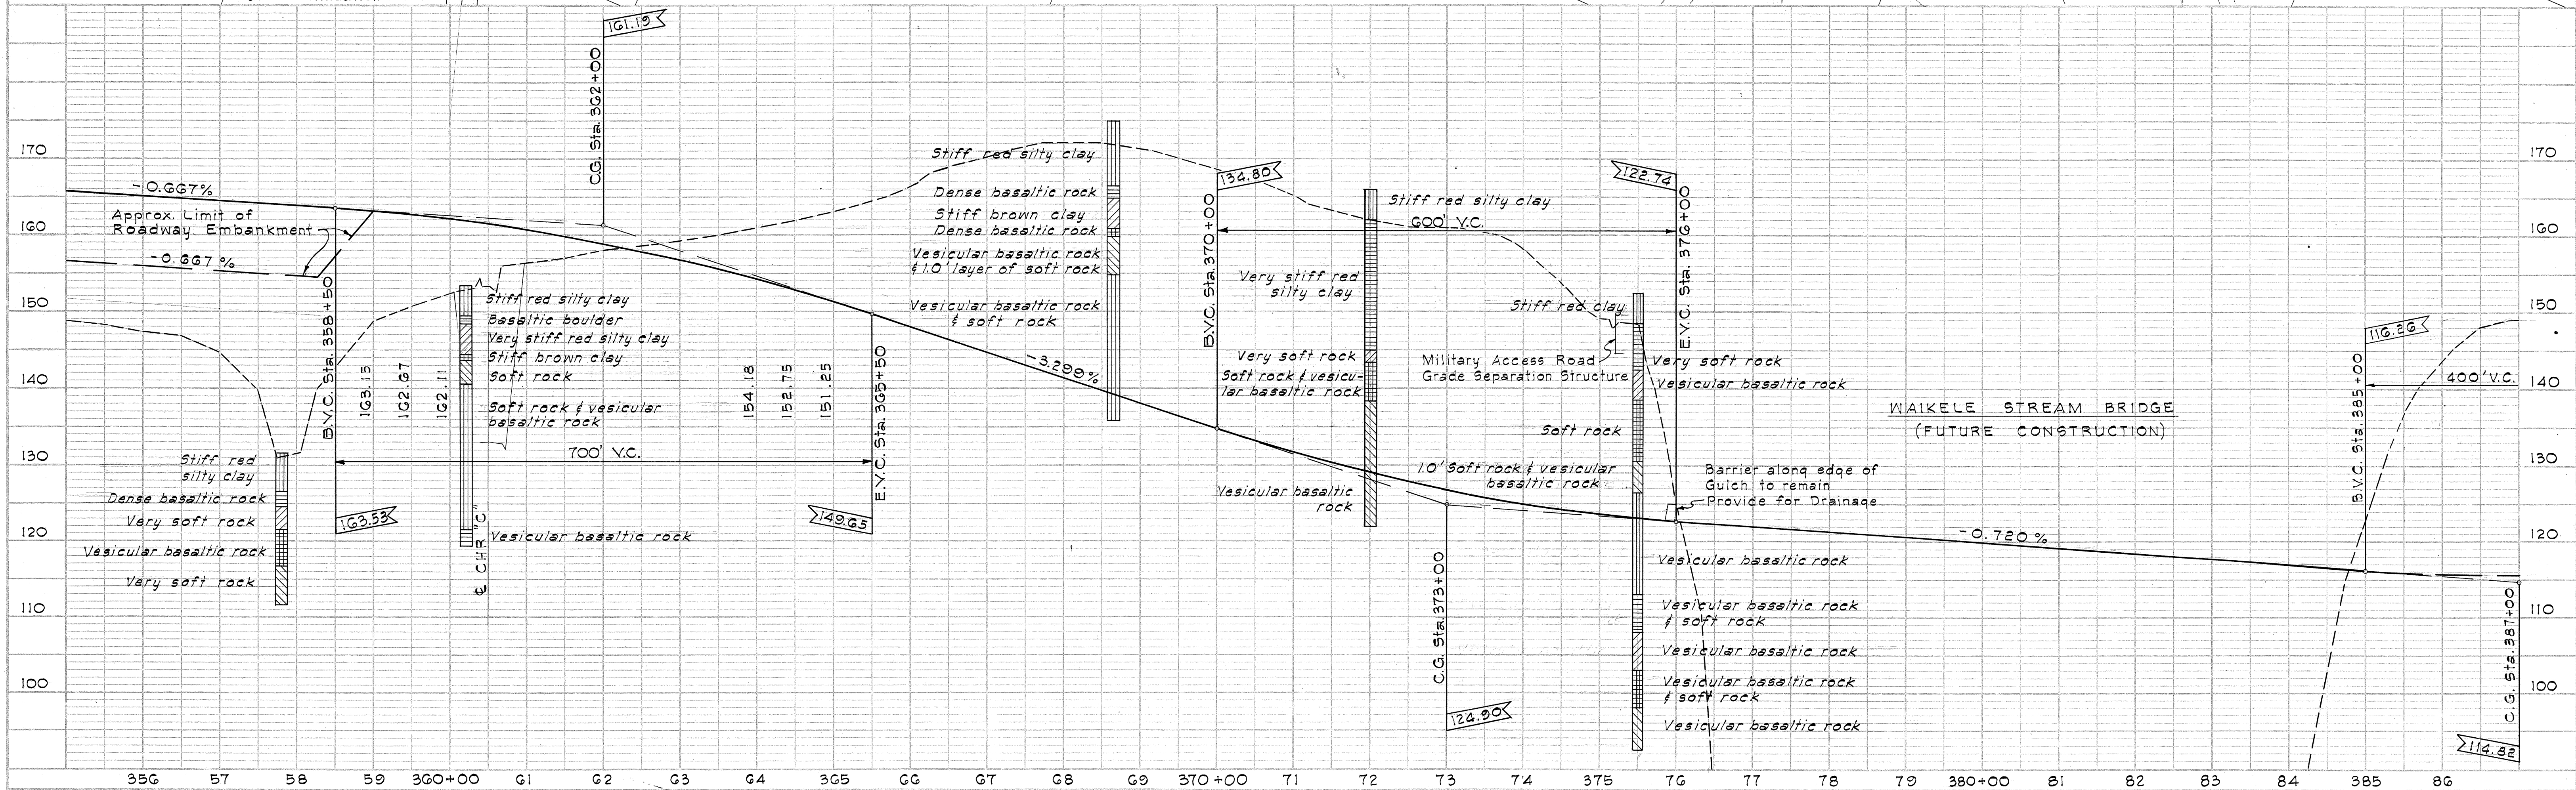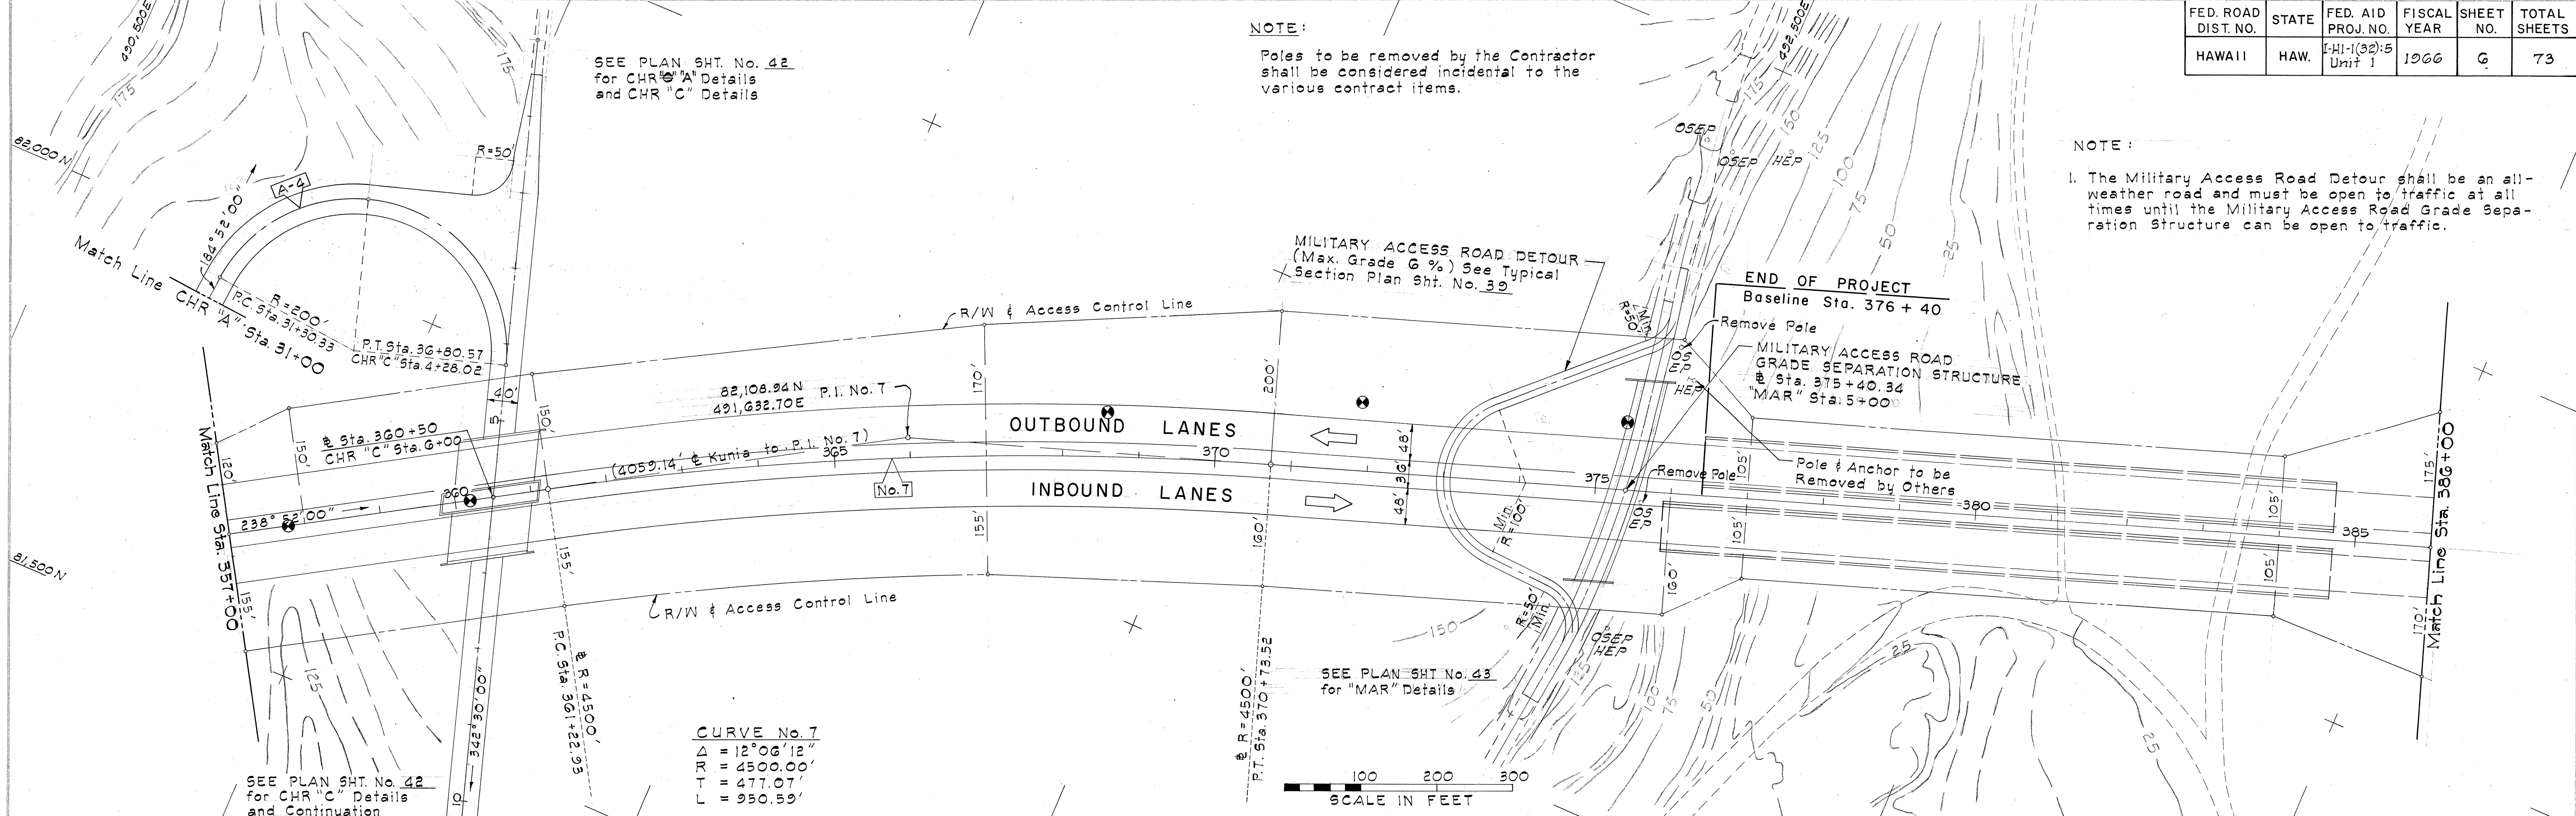


PLAN	SURVED	RV	DATE
	PLOTTED		
	NOTE BOOK		
	ALIGNMENT CHECKED		
	RT. OF WIN CHECKED		
NO.			

PROFILE		SURVEYED		BY		DATE	
1. AGE BOOK		PLOTTED					
2. GRADES CHECKED							
3. M.A. NOTED							
NO. _____		STRUCTURE NOTATING CHKD.					

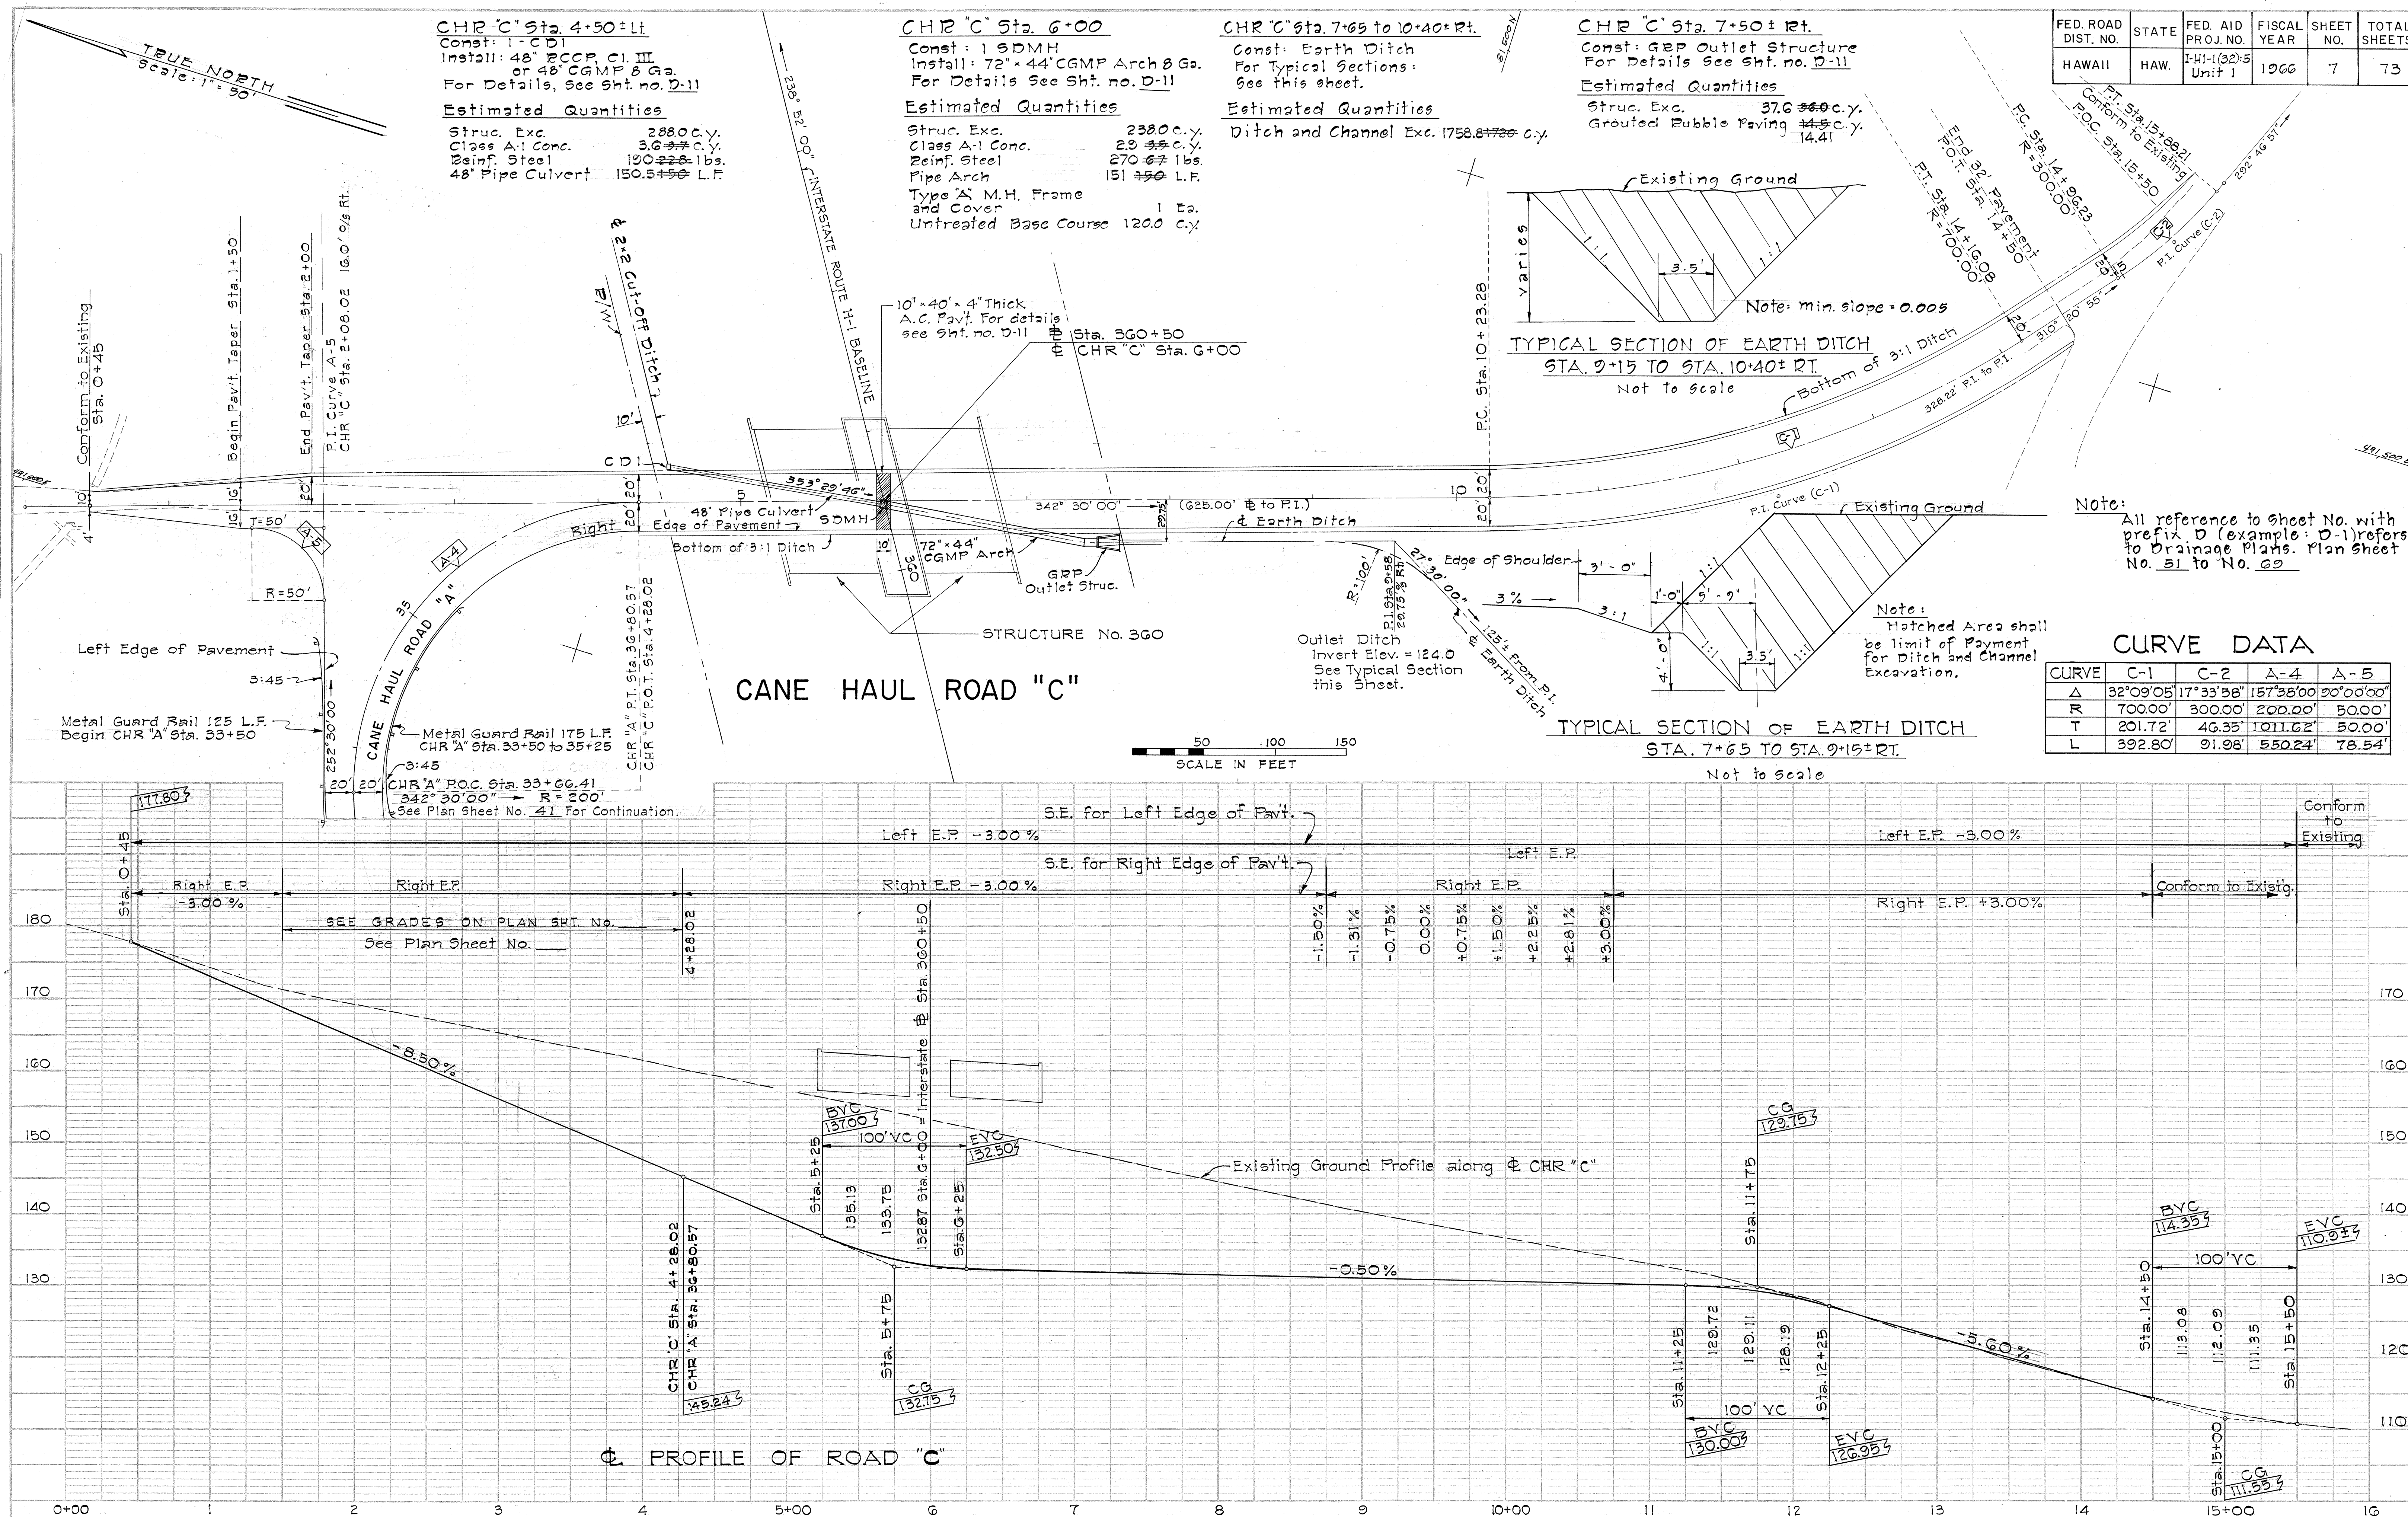

FED. ROAD DIST. NO.	STATE	FED. AID PROJ. NO.	FISCAL YEAR	SHEET NO.	TOTAL SHEETS
HAWAII	HAW.	I-414(22)5 Unit 1	1966	8	73

Revised: Jan. 24, 1967

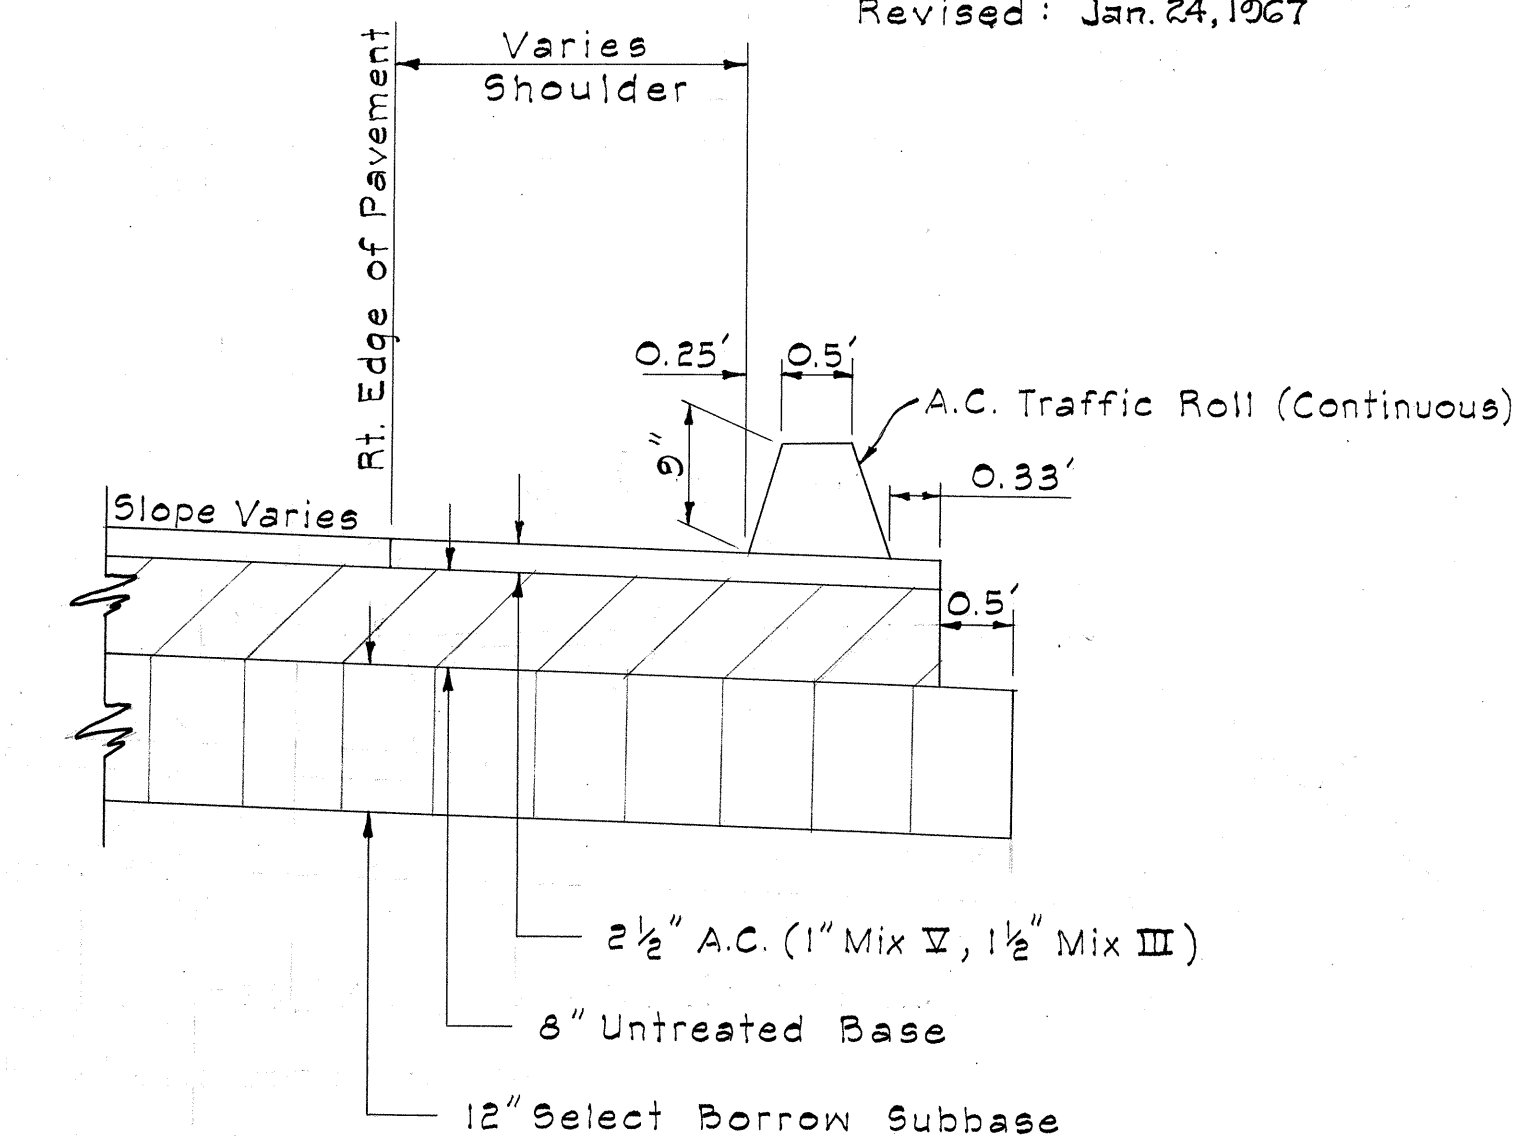


TYPICAL 2 1/2" A.C. PAVED SHOULDER
MILITARY ACCESS ROAD

Scale: 3/4" = 1'-0"

CURVE	MAR-1	MAR-2	MAR-3	MAR-4	MAR-5	MAR-6
Δ	4°27'52"	3°07'48"	9°24'59"	6°17'02"	0°50'20"	8°03'
R	1409.06	1830.48	1432.69	840.90	6839.34	1449.58
T	54.93	50.00	118.00	50.00	50.00	102.00
L	109.79	99.98	235.46	99.90	100.00	203.66

Note:
All reference to sheet No. with prefix
p (example: p-1) refers to Drainage
plans. Plan sheet No. 51 to No. 62

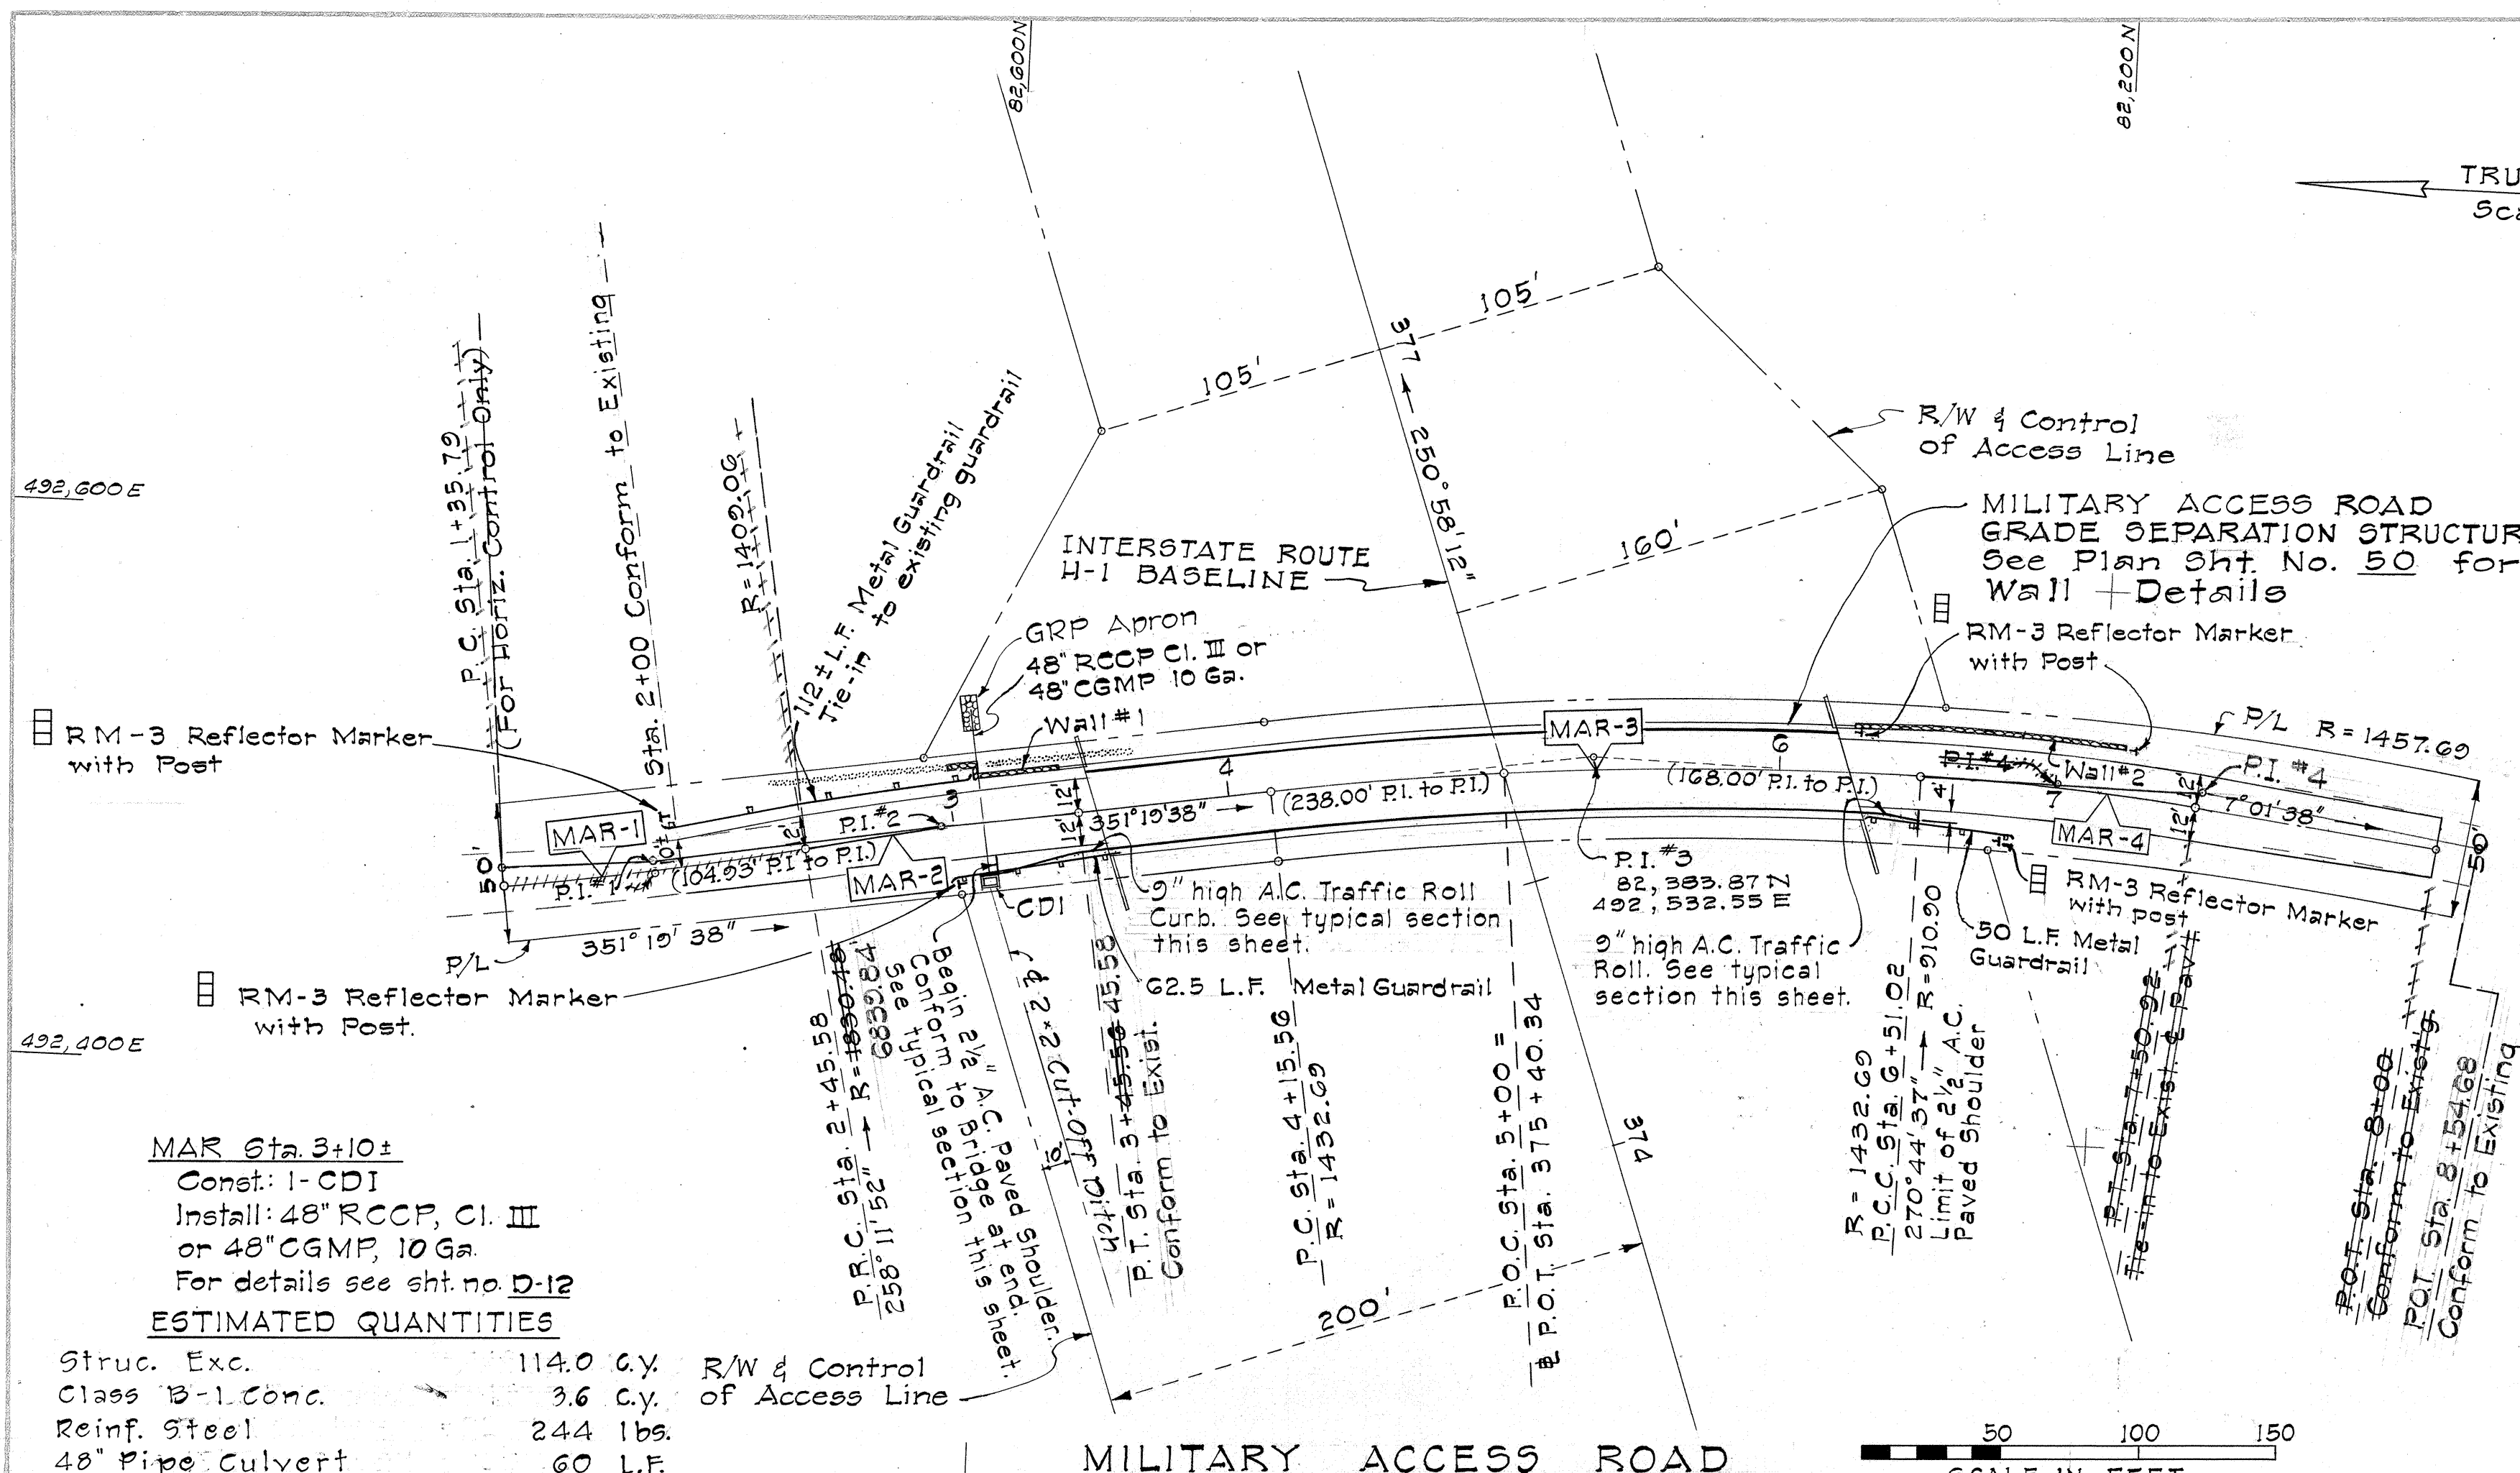


MILITARY ACCESS ROAD

SCALE IN FEET
0 50 100 150

S.E. DIAGRAM FOR MILITARY ACCESS ROAD

Note: All rounding 50 ft. Vertical Curve

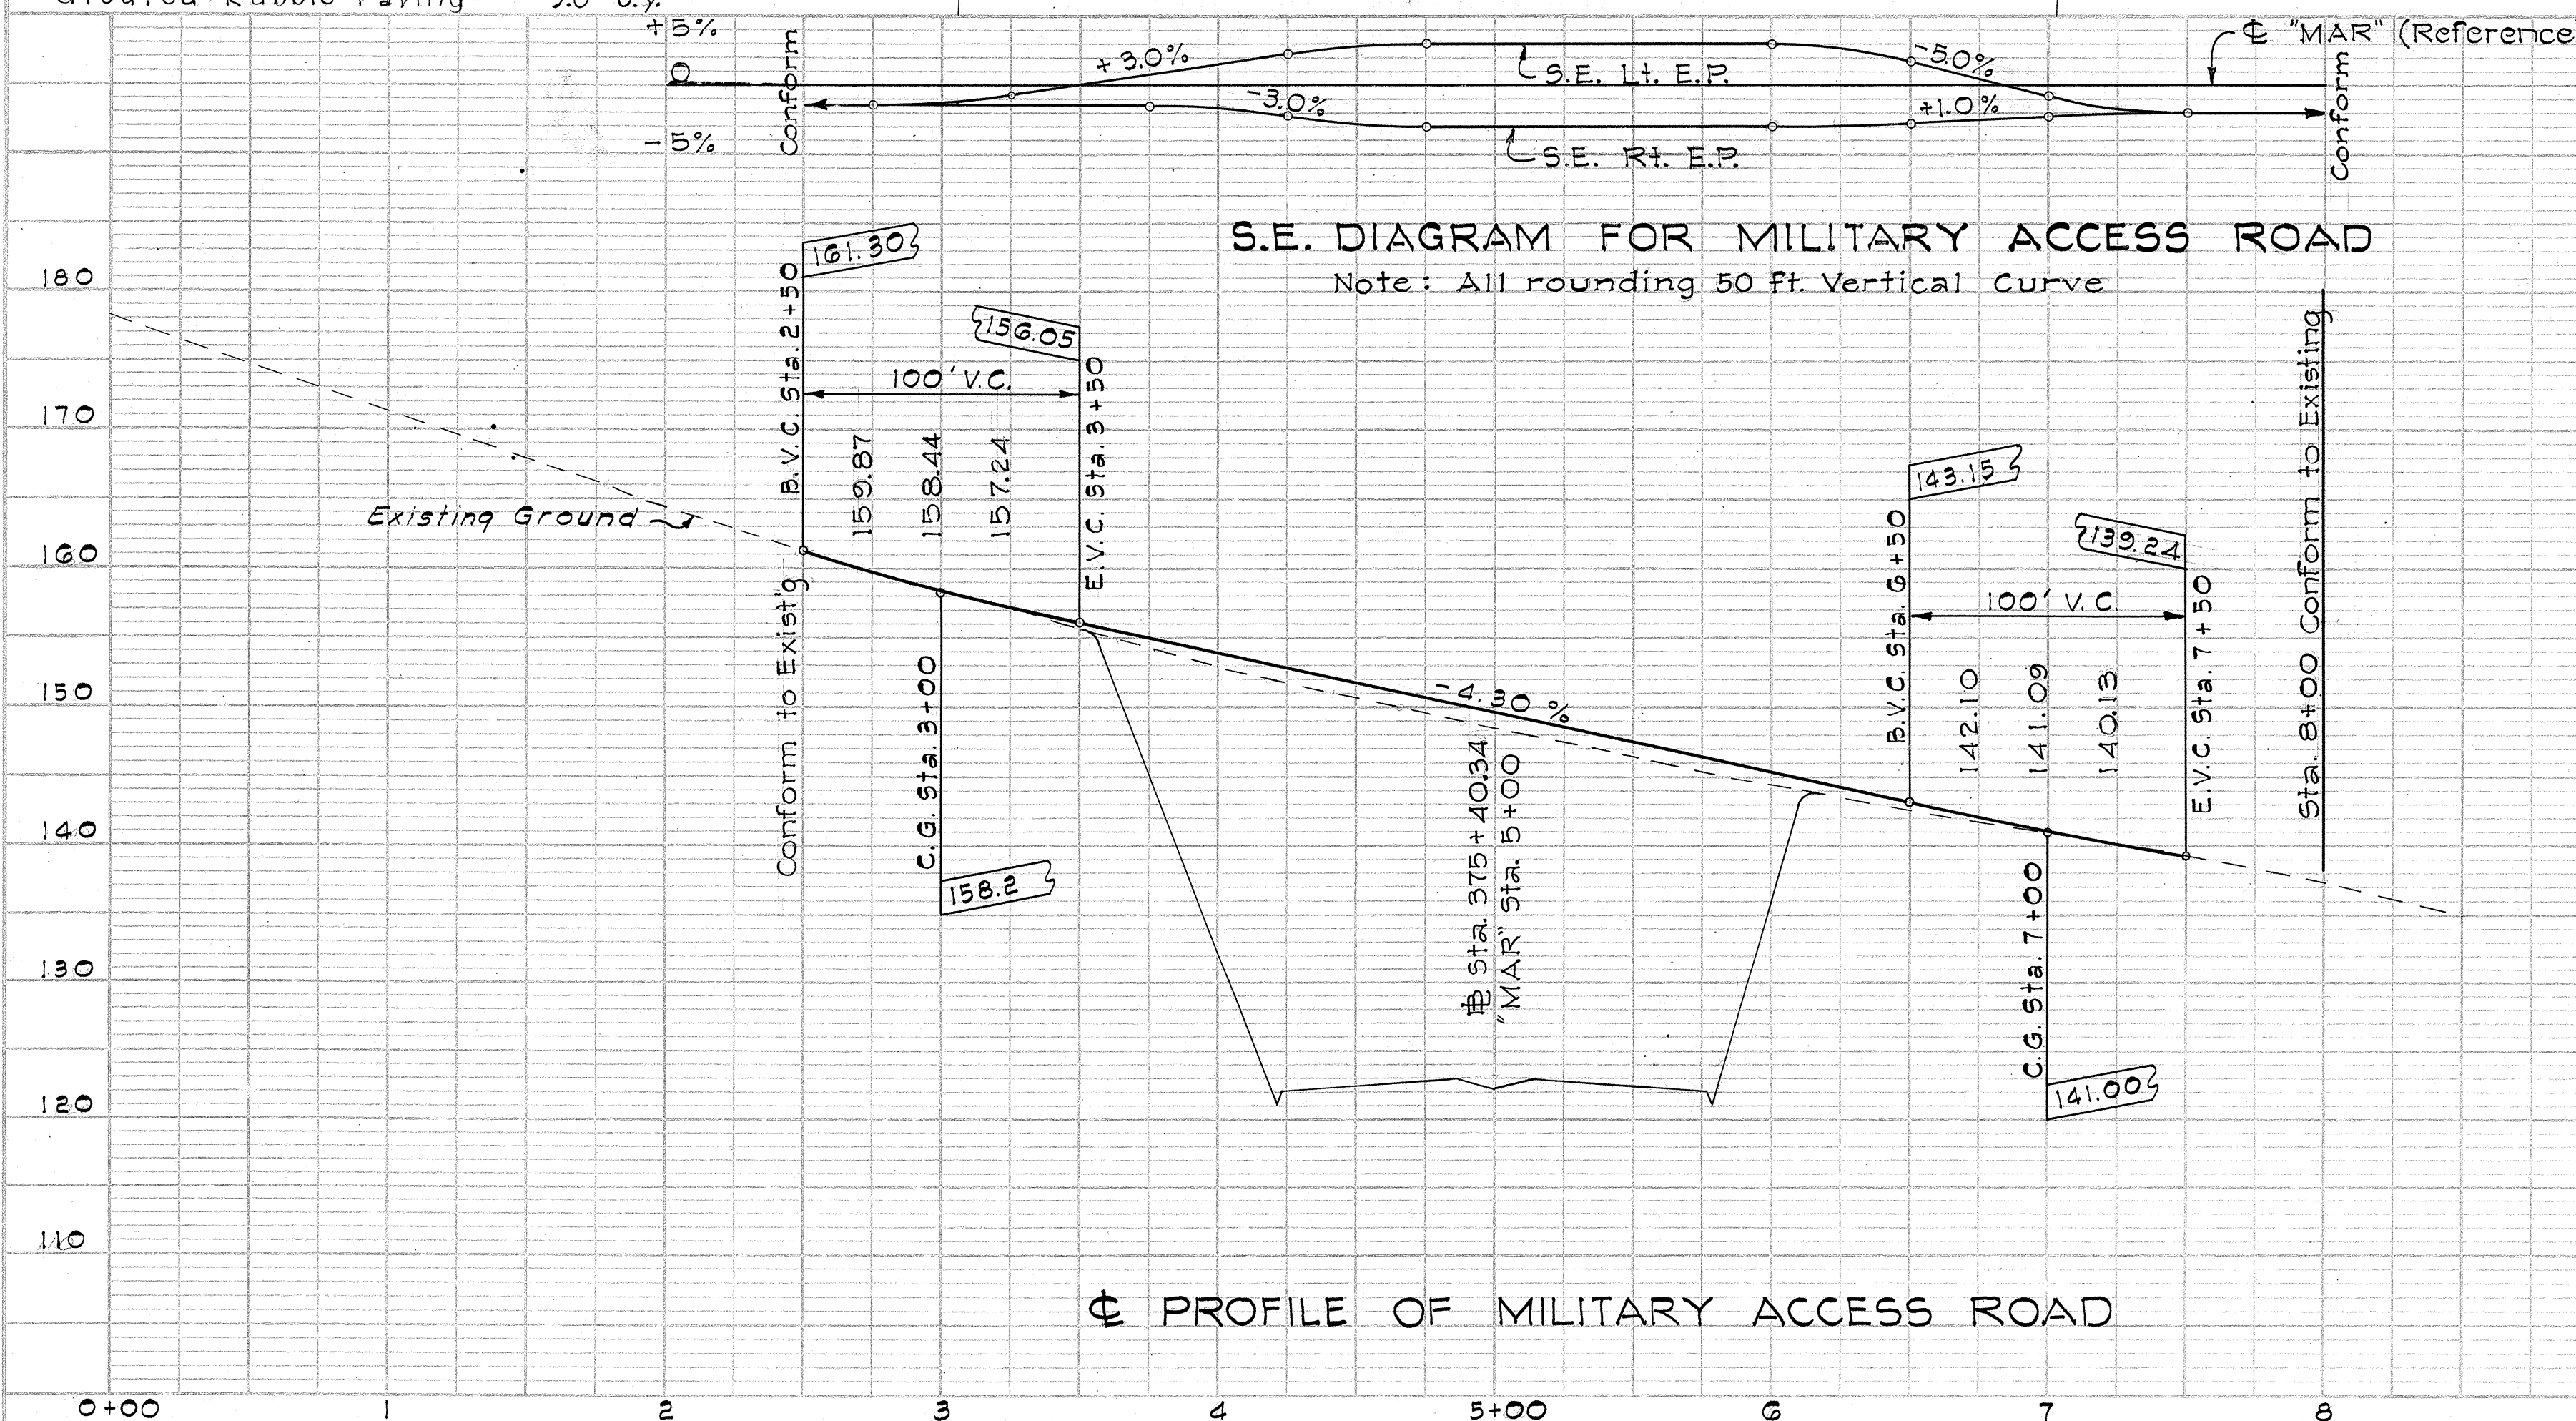

PROFILE OF MILITARY ACCESS ROAD

THIS SHEET SUPERSEDES SHEET NO. 43