
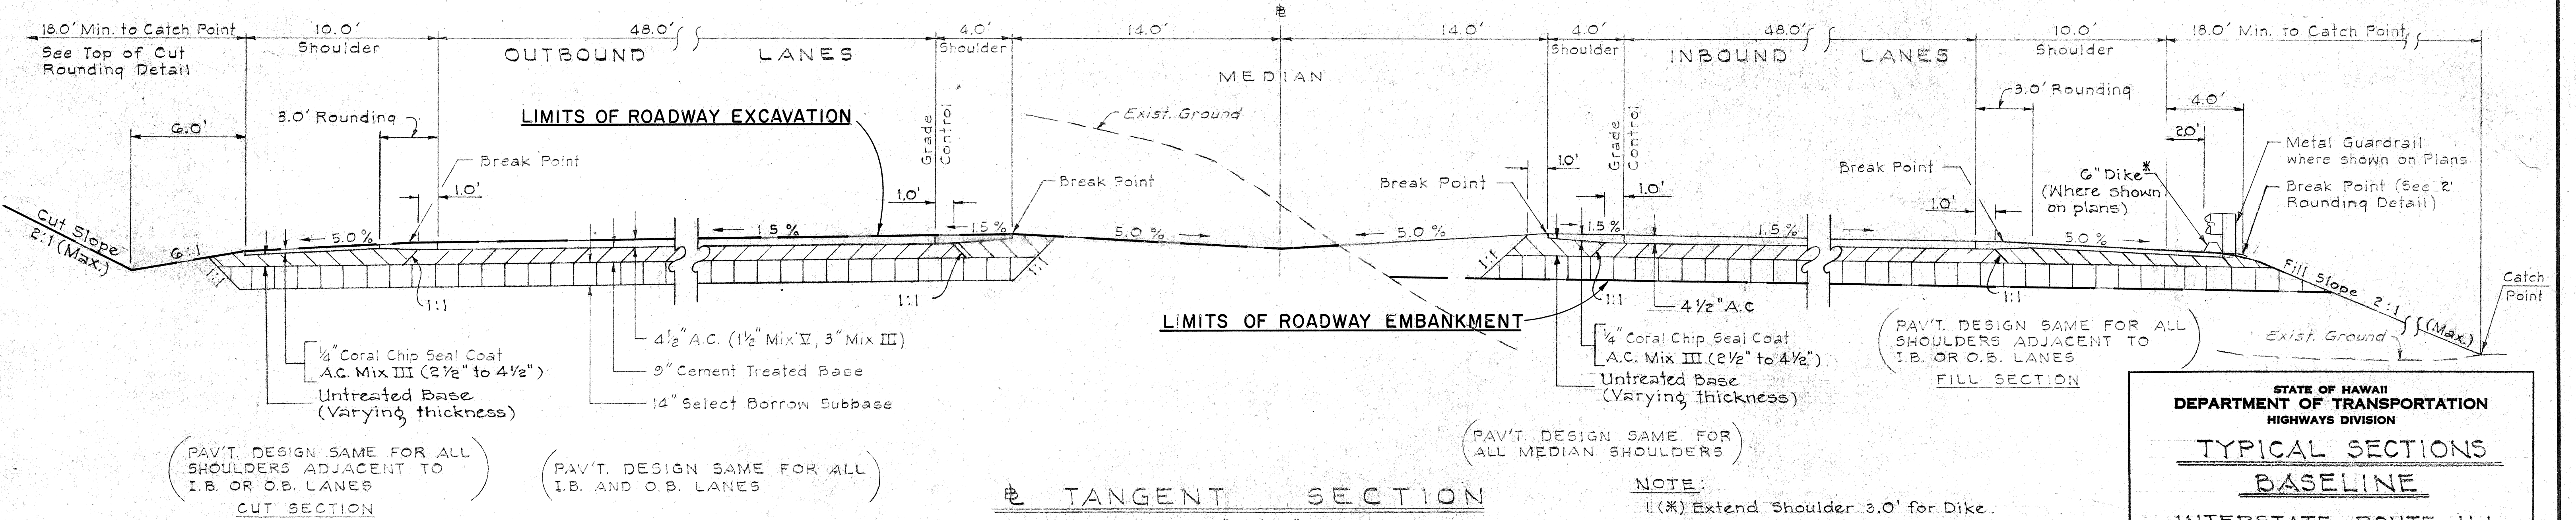


REVISED: Jan. 24, 1967

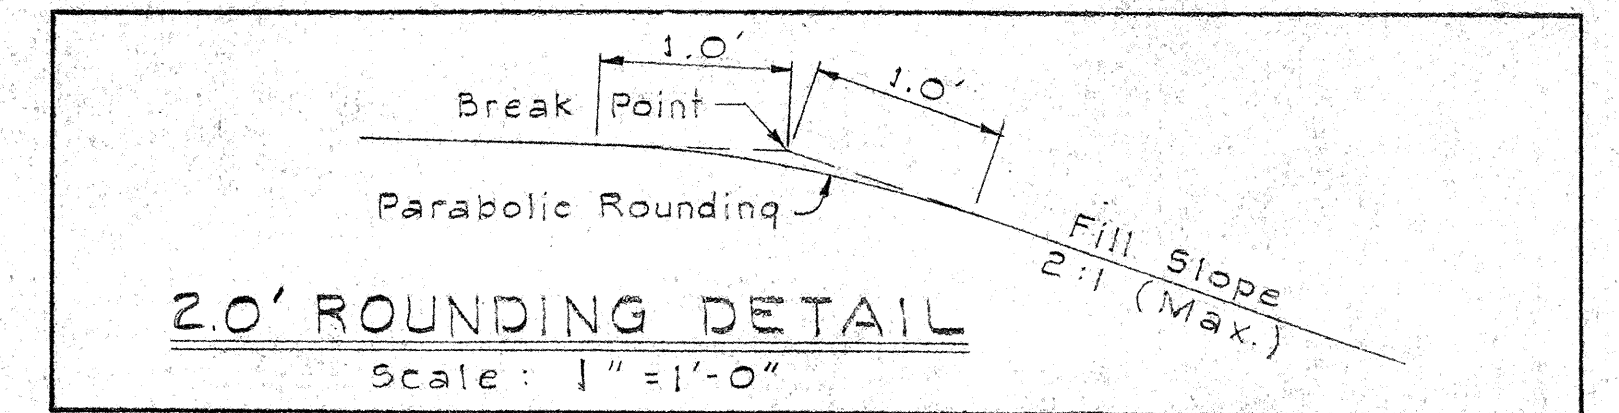

THIS SHEET SUPERSEDES SHEET NO. 37

STATE OF HAWAII
DEPARTMENT OF TRANSPORTATION
HIGHWAYS DIVISION

TYPICAL SECTIONS
BASELINE


INTERSTATE ROUTE H-1
F.A.I. Proj. No. I-HI-1(32)5, Unit 1

Scale: As Shown Date: Jan., 1967

SHEET No. OF SHEETS


FED. ROAD DIST. NO.	STATE	FED. AID PROJ. NO.	FISCAL YEAR	SHEET NO.	TOTAL SHEETS
HAWAII	HAW.	I-HI-1(32):5 Unit I	1966	3	73

REVISED: Jan. 24, 1967

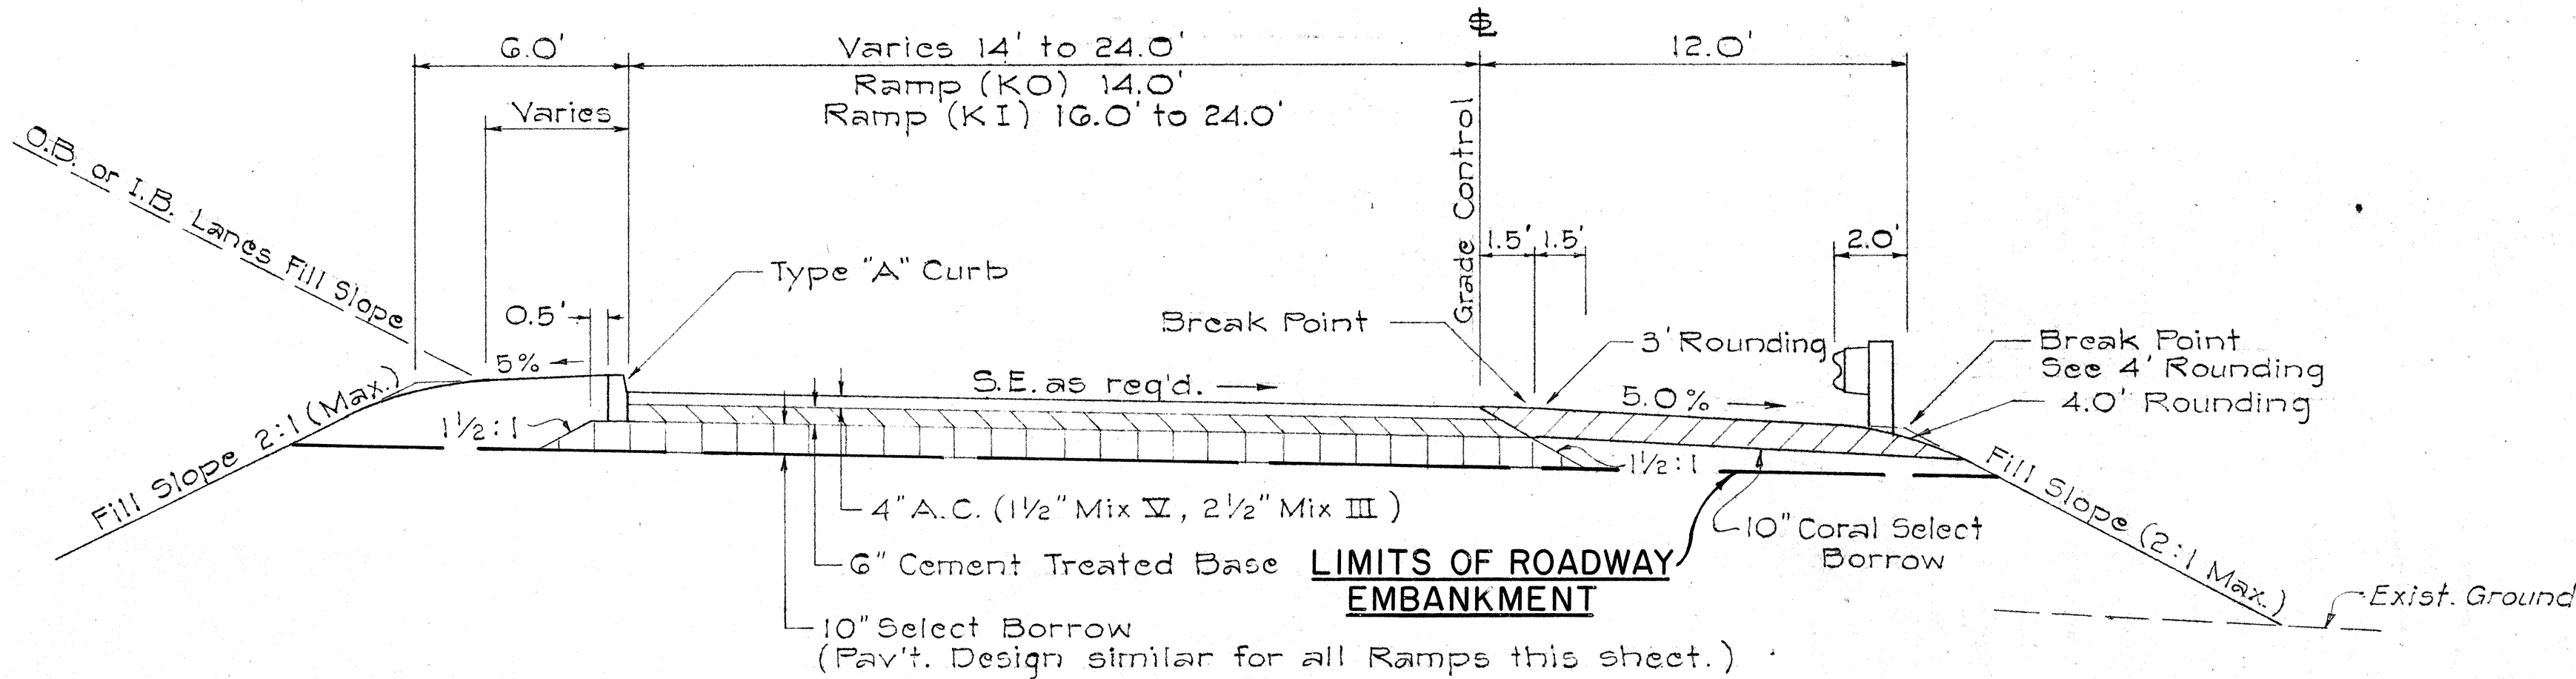


RAMP (KI) AND (KO) TANGENT SECTION (IN FILL)


Note: Section shown viewed against stationing for Ramp (KO)

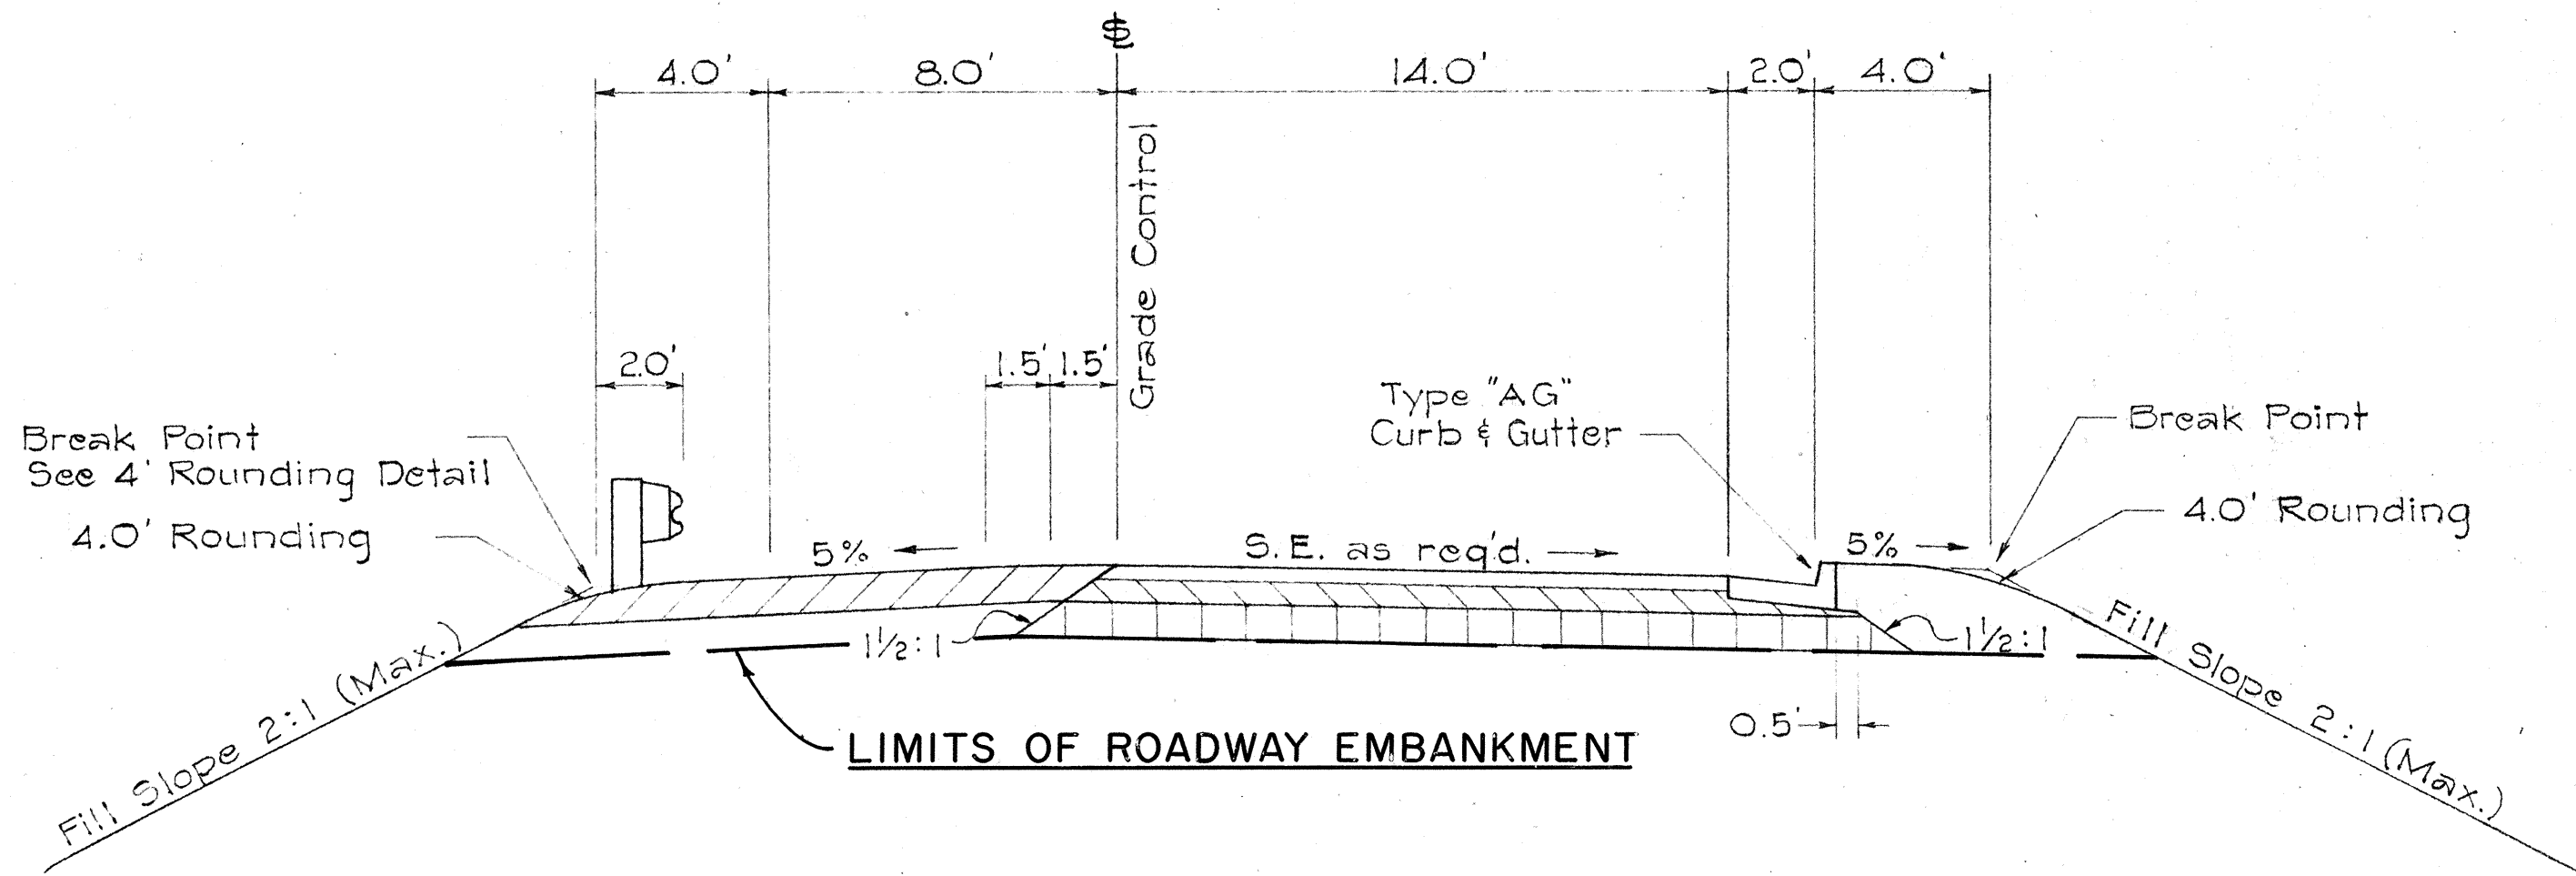

RAMP (KO) SUPERELEVATED SECTION (CURVE TO RIGHT)

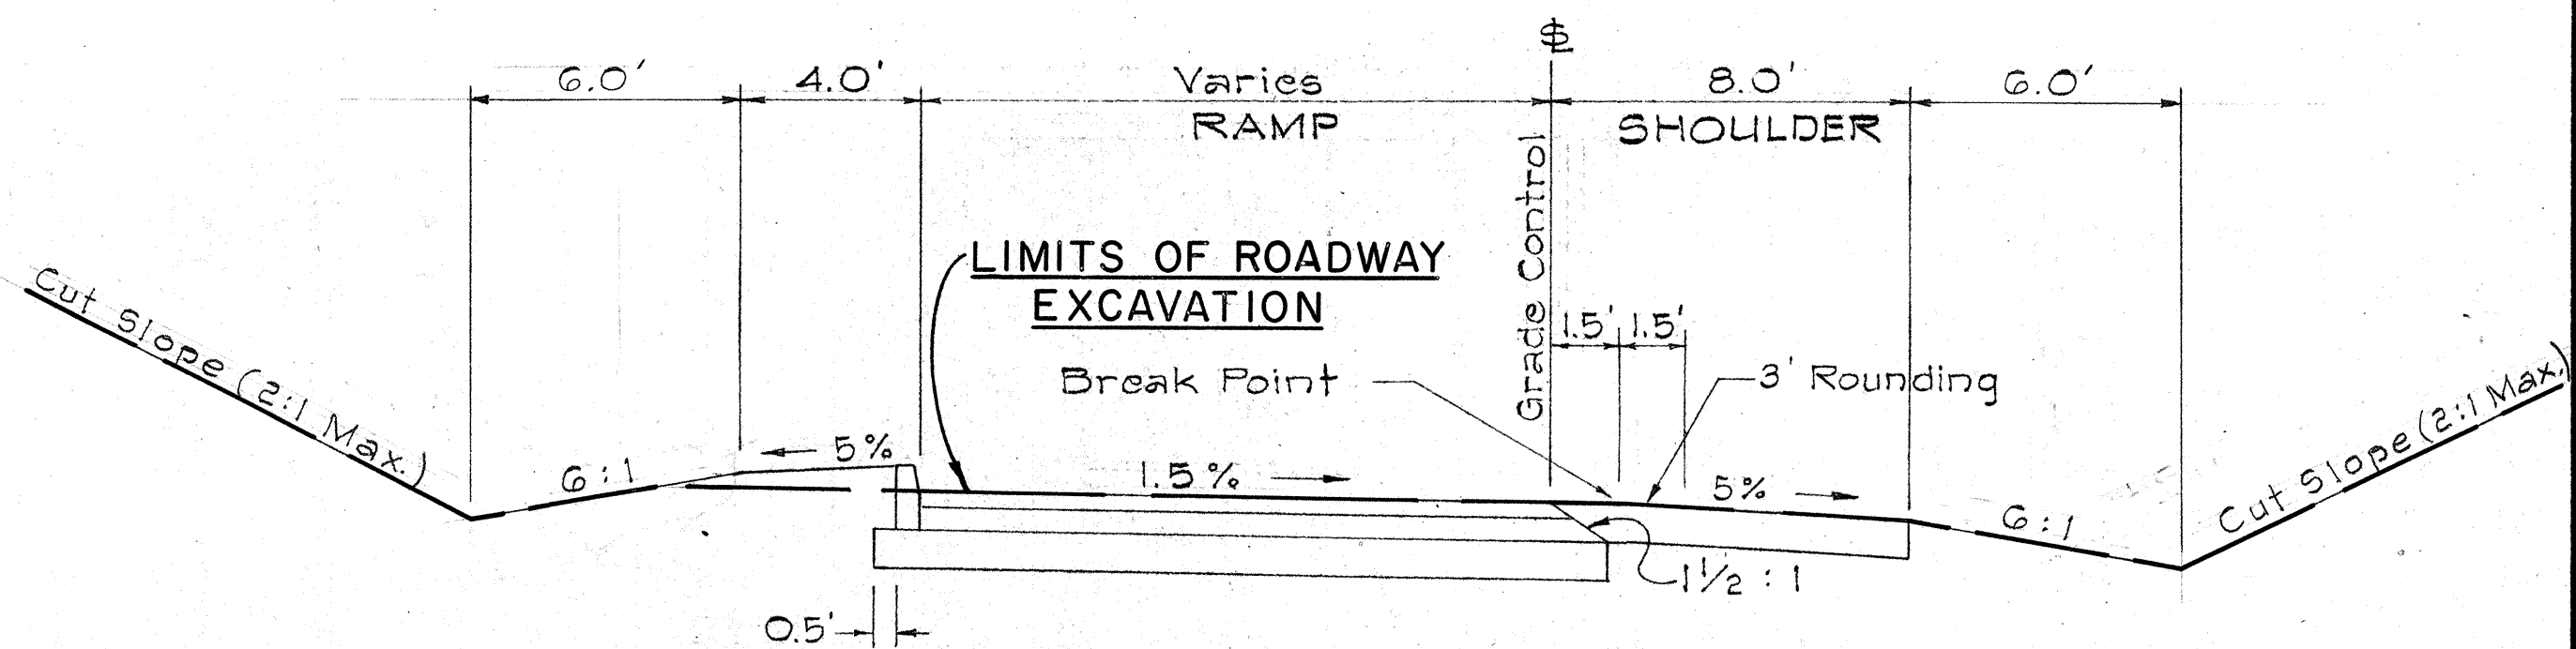

RAMP TANGENT SECTION (IN CUT)

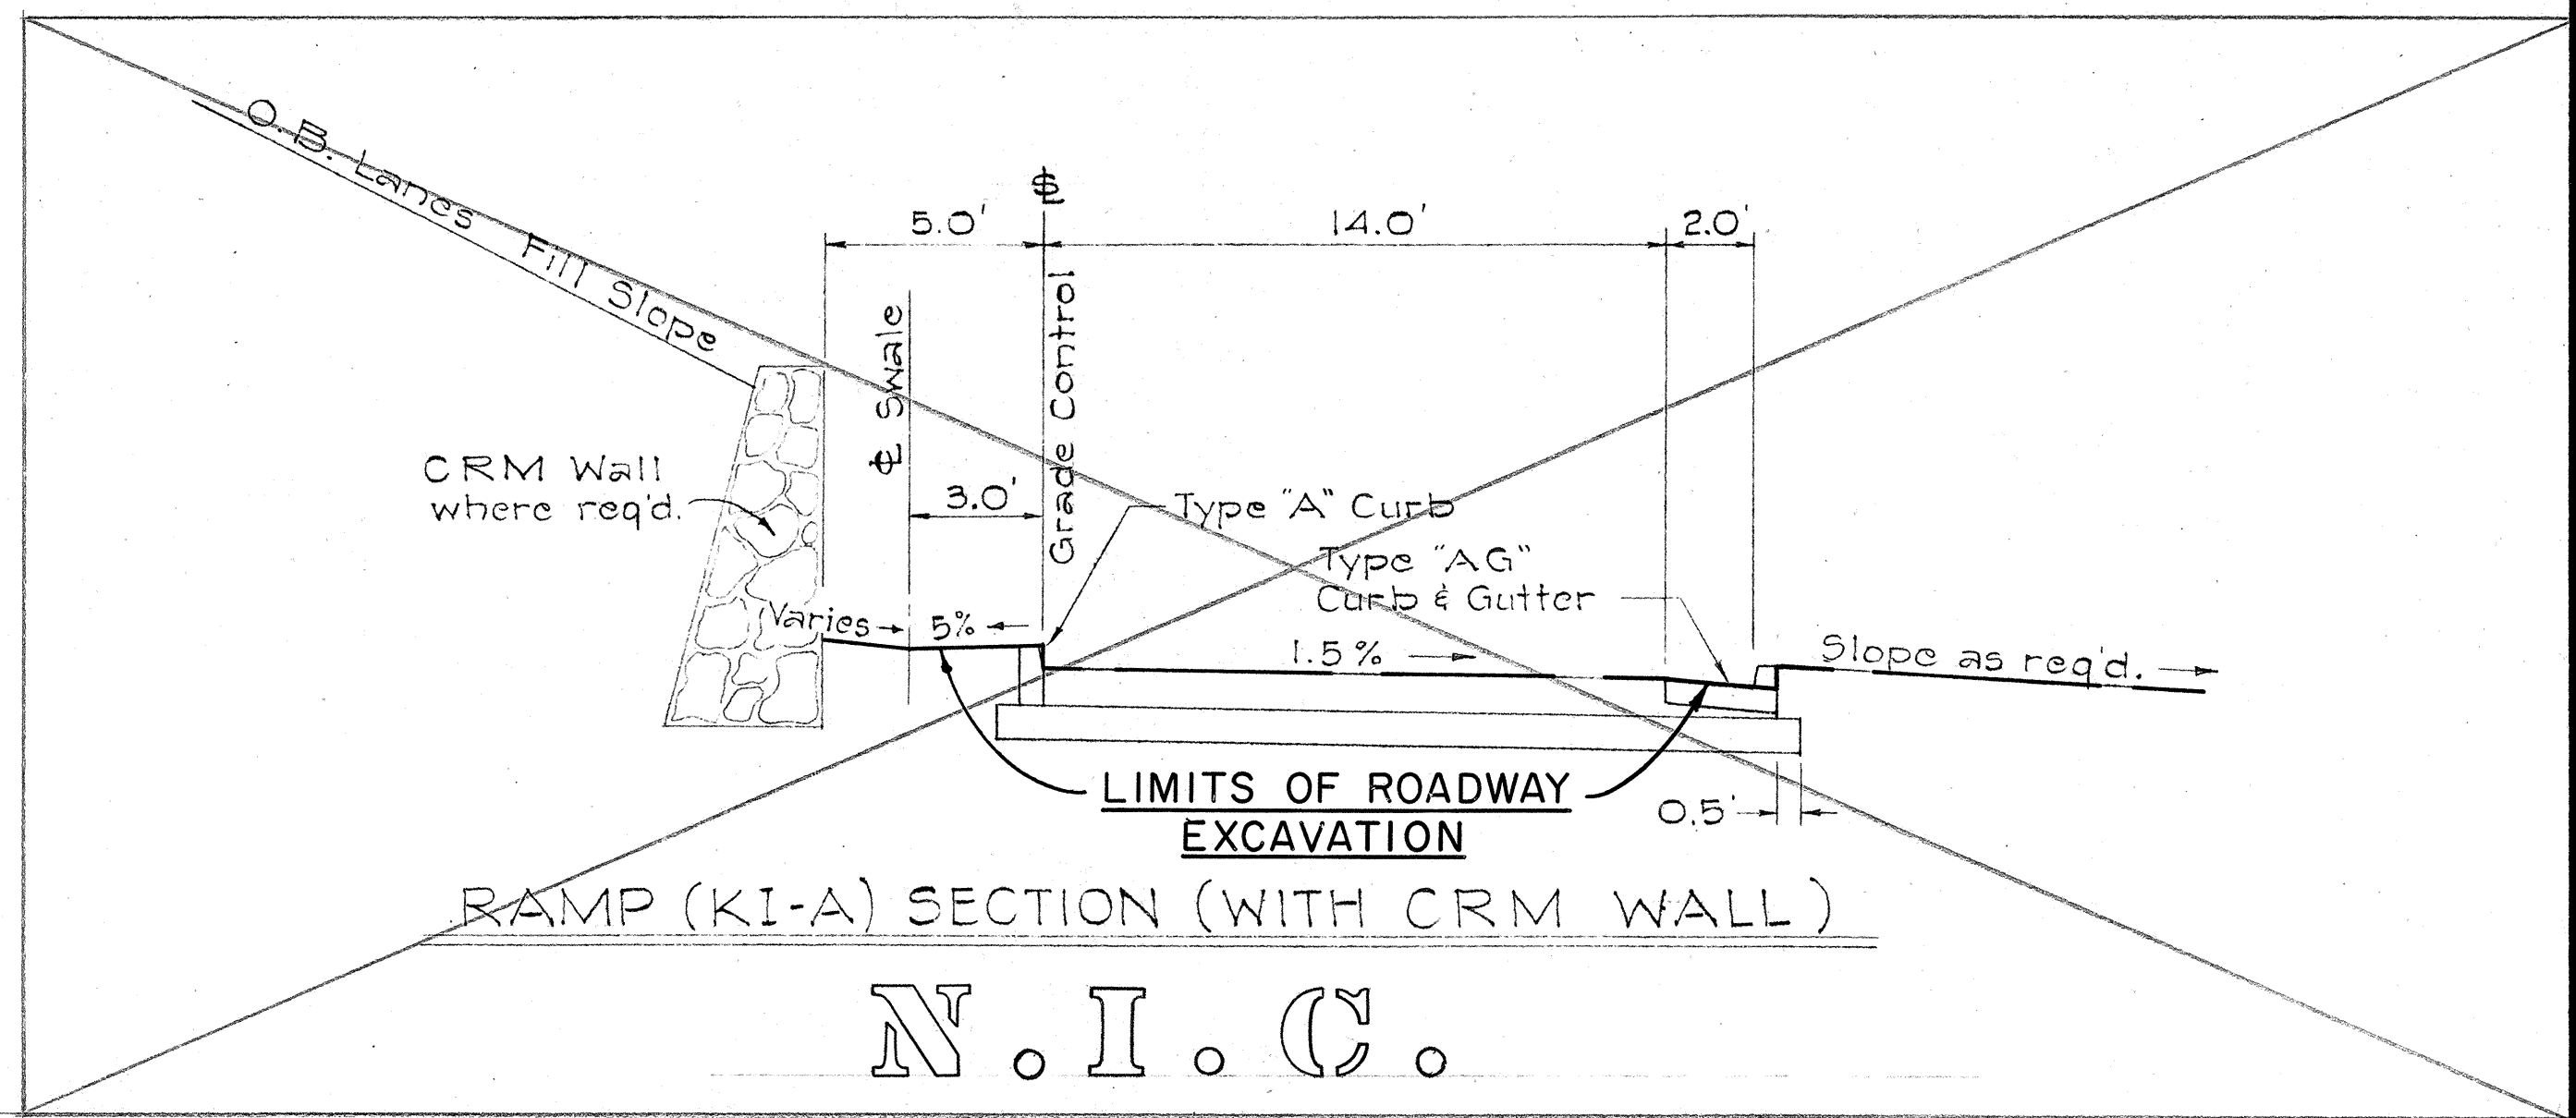

N.I.C.

GENERAL NOTES

a. Excavation and Embankment

1. It is the intent to use all suitable material from excavation as material for the roadway embankment.

2. Since the material from excavation will be insufficient to complete the roadway embankment prism, as designed, the Contractor shall exercise care to properly grade the incomplete roadway prism to avoid pocketing of drainage water.

3. The plan and profile indicate the location of the approximate upper limit of roadway embankment due to insufficient fill material. Refer to cross sections for additional details of excavation or embankment limits.

b. Boring Data

1. The boring data shown on the Plan and Profile and Structural Plans is for design purposes only and is for the convenience of the Engineer in the control of earthwork.

2. The borings were carefully taken and are believed to be reliable, however, the Department assumes no responsibility whatsoever in respect to the sufficiency or accuracy of borings, or of the interpretation thereof, and will not make any guarantee of any of the same.

c. Work Outside of Highway Rights-of-way

1. For work involving rehabilitation of existing improvements beyond the highway rights of way, the Contractor shall obtain permission from the Engineer prior to entering any adjacent or abutting property.

d. Sheet Reference

1. All reference to "Plan Sheet No. ___" refers to composite numbering of sheets for the entire Contract Plans which appears at the extreme right bottom corner of the sheet.

2. All reference on Structure Plans referring to "Sheet No. ___" refers to individual

Structure Plans, "Plan Sheet Nos. 70 to 79" (Grade Separation Structure No. 360) and "Plan Sheet Nos. 80 to 90" (Military Access Road Grade Separation Structure).

3. Reference to "Std. Det. Sht. # 5 ___" or "Sht. # 5 ___", refers to Standard Bridge Details (5-1 to 5-9), "Plan Sheet Nos. 26 to 35".

4. Sheet Nos. appearing on the bottom of the sheet, near the center refer to sheet Nos. for each project separately. This reference is for the Engineer's use only.

e. Miscellaneous

1. The plans show some items of work not included in this contract. These items of work are to be constructed under a future project and are labeled "N.I.C." (Not in Contract).

2. Items of work to be deferred for completion under a future Contract shall also include paving, highway lighting, guard rail, traffic signs, utility relocation, access control fencing, and landscaping.

THIS SHEET SUPERSEDES SHEET NO. 38

STATE OF HAWAII
DEPARTMENT OF TRANSPORTATION
HIGHWAYS DIVISION
TYPICAL SECTIONS
RAMPS

INTERSTATE ROUTE H-1
F.A.I. Proj. No. I-HI-1(32):5, Unit I


Scale: 1/4" = 1'-0" Date: Aug. 1966

SHEET No. OF SHEETS


C O 3

C O 3 S


FED. ROAD DIST. NO.	STATE	FED. AID PROJ. NO.	FISCAL YEAR	SHEET NO.	TOTAL SHEETS
HAWAII	HAW.	I-HI-1(32):5 Unit 1	1966	4	73

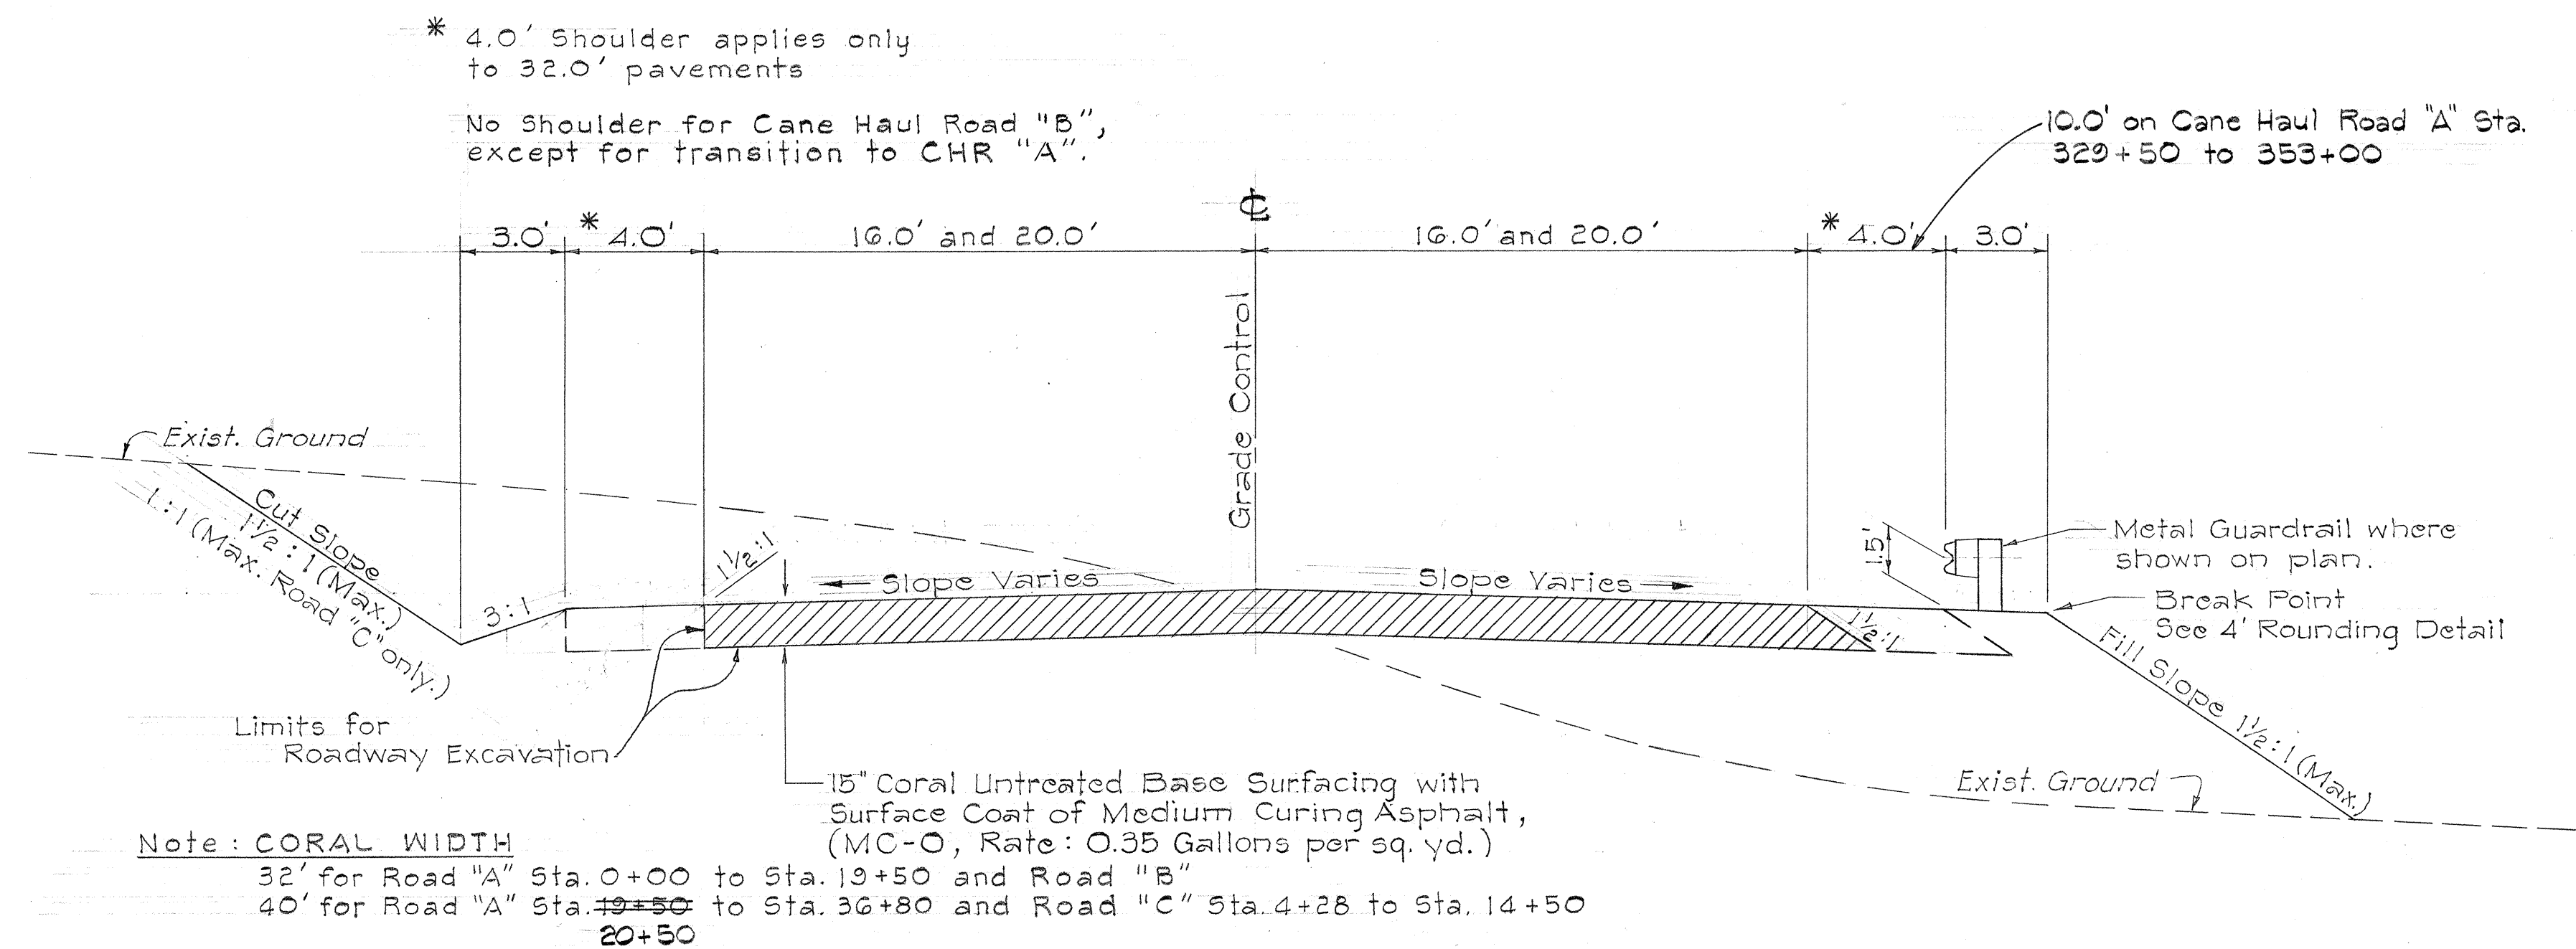


CANE HAUL ROAD (2-WAY)

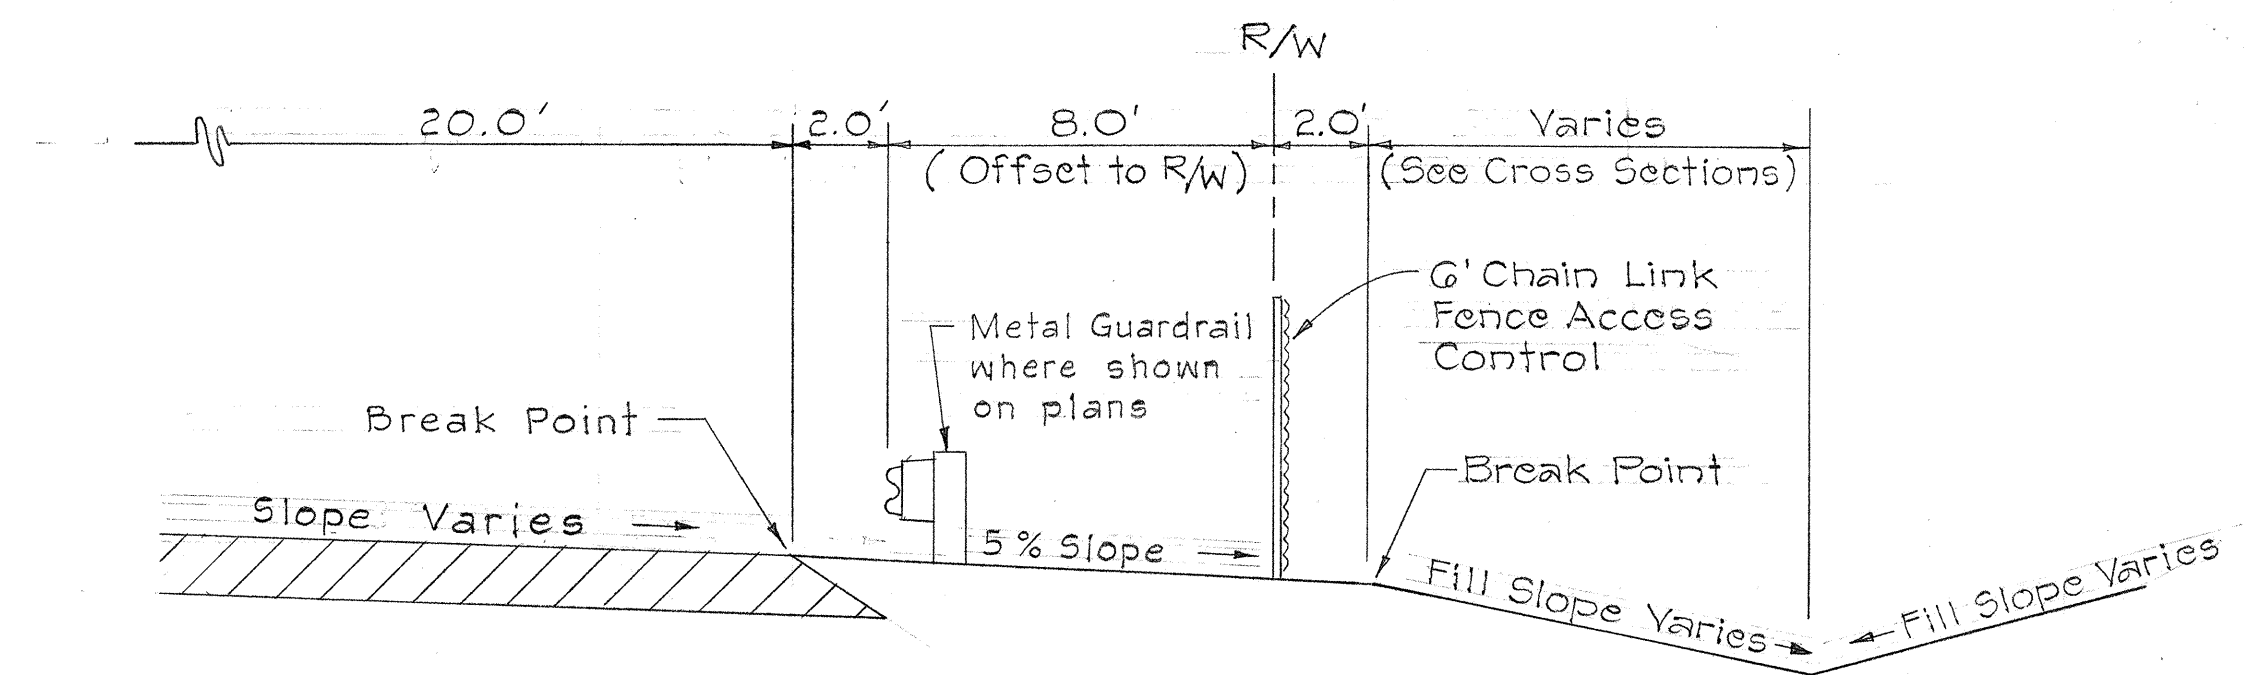


TYPICAL CANE HAUL ROAD SHOULDER IN FILL SECTION ADJACENT TO INTERSTATE LANES

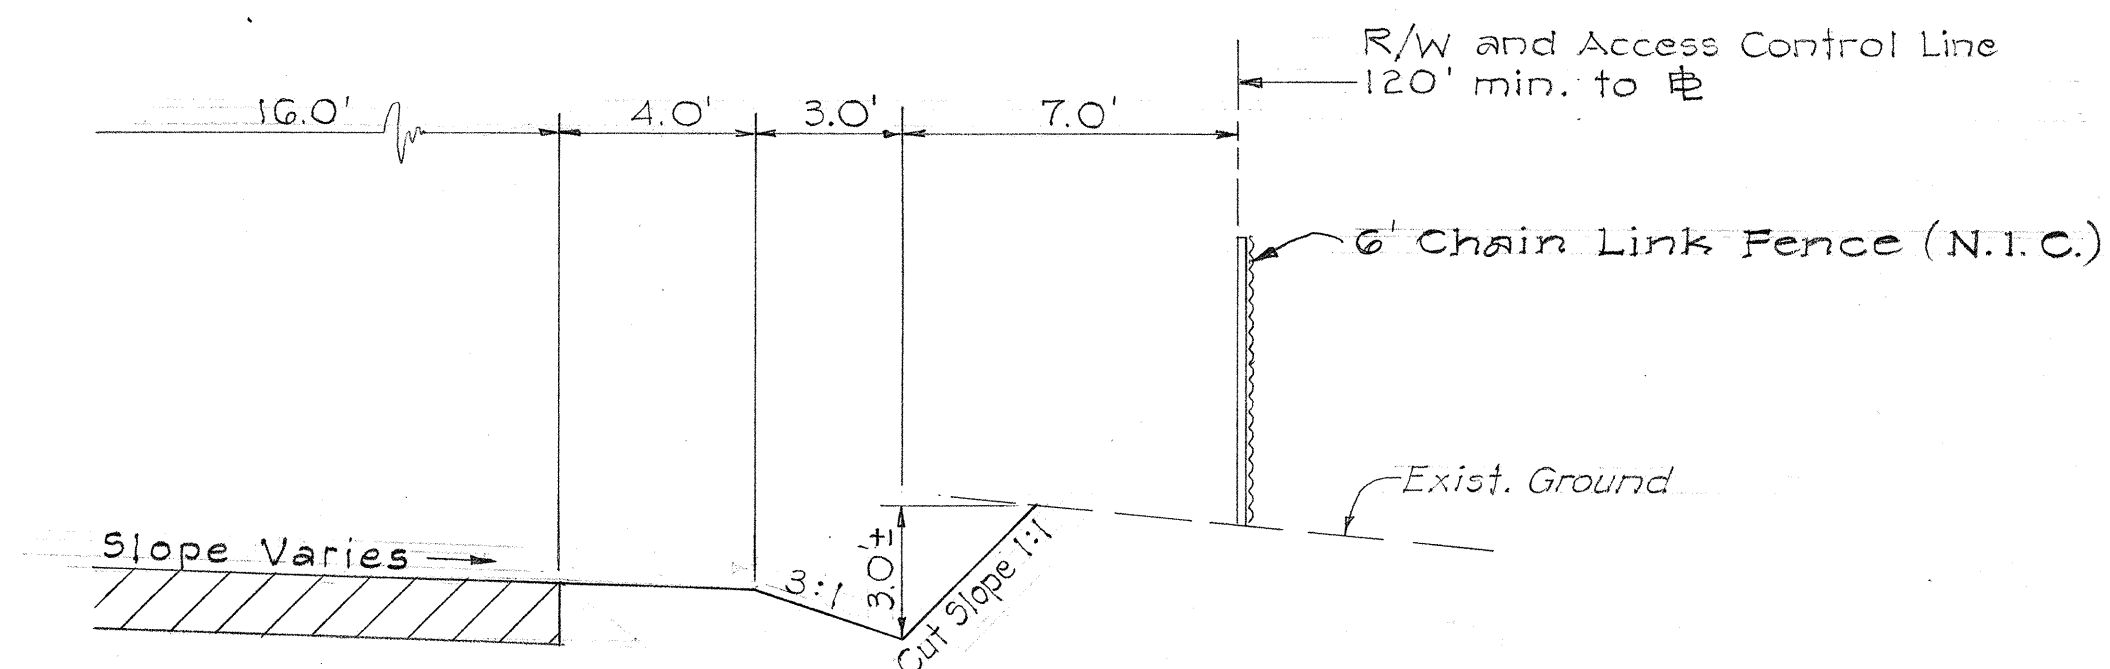

TYPICAL CANE HAUL ROAD SHOULDER IN CUT SECTION ADJACENT TO INTERSTATE LANES

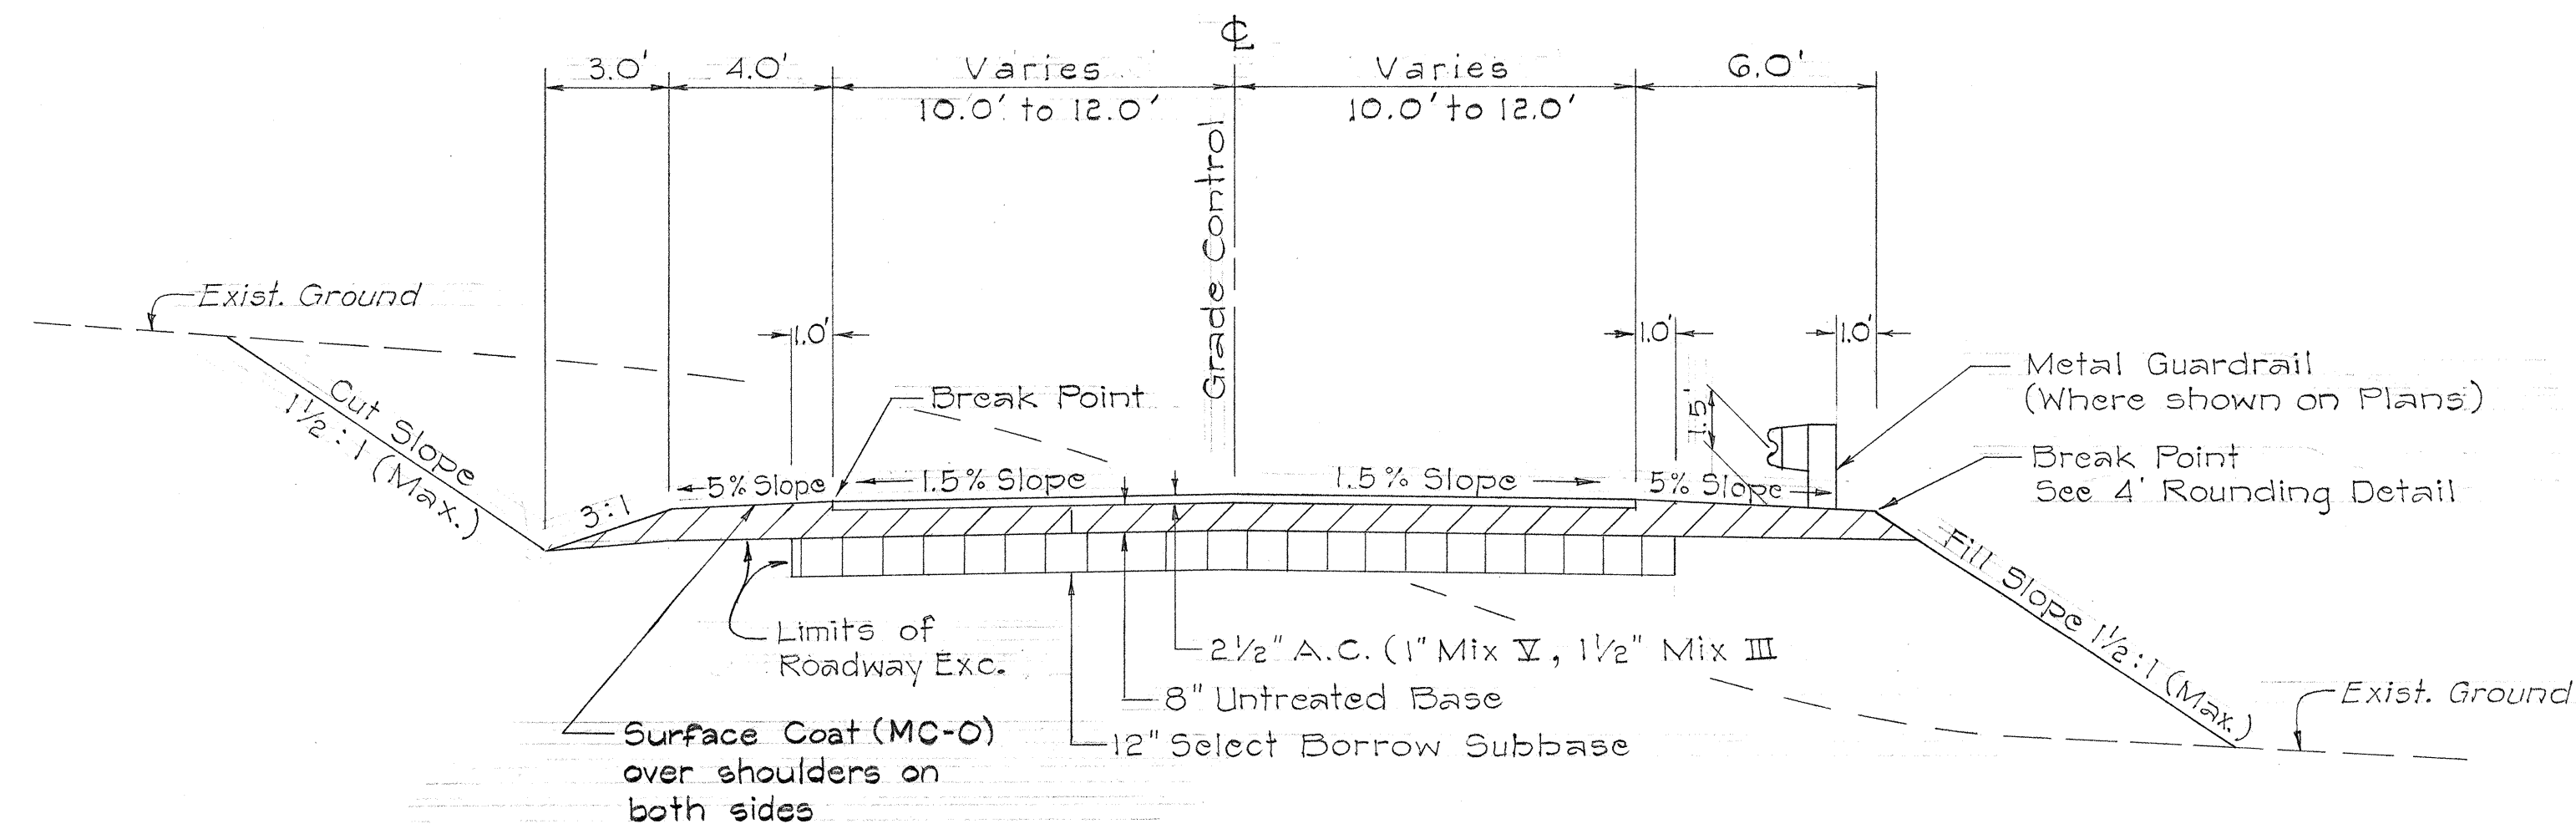

MILITARY ACCESS ROAD

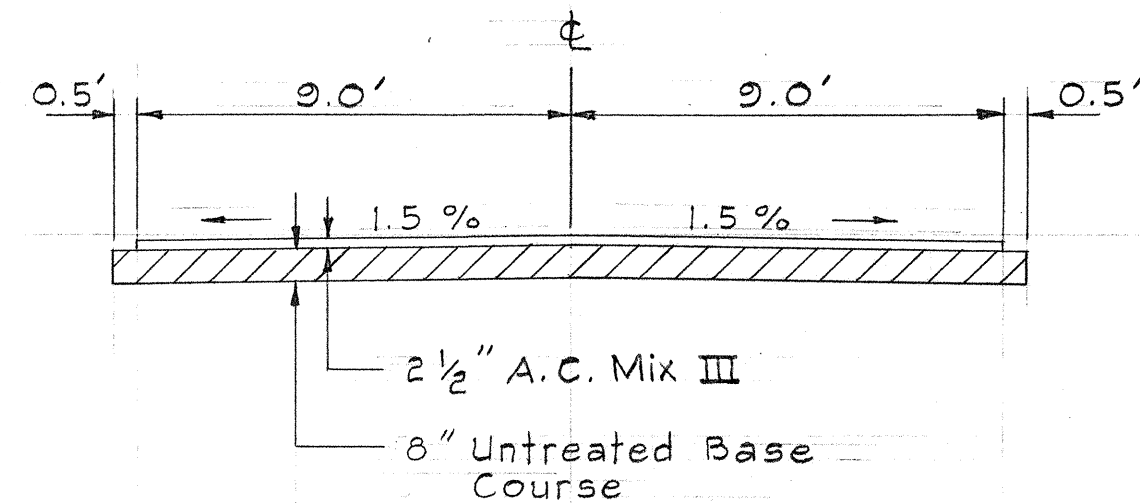

TYPICAL SECTION - DETOUR ROAD

STATE OF HAWAII	
DEPARTMENT OF TRANSPORTATION	
HIGHWAYS DIVISION	
TYPICAL SECTIONS	
CANE HAUL ROADS	
INTERSTATE ROUTE H-1	
F.A.I. Proj. No. I-HI-1(32):5, Unit 1	
Scale: 1/4" = 1'-0"	Date: Aug. 1966
SHEET No. 4	OF 73 SHEETS

DATE	BY
DESIGNED BY	
DRAWN BY	
CHECKED BY	
NOTED BY	
NO.	