
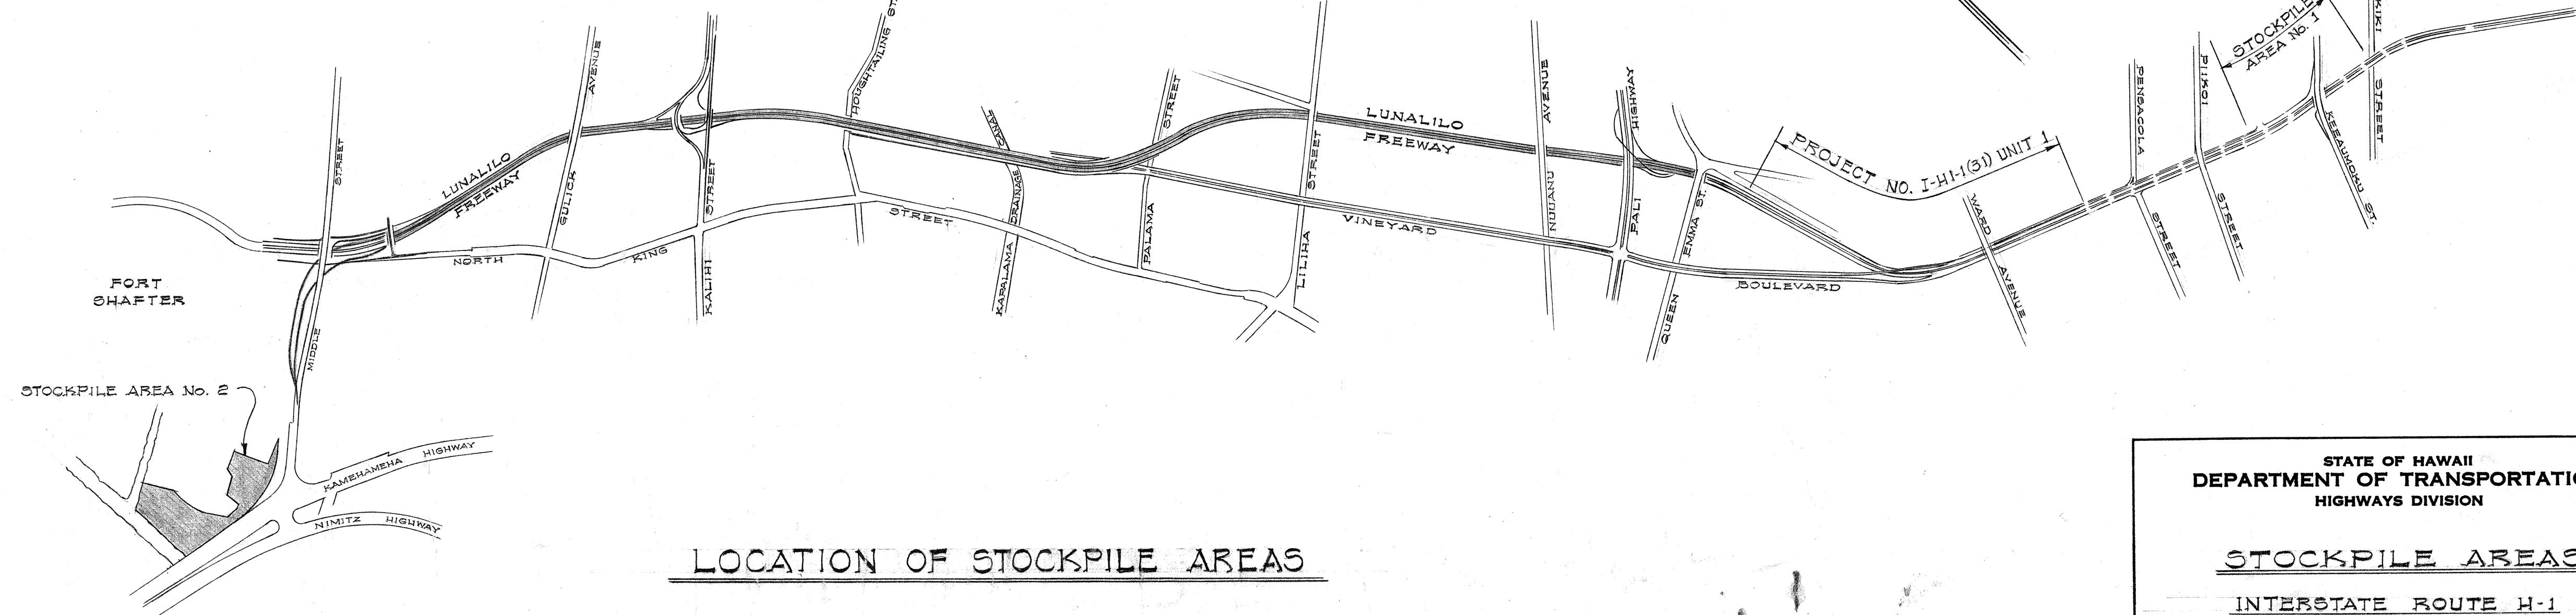
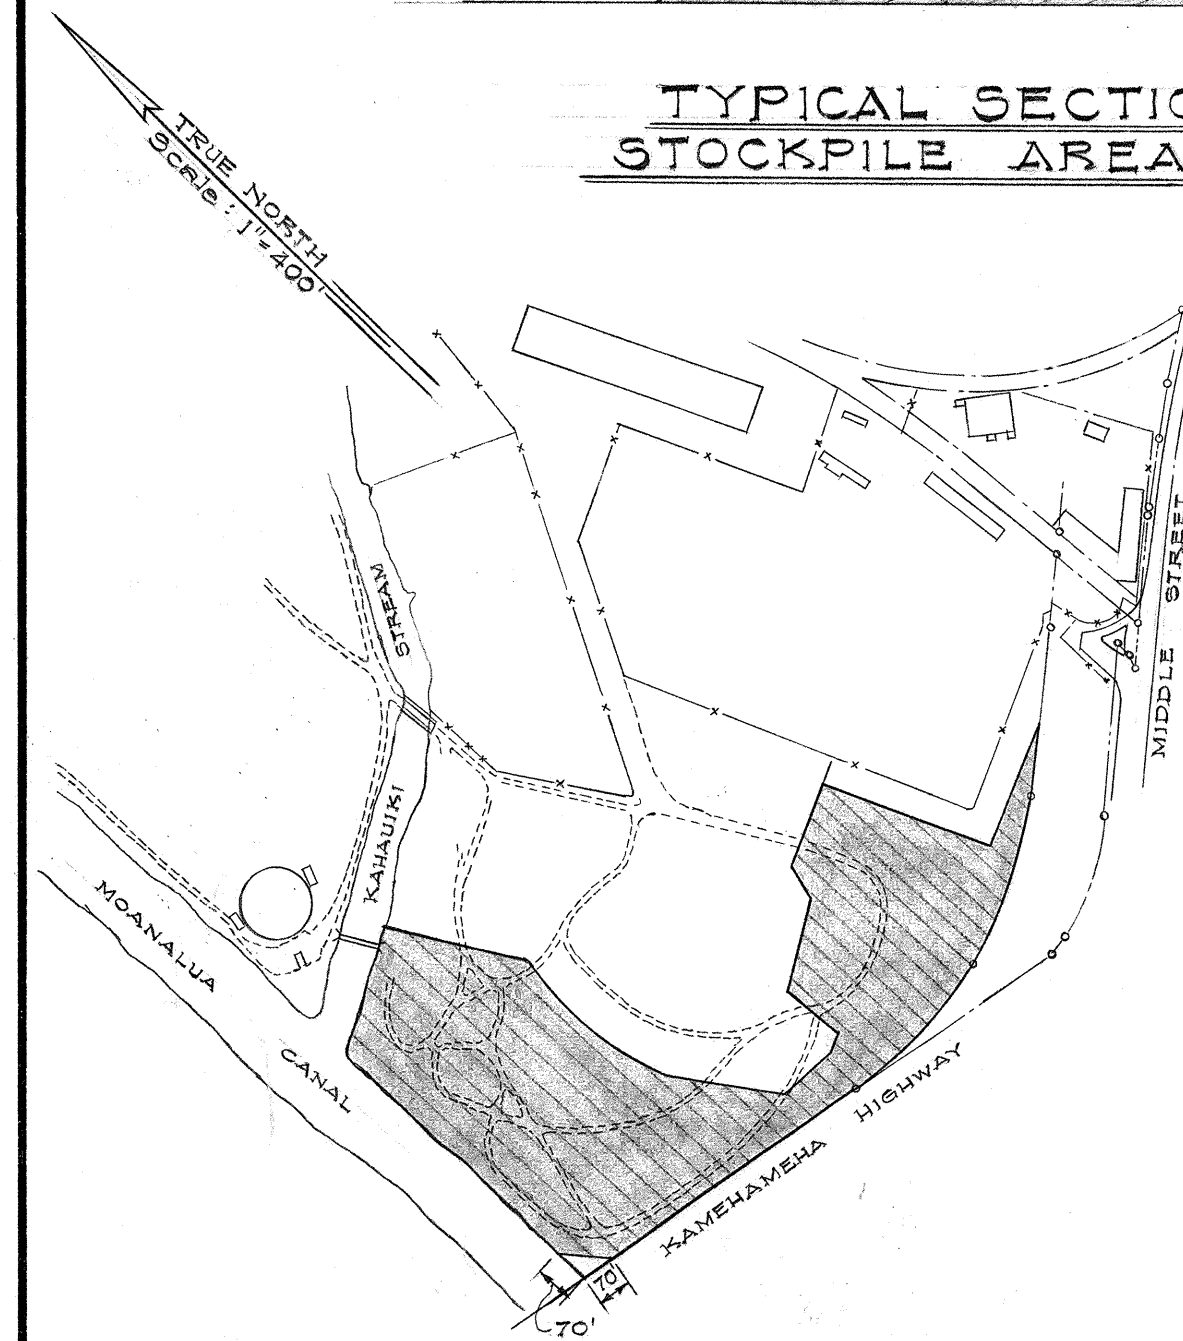
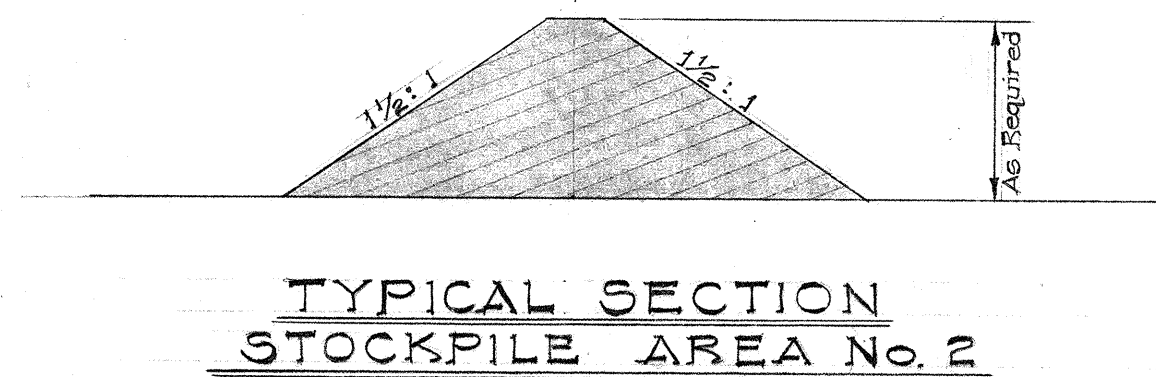
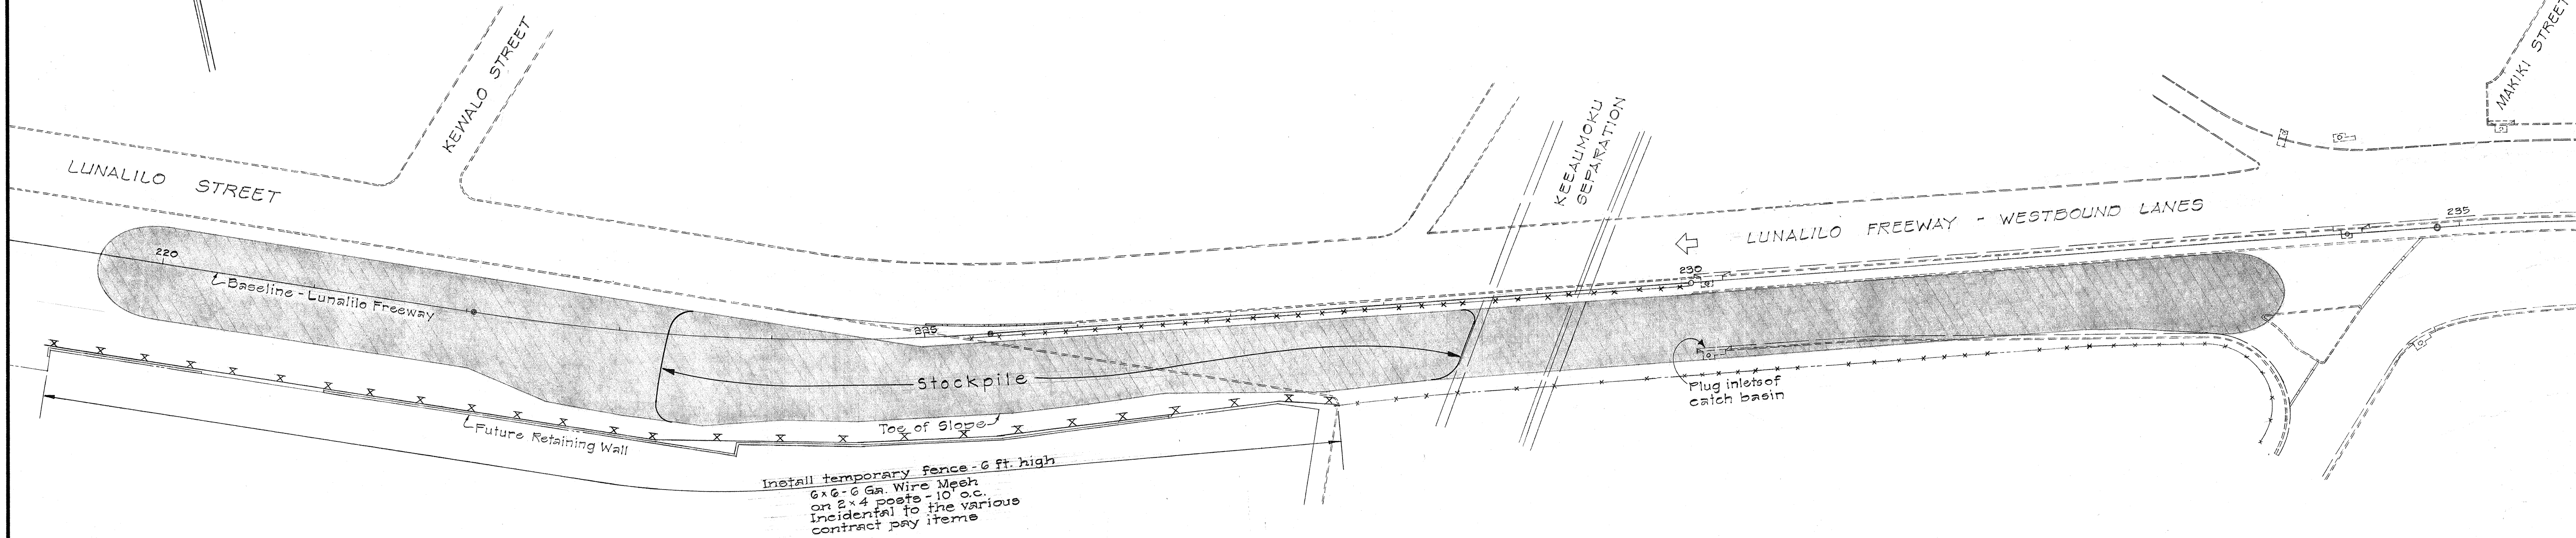
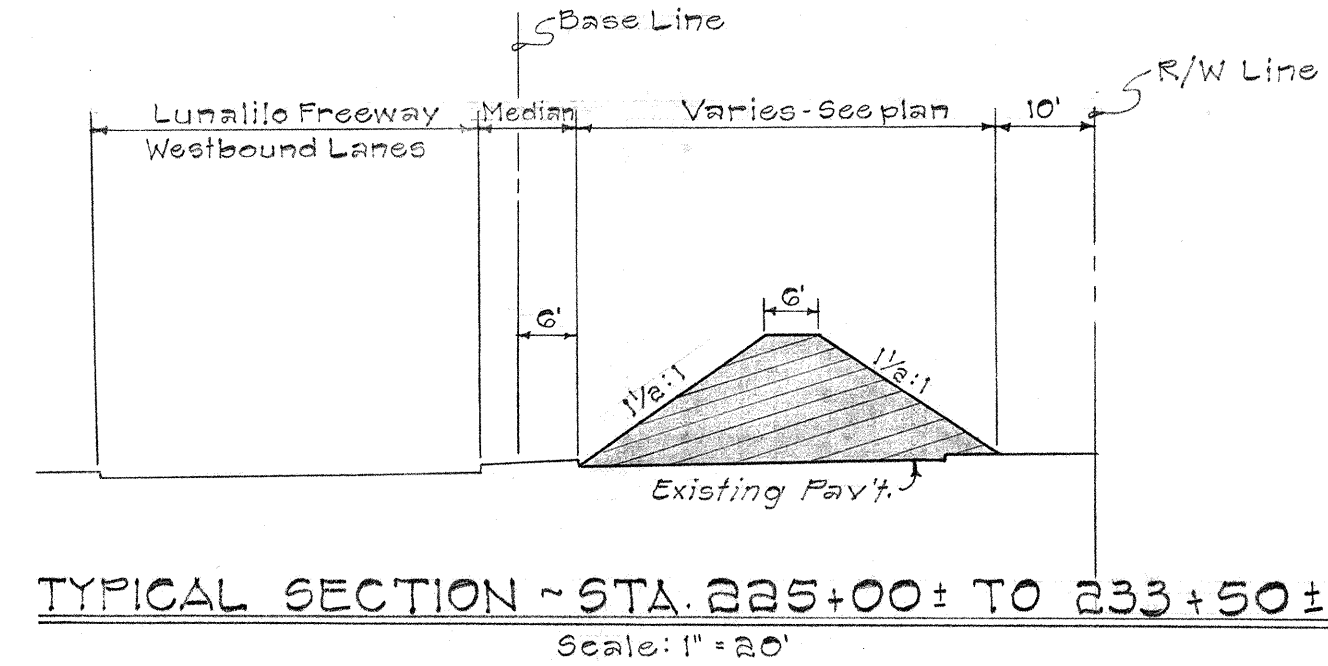


FED. ROAD DIST. NO.	STATE	FED. AID PROJ. NO.	FISCAL YEAR	SHEET NO.	TOTAL SHEETS
HAWAII	HAW.	I-H-1(31) Unit 1	1967	30	222

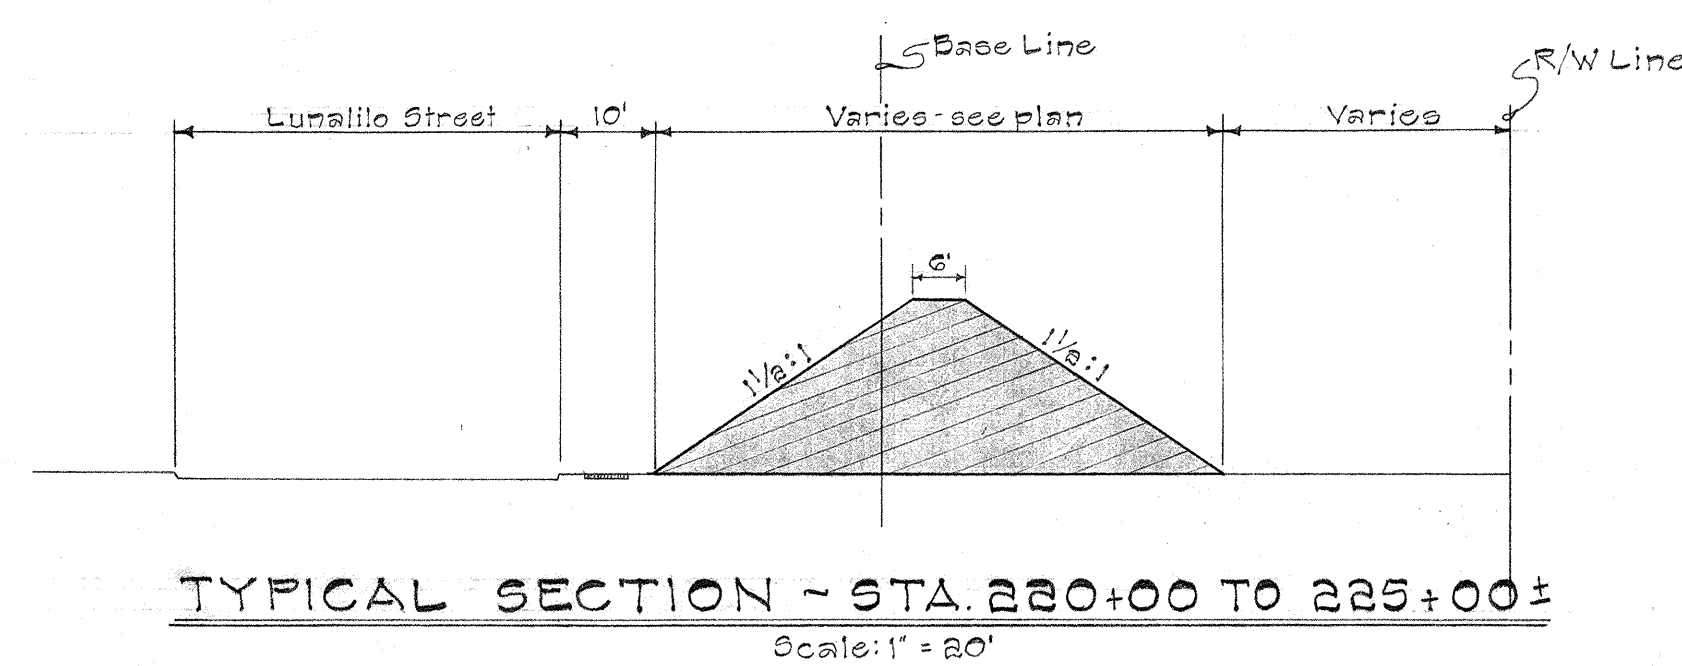

NOTE:
Distance from center of mass at Stockpile Area No. 2 to center of mass at F.A.I.P. No. I-H-1(31), Unit 1 is 3.8 miles (4.0 miles - 0.2 mile freehaul)

STATE OF HAWAII
DEPARTMENT OF TRANSPORTATION
HIGHWAYS DIVISION

STOCKPILE AREAS

INTERSTATE ROUTE H-1
(LUNALILO FREEWAY)
Pele Street to Victoria Street
F.A.I. Proj. No. I-H-1(31), Unit 1

Scale: As Shown Date: May, 1966

SHEET No. 1 OF 1 SHEETS

ORIGINAL PLAN	DATE
DRAWN BY	DESIGNED BY
CHECKED BY	NOTED BY
NO.	