




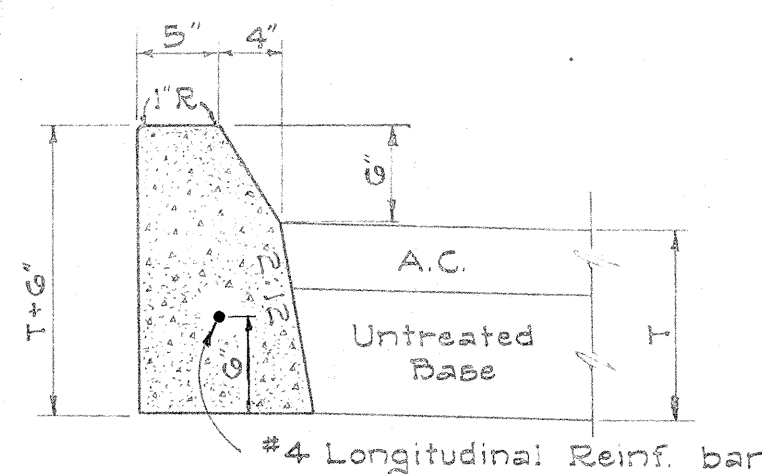


TYPE "A" CURB

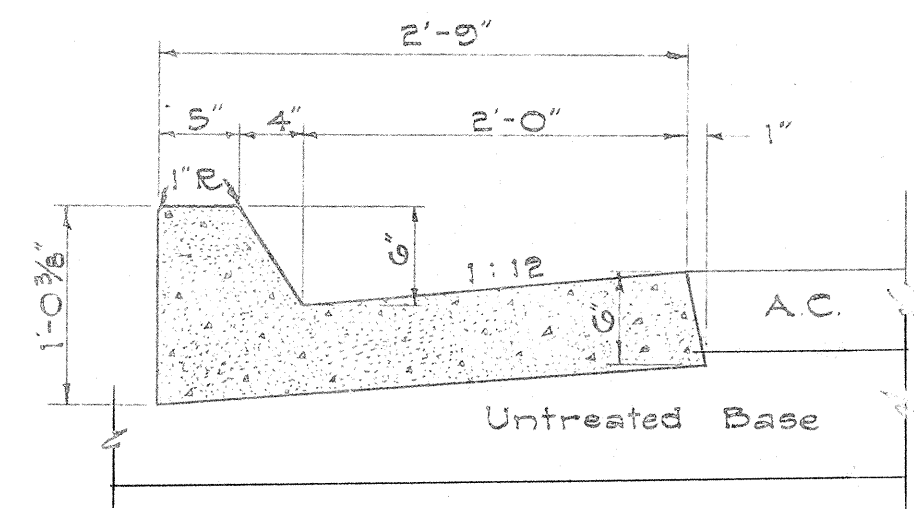


TYPE "AG" CURB & GUTTER

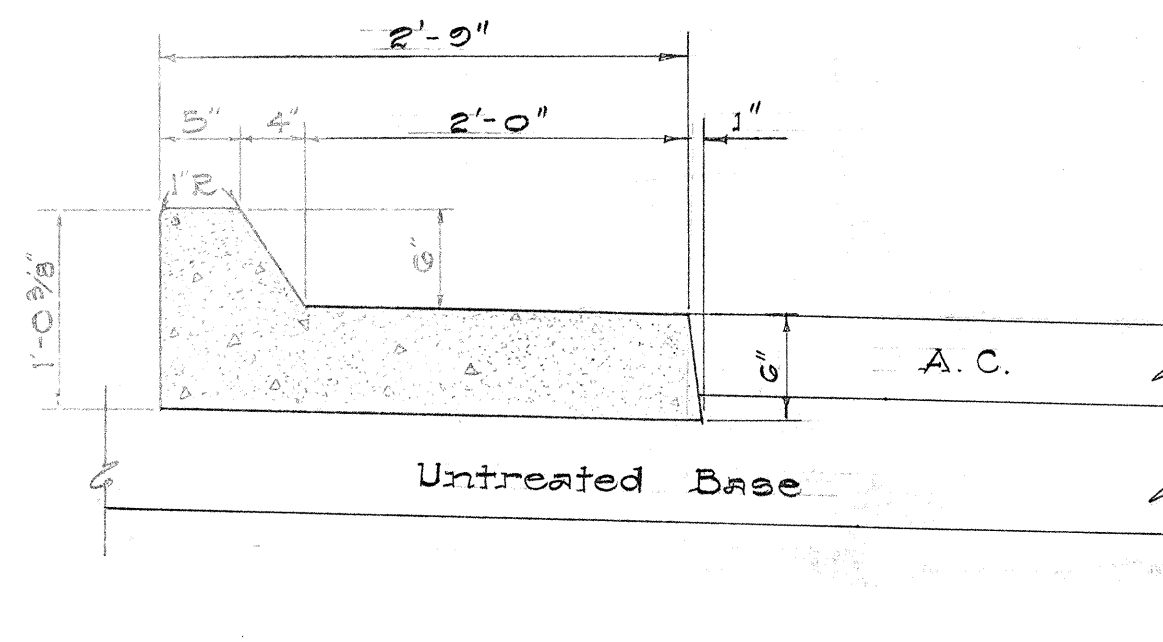


TYPE "AG-M" CURB & GUTTER

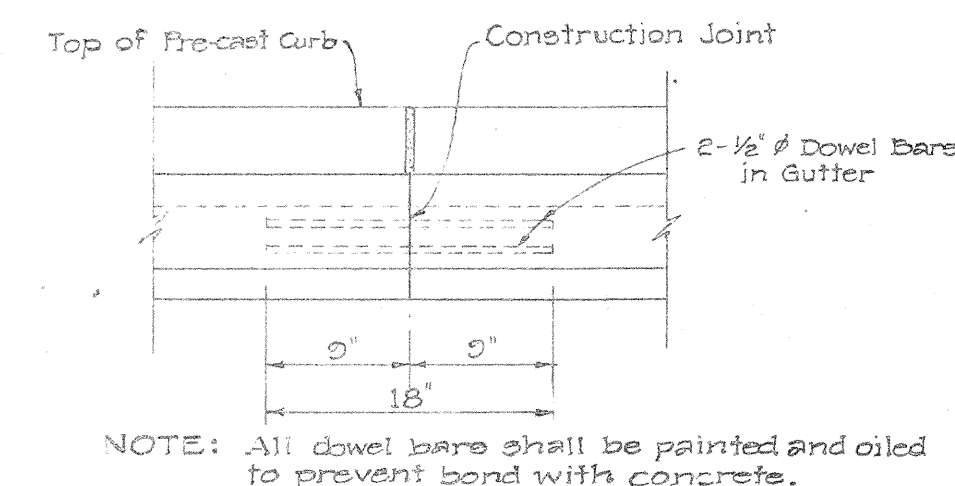


CONSTRUCTION JOINT DETAIL FOR TYPE "A" C.I.P. GUTTER
Scale: 1"=1'-0"

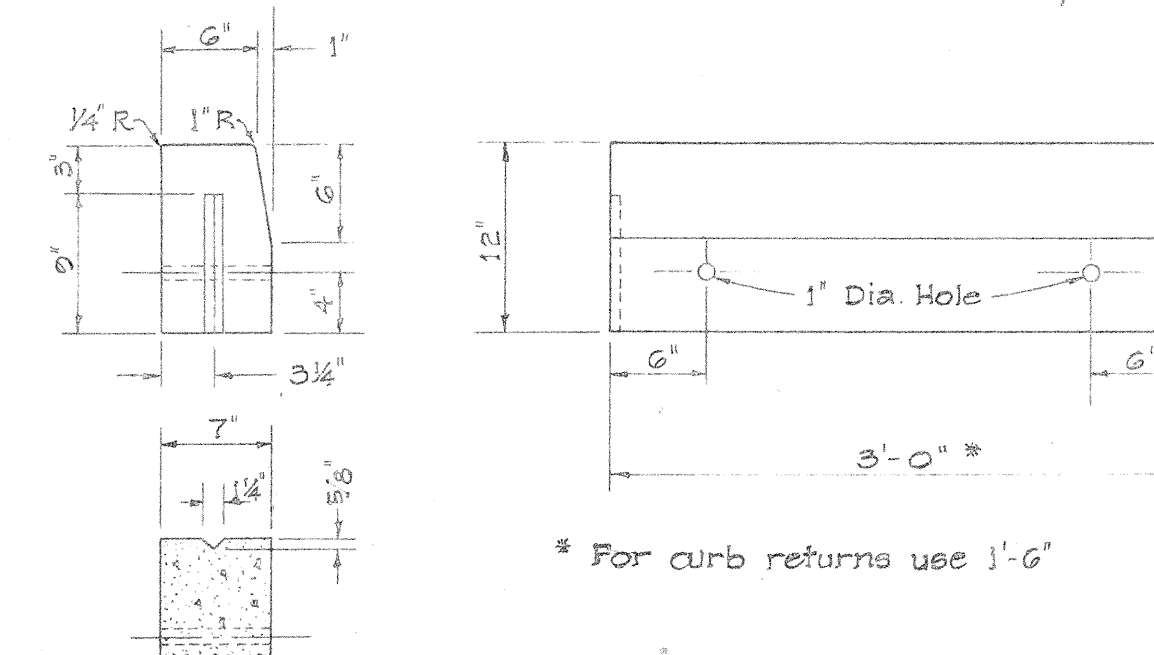


PRECAST CONCRETE CURB

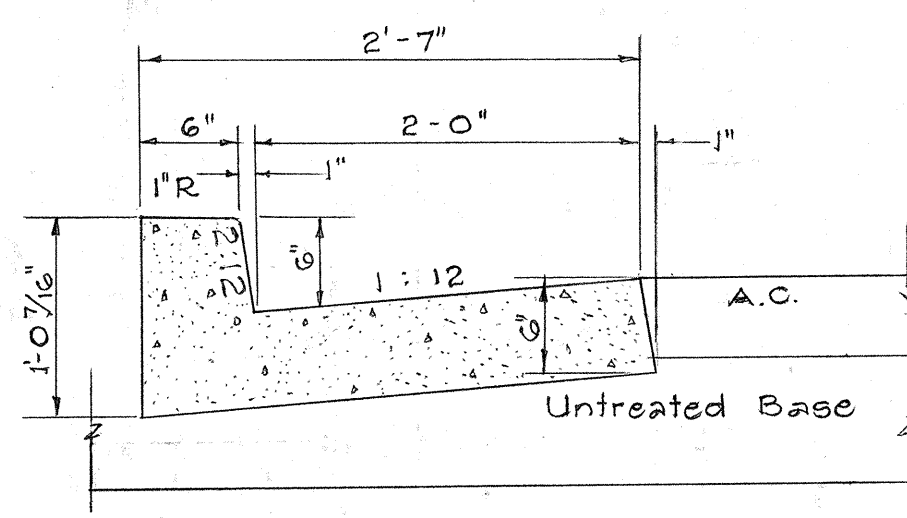


TYPE "DG" CURB & GUTTER

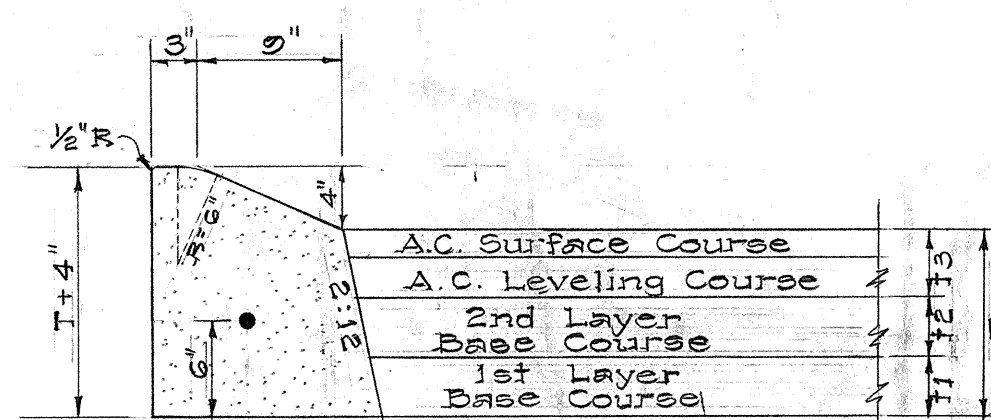


TYPE "E" CAST-IN-PLACE CONCRETE CURB

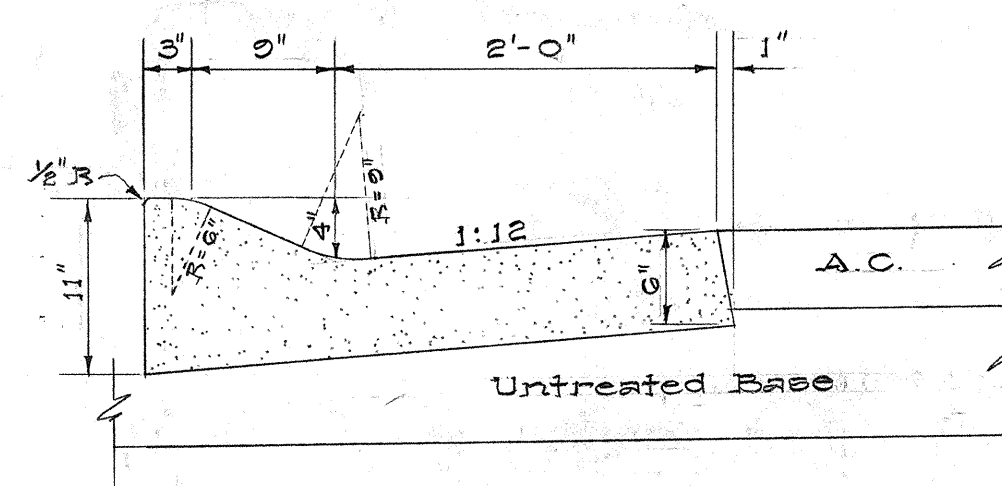

TYPE "EG" CURB & GUTTER

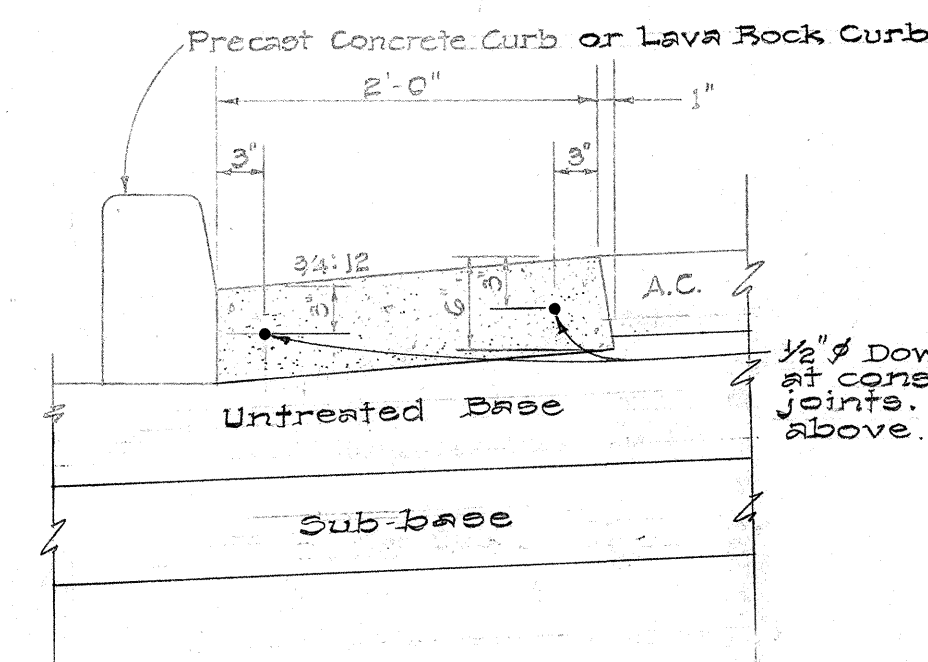


TYPE "A" CAST-IN-PLACE GUTTER
Scale: 1"=1'-0"

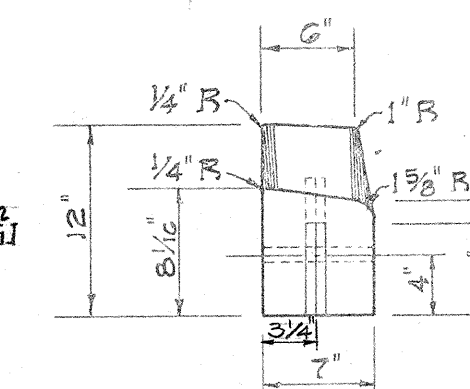


PRECAST CONCRETE DROP CURB


Note: * - Reduce to 3'-0" where shown on plans.

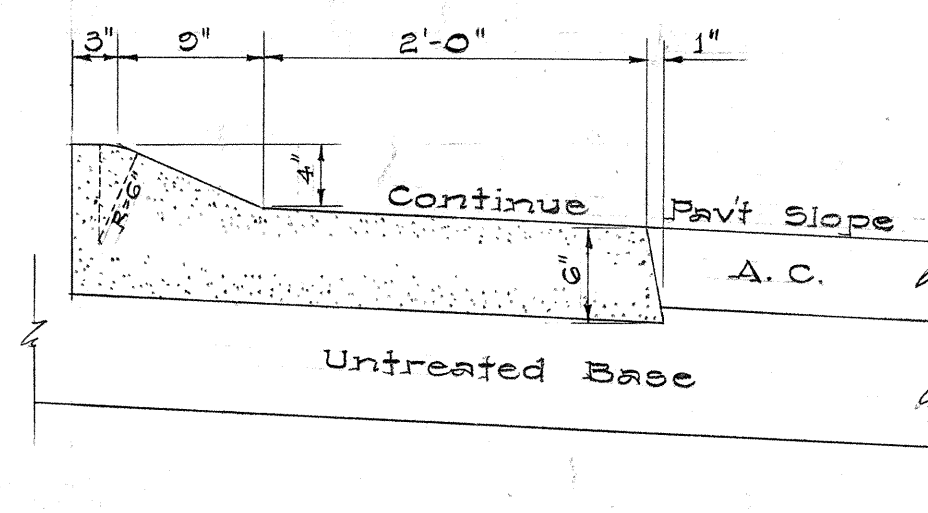


TYPE "EGS" CURB & GUTTER

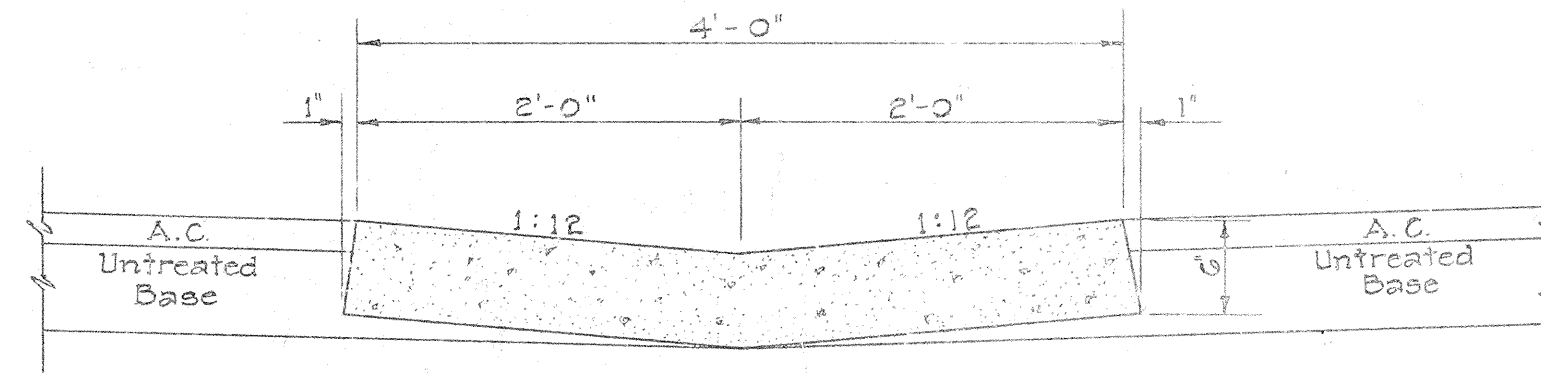

TYPE "G" GUTTER

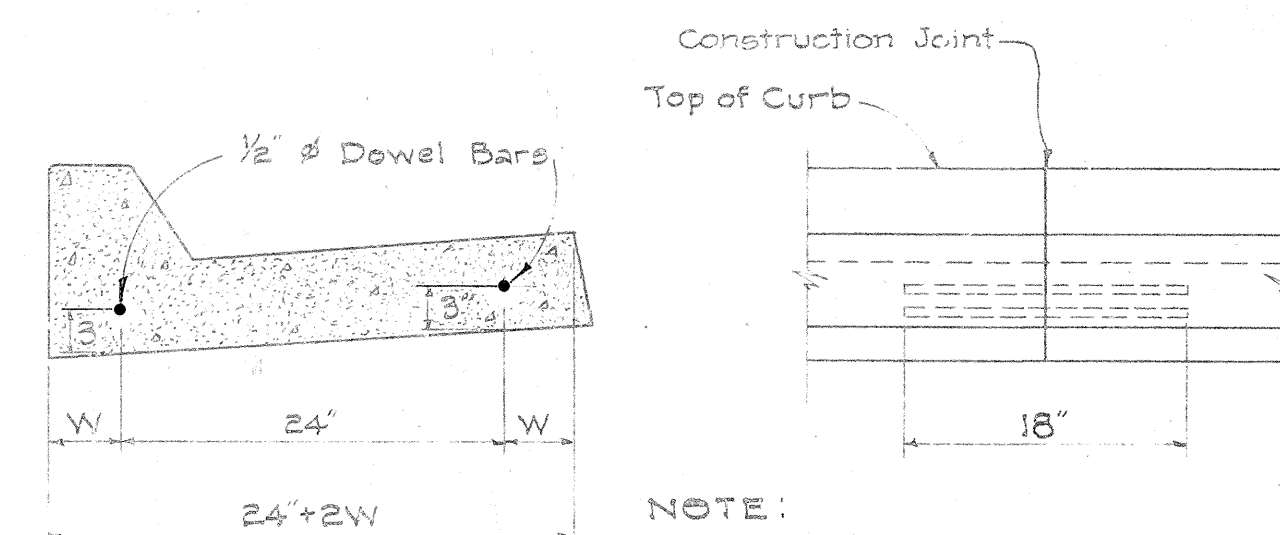


TYPICAL CONSTRUCTION JOINT DETAIL FOR CAST-IN-PLACE CONCRETE CURB & GUTTER
Scale: 1"=1'-0"

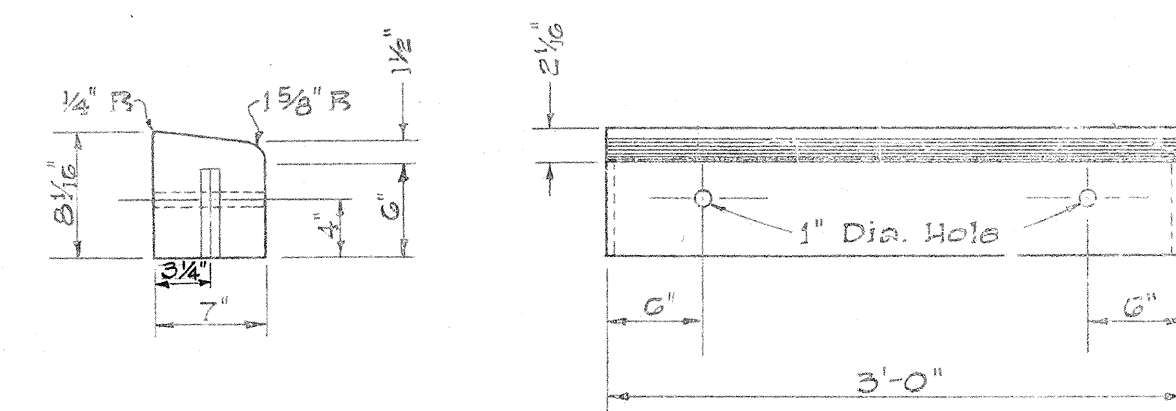

PRECAST CONCRETE DRIVEWAY CURB


PRECAST CONCRETE CURBS
Scale: 1"=1'-0"

DETAIL OF CAST-IN-PLACE CURBS, GUTTERS, AND CURBS & GUTTERS
Scale: 1"=1'-0"

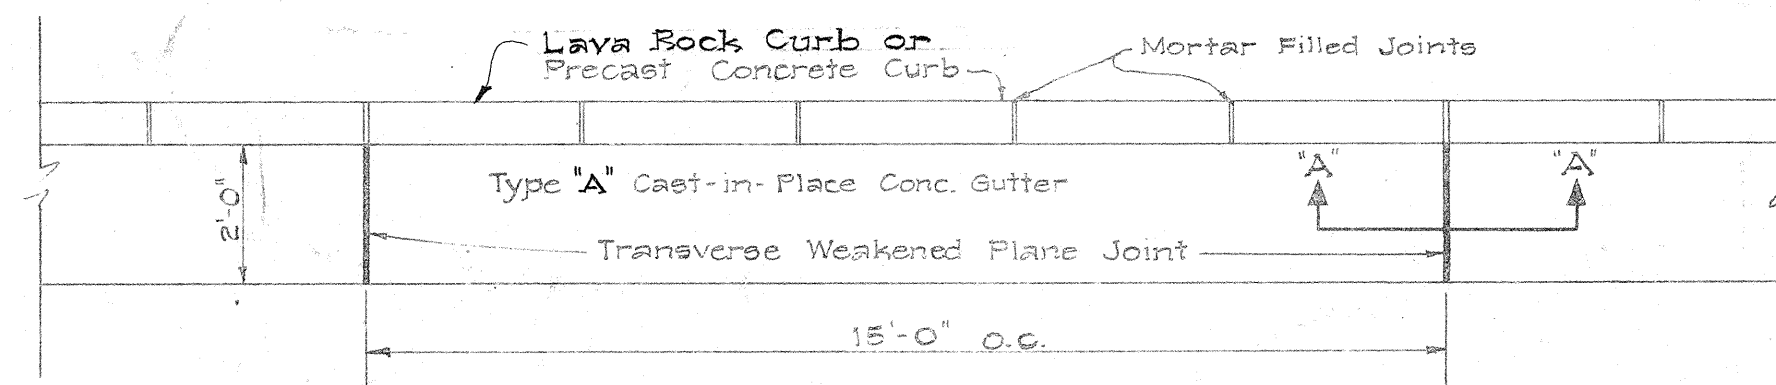


PLAN
Scale: 3/8"=1'-0"

TRANSVERSE WEAKENED PLANE JOINT DETAIL FOR TYPE "A" CAST-IN-PLACE CONC. GUTTERS
Scale: As Shown

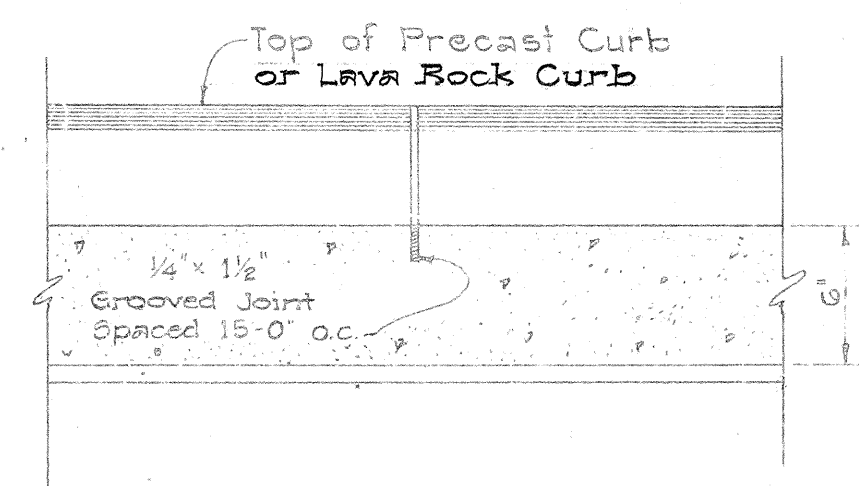

SECTION "A-A"
Scale: 1/2"=1'-0"

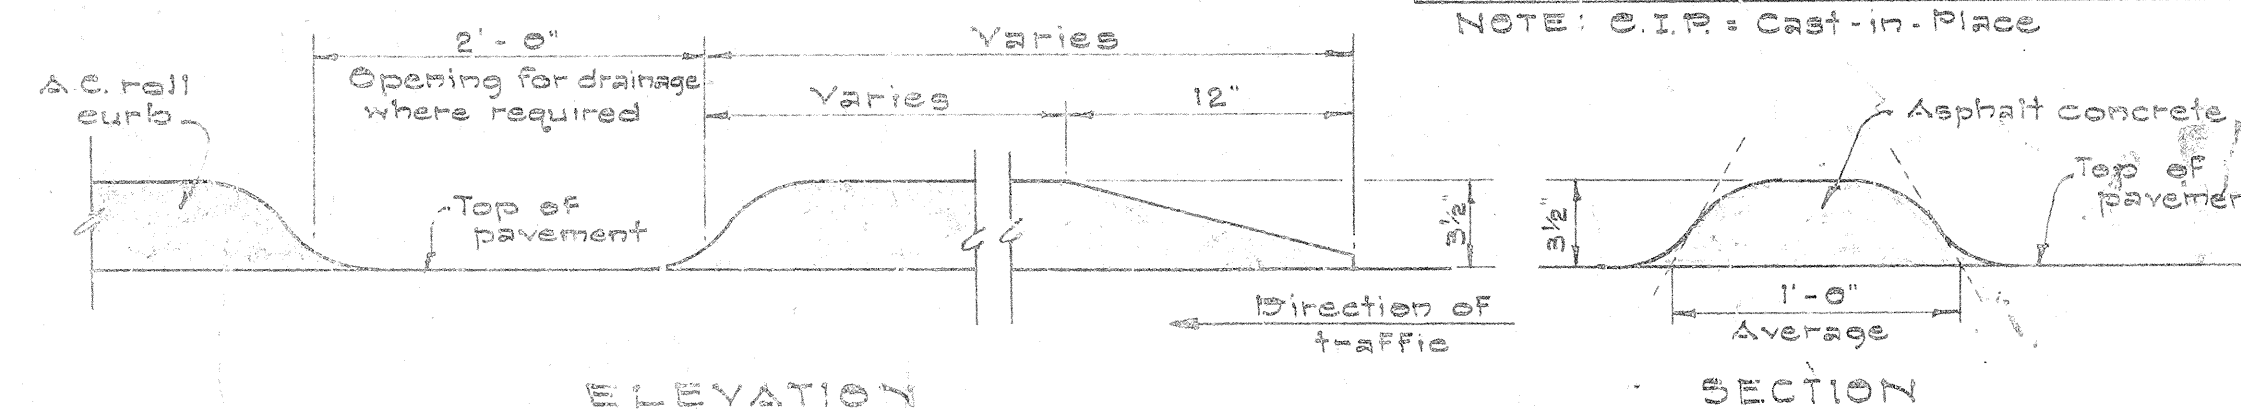

ELEVATION

A.C. TRAFFIC ROLL CURB
Not to Scale

PAYMENT FOR CURB AND CURB & GUTTER TRANSITIONS		
TYPE OF TRANSITION	MEASURED FOR PAYMENT AS:	
C.I.P. curb or Pre-Cast Curb	C.I.P. Curb & Gutter	C.I.P. Curb & Gutter
C.I.P. Curb & Gutter	Pre-Cast Curb & C.I.P. Gutter	C.I.P. Curb & Gutter
C.I.P. Curb & Gutter Type	C.I.P. Curb & Gutter Type	C.I.P. Curb & Gutter 1/2 of Transition to each type
C.I.P. Curb Type	C.I.P. Curb Type	C.I.P. Curb 1/2 of Transition to each type
Bridge Abutments	C.I.P. Curb and/or Gutter or Pre-Cast Curb or Lava Rock Curb	C.I.P. Curb and/or Gutter or Pre-Cast Curb or Lava Rock Curb

NOTE: C.I.P. = Cast-in-Place


STATE OF HAWAII
DEPARTMENT OF TRANSPORTATION
DETAILS FOR CONCRETE CURBS AND GUTTERS
INTERSTATE ROUTE H-1 (LUNALILO FREEWAY)
Pele Street to Victoria Street
H.A.I. Proj. No. I-HI-1(31), Unit 1
Scale: As Shown Date: April, 1966
SHEET NO. 1 OF 10 SHEETS

CURB AND CURB & GUTTER QUANTITIES

LOCATION			LINEAL FEET									
			Reconstructed Lava Rock Curb	A.C. Roll	Precast Conc. Curb	Type "A" Curb	Type "A" Gutter	Type "AG" Curb & Gutter	Type "AGM" Curb & Gutter	Type "E" Curb	Type "DG" Curb & Gutter	Type "G" Gutter
Freeway (Westbound)	1G4+88 to 1G9+00	Median						412				
Freeway (Westbound)	1G9+00 to 199+00	Median		10				3,000				
Freeway (Westbound)	1G4+45 to 1G5+25	Left				88					2,118	
Freeway (Westbound)	1G6+27 to 187+45	Left									1,114	
Freeway (Westbound)	187+G4 to 187+75	Left				14						
Freeway (Westbound)	187+G5 to 199+00	Left										
Freeway (Eastbound)	1G4+95 to 177+20	Median						1,225				
Freeway (Eastbound)	177+20 to 190+40	Median						1,320				
Freeway (Eastbound)	190+58 to 199+00	Median						842				
Freeway (Eastbound)	171+30 to 174+80	Right									350	
Freeway (Eastbound)	183+90 to 188+37	Right						470				
Freeway (Eastbound)	190+00 to 195+25	Right									52G	
Ramp "H"	1G5+25 to 171+30	Right									605	
Ramp "B-1"	B-1 Sta. 0+35 to B-1 Sta. 4+96.04	Right									49G	
Ramp "B-1"	B-1 Sta. 4+96 to B-1 Sta. 7+30	Lt. & Rt.						235		235		
Ramp "C"	4 Ward G+22.94 to 4 198+80	Lt. & Rt.									850	
Ramp "E"	199+00 to 202+70	Left									370	
Vineyard (Westbound)	Vin. 151+75 to Vin. 159+30	Median				755						
Vineyard (Westbound)	Vin. 1G3+92 to Vin. 1G8+10	Rt. E.P.				418						
Vineyard (Westbound)	Vin. 151+90 to Vin. 159+31	Lt. E.P.									7G6	
Vineyard (Westbound)	Vin. 1G3+92 to Vin. 1G8+00	Lt. E.P.									408	
Vineyard (Eastbound)	Vin. 152+55 to Vin. 1G0+13	Median				758						
Vineyard (Eastbound)	Vin. 1G2+50 to Vin. 1G9+09	Lt. E.P.						650				
Vineyard (Eastbound)	Vin. 1G2+50 to Vin. 1G3+10	Rt. E.P.									60	
Vineyard (Eastbound)	Vin. 154+50 to Vin. 1G0+13	Rt. E.P.									5G3	
Frontage Road "J"	"J" 3+G7 to "J" 5+57	Right	149									
Frontage Road "J"	"J" 8+07 to "J" 8+57	Right	50									
Frontage Road "J"	"J" 10+50 to "J" 11+00	Right	35									
Frontage Road "J"	"J" 11+75	Right	50									
Frontage Road "J"	"J" 12+80	Right	30									
Frontage Road "J"	"J" 14+50	Right	50									
Frontage Road "J"	"J" 19+00 to 27+00	Right	800					612				
Frontage Road "J"	"J" 19+00 to 21+50	Left	281									
Frontage Road "J"	"J" 21+37 to 21+75	Left										38
Frontage Road "J"	"J" 24+11 to 25+81	Left			172		142					
Frontage Road "J"	"J" 25+G5 to 26+37	Left										73
Frontage Road "J"	"J" 27+00 to 29+85	Right	2G7					237				
Frontage Road "J"	"J" 27+20	Left	12									
Frontage Road "J"	"J" 30+55 to 41+12	Right	1,0G5									
Frontage Road "K"	"K" 0+00 to G+G8	Left			658		658					
Frontage Road "K"	"K" 0+00 to 0+75	Right			124							
Frontage Road "K"	"K" 0+75 to G+70	Right			595		595					
Pele St.	Cul-De-Sacs		187									
Miller St.	" " "		194									
Frear St.	" " "		192									
Launala St.	" " "		135									
Alapai St.	" " "		78									
Victoria St.	" " "		102									
Capt. Cook Ave.	" " "		3G0									
Ward Ave.	Ward G+20 to 8+40	Left			231		231					
Ward Ave.	Ward G+45 to 8+00	Right			15G		15G					
Lusitana	Vin. 153+25 to Lu 5+75.59		741	141			317				142	

NOTE:
All the quantities shown are original theoretical quantities. For actual quantities, refer to project ledger and/or computation book.

STATE OF HAWAII
DEPARTMENT OF TRANSPORTATION
HIGHWAYS DIVISION
4'-0" CHAIN LINK FENCE AND
ESTIMATED QUANTITIES OF
CHAIN LINK FENCE, CURBS,
AND CURBS & GUTTERS
INTERSTATE ROUTE H-1
(LUNALILO FREEWAY)
Pele Street to Victoria Street
F.A.I. Proj. No. 1-H1-1(31) Unit 1
Scale: 1/8" = 1'-0" Date: May, 1966
SHEET No. 2 OF 10 SHEETS

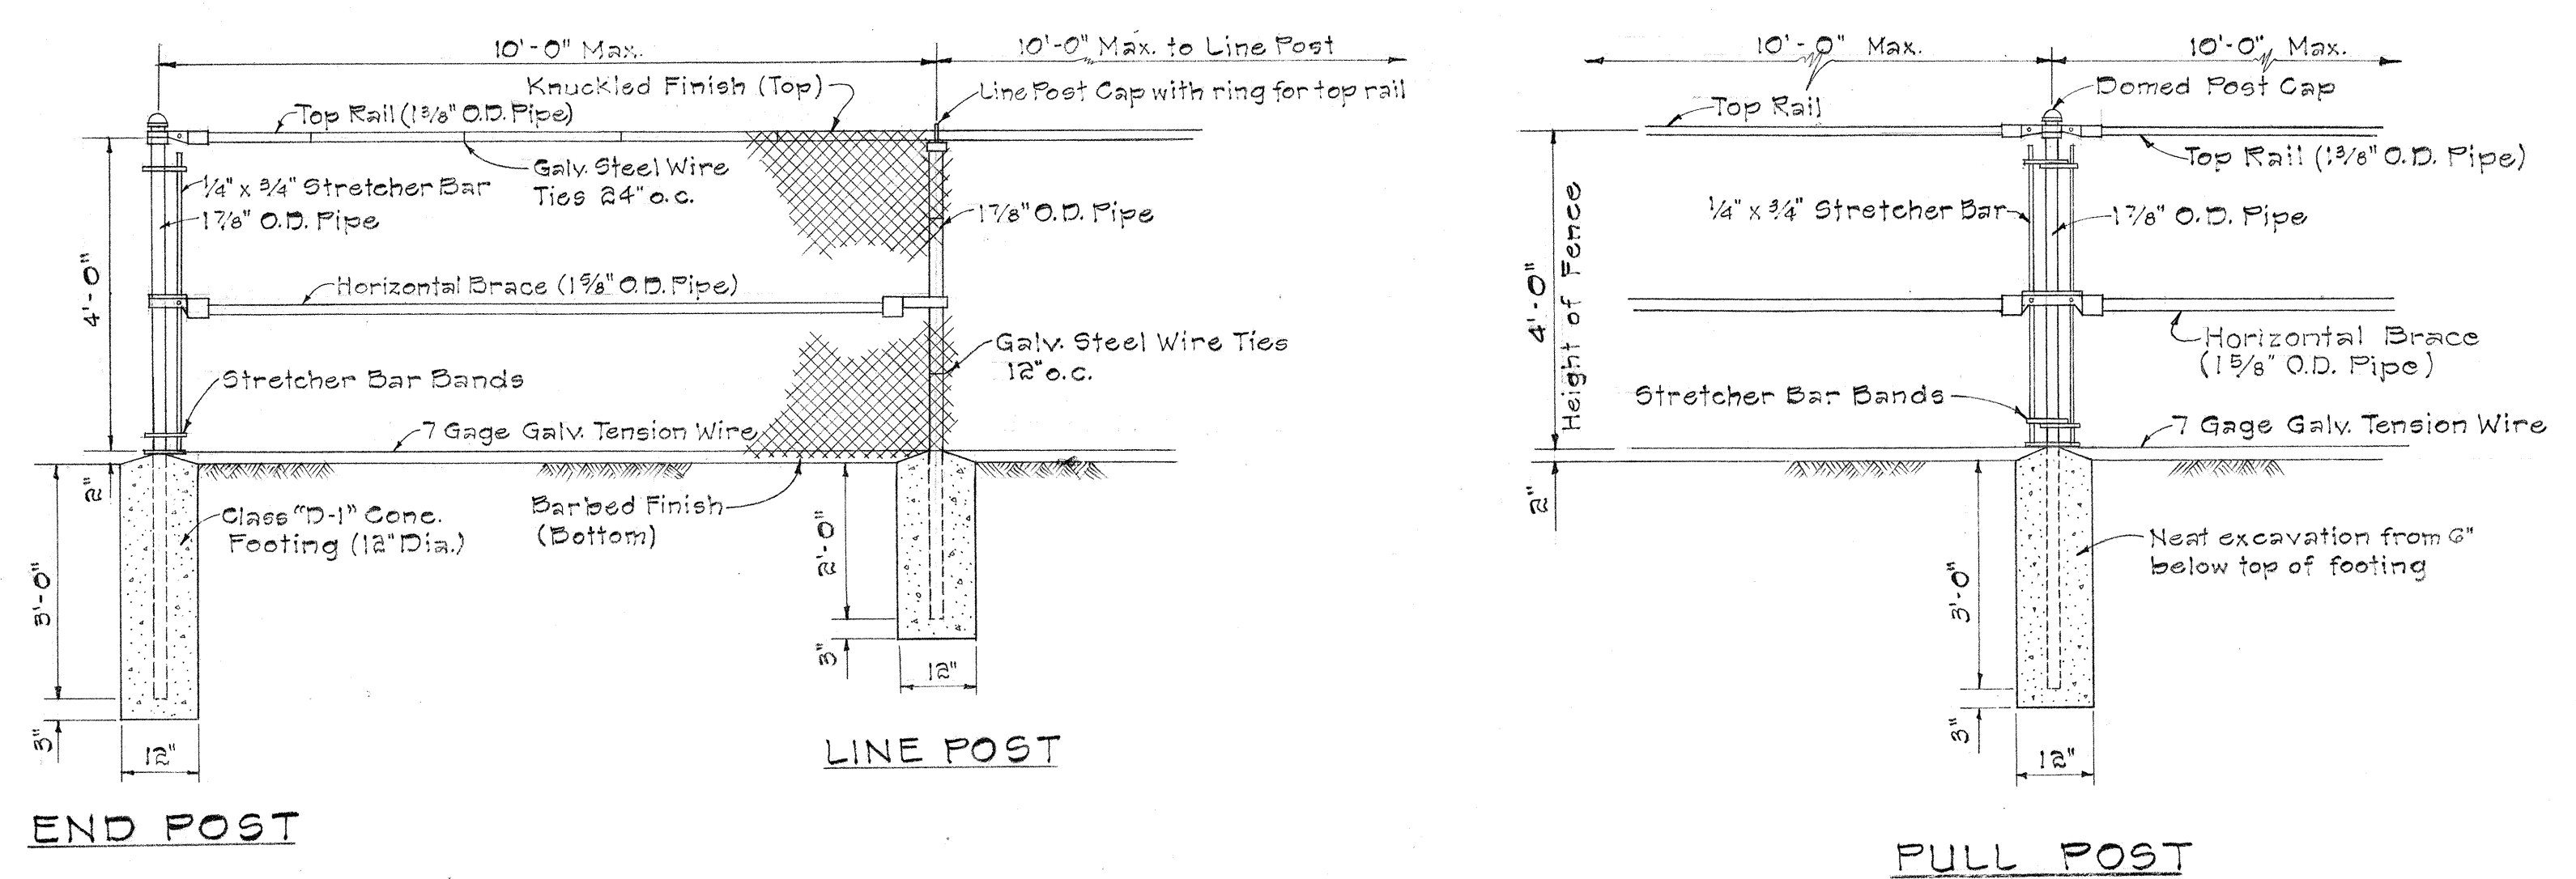


CHAIN LINK FENCE DETAIL
Scale: 1/8" = 1'-0"

CHAIN LINK FENCE QUANTITIES

LOCATION			Item 88.06 6-Ft. Chain Link Fence on Conc. Footing Lin. Ft.	Item 88.16 6-Ft. Chain Link Fence on Retain- ing Wall Lin. Ft.	Item 88.36 Reconstructed 6-Ft. Chain Link Fence on Ret. Wall Lin. Ft.	Item 88.14 4-Ft. Chain Link Fence on Ret. Wall Lin. Ft.	Item 88.24 4-Ft. Chain Link Fence on CRV Wall Lin. Ft.
Freeway (Westbound)	1G7+30 to 181+40	Left	1,028				
Freeway (Eastbound)	1G5+75 to 170+25	Right		450			
Freeway (Eastbound)	170+25 to 178+00	Right	811				
Freeway (Eastbound)	179+00 to 182+50	Right	188	75			
Freeway (Eastbound)	184+00 to 188+75	Right	510				
Freeway (Eastbound)	188+75 to 191+25	Right		248			
Freeway (Eastbound)	192+25 to 194+00	Right		202			
Freeway (Eastbound)	194+00 to 195+90	Right	188				
Freeway (Eastbound)	195+90 to 198+80	Right	297				
Freeway (Eastbound)	198+80 to 202+90	Right		442			
Freeway (Eastbound)	179+00 to 182+25	Right					385
Vineyard (Westbound)	151+90 to 157+20	Left	604				
Vineyard (Eastbound)	153+10 to Lu 3+80				2G5		
Vineyard (Eastbound)	155+00 to 158+90	Right	400				
Ward Ave.	G+30 to 7+45	Right				108	

ORIGINAL PLAN
DATE
SURVEY PLATTED BY
DRAWN BY
TRACED BY
NOTED BY
CHECKED BY

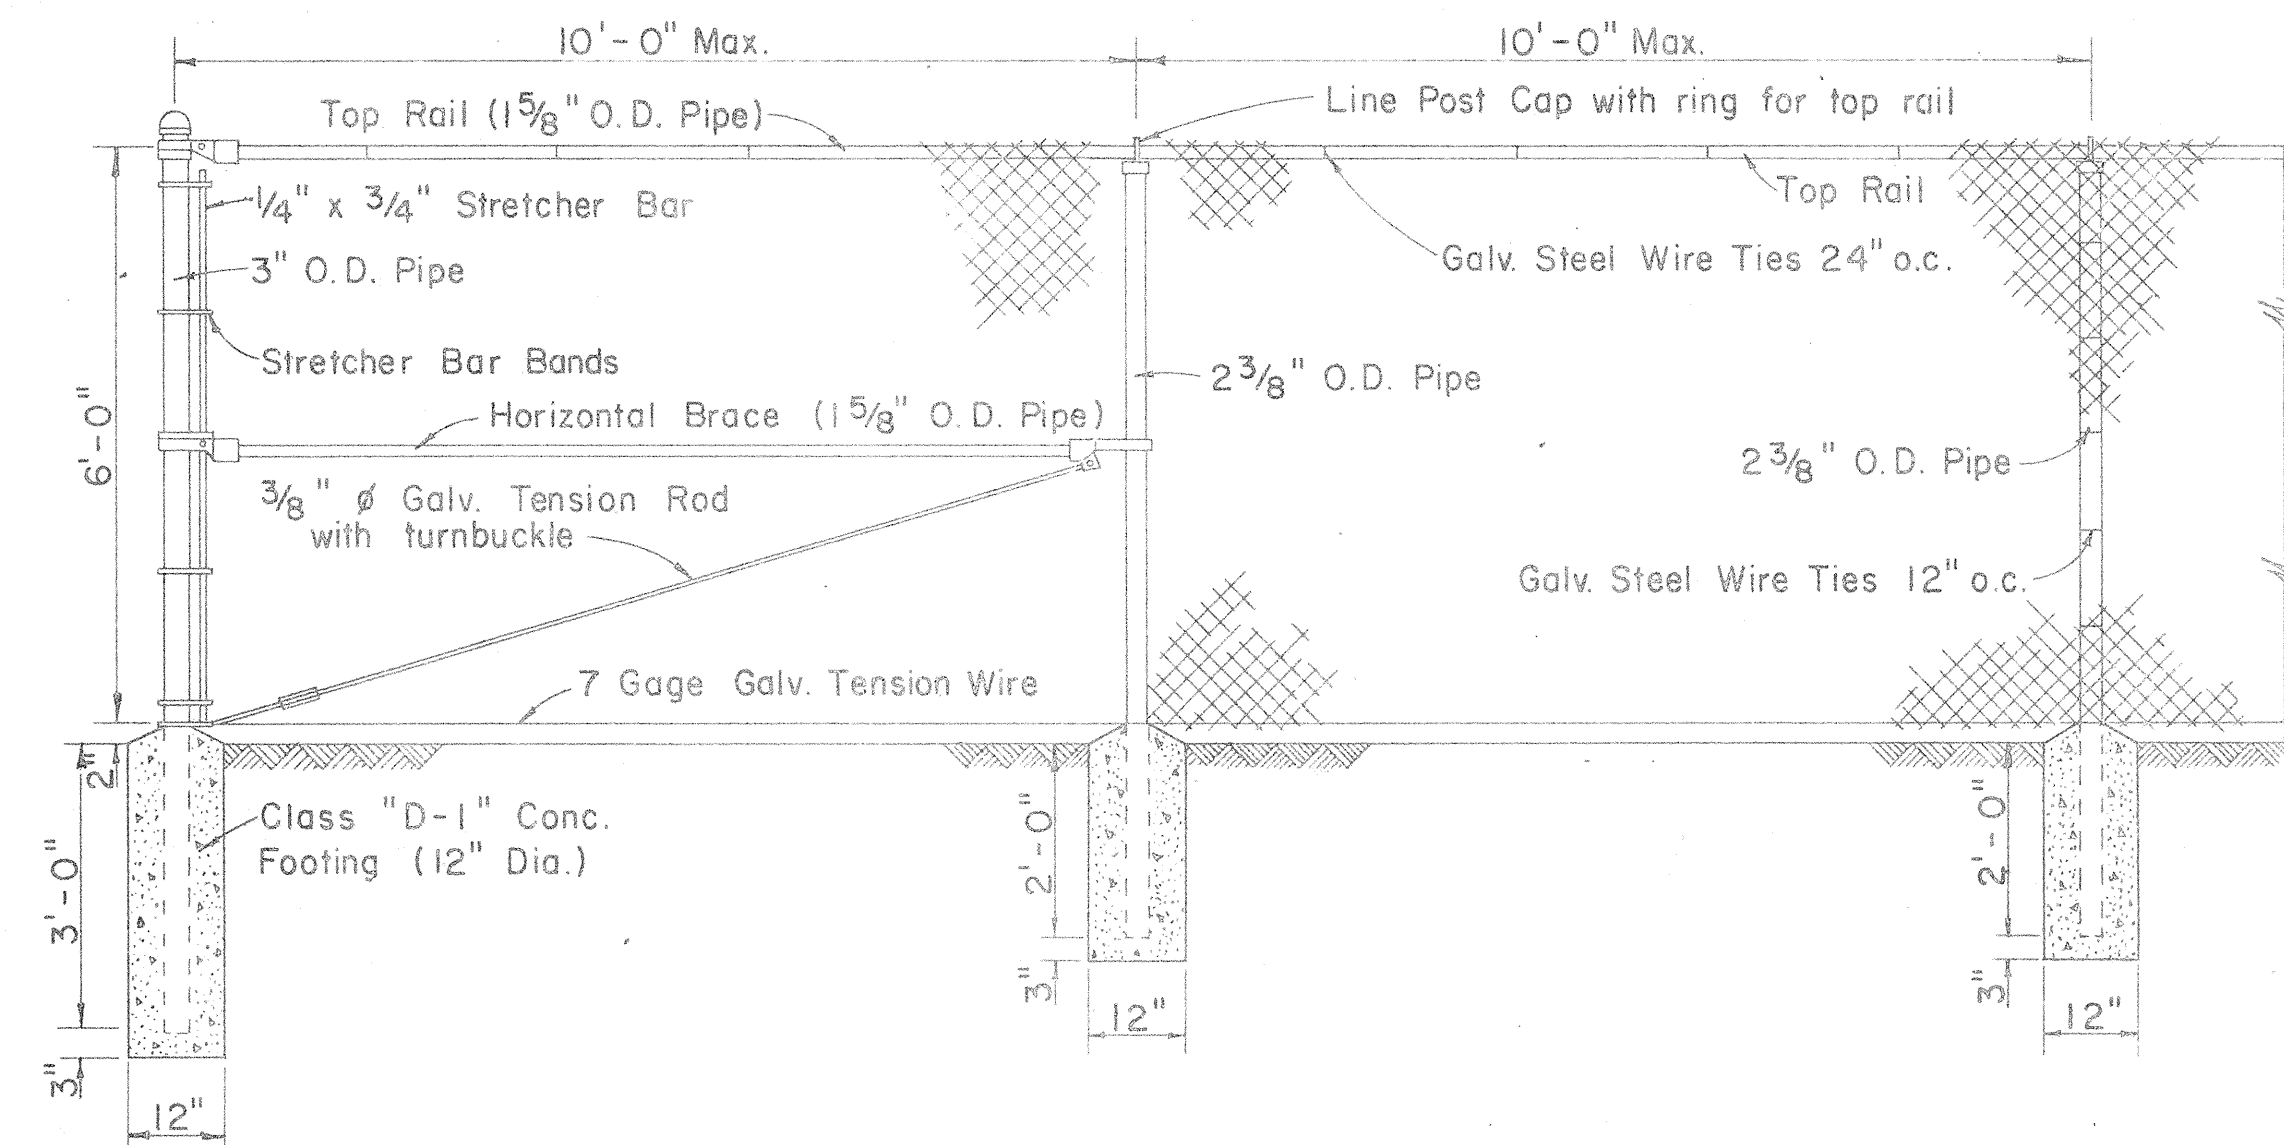

END POST

LINE POST

LINE POST

LINE POST

PULL POST


LINE POST

GATE POST

GATE POST


CHAIN LINK FENCE DETAIL

Scale: 1/2" = 1'-0"

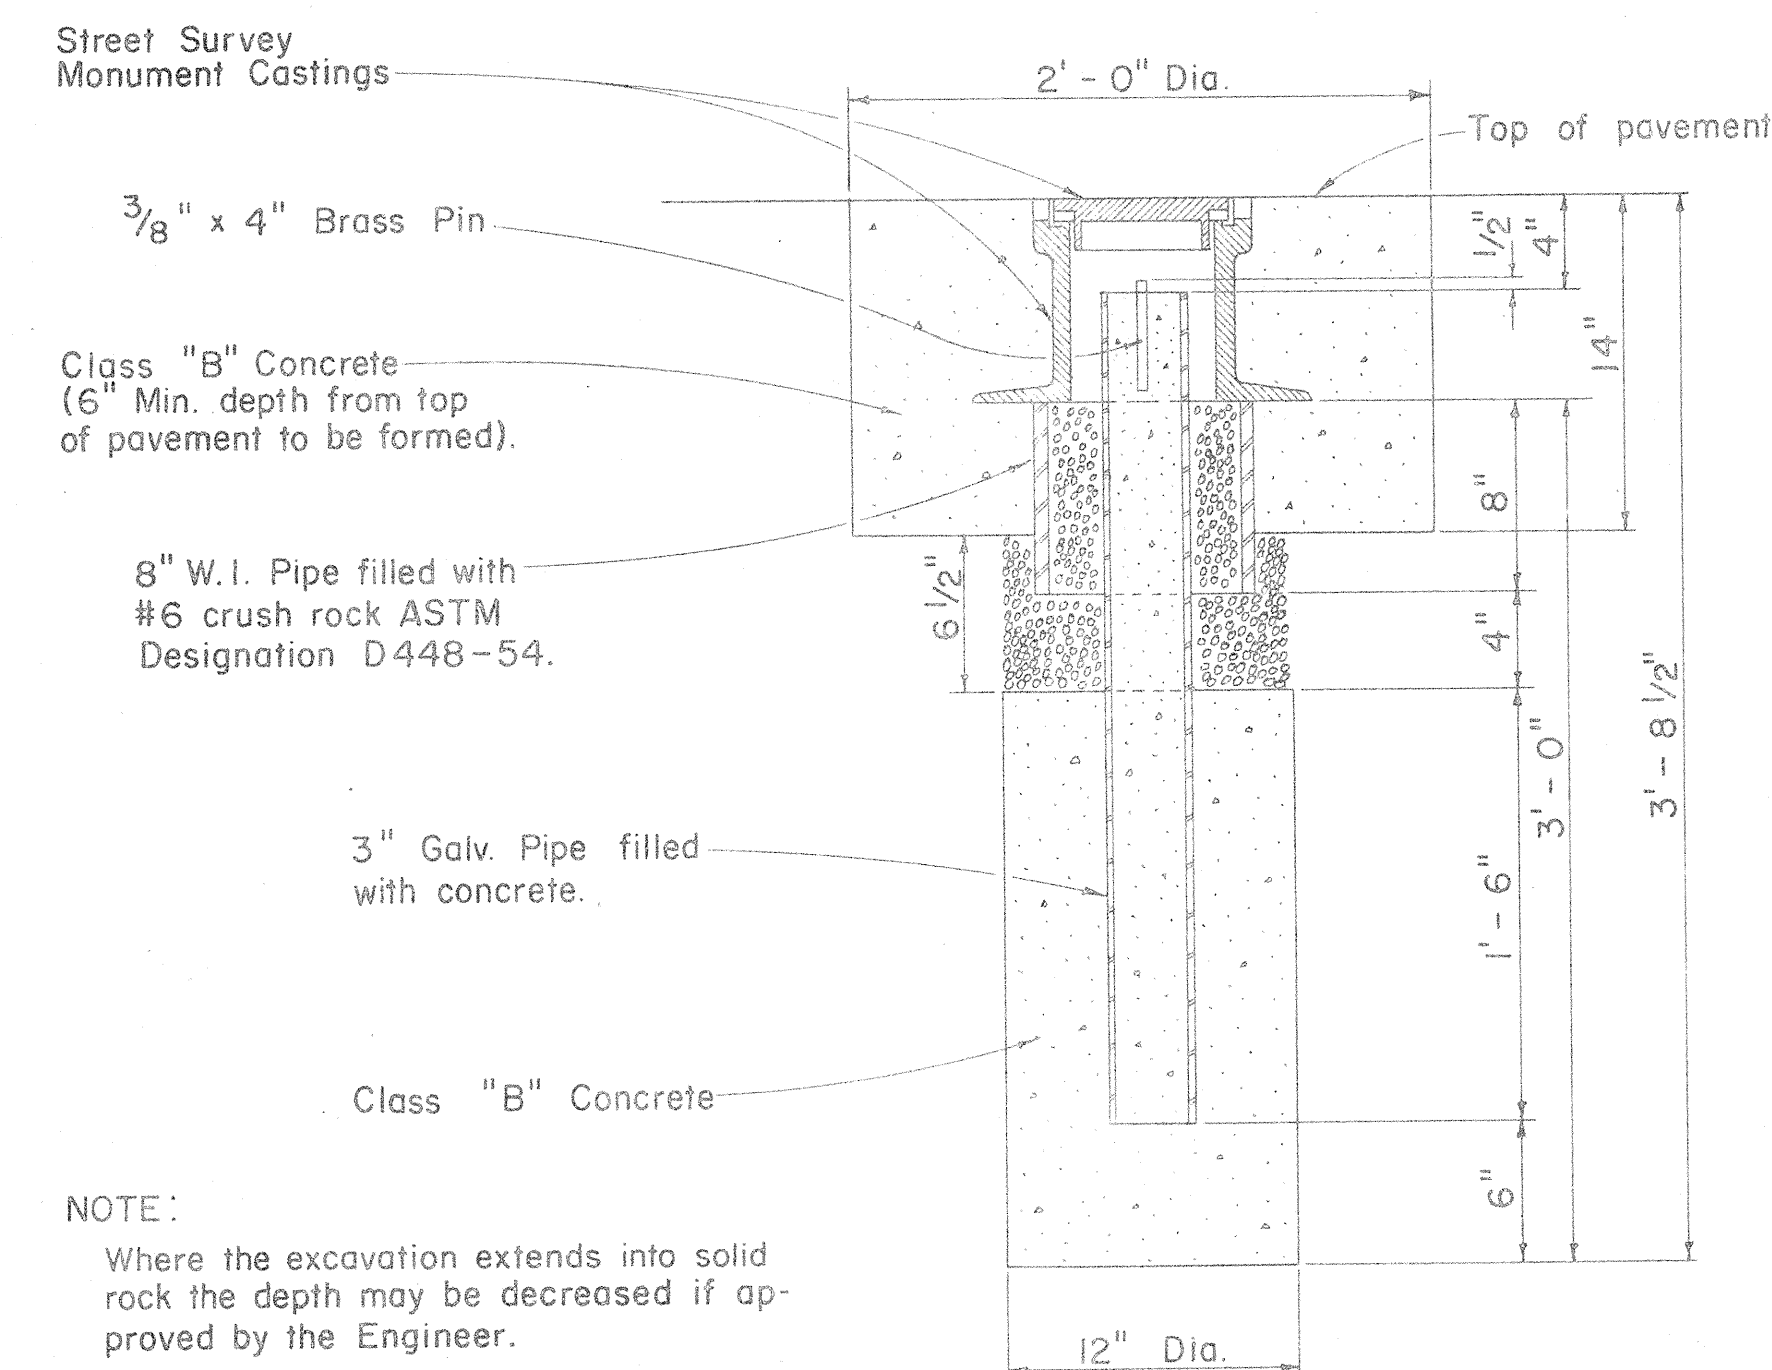


STREET SURVEY MONUMENT


Scale: 1/2" = 1'-0"

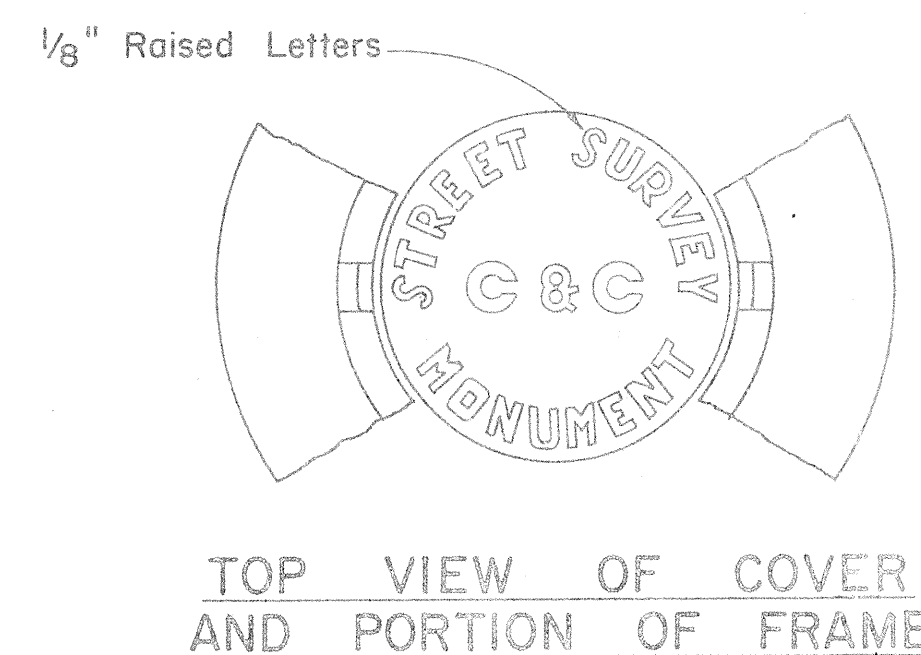


TOP VIEW OF COVER AND PORTION OF FRAME

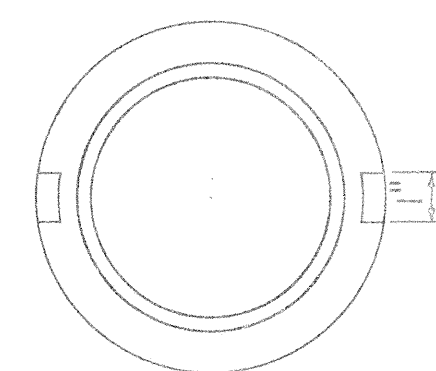


BOTTOM OF COVER

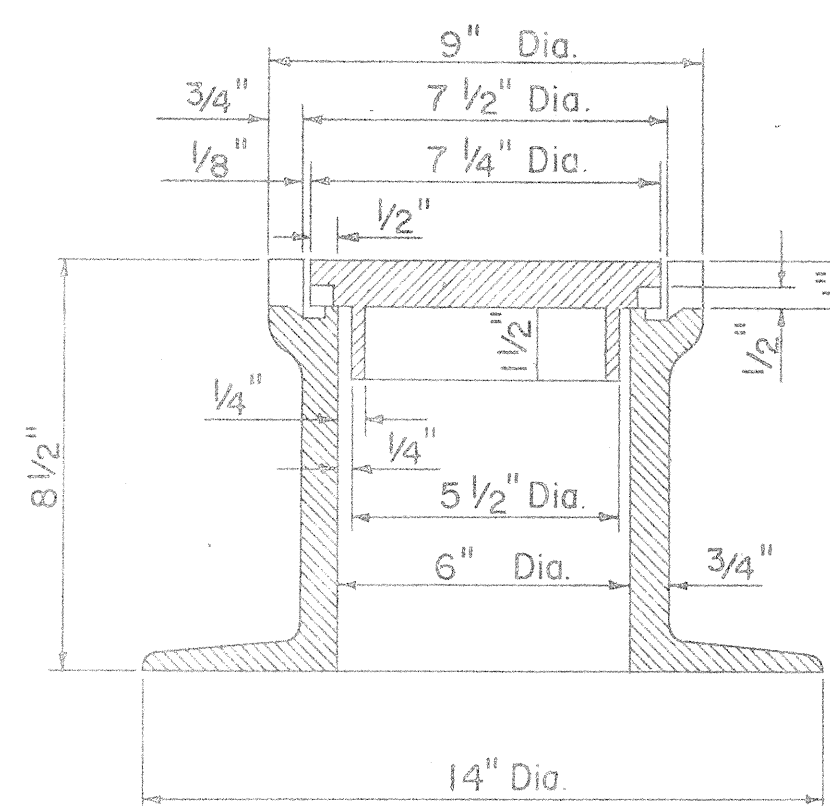

SECTIONAL VIEW OF FRAME AND COVER

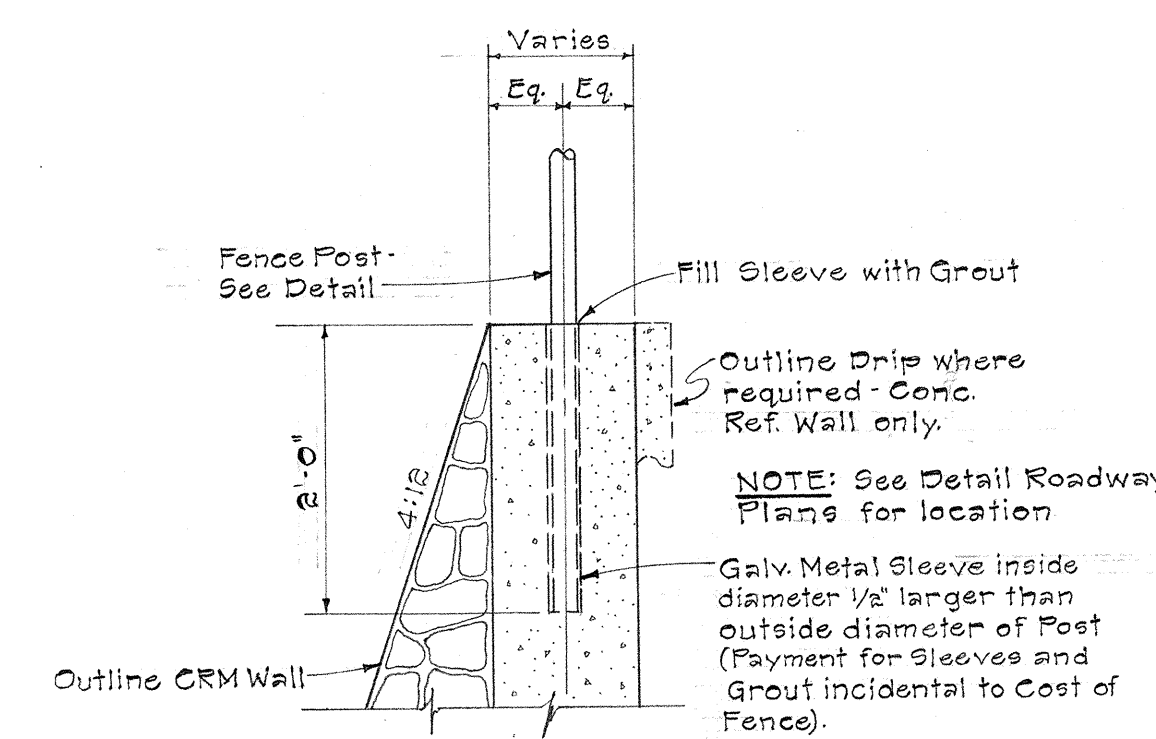


TYPICAL SECTION OF FENCE POST ON CRM & CONC. RETAINING WALL

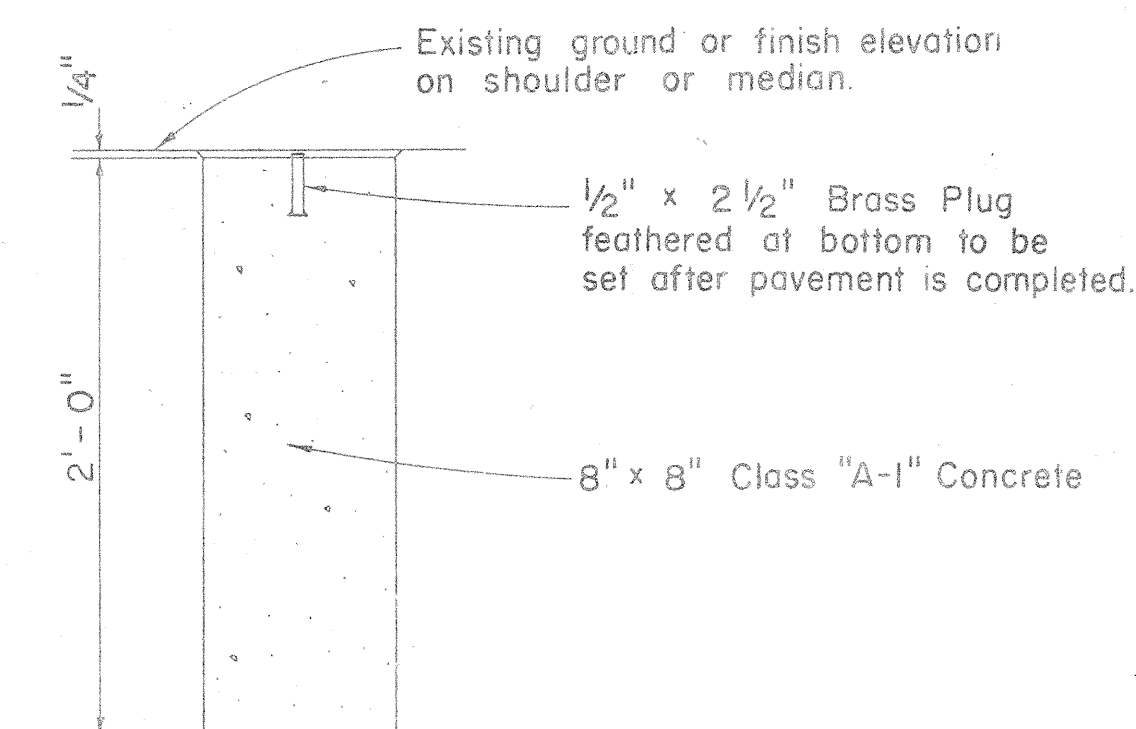

DETAIL FOR C AND REFERENCE SURVEY MONUMENT


Scale: 1/2" = 1'-0"

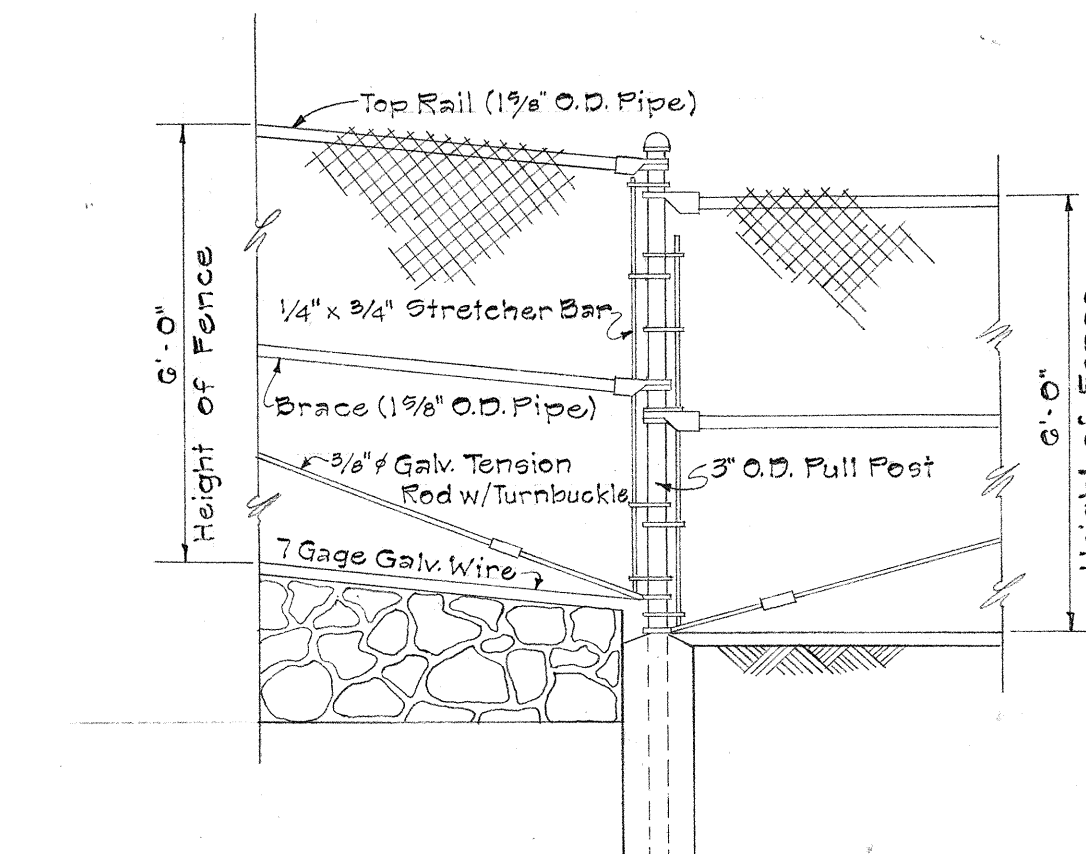

TYPICAL FENCE CONNECTION DETAIL AT RETAINING WALL

STATE OF HAWAII
DEPARTMENT OF TRANSPORTATION
CHAIN LINK FENCE AND MONUMENT DETAILS
INTERSTATE ROUTE H-1
(LUNALILO FREEWAY)
Pele Street to Victoria Street
FAL Proj. No. I-H1-1(31), Unit 1
Scale: As Shown Date: April, 1966
SHEET NO. 3 OF 10 SHEETS

DATE: _____
DRAWN BY: _____
DESIGNED BY: _____
CHECKED BY: _____
NO. _____

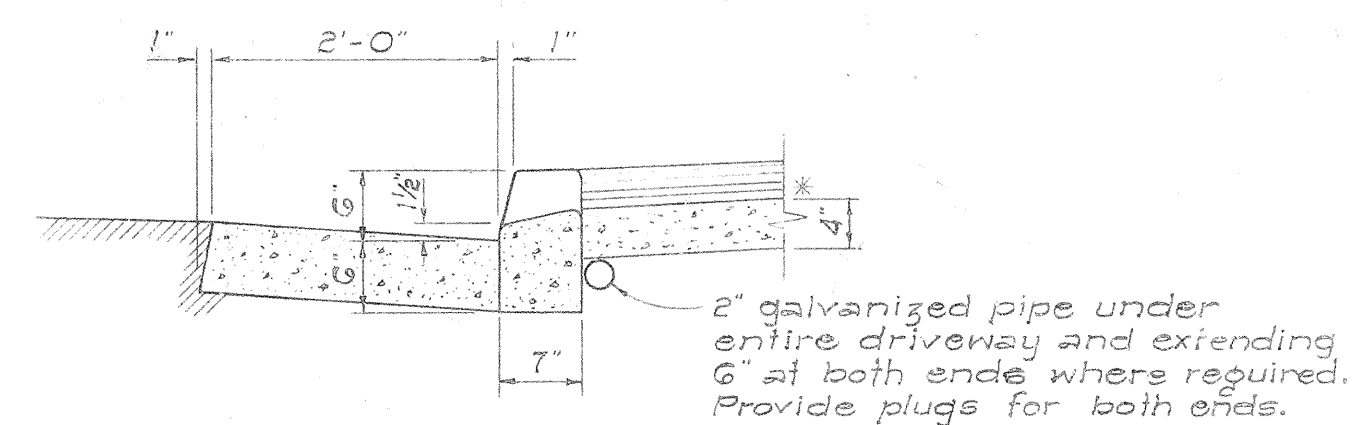

DETAIL "A"
Scale: $\frac{3}{4}" = 1'-0"$

* Use dimension shown unless otherwise noted on the plans.


** Denotes 6" thick P.C.C. dropped driveway.

1. All measurements shown on this sheet are estimated only.
2. Private A.C. driveways shall have the following pavement section:
Wearing Surface: 2" Asphalt Concrete Mix V
Base Course: 6" Untreated Base
Sub-base Course: None
3. Dropped driveways in Business Zone shall be 6" thick.

All the quantities shown are original theoretical quantities. For actual quantities, refer to project ledger and/or computation book.


FED. ROAD DIST. NO.	STATE	FED. AID PROJ. NO.	FISCAL YEAR	SHEET NO.	TOTAL SHEETS
HAWAII	HAW.	I-H-1(31) UNIT 1	1969	34 S-1	202

Revised: 8-7-69

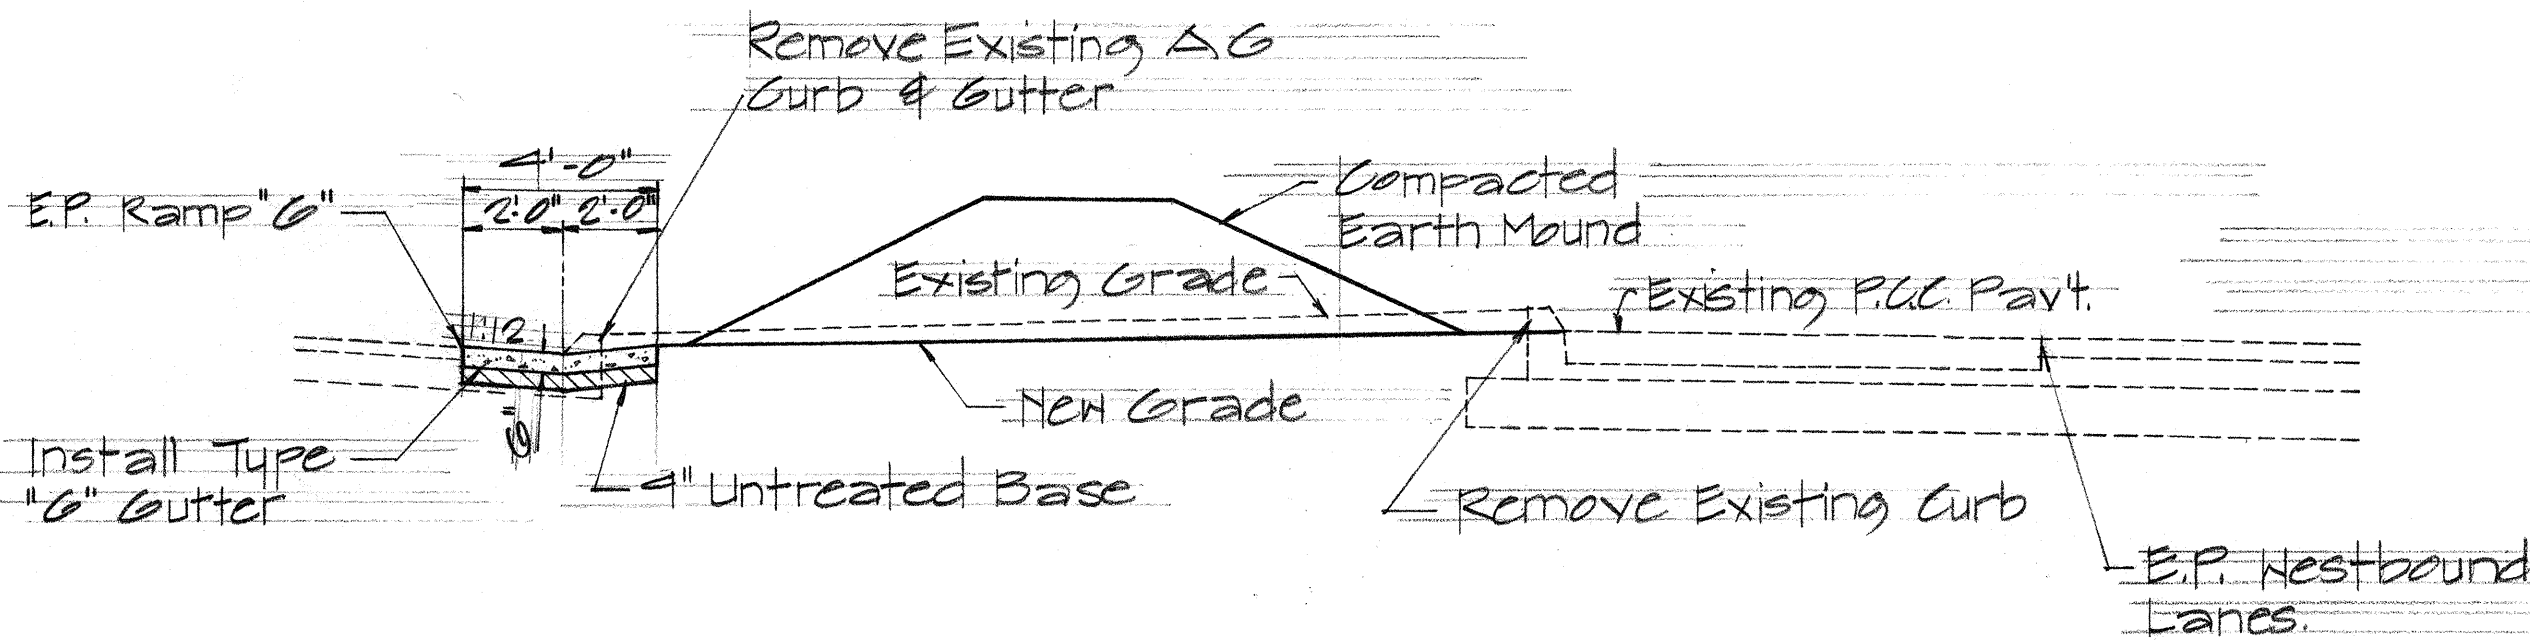


SECTION "D"-D"
 Scale: 1/4"=1'-0"


CURVE DATA
 $\Delta = 40^{\circ} 06' 25''$
 $R = 10'$
 $LC = 7.0'$

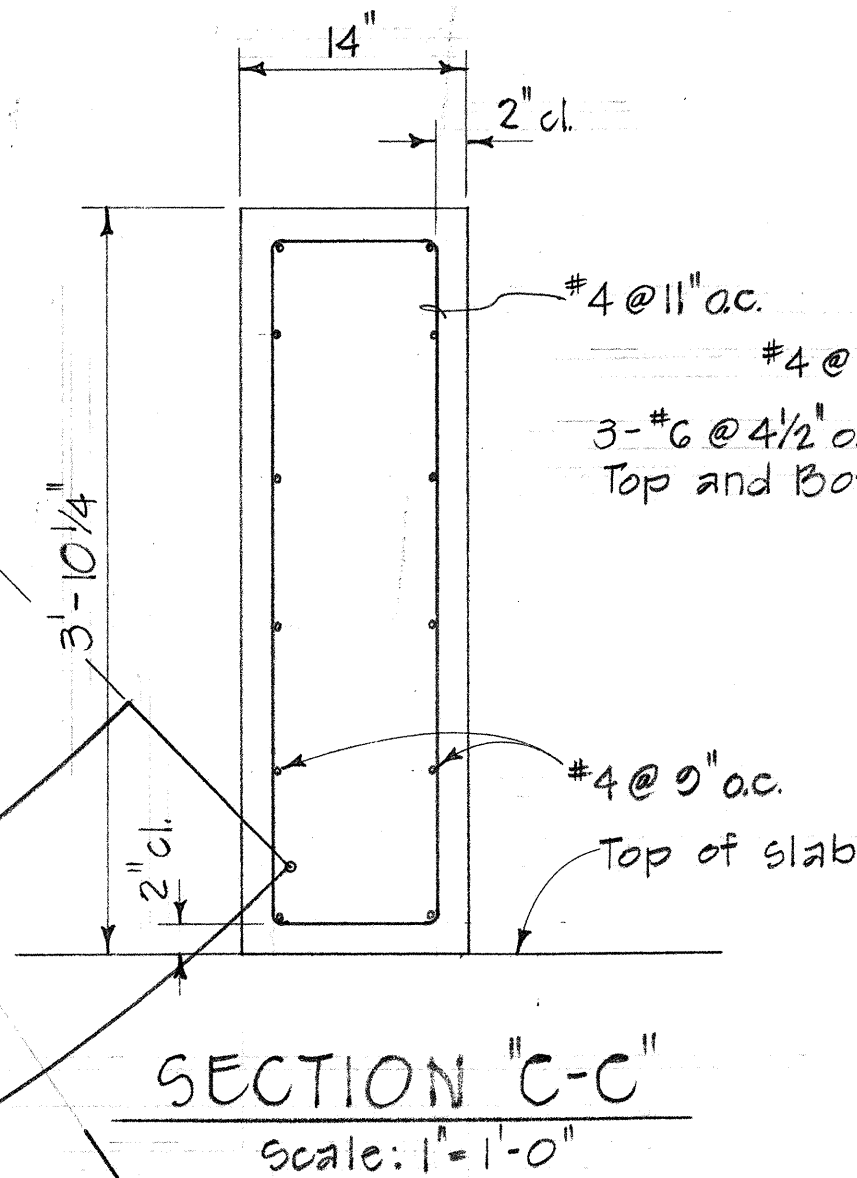

SECTION "A-A"
 Scale: 1"=1'-0"

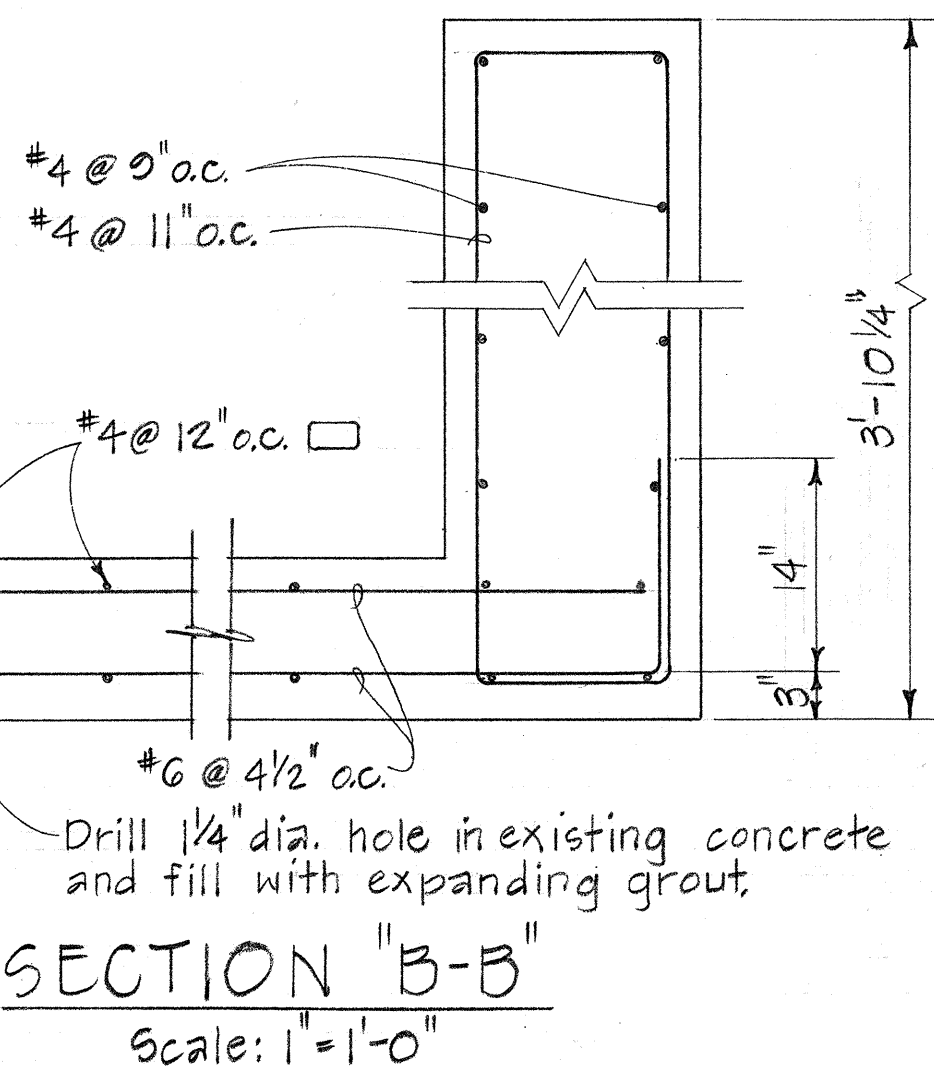


GENERAL NOTE
 The Contractor shall verify dimensions and locations of existing equipment and facilities.

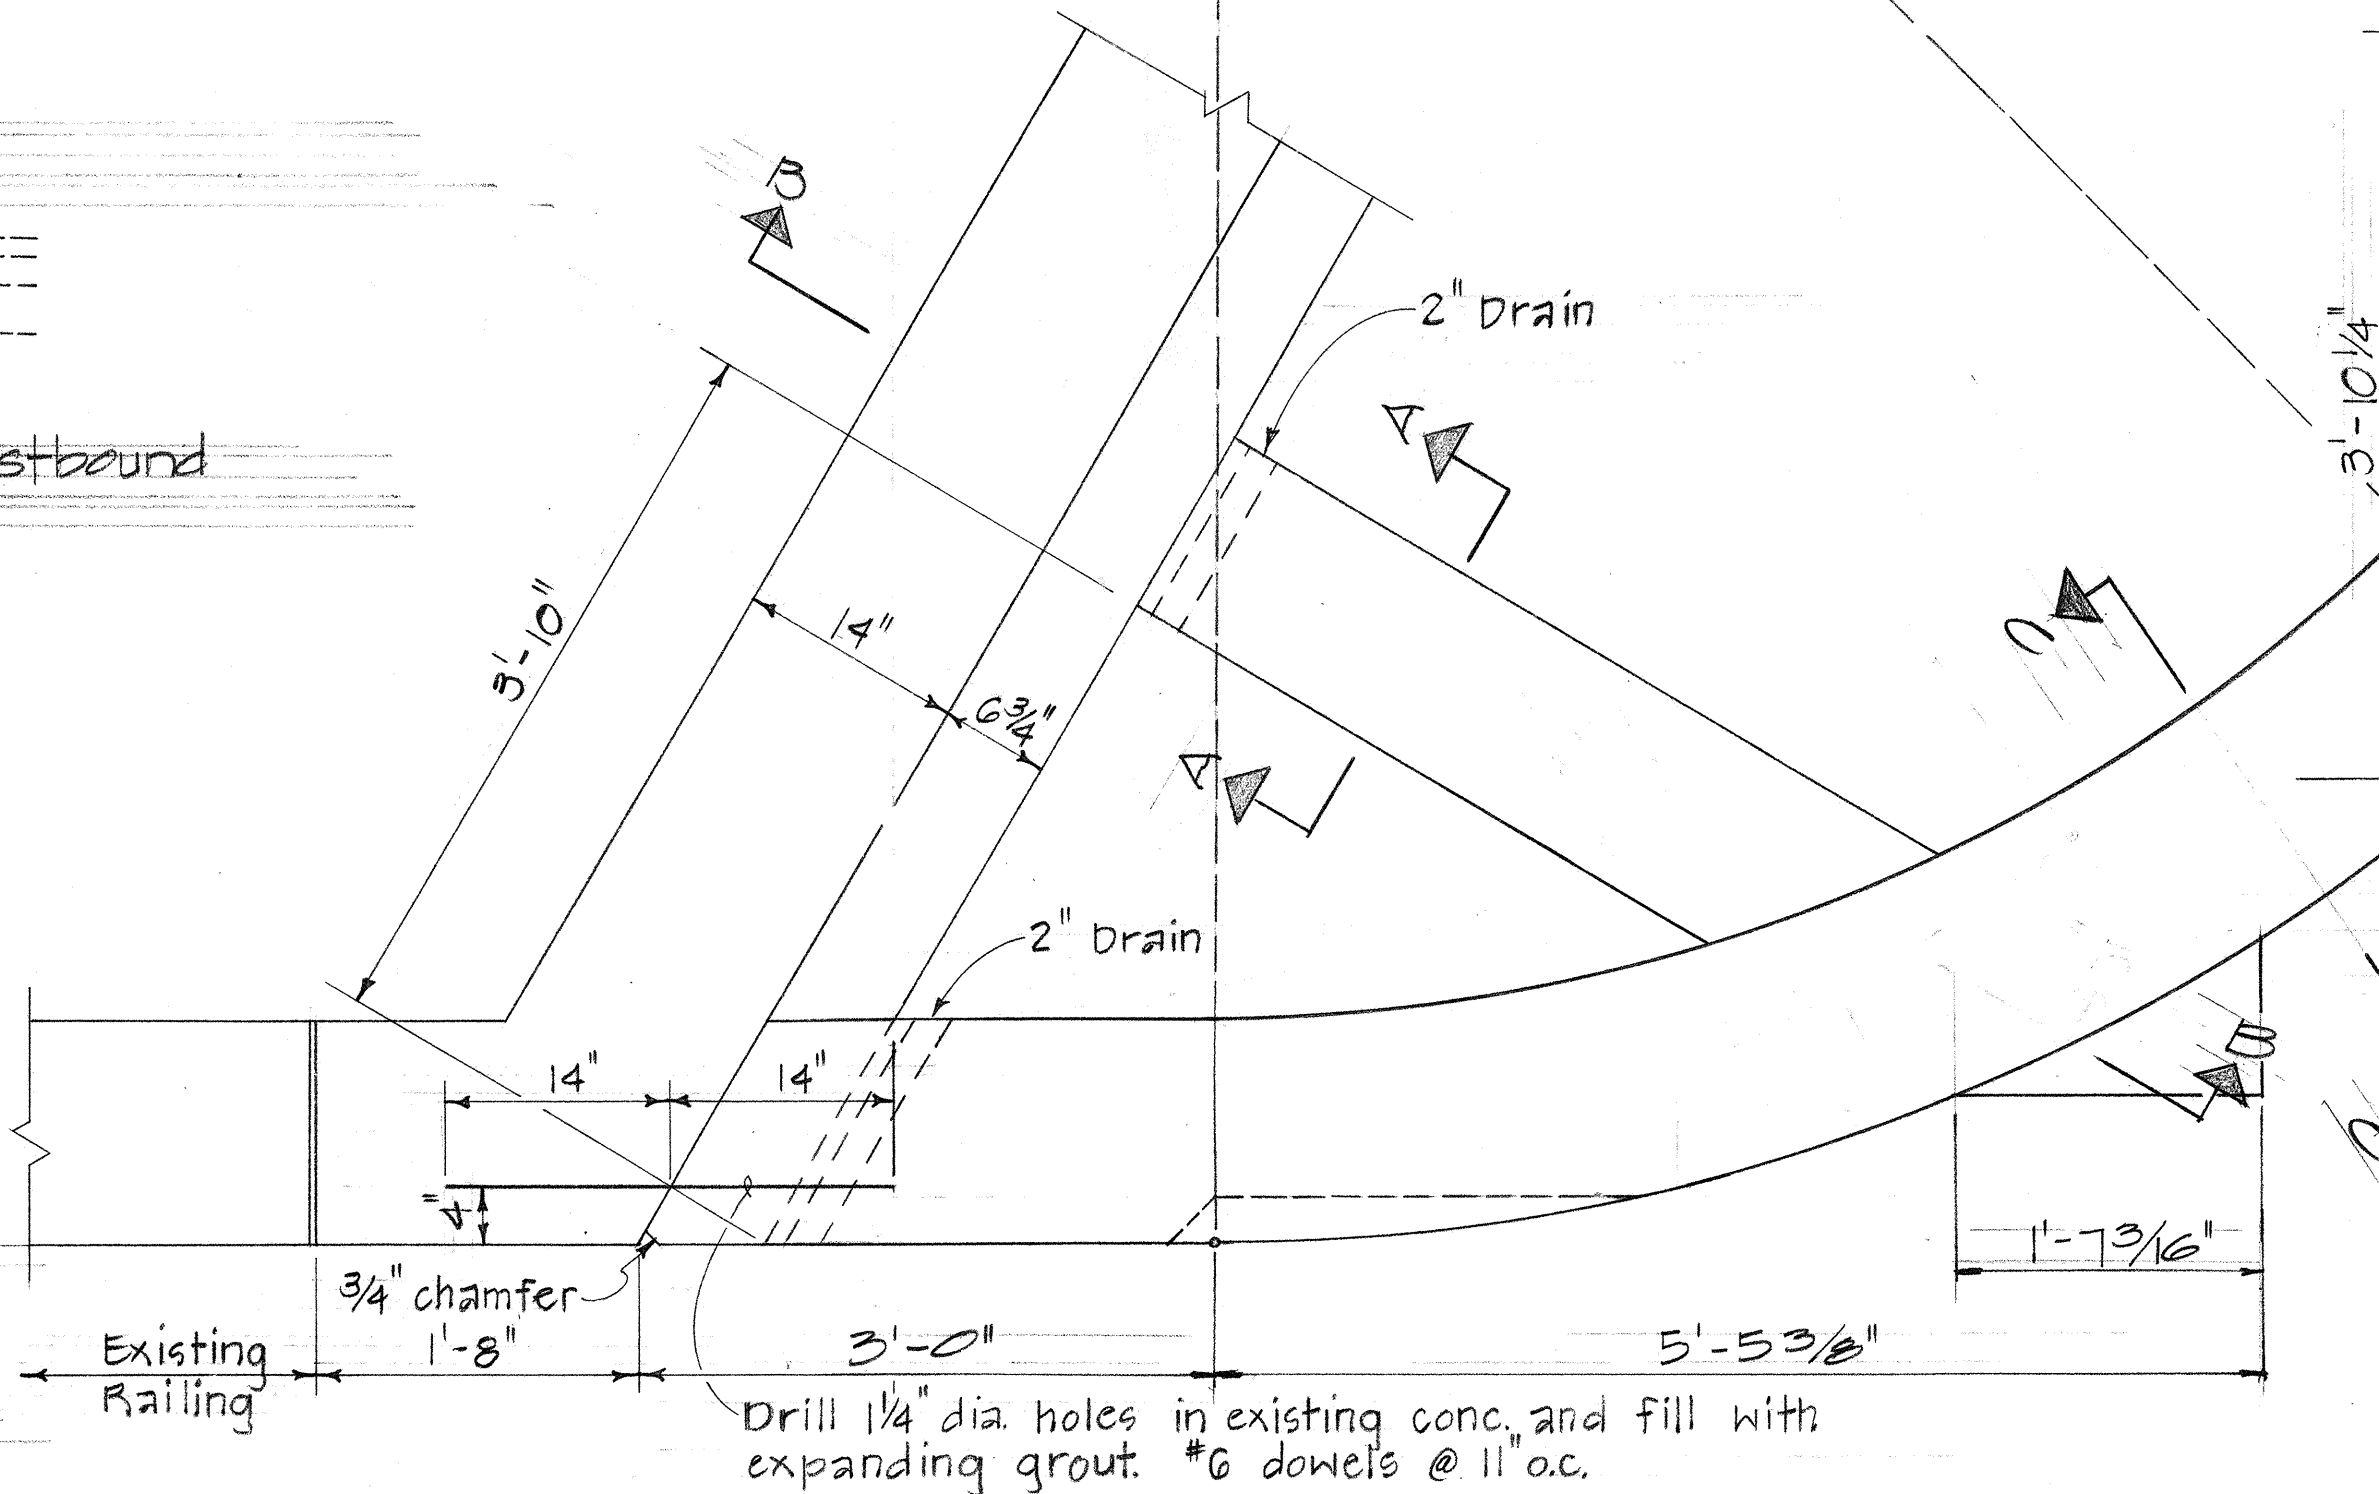

PLAN
 Scale: 1"=1'-0"

NOTE:
 For Detail of Standard End Post Connection to Metal Guard Rail See Sheet C034 S-5.

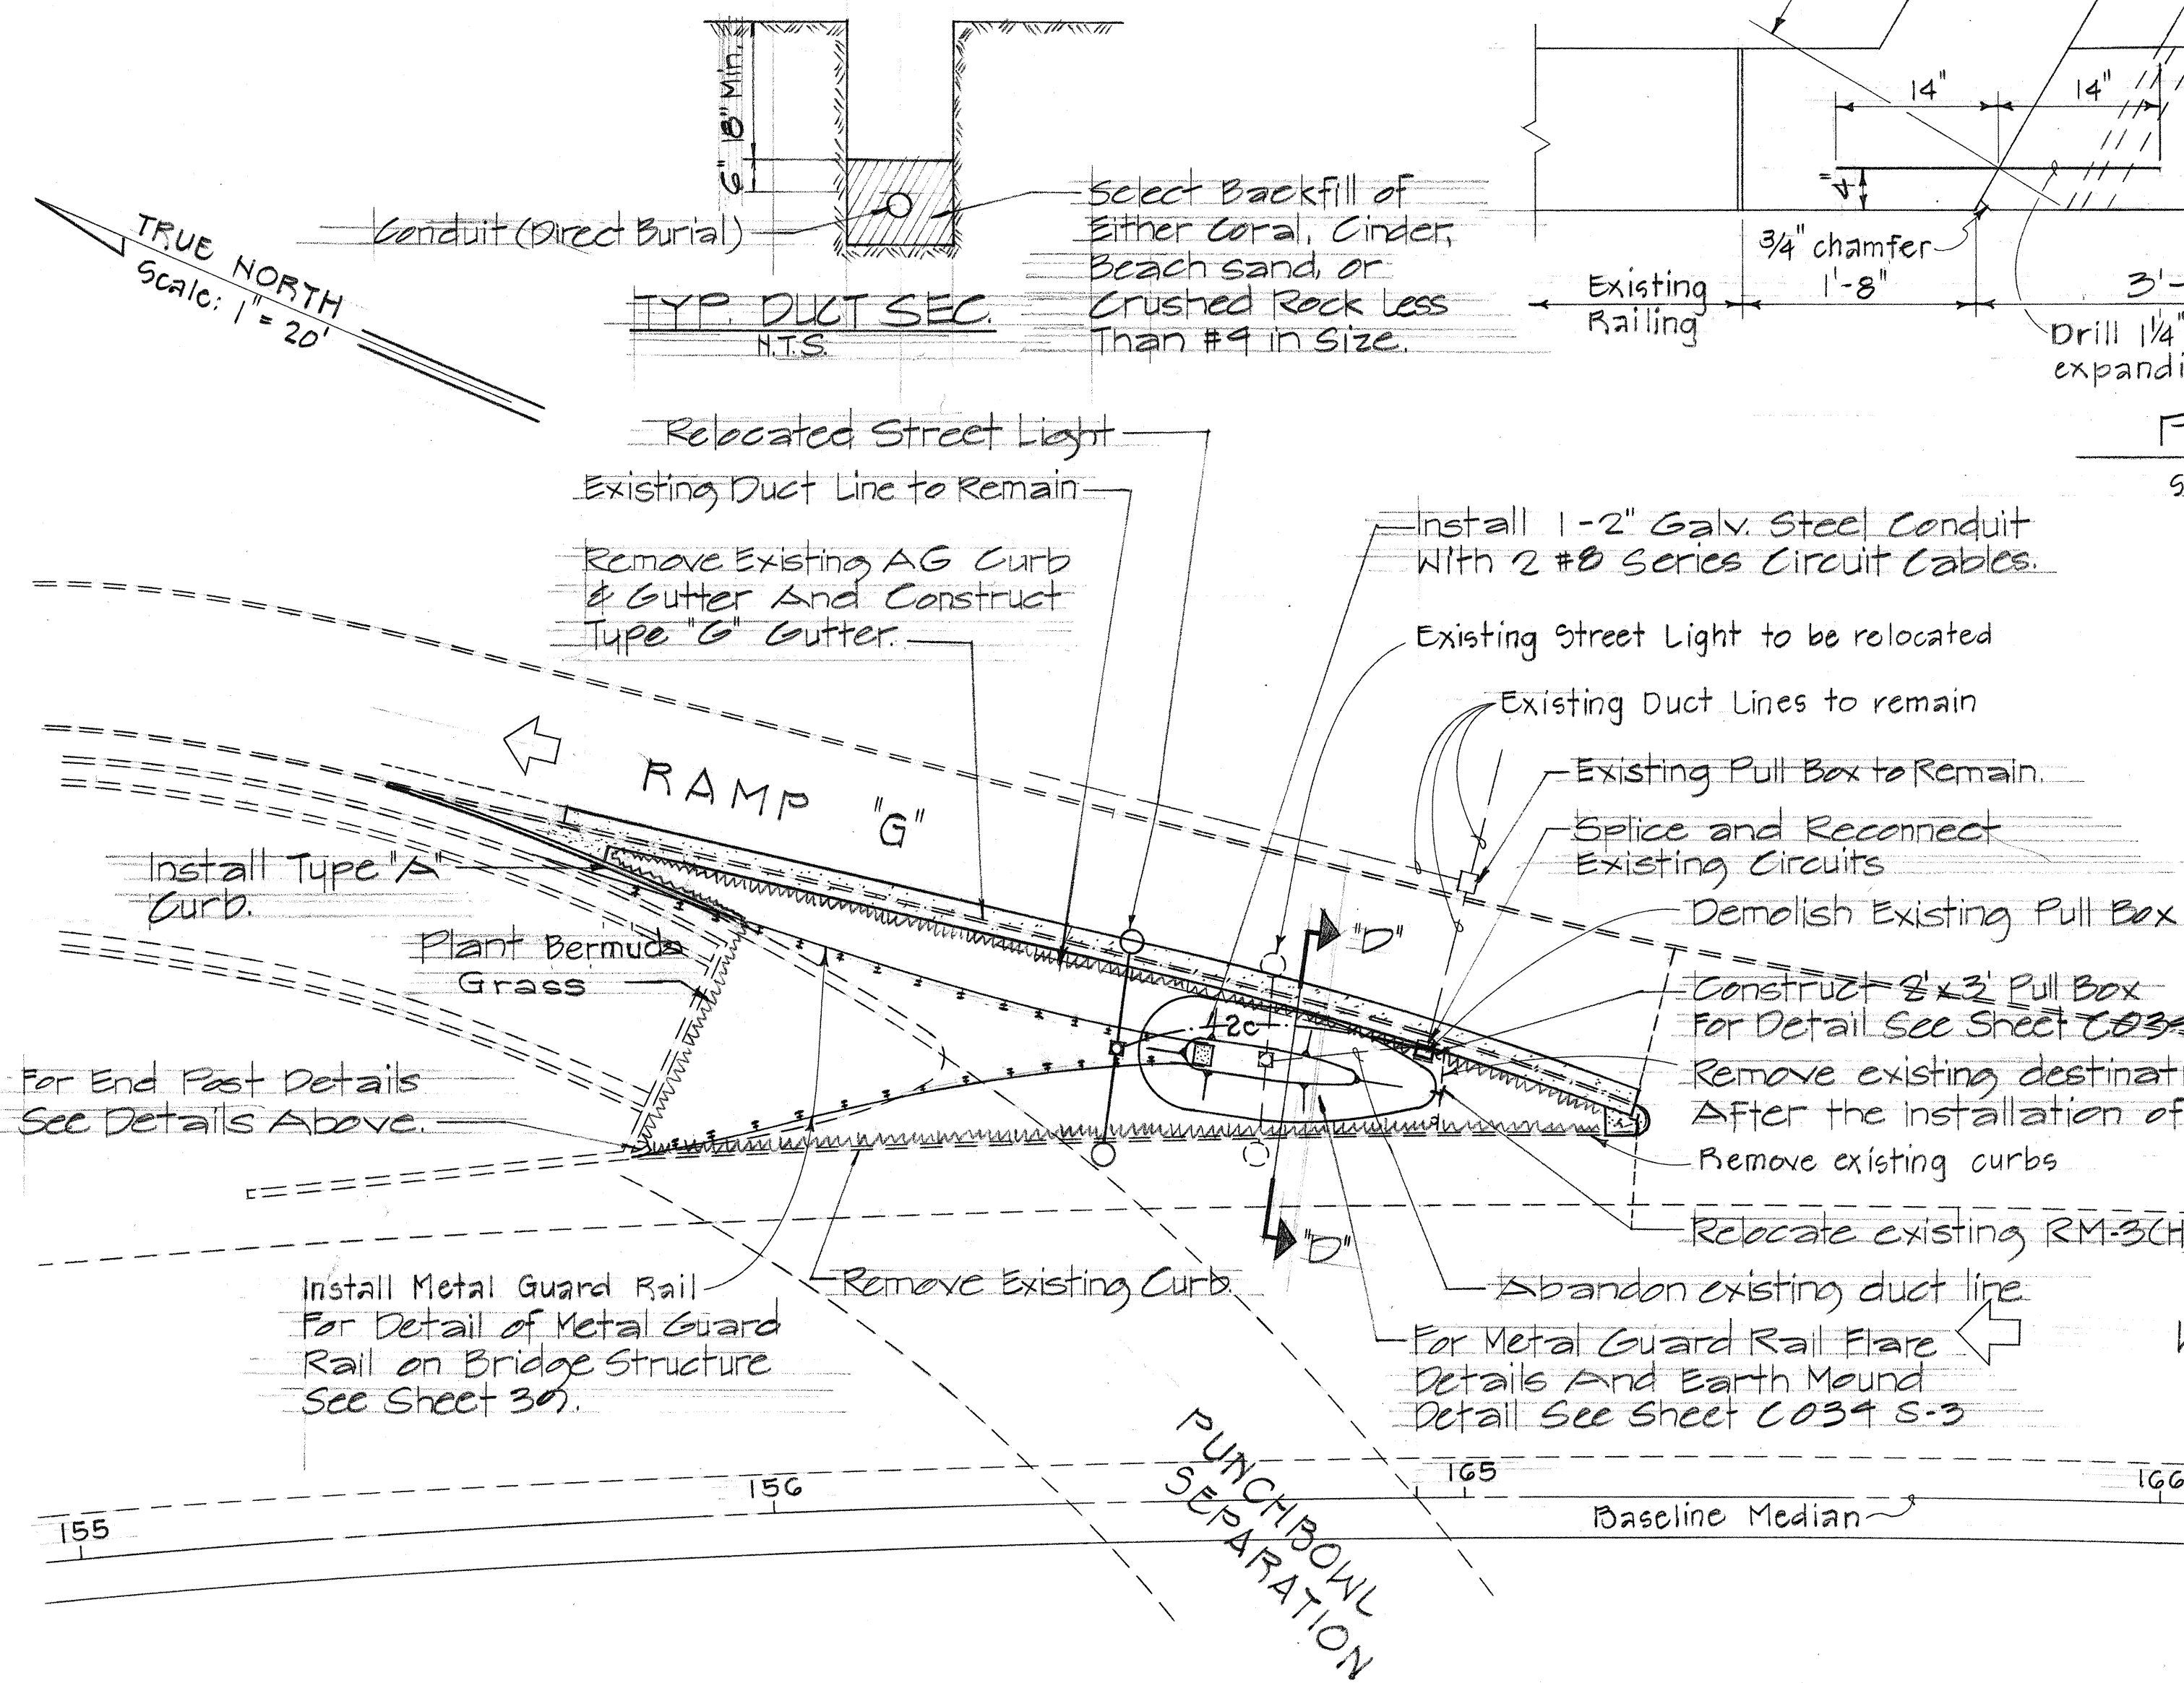

PLAN
 Scale: 1"=20'-0"


THIS SHEET IS A SUPPLEMENT TO THE CONTRACT PLANS.

STATE OF HAWAII
 DEPARTMENT OF TRANSPORTATION
 HIGHWAYS DIVISION
 DETAIL PLAN ROADWAY
 AND END POST DETAILS
 INTERSTATE ROUTE H-1
 Pele Street to Victoria Street
 F.A.I. Proj. No. I-H-1(31), Unit 1
 Scale: As Shown Date: Jan. 1969
 SHEET No. OF SHEETS


C034 S-1

DATE	_____
SURVEY PLOTTED BY	_____
DRAWN BY	_____
DESIGNED BY	_____
QUANTITIES BY	_____
CHECKED BY	_____
ORIGINAL PLAN	_____
NOTE BOOK	_____
No.	_____


FED. ROAD DIST. NO.	STATE	FED. AID PROJ. NO.	FISCAL YEAR	SHEET NO.	TOTAL SHEETS
HAWAII	HAW.	I-HI-1(31) UNIT 1	1967	60 3452	202

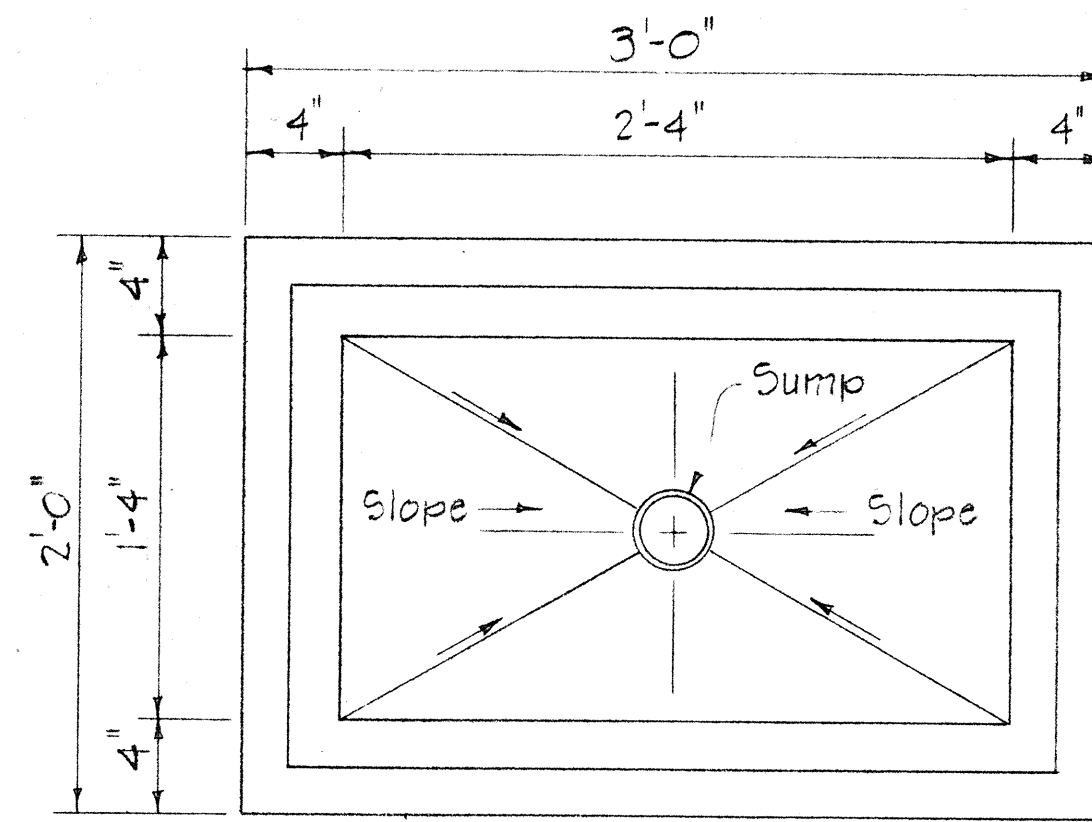


PLAN
Scale: 1/2" = 1'-0"

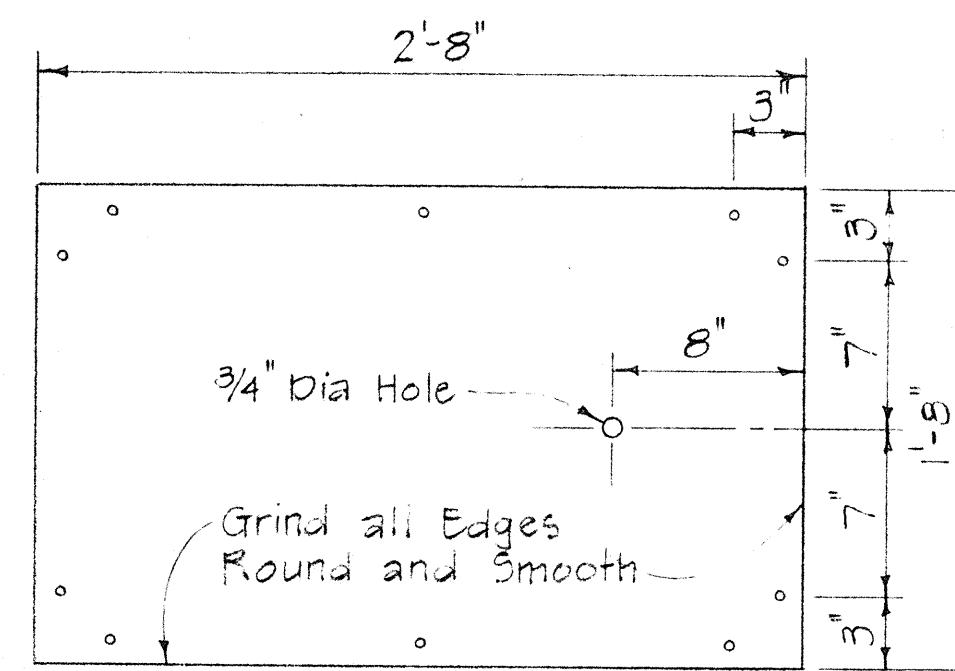

3/8" CHECKED PLATE COVER.
(Hot Dip Galvanizing Checkered Plate after Drilling, Countersinking and Grinding Edge)
Scale: 1/2" = 1'-0"

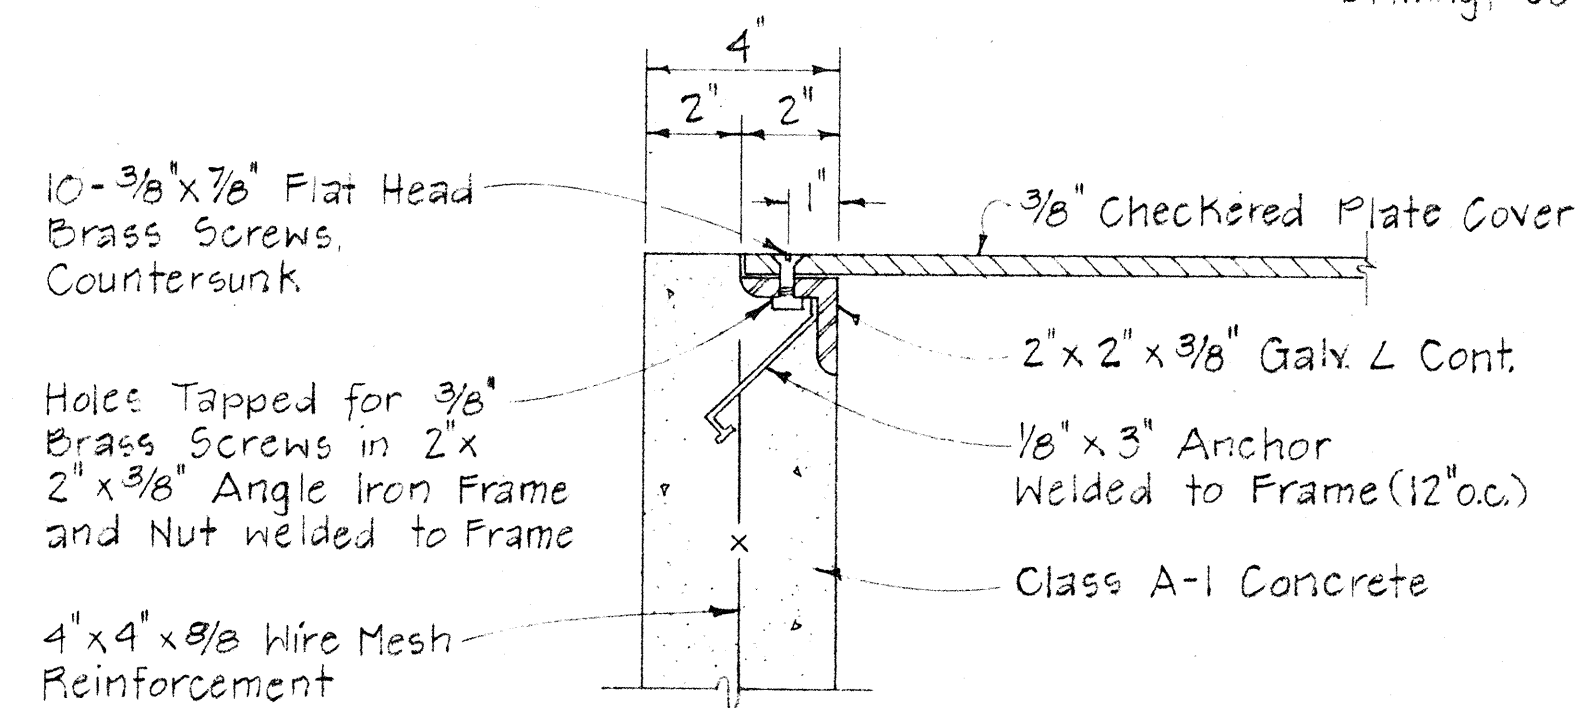

DETAIL "A"
Scale: 3" = 1'-0"

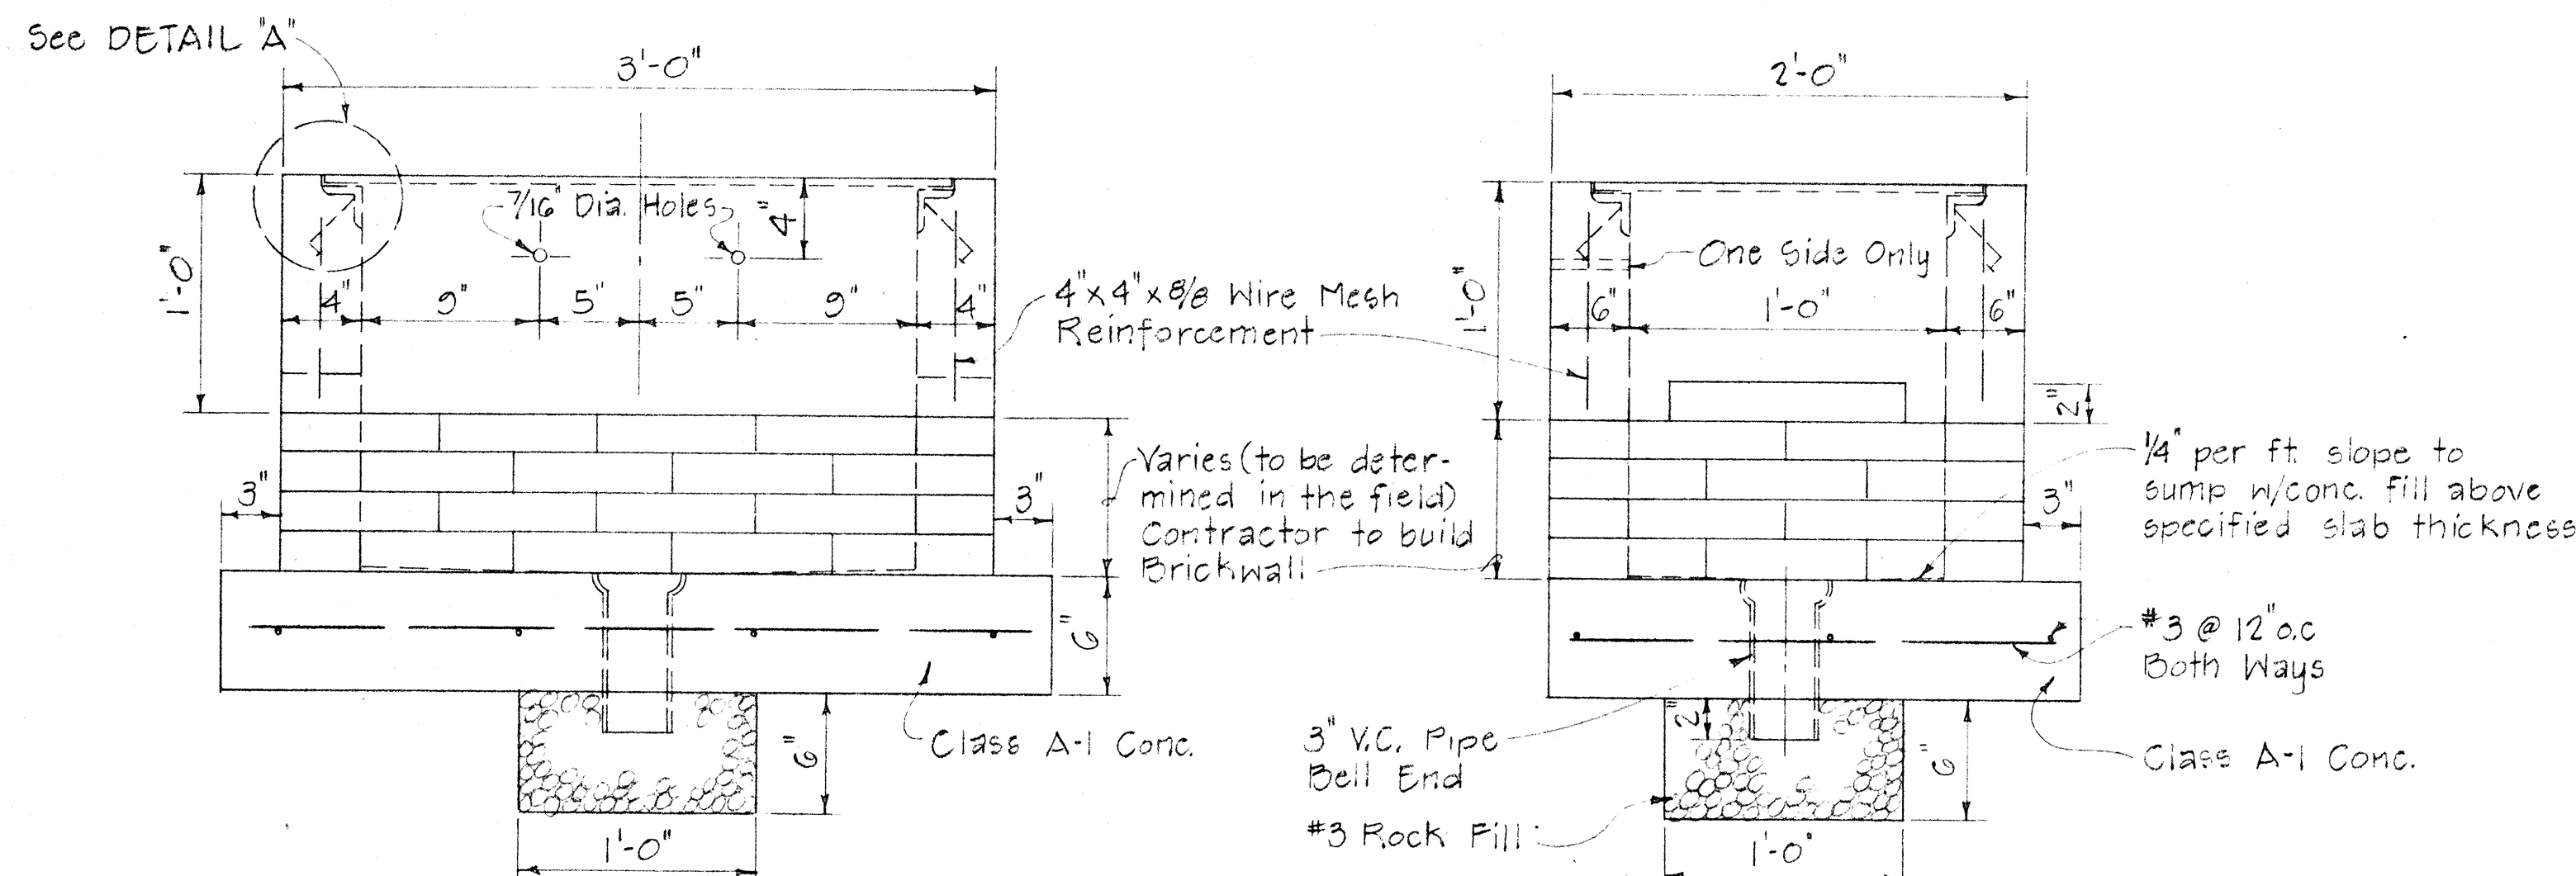


SIDE VIEW
Scale: 1/2" = 1'-0"

END VIEW
Scale: 1/2" = 1'-0"

2'-0" x 3'-0" CONCRETE PULLBOX

NOTES:

- Concrete Pullbox shall consist of all work necessary for constructing the Pullbox for the Highway Lighting in the median and shall include furnishing & installing all materials, appurtenances and galvanizing as shown above.
- A mounting bracket or a 10" x 10" x 6" high (minimum) shelf shall be provided in each Pullbox for the installation of an isolating transformer (Incidental to Concrete Pullbox)

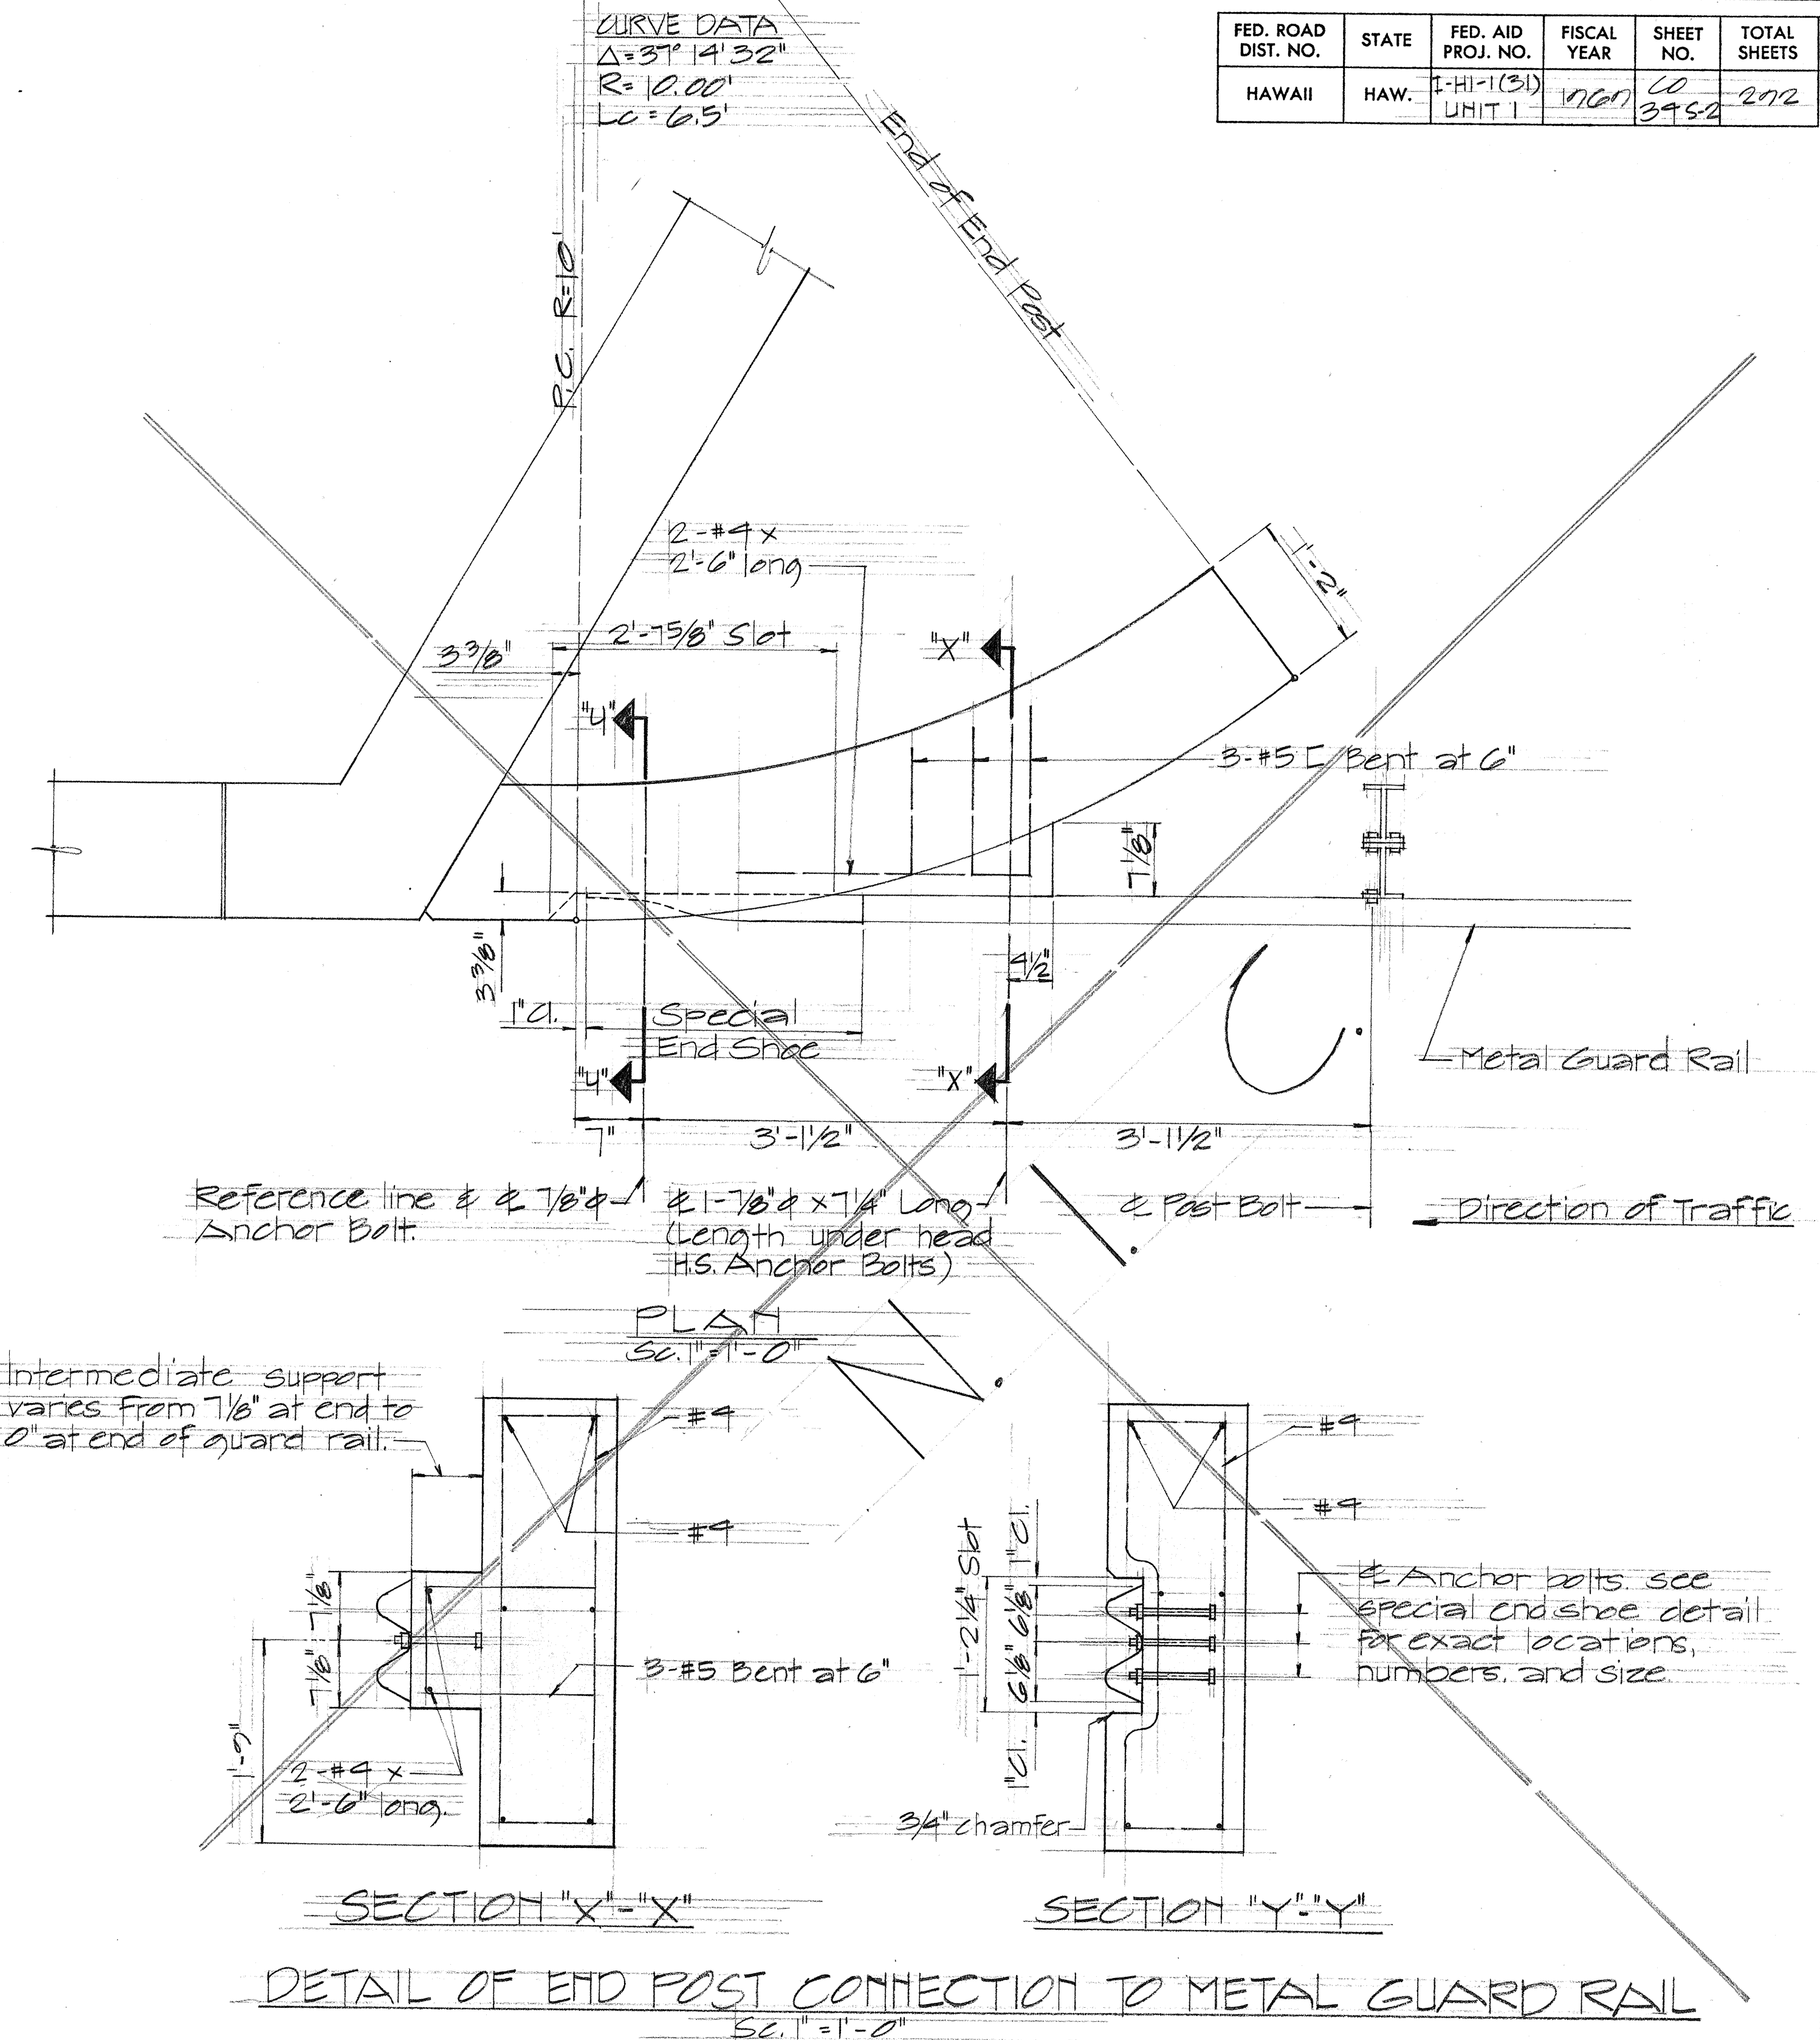

SECTION "X-X"

SECTION "Y-Y"

DETAIL OF END POST CONNECTION TO METAL GUARD RAIL
Scale: 1" = 1'-0"

THIS SHEET IS A SUPPLEMENT
TO THE CONTRACT PLANS.

STATE OF HAWAII
DEPARTMENT OF TRANSPORTATION
HIGHWAYS DIVISION

2' x 3' CONCRETE PULL BOX

INTERSTATE ROUTE H-1
PELE STREET TO VICTORIA STREET
F.A.T. PROJECT NO. I-HI-1(31) U-1
Scale as shown Date: Jan. 1967

SHEET No. OF SHEETS


60 3452 S-2

DATE	_____
DESIGNED BY	_____
TRACED BY	_____
NOTED BY	_____
CHECKED BY	_____


PRINTED ON NO. 1000H CLEARPRINT

FED. ROAD DIST. NO.	STATE	FED. AID PROJ. NO.	FISCAL YEAR	SHEET NO.	TOTAL SHEETS
HAWAII	HAW.	I-HI-1(31) UNIT 1	1969	5-6	202


Revised: 6-14-69

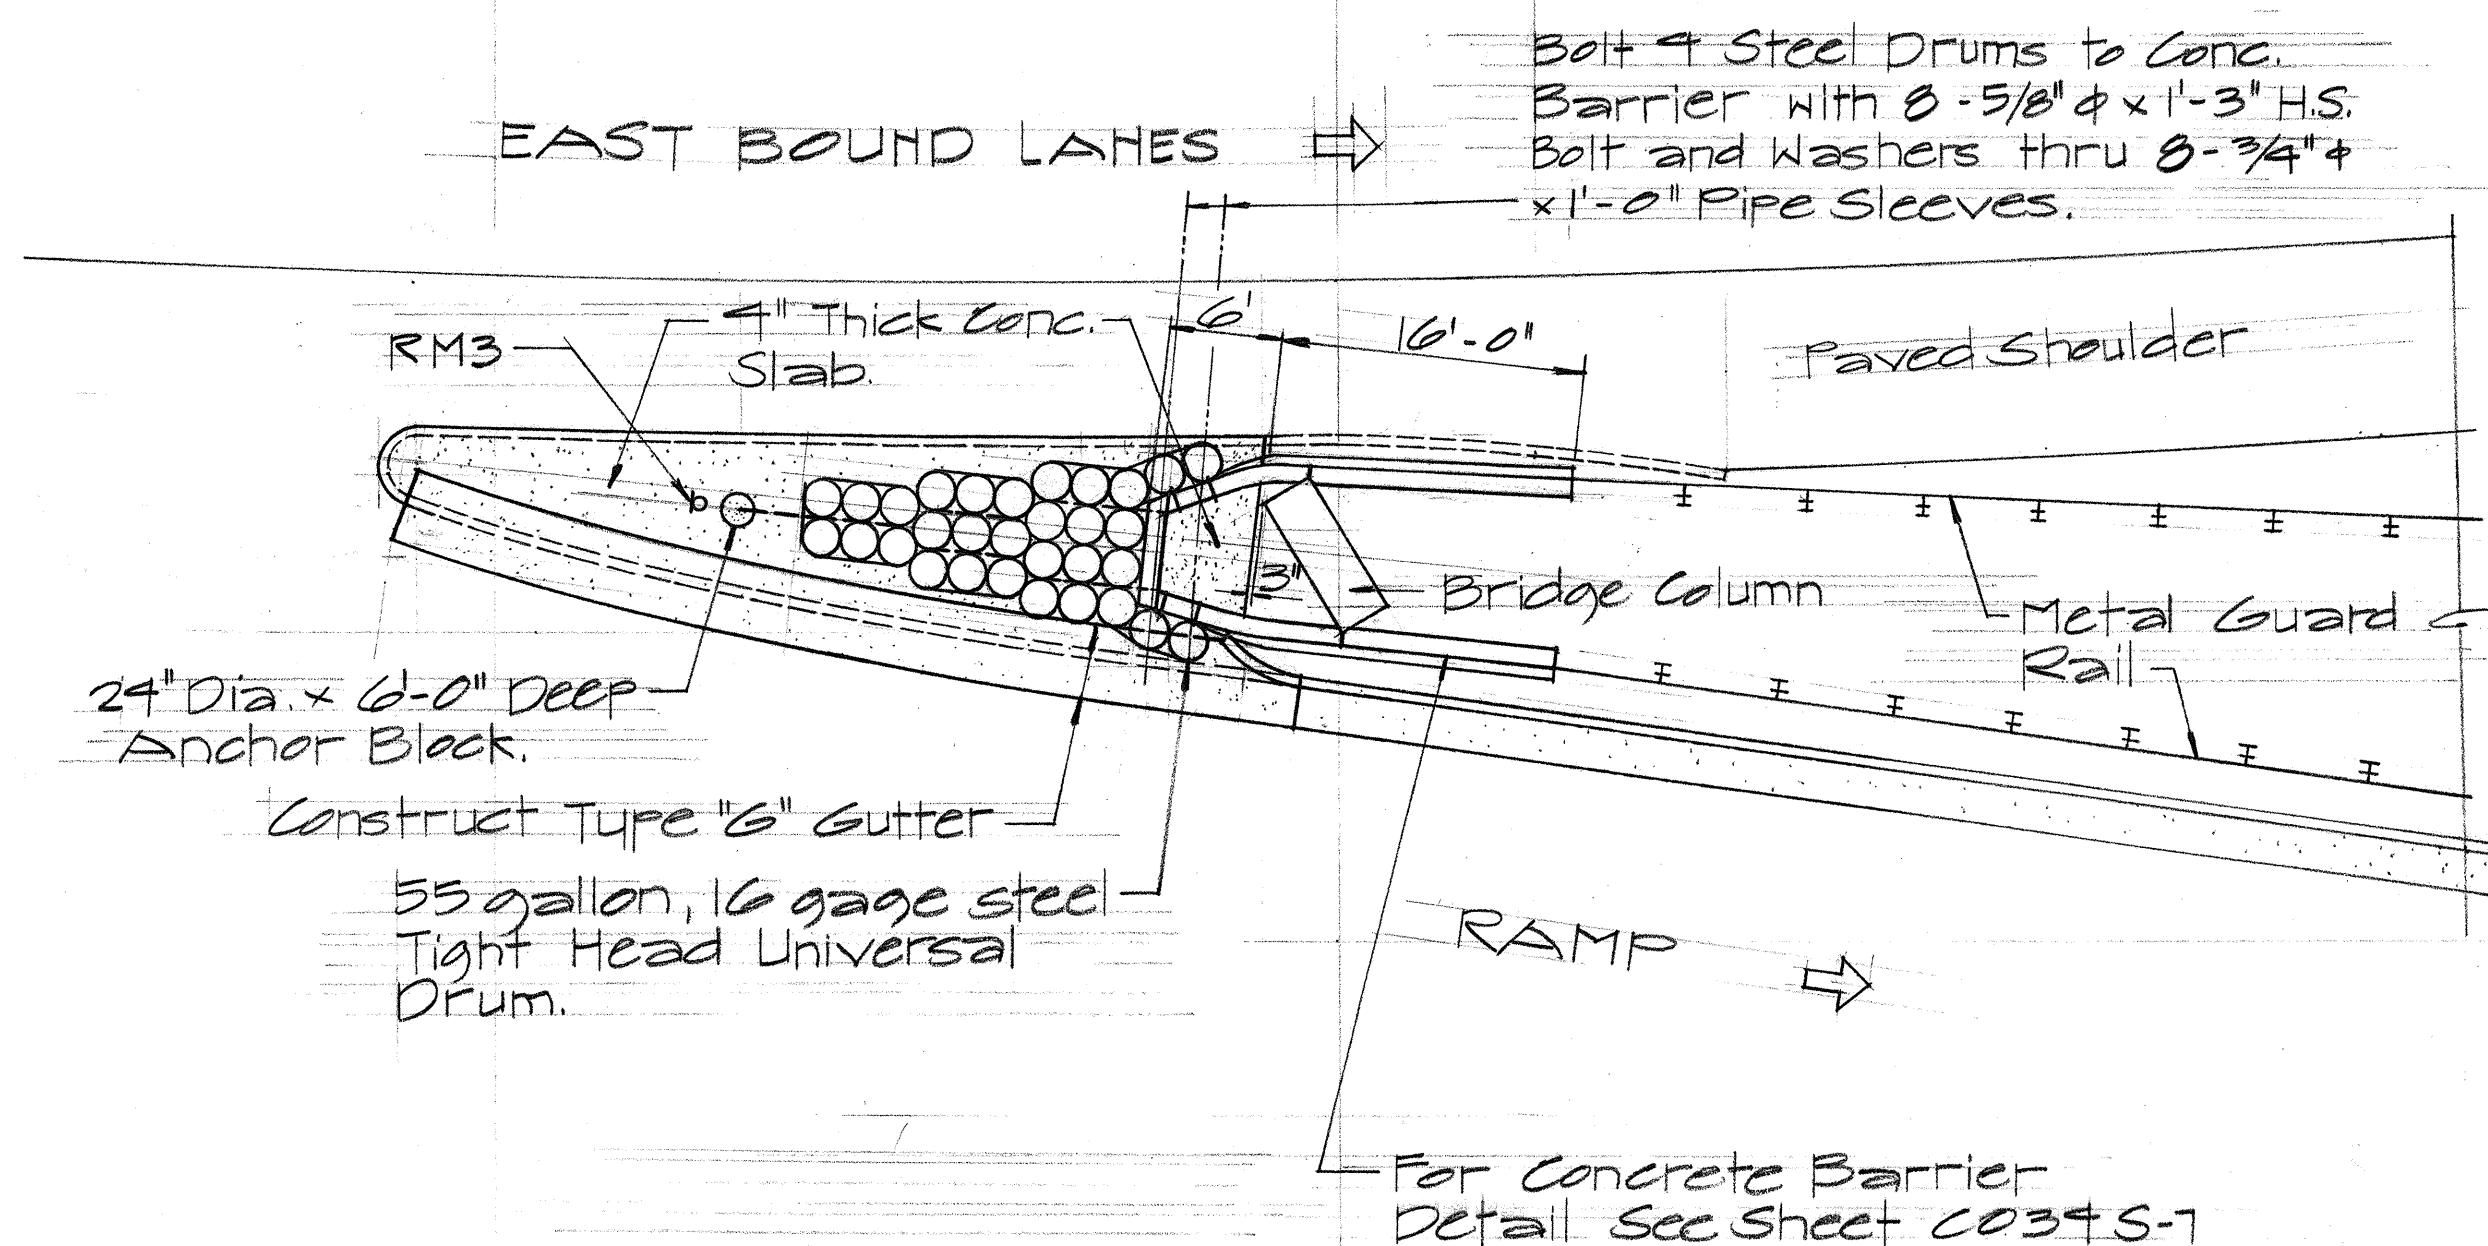


ENLARGED PLAN
Sc. 1" = 10'-0"

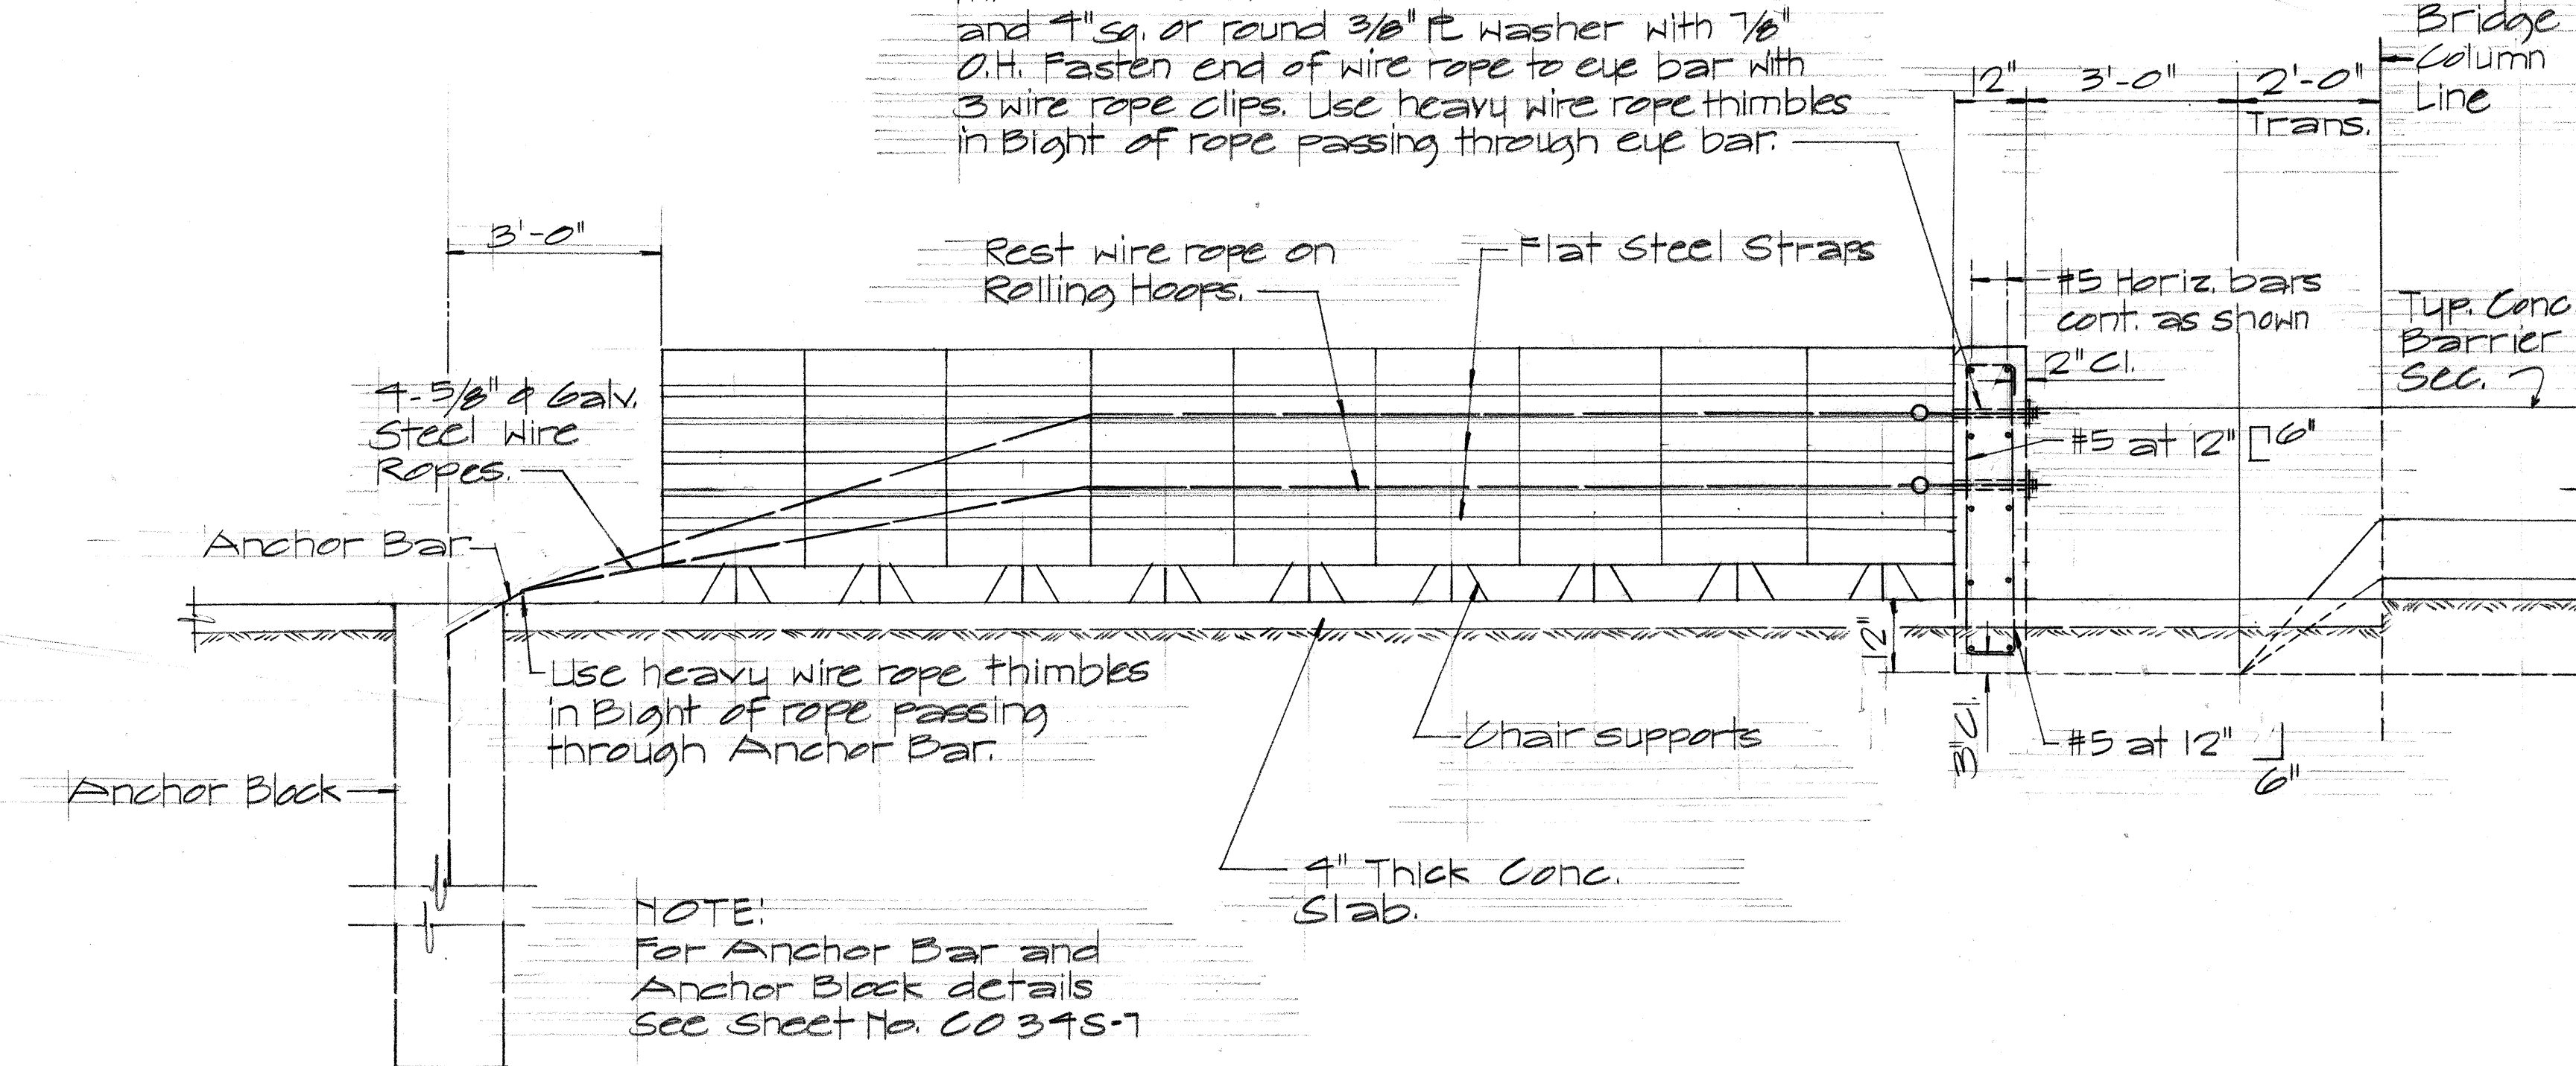


ELEVATION
Sc. 1/2" = 1'-0"

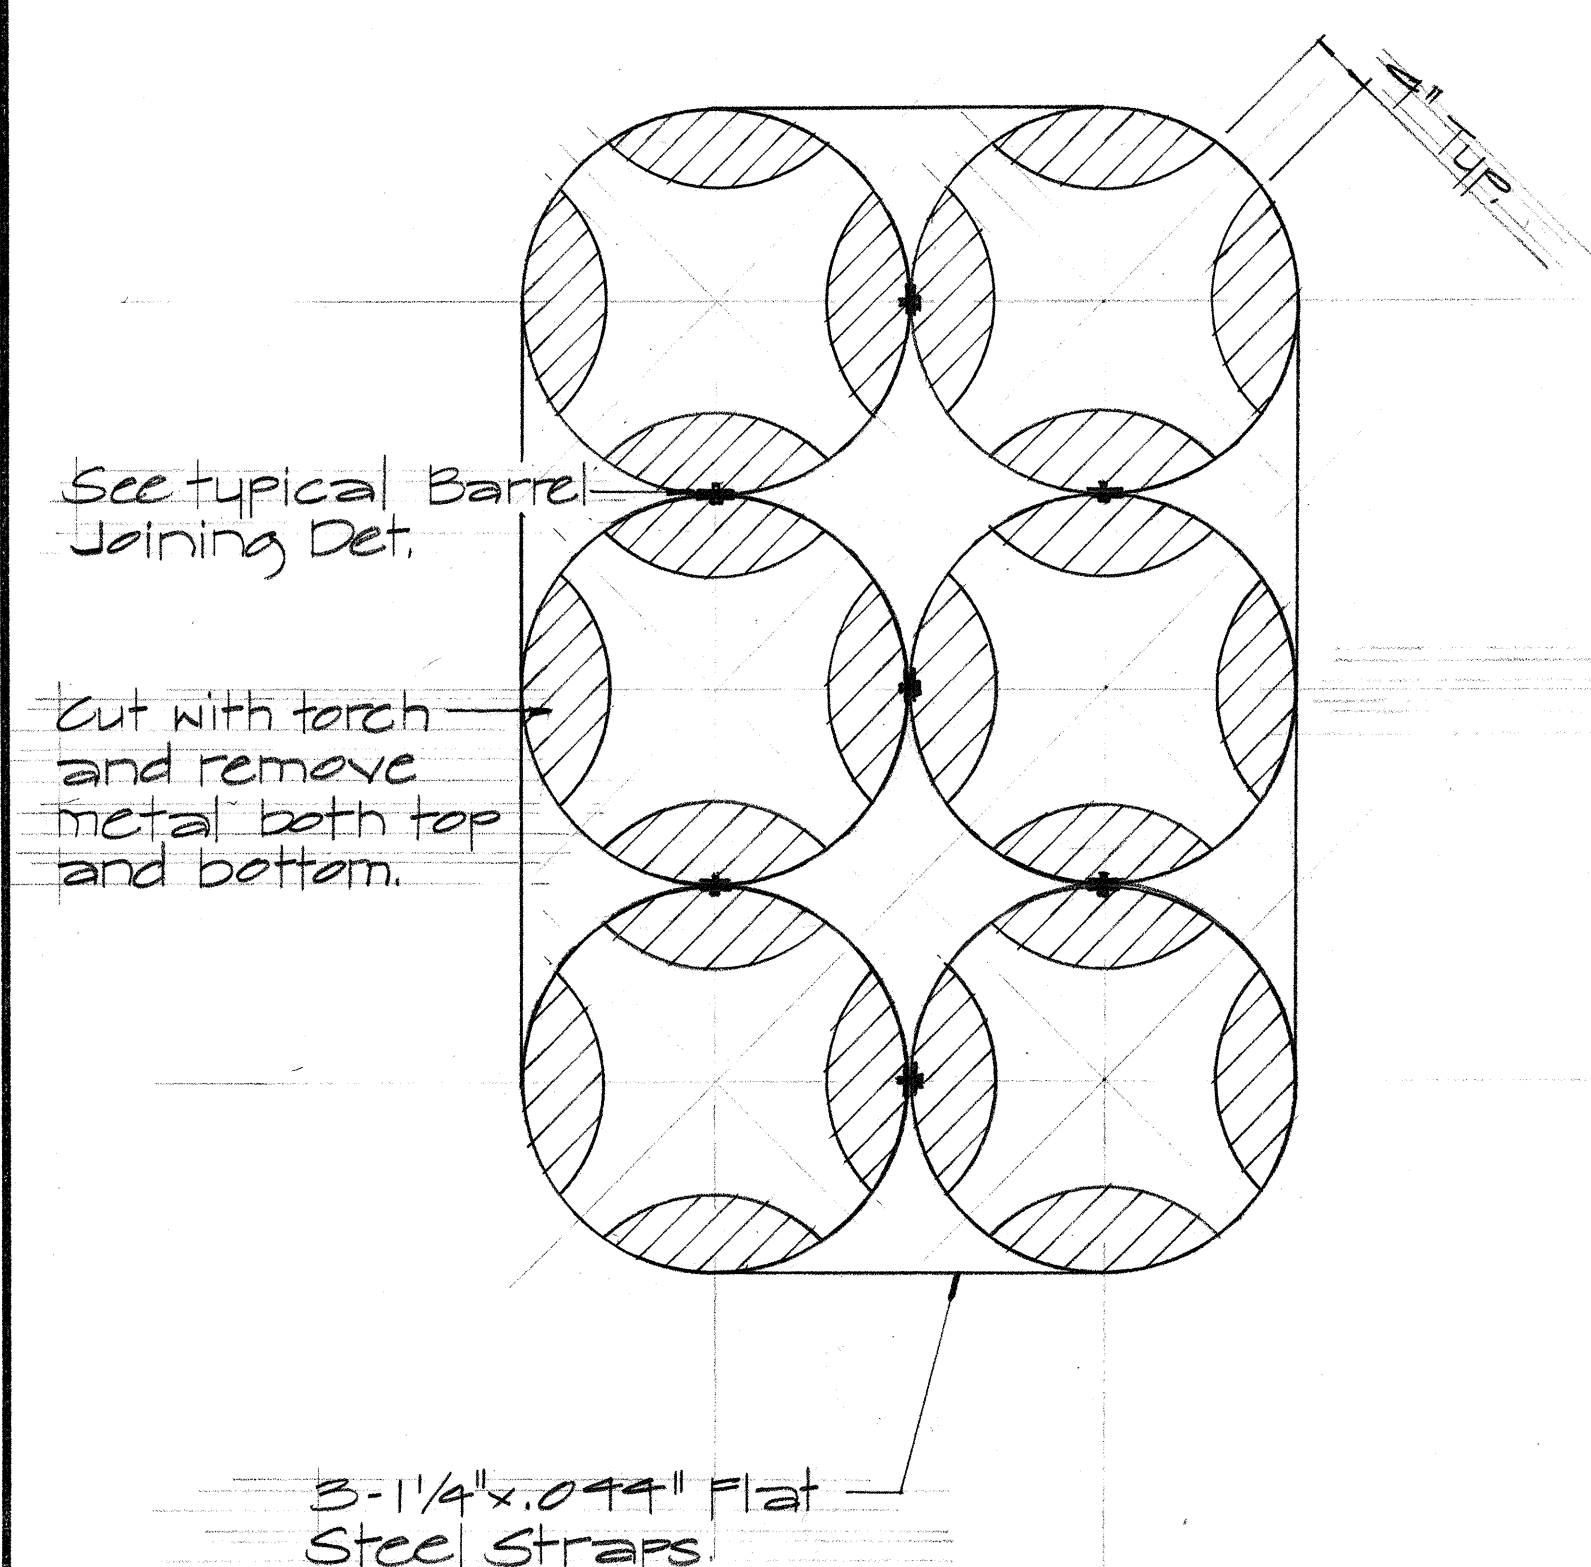

TYP. BARREL LAYOUT
Sc. 1" = 1'-0"

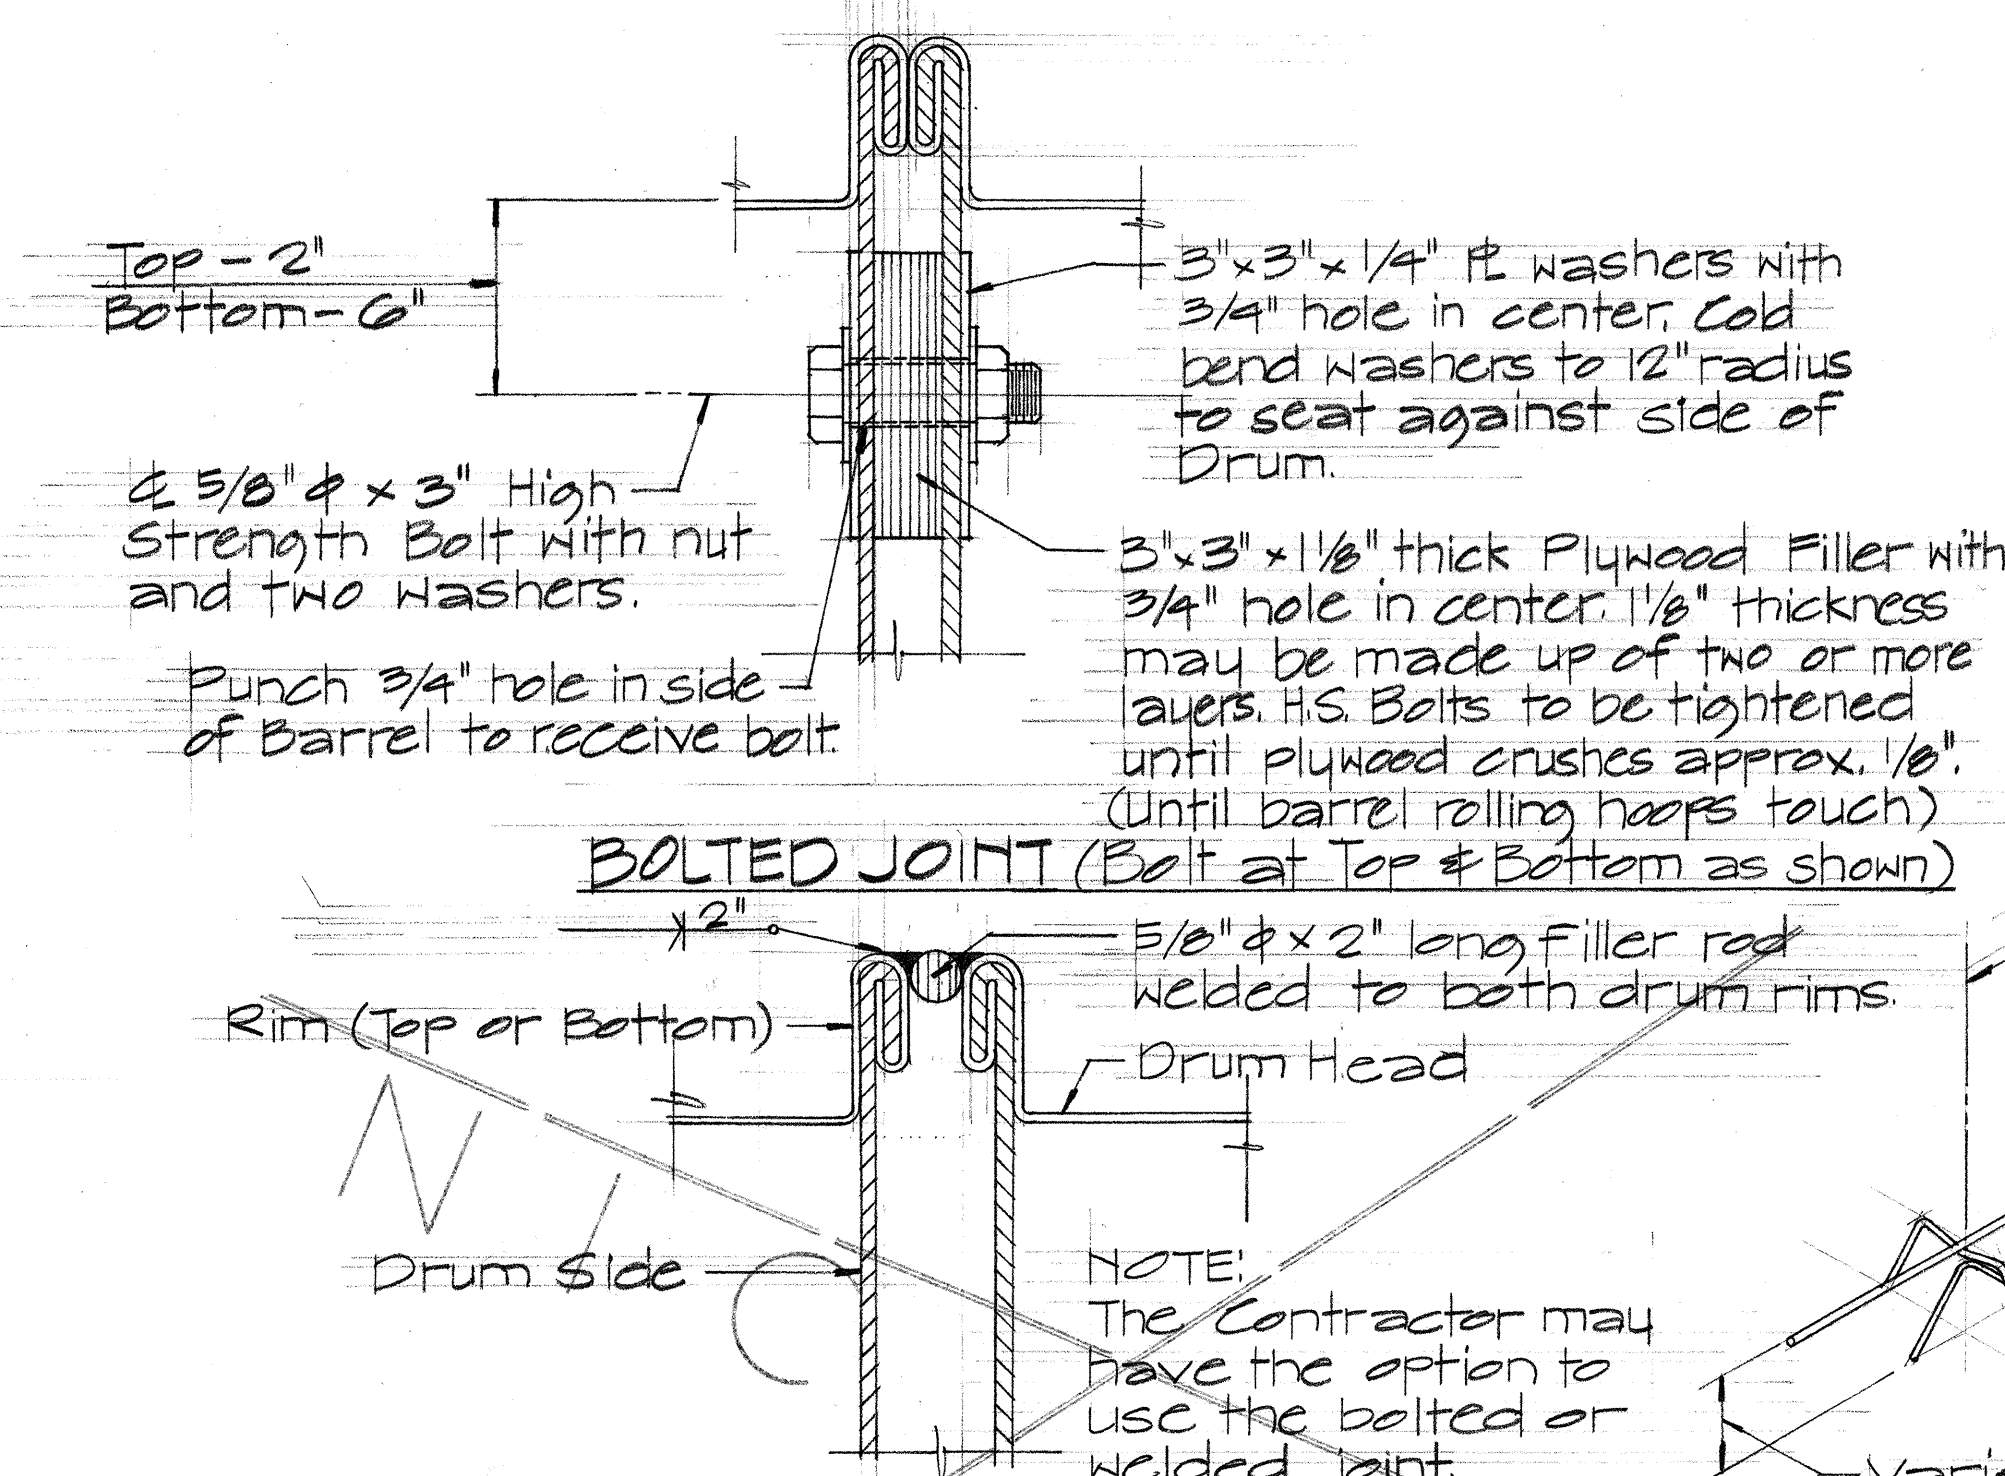

TYP. BARREL JOINING DETAILS
Not To Scale

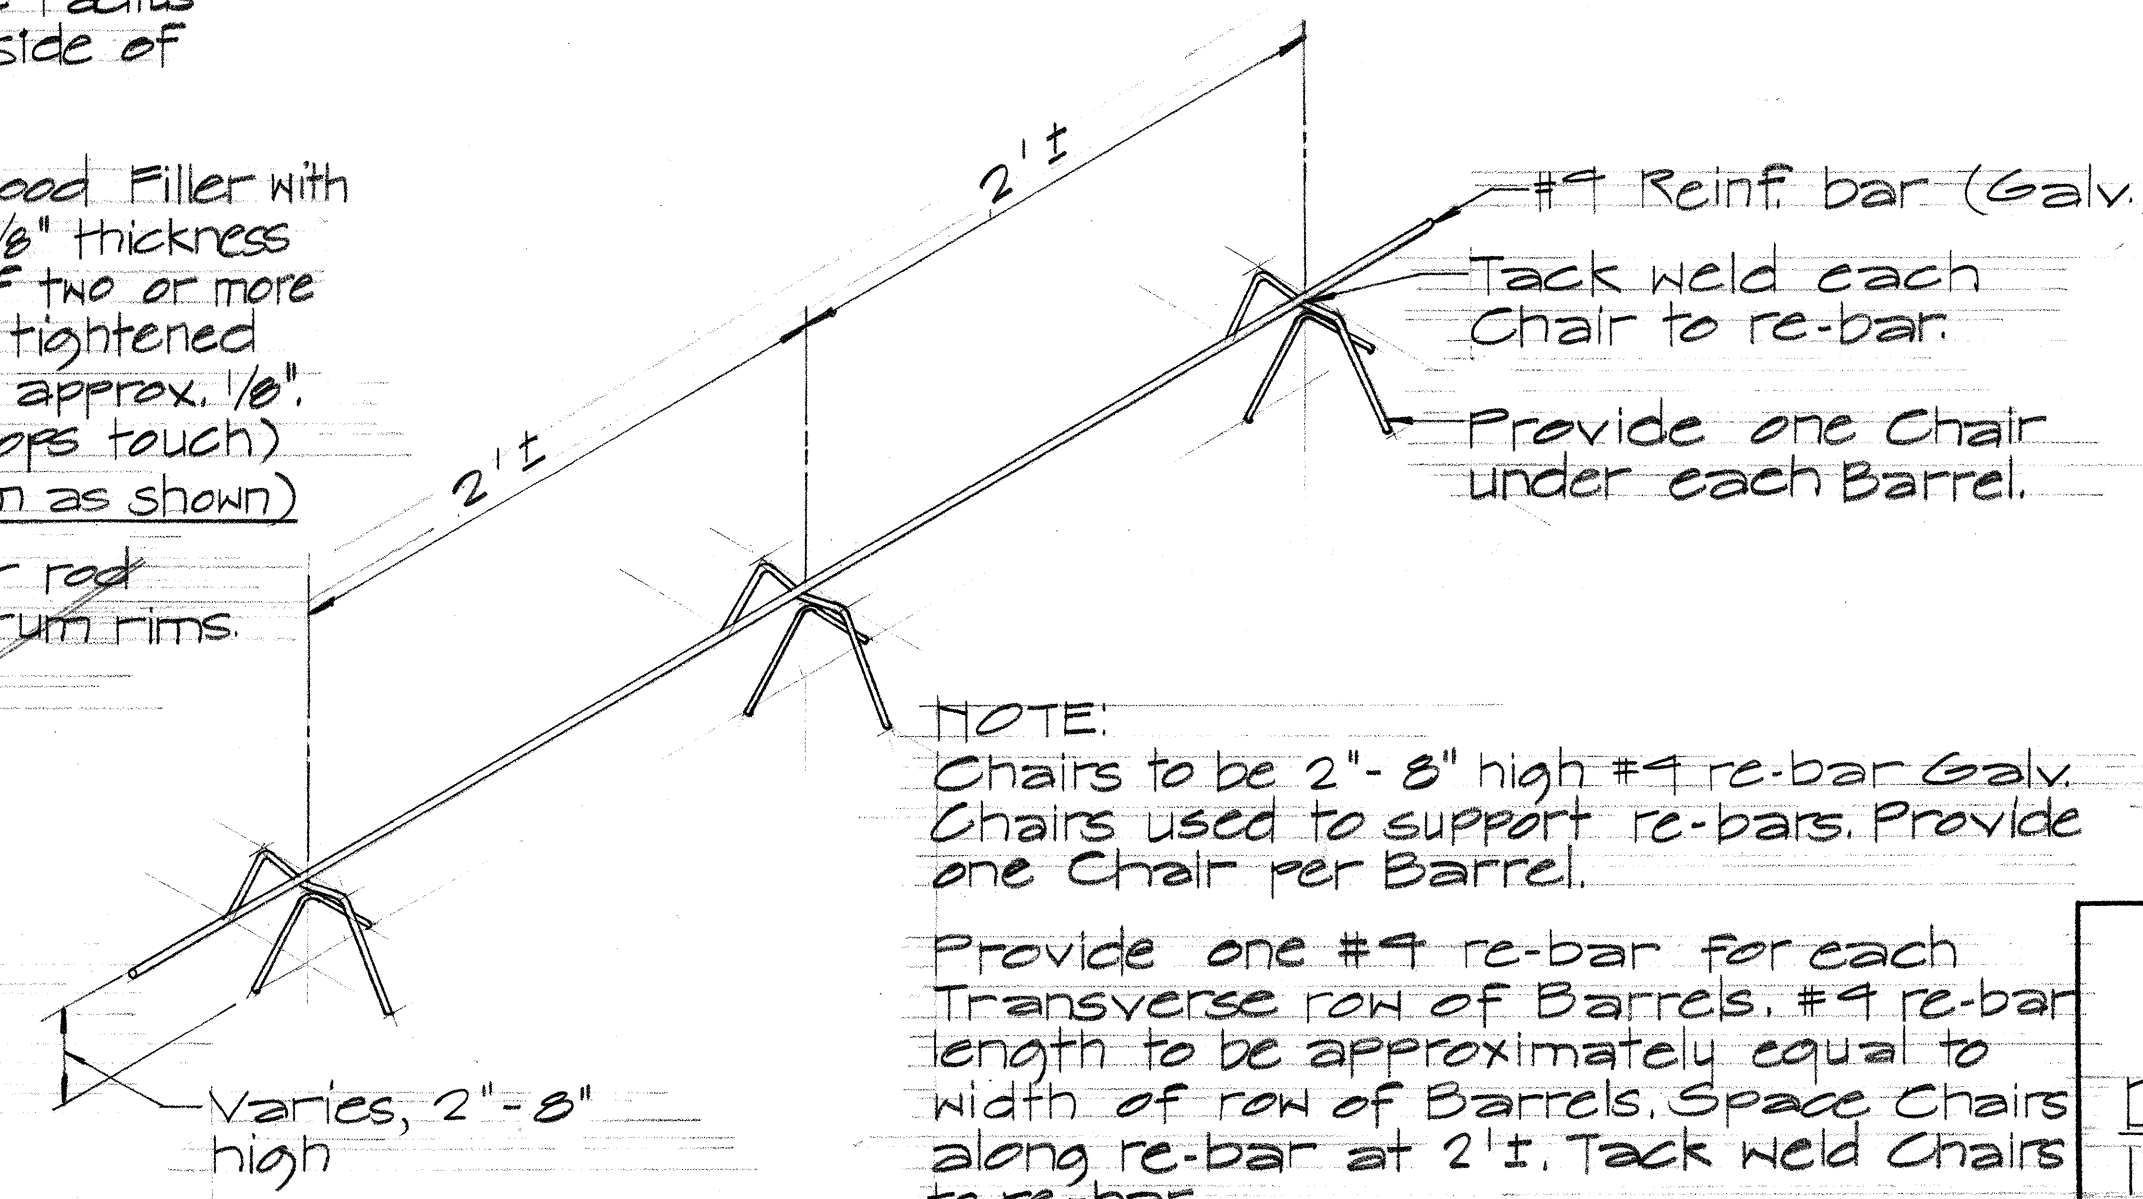

TYP. DET. OF CHAIR SUPPORTS
Not To Scale

THIS SHEET IS A SUPPLEMENT TO THE CONTRACT PLANS

STATE OF HAWAII
DEPARTMENT OF TRANSPORTATION
HIGHWAYS DIVISION

DETAIL OF STEEL DRUM
IMPACT ATTENUATOR

INTERSTATE ROUTE H-1
(LUALABU FREEWAY)

PELE STREET TO VICTORIA STREET

P.A.I. PROJECT No. I-HI-1(31) UNIT 1

SC As Shown April 1969

SHEET No. OF SHEETS


DATE	
SURVEY PLOTTED BY	
DRAWN BY	
CHECKED BY	
QUANTITIES BY	
NOTE BOOK	
No.	

FED. ROAD DIST. NO.	STATE	FED. AID PROJ. NO.	FISCAL YEAR	SHEET NO.	TOTAL SHEETS
HAWAII	HAW.	HI-1(3) UNIT	1969	34	272


Revised: 6-14-69

GENERAL NOTES


- 1-The Vehicular Impact Barrel Assembly shall include furnishing and installing all barrels, wire rope and fittings, all bolts, nuts, washers and eye bars and all fabrication and necessary coatings and painting together with all other attachments and appurtenances necessary to complete the assembly.
- 2-Concrete for Concrete Barrier, Anchor Block and Buttress shall be Class "A-1" concrete.
- 3-H.S. Bolts shall conform to the requirements of ASTM A-325.
- 4-Special End Shoe shall be fabricated from 10 ga. steel conforming to the requirements of AASHTO 180.
- 5-Exterior Barrels shall be painted with White Reflectorized Paint.

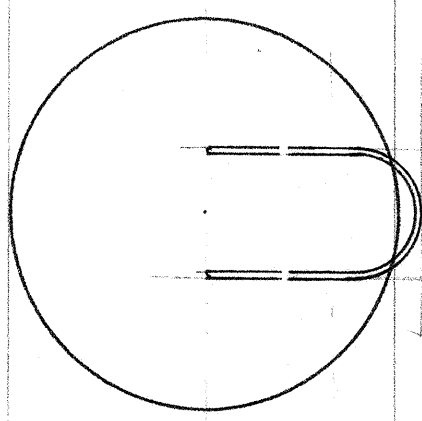

PLAN

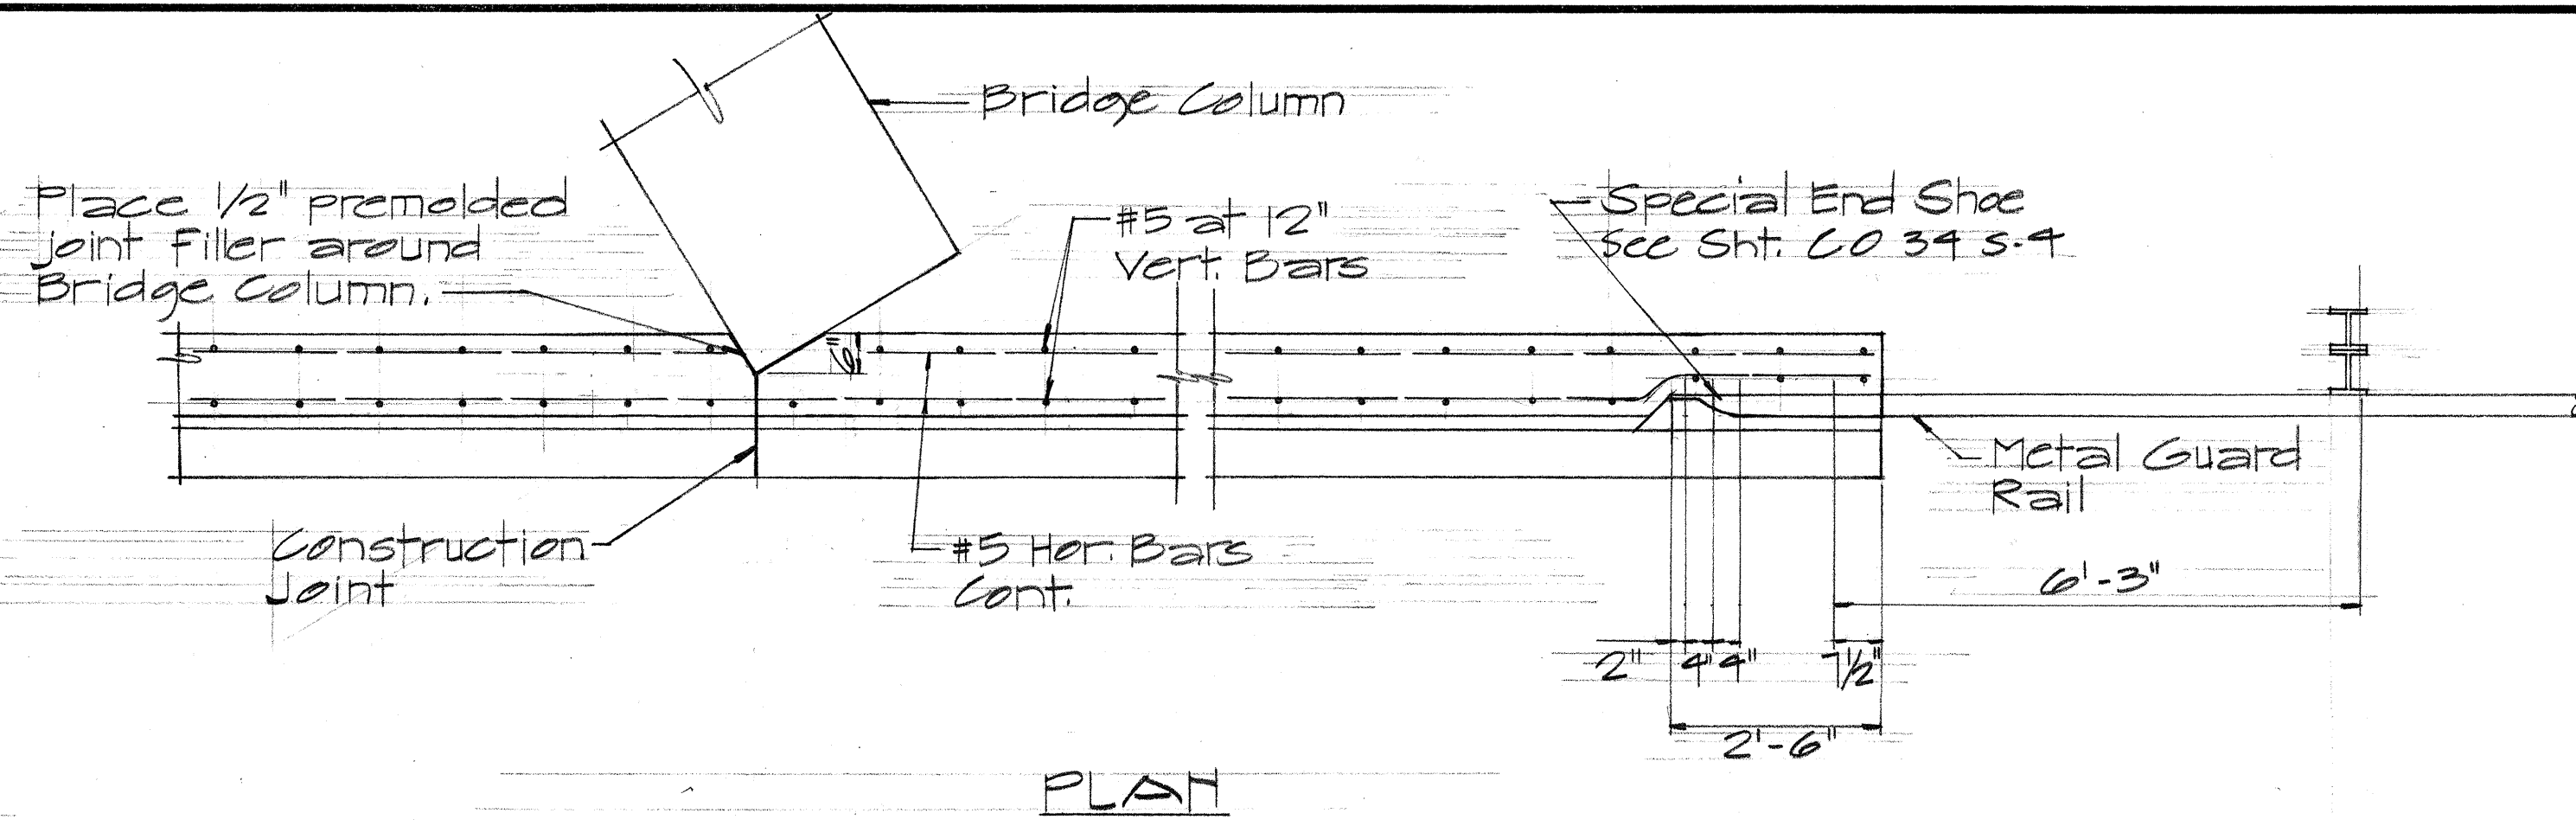


PLAN

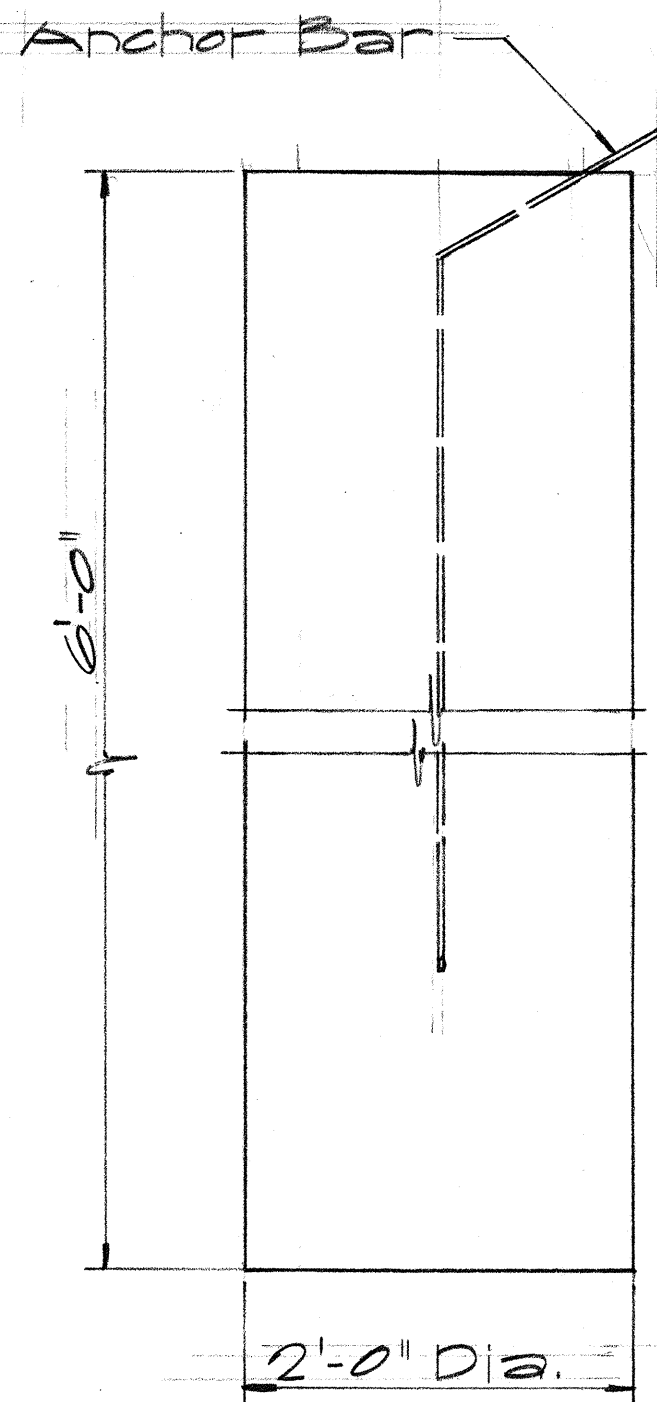


ELEVATION

ANCHOR BLOCK DET.
Sc. 1" = 1'-0"

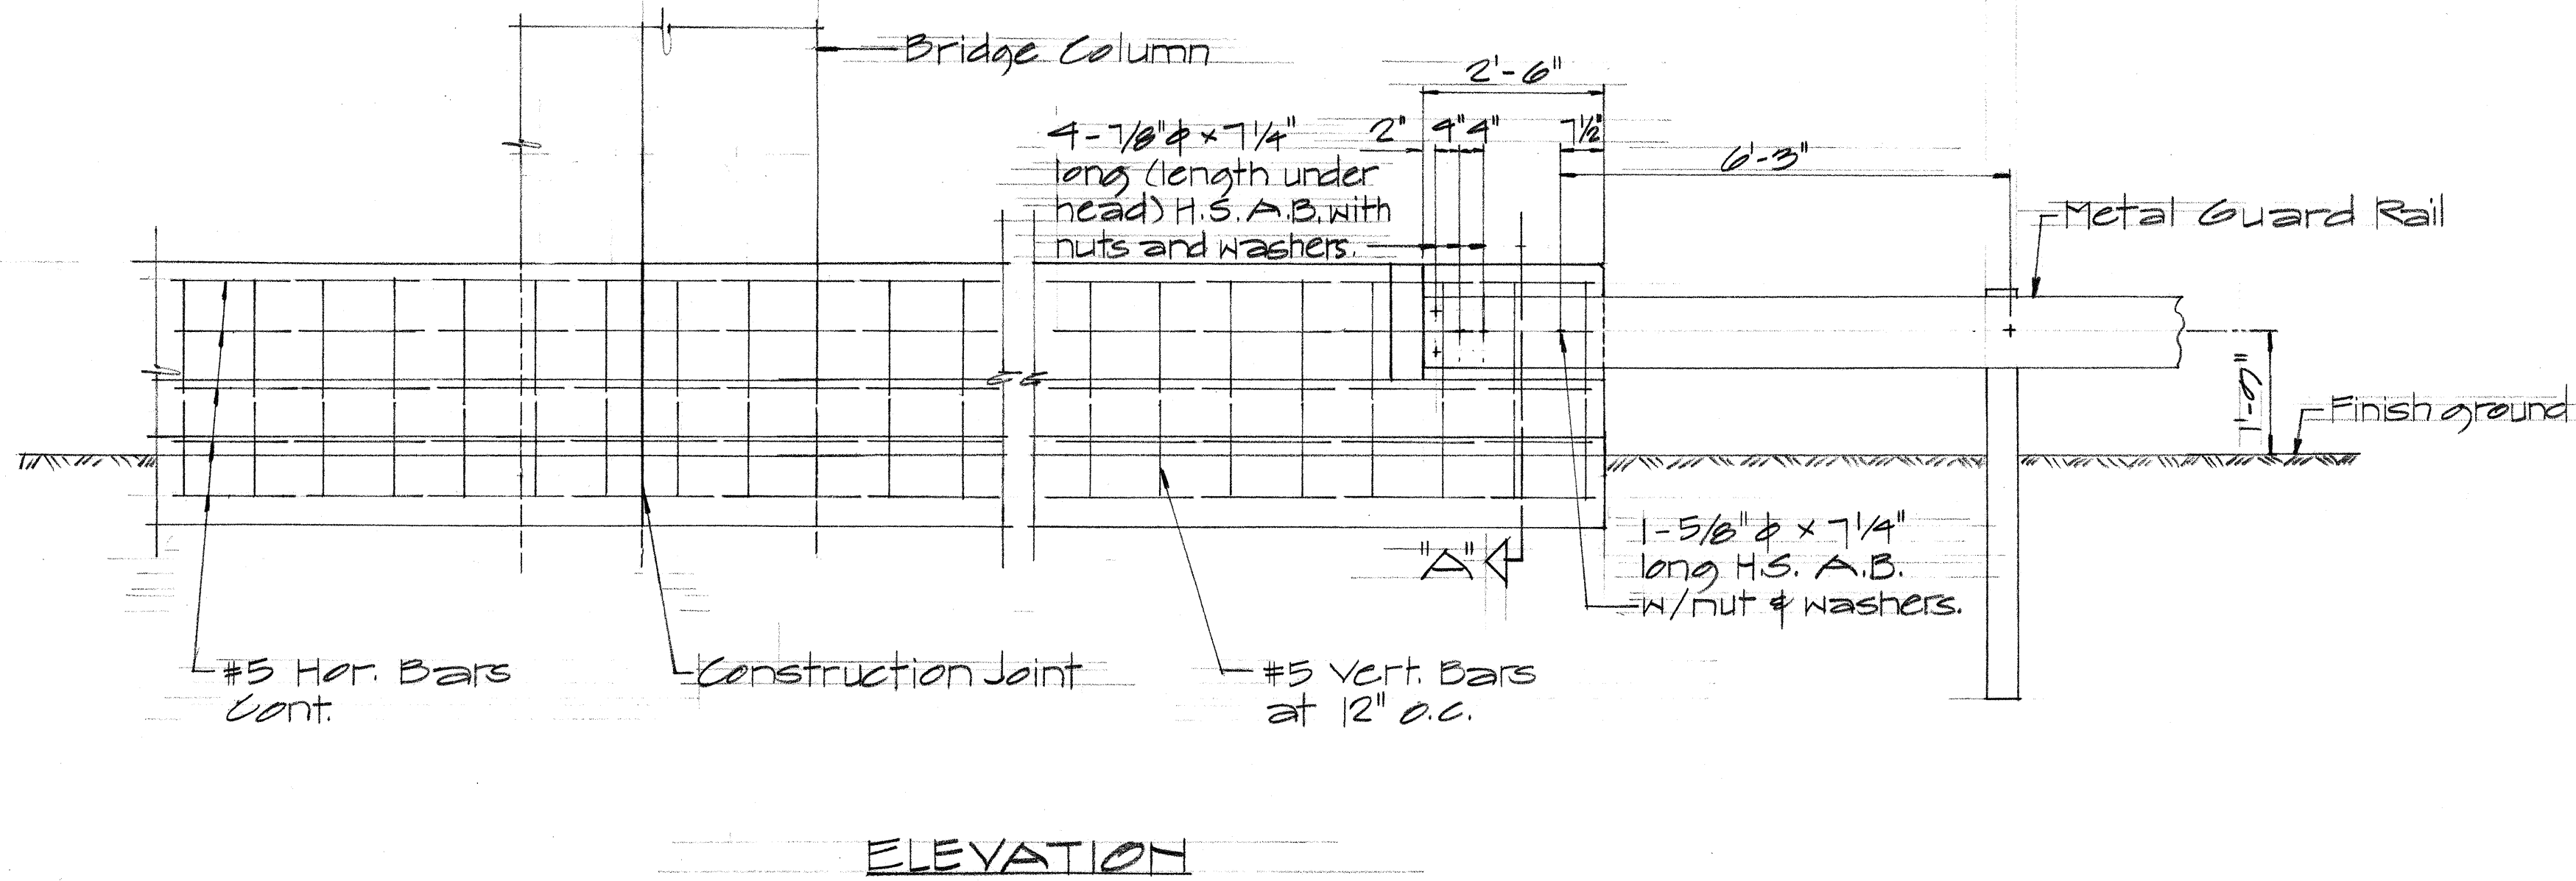


ELEVATION

CONCRETE BARRIER DET.
Sc. 1/2" = 1'-0"

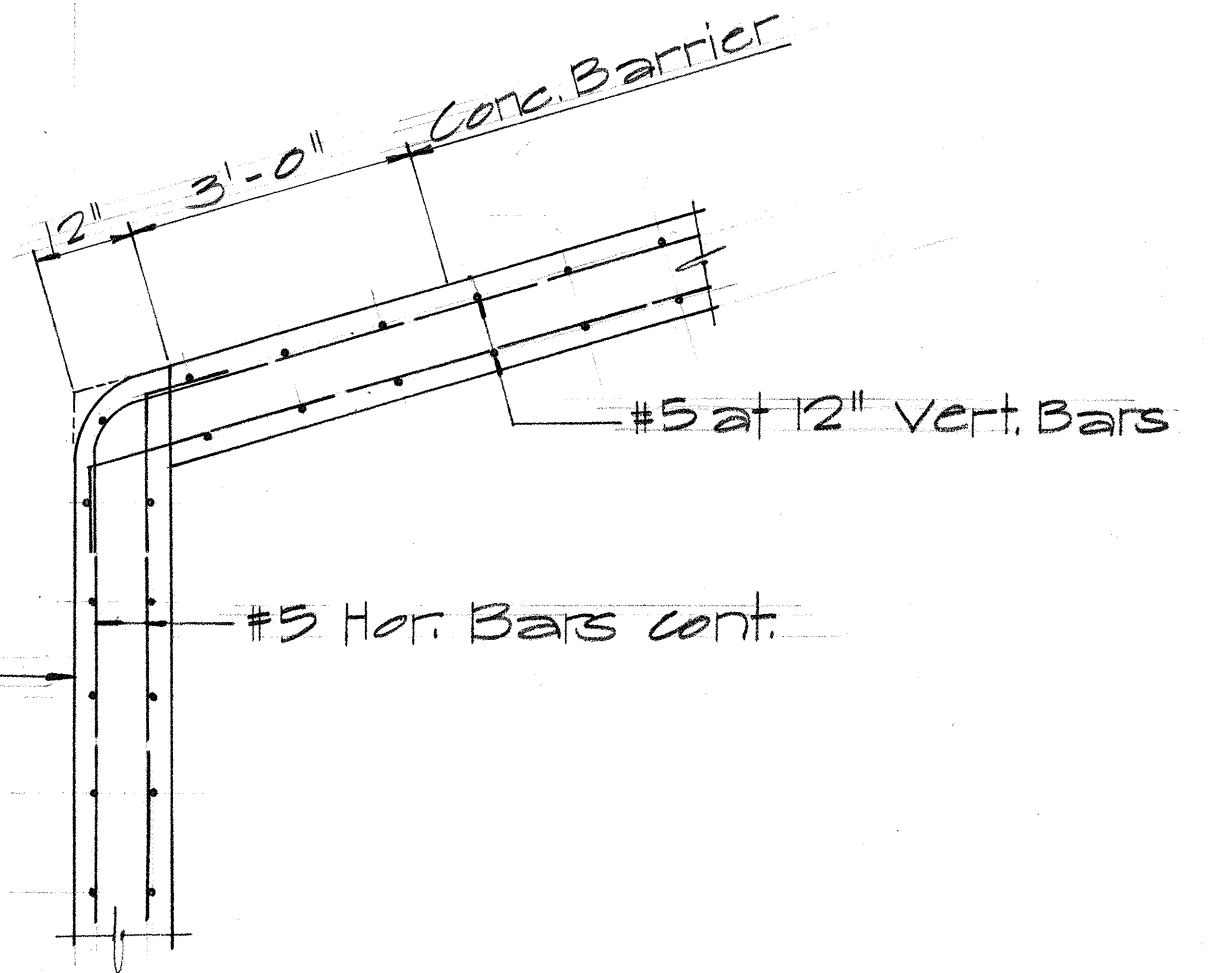



TYP. CORNER DET.
Sc. 1/2" = 1'-0"

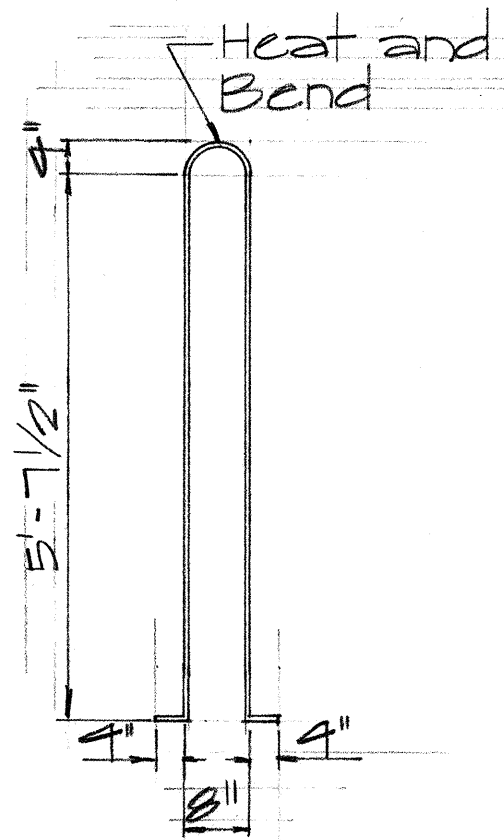


FRONT

SIDE

ANCHOR BAR DET.
Sc. 1/2" = 1'-0"

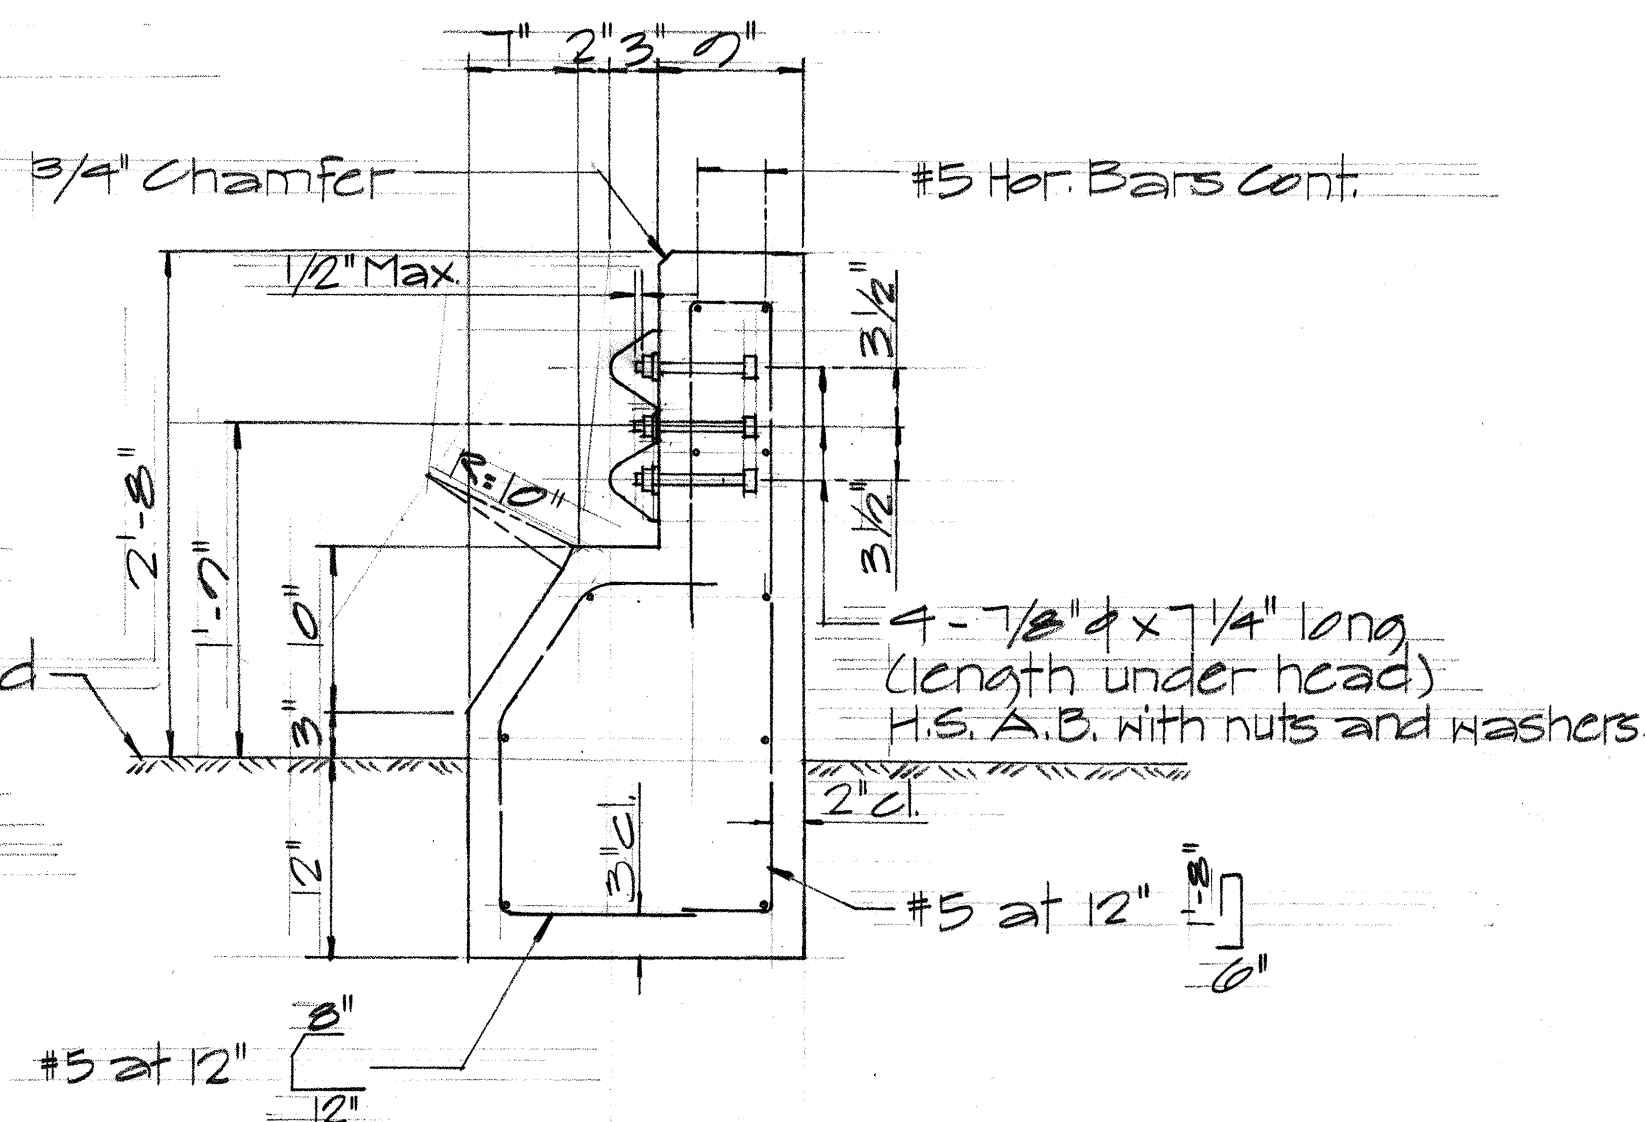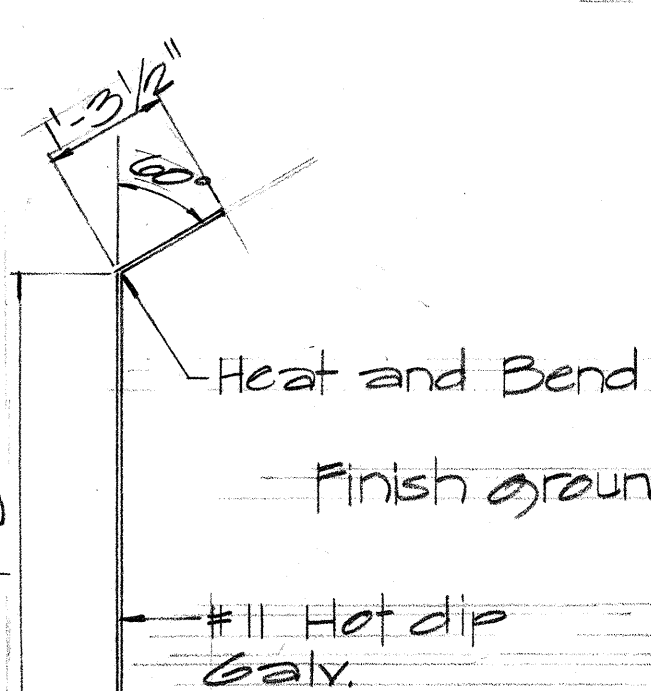

SECTION "A"
Sc. 1" = 1'-0"

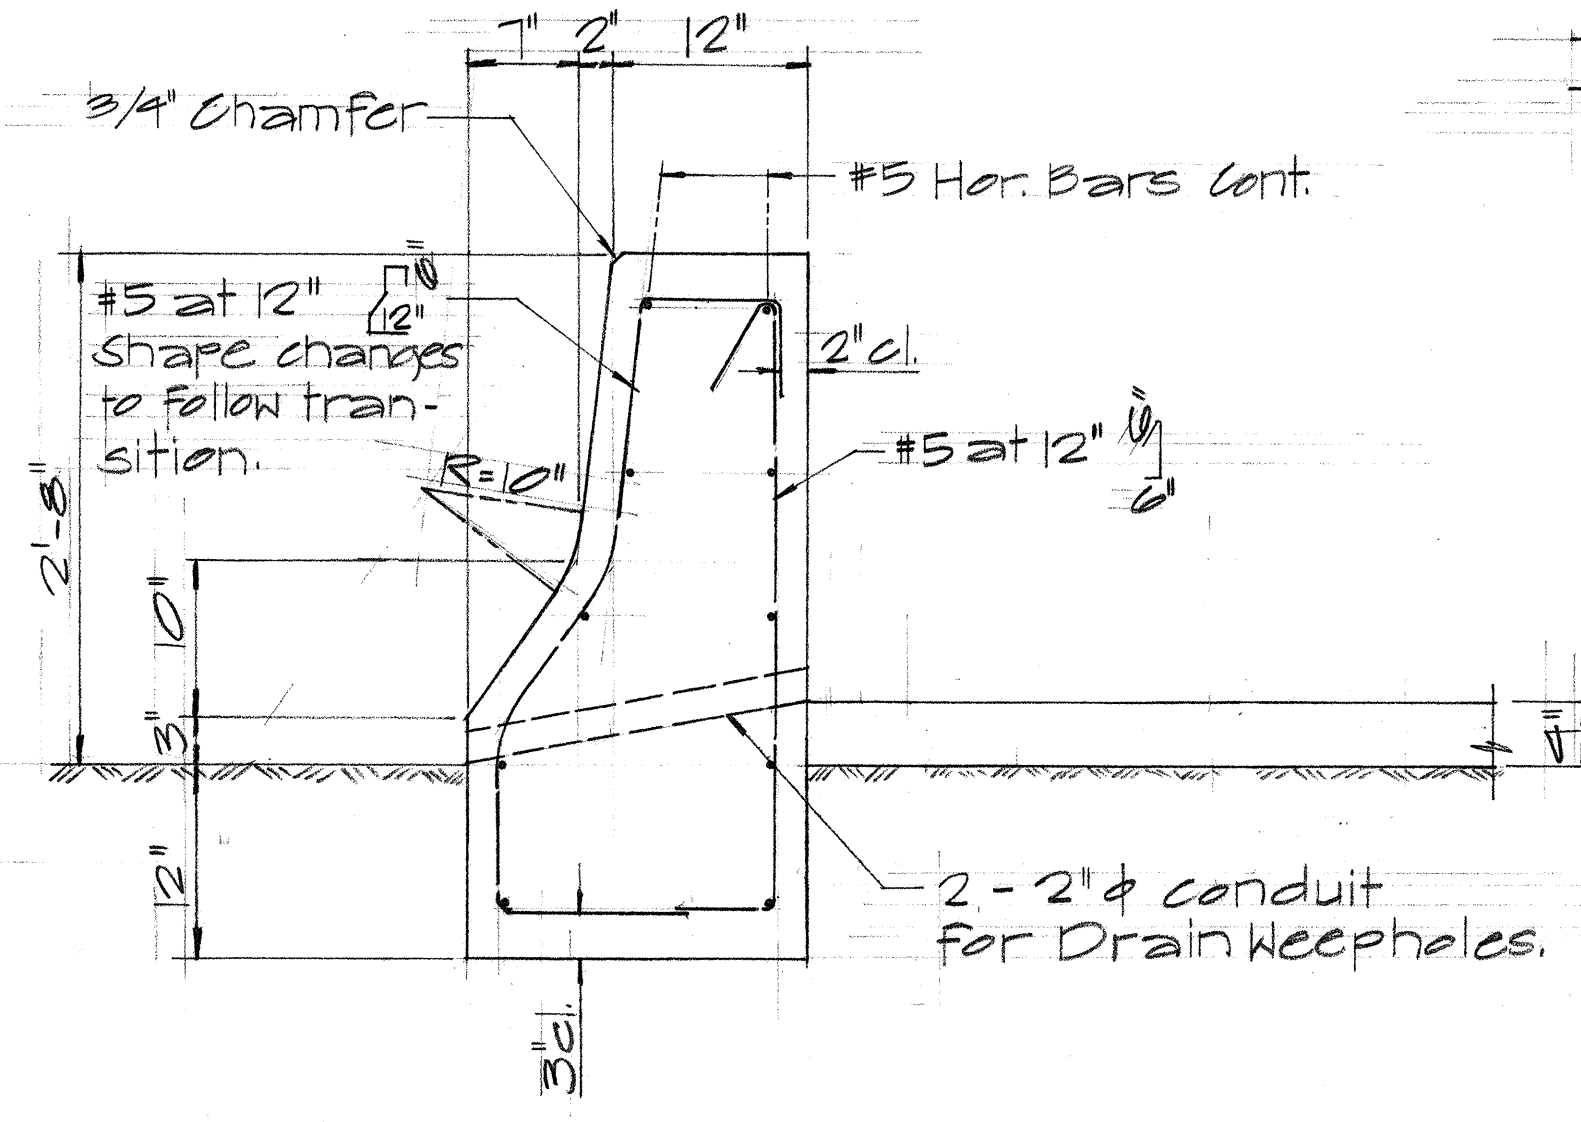






TYP. CONC. BARRIER SEC.
Sc. 1" = 1'-0"

THIS SHEET IS A SUPPLEMENT
TO THE CONTRACT PLANS.

STATE OF HAWAII
DEPARTMENT OF TRANSPORTATION
HIGHWAYS DIVISION
DETAIL OF STEEL DRUM
IMPACT ATTENUATOR
INTERSTATE ROUTE H-1
(LUALABU FREEWAY)
PELE STREET TO VICTORIA STREET
P.A. PROJECT NO. HI-1(3) UNIT
Sc. As Shown April, 1969

SHEET No. OF SHEETS

C O 34 S-7

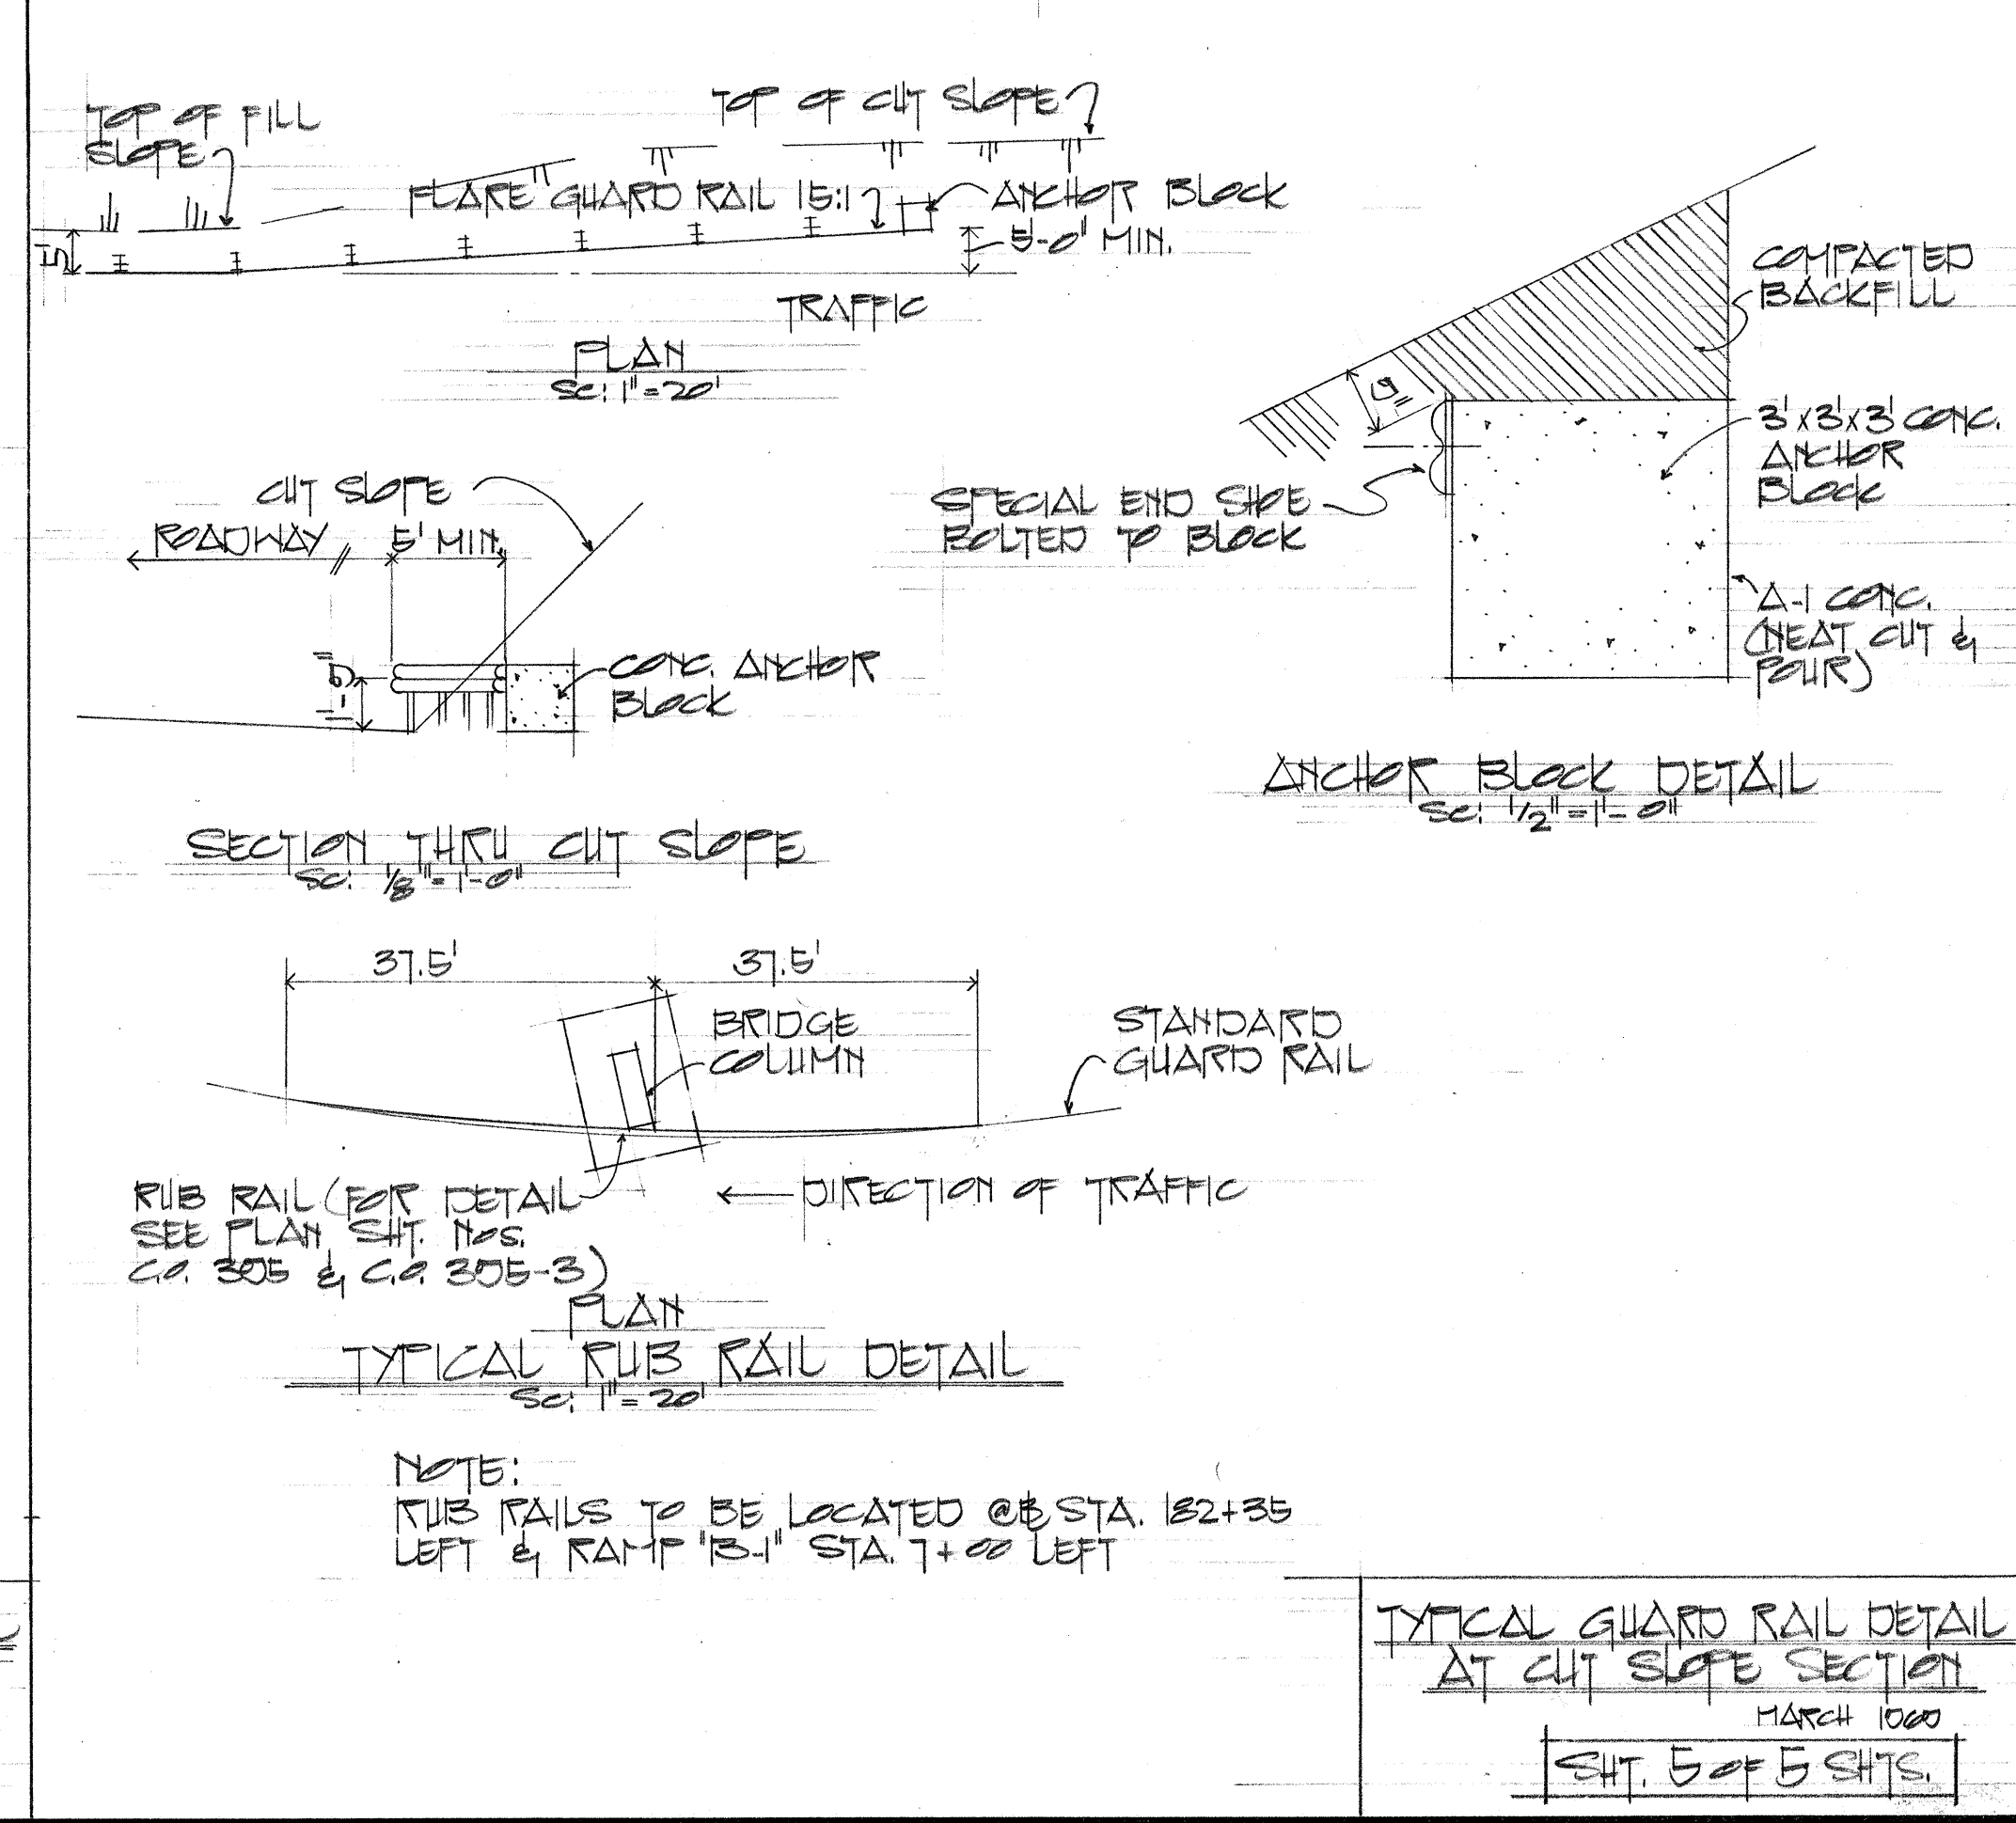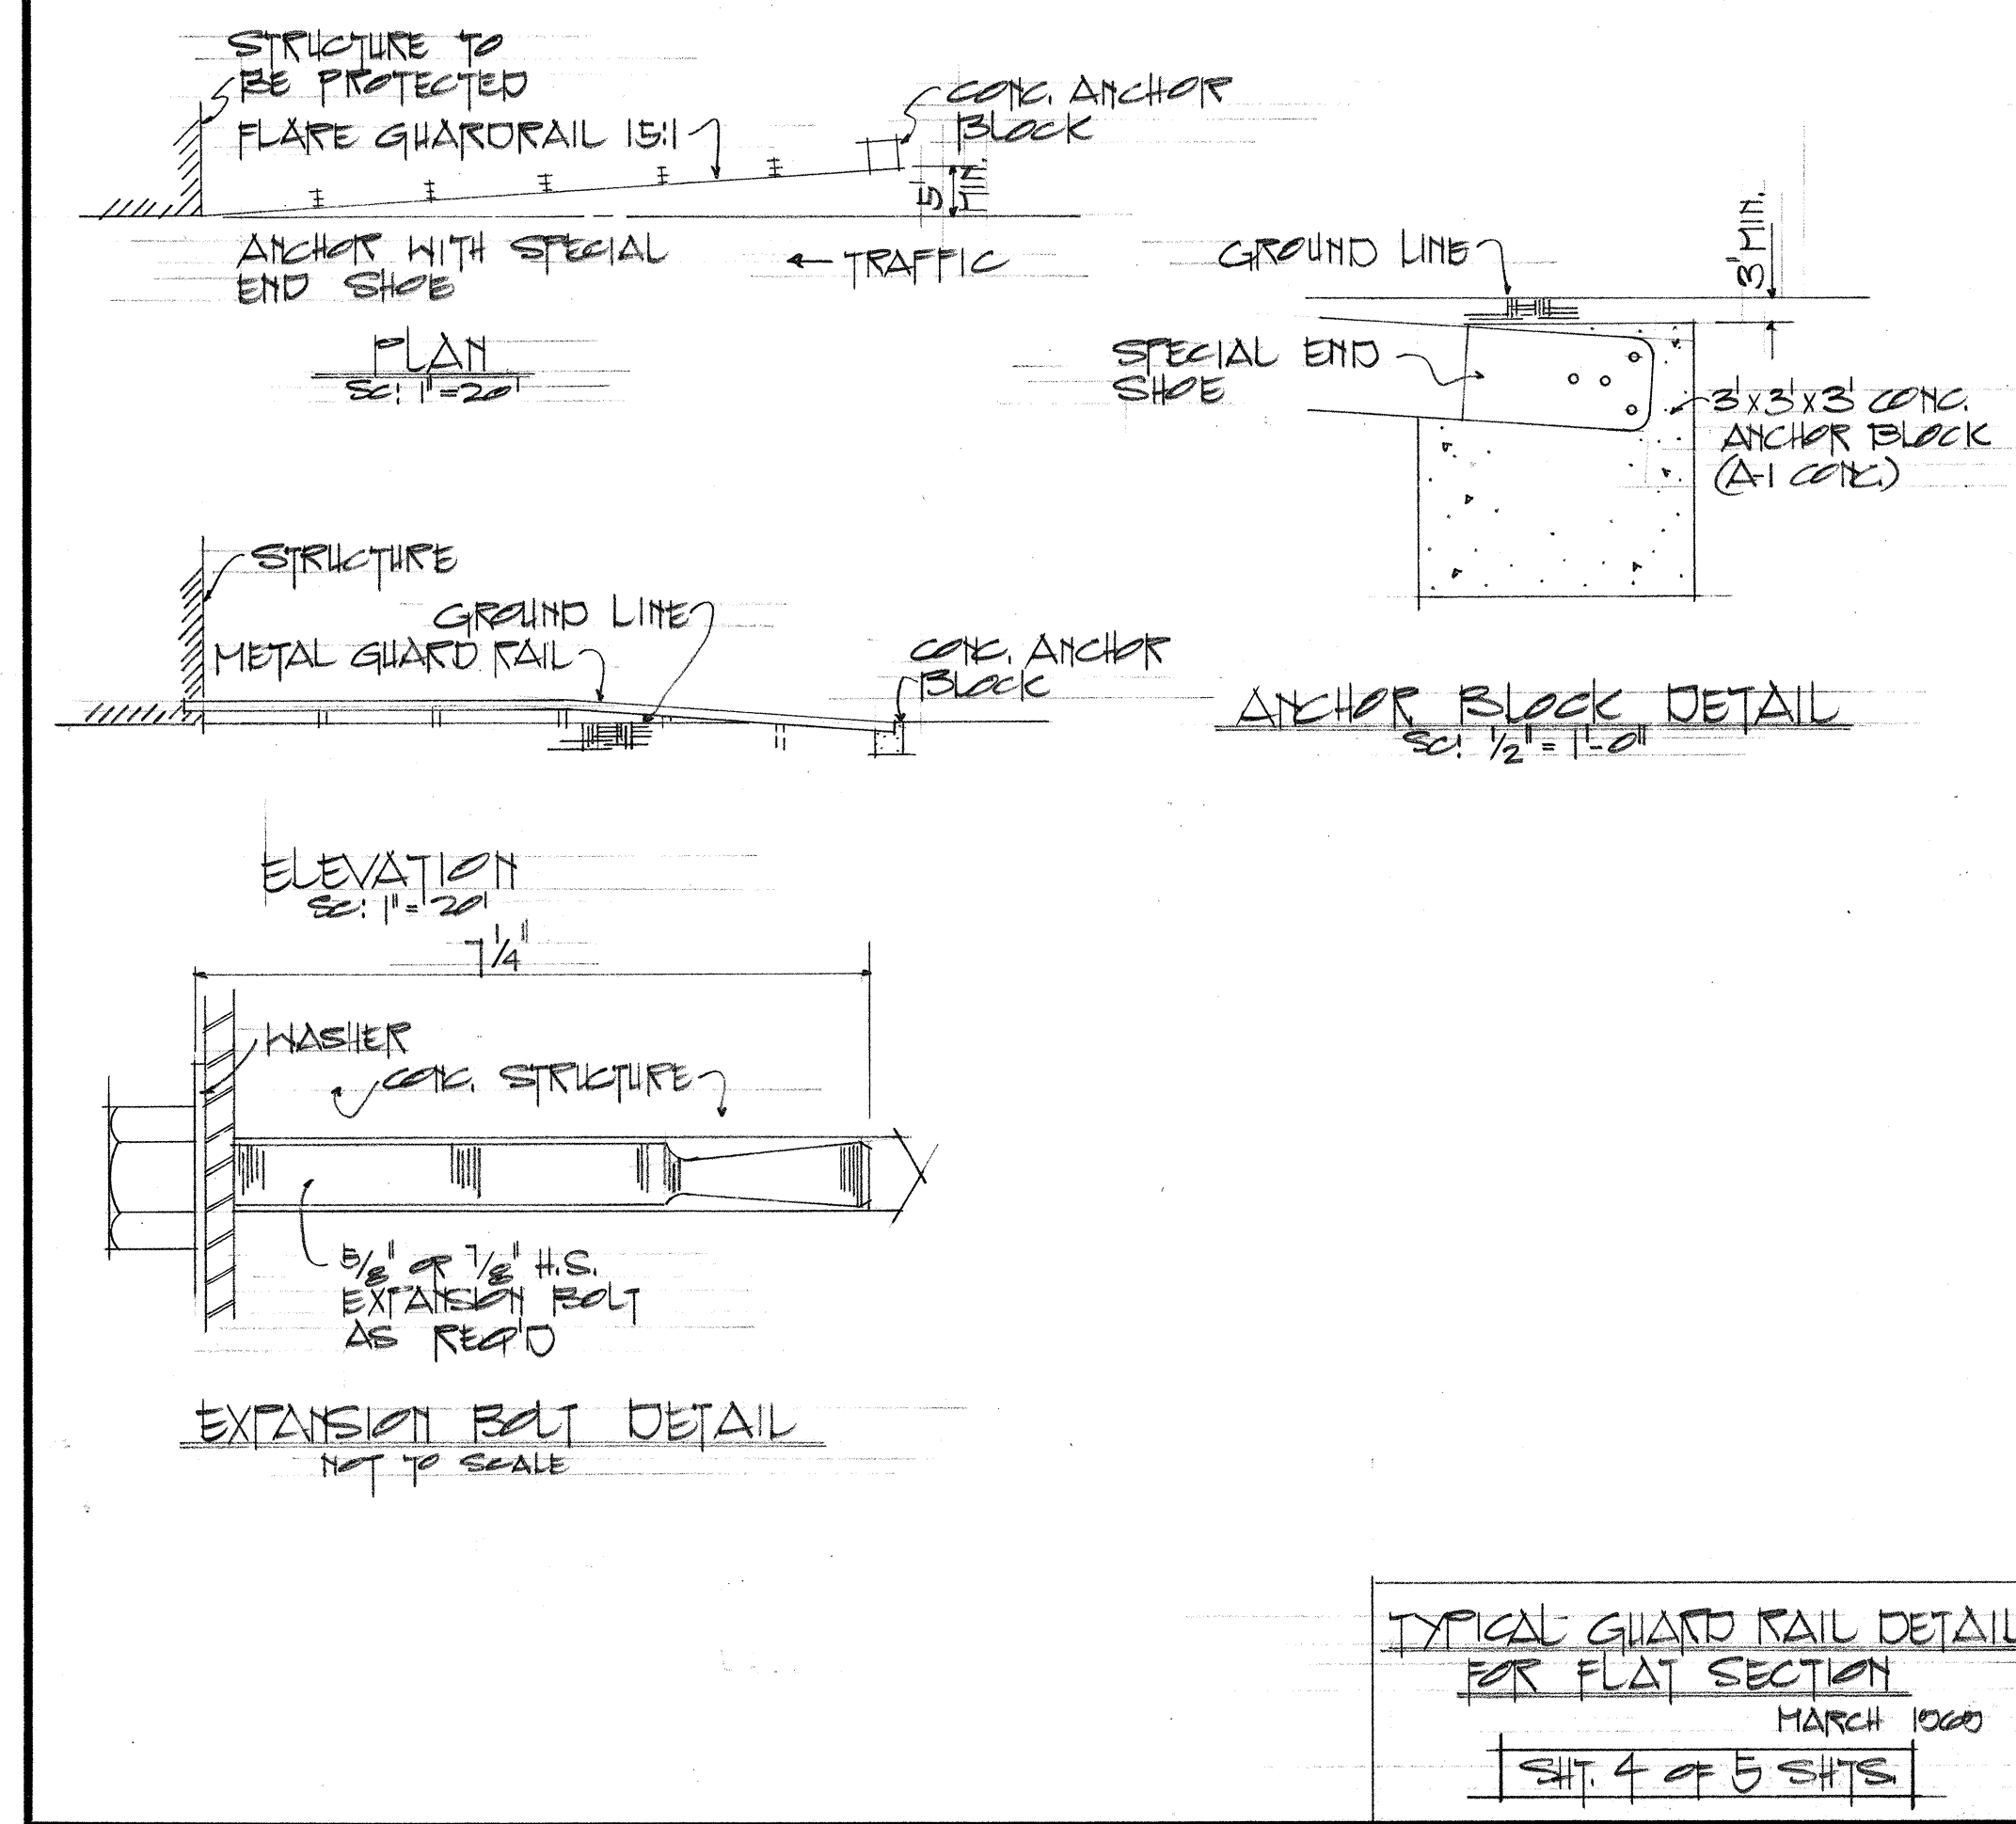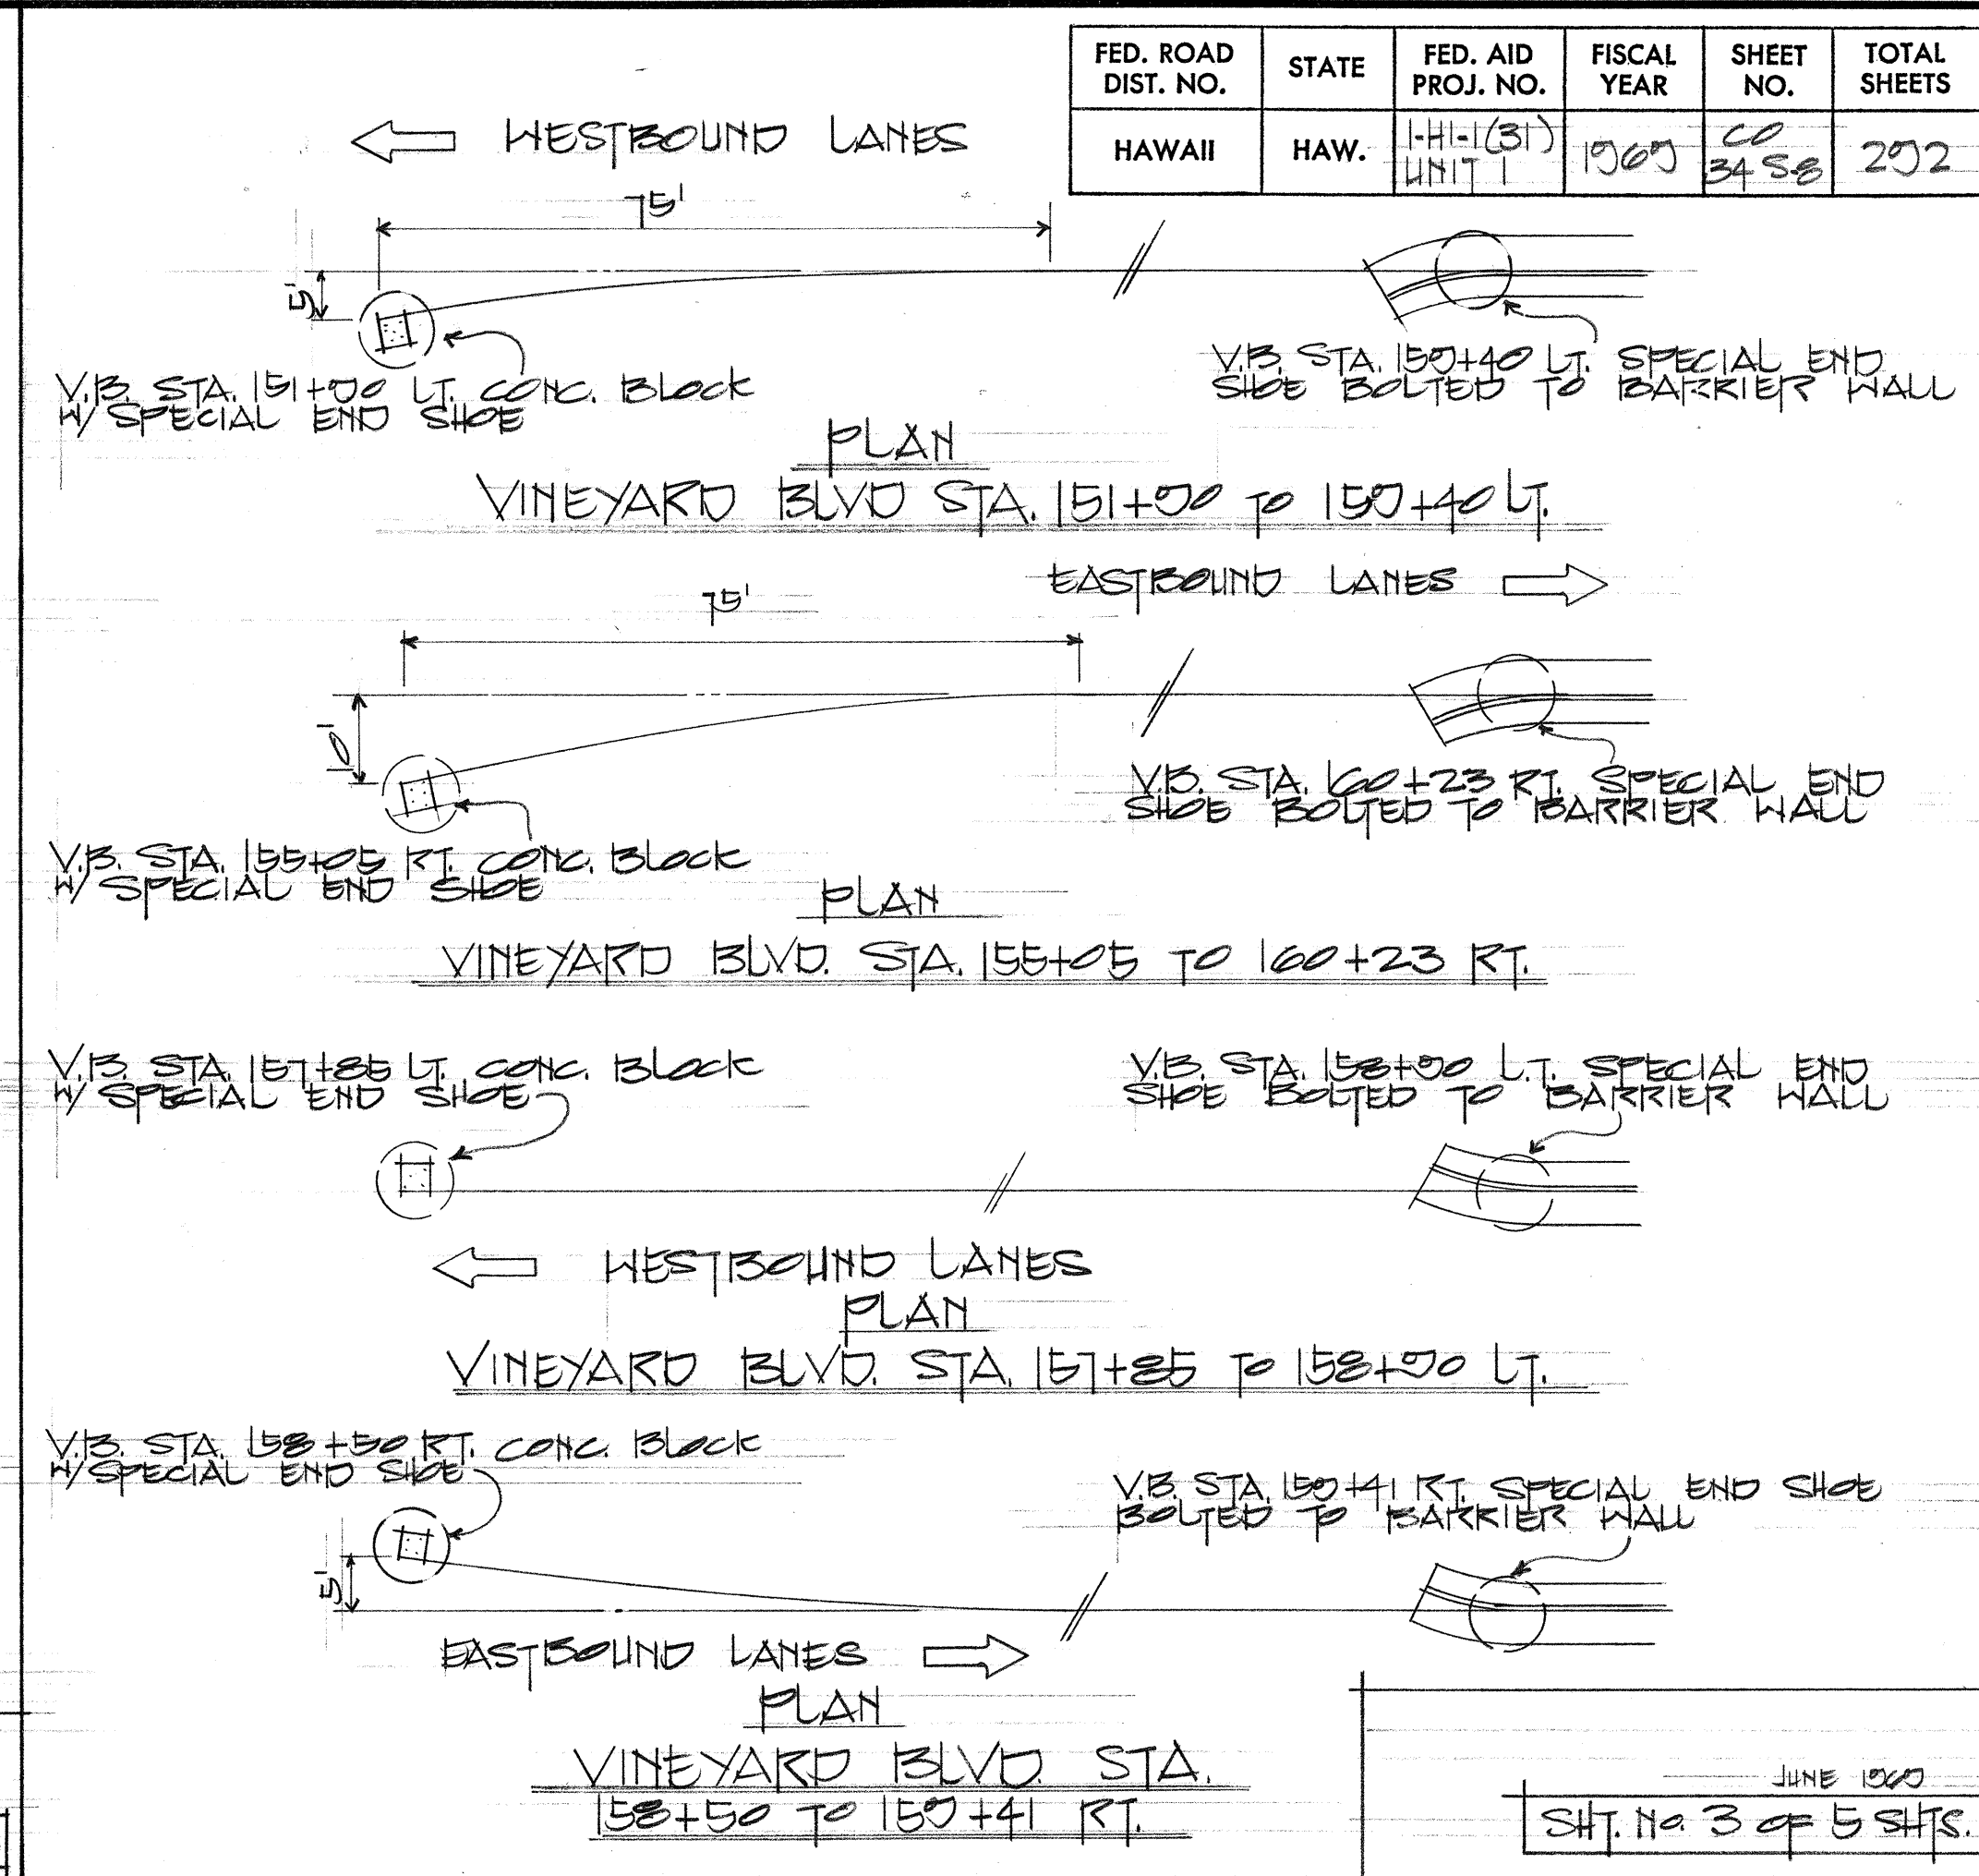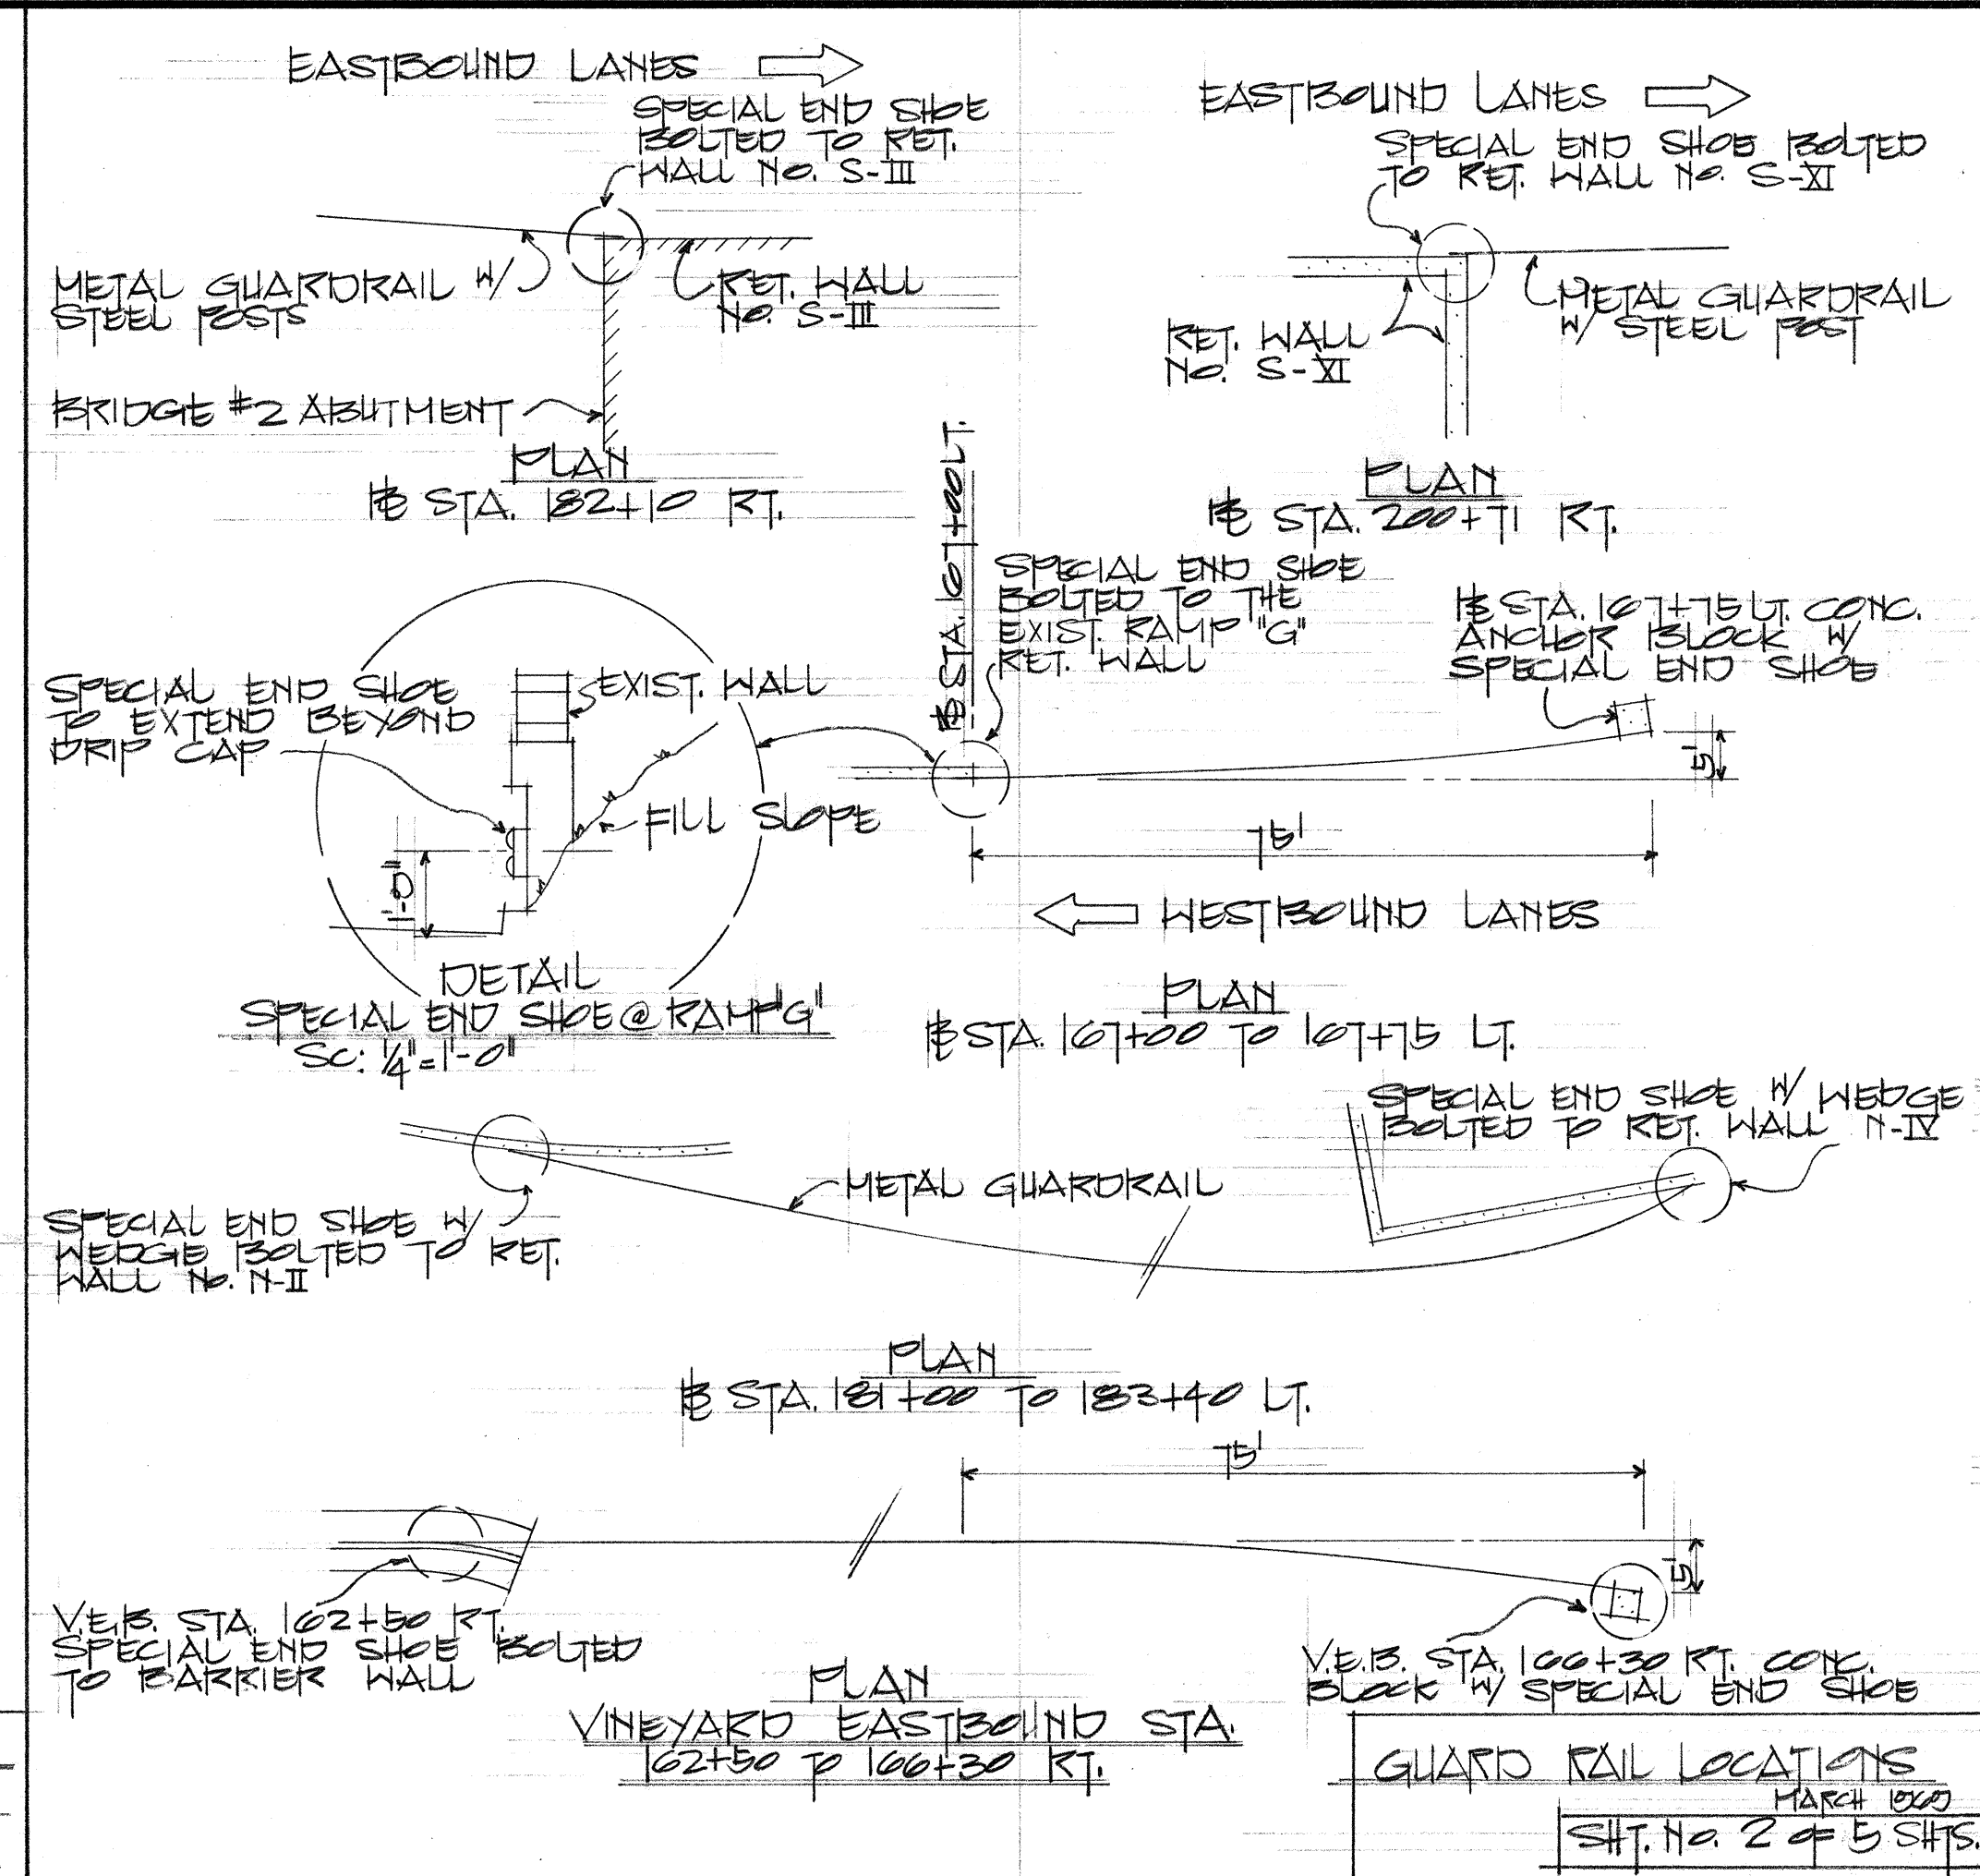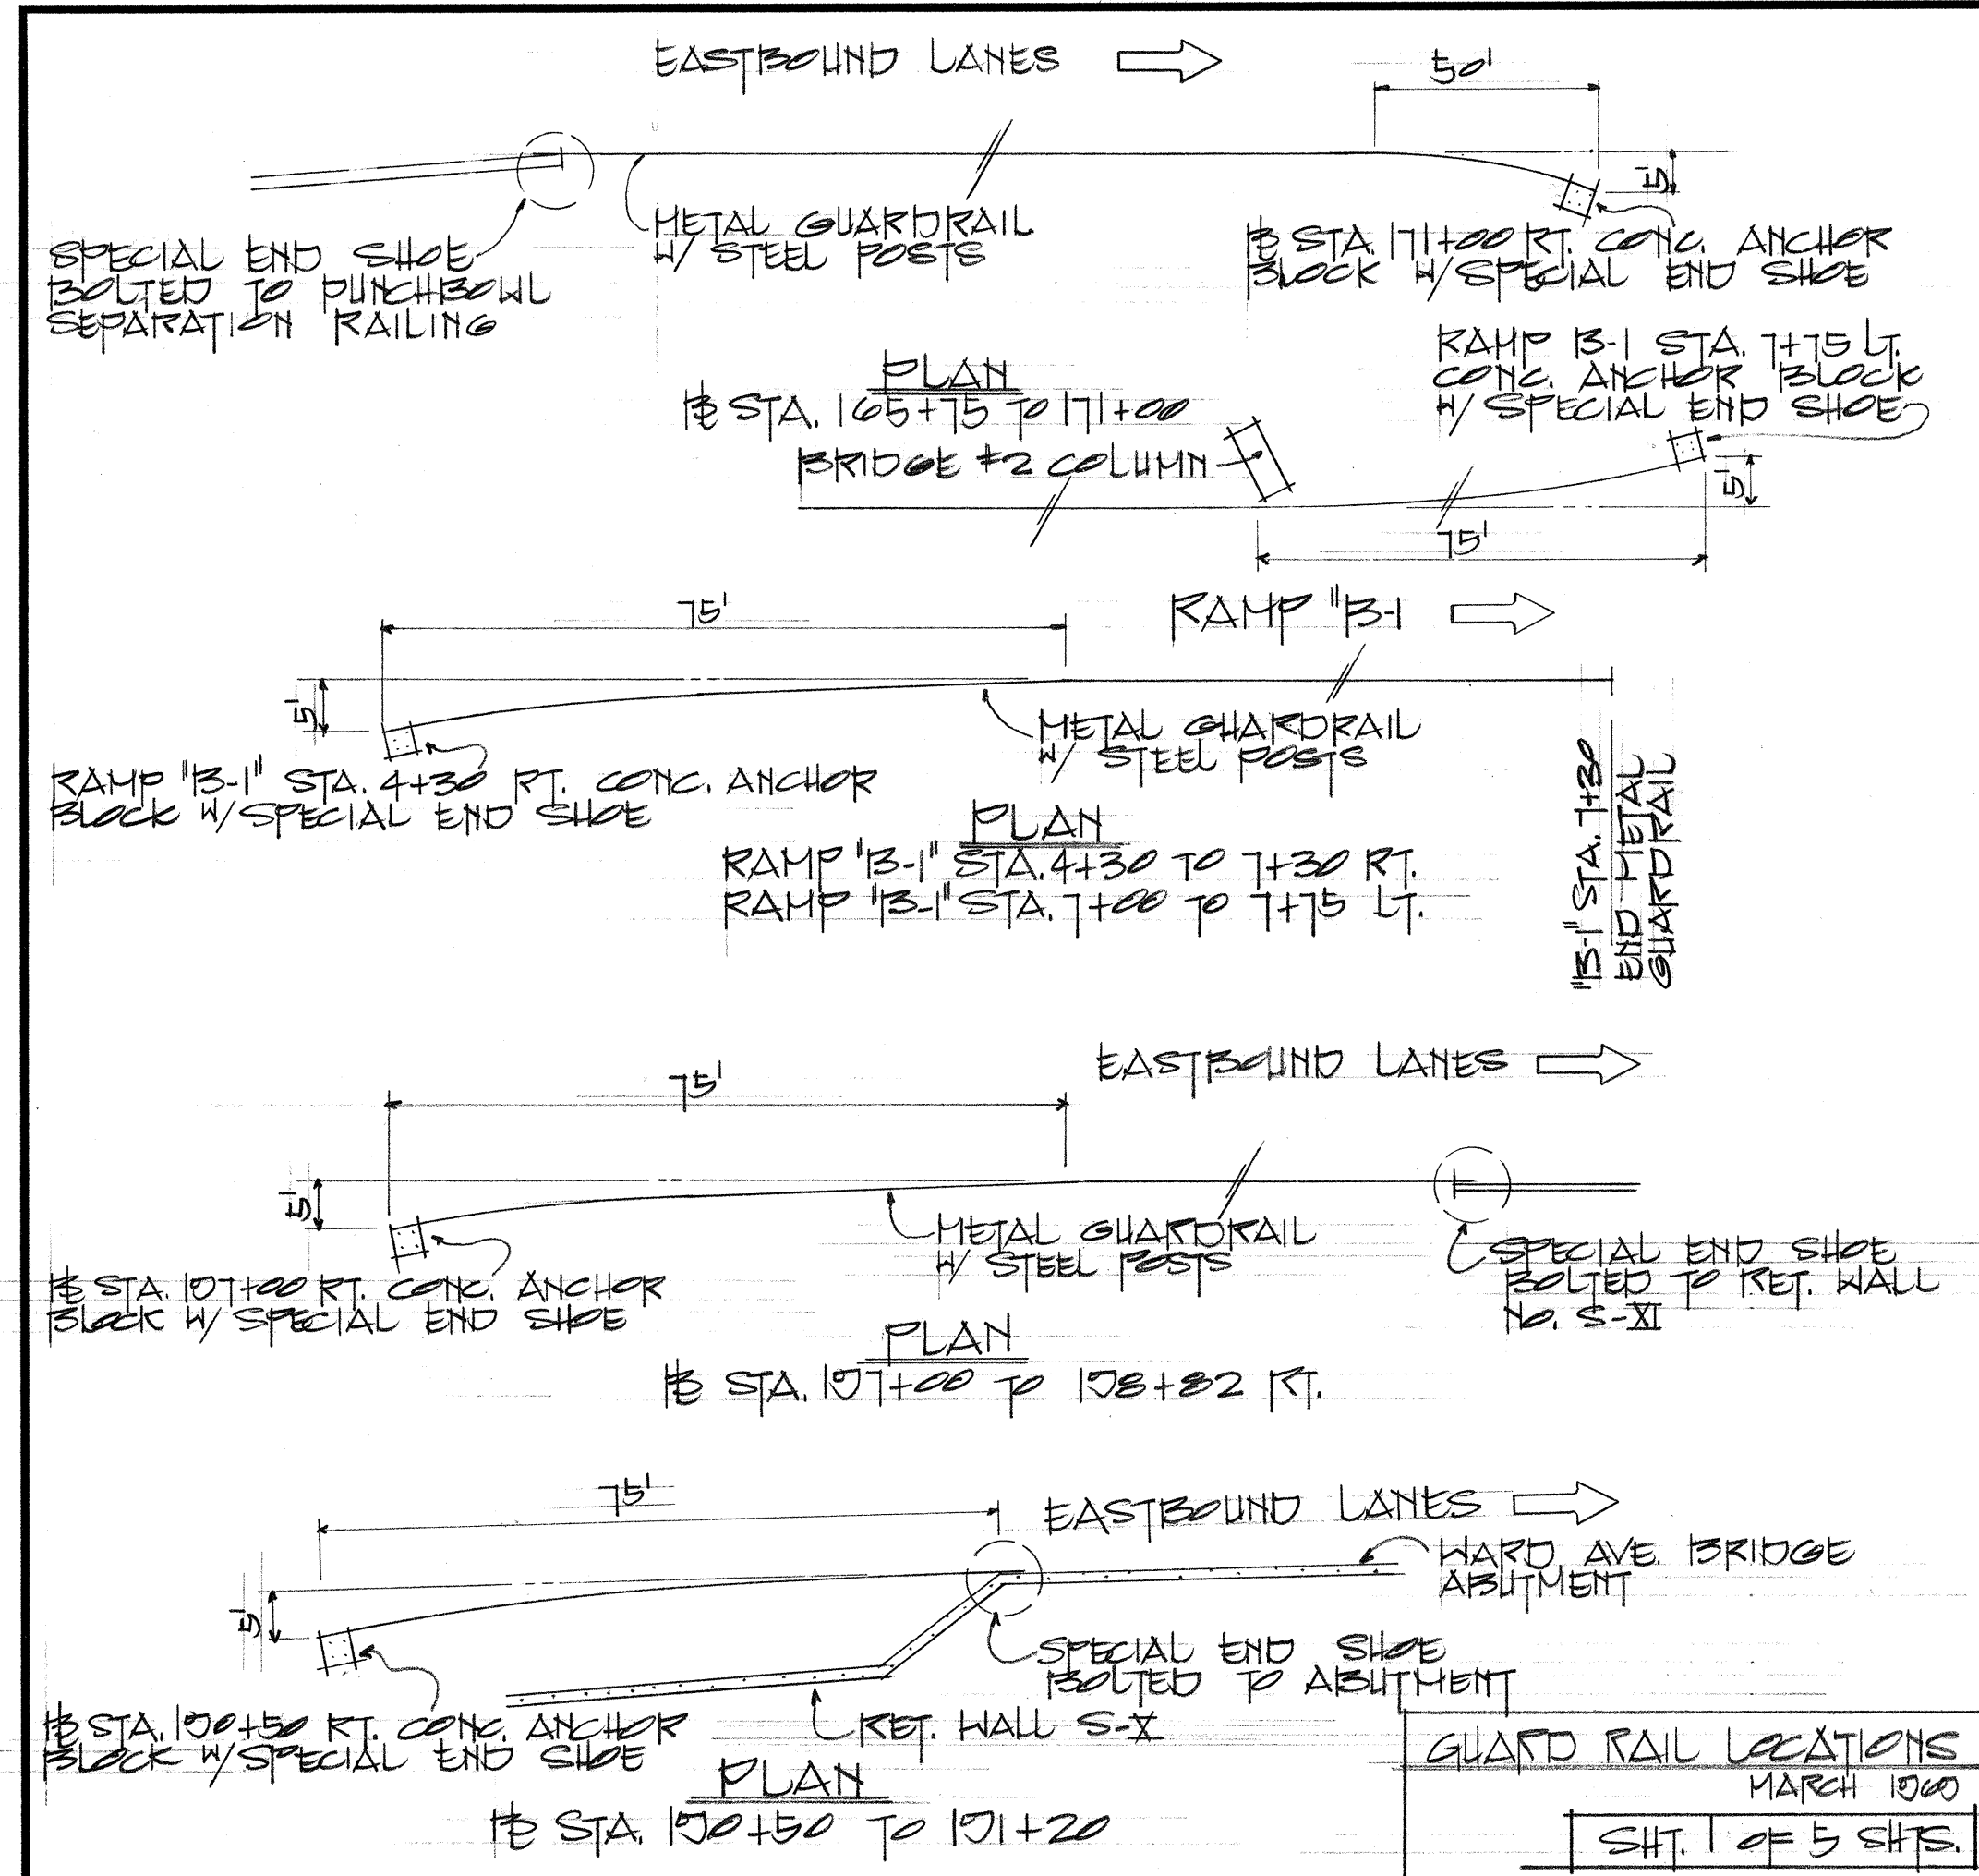

FED. ROAD DIST. NO.	STATE	FED. AID PROJ. NO.	FISCAL YEAR	SHEET NO.	TOTAL SHEETS
HAWAII	HAW.	1-HI-1(31) UNIT 1	1960	34	38

NOTE:
THIS SHEET IS A SUPPLEMENT SHEET ADDED DURING 'AS-BUILT' POSTING

**STATE OF HAWAII
DEPARTMENT OF TRANSPORTATION
HIGHWAYS DIVISION**


GUARD RAIL DETAILS

INTERSTATE ROUTE HI (LUALABA FREEWAY)
PAIP NO. 1-HI-1(31) UNIT 1

SCALE: AS SHOWN


SHEET NO. 34 OF 38

SURVEY PLOTTED BY: _____
DATE: _____
DESIGNED BY: _____
CHECKED BY: _____
NOTE BOOK: _____
No. _____

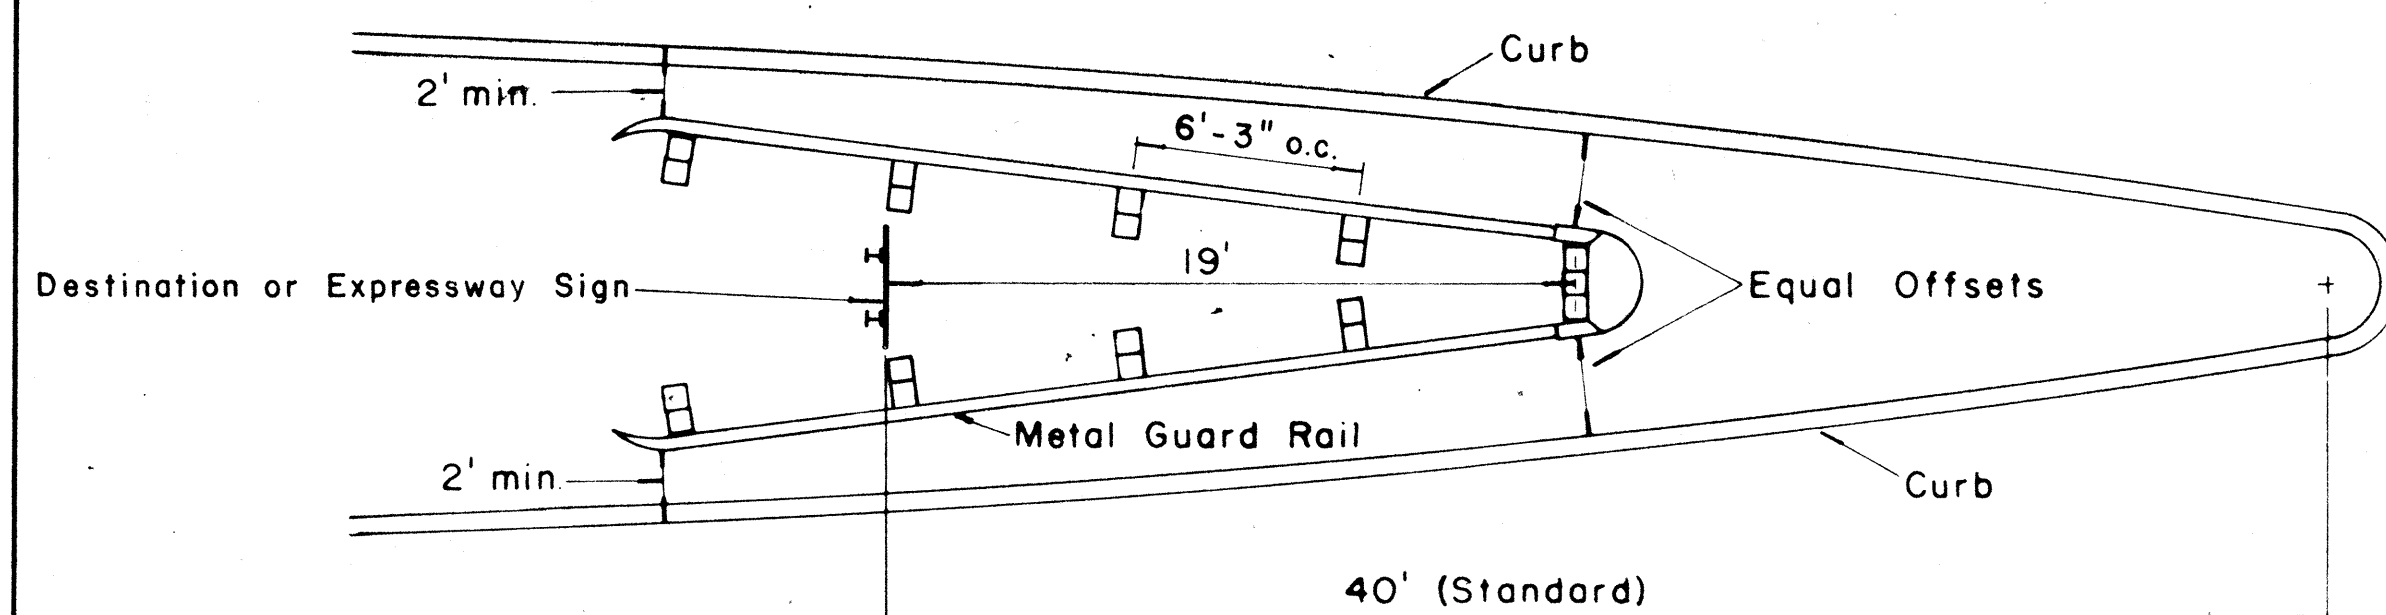

GORE MOUNTED SIGN


Scale: $\frac{3}{16}" = 1' - 0"$

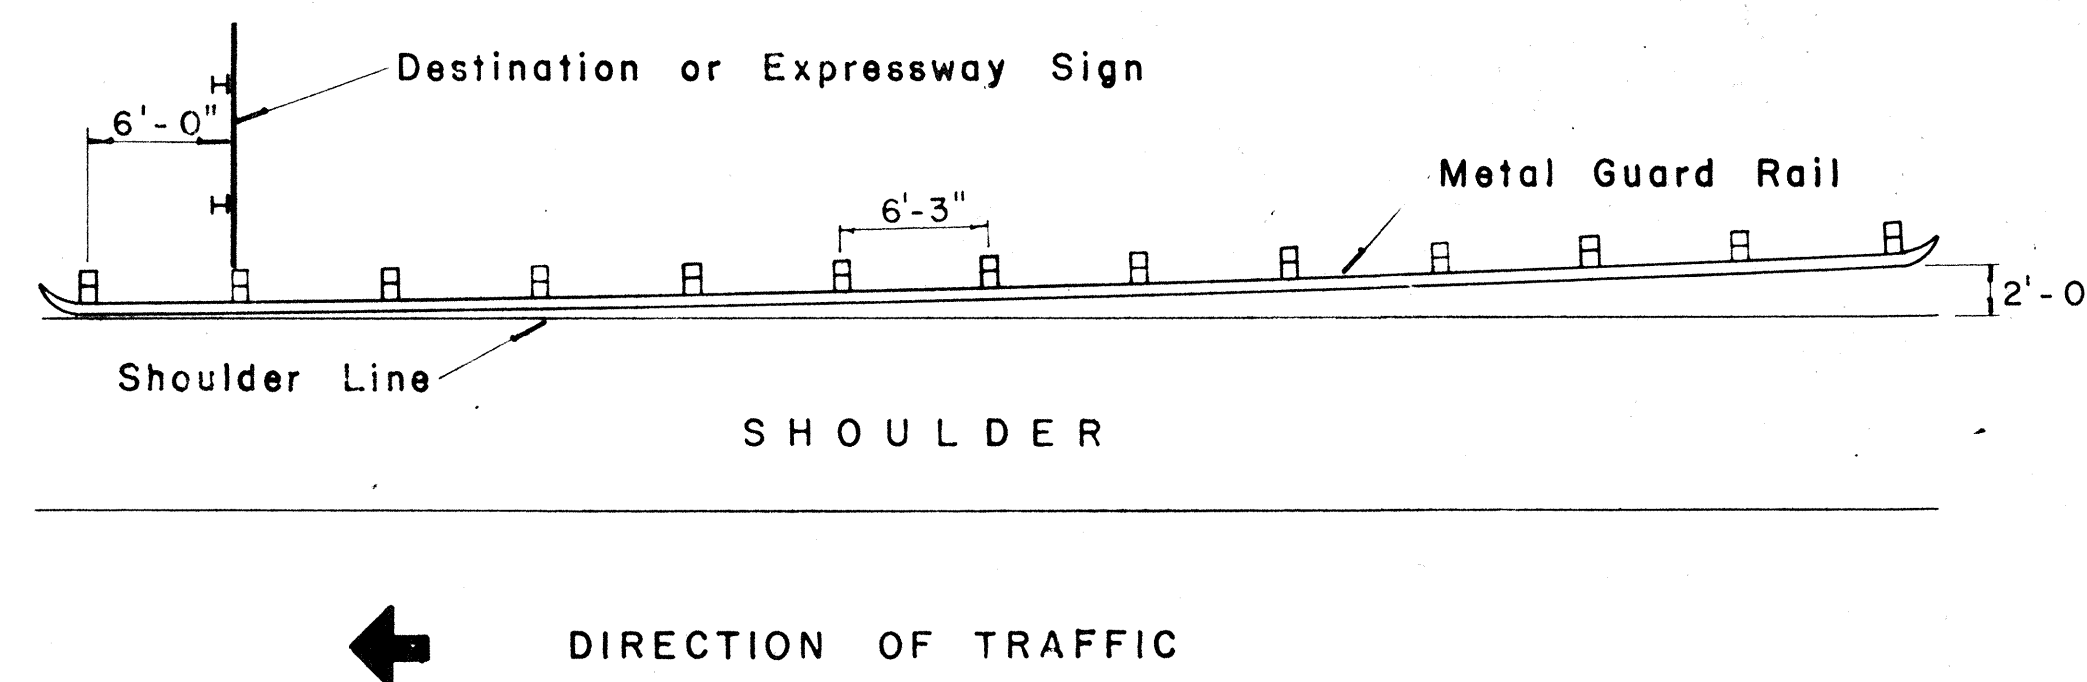


SHOULDER MOUNTED SIGN

Scale: $\frac{1}{8}" = 1' - 0"$


INSTALLATION OF METAL GUARD RAIL FOR DESTINATION AND EXPRESSWAY SIGNS

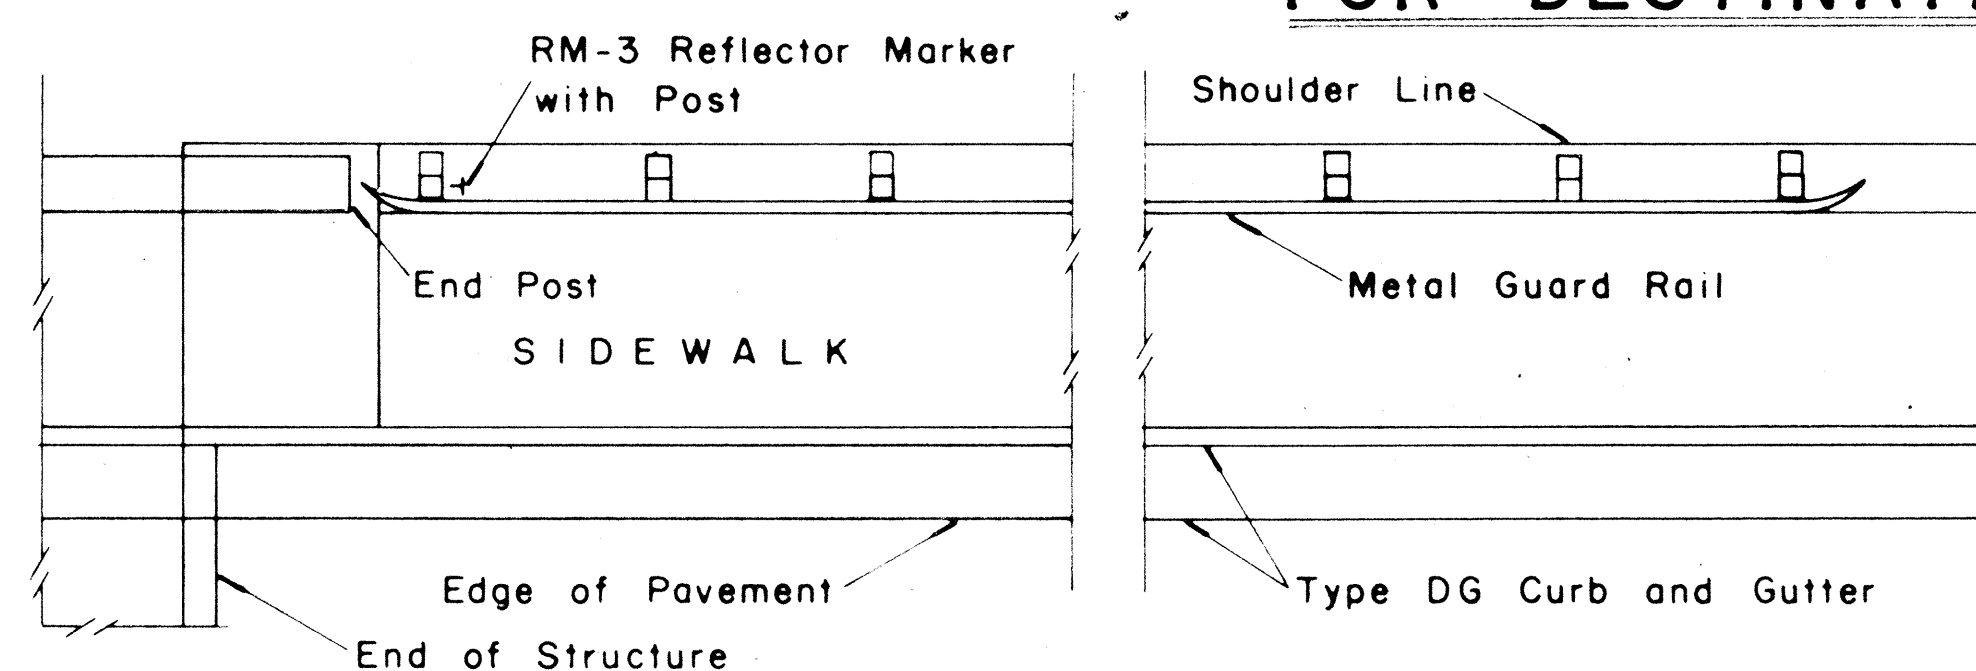

SIDEWALK CARRIED THROUGH STRUCTURE

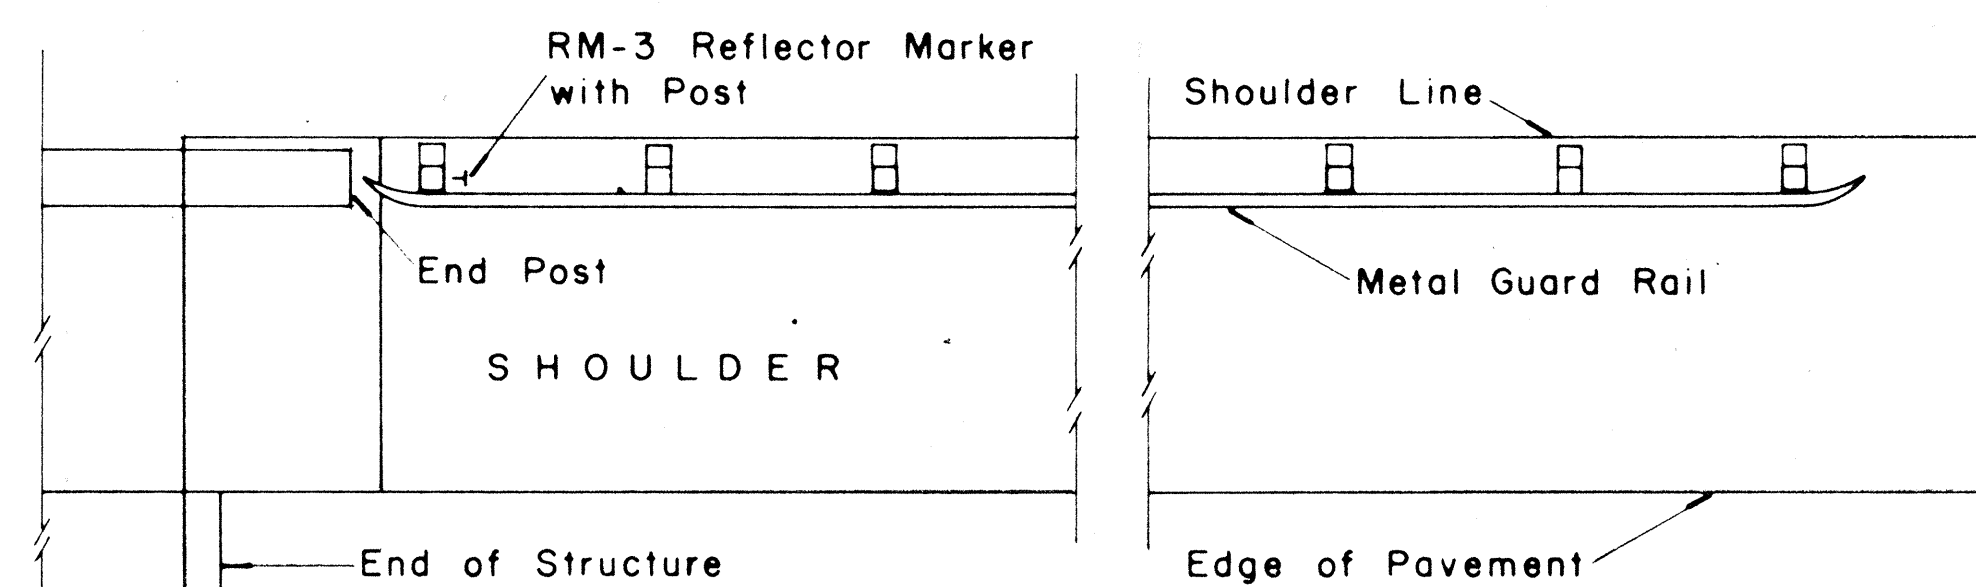


SHOULDER CARRIED THROUGH STRUCTURE

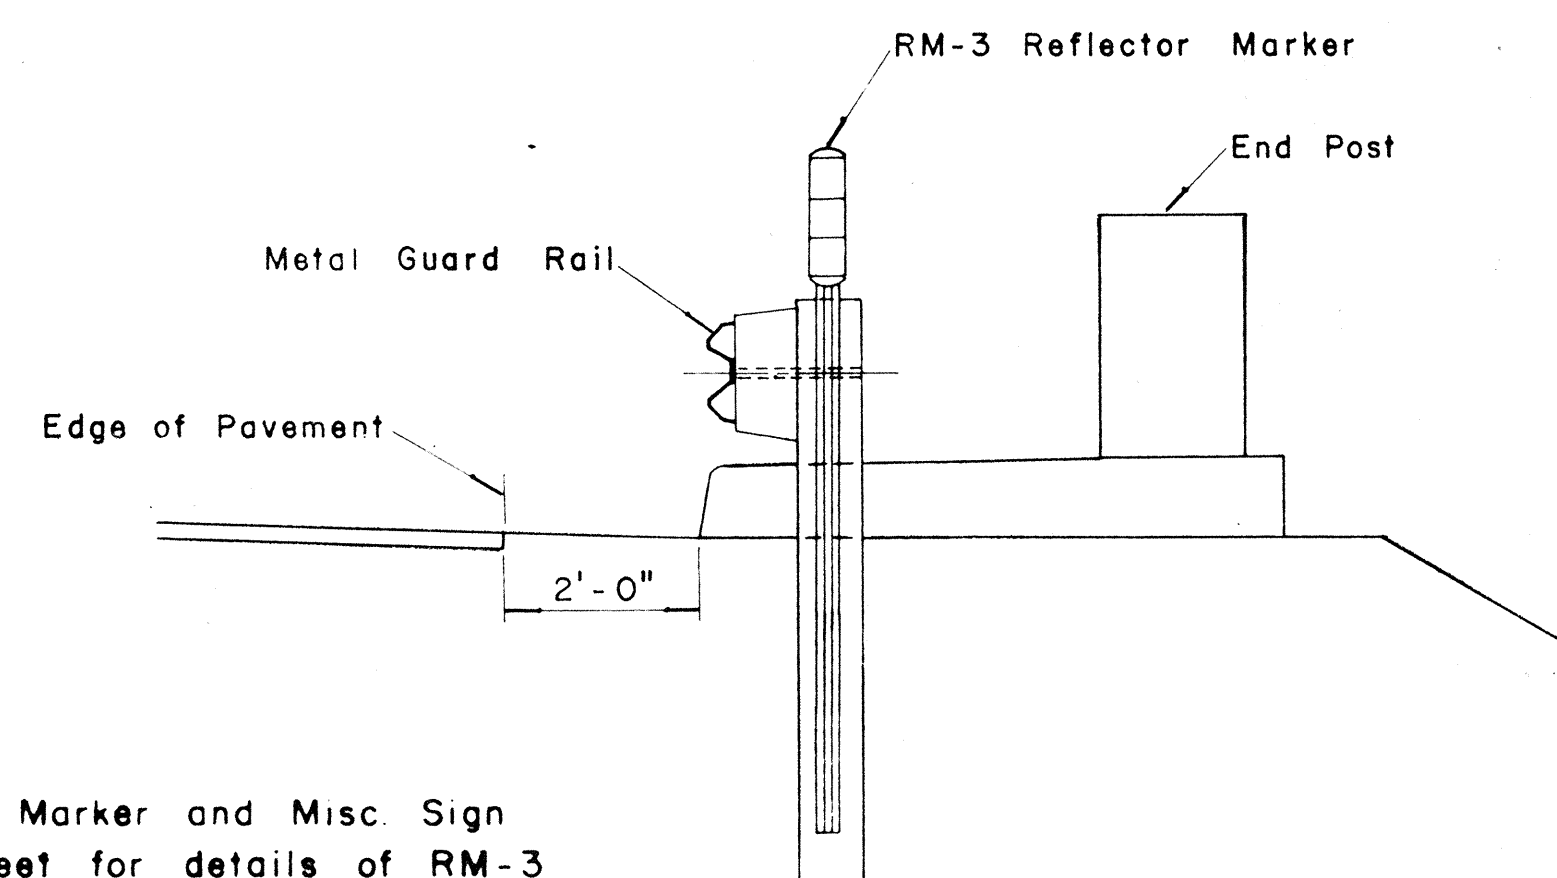

SECTION "A-A"

Scale: $\frac{1}{2}" = 1' - 0"$

NOTE
See F A Marker and Misc. Sign
Detail sheet for details of RM-3
Reflector Marker with Post.

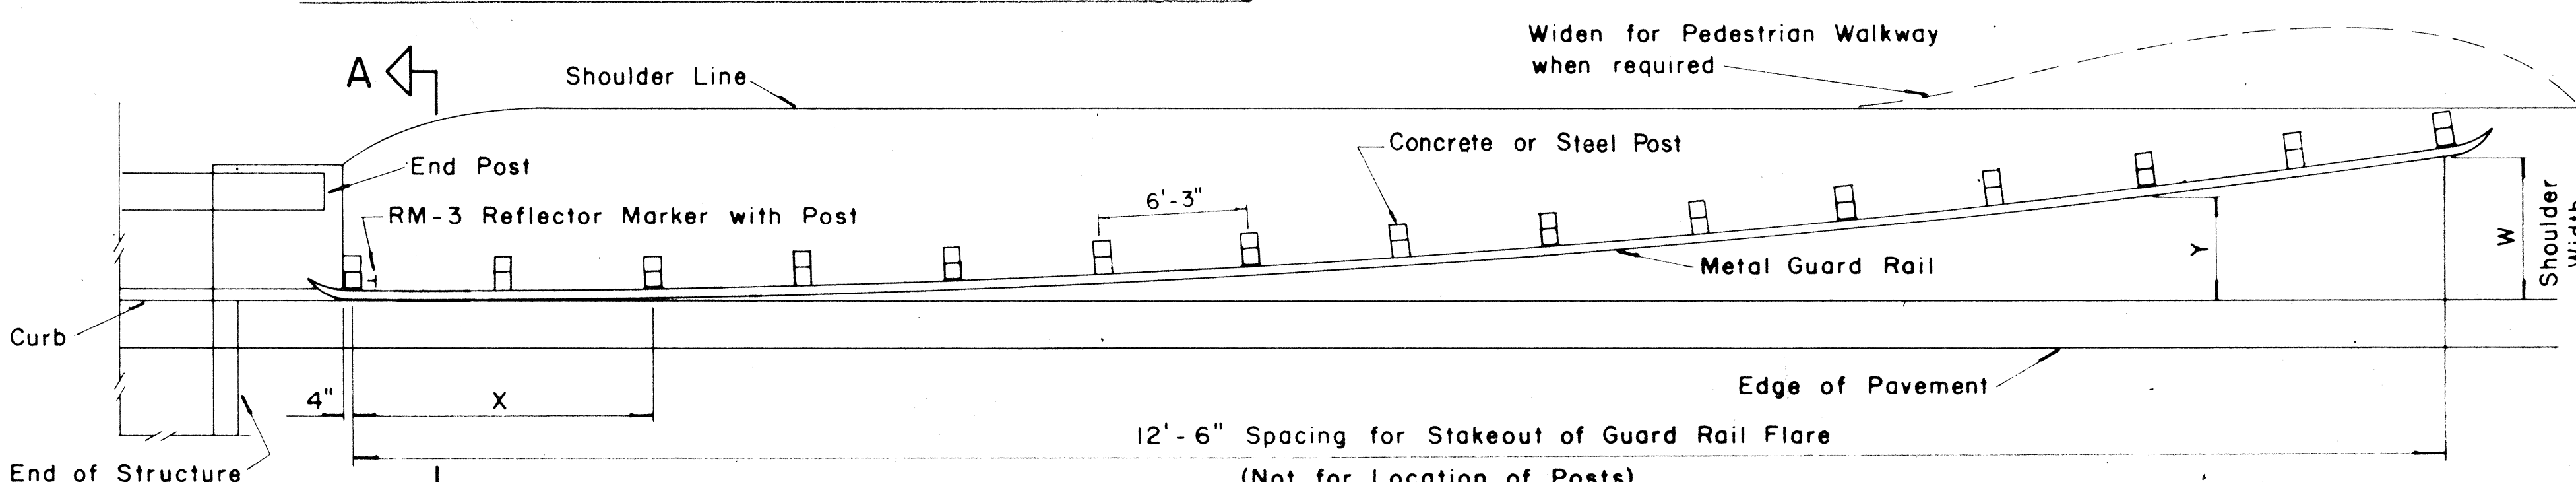

SHOULDER NOT CARRIED THROUGH STRUCTURE
INSTALLATION OF METAL GUARD RAIL FLARE AT STRUCTURES

Scale: $\frac{3}{16}" = 1' - 0"$


X	Y					
	W=3'	W=4'	W=5'	W=6'	W=7'	W=8'
12.5	0.19	0.16	0.14	0.12	0.09	0.08
25.0	0.75	0.64	0.55	0.49	0.35	0.32
37.5	1.69	1.44	1.25	1.10	0.78	0.72
50.0	3.00	2.56	2.22	1.96	1.38	1.28
62.5		4.00	3.47	3.06	2.16	2.00
75.0			5.00	4.41	3.11	2.85
87.5				6.00	4.23	3.92
100.0					5.53	5.12
112.5					7.00	6.48
125.0						8.00

W = GUARD RAIL FLARE

X = DISTANCE FROM POST AT
BRIDGE TO OFFSET POINTS

Y = GUARD RAIL FLARE OFFSET

GUARD RAIL OFFSET

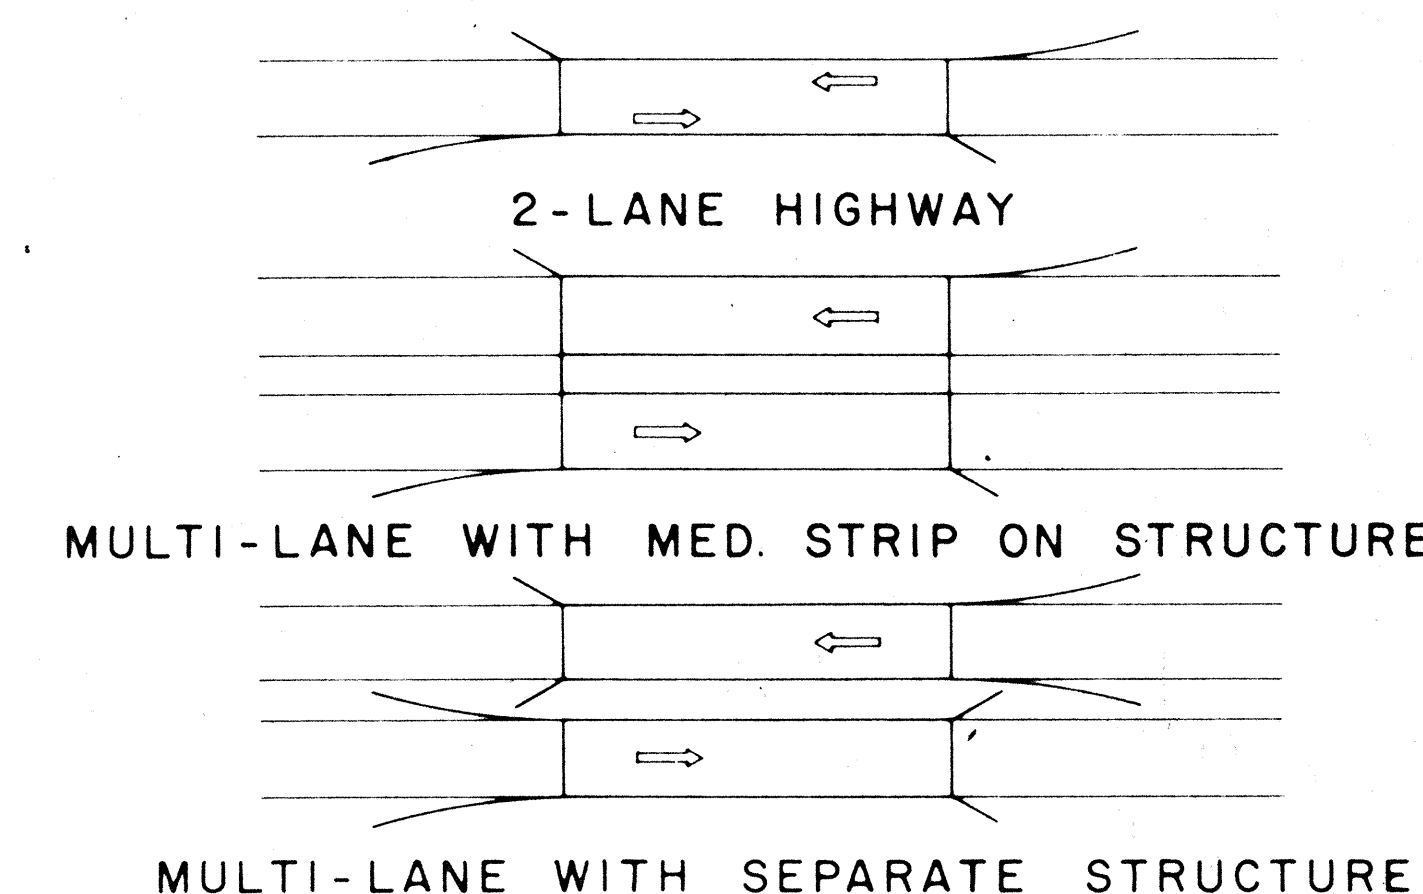

TYPICAL GUARD RAIL FLARES AT STRUCTURE APPROACHES

STATE OF HAWAII
DEPARTMENT OF TRANSPORTATION
HIGHWAYS DIVISION
STANDARD DETAILS
METAL GUARD RAILS
AT
STRUCTURES & GUIDE SIGNS


Scale: As Noted

SHEET No. 5 OF 10 SHEETS

DATE
DRAWN BY
CHECKED BY
DESIGNED BY
NOTED BY
ORIGINAL

BOLT DIMENSIONS		
TYPE A BOLT		
Splice Bolt	D 5/16"	L 11 1/4"
Post Bolt for Conc. Post w/ Double Wood Blocks	3/32"	25"
Post Bolt for Conc. Post w/ Single Wood Block	3/32"	18"
Rail Bolt for Metal Block	3/32"	2"

BOLT DIMENSIONS		
TYPE B BOLT		
Post Bolt for Conc. Post w/ Metal Blocks	L 9 1/2"	
Post Bolt for Metal Post w/ Metal Block	L 13 3/4"	

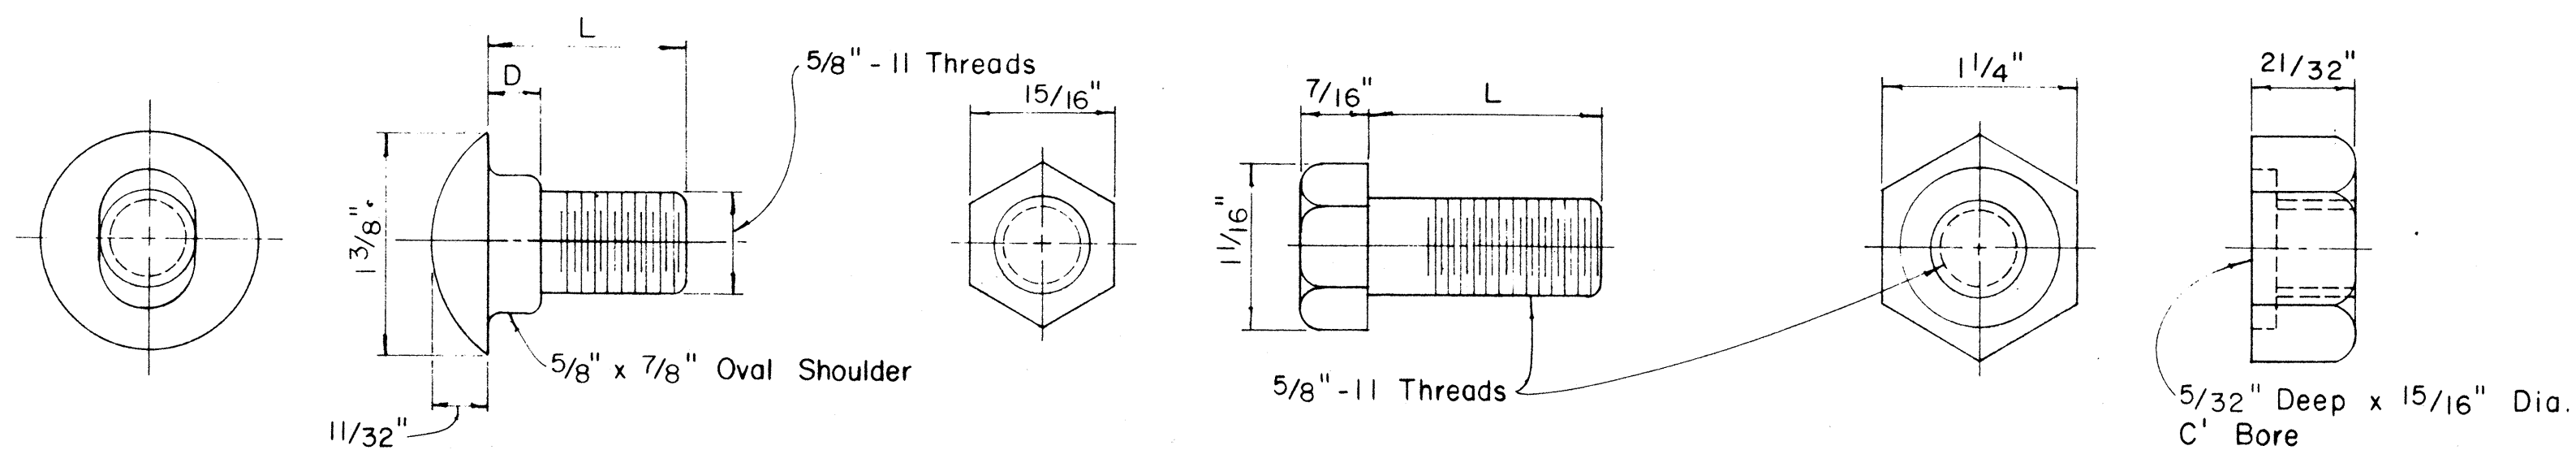

TYPE A BOLT


TYPE B BOLT

HEXAGON NUT

Scale: Full Size

SPLICE RAIL AND POST BOLTS

Scale: Full Size

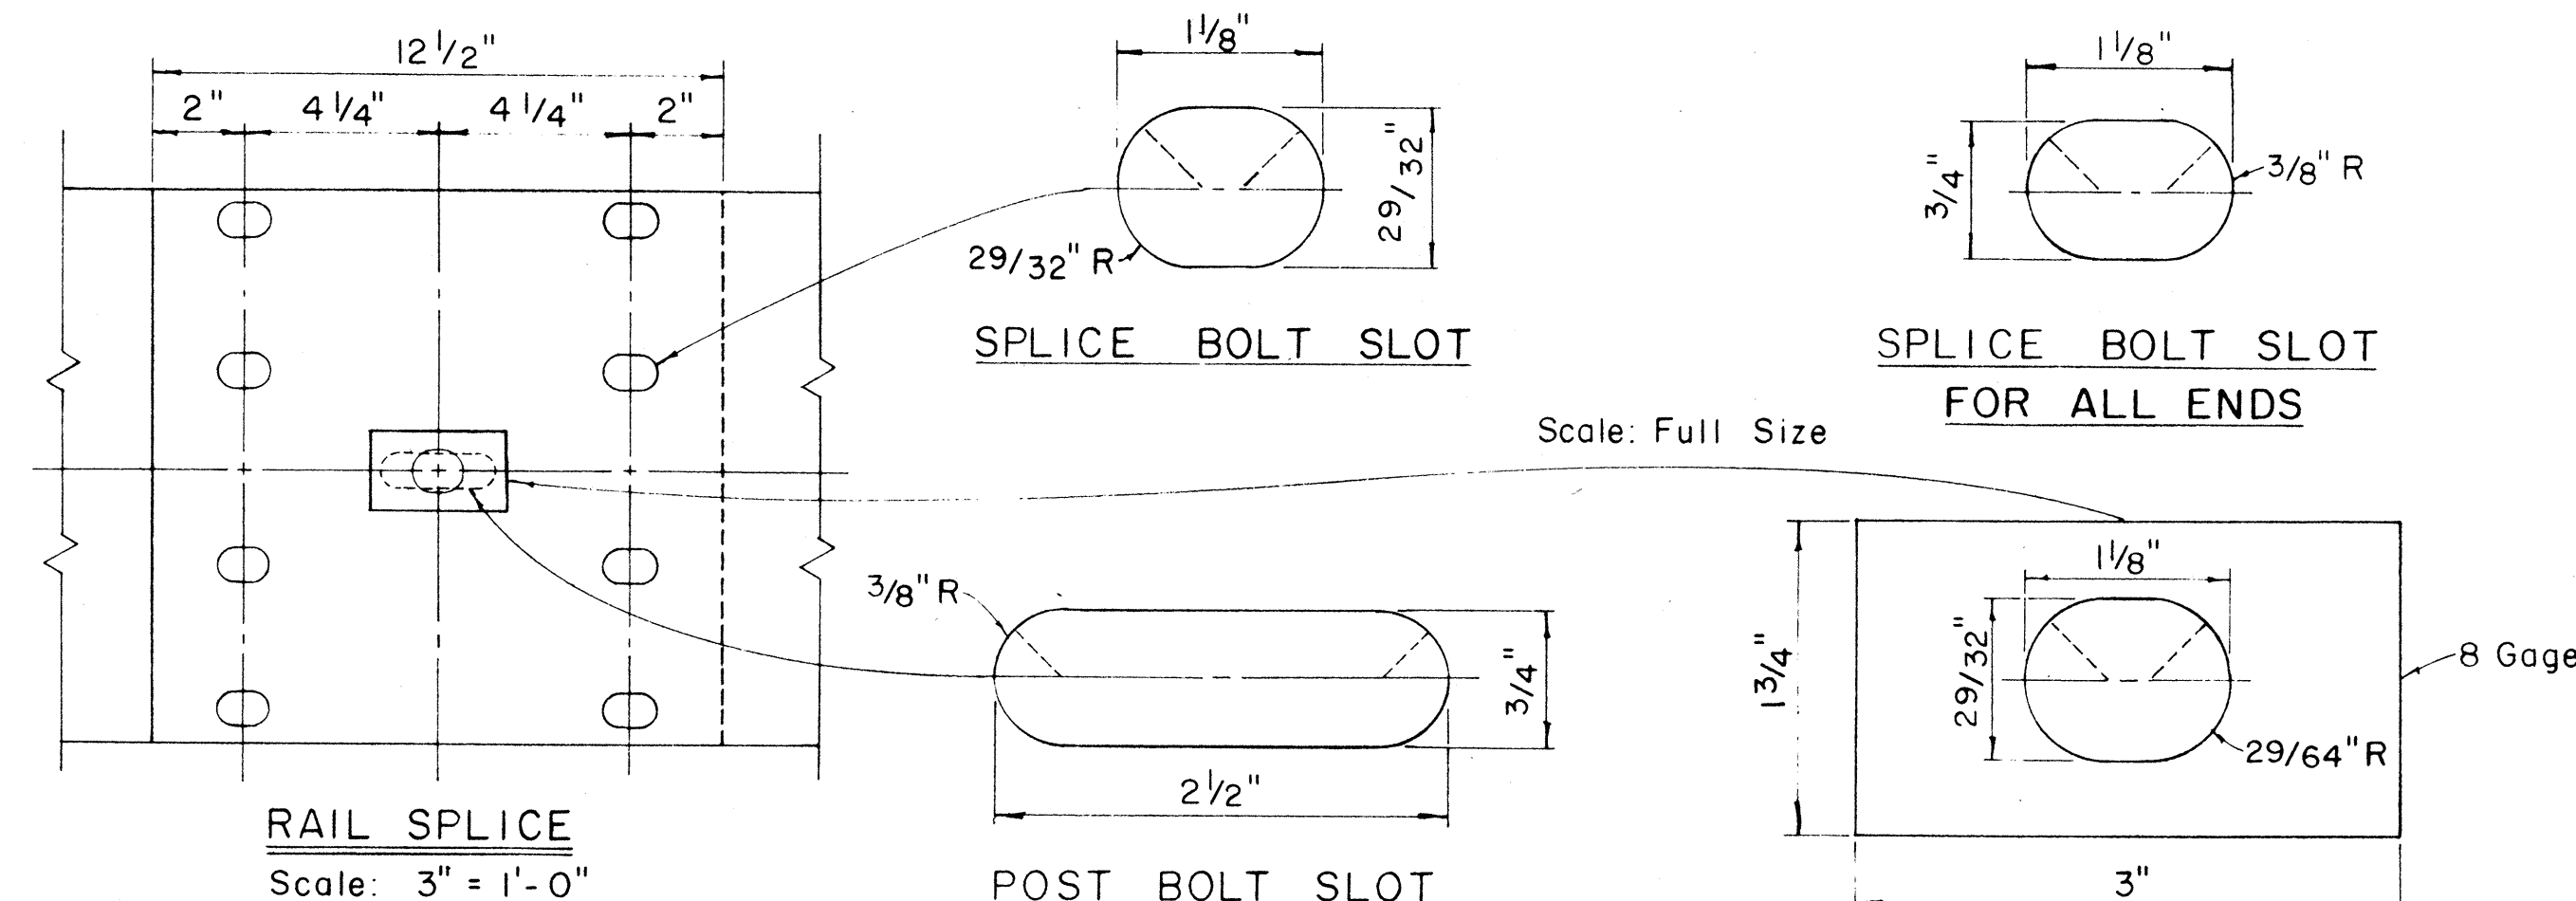


RAIL SPLICE

Scale: 3\"/>

POST BOLT SLOT

RAIL WASHER

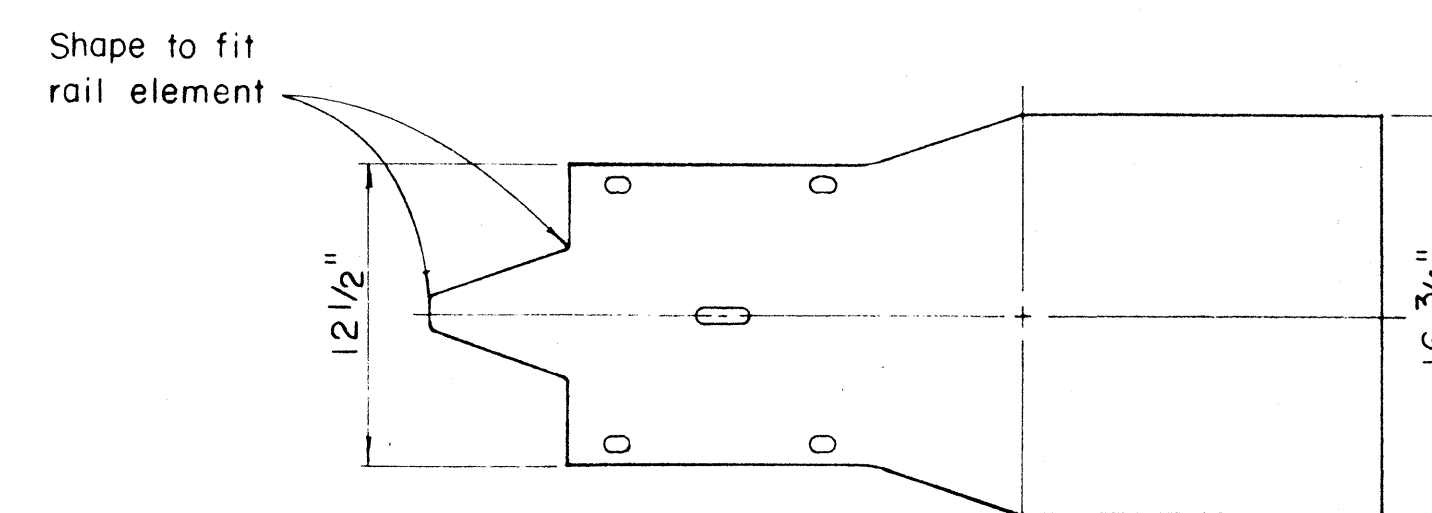

FLARED END


Scale: 1 1/2\"/>

MEDIAN END

Scale: 1 1/2\"/>


MEDIAN END DIMENSIONS

TYPE OF POST AND BLOCK	W	R
Double Metal Guard Rail on Concrete Post with Wood Blocks	29 3/4"	14 7/8"
Double Metal Guard Rail on Concrete Post with Metal Blocks (BJ6)	26 1/2"	13 1/4"
Double Metal Guard Rail on Metal Post with Metal Blocks (BJ6)	24 3/8"	12 3/16"

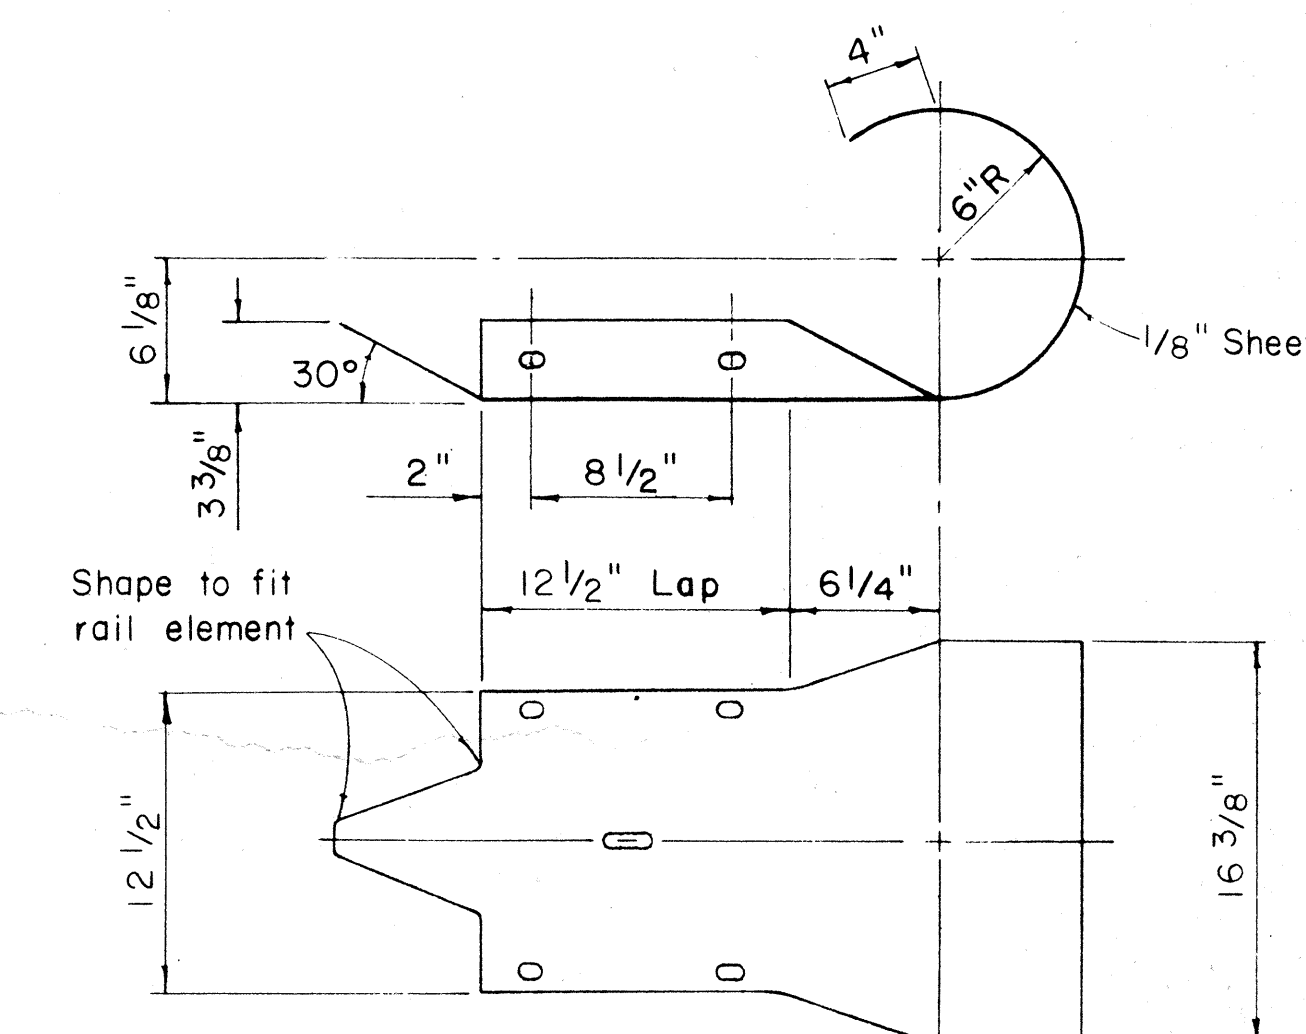


CURVED END

Scale: 1 1/2\"/>

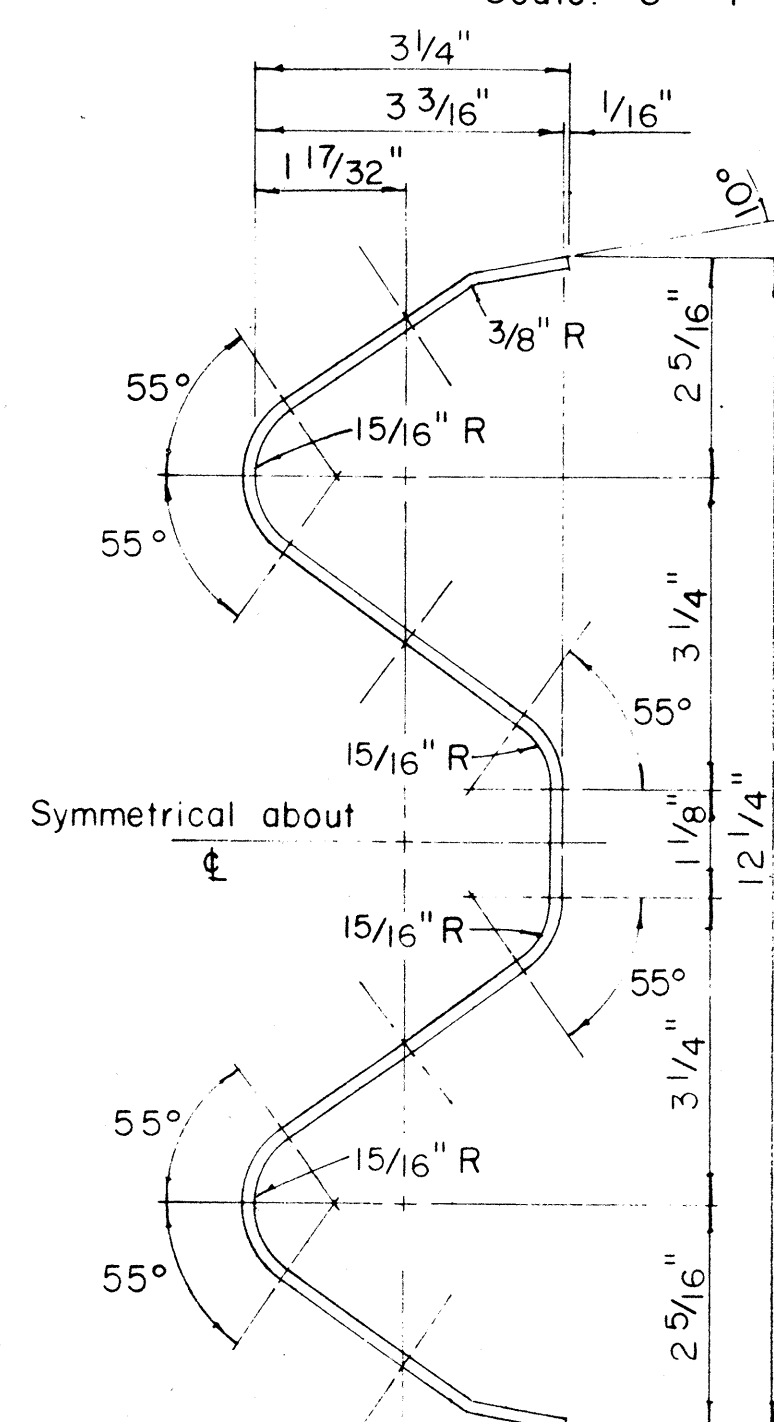

RAIL ELEMENT SECTION

Scale: 6\"/>

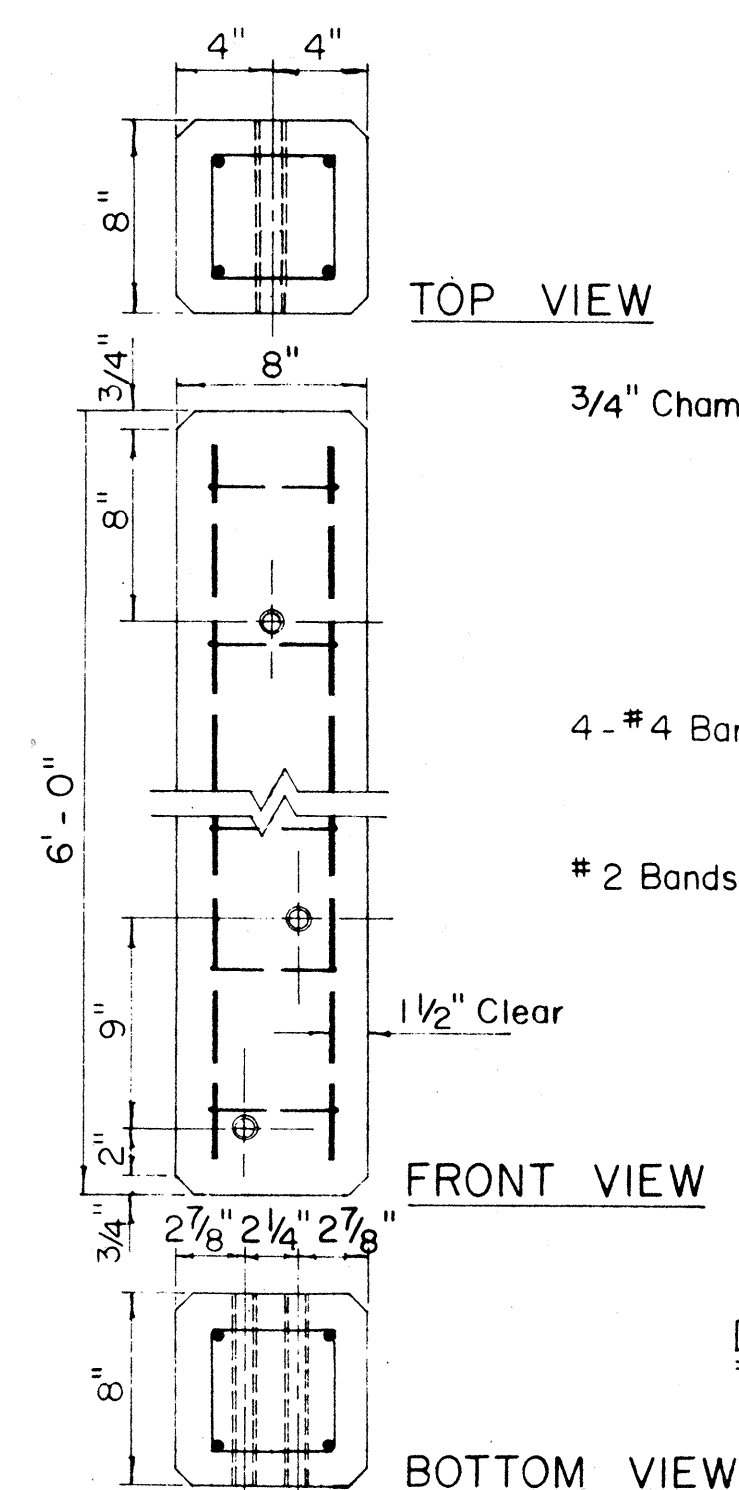


TOP VIEW

FRONT VIEW

BOTTOM VIEW


NOTE:
Concrete post shall be precast

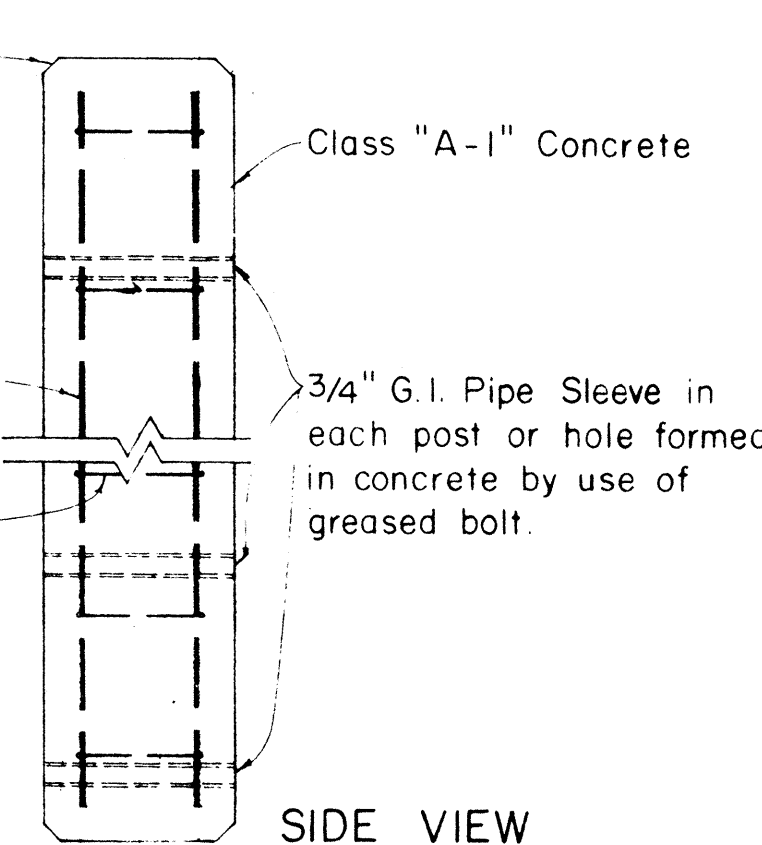

SIDE VIEW

DETAIL OF CONCRETE POST


Scale: 1 1/2\"/>

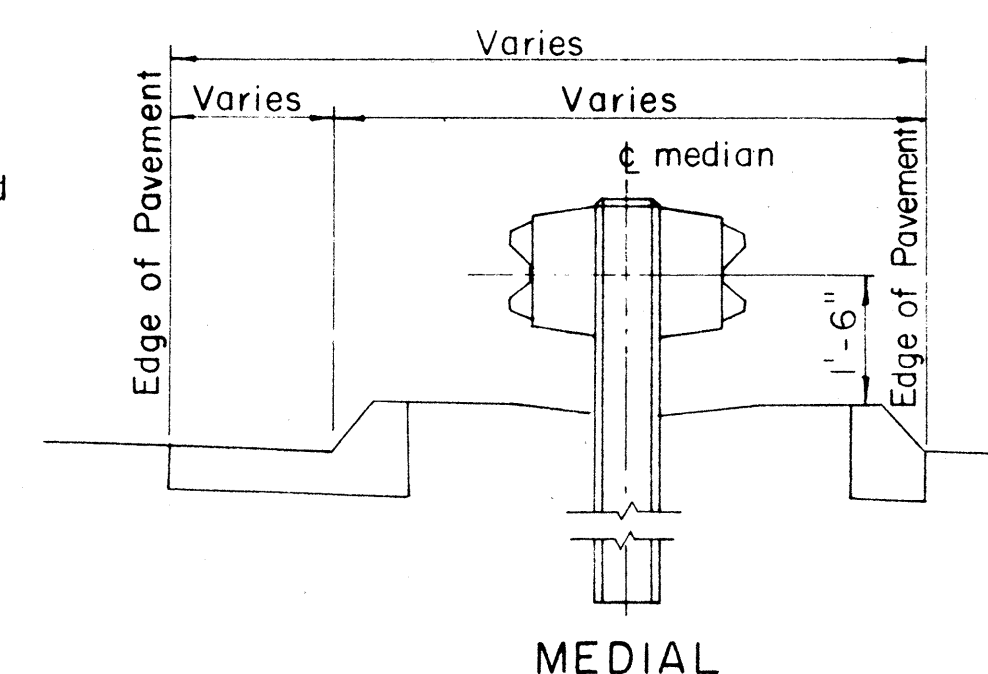

MEDIAN

TYPICAL GUARD RAIL DETAIL

Scale: 1/2\"/>

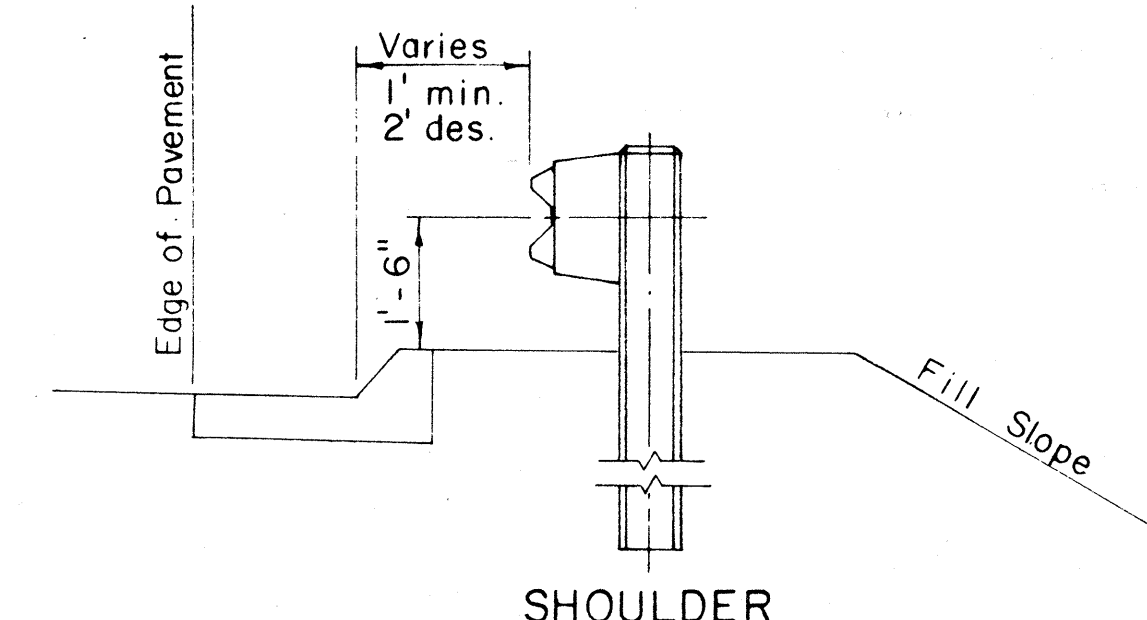

SHOULDER


STATE OF HAWAII
DEPARTMENT OF TRANSPORTATION
HIGHWAYS DIVISION

STANDARD DETAILS

METAL GUARD RAIL


Scale: as noted

SHEET No. 6 OF 10 SHEETS

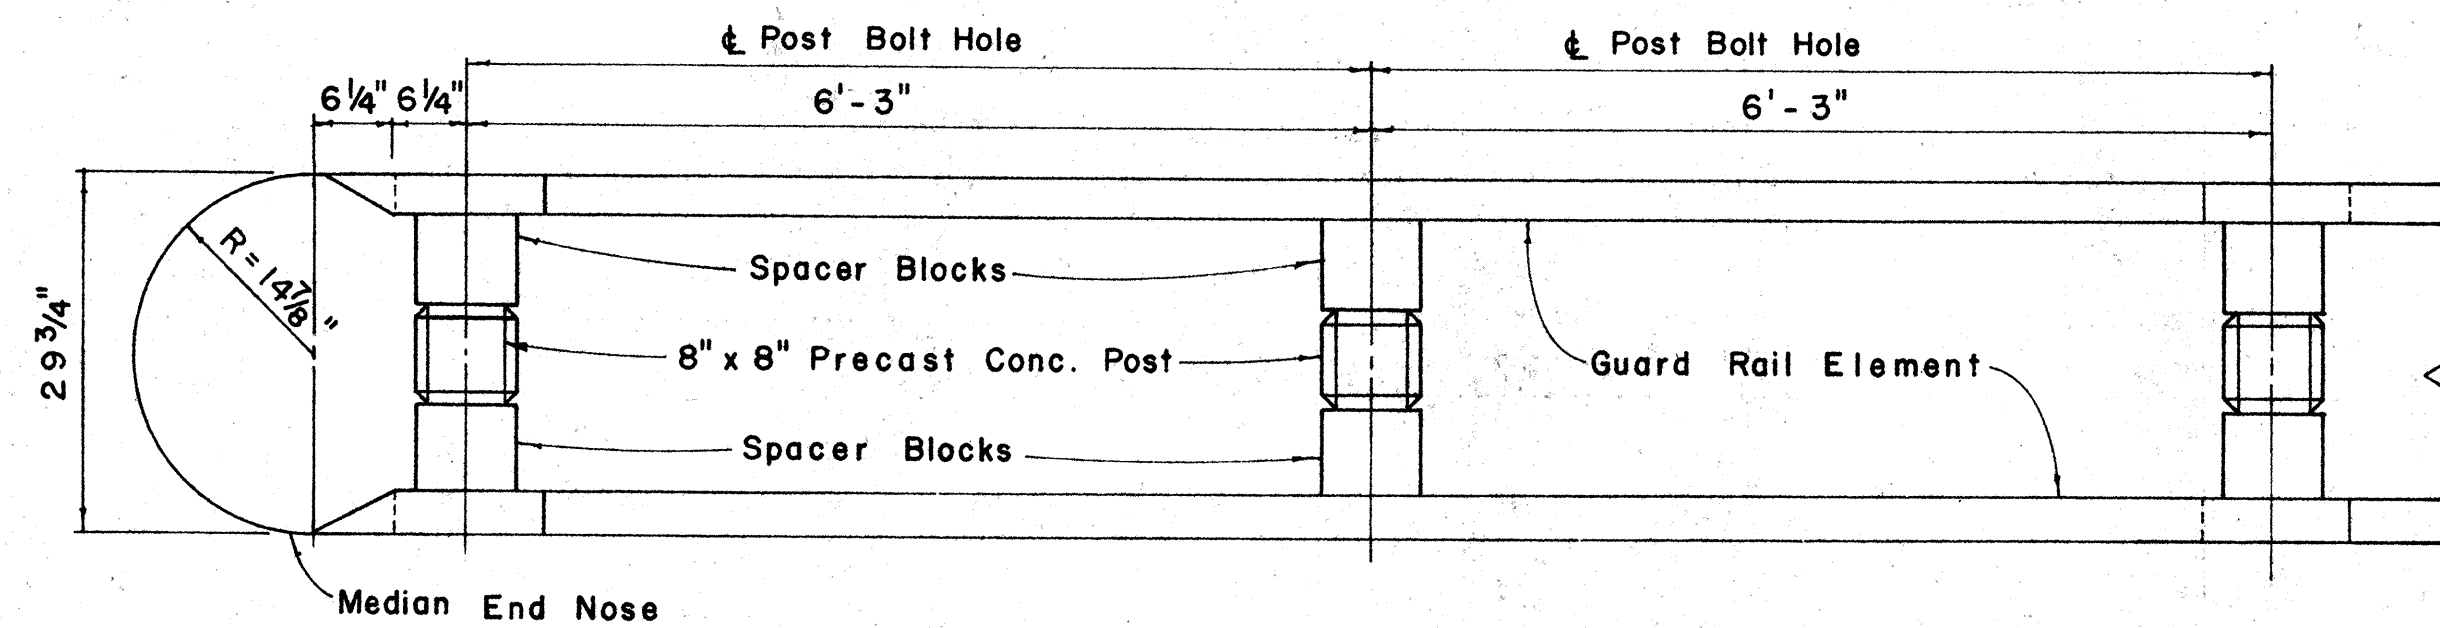

PLAN


Scale: $\frac{3}{4}$ " = 1' - 0"

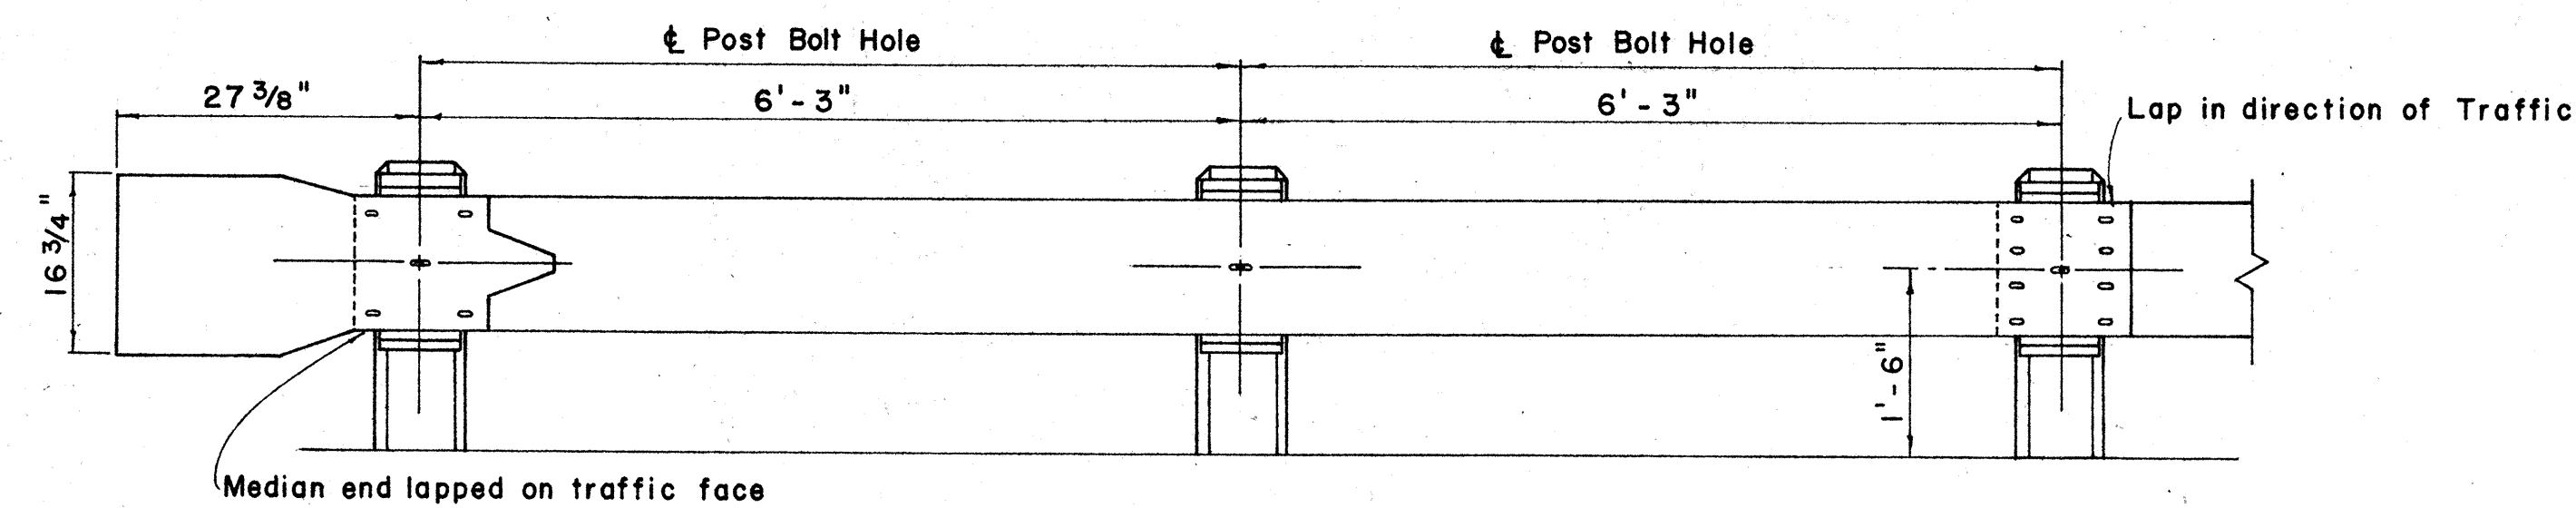

ELEVATION


METAL GUARD RAIL ON CONCRETE POSTS AND WOOD SPACER BLOCKS

Scale: $\frac{3}{4}$ " = 1' - 0"

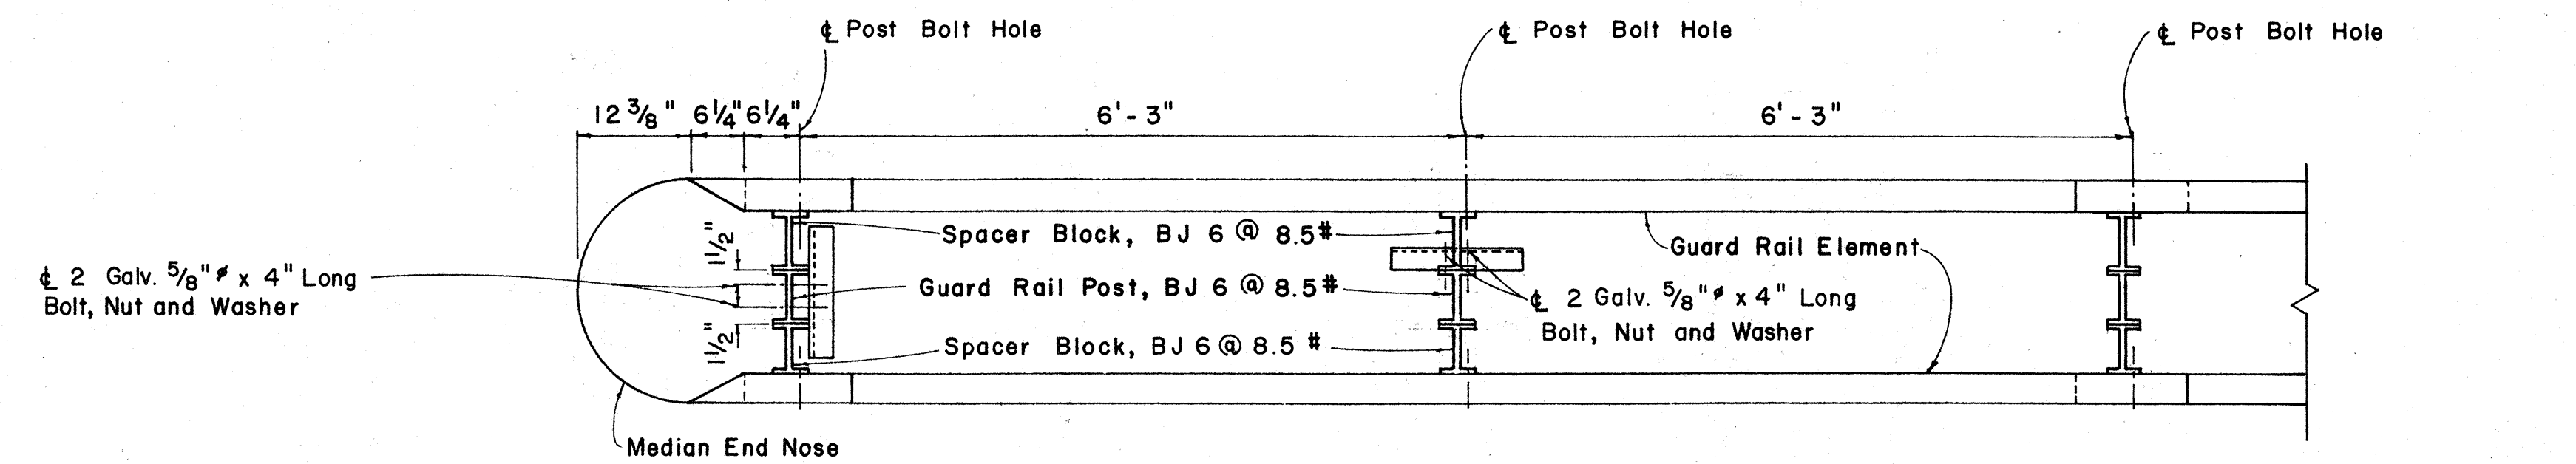

PLAN

Scale: $\frac{3}{4}$ " = 1' - 0"

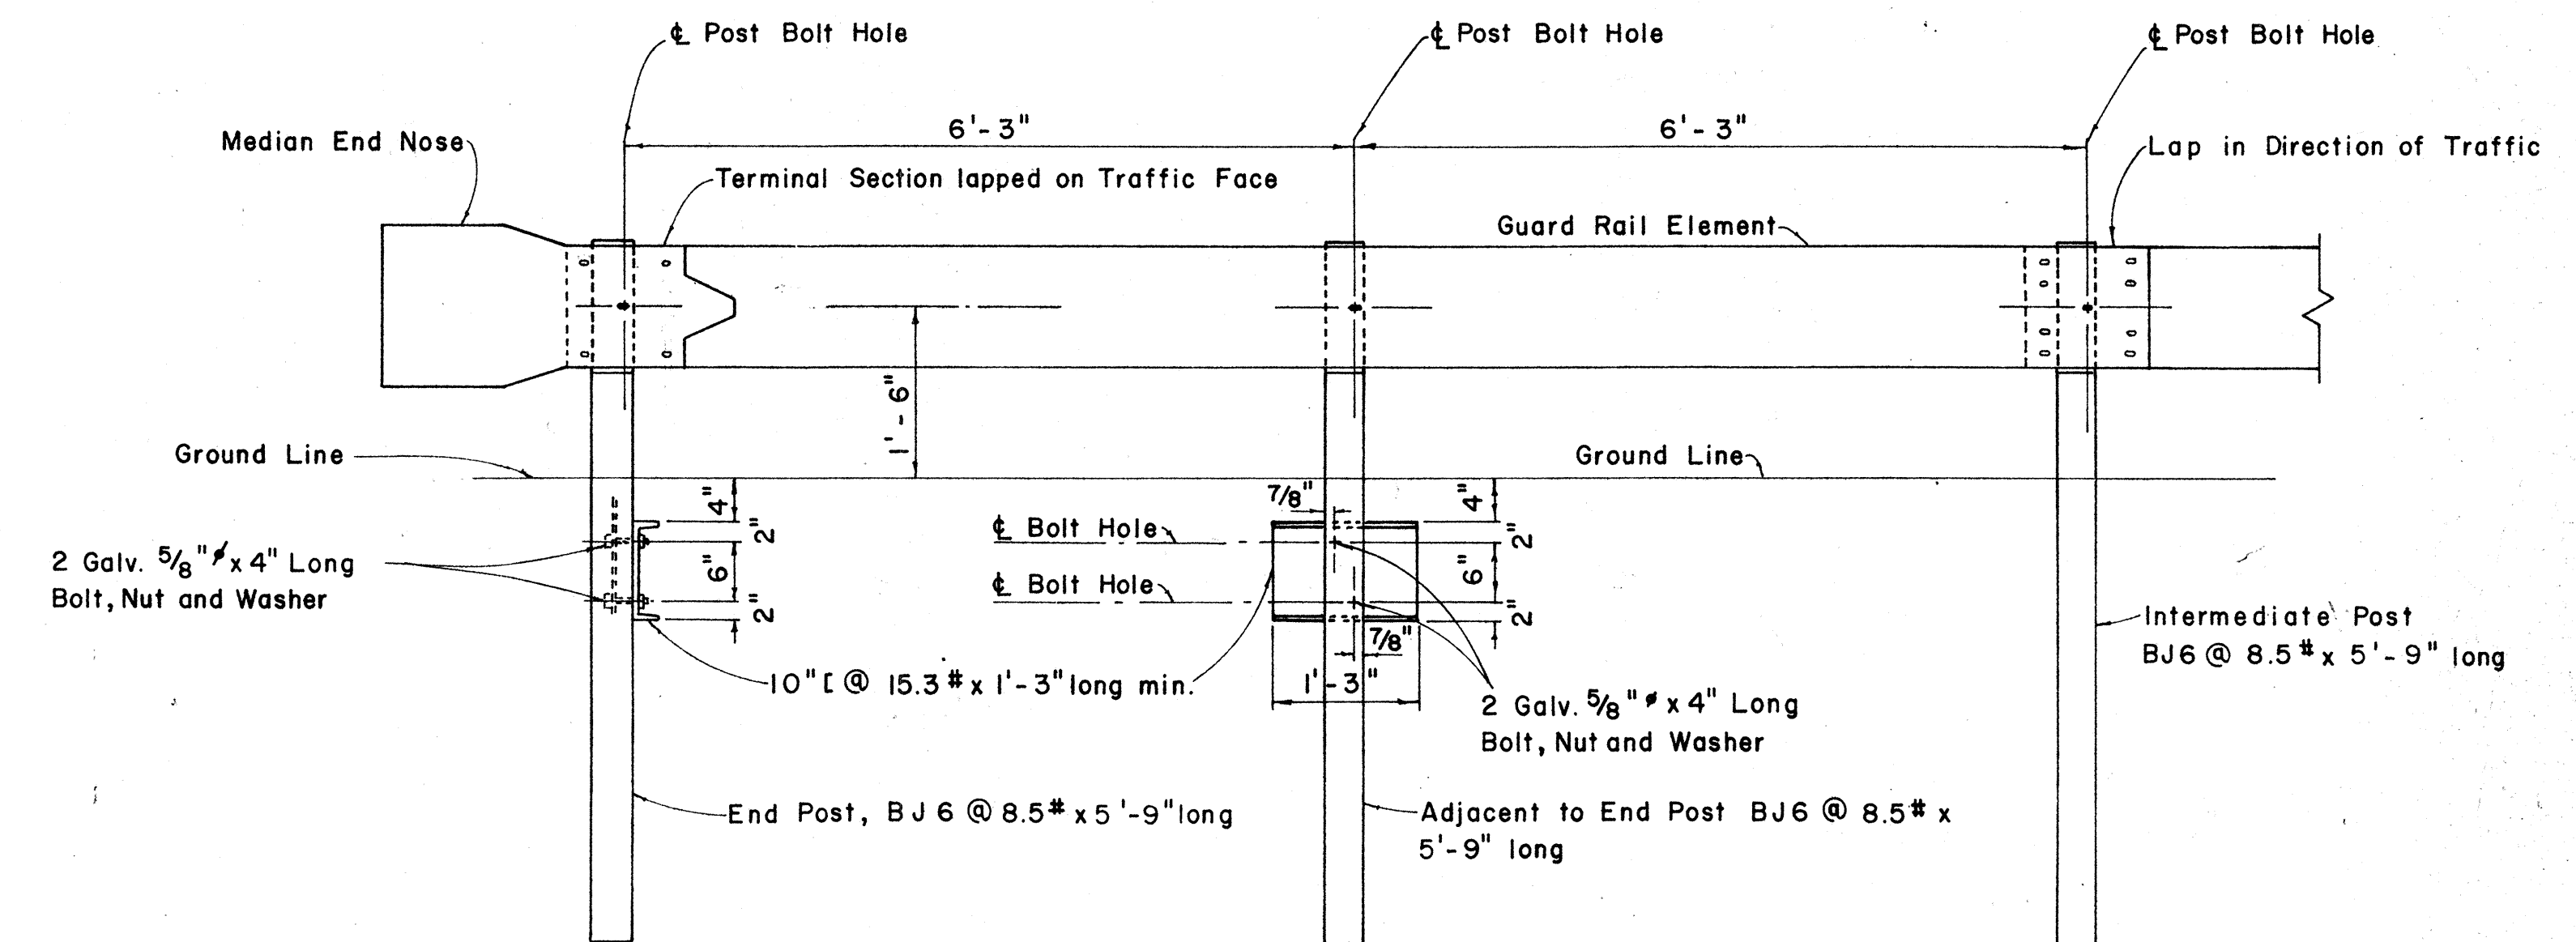

ELEVATION

METAL GUARD RAIL ON METAL POSTS AND METAL SPACER BLOCKS

Scale: $\frac{3}{4}$ " = 1' - 0"

DETAIL FOR DOUBLE METAL GUARD RAIL IN MEDIAN

Scale: As Shown




DESIGNED BY	DATE
DRAWN BY	
CHECKED BY	
NOTED BY	
NO.	

STATE OF HAWAII
DEPARTMENT OF TRANSPORTATION
HIGHWAYS DIVISION

STANDARD DETAILS
METAL GUARD RAIL



SHEET No. 7 OF 10 SHEETS

FED. ROAD DIST. NO.	STATE	FED. AID PROJ. NO.	FISCAL YEAR	SHEET NO.	TOTAL SHEETS
HAWAII	HAW.	2-111(81) UNIT 1	1967	38	292

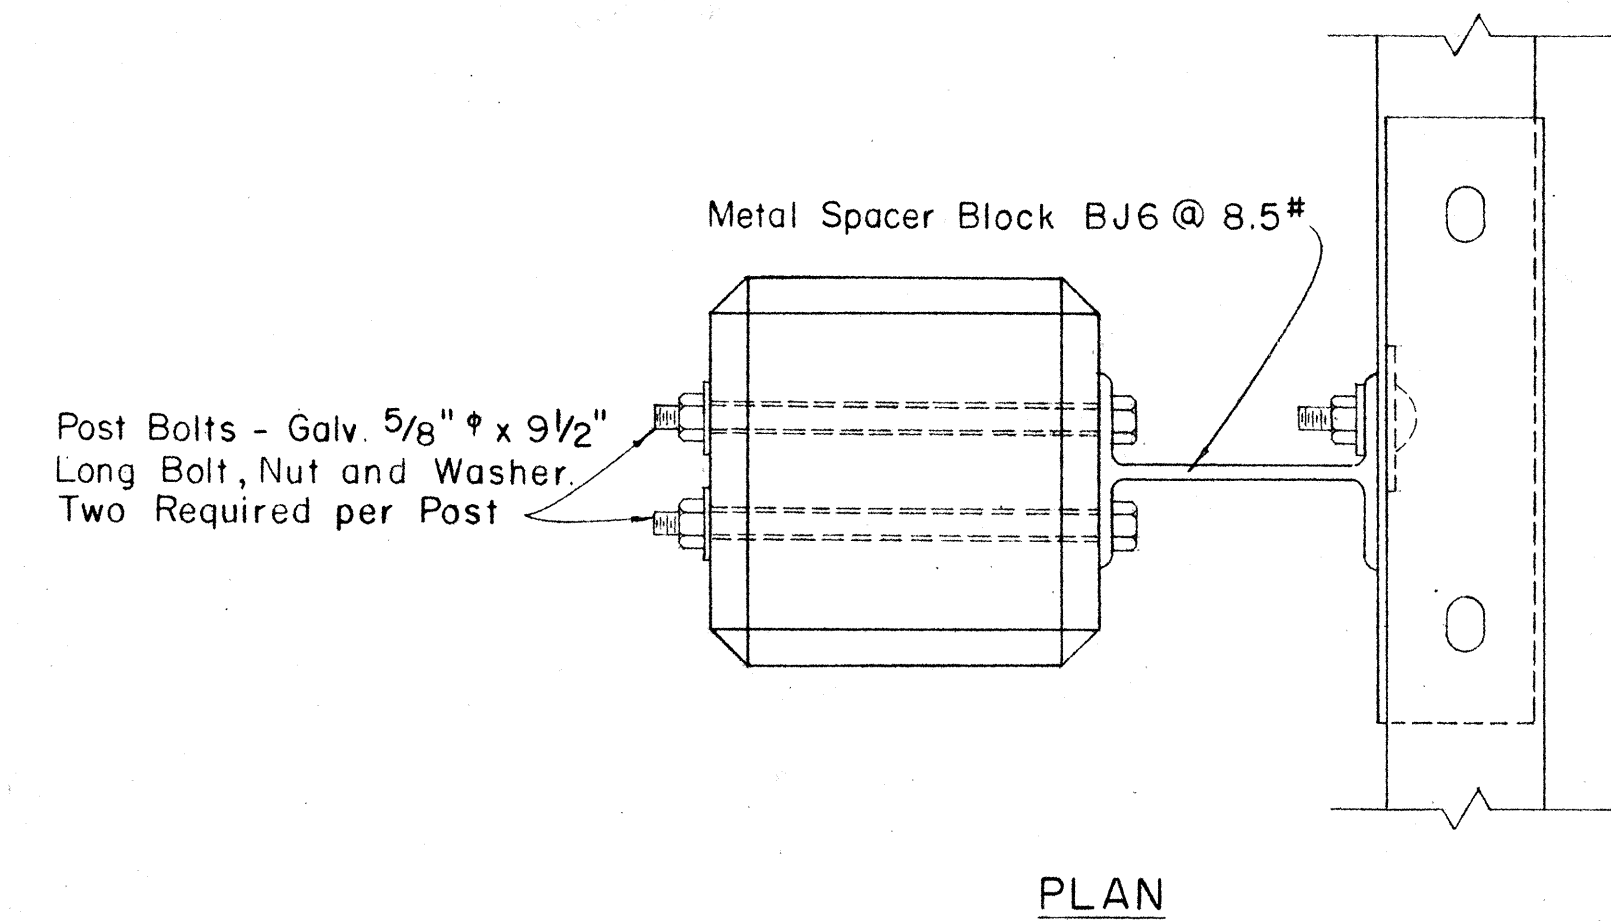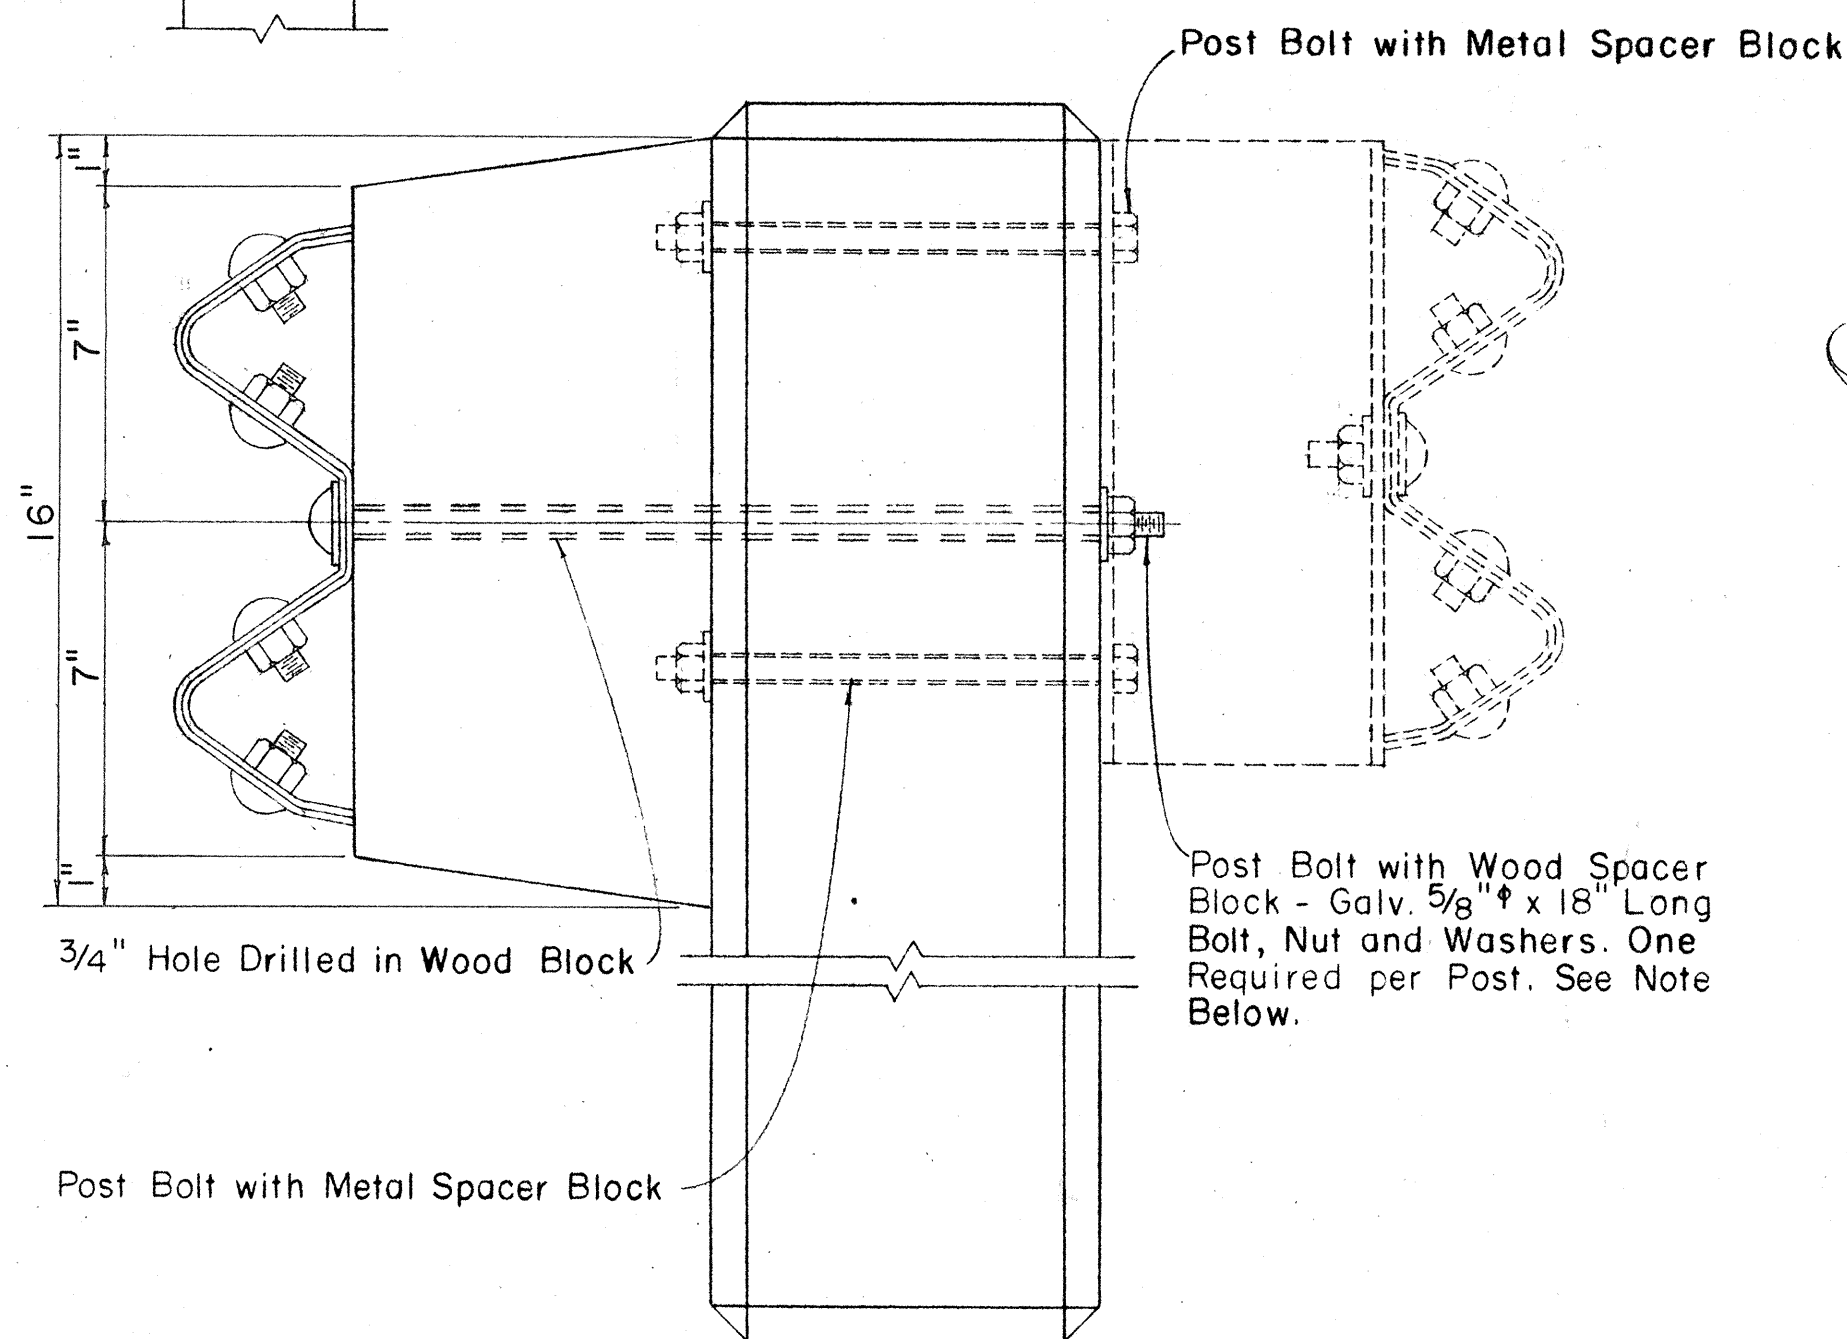
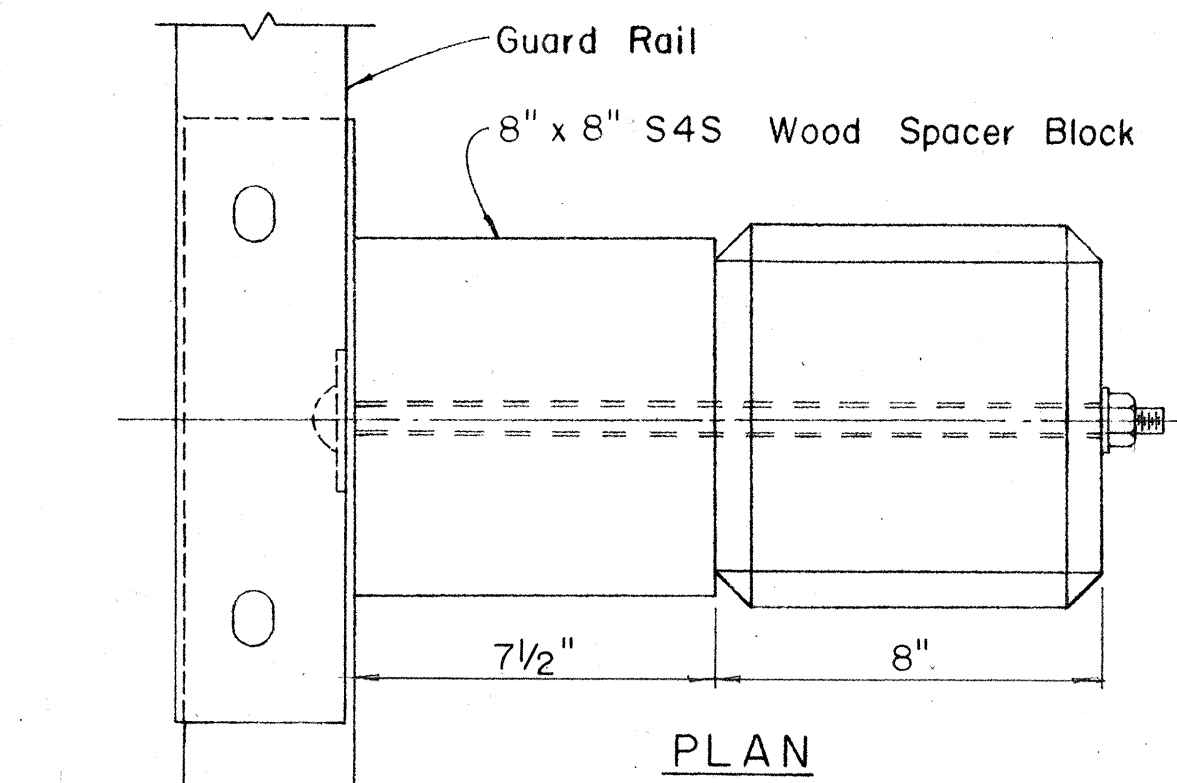


SINGLE METAL GUARD RAIL ON PRECAST
CONCRETE POST WITH WOOD OR METAL SPACER BLOCK
Scale: 3" = 1' - 0"



NOTE:
Single Guard Rails Shown. For Double Guard Rails Additional Spacer Blocks
and Rail Elements Required on Opposite Side of Posts. See Bolt Schedule
for Required Bolt Lengths.

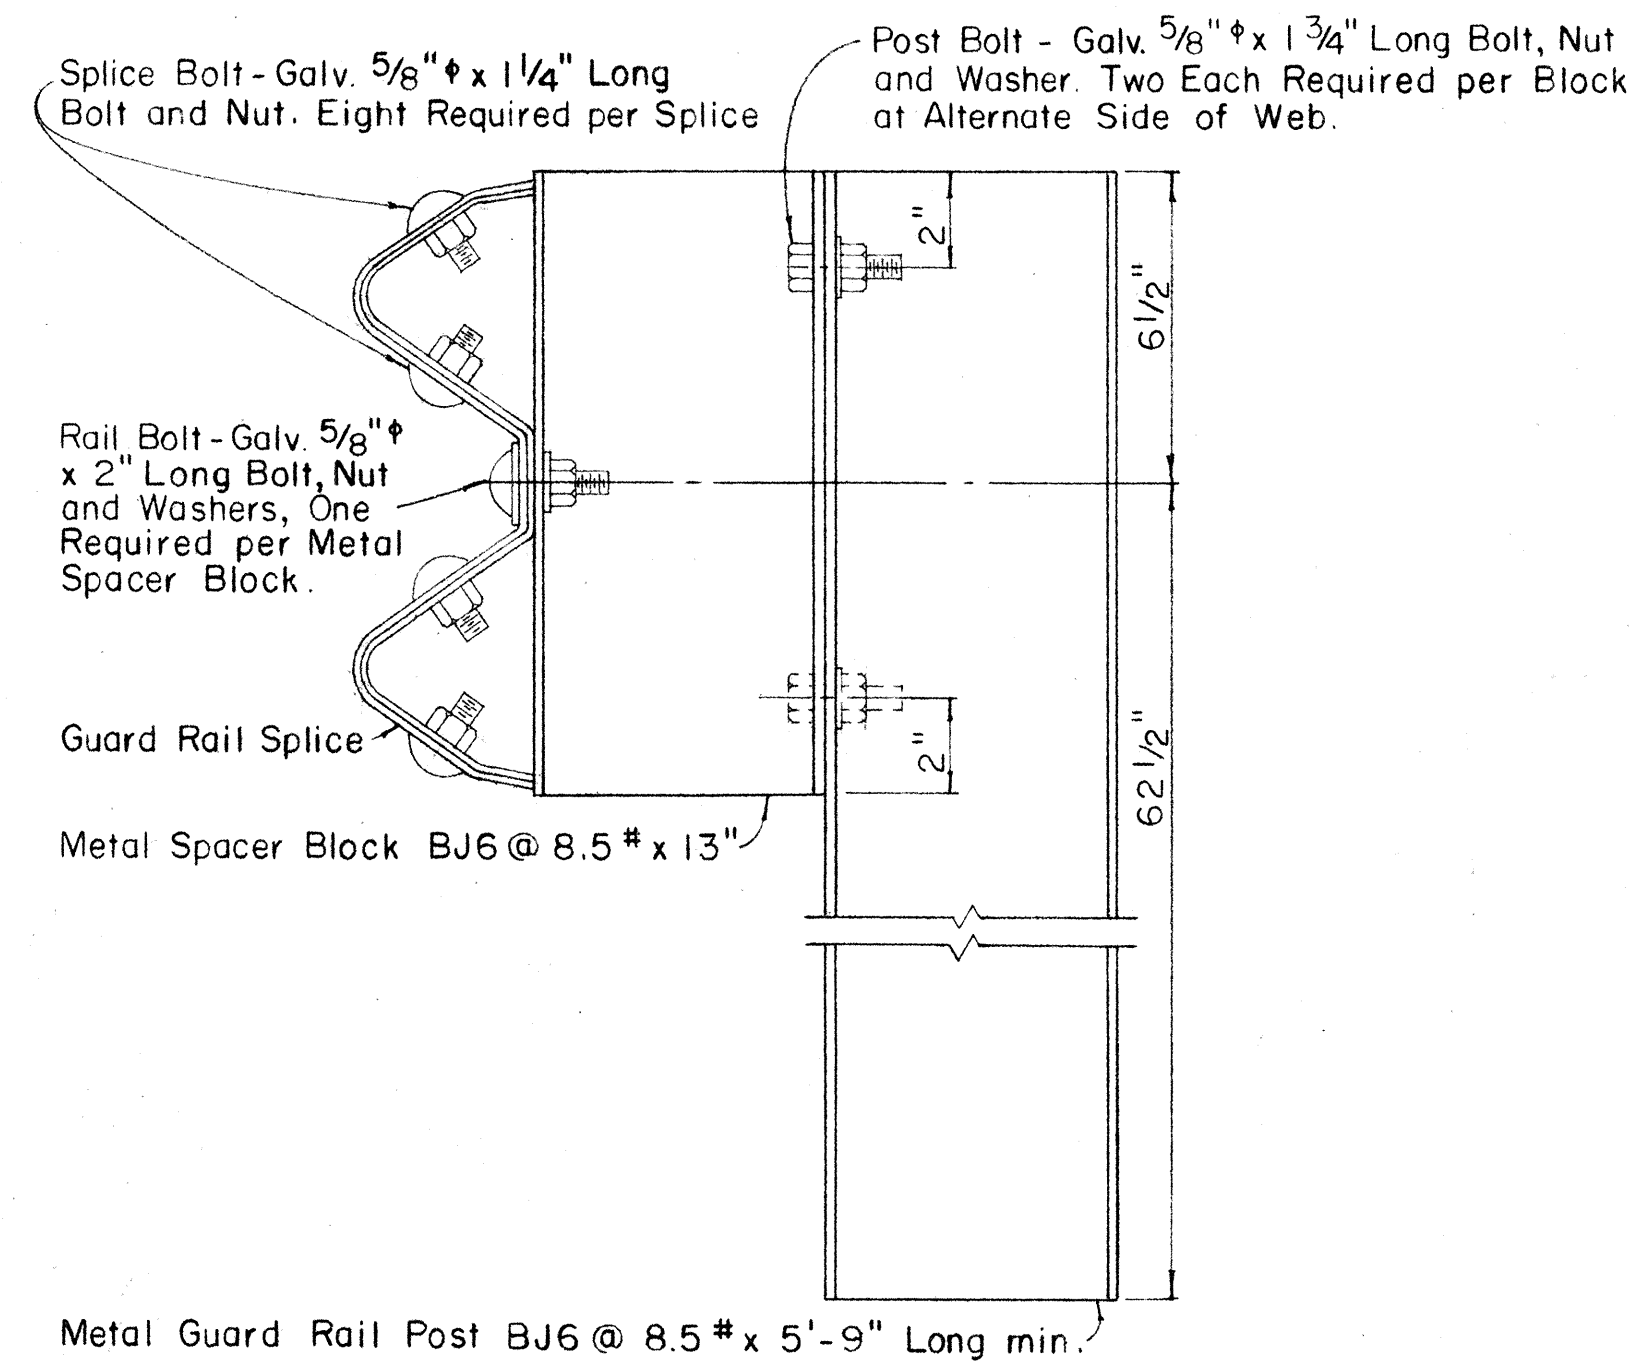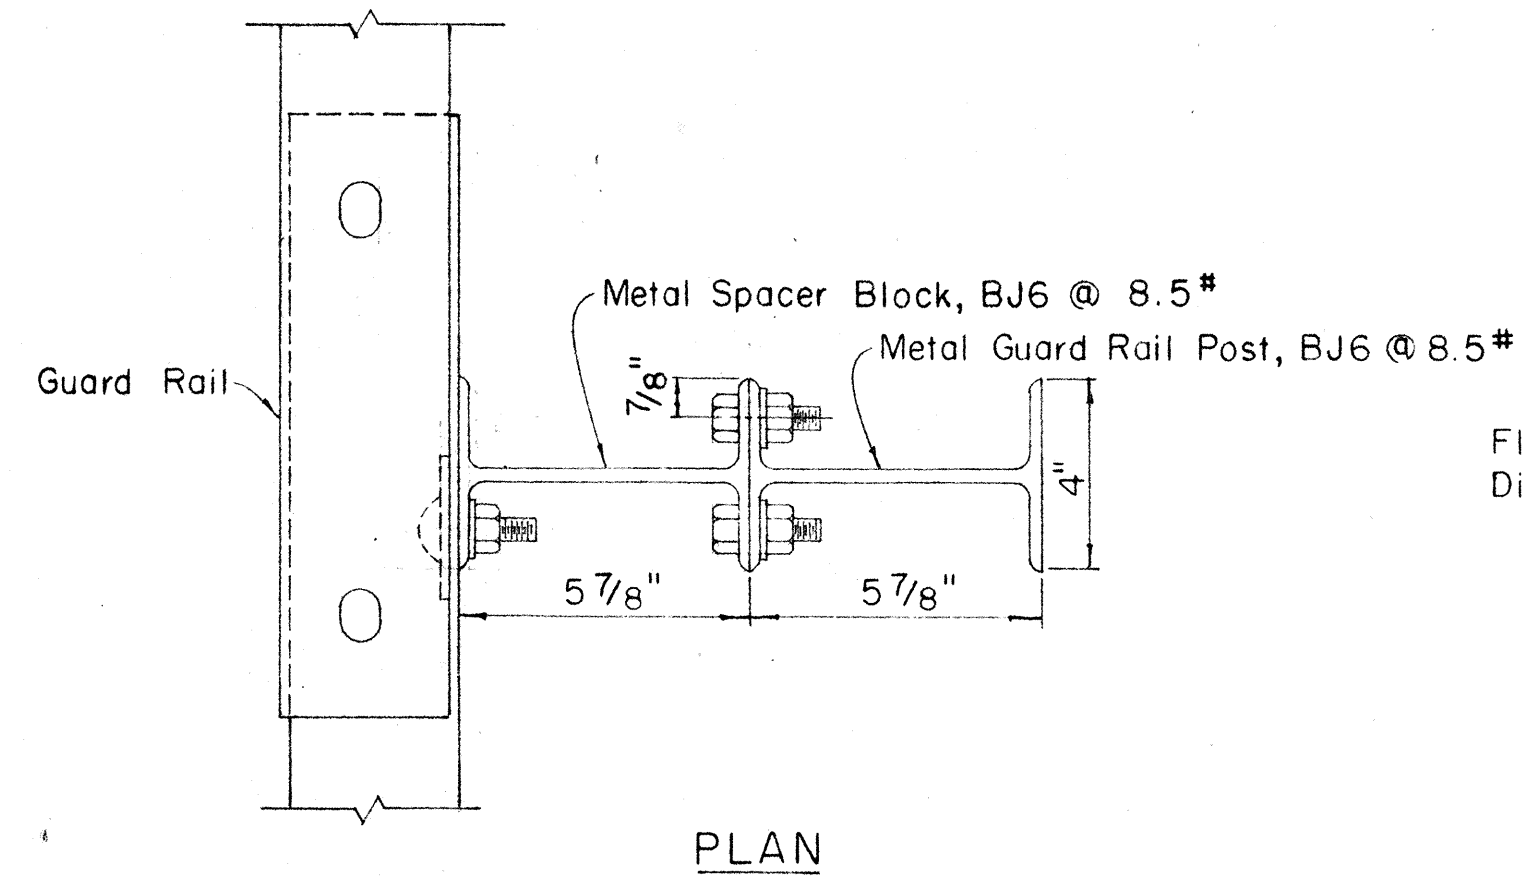

SINGLE METAL GUARD RAIL ON METAL POST
WITH METAL SPACER BLOCK
Scale: 3" = 1' - 0"

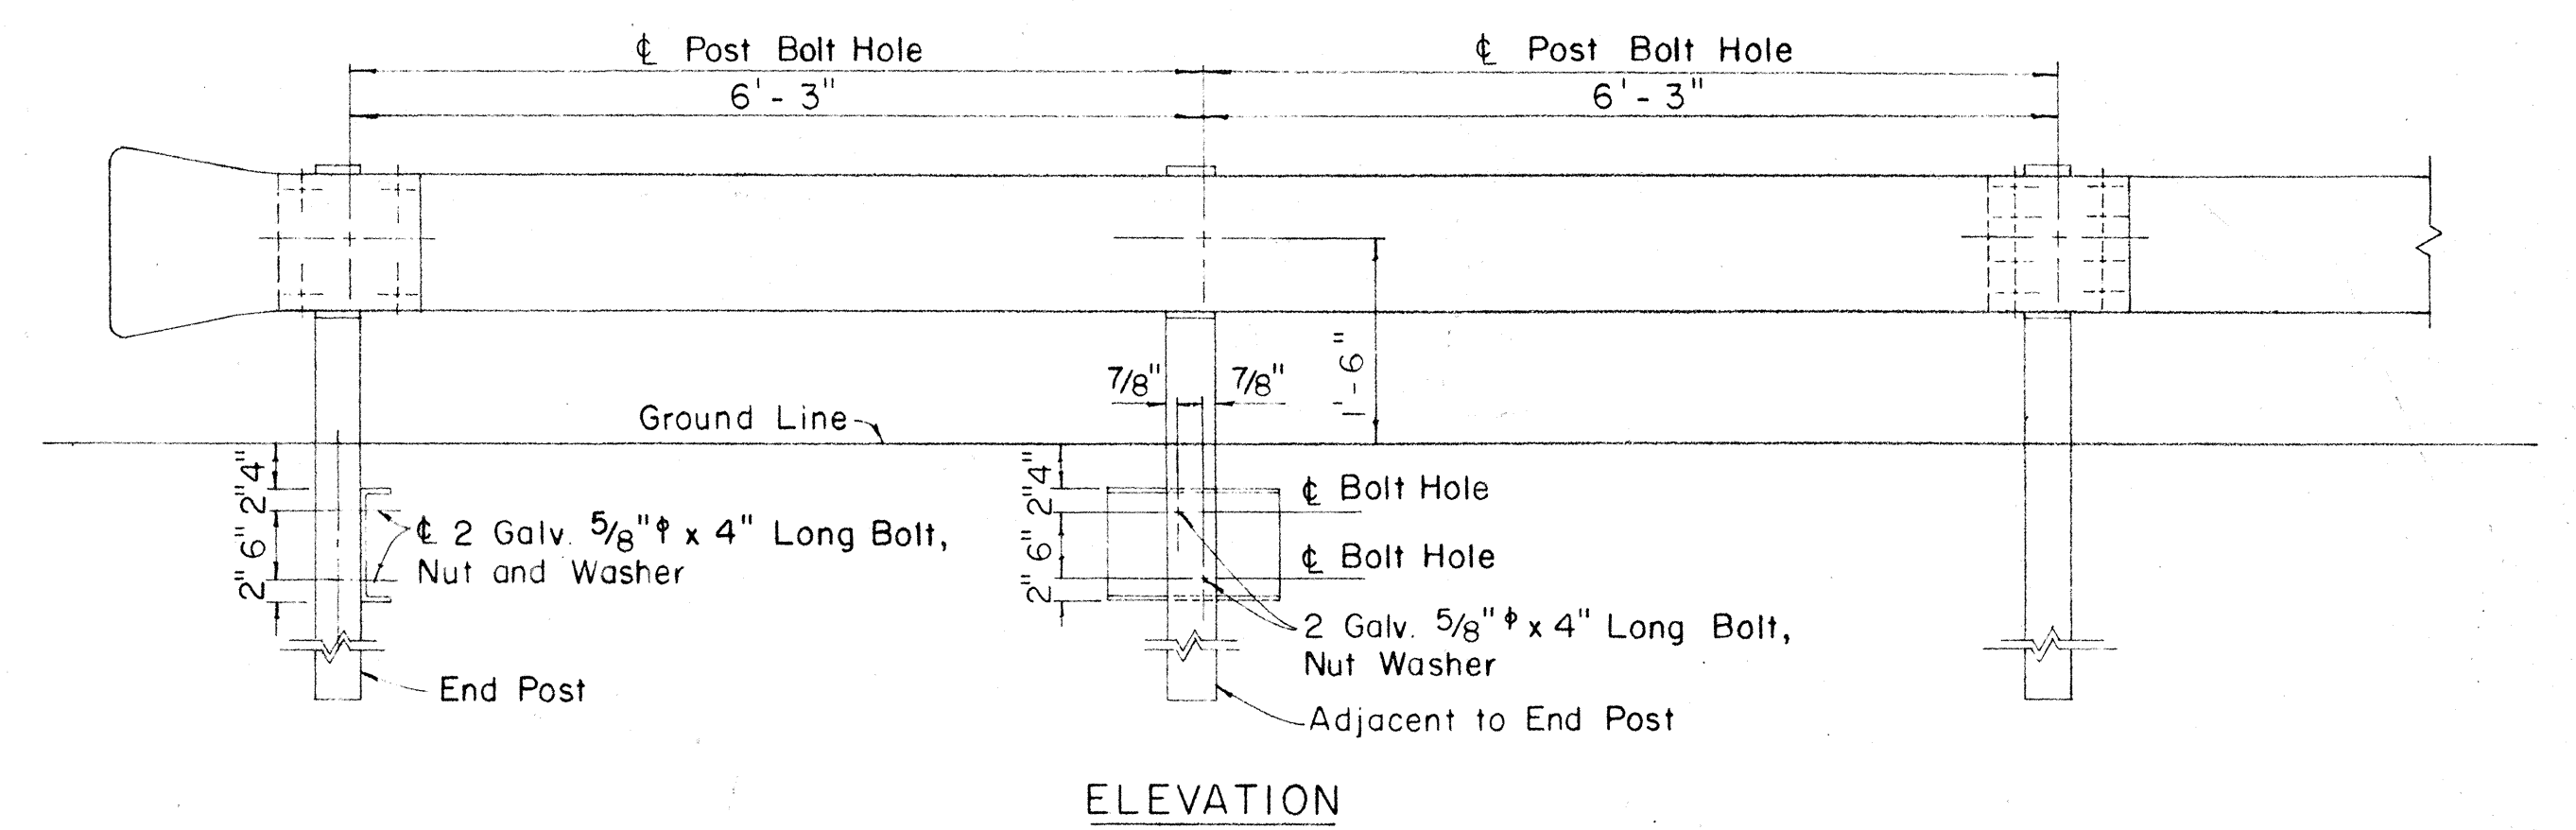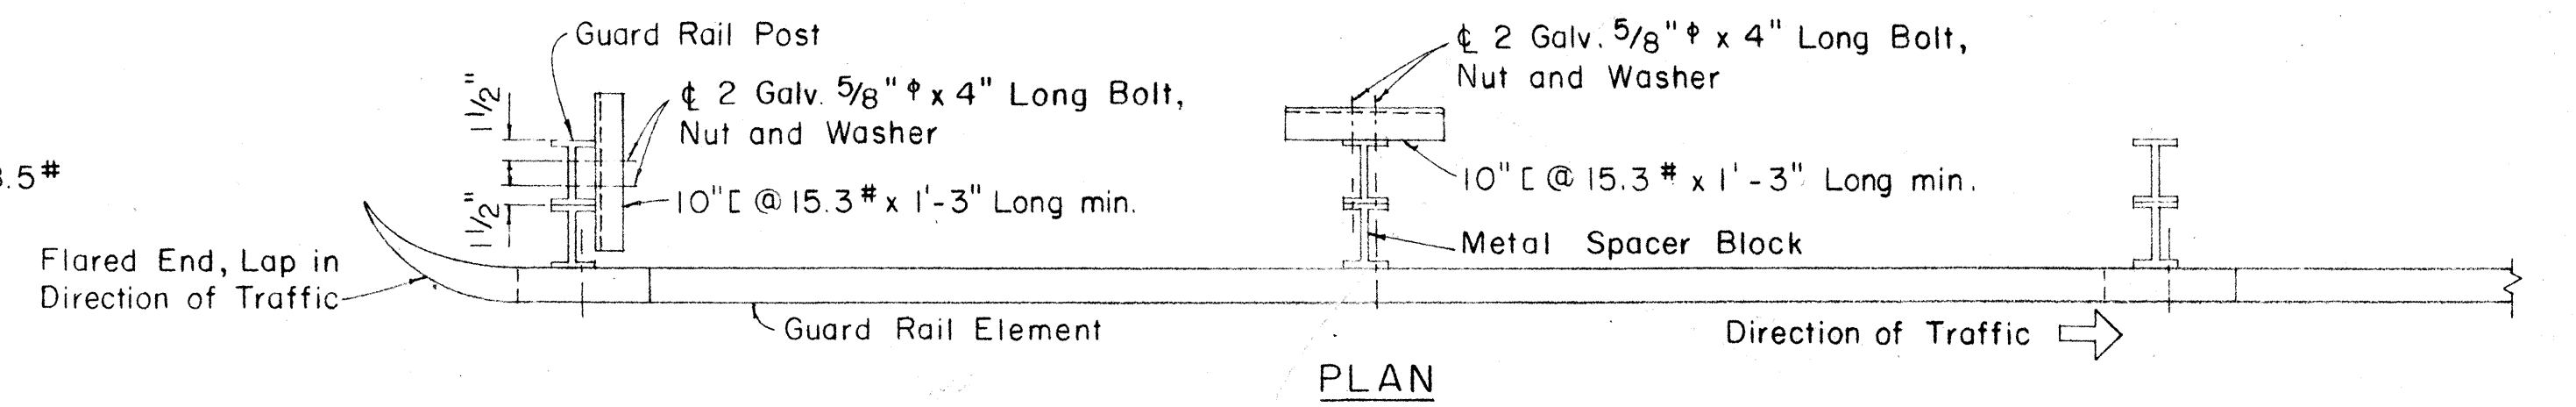

METAL GUARD RAIL ON METAL POST WITH METAL SPACER BLOCK
Scale: 3/4" = 1' - 0"

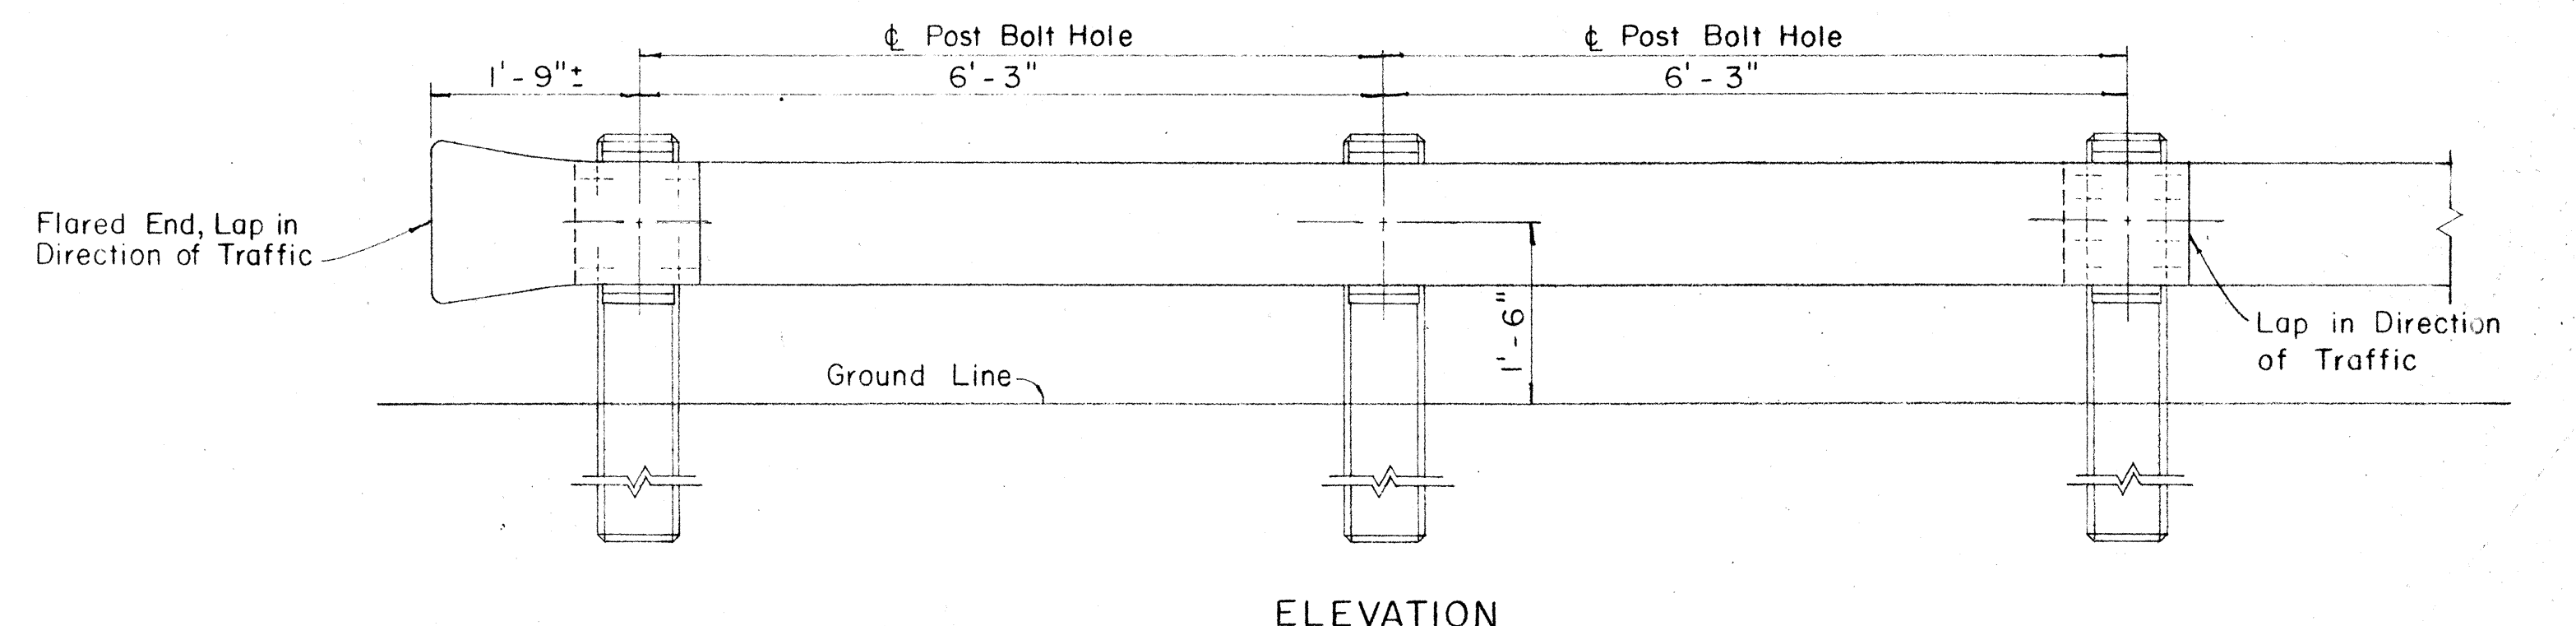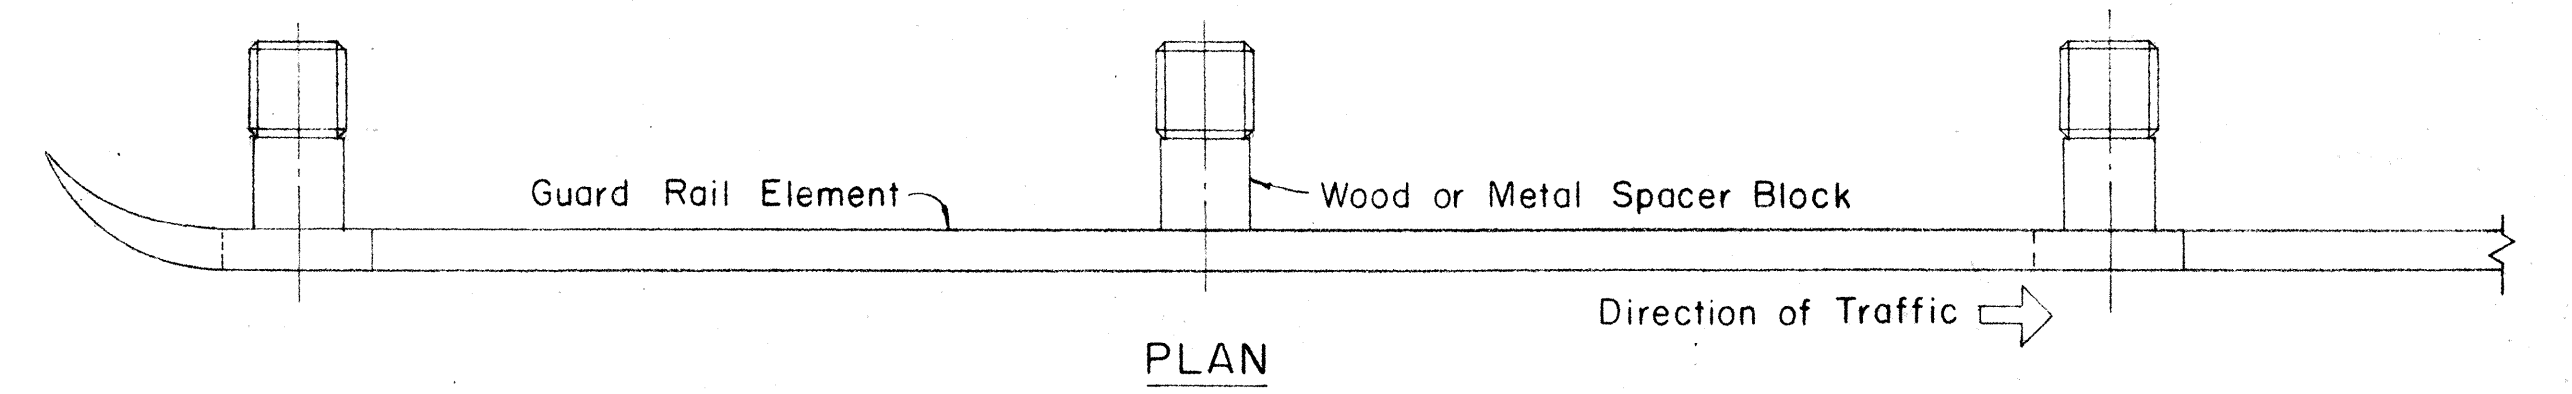

METAL GUARD RAIL ON CONCRETE POST WITH WOOD OR METAL SPACER BLOCK
Scale: 3/4" = 1' - 0"

DETAILS FOR SINGLE GUARD RAIL

STATE OF HAWAII

DEPARTMENT OF TRANSPORTATION

HIGHWAYS DIVISION


STANDARD DETAILS

METAL GUARD RAIL


Scale: as noted

SHEET No. 8 OF 10 SHEETS

DATE	_____
DESIGNED BY	_____
CHECKED BY	_____
NOTED BY	_____
ORIGINAL PLAN	_____
NO.	_____

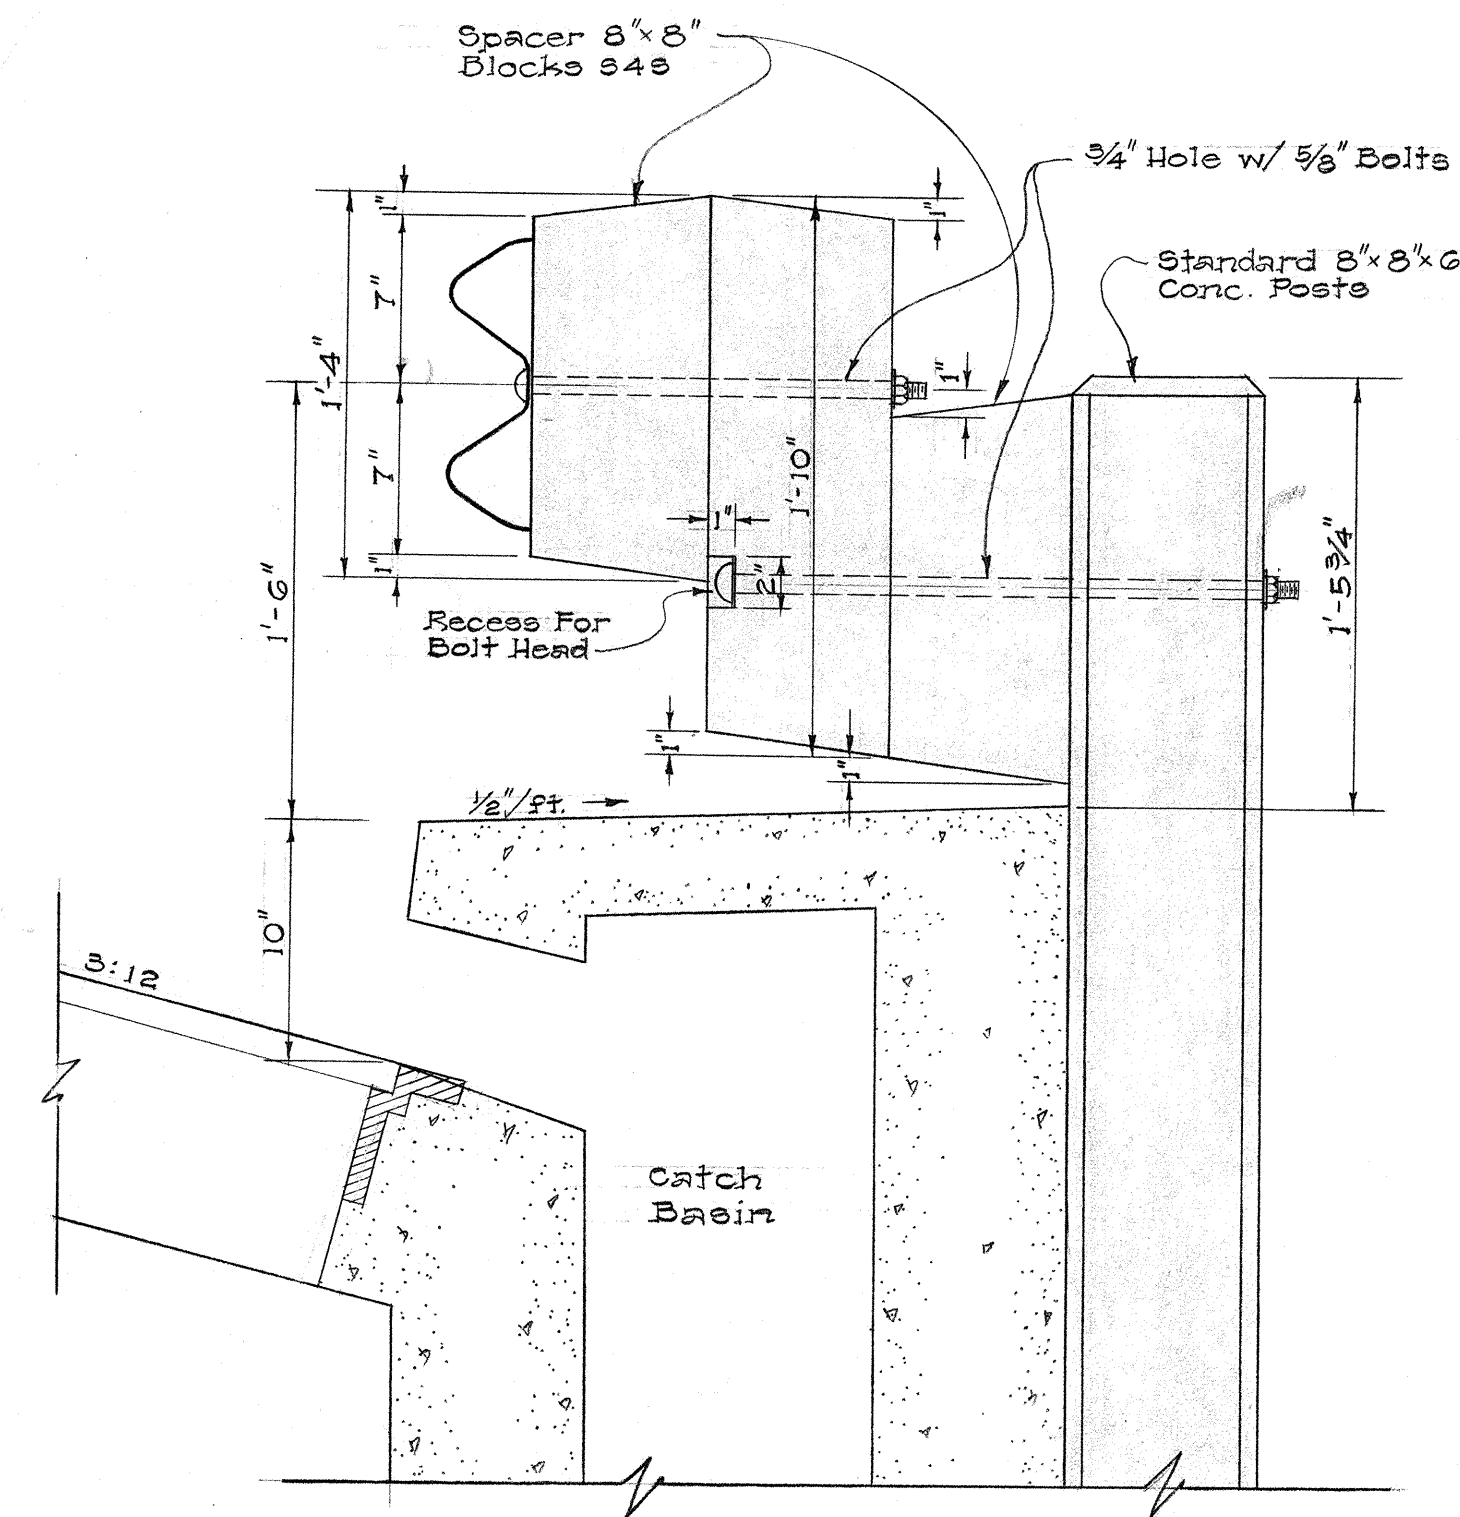

METAL GUARD RAIL ON CONC. POST

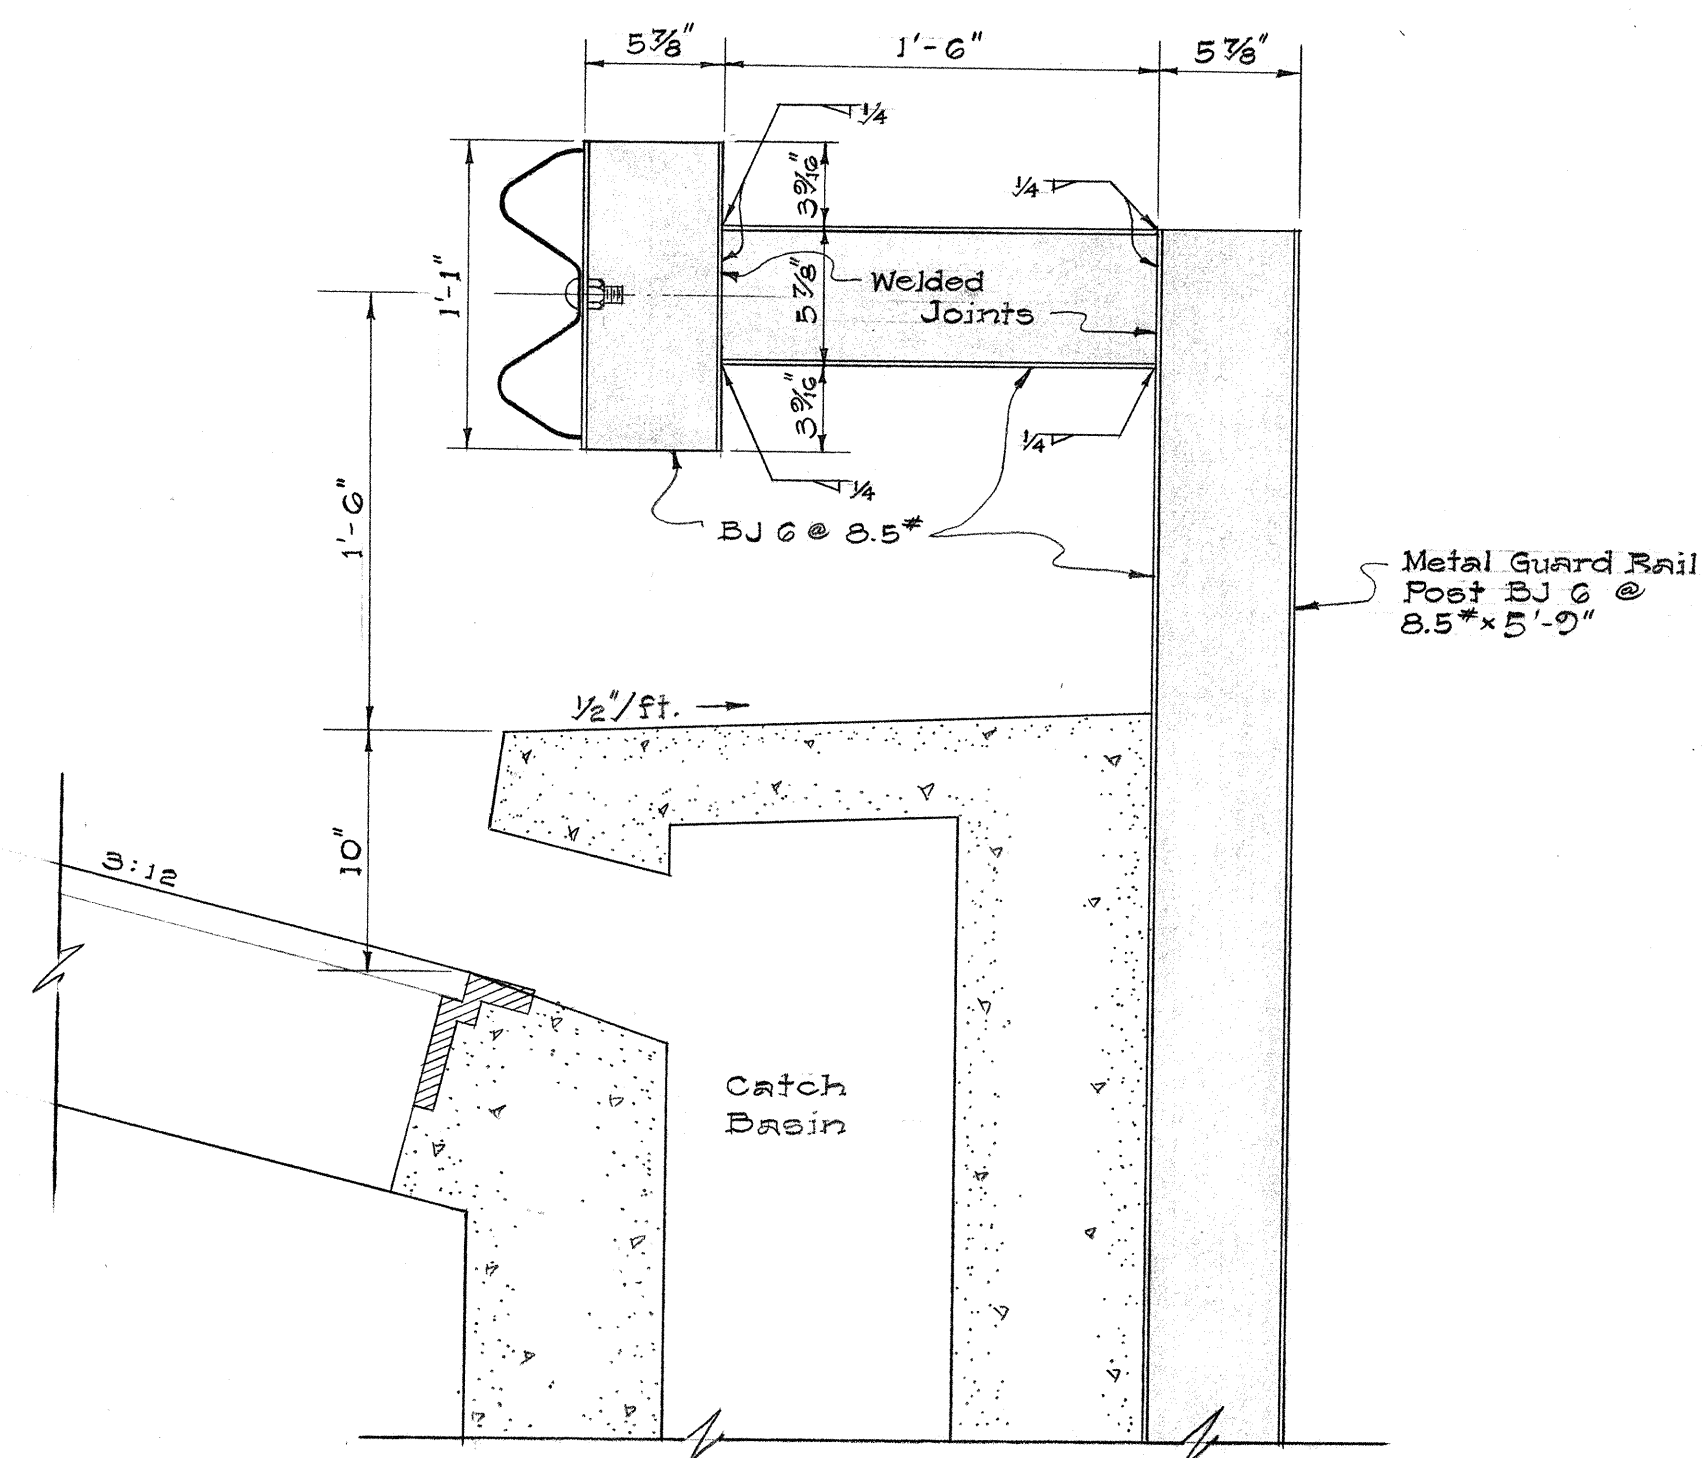

METAL GUARD RAIL ON METAL POST

GUARD RAIL INSTALLATION OVER CATCH BASINS IN SHOULDER

Scale: 1 1/2" = 1'-0"


METAL GUARD RAIL QUANTITIES

LOCATION			ESTIMATED LENGTH Lineal Feet	
ROAD	STATION TO STATION	SIDE	SINGLE	DOUBLE
Freeway	156 + 40* to 178 + 25	Median		1,383
Freeway	189 + 50 to 191 + 20	Median		170
Freeway	192 + 45 to 198 + 75	Median		630
Freeway (Westbound)	178 + 25 to 189 + 50	Median	1,125	
Freeway (Westbound)	191 + 20 to 192 + 45	Median	125	
Freeway (Eastbound)	178 + 25 to 189 + 50	Median	1,125	
Freeway (Eastbound)	191 + 20 to 192 + 45	Median	125	
Freeway (Eastbound)	179 + 80 to 182 + 10	Right	245	
Freeway (Eastbound)	200 + 75 to 202 + 25	Right	150	
Freeway (Westbound)	181 + 40 to 183 + 35	Left	185	
Ramp "H"	165 + 75 to 170 + 75		500	
Vineyard (Westbound)	Vin. Sta. 157 + 83 to 158 + 83	Left	100	
Ramp B-1	B-1 Sta. 5 + 40 to 7 + 05	Left	170	
Ramp B-1	B-1 Sta. 4 + 35 to 7 + 30	Right	295	
Ramp "C"	0 + 40 to 2 + 22	Right	190	
Ramp "C"	5 + 22 to 7 + 05	Right	185	
Vineyard (Eastbound)	Vin. Sta. 158 + 67 to 159 + 42	Left	75	
Vineyard	Vin. Sta. 151 + 80 to 159 + 37	Median	757	
Vineyard (Westbound)	Vin. Sta. 163 + 92 to 164 + 81	Left	90	
Vineyard (Westbound)	Vin. Sta. 165 + 00 to 167 + 25	Right	225	
Vineyard (Eastbound)	Vin. Sta. 155 + 05 to 160 + 23	Right	523	
Vineyard (Eastbound)	Vin. Sta. 162 + 50 to 166 + 30	Right	380	
Pele St.	Cul - De - Sacs		65	
Miller St.	" " "		65	
Frear St.	" " "		65	
Lauhala St.	" " "		25	
Alapai St.	" " "		25	
Victoria St.	" " "		65	


* EQUATION 156 + 22.15 = 164 + 22.27

LOCATION			ESTIMATED LENGTH Lineal Feet	
ROAD	STATION TO STATION	SIDE	SINGLE	DOUBLE
Freeway	155 + 80 to 156 + 30	Left	70	
Freeway	167 + 00 to 167 + 60	Left	60	
Freeway	190 + 60 to 191 + 40	Right	80	


NOTE:
All the quantities shown are original theoretical quantities. For actual quantities, refer to project ledger and/or computation book.

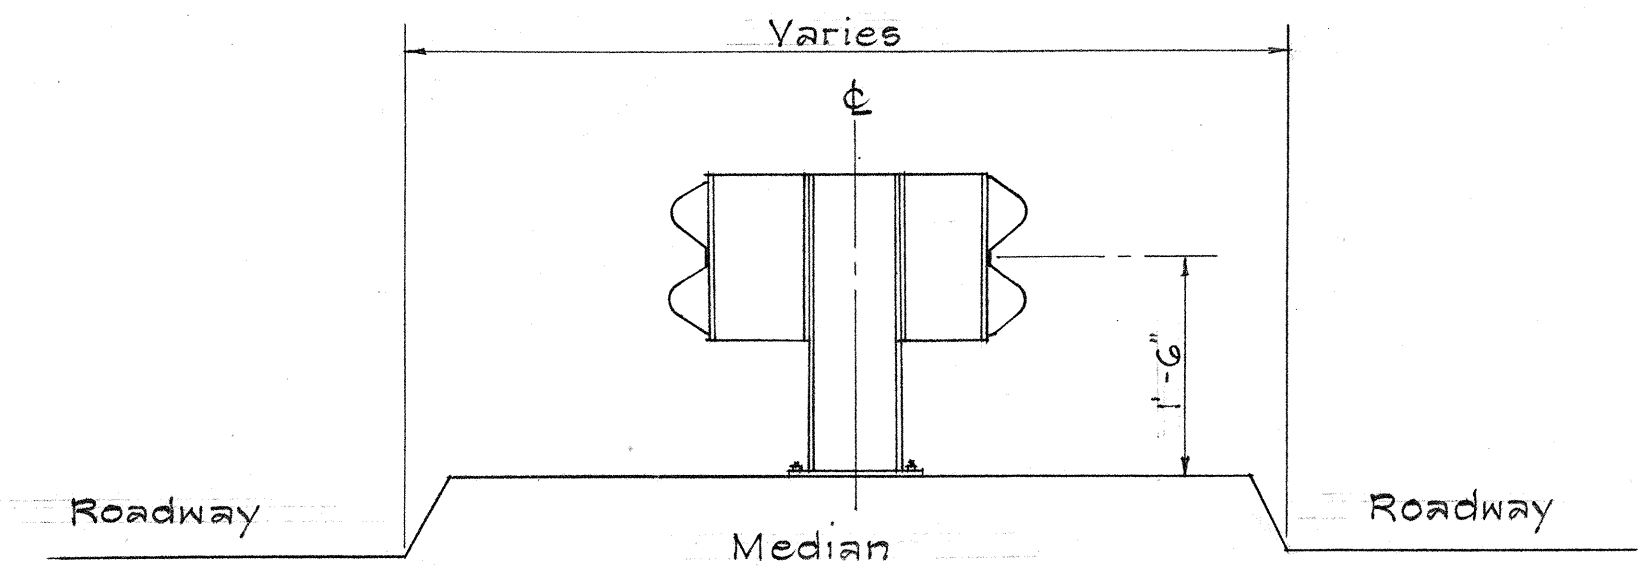

TYPICAL INSTALLATION
Scale: 3/4" = 1'-0"

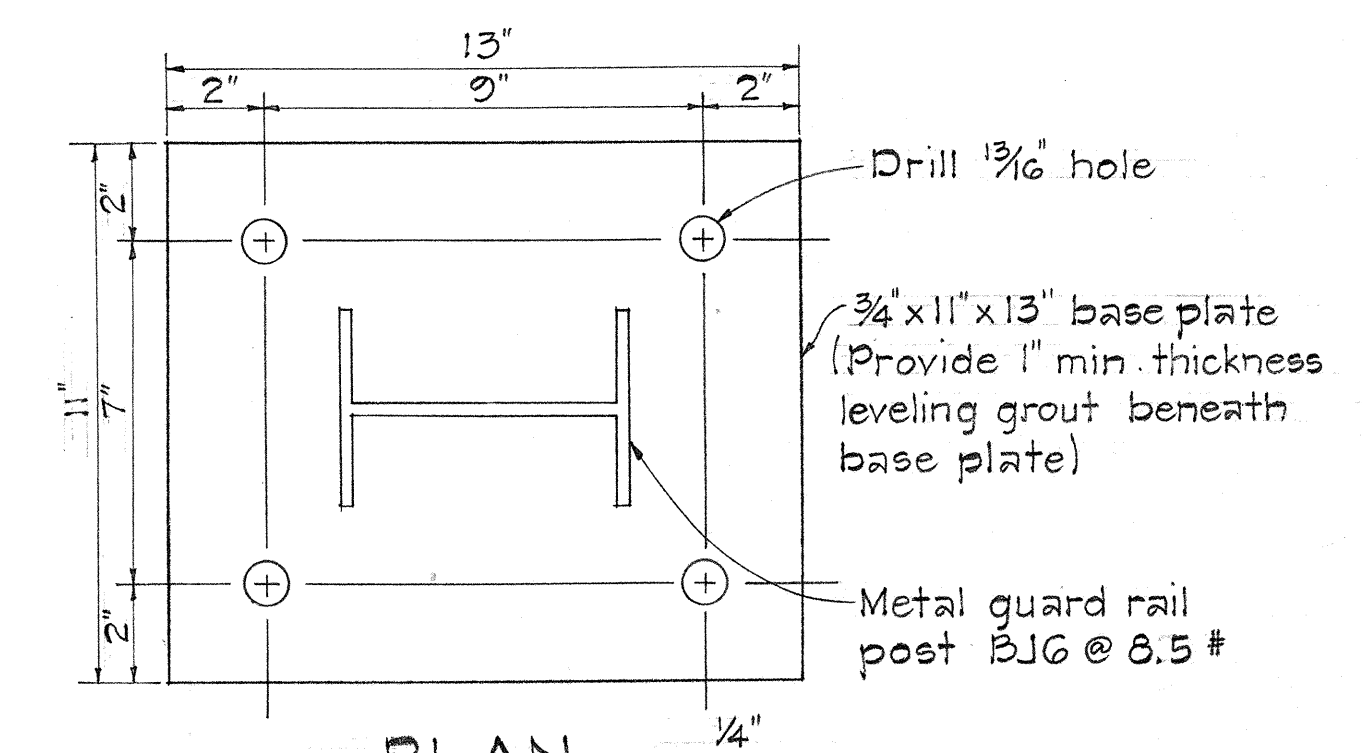

PLAN
Scale: 1" = 3'-0"

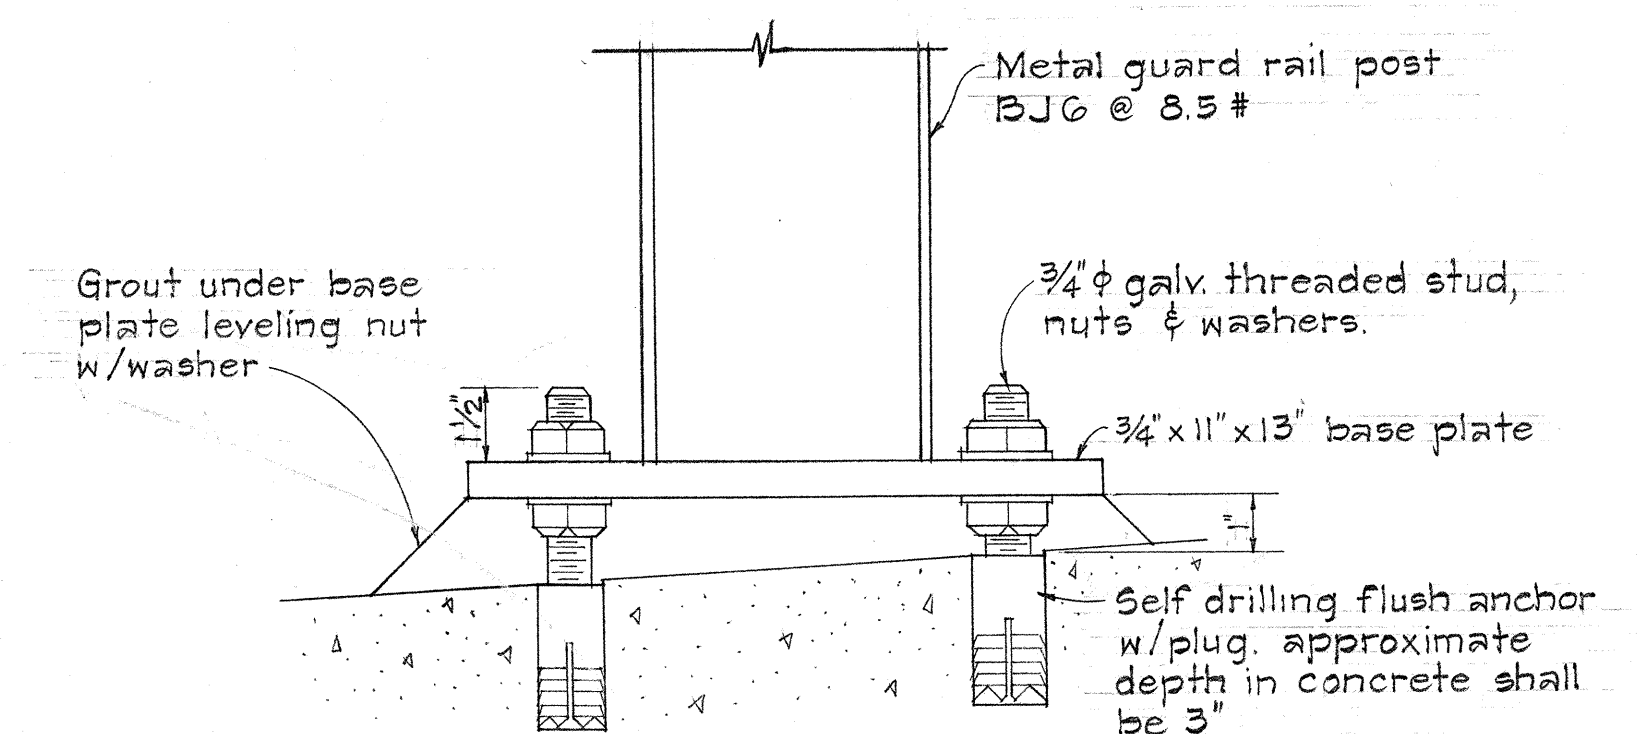

DETAIL OF CONNECTION
Scale: 1" = 3'-0"

METAL GUARD RAIL ON MEDIAN ON BRIDGE STRUCTURE

STATE OF HAWAII
DEPARTMENT OF TRANSPORTATION
HIGHWAYS DIVISION


**METAL GUARD RAIL SUMMARY
& DETAILS OF GUARD RAILS
OVER CATCH BASINS
AND ON BRIDGE STRUCTURE
INTERSTATE ROUTE H-1
(LUNALILO FREEWAY)
Pele Street to Victoria Street
P.A.I. Proj. No. 1-HI-1(31) Unit 1**

Scale: 1 1/2" = 1'-0" Date: May, 1966


SHEET No. 2 OF 10 SHEETS

SURVEY PLOTTED BY: _____ DATE: _____
PLAN CHECKED BY: _____
DESIGNED BY: _____
NOTE BOOK: _____
QUANTITIES BY: _____
CHECKED BY: _____

FED. ROAD DIST. NO.	STATE	FED. AID PROJ. NO.	FISCAL YEAR	SHEET NO.	TOTAL SHEETS
HAWAII	HAW.	I-HI-1(3) UNIT 1	1967	00378	202

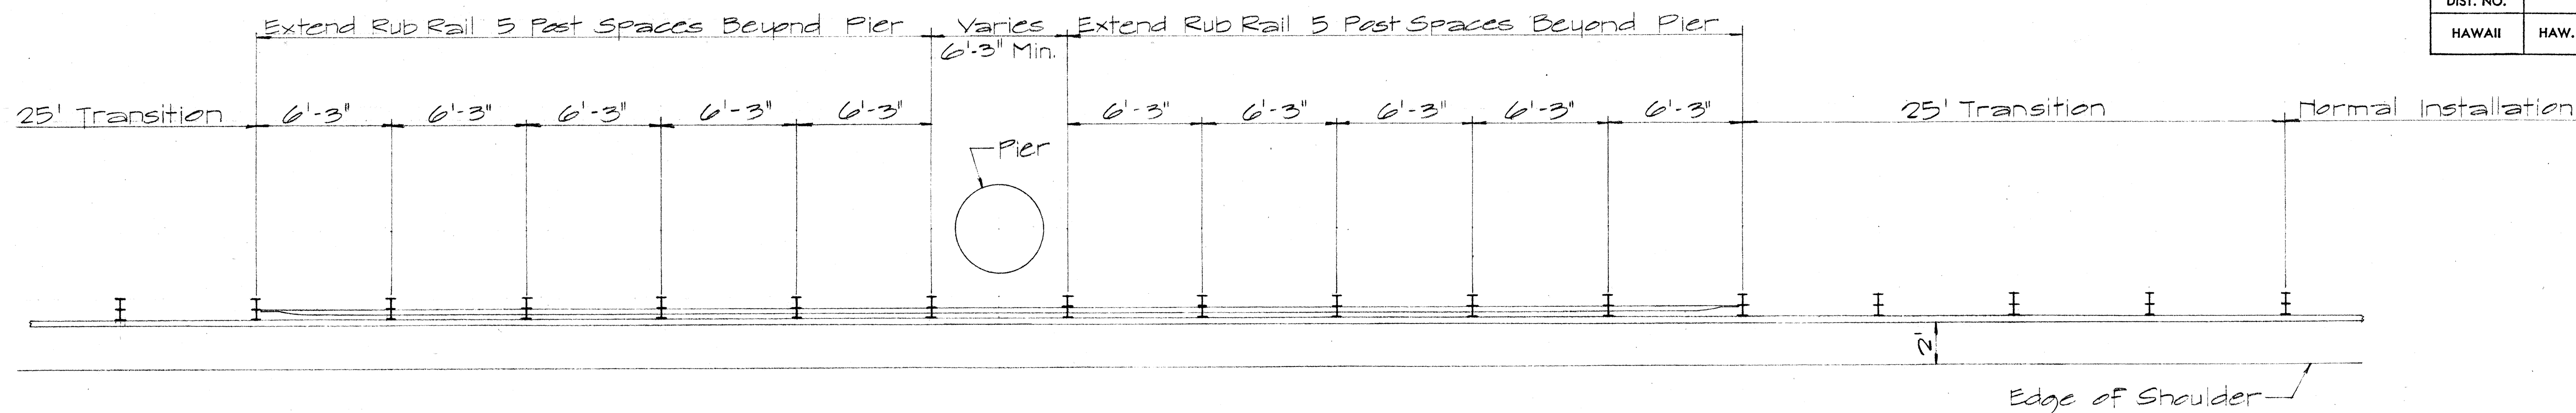


PLAN

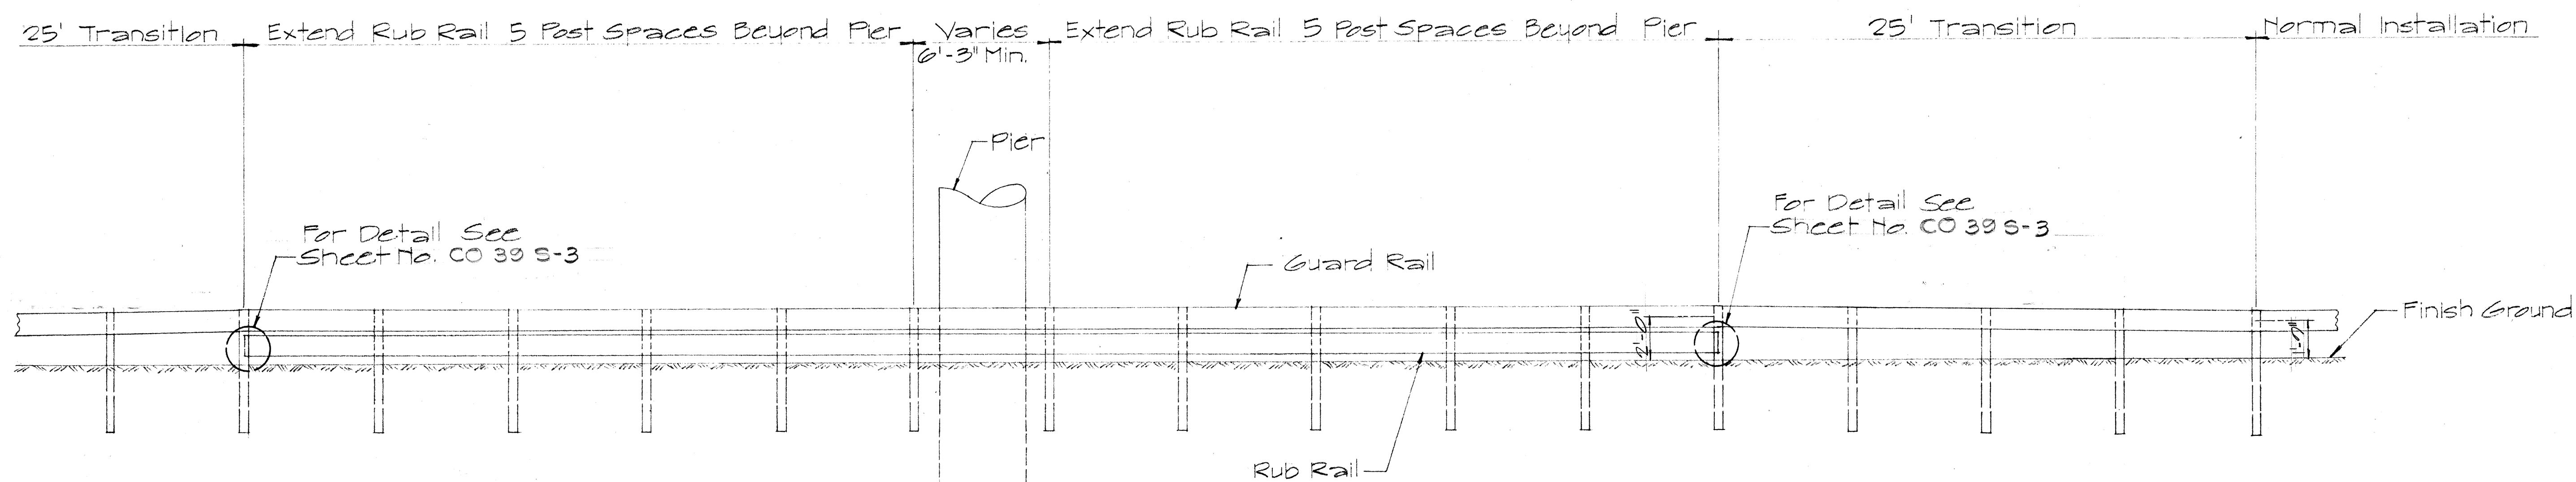

ELEVATION

DETAIL OF GUARD RAIL INSTALLATION AT PIER
SC. 1/4" = 1'-0"

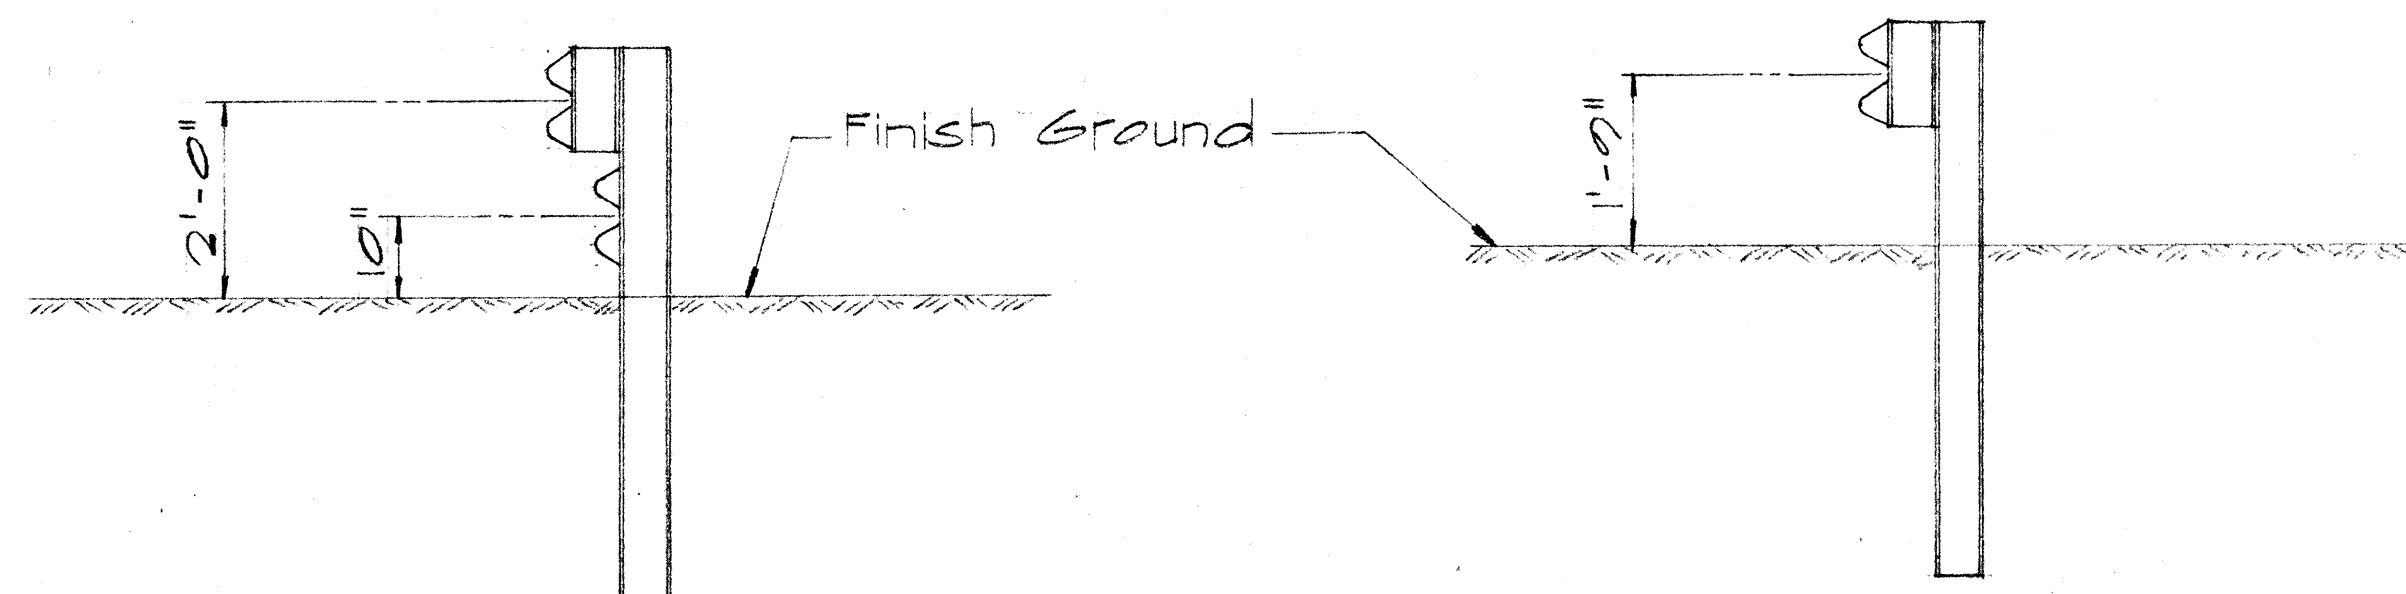

TYP. SEC. AT PIER

TYP. SEC. AT NORMAL INSTALLATION

TYP. GUARD RAIL SECTIONS
SC. 1/2" = 1'-0"

THIS SHEET SUPERCEDES
AND REPLACES SHEET 00378
DATED NOVEMBER 30, 1967.

STATE OF HAWAII
DEPARTMENT OF TRANSPORTATION
HIGHWAYS DIVISION

DETAILS OF RUB RAIL
PELE STREET TO VICTORIA STREET
F.A.I. PROJ. NO. I-HI-1(3), UNIT 1

SC. AS NOTED JUNE 1967
SHEET No. OF SHEETS

00378

DATE	_____
SURVEY PLOTTED BY	_____
DRAWN BY	_____
TRACED BY	_____
NOTED BY	_____
CHECKED BY	_____
ORIGINAL PLAN	_____
NOTE BOOK	_____
No.	_____

FED. ROAD DIST. NO.	STATE	FED. AID PROJ. NO.	FISCAL YEAR	SHEET NO.	TOTAL SHEETS
HAWAII	HAW.	I-H-1(31), Unit 1	1968	003951	292

NOTE:
All the quantities shown are original theoretical quantities. For actual quantities, refer to project ledger and/or computation book.


SUMMARY OF CONCRETE MEDIAN BARRIER					
STATION	TYPE "A"	TYPE "B"	TYPE "C"	TYPE "C" AT EXPRESS-WAY SIGN	TRANS.
	(LIN. FT.)	(LIN. FT.)	(LIN. FT.)	(LIN. FT.)	(LIN. FT.)
164+92 to 166+92			200		
166+92 to 167+48				6	50
167+48 to 176+62			914		
176+62 to 177+18				6	50
177+18 to 180+70			352		
180+70 to 181+10		80			
181+10 to 182+97			187		
182+97 to 183+53				6	50
183+53 to 191+12			759		
191+12 to 191+37					25
191+37 to 191+98	61				
191+98 to 192+42					44
192+42 to 192+73				6	25
192+73 to 202+00			927		
202+00 to 202+25					25
TOTALS	61	80	3339	24	269

- NOTES:
- Concrete for Concrete Barriers shall be A-1
 - Reinforcing Steel and Construction Joint shall be provided at all Structure Columns as shown in details for Type "A" Concrete Barrier (Incidental to Concrete Barrier)
 - Expansion Joint shall be constructed at ninety(90) foot intervals or at existing expansion joints of structures. (Use 1/2" pre-molded joint filler, incidental to Concrete Barrier)
 - Construction Joints with Keys shall be provided for all Concrete Barriers.
 - Precast Type "C" Concrete Barrier may be installed as an alternate to Cast-in-place Type "C" Concrete Barrier at tangent sections only.
 - 2 1/2" ϕ hole spaced 10' o.c. as shown in details shall be provided for all types of Concrete Barriers. (Incidental to Concrete Barrier)



STATE OF HAWAII
DEPARTMENT OF TRANSPORTATION
HIGHWAYS DIVISION

CONCRETE MEDIAN BARRIER


INTERSTATE ROUTE H-1
(LUNALILO FREEWAY)
Pele Street to Victoria Street
F.A.I. Proj. No. I-H-1(31), Unit 1
Scale: As Shown Date: Aug., 1968
SHEET No. OF SHEETS

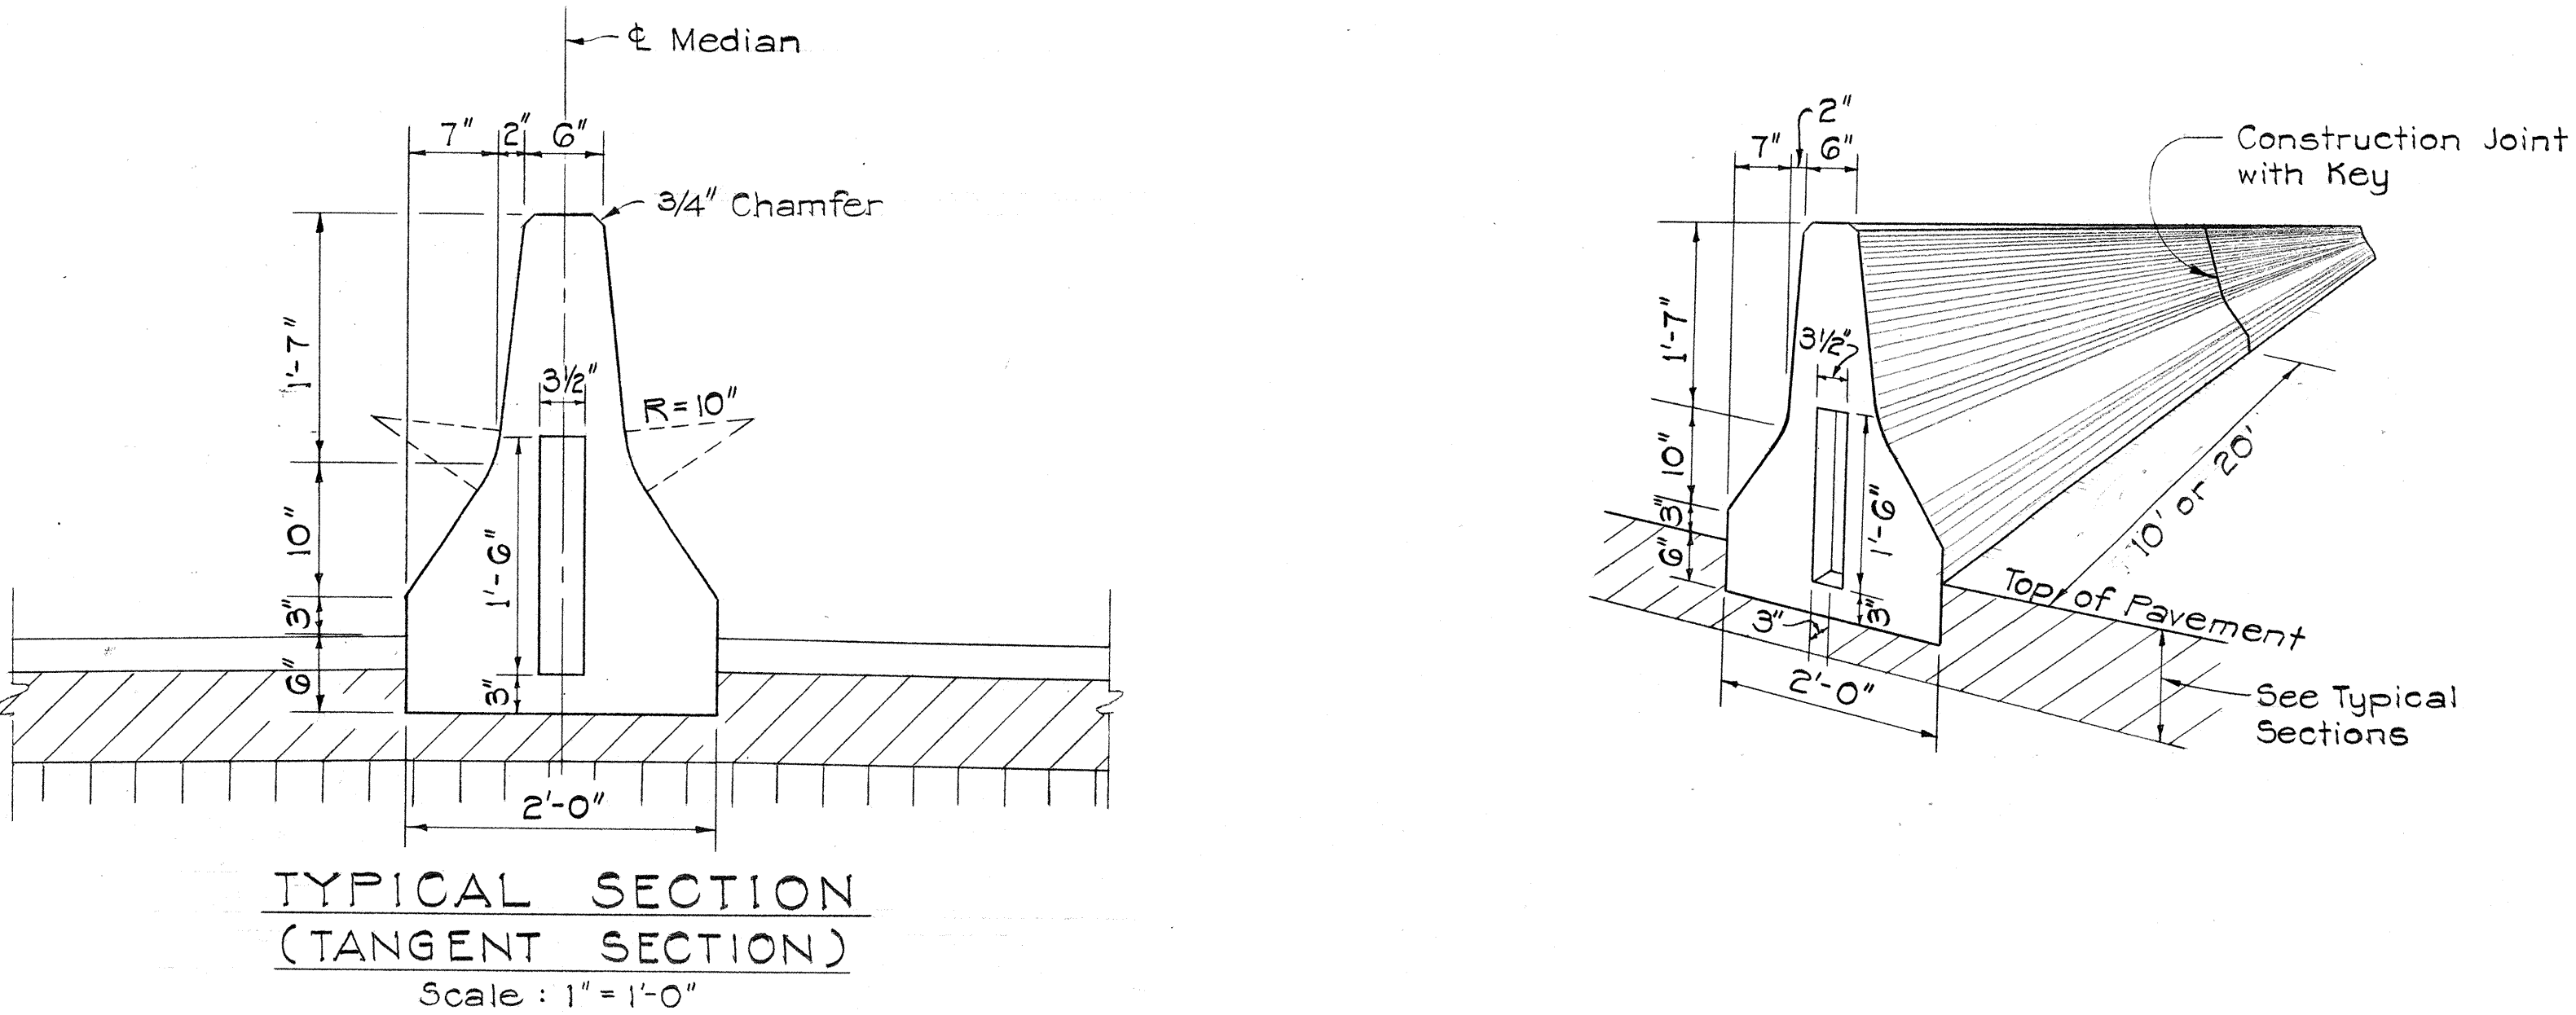


DETAILS FOR CAST-IN-PLACE TYPE "C" CONCRETE BARRIER

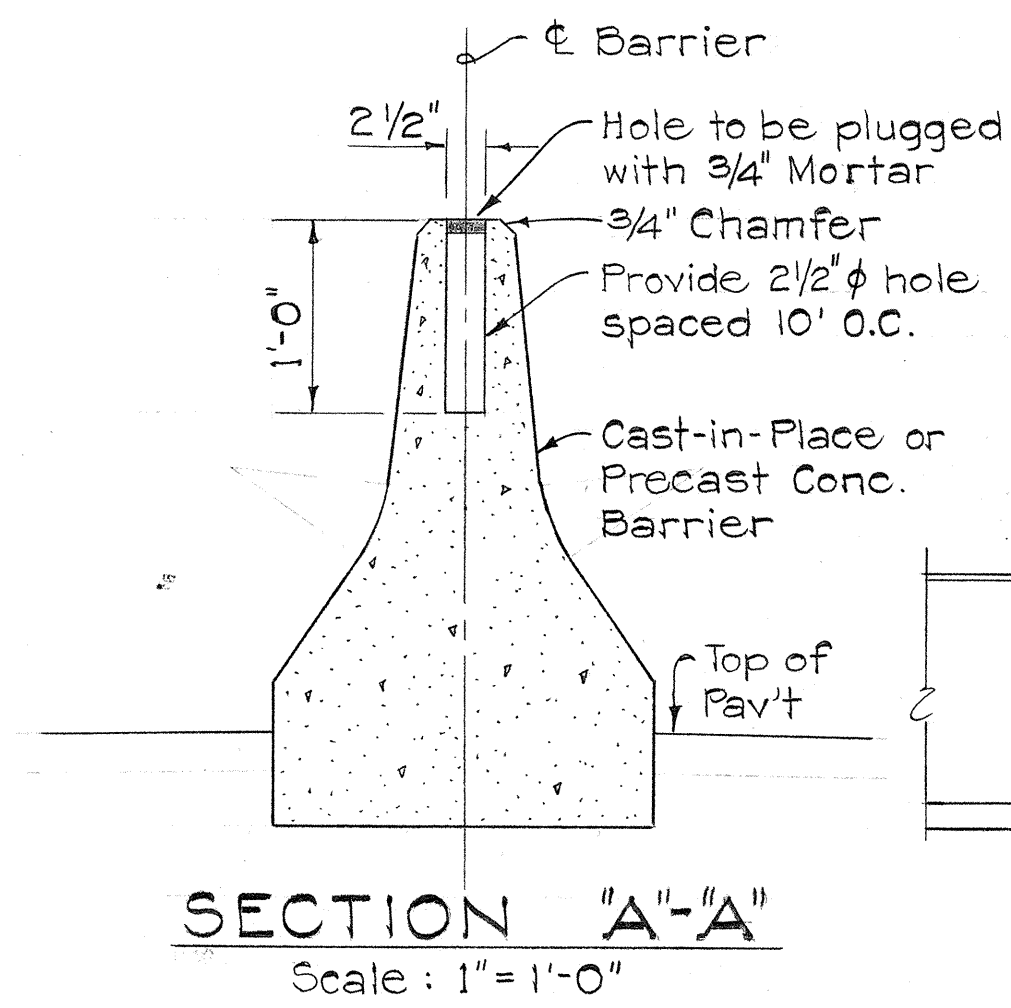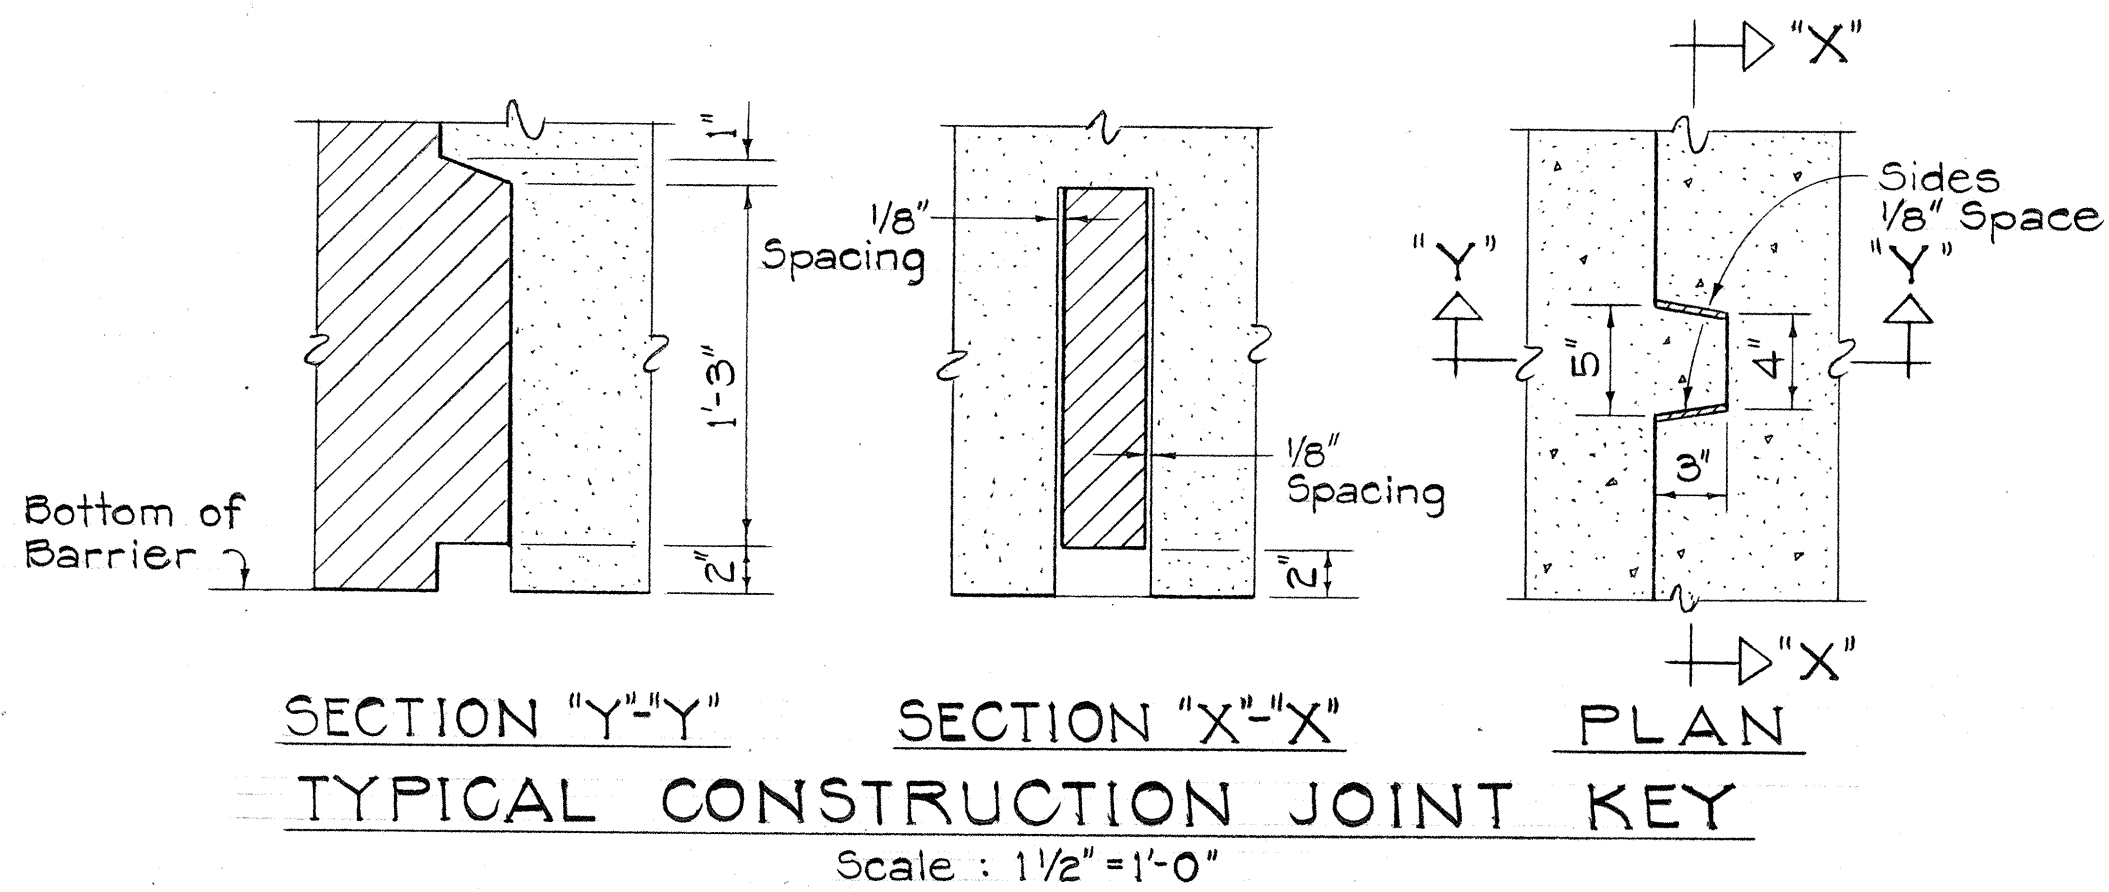


TYPICAL SECTION TYPE "C" CONCRETE BARRIER (SUPERELEVATED SECTION)
Scale: 1" = 1'-0"

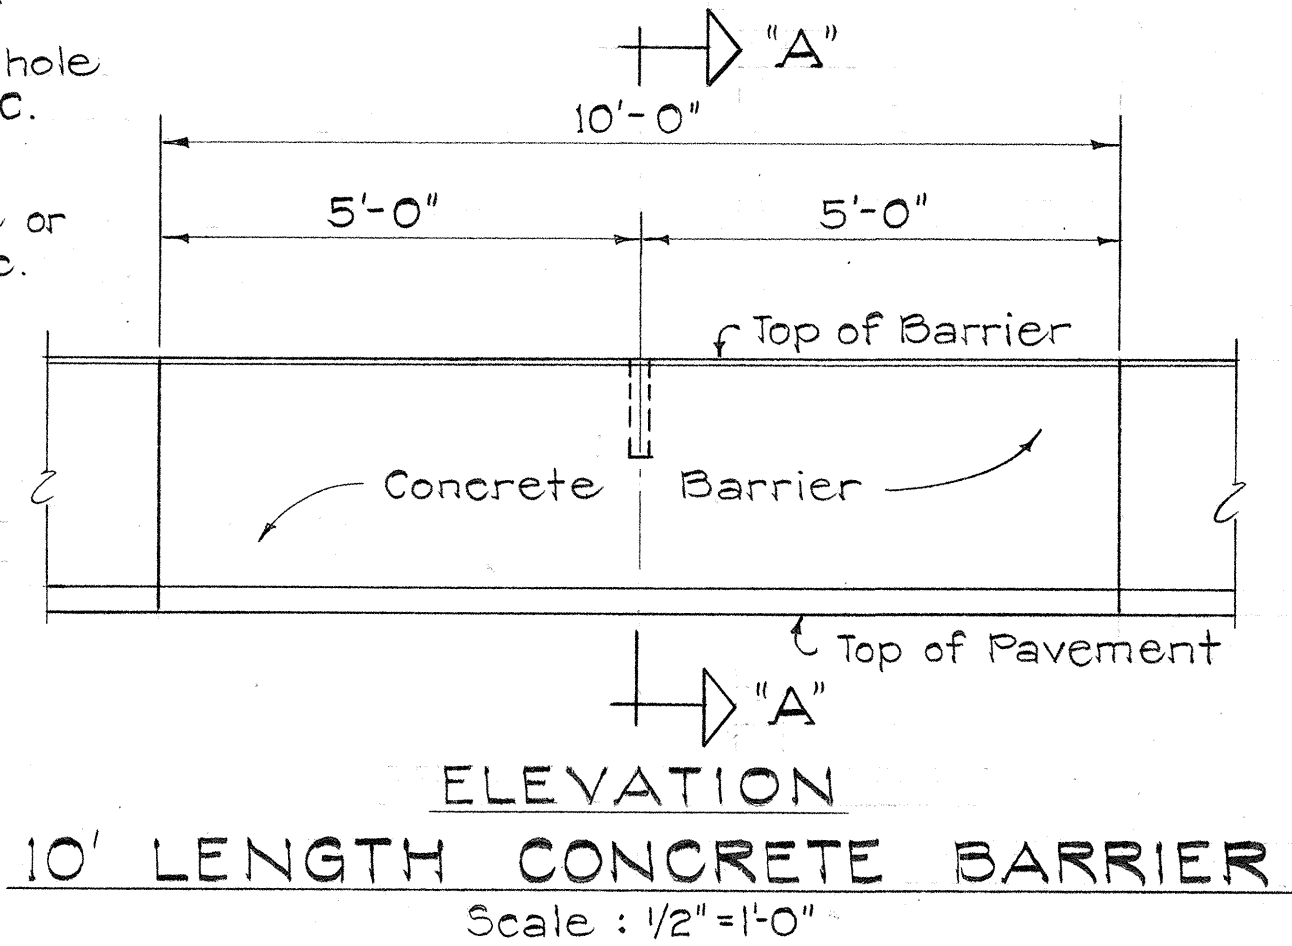

ELEVATION
10' LENGTH CONCRETE BARRIER
Scale: 1/2" = 1'-0"

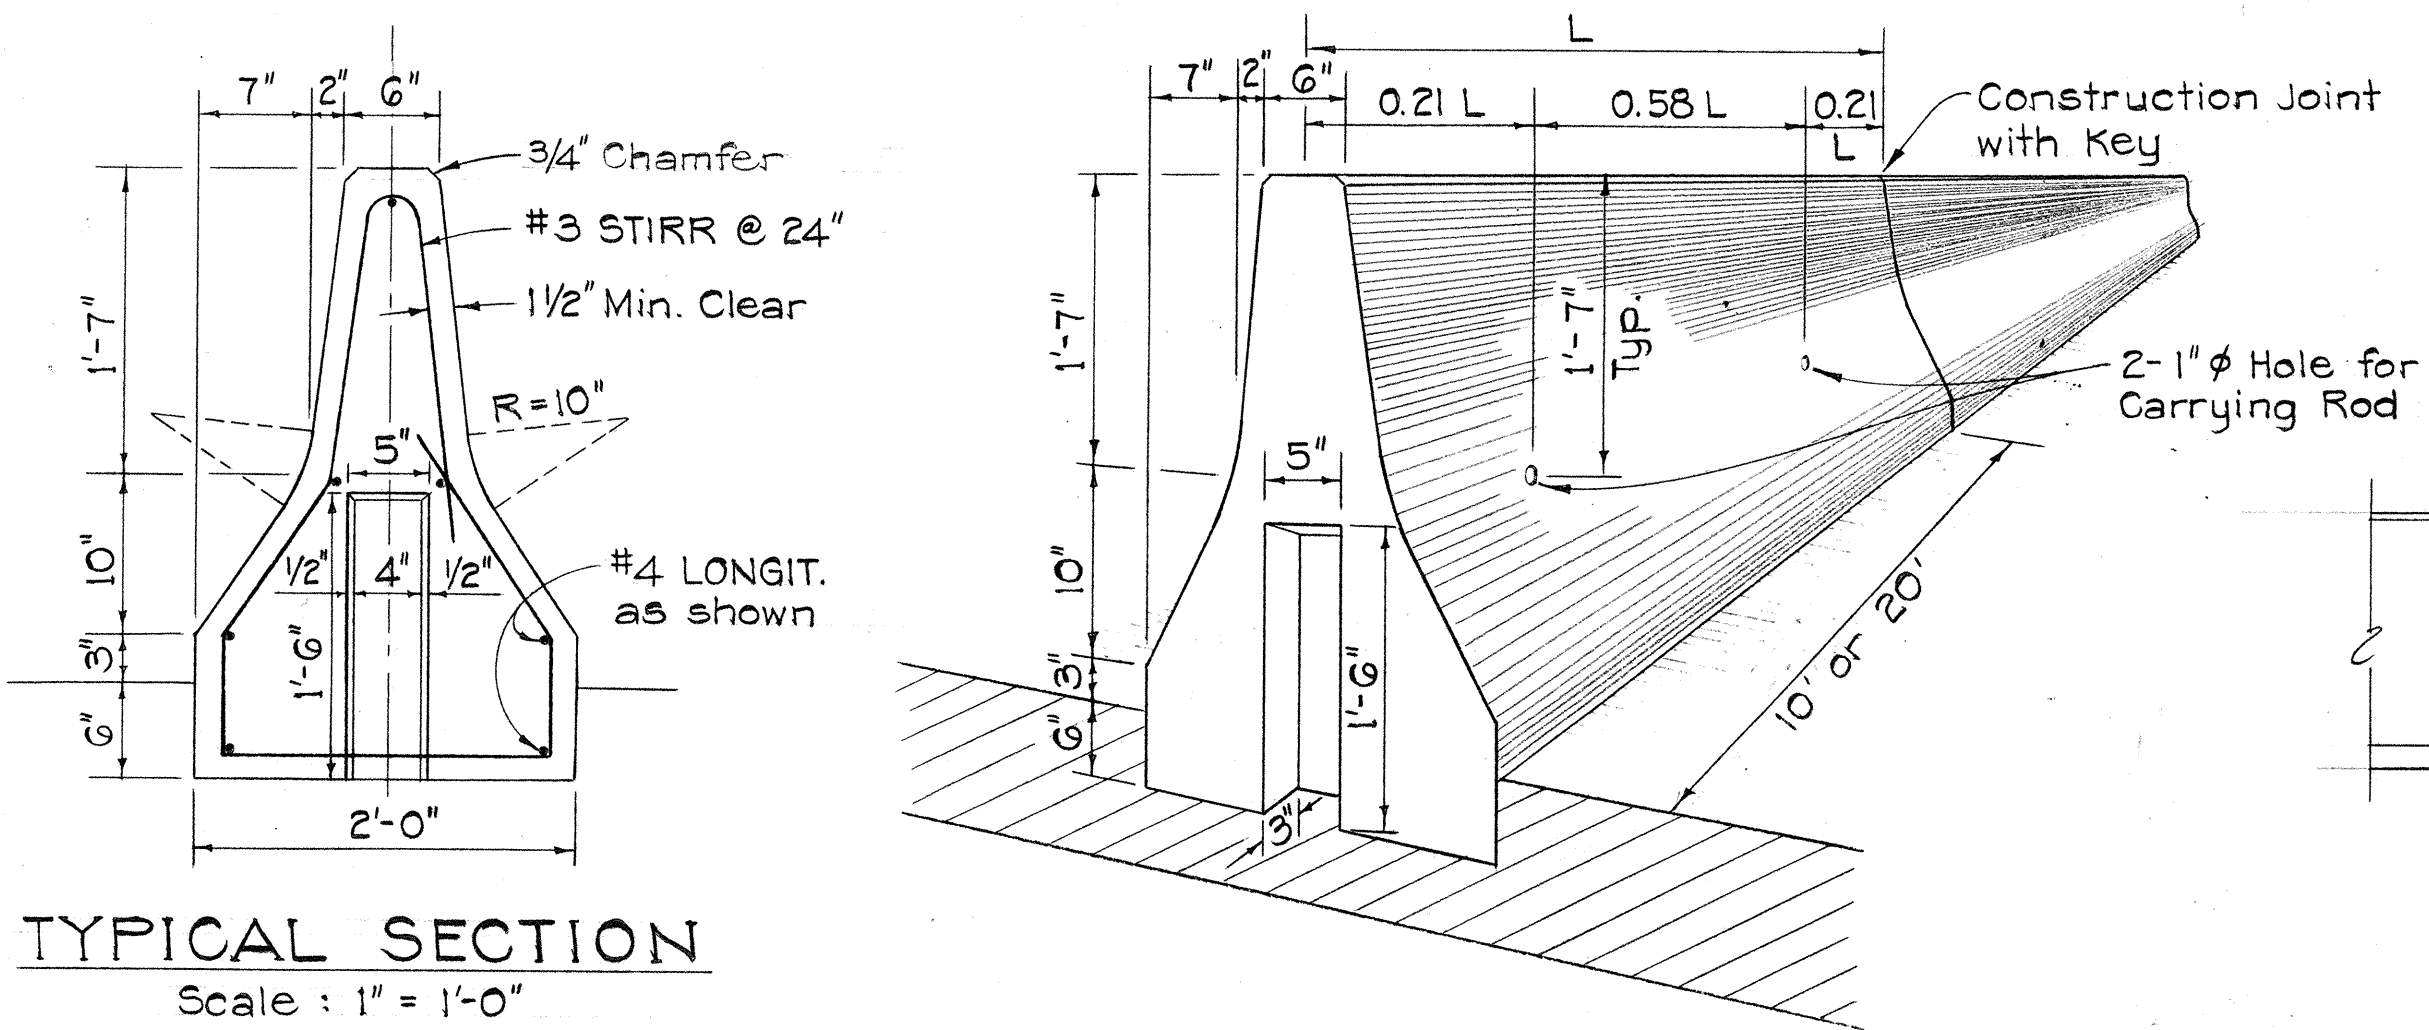

TYPICAL SECTION
Scale: 1" = 1'-0"
DETAILS FOR PRECAST TYPE "C" CONCRETE BARRIER




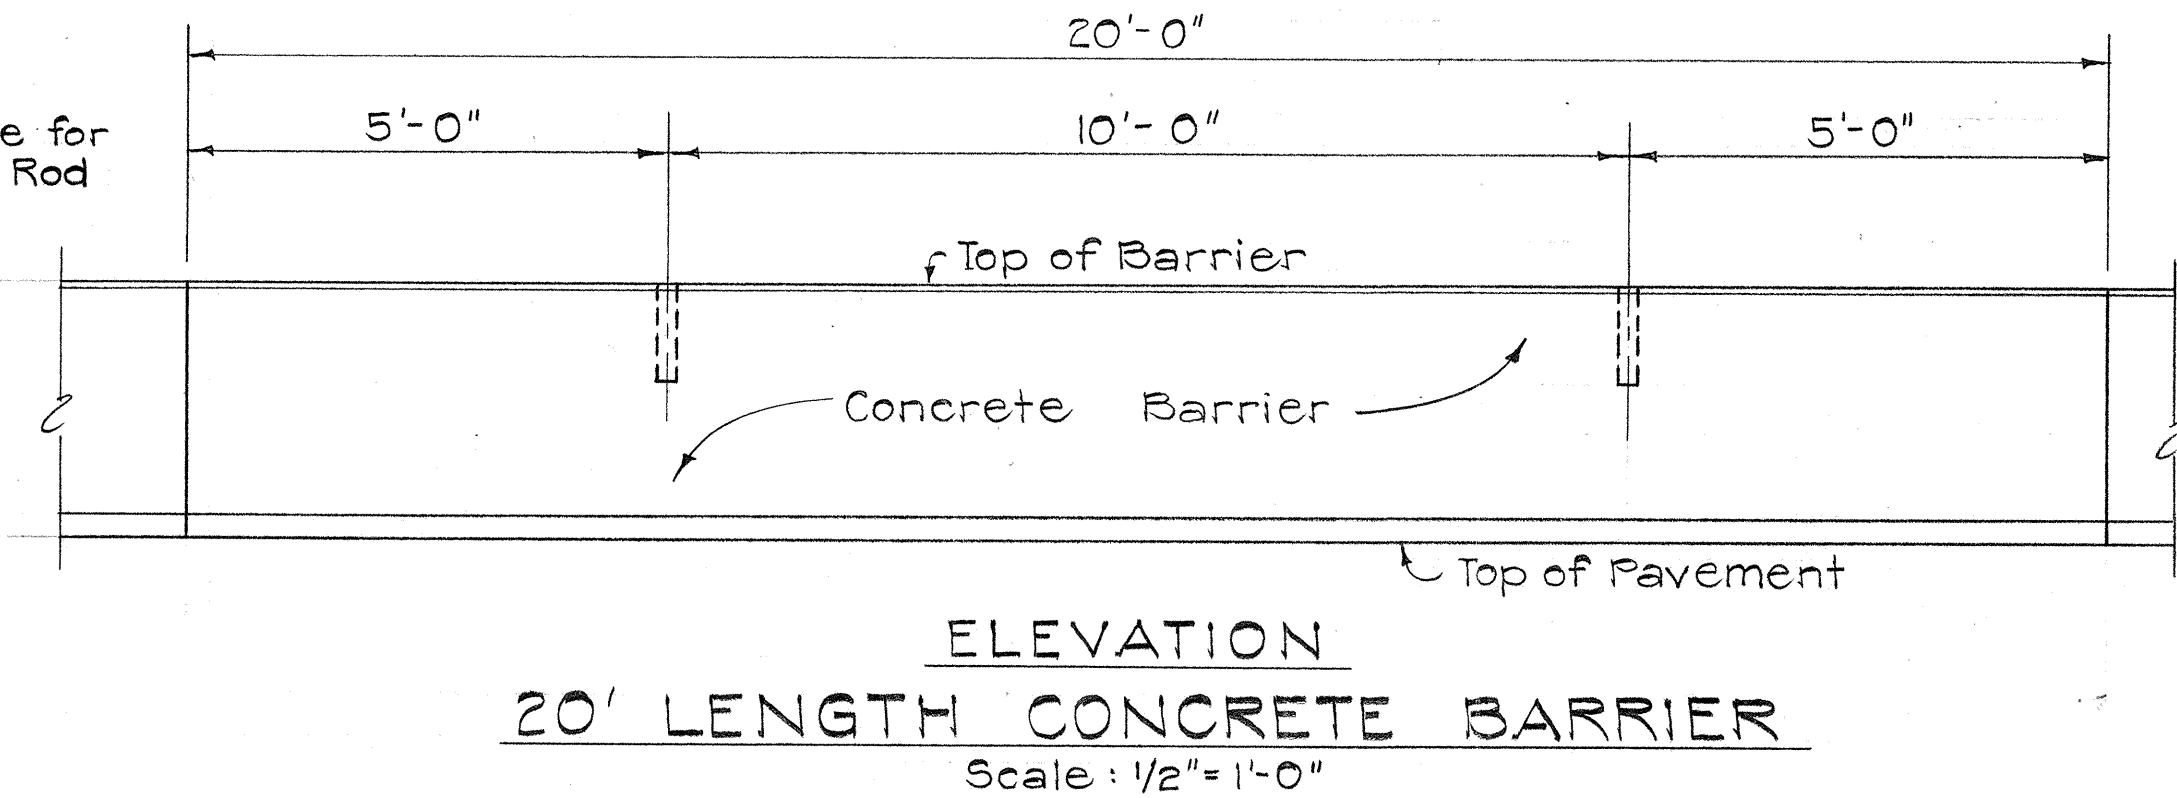


ELEVATION
20' LENGTH CONCRETE BARRIER
Scale: 1/2" = 1'-0"
HOLE SPACING DETAILS FOR CONC. BARRIER



THIS SHEET IS A SUPPLEMENT TO THE CONTRACT DRAWINGS

003951

FED. ROAD DIST. NO.	STATE	FED. AID PROJ. NO.	FISCAL YEAR	SHEET NO.	TOTAL SHEETS
HAWAII	HAW.	I-HI-1(31) Unit I	1968	C03952	292

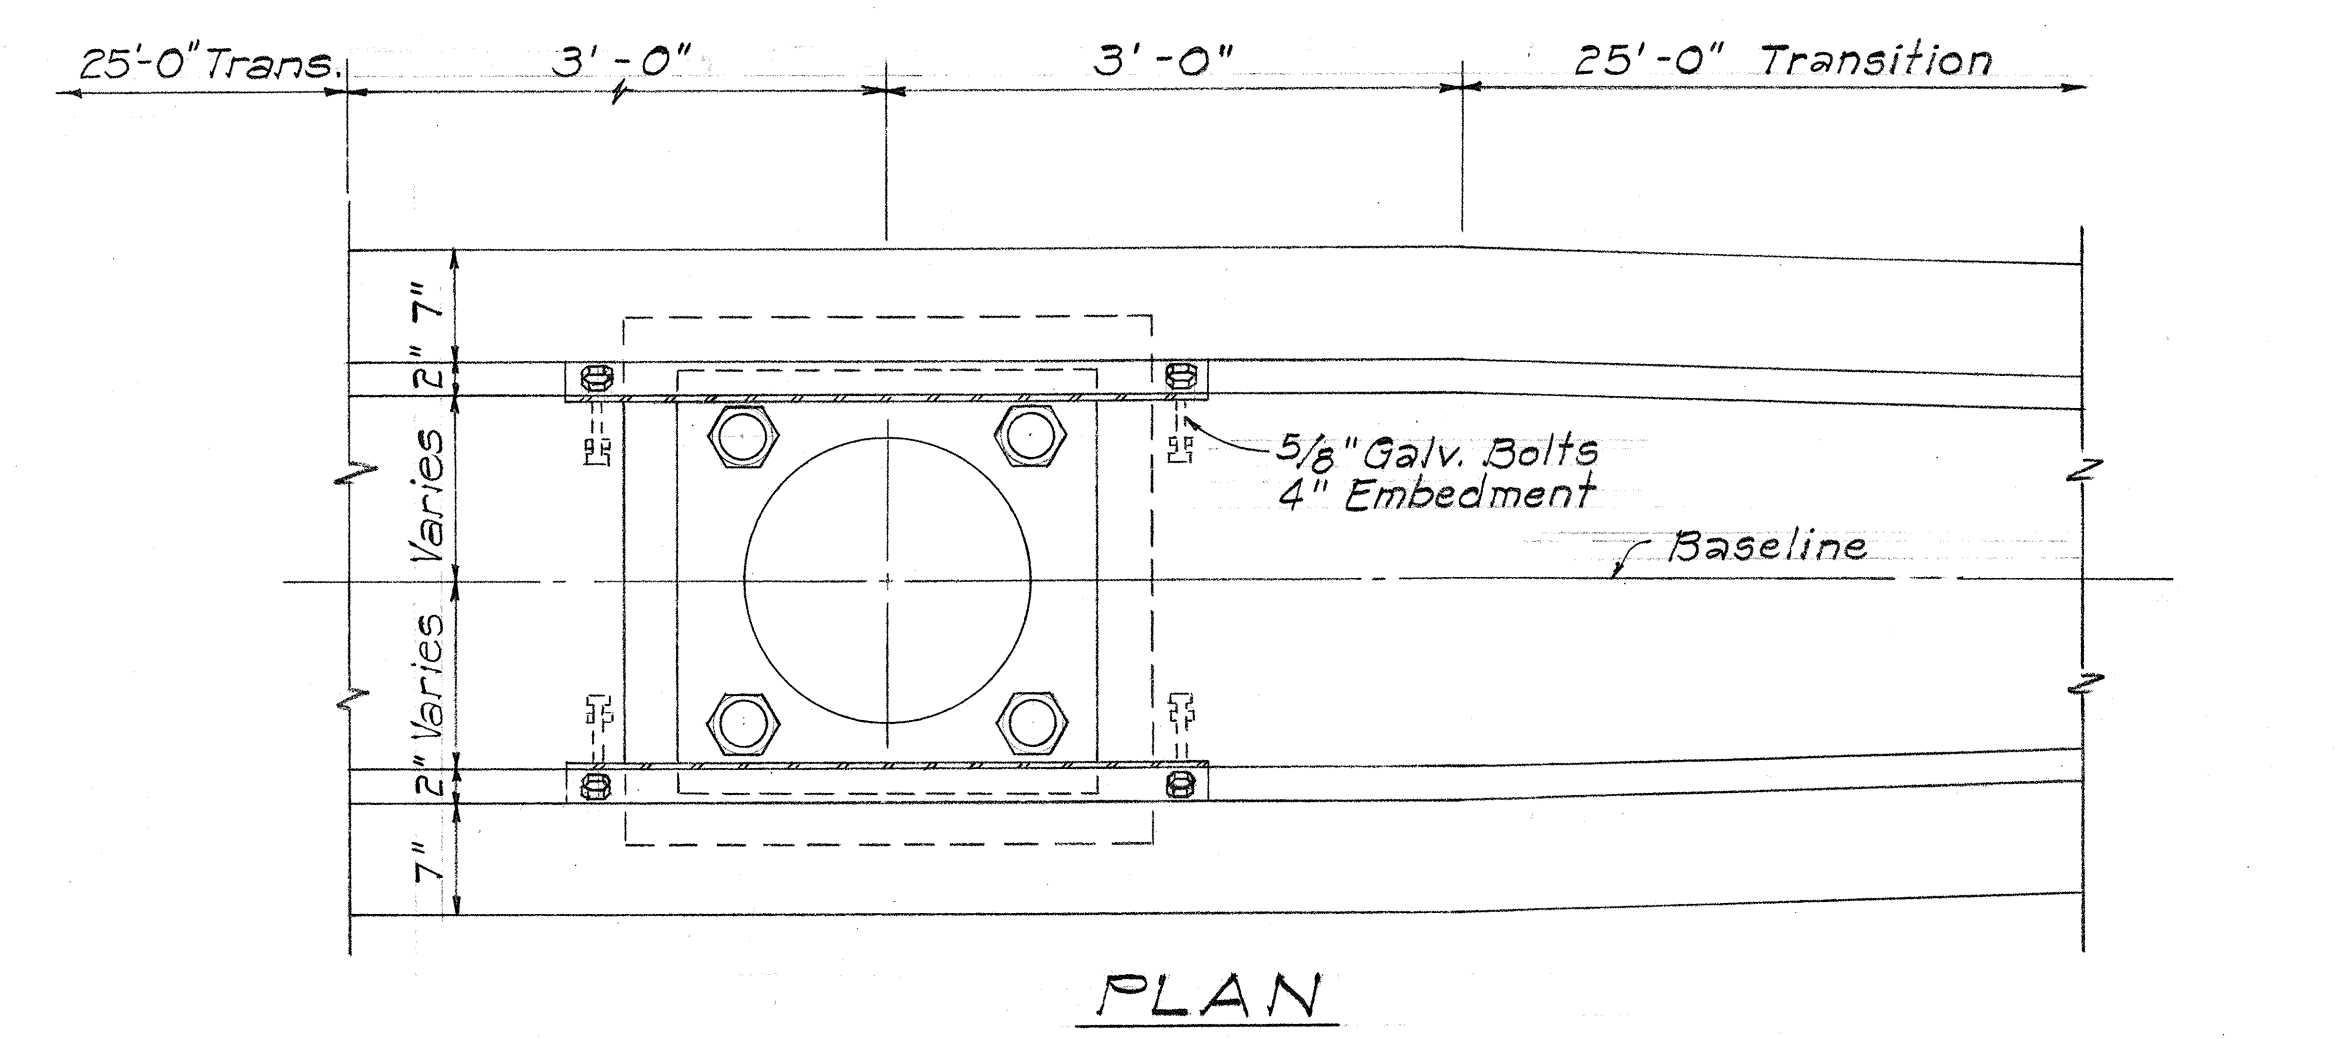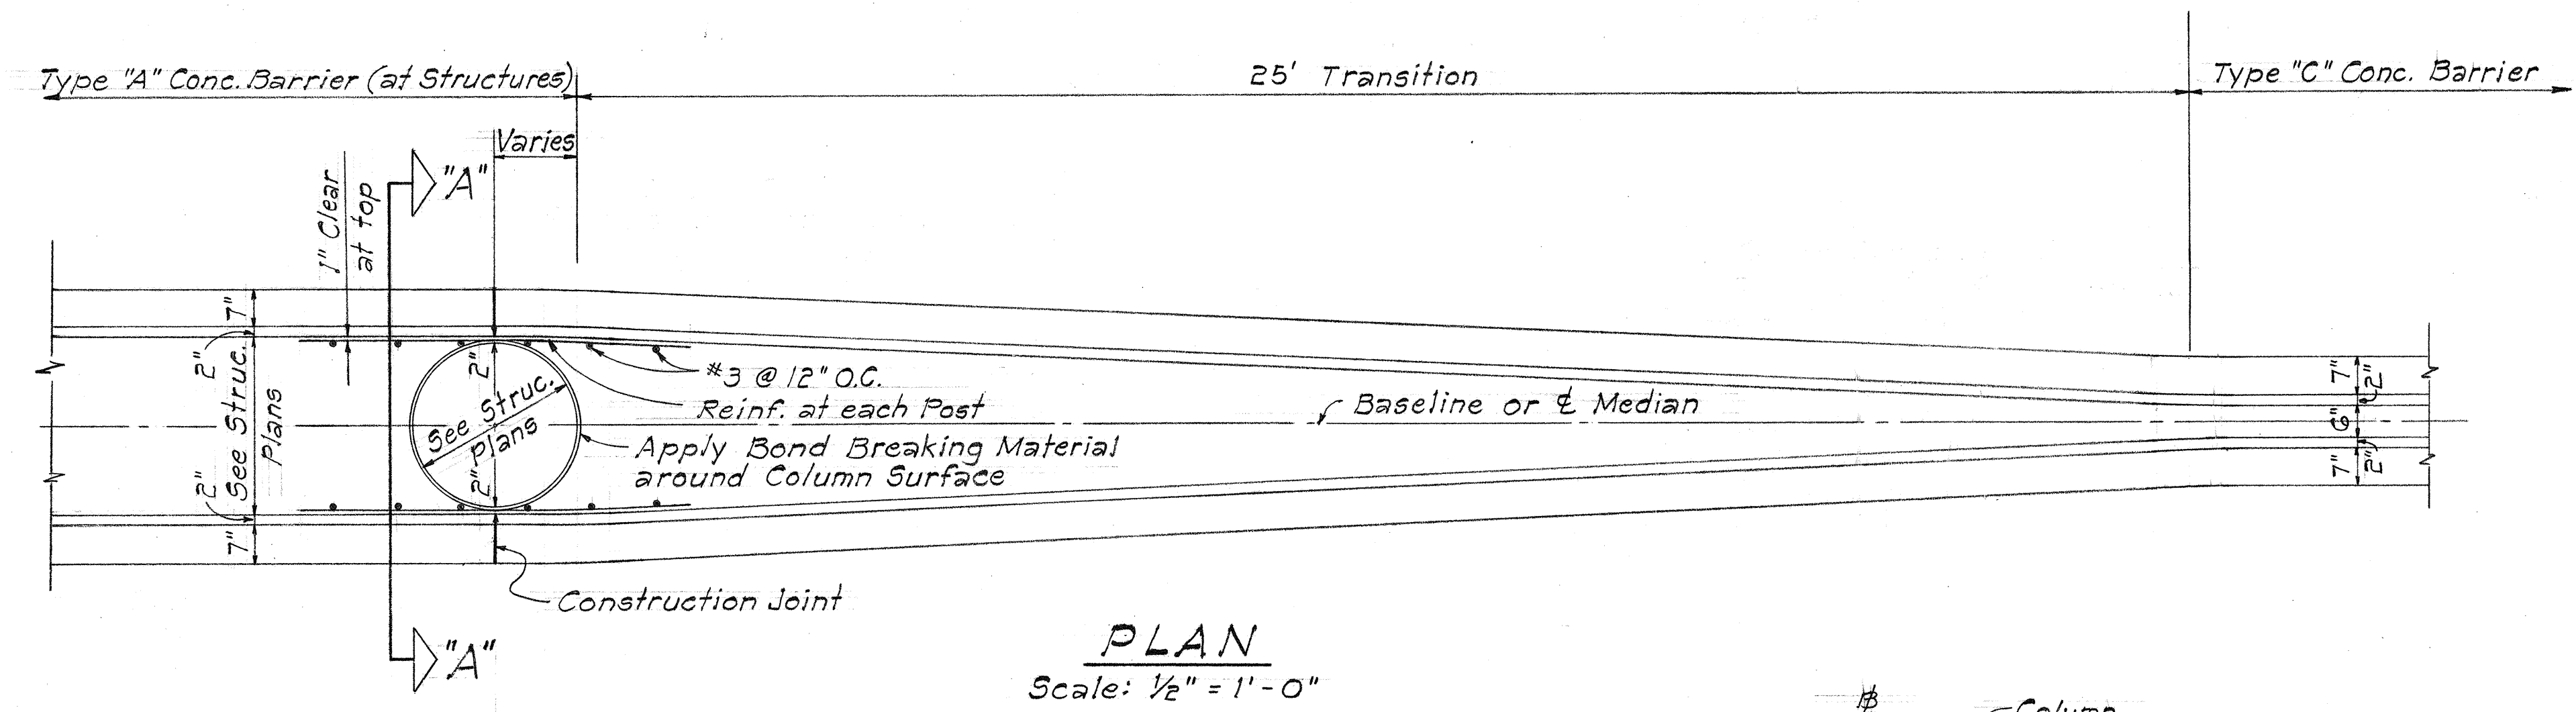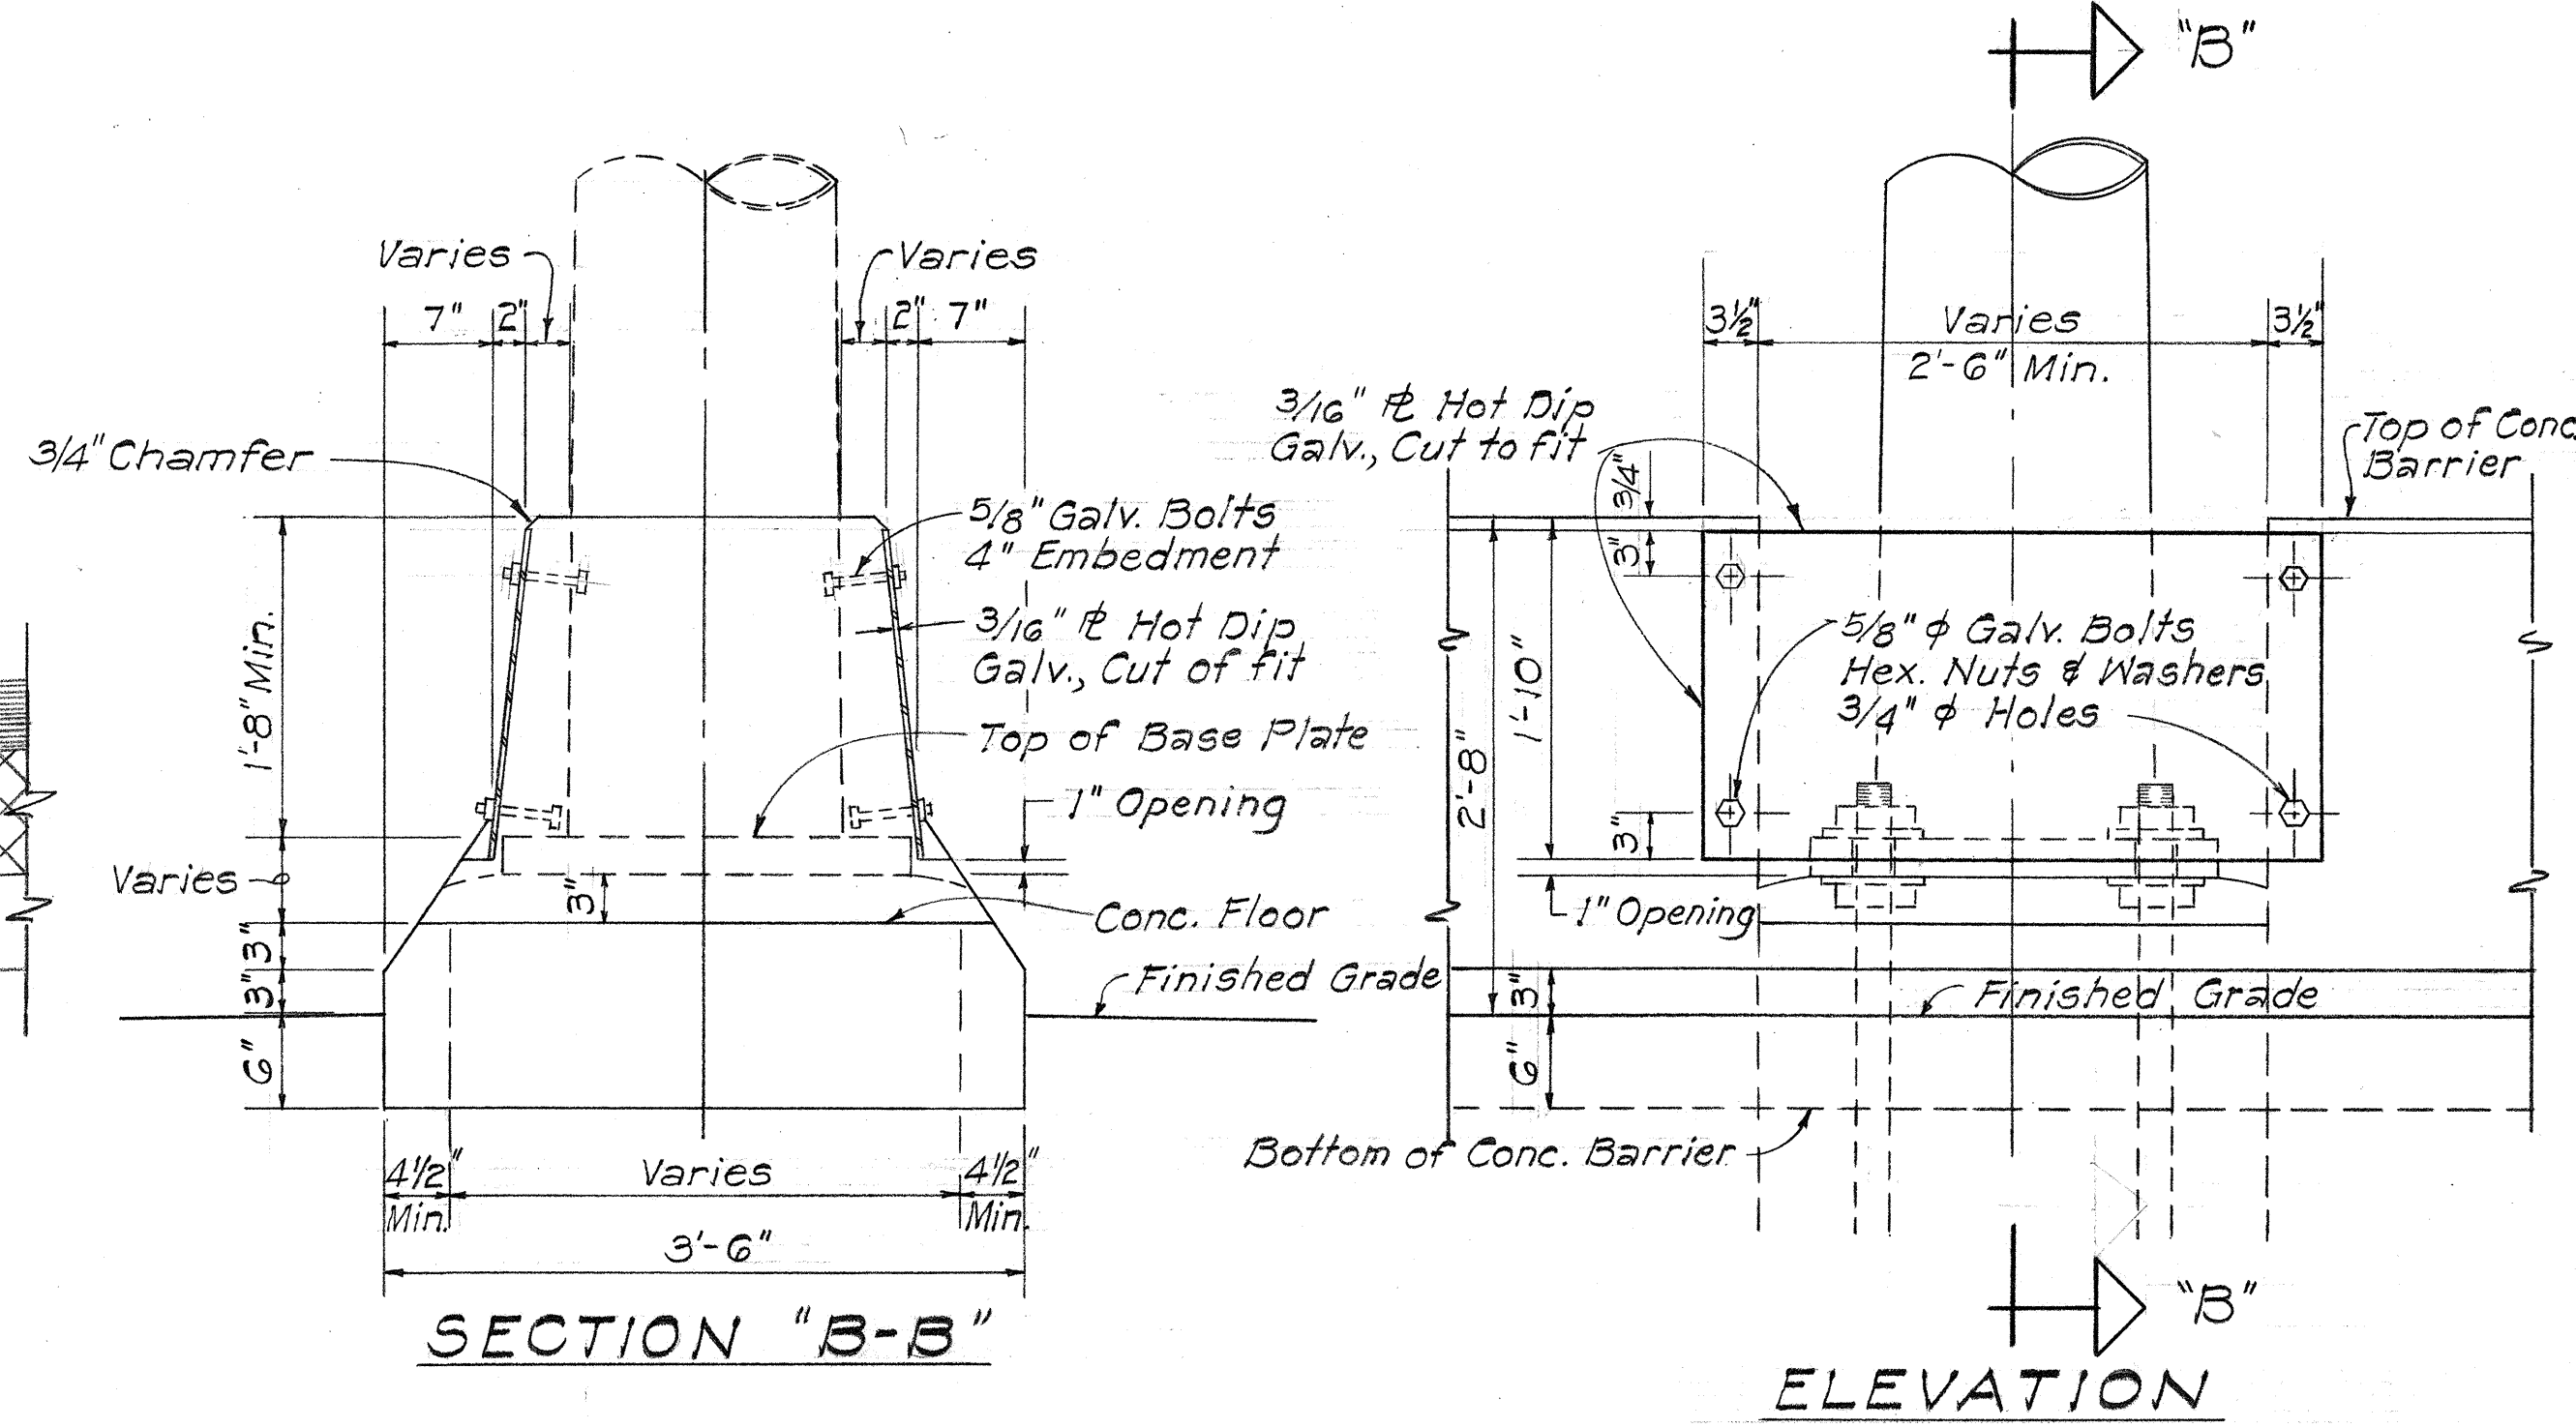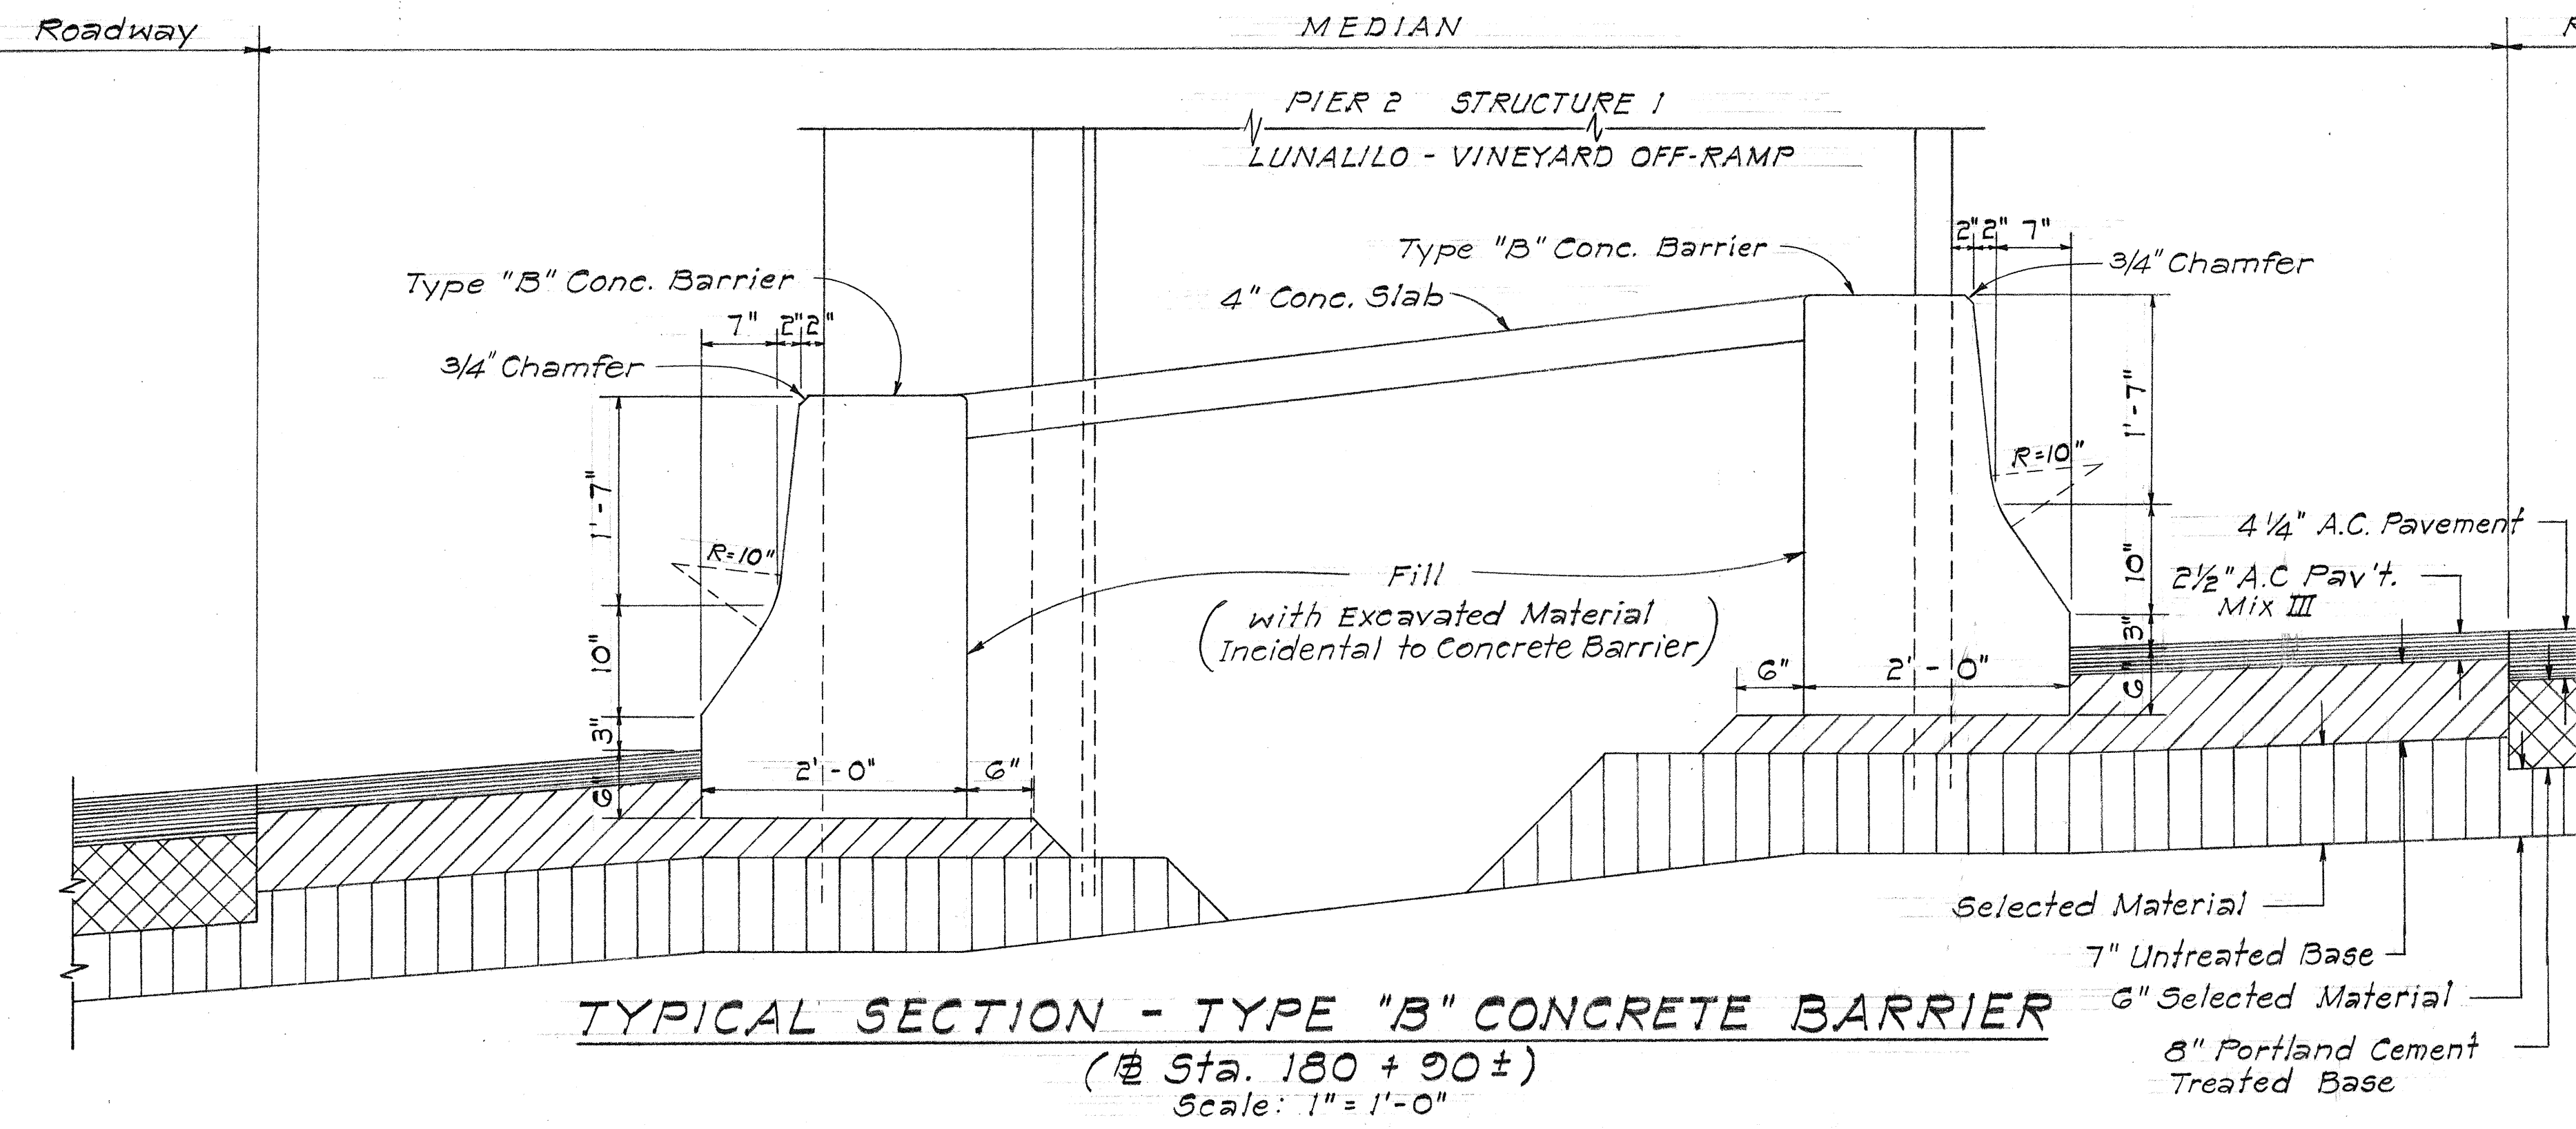

- NOTE:**
1. Constructing Concrete Barrier at Expressway Sign Pole including furnishing and installing steel plate, bolts, nuts and washers shall be considered incidental to Concrete Median Barrier and no extra payment shall be made.
 2. The length of steel plate cover shall be determined in the field.
 3. Refer to PLAN, TYPE "A" CONCRETE BARRIER for transition details of Type "C" Concrete Barrier at Expressway Sign Pole.
 4. Constructing Concrete Barrier at Piers including furnishing and installing reinforcing steel shall be considered incidental to Concrete Median Barrier and no extra payment shall be made.

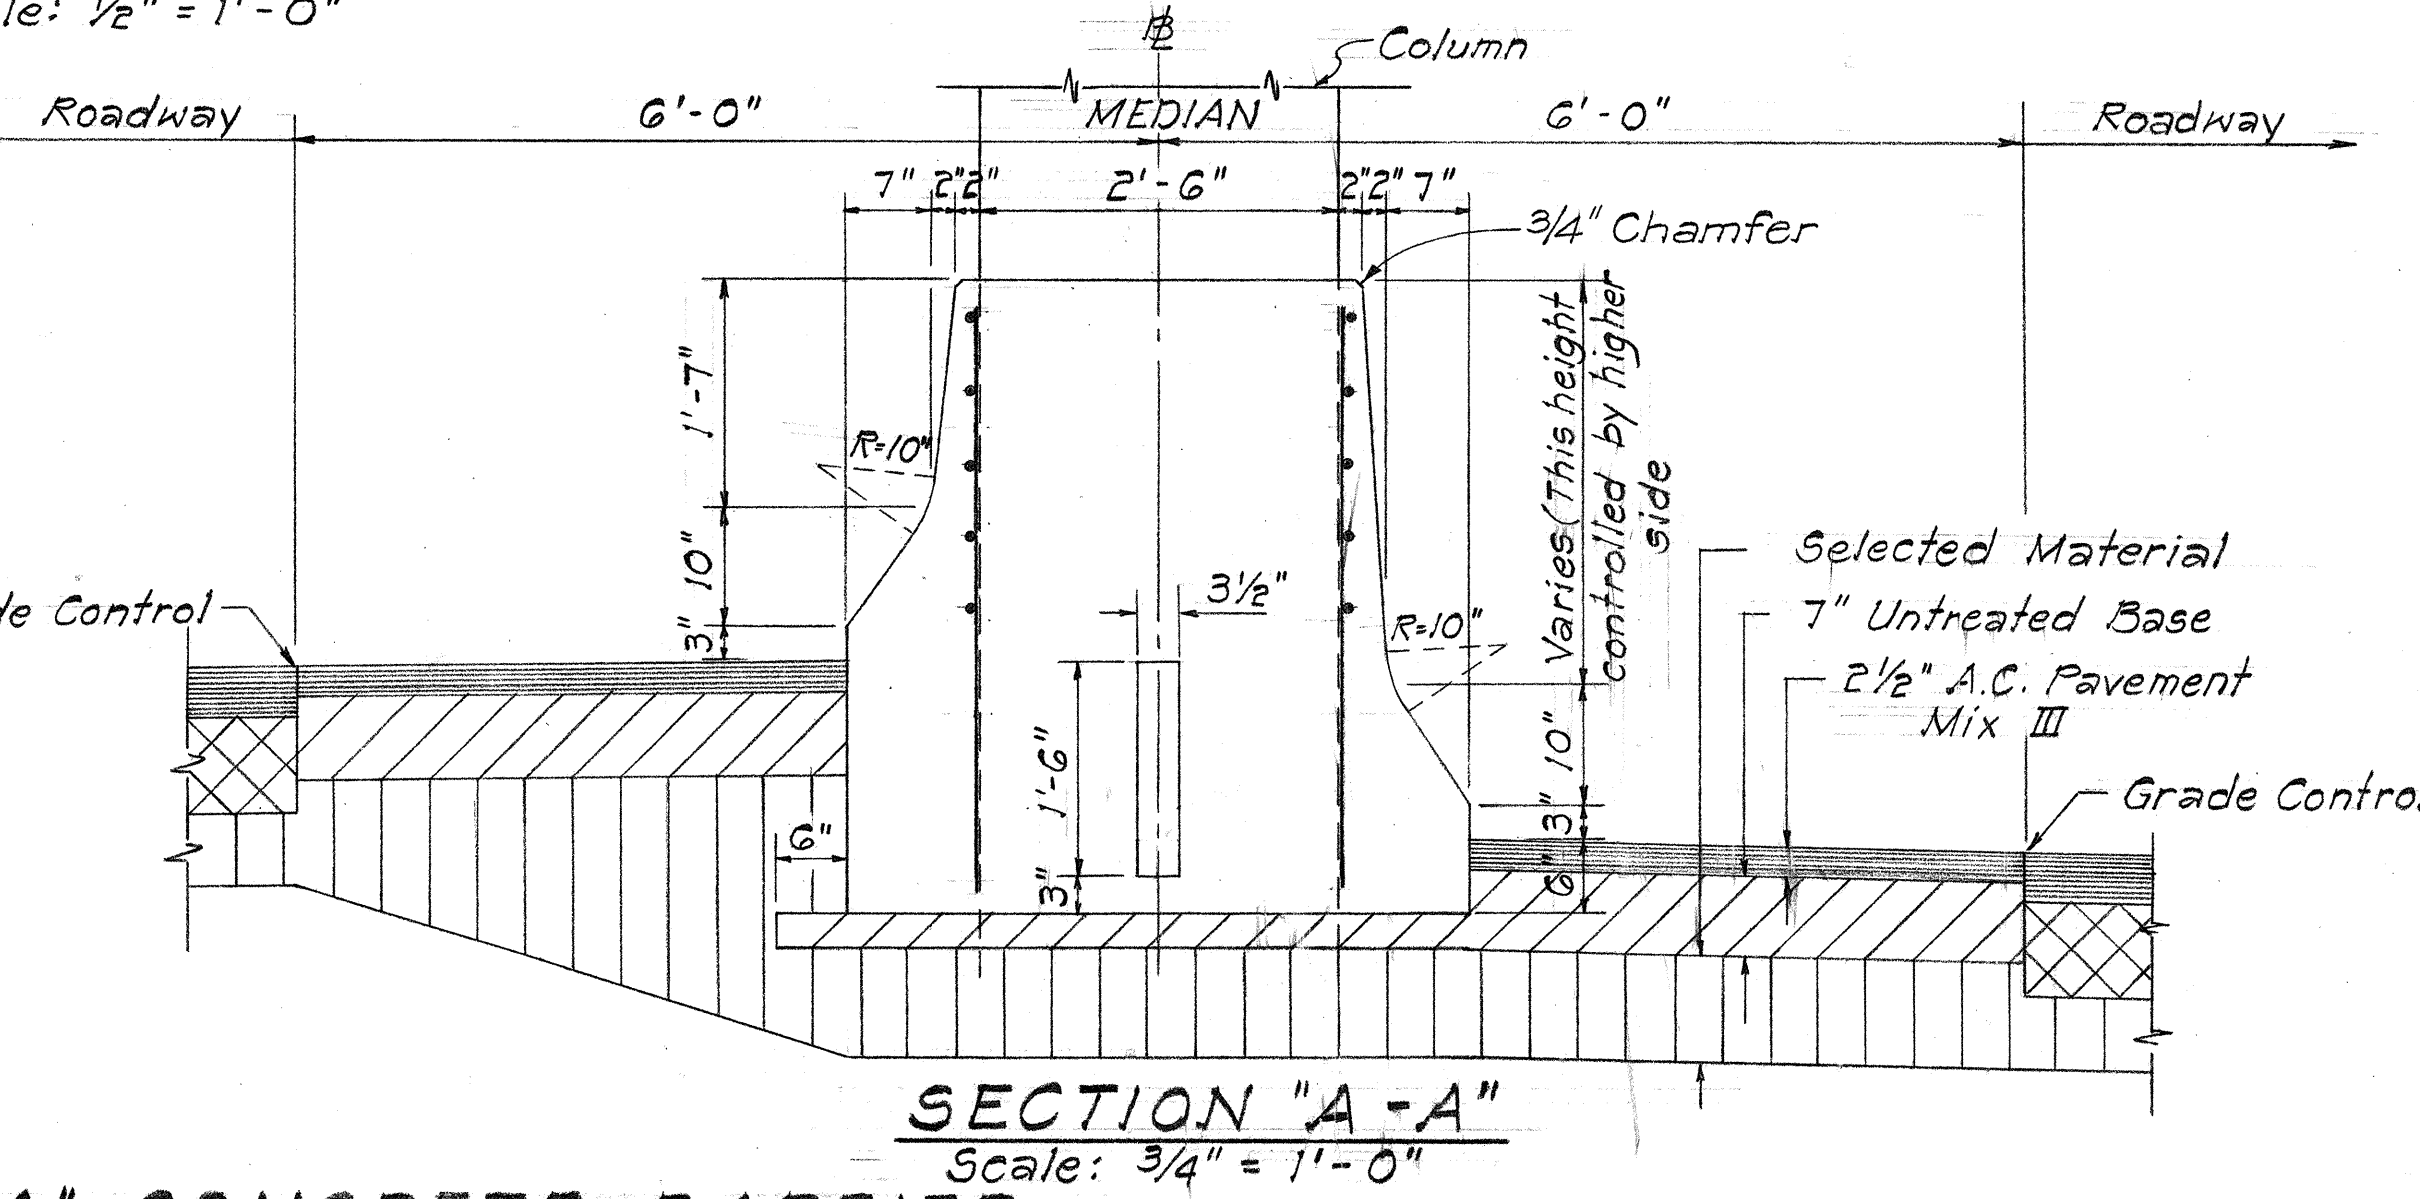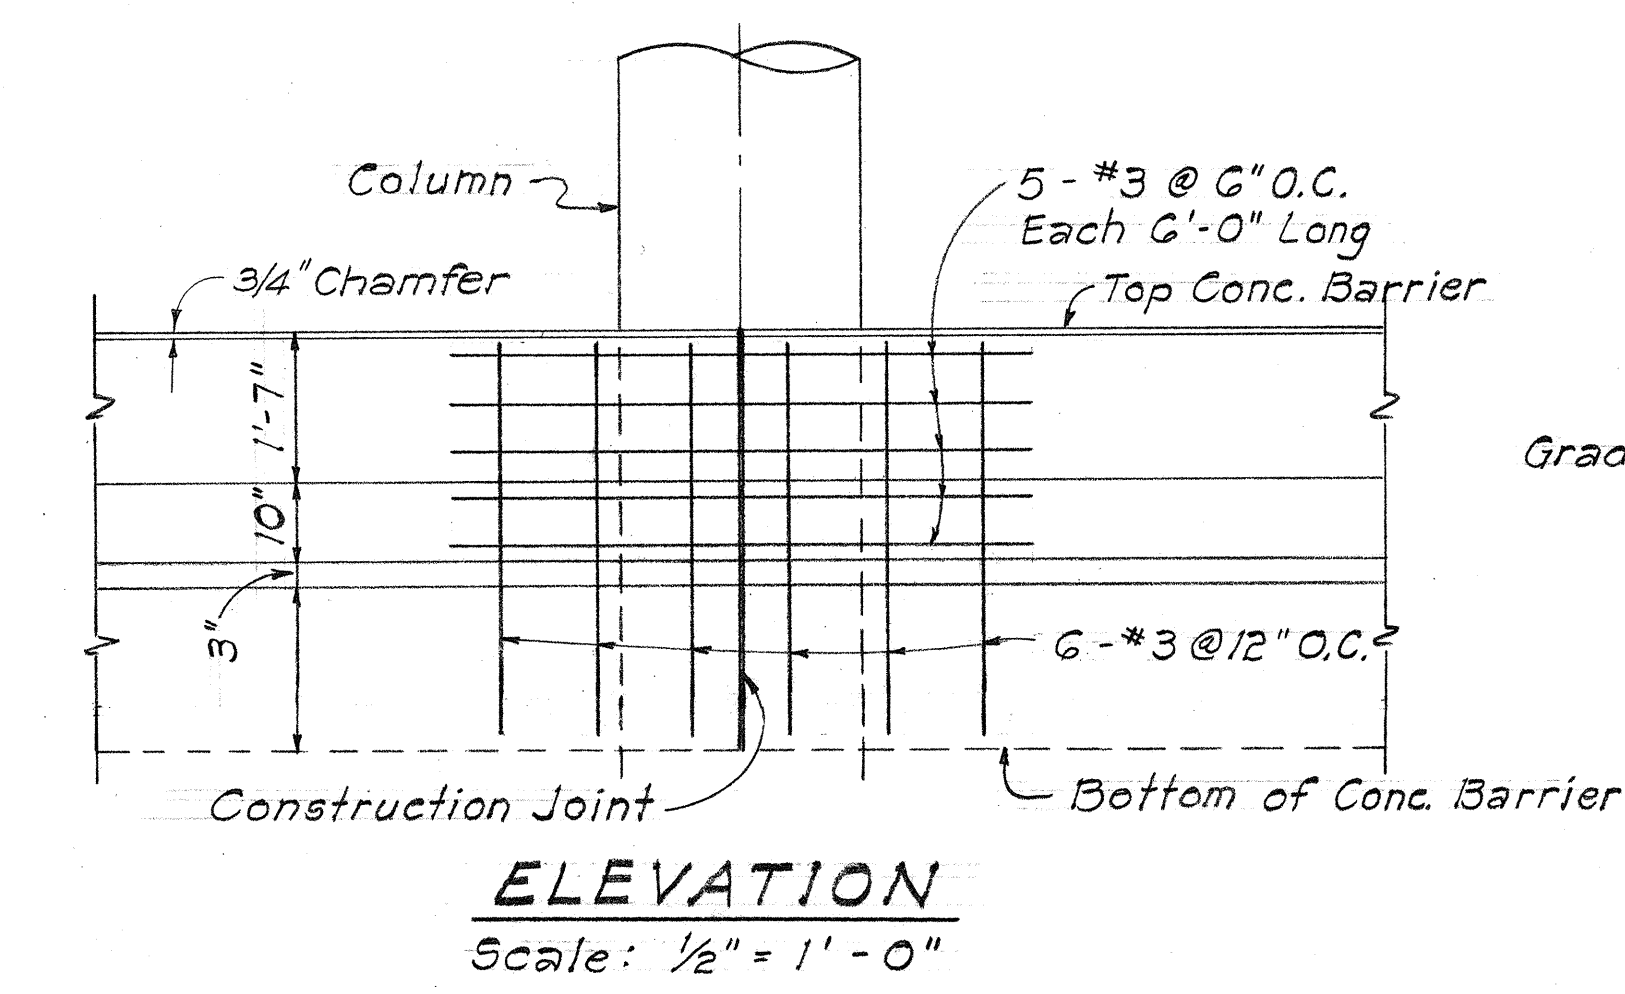

TYPE "A" CONCRETE BARRIER

THIS SHEET IS A SUPPLEMENT
 TO THE CONTRACT DRAWINGS

STATE OF HAWAII
 DEPARTMENT OF TRANSPORTATION
 HIGHWAYS DIVISION

CONCRETE MEDIAN BARRIER

INTERSTATE ROUTE H-1
 (LUNALILO FREEWAY)
 Pele Street to Victoria Street
 F.A.I. Proj. No. I-HI-1(31), Unit I



Scale: As Shown Date: Aug., 1968

SHEET No. OF SHEETS

DATE	_____
SURVEY PLOTTED BY	_____
DRAWN BY	_____
DESIGNED BY	_____
NOTED BY	_____
CHECKED BY	_____
ORIGINAL PLAN	_____
NOTE BOOK	_____
NO.	_____

FED. ROAD DIST. NO.	STATE	FED. AID PROJ. NO.	FISCAL YEAR	SHEET NO.	TOTAL SHEETS
HAWAII	HAW.	1-HH(31) UNIT 1	1967	603953	292



REVISED: 12-11-66
REVISED: 2-24-67

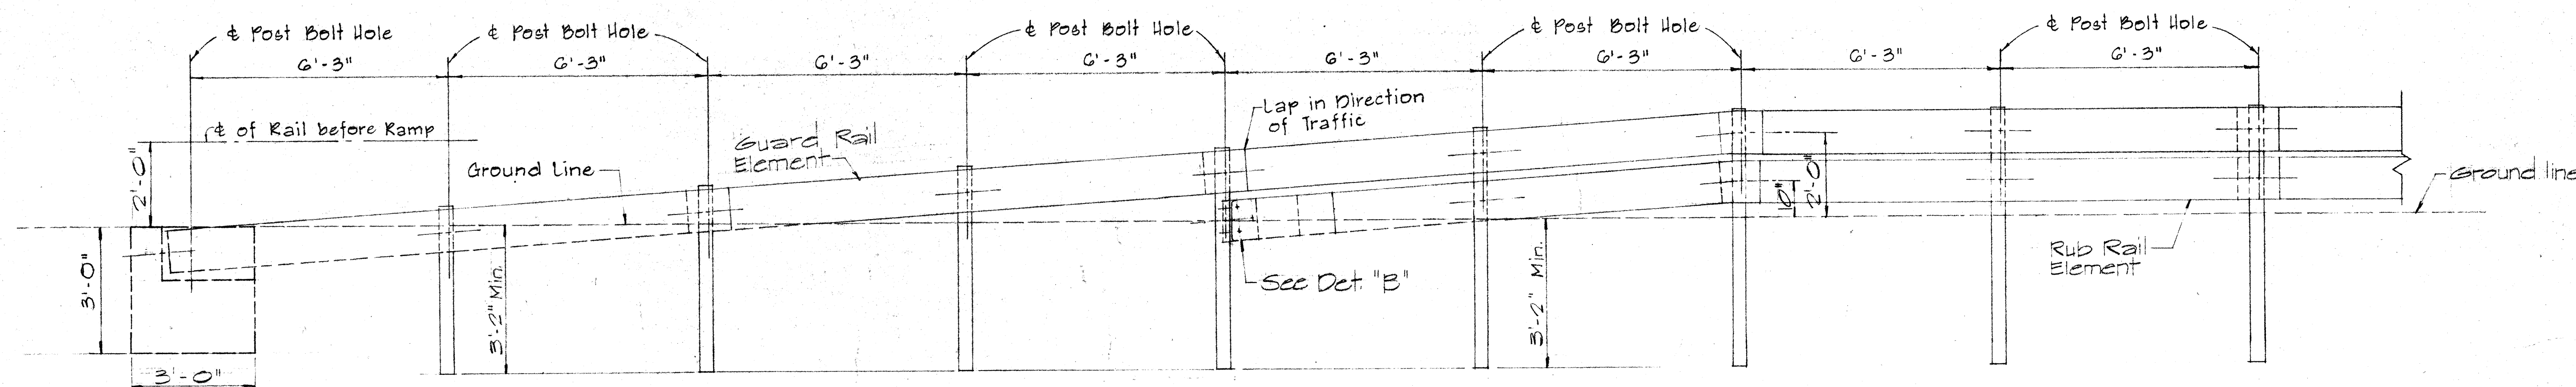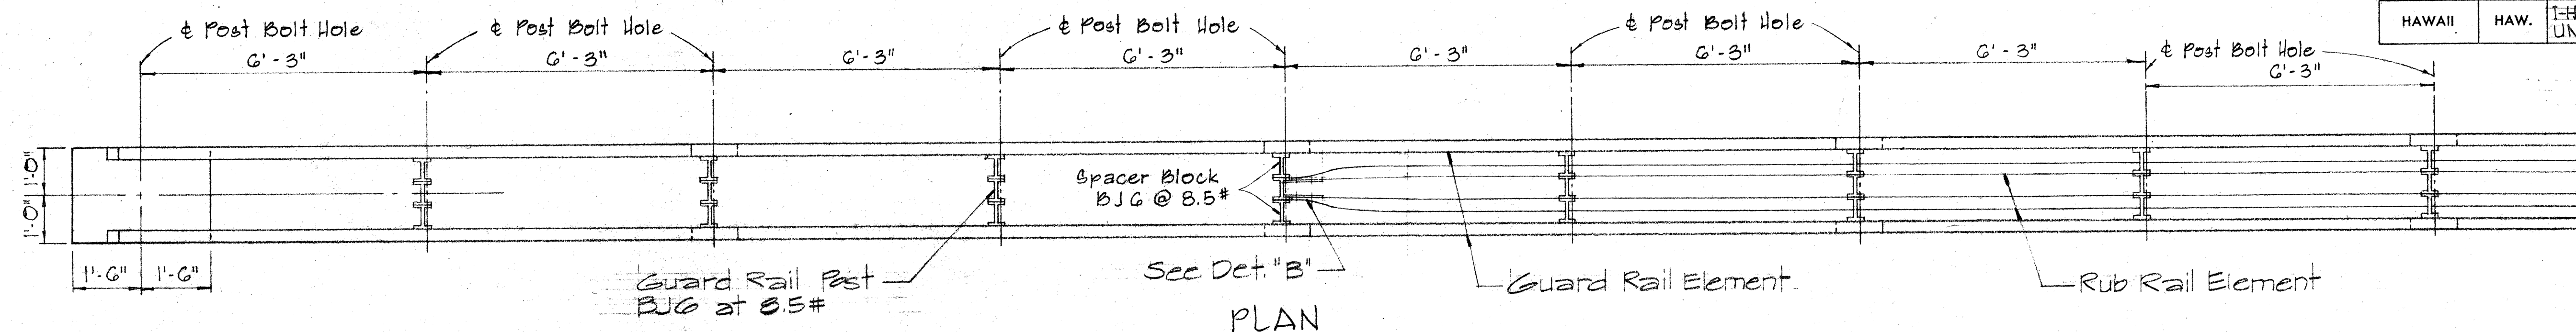

STRAIGHT APPROACH - RAMP END ANCHORAGE (MEDIAN)


Scale: 1/2" = 1'-0"

5/8" Bolts with 3/4" G.I. Pipe Sleeve in each hole. Incidental to Metal Guard Rail. All Metal Pieces shall be Galvanized.

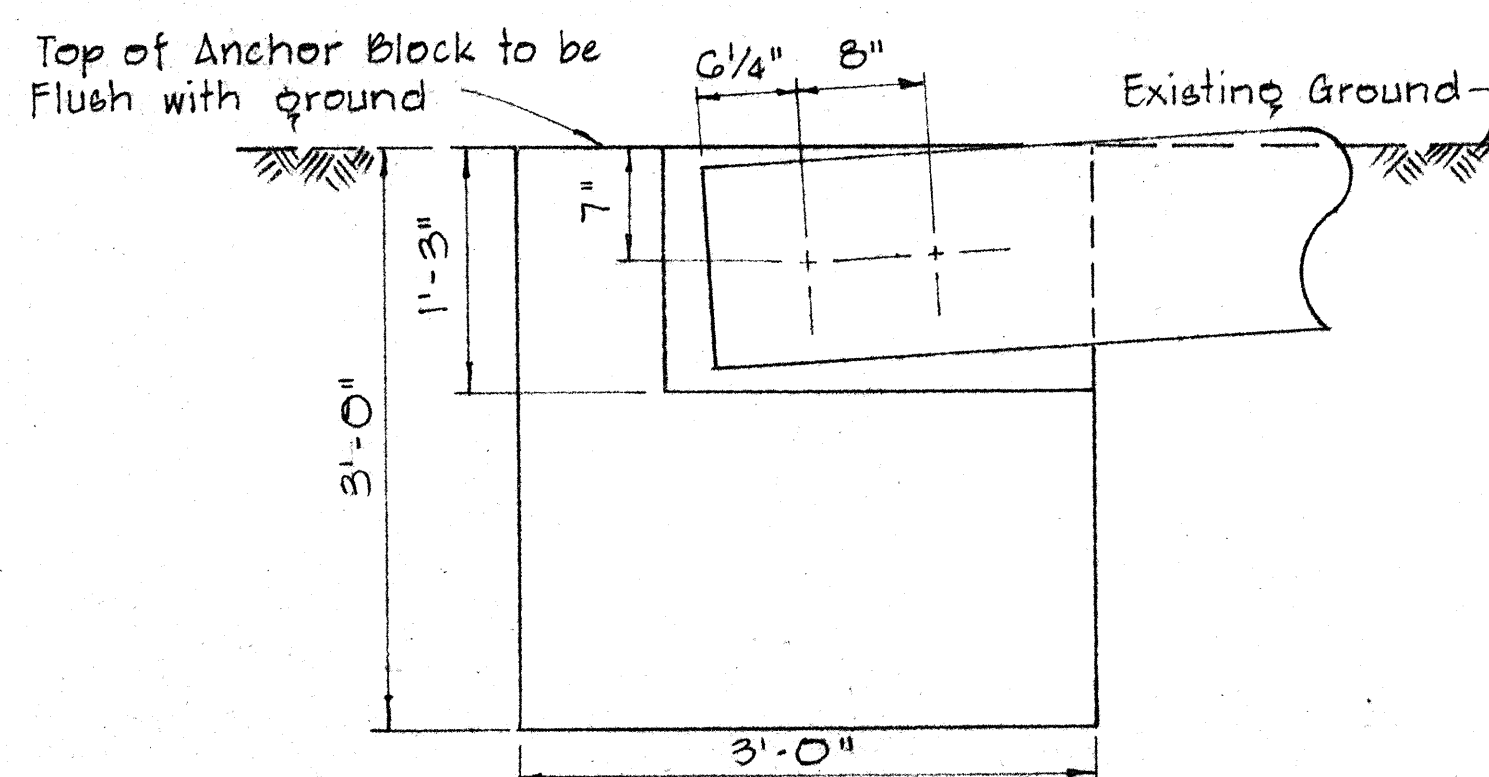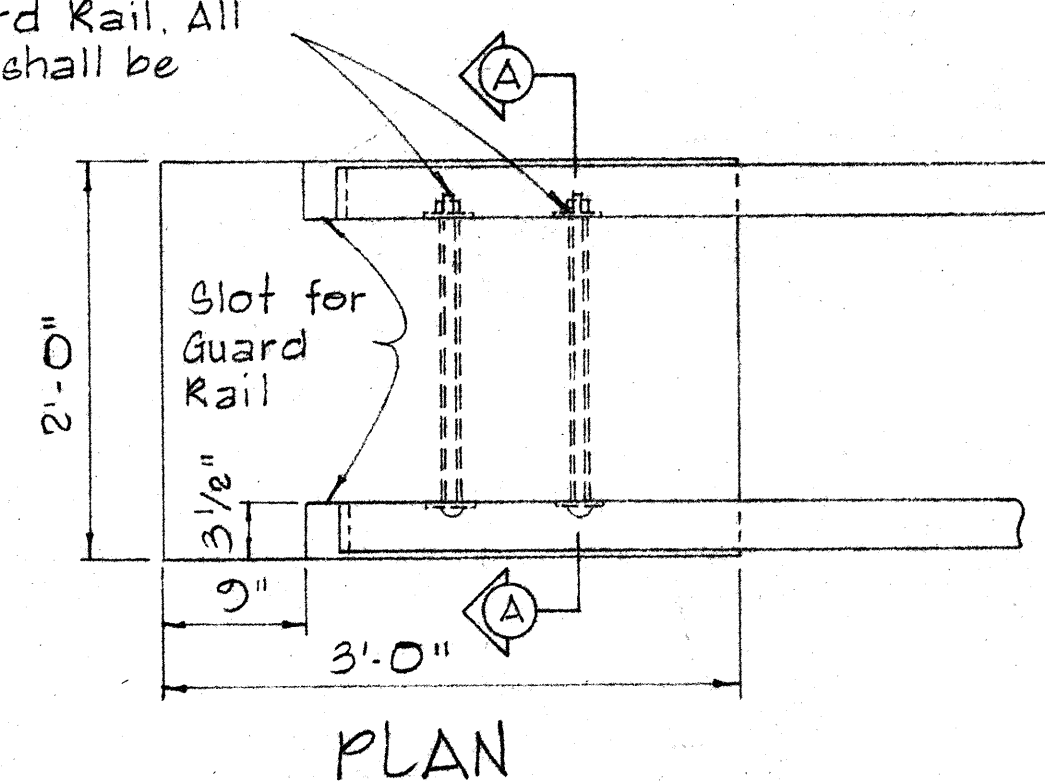


CONCRETE ANCHOR BLOCK FOR RAMP END


Scale: 1" = 1'-0"

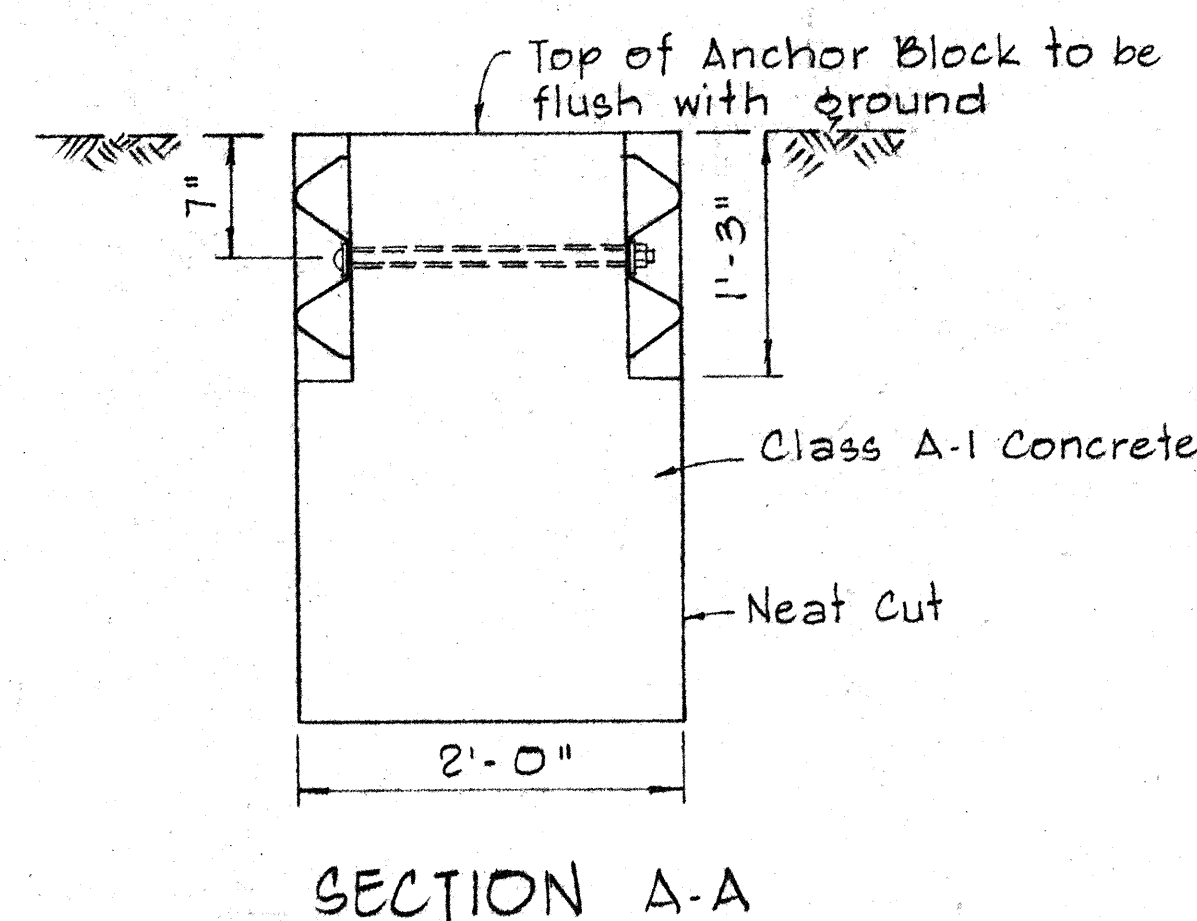

NOTE: Concrete, Excavation, and Miscellaneous Appurtenances necessary to anchor the Guard Rail Ends, shall be incidental to the Metal Guard Rail.

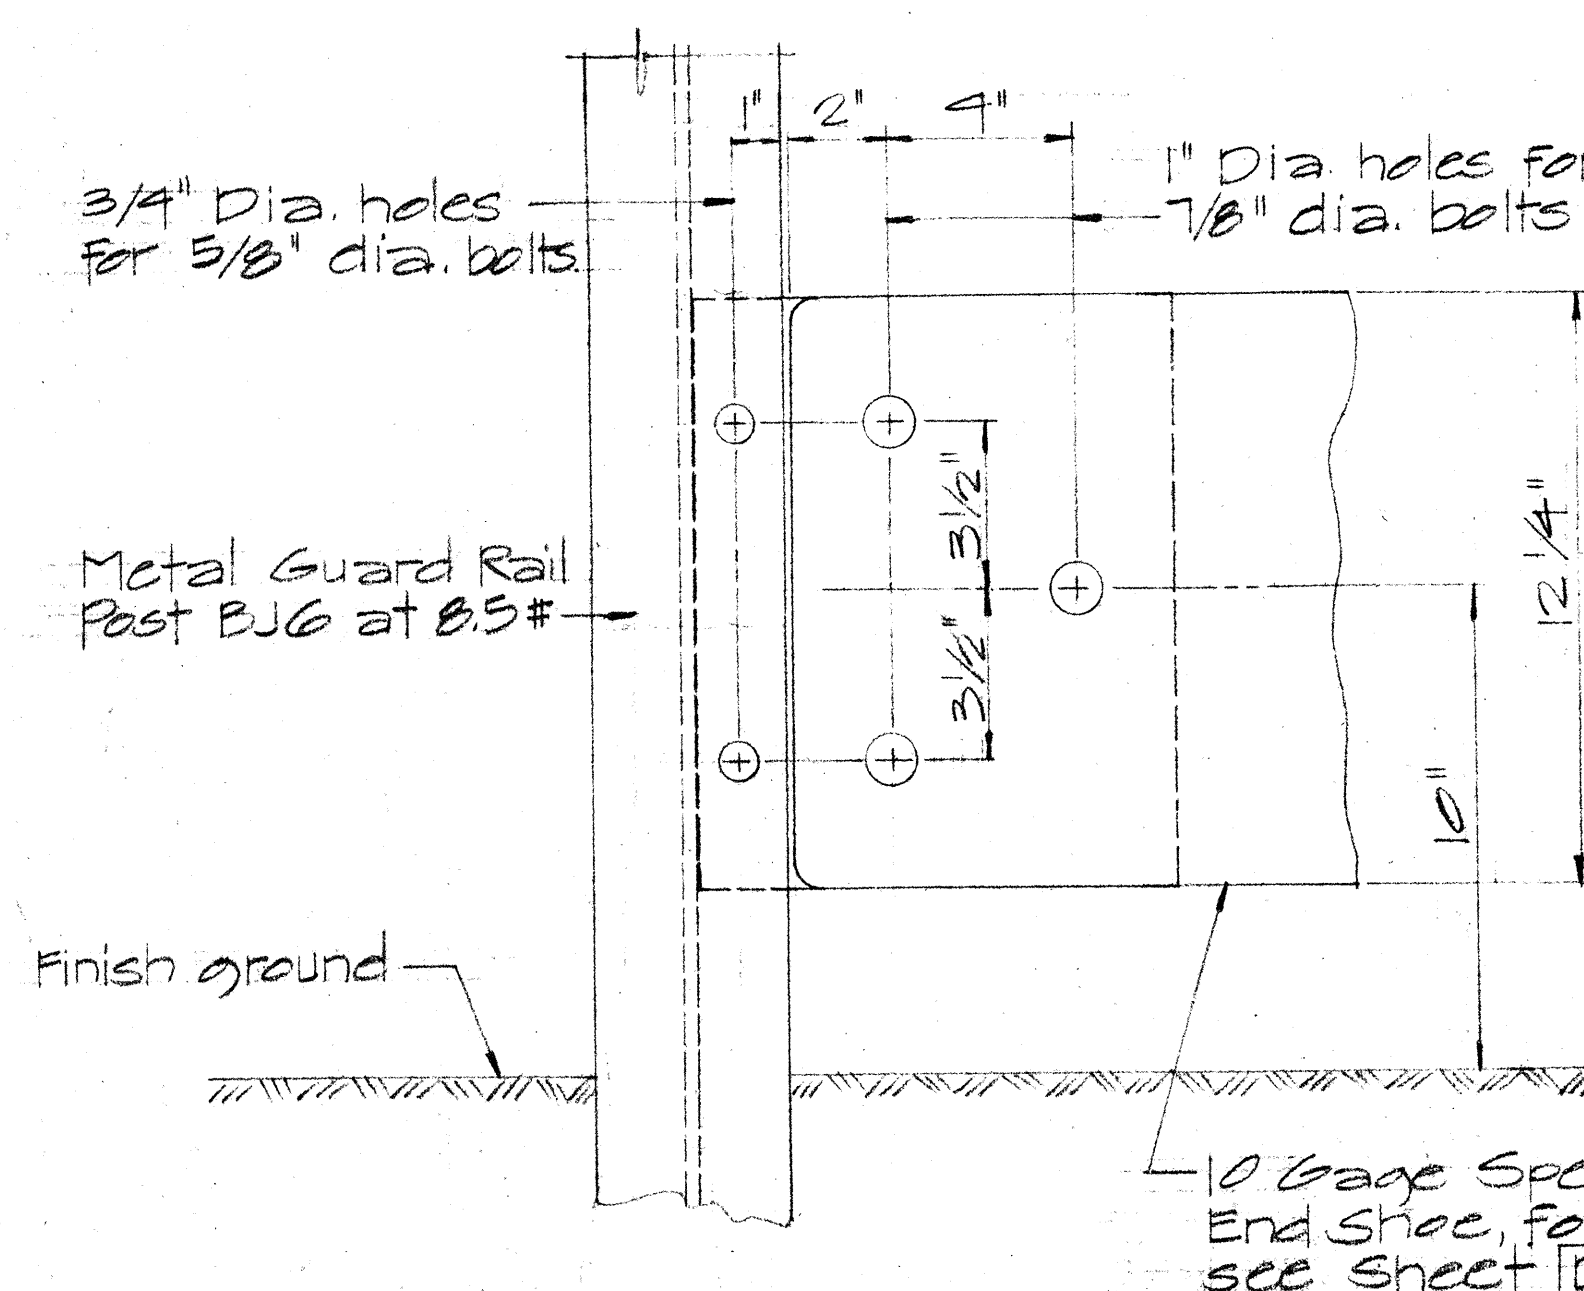

NOTE: All Shoe Assembly, including anchor bolts, nuts, and washers, shall be galvanized.

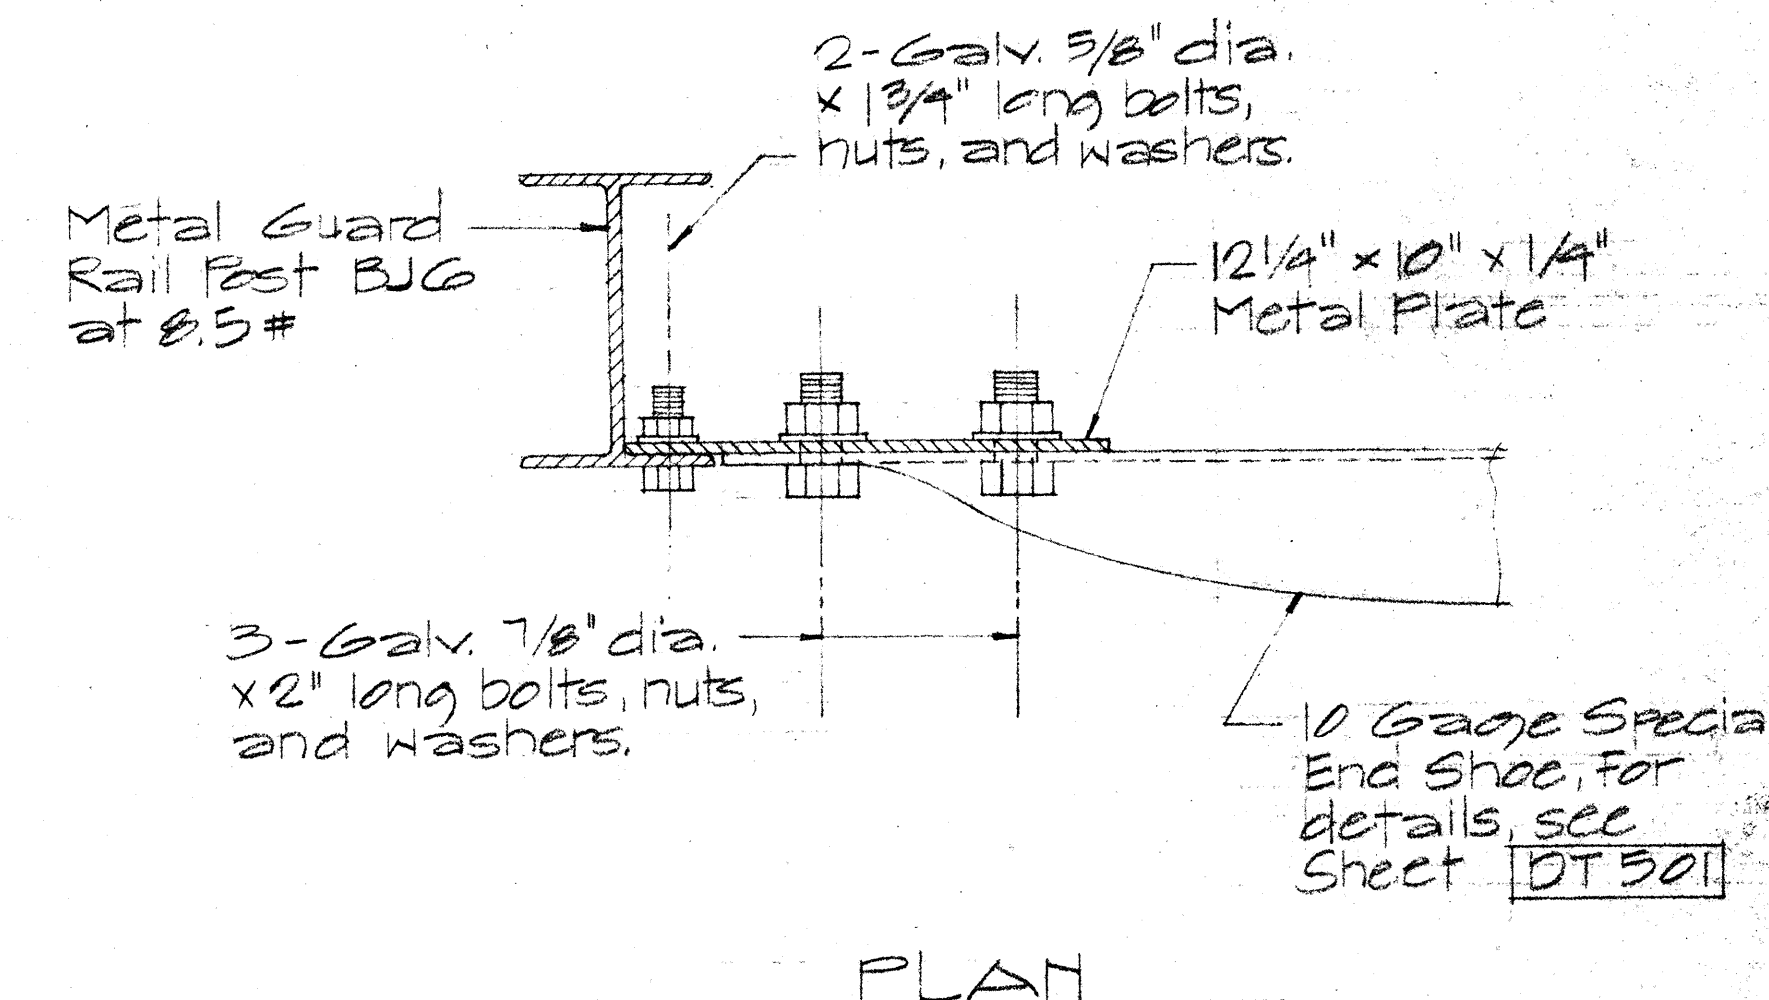

STATE OF HAWAII
DEPARTMENT OF TRANSPORTATION
HIGHWAYS DIVISION


STANDARD DETAIL GUARD RAIL RAMP END ANCHORAGE

Scale: as Noted


August, 1968

SHEET NO. OF SHEETS DT 502


DATE	
DESIGNED BY	
DRAWN BY	
CHECKED BY	
NOTED BY	
ORIGINAL PLAN	
NOTE BOOK	
No.	

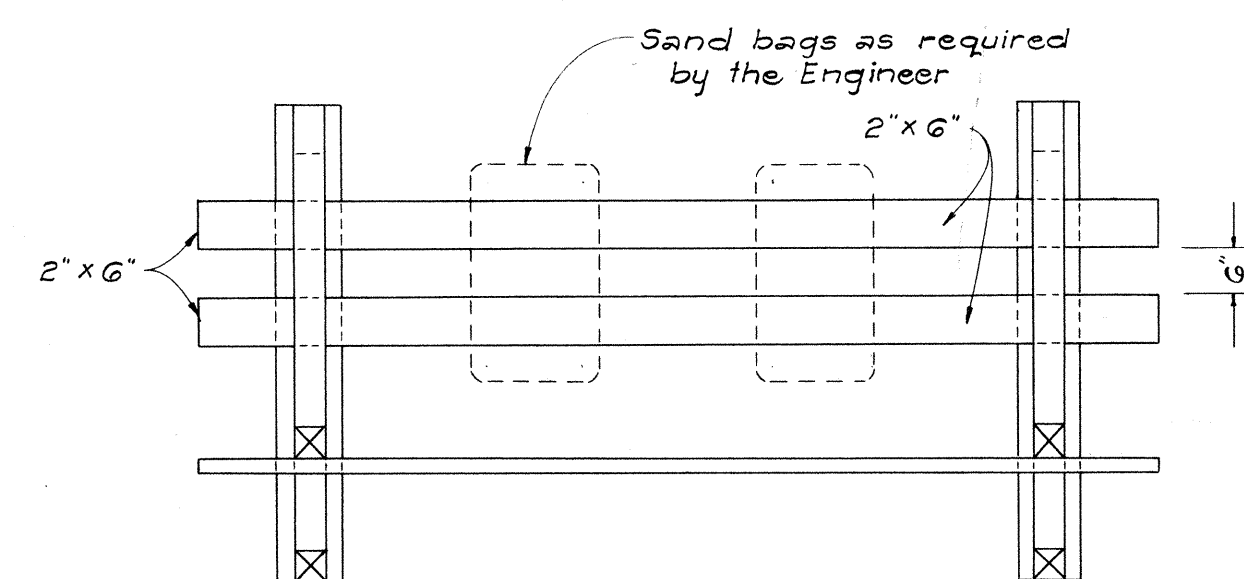


PLAN VIEW

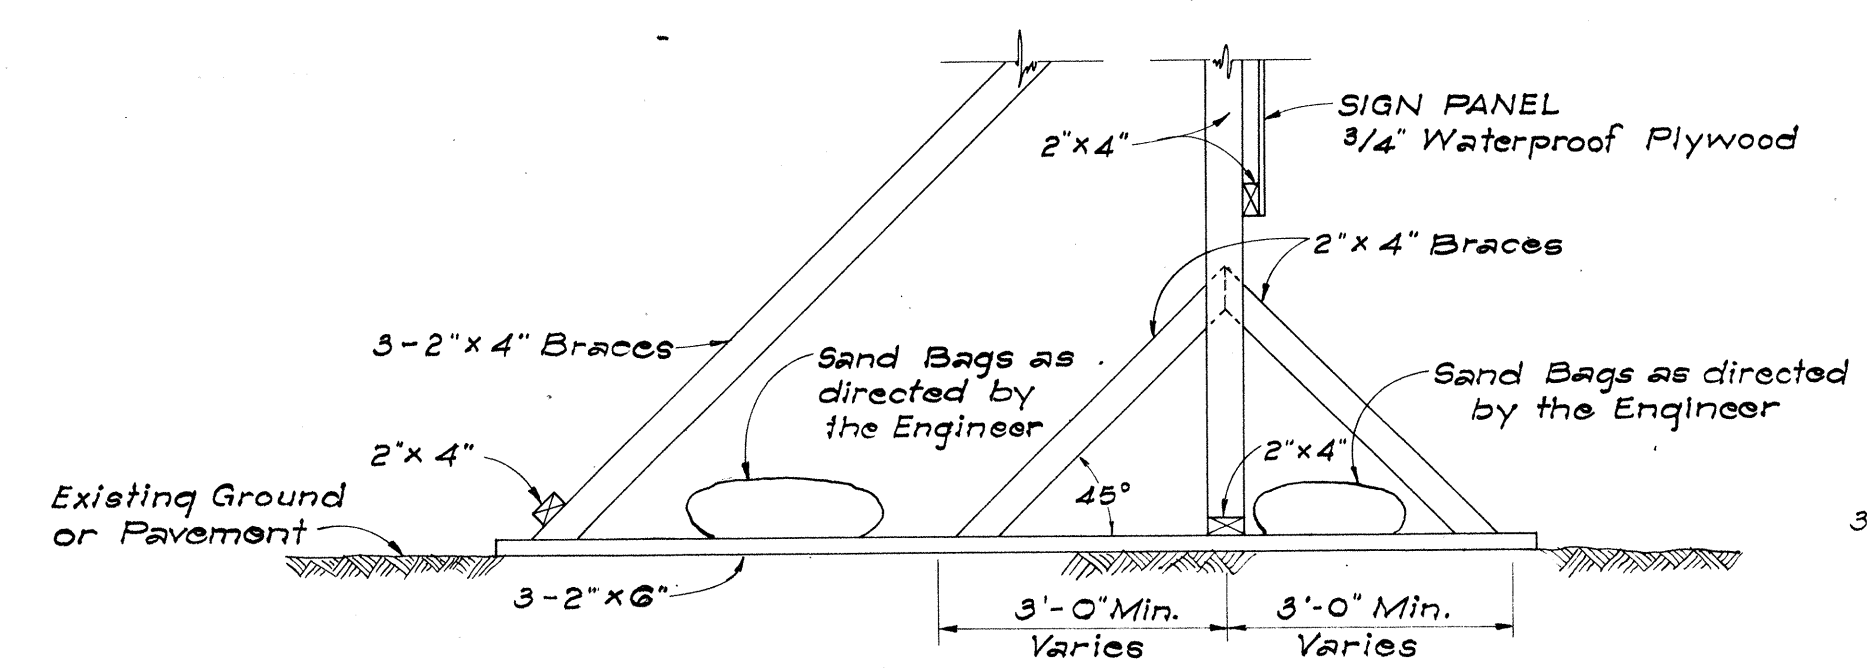

SIDE VIEW
(SIGN FRAME WEIGHTED DOWN)

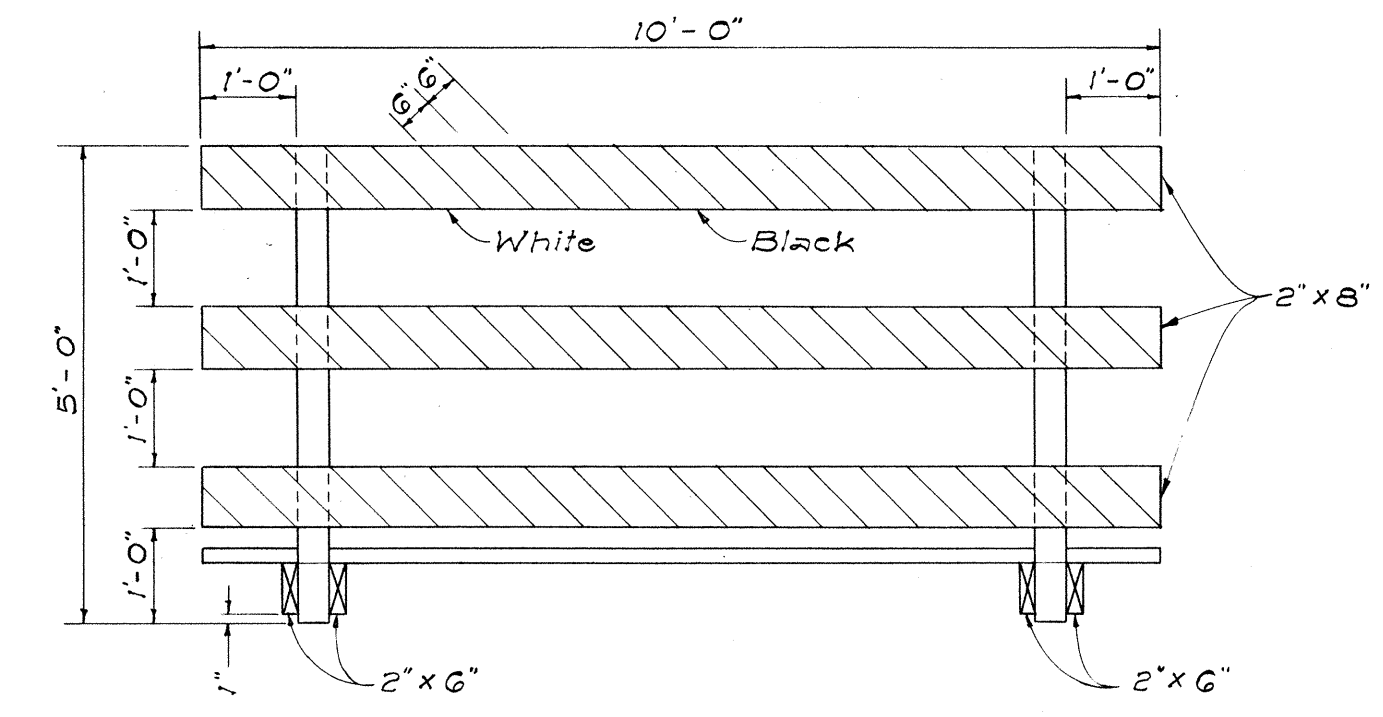


FRONT VIEW

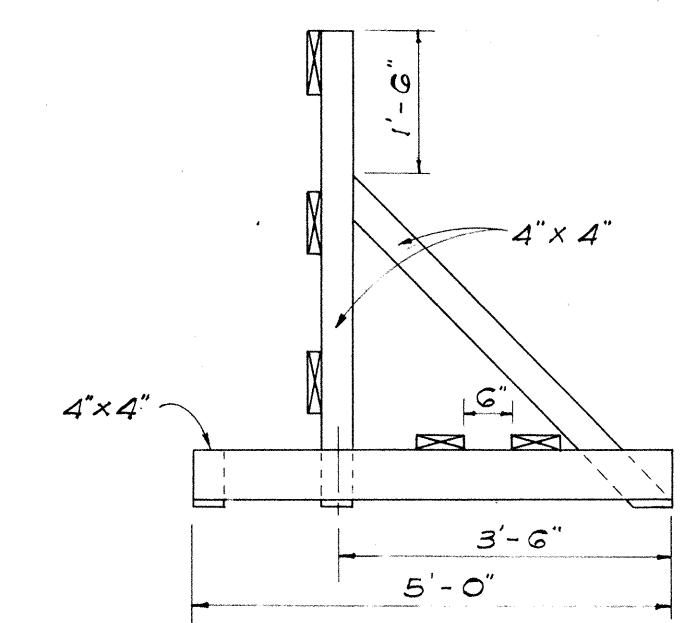


END VIEW


CLASS I BARRICADE

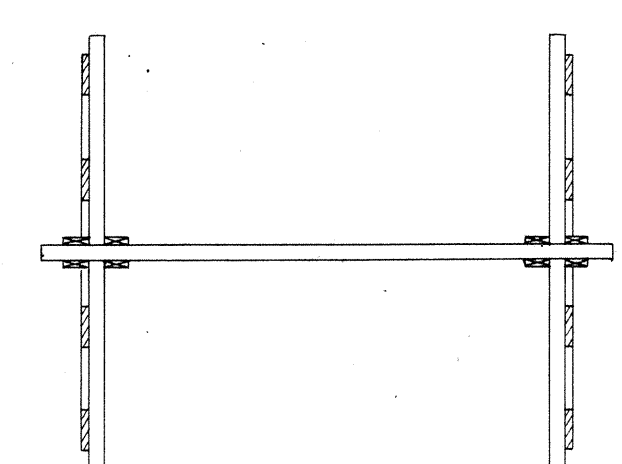

PLAN VIEW

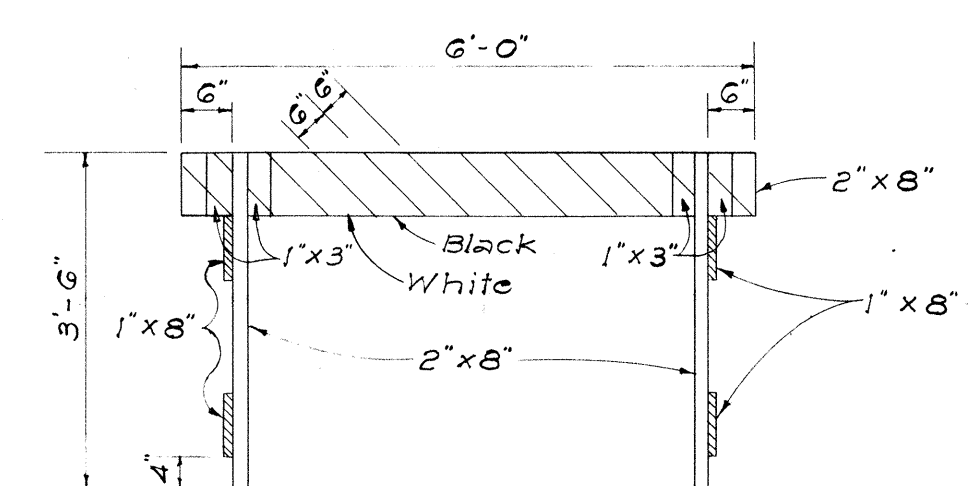


FRONT VIEW

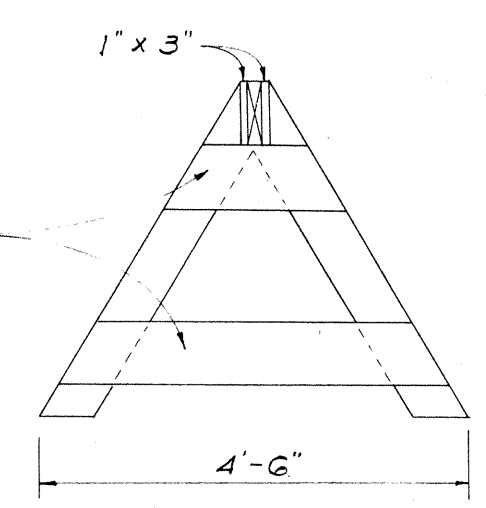


END VIEW

CLASS II BARRICADE

Scale: 1/2" = 1'-0"

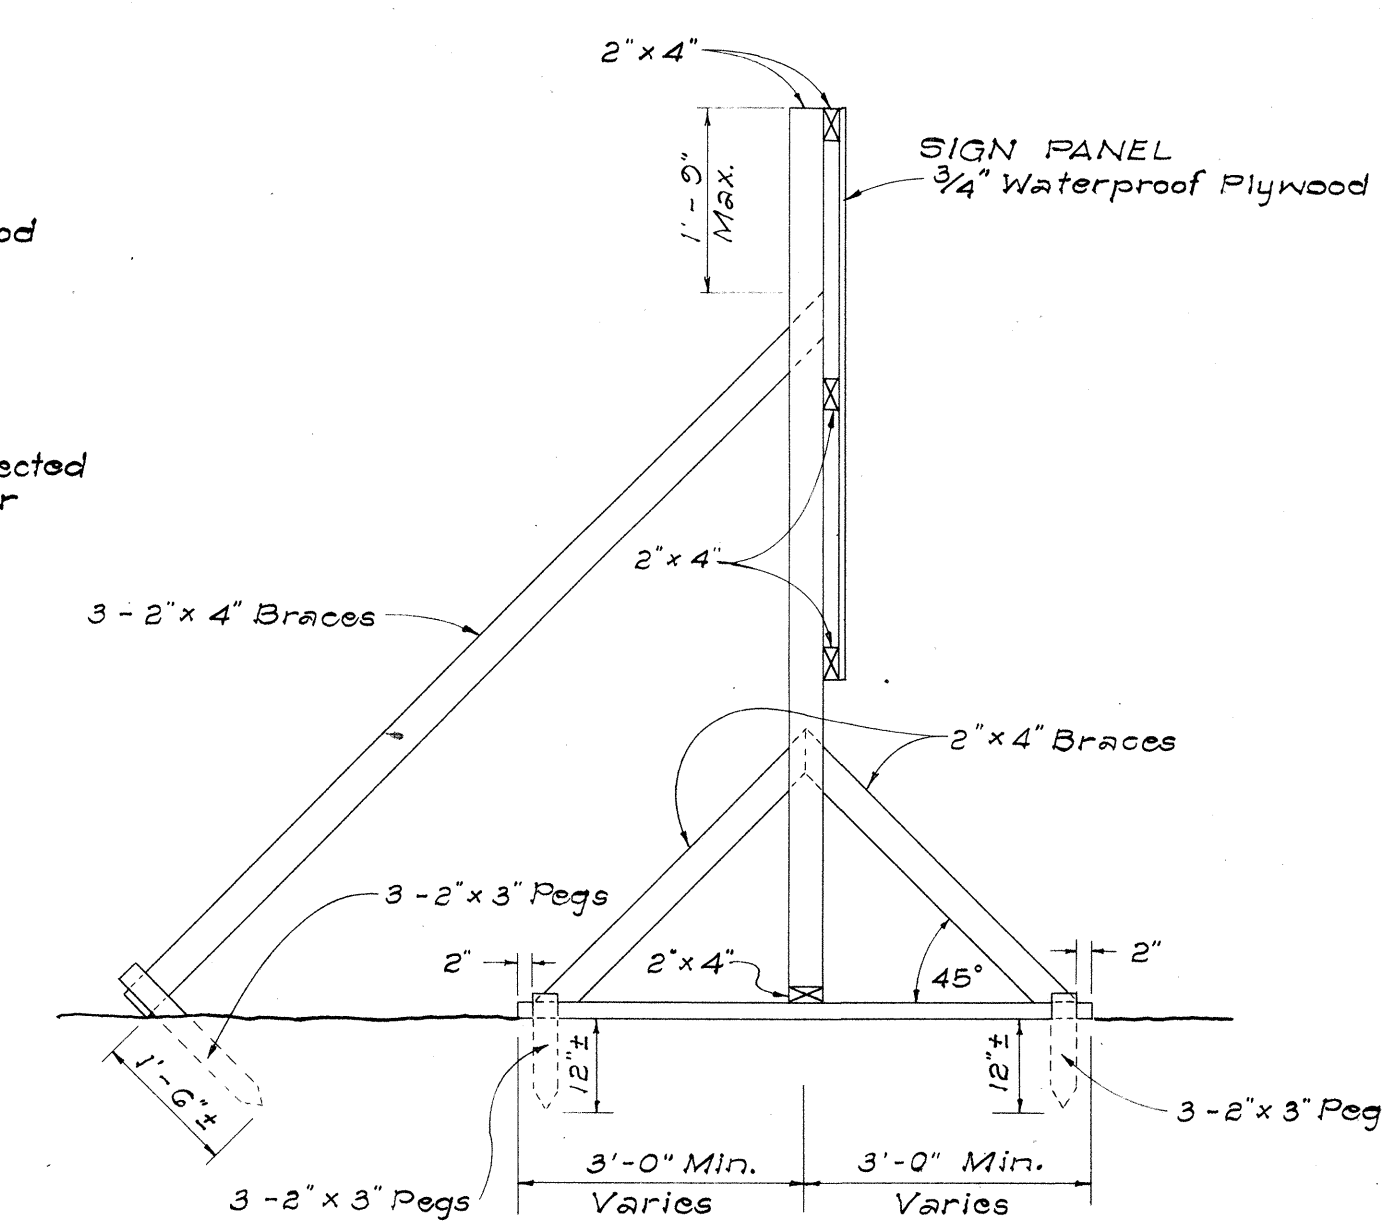


SIDE VIEW
(SIGN FRAME ANCHORED IN GROUND)

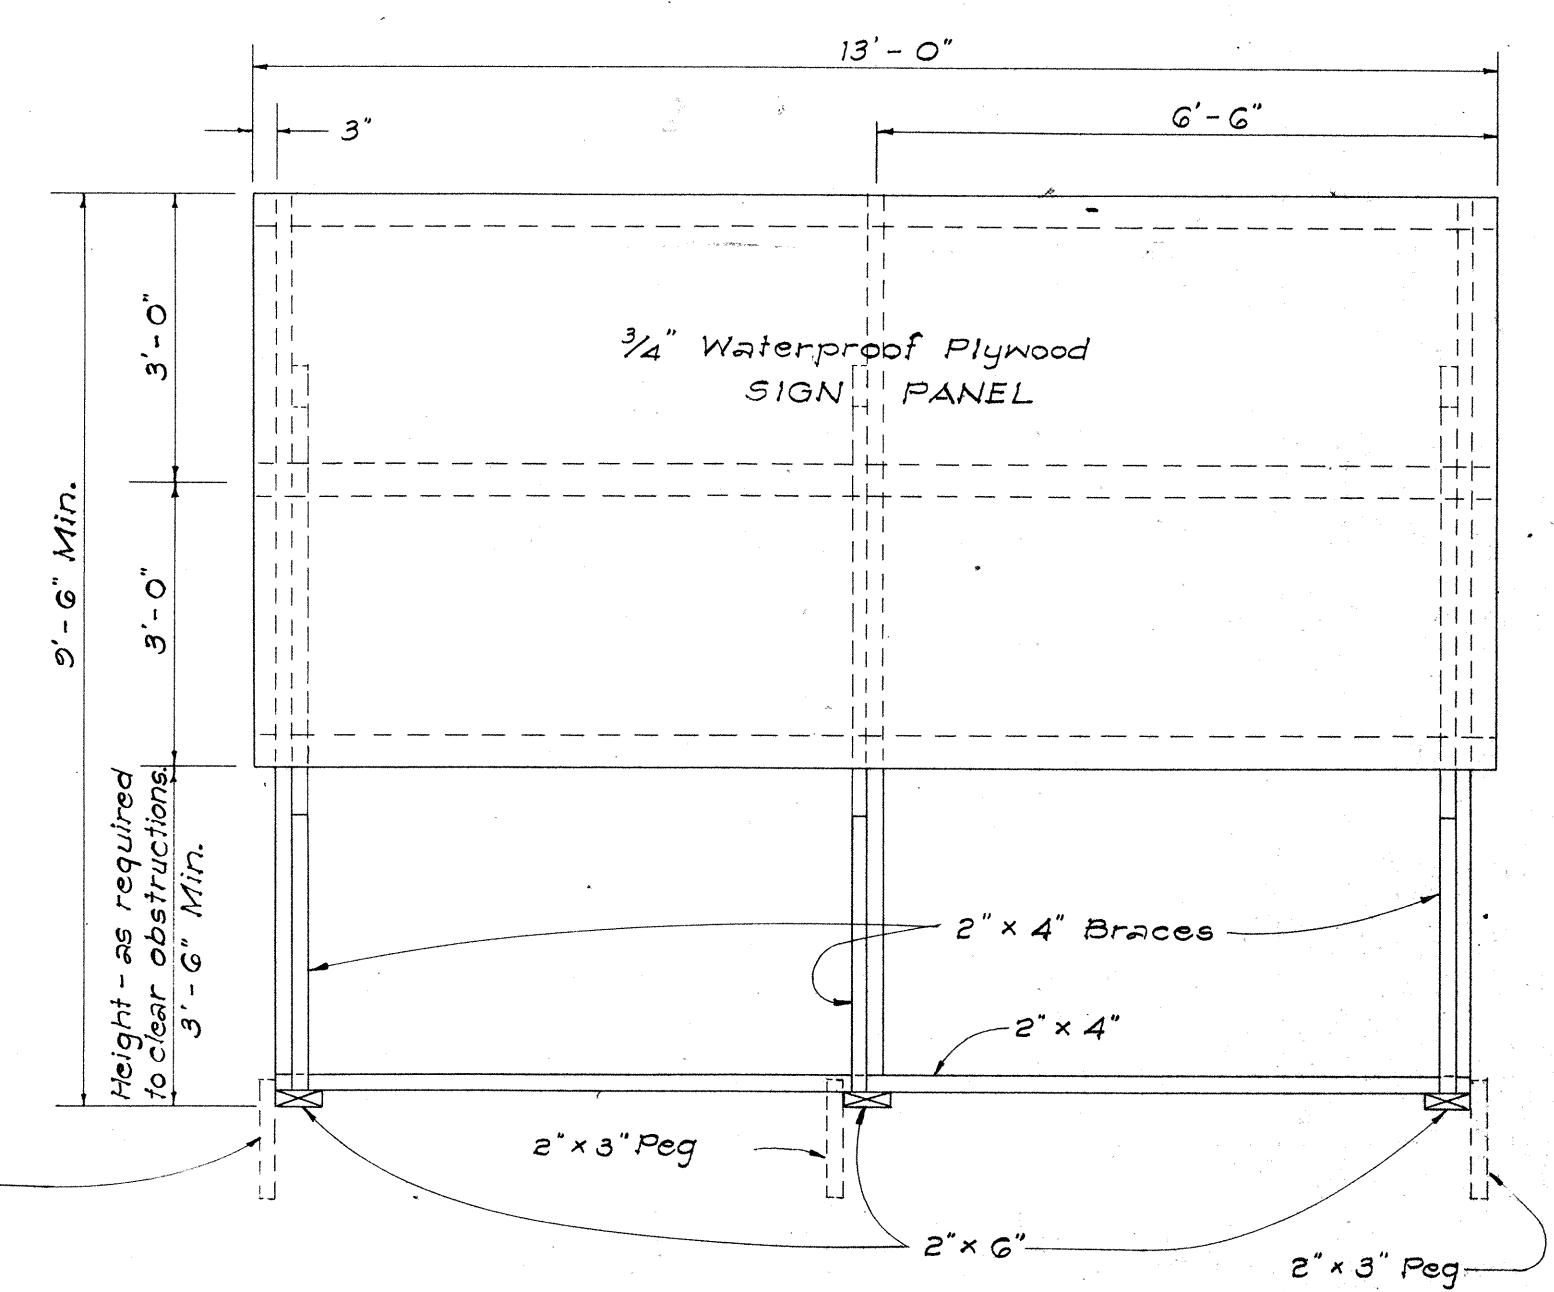

FRONT VIEW

ELEVATIONS

Scale: 1/2" = 1'-0"

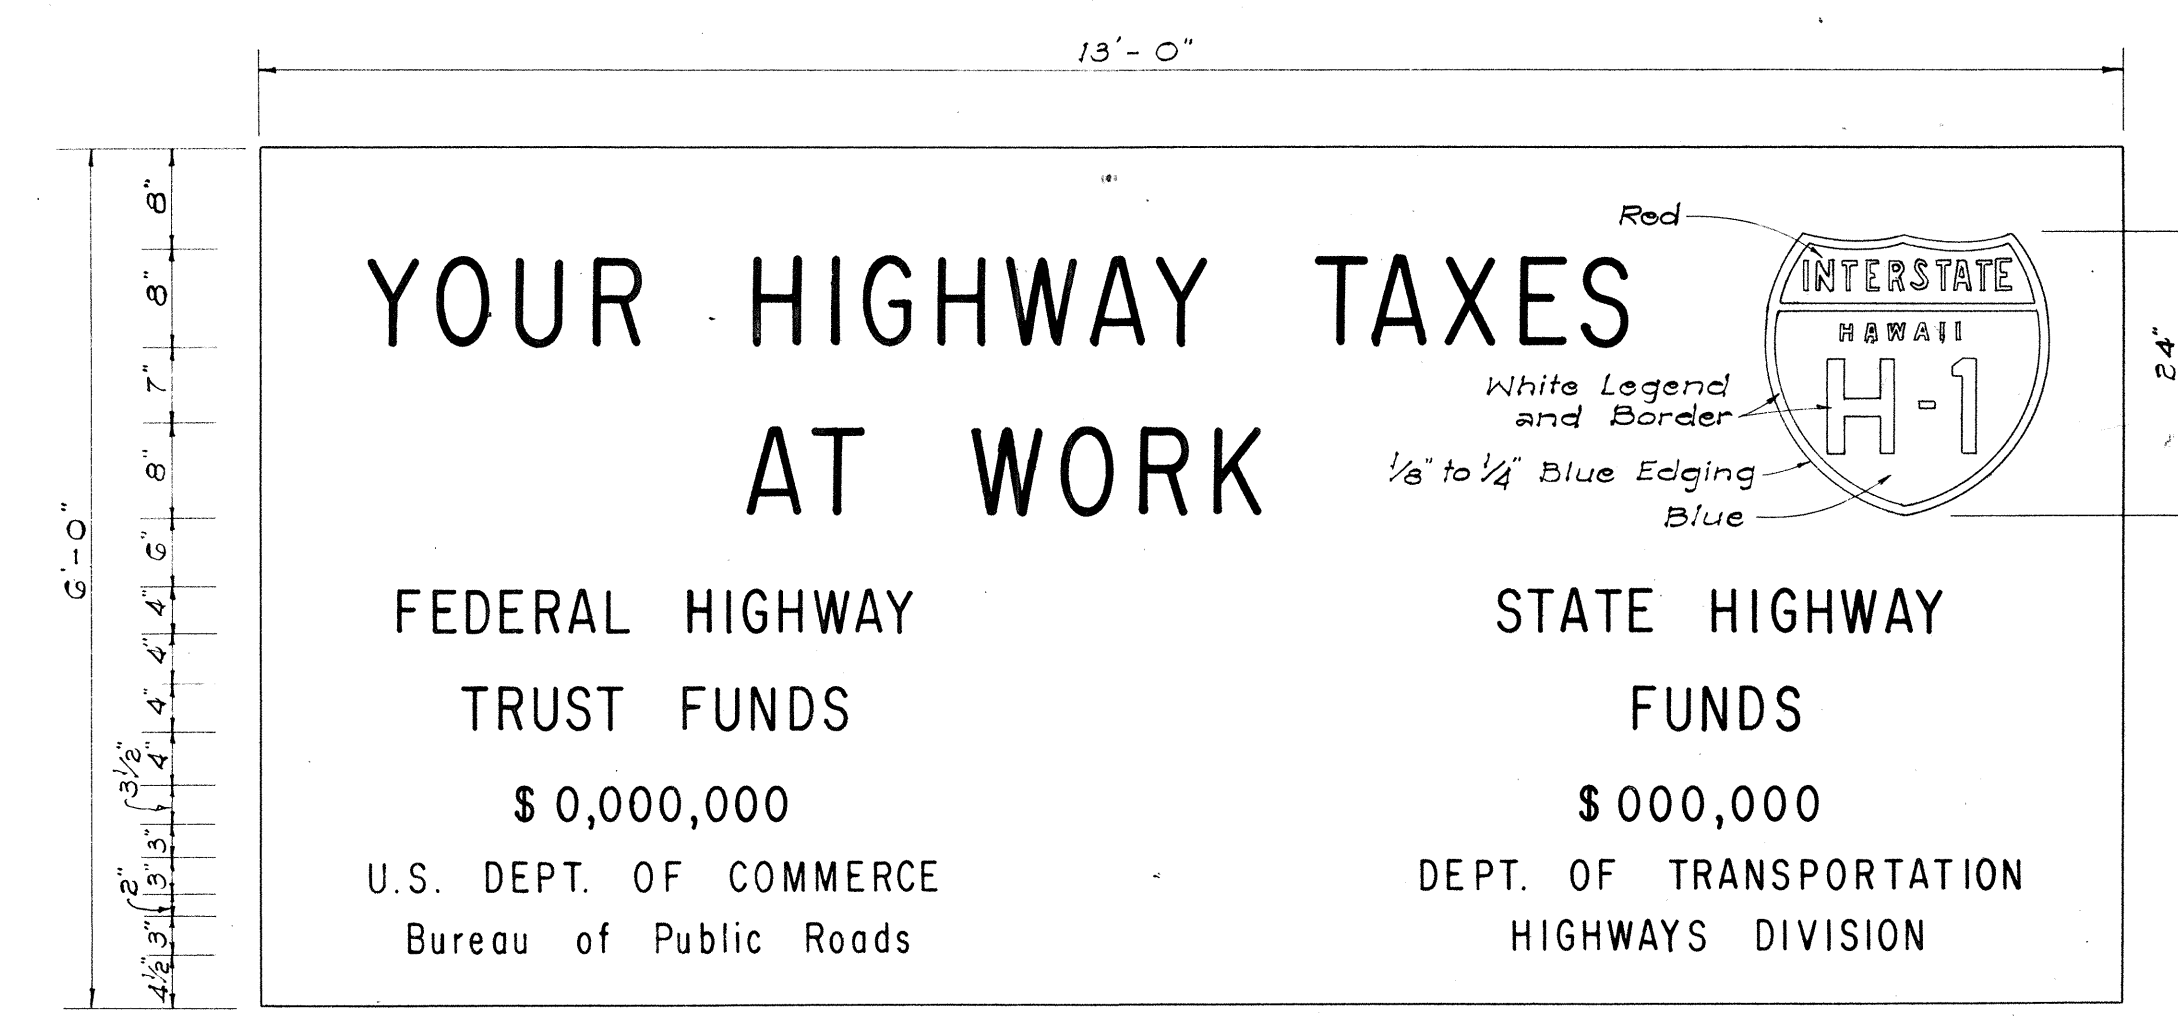

SIGN PANEL
Scale: 3/4" = 1'-0"

INTERSTATE SYSTEM
CONSTRUCTION IDENTIFICATION SIGN

Scale: As Shown

NOTES:

- A. CONSTRUCTION IDENTIFICATION SIGNS
- The sign legend shall be black on white background except for the Interstate Route marker which shall be as shown on the plan.
 - The Contractor shall construct, install and maintain the project signs at the locations shown on the Plans and as ordered by the Engineer.
 - The signs shall be removed and stockpiled upon completion of the project as ordered by the Engineer and are to become State property.
 - Letters shall be Series "C" of the sizes shown on the Plan and shall conform with the Standard Alphabet for Highway Signs, Bureau of Public Roads, 1952.
 - The Contractor shall fill in the proper numerals in place of ciphers as ordered by the Engineer.

- B. WOOD BARRICADES
- The Contractor shall construct, install and maintain the wood barricades at the locations shown on the Plans and as ordered by the Engineer.
 - The permanent wood barricades shall be left in place or relocated upon completion of the project as ordered by the Engineer and are to become State property.

STATE OF HAWAII
DEPARTMENT OF TRANSPORTATION
HIGHWAYS DIVISION

TYPICAL DETAILS
CONSTRUCTION IDENTIFICATION SIGN
AND
WOOD BARRICADES

SCALE: As Shown DATE: May, 1966

SHEET No. 10 OF 10 SHEETS

SURVEY PLOTTED BY	DATE
DRAWN BY	
DESIGNED BY	
QUANTITIES BY	
CHECKED BY	
ORIGINAL PLAN	
NOTE BOOK	
No.	