

FED. ROAD DIST. No.	STATE	FED. AID PROJ. No.	FISCAL YEAR	SHEET No.	TOTAL SHEETS
HAWAII	HAW.	I-HI-1(31) Unit	1967	7	292

BEG. OF PROJ. No. I-HI-1(31), UNIT 1
Baseline Sta. 144 + 72

BEG. OF ROADWAY CONSTRUCTION
EQUATION $\frac{\text{Sta. } 156 + 92.15 =}{\text{Sta. } 164 + 92.27}$

NOTE: For Profile of Frontage Road "J" and Ramp "B-1" See Sht. No. 13

Existing off-street parking lot to be preserved until westbound freeway traffic can be detoured on completed eastbound lanes

B.M.
"u" Cut on ~~Cone Block~~ Catch Basin.
Elev. ~~95.40~~
96.01

Existing R/W Line ↗

2 POT 57a. 175+14.93²
 PCWS.E.P. 57a. 175+14.93
 R=1300.00'

GENERAL NOTES

1. Buildings numbered thus (A) to (G) inclusive are to be demolished. See Special Provisions.
2. Azimuthes and coordinates are referred to Punchbowl "Trig." station.
3. Bench Marks are referred to Mean Sea Level datum.
4. The boring data shown on these plans are for design purposes only, and are for the conveniences of the Engineer in control of earthwork. The borings were carefully taken and are believed to be reliable, however, the Department assumes no responsibility whatsoever in respect to the sufficiency or accuracy of

the borings, or of the interpretation thereof, and will not either impliedly or expressly make any guarantee of any of the same.

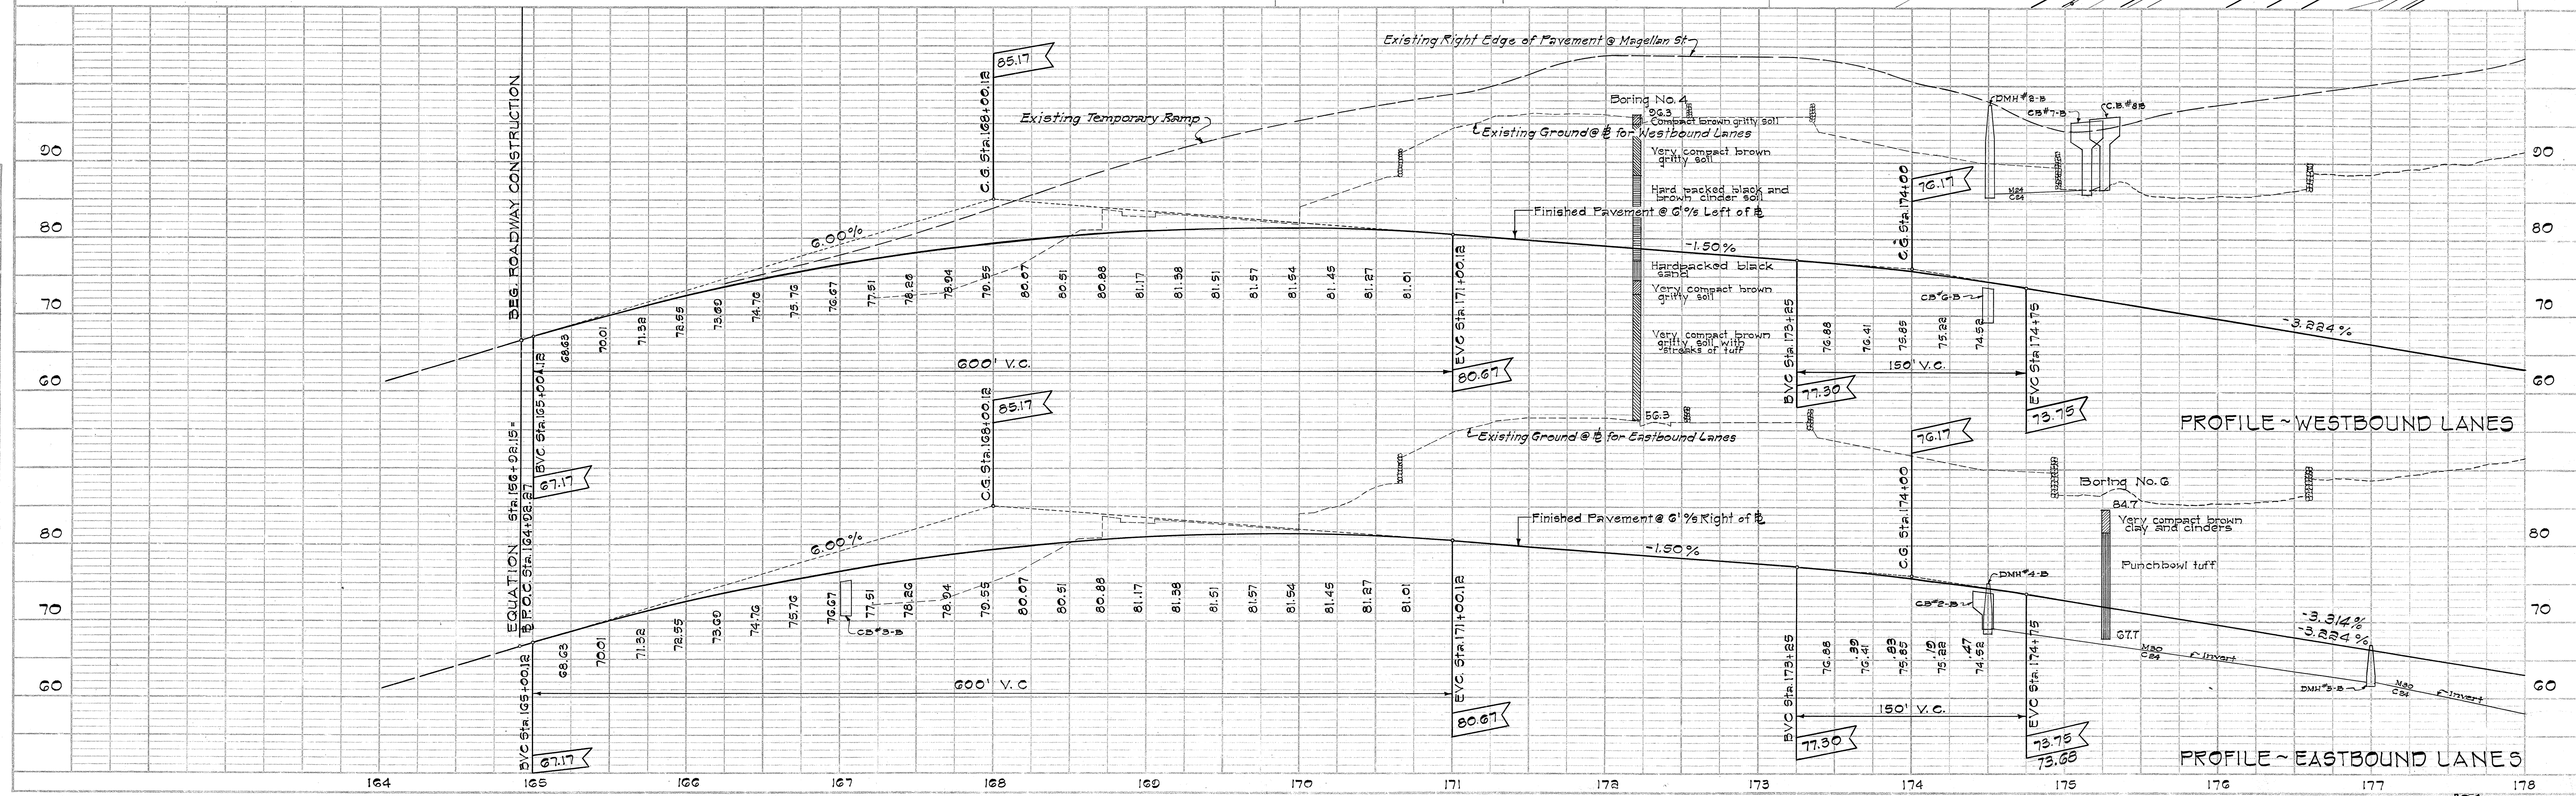


PLATE 1 - PLAN-PROFILE O. P. R. & R. E. STANDARD
REUFFEL & ESSER CO., NEW YORK.
K & E Co. No. 348-16
"IMPROVED" TRACHEAL PLATE
19714

6 1 11 DO-I-1 11 111111

PLAN	BY	DATE
SURVEYED		
NOTED		
ALIGNED		
CHECKED		
RT. OF WAY		
NO.		

PROFILE	BY	DATE
SURVEYED		
NOTED		
GRADES		
CHECKED		
STRUCTURE		
NOTING		
CHKO.		
NO.		

NOTE: For Profiles of Frontage Road 'J',
Frontage Road 'K', Ramp 'B-1' and
Ramp 'C', See Sht. No. 12A

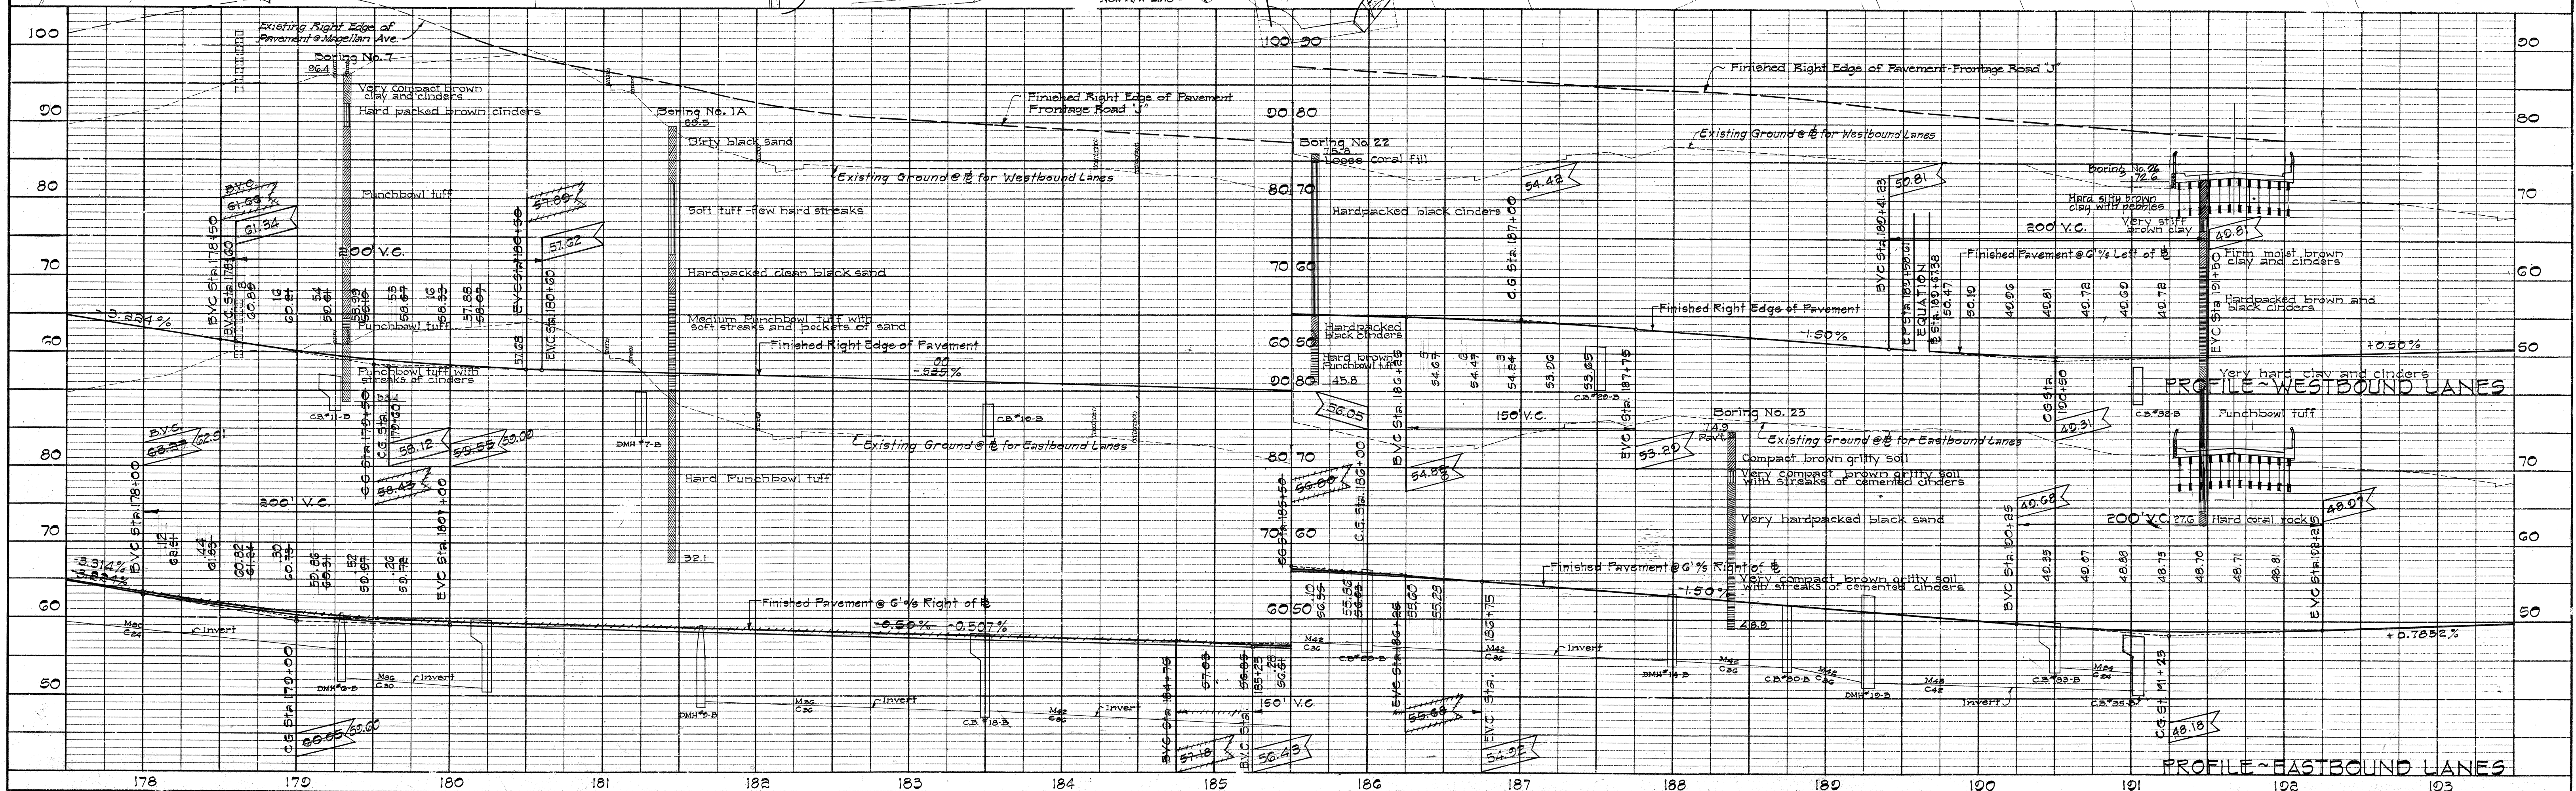
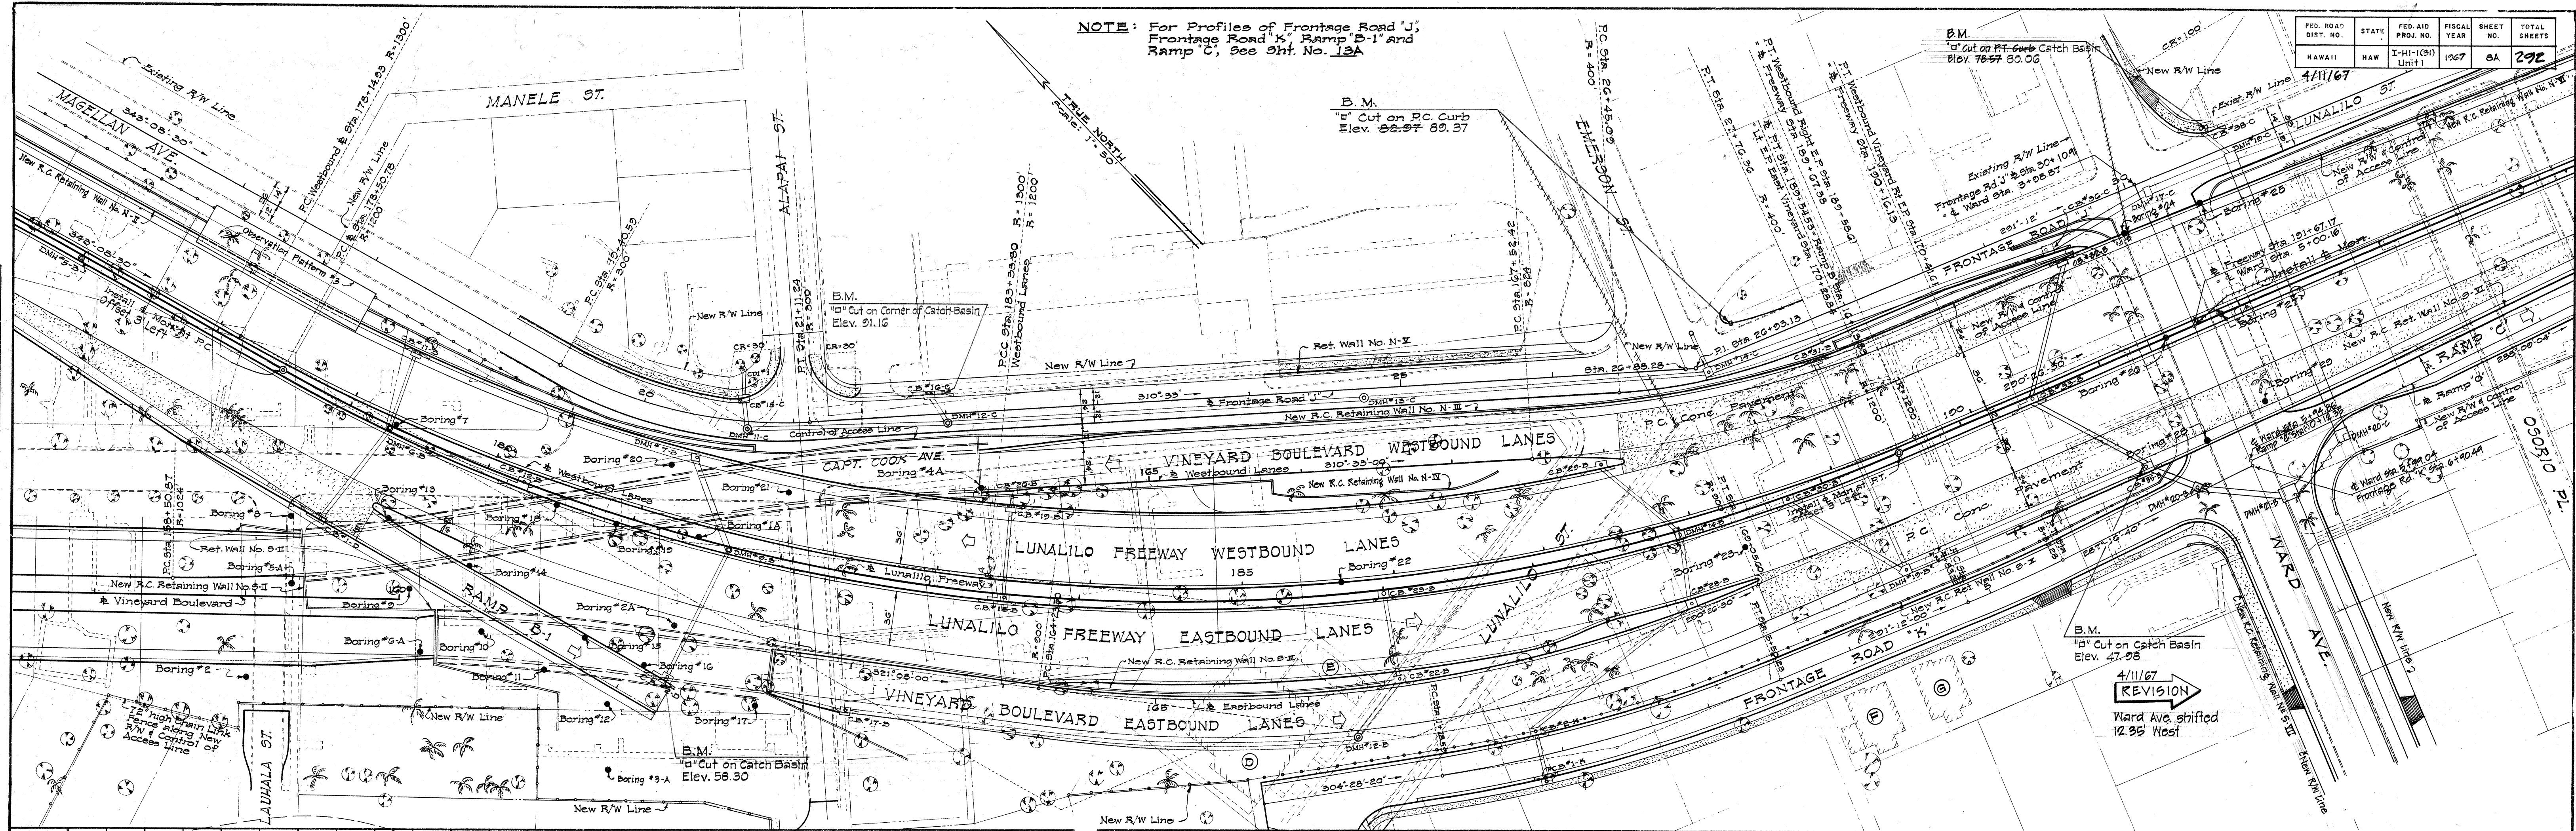
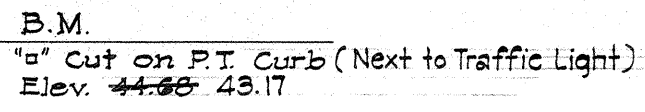
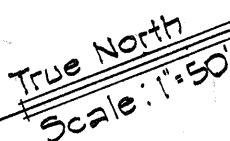


PLATE 1-PLAN-PROFILE O. P. R. & E. STANDARD
KEUFFEL & ESSER CO. NEW YORK


THIS SHEET SUPERCEDES SHEET 8

SA

4/11/67

[illegible]

4/11/67
REVISION
Ward Ave. shifted
12.35 West

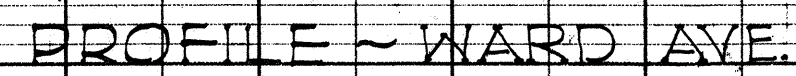

€ KINAL ST

Existing Ground @ 2

K. & E. Co. No. 348-IC
"IMPERIAL" TRACING CLOTH
M281

10A

DD-I-1

PLAN	BY	DATE
SURVEYED		
NOTE BOOK		
ALIGNED CHECKED		
RT. OF WAY CHECKED		
NO.		

PROFILE	BY	DATE
SURVEYED		
GRADES CHECKED		
NOTE BOOK		
STRUCTURE NOTATIONS CHD.		
NO.		

