

SHEET NO.	DESCRIPTION
1	TITLE SHEET
2-6	TYPICAL SECTIONS
7-12	PLAN AND PROFILE
13	RAMP PROFILES
14-26	DETAIL PLAN OF ROADWAY
27-29	CONSTRUCTION PHASING AND DETOUR PLANS WITH DETAILS
30	LOCATION OF STOCKPILE AREAS
31-40	MISCELLANEOUS ROADWAY DETAILS
41-82	UTILITY PLANS AND DETAILS
83-108	DRAINAGE DETAILS
109-110	ADJUSTMENT PLANS
11-197	STRUCTURES (SEE NOTE BELOW)
198-222	TRAFFIC SIGNS
223-228	TRAFFIC SIGNAL SYSTEM
229-234	HIGHWAY LIGHTING SYSTEM
235-240	LANDSCAPING PLANS
241-264	SPRINKLER SYSTEM
265-292	CROSS SECTIONS

NOTE: See sht. No. 2 for index to the various bridges and retaining walls.

See this sheet for additions to index.

STATE OF HAWAII
DEPARTMENT OF TRANSPORTATION
HIGHWAYS DIVISION
HONOLULU, HAWAII


"AS BUILT" PLANS FOR
CONSTRUCTION OF A PORTION OF
INTERSTATE ROUTE H-1 (LUNALILO FREEWAY)
PELE STREET TO KEEAUMOKU STREET
(PELE STREET TO VICTORIA STREET)
FEDERAL AID INTERSTATE PROJECT No. I-HI-1(31), UNIT 1
DISTRICT OF HONOLULU
ISLAND OF OAHU

PLAN-PROFILE HOR. 1" = 50' CROSS SECTION HOR. 1" = 10'
VER. 1" = 10' VER. 1" = 10'
DETAIL PLAN 1" = 20'

LAYOUT PLAN

NET LENGTH OF ROADWAY.....0.938 MI.
BRIDGES OVER 20' 0" SPAN.....0.000 MI. GROSS LENGTH OF PROJECT.....0.938 MI.

SCALE IN FEET

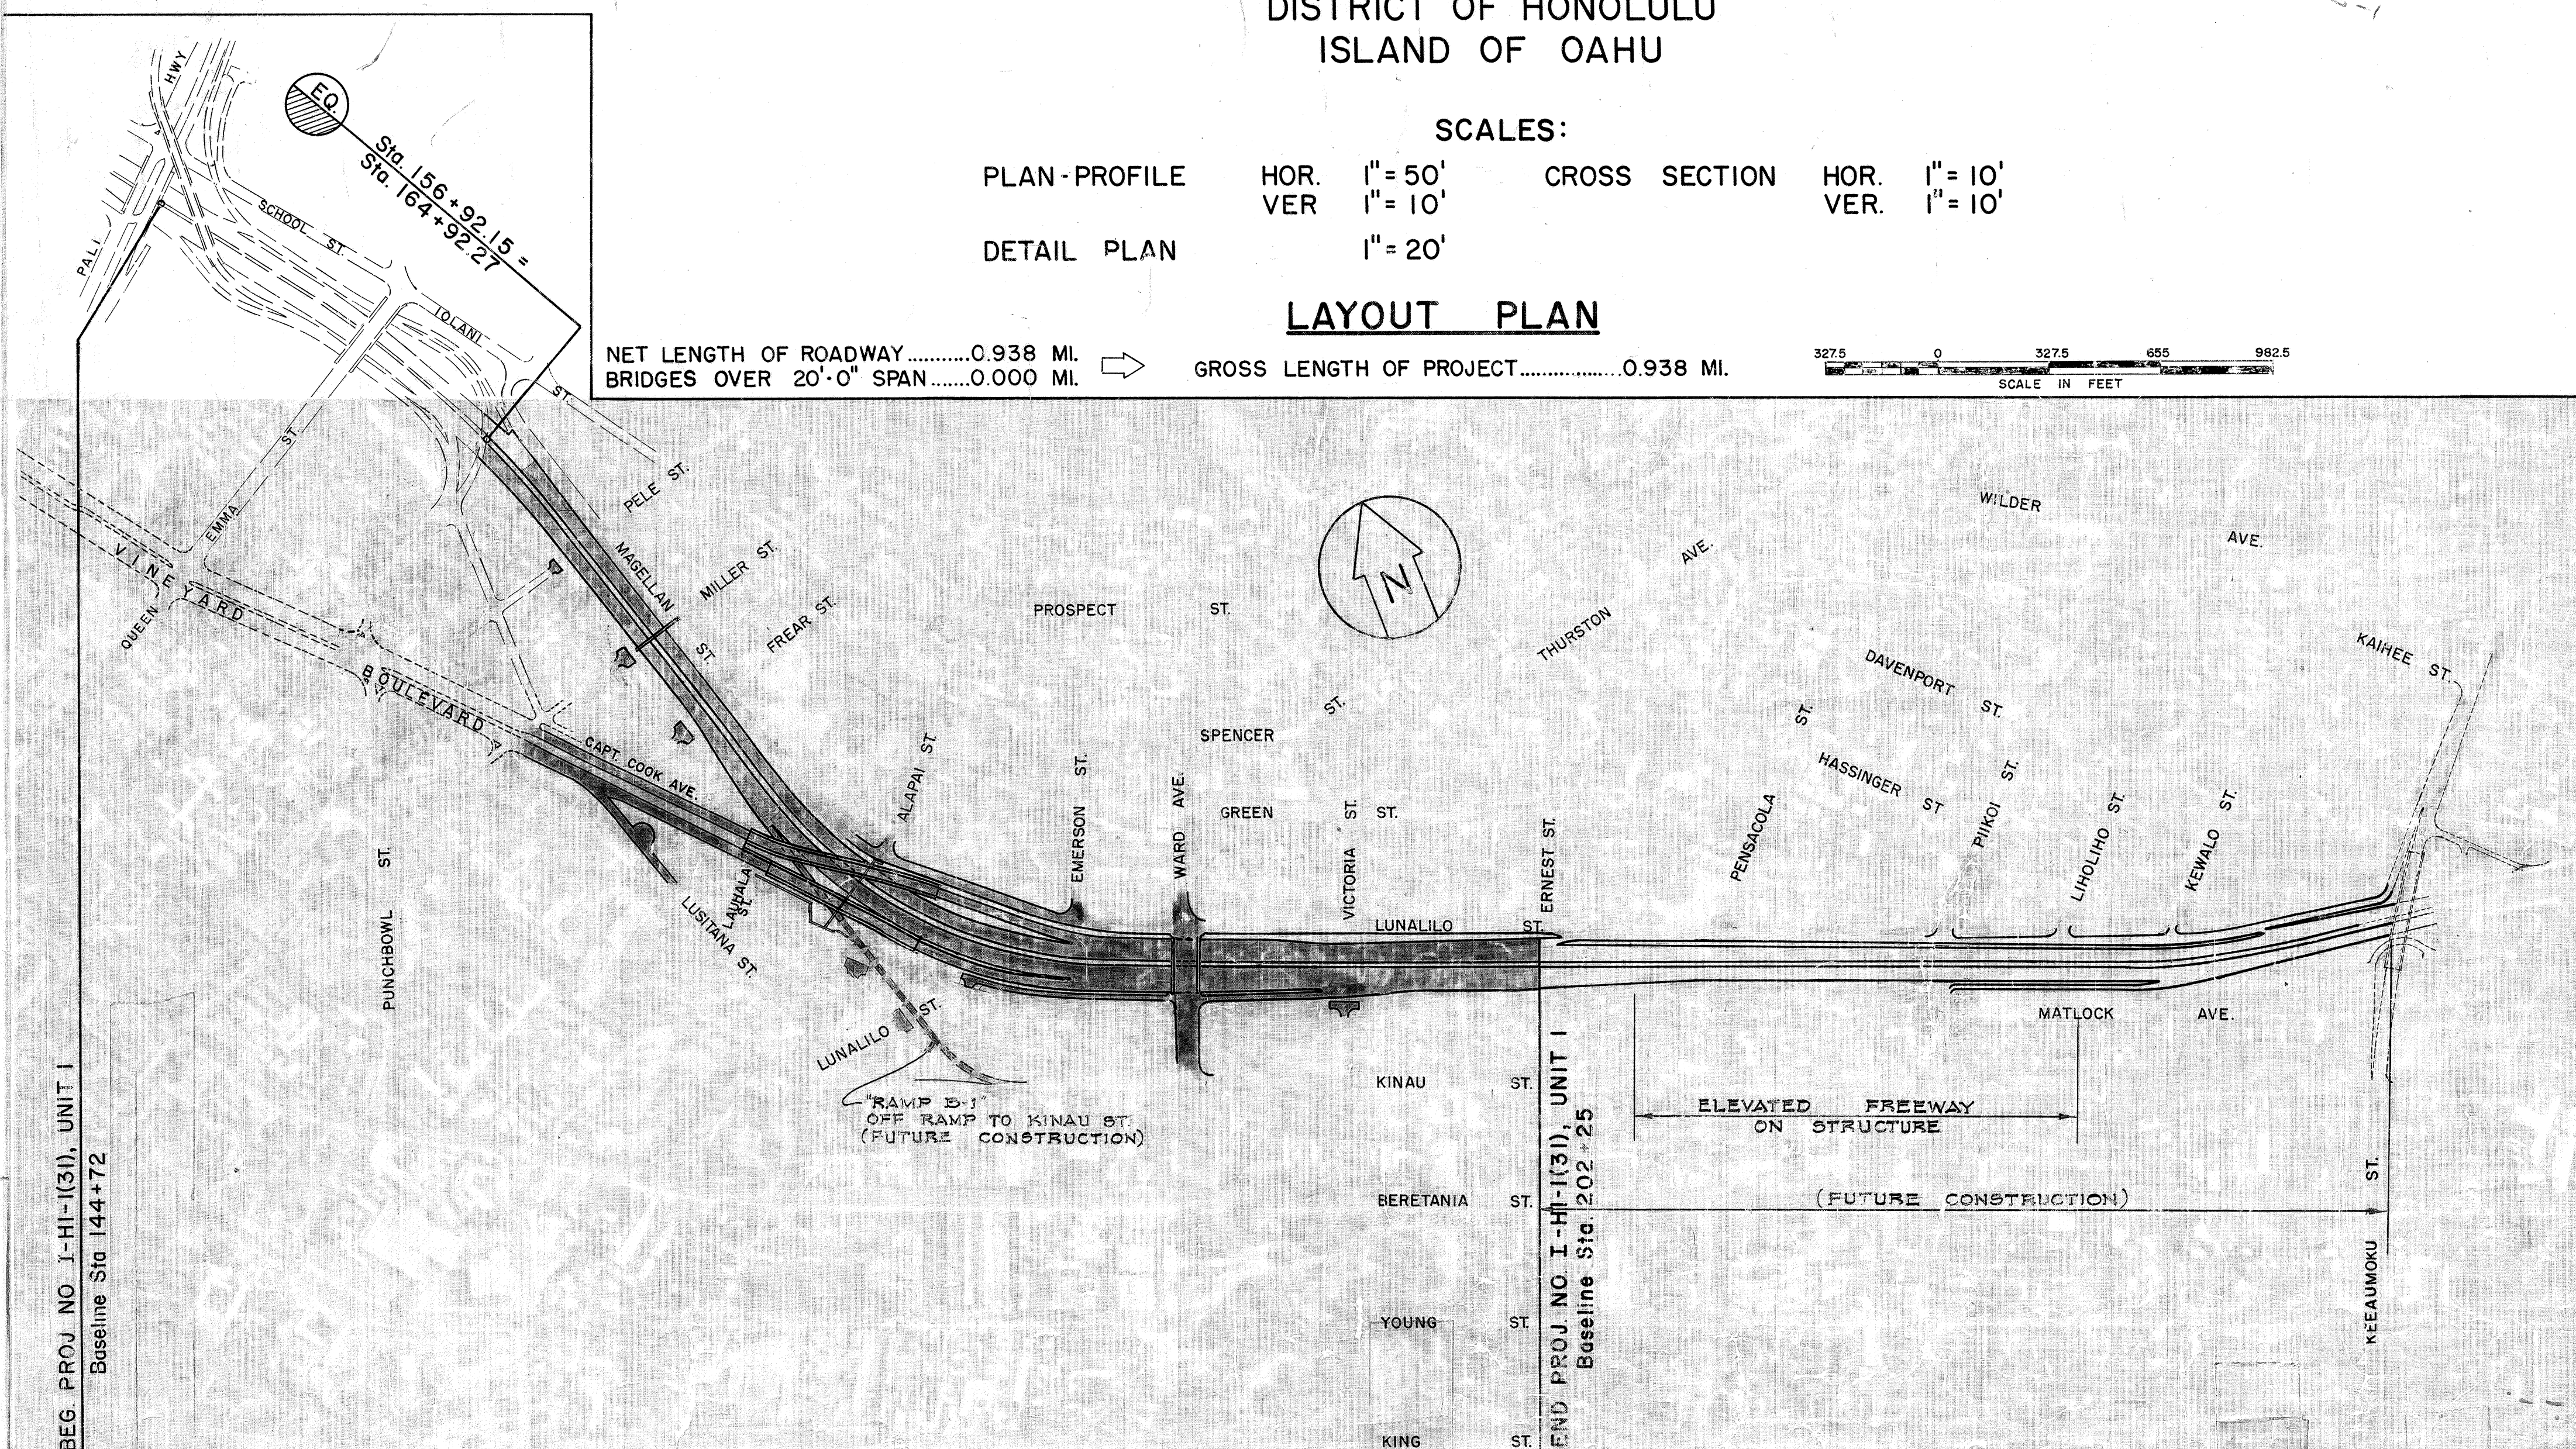

LOCATION OF PROJECT

NOTE:

ALL CHANGES MADE DURING CONSTRUCTION HAVE BEEN NOTED IN RED ON THESE TRACINGS AND CHECKED BY

PROJECT ENGINEER

DATE

DESIGN CLASSIFICATION

ADT (1966)57,900 T..... 2.0%
ADT (1986) 127,200 T24 3.0%
DHV (11%)(DIRECTIONAL) 8,400 V.....50 m.p.h.
D60/40

THESE SHEETS ADDED TO ORIGINAL CONTRACT PLANS.

CO18S, CO34S-1, CO34S-2, CO34S-3, CO34S-4, CO34S-5, CO34S-6, CO34S-7, CO34S-8, CO39S, CO39S-1, CO39S-2, CO39S-3, 45XS-1, CO46S-1, CO46S-2, CO46S-3, CO46S-4, CO102S(1), CO102S(2), CO102S(3), CO102S(4), CO102S(5), CO113S-1, CO115S-1, CO136S-1, CO158B, CO158C, CO165A, CO172D, CO172D(S), CO172E, CO172F, CO172G, CO172H, CO172J, CO172K, CO172L, CO177B, CO177C & CO183SI

DEPARTMENT OF TRANSPORTATION
STATE OF HAWAII
APPROVED: 2/10/67
DIRECTOR DATE

DEPARTMENT OF COMMERCE
BUREAU OF PUBLIC ROADS
APPROVED: 9-23-66
DIVISION DATE