



| FED. ROAD<br>DIST. NO. | STATE | FED. AID<br>PROJ. NO.   | FISCAL<br>YEAR | SHEET<br>NO. | TOTAL<br>SHEETS |
|------------------------|-------|-------------------------|----------------|--------------|-----------------|
| HAWAII                 | HAW.  | I-HI-1(32):5,<br>Unit 2 | 1967           | 8            | 45              |

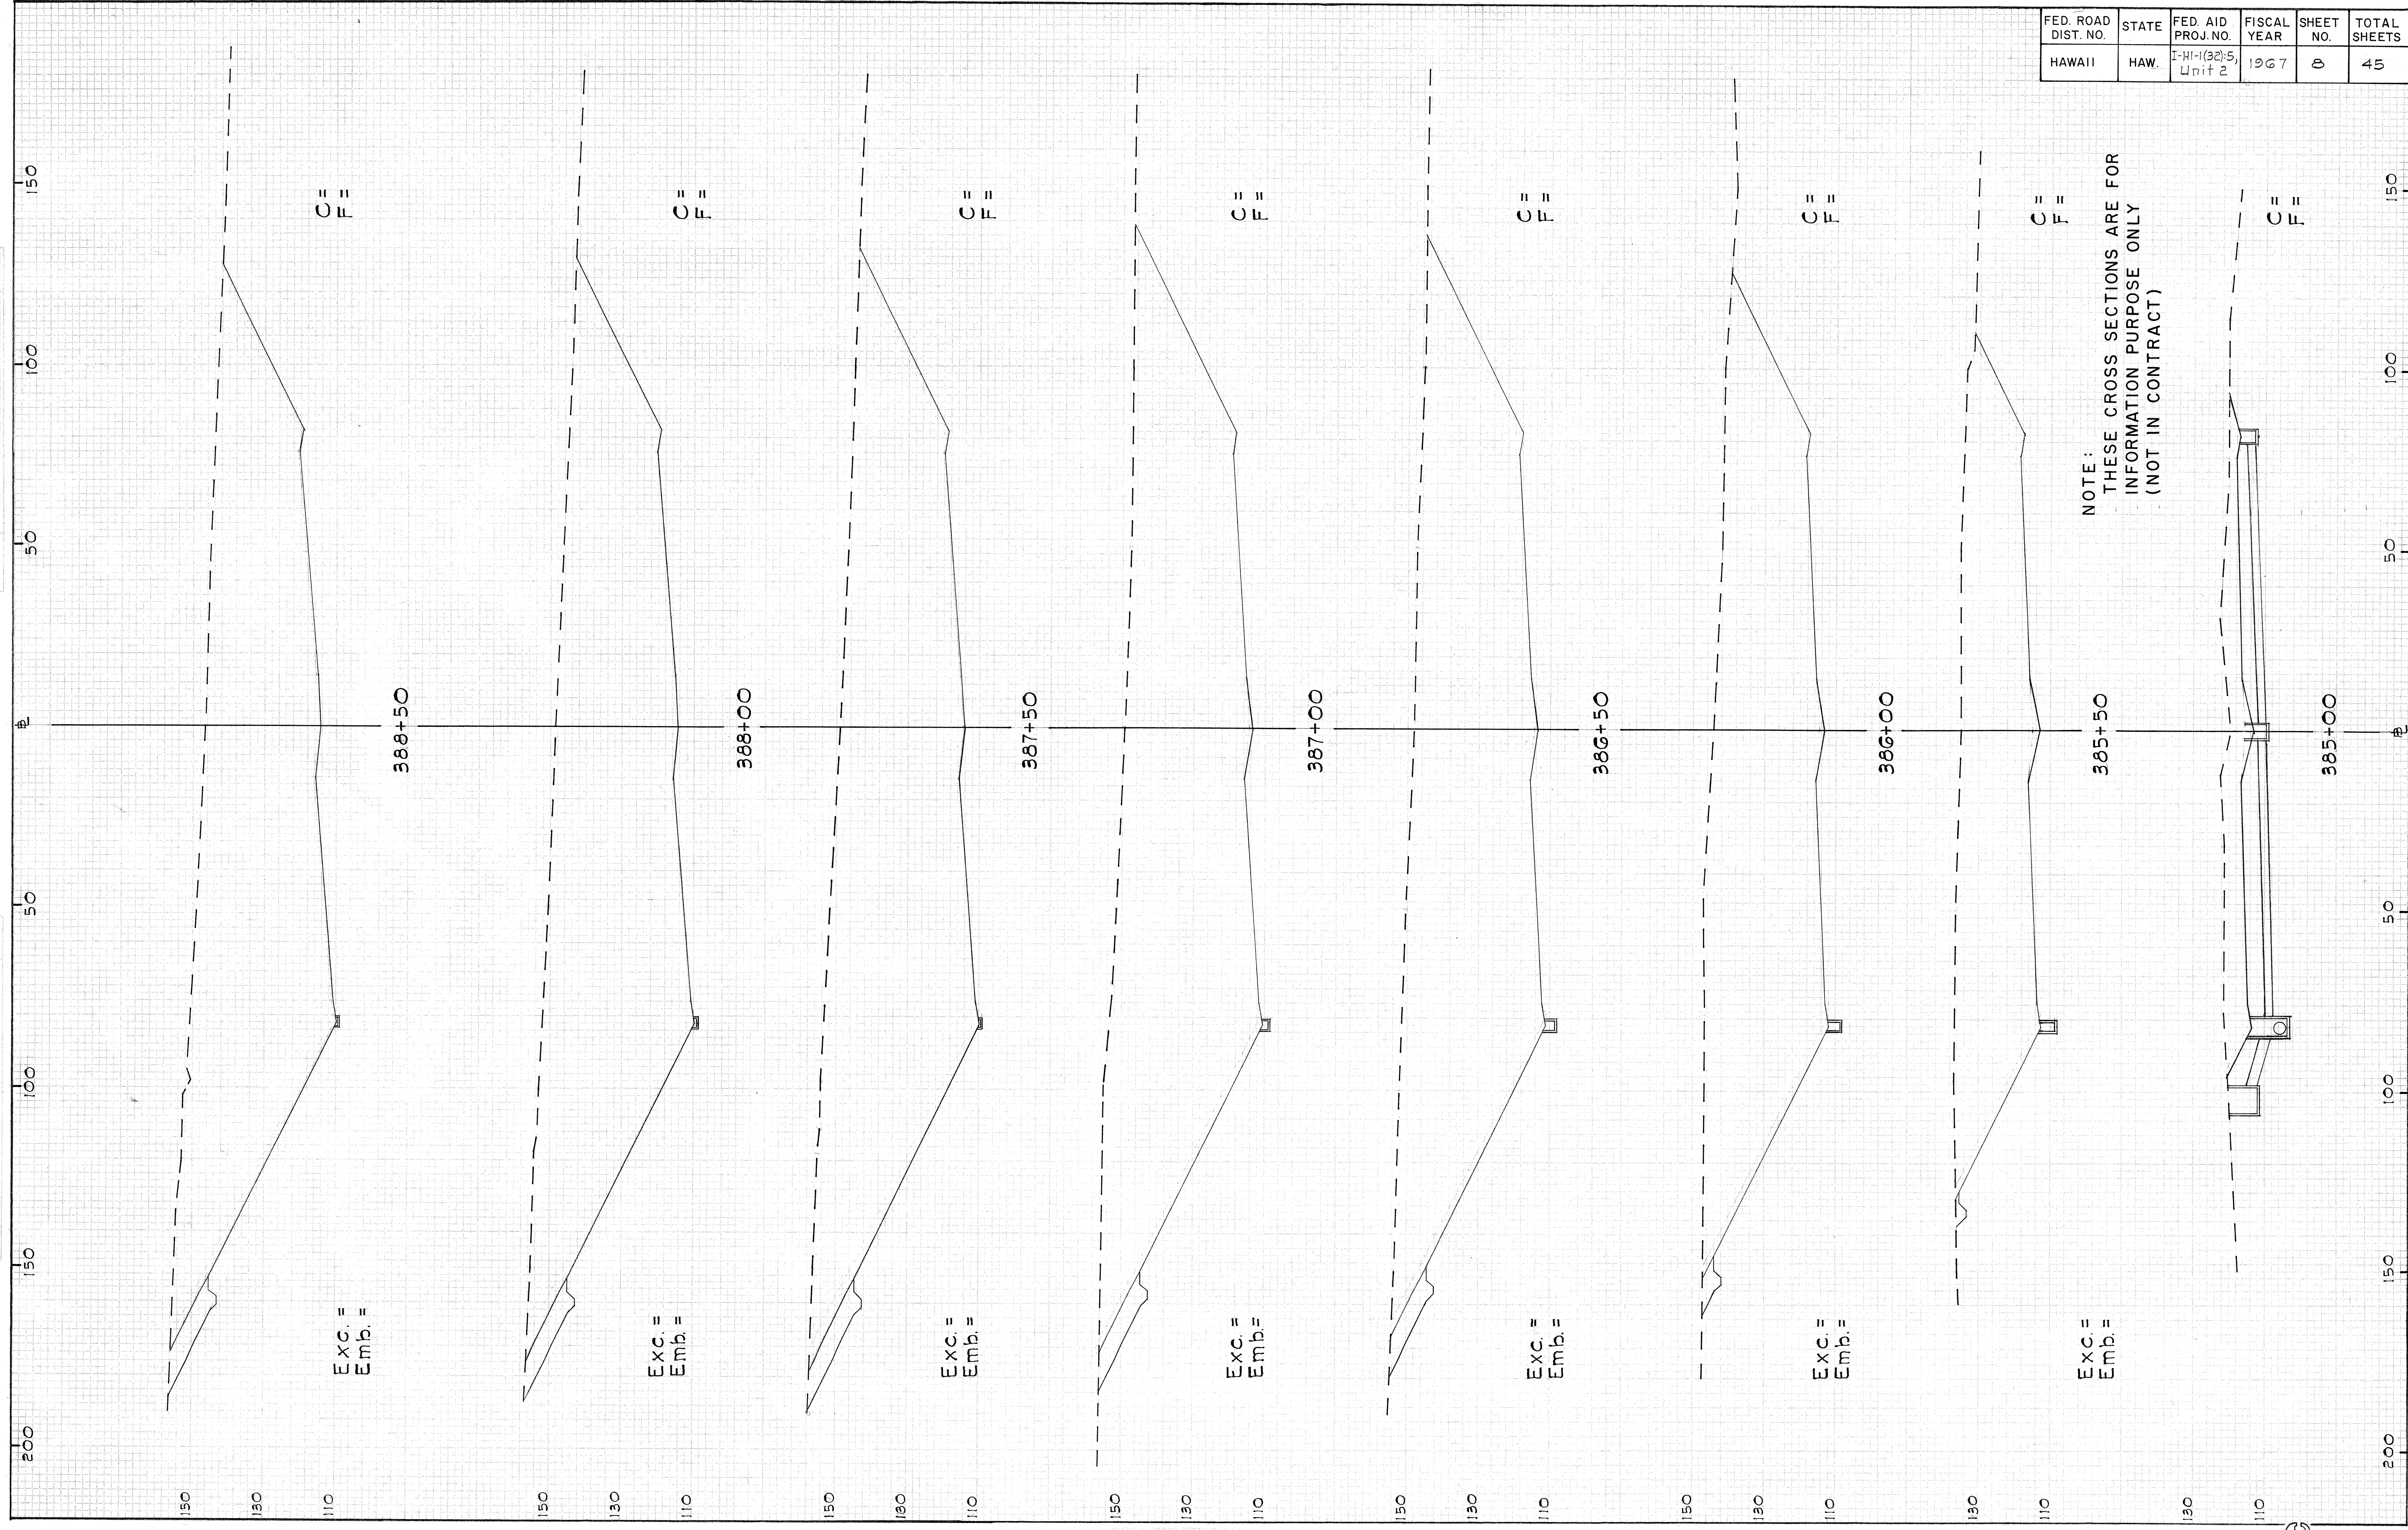

|          |        |      |
|----------|--------|------|
| ORIGINAL | SURVEY | DATE |
| NO.      | NO.    | NO.  |
| NO.      | NO.    | NO.  |
| NO.      | NO.    | NO.  |

|       |        |      |
|-------|--------|------|
| FINAL | SURVEY | DATE |
| NO.   | NO.    | NO.  |
| NO.   | NO.    | NO.  |
| NO.   | NO.    | NO.  |

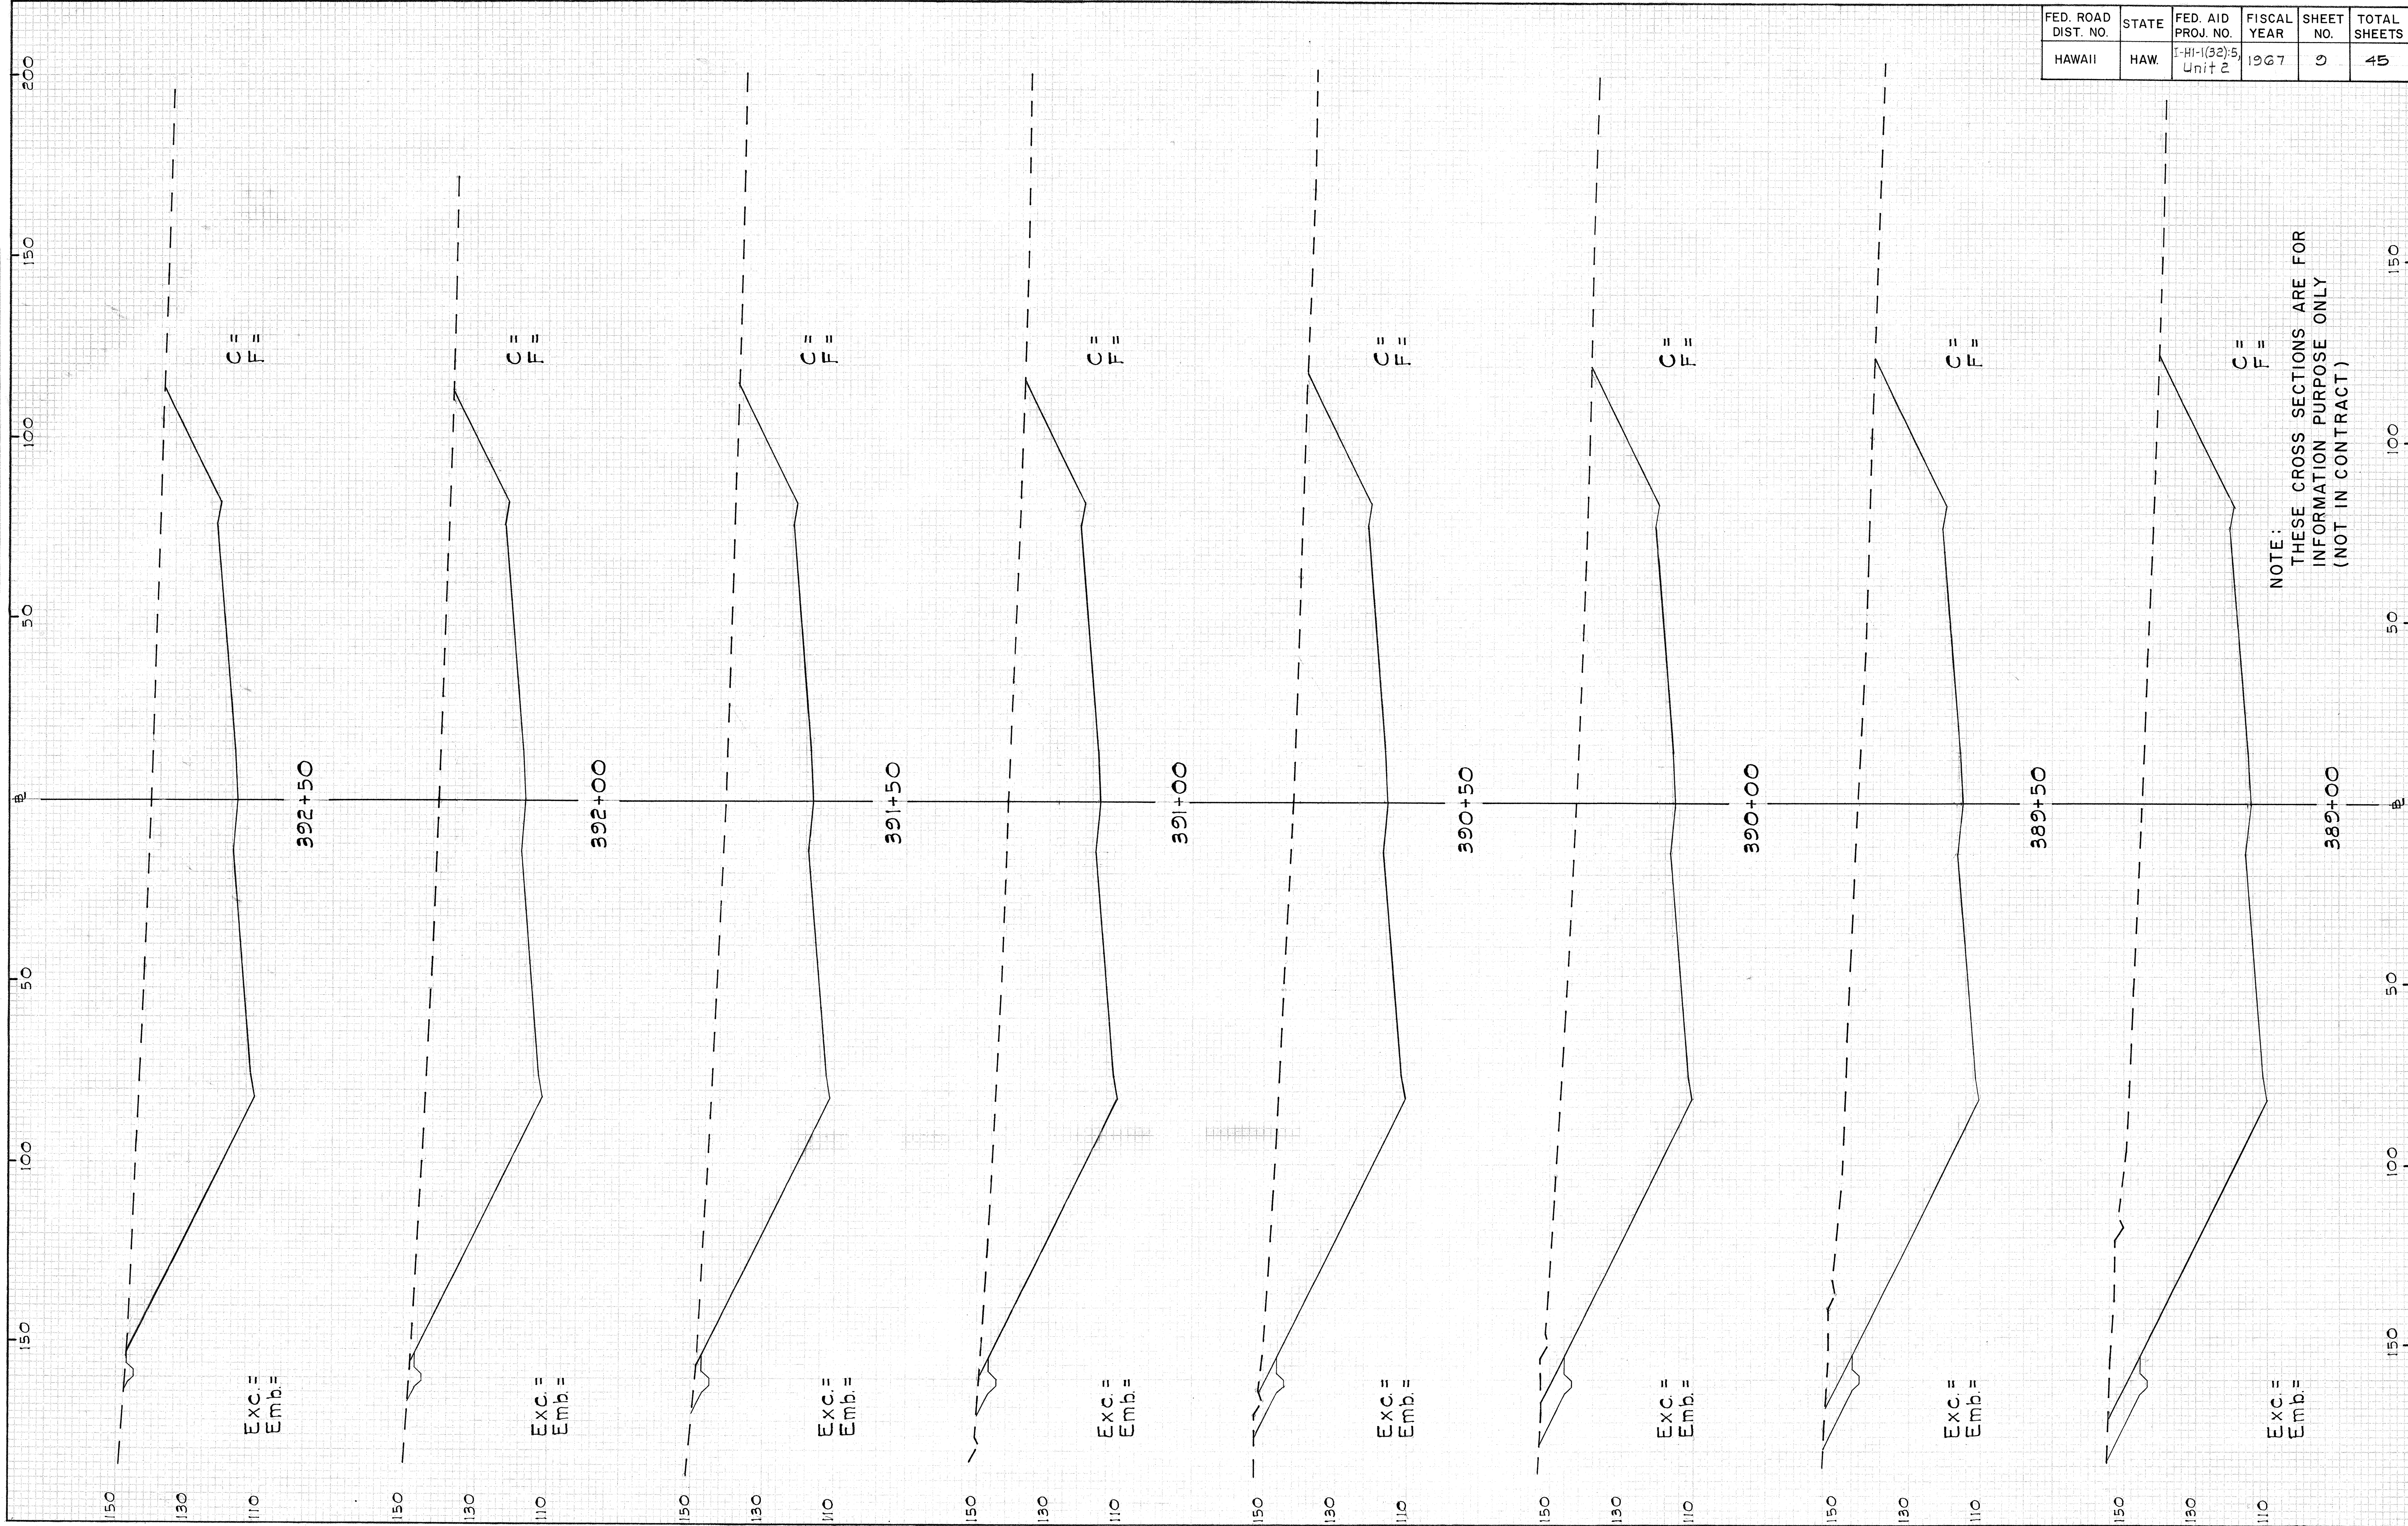


|                     |       |                      |             |           |              |
|---------------------|-------|----------------------|-------------|-----------|--------------|
| FED. ROAD DIST. NO. | STATE | FED. AID PROJ. NO.   | FISCAL YEAR | SHEET NO. | TOTAL SHEETS |
| HAWAII              | HAW.  | 1-HI-1(32)-5, Unit 2 | 1967        | 9         | 45           |

NOTE:  
THESE CROSS SECTIONS ARE FOR  
INFORMATION PURPOSE ONLY  
(NOT IN CONTRACT)

|          |        |      |
|----------|--------|------|
| ORIGINAL | SURVEY | DATE |
| NO.      | DATE   |      |
| NO.      | DATE   |      |
| NO.      | DATE   |      |

|       |        |      |
|-------|--------|------|
| FINAL | SURVEY | DATE |
| NO.   | DATE   |      |
| NO.   | DATE   |      |
| NO.   | DATE   |      |

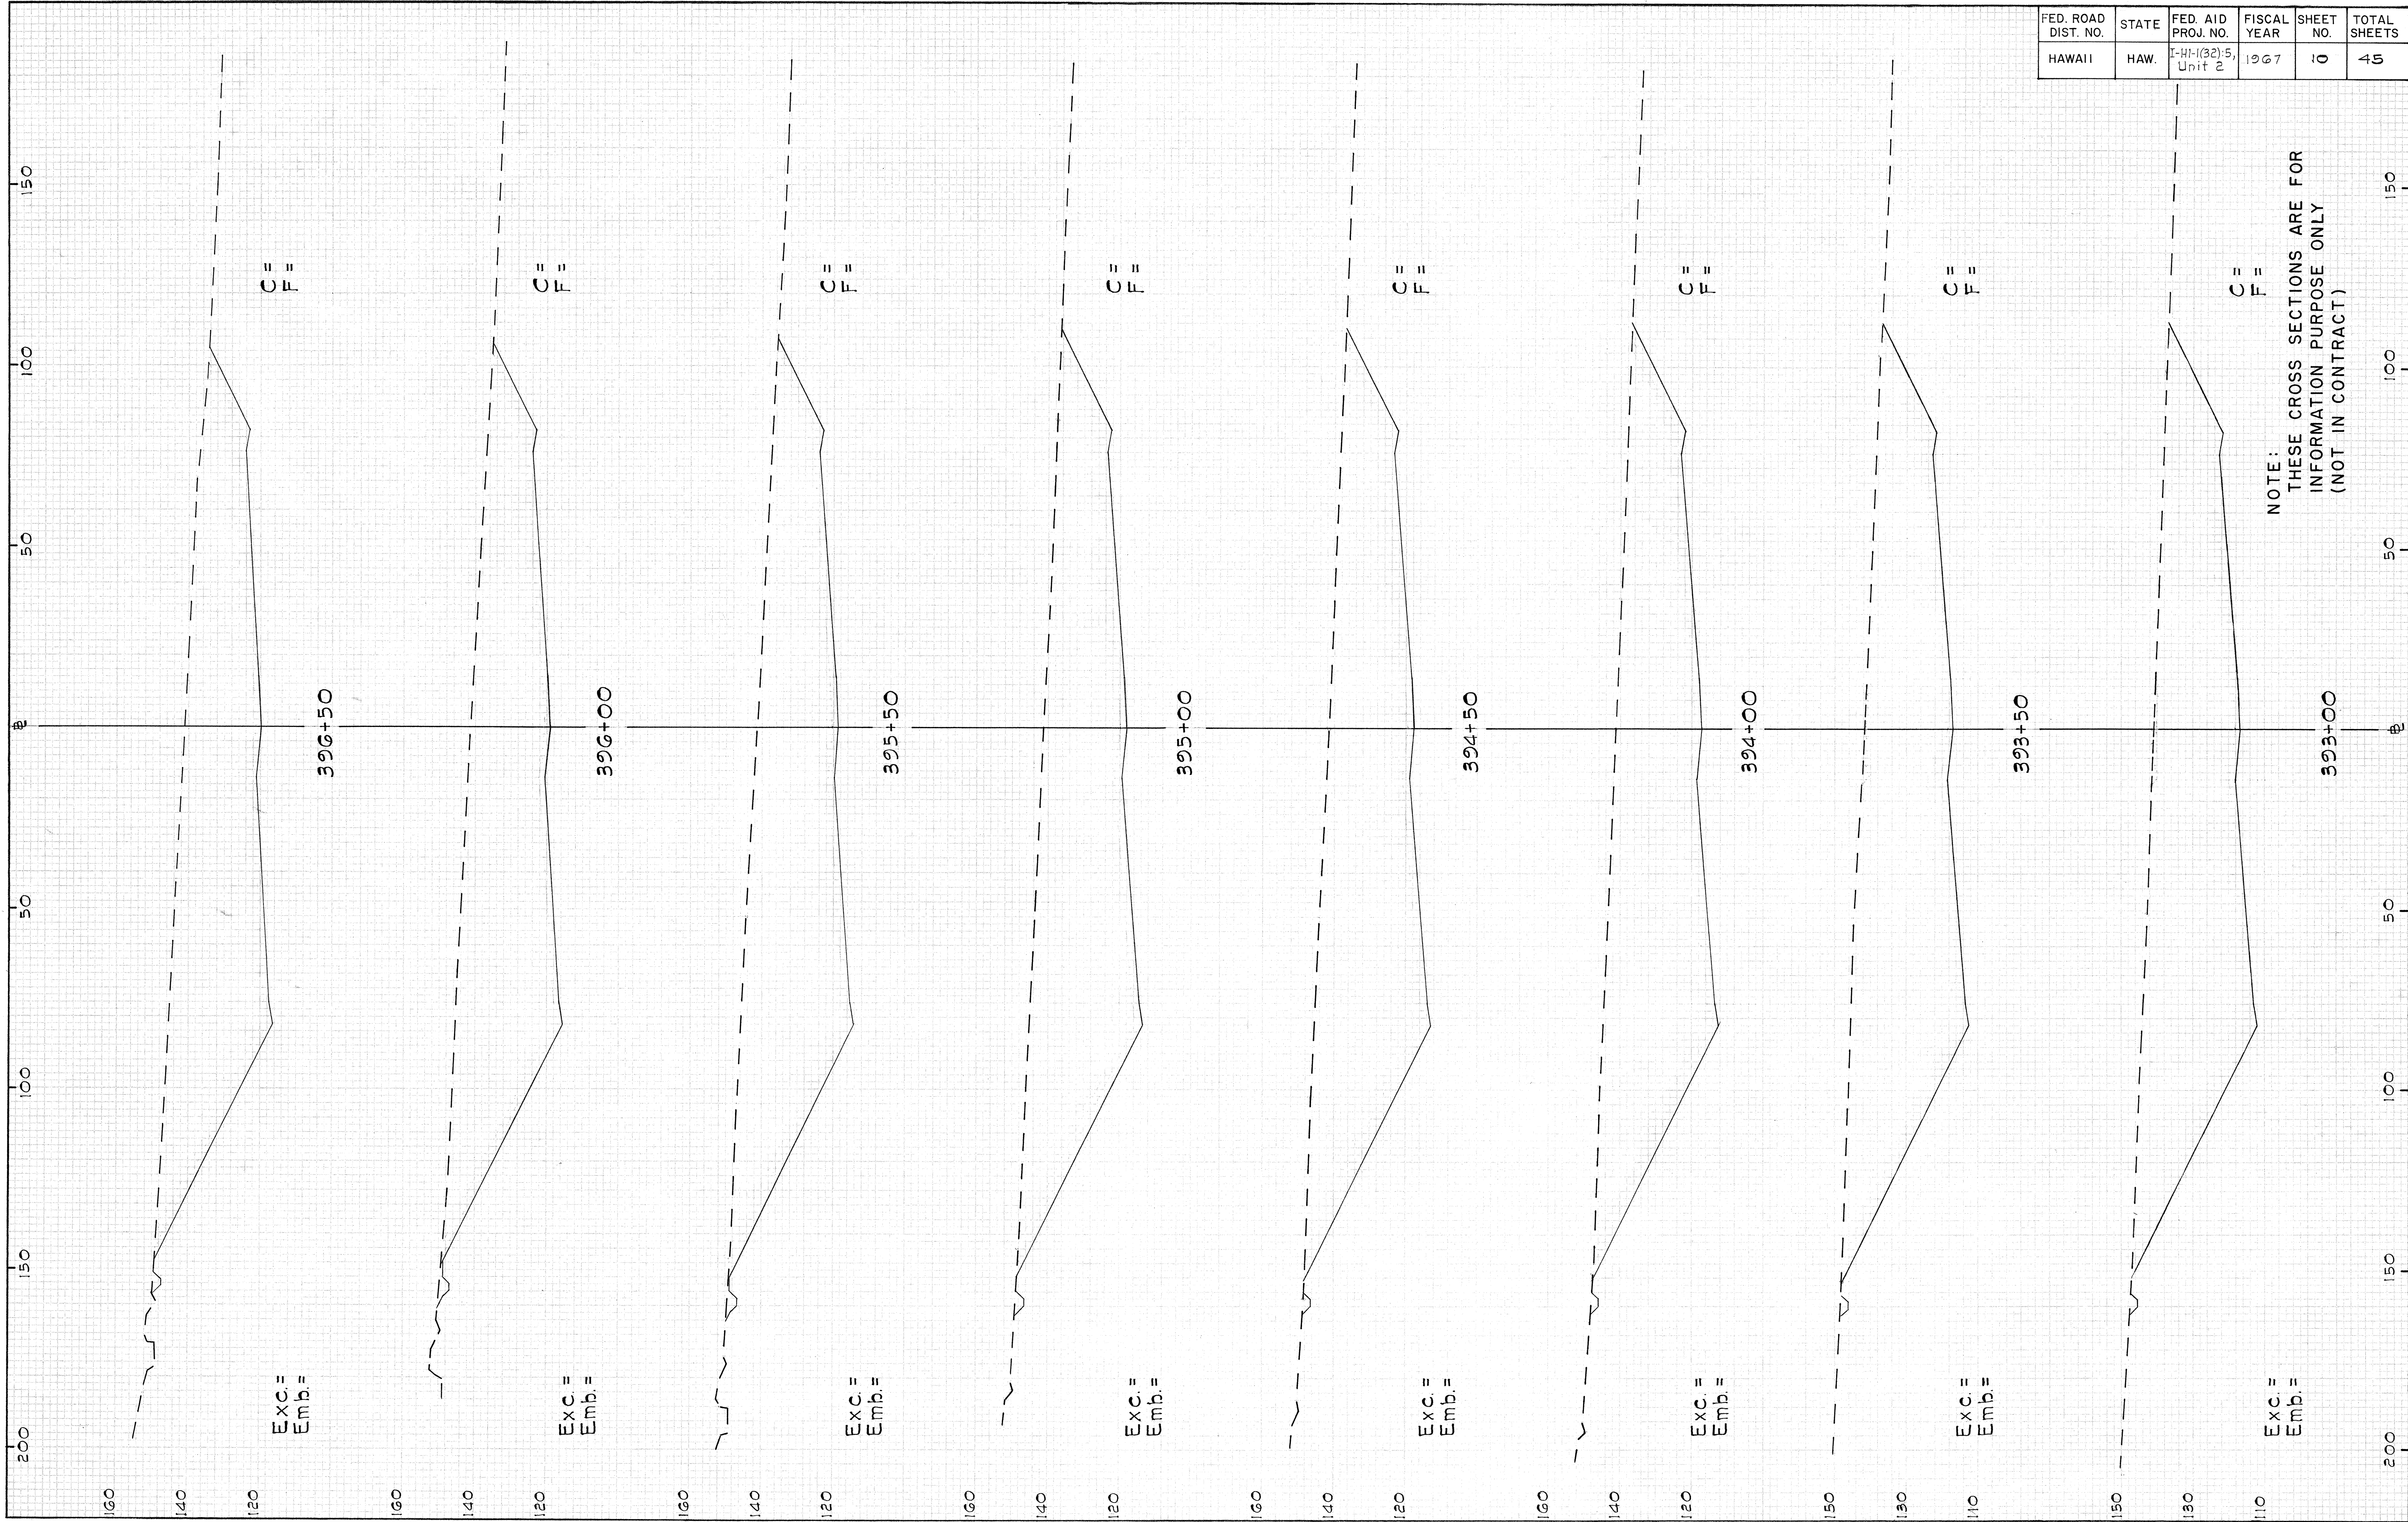

|                     |       |                     |             |           |              |
|---------------------|-------|---------------------|-------------|-----------|--------------|
| FED. ROAD DIST. NO. | STATE | FED. AID PROJ. NO.  | FISCAL YEAR | SHEET NO. | TOTAL SHEETS |
| HAWAII              | HAW.  | I-41-(32)-5, Unit 2 | 1967        | 10        | 45           |

NOTE:  
THESE CROSS SECTIONS ARE FOR  
INFORMATION PURPOSE ONLY  
(NOT IN CONTRACT)

|           |               |    |      |
|-----------|---------------|----|------|
| ORIGINAL  | STATION       | BY | DATE |
| SURVEY    | PLOTTED       |    |      |
| NOTE BOOK | TEMPLATE      |    |      |
| NO.       | AREAS CHANGED |    |      |

|           |               |    |      |
|-----------|---------------|----|------|
| FINAL     | STATION       | BY | DATE |
| SURVEY    | PLOTTED       |    |      |
| NOTE BOOK | TEMPLATE      |    |      |
| NO.       | AREAS CHANGED |    |      |



| FED. ROAD DIST. NO. | STATE | FED. AID PROJ. NO.   | FISCAL YEAR | SHEET NO. | TOTAL SHEETS |
|---------------------|-------|----------------------|-------------|-----------|--------------|
| HAWAII              | HAW.  | I-HI-1(32)-5, Unit 2 | 1967        | 11        | 45           |

NOTE:  
THESE CROSS SECTIONS ARE FOR  
INFORMATION PURPOSE ONLY  
(NOT IN CONTRACT)