
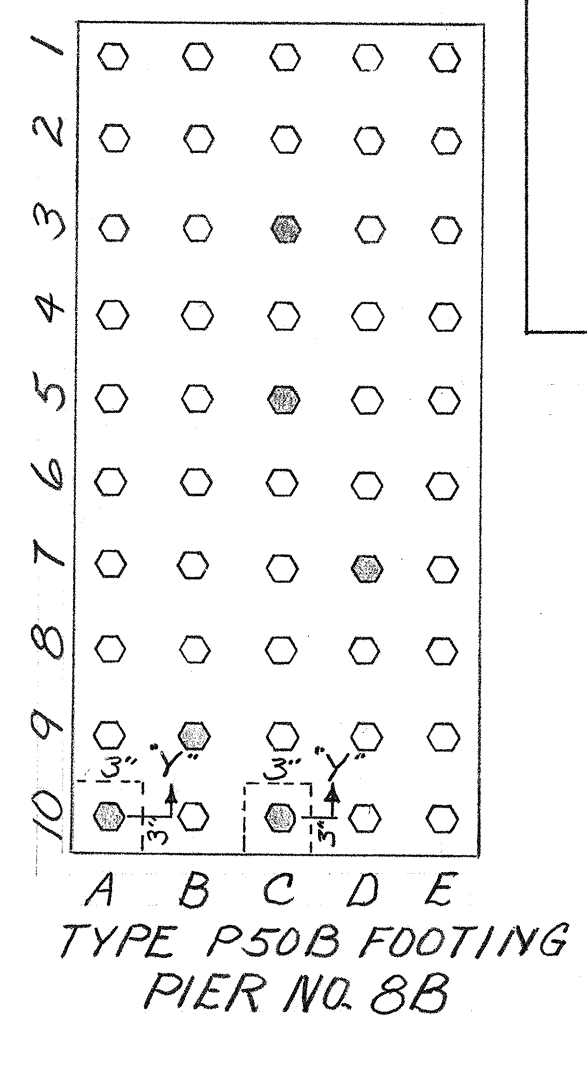
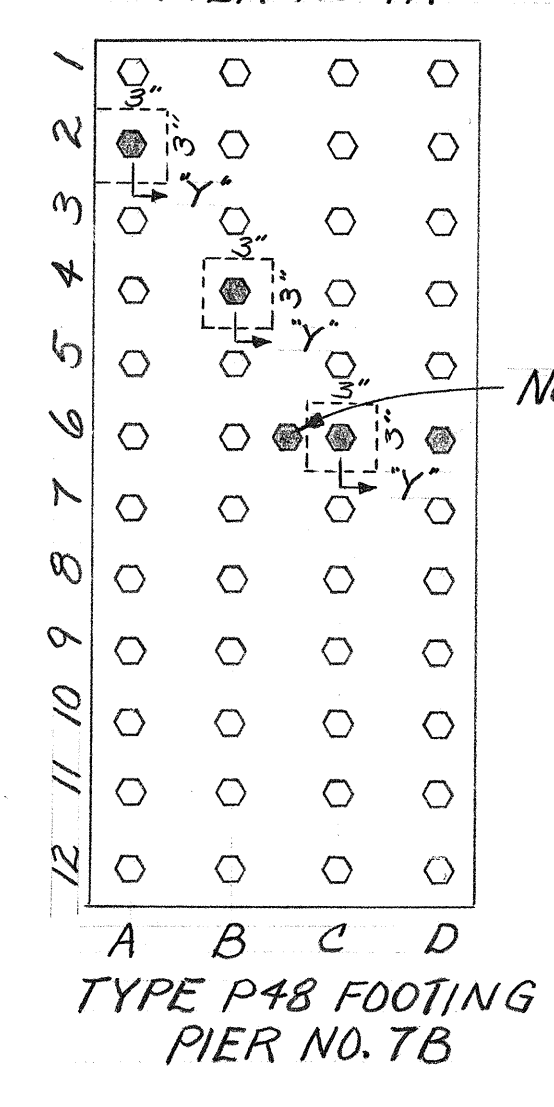
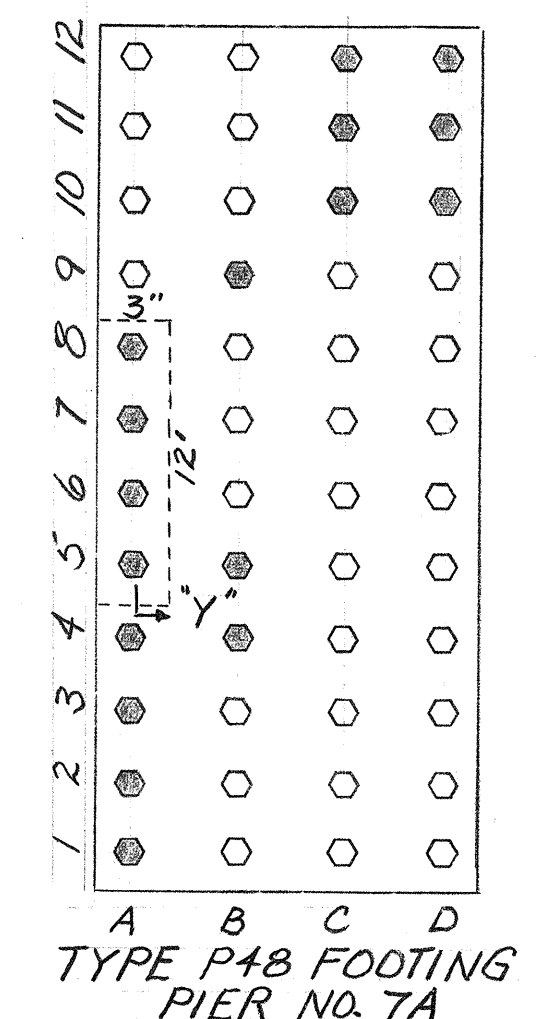
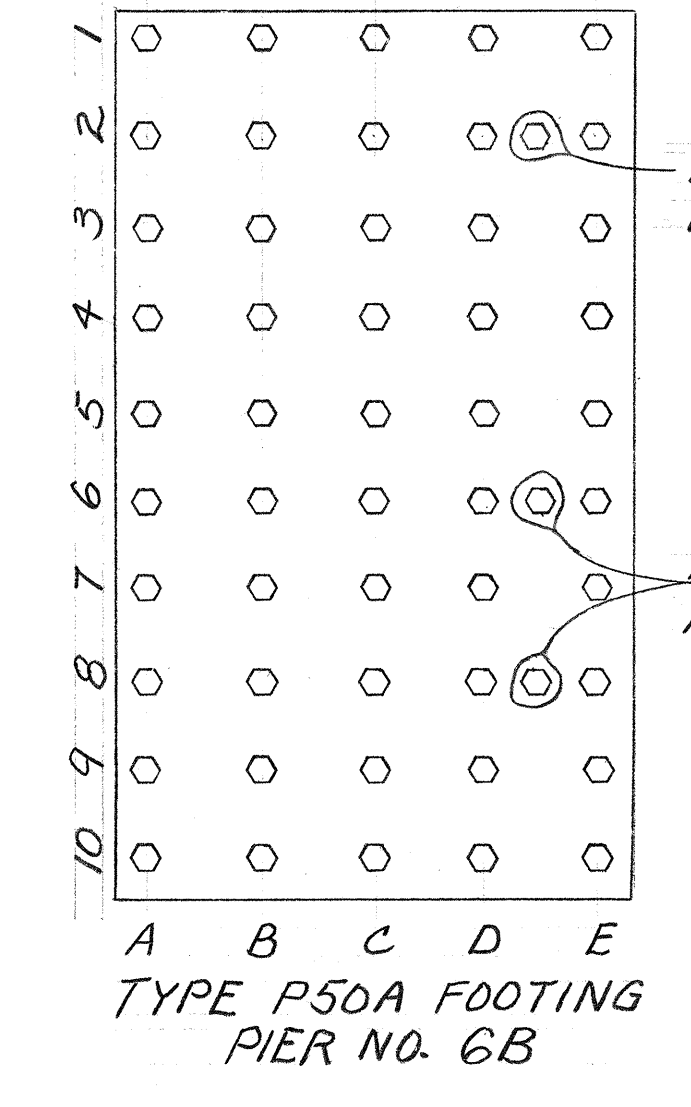
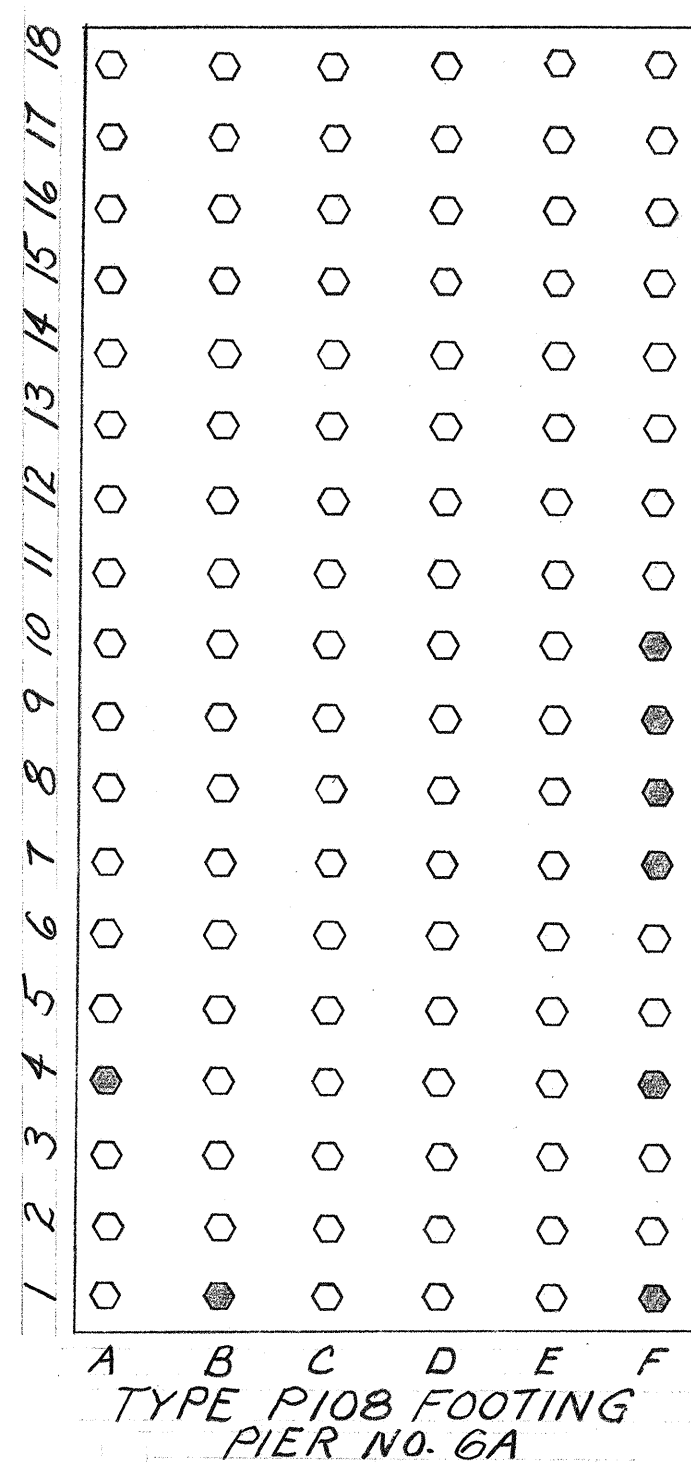
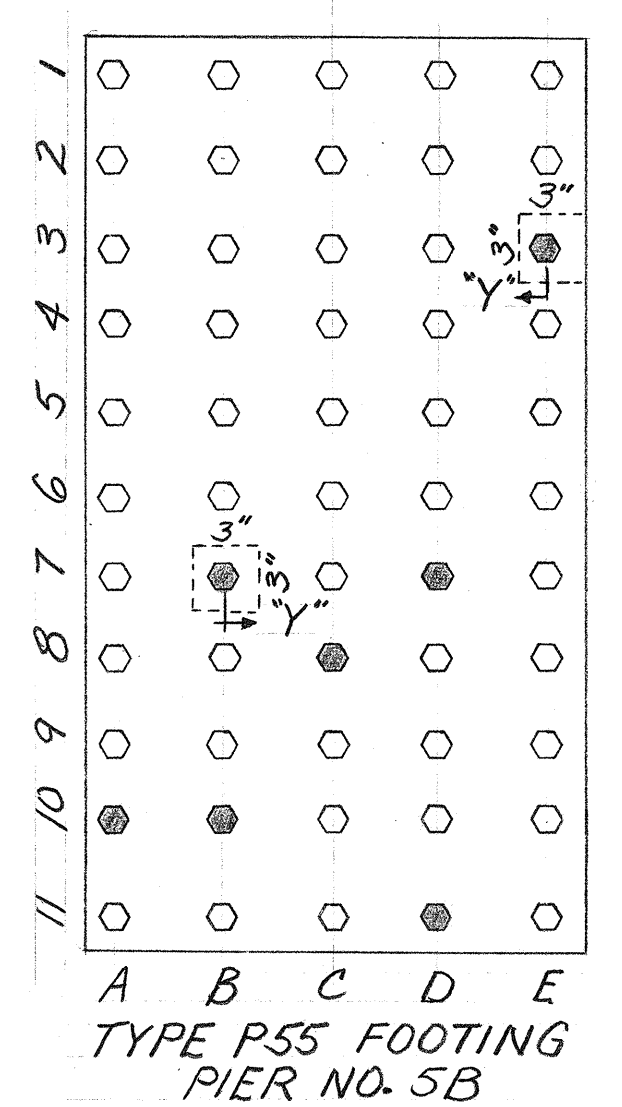




FED. ROAD DIST. NO.	STATE	FED. AID PROJ. NO.	FISCAL YEAR	SHEET NO.	TOTAL SHEETS
HAWAII	HAW.	I-HI-1(32):5 UNIT 2	1967	47	45

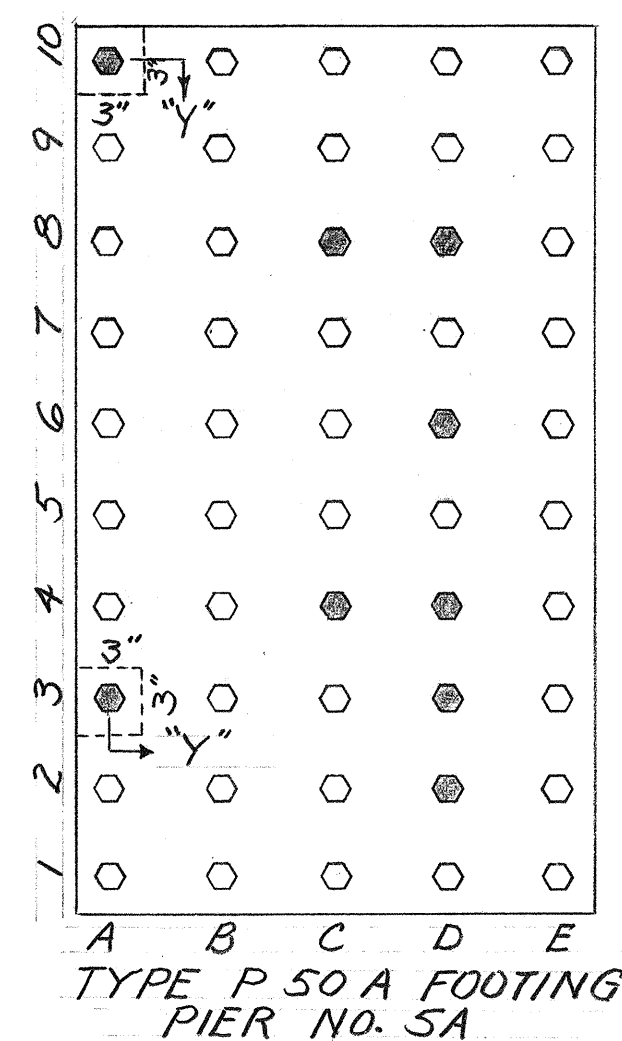


← OUTBOUND

New Pile


INBOUND →

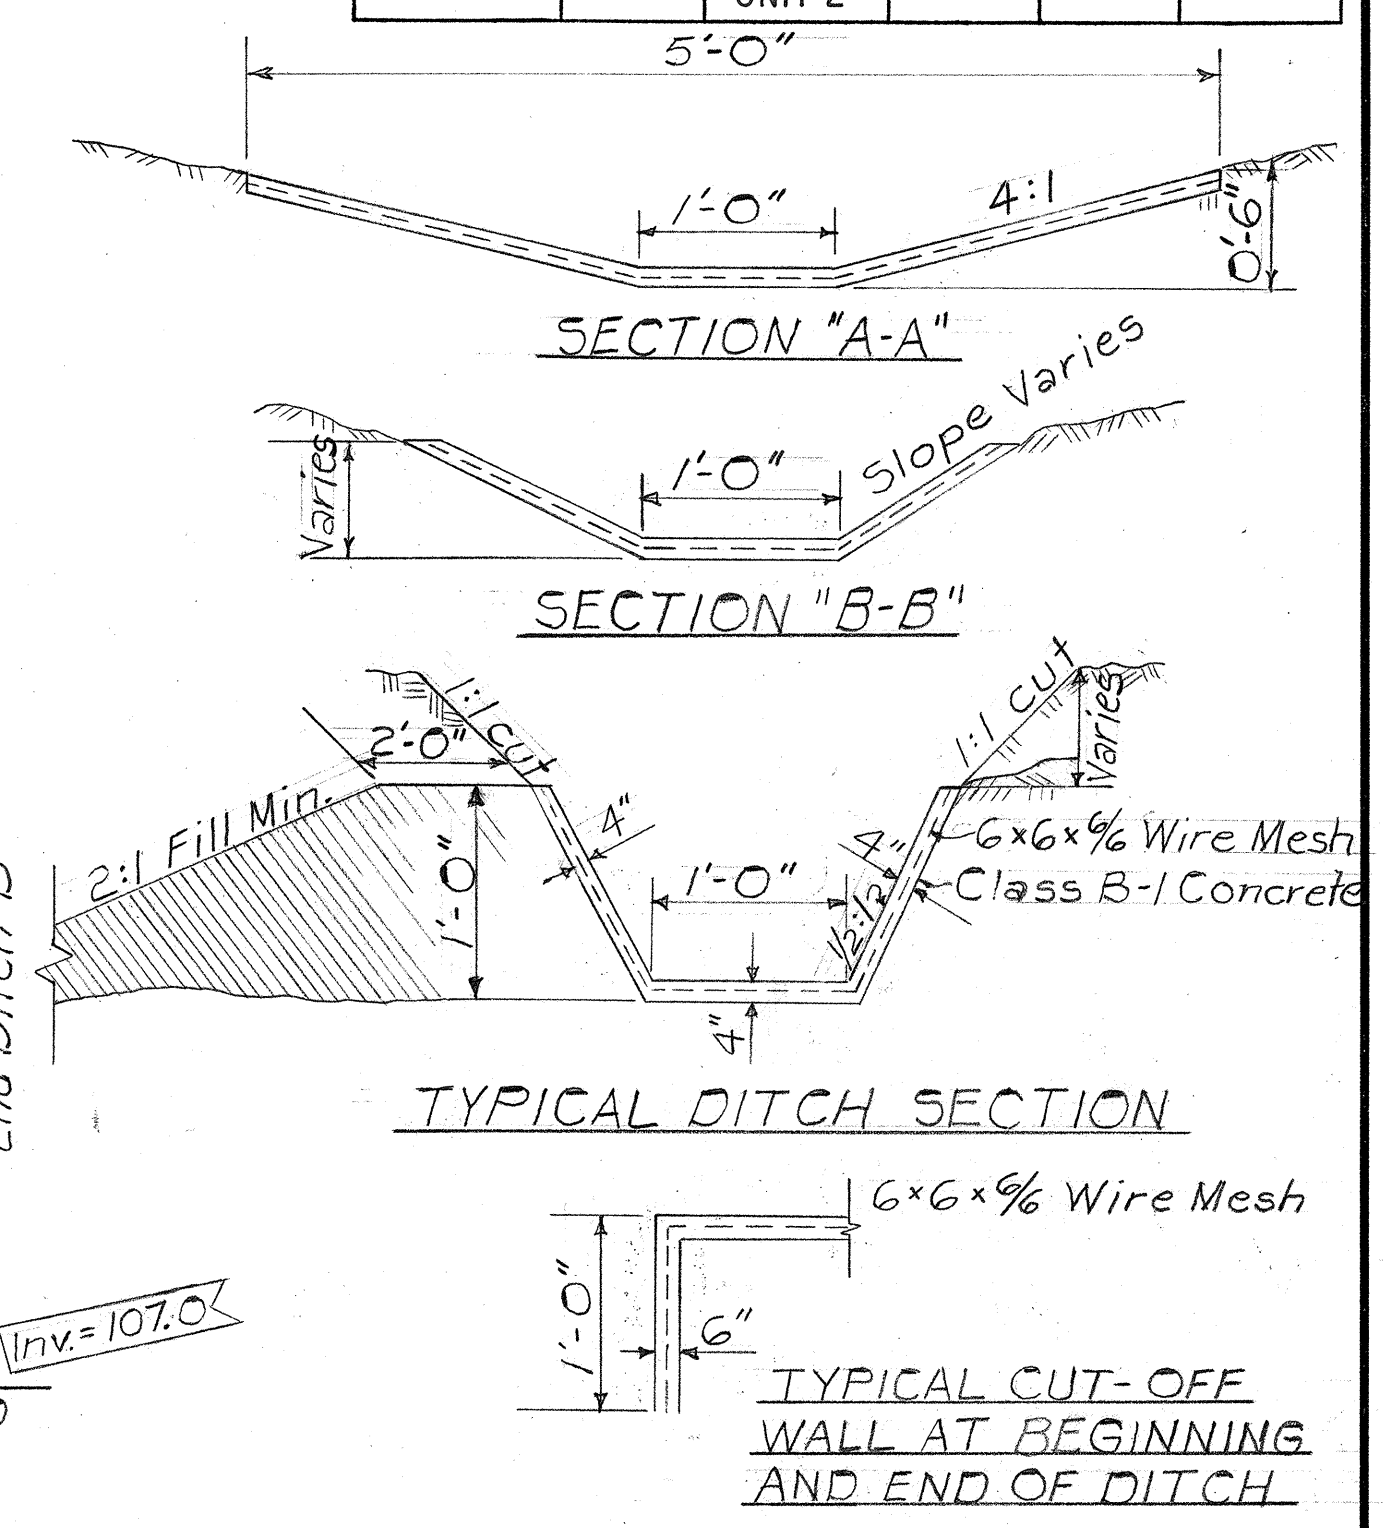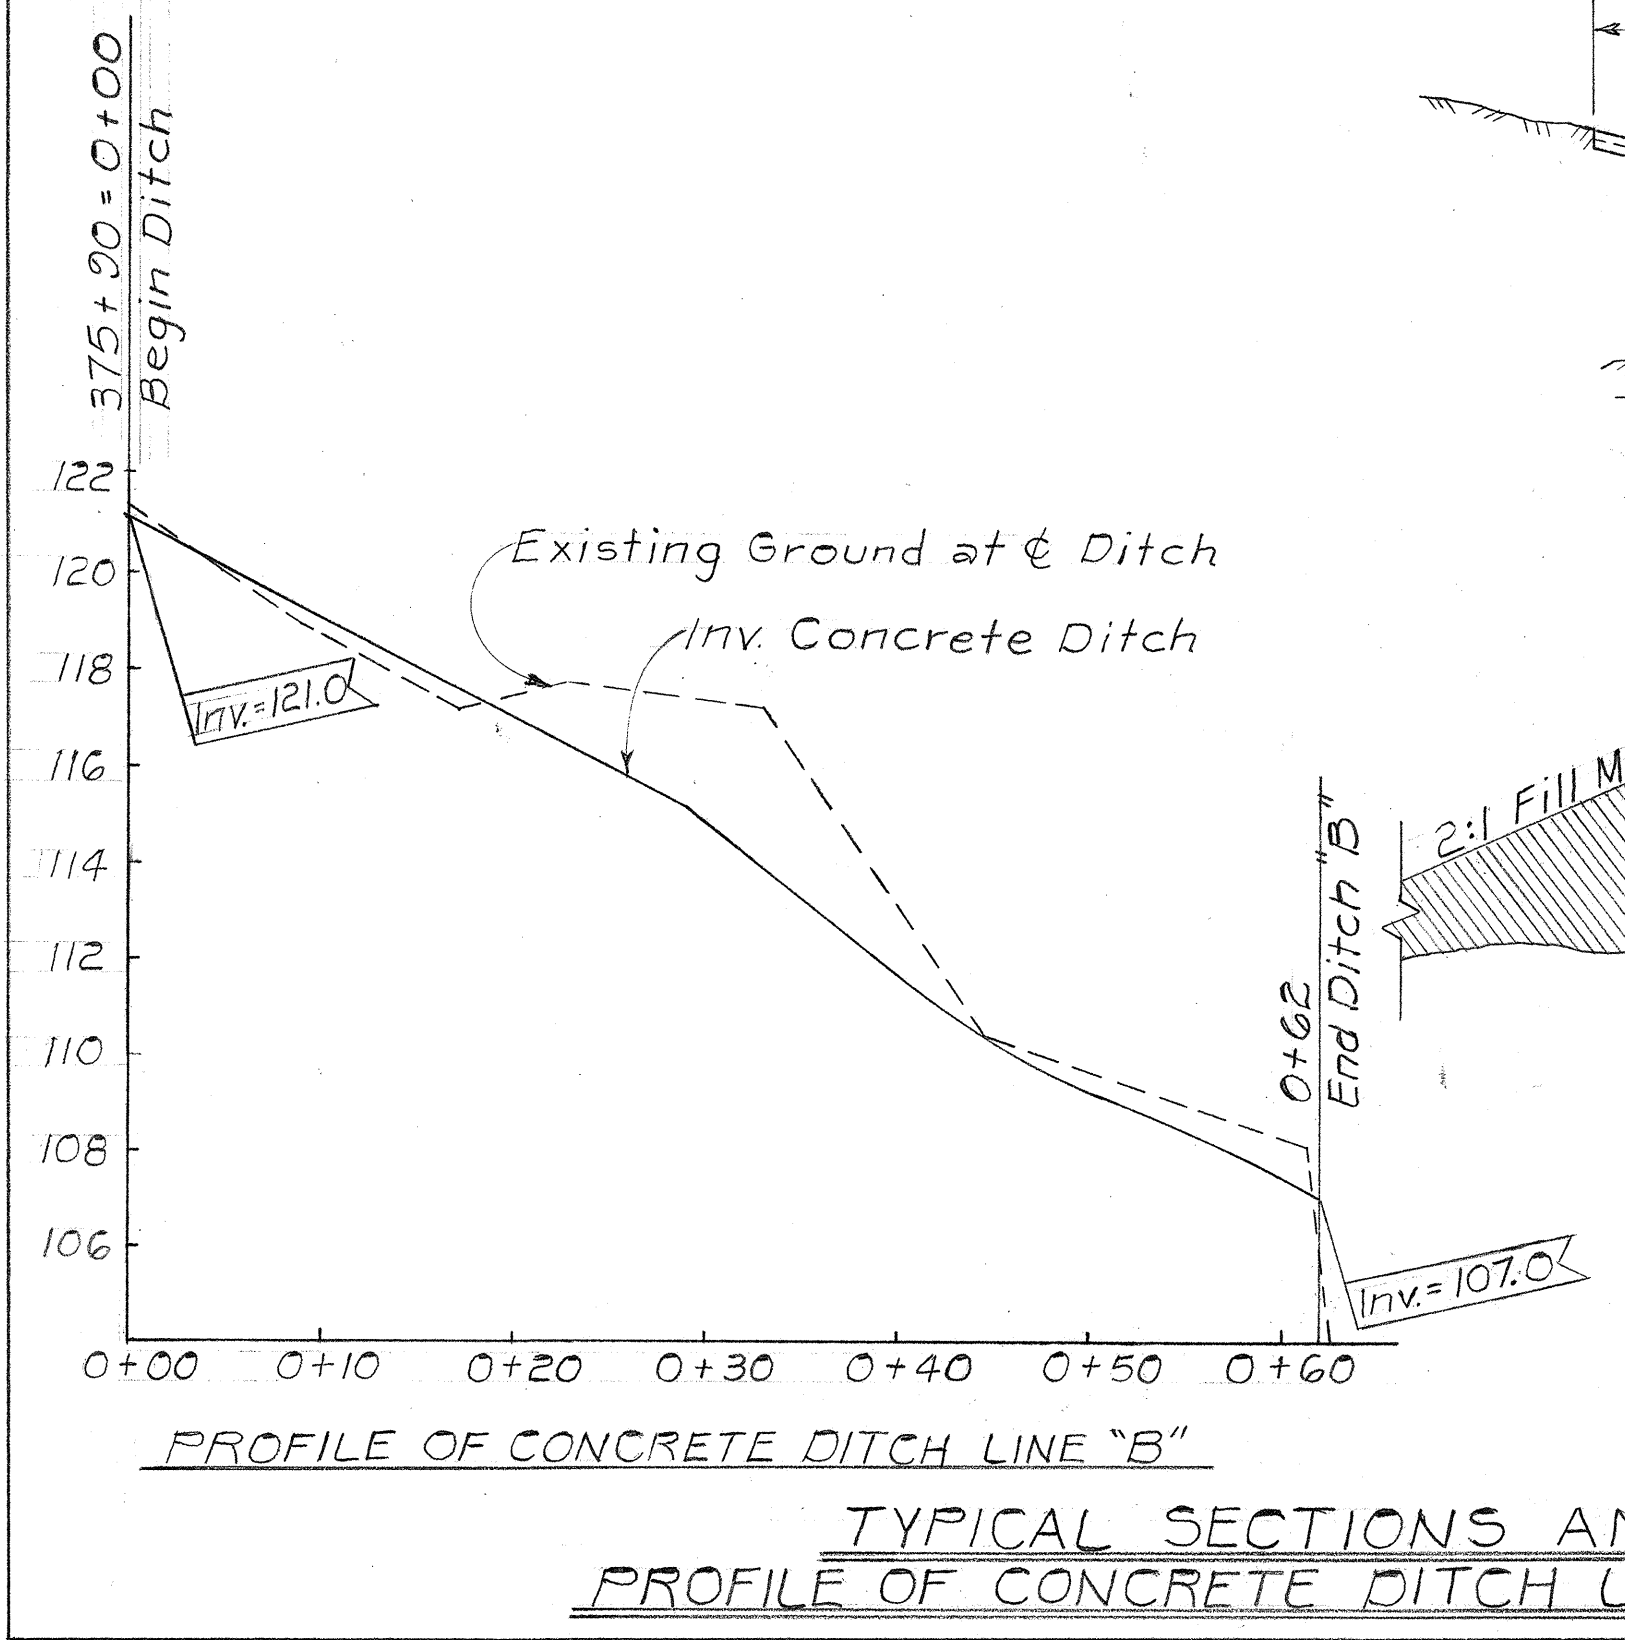


- NOTES:
1. Install dowels on piles as shown.
 2. Portion of pile embedded into ftg. shall be sound concrete. Damaged portions shall be removed and pile cut-off elev. lowered as required by the Engineer.
 3. 4-8x4-8" dowels as shown shall be provided for all piles having less than 18" prestress wire strands extension in ftg.
 4. No changes in foundation detail except as noted in contract change.

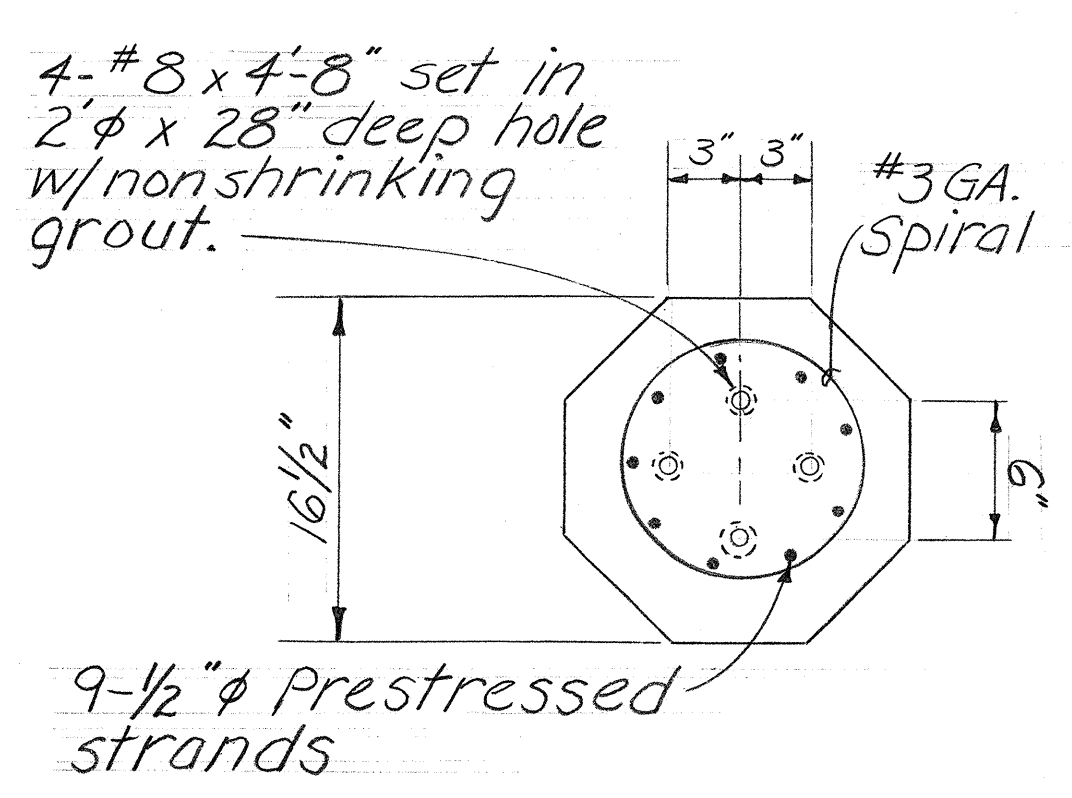

TYPICAL X-SECTION PILE
Not to Scale

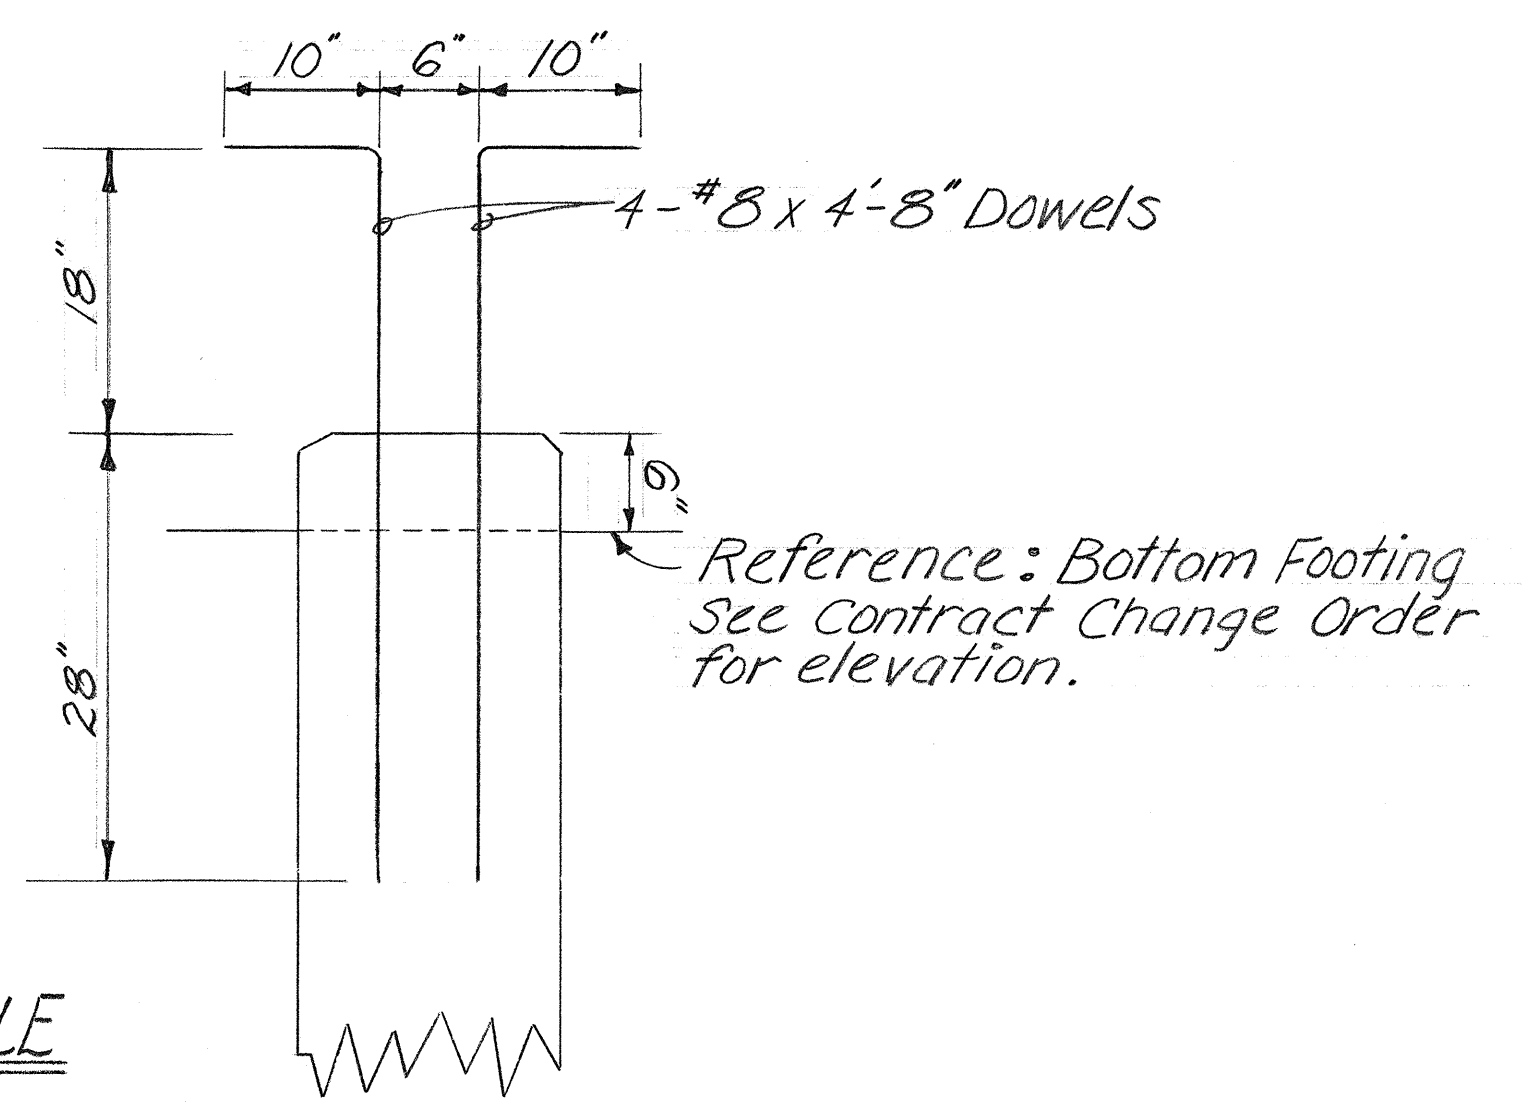

TYPICAL LONG SECTION PILE
Scale: 1"=1'-0"

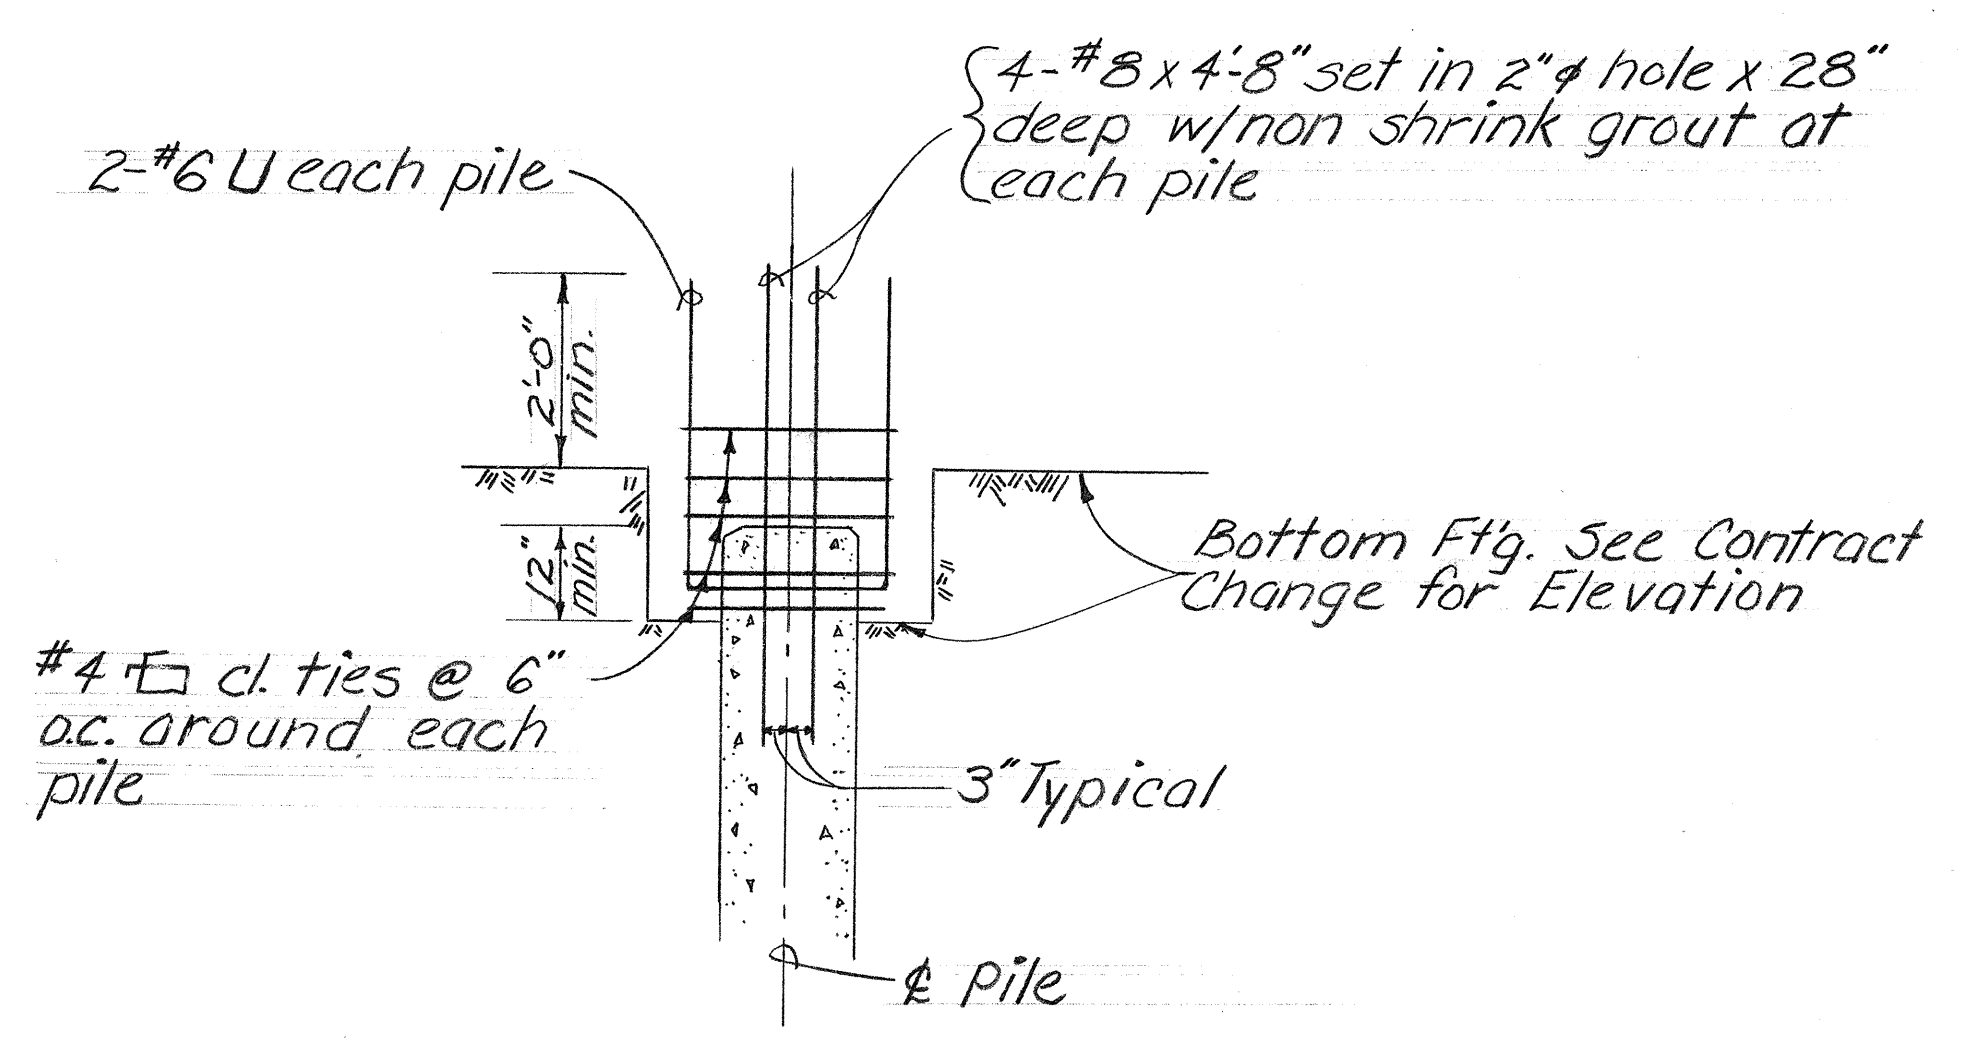

SECTION "Y"
Scale: 1/2"=1'-0"

STATE OF HAWAII
DEPARTMENT OF TRANSPORTATION
HIGHWAYS DIVISION

WAIKELE STREAM BRIDGE
AS BUILT
FOUNDATION DETAIL
Proj. No. I-HI-1(32):5,unit2
Scale As Shown Date:

SHEET No. 47 OF 45 SHEETS

ORIGINAL PLAN	DATE
DESIGNED BY	
QUANTITIES BY	
CHECKED BY	
NO.	