

INDEX TO DRAWINGS	
SHEET NO.	DESCRIPTION
1	TITLE SHEET
2-3	TYPICAL SECTIONS
4	PLAN AND PROFILE
5	SUPER ELEVATION DIAGRAM
6-7	CONSTRUCTION I.D. SIGN
8-11	CROSS SECTIONS
12-45	STRUCTURE PLANS AND DETAILS
46	REVISION PIER I-B
47	REINFORCING STEEL DOWELS IN PILES

FED. ROAD DIST. NO.	STATE	FED. AID PROJ. NO.	FISCAL YEAR	SHEET NO.	TOTAL SHEETS
HAWAII	HAW	I-HI-1(32):5 Unit 2	1967	1	45

STATE OF HAWAII
DEPARTMENT OF TRANSPORTATION
HIGHWAYS DIVISION
HONOLULU, HAWAII
"AS BUILT"
PLANS FOR
CONSTRUCTION OF A PORTION OF
INTERSTATE ROUTE H-1
WAIKELE STREAM BRIDGE

FEDERAL AID INTERSTATE PROJECT No. I-HI-1(32):5, UNIT 2

DISTRICT OF EWA
ISLAND OF OAHU

NOTE:
ALL CHANGES MADE DURING CONSTRUCTION HAVE BEEN
NOTED ON THESE TRACINGS IN RED AND CHECKED BY:


Thomas N. Miyamoto
PROJECT ENGINEER

5/6/69
DATE


SCALES:

PLAN & PROFILE HOR. 1"=100'
VER. 1"= 10'

CROSS SECTION HOR. 1"= 20'
VER. 1"= 20'

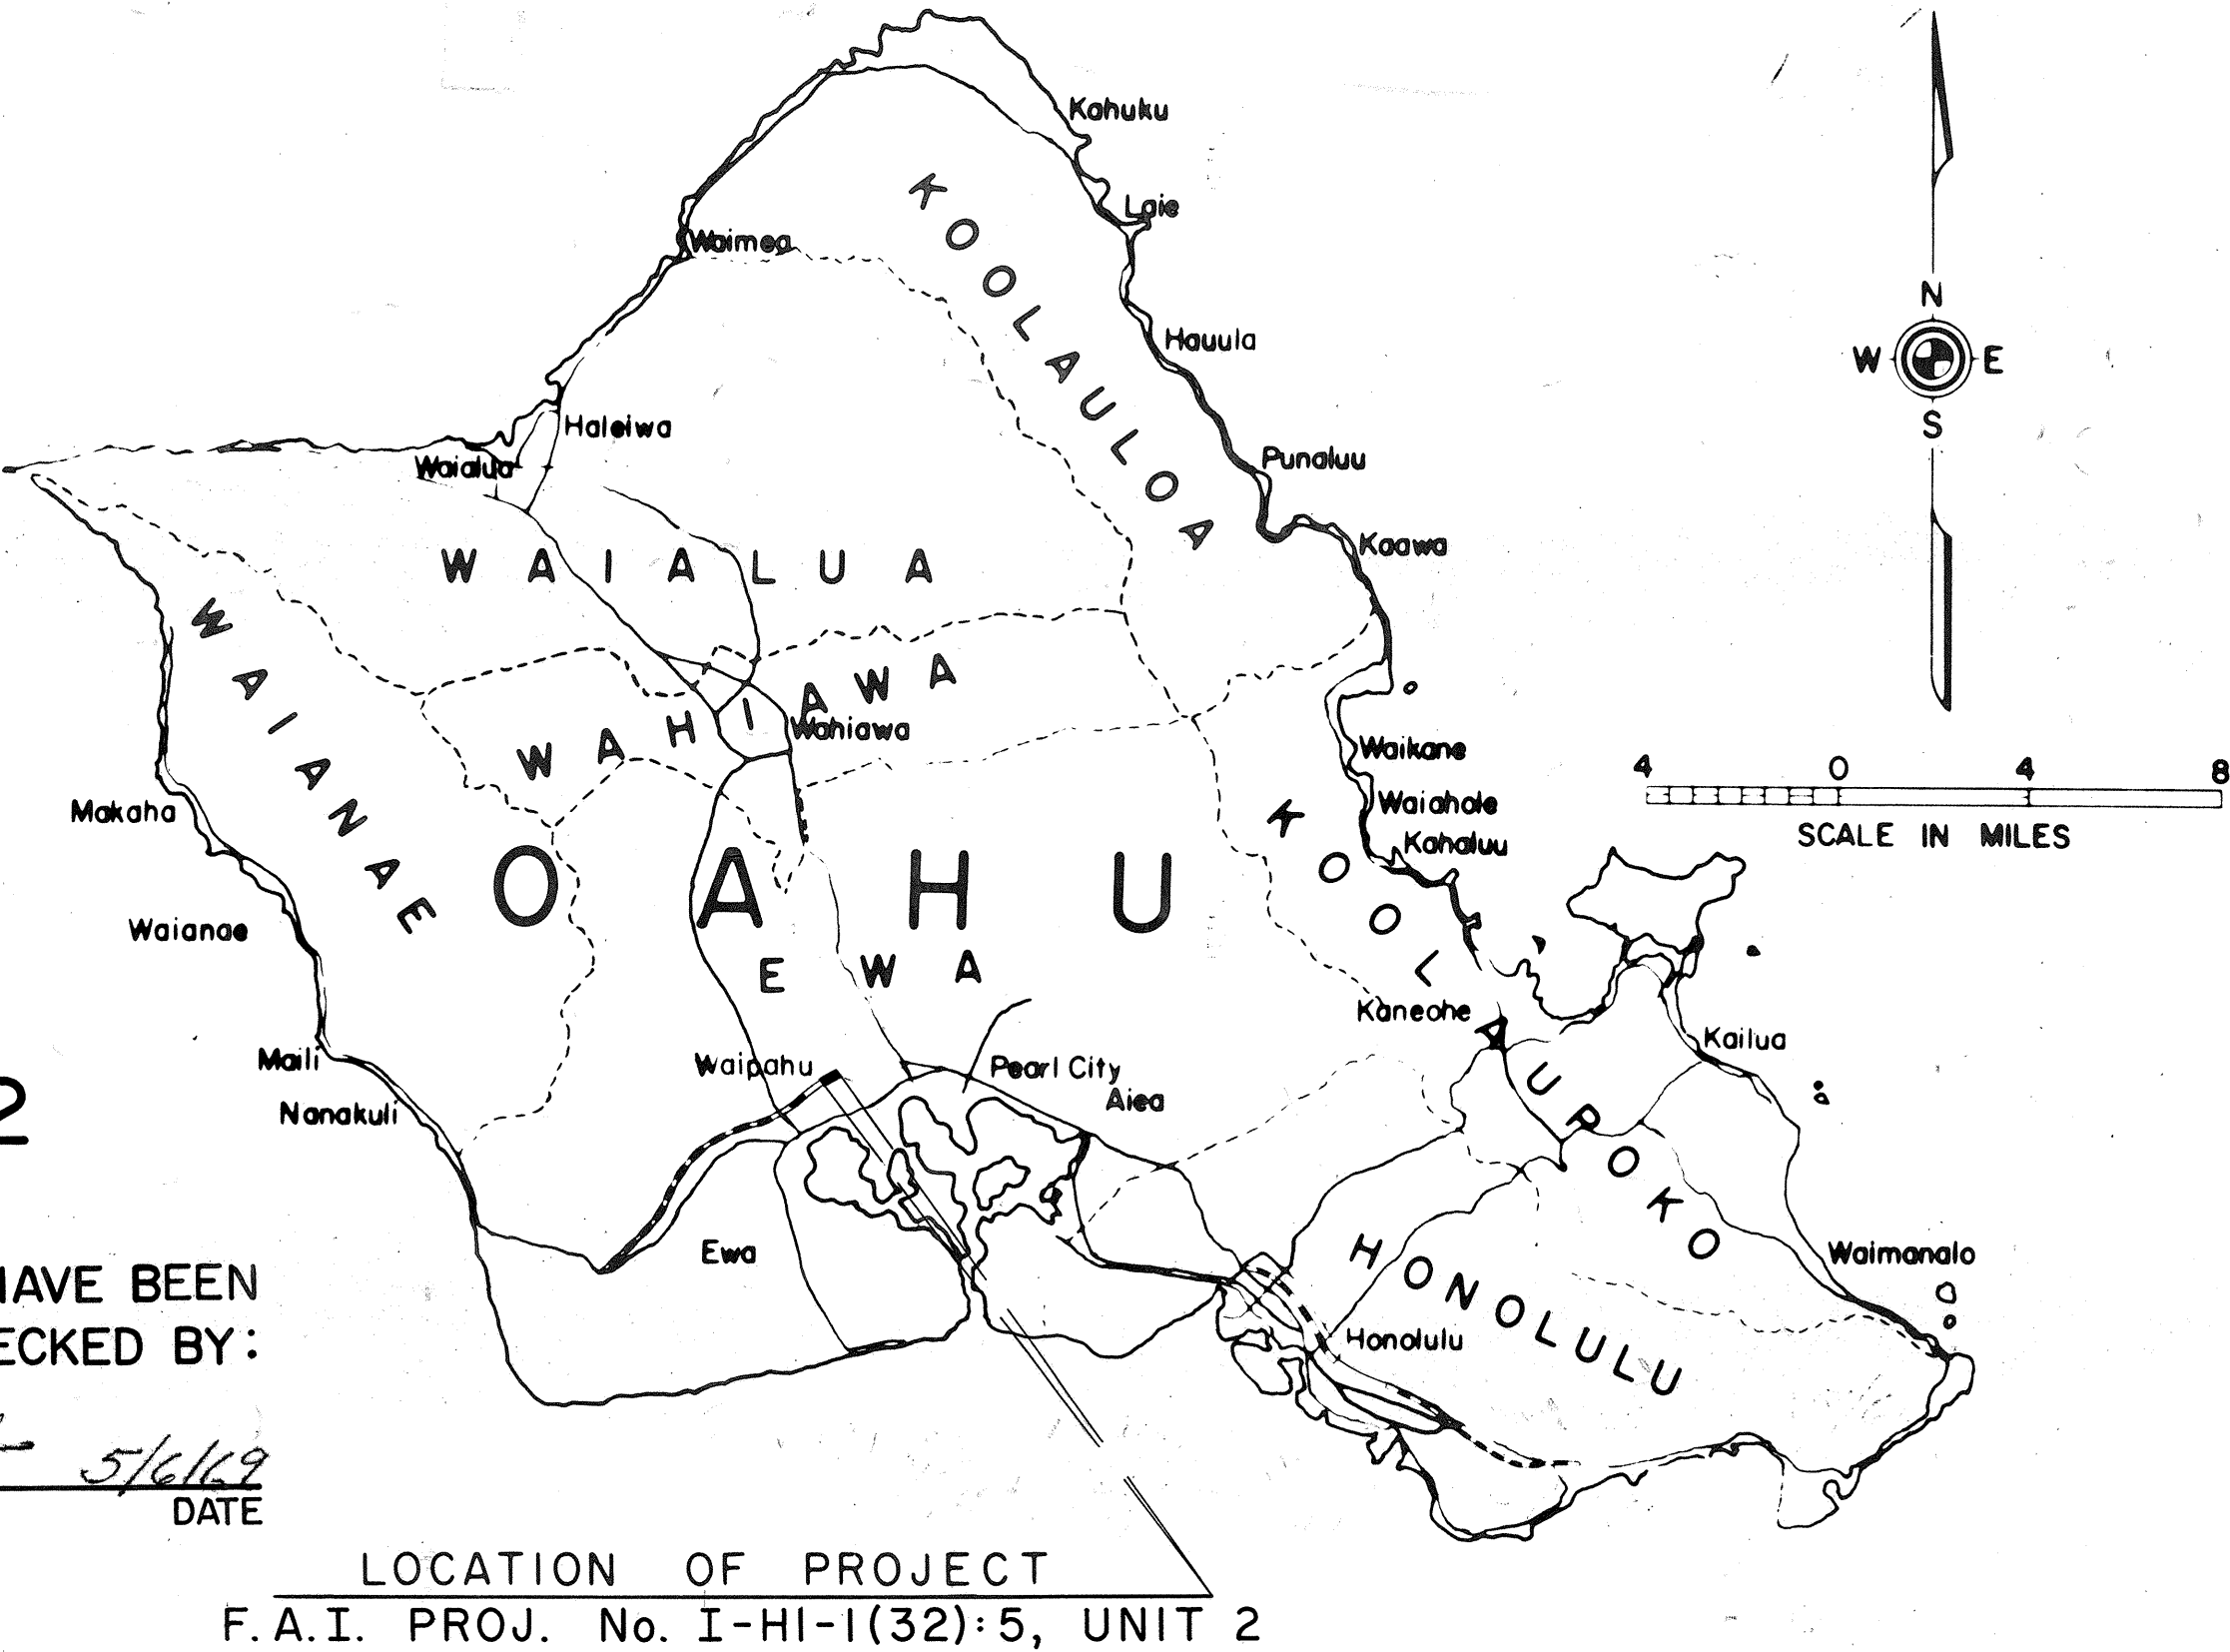

LOCATION OF PROJECT
F.A.I. PROJ. No. I-HI-1(32):5, UNIT 2

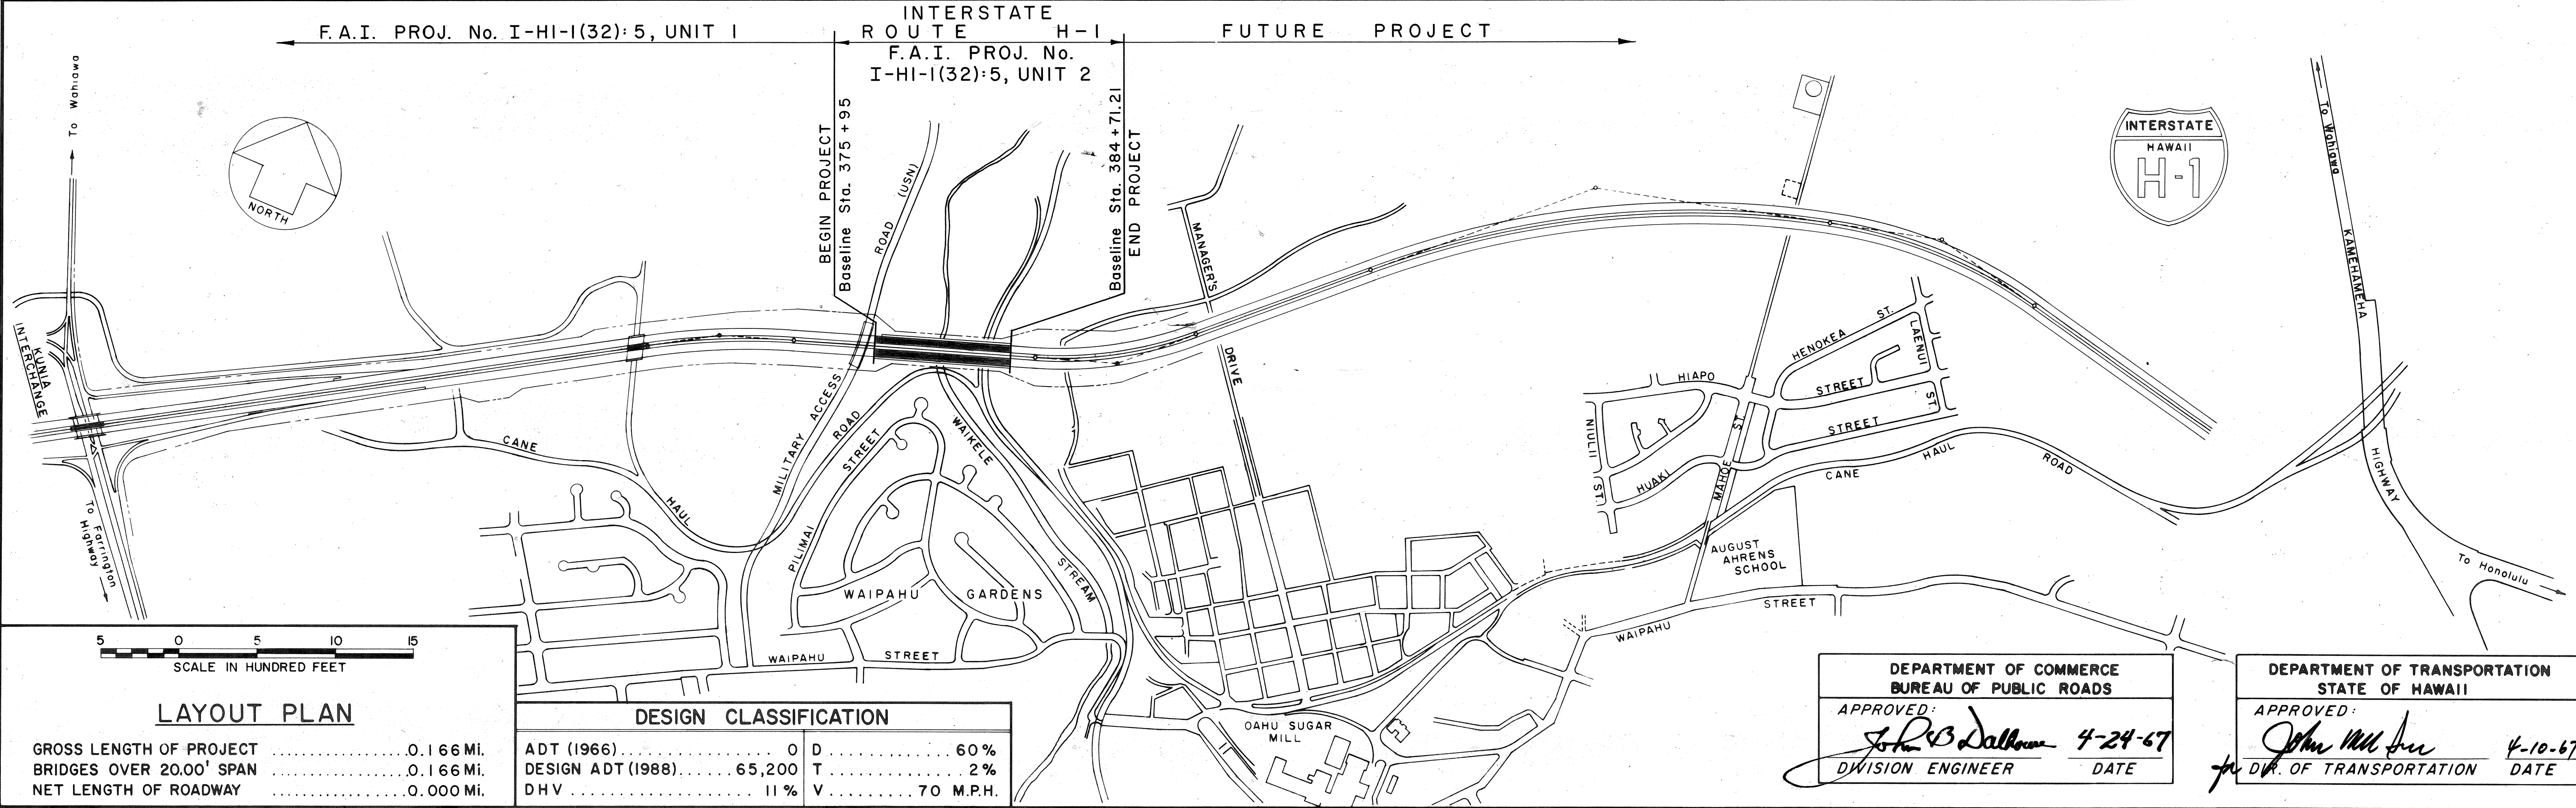

LAYOUT PLAN

GROSS LENGTH OF PROJECT0.166 Mi.
BRIDGES OVER 20.00' SPAN0.166 Mi.
NET LENGTH OF ROADWAY0.000 Mi.

DESIGN CLASSIFICATION

ADT (1966) 0 D 60%
DESIGN ADT (1988) 65,200 T 2%
DHV 11% V 70 M.P.H.

DEPARTMENT OF COMMERCE
BUREAU OF PUBLIC ROADS
APPROVED: *John B. Dalton* 4-24-67
DIVISION ENGINEER DATE

DEPARTMENT OF TRANSPORTATION
STATE OF HAWAII
APPROVED: *John M. Lee* 4-18-67
DIR. OF TRANSPORTATION DATE