



ED. ROAD DIST. NO.	STATE	FED. AID PROJ. NO.	FISCAL YEAR	HEET NO.	TOTAL SHEETS
HAWAII	HAW.	I-11-1(G) UNIT #3	1966	225	235

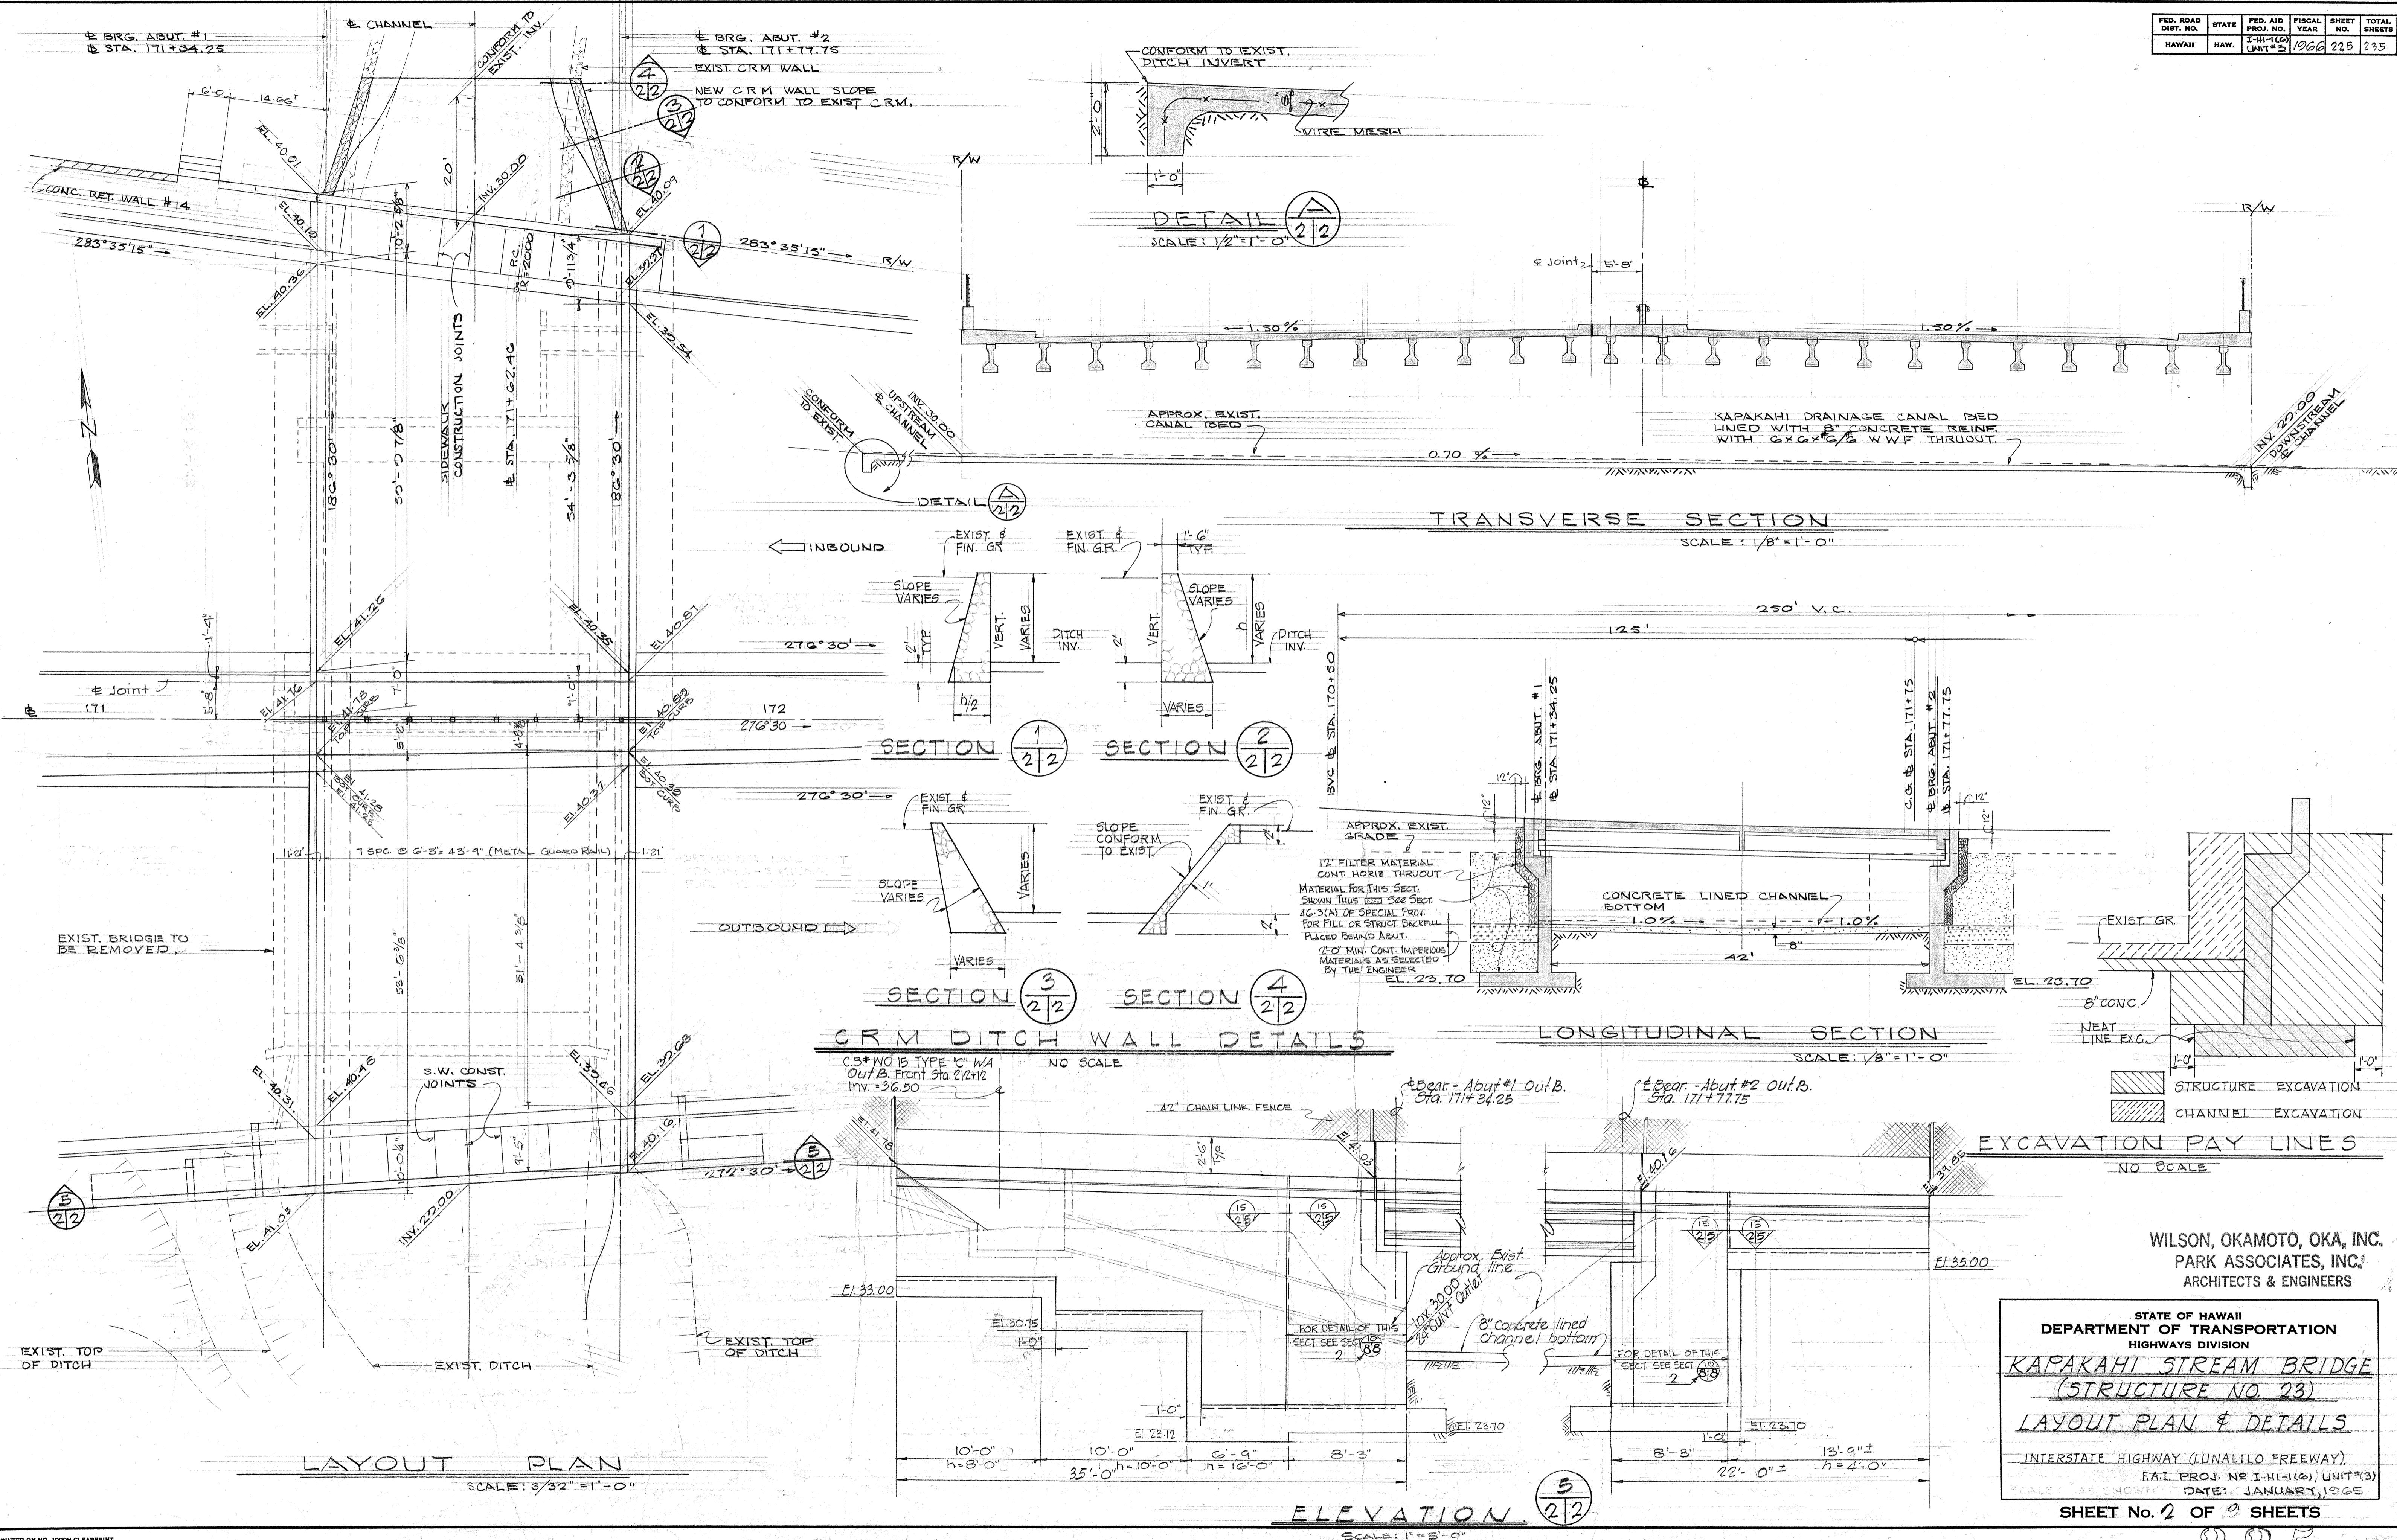


FED. ROAD DIST. NO.	STATE	FED. AID PROJ. NO.	FISCAL YEAR	SHEET NO.	TOTAL SHEETS
HAWAII	HAW.	F-1-HI-102 UNIT #3	1066	22G	235

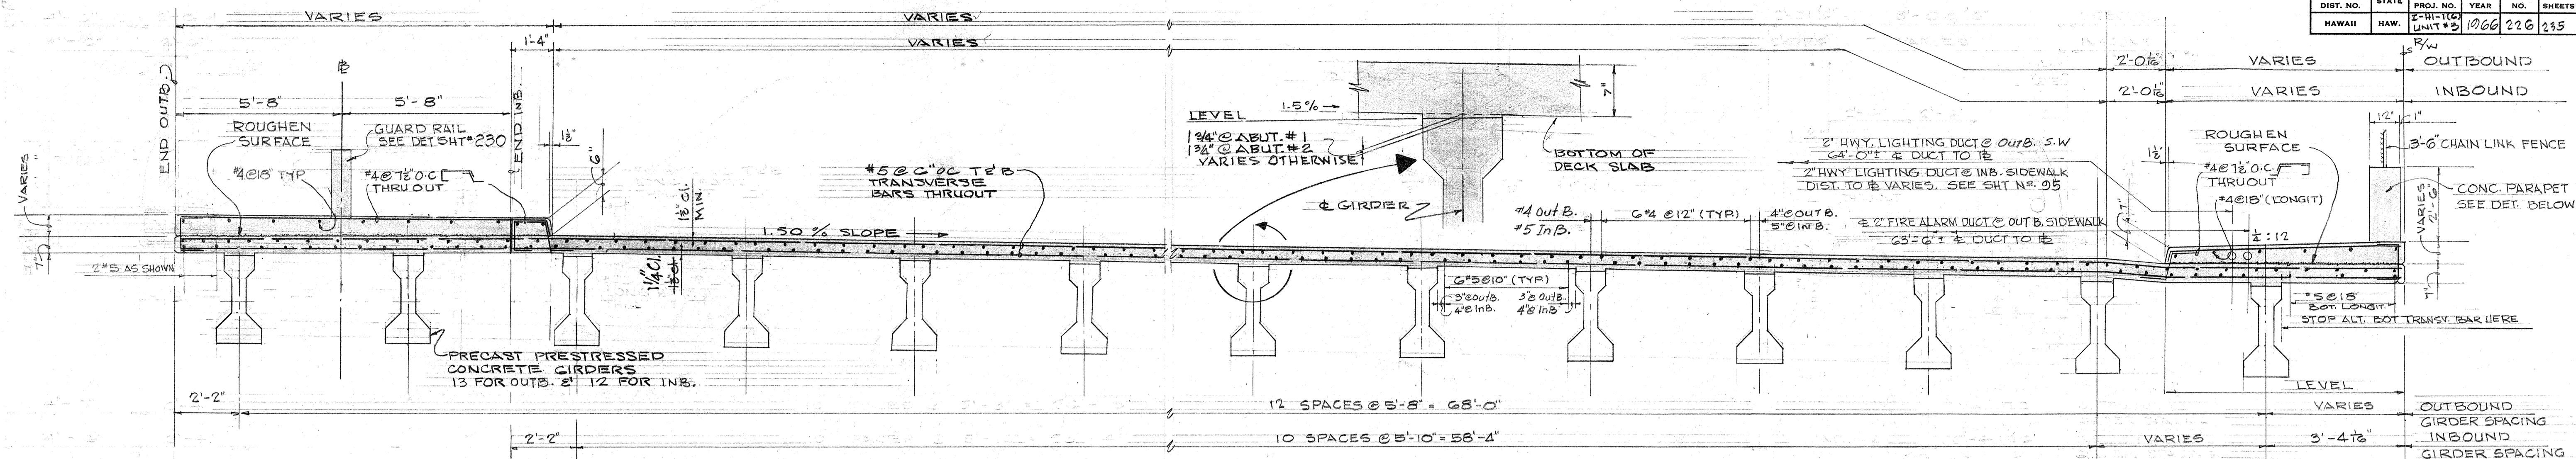

TYPICAL BRIDGE SECTION

SCALE: 3/8" = 1'-0"

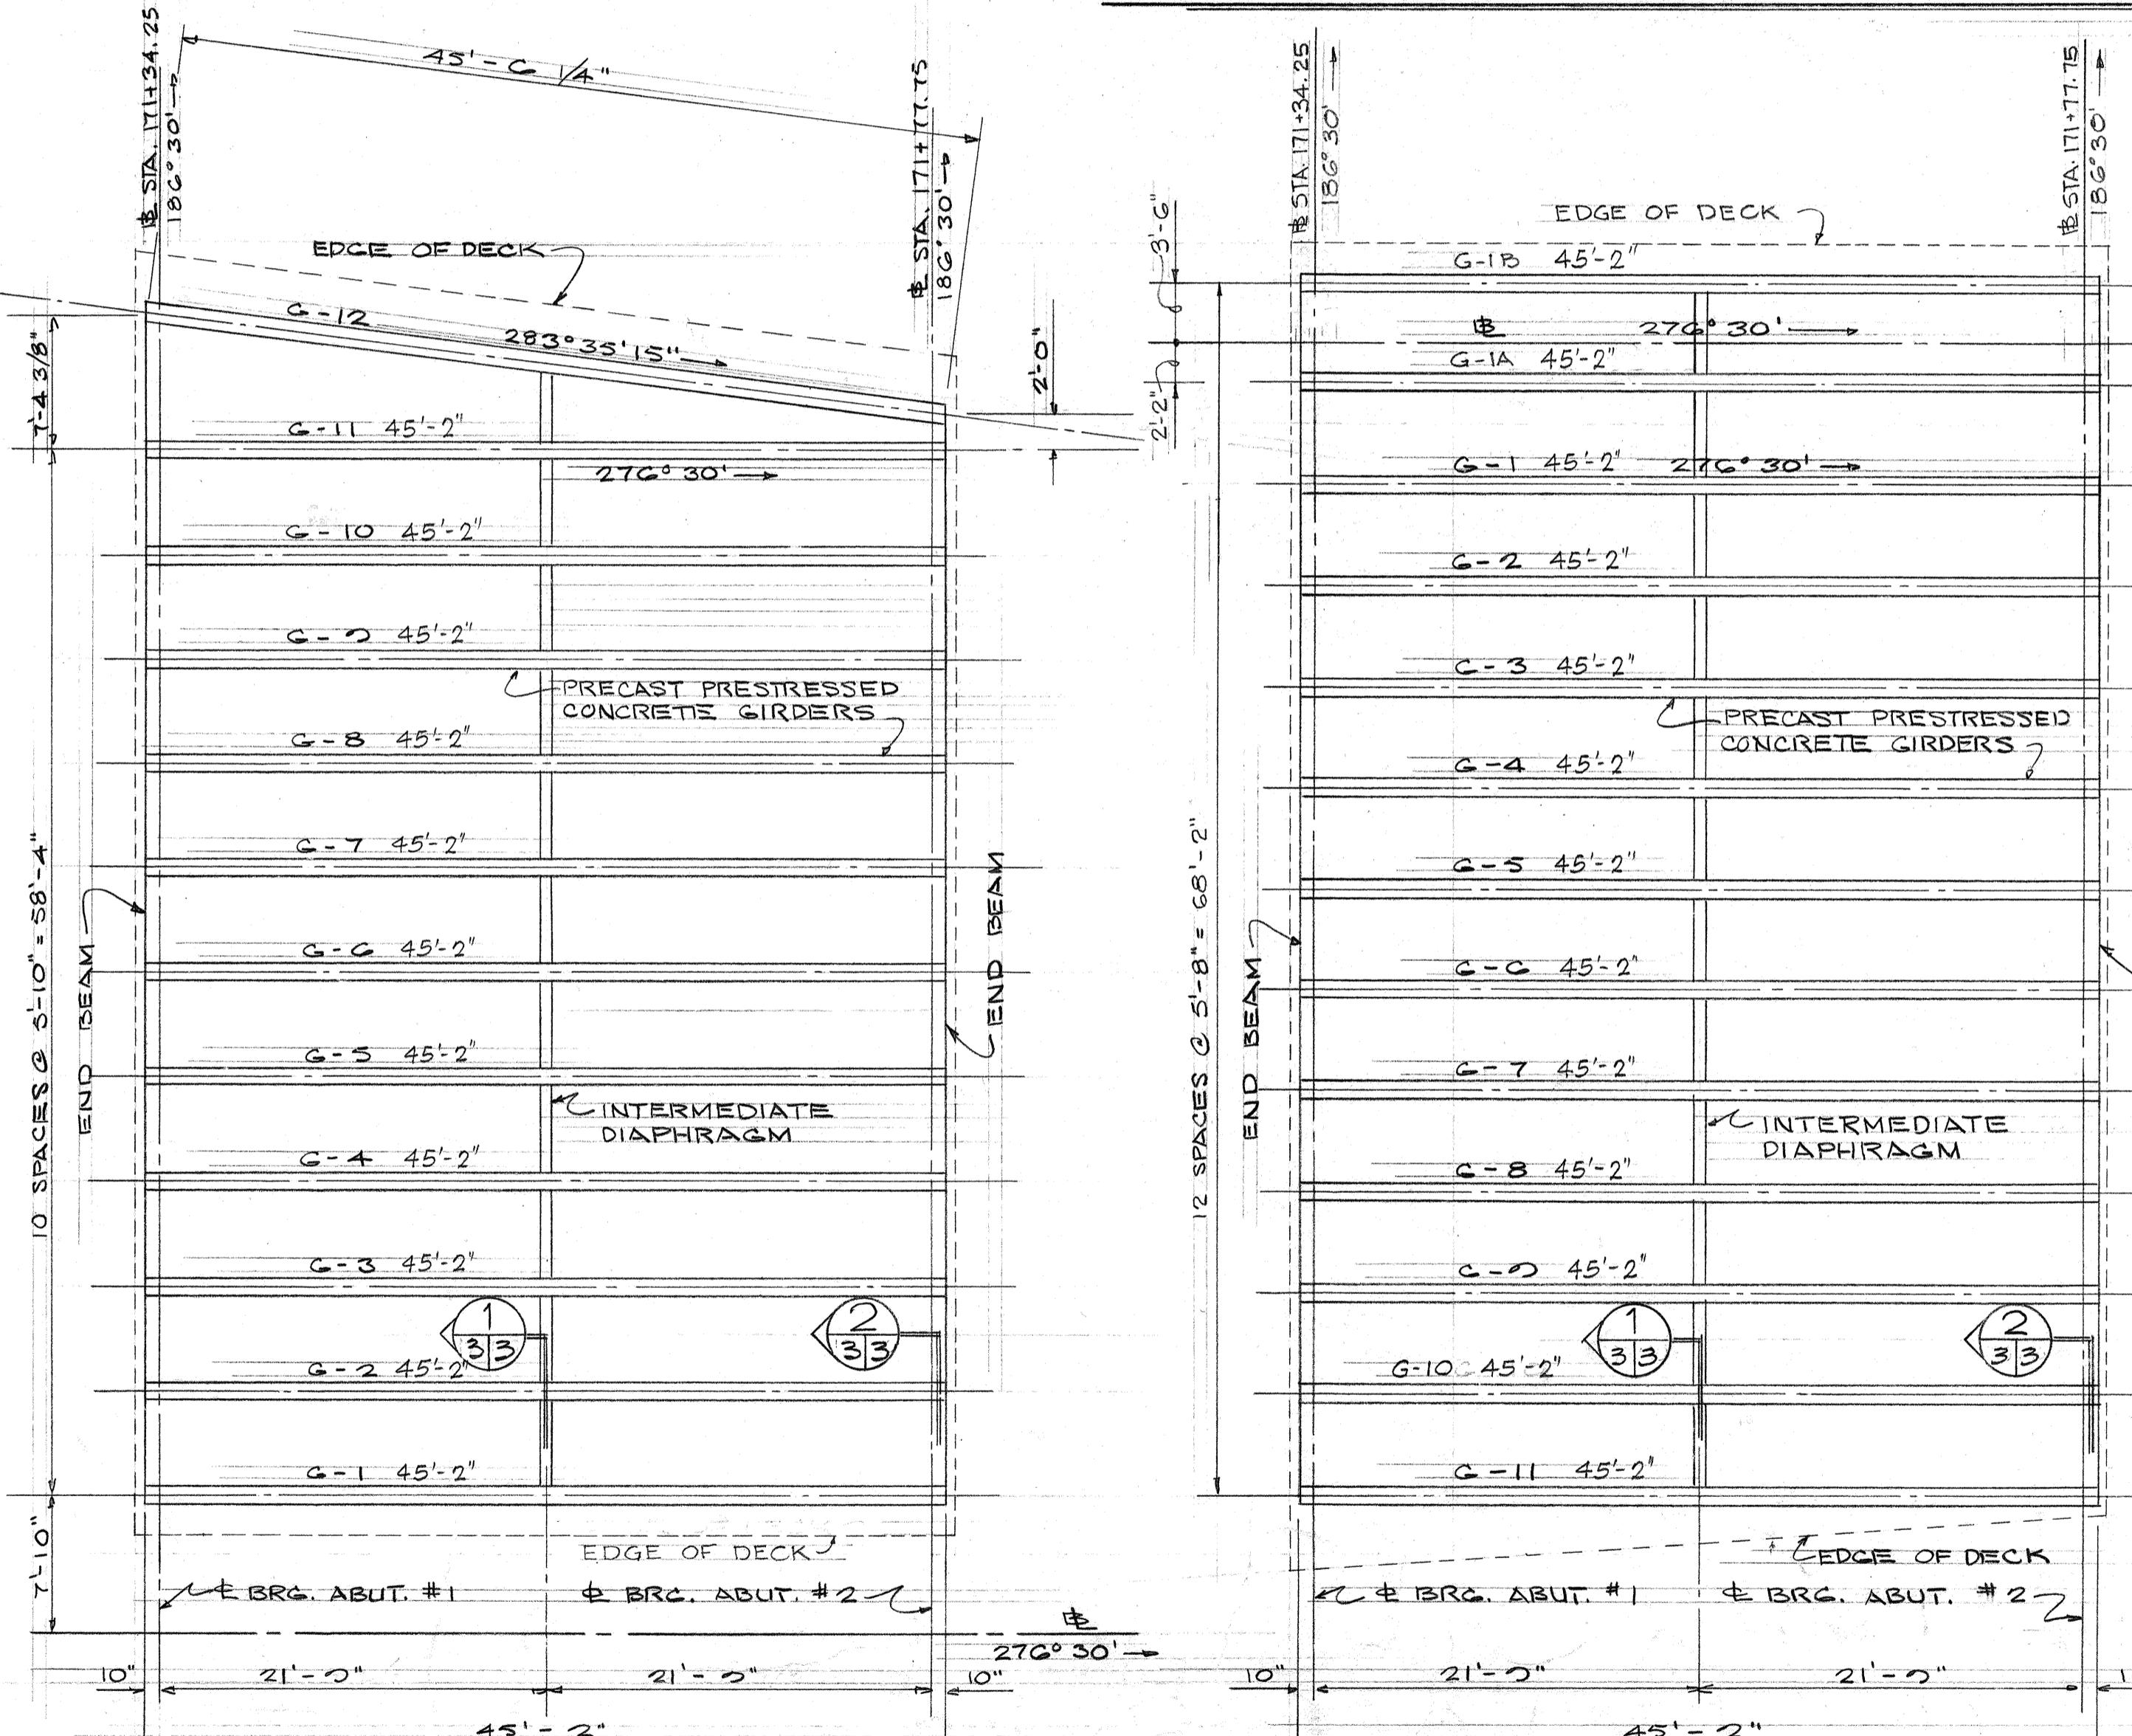


INBOUND


DECK FRAMING PLAN

SCALE: 1/8" = 1'-0"


OUTBOUND

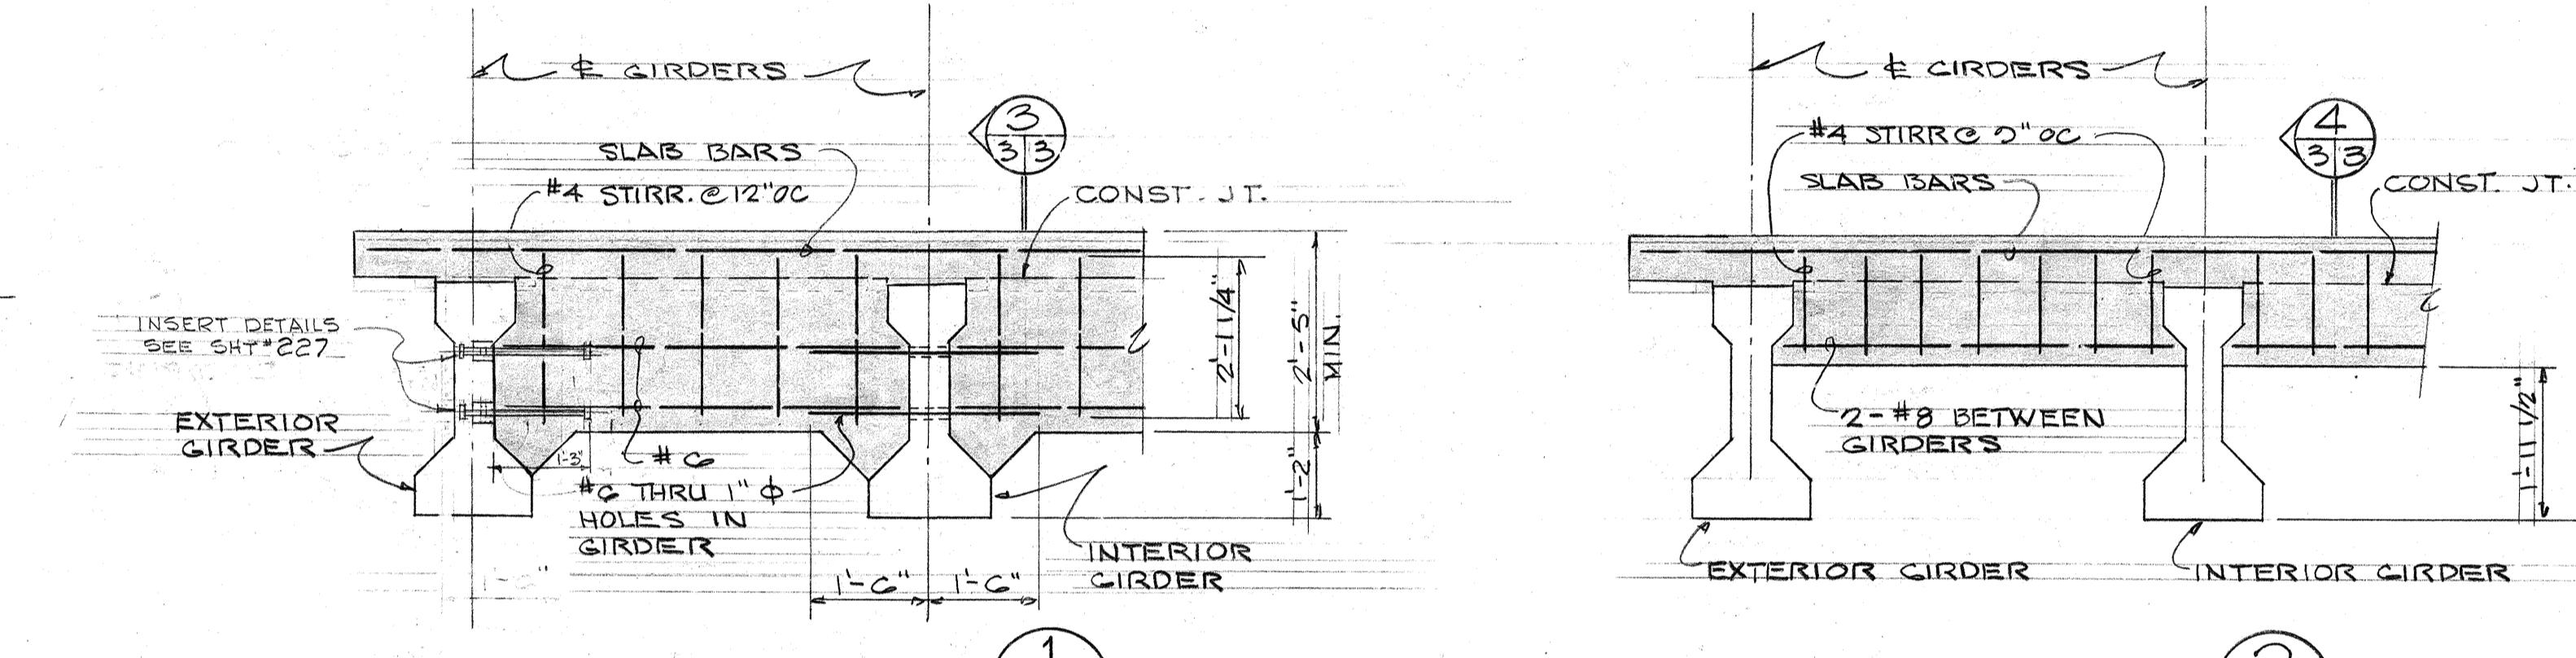

SECTION 1
3/3

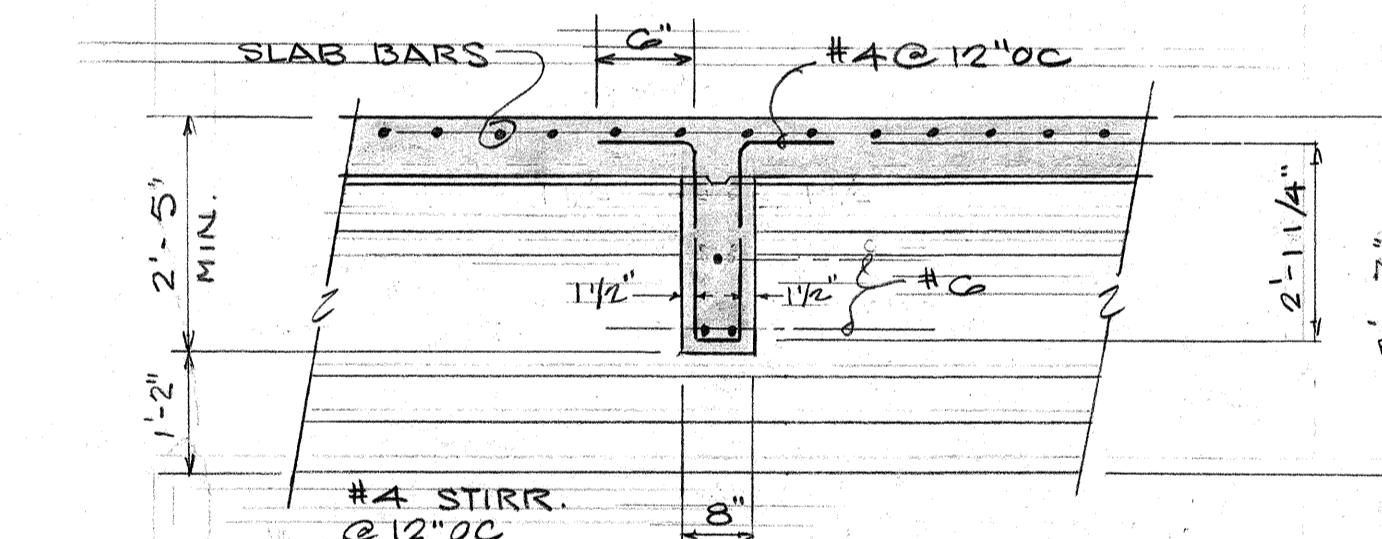


SECTION 2
3/3

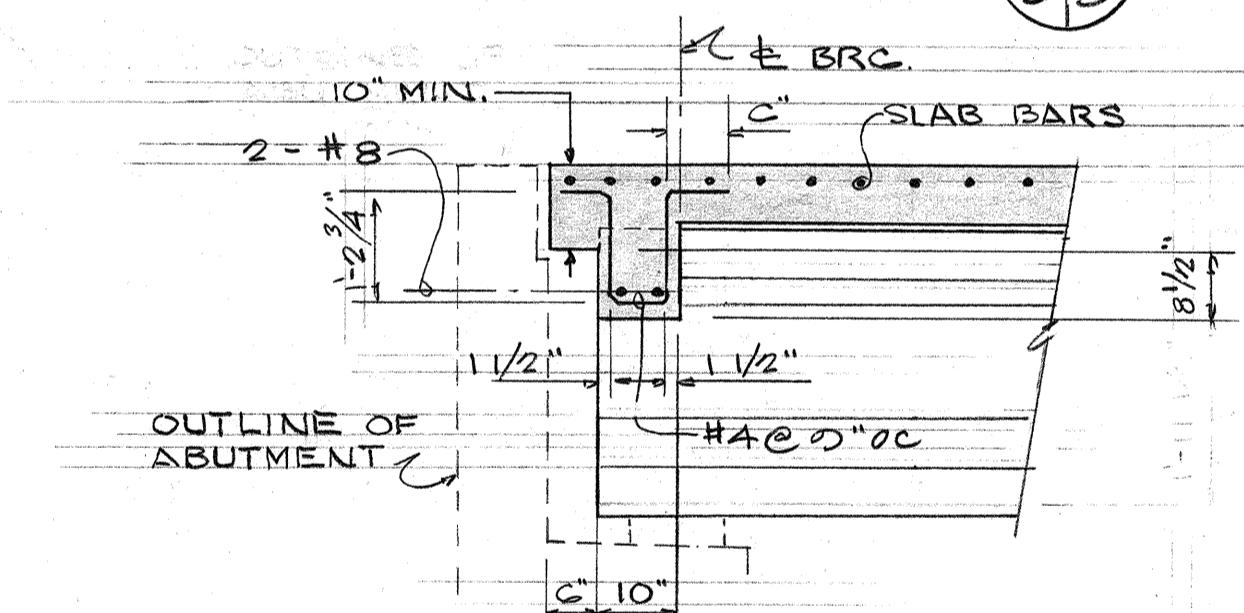

SECTION 3
3/3

TYP. INTERMEDIATE DIAPHRAGM


SCALE: 1/2" = 1'-0"

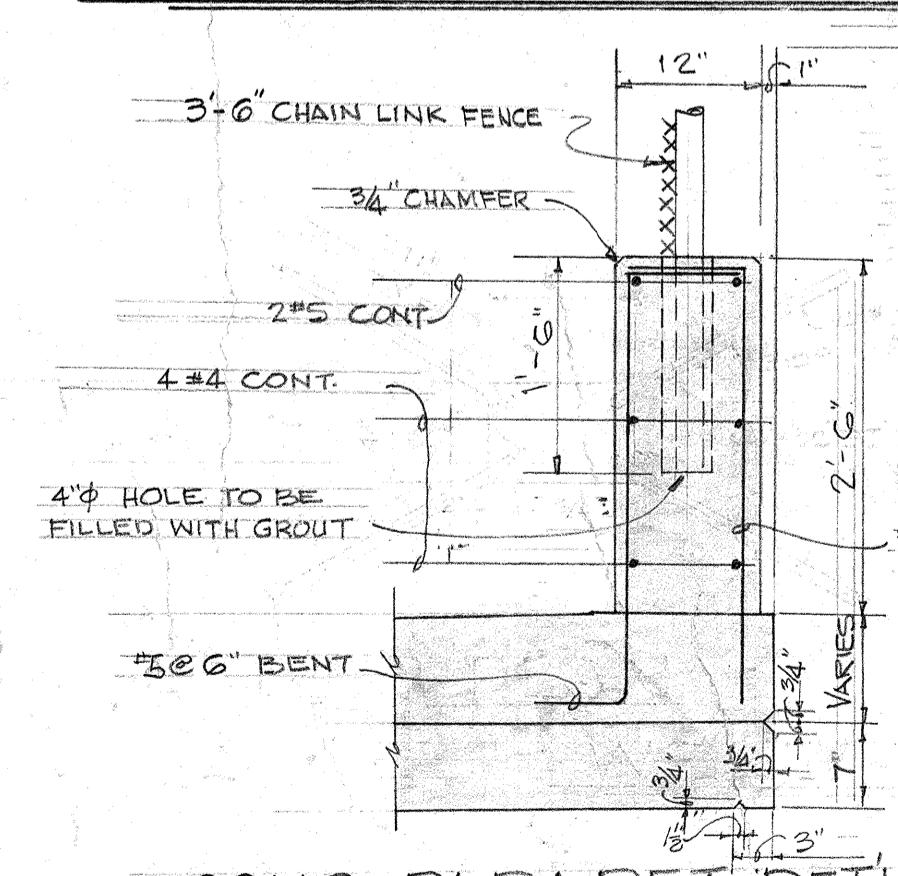

SECTION 4
3/3

TYPICAL END BEAM

SCALE: 1/2" = 1'-0"

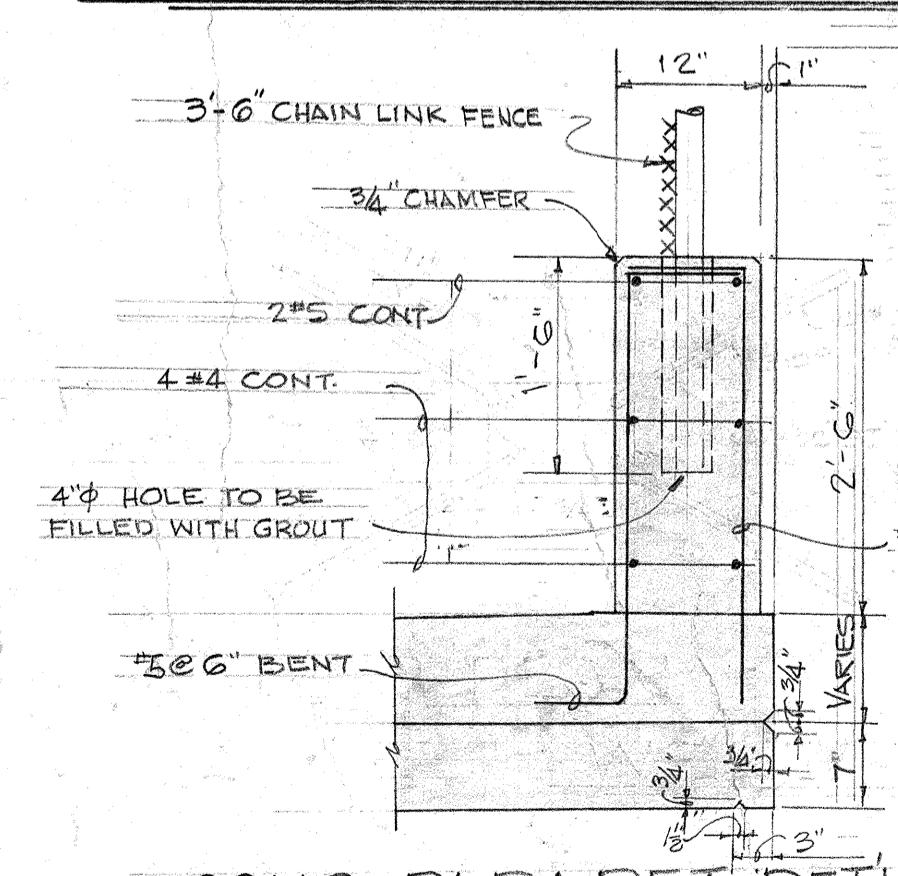

WILSON, OKAMOTO, OKA, INC.
PARK ASSOCIATES, INC.
ARCHITECTS & ENGINEERS

APPROVED
HARRY TANAKA
TRAFFIC ENGINEER, CEC OF HONOLULU
DATE: 11/1/66


STATE OF HAWAII
DEPARTMENT OF TRANSPORTATION
HIGHWAYS DIVISION

KAPAKAHII STREAM BRIDGE
(STRUCTURE NO. 23)

TYPICAL SECTIONS &
FRAMING DETAILS
INTERSTATE HIGHWAY (UNAULIO FREEWAY)
FAI. PROJ. NO I-HI-1(G) UNIT #3
SCALE: AS SHOWN
DATE: JANUARY, 1966

SHEET No. 3 OF 9 SHEETS

ORIGINAL PLAN	SURVEY PLOTTED BY
TRACED BY	TRACED BY
NOTE BOOK	QUANTITIES BY
No. _____	CHECKED BY

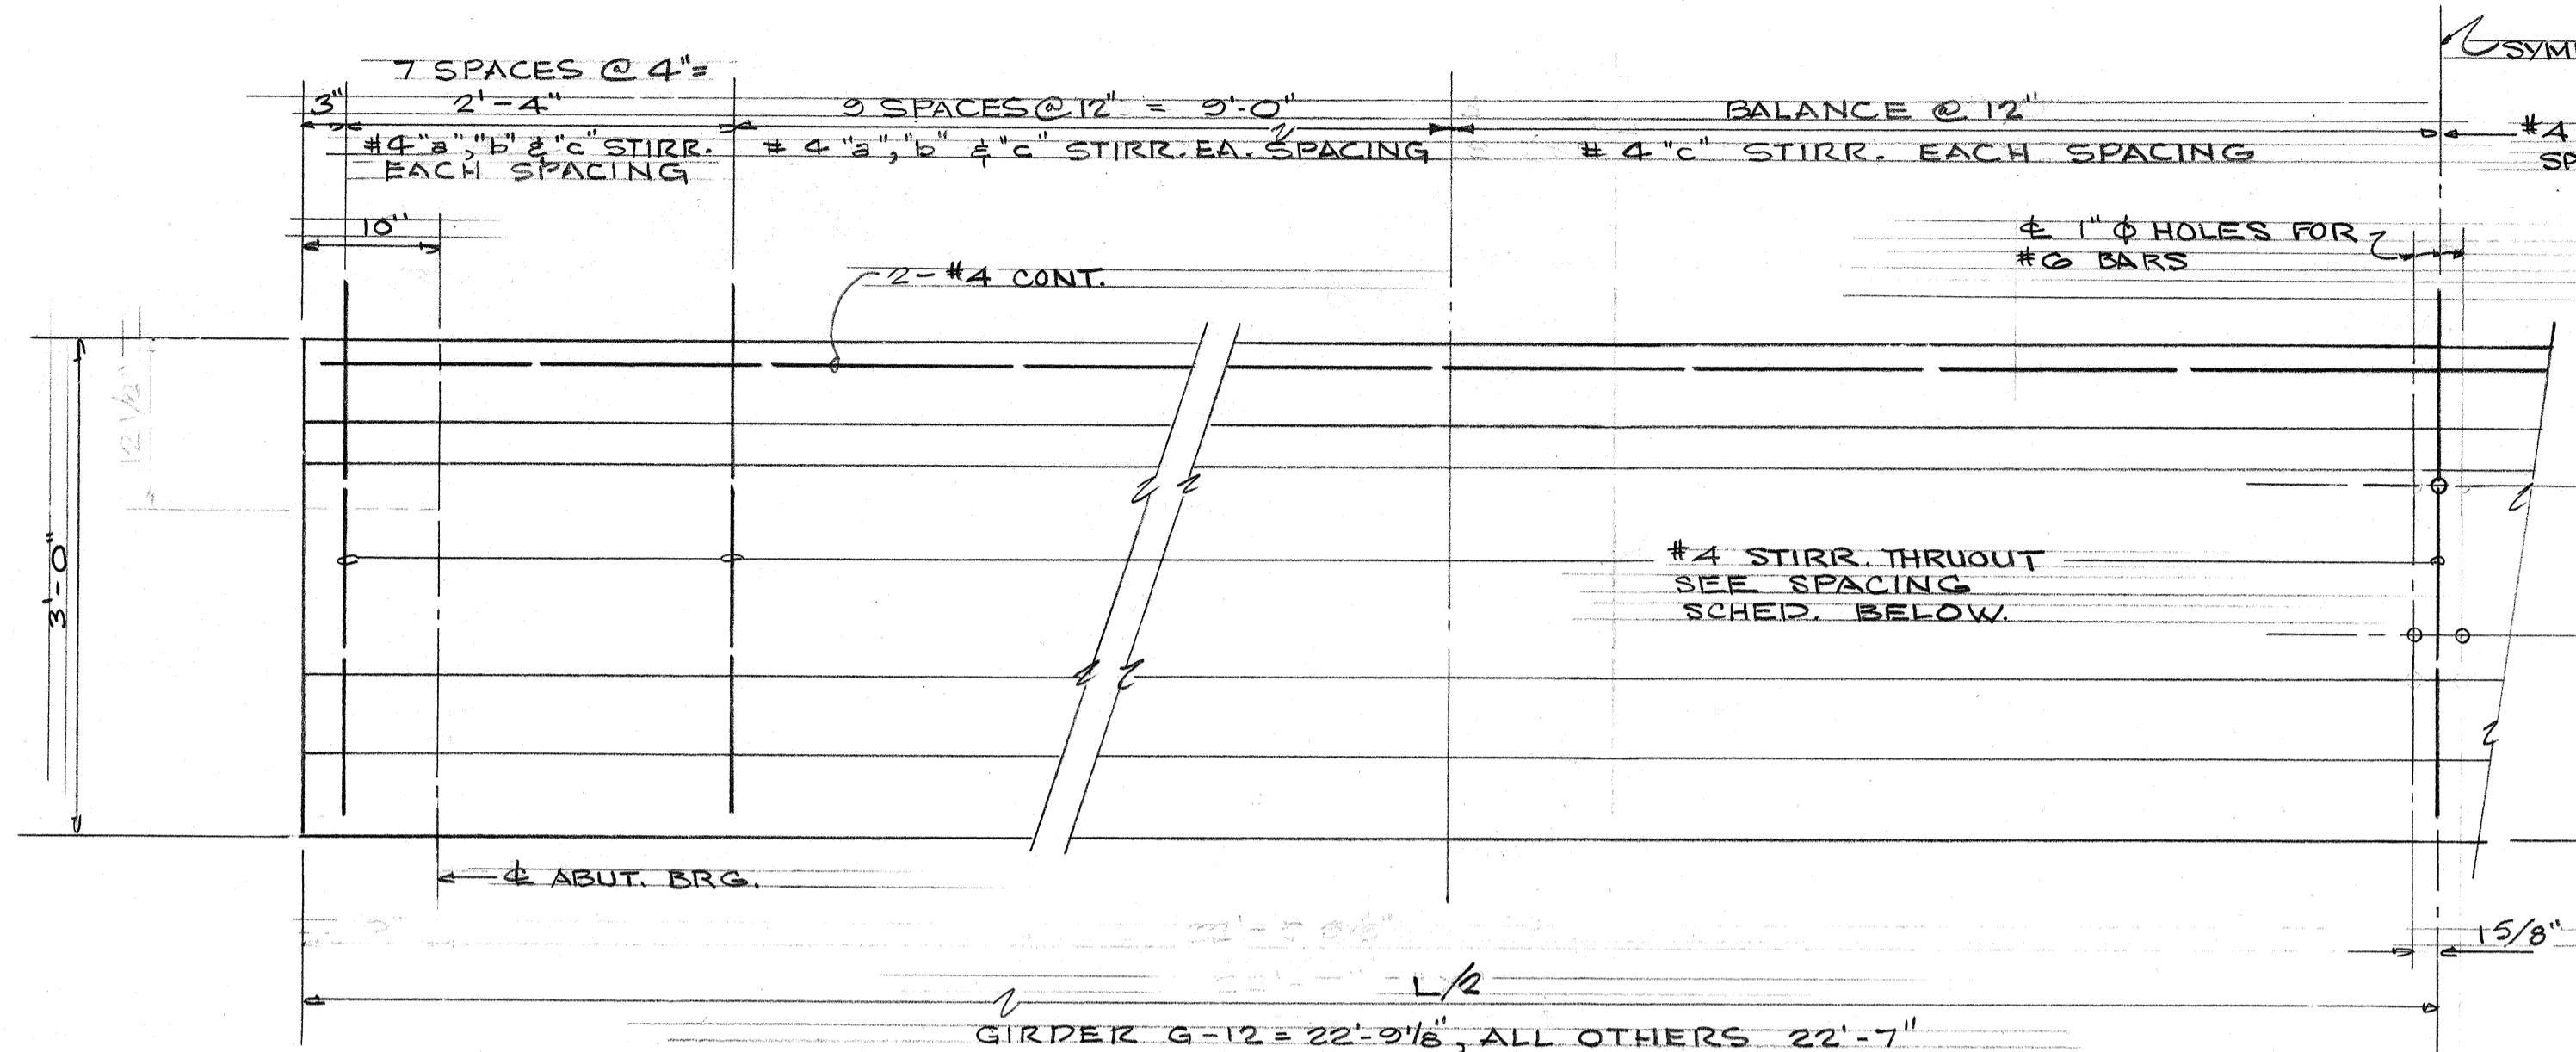


ELEVATION

SECTION SHOWING STIRRUPS

SECTION SHOWING PRESTRESS STRANDS

PRECAST PRESTRESSED CONCRETE GIRDER DETAILS


SCALE: 1" = 1'-0"

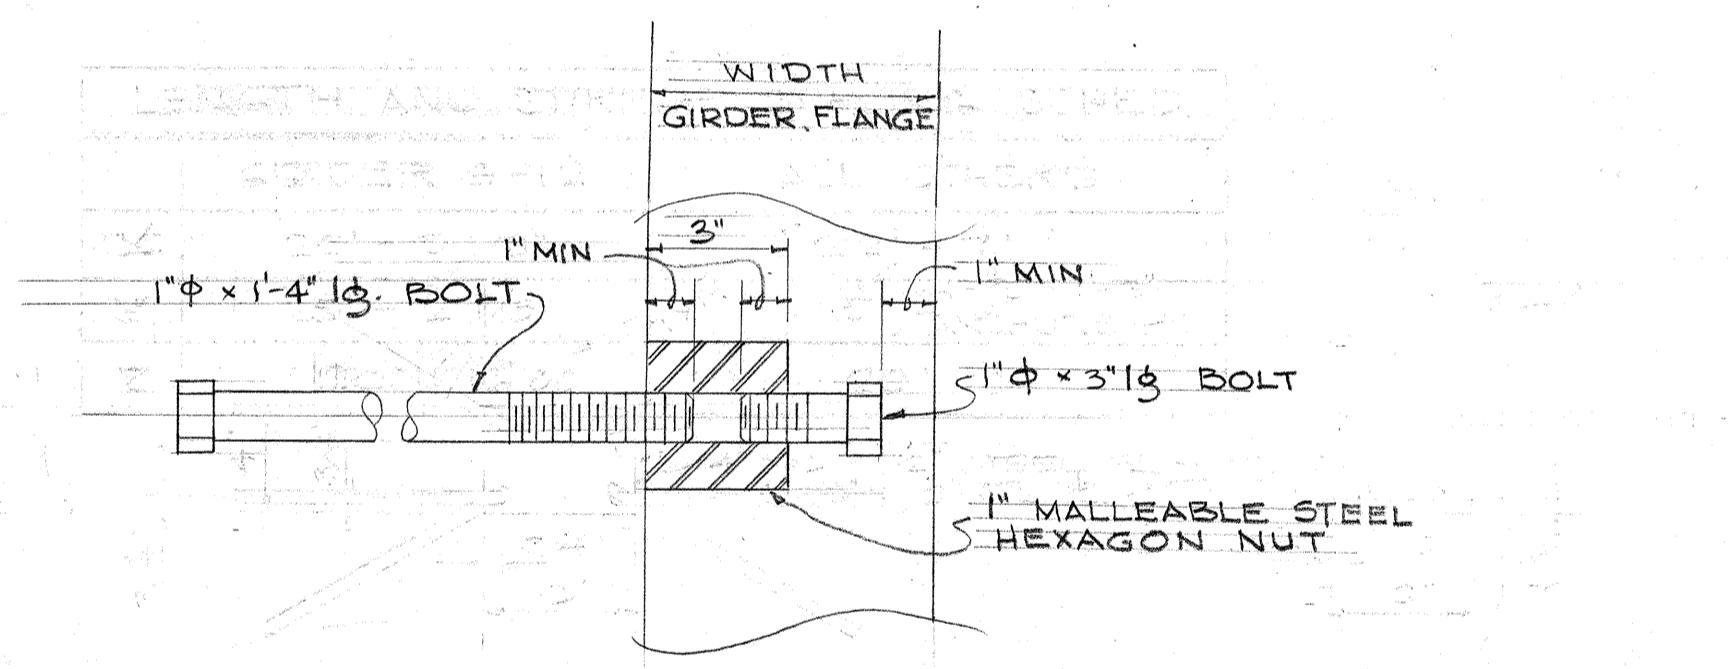

INSERT ASSEMBLY DETAIL

12 REQ

SCALE: 3" = 1'

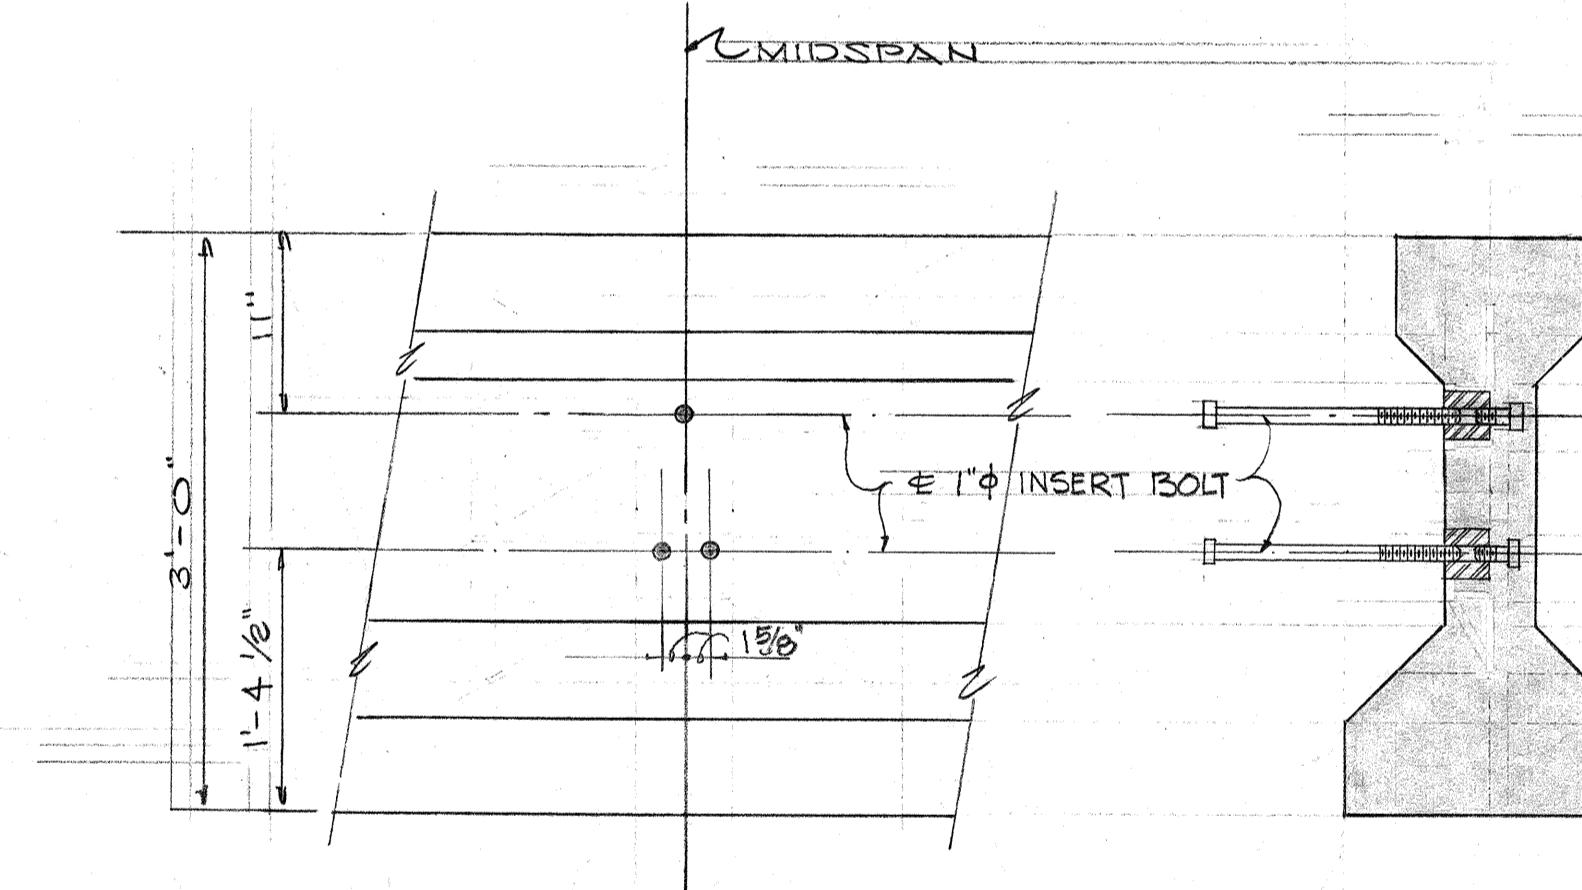

ELEVATION SECTION
INSERT ASSEMBLY LOCATION DETAIL

INSERT ASSEMBLY TO BE CAST INTO
GIRDERS AS SHOWN IN PLACE OF
THE 4 1" Ø HOLES FOR GIRDERS
G-1 & G-12 OF INBOUND AND
G-13 & G-11 OF OUTBOUND. (TOTAL OF 4)

PRESTRESS NOTES

LIVE LOAD: H 20 - S 16 - 44

PRETENSIONING STEEL : INDIVIDUAL TENDONS IN PRETENSIONED SECTIONS SHALL BE SEVEN WIRE, UNCOATED, STRESS RELIEVED STEEL STRANDS WHICH HAVE A NOMINAL DIAMETER OF 7/16" AND A MINIMUM ULTIMATE STRENGTH OF 250,000 P.S.I. AN INITIAL FORCE OF 18,200 LB. SHALL BE APPLIED TO EACH STRAND.

PRECAST PRESTRESSED CONCRETE: ALL PRESTRESSED CONCRETE SHALL ATTAIN A MINIMUM COMPRESSIVE STRENGTH OF 5,000 P.S.I. AT THE AGE OF 28 DAYS. THE MINIMUM COMPRESSIVE STRENGTH OF CONCRETE AT THE TRANSFER OF PRESTRESS SHALL BE 4,000 P.S.I.

**WILSON, OKAMOTO, OKA, INC.
PARK ASSOCIATES, INC.
ARCHITECTS & ENGINEERS**

**STATE OF HAWAII
DEPARTMENT OF TRANSPORTATION**

HIGHWAYS DIVISION


PRESTRESSED CONCRETE

CIPPER DETAILS

GIRDER DETAILS
INTERSTATE HIGHWAY (LUNALILLO FREEWAY)
A.I. PROJECT NO. I-HI-1(G) UNIT 3
JANUARY 1965

SHEET No. 4 OF 9 SHEETS

D. ROAD ST. NO.	STATE	FED. AID PROJ. NO.	FISCAL YEAR	SHEET NO.	TOTAL SHEETS
AHAWAII	HAW.	I-H-1(G) UNIT #3	1966	228	235

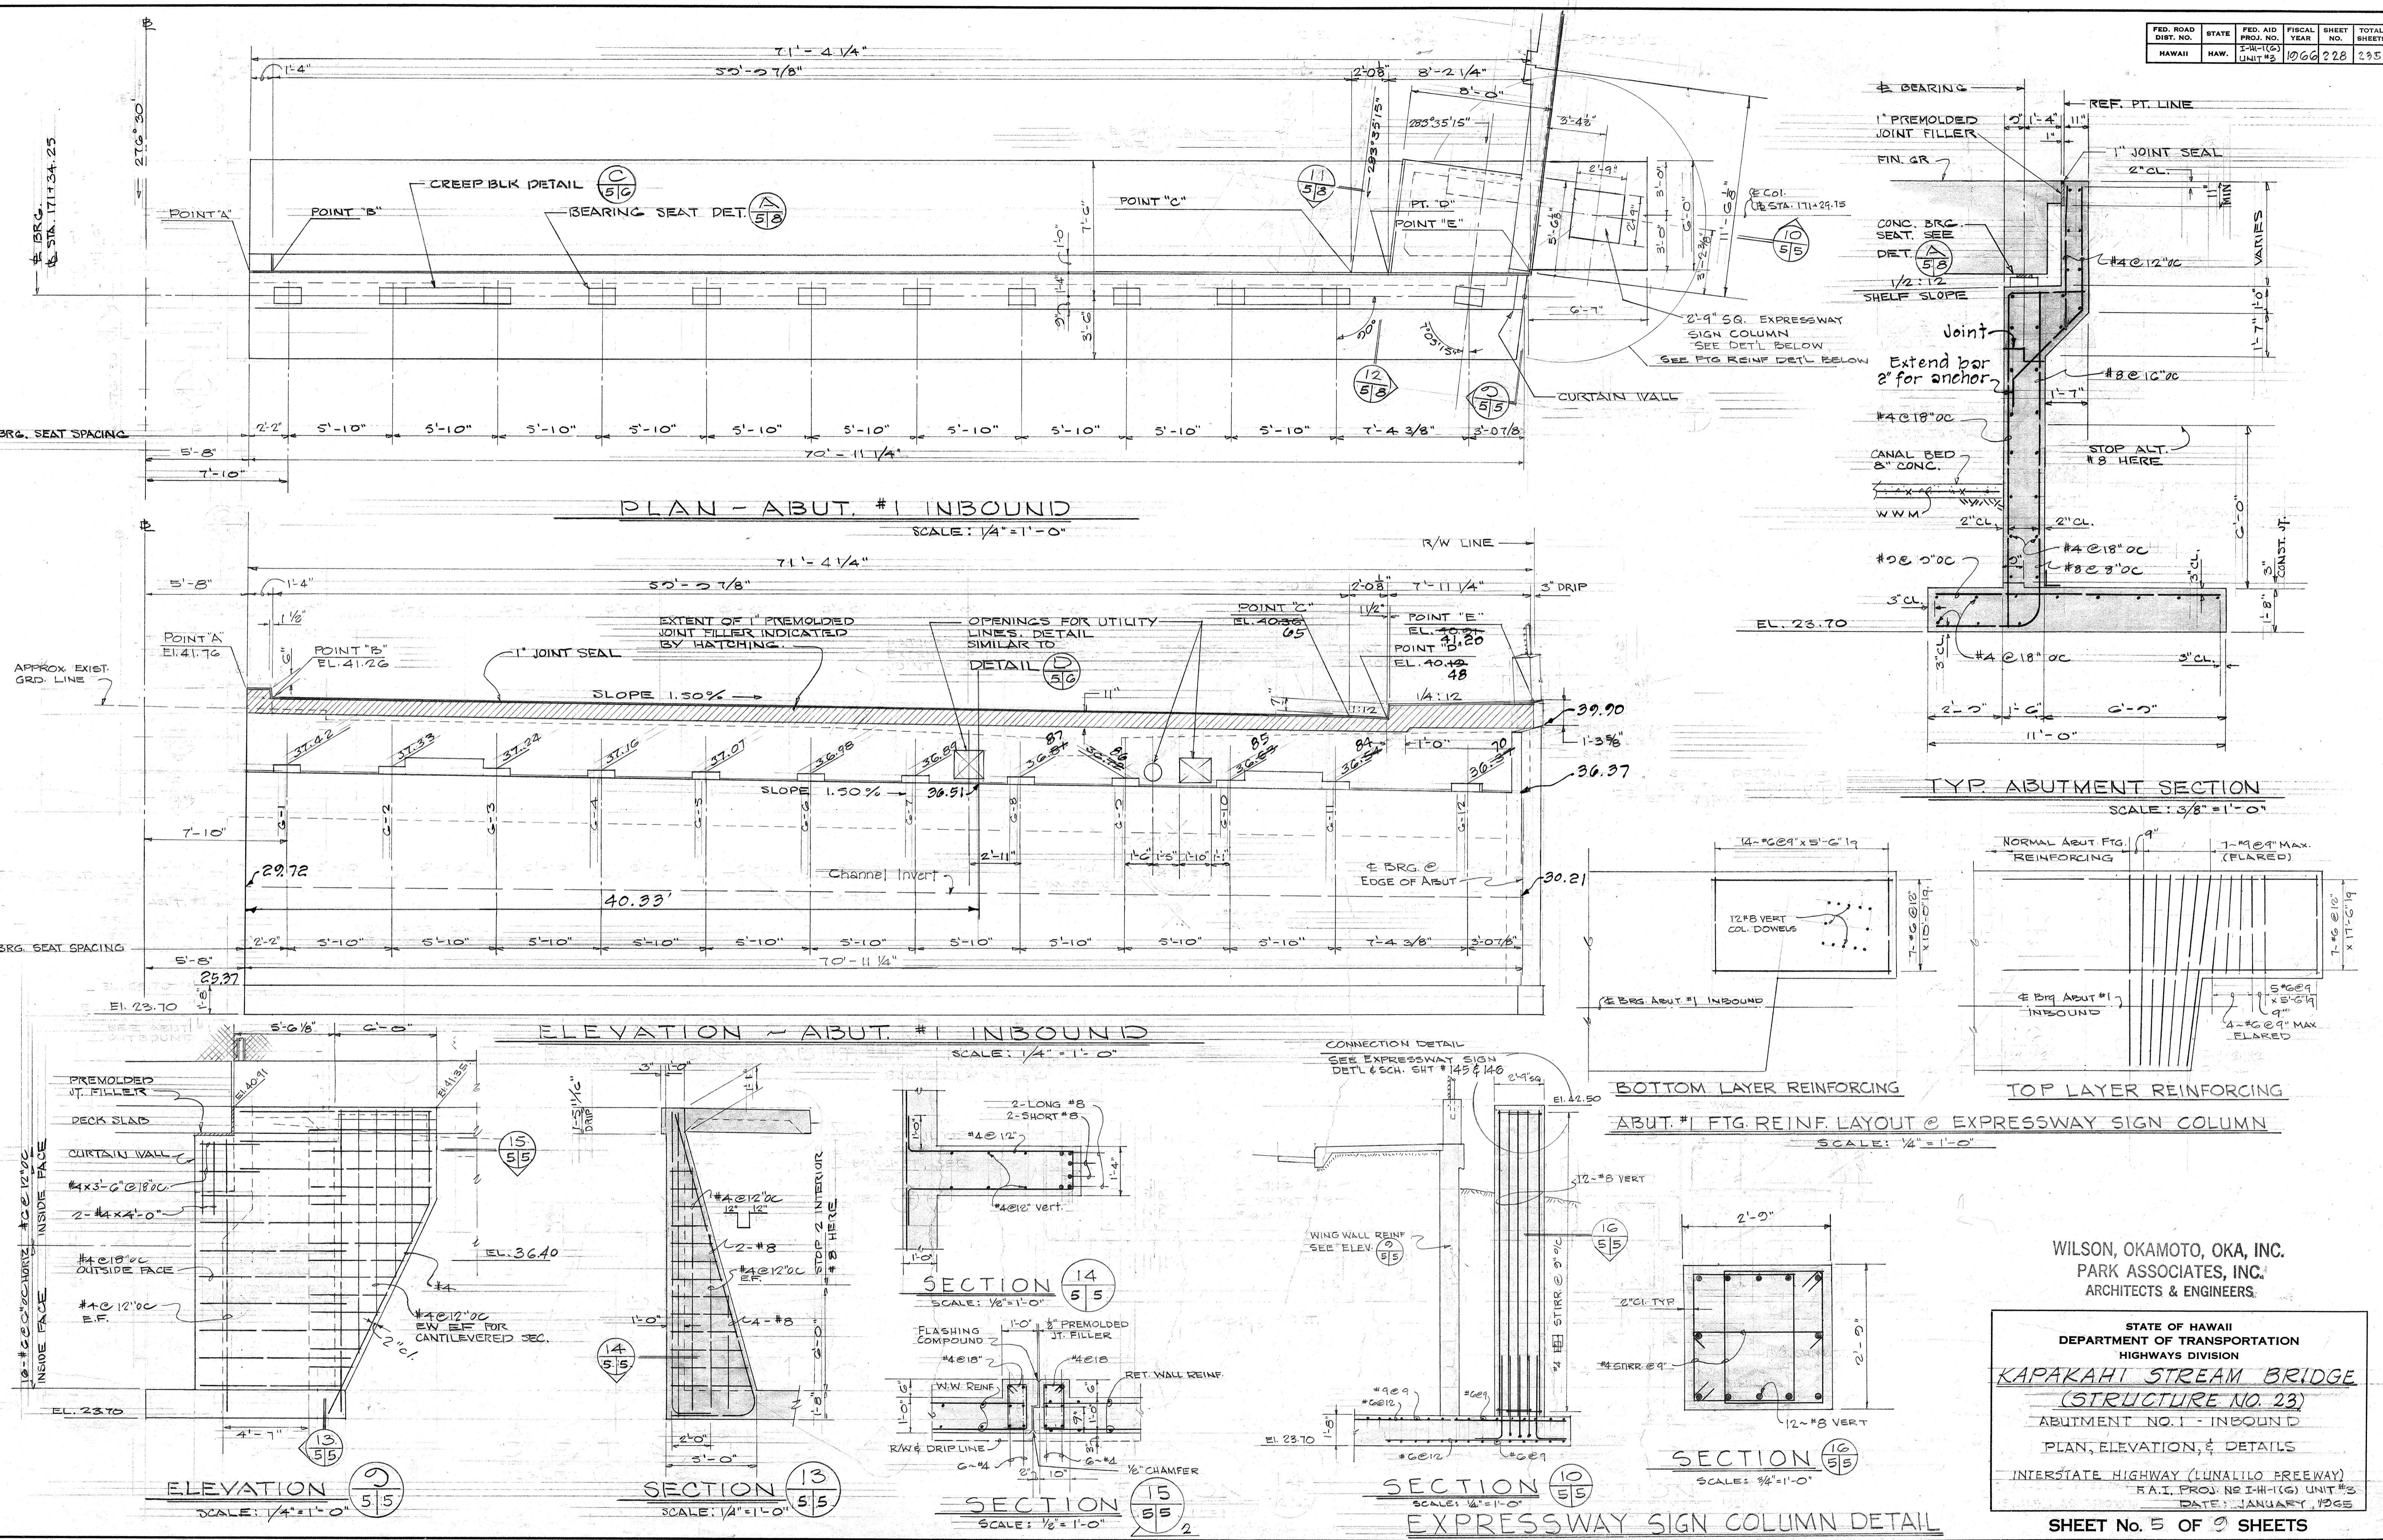

**WILSON, OKAMOTO, OKA, INC.
PARK ASSOCIATES, INC.
ARCHITECTS & ENGINEERS**

**STATE OF HAWAII
DEPARTMENT OF TRANSPORTATION**

HIGHWAYS DIVISION

AKAHI STREAM BRIDGE
(STRUCTURE NO. 23)

(STRUCTURE NO. 23)
APARTMENT NO. 1 - INBOUNDR

ABUTMENT NO. 1 - INBOUND

PLAN, ELEVATION, & DETAILS

ERSTATE HIGHWAY (LUNALITO FREEWAY)

R.A.I. PROJ. NO I-H-1(G) UNIT -3
DATE: JANUARY, 1965


SHEET No. 5 OF 9 SHEETS

A decorative horizontal line featuring three identical, symmetrical motifs. Each motif consists of a central circular element flanked by two curved, leaf-like or petal-like shapes pointing towards it, resembling stylized flowers or leaves.

A decorative horizontal border featuring a repeating pattern of stylized, symmetrical motifs resembling stylized flowers or flames. The motifs are rendered in a light color against a dark background.


For more information about the study, please contact Dr. John C. Scott at (319) 335-1111 or via email at jscott@uiowa.edu.

D. ROAD LIST. NO.	STATE	FED. AID PROJ. NO.	FISCAL YEAR	HEET NO.	TOTAL HEET
HAWAII *	HAW.	I-HI-1(G) UNIT #3	1966	229	235

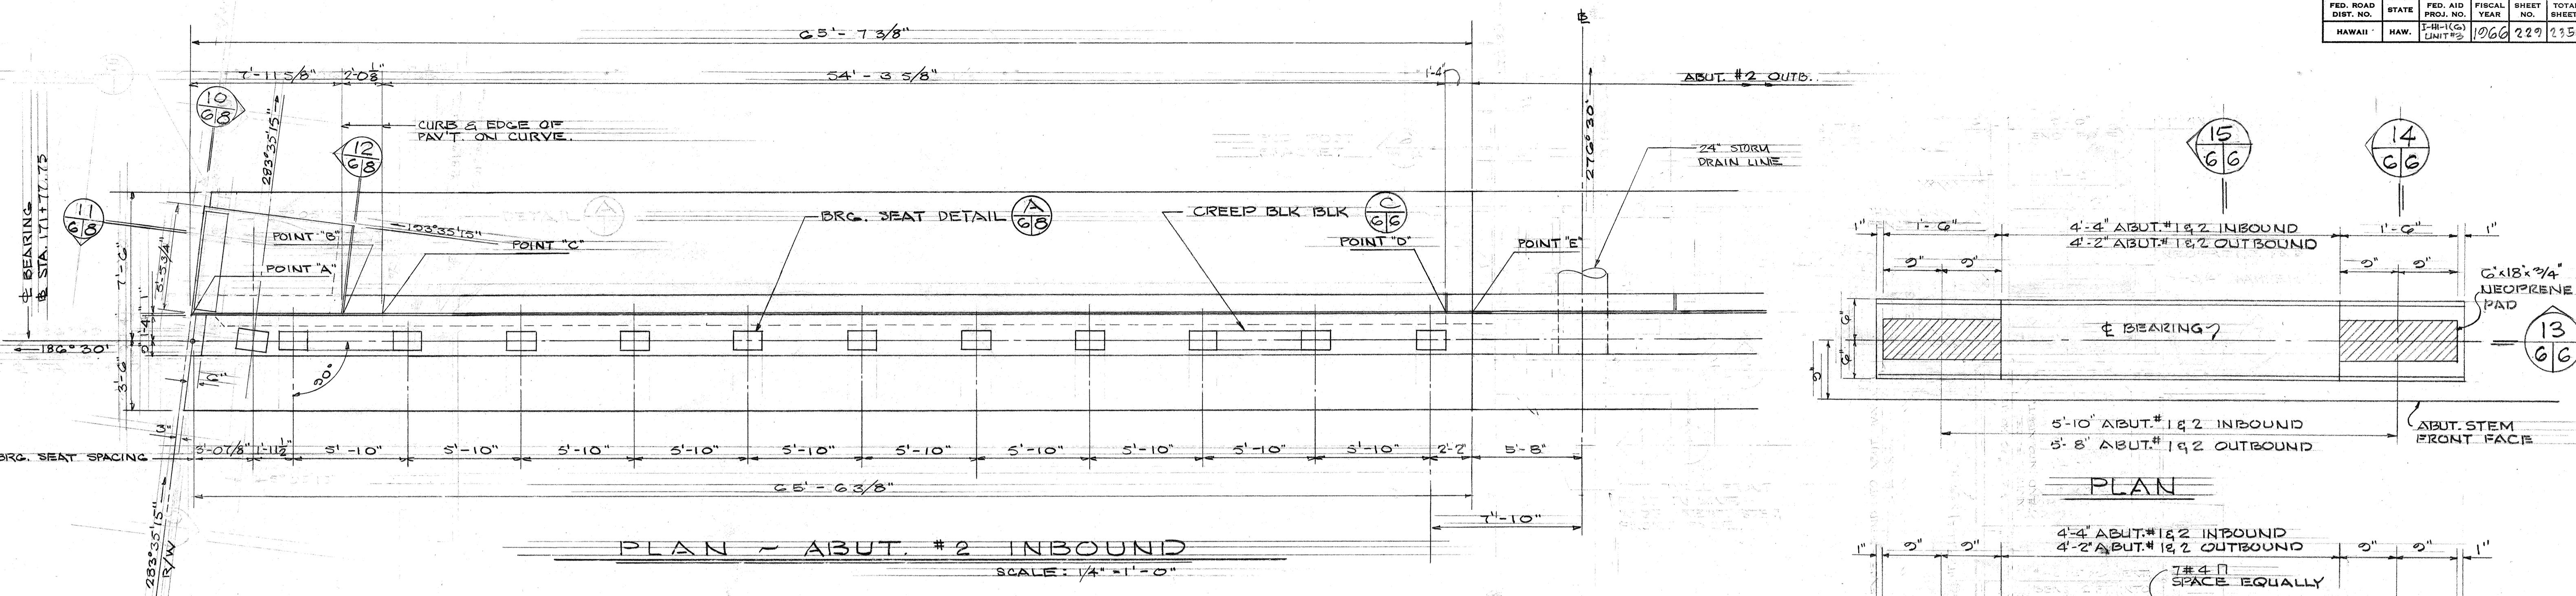


PLAN - ABUT. #2 INBOUND

SCALE: $\frac{1}{4}'' = 1'-0''$

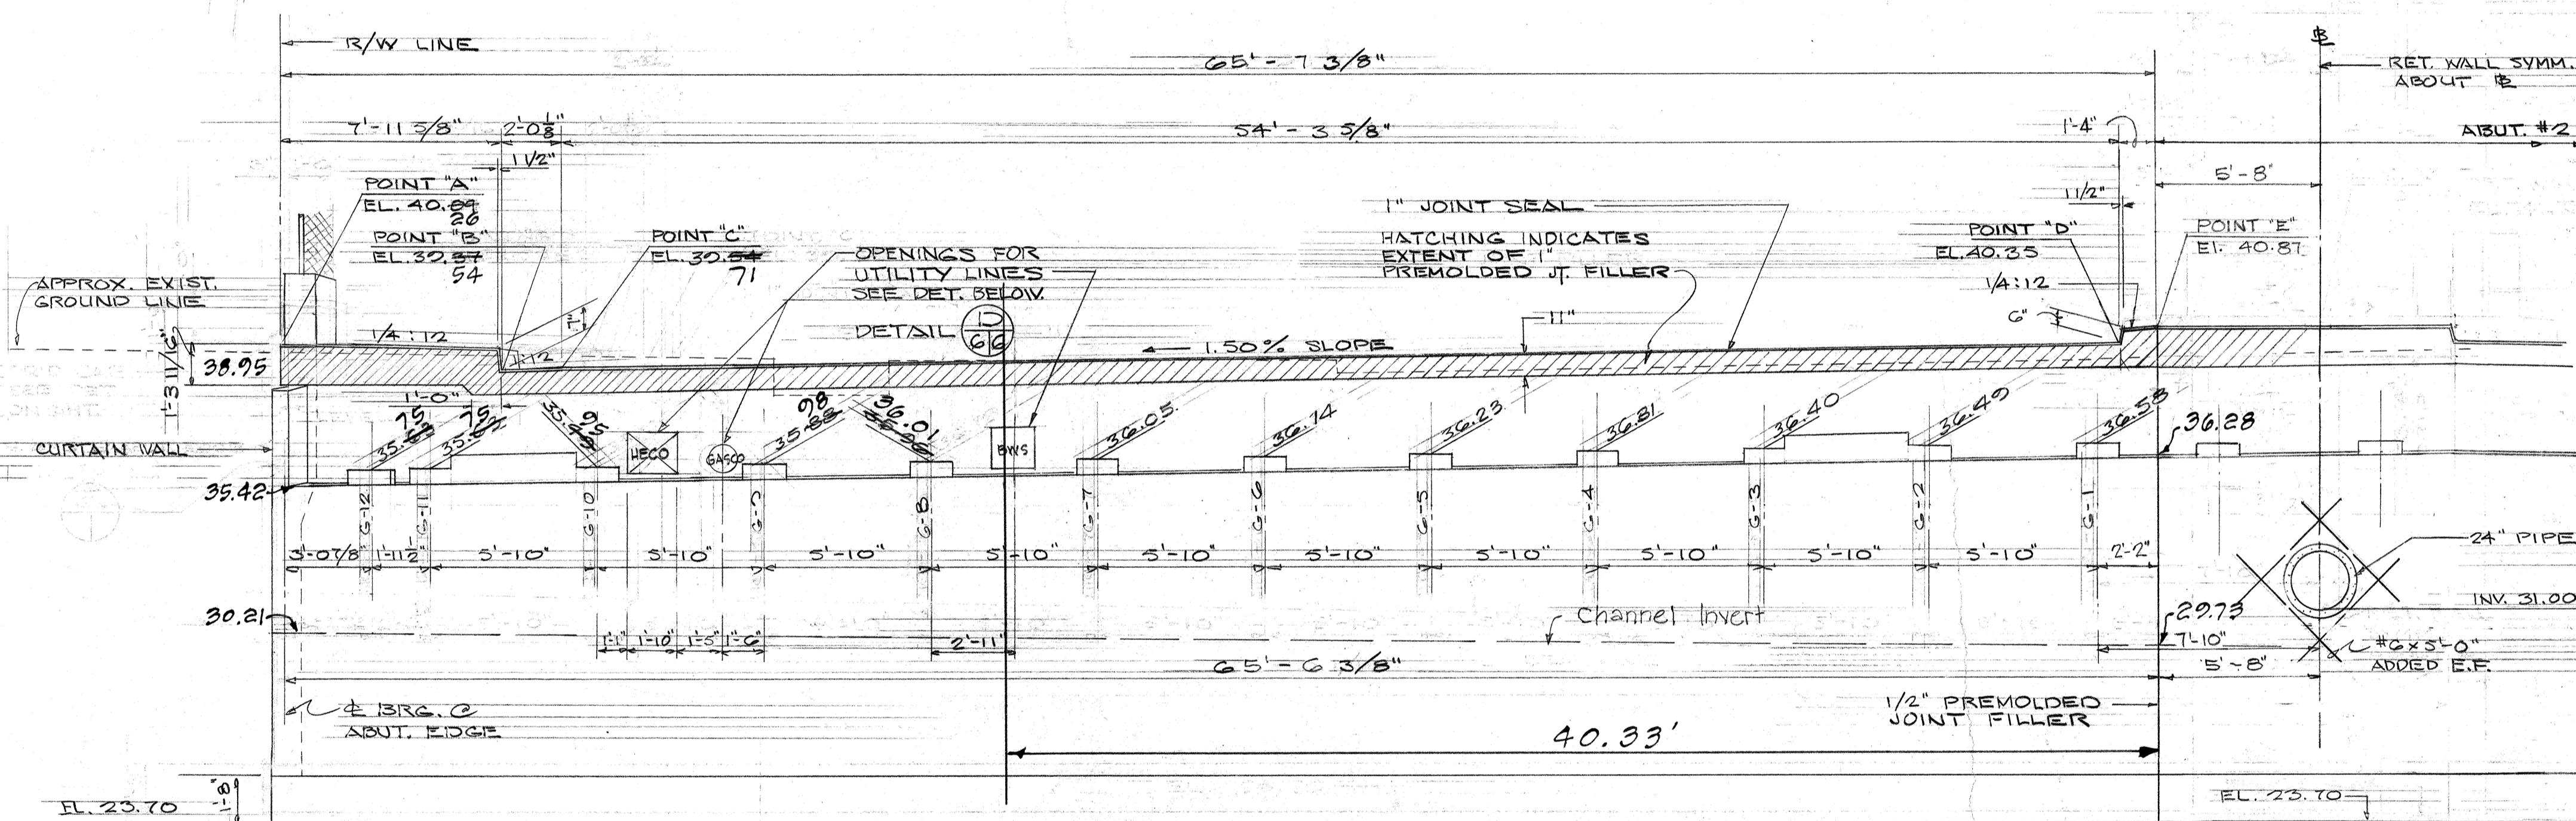

ELEVATION - ABUT. #2 INBOUND

SCALE: 1/

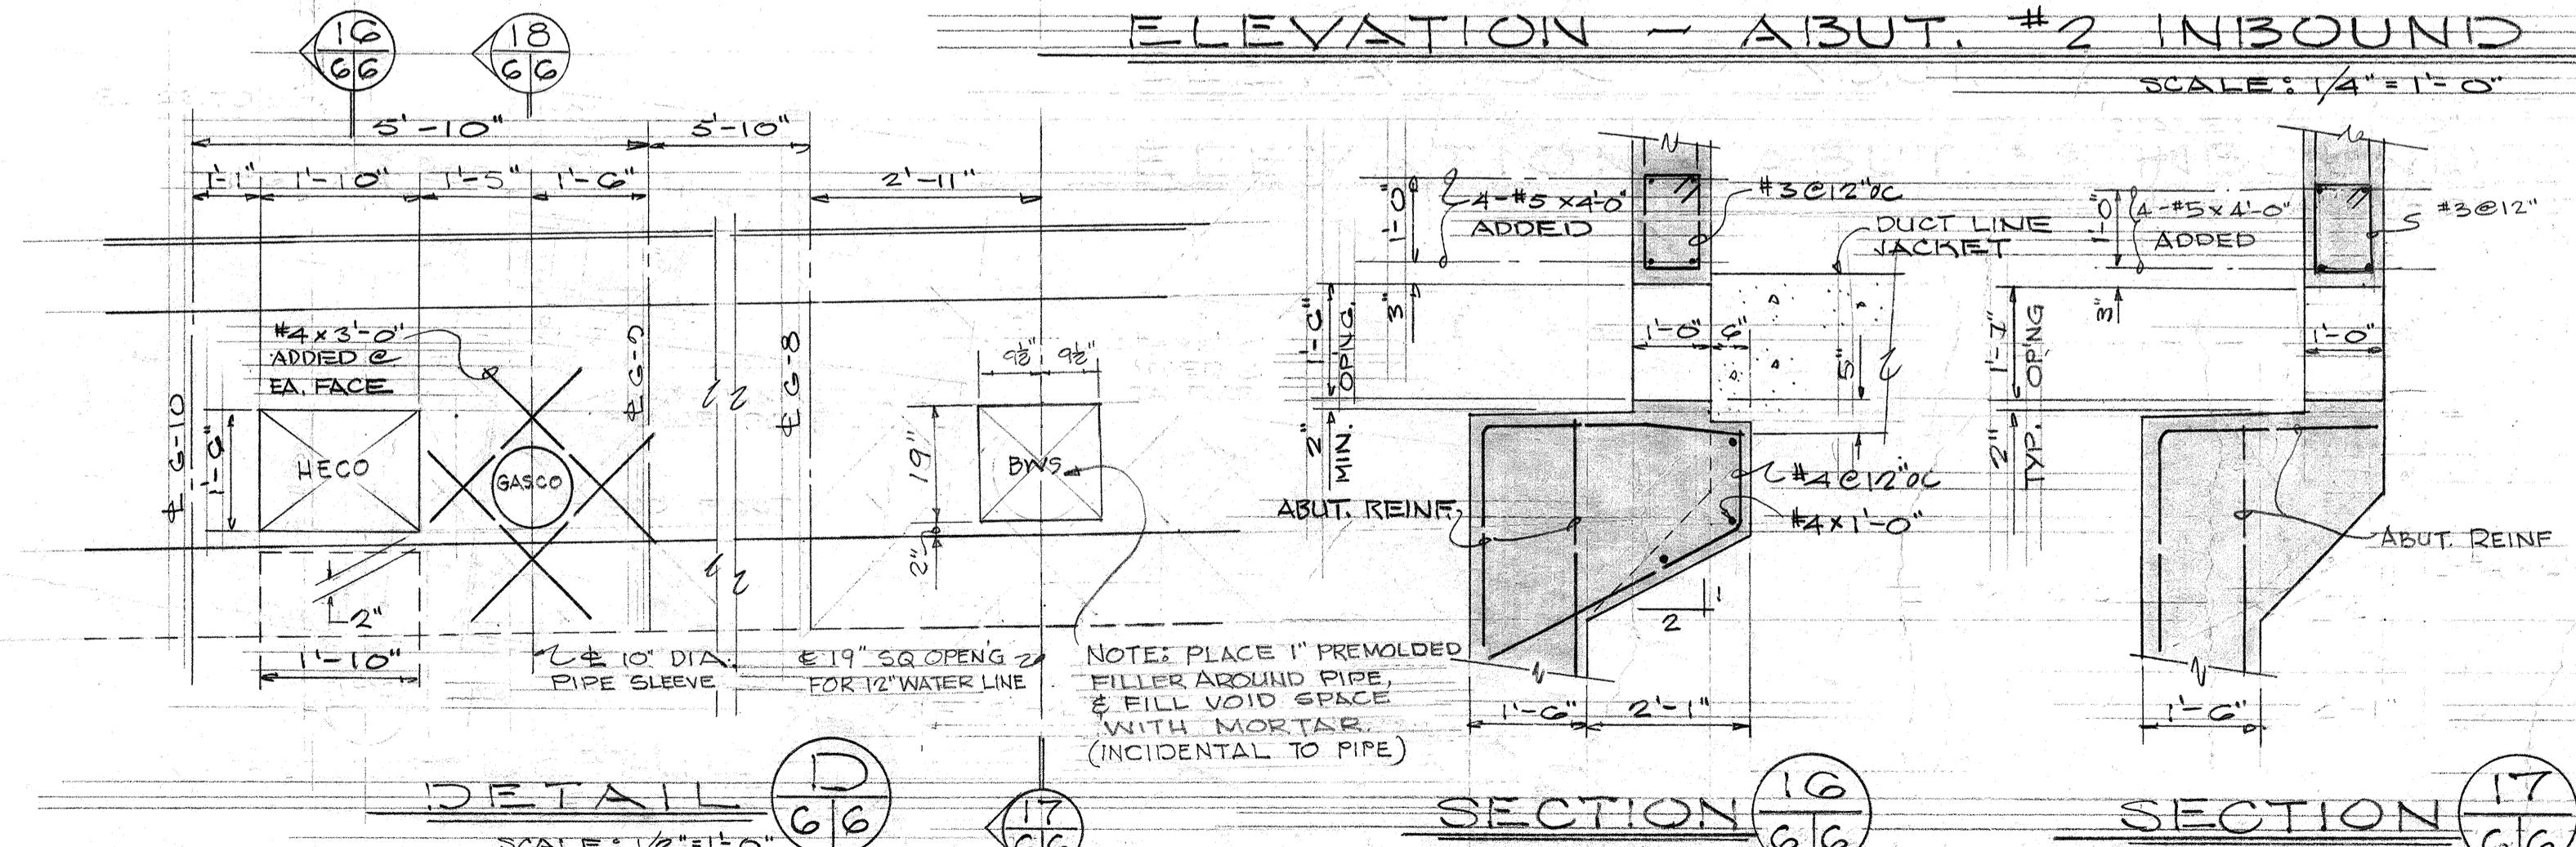


SECTION 6
SCALE: $1/2'' = 1'-0''$
(HECO)

SECTION 6

SECTION

NOT

1. FOR ADDITIONAL WATER LINE DETAIL
SEE MISC. WATER DETAIL SHT. NO. 70
 2. FOR ADDITIONAL UTILITY LINE DETAILS
SEE UTILITY DETAIL SHT. NO. 95

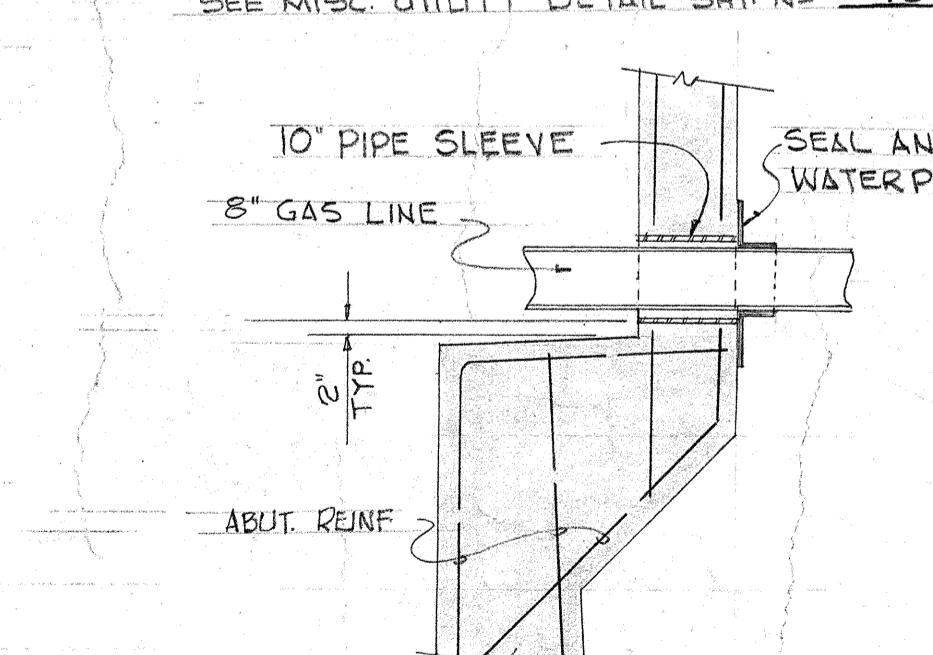



APPROVED:
V. S. Francis
ASSISTANT CHIEF ENGINEER, BWS 9-12-66
DATE
Thomaskin
WATAN ELECTRIC CO., INC. Welco
DATE
Paul C Joy
DIRECTOR OF DEVELOPMENT, HON. GAS CO. LTD. 10/15/66
DATE

10. The following table shows the number of hours worked by 1000 workers in a certain industry.

STATE OF HAWAII
DEPARTMENT OF TRANSPORTATION
HIGHWAYS DIVISION


**WILSON, OKAMOTO, OKA, INC.
PARK ASSOCIATES, INC.
ARCHITECTS & ENGINEERS**

ED. ROAD LIST. NO.	STATE	FED. AID PROJ. NO.	FISCAL YEAR	SHEET NO.	TOTAL SHEETS
HAWAII 1	HAW.	I-HI-1(G) UNIT #3	1066	230	235

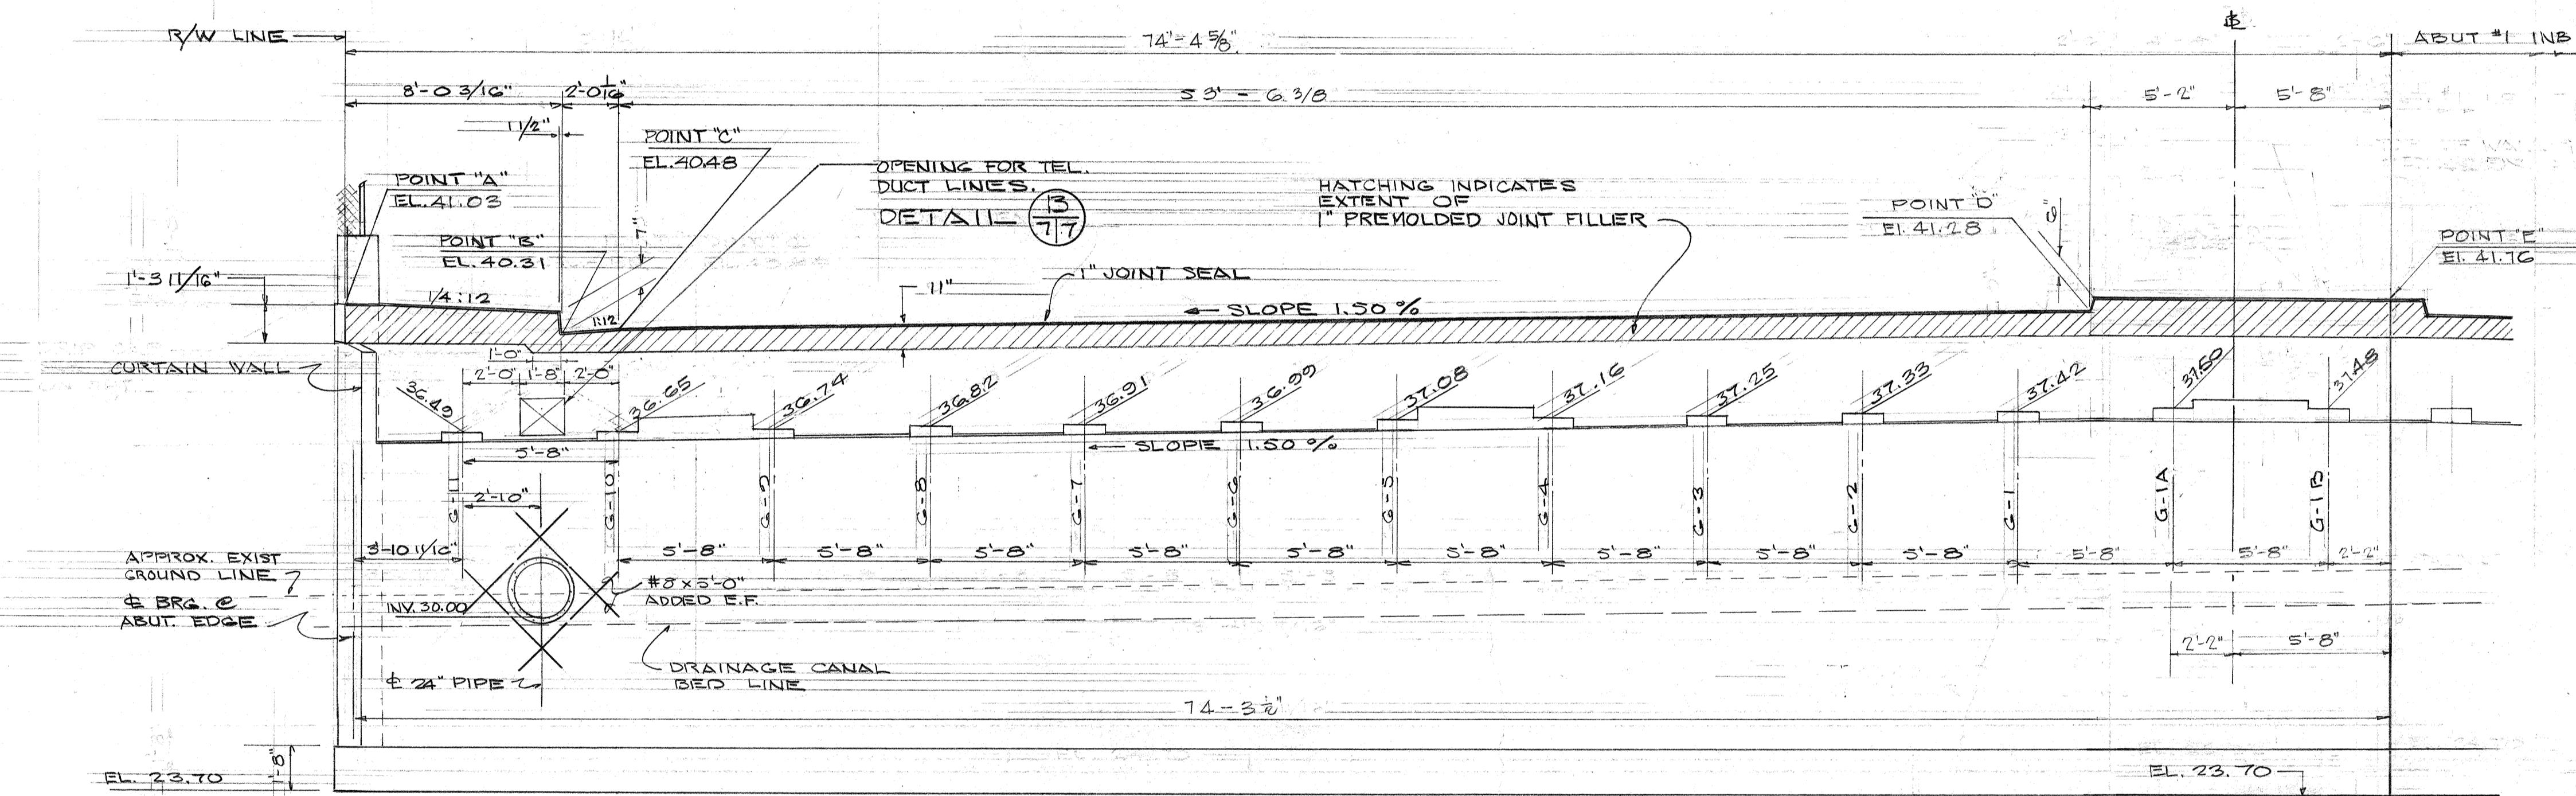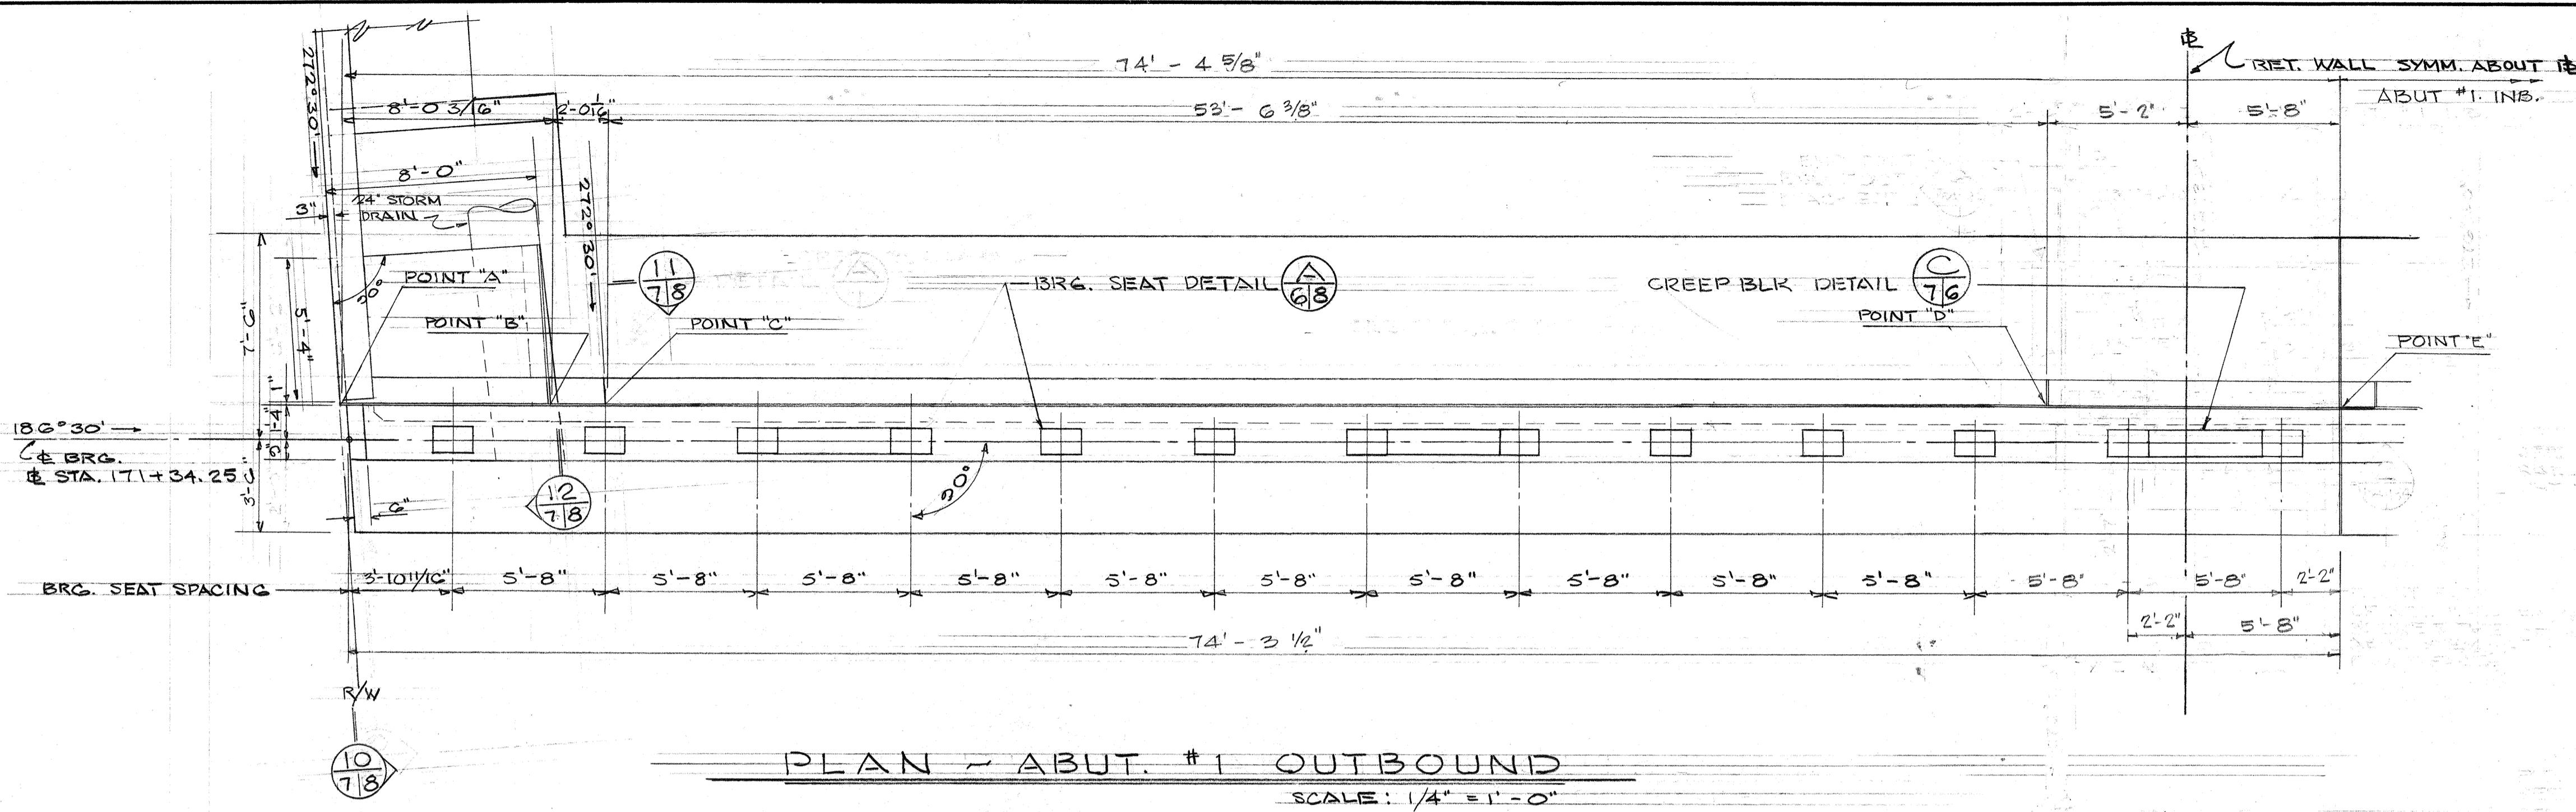

ELEVATION - ABUT. #1 OUTBOUND

SCALE: 1/4" = 1'-0"

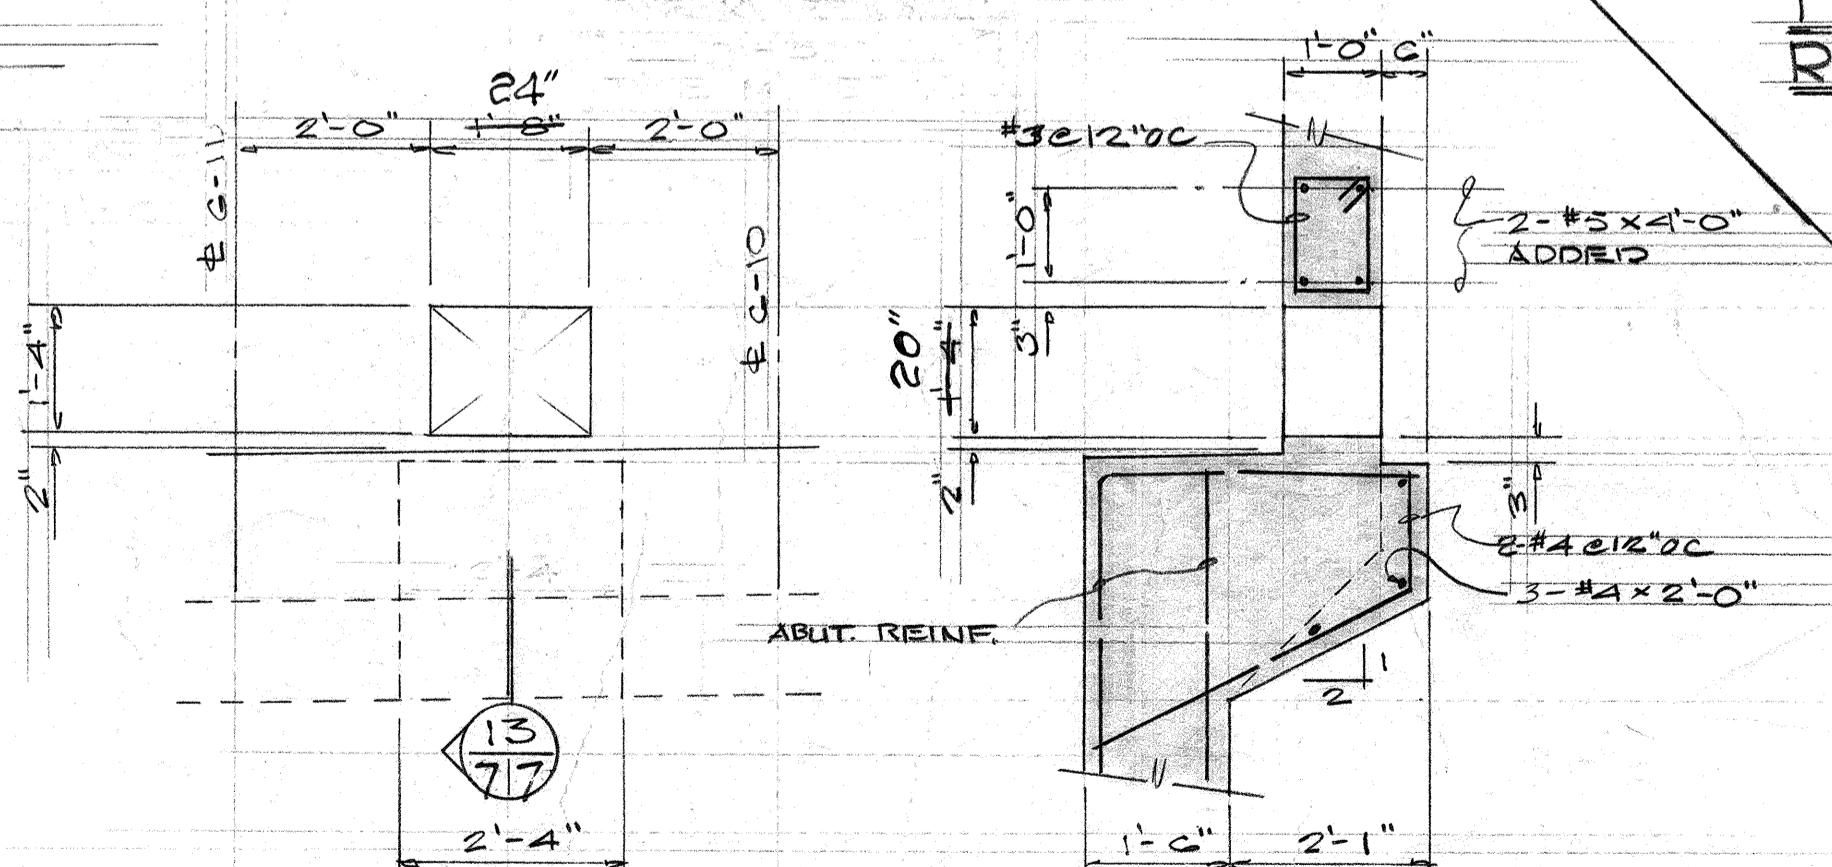

TYPICAL DETAIL for METAL GUARD RAIL POST ON BRIDGE MEDIAN


ALE: 3" = 1'-0" NOTE: FOR GUARD RAIL CONN.
DETAIL SEE SHT# 52

APPROVED
M.R.J 11-7-16
OUTSIDE PLANT ENGINEER, H.T.CO. LTD. DATE

SECTION 13-77 WILSON, OKAMOTO, OKA, INC.
SCALE: 1/2"=1'-0" PARK ASSOCIATES, INC.
ARCHITECTS & ENGINEERS

STATE OF HAWAII
DEPARTMENT OF TRANSPORTATION
HIGHWAYS DIVISION
PAKAHI STREAM BRIDGE
(STRUCTURE NO. 23)

ROAD ST. NO.	STATE	FED. AID PROJ. NO.	FISCAL YEAR	HEET NO.	TOTAL SHEETS
AWAII	HAW.	I-HI-1(6) UNIT #2	1966	231	235

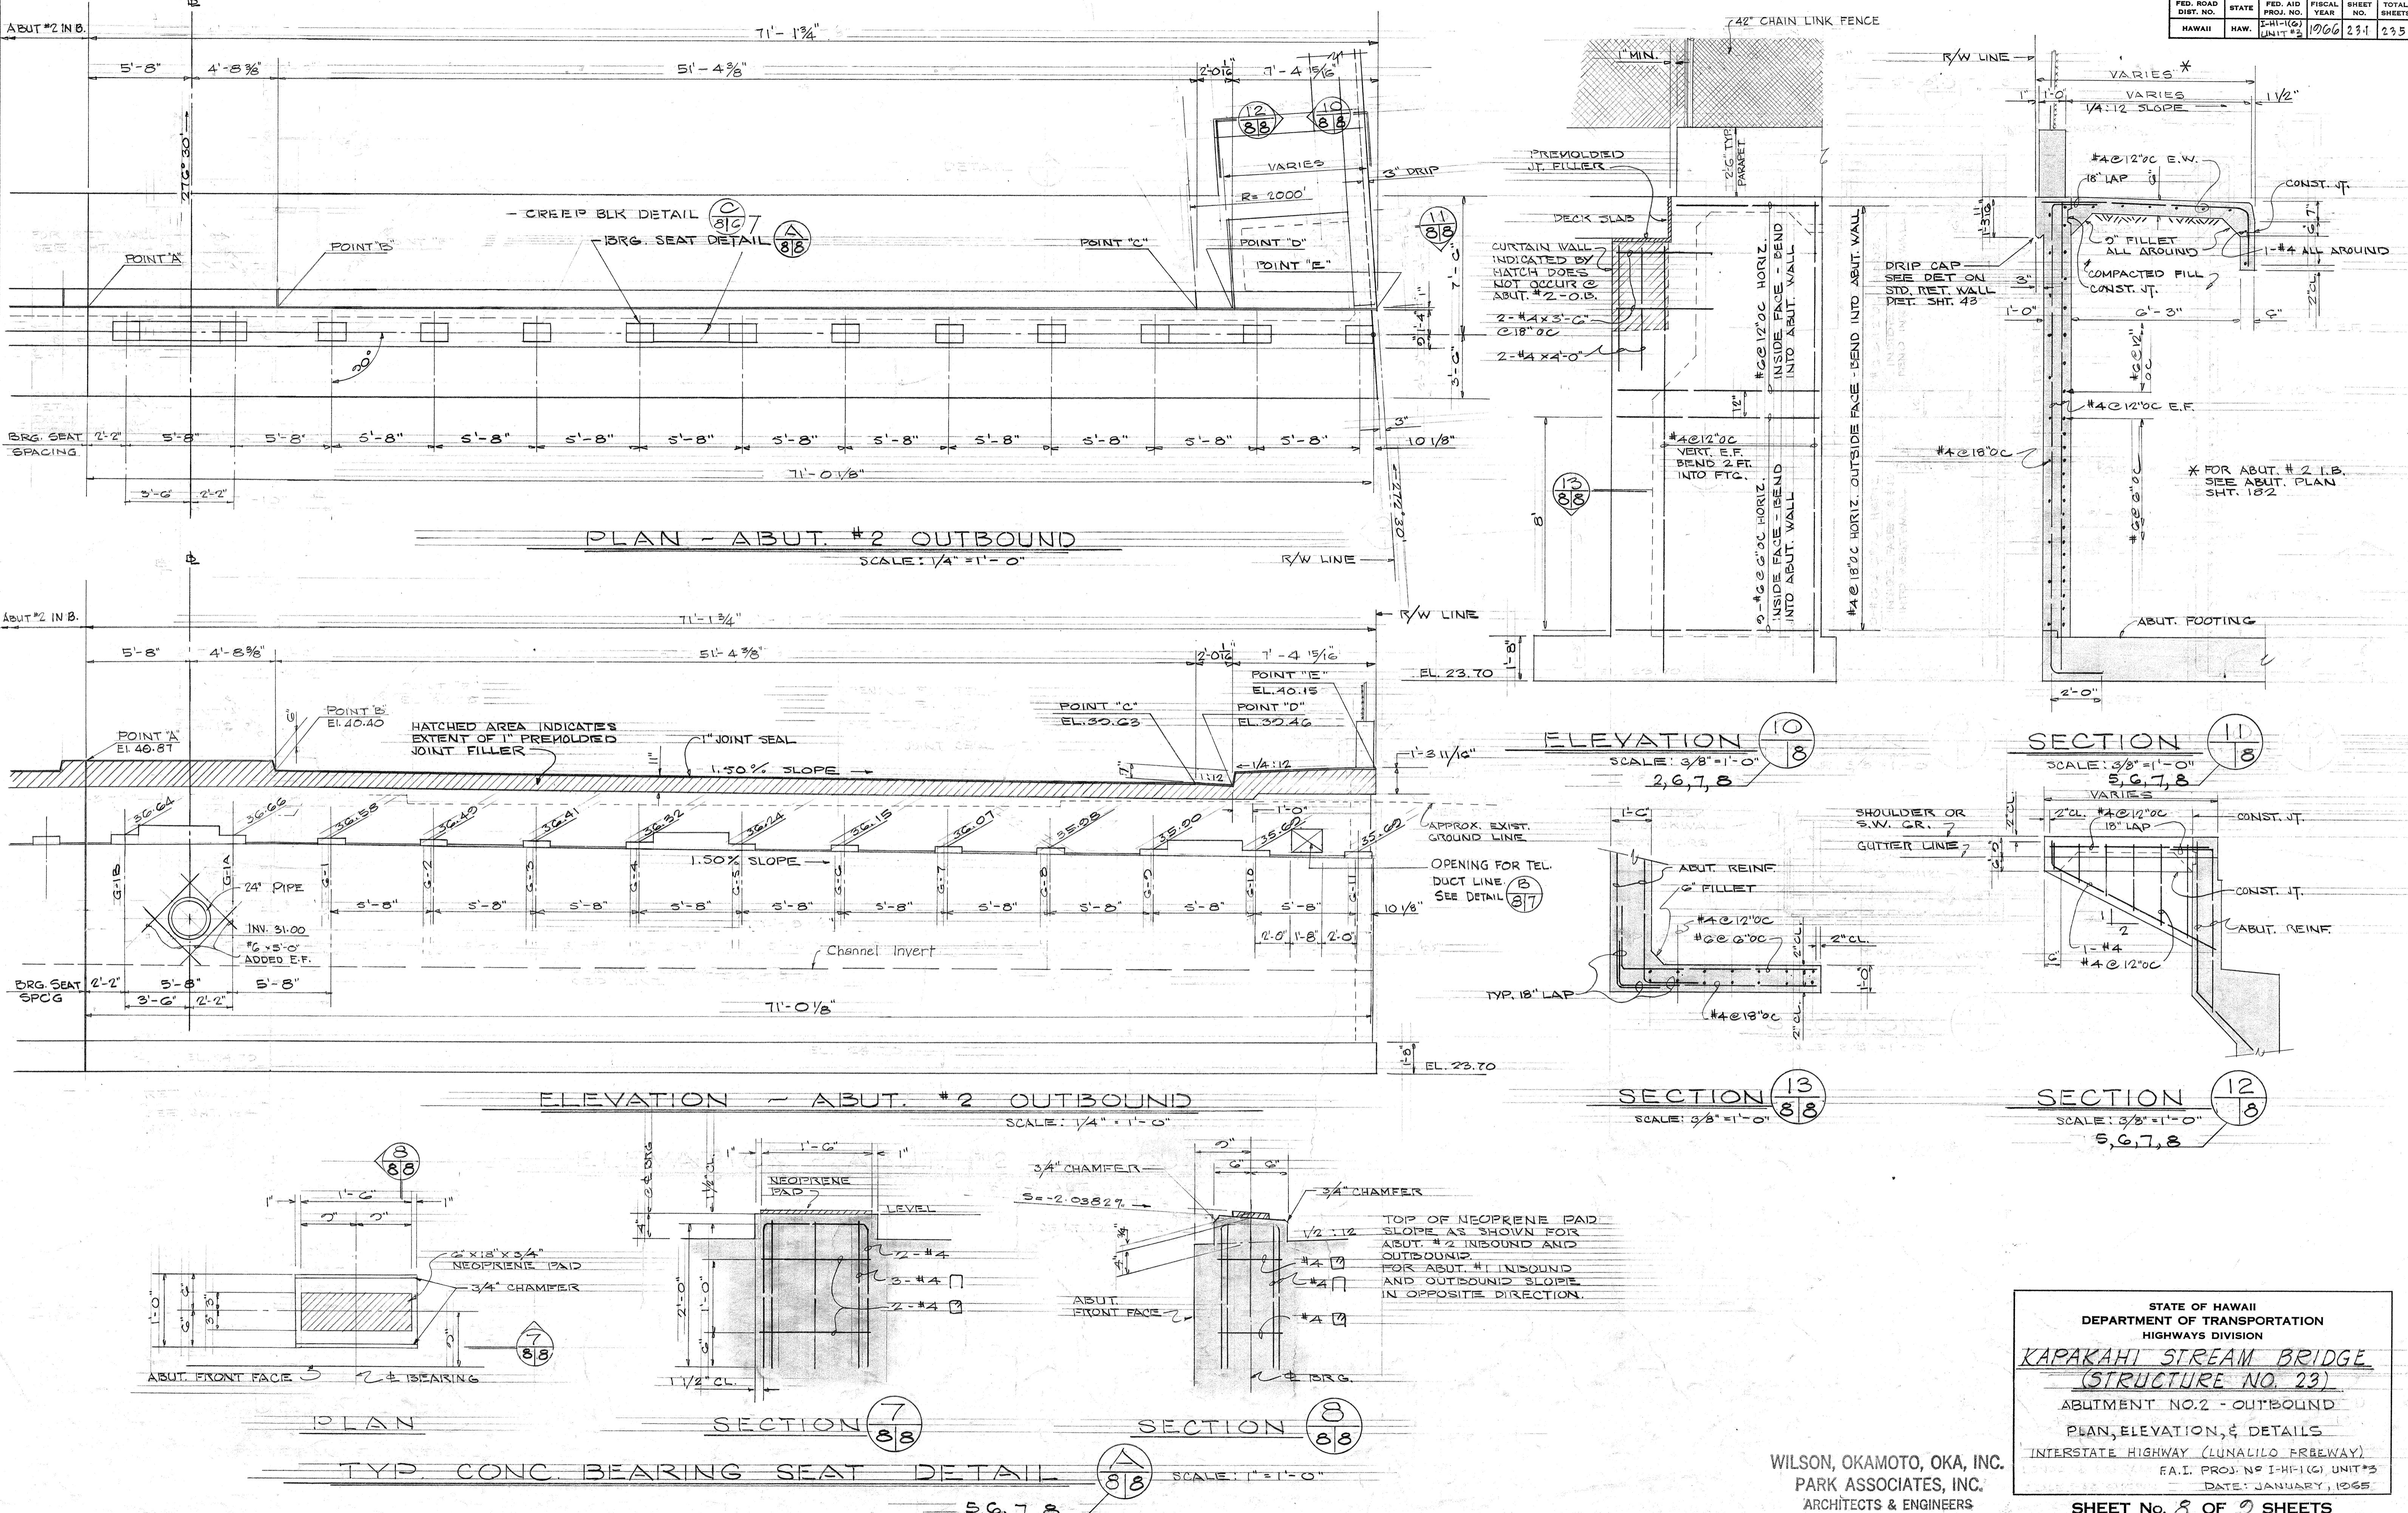


WILSON, OKAMOTO, OKA, INC.
PARK ASSOCIATES, INC.
ARCHITECTS & ENGINEERS

STATE OF HAWAII
DEPARTMENT OF TRANSPORTATION
HIGHWAYS DIVISION

SHEET No. 8 OF 9 SHEETS

D. ROAD ST. NO.	STATE	FED. AID PROJ. NO.	FISCAL YEAR	HEET NO.	TOTAL SHEETS
HAWAII	HAW.	I-HI-1(6) UNIT 3	1966	232	235

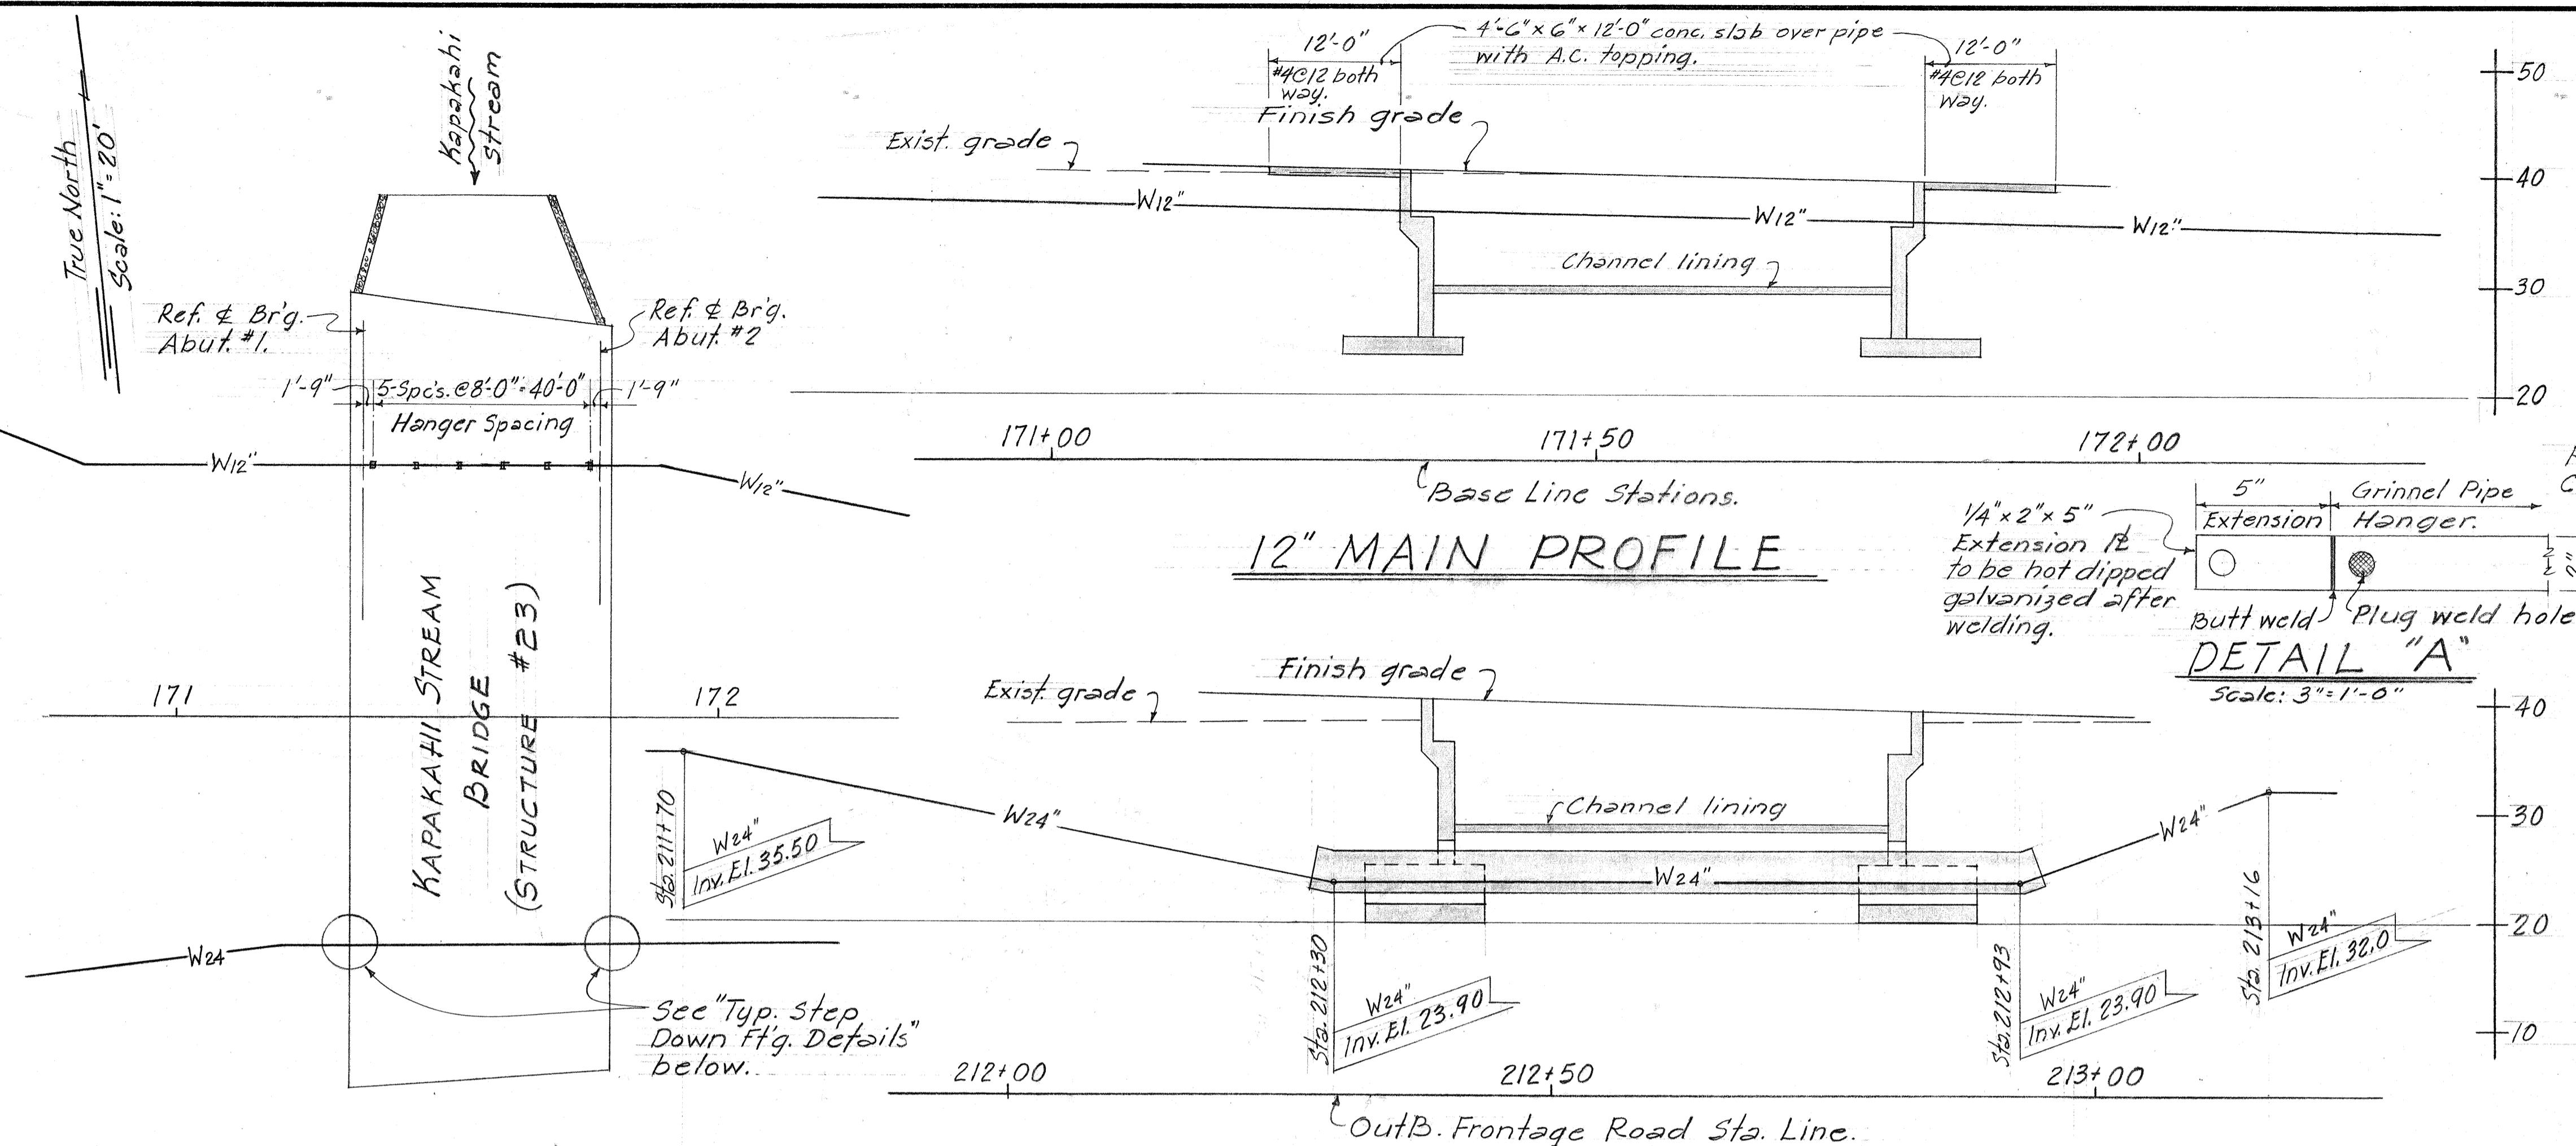

LAYOUT PLAN

Fill material shall be approved by the Engineer.
(Incidental to concrete in Bridge)

2-#5 x 7'-0" lg. added ea. face.

Typ. Abut. ft'g. reinf.

#4 @ 9" thruout

Constr. jt.

#5 @ 9" L bent thruout

\$ Water Main. Symm. about \$.

Fill "W" sec "Typ. 12" Conc. Jacket min Det. on sh. # 223.

1-#5 x 10'-0" lg. added ea. face.

Outline channel liner

1" premolded jt. filler

2-#8 cont.

Ref. top of ft'g.

Ref. bott of ft'g

Typ. Abut. ft'g. reinf.

#4 @ 18 cont.

3" cl. (typ.)

Bott. of step down ft'g. El. 20.0

4-#10 L bent spaced equally. (Rear fac

see "Typ. Abut. Sect." for bar height.

2-#8 (See "Port Plan" for location)

SECTION B

TYPICAL STEP DOWN FIT'G. DETAILS

Scale: $\frac{3}{8}'' = 1'-0''$

Note!
For hanger spacing,
see "Layout Plan."

Insert - See
details below.

W12" MAIN HANGER DETAIL

21c: $3\frac{1}{4}'' = 1' - 0''$

2-#4 bent
bars

3" x 3/8" x 4" P welded.

2 1/2" x 3/8" bent P.

Adjust for tight fit.

*3" x 3/8" x 3 1/2" P
embedded in
precast prestressed
girder.*

*2 - 5/8" φ Bolts with hex. nuts
and lock washers.*

NOTE: Lateral bracing shall be painted. See Subarticle 44.3(I)

PLAN VIEW OF
LATERAL BRACING

'cale: 3" = 1'-0"

A hand-drawn technical sketch showing the elevation of a soffit panel. The panel has a total width of 6". It features a central vertical rib with a height of 6". A horizontal slot is located at the bottom of the panel, indicated by a dashed line. The panel is divided into sections by vertical and horizontal lines. A bracketed section on the right side is labeled "1 1/4" 1 1/4" 2 1/2"". A vertical dimension line indicates a height of 1" from the bottom of the panel to the top of the hatched area. A horizontal dimension line shows a distance of 1/2" from the center of the panel to the edge of the hatched area. A label "1 5/8"" is placed near the bottom right corner. Below the sketch, handwritten text reads "Soffit of depressed panel." and "ELEVATION".


NORMAL SECTION

APPROVED:

STATE OF HAWAII
DEPARTMENT OF TRANSPORTATION
HIGHWAYS DIVISION


SHEET No. 9 OF 9 SHEETS

FED. ROAD DIST. NO.	STATE	FED. AID PROJ. NO.	FISCAL YEAR	SHEET NO.	TOTAL SHEETS
HAWAII	HAW.	L-44-1(6), Unit 3	1985	C-9 2985-1	235

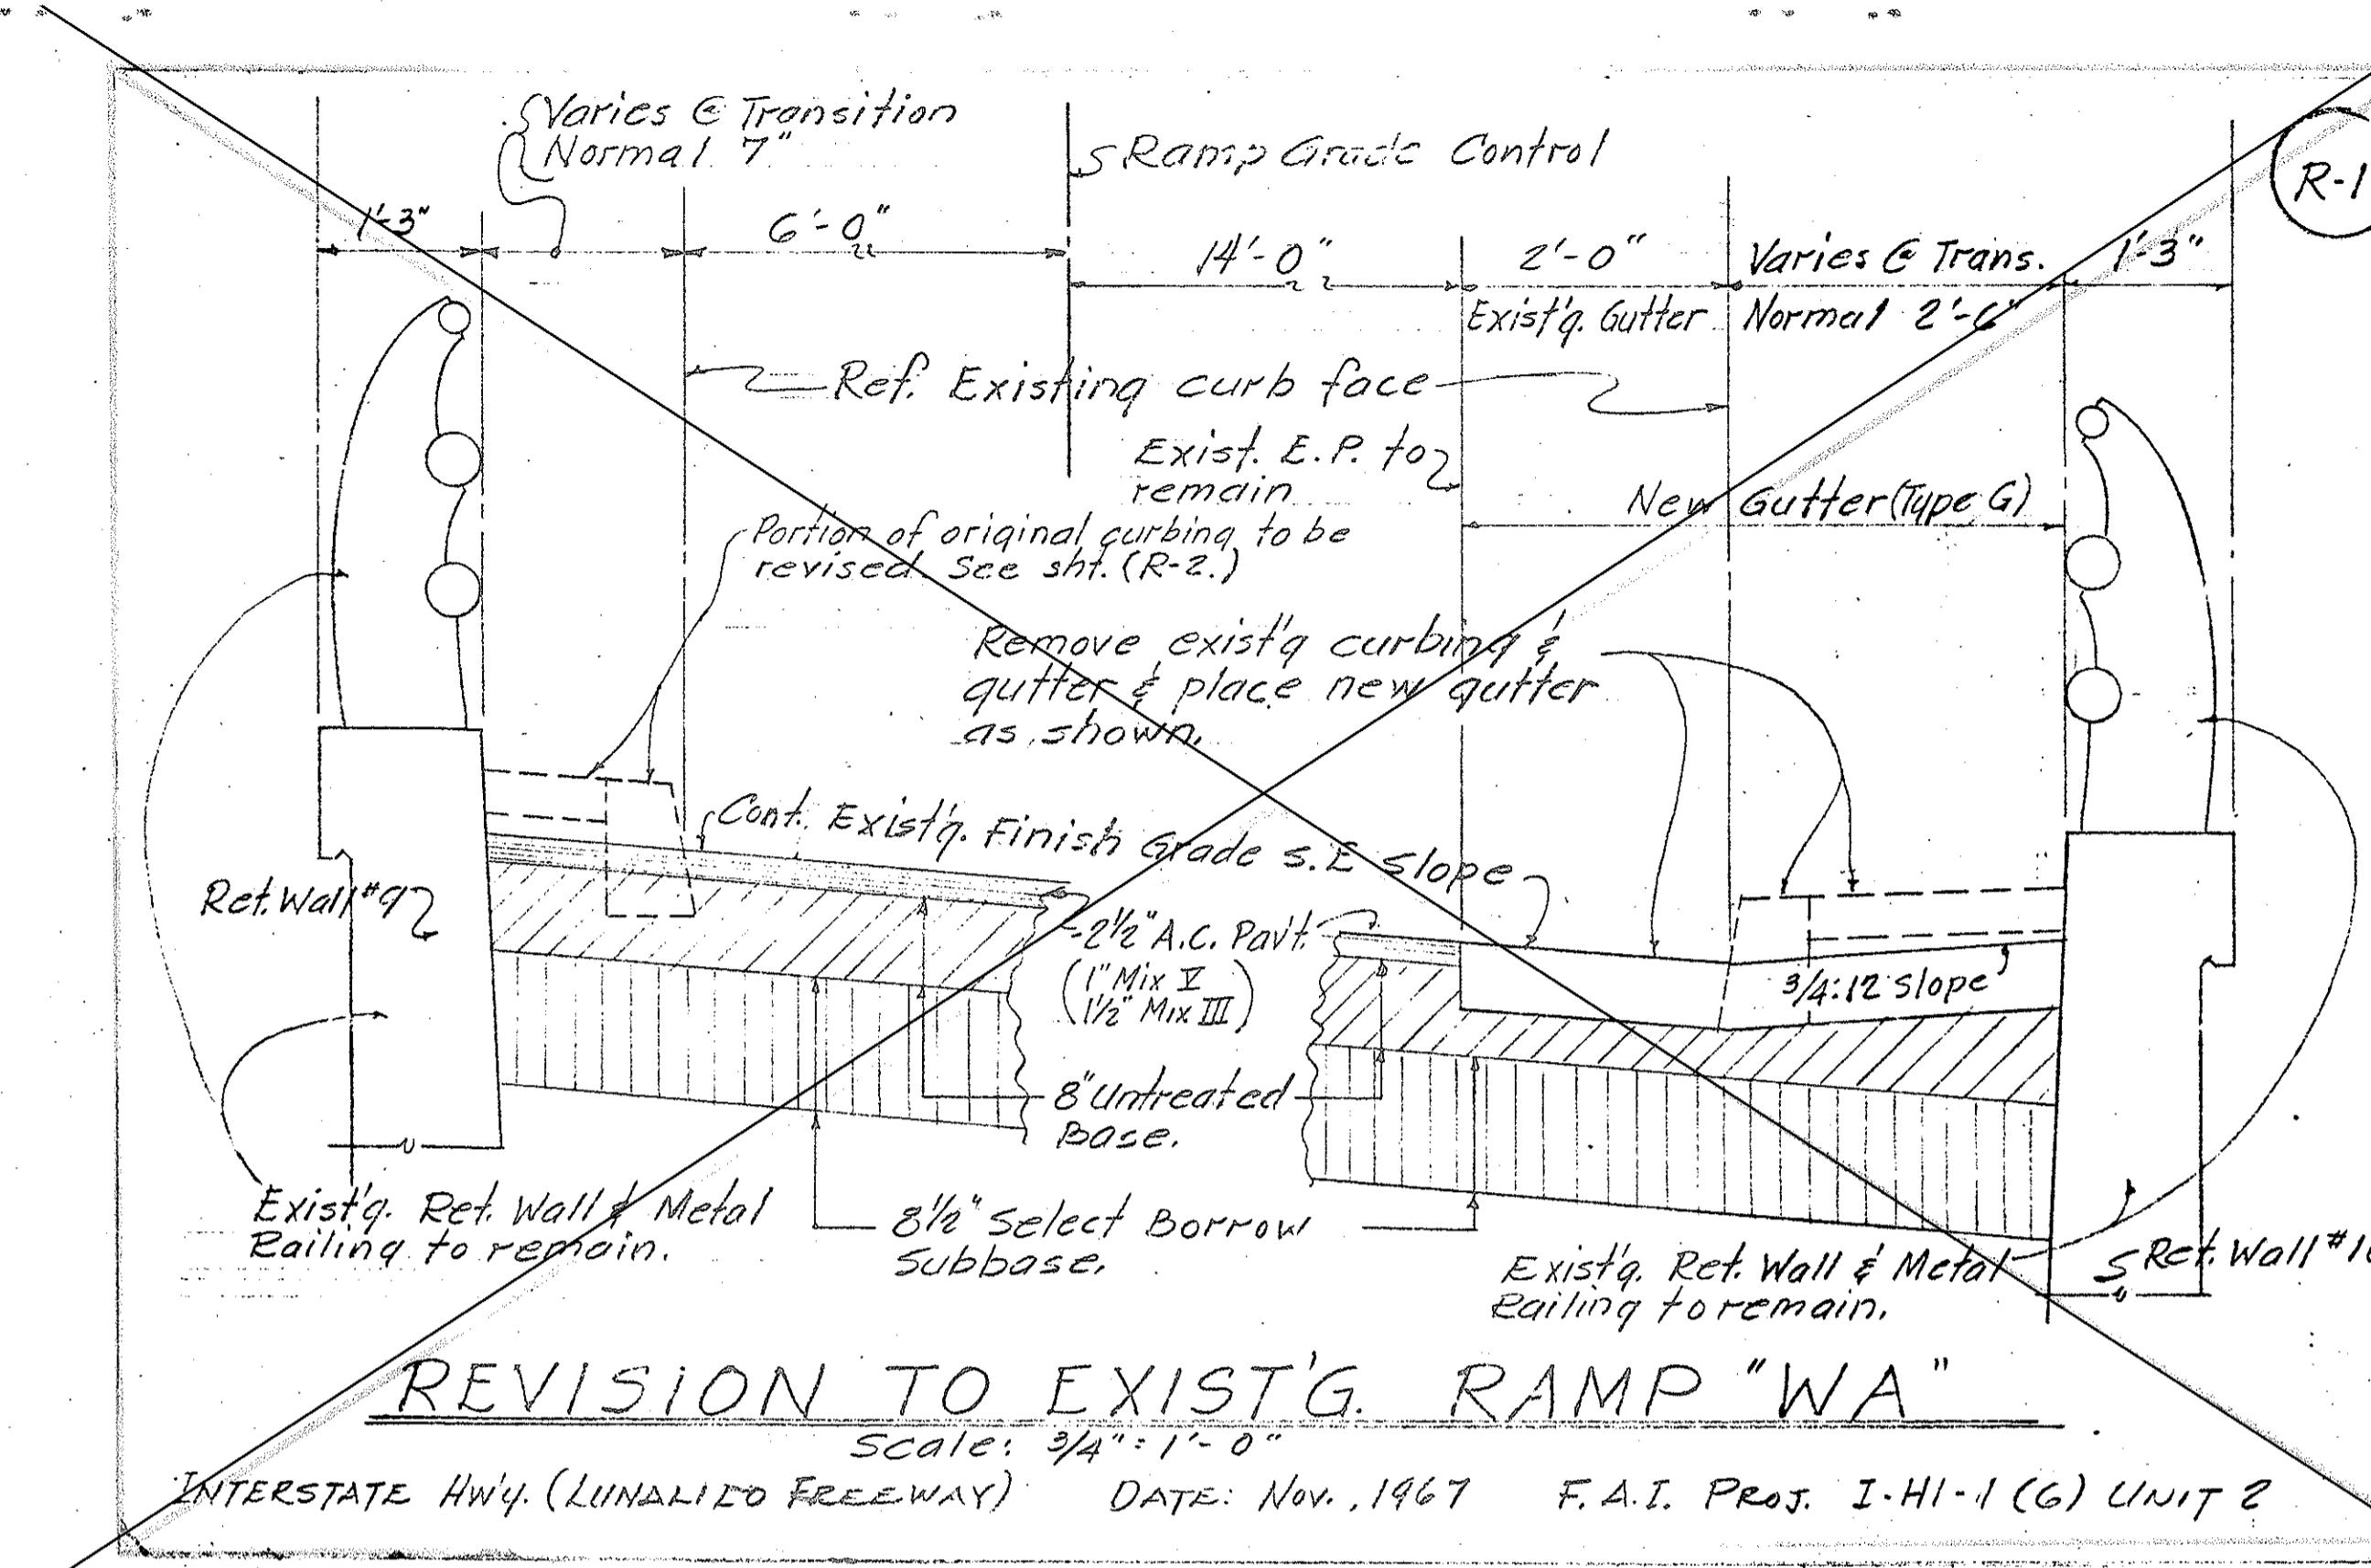

REVISION TO EXIST'G. RAMP "WA

SCALE: 3/4": 1'-0" INTERSTATE HWY. (LUNA LDO FREEWAY) DATE: Nov., 1967 F.A.I. PROJ. I-HI-1(6) UNIT 2

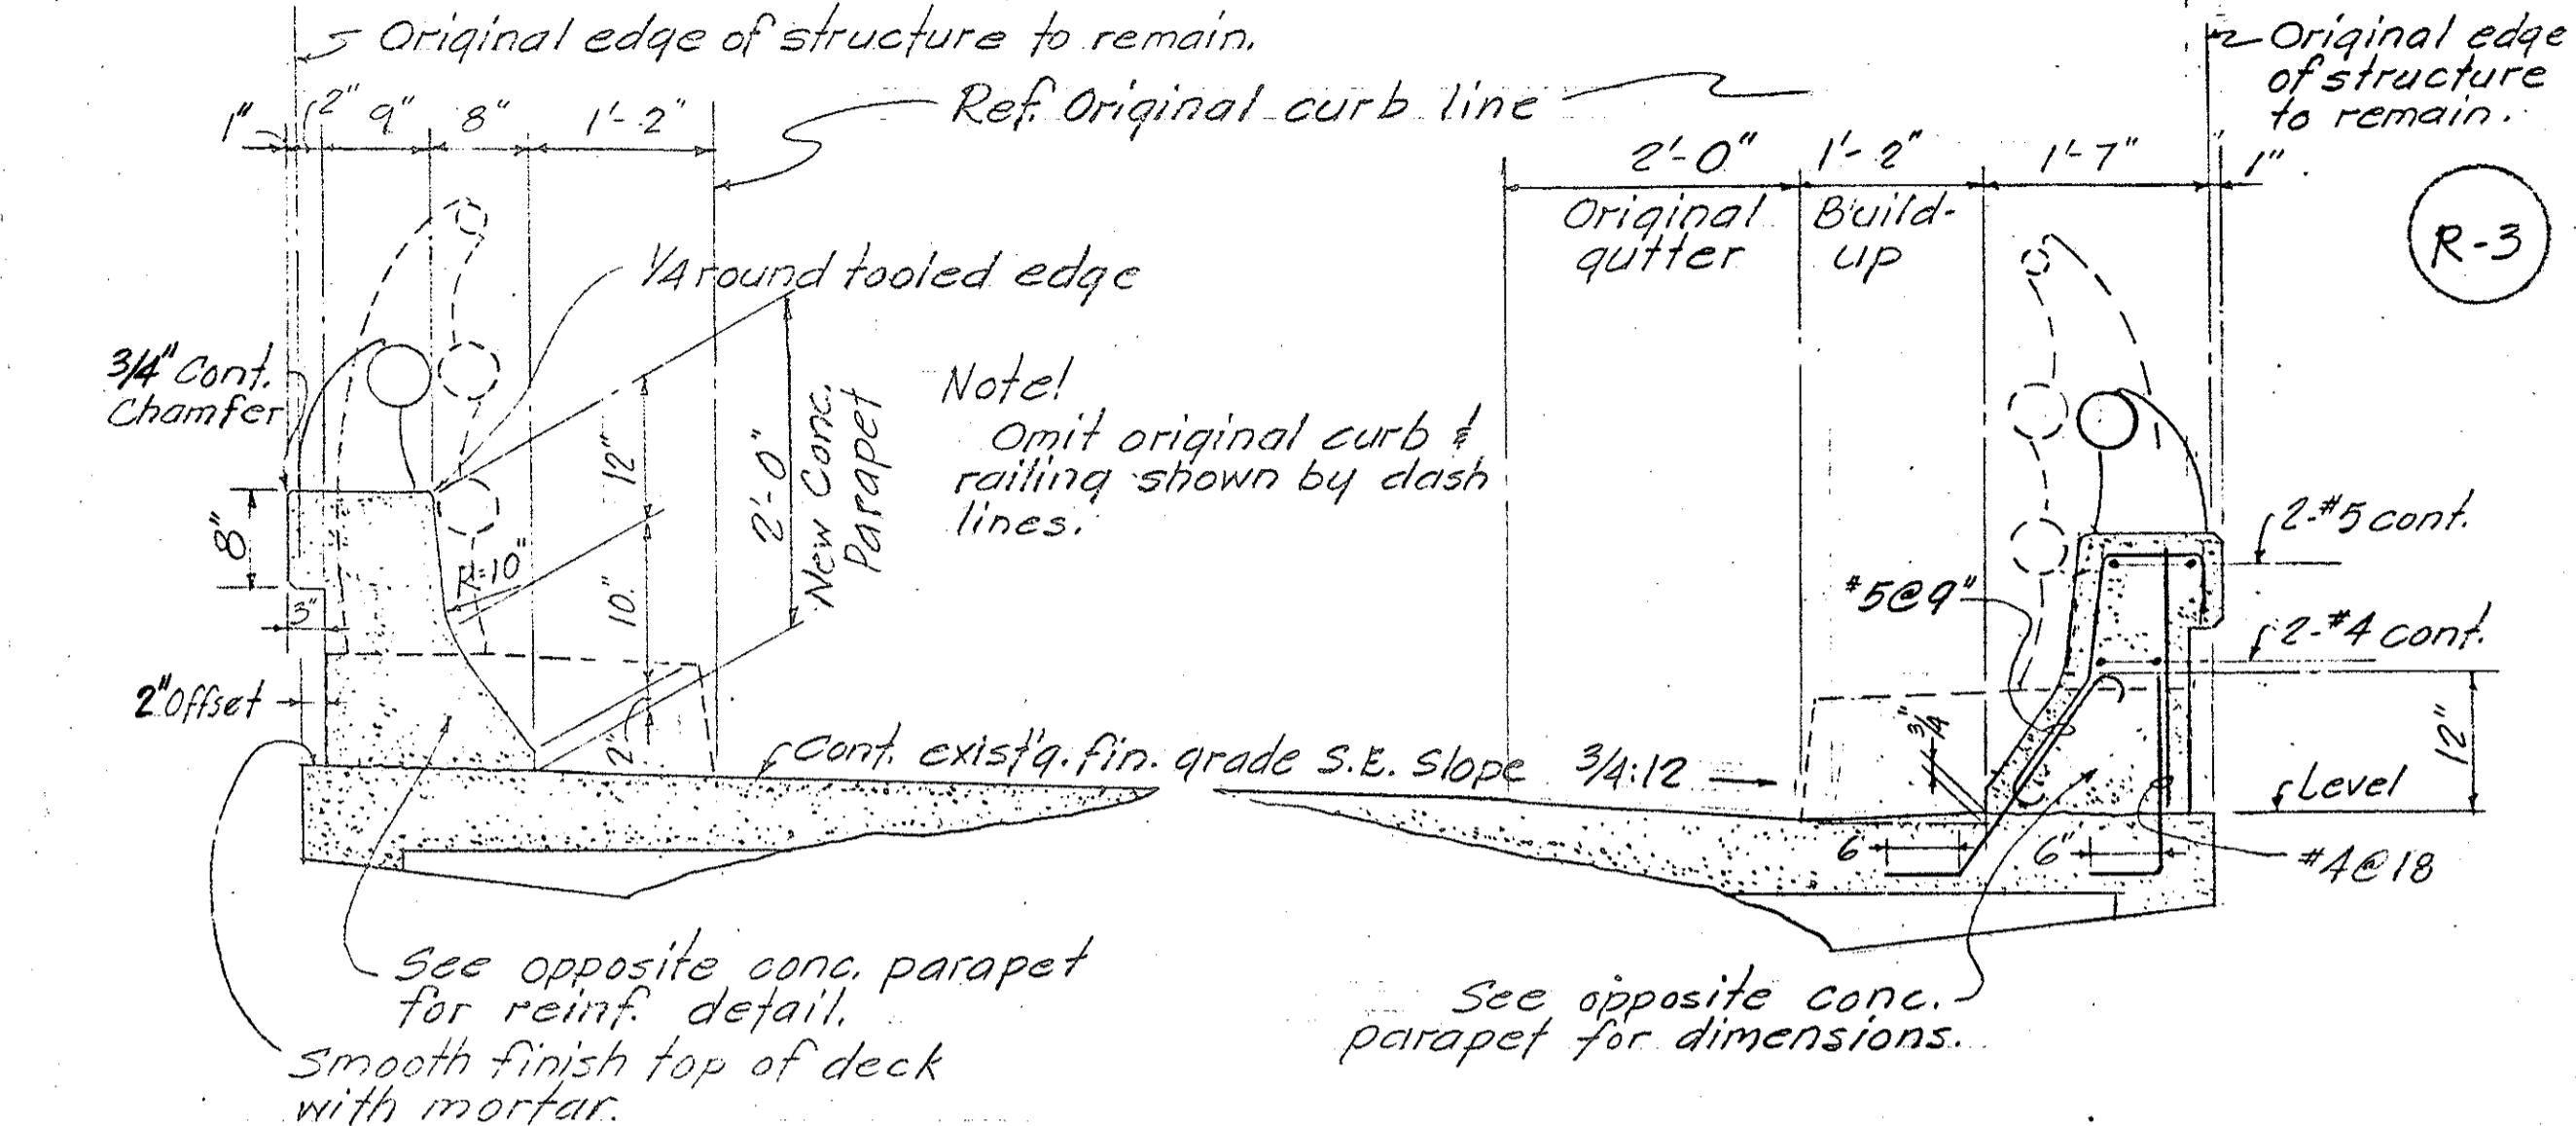


REVISED NORMAL PART SECTION

Scale: $\frac{3}{4}'' = 1'-0''$
PICTURE N° 20


INTERSTATE HWY. (LUNALILO FREEWAY) DATE: NOV., 1967

F.A.I. PROJ. I-H1-1(6) UNIT 3

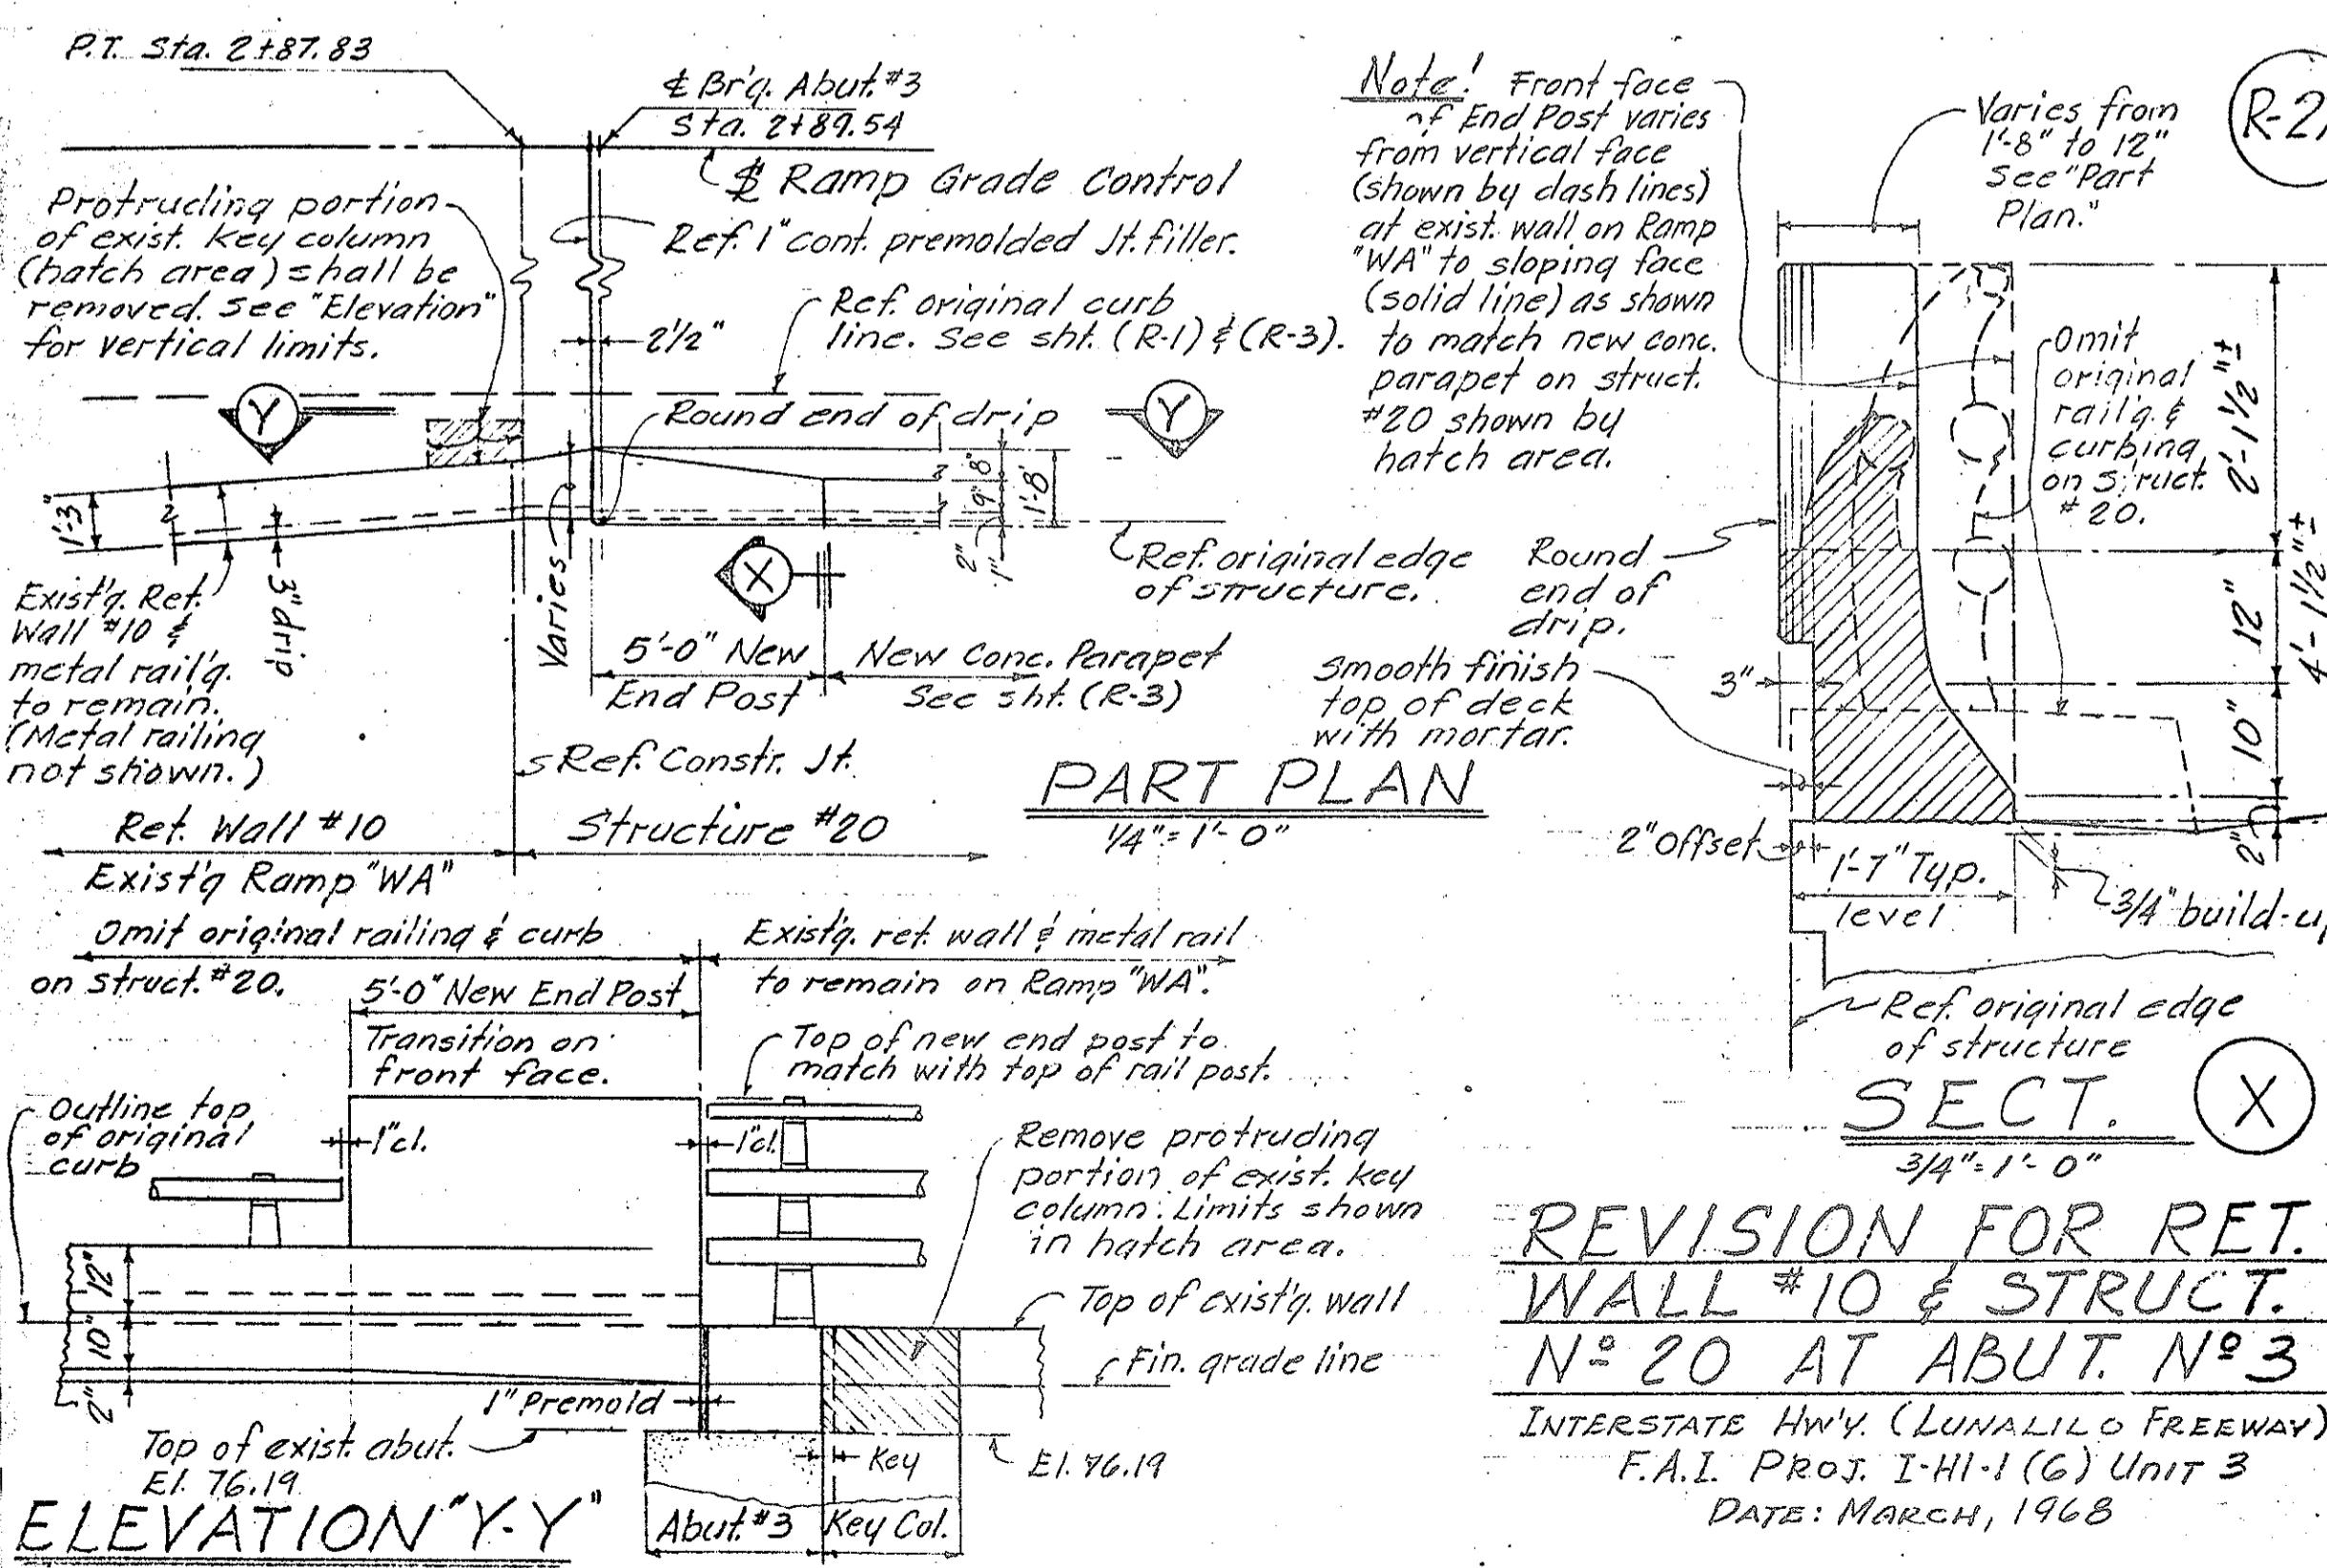

REVISION FOR RE
WALL #10 & STRUCT
Nº 20 AT ABUT. Nº

E.I. 76.19 E.I. 76.19
ELEVATION "Y-Y" Abut. #3 Key Col.

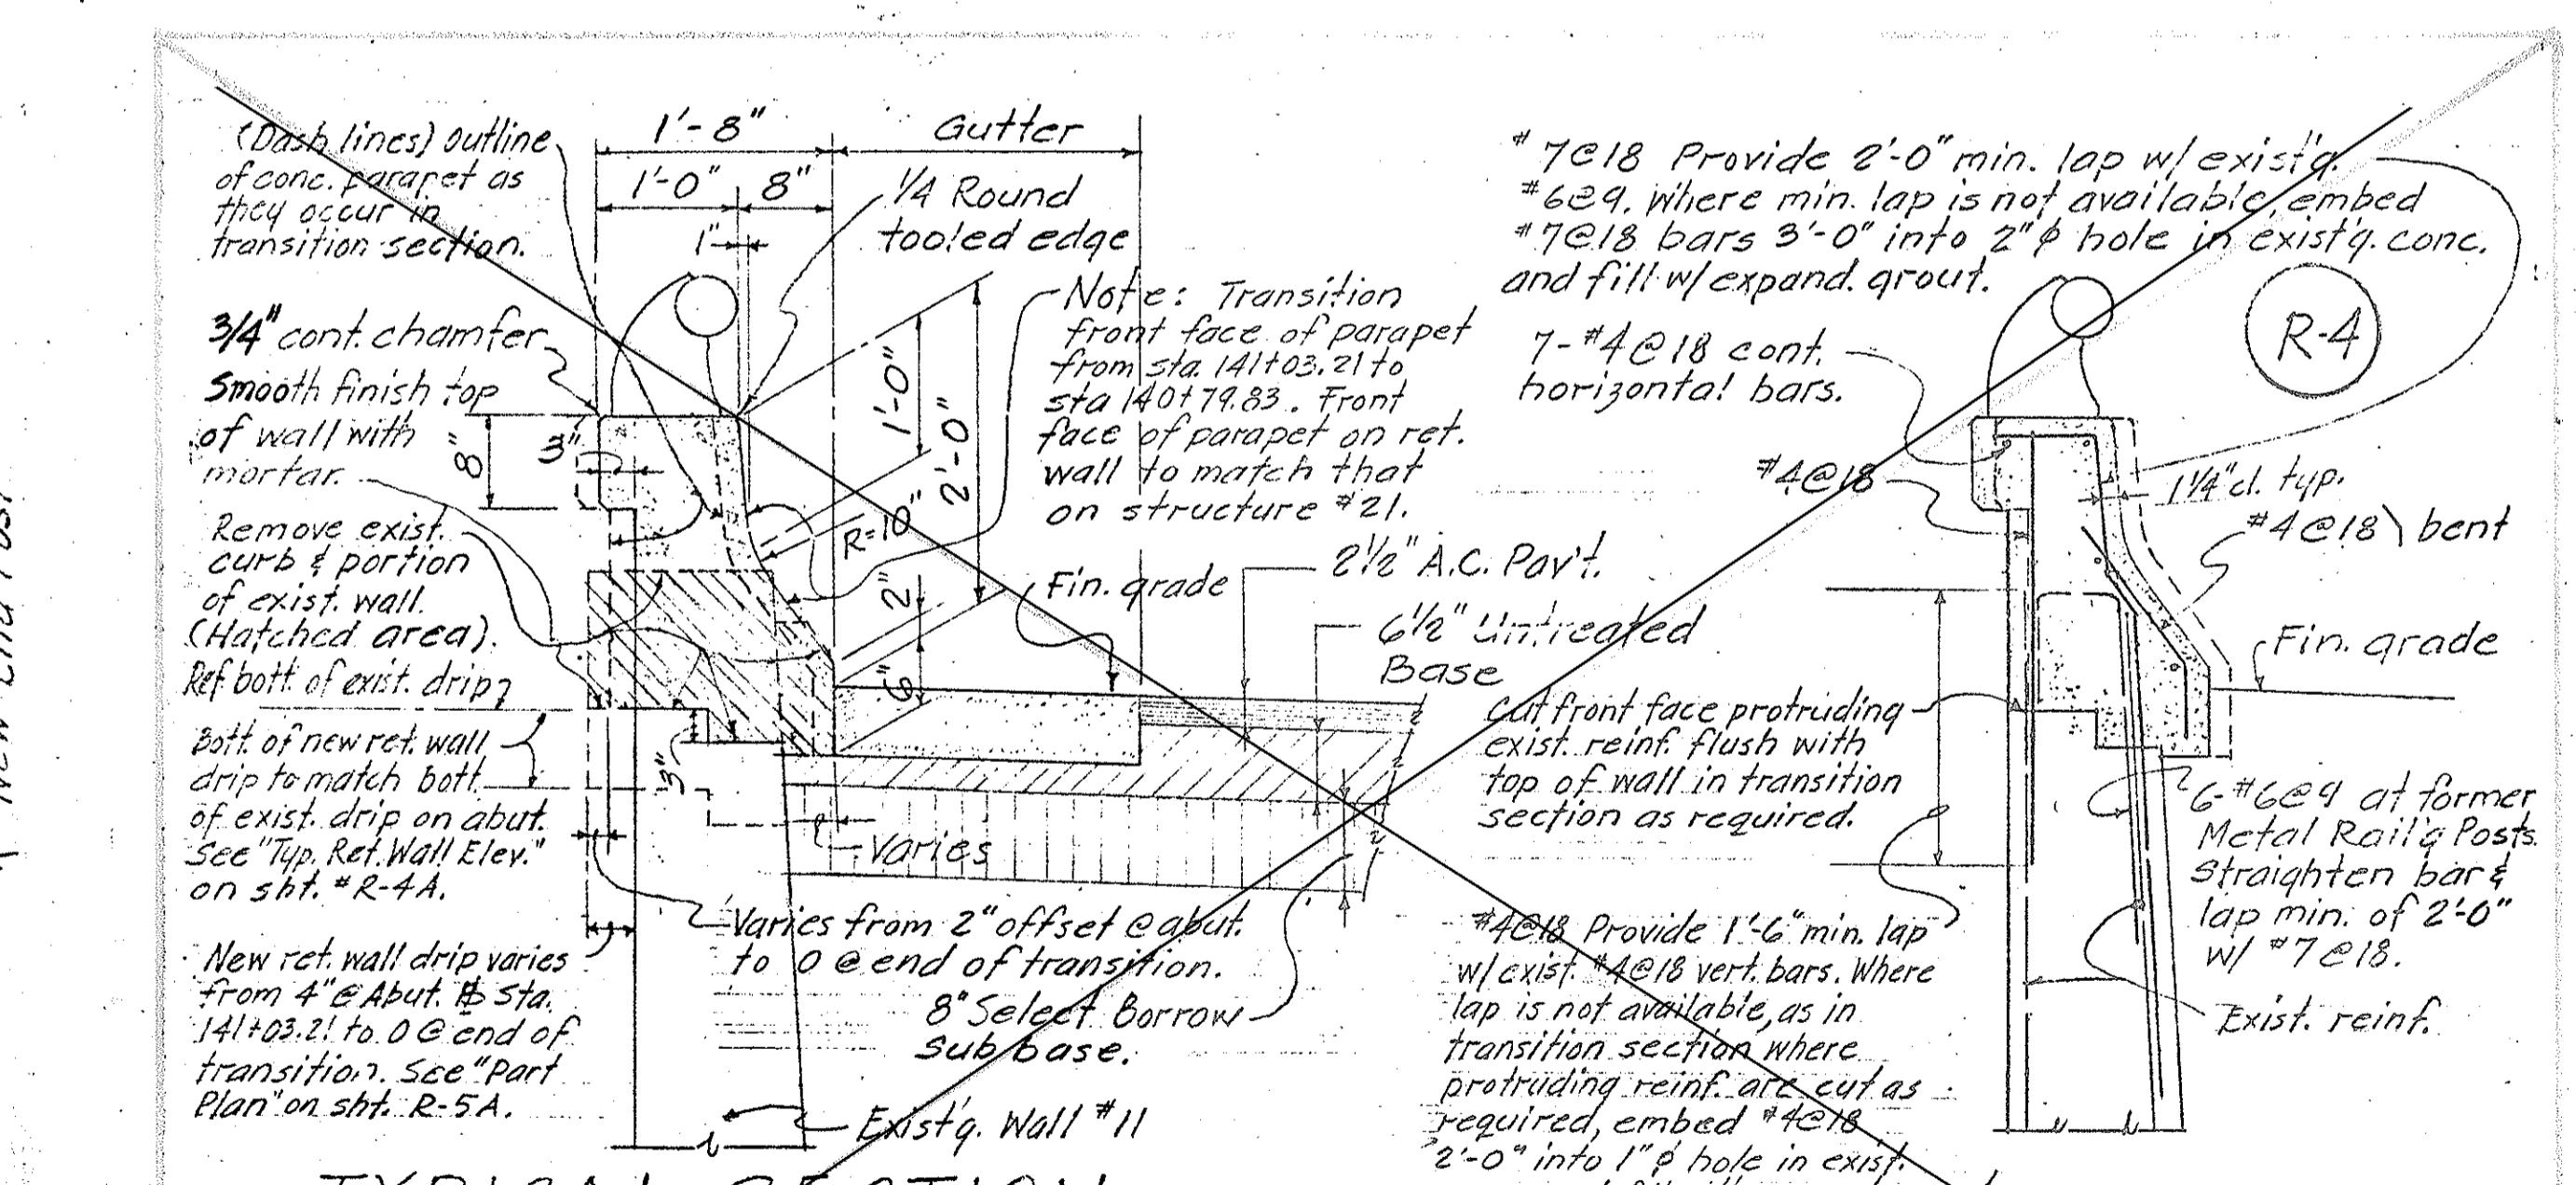

TYPICAL SECTION

REVISED CONC. PARAPET & RAIL'G. DETAILS
FOR RET. WALL N° 11



Scale: 3/4" = 1'-0" INTERSTATE HWY. (LUNALILO FREEWAY) DATE: NOV. 1967 F.A.I. PROJ. N° I-HI-1(6) UNIT 2

**STATE OF HAWAII
DEPARTMENT OF TRANSPORTATION
HIGHWAYS DIVISION**

CHANGE ORDER

A.I. PROJ. NO. I-H-1(6).

FED. ROAD DIST. NO.	STATE	FED. AID PROJ. NO.	FISCAL YEAR	SHEET NO.	TOTAL SHEETS
HAWAII	HAW.	I-HI-1(6), UNIT 3	1985	C.O. 232S-2	235

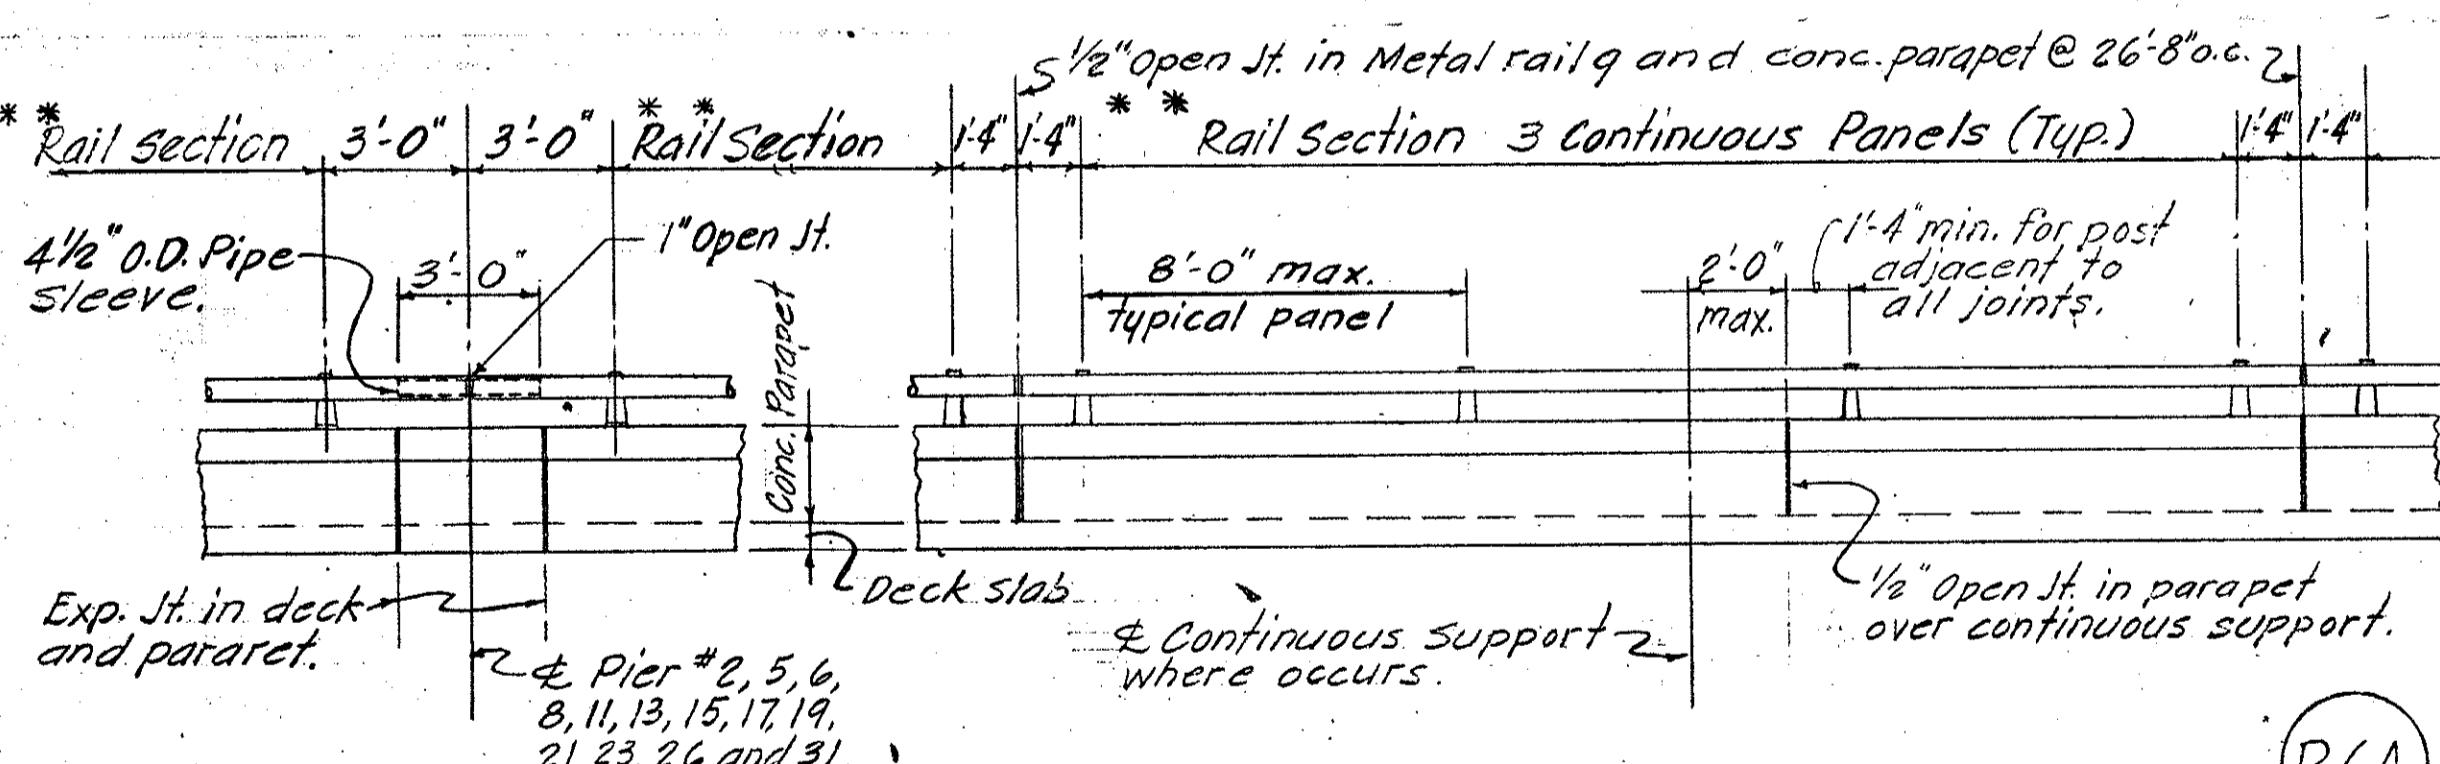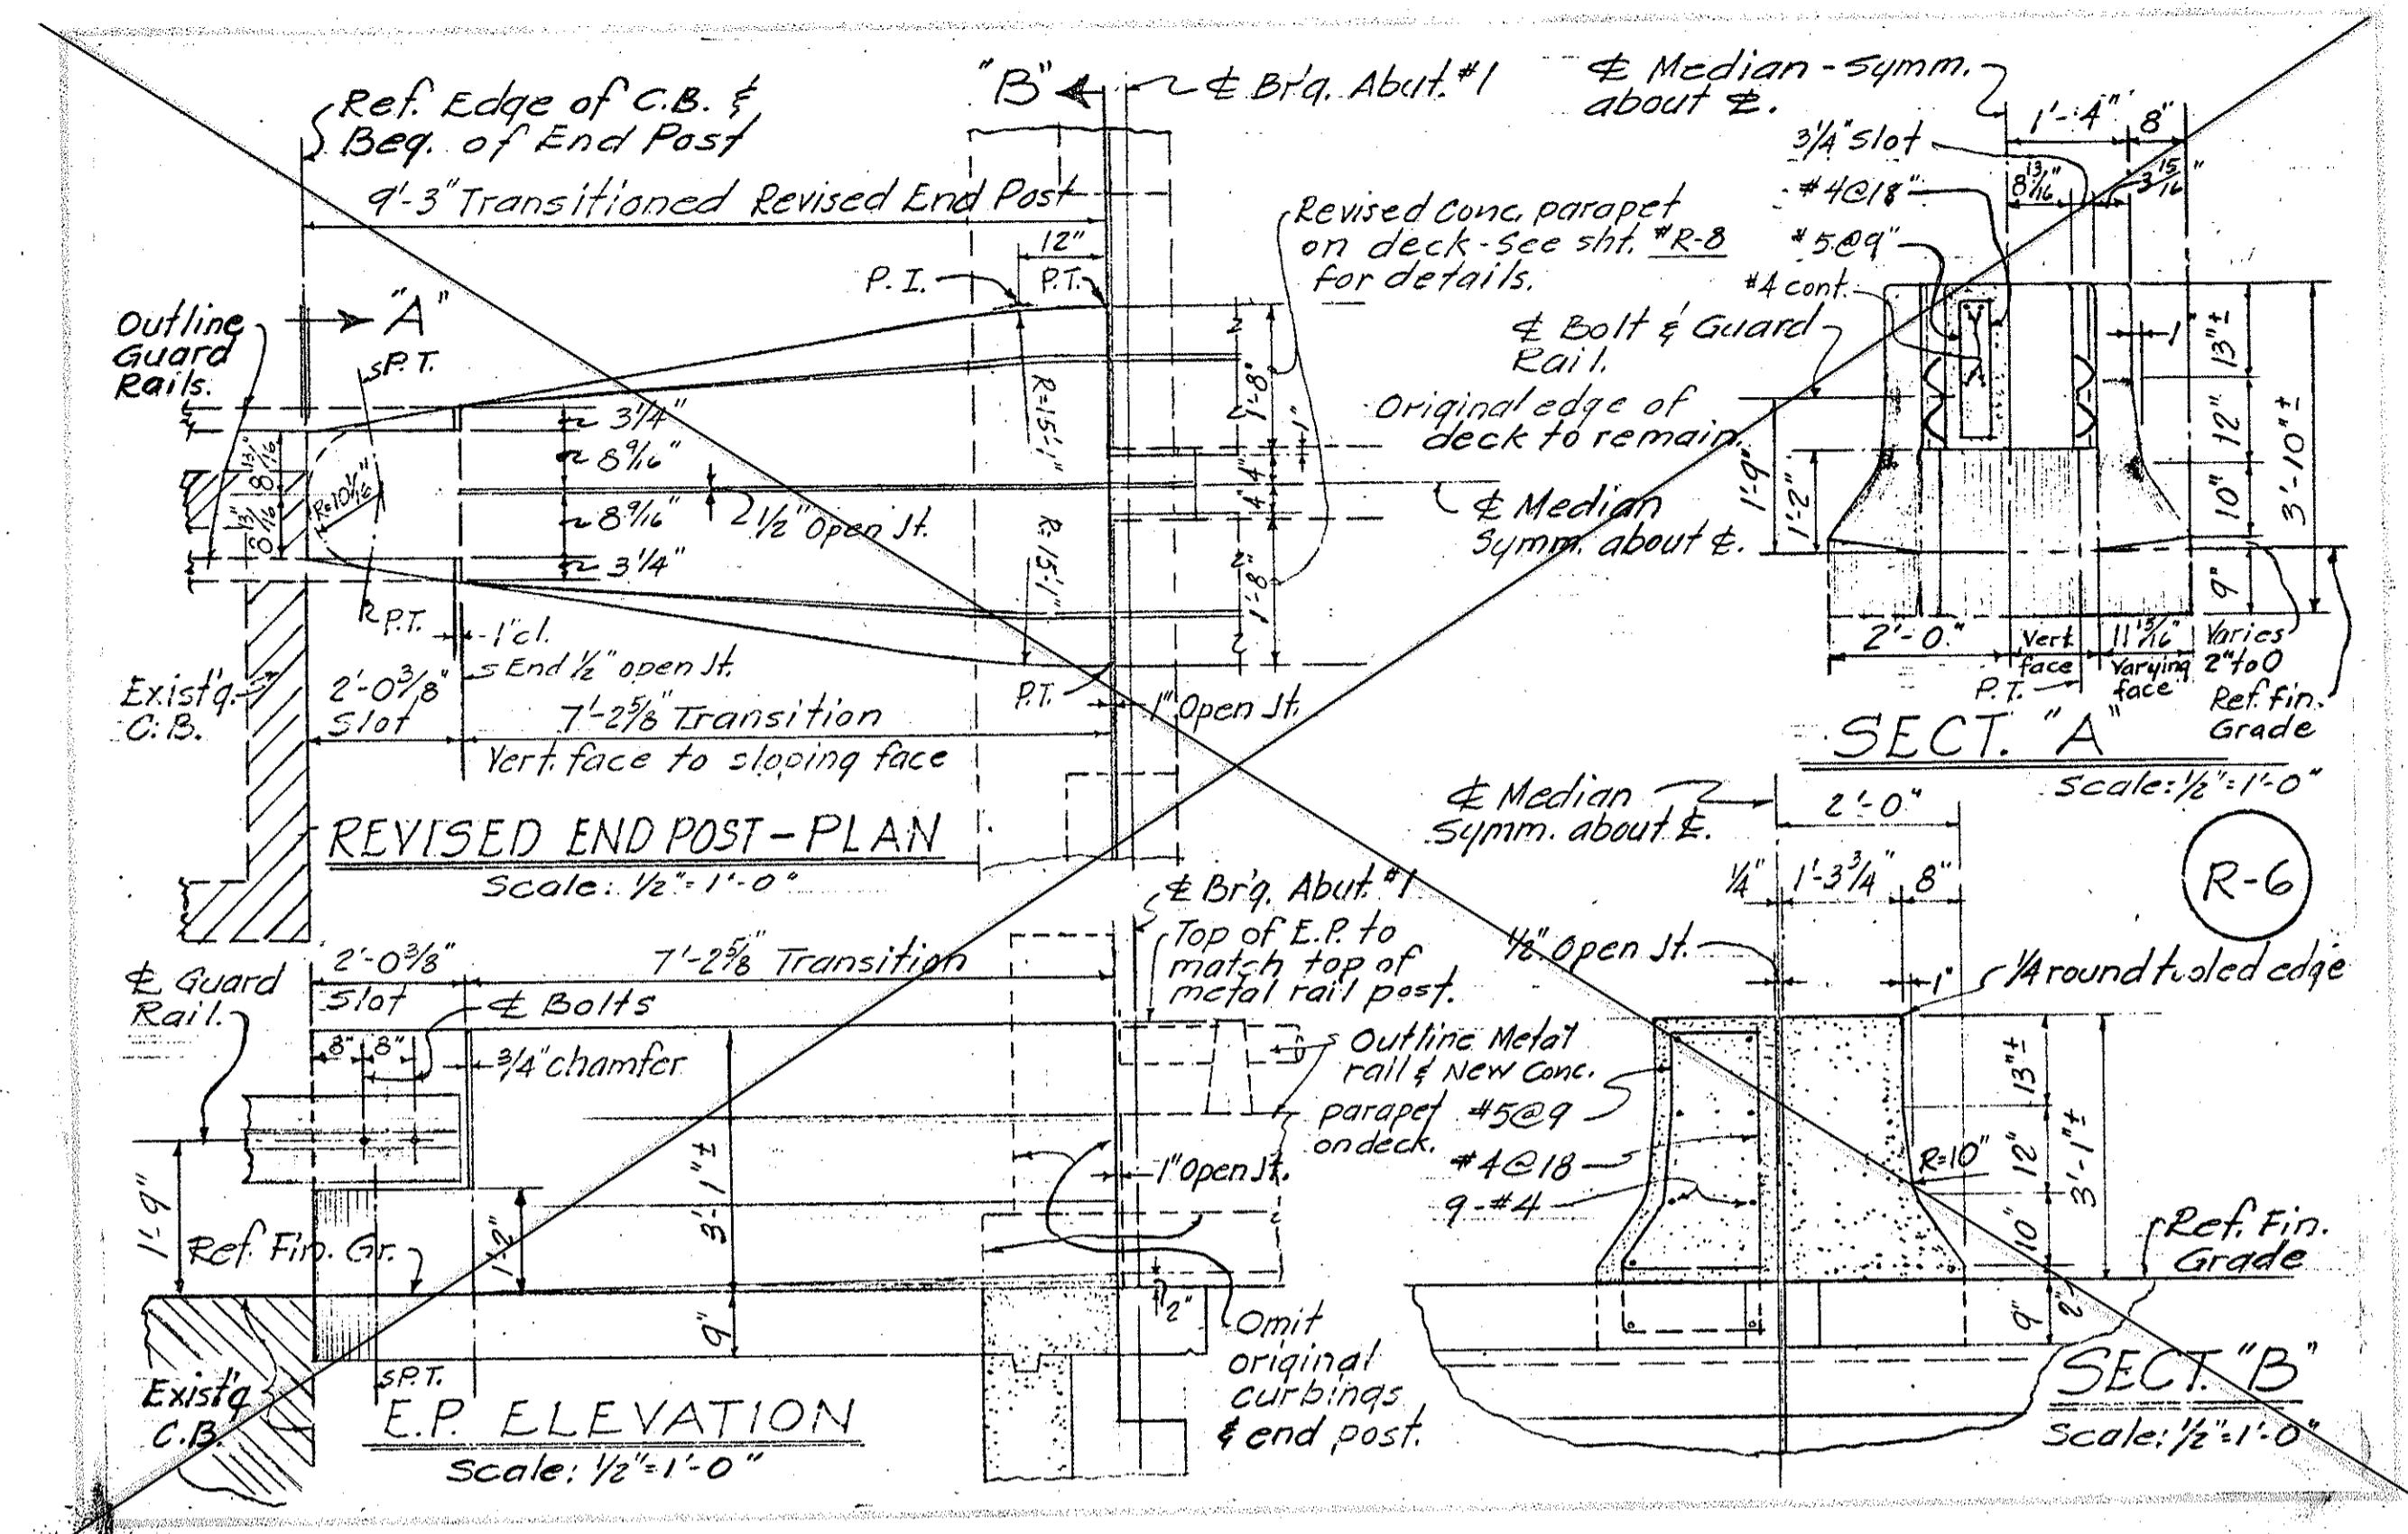


AT DECK EXP. JOINT INTERMEDIATE EXTERIOR RAILING ELEVATION

*** * NOTE:**
The Contractor shall layout the railing to provide 3 continuous panels whenever possible. 2 or 4 cont. panels will be permitted to complete the layout when 3 cont. panels cannot be made. Single panel will not be permitted.

Rail posts shall be normal to grade. Provide double posts at each parapet expansion joint except where joint occurs at continuous support, use single post as shown on detail drawing above. Also, use single post at deck expansion joint as shown on detail above..

STANDARD RAIL SPACING DETAILS

INTERSTATE Hwy (LUNALILO FREEWAY) DATE: MARCH, 1968 F.A.I. PROJ. I-HI-1(6) UNIT 3

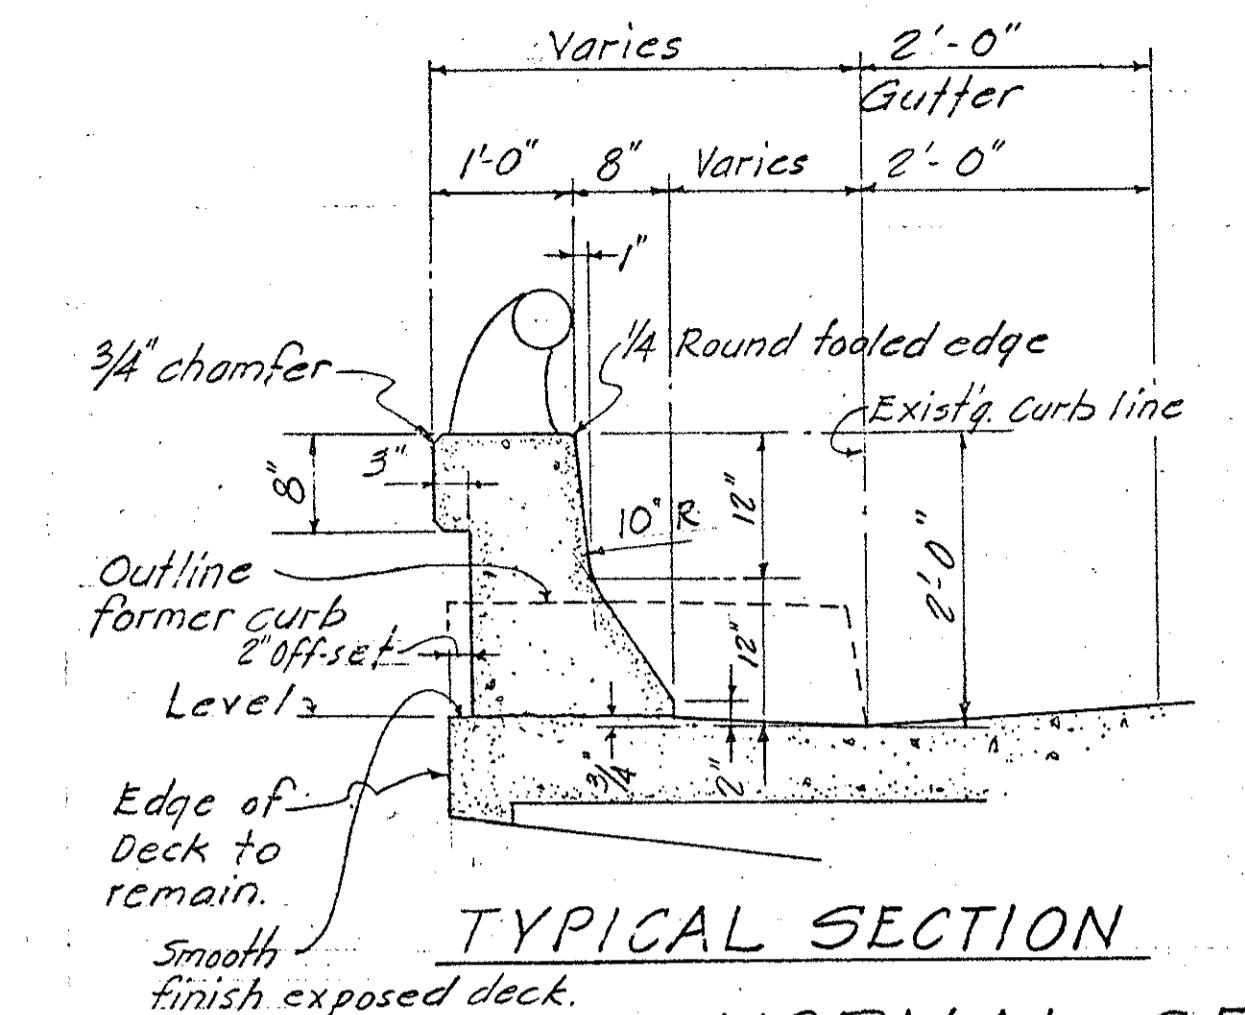


NORMAL SECTION AT EXTERIOR END OF STRUCTURE

Scale: $\frac{3}{4}$ " = 1'-0"

STRUCTURE N° 21
INTERSTATE HIGHWAY (LUNALILO FREEWAY)
F.A.I. PROJ. I-HI-1(6) UNIT 3 DATE: Nov, 1967

REINF. DETAIL

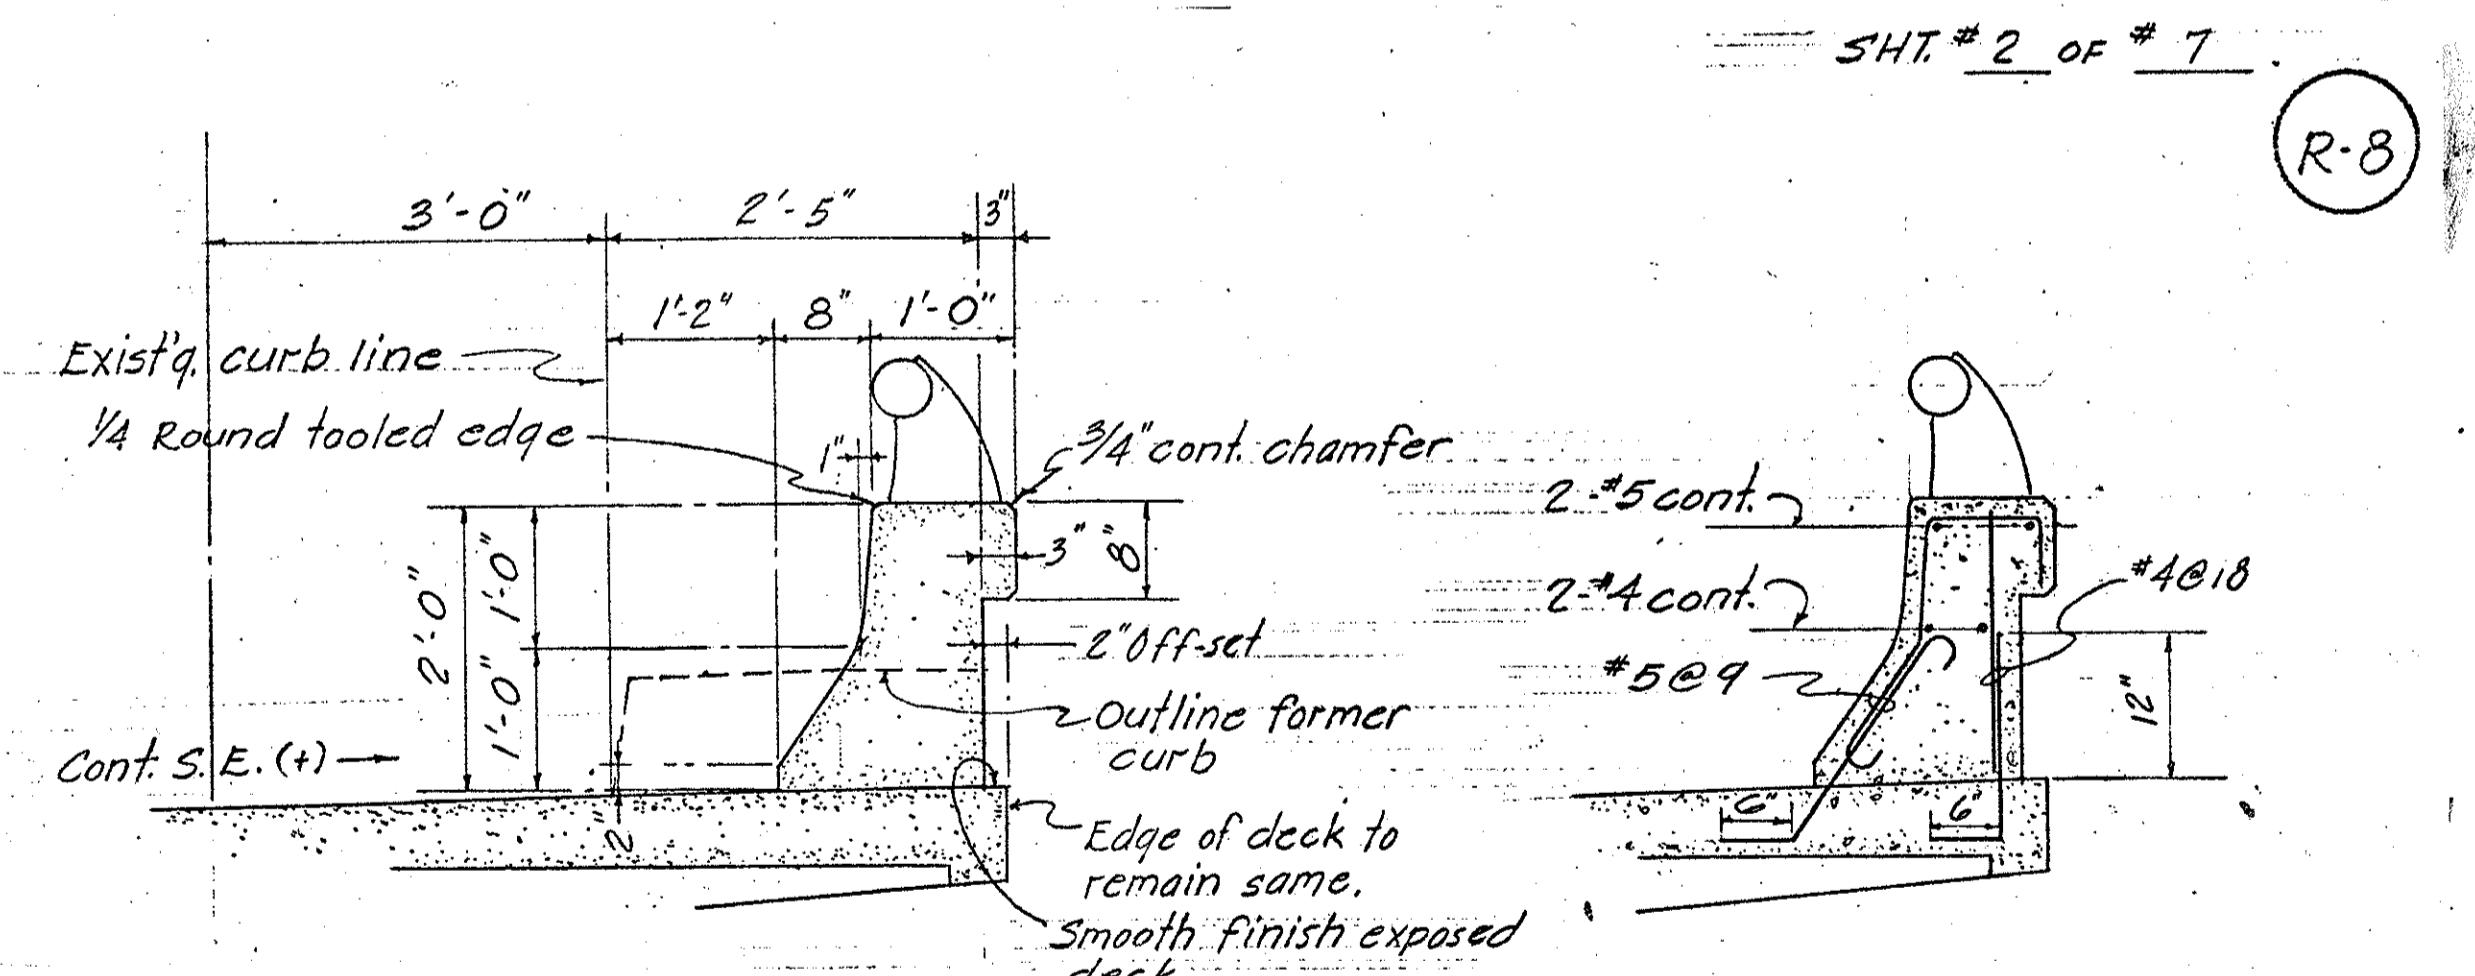

NORMAL SECTION AT MEDIAN END OF STRUCTURE

Scale: $\frac{3}{4}$ " = 0"

STRUCTURE N° 21
INTERSTATE HIGHWAY (LUNALILO FREEWAY)
F.A.I. PROJ. I-HI-1(6) UNIT 3 DATE: Nov, 1967

STATE OF HAWAII
DEPARTMENT OF TRANSPORTATION
HIGHWAYS DIVISION

CHANGE ORDER

DETAILS R-6, R-6A, R-7 & R-8


F.A.I. PROJ. NO. I-HI-1(6) UNIT 3

SHEET NO. 2 OF 6 SHEETS

C.O. 232S-2

FED. ROAD DIST. NO.	STATE	FED. AID PROJ. NO.	FISCAL YEAR	SHEET NO.	TOTAL SHEETS
HAWAII	HAW.	I-H1-1(6), UNIT 3	1985	C.O. 232S-3	235

Light std. 2

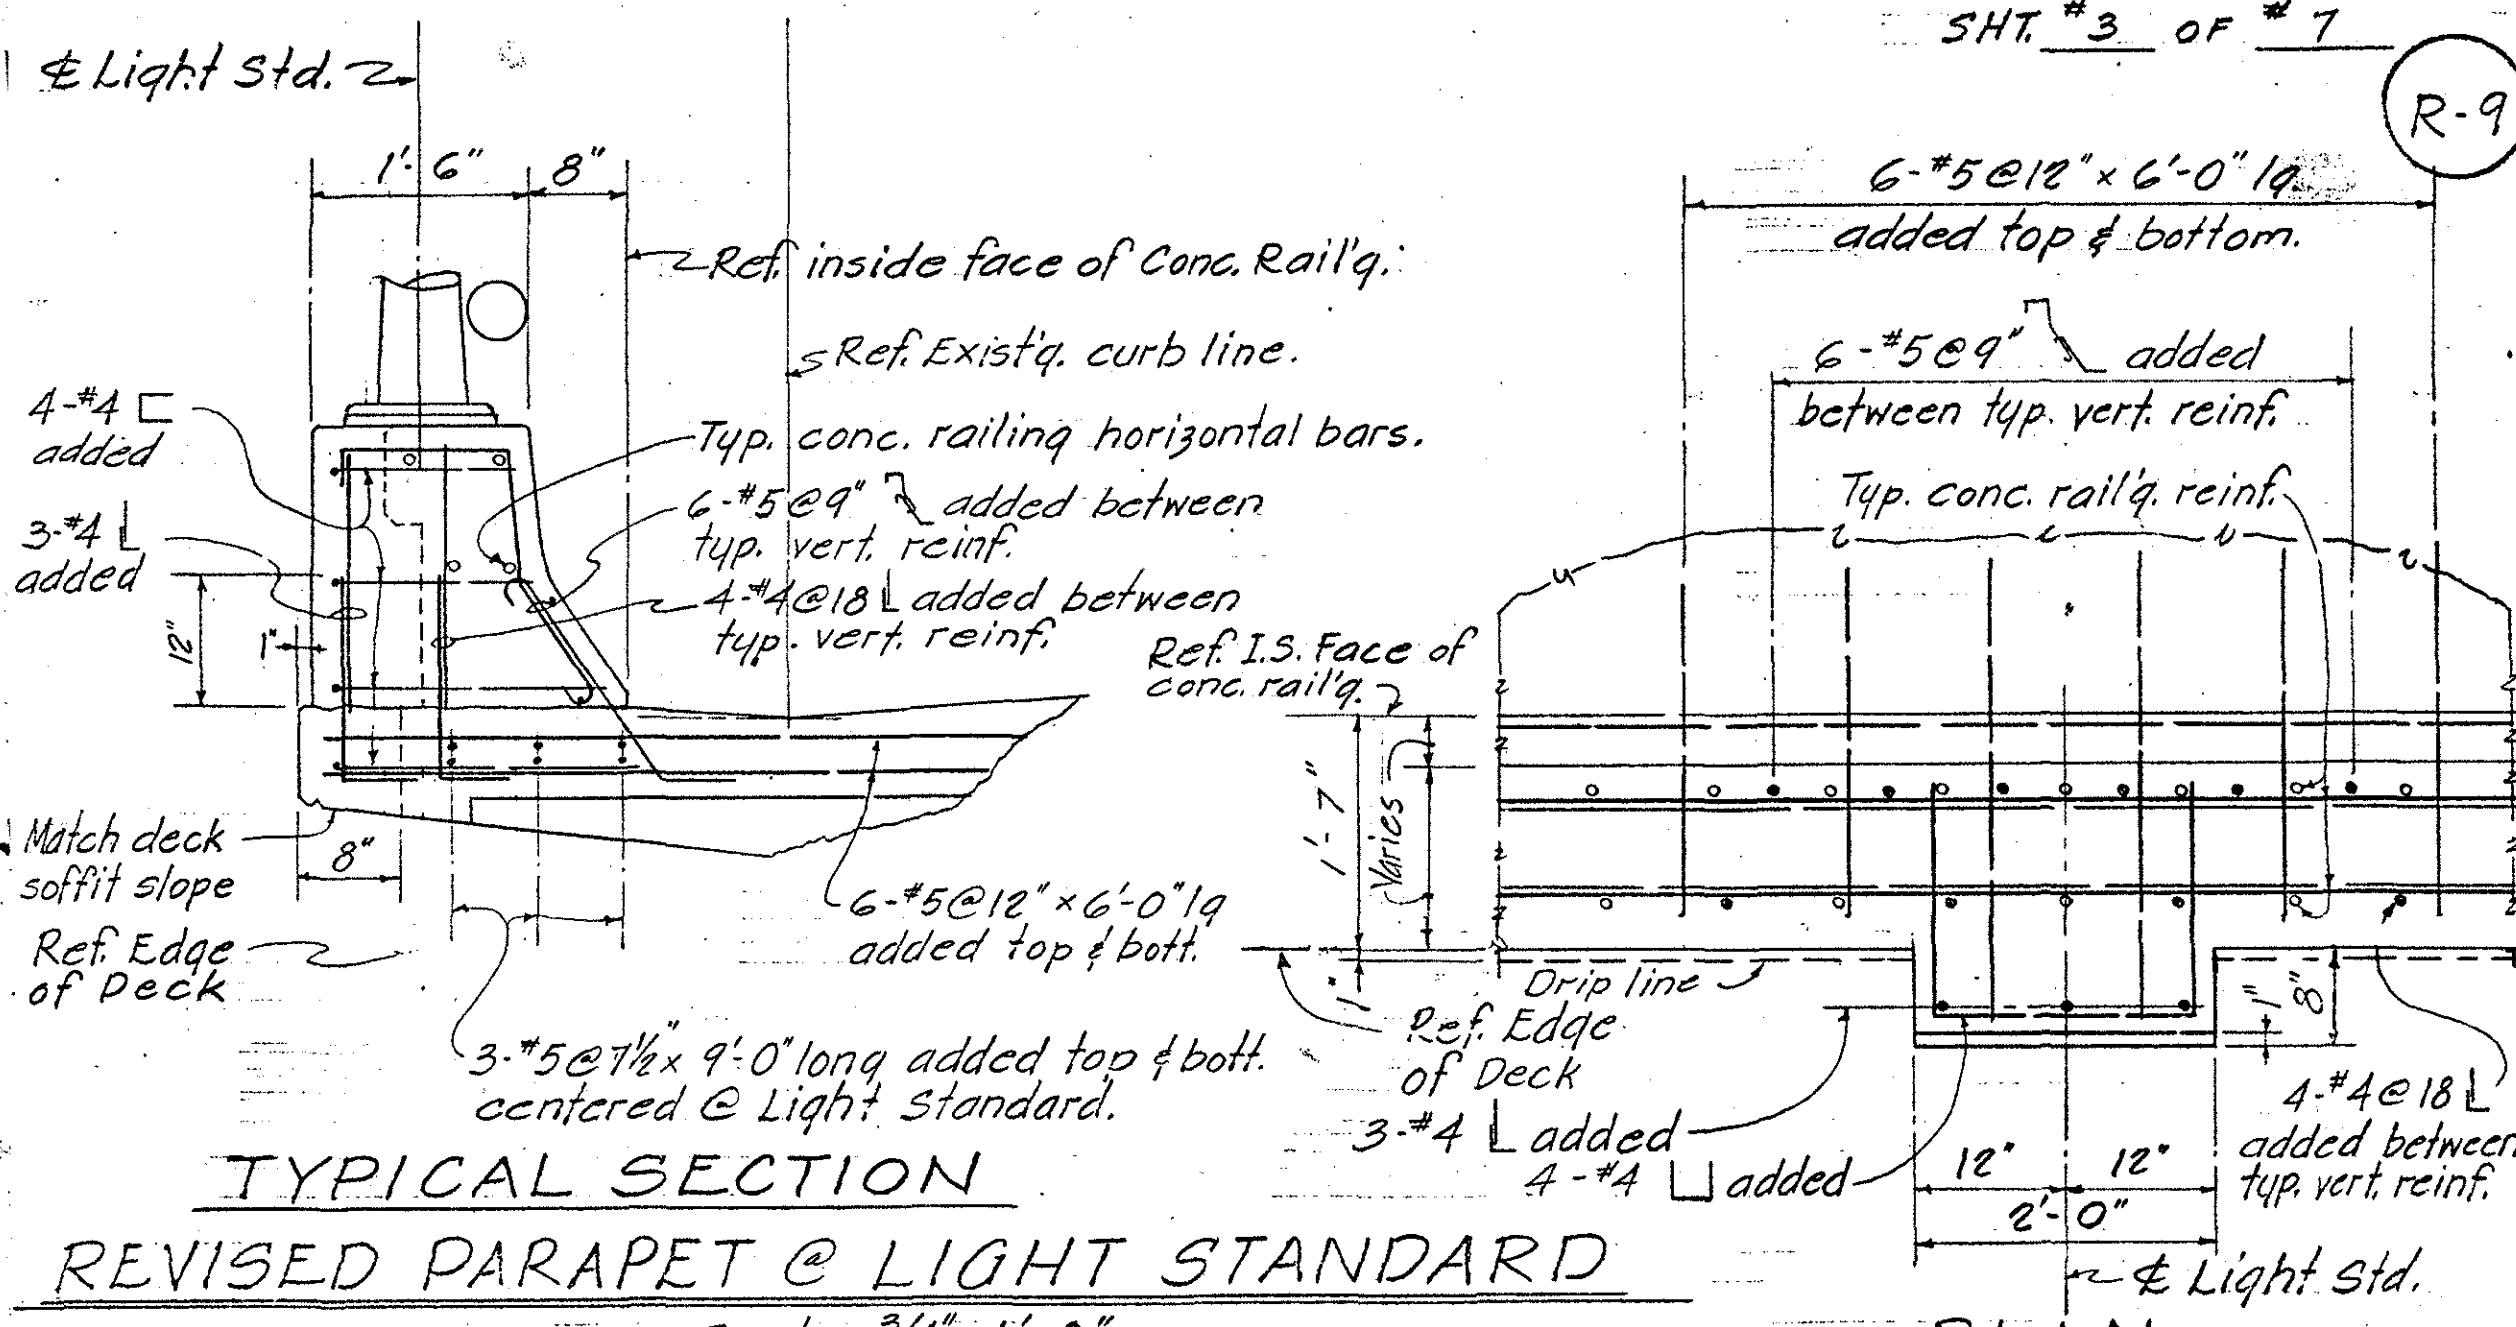

REVISED PARAPET @ LIGHT STANDARD

Scale: 3/4"


STRUCTURE N° 21

INTERSTATE HIGHWAY (LUNALILO FREEWAY)

F.A.I. PROJ. I-HI-1(6) UNIT 3 DATE: NOV., 1967

SHT. *3 OF *7

R-9

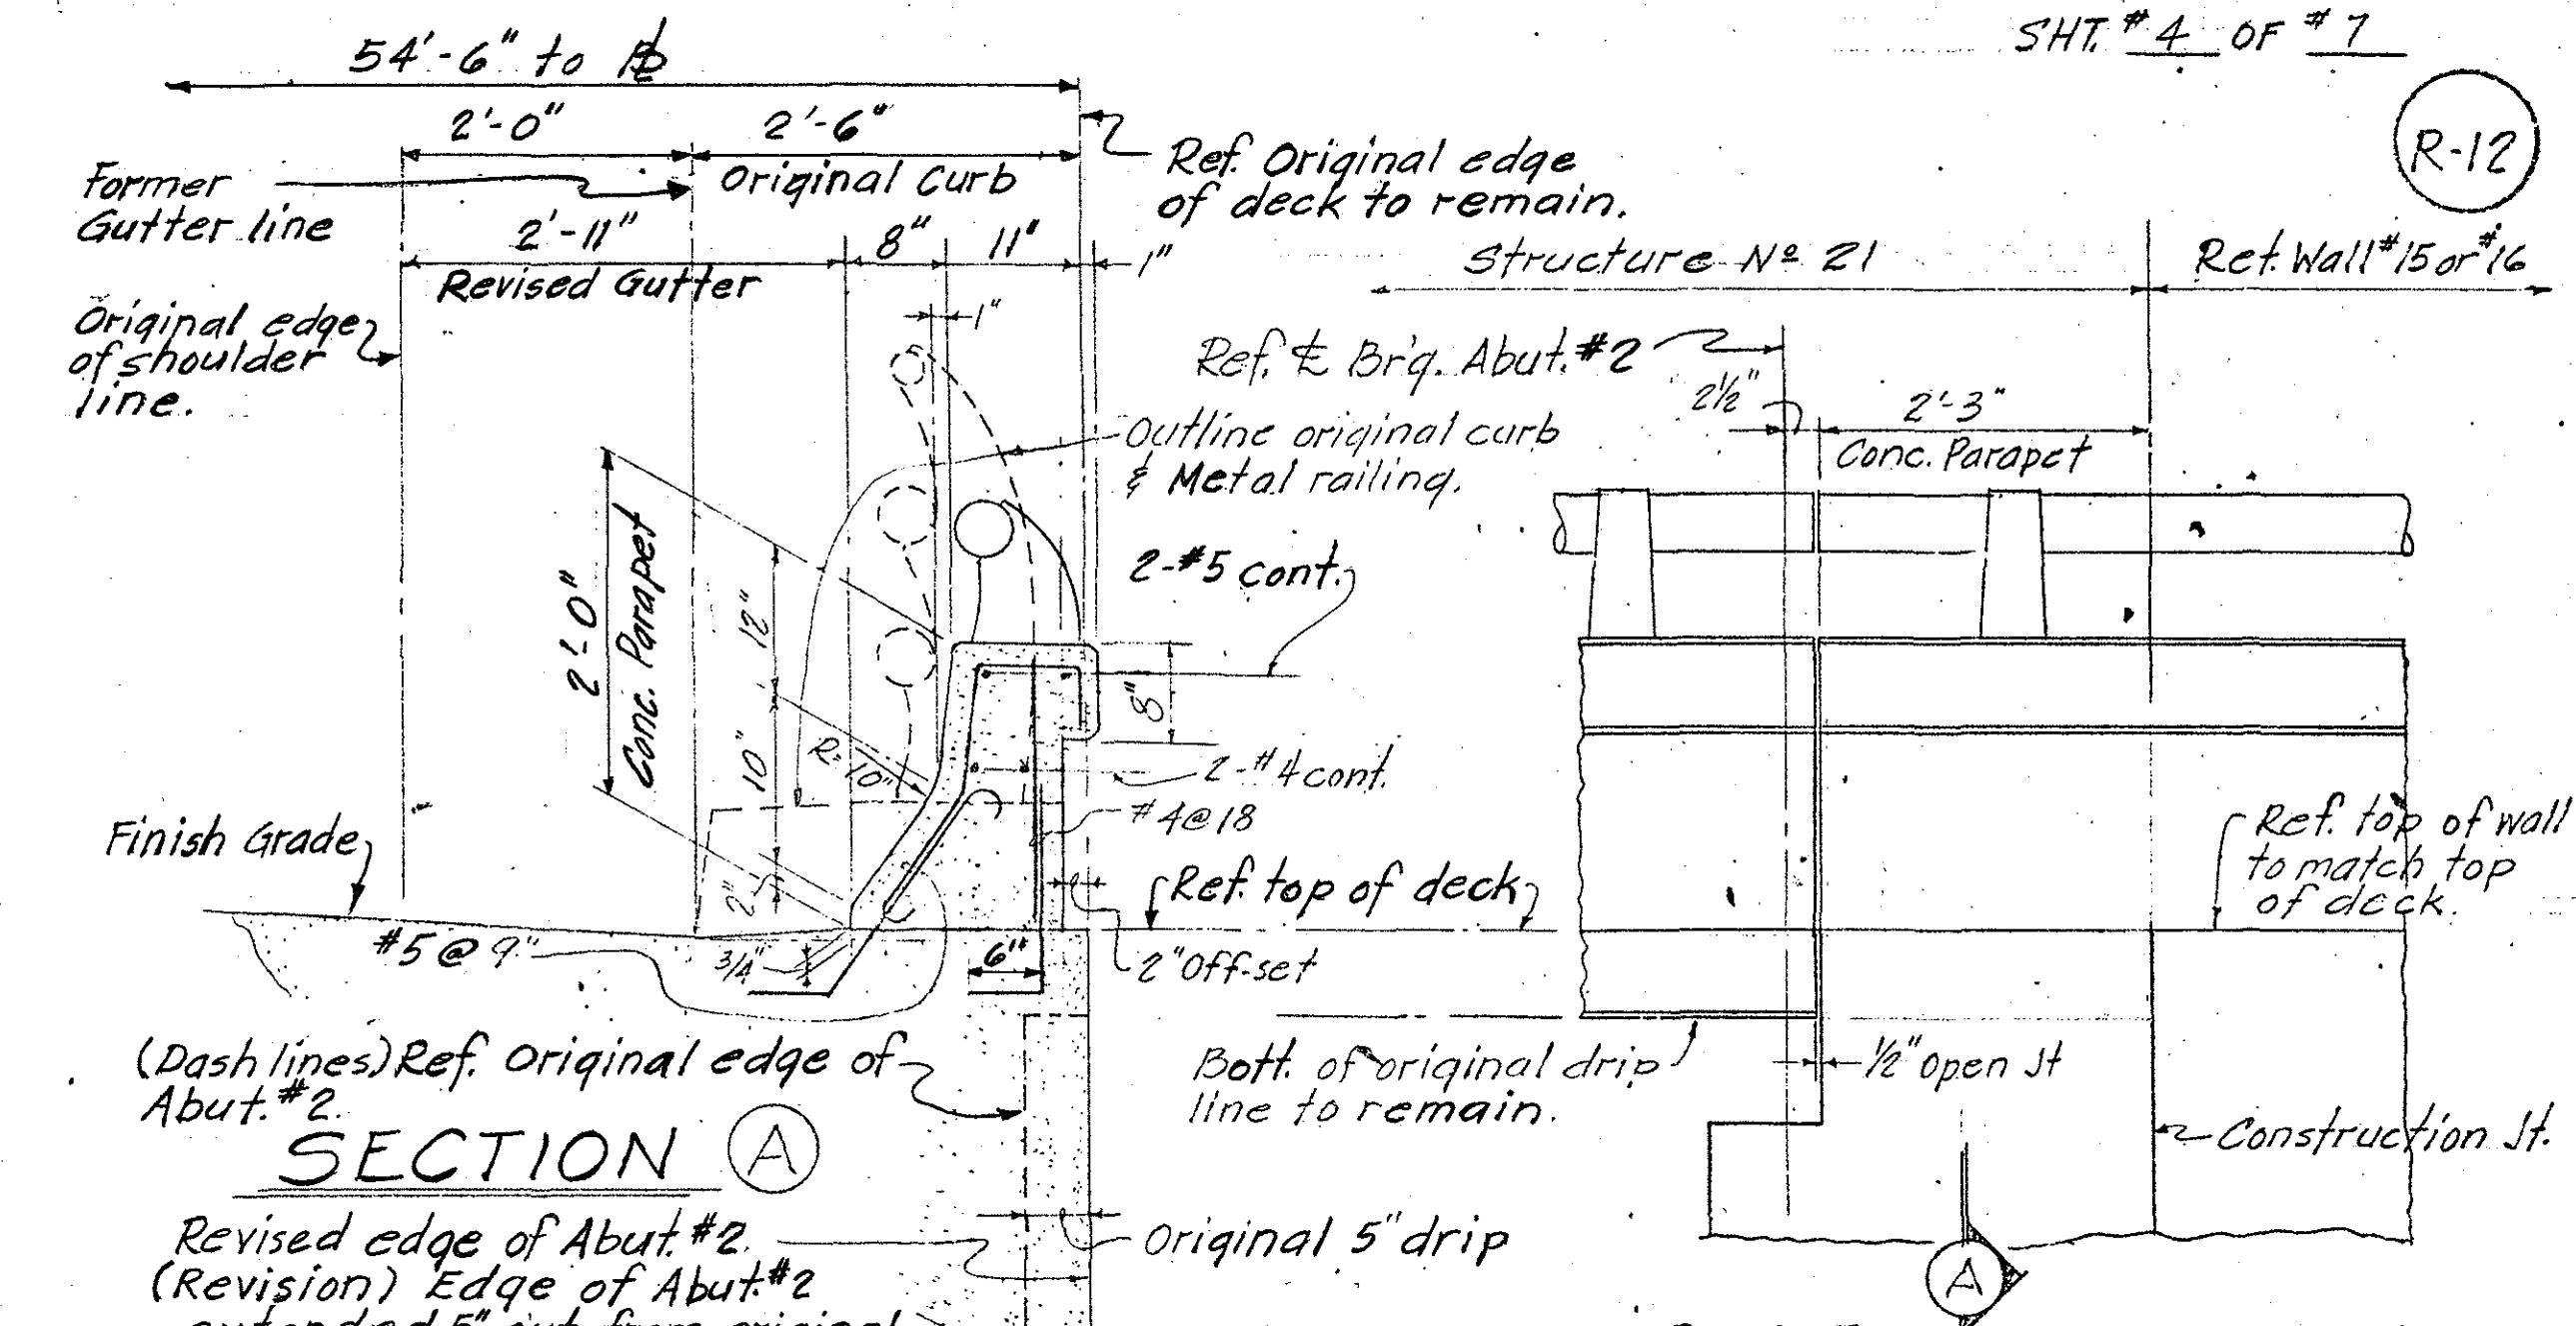

PART ELEVATION

PLAN

2'-7" omit original curb & rail.

10'-0" 10'-0"

2" cont. ledge S & Girder C (33)

1'-8" parapet D (33)

1'-5" New Conc.

Drain S S S S 8" B

Concrete Girder below

#5@12" o.c. top layer
#5@6" o.c. bott. layer

P7 Symm. about B

2 Exended Slab reinf. Top & Bott. layer

2 Ref. Original edge of deck.

2" Cont. ledge at plant Box.

Extend slab reinf.

SECTION C (33) R-11

2-#6 Top
#4@12
#4@9
Waterproofing see Specs.

Slope

SECTION D (33)

Waterproofing - see Specs.

Ext. slab reinf. Top & Bott. layer

40 bar dia. lap. (typ.)

1" plastic tube drain

#5@12 Toplayer

1/3" lap

1/3" lap

40 bar dia. lap

SECTION E (33)

Cont. horizontal reinf.

Waterproofing see Specs.

1/3" lap

1/3" lap

40 bar dia. lap

1" plastic tube drain

#5@6 Bott. layer

Conc. Girder

Scale: $\frac{3}{4}'' = 1'-0''$

S & Girder - Symm. about.

Revised top of plant box to match top of new rail post. omit original curb & railing.

2'-7" omit, original curb & rail.


1'-7" 8"

Outline original plant box. f Level

1'-6" 8"

1'-6" 8"

1'-6" 8"

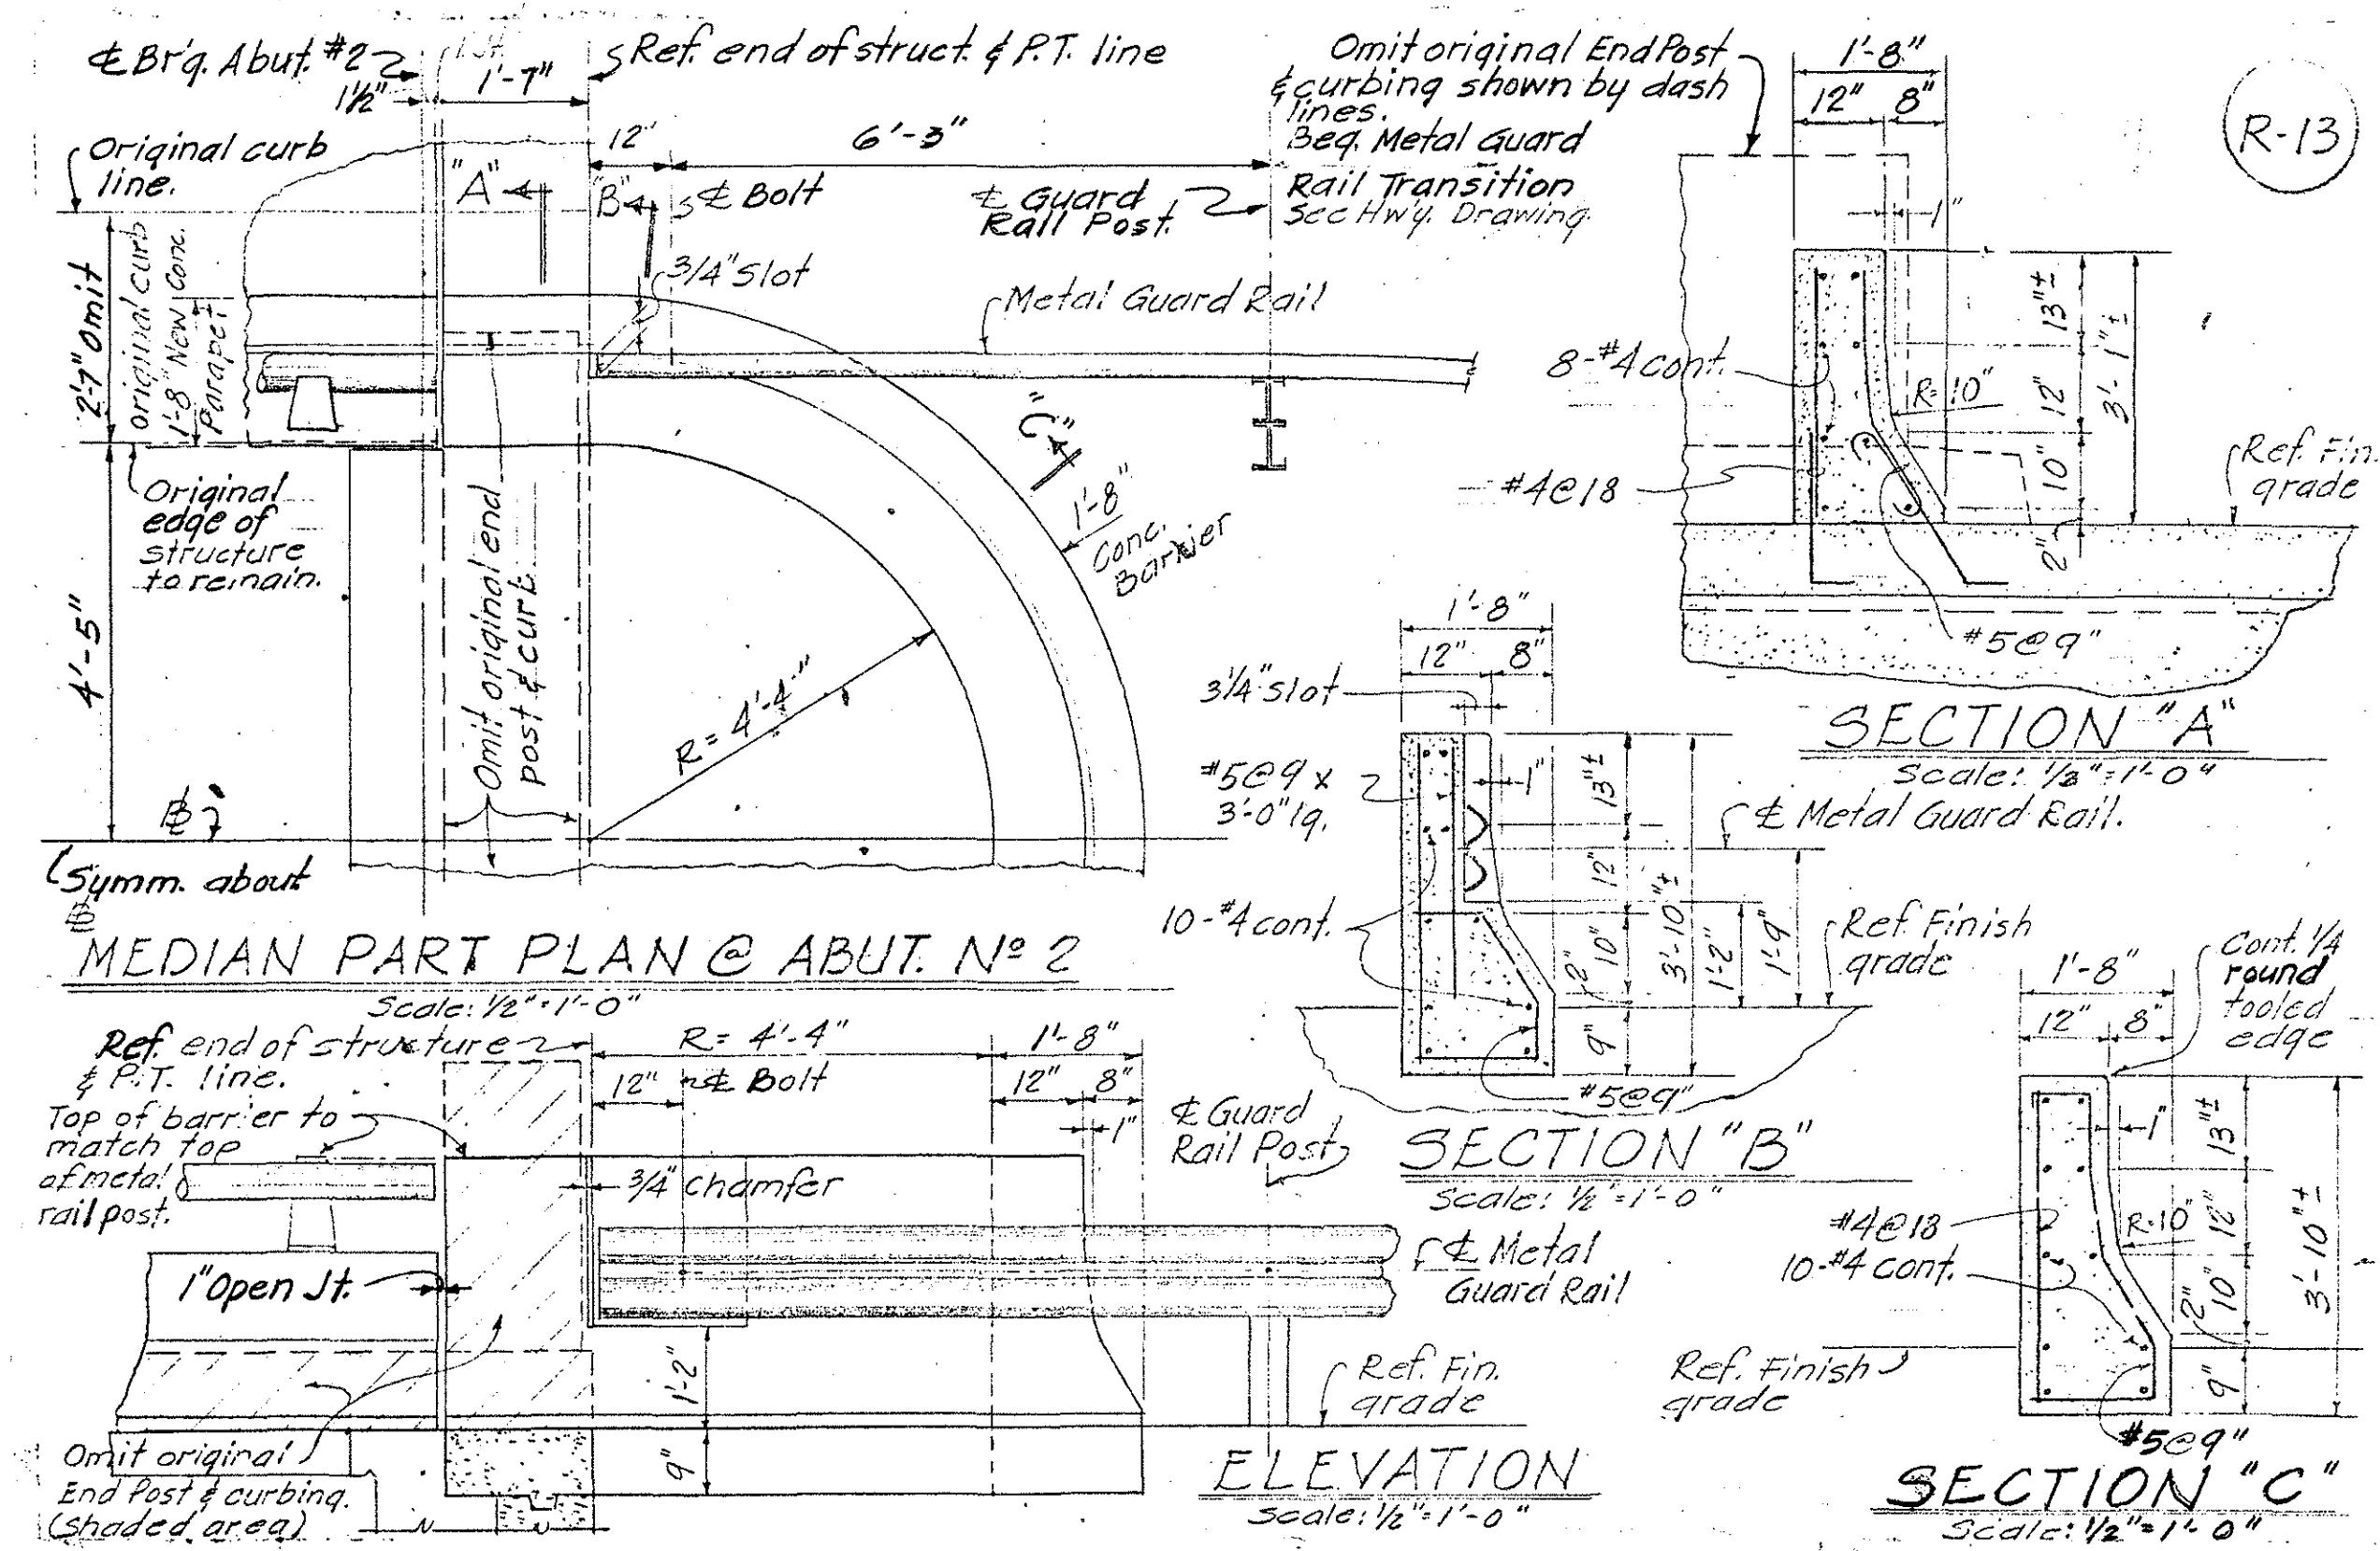

**STATE OF HAWAII
DEPARTMENT OF TRANSPORTATION
HIGHWAYS DIVISION**


CHANGE ORDER

DETAILS R-9, R-11, R-12 & R-13

F.A.I. PROJ. NO. I-H1-1(6) UNIT 3

SHEET No. 3 OF 6 SHEETS


FED. ROAD DIST. NO.	STATE	FED. AID PROJ. NO.	FISCAL YEAR	SHEET NO.	TOTAL SHEETS
HAWAII	HAW.	I-H1-1(6), Unit 3	1985	C.O. 232 S-4	235

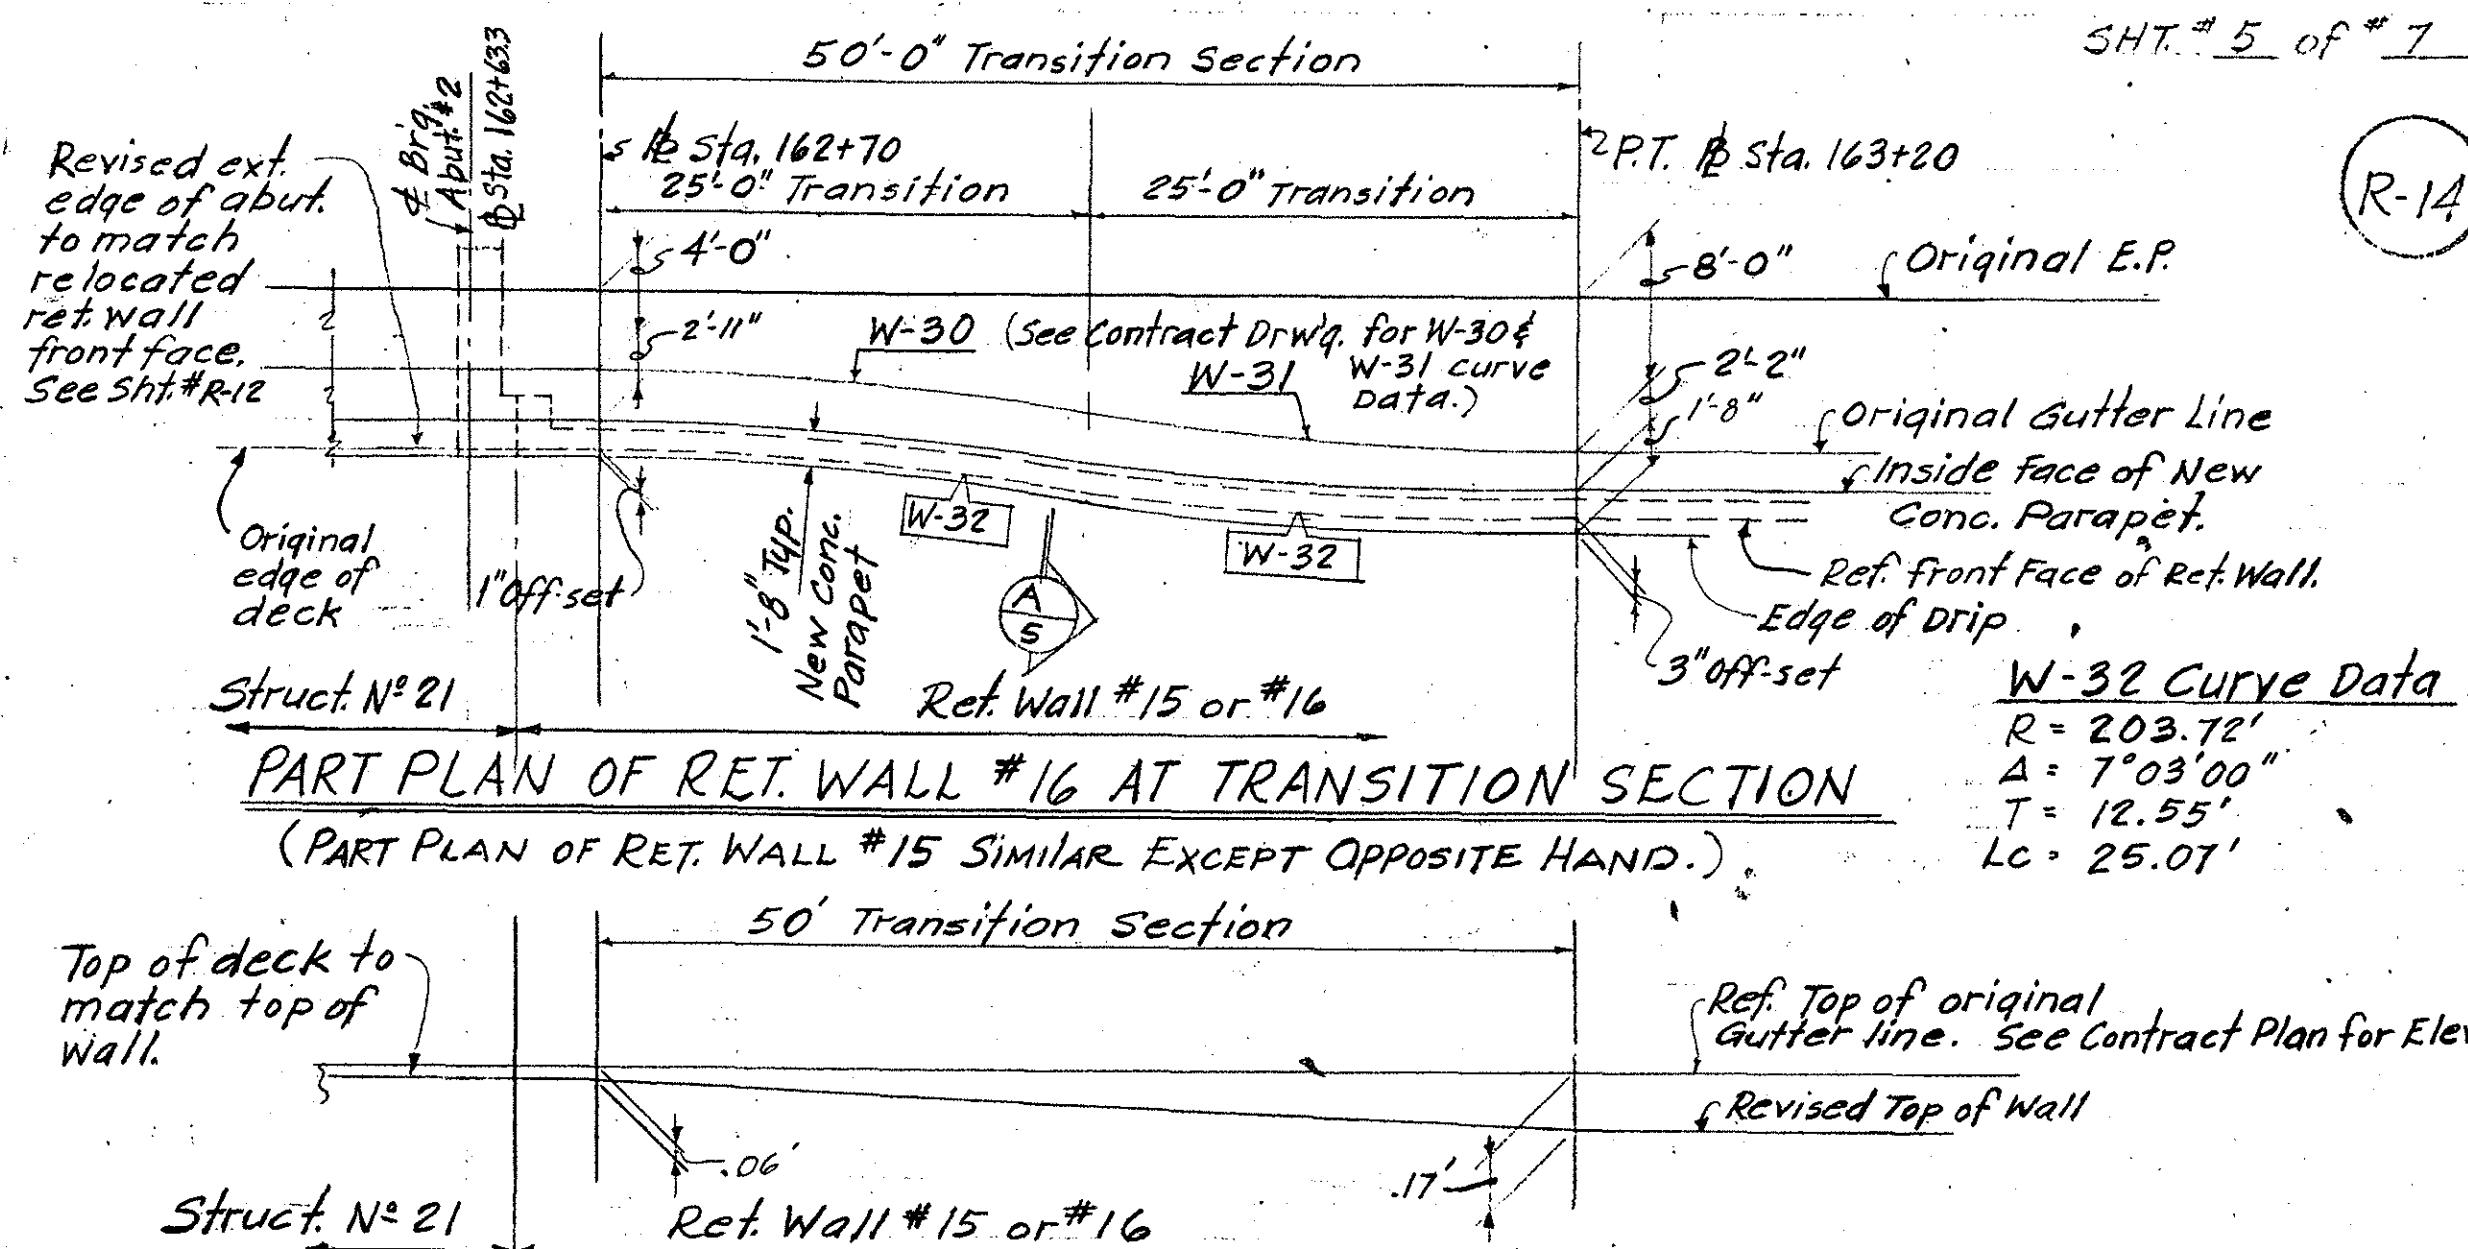

REVISED TOP OF WALL-PROFILE ALONG FRONT FACE OF WALL


RET. WALLS N°15 & 16 AT TRANSITION SECTION

INTERSTATE Hwy (LONALINO FREEWAY) F.A.I. PROJ. N° I-HI-176 UNIT 3 DATE: Nov., 1967 SCALE: No scale

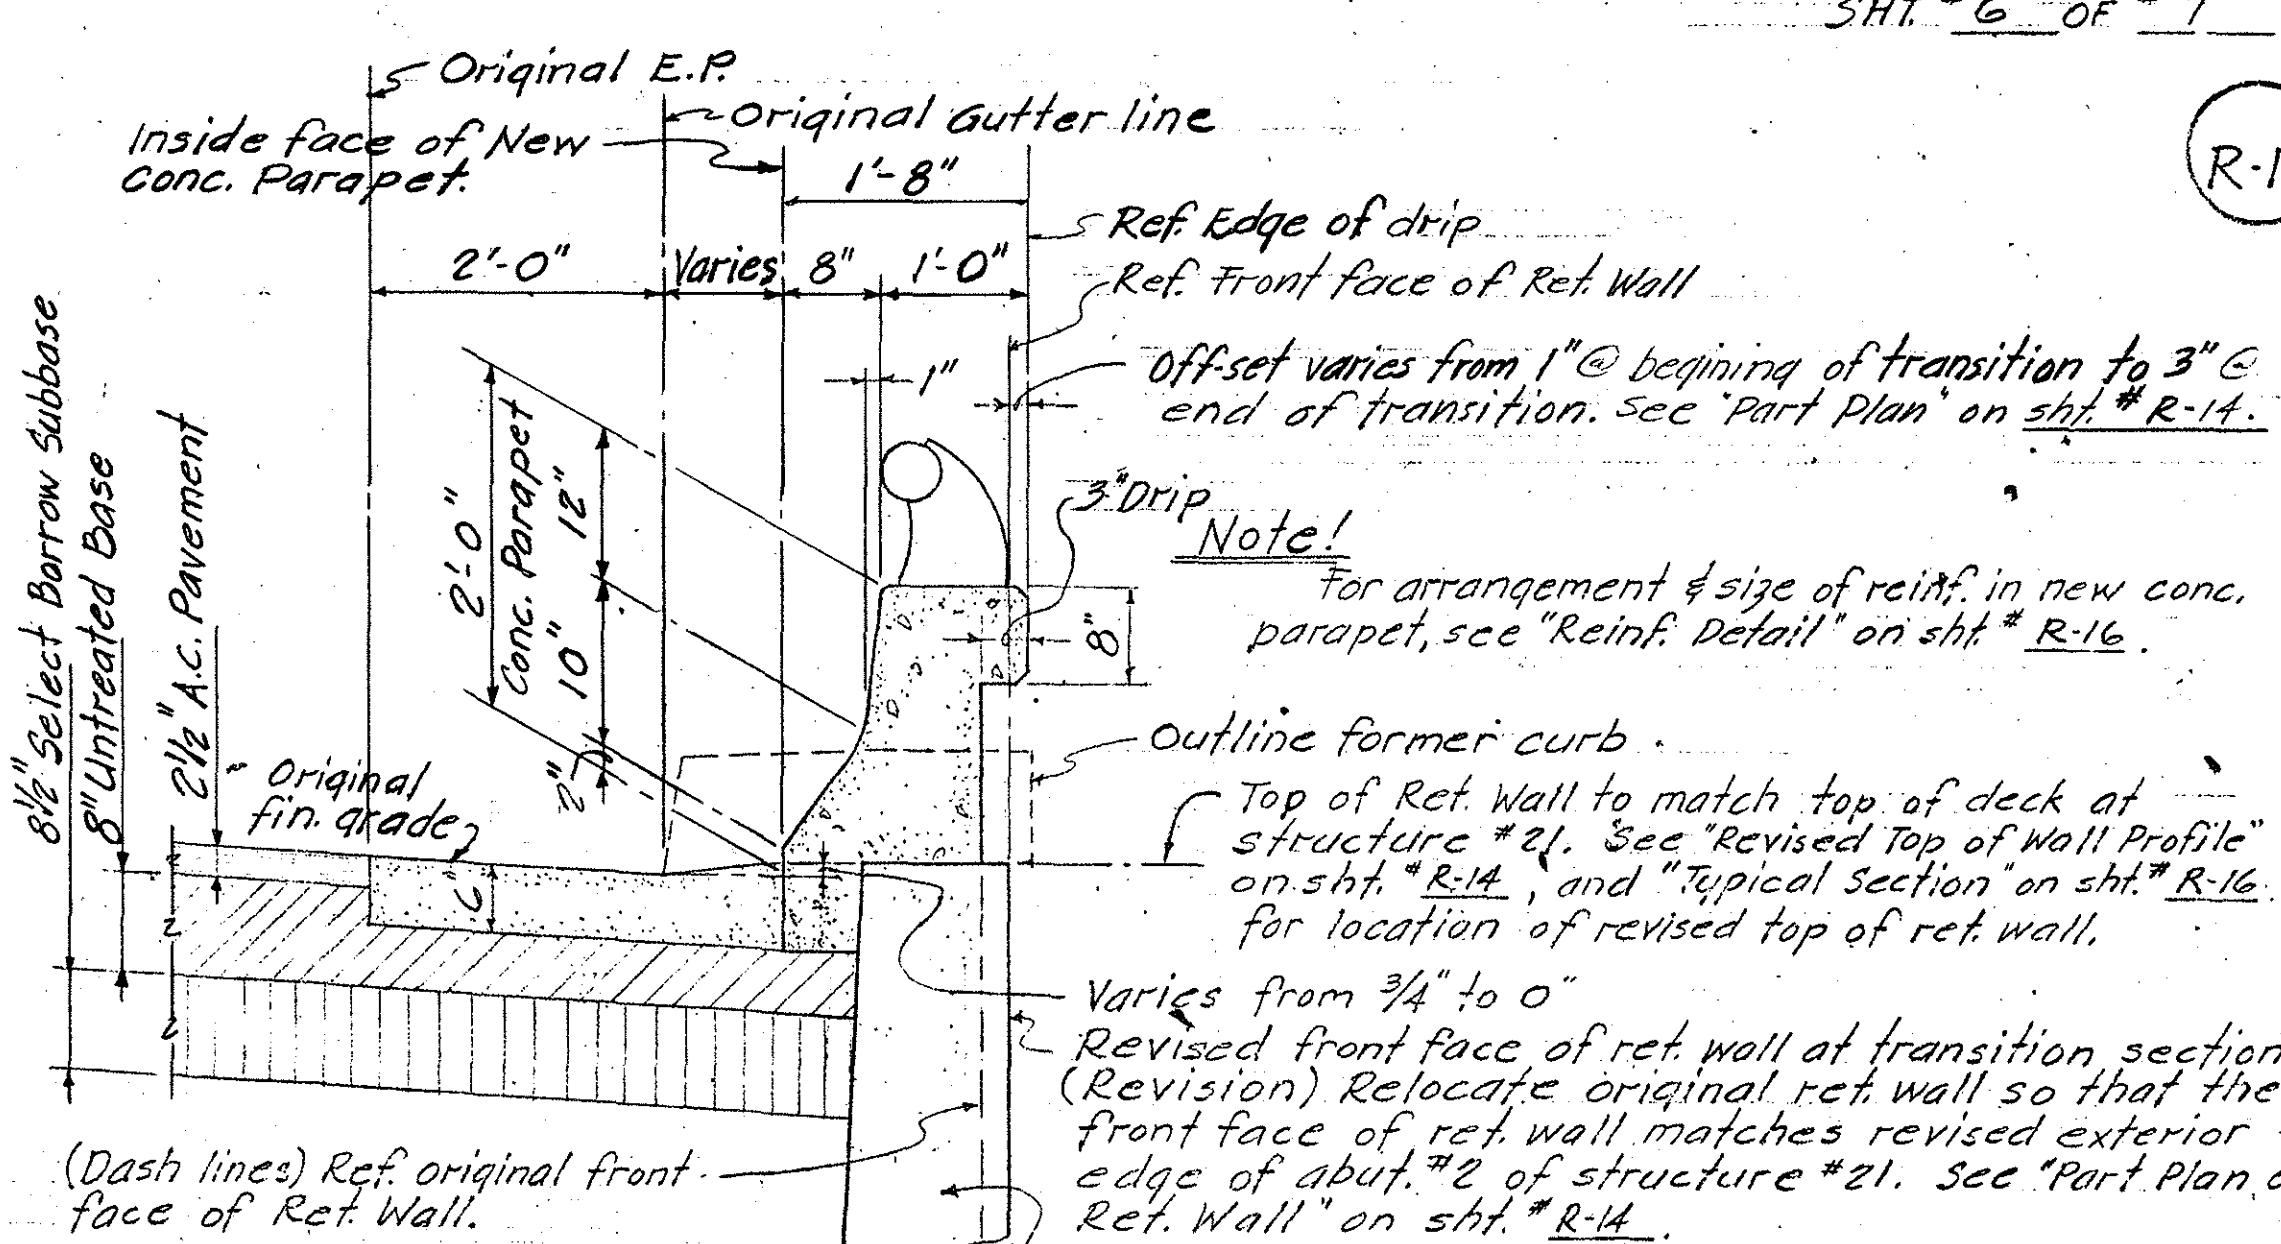


SECTION A-5 TYP. SECTION AT TRANSITION SECTION

INTERSTATE HWY. (LUNALILO FREEWAY) DATE: Nov., 1967 F.A.I. PROJ. N° I-HI-1(6) UNIT 3

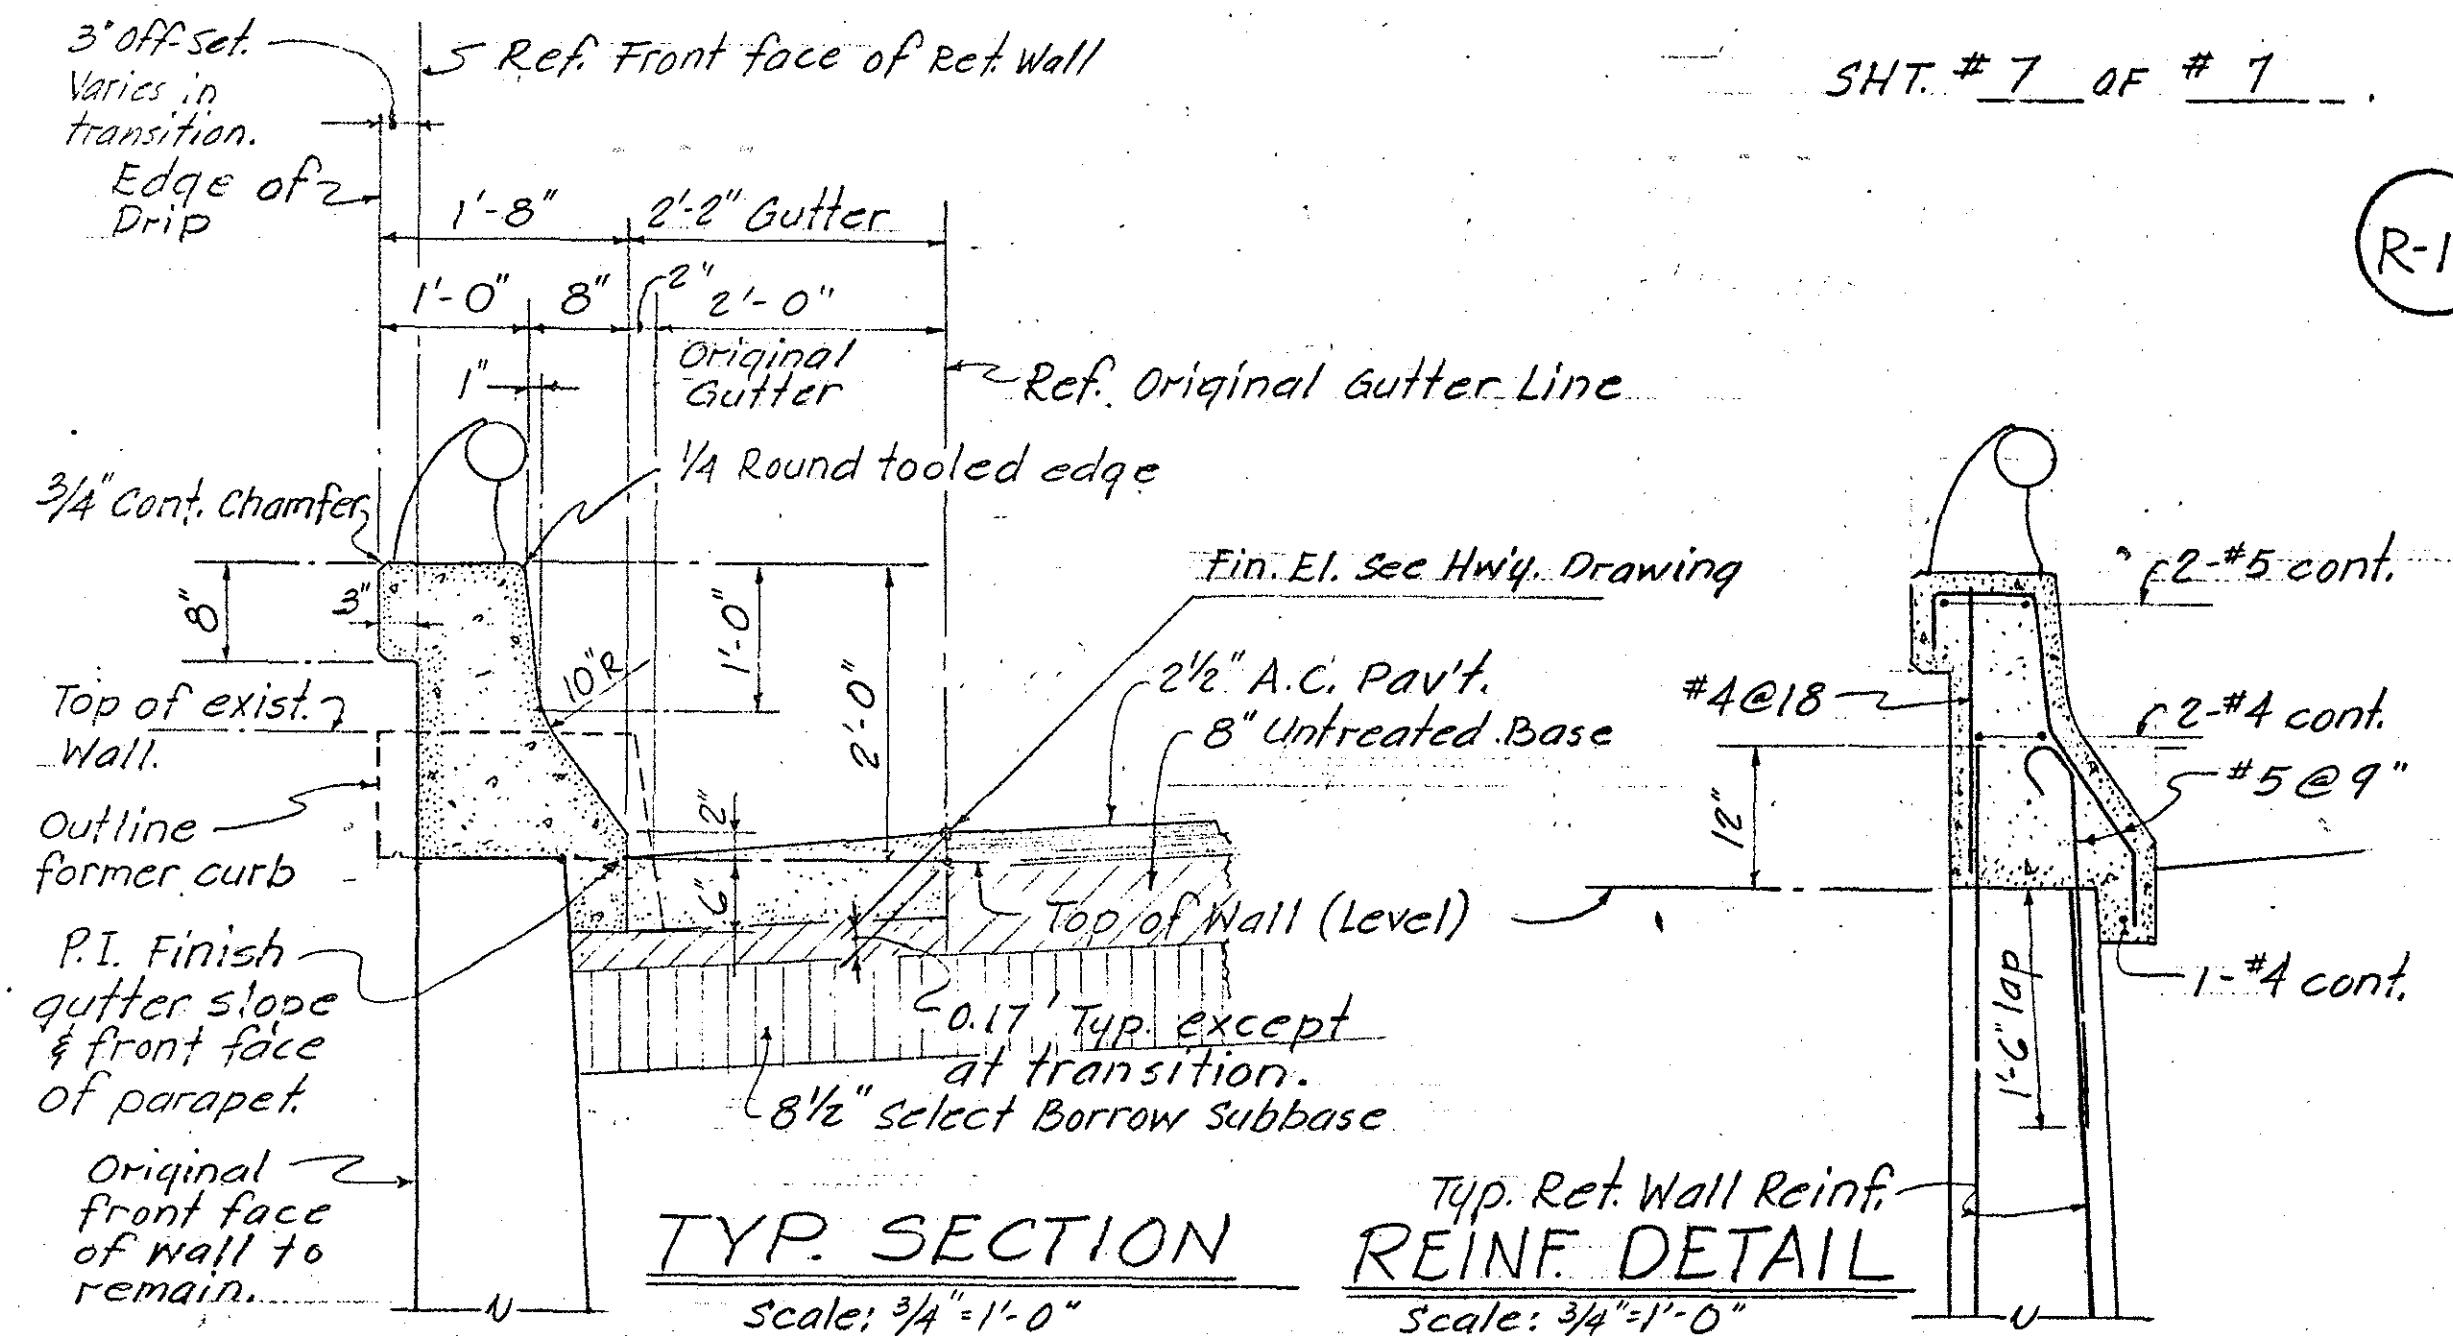

RET. WALL N° 15 & 16 AT NORMAL SECTION

INTERSTATE HWY. (LUNALILO FREEWAY) DATE: NOV., 1967 F.A.I. PROJ. N° I-1H-1(6) UNIT 3

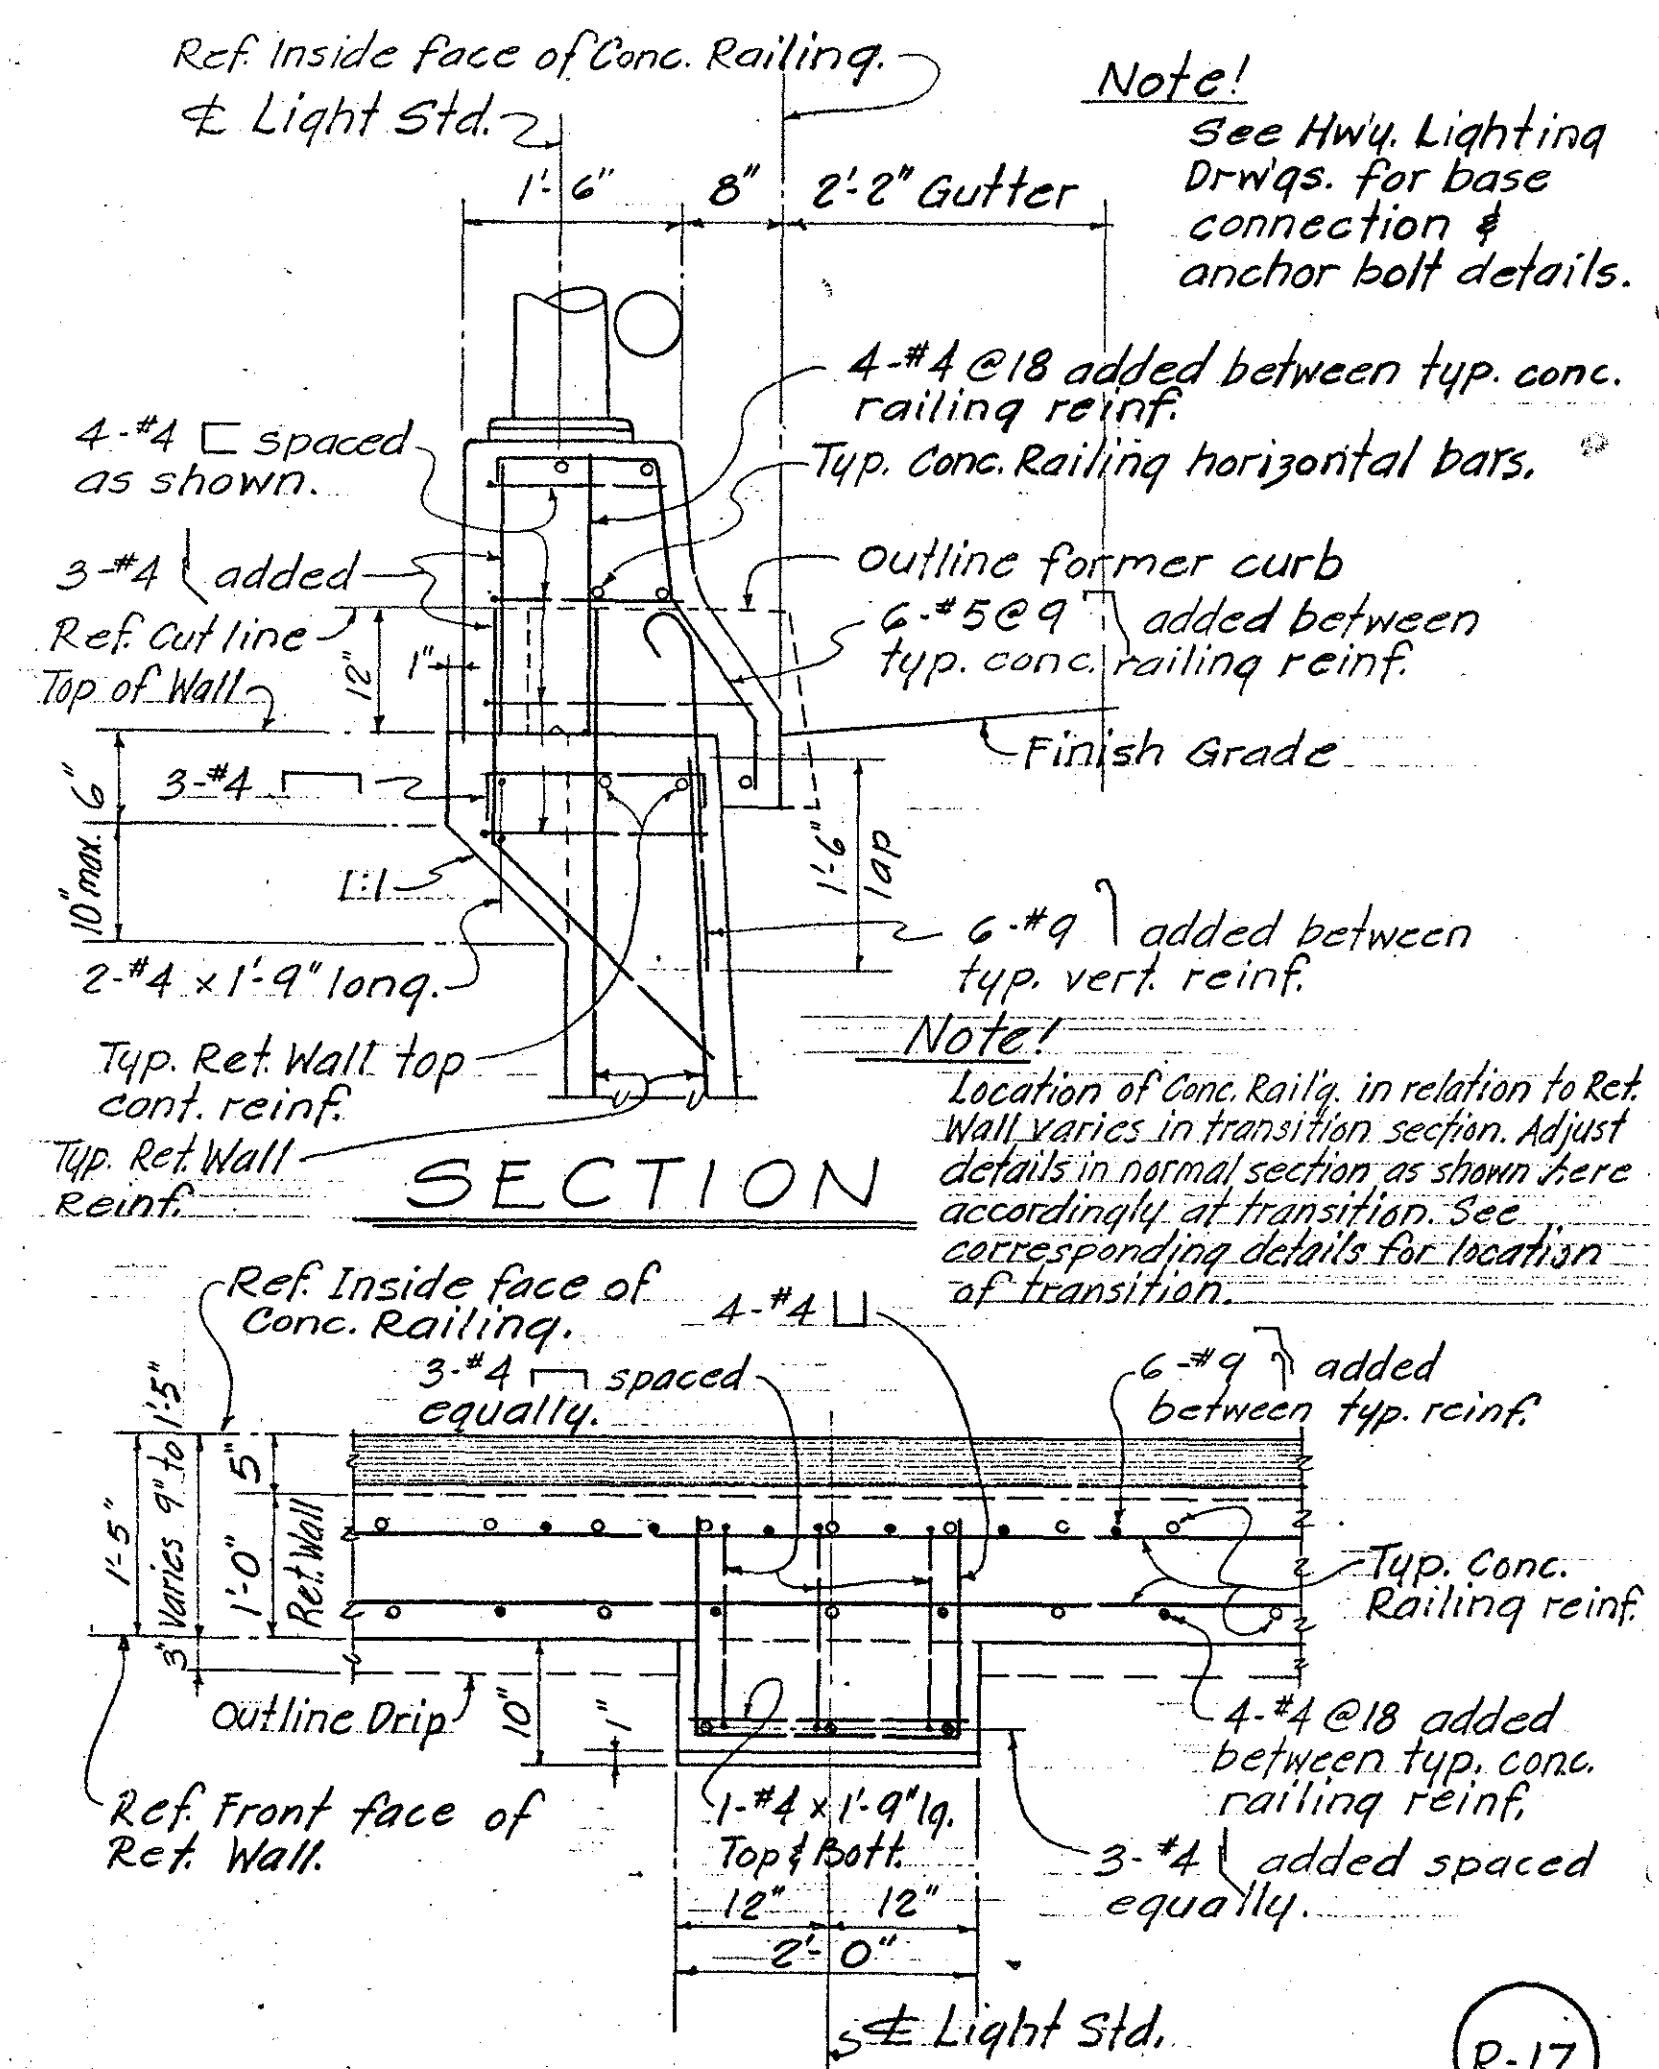

PLAN

REVISED PARAPET @ LIGHT STAND.

FOR RET. WALL N° 11, 15 & 16
INTERSTATE Hw'y. (LUNALILO FREEWAY) F.A.I. PROJ. # I-HI-1(6) UNIT # 3



**STATE OF HAWAII
DEPARTMENT OF TRANSPORTATION
HIGHWAYS DIVISION**

CHANGE ORDER

DETAILS R-14, R-15, R-16 & R-17


F.A.I. PROJ. NO. I-H1-1(6) UNIT 3

FED. ROAD DIST. NO.	STATE	FED. AID PROJ. NO.	FISCAL YEAR	HEET NO.	TOTAL SHEETS
HAWAII	HAW.	I-HI-1(6) Unit 3	1985	C.O. 232S-5	235

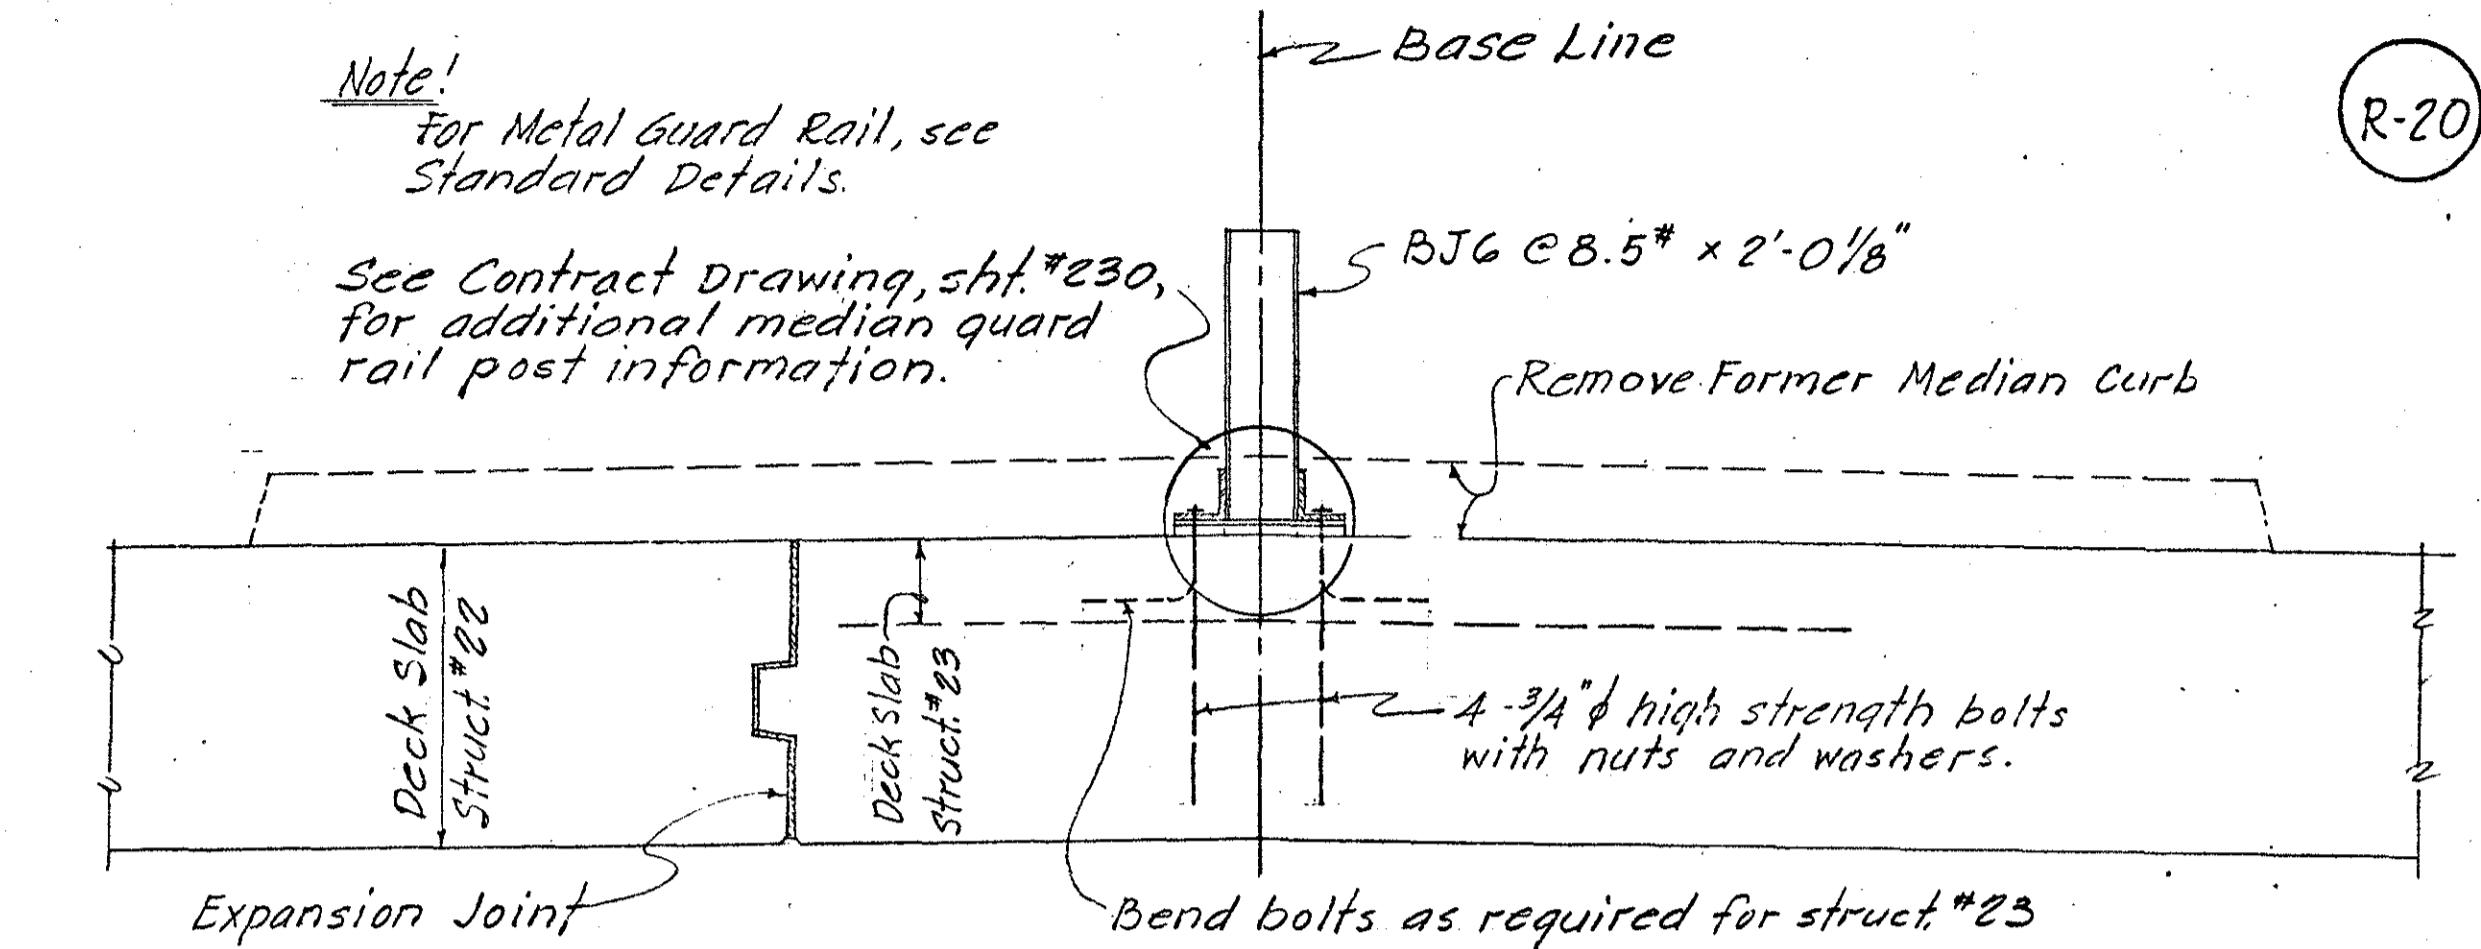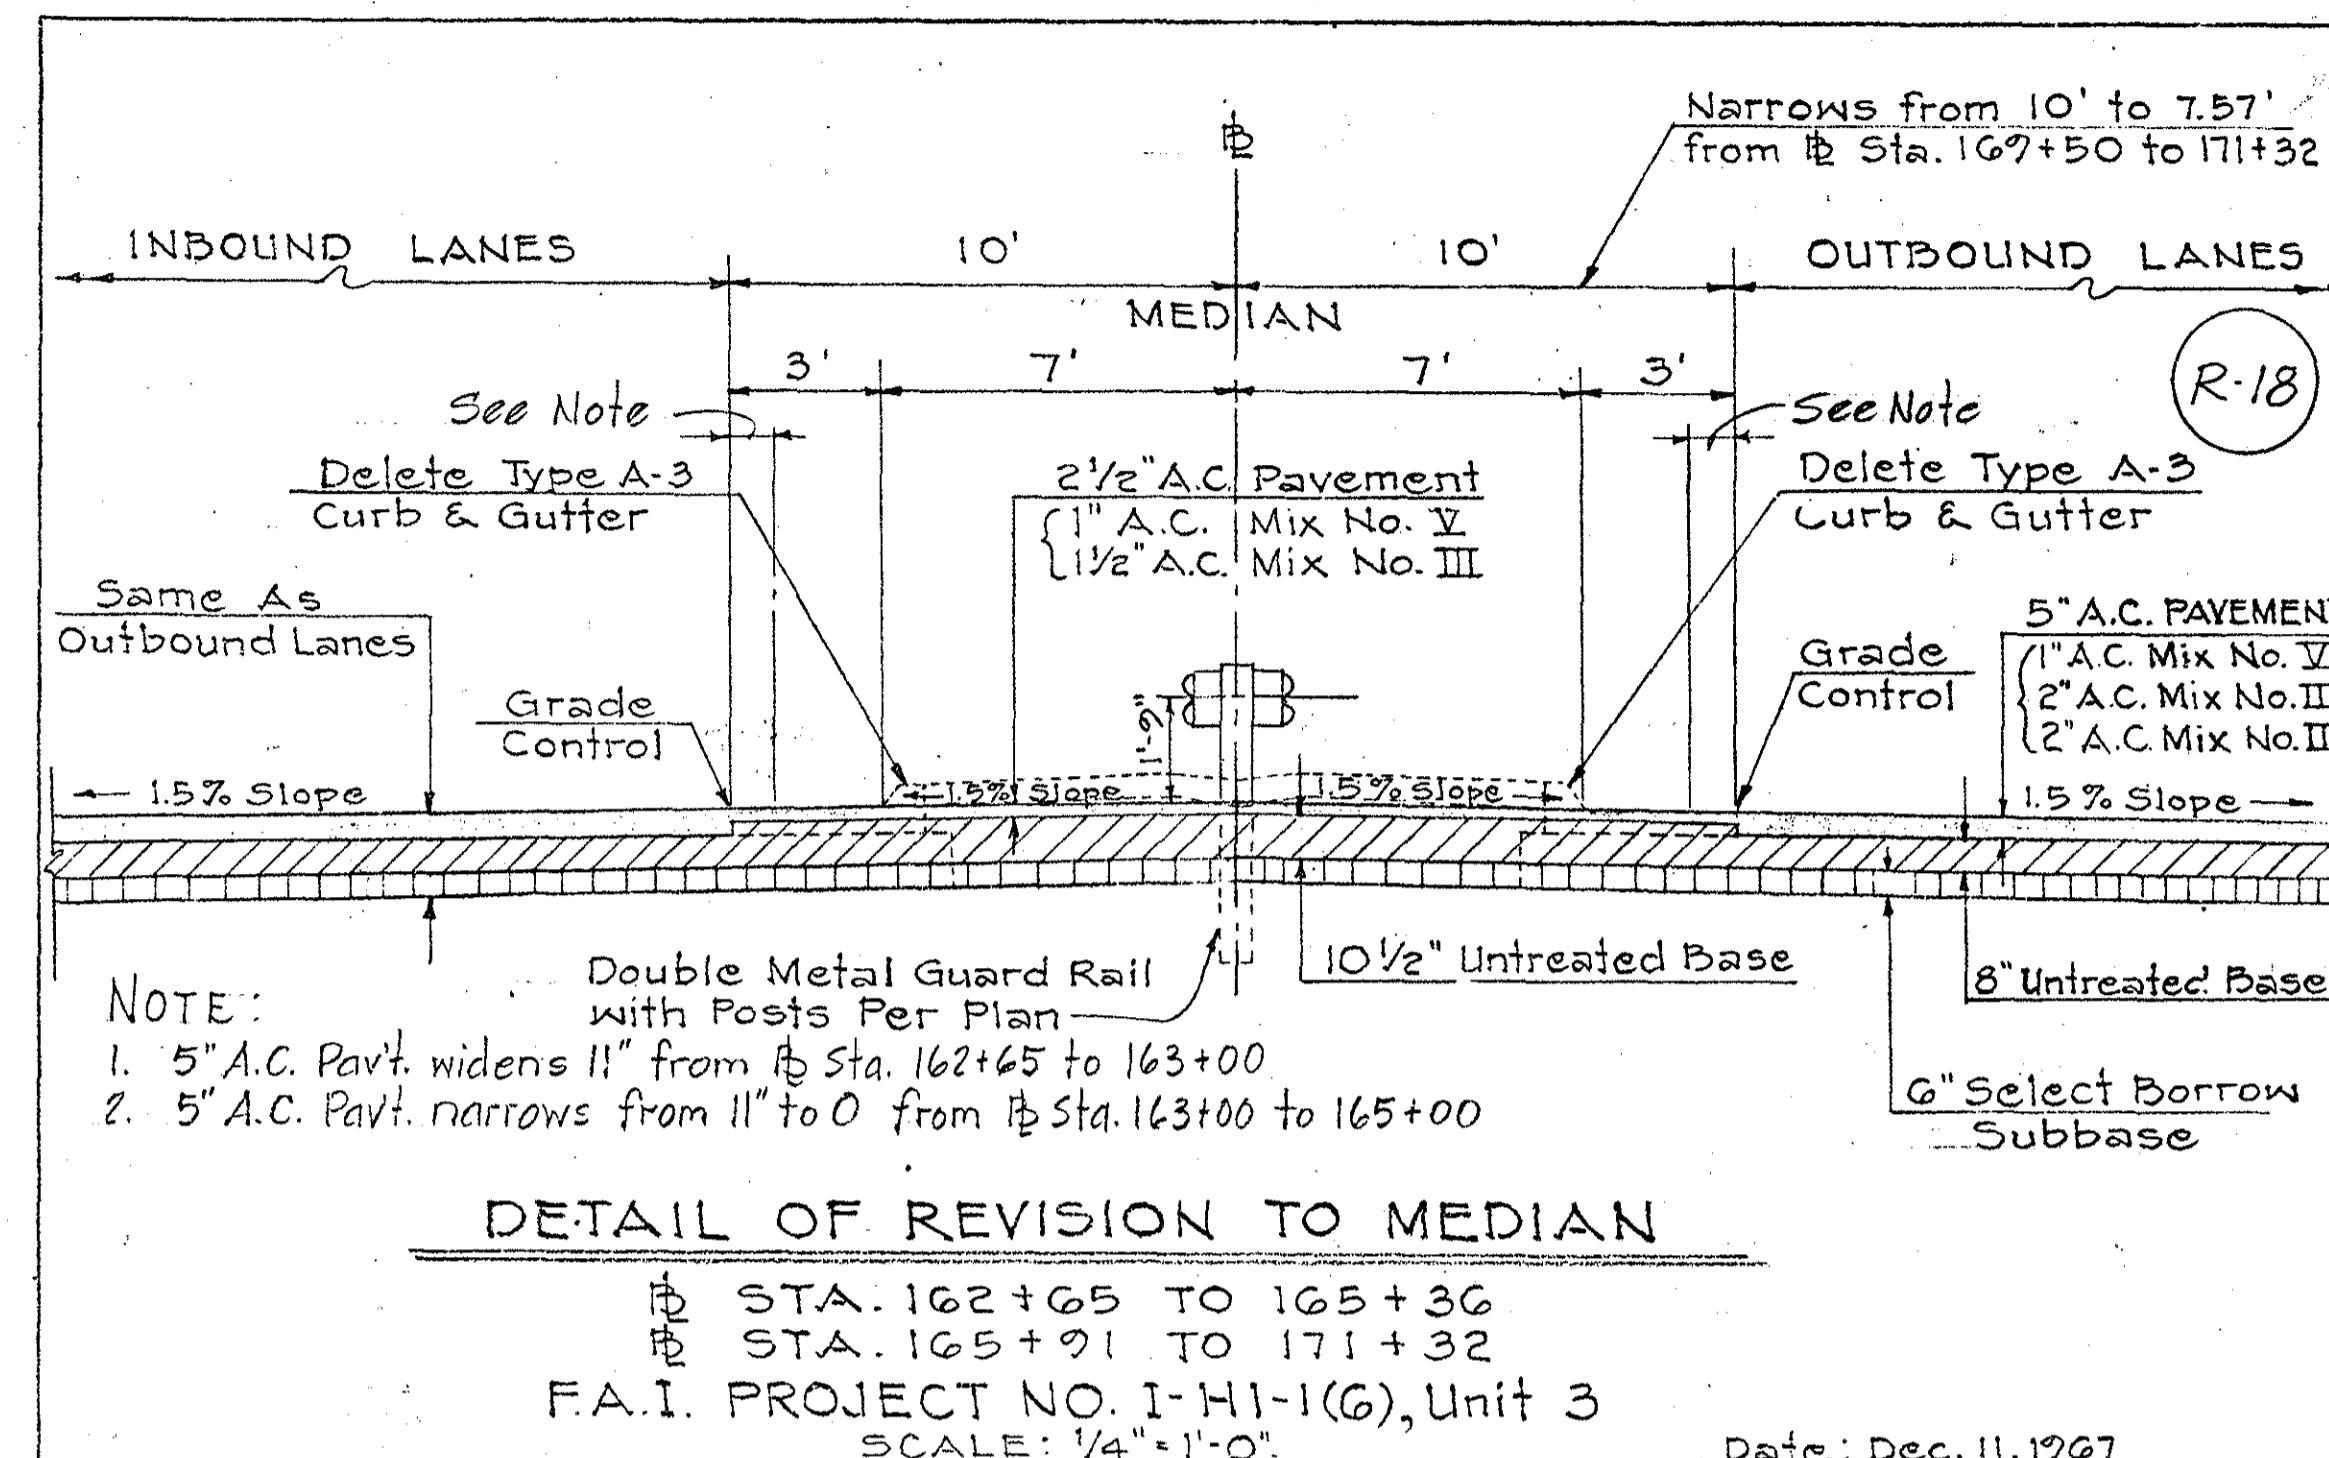

REVISED MEDIAN FOR INTERSTATE STRUCTURE N° 22 & 23


INTERSTATE Hwy. (LUNALILO FREEWAY) F.A.I. PROJ. # I-HI-1(6) UNIT # 3

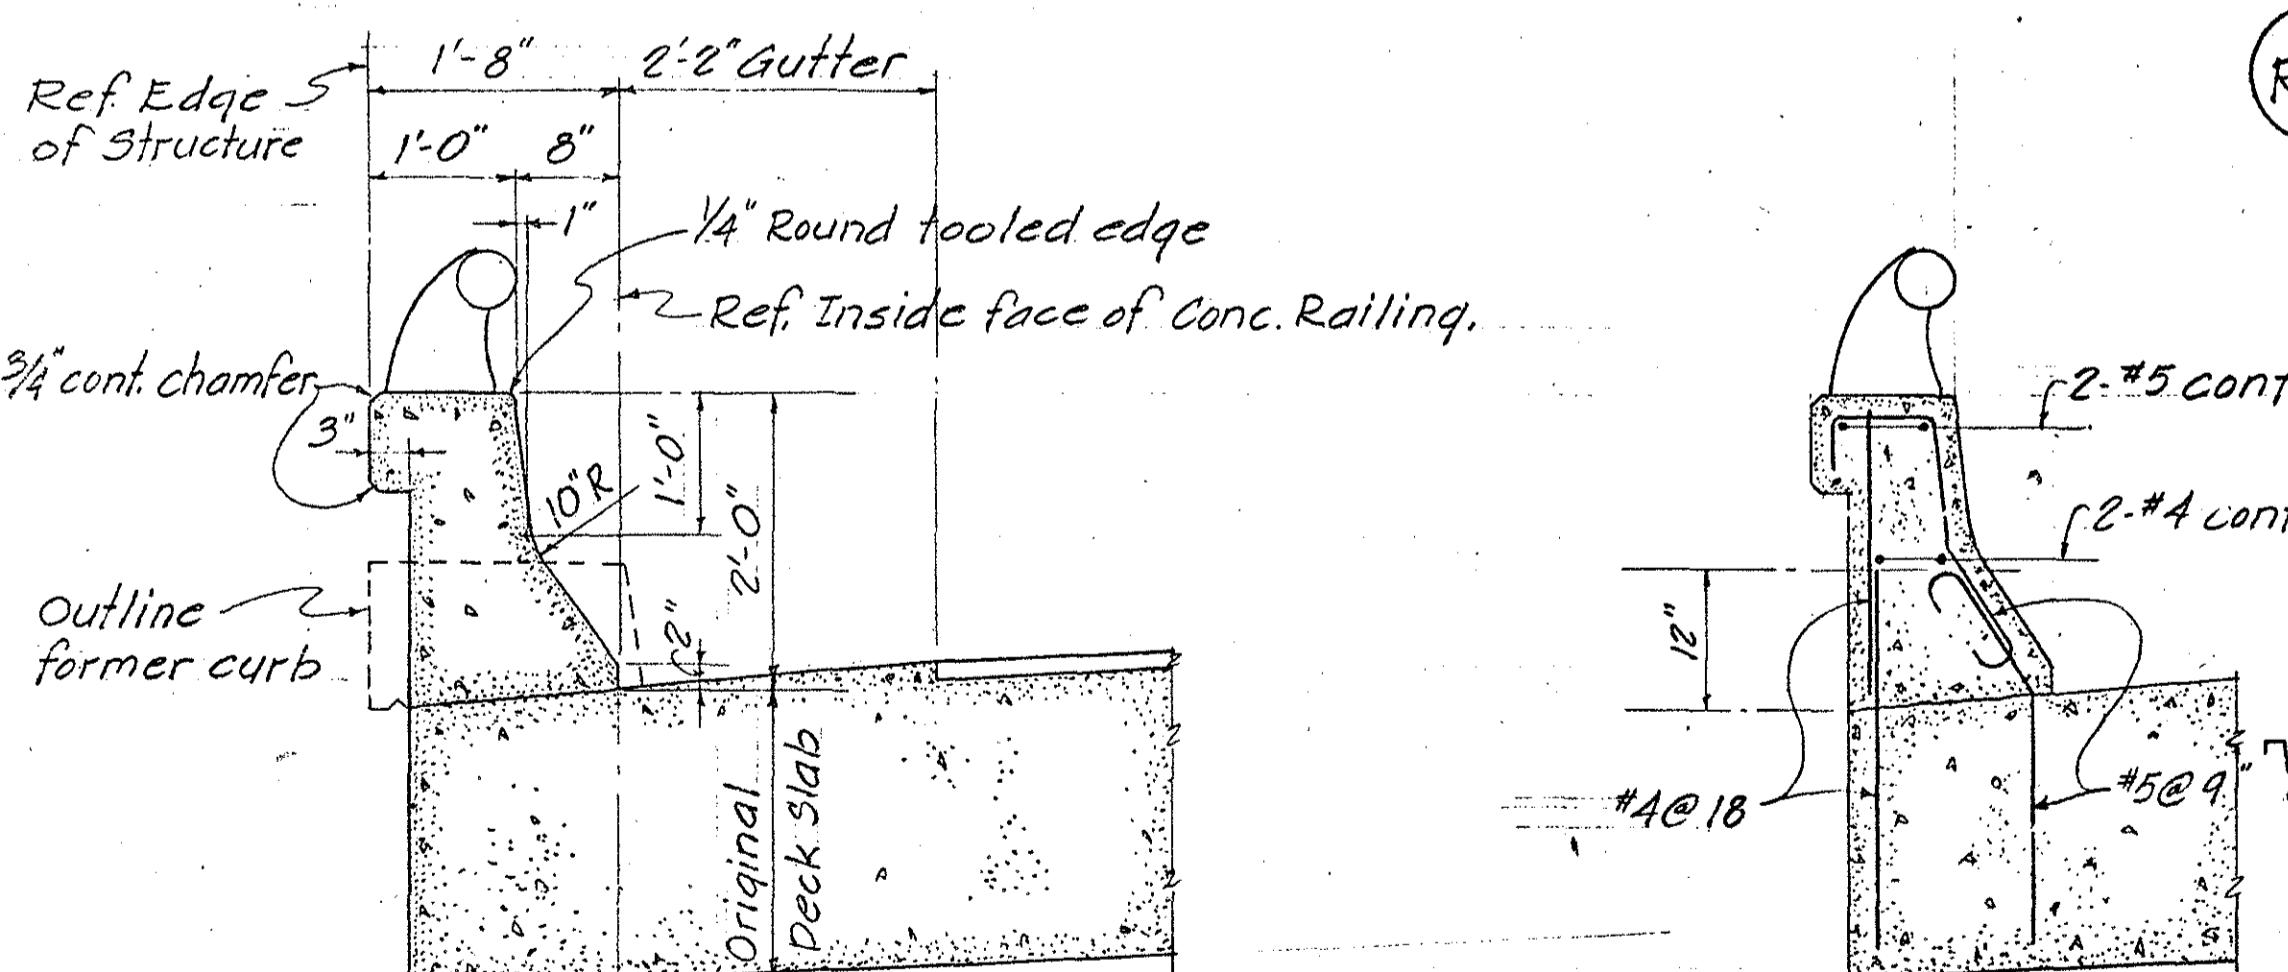

TYPICAL SECTION REINF. DETAIL REVISED PARAPET

FOR INTERSTATE STRUCTURE N° 22

INTERSTATE HIGHWAY (LUNALILO FREEWAY) F.A.I. PROJ. N° I-HI-1(6) UNIT 3

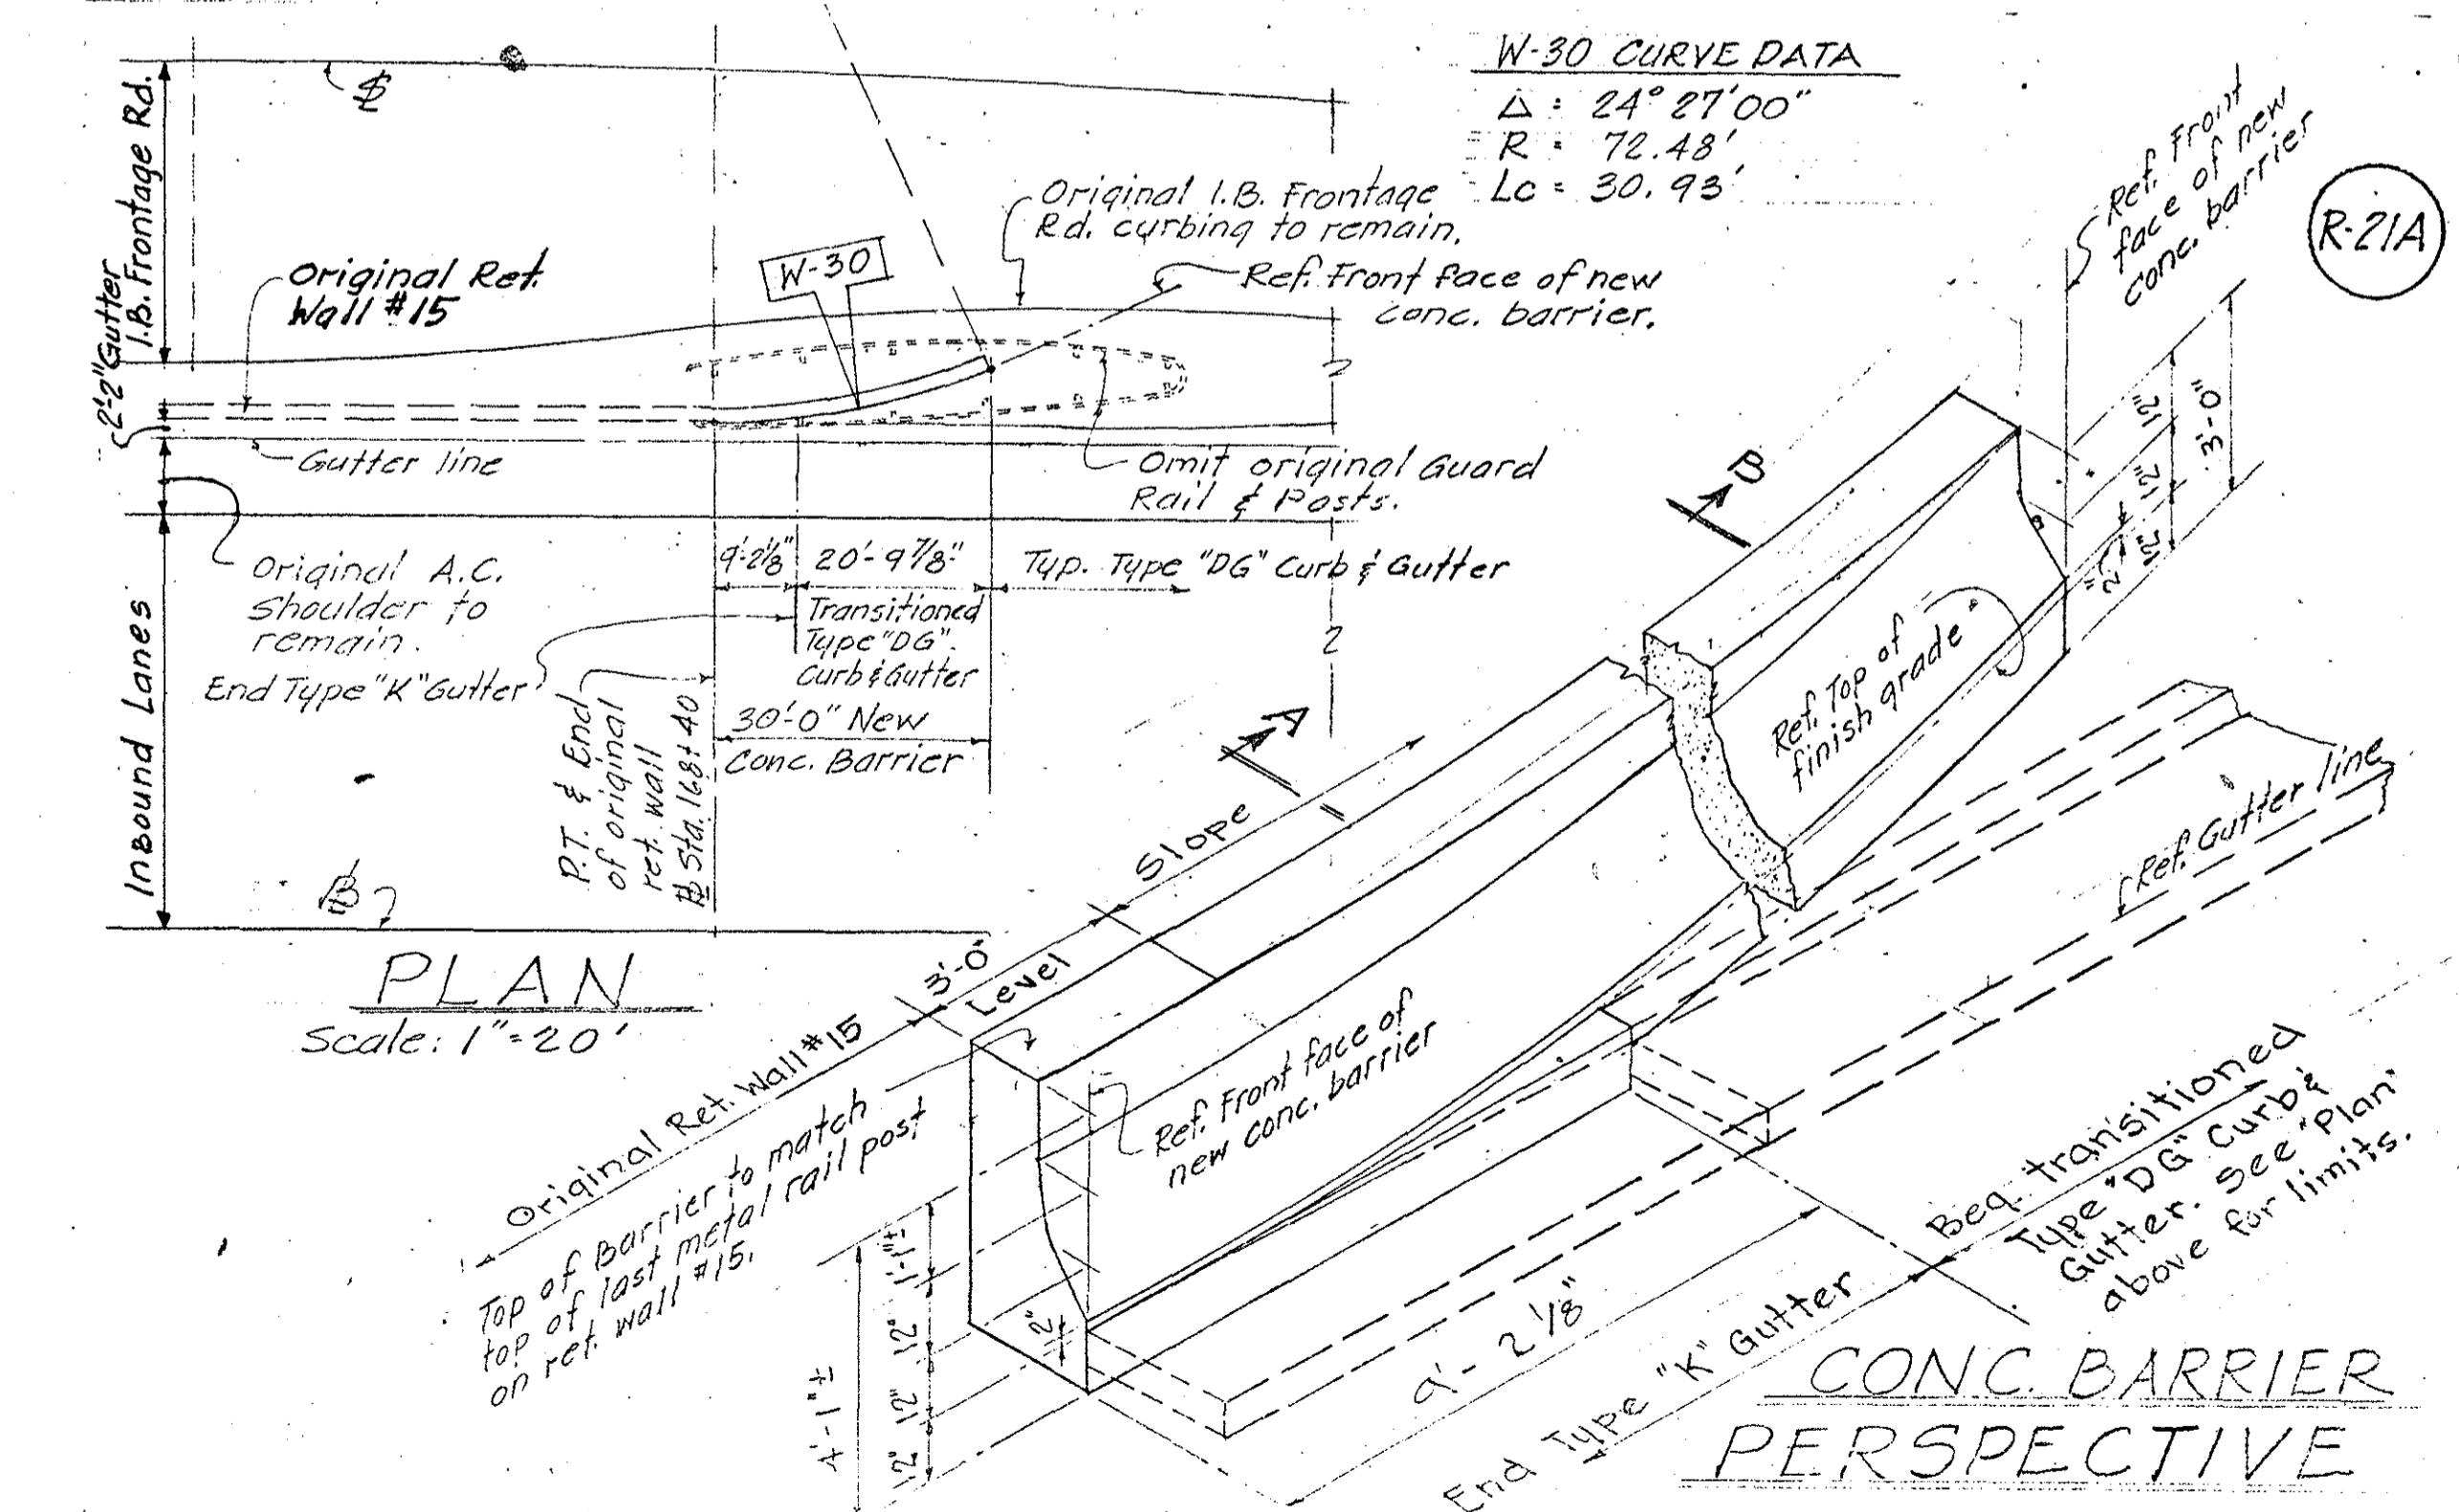



STATE OF HAWAII
DEPARTMENT OF TRANSPORTATION
HIGHWAYS DIVISION

CHANGE ORDER

DETAILS R-18, R-19, R-20 & R-21A

F.A.I. PROJ. NO. I-HI-1(6) UNIT 3

FED. ROAD DIST. NO.	STATE	FED. AID PROJ. NO.	FISCAL YEAR	SHEET NO.	TOTAL SHEETS
HAWAII	HAW.	I-HI-1(6), Unit 3	1985	C.O. 232S-1	235

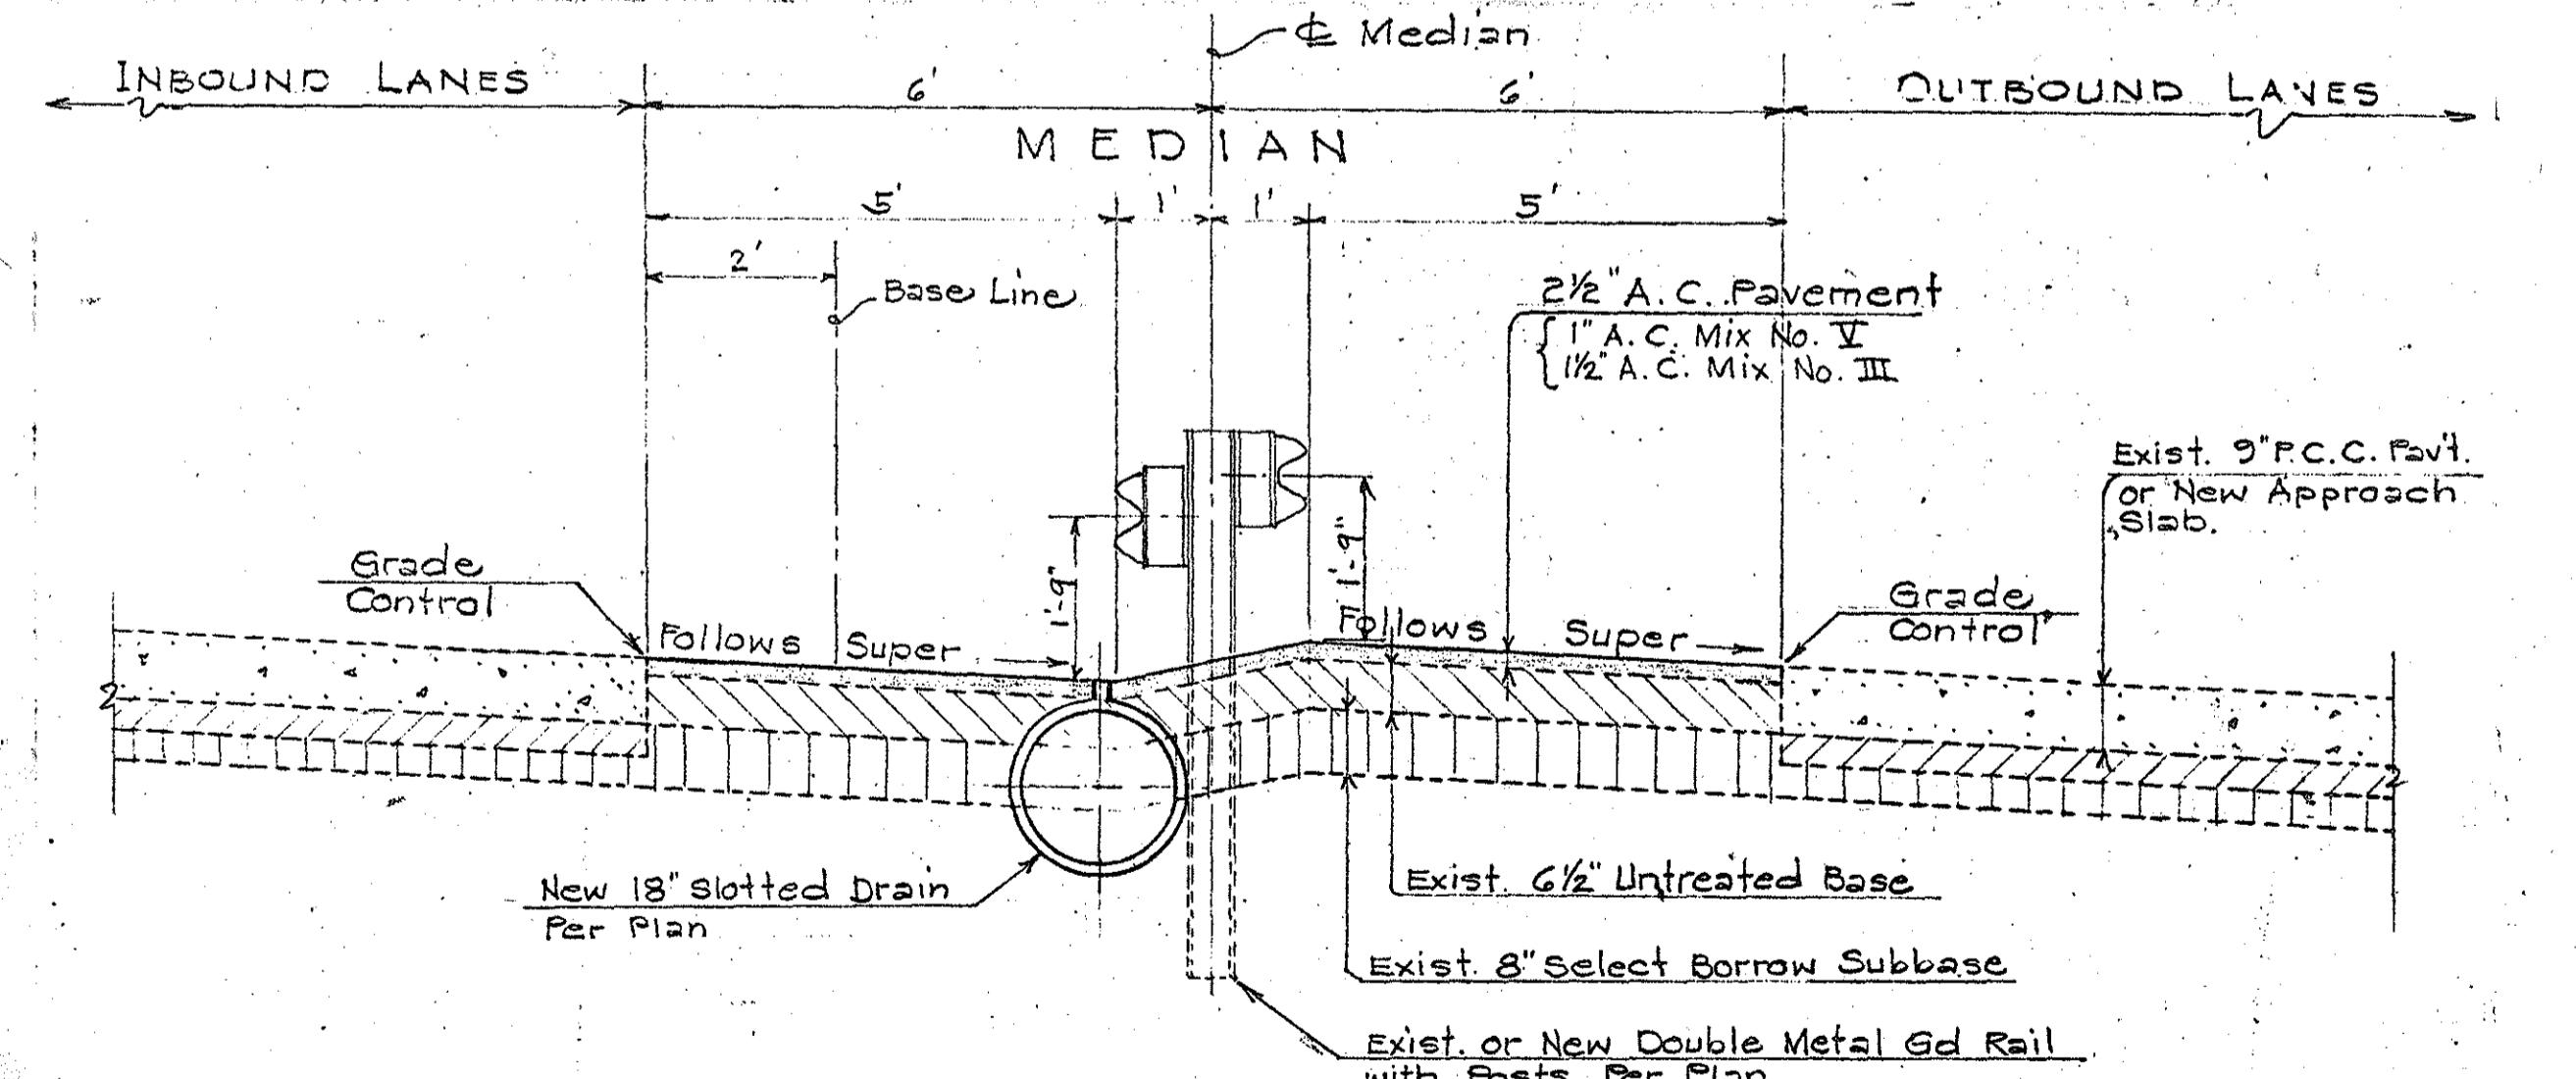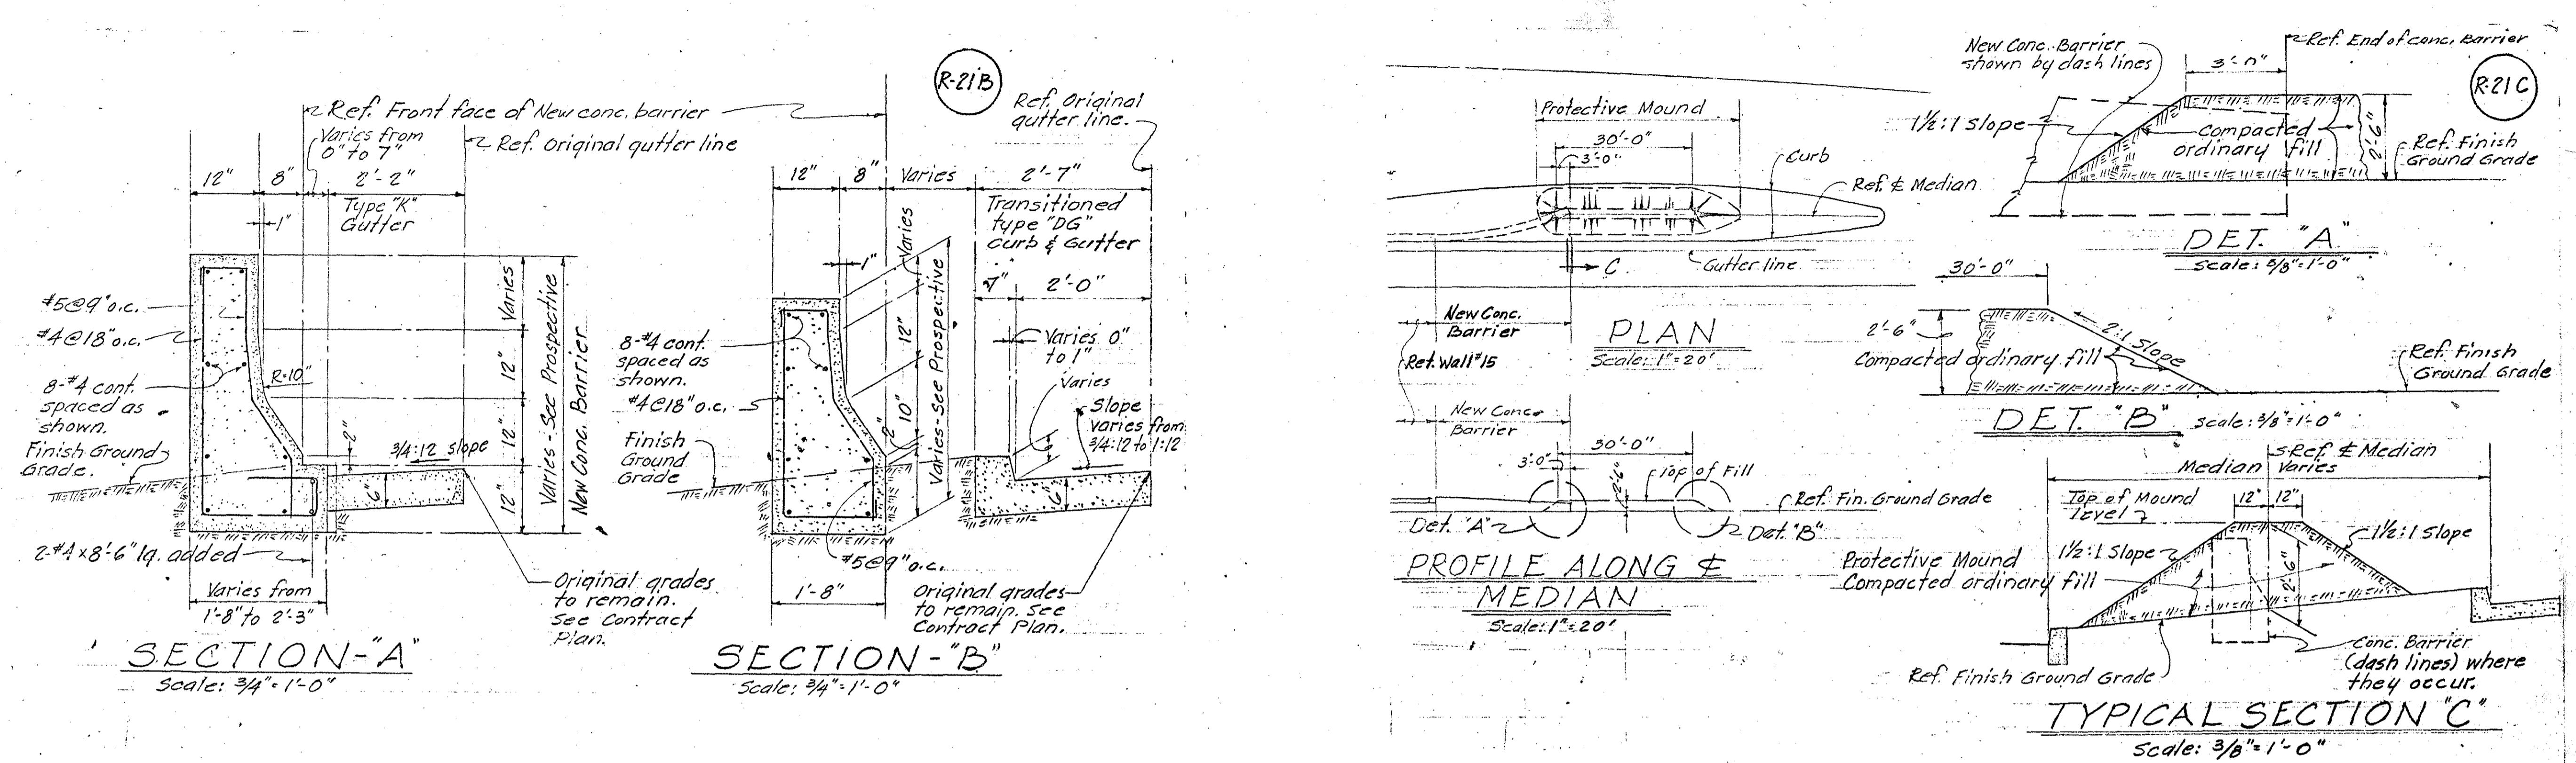

DETAIL OF REVISION TO MEDIAN

STA. 138 + 53 TO 141 + 03 ±
F.A.I. PROJ. NO. I-HI-1(6), UNIT 3
SCALE: $\frac{1}{2}$ " = 1'-0"

DATE: JAN. 11, 1968

(R-22)

STATE OF HAWAII
DEPARTMENT OF TRANSPORTATION
HIGHWAYS DIVISION

CHANGE ORDER

DETAILS R-21B, R-21C, & R-22

F.A.I. PROJ. NO. I-HI-1(6) UNIT 3

SHEET No. 6 OF 6 SHEETS

C.O. 232S-6