

SEWER NOTES

- Existing Sewer Lines shown on the plans are based on existing records of varying degrees of accuracy and completeness, verified wherever possible by field surveys. The Contractor shall verify actual location and inverts of existing lines, and shall be required to make adjustment to any new or existing sewer system wherever directed by the Engineer.
- Adjust existing sewer manholes and manhole frames and covers within proposed roadway to fit new roadway finished grades.
- If laterals other than those shown on the plans are exposed during construction, the same shall be cut and plugged, or extended and reconnected as required.
- All services connected to existing sewer mains which are to be abandoned or removed shall be reconnected to new sewer mains if services are required.
- All work involved in installation of new sewer mains, connection of existing house sewers to new sewer line, construction of concrete jackets around sewer mains, extension of laterals to new property line, and cutting and plugging of abandoned sewer lines and laterals shall be performed in accordance with the latest City and County Standard Sewer Details and Specifications and under the supervision of an Inspector or representative of the Division of Sewers, City and County of Honolulu.
- Concrete blocks and cradles shall be placed for all sewer mains and laterals.
- Salvaged 24 inch diameter manhole frames and covers may be used only for manholes at end of lines and only if the depth of manholes are 5 feet or less. All salvaged 24 inch frames and covers shall be used before 24 inch frames and covers are used.
- All services shall be maintained at all times during construction. Alterations to service lines shall be done with the least amount of disturbance to the existing services to the various houses.
- All trees, lawns, shrubbery, fences, etc., disturbed in the process of performing work on sewer service lines, shall be restored by the Contractor to the satisfaction of the Engineer. Such restoration work will not be paid for separately, but shall be considered as incidental to the various contract items for the sewer system.
- Contractor shall notify the Division of Sewers five (5) days prior to commencement of sewer work.

WATER NOTES

- The Contractor shall notify the Board of Water Supply in writing one week prior to commencing work on water system.
- The locations of existing water mains and appurtenances shown on the plans are approximate only. Any adjustment to the water mains and appurtenances whether shown on the construction plans or not shall be made and paid for by the project.
- The utility lines shown on these plans are located from the best sources available. The Contractor shall check and verify the exact location and depth of same. Exposing of existing water main to be done by hand excavation.
- Utility lines other than B.W.S. Lines and Sewer Dept. Lines are shown for the Contractors convenience only. For layout of other utilities, see respective utility plans.
- All excavation and backfill shall be done by the Contractor, including excavation for the relocation and lowering or raising of existing main and excavation for meter to house service connections.
- The Contractor shall arrange with the Board of Water Supply to cut off existing unused service laterals and remove meter boxes and appurtenances prior to commencement of clearing and grading operations. Contractor to provide all necessary excavations.
- All Water System are tied to Baseline and Roadway Stationing unless otherwise noted.
- Any blasting work in the vicinity of the existing water systems shall be kept at a minimum.
- Any water mains adjacent to pile driving operation shall be kept exposed during the progress of the work.
- Any damage incurred to the water system from blasting and pile driving shall be the responsibility of the Contractor.
- Items indicated as "SALVAGE" on the plans shall be removed, cleaned and returned to BWS Kalihii Store Yard by the Contractor.

- Items indicated as "RELOCATE" on the plans shall be removed, cleaned, painted and reinstalled at the new location by the Contractor unless otherwise specified.
- Asterisk (*) indicates work to be performed by B.W.S. Materials to be furnished by the Contractor or State unless specified as "RELOCATE".
- Wherever a corporation stop shown tapping into a new main is larger than that allowed by BWS standards, a double hub fitting with boss tapped for appropriate size corporation shall be used.
- The minimum clearance between fire hydrants and utility poles or light standards shall be 3.0 feet.
- Items noted thus "(State)" indicate materials furnished by the State.


- The Contractor shall plug the ends of abandoned water mains with Class "C-1" Concrete. Payment for Class "C-1" Concrete used as plugs shall be considered incidental to the various contract items for the water system.
- 16" and 24" C.I. Fittings shall be either Class D (Leadjoints) or Class 150 (Mechanical Joints)
- Contractor shall provide adequate size sleeves thru walls, as directed by the Engineer to facilitate B.W.S. extension of water service pipe into customers property and reconnection.
- For service connections to Sprinkler System, see Sprinkler System Plan Sheet Nos. 158 to 165 inclusive.

L E G E N D			
	Existing Type "A" Water Manhole		New Water Meter
	New Type "A" Water Manhole		Existing Sewer Line (Sizes Indicated)
	Existing Water Valve Manhole		New Sewer Line (Sizes Indicated)
	New Water Valve Manhole		Cut and Plug Existing Water, Sewer or Gas
	Existing Water Line (Sizes Indicated)		Existing Gas Line (Sizes Indicated)
	New Water Line (Sizes Indicated)		New Gas Lines (Sizes Indicated)
	Existing Fire Hydrant		Existing H.E.Co. & H.T.Co. UNDERGROUND DUCT LINES
	New Fire Hydrant		New H.E.Co. & H.T.Co. UNDERGROUND DUCT LINES
	Existing Water Meter		Catch Basin

FED. ROAD DIST. NO.	STATE	FED. AID PROJ. NO.	FISCAL YEAR	SHEET NO.	TOTAL SHEETS
HAWAII	HAW.	1966	1966	65	235

DATE
SURVEY ELABORATED BY
PLAN CHECKED BY
DESIGNED BY
QUANTITIES BY
CHECKED BY
ORIGINAL PLAN
NOTE BOOK
No.

PRINTED ON NO. 10001 CLEARPRINT

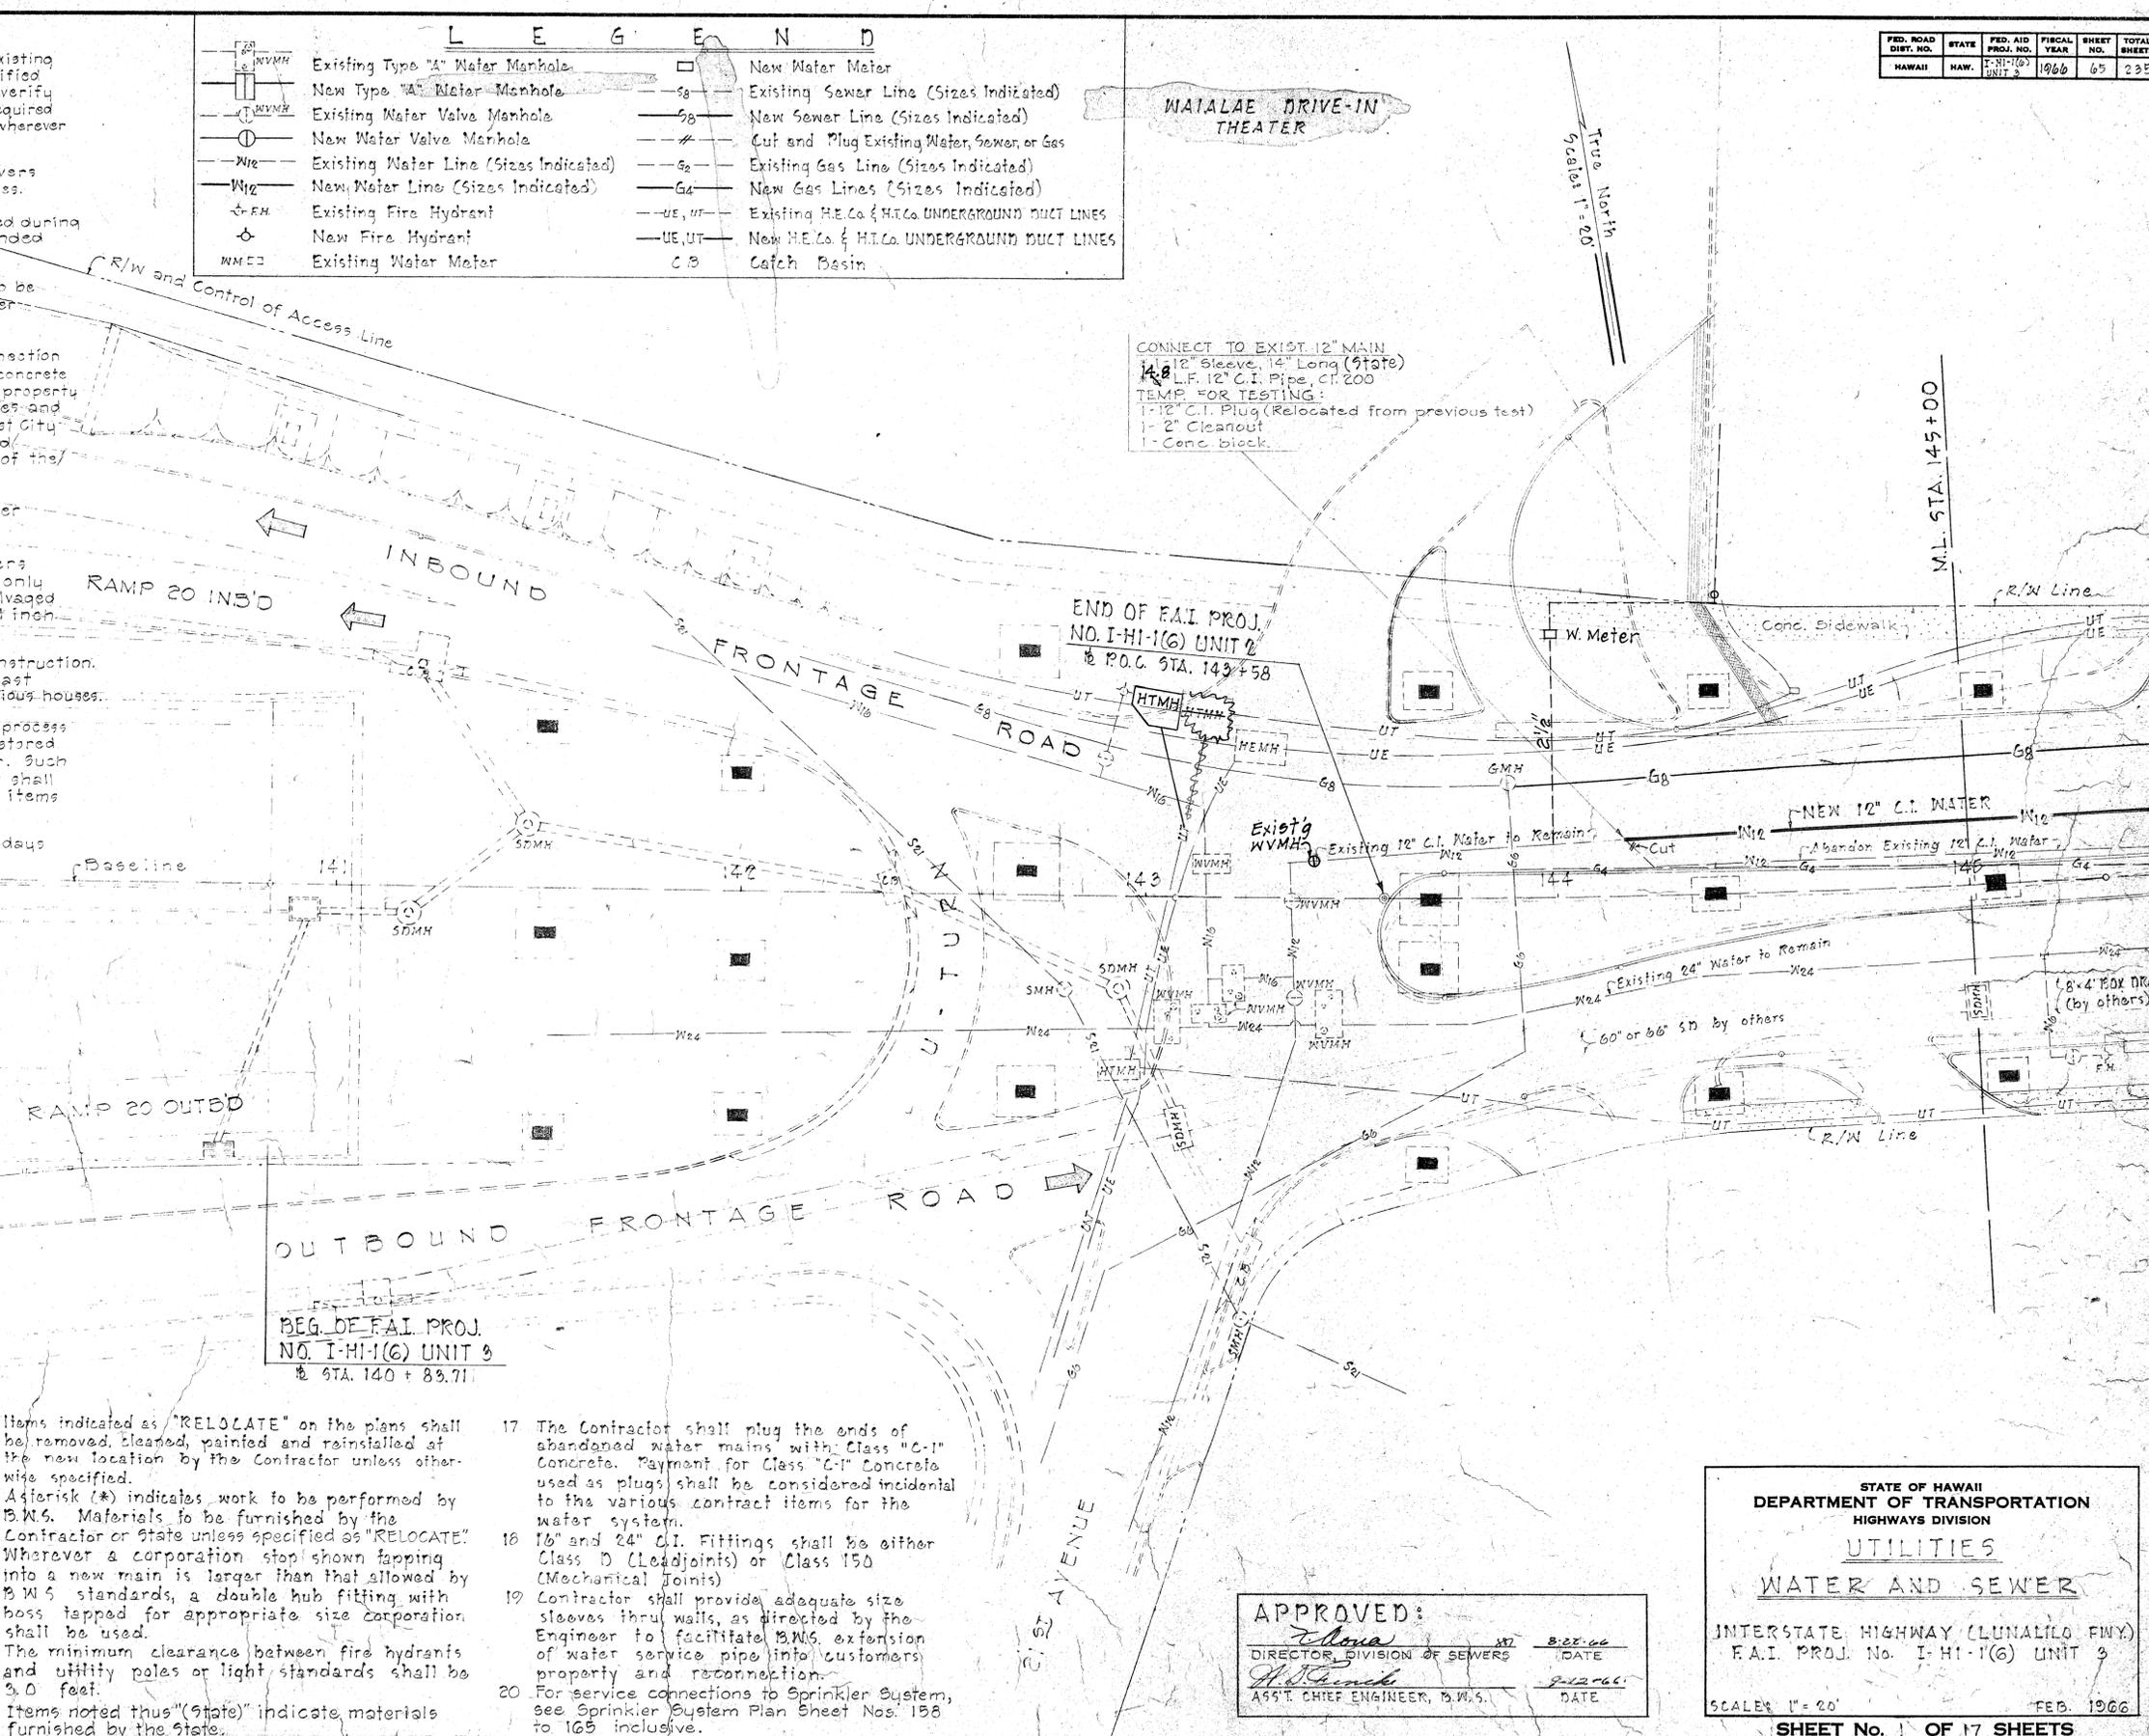

APPROVED:
[Signature]
 DIRECTOR, DIVISION OF SEWERS
[Signature]
 ASST. CHIEF ENGINEER, B.W.S.

DATE: 8-28-66
 DATE: 9-12-66

STATE OF HAWAII
 DEPARTMENT OF TRANSPORTATION
 HIGHWAYS DIVISION
UTILITIES
WATER AND SEWER
 INTERSTATE HIGHWAY (LUNALILO Fwy)
 F.A.I. PROJ. No. I-HI-1(6) UNIT 9
 SCALE: 1" = 20'
 FEB. 1966
SHEET No. 1 OF 17 SHEETS

65

SEWER NOTES

- Existing Sewer Lines shown on the plans are based on existing records of varying degrees of accuracy and completeness, verified wherever possible by field surveys. The Contractor shall verify actual location and inverts of existing lines, and shall be required to make adjustment to any new or existing sewer system wherever directed by the Engineer.
- Adjust existing sewer manholes and manhole frames and covers within proposed roadway to fit new roadway finished grades.
- If laterals other than those shown on the plans are exposed during construction, the same shall be cut and plugged, or extended and reconnected as required.
- All services connected to existing sewer mains which are to be abandoned or removed shall be reconnected to new sewer mains if services are required.
- All work involved in installation of new sewer mains, connection of existing house sewers to new sewer line, construction of concrete jackets around sewer mains, extension of laterals to new property line, and cutting and plugging of abandoned sewer lines and laterals shall be performed in accordance with the latest City and County Standard Sewer Details and Specifications and under the supervision of an Inspector or representative of the Division of Sewers, City and County of Honolulu.
- Concrete blocks and cradles shall be placed for all sewer mains and laterals.
- Salvaged 21 inch diameter manhole frames and covers may be used only for manholes at end of lines and only if the depth of manholes are 5 feet or less. All salvaged 24 inch frames and covers shall be used before 21 inch frames and covers are used.
- All services shall be maintained at all times during construction. Alterations to service lines shall be done with the least amount of disturbance to the existing services to the various houses.
- All trees, lawns, shrubbery, fences, etc., disturbed in the process of performing work on sewer service lines, shall be restored by the Contractor to the satisfaction of the Engineer. Such restoration work will not be paid for separately, but shall be considered as incidental to the various contract items for the sewer system.
- Contractor shall notify the Division of Sewers five(5) days prior to commencement of sewer work.

WATER NOTES

- The Contractor shall notify the Board of Water Supply in writing one week prior to commencing work on water system.
- The locations of existing water mains and appurtenances shown on the plans are approximate only. Any adjustment to the water mains and appurtenances whether shown on the construction plans or not shall be made and paid for by the project.
- The utility lines shown on these plans are located from the best sources available. The Contractor shall check and verify the exact location and depth of same. Exposing of existing water main to be done by hand excavation.
- Utility lines other than B.W.S. Lines and Sewer Dept. Lines are shown for the Contractors convenience only. For layout of other utilities, see respective utility plans.
- All excavation and backfill shall be done by the Contractor, including excavation for the relocation and lowering or raising of existing main and excavation for meter to house service connections.
- The Contractor shall arrange with the Board of Water Supply to cut off existing unused service laterals and remove meter boxes and appurtenances prior to commencement of clearing and grading operations. Contractor to provide all necessary excavations.
- All Water System are tied to Baseline and Roadway Stationing, unless otherwise noted.
- Any blasting work in the vicinity of the existing water systems shall be kept at a minimum.
- Any water mains adjacent to pile driving operation shall be kept exposed during the progress of the work.
- Any damage incurred to the water system from blasting and pile driving shall be the responsibility of the Contractor.
- Items indicated as "SALVAGE" on the plans shall be removed, cleaned and returned to BWS Kalih'i Store Yard by the Contractor.

- Items indicated as "RELOCATE" on the plans shall be removed, cleaned, painted and reinstalled at the new location by the Contractor unless otherwise specified.
- Asterisk (*) indicates work to be performed by B.W.S. Materials to be furnished by the Contractor or State unless specified as "RELOCATE".
- Wherever a corporation stop shown tapping into a new main is larger than that allowed by BWS standards, a double hub fitting with boss tapped for appropriate size corporation shall be used.
- The minimum clearance between fire hydrants and utility poles or light standards shall be 9.0 feet.
- Items noted thus "(State)" indicate materials furnished by the State.

- The Contractor shall plug the ends of abandoned water mains with Class "C-1" Concrete. Payment for Class "C-1" Concrete used as plugs shall be considered incidental to the various contract items for the water system.
- 16" and 24" C.I. Fittings shall be either Class D (Leadjoints) or Class 150 (Mechanical Joints)
- Contractor shall provide adequate size sleeves thru walls, as directed by the Engineer to facilitate BWS extension of water service pipe into customers property and reconnection.
- For service connections to Sprinkler System, see Sprinkler System Plan Sheet Nos. 158 to 165 inclusive.


LEGEND

	Existing Type "A" Water Manhole		New Water Meter
	New Type "A" Meter Manhole		Existing Sewer Line (Sizes Indicated)
	Existing Water Valve Manhole		New Sewer Line (Sizes Indicated)
	New Water Valve Manhole		Cut and Plug Existing Water, Sewer, or Gas
	Existing Water Line (Sizes Indicated)		Existing Gas Line (Sizes Indicated)
	New Water Line (Sizes Indicated)		New Gas Lines (Sizes Indicated)
	Existing Fire Hydrant		Existing H.E.Co & H.T.Co UNDERGROUND DUCT LINES
	New Fire Hydrant		New H.E.Co & H.T.Co UNDERGROUND DUCT LINES
	Existing Water Meter		Catch Basin

MAIALAE DRIVE-IN THEATER

DESIGNED BY	DATE	SCALE	PROJECT NO.	SHEET NO.	TOTAL SHEETS
7/65R		1" = 20'		235	

Revised May 5, 1967

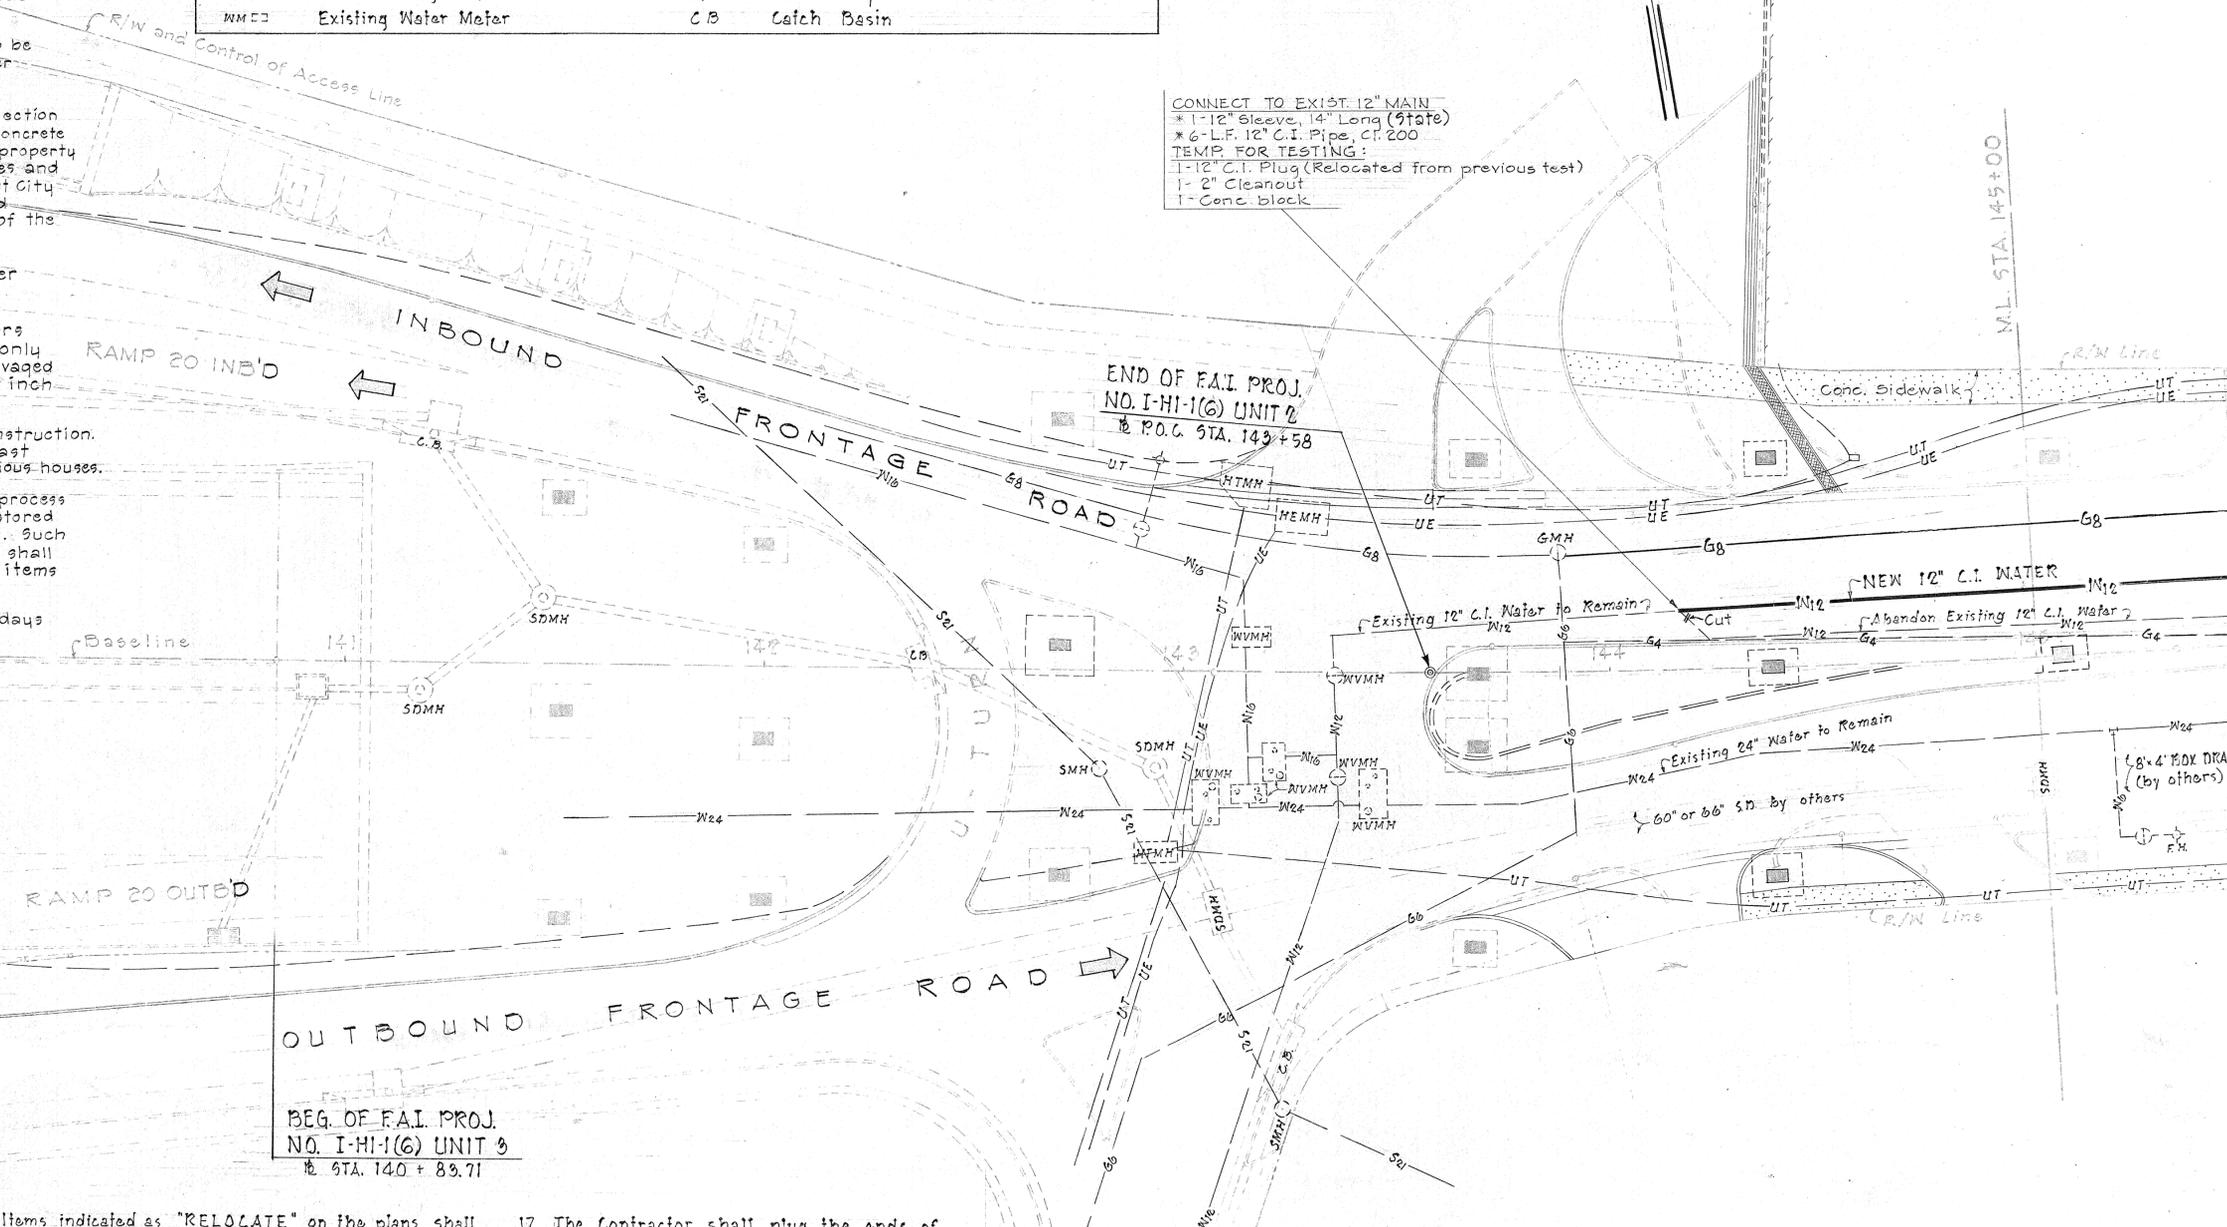

CONNECT TO EXIST. 12" MAIN
 * 1-12" Sleeve, 14" Long (State)
 * 6-L.F. 12" C.I. Pipe, C.I. 200
 TEMP. FOR TESTING:
 1-12" C.I. Plug (Relocated from previous test)
 1- 2" Cleanout
 1- Conc. block

APPROVED:
 [Signature] 8-22-66
 DIRECTOR, DIVISION OF SEWERS DATE
 [Signature] 8-22-66
 ASST. CHIEF ENGINEER, B.W.S. DATE


STATE OF HAWAII
 DEPARTMENT OF TRANSPORTATION
 HIGHWAYS DIVISION
UTILITIES
WATER AND SEWER
 INTERSTATE HIGHWAY (LUNALILO FWY)
 F.A.I. PROJ. No. I-HI-1(6) UNIT 3
 SCALE: 1" = 20' MAY, 1967
 SHEET No. 1 OF 17 SHEETS

651R

FED. ROAD DIST. NO.	STATE	FED. AID PROJ. NO.	FISCAL YEAR	SHEET NO.	TOTAL SHEETS
HAWAII	HAW.	I-1(6) UNIT 3	1967	07R	235

Revised May 5, 1967

M.L. STA. 150 + 50

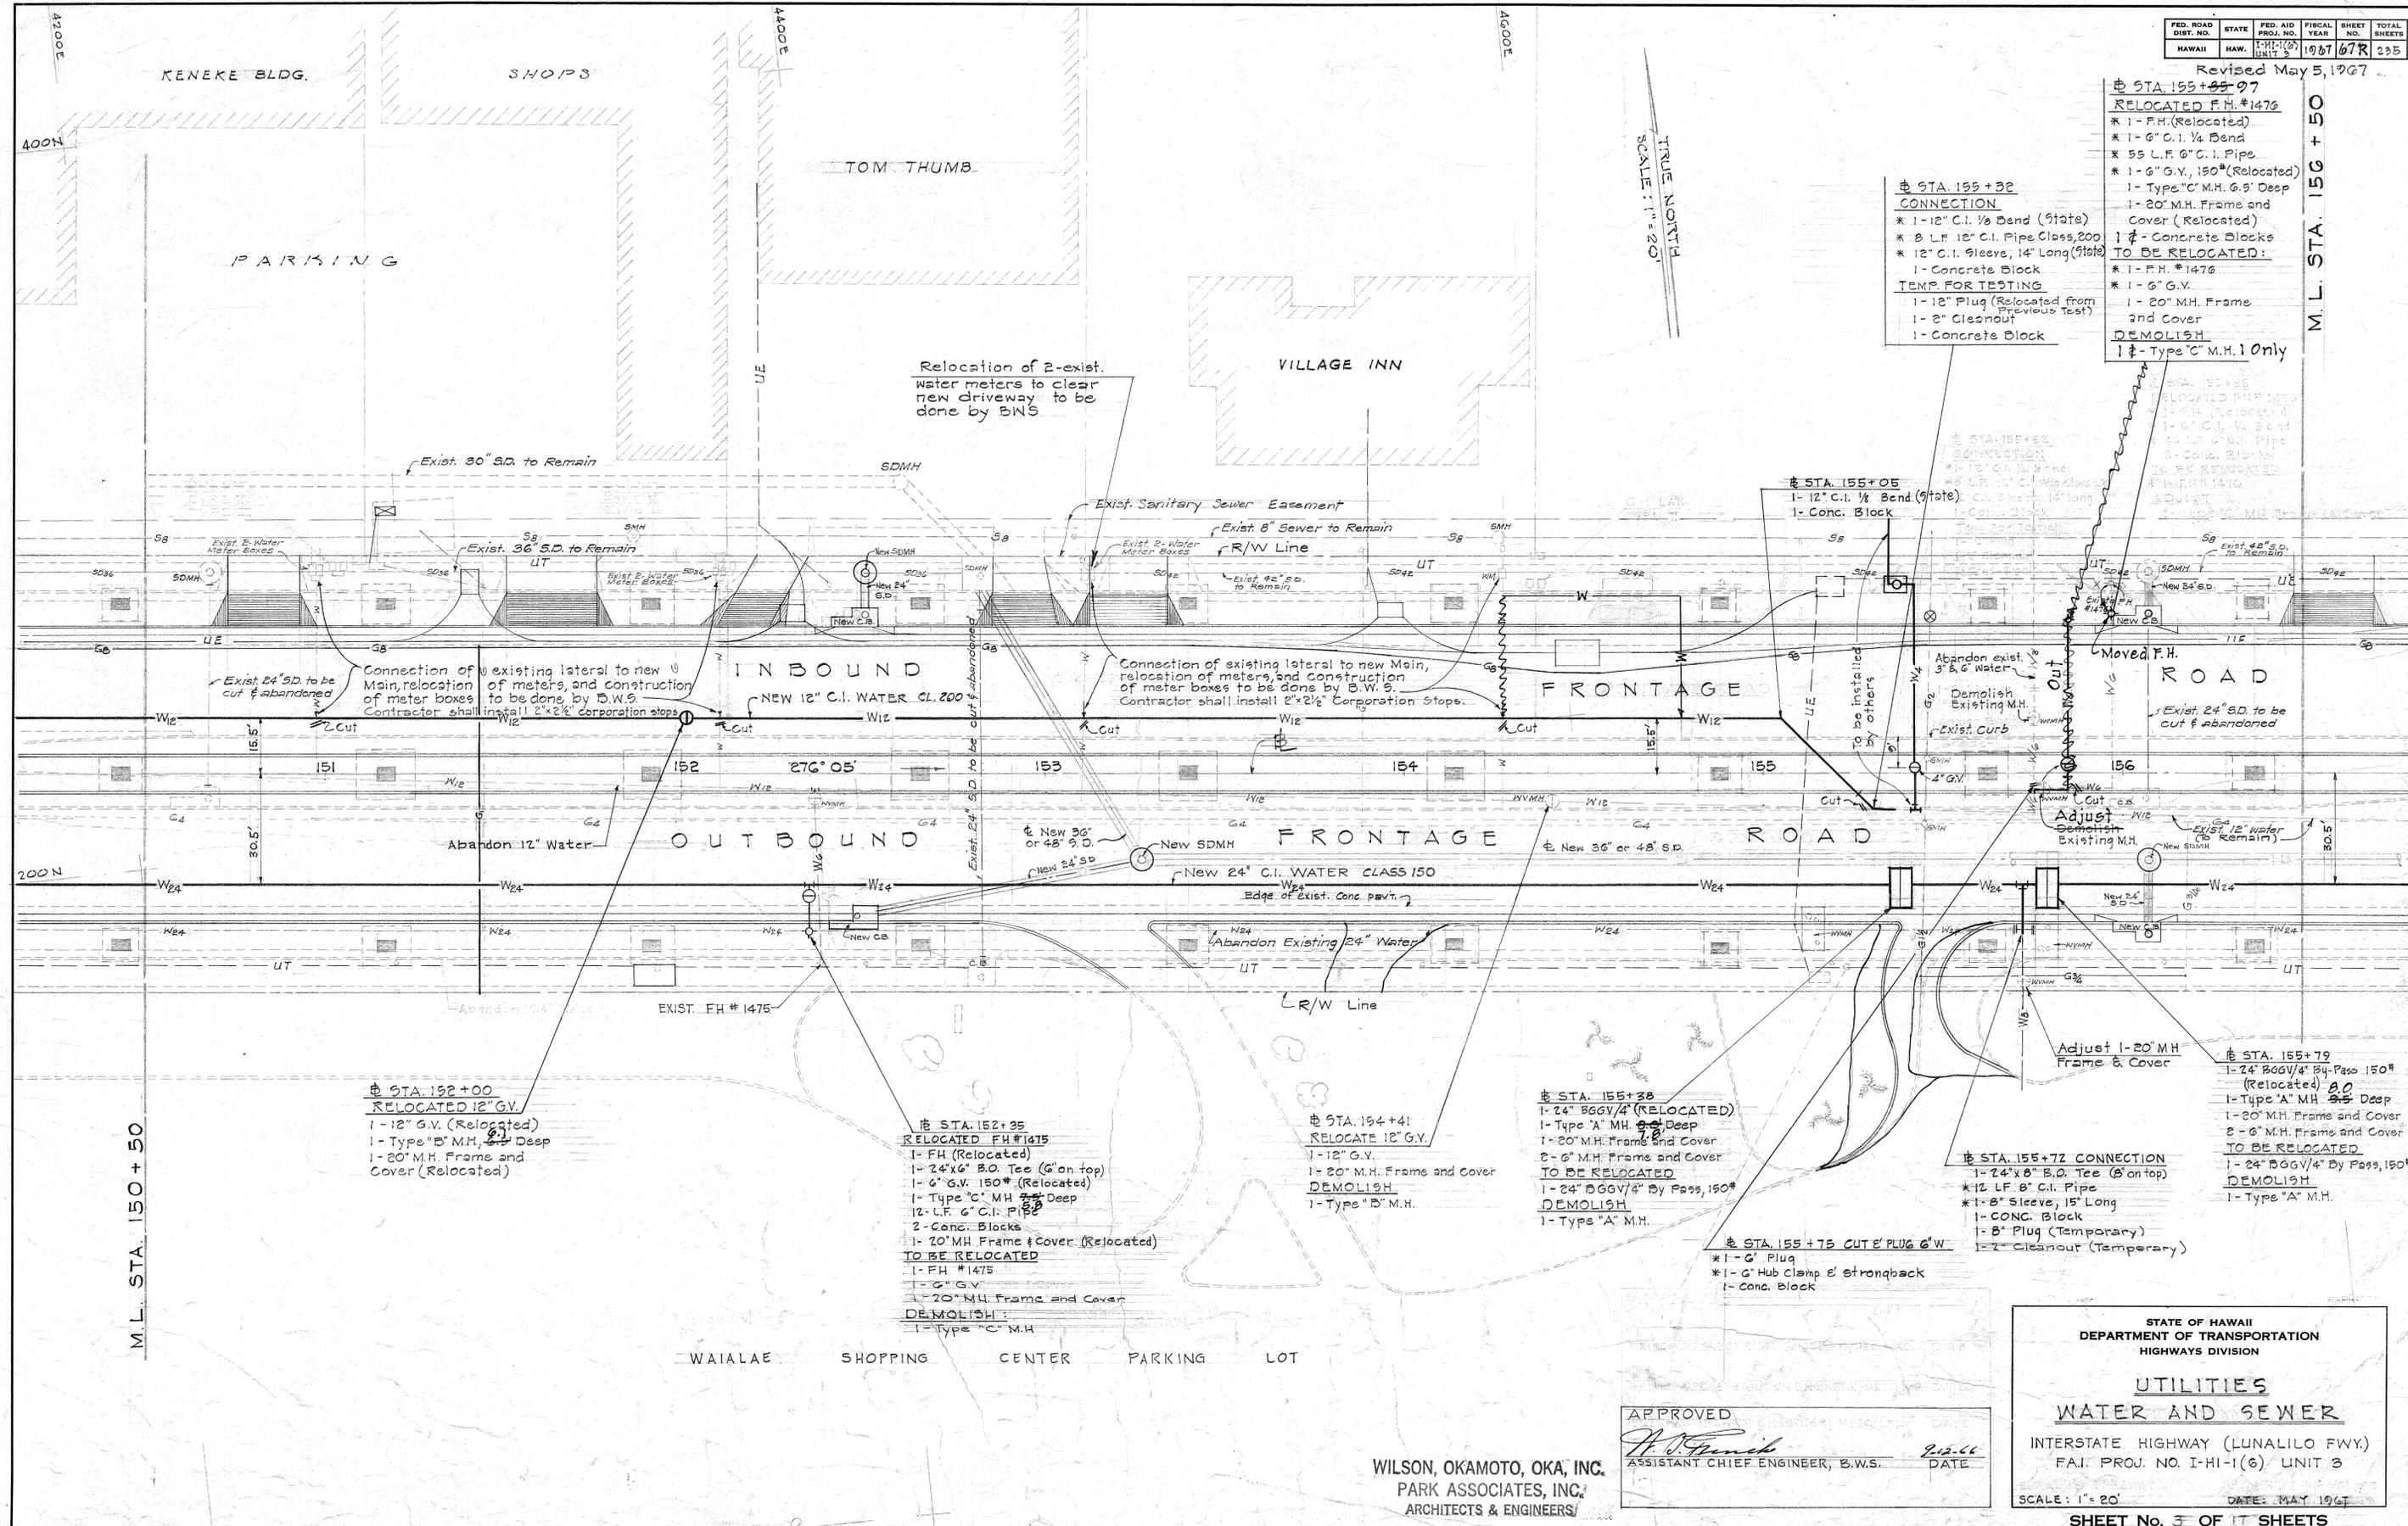

STA. 155+32 CONNECTION
 1- 12" C.I. 1/4 Bend (State)
 * 8 L.F. 12" C.I. Pipe Class 200
 * 12" C.I. Gleeve, 14' Long (State)
 1- Concrete Block
TEMP. FOR TESTING
 1- 12" Plug (Relocated from Previous Test)
 1- 2" Cleanout
 1- Concrete Block

STA. 155+07 RELOCATED F.H. #1476
 * 1- F.H. (Relocated)
 * 1- 6" C.I. 1/4 Bend
 * 55 L.F. 6" C.I. Pipe
 * 1- 6" G.V., 190" (Relocated)
 1- Type "C" M.H. 6.5' Deep
 1- 20" M.H. Frame and Cover (Relocated)
TO BE RELOCATED:
 * 1- F.H. #1476
 * 1- 6" G.V.
 1- 20" M.H. Frame and Cover
DEMOLISH
 1- Type "C" M.H. 1 Only

STA. 155+05 CONNECTION
 1- 12" C.I. 1/4 Bend (State)
 1- Conc. Block

STA. 152+00 RELOCATED 12" G.V.
 1- 12" G.V. (Relocated)
 1- Type "B" M.H. 6.5' Deep
 1- 20" M.H. Frame and Cover (Relocated)

STA. 152+95 RELOCATED F.H. #1475
 1- F.H. (Relocated)
 1- 24"x6" B.O. Tee (6" on top)
 1- 6" G.V. 150" (Relocated)
 1- Type "C" M.H. 6.5' Deep
 12- L.F. 6" C.I. Pipe
 2- Conc. Blocks
 1- 20" M.H. Frame & Cover (Relocated)
TO BE RELOCATED
 1- F.H. #1475
 1- 6" G.V.
 1- 20" M.H. Frame and Cover
DEMOLISH:
 1- Type "C" M.H.

STA. 154+41 RELOCATE 12" G.V.
 1- 12" G.V.
 1- 20" M.H. Frame and Cover
DEMOLISH
 1- Type "B" M.H.

STA. 155+38
 1- 24" BGGV/4" (RELOCATED)
 1- Type "A" M.H. 6.5' Deep
 1- 20" M.H. Frame and Cover
 2- 6" M.H. Frame and Cover
TO BE RELOCATED
 1- 24" BGGV/4" By Pass, 150"
DEMOLISH
 1- Type "A" M.H.

STA. 155+75 CUT & PLUG 6" W.
 * 1- 6" Plug
 * 1- 6" Hub clamp & Strongback
 1- Conc. Block

STA. 155+79
 1- 24" BGGV/4" By Pass 150"
 (Relocated) 8.0
 1- Type "A" M.H. 6.5' Deep
 1- 20" M.H. Frame and Cover
 2- 6" M.H. Frame and Cover
TO BE RELOCATED
 1- 24" BGGV/4" By Pass, 150"
DEMOLISH
 1- Type "A" M.H.

STA. 155+72 CONNECTION
 1- 24"x8" B.O. Tee (8" on top)
 * 12 L.F. 8" C.I. Pipe
 * 1- 8" Sleeve, 15' Long
 1- CONC. Block
 1- 8" Plug (Temporary)
 1- 2" Cleanout (Temporary)

SURVEY PLOTTED BY	DATE
ORIGINAL PLAN	DESIGNED BY
NOTE BOOK	QUANTITIES BY
	CHECKED BY

APPROVED
H. O. French
 ASSISTANT CHIEF ENGINEER, B.W.S. 2.12.66
DATE


WILSON, OKAMOTO, OKA, INC.
 PARK ASSOCIATES, INC.
 ARCHITECTS & ENGINEERS

STATE OF HAWAII
 DEPARTMENT OF TRANSPORTATION
 HIGHWAYS DIVISION
UTILITIES
WATER AND SEWER
 INTERSTATE HIGHWAY (LUNALILO FWY.)
 F.A.I. PROJ. NO. I-1(6) UNIT 3
 SCALE: 1" = 20' DATE: MAY 1967
SHEET No. 3 OF 17 SHEETS

G 7 IR

FED. ROAD DIST. NO.	STATE	FED. AID PROJ. NO.	FISCAL YEAR	SHEET NO.	TOTAL SHEETS
HAWAII	HAW.	1-11(16)	1966	68	235

- IND. FRONT RD STA. 203+15
- 1-12" x 6" Tee (State)
 - 1-6" G.V. (Relocated)
 - 1-Type "C" M.H. 5'-0" Deep
 - 1-20" M.H. Frame and Cover (Relocated)
 - 1-6" Tee
 - 1-6" C.I. 1/2 Bend
 - 1-6" C.I. 1/2 Bend
 - 1-6" Roundnose Plug Tapped for 2 1/2" I.P.T.
 - 55-LF 6" C.I. Pipe
 - 4-Conc. Blocks

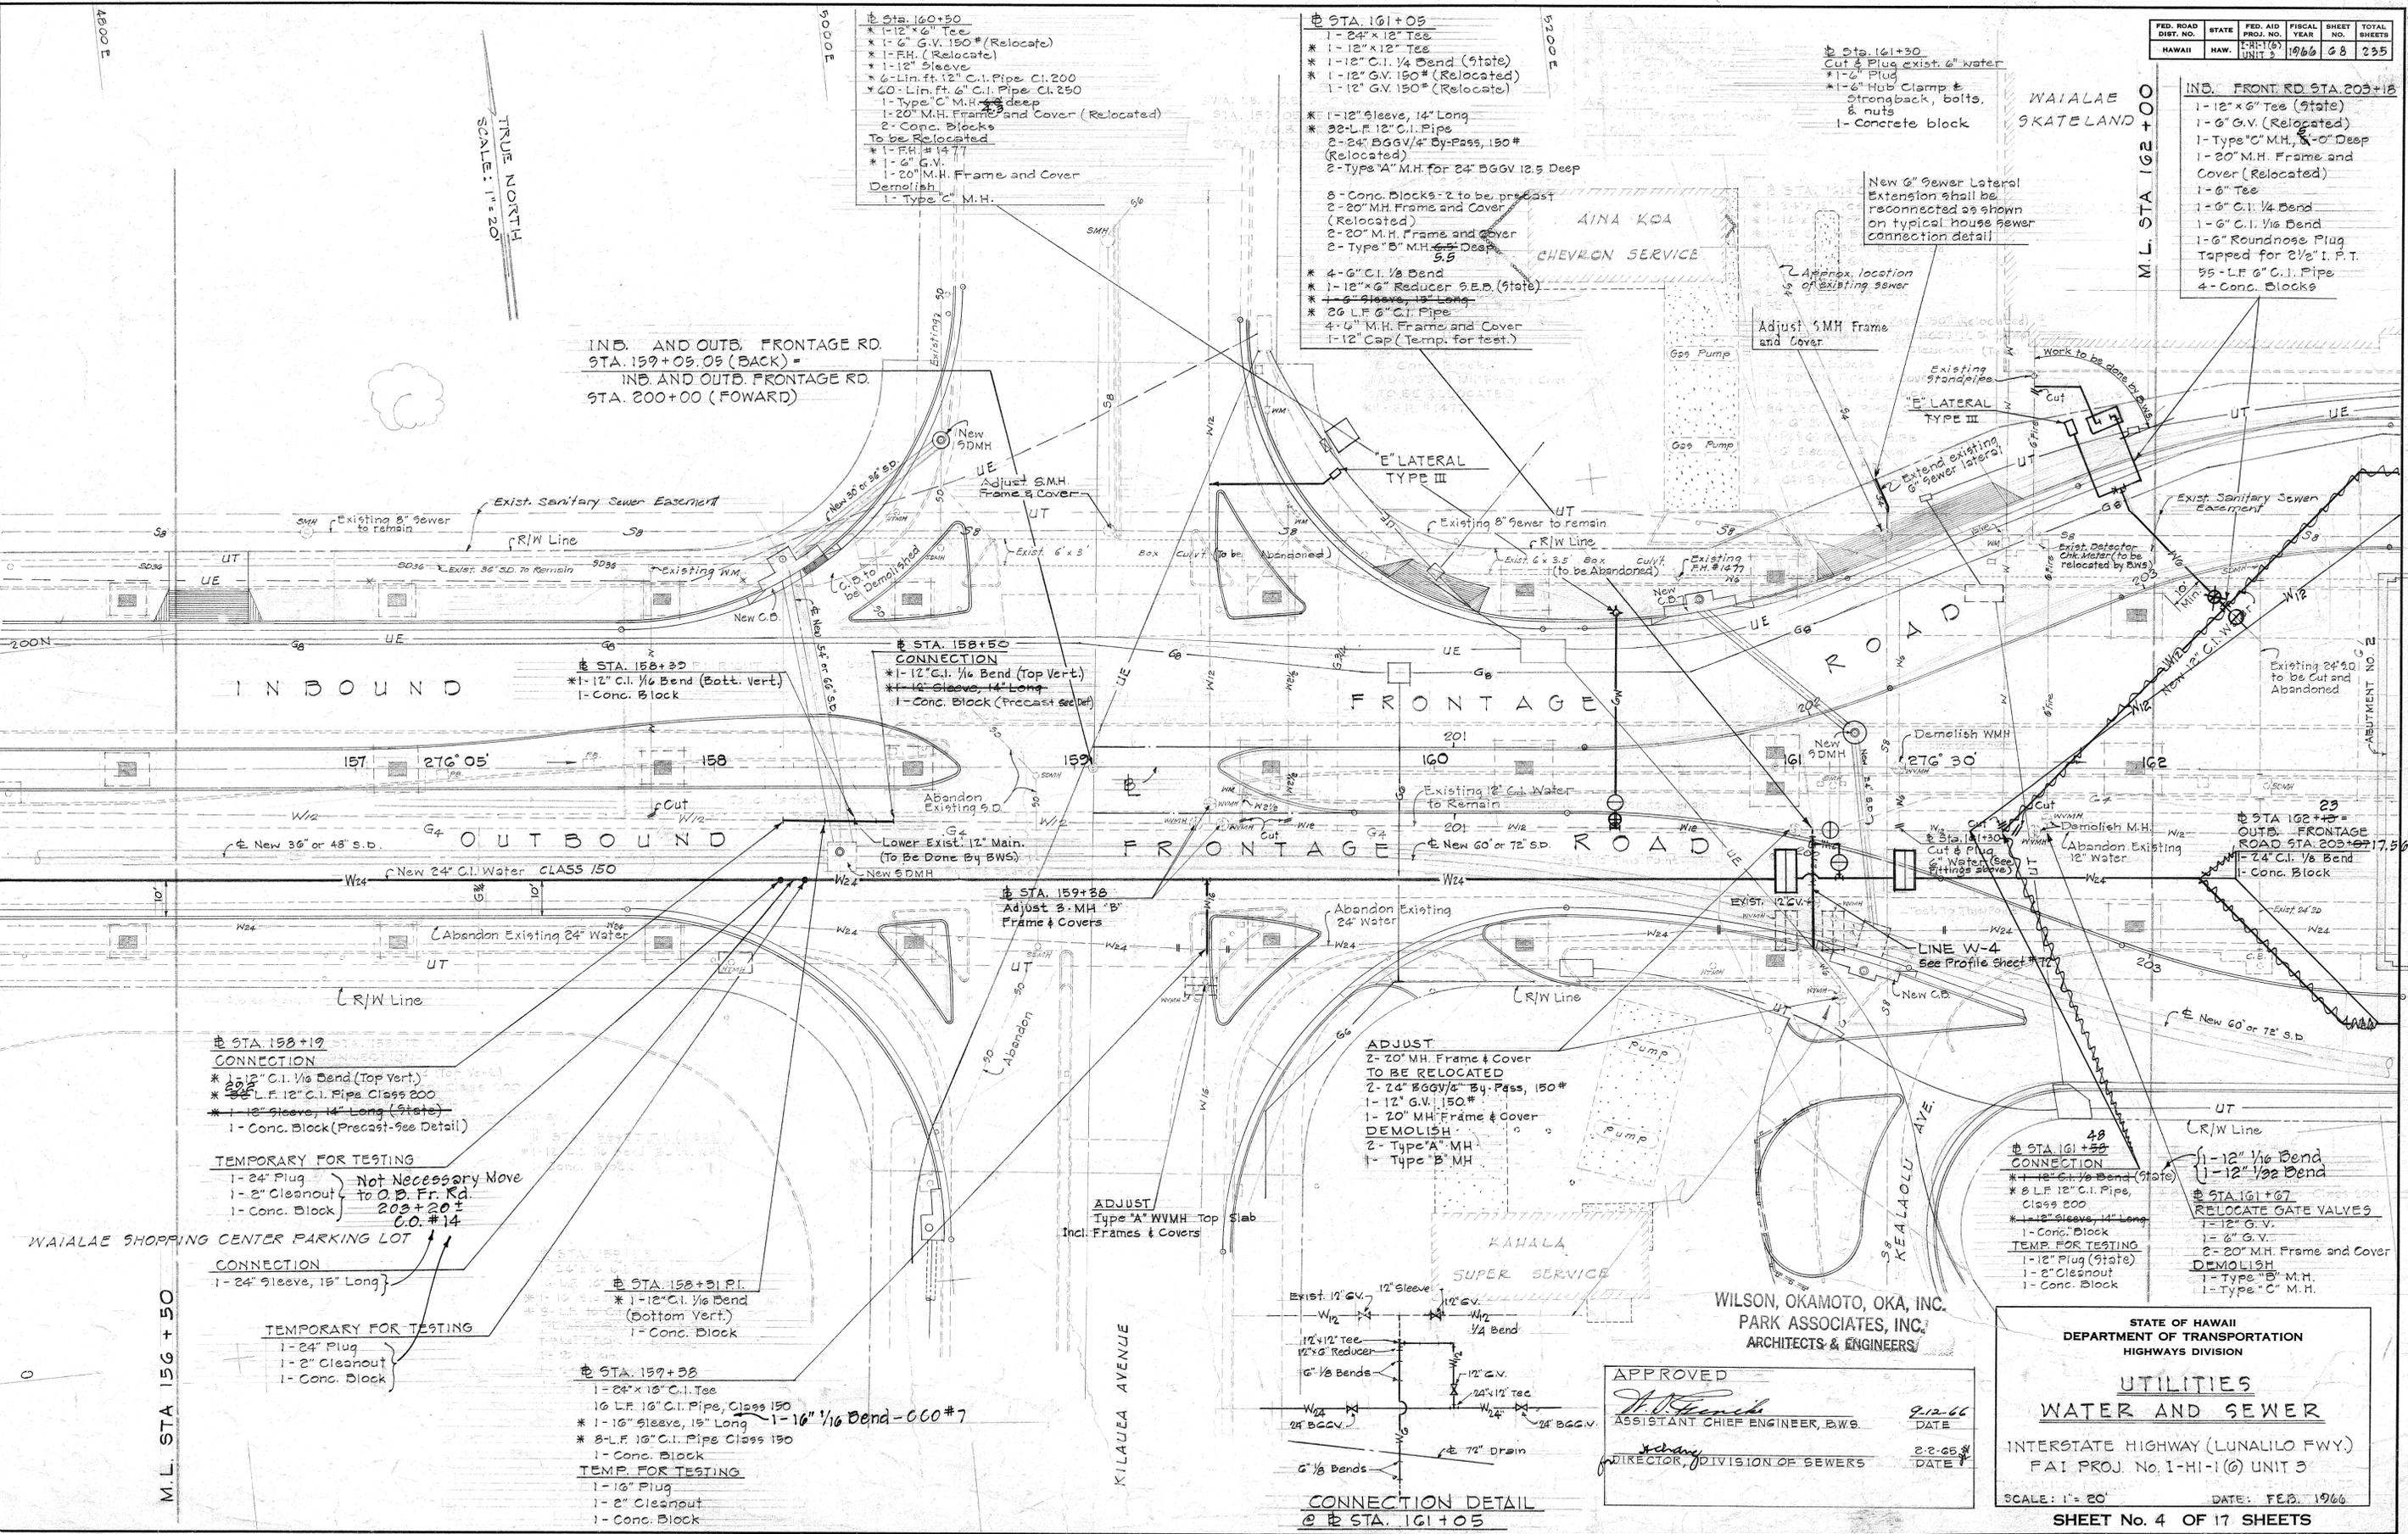

- Sta. 160+50
- 1-12" x 6" Tee
 - 1-6" G.V. 150# (Relocate)
 - 1-F.H. (Relocate)
 - 1-12" Sleeve
 - 6-Lin. ft. 12" C.I. Pipe Cl. 200
 - 40-Lin. ft. 6" C.I. Pipe Cl. 250
 - 1-Type "C" M.H. 5'-0" Deep
 - 1-20" M.H. Frame and Cover (Relocated)
 - 2-Conc. Blocks
 - To be Relocated
 - 1-F.H. #14
 - 1-6" G.V.
 - 1-20" M.H. Frame and Cover
 - Demolish
 - 1-Type "C" M.H.

- Sta. 161+05
- 1-24" x 12" Tee
 - 1-12" x 12" Tee
 - 1-12" C.I. 1/2 Bend (State)
 - 1-12" G.V. 150# (Relocated)
 - 1-12" G.V. 150# (Relocate)
 - 1-12" Sleeve, 14" Long
 - 30-LF 12" C.I. Pipe
 - 2-24" BGGV 1/4" By-Pass, 150# (Relocated)
 - 2-Type "A" M.H. for 24" BGGV 12.5 Deep
 - 5-Conc. Blocks-2 to be precast
 - 2-20" M.H. Frame and Cover (Relocated)
 - 2-20" M.H. Frame and Cover
 - 2-Type "B" M.H. 5'-0" Deep
 - 4-6" C.I. 1/2 Bend
 - 1-12" x 6" Reducer 9 E.D. (State)
 - 1-6" Sleeve, 15" Long
 - 20-LF 6" C.I. Pipe
 - 4-6" M.H. Frame and Cover
 - 1-12" Cap (Temp. for test)

- Sta. 161+30
- Cut & Plug exist. 6" water
 - 1-6" Plug
 - 1-6" Hub Clamp & Strongback, bolts, & nuts
 - 1-Concrete block

New 6" Sewer Lateral Extension shall be reconnected as shown on typical house sewer connection detail

IND. AND OUTB. FRONTAGE RD. STA. 159+09.09 (BACK) = IND. AND OUTB. FRONTAGE RD. STA. 200+00 (FORWARD)

INBOUND

OUTBOUND

FRONTAGE ROAD

FRONTAGE ROAD

FRONTAGE ROAD

Sta. 158+19 CONNECTION

- 1-12" C.I. 1/2 Bend (Top Vert.)
- 20-LF 12" C.I. Pipe Class 200
- 1-12" sleeve, 14" Long (State)
- 1-Conc. Block (Precast-see Detail)

TEMPORARY FOR TESTING

- 1-24" Plug
 - 1-2" Cleanout
 - 1-Conc. Block
- Not Necessary Move to O.D. Fr. Rd. 203+20 I.C.O. #14

CONNECTION

- 1-24" Sleeve, 15" Long

TEMPORARY FOR TESTING

- 1-24" Plug
- 1-2" Cleanout
- 1-Conc. Block

Sta. 158+31 P.I.

- 1-12" C.I. 1/2 Bend (Bottom Vert.)
- 1-Conc. Block

Sta. 159+38

- 1-24" x 12" C.I. Tee
- 10-LF 16" C.I. Pipe, Class 150
- 1-16" sleeve, 15" Long
- 1-16" 1/2 Bend-000 #7
- 3-LF 16" C.I. Pipe Class 150

TEMP. FOR TESTING


- 1-16" Plug
- 1-2" Cleanout
- 1-Conc. Block

ADJUST

- 2-20" M.H. Frame & Cover TO BE RELOCATED
- 2-24" BGGV 1/4" By-Pass, 150#
- 1-12" G.V. 150#
- 1-20" M.H. Frame & Cover
- DEMOLISH
- 2-Type "A" M.H.
- 1-Type "B" M.H.

ADJUST

- Type "A" WMM Top Slab
- Incl. Frames & Covers

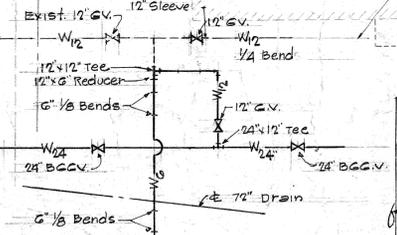

CONNECTION DETAIL @ Sta. 161+05

APPROVED
[Signature]
 ASSISTANT CHIEF ENGINEER, BWS
 DATE: 9-12-66

[Signature]
 DIRECTOR, DIVISION OF SEWERS
 DATE: 2-2-65

STATE OF HAWAII
 DEPARTMENT OF TRANSPORTATION
 HIGHWAYS DIVISION

UTILITIES
 WATER AND SEWER


INTERSTATE HIGHWAY (LUNALILO FWY.)
 FAI PROJ. No. I-HI-1(6) UNIT 3

SCALE: 1" = 20'
 DATE: FEB. 1966
 SHEET No. 4 OF 17 SHEETS

DATE	BY
DESIGNED BY	BY
CHECKED BY	BY
NO.	

FED. ROAD DIST. NO.	STATE	FED. AID PROJ. NO.	FISCAL YEAR	SHEET NO.	TOTAL SHEETS
HAWAII	HAW.	PH-111(6) UNIT 3	1966	69	235

STAR OF THE SEA CHURCH AND SCHOOL

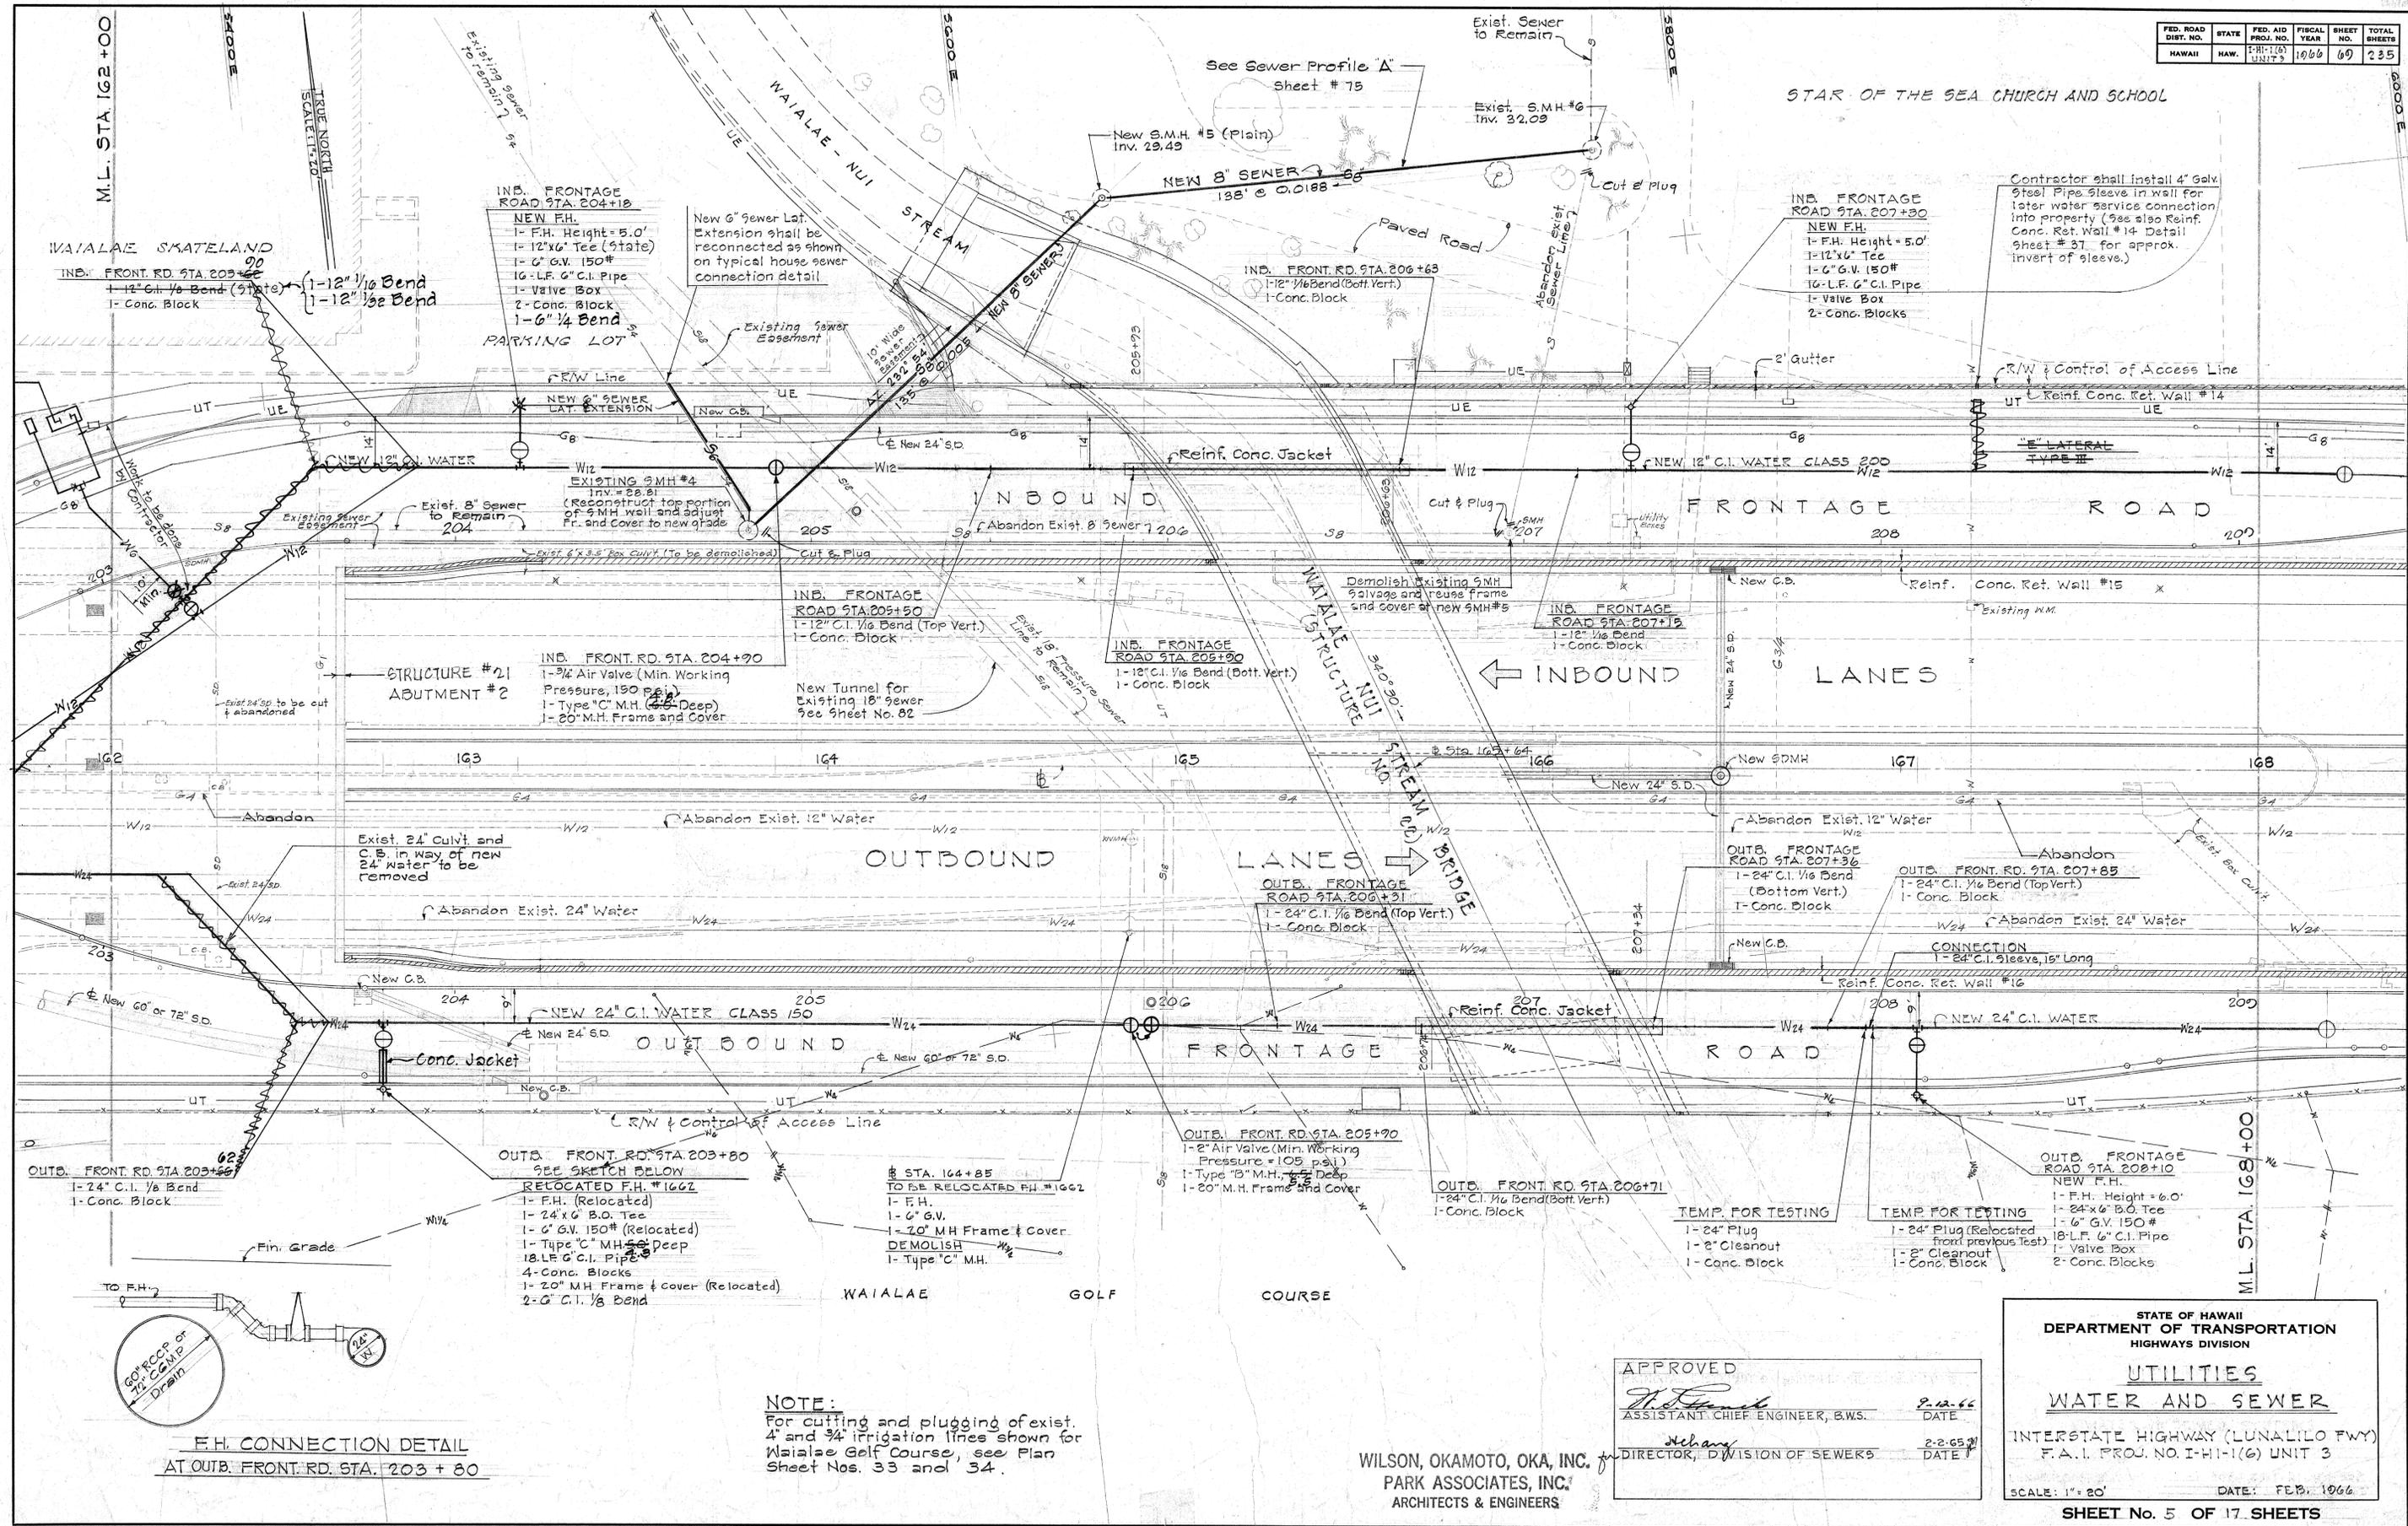

SURVEY PLOTTED BY	DATE
DRAWN BY	DESIGNED BY
NOTE BOOK	QUANTITIES BY
	CHECKED BY

F.H. CONNECTION DETAIL
AT OUTB. FRONT. RD. STA. 203+80

NOTE:
For cutting and plugging of exist. 4" and 3/4" irrigation lines shown for Waialae Golf Course, see Plan Sheet Nos. 33 and 34.

WILSON, OKAMOTO, OKA, INC.
PARK ASSOCIATES, INC.
ARCHITECTS & ENGINEERS

APPROVED
[Signature]
ASSISTANT CHIEF ENGINEER, B.W.S.
DATE: 2-12-66

[Signature]
DIRECTOR, DIVISION OF SEWERS
DATE: 2-2-65

STATE OF HAWAII
DEPARTMENT OF TRANSPORTATION
HIGHWAYS DIVISION

UTILITIES
WATER AND SEWER

INTERSTATE HIGHWAY (LUNALILO FWY)
F.A.I. PROJ. NO. I-111(6) UNIT 3


SCALE: 1" = 20'
DATE: FEB. 1966

SHEET No. 5 OF 17 SHEETS

FINAL SURVEY
 DATE: _____
 BY: _____
 CHECKED: _____
 NO. _____

ORIGINAL SURVEY
 DATE: _____
 BY: _____
 CHECKED: _____
 NO. _____

NOTE:
 WATER MAIN PROFILES ARE DRAWN "STATION WISE" TO BASELINE OR FRONTAGE ROAD STATIONS. HOWEVER, PROFILES HAVE BEEN SHOWN ALONG THE PIPE WHEREVER POSSIBLE.

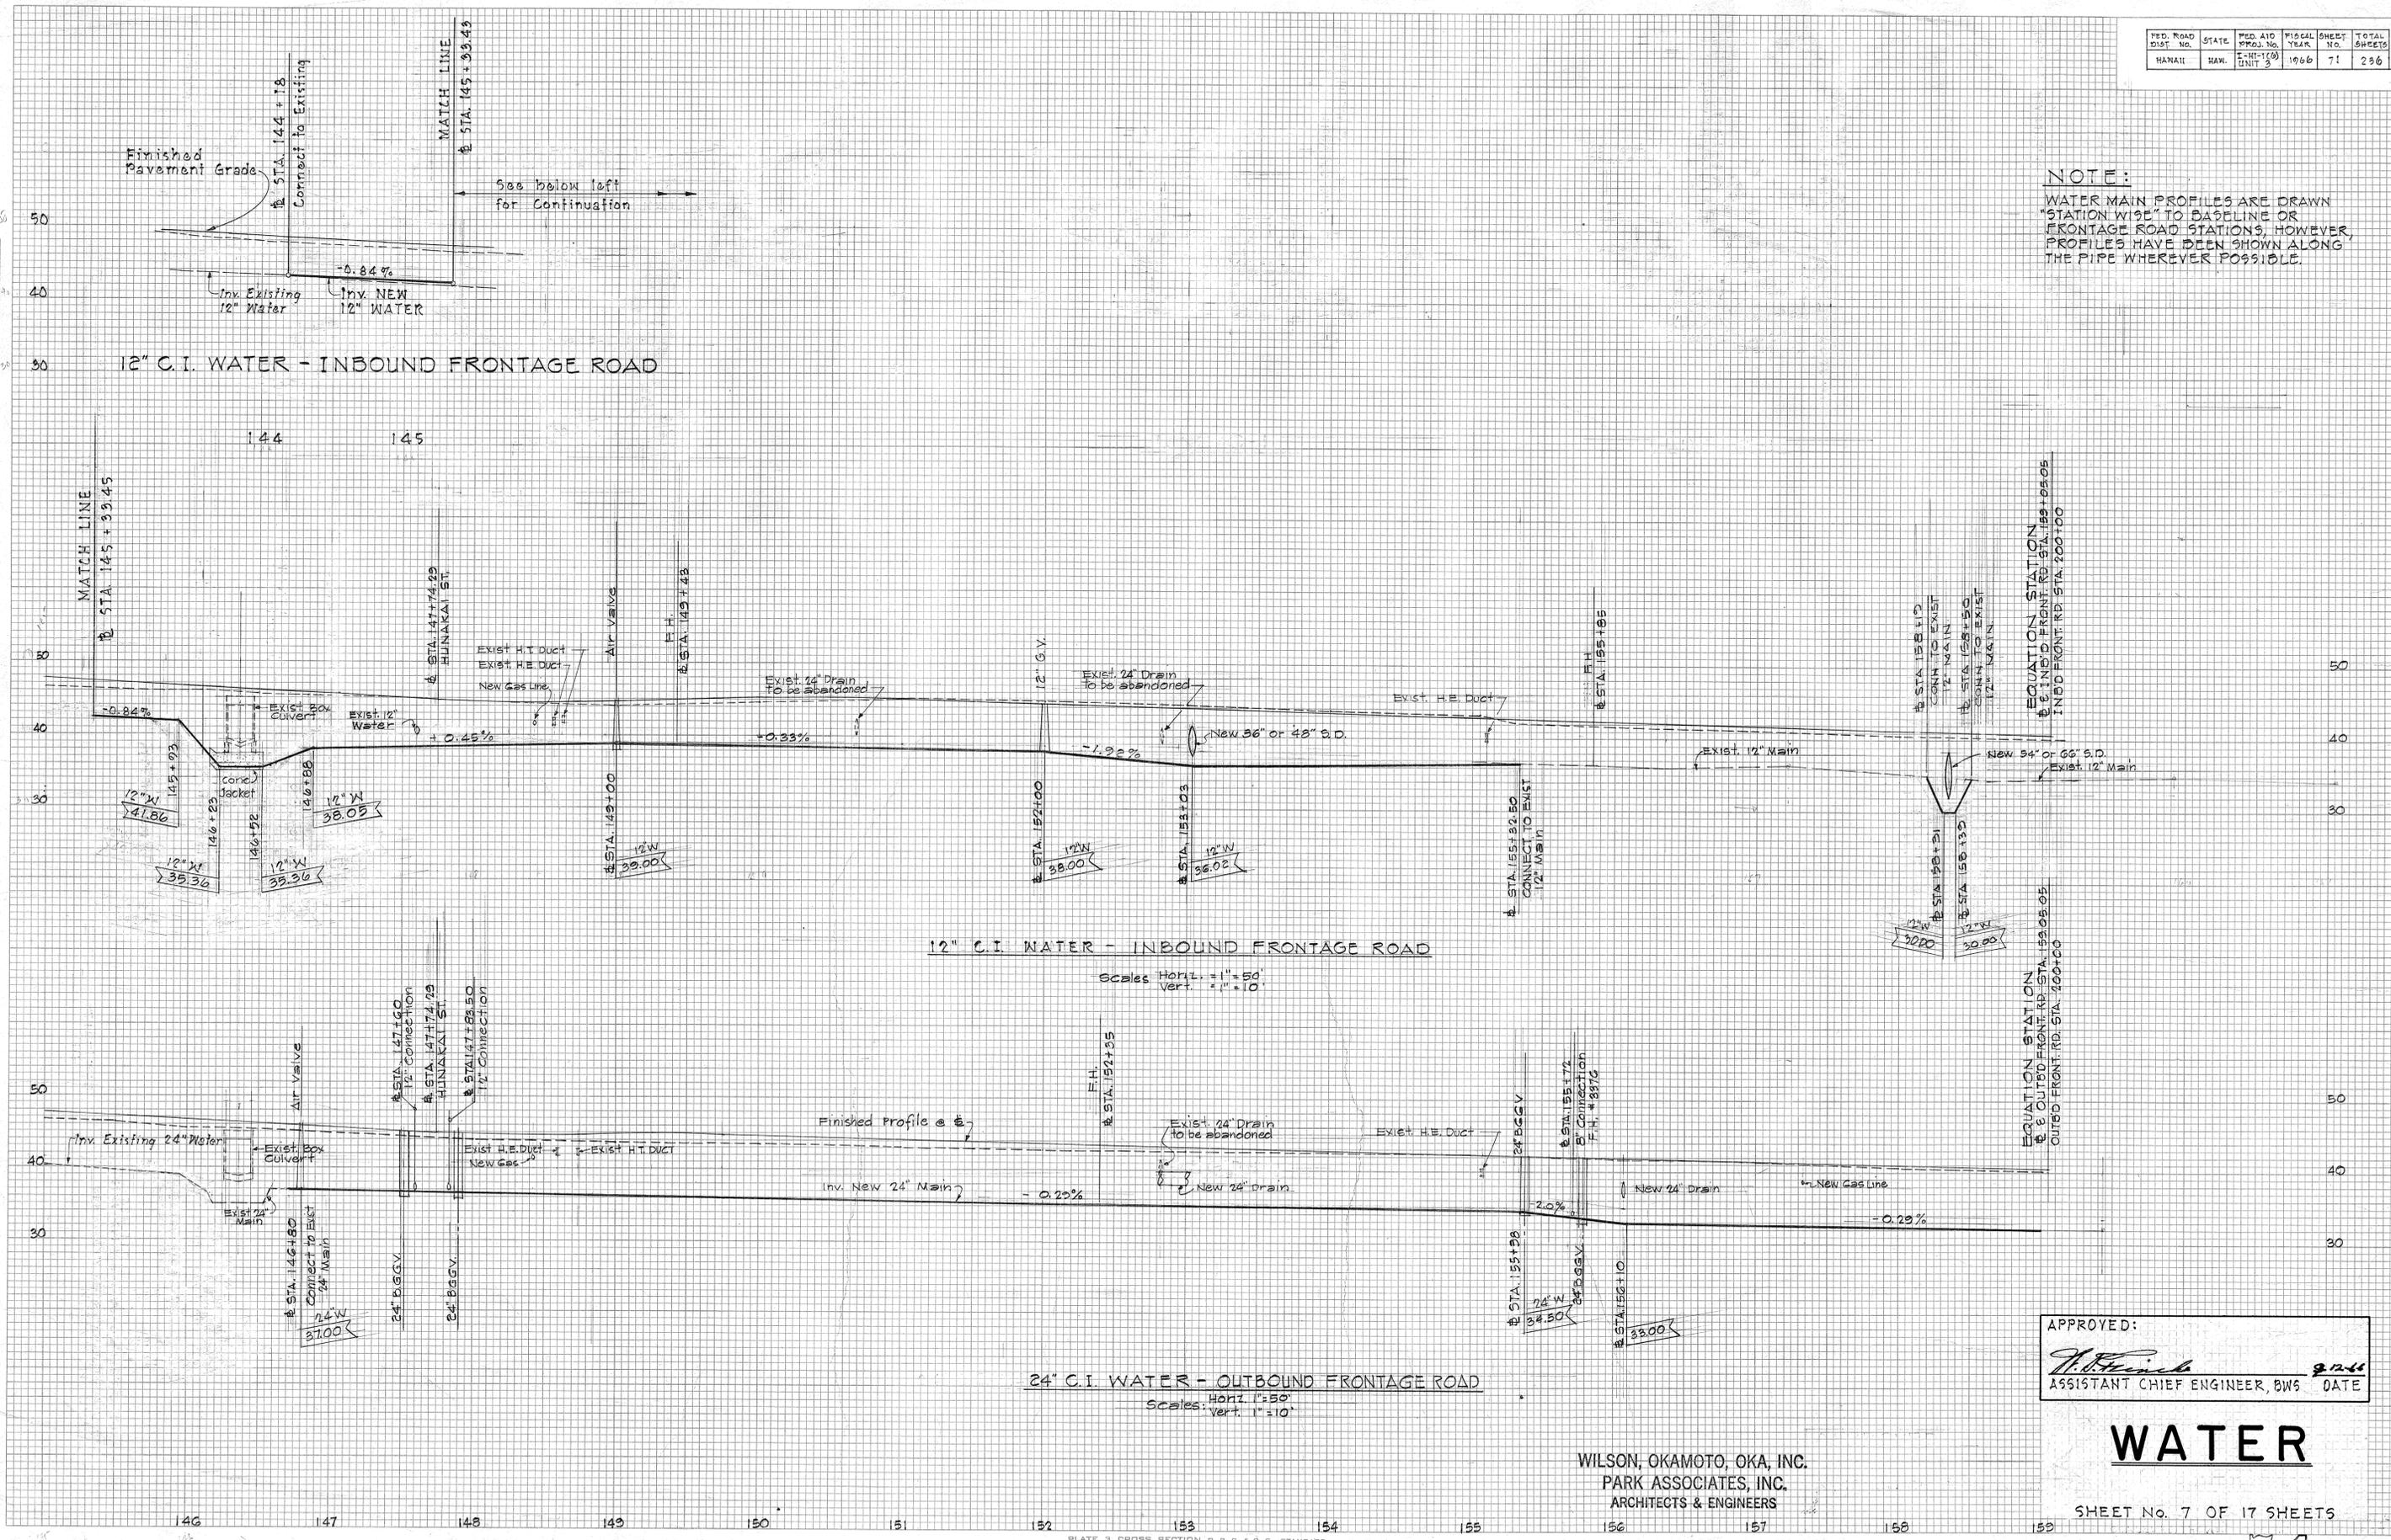

12" C.I. WATER - INBOUND FRONTAGE ROAD
 Scales: Horiz. 1"=50'
 Vert. 1"=10'

24" C.I. WATER - OUTBOUND FRONTAGE ROAD
 Scales: Horiz. 1"=50'
 Vert. 1"=10'

APPROVED:
H. O. Smith
 ASSISTANT CHIEF ENGINEER, BWS DATE


WILSON, OKAMOTO, OKA, INC.
 PARK ASSOCIATES, INC.
 ARCHITECTS & ENGINEERS

WATER

SHEET No. 7 OF 17 SHEETS


FED. ROAD DIST. NO.	STATE	FED. AID PROJ. NO.	FISCAL YEAR	SHEET NO.	TOTAL SHEETS
HAWAII	HAW.	1-11-100	1966	72	235

- NOTE:**
1. WATER MAIN PROFILES ARE DRAWN "STATION WISE" TO BASELINE OR FRONTAGE ROAD STATIONS, HOWEVER, PROFILES HAVE BEEN SHOWN ALONG THE PIPE WHEREVER POSSIBLE.
 2. FOR DETAILS OF PIPE AND CONCRETE JACKET PASSING UNDER FOOTINGS OF STRUCTURES NO. 22 AND NO. 23, SEE STRUCTURE DRAWINGS.

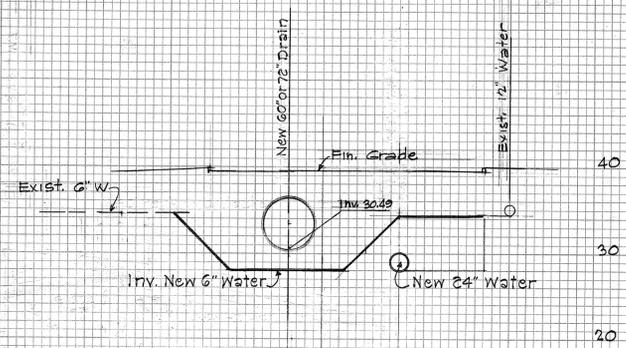

LINE W-4 @ STA 101+05

SCALE: Horiz. 1" = 10'
Vert. 1" = 10'

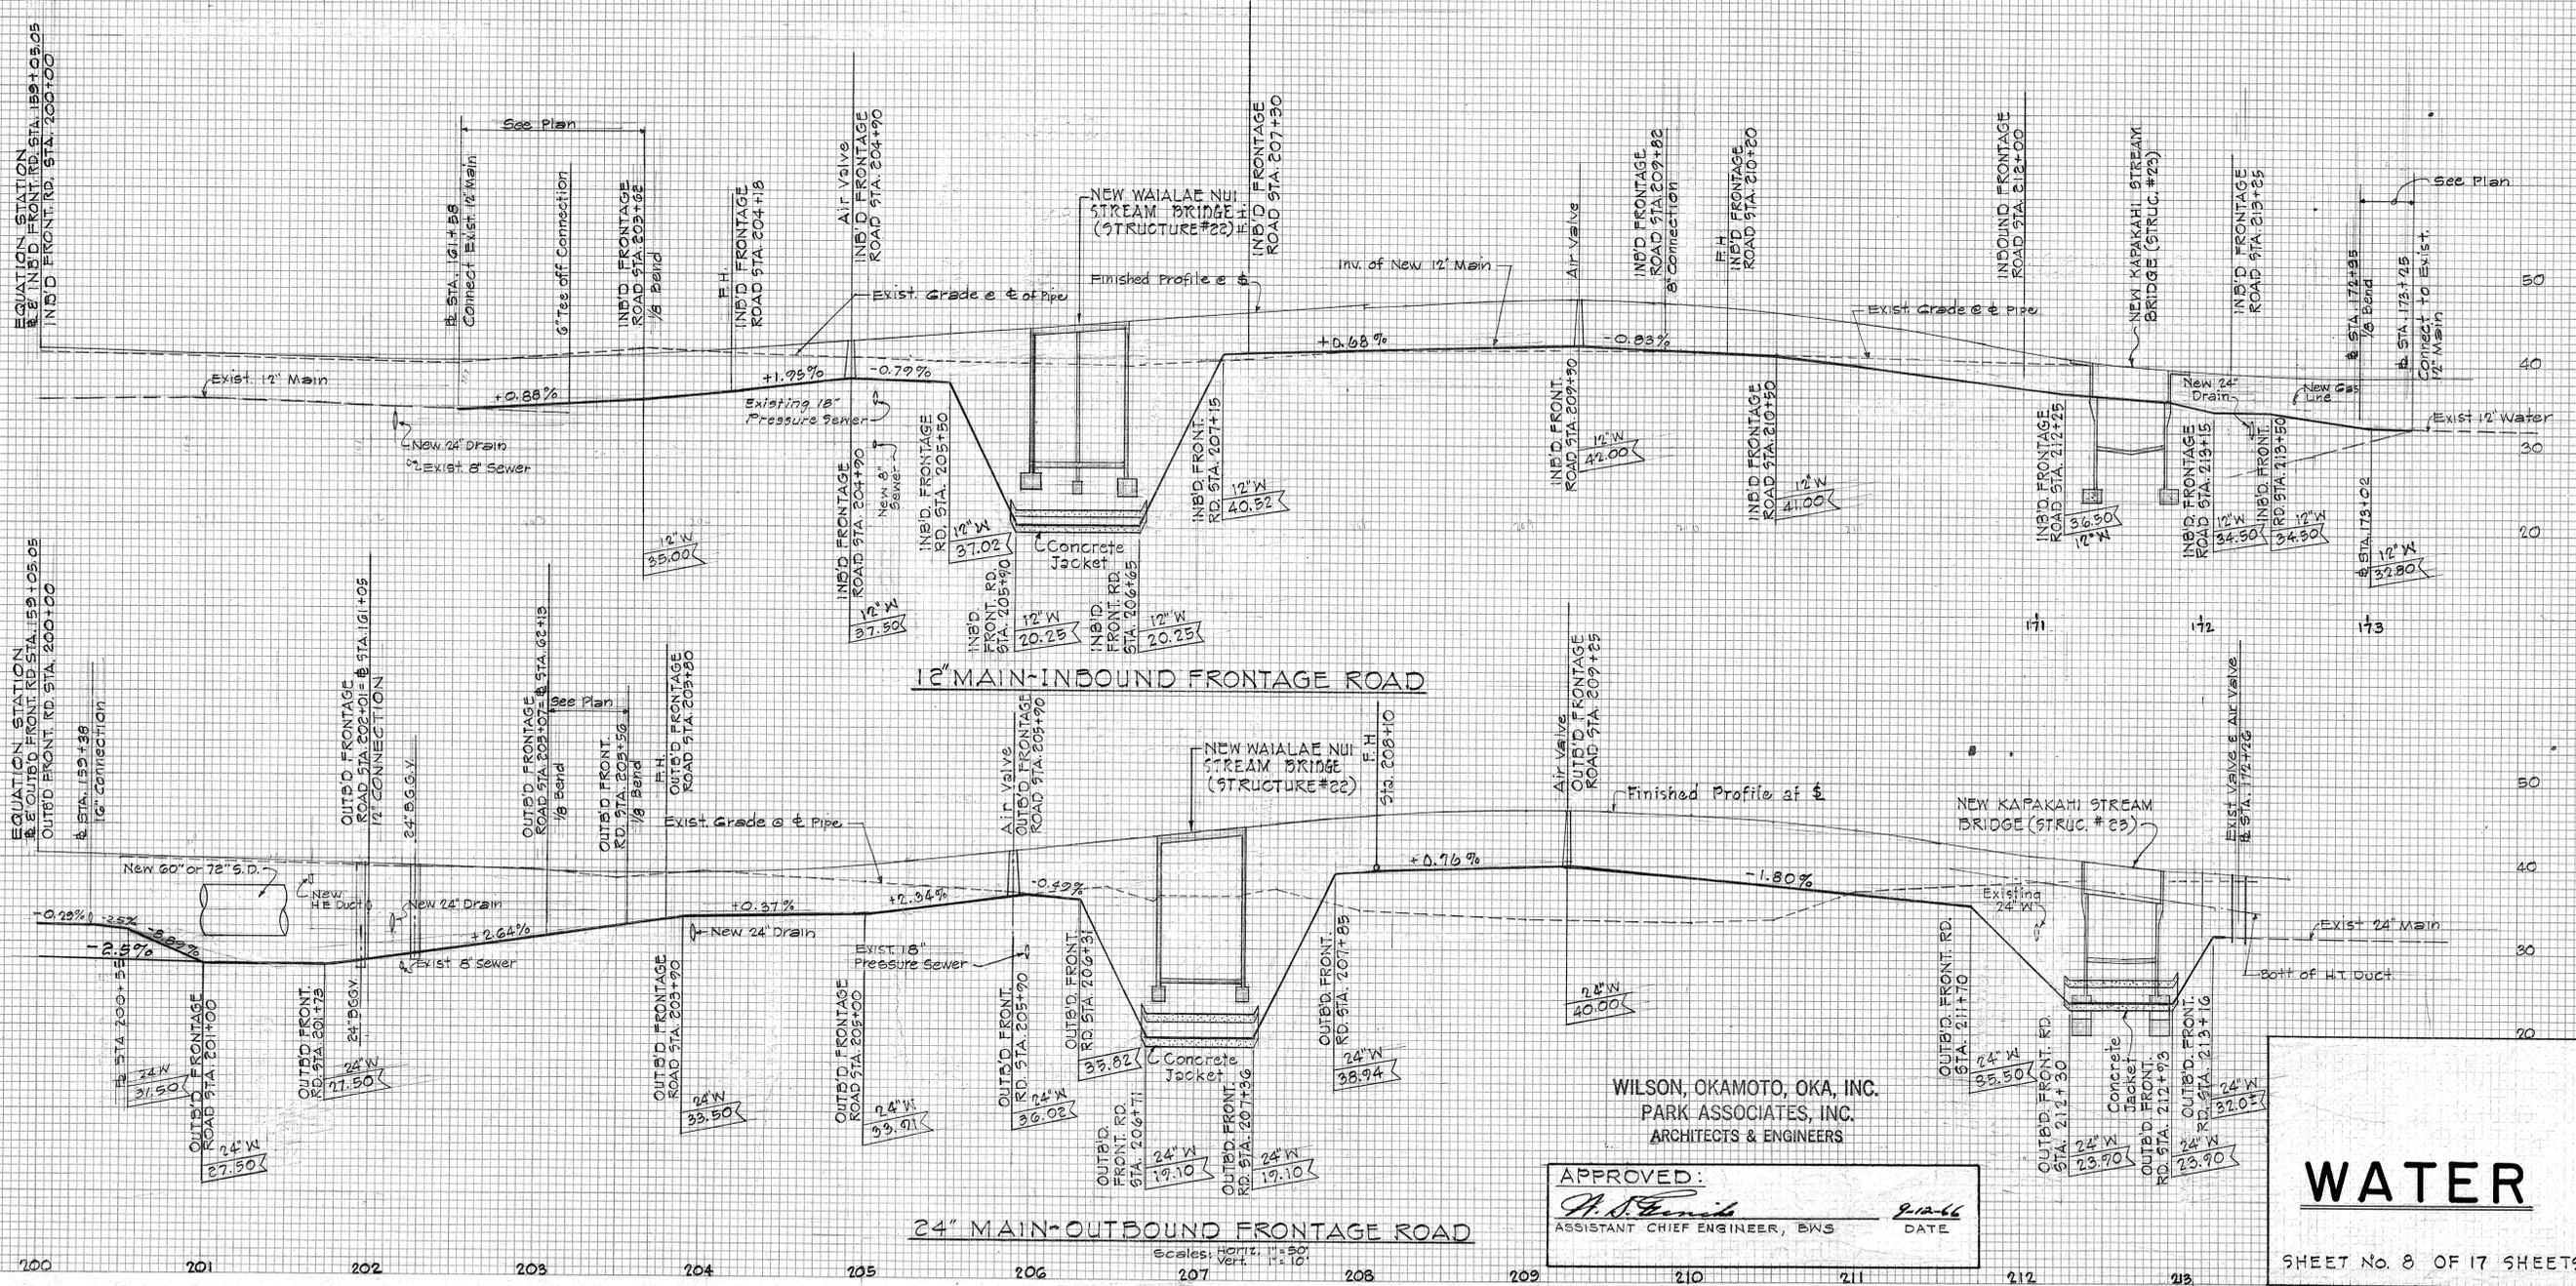

WILSON, OKAMOTO, OKA, INC.
PARK ASSOCIATES, INC.
ARCHITECTS & ENGINEERS

APPROVED:
H. N. Fenick
ASSISTANT CHIEF ENGINEER, BWS
DATE: 9-12-66


WATER

SHEET No. 8 OF 17 SHEETS


DATE: _____
BY: _____
FINAL SURVEY PLOTTED TEMPLATE NOTE BOOK AREAS CHECKED NO.

DATE: _____
BY: _____
ORIGINAL SURVEY PLOTTED TEMPLATE NOTE BOOK AREAS CHECKED NO.


FED. ROAD DIST. NO.	STATE	FED. AID PROJ. NO.	FISCAL YEAR	SHEET NO.	TOTAL SHEETS
HAWAII	HAW.	I-HI-1(6) UNIT 3	1966	73	235

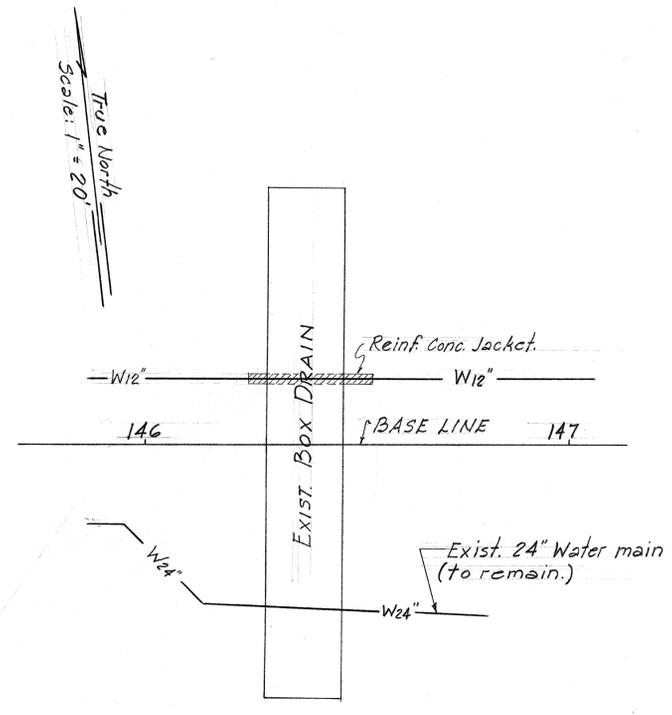

LAYOUT PLAN

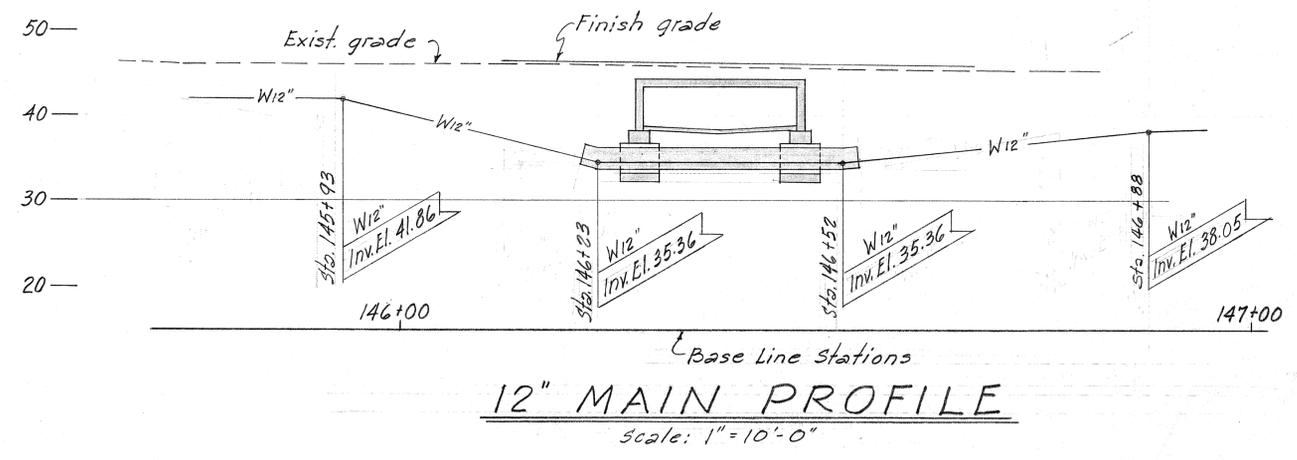


12" MAIN PROFILE
Scale: 1" = 10'-0"

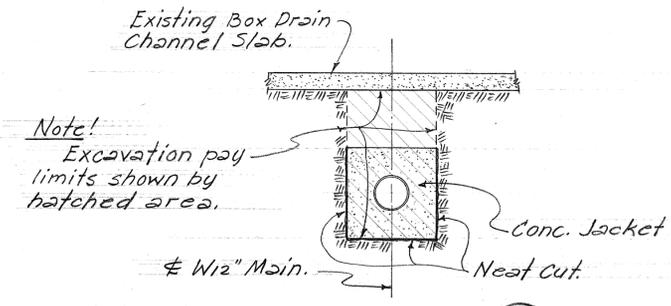

SECTION D
Scale: 3/8" = 1'-0"


NOTE

If any part of the existing invert slab is removed for installation of the 12" main, it shall be restored as much as possible to original condition (with proper reinforcement) as directed by the Engineer. Concrete shall be Class A-1. Materials and labor for removal and restoration of the slab shall be incidental to the various contract items.

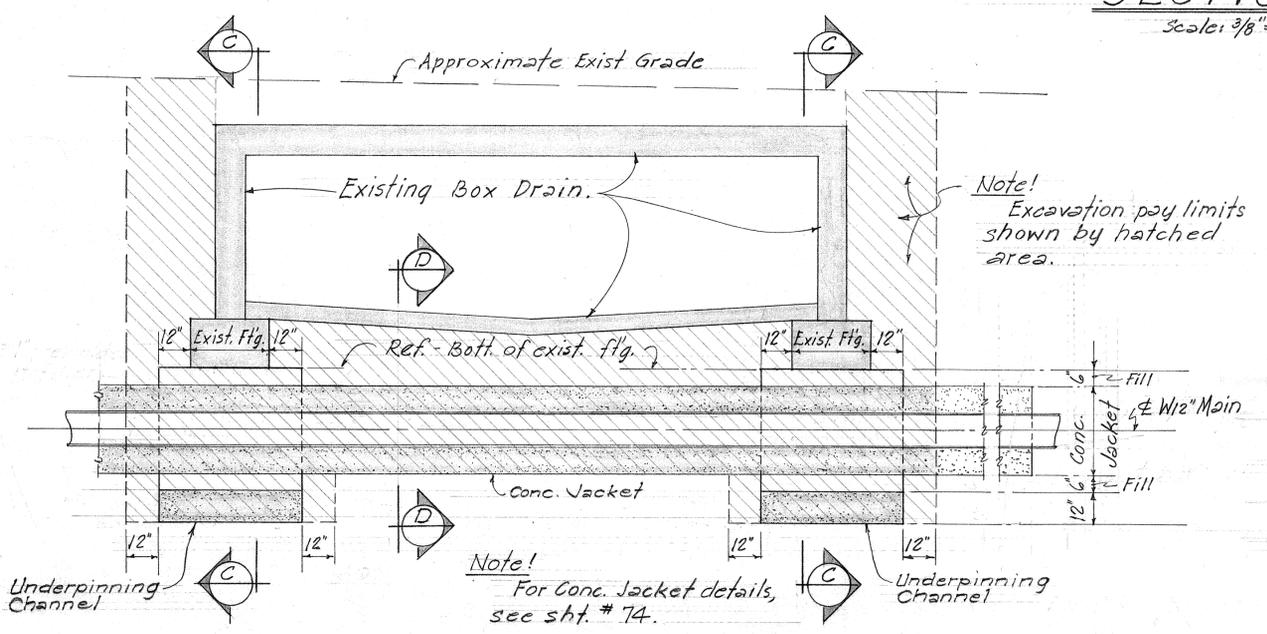

SECTION ALONG # 12" WATER MAIN

Scale: 3/8" = 1'-0"

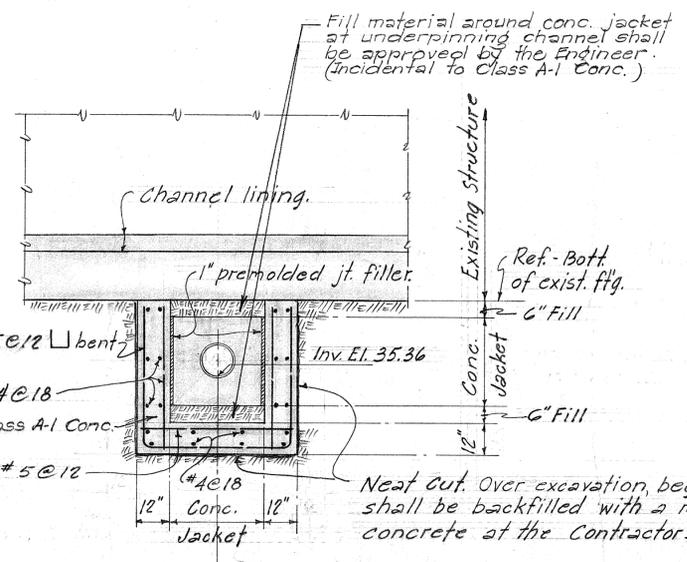


SECTION C
Scale: 3/8" = 1'-0"

APPROVED:
H. Stenick
ASSISTANT CHIEF ENGR, BWS
9-12-66
DATE


STATE OF HAWAII
DEPARTMENT OF TRANSPORTATION
HIGHWAYS DIVISION
DETAILS OF NEW 12" C.I. WATER MAIN UNDER EXIST. 18' x 5.32' BOX CULVERT AT WAIALAE MAJOR STORM DRAIN
INTERSTATE HWY (LUNALILO FREEWAY)
F.A.I. PROJ. NO. I-HI-1(6), UNIT 3
SCALE: AS NOTED
DATE: JULY, 1966

REVISIONS:
DATE 8-22
DRAWN BY J.L.R. 2/21/66
DESIGNED BY X. CHANG
CHECKED BY L.A. F.V.O.
ORIGINAL PLAN
NOTE BOOK
No.


FED. ROAD DIST. NO.	STATE	FED. AID PROJ. NO.	FISCAL YEAR	SHEET NO.	TOTAL SHEETS
HAWAII	HAW.	1-11-10	1966	74	235

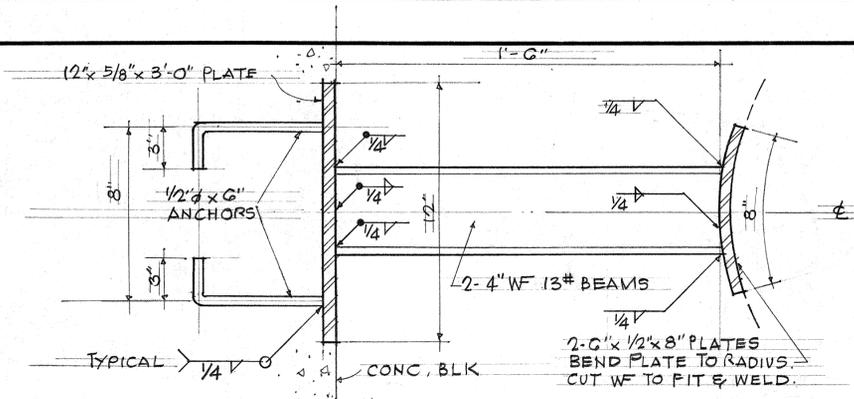

BEAM DETAIL SCALE: 3" = 1'-0"

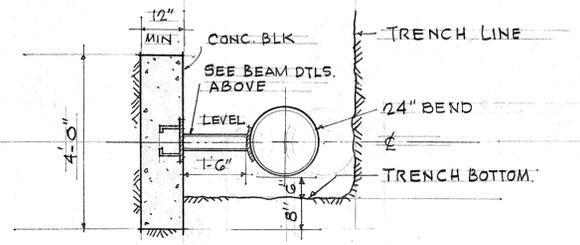

SECTION A SCALE: 1/2" = 1'-0"

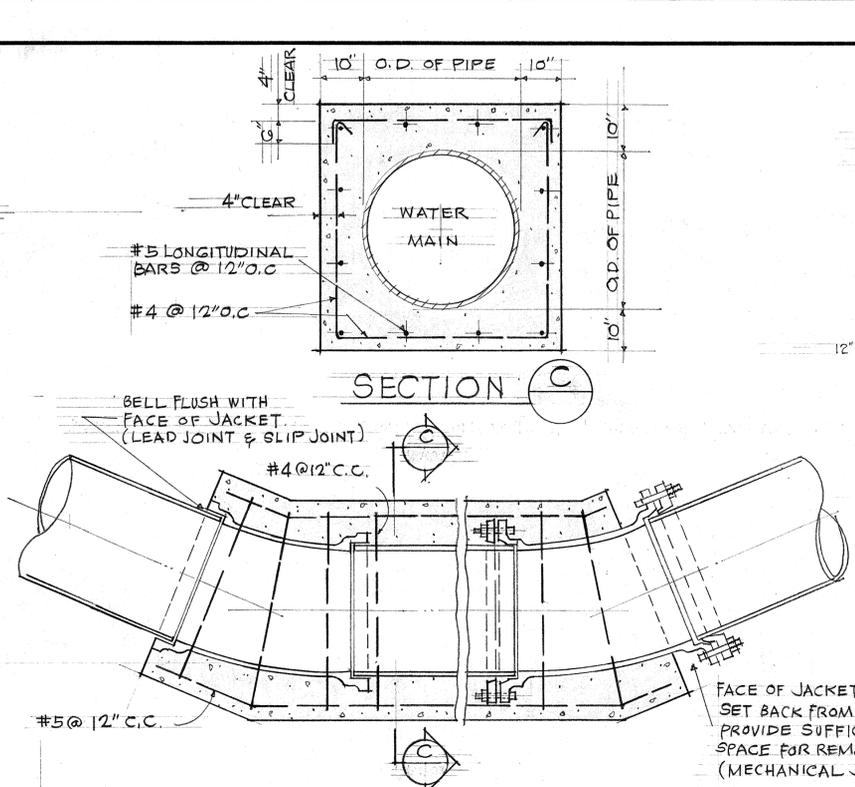

JACKET TO BE POURED AFTER COMPLETION OF TEST. 2 1/2" DEPTH OF LEAD FOR LEAD JOINT PIPE REQUIRED AT ALL EMBEDDED JOINTS. WHEREVER CONSTRUCTION JOINTS ARE REQUIRED G" RUBBER OR NEOPRENE WATERSTOPS SHALL BE INSTALLED. WATERSTOP SHALL BE OF THE TYPE SPECIFIED AND MANUFACTURED BY THE SERVICIZED PRODUCTS CORP., GATE RUBBER CO. OR APPROVED EQUAL.

REINFORCED CONCRETE JACKET


PRECAST CONCRETE REACTION BLOCK

SCALE: 3/4" = 1'-0"


GENERAL NOTES

Typical details of precast concrete reaction blocks are shown. Detail drawings of actual precast blocks and other reaction blocks (not precast) to be used, shall be furnished during construction by B.W.S.


Steel plates, struts, and straps, anchor bolts, nuts, washers, etc., furnished only or furnished and installed by the contractor will not be paid for directly, but shall be considered incidental to the various contract items for the water system.

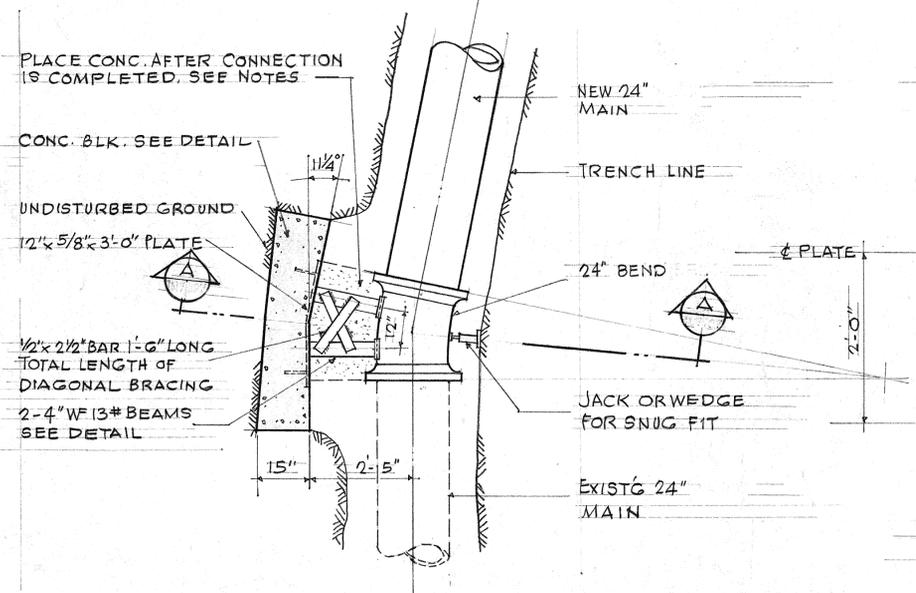

PLAN SCALE: 1/2" = 1'-0"

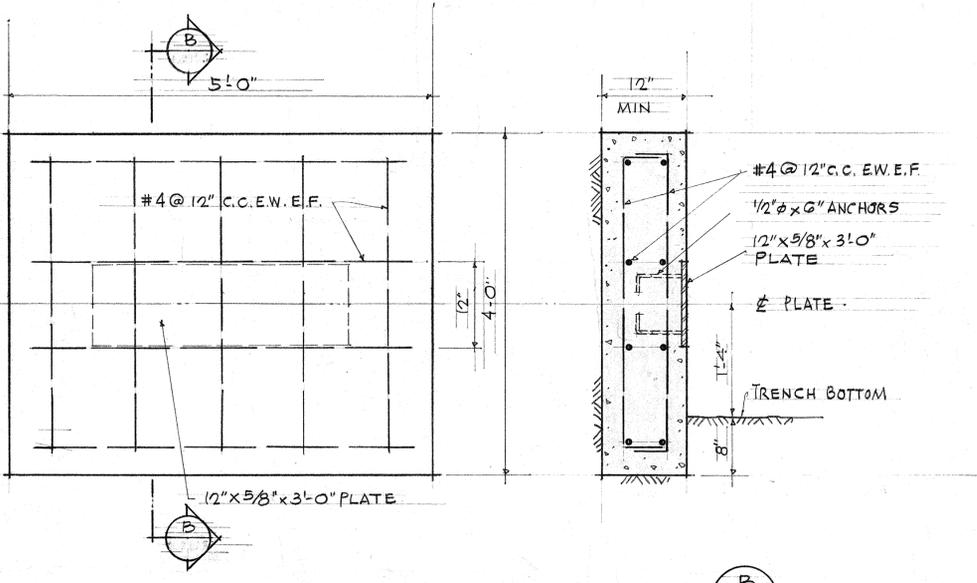

ELEVATION SECTION B DETAILS OF CONCRETE BLOCK SCALE: 1" = 1'-0"

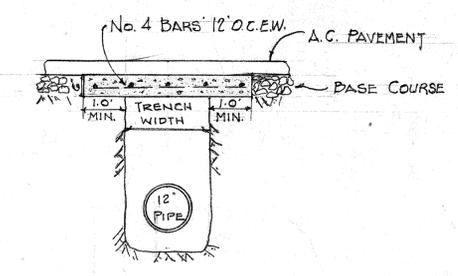

CONC. SLAB DETAIL SCALE: 1/2" = 1'-0"

- NOTES:
- 1 - MINIMUM COVER OVER REINFORCING SHALL BE 3".
 - 2 - CONCRETE SHALL BE CLASS "B-1" 2500 P.S.I.
 - 3 - APPROX CONCRETE YARDAGE OF BLK @ 0.93 C.Y.
 - 4 - DOTTED AREA TO BE FILLED WITH CONC. AFTER CONNECTION IS COMPLETED.

DETAILS-CONCRETE BLOCK WITH STRUCTURAL STRUT. (FOR BENDS AT CONNECTIONS) ALSO: 24" TEE CONNECTIONS

APPROVED
[Signature]
 ASSISTANT CHIEF ENGINEER, B.W.S. DATE

WILSON, OKAMOTO, OKA, INC.
 PARK ASSOCIATES, INC.
 ARCHITECTS & ENGINEERS


STATE OF HAWAII
 DEPARTMENT OF TRANSPORTATION
 HIGHWAYS DIVISION

UTILITIES
 SPECIAL WATER DETAILS


INTERSTATE HIGHWAY (LUNALILO FREEWAY)
 FAJ PROJ. NO. I-41-1(6) UNIT 3

SCALE: AS SHOWN DATE: AUGUST, 1966
 SHEET No. 10 OF 17 SHEETS

DATE
SURVEY PLOTTED BY
FRACED BY
DESIGNED BY
QUANTITIES BY
CHECKED BY
ORIGINAL PLAN
NOTE BOOK
No.

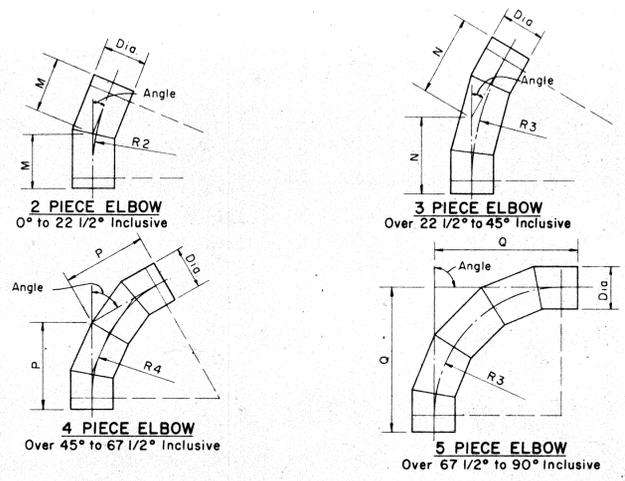


STANDARD FITTING DIMENSIONS													
DIAMETER	ELBOWS (Center to End)										5 Piece (67 1/2° to 90°)		
	TEE		CROSS (Both Ways)		LATERAL (30° to 75°)		2 Piece (up to 22 1/2°)		3 Piece (22 1/2° to 45°)			4 Piece (45° to 67 1/2°)	
	Run J+J	Outlet J	Run J+J	Outlet J	Run X+Y	Outlet Y	M	R2	N	R3		P	R4
16"	34"	17"	34"	62"	52"	12"	60"	18"	44"	26"	39"	34"	
18"	36"	18"	36"	66"	56"	12"	60"	19"	47"	27"	41"	36"	
20"	38"	19"	38"	72"	60"	13"	65"	20"	49"	28"	42"	39"	
22"	40"	20"	40"	78"	66"	13"	65"	21"	51"	30"	45"	41"	
24"	42"	21"	42"	84"	72"	14"	70"	22"	54"	32"	48"	44"	
30"	60"	30"	60"	96"	84"	15"	75"	25"	61"	37"	51"	51"	
36"	66"	33"	66"	110"	96"	16"	80"	27"	66"	40"	60"	56"	

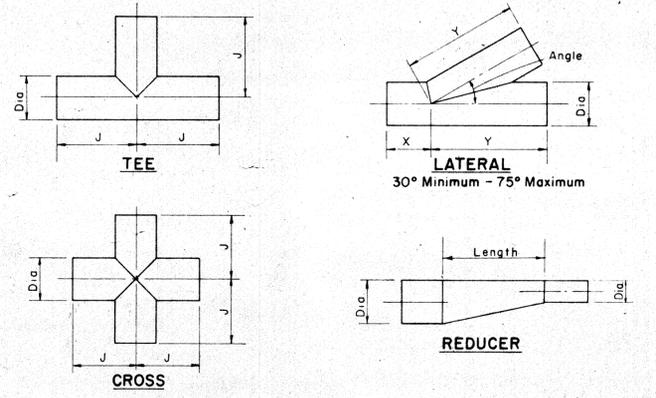


DIMENSIONS FOR ECCENTRIC REDUCER REDUCING SECTION

36" X 30"	Eccentric Reducer - Length 66"
30" X 24"	Eccentric Reducer - Length 66"
24" X 20"	Eccentric Reducer - Length 26"
20" X 16"	Eccentric Reducer - Length 26"

NOTE:
 All dimensions shown are laying lengths.
 All fittings and specials shall be fabricated independent from pipe sections and in accordance with the dimensions shown.
 All fittings and specials shall be all bell unless otherwise noted.
 All tees, wyes, crosses and reducers 16-inch in diameter and larger shall be reinforced with steel ribs or steel crotch plates welded continuously to the cylinder or by other methods to withstand the longitudinal crushing effect caused by the test pressure as called for in the plans.

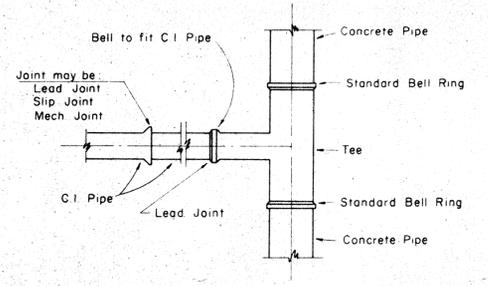


TYPICAL CAST IRON PIPE CONNECTION TO CONCRETE CYLINDER PIPE

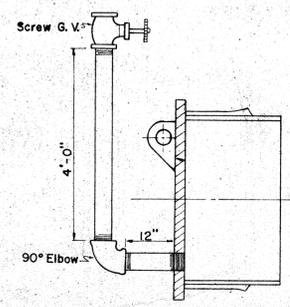


TYPICAL SECTION OF TEMPORARY CLEANOUT


NOTE:
 For Pipe Sizes 12" and Below - 2 1/2" Cleanout
 For Pipe Sizes 16" and Above - 4" Cleanout

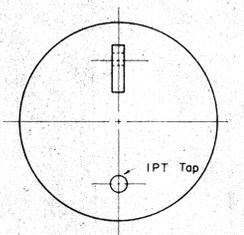


PLAN OF STEEL PLATE

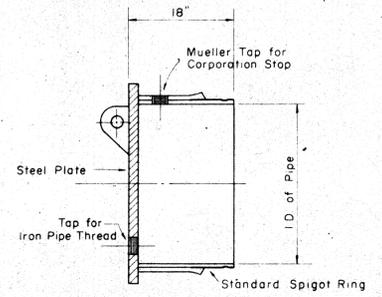


DETAIL OF PLUG

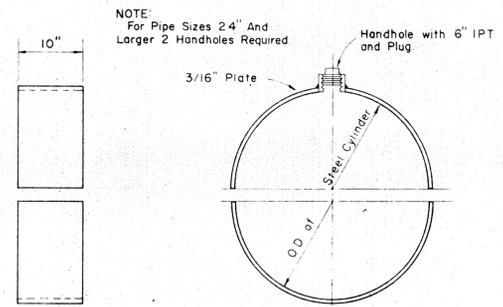


DETAIL OF SPLIT BUTT STRAP

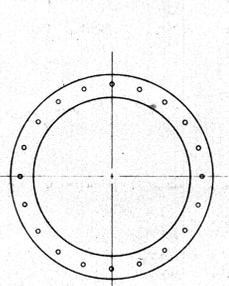


FLANGE
See Specs. for Flange Class

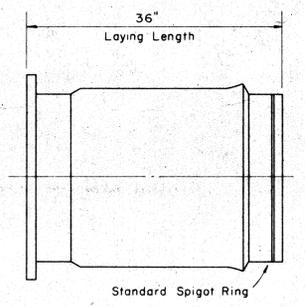


Standard Spigot Ring

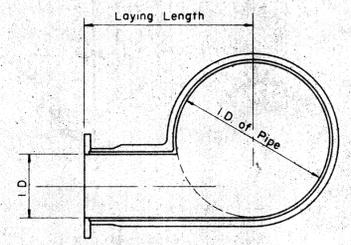


SECTION

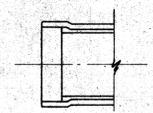


BELL SECTION

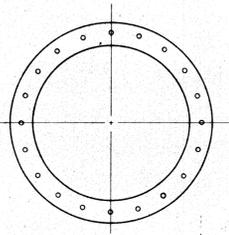


FLANGE
See Specs. for Flange Class

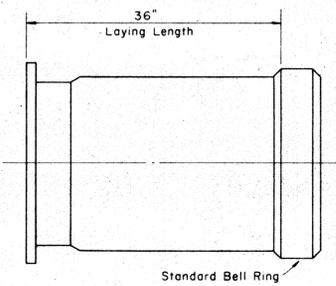


Standard Bell Ring

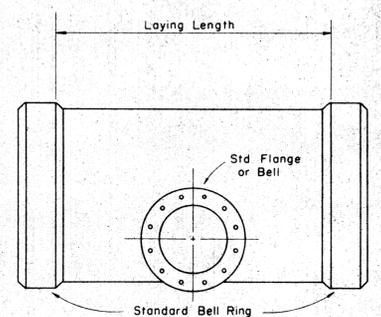

TYPICAL DETAIL OF BLOW-OFF TEE

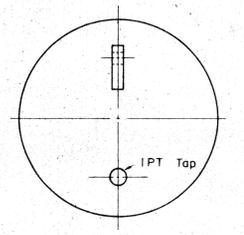

PLAN OF STEEL PLATE

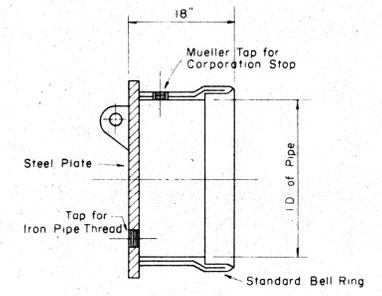

DETAIL OF CAP

TYPICAL DETAIL OF ADAPTER

CONCRETE CYLINDER PIPE MISCELLANEOUS DETAILS

APPROVED: _____ ASSISTANT CHIEF ENGINEER


SCALE: No Scale DATE: April 25, 1968

BOARD OF WATER SUPPLY
HONOLULU, HAWAII

SHEET ___ OF ___ SHEETS FIELD BOOK NO. _____

SURVEYED BY _____
 DRAWN BY L.K.
 TRACED BY L.K.
 ENGINEER _____
 CHECKED BY _____
 FILE _____
 POCKET FOLDER NO. _____

FED. ROAD DIST. NO.	STATE	FED. AID PROJ. NO.	FISCAL YEAR	SHEET NO.	TOTAL SHEETS
HAWAII	HAW.	101-1(6) UNIT 3	1966	75	235

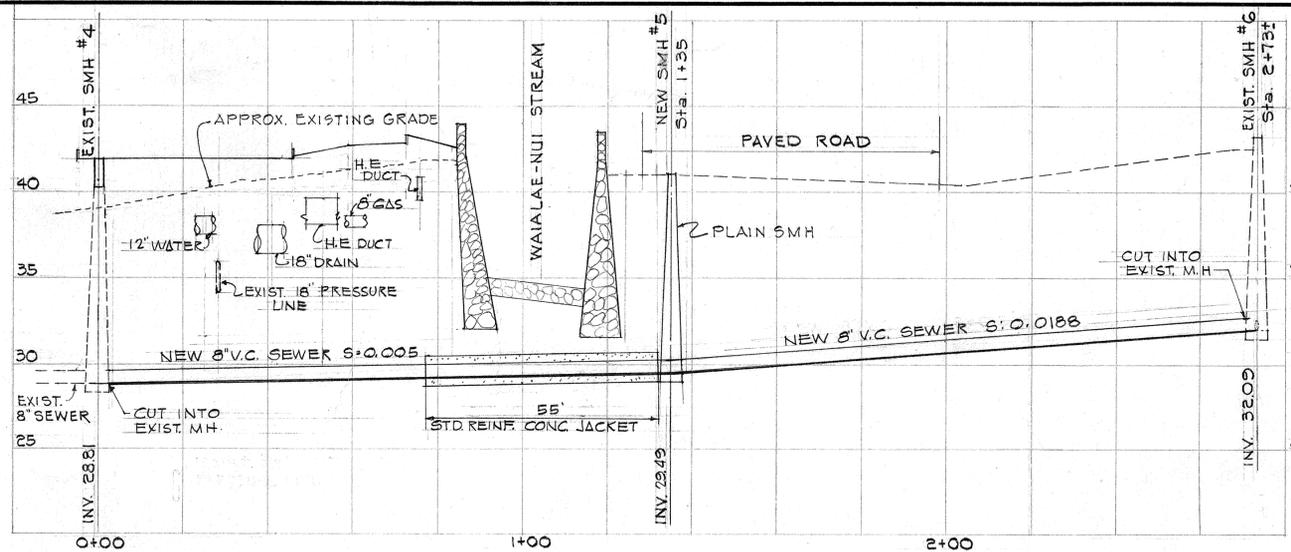


SEWER PROFILE (A)

SCALE: HOR. 1" = 20'
VERT. 1" = 5'


NOTE:

CONSTRUCTION OF SEWER STRUCTURES SHALL CONFORM TO CITY & COUNTY OF HONOLULU, DIVISION OF SEWER STANDARDS.

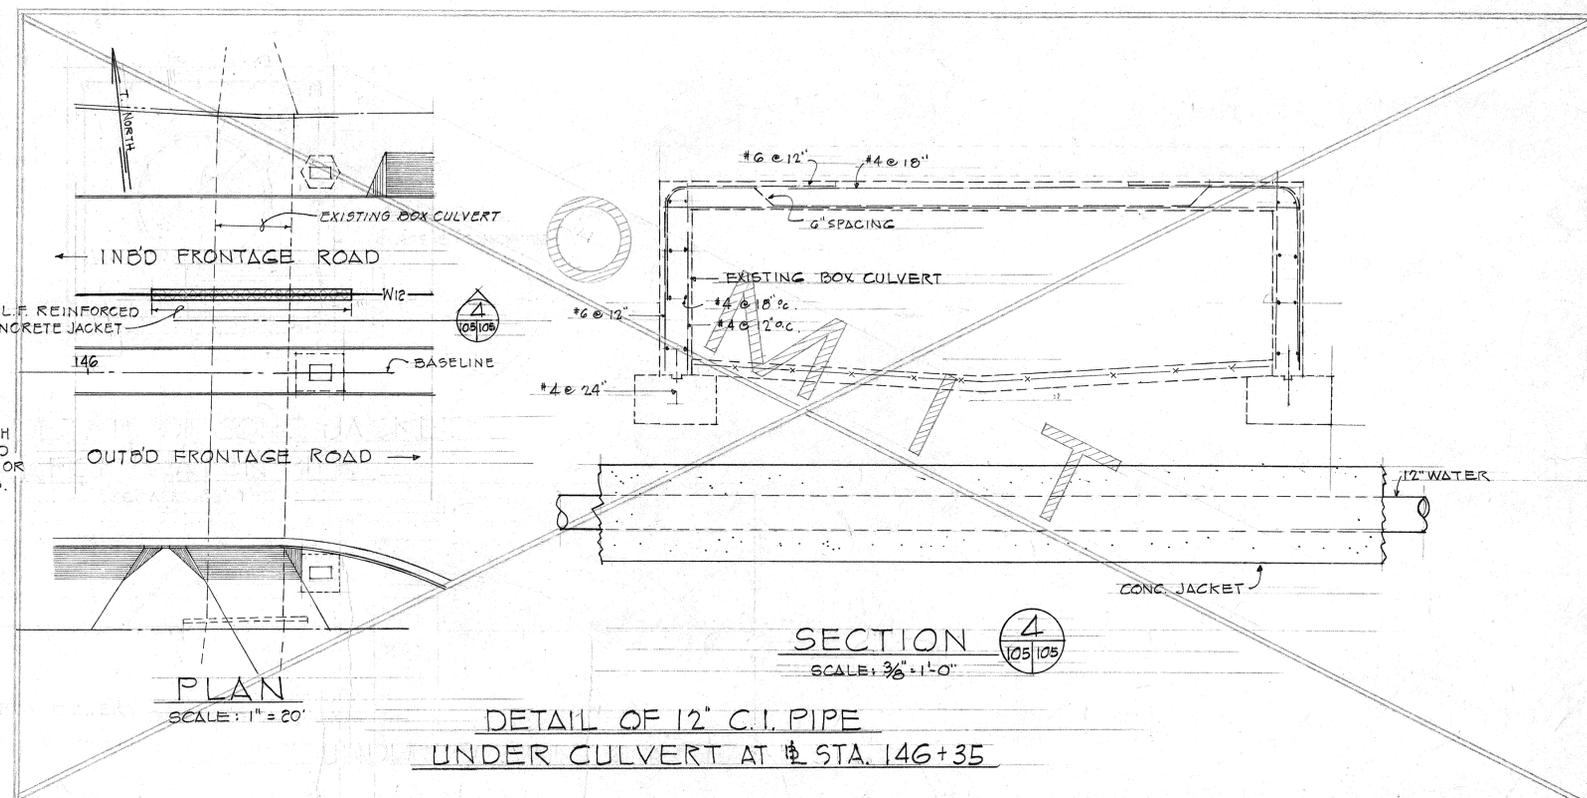

SECTION (4)
SCALE: 3/8" = 1'-0"

DETAIL OF 12" C.I. PIPE UNDER CULVERT AT STA. 146+35

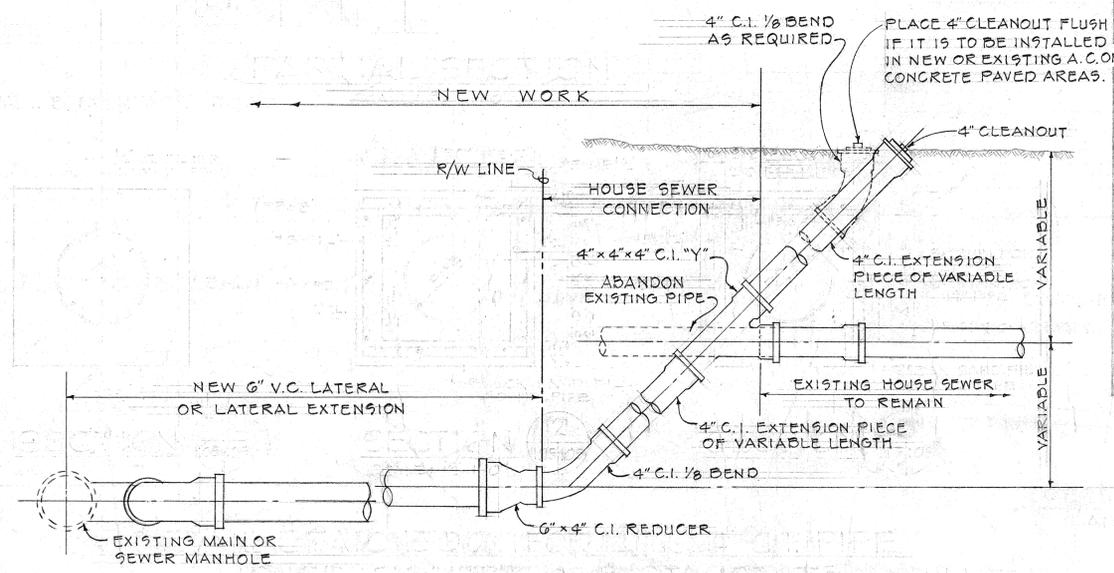

TYPICAL DETAIL OF HOUSE SEWER CONNECTION

SCALE: 3/4" = 1'-0"

SURVEY PLOTTED BY	DATE
DESIGNED BY	
NOTED BY	
CHECKED BY	
DATE	


APPROVED: *Helene*
DIRECTOR, DIVISION OF SEWERS
DATE: 2-2-66

WILSON, OKAMOTO, OKA, INC.
PARK ASSOCIATES, INC.
ARCHITECTS & ENGINEERS


STATE OF HAWAII
DEPARTMENT OF TRANSPORTATION
HIGHWAYS DIVISION
UTILITIES
SEWER PROFILE (A)
AND
MISC. DETAILS
INTERSTATE HIGHWAY (LUNALILO FREEWAY)
FAI PROJ. NO. I-HI-1(6) UNIT 3
SCALE: AS SHOWN DATE: FEB. 1966
SHEET No. 11 OF 17 SHEETS

FED. AID DIST. NO.	STATE	FED. AID PROJ. NO.	FISCAL YEAR	SHEET NO.	TOTAL SHEETS
HAWAII	HAWAII	I-HI-1(6) UNIT 3	1966	76	235


NOTE:
Contractor to furnish 1/2" brass plug (Tapered thread) to replace corporation stop upon completion of chlorination.

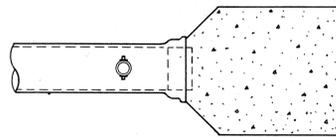

TOP VIEW

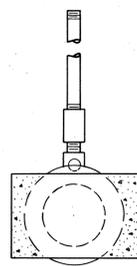


END VIEW

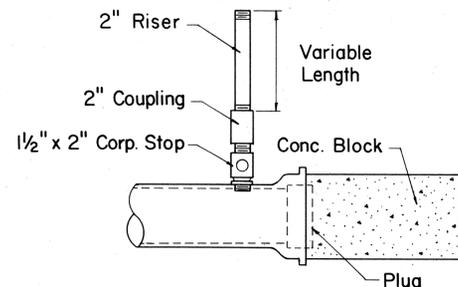


SIDE VIEW


DETAIL OF TEMPORARY 2" CLEANOUT
Not to Scale

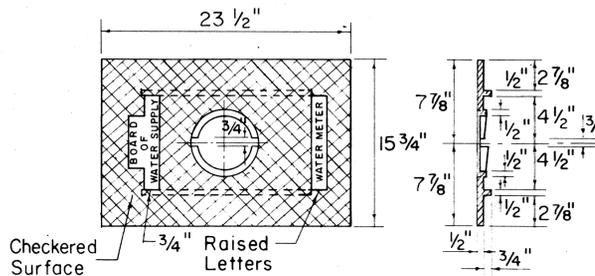


COVER PLATE

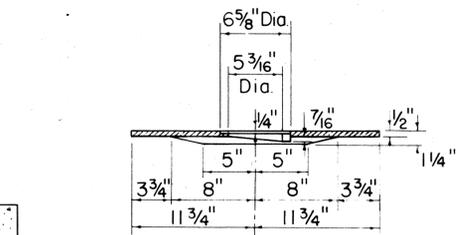

FRAME CAST IRON FRAME AND PLATE TYPE II
Scale: 1 1/2" = 1'-0"


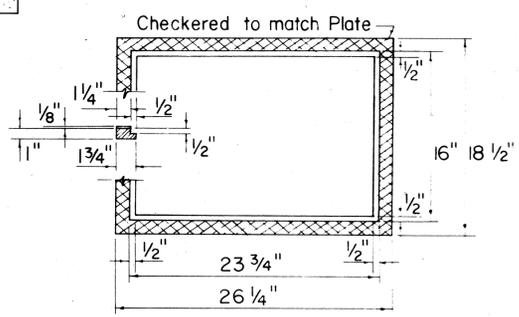


CAST IRON FRAME AND PLATE TYPE II

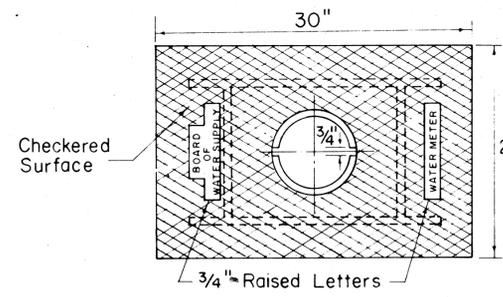

COVER PLATE

CAST IRON FRAME, PLATE AND COVER TYPE III
Scale: 1 1/2" = 1'-0"

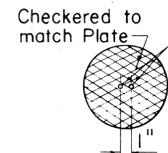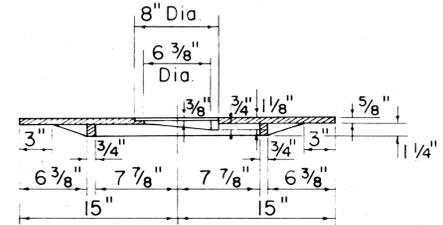


FRAME


READING COVER

FRAME

READING COVER

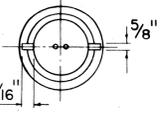

CAST IRON COVER FOR TYPE II FRAME
Not to Scale

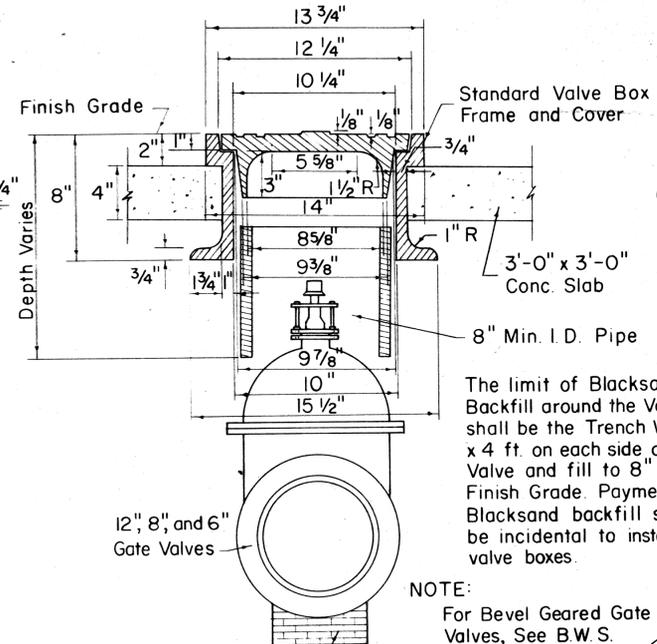


INSTALLATION OF VALVE BOX FOR GATE VALVES
Not to Scale


NOTE:
For Bevel Geared Gate Valves, See B.W.S. Standard (Detail Sheet filed in B.W.S. Engr. Division)

Concrete Pedestal or Brick Pedestal Cement Mortared Under Valves

The limit of Blacksand Backfill around the Valve shall be the Trench Width x 4 ft. on each side of Valve and fill to 8" below Finish Grade. Payment for Blacksand backfill shall be incidental to installing valve boxes.

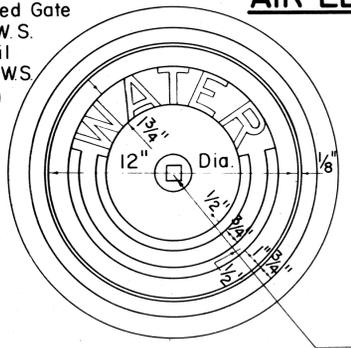


CAST IRON FRAME AND COVER
Scale: 3" = 1'-0"

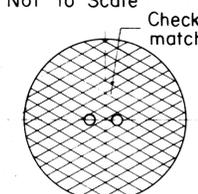


READING COVER

CHECKERED PATTERN

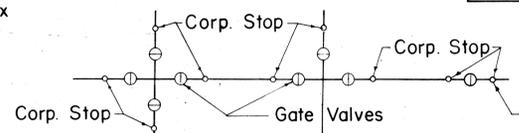

CORP. STOP LAYOUT
Not to Scale


Size of one Corp. Stop given in Table "A". Extra Corp. Stop required at valves located on the "run" shall be 1" x 1 1/4" for all sizes of pipes and shall be installed as directed by the Engineer.

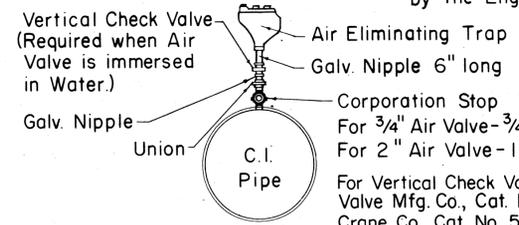

DETAIL OF CONNECTION FOR AIR ELIMINATING TRAP
Not to Scale

Offset word "WATER" 1 3/4" high, 1/8" deep

NOTE:
All castings shall be made accurately to the dimensions shown. Seat and Cover shall be ground where necessary to secure flat and true surfaces. The Cover shall not rattle in any position.
Minor changes in dimensions may be made to suit foundry conditions provided such changes are approved by the Board of Water Supply.

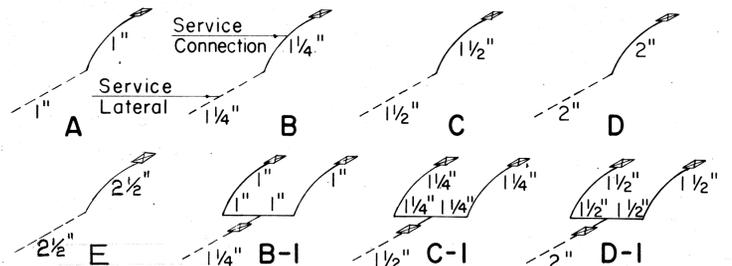

TYPICAL LAYOUT OF SERVICE LATERALS AND CONNECTIONS
Not to Scale

APPROVED:


[Signature]
ASSISTANT CHIEF ENGINEER
BOARD OF WATER SUPPLY
DATE: 9-12-66

STATE OF HAWAII
DEPARTMENT OF TRANSPORTATION
HIGHWAYS DIVISION
BOARD OF WATER SUPPLY
CITY & COUNTY OF HONOLULU
STANDARD DETAILS
INTERSTATE HIGHWAY (LUNALILO FRWY)
F.A.I. PROJ. NO. I-HI-1(6) UNIT 3
Scale: As Noted Date: Aug. 1966


**SCHEDULE OF COPPER FITTINGS
(SOLDERED JOINT)**

ITEM NO.	DESCRIPTION	SINGLE SERVICE CONN.	MULTIPLE SERV. CONN.	
			TWO SERVICES	THREE SERVICES
1	Corporation Stop Brass (H-10003)	1	1	1
2	Ground Joint Union (Style Copper To N.P.T.E. No. C-109)	1	1	1
3	Adapter, Copper To N.P.T.E. (Style No. C-101)	2	1	1
4	Stopcock Brass (BWS Standard)	1	1	1
5	Fitting Adapter, (Style Fitting To N.P.T.E. No. C-104)	-	1	1
6	Tee, Copper To Copper To Copper (Style No. T-300)	-	1	1
7	Bushings, Fitting To Copper (Style No. C-103)	-	2	2
8	90° Elbow, Copper To Copper (Style No. C-200)	-	2	2
9	Adapter, Copper To N.P.T.E. (Style No. C-101)	1	2	3
10	Stopcock Brass (BWS Standard)	1	2	3
11	Reducing Tee, Copper To Copper To Copper (Substitute For Items Number 6 and 7). (Style No. T-300)	-	1	1
12	Tee, Copper To Copper To Copper (Style No. T-300)	-	-	1
13	Bushing, Fitting To Copper (Style No. C-103)	-	-	1
14	Reducing Tee, Copper To Copper To Copper (Substitute For Items Number 12 and 13) (Style No. T-300)	-	-	1

NOTE:
Reference Numbers shown thus (H-10003) are from Mueller Co. Catalog "H" and (Style No. T-300) are from Mueller Brass Co. "Streamline" Catalog S-354. Approved Equal may be used.

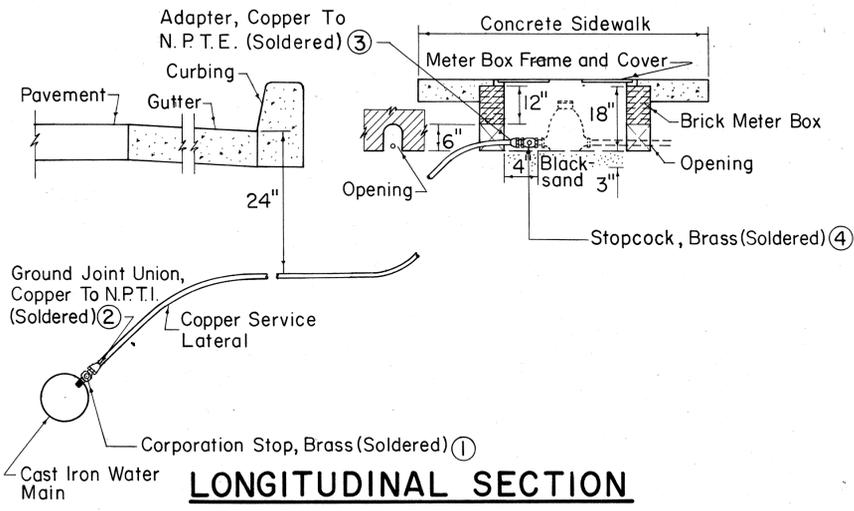


LONGITUDINAL SECTION

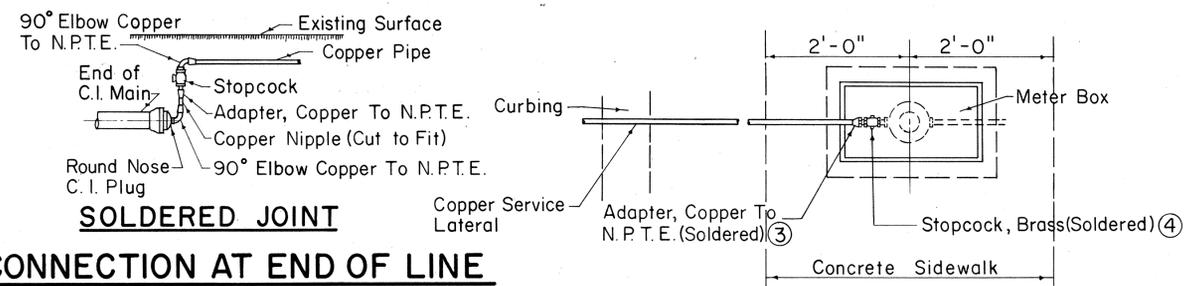

SOLDERED JOINT


SERVICE LATERAL CONNECTION AT END OF LINE

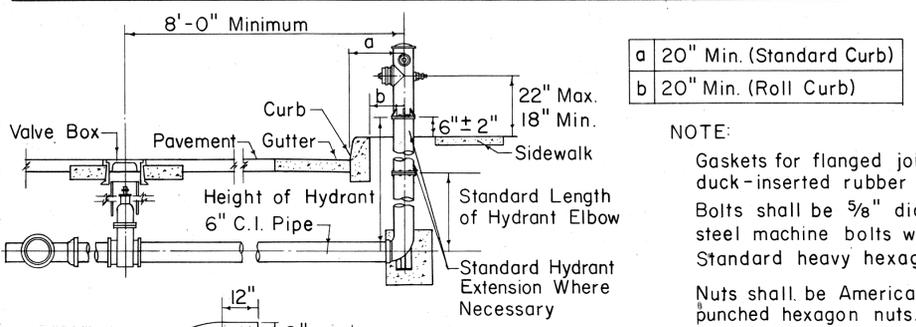

a	20" Min. (Standard Curb)
b	20" Min. (Roll Curb)

NOTE:
Gaskets for flanged joints shall be 1/16 inch duck-inserted rubber packing Garlock No. 19. Bolts shall be 5/8" diameter x 2 3/4" long steel machine bolts with cut threads, American Standard heavy hexagon heads, galvanized. Nuts shall be American Standard heavy cold punched hexagon nuts, galvanized.

SINGLE SERVICE CONNECTION

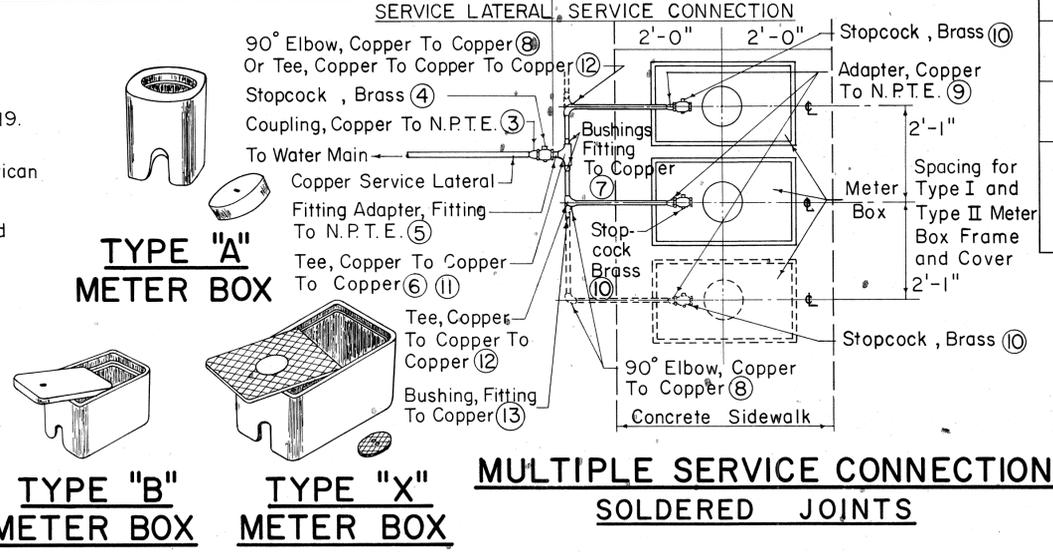

TYPE "A" METER BOX

TYPE "B" METER BOX


TYPE "X" METER BOX

**MULTIPLE SERVICE CONNECTION
SOLDERED JOINTS**

STANDARD LENGTHS FOR HYDRANT ELBOWS

30"
36"
42"
48"

Standard Hydrant Extensions are available in the following Lengths:
6 to 30 inches long in increments of 6 inches

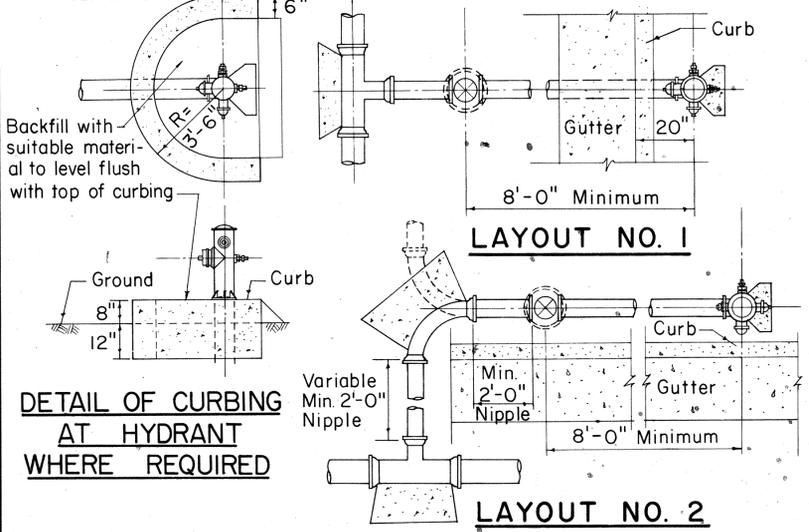

STANDARD FIRE HYDRANT LAYOUT


APPROVED:

H. D. ...
ASSISTANT CHIEF ENGINEER
BOARD OF WATER SUPPLY
DATE 7-12-66


STATE OF HAWAII
DEPARTMENT OF TRANSPORTATION
HIGHWAYS DIVISION
BOARD OF WATER SUPPLY
CITY & COUNTY OF HONOLULU

STANDARD DETAILS


INTERSTATE HIGHWAY (LUNALILO FRWY)
F.A.I. PROJ. NO. I-HI-1(6) UNIT 3
Not to Scale Date: Aug. 1966

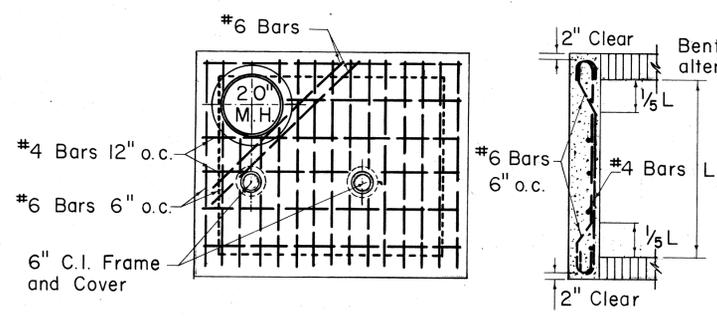

PLAN OF TOP SLAB



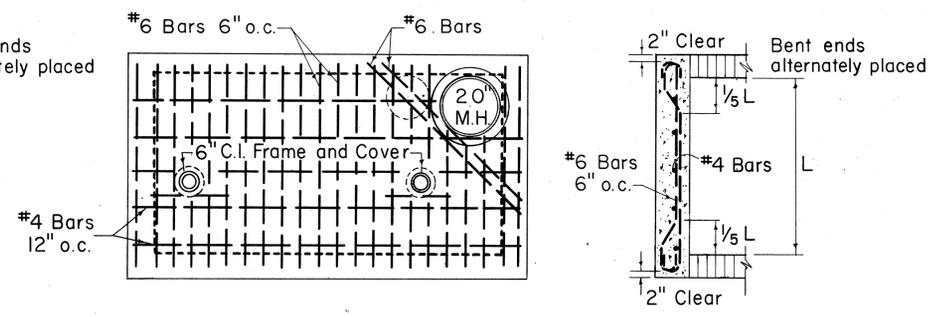


PLAN OF TOP SLAB

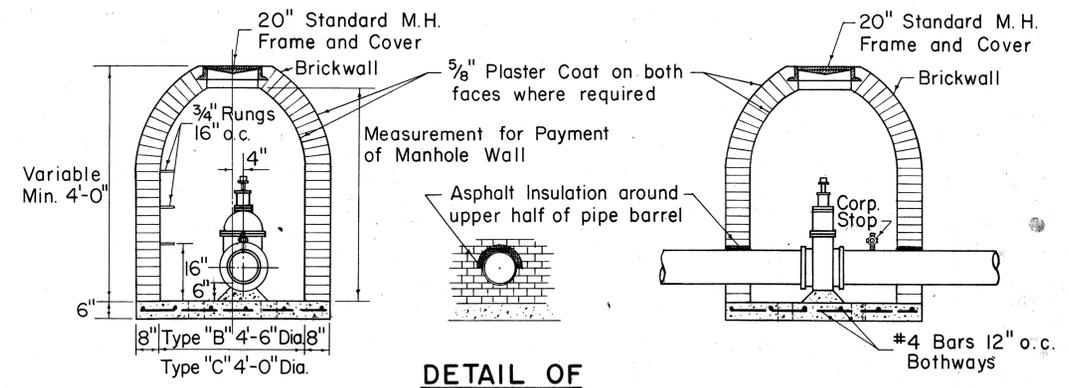


SECTION A-A


DETAIL OF ASPHALT FILLER

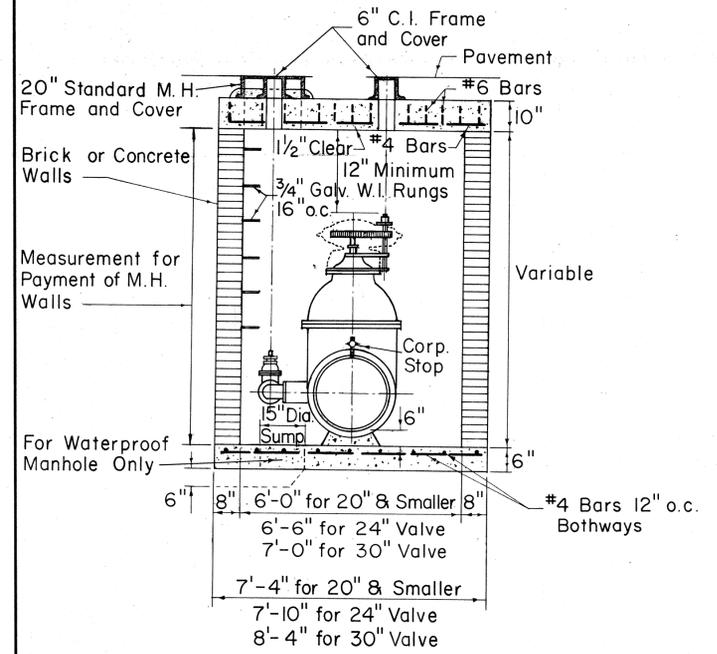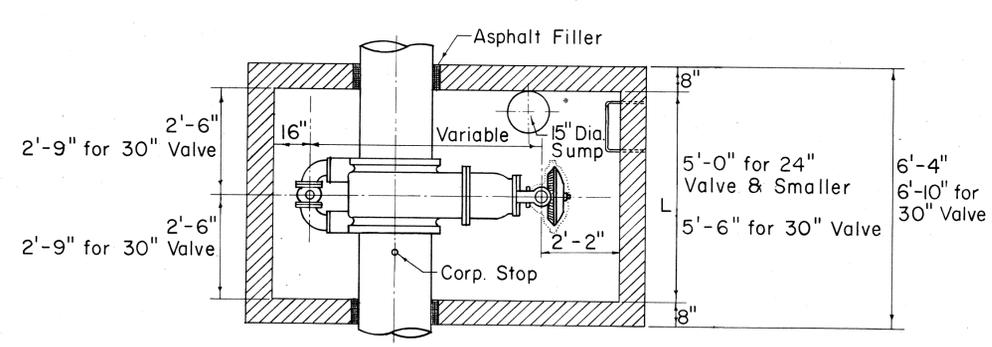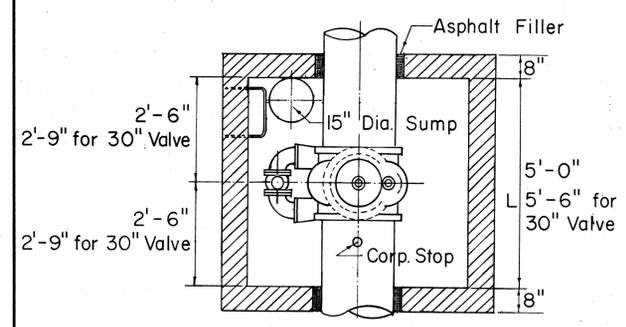

SECTION TYPE "A" MANHOLE FOR SPUR GEARED GATE VALVES

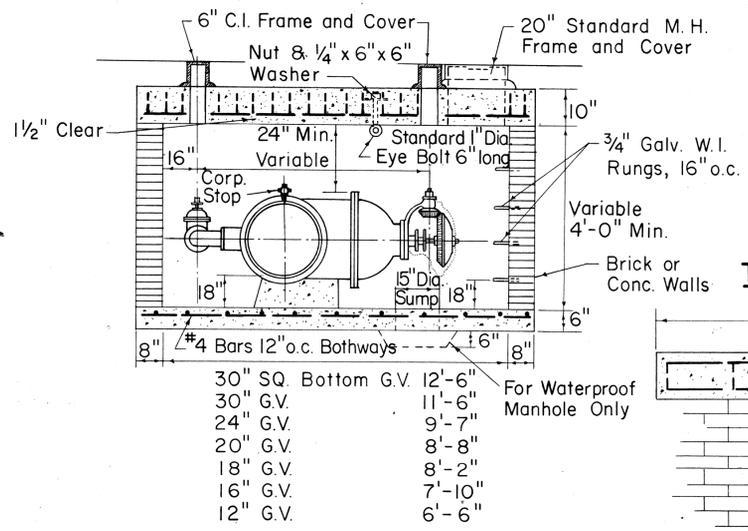


SECTION TYPE "A" MANHOLE FOR BEVEL GEARED GATE VALVES

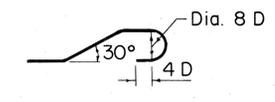


BAR BENDING DETAIL


SECTION THRU LINTEL

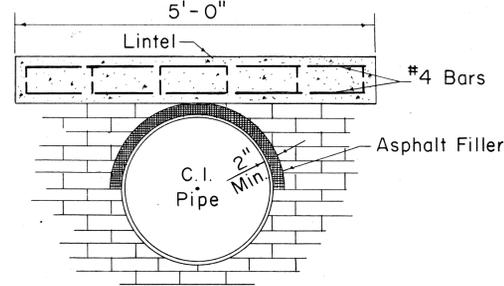

DETAIL OF LINTEL AND ASPHALT FILLER

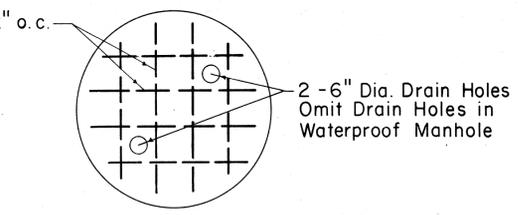


STEEL DETAIL IN BOTTOM SLAB

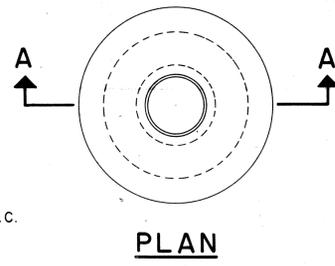

PLAN

TABLE "A" REQUIRED CORPORATION STOP SIZES AT GATE VALVE

DIA. OF MAIN INCHES	SIZE OF CORP STOP
4	1" x 1/4"
6	1" x 1/4"
8	1" x 1/4"
12	1" x 1/4"
16	1" x 1/4"
20	1" x 1/4"
24	1 1/2" x 2"
36	1 1/2" x 2"
42	1 1/2" x 2"

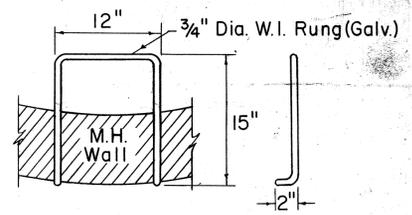

DETAIL OF RUNG


TYPE "B" AND "C" MANHOLES
TYPE "B" 4'-6" DIA. (FOR 12" G.V.)
TYPE "C" 4'-0" DIA. (FOR 6" & 8" G.V.)

APPROVED:

[Signature]
ASSISTANT CHIEF ENGINEER
BOARD OF WATER SUPPLY
DATE

STATE OF HAWAII
DEPARTMENT OF TRANSPORTATION
HIGHWAYS DIVISION
BOARD OF WATER SUPPLY
CITY & COUNTY OF HONOLULU
STANDARD DETAILS
INTERSTATE HIGHWAY (LUNALILO FRWY)
F.A.I. PROJ. NO. I-HI-1(6) UNIT 3
Not to Scale Date: Aug. 1966
SHEET NO. 14 OF 17 SHEETS


FED AID DIST. NO.	STATE	FED AID PROJ. NO.	FISCAL YEAR	SHEET NO.	TOTAL SHEETS
HAWAII	HAWAII	I-HI-1(6) UNIT 3	1966	79	235

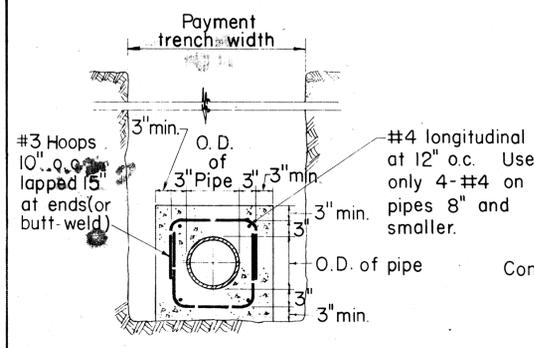


DETAIL OF CONCRETE JACKET
Scale: 3/4" = 1'-0"

METHOD OF USING BRICKS UNDER CONCRETE BLOCKS
Not To Scale



Contractor shall set Concrete Blocks on undisturbed ground. Where ground is too low, the contractor shall not heap up dirt under the Concrete Block but use Concrete Bricks to take up the deficiency, scraping away beneath Concrete Block to give sufficient room for Brick.

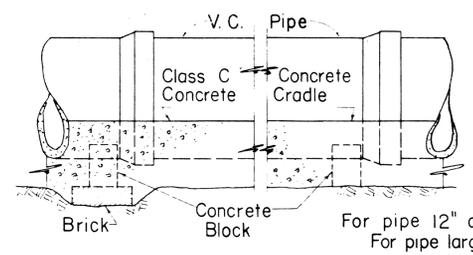


ELEVATION SHOWING METHOD OF LAYING PIPE
Not To Scale

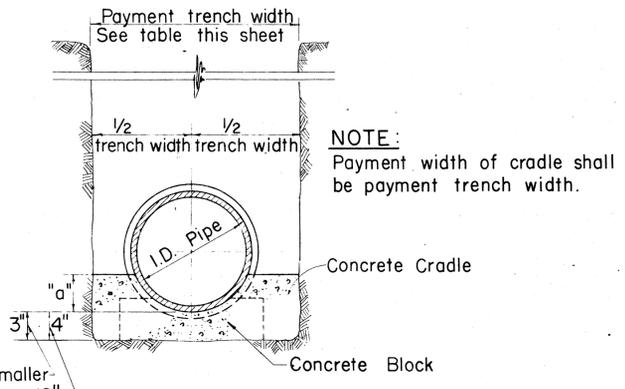


CONCRETE CRADLE FOR VITRIFIED CLAY PIPE
Not To Scale

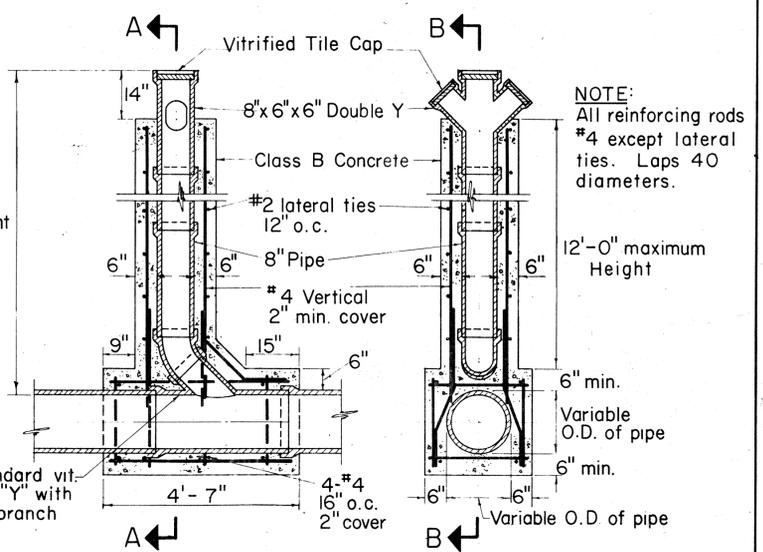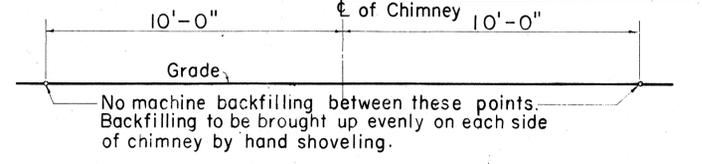

SECTION B-B SECTION A-A DETAILS OF CHIMNEY
Scale: 1/2" = 1'-0"

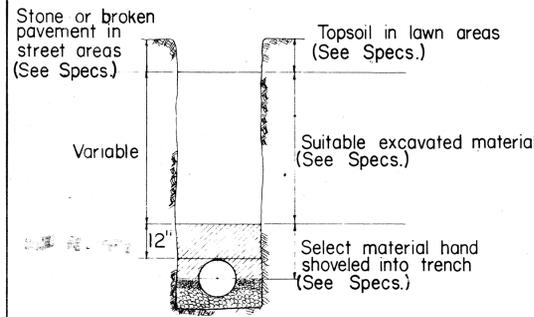


METHOD OF BACKFILL
Not To Scale

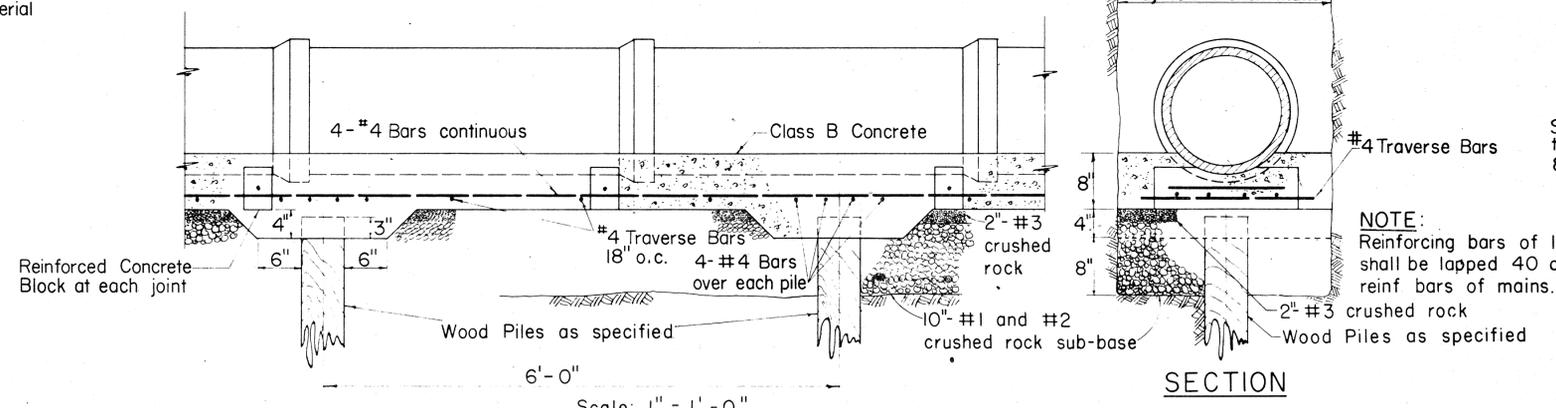


DETAIL OF REINFORCED CONCRETE CRADLE ON WOOD PILES (FOR 6, 8, 10 & 12 IN. V.C. PIPE)
Scale: 1" = 1'-0"

DETAIL OF REINFORCED CONCRETE CRADLE WITHOUT PILES SIMILAR EXCEPT FOR WOOD PILES AND PILE CAPS

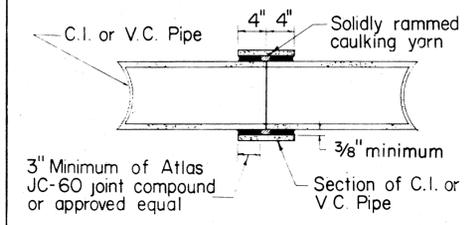


BUTT JOINT DETAIL
Scale: 1" = 1'-0"

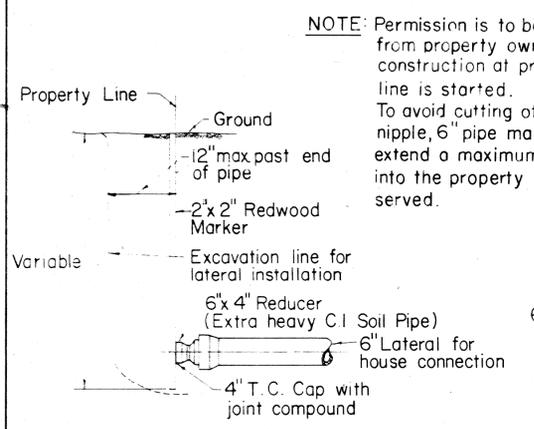


DETAIL AT PROPERTY LINE

NOTE: Permission is to be secured from property owner before construction at property line is started. To avoid cutting of short nipple, 6" pipe may extend a maximum of 12" into the property to be served.

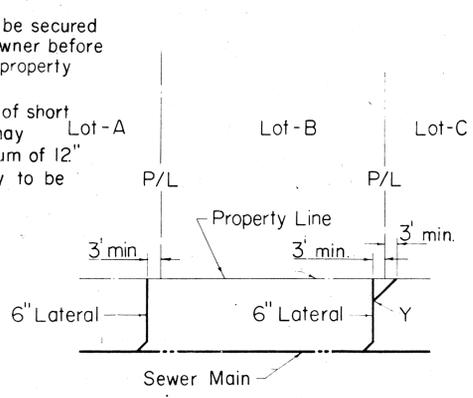


CONSTRUCTION OF LATERALS
Not To Scale

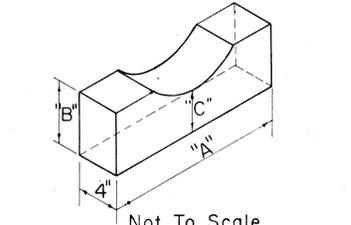


DETAIL OF PRECAST CONC. PIPE BLOCK

PIPE SIZE	CONCRETE BLOCK DIMENSIONS		
	"A"	"B"	"C"
6"	1'-2"	6"	3"
8"	1'-5"	6"	3"
10"	1'-7"	6"	3"
12"	1'-7"	6"	3"
15"	1'-8"	6"	4"
18"	1'-9"	6"	4"
21"	1'-10"	6"	4"
24"	1'-11"	6"	4"
27"	2'-0"	6"	4"
30"	2'-3"	6"	4"

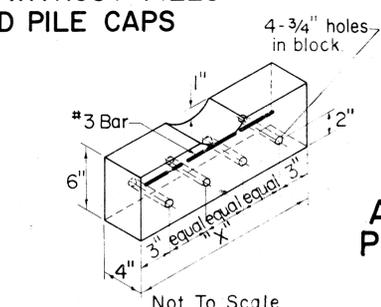

DETAIL OF CONC. PIPE BLOCK FOR REINF. CRADLE

PIPE SIZE	DIM. OF REINF. CONC. BLOCK
	"X"
6"	1'-6"
8"	1'-6"
10"	1'-8"
12"	1'-8"
15"	1'-10"
18"	1'-10"
21"	2'-0"
24"	2'-0"
27"	2'-0"
30"	2'-0"

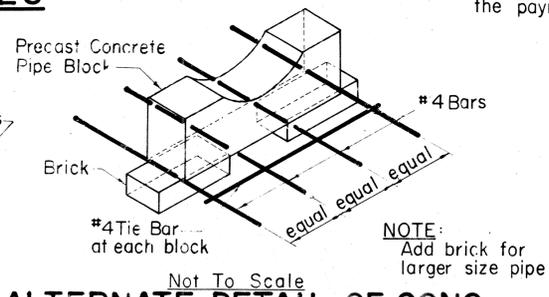

ALTERNATE DETAIL OF CONC. PIPE BLOCK FOR REINF. CRADLE


APPROVED:

Alona
SEWER SYSTEM DIRECTOR,
DIVISION OF SEWERS
DATE 8-22-66

VITRIFIED CLAY PIPE TABLE				
TRENCH WIDTHS		DIM. OF CONC. CRADLE		
PIPE SIZE	PAY. WIDTH	PIPE SIZE	"a"	WIDTH
6"	24"	6"	3"	24"
8"	24"	8"	3"	24"
10"	24"	10"	3"	24"
12"	30"	12"	3"	30"
15"	38"	15"	4"	38"
18"	41"	18"	5"	41"
21"	45"	21"	5"	45"
24"	50"	24"	6"	50"
27"	53"	27"	7"	53"
30"	57"	30"	7"	57"


STATE OF HAWAII
DEPARTMENT OF TRANSPORTATION
HIGHWAYS DIVISION
DIVISION OF SEWERS
CITY & COUNTY OF HONOLULU
STANDARD DETAILS
SEWERS - CONCRETE JACKET & MISCELLANEOUS DETAILS
INTERSTATE HIGHWAY (LUNALILO FRWY)
F.A.I. PROJ. NO. I-HI-1(6) UNIT 3
Scales: As Noted Date: Aug. 1966

FED. AID DIST. NO.	STATE	FED. AID PROJ. NO.	FISCAL YEAR	SHEET NO.	TOTAL SHEETS
HAWAII	HAWAII	I-HI-1(6) UNIT 3	1966	80	235

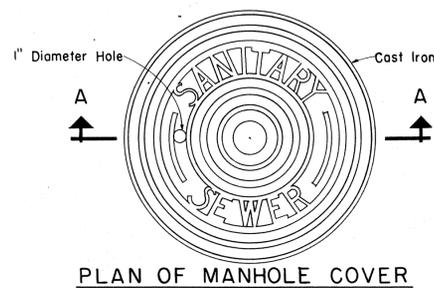

PLAN OF MANHOLE COVER


Scale: 1 1/2" = 1'-0"

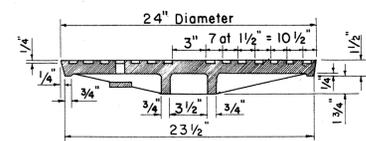

SECTION A-A


Scale: 1 1/2" = 1'-0"

NOTE: This cover is used with the "SA" or "SD" frame

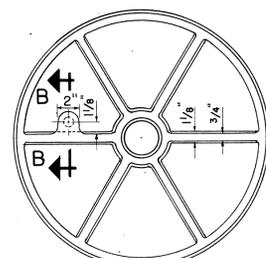


BOTTOM VIEW OF COVER

Scale: 1 1/2" = 1'-0"

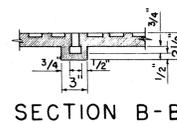


SECTION B-B

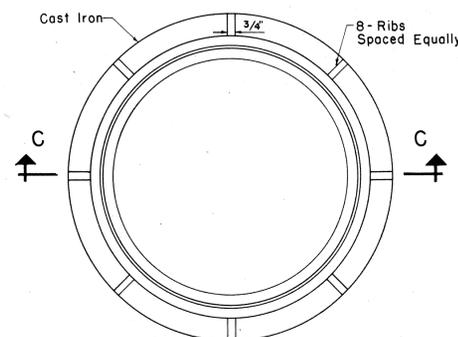

PLAN OF MANHOLE FRAME

Scale: 1 1/2" = 1'-0"

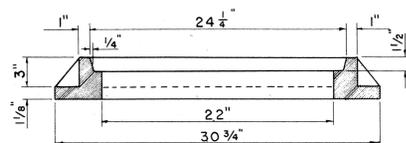


SECTION C-C

Scale: 1 1/2" = 1'-0"


TYPE "SA" SEWER MANHOLE FRAME AND COVER

Scale: 1 1/2" = 1'-0"

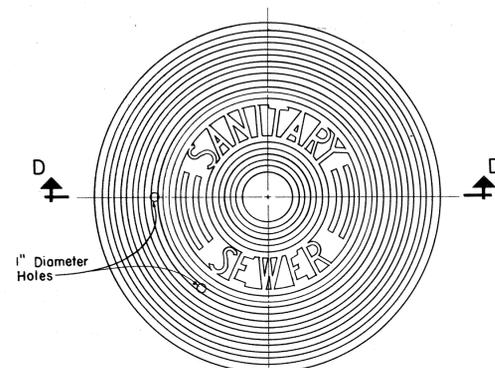

PLAN SPECIAL MANHOLE COVER


Scale: 1 1/2" = 1'-0"

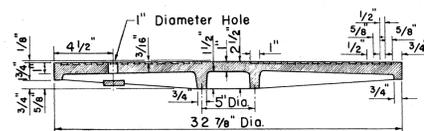

SECTION D-D


Scale: 1 1/2" = 1'-0"

Approx. Weight 260 Pounds

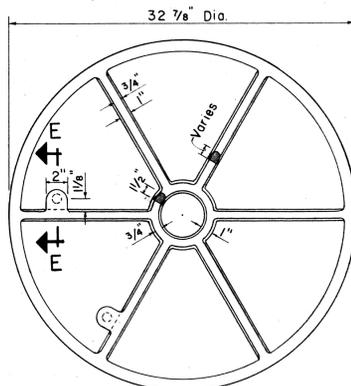

BOTTOM VIEW OF COVER

Scale: 1 1/2" = 1'-0"

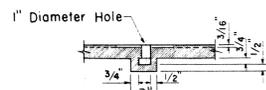


SECTION E-E


Scale: 1 1/2" = 1'-0"

TYPE "SB" SEWER MANHOLE FRAME AND COVER

Scale: 1 1/2" = 1'-0"

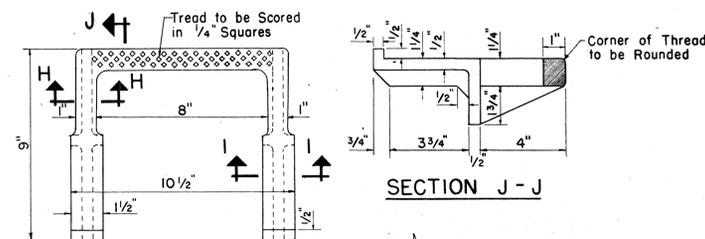


SECTION J-J

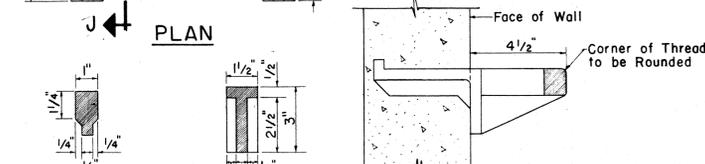

METHOD OF INSTALLATION

TYPE "SB" MANHOLE RUNGS (CAST IRON)


Scale: 3" = 1'-0"

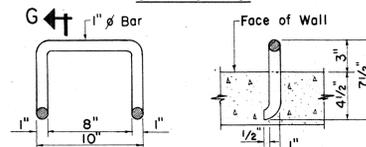

SECTION G-G

TYPE "SA" MANHOLE RUNGS (WROUGHT IRON)


Scale: 1 1/2" = 1'-0"

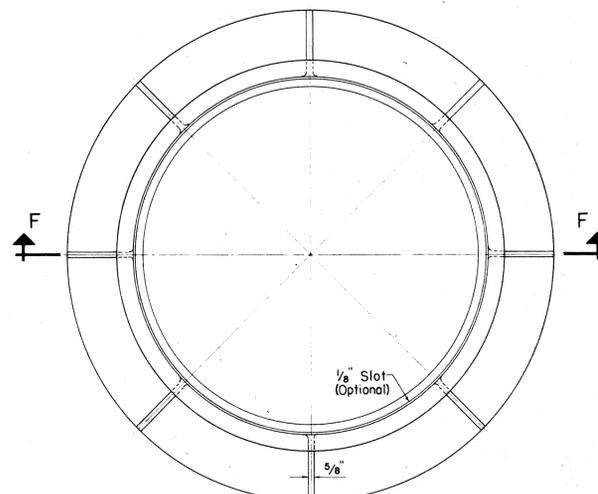

PLAN SPECIAL MANHOLE FRAME

Scale: 1 1/2" = 1'-0"

Approx. Weight 437 Pounds

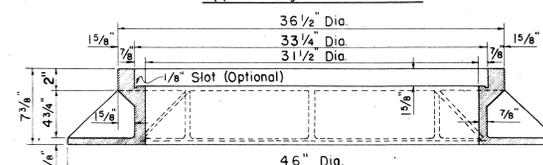


SECTION F-F


Scale: 1 1/2" = 1'-0"

Cast Iron 1/8" Raised Letters


PLAN OF COVER

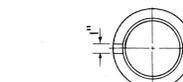

BOTTOM OF COVER

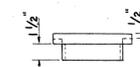

ELEVATION

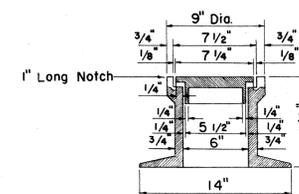

SECTION

DROP MANHOLE CHIMNEY CASTINGS

Scale: 1 1/2" = 1'-0"

APPROVED:

S. A. Jones
SEWER SYSTEM DIRECTOR, DIVISION OF SEWERS
DATE: 8-22-66


STATE OF HAWAII
DEPARTMENT OF TRANSPORTATION
HIGHWAYS DIVISION
DIVISION OF SEWERS
CITY & COUNTY OF HONOLULU
STANDARD DETAILS
SEWERS - MANHOLE RUNGS,
CHIMNEY CASTINGS AND
FRAME AND COVER DETAILS
INTERSTATE HIGHWAY (LUNALILO FRWY)
F.A.I. PROJ. NO. I-HI-1(6) UNIT 3
Scales: As Noted Date: Aug. 1966

SHEET NO. 16 OF 17 SHEETS


DESIGNED BY	DATE
DRAWN BY	1-5-65
CHECKED BY	1-5-65
NOTED BY	
NO.	




FED. AID DIST. NO.	STATE	FED. AID PROJ. NO.	FISCAL YEAR	SHEET NO.	TOTAL SHEETS
HAWAII	HAWAII	I-HI-1(6) UNIT 3	1966	81	235

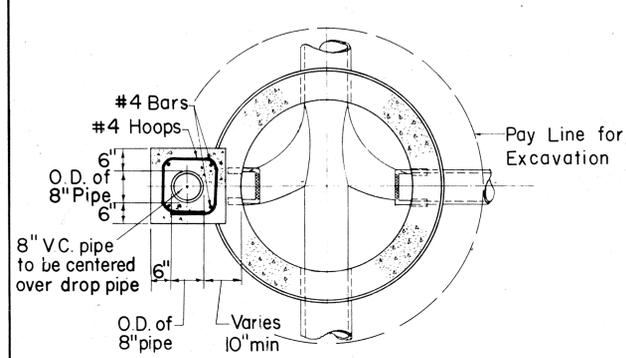


SECTION A-A
Scale: 1/2" = 1'-0"

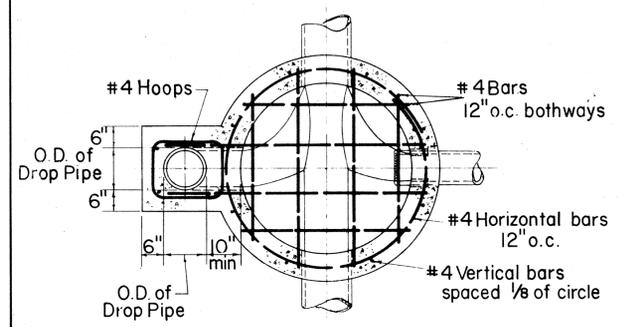


SECTION B-B
Scale: 1/2" = 1'-0"

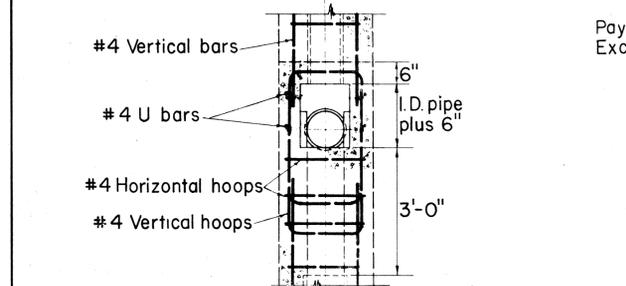


SECTION C-C
Scale: 1/2" = 1'-0"

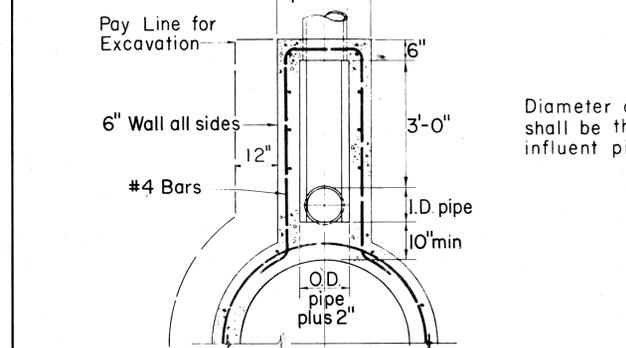


SECTION D-D
Scale: 1/2" = 1'-0"

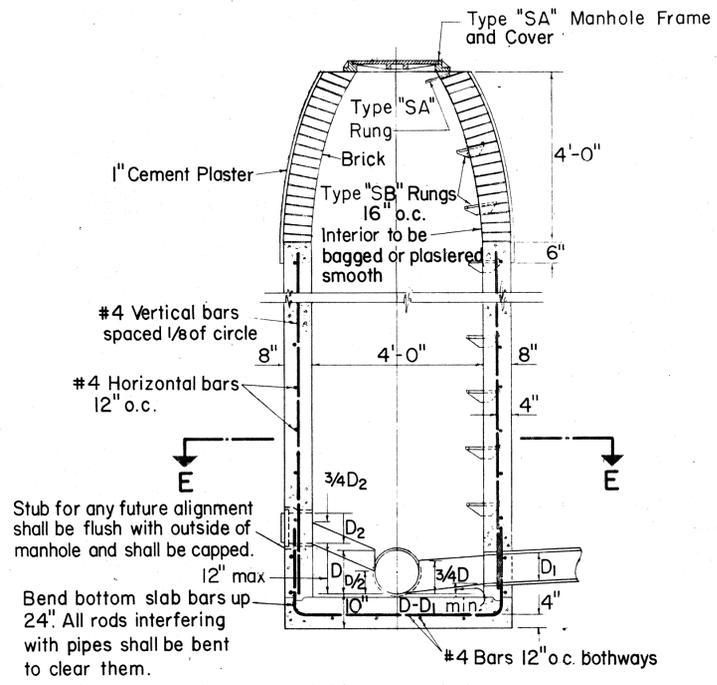


PLAIN MANHOLE
Scale: 1/2" = 1'-0"

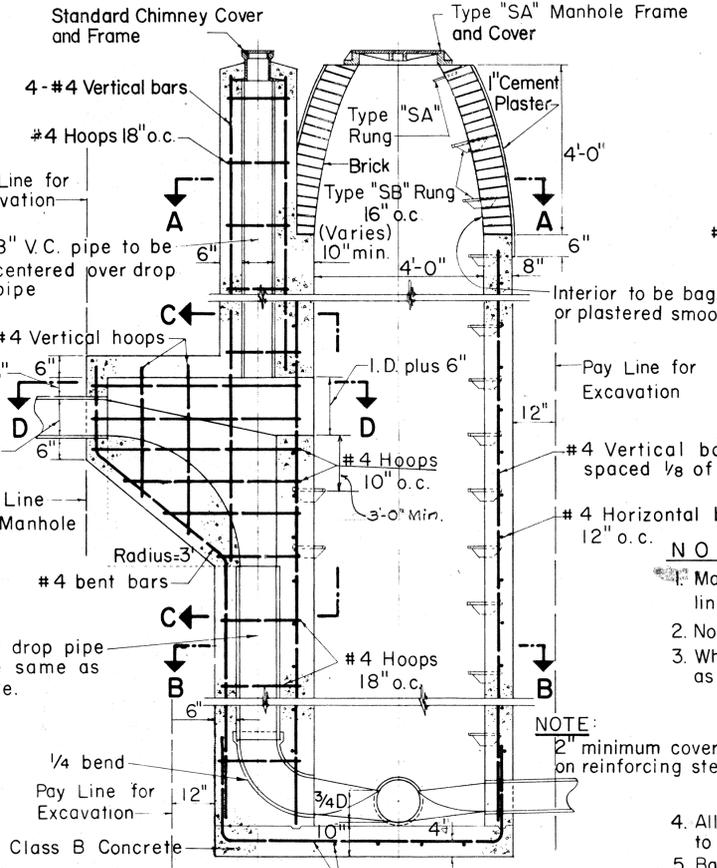


DROP MANHOLE
Scale: 1/2" = 1'-0"

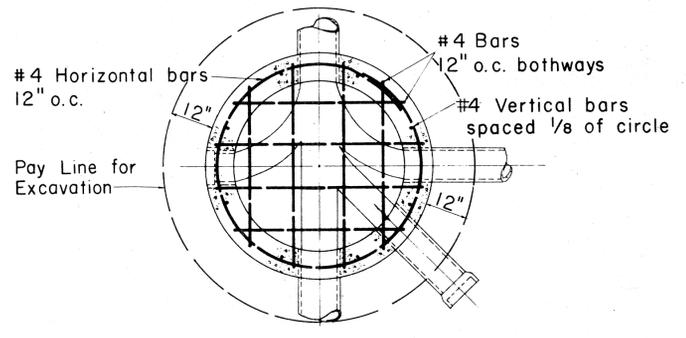

SECTION E-E
Scale: 1/2" = 1'-0"

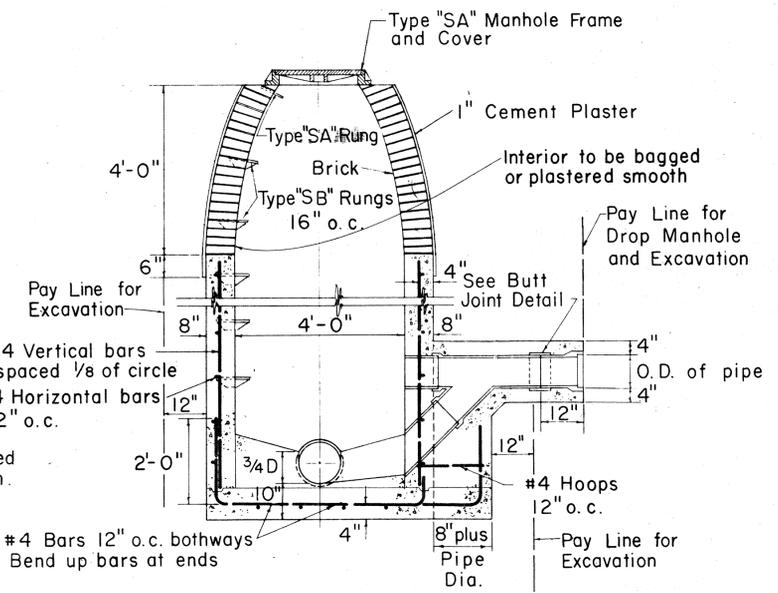

SHALLOW DROP MANHOLE
Scale: 1/2" = 1'-0"

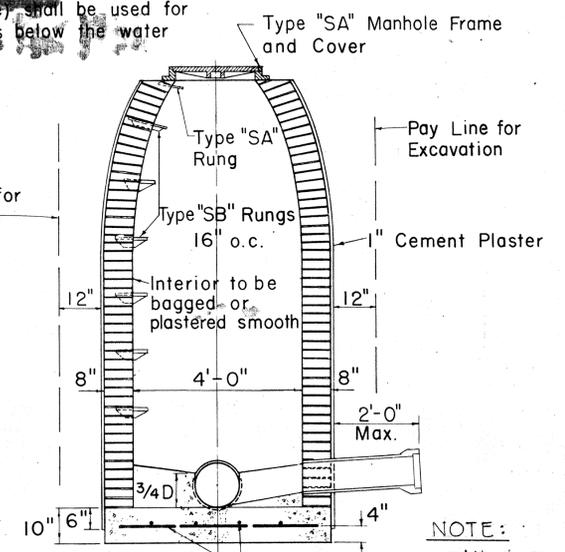

BRICK MANHOLE
Scale: 1/2" = 1'-0"

NOTE:

Reinforced concrete manhole walls (See detail of plain manhole) shall be used for portions below the water table.

NOTE:

All pipes entering or leaving manholes shall have a joint within 2'-0" of the manhole wall.

Payment for excavation for manholes shall be made under unit price for trench excavation and shall be measured to one foot outside of walls from original ground elevation to authorized bottom elevation. Payment for manhole walls (brick, or cast-in-place concrete) shall include brick, mortar, concrete, reinforcing steel, cast-iron steps, galvanized wrought iron rungs, and plastering.

NOTE:

- Manhole rungs shall not be aligned above any flow line except in drop manhole.
- No rungs shall be installed in manholes less than 3' high.
- When not otherwise noted, manhole stubs shall be sloped as follows:

Pipe Size	Rise Per Foot
6"	1/8"
8"	3/32"
10"	1/16"
12"	1/16"

- All reinforcing rods interfering with pipes shall be bent to clear them.
- Bar lap to be 40 diameters in length.
- Data for special manholes not shown shall be similar to that for plain manholes.
- Size of drop pipe in all Drop Manholes shall be same as influent line.

- Manhole wall to be of reinforced concrete to height 1' above normal ground water table.

APPROVED:

[Signature]
SEWER SYSTEM DIRECTOR,
DIVISION OF SEWERS
DATE: 8-22-66

STATE OF HAWAII
DEPARTMENT OF TRANSPORTATION
HIGHWAYS DIVISION
DIVISION OF SEWERS
CITY & COUNTY OF HONOLULU

STANDARD DETAILS

SEWERS - DROP MANHOLE AND BRICK MANHOLE DETAILS

INTERSTATE HIGHWAY (LUNALILO FREEWAY)
F.A.I. PROJ. NO. I-HI-1(6) UNIT 3
Scale: As Noted Date: Aug. 1966