

DD-1-2

PLAN	DATE	BY
SURVEYED		
PLOTTED		
NOTE BOOK		
NO.		

PROFILE	DATE	BY
SURVEYED		
PLOTTED		
NOTE BOOK		
NO.		

GENERAL NOTES

1. Azimuths and coordinates are referred to Punchbowl "Trig." Station.
2. Bench Marks are referred to Mean Sea Level datum.
3. The boring data shown on these plans are for design purposes only, and are for the conveniences of the Engineer in control of earthwork. The borings were carefully taken and are believed to be reliable, however, the Department assumes no responsibility whatsoever in respect to sufficiency or accuracy of the borings, or of the interpretation thereof, and will not either impliedly or expressly make any guarantee of any of the same. See Bridge plans for additional borings.



BM
"B" cut on C.B.
Fronting Ernest
Elev. = 56.67

BEG. PROJECT No. I-H-1(31) UNIT 2
Baseline Sta. 202+25

BM #14
"B" cut on P.T. Curb C.B.
Corner of Pensacola
and Lunalilo
Elev. = 36.70 38.95

NOTE: For Profile of Road "J"
and Ramp "E", see sht. No. 8.

FED. ROAD DIST. NO.	STATE	FED. AID PROJ. NO.	FISCAL YEAR	SHEET NO.	TOTAL SHEETS
HAWAII	HAW.	I-H-1(31) Unit 2	1967	5	217

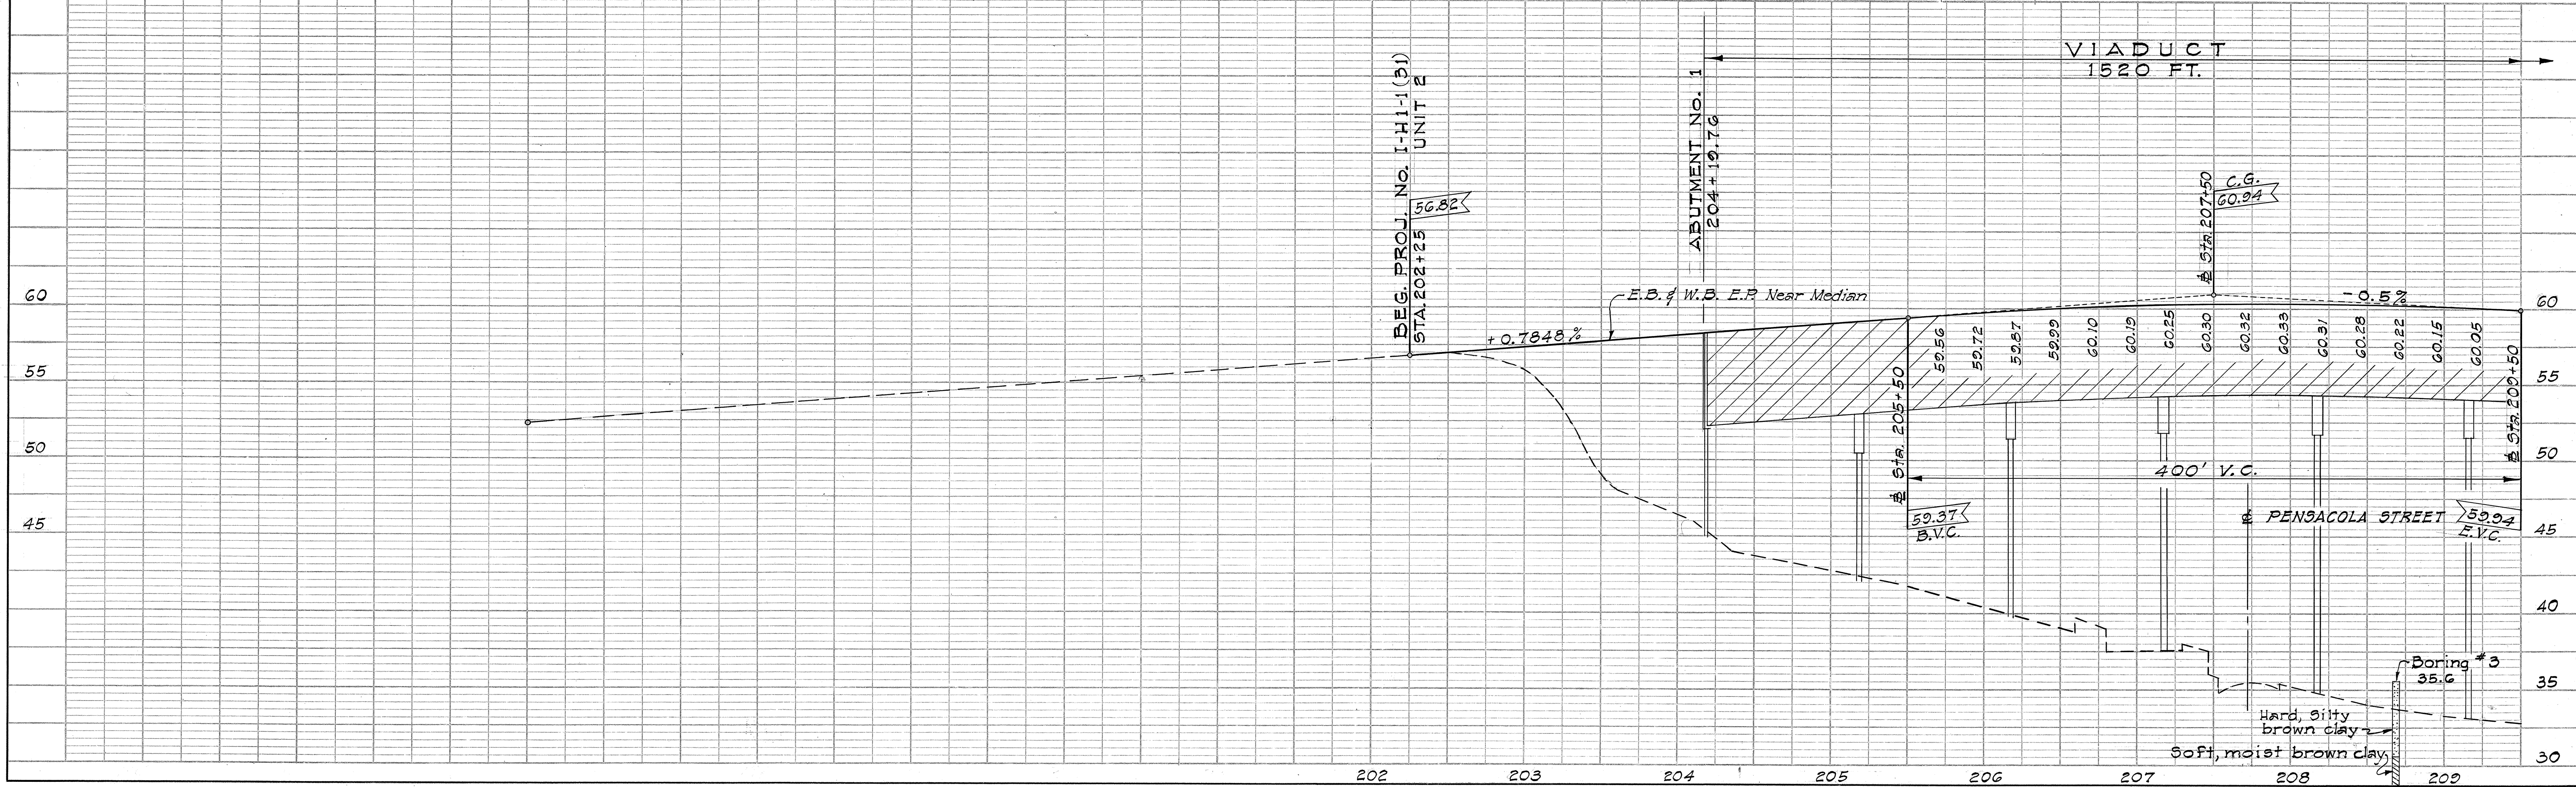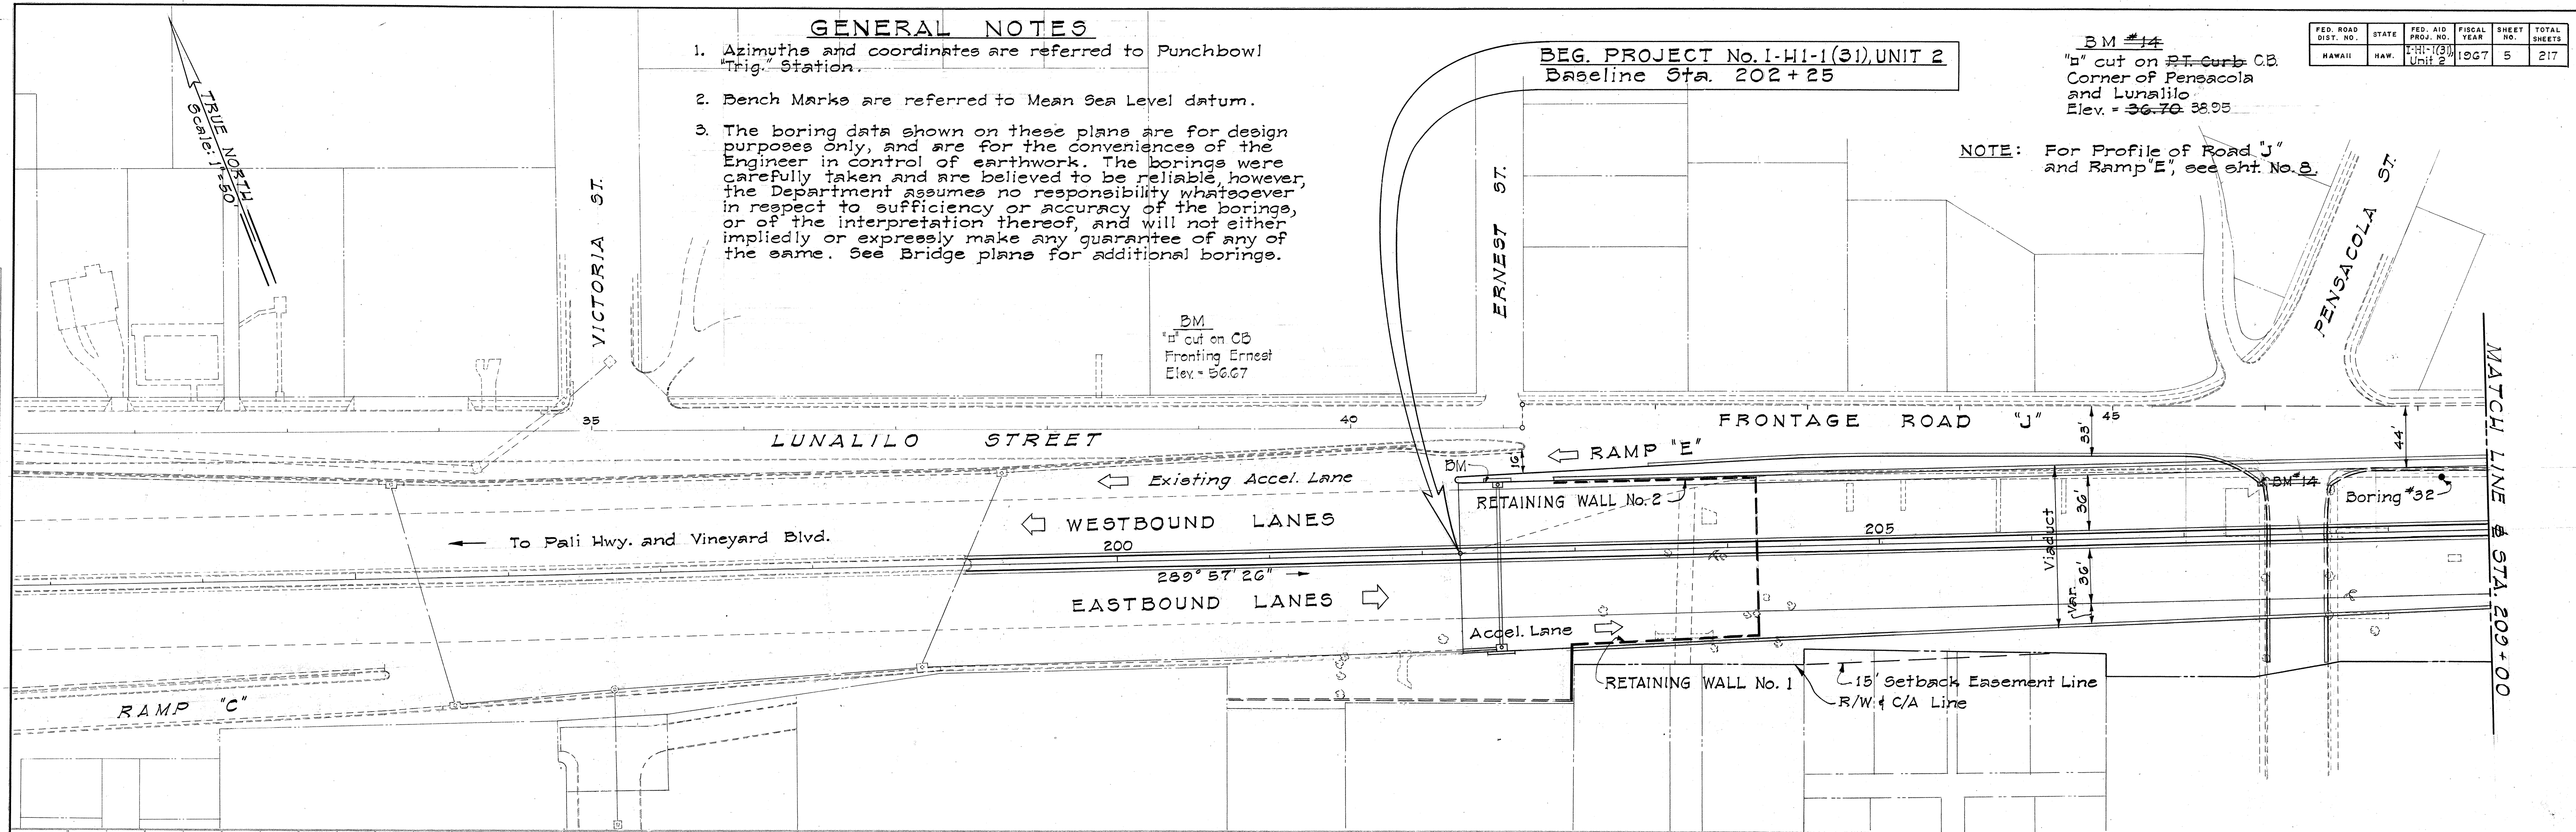


DD-T-2

5

PLAN	SURVEYED	BY	DATE
	PLOTTED NOTE BOOK ALIGNMENT CHECKED RT. OF WAY CHECKED NO.		



PROFILE	SURVEYED	BY	DATE
NOTE BOOK	PLOTTED		
NO.	GRADES CHECKED		
	B. M.S NOTED		
	STRUCTURE NOTATIONS CHK'D		

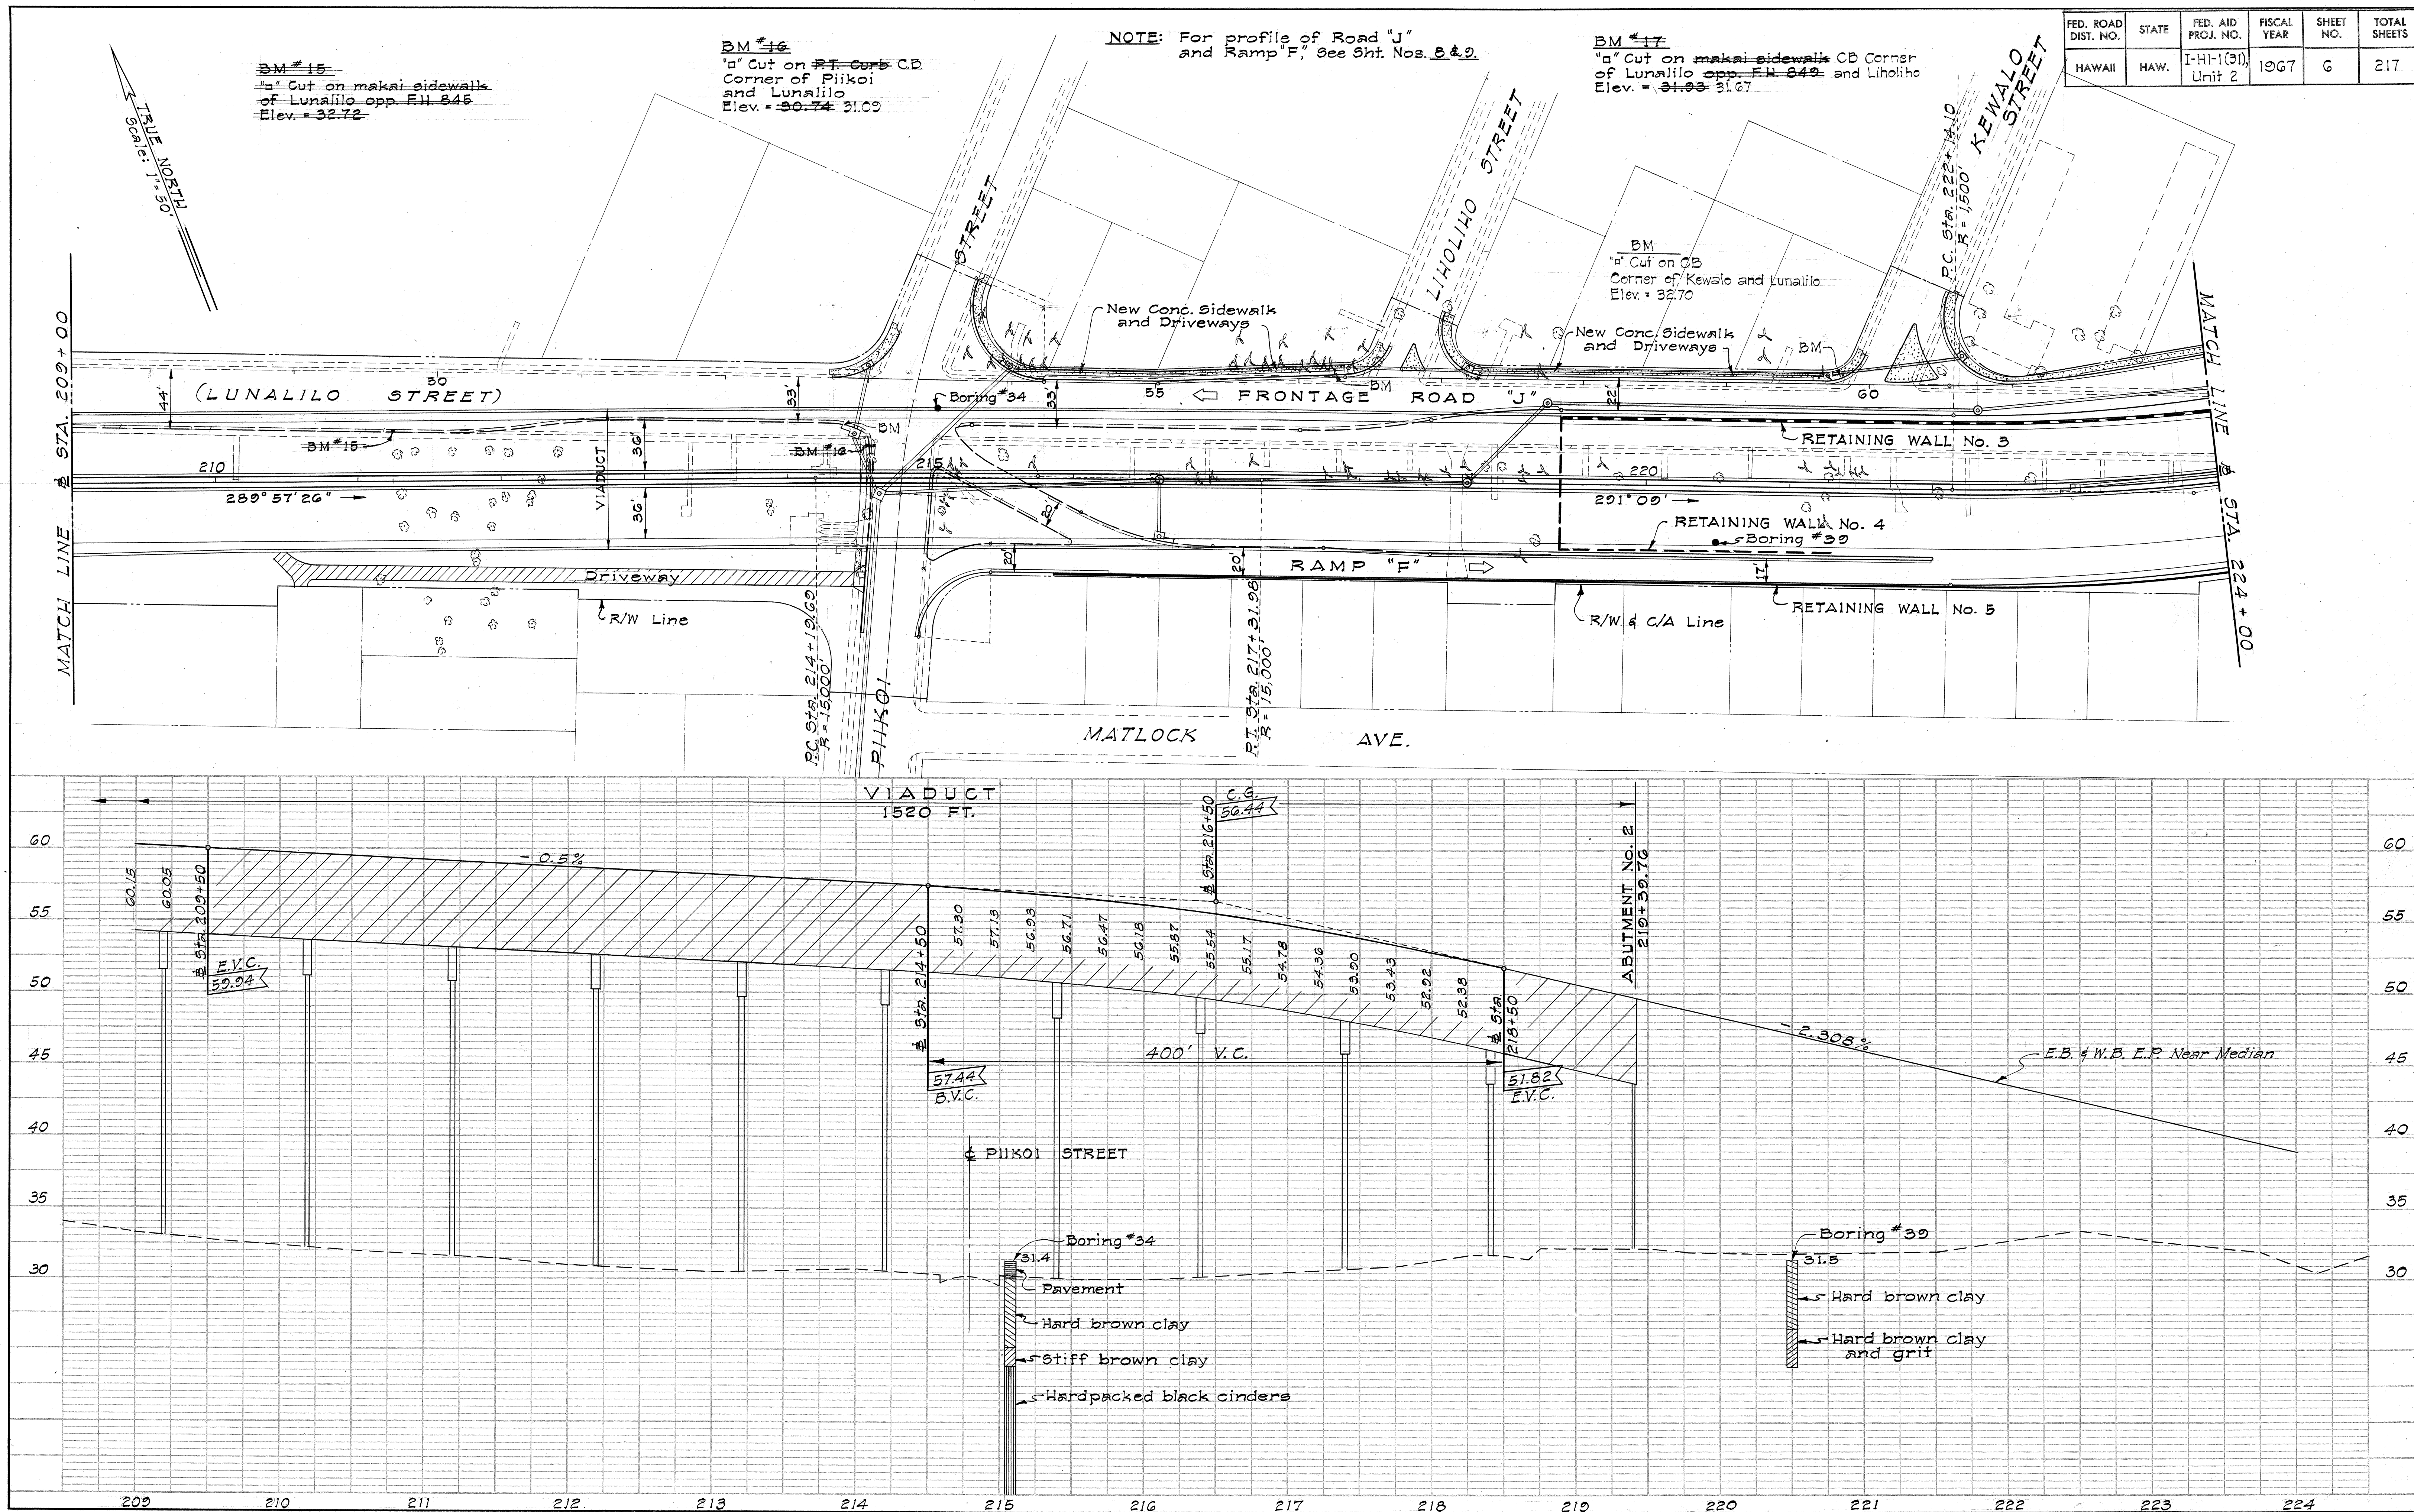

PLAN	DATE	BY
SURVEYED		
NOTE BOOK		
ALIGNMENT CHECKED		
RT. OF WAY CHECKED		
NO.		

PROFILE	DATE	BY
SURVEYED		
GRADES CHECKED		
PLOTTED		
NO.		


FED. ROAD DIST. NO.	STATE	FED. AID PROJ. NO.	FISCAL YEAR	SHEET NO.	TOTAL SHEETS
HAWAII	HAW.	I-HI-1(31), Unit 2	1967	7	217

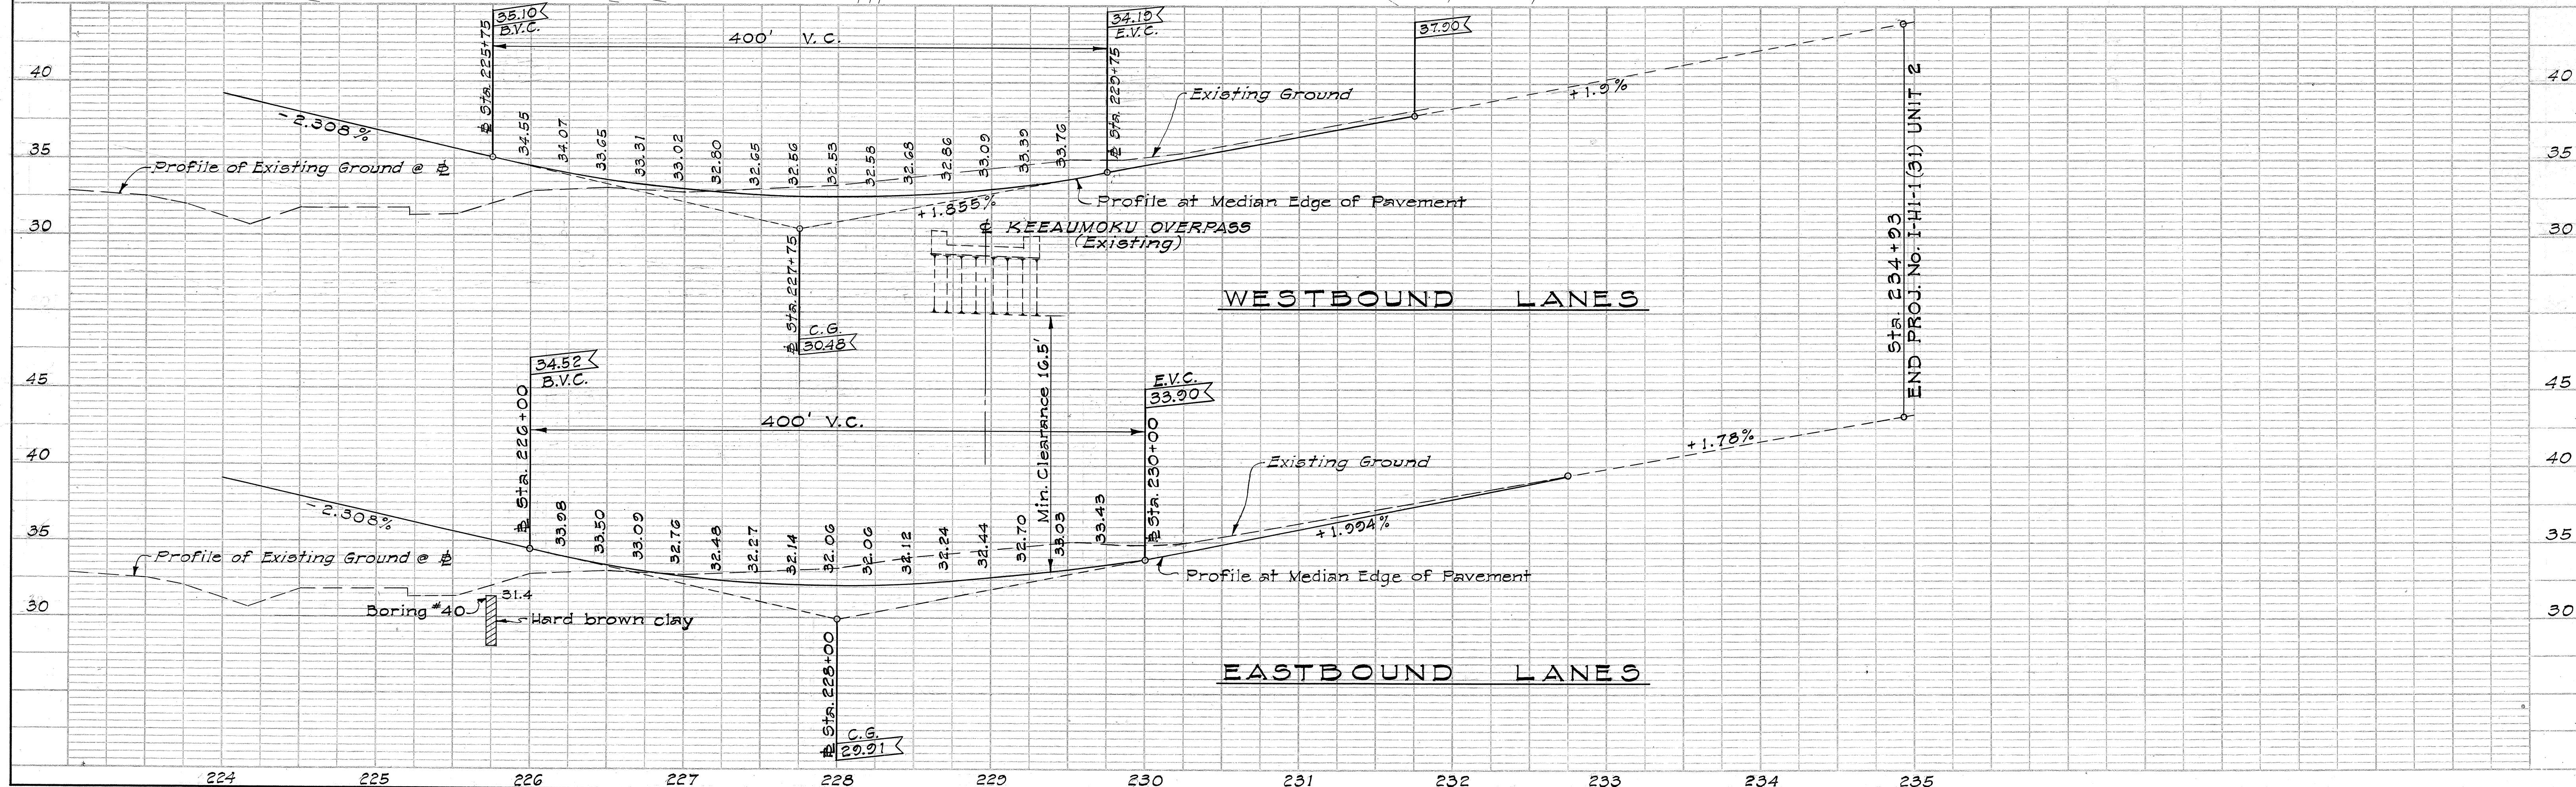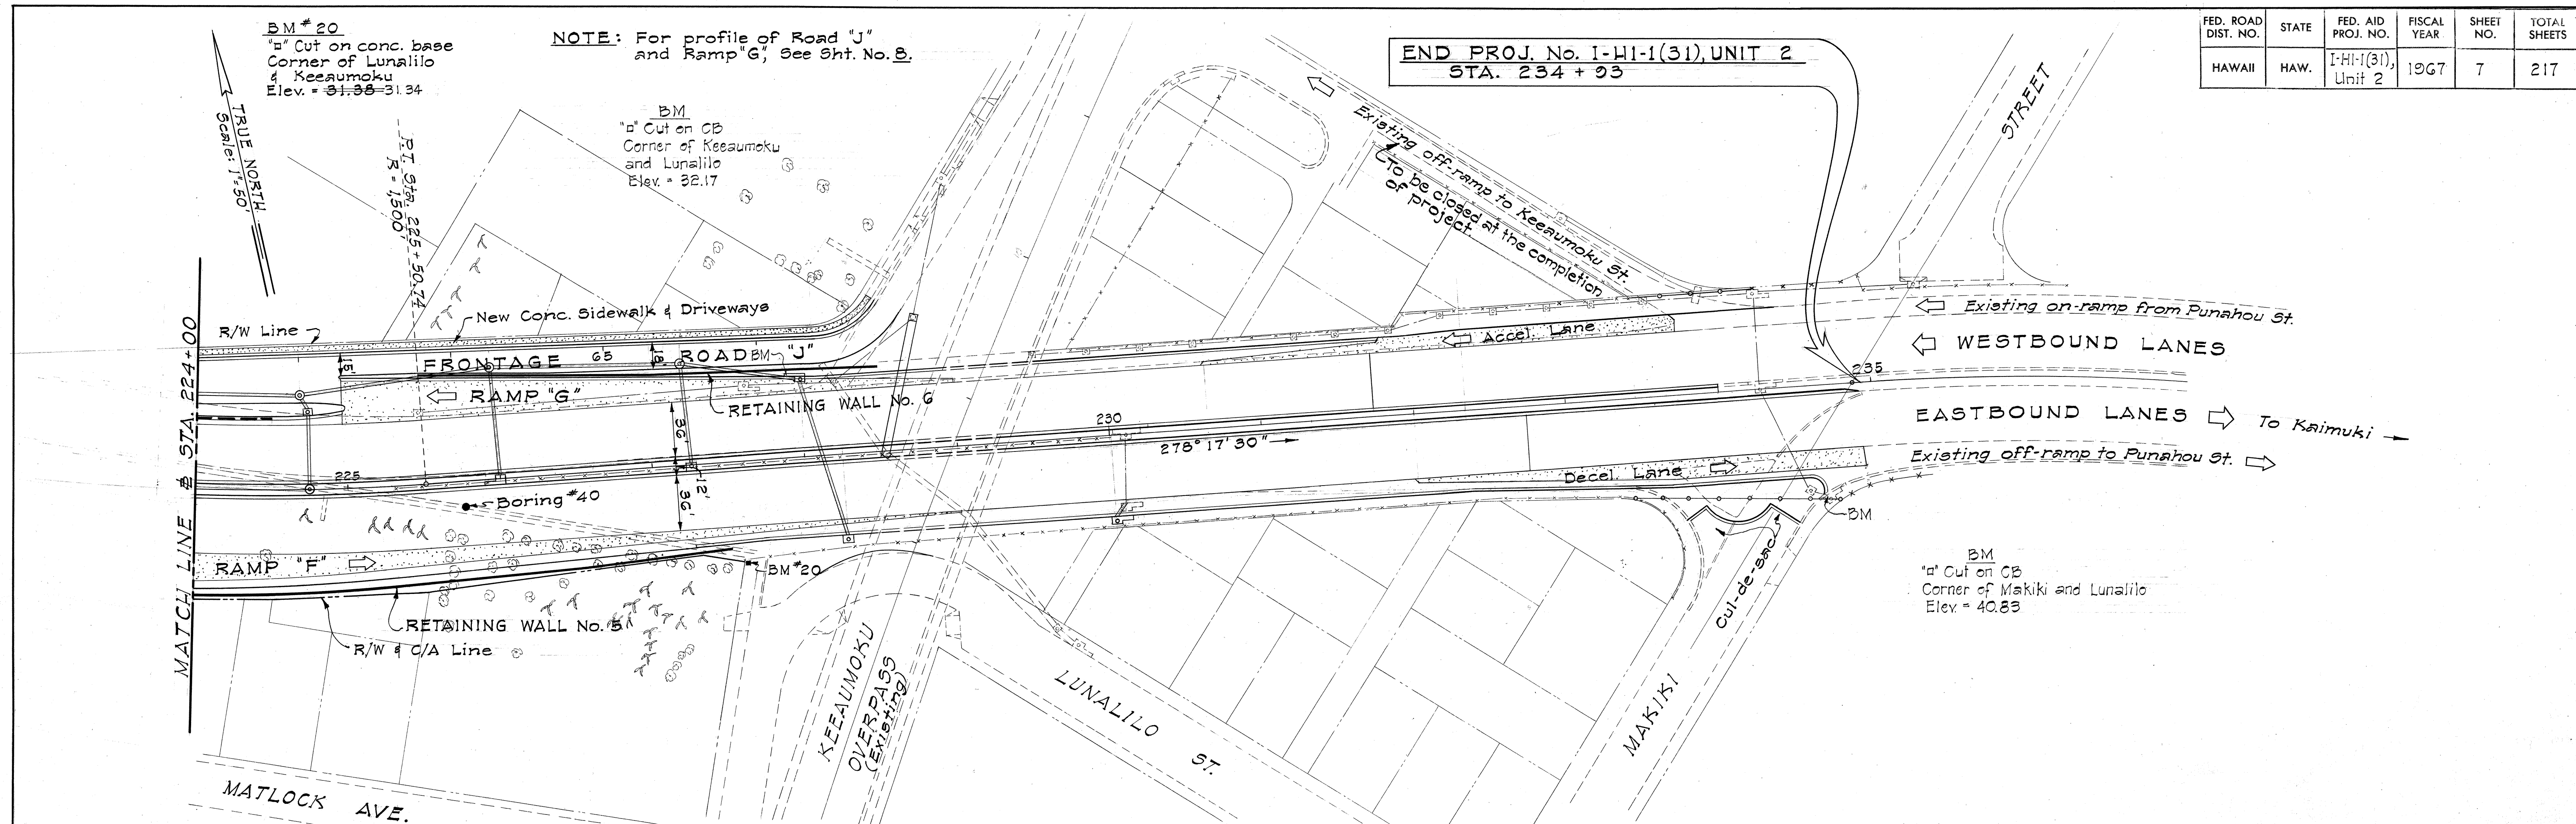

FED. ROAD DIST. NO.	STATE	FED. AID PROJ. NO.	FISCAL YEAR	SHEET NO.	TOTAL SHEETS
HAWAII	HAW.	I-HI-1(31), Unit 2	1967	8	217


DATE	BY	NO.
FINAL SURVEY		
NOTE BOOK		
AREAS CHECKED		

DATE	BY	NO.
ORIGINAL SURVEY		
NOTE BOOK		
AREAS CHECKED		

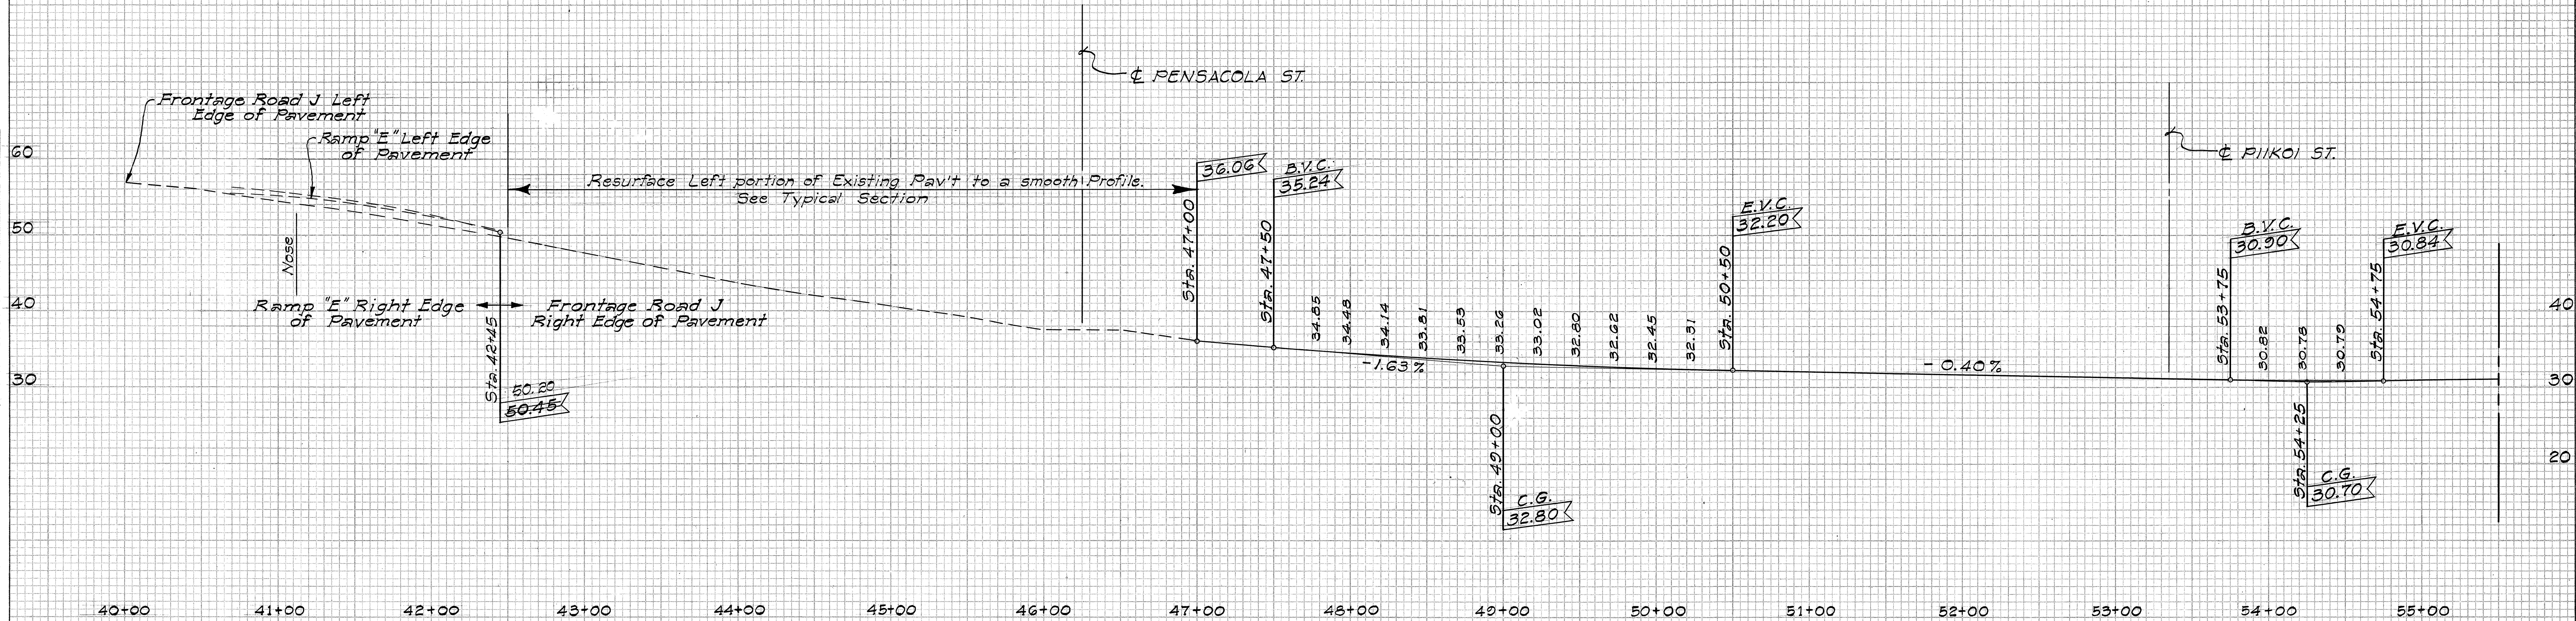

PROFILE FRONTAGE ROAD "J"

Scale: Horiz. 1" = 50'
Vert. 1" = 10'

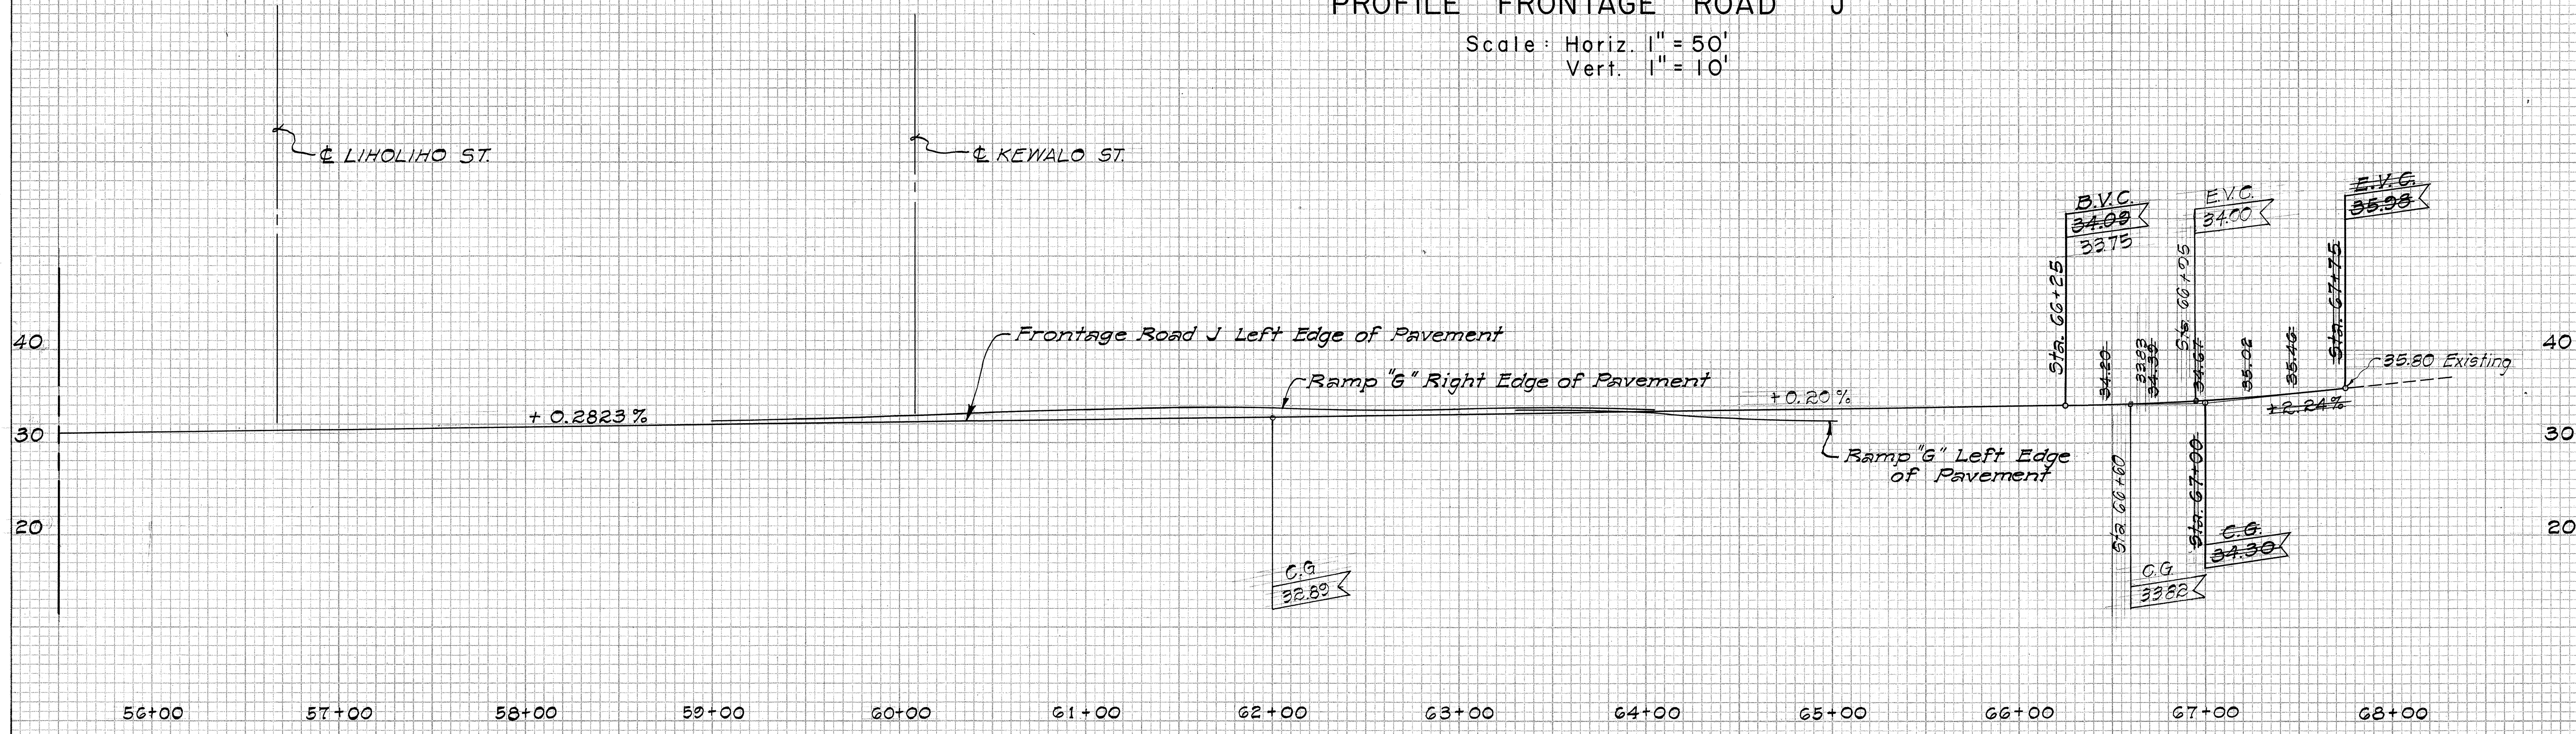

PROFILE FRONTAGE ROAD "J"

STATE OF HAWAII
DEPARTMENT OF TRANSPORTATION
HIGHWAYS DIVISION


PROFILE OF FRONTAGE ROAD "J"

INTERSTATE ROUTE H-1
Victoria St. to Keeaumoku St.
F.A.I. Proj. No. I-HI-1(31), Unit 2

Scale: As Shown Date: April 1967

FINAL SURVEY	SURVEYED	BY	DATE
	PLOTTED		
	TEMPLATE		
	AREAS		
NO.	AREAS CHECKED		

ORIGINAL SURVEY		BY	DATE
NOTE BOOK	SURVEYED PLOTTED TEMPLATE		
NO.	AREAS AREAS CHECKED		

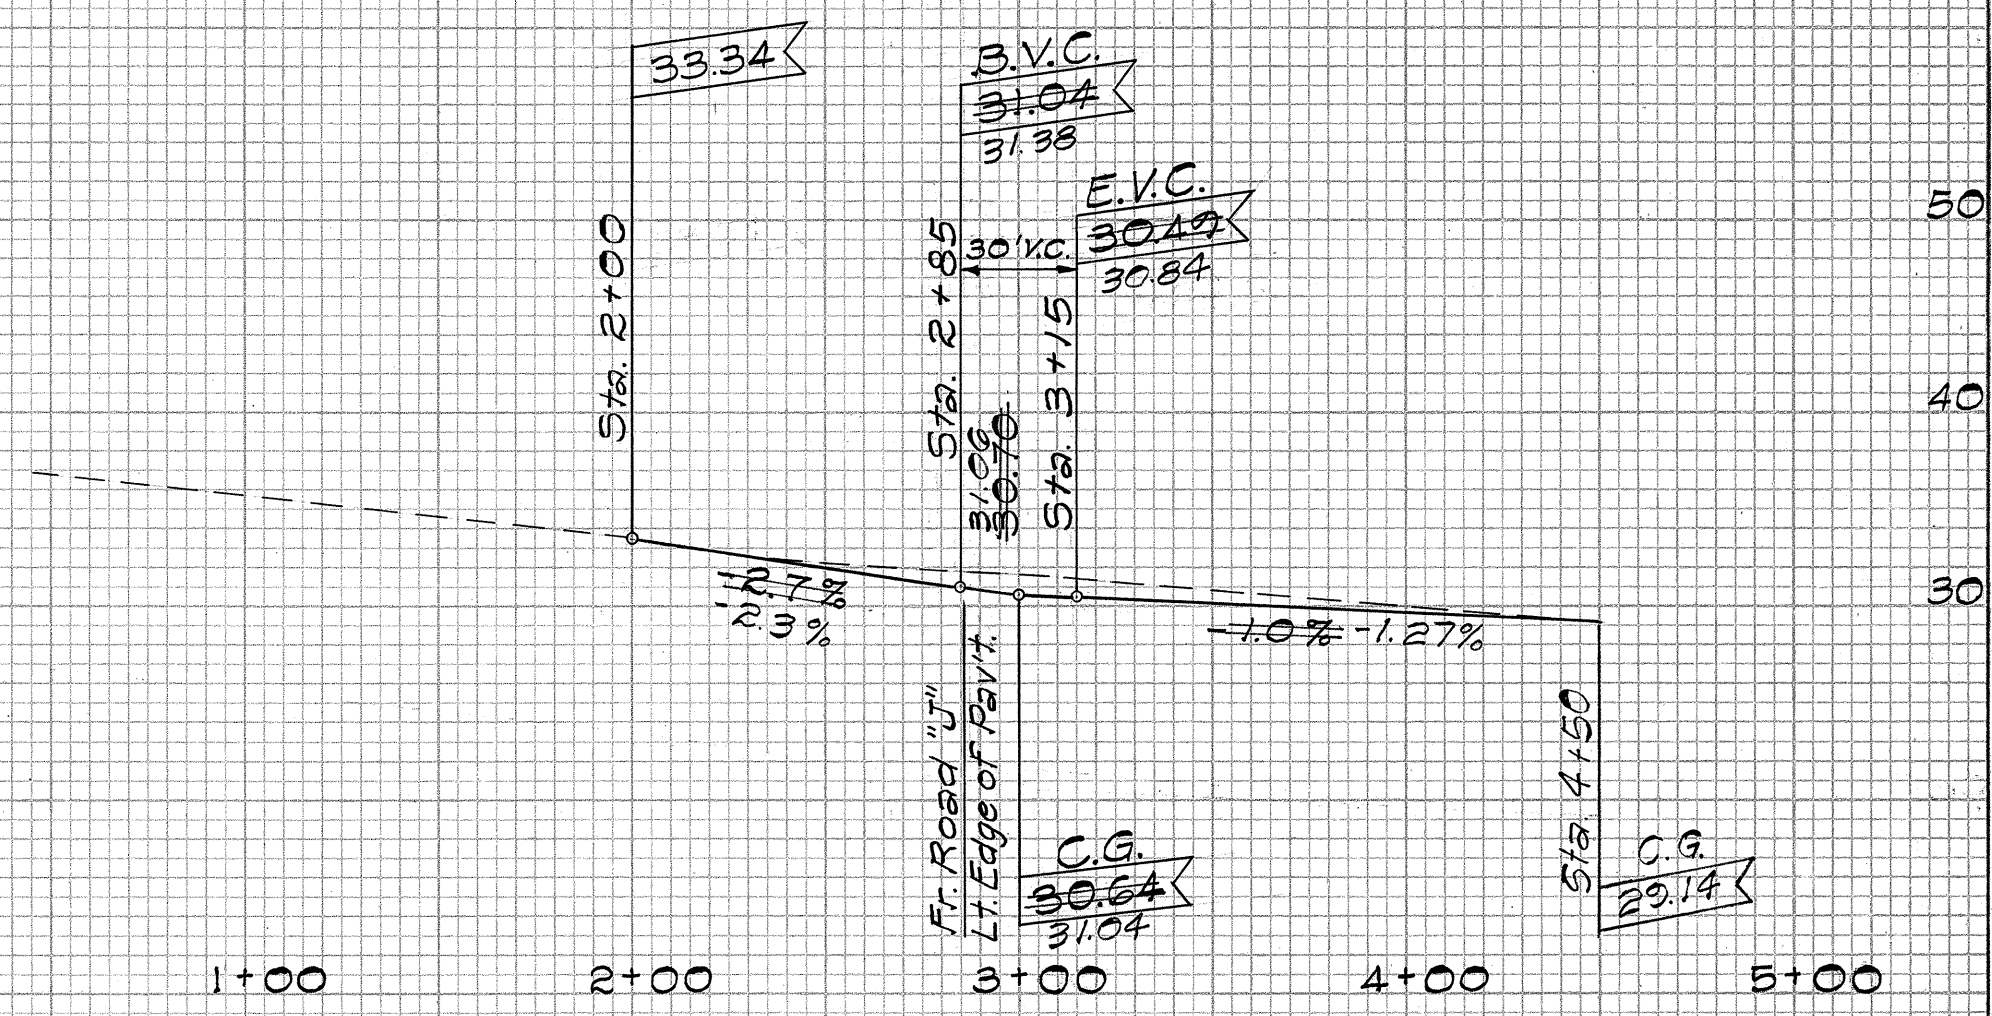


STATE OF HAWAII
DEPARTMENT OF TRANSPORTATION
HIGHWAYS DIVISION


PROFILE OF RAMP "F"
AND PIIKOI STREET
INTERSTATE ROUTE H-1
Victoria St. to Keeaumoku St.
F.A.I. Proj. No. I-HI-1(31), Unit 2

Scale: As Shown Date: April 1967


FED. ROAD DIST. NO.	STATE	FED. AID PROJ. NO.	FISCAL YEAR	SHEET NO.	TOTAL SHEETS
HAWAII	HAW.	I-HI-1(31), Unit 2	1967	10	217

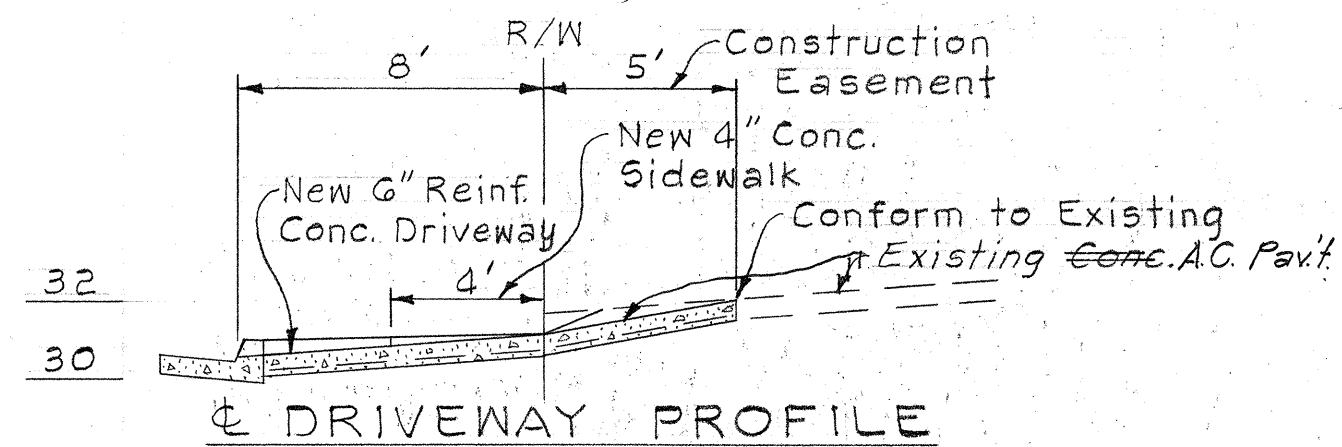


DRIVEWAY & WALK AT 1212 LUNALILO ST.
FRONTAGE ROAD J STA. 54+42 ± (Driveway)
STA. 54+65 ± (Walk)

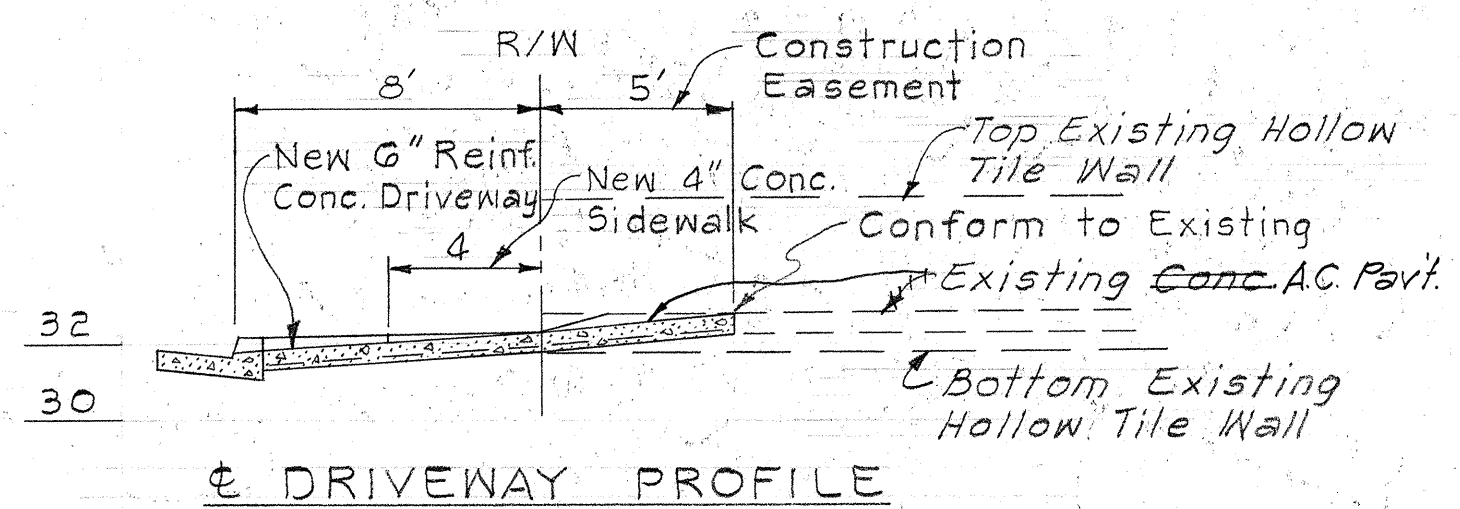


DRIVEWAY & WALK AT 1254 LUNALILO ST.
FRONTAGE ROAD J STA. 58+47 ± (Driveway)
STA. 58+76 ± (Walk)

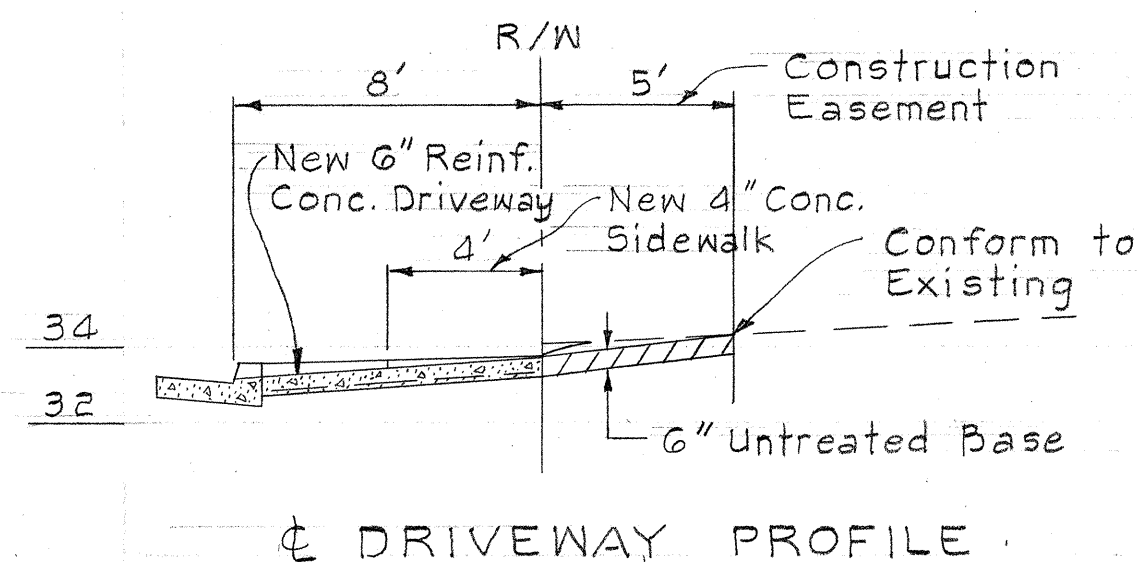


DRIVEWAY AT 1328 LUNALILO ST.
FRONTAGE ROAD J STA. 63+51 ±

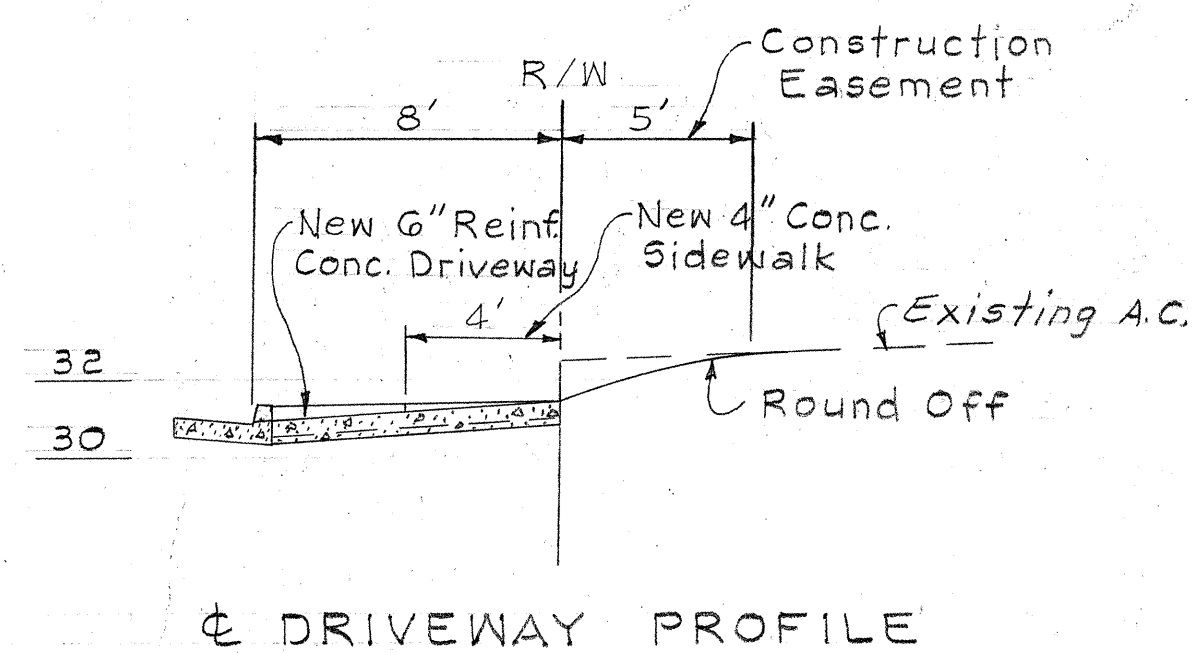


DRIVEWAY AT 1228 LUNALILO ST.
FRONTAGE ROAD J STA. 55+59 ±

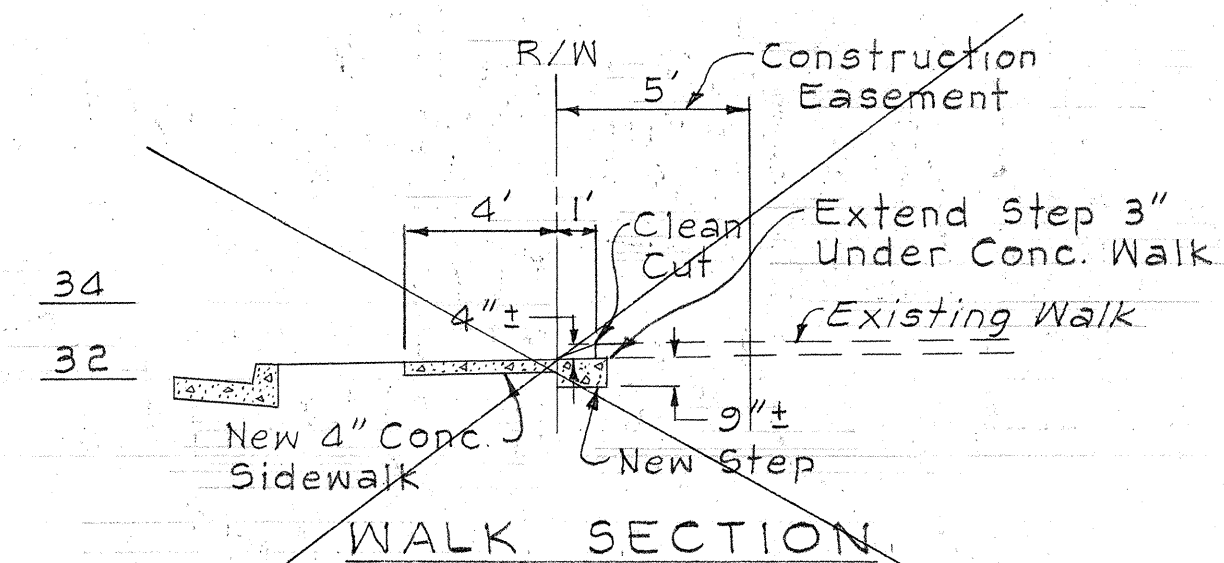


WALK AT 1256 LUNALILO ST.
FRONTAGE ROAD J STA. 59+38 ±

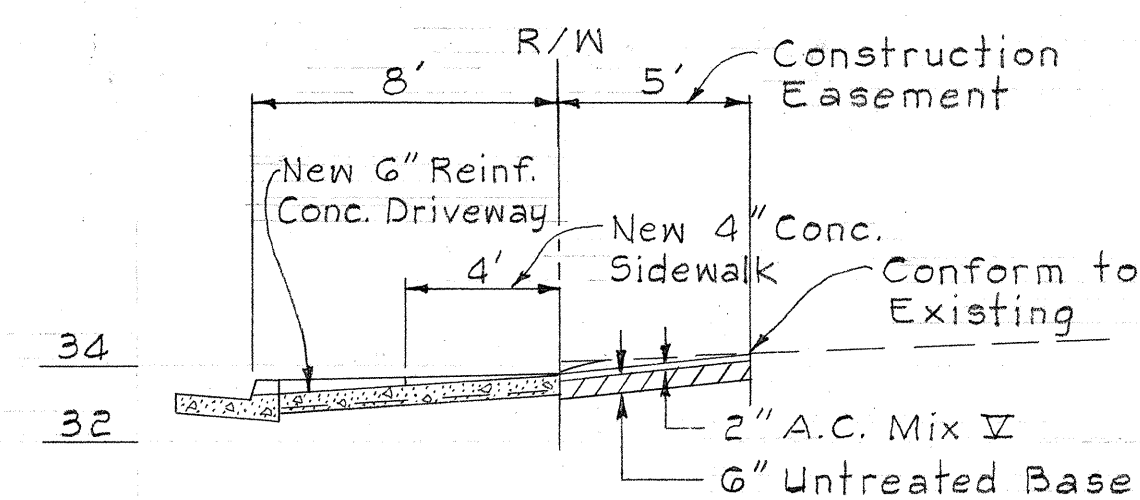


DRIVEWAY AT 1332B LUNALILO ST.
FRONTAGE ROAD J STA. 63+67 ±

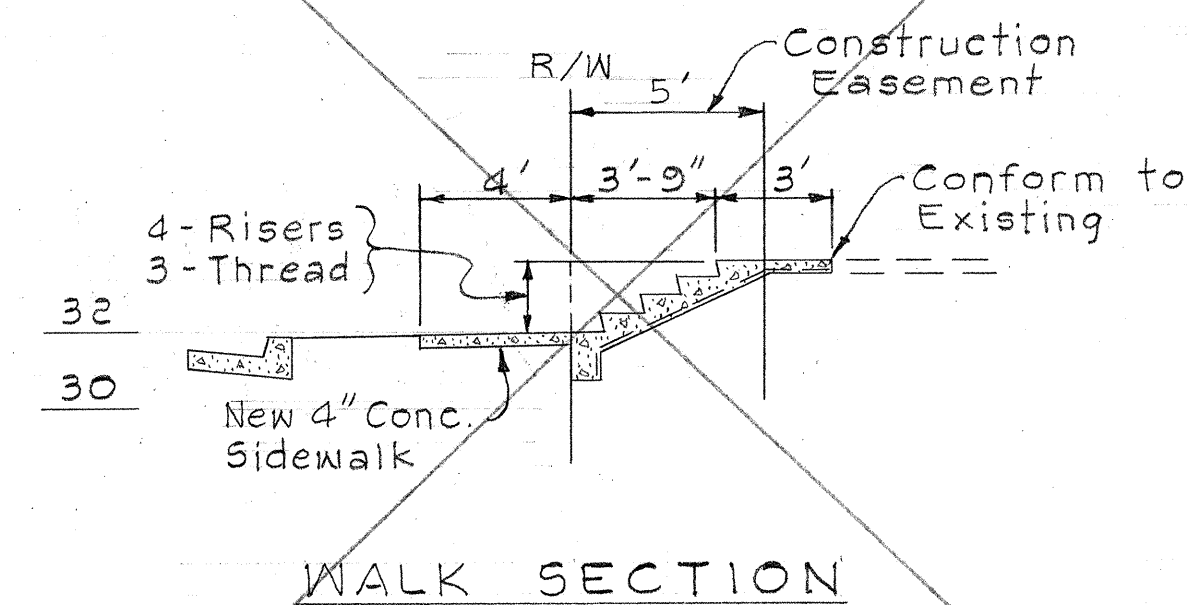


WALK AT 1238 LUNALILO ST.
FRONTAGE ROAD J STA. 57+38 ±

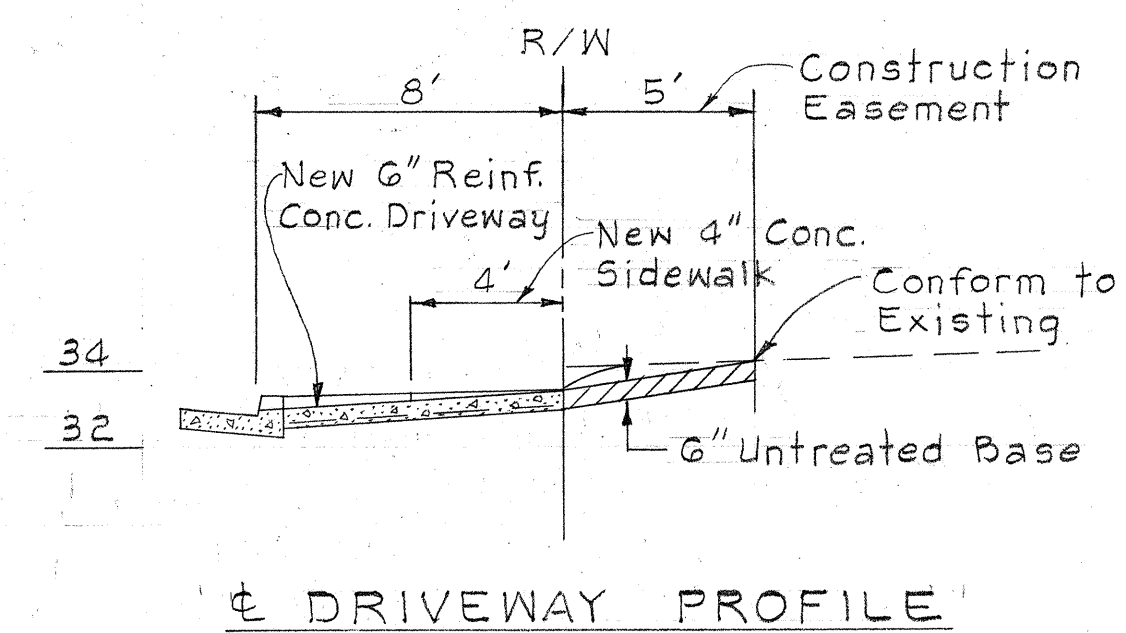


DRIVEWAY AT 1318 LUNALILO ST.
FRONTAGE ROAD J STA. 62+55 ±

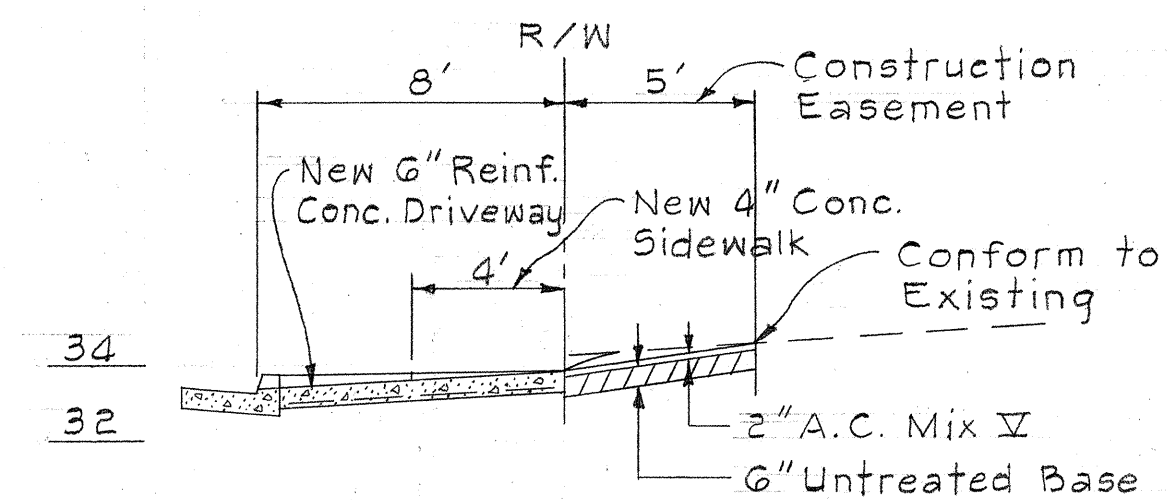

DRIVEWAY AT 1332C LUNALILO ST.
FRONTAGE ROAD J STA. 64+20 ±

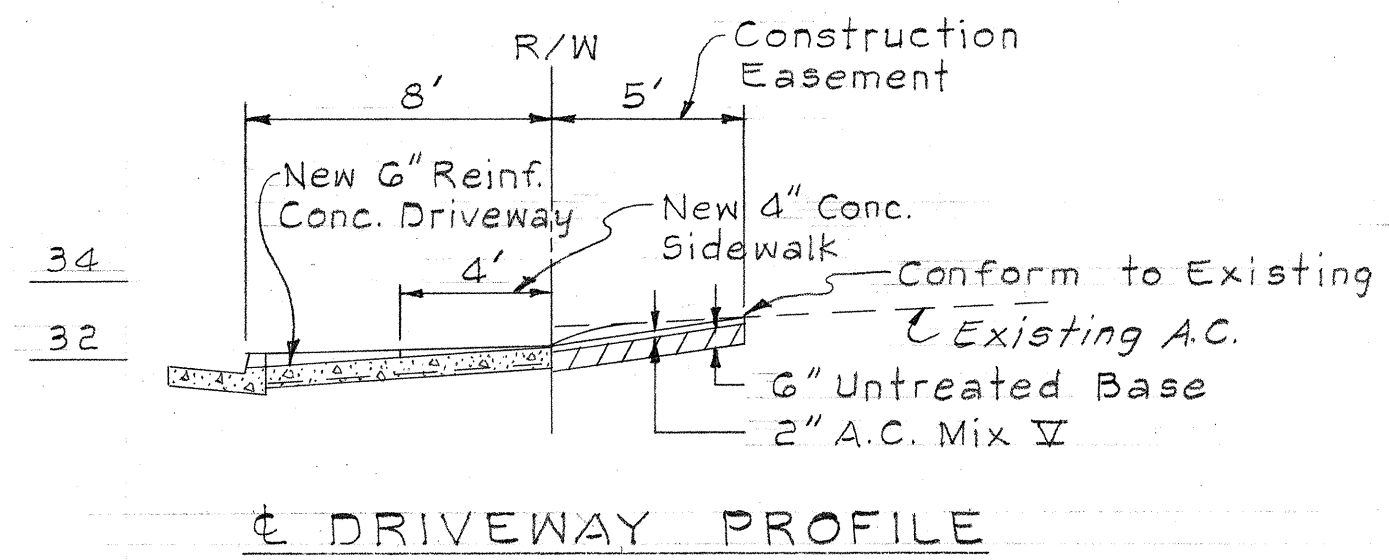

DRIVEWAY AT 1248 LUNALILO ST.
FRONTAGE ROAD J STA. 58+22 ±

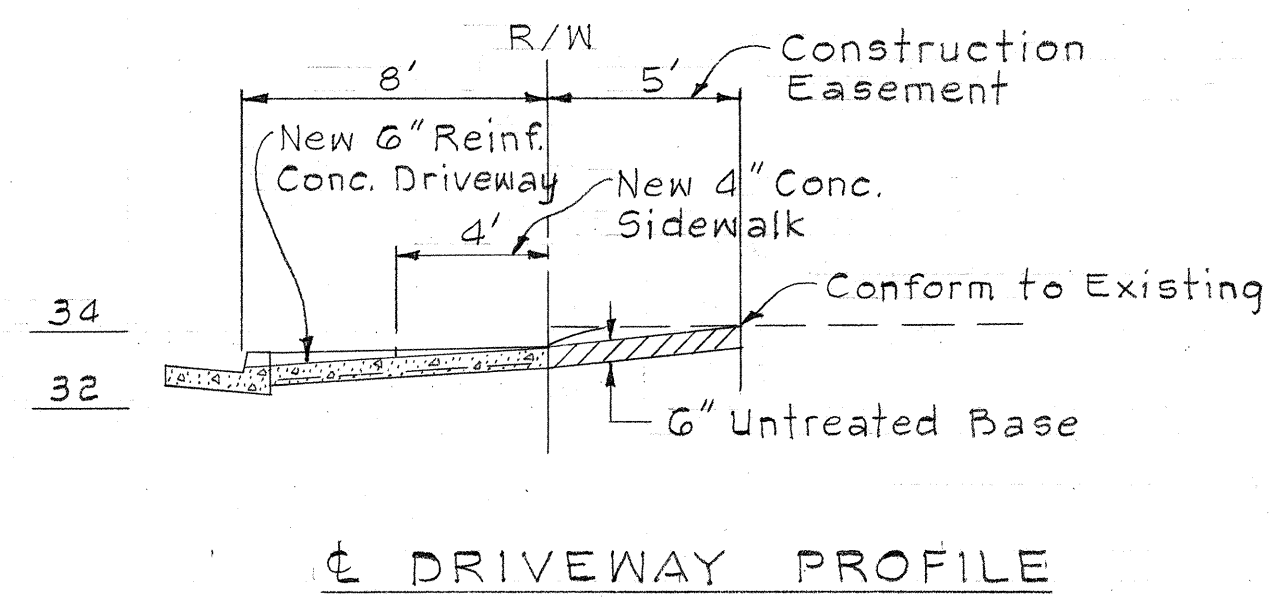

DRIVEWAY AT 1324 LUNALILO ST.
FRONTAGE ROAD J STA. 62+91 ±

SCALE: Horiz. 1" = 5'
Vert. 1" = 5'

STATE OF HAWAII
DEPARTMENT OF TRANSPORTATION
HIGHWAYS DIVISION

PROFILE OF
DRIVEWAYS & STEPS

INTERSTATE ROUTE H-1
(Victoria St. to Keeaumoku St.)
F.A.I. Proj. No. I-HI-1(31), Unit 2

Scale: As Noted Date: April, 1967

SHEET No. OF SHEETS