
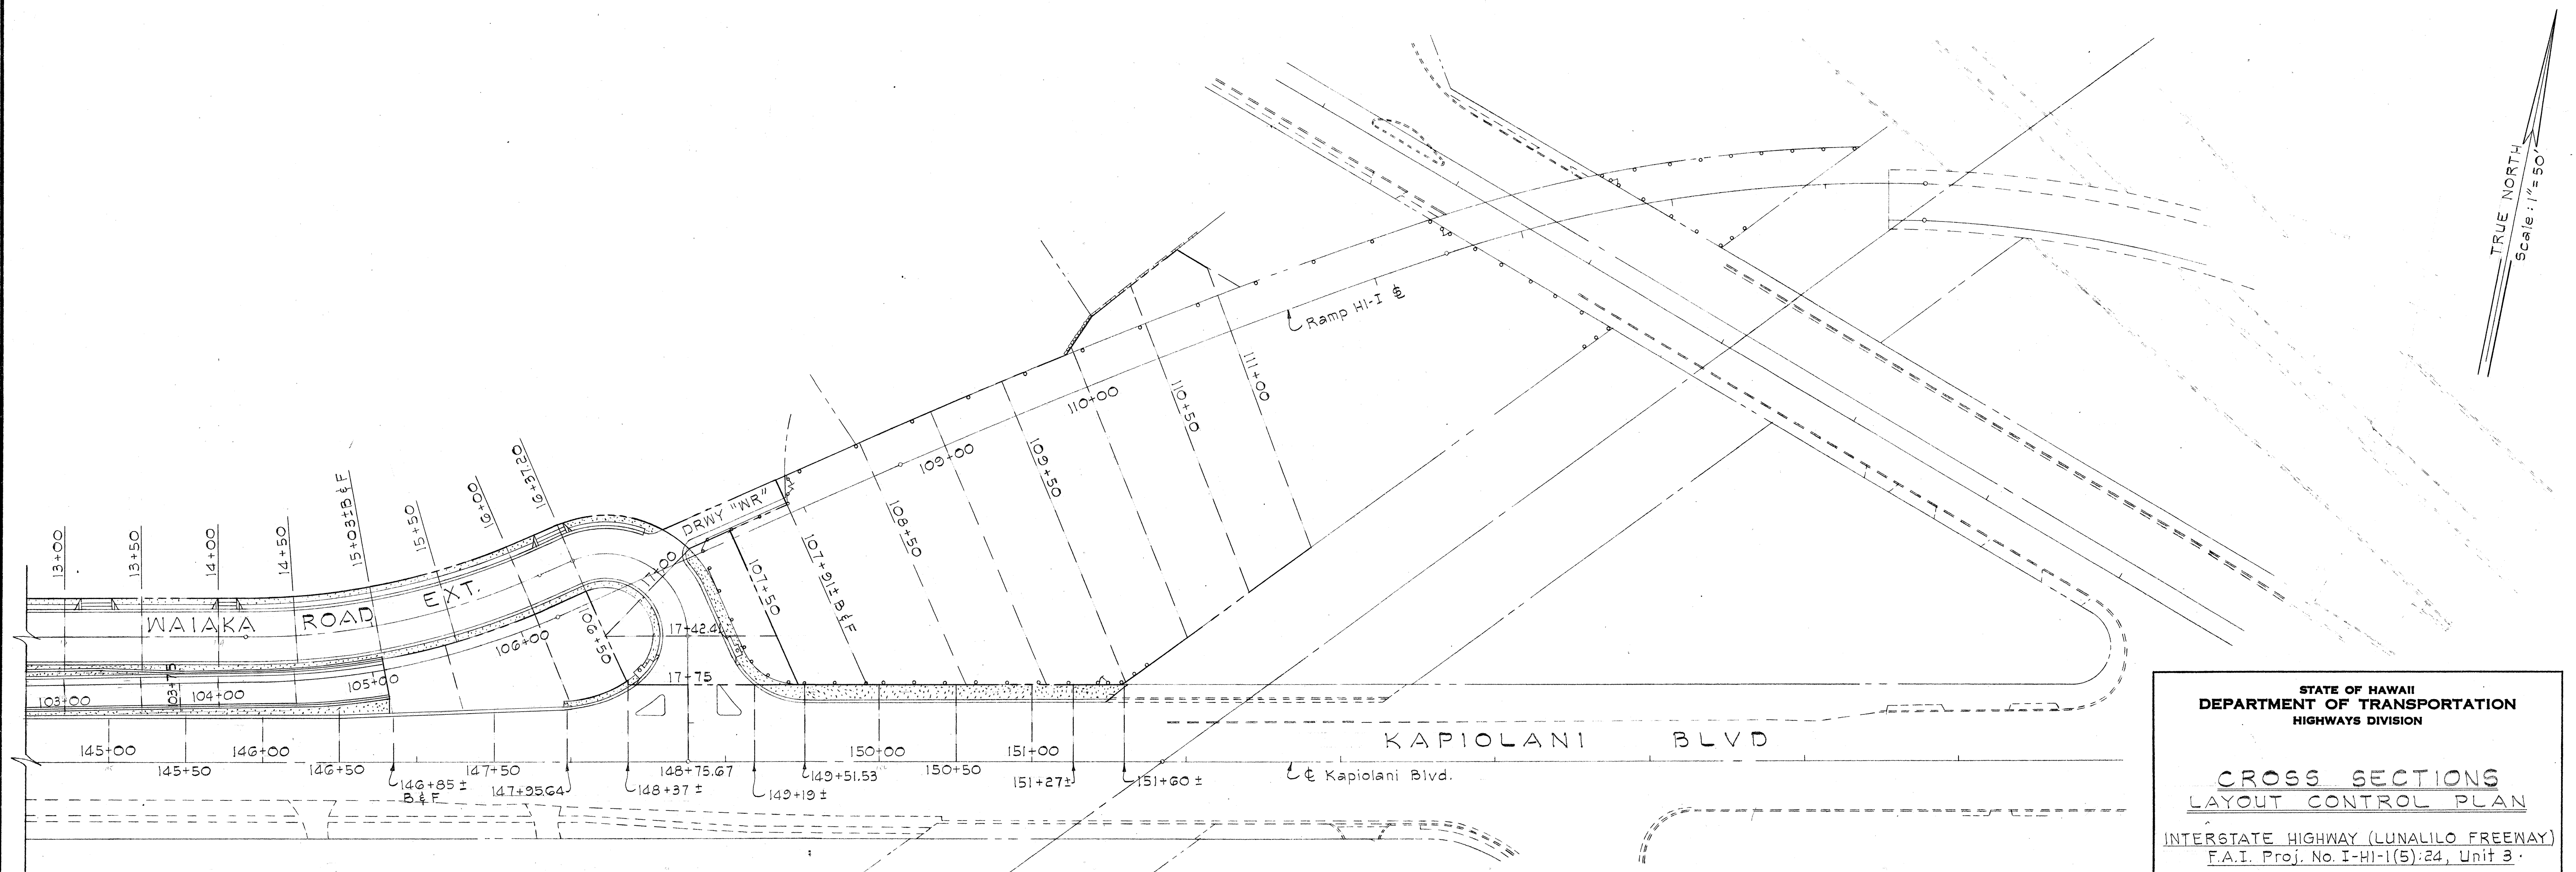


FED. ROAD DIST. NO.	STATE	FED. AID PROJ. NO.	FISCAL YEAR	SHEET NO.	TOTAL SHEETS
HAWAII	HAW.	I-HI-1(5)-24 Unit 3	1967	144	152

REVISED: Nov. 21, 1967

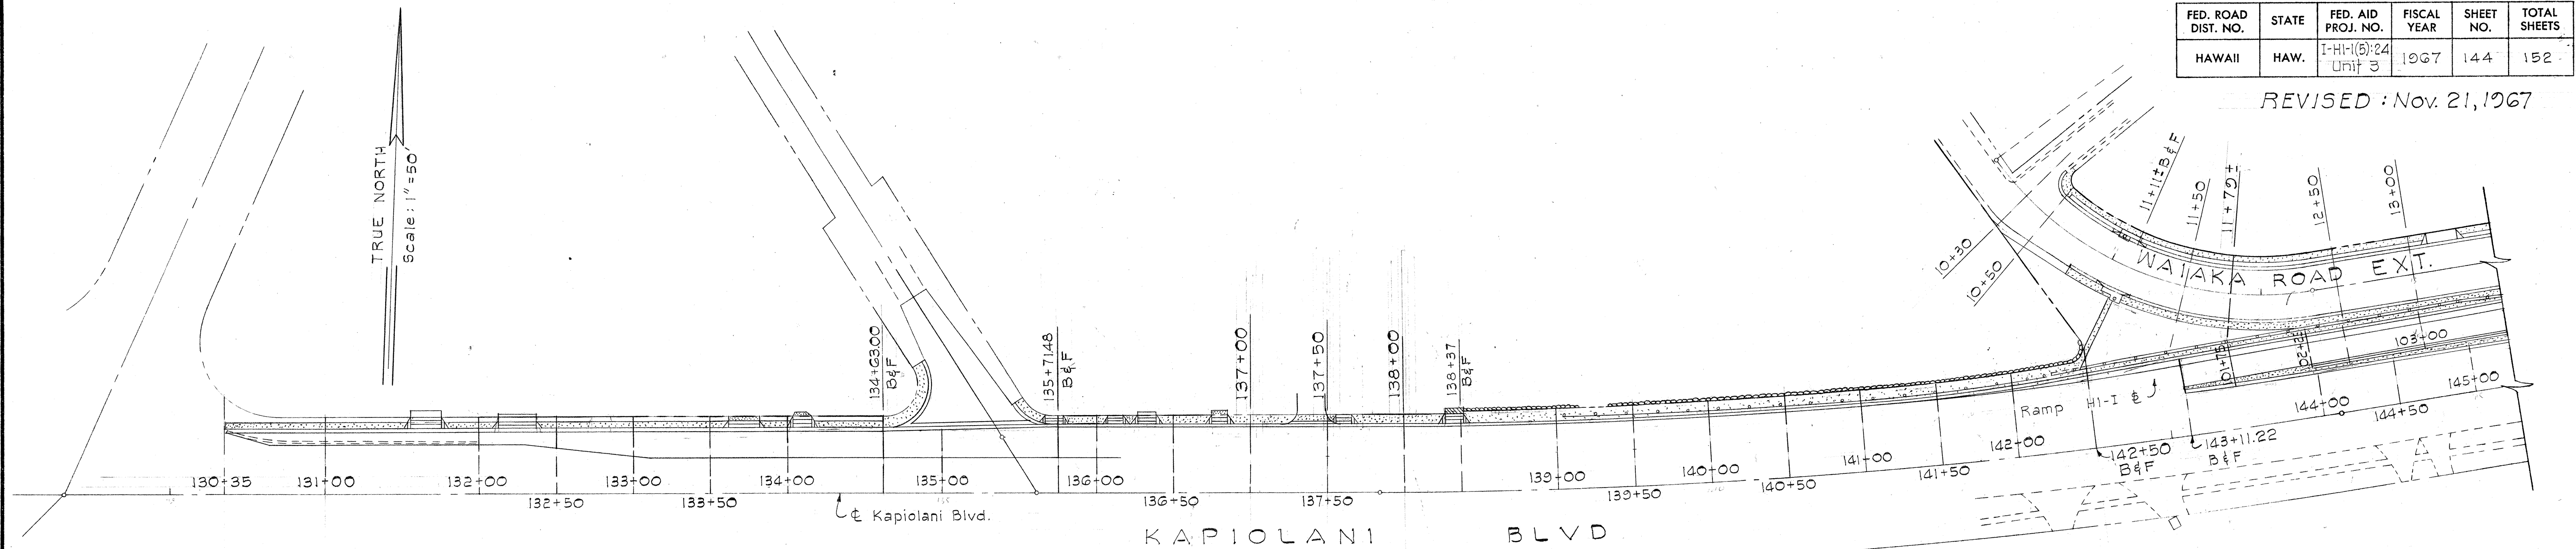

THIS SHT. SUPERSEDES SHT. No. 144

STATE OF HAWAII
DEPARTMENT OF TRANSPORTATION
HIGHWAYS DIVISION

CROSS SECTIONS
LAYOUT CONTROL PLAN

INTERSTATE HIGHWAY (LUNALILO FREEWAY)
F.A.I. Proj. No. I-HI-1(5)-24, Unit 3

Scale: 1" = 50' Date: May, 1967


SHEET No. OF SHEETS

144

SURVEY PLANNED BY	DATE
DRAWN BY	
DESIGNED BY	
NOTED BY	
CHECKED BY	
NO.	

DATE	
BY	
ORIGINAL SURVEY	
NOTED	
NO.	

DATE	
BY	
ORIGINAL SURVEY	
NOTED	
NO.	

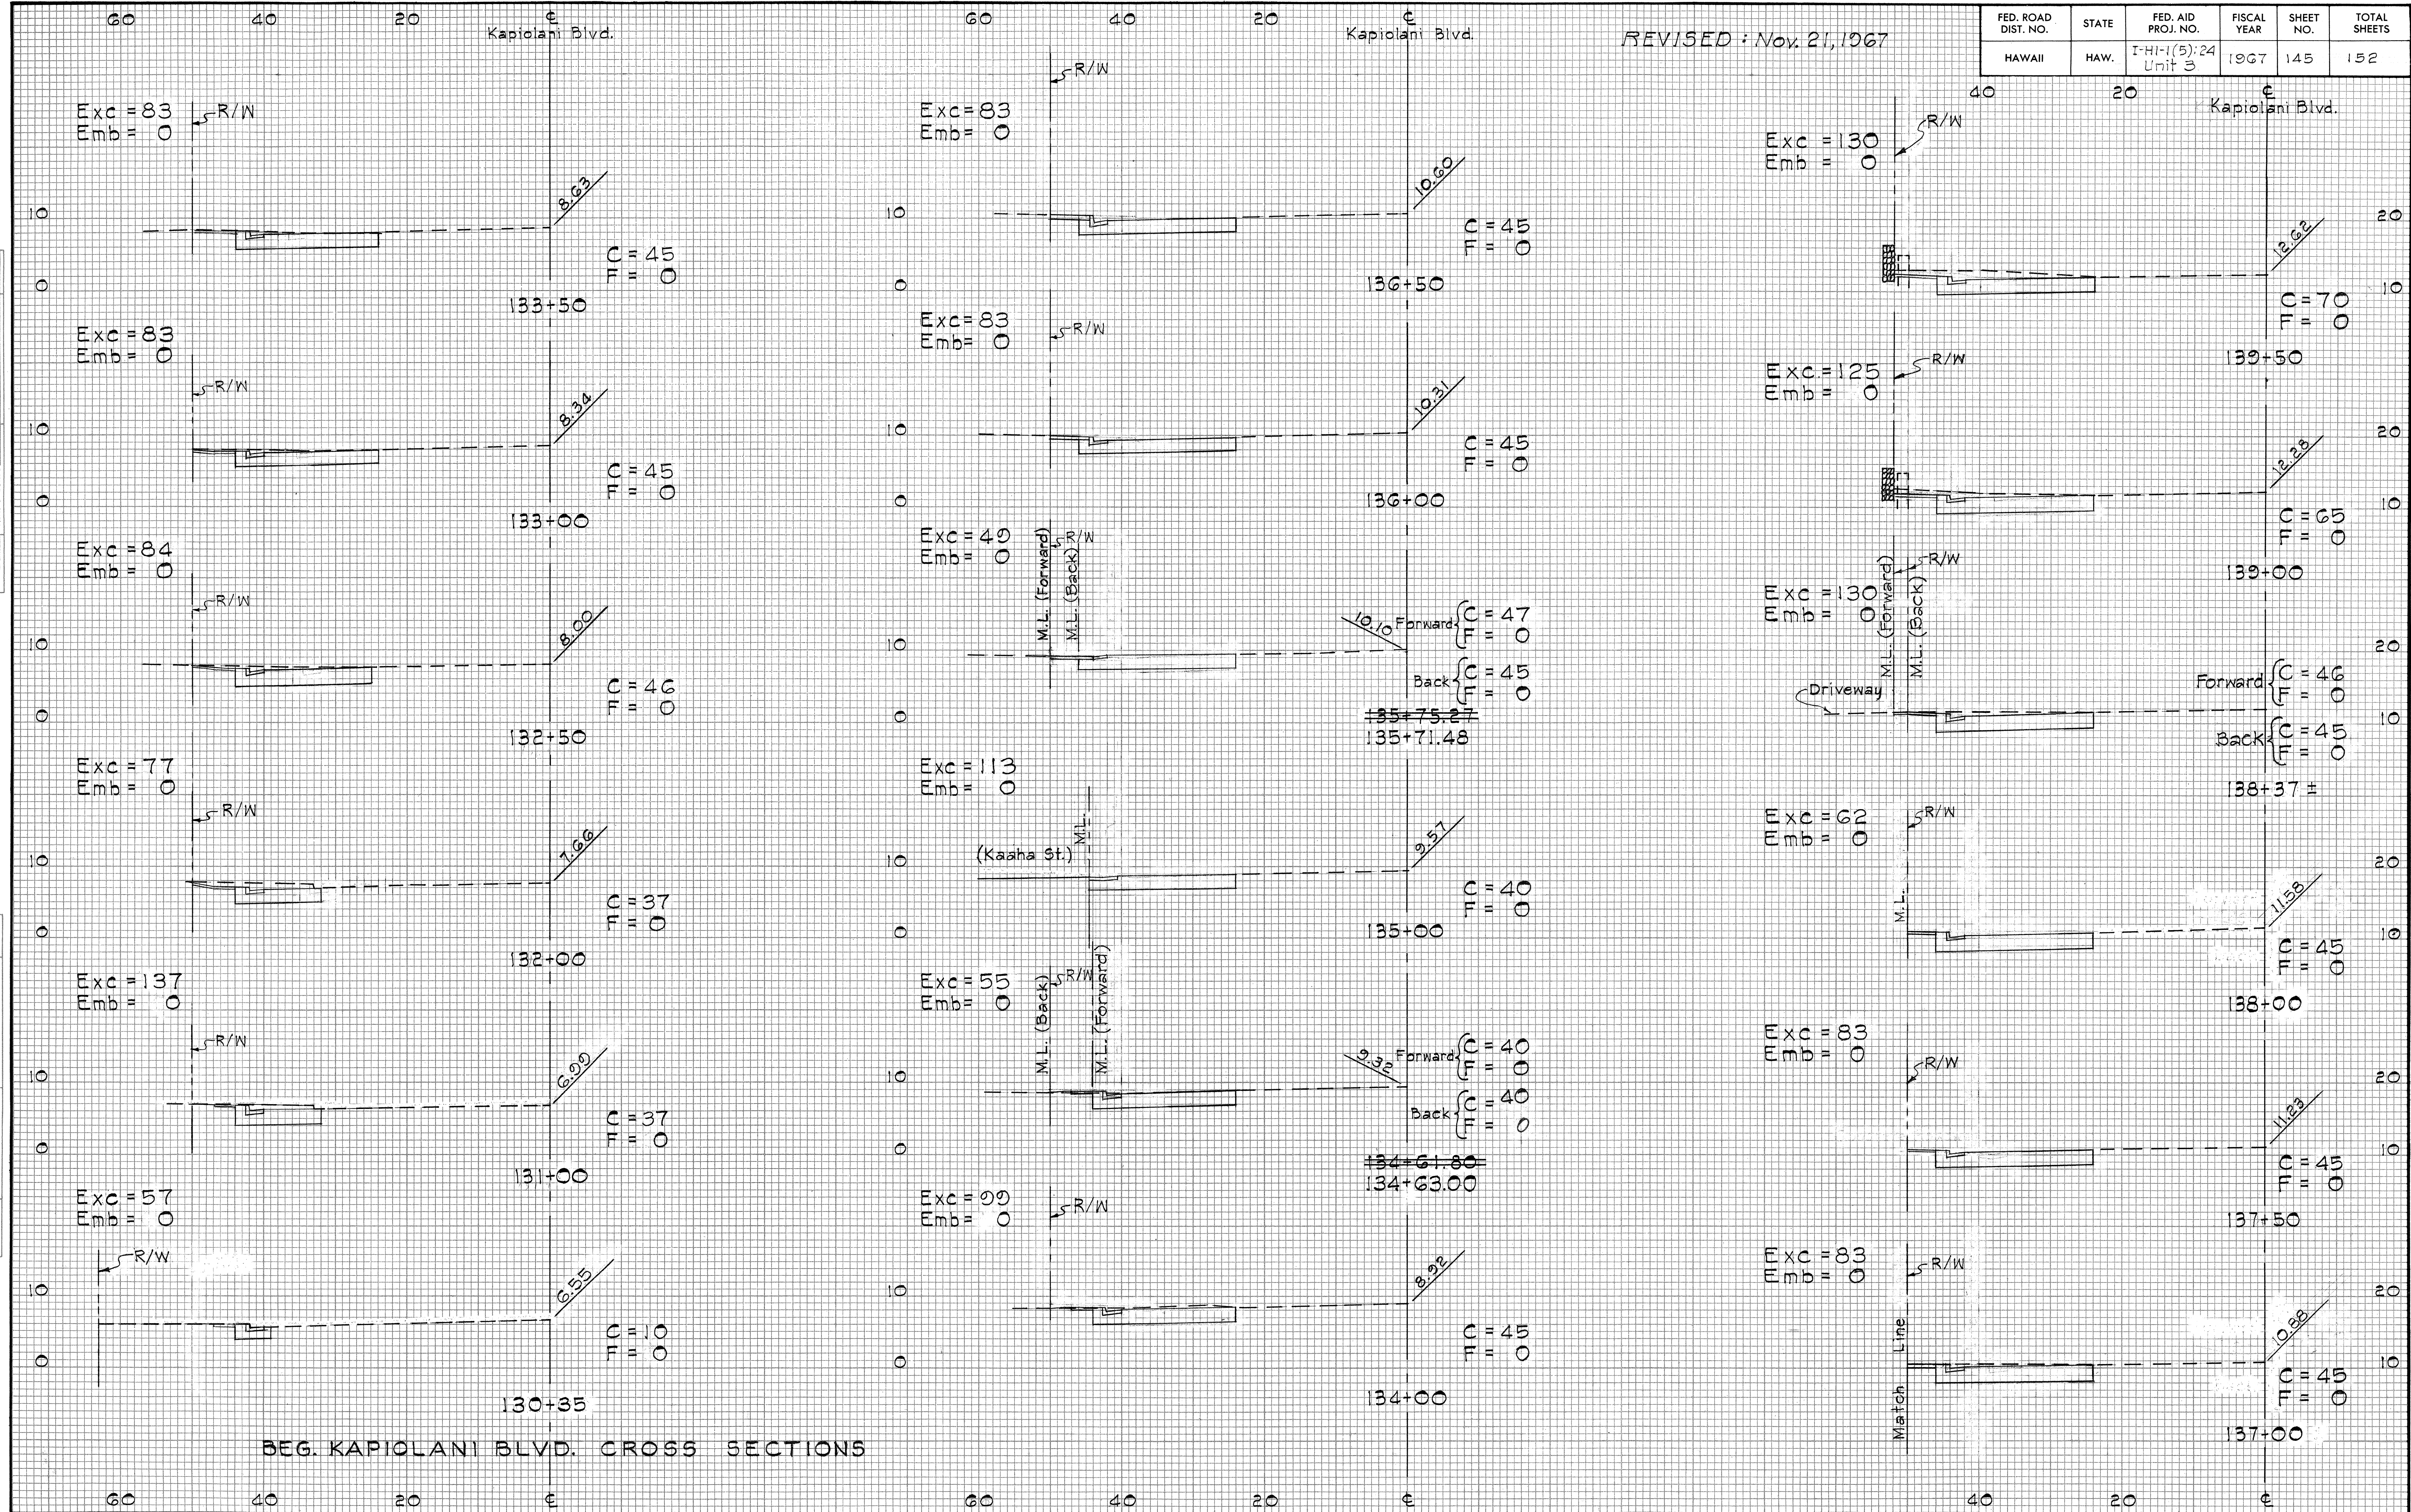

REVISED: Nov. 21, 1967


FED. ROAD DIST. NO.	STATE	FED. AID PROJ. NO.	FISCAL YEAR	SHEET NO.	TOTAL SHEETS
HAWAII	HAW.	I-HI-1(5):24 Unit 3	1967	145	152

FED. ROAD DIST. NO.	STATE	FED. AID PROJ. NO.	FISCAL YEAR	SHEET NO.	TOTAL SHEETS
HAWAII	HAW.	I-HI-1(5):24 Unit 3	1967	147	152

REVISED: Nov. 21, 1967

FINAL SURVEY	DATE
SURVEYED	BY
NOTE BOOK	NO.
PLATE	
AREAS CHECKED	

ORIGINAL SURVEY	DATE
SURVEYED	BY
NOTE BOOK	NO.
PLATE	
AREAS CHECKED	

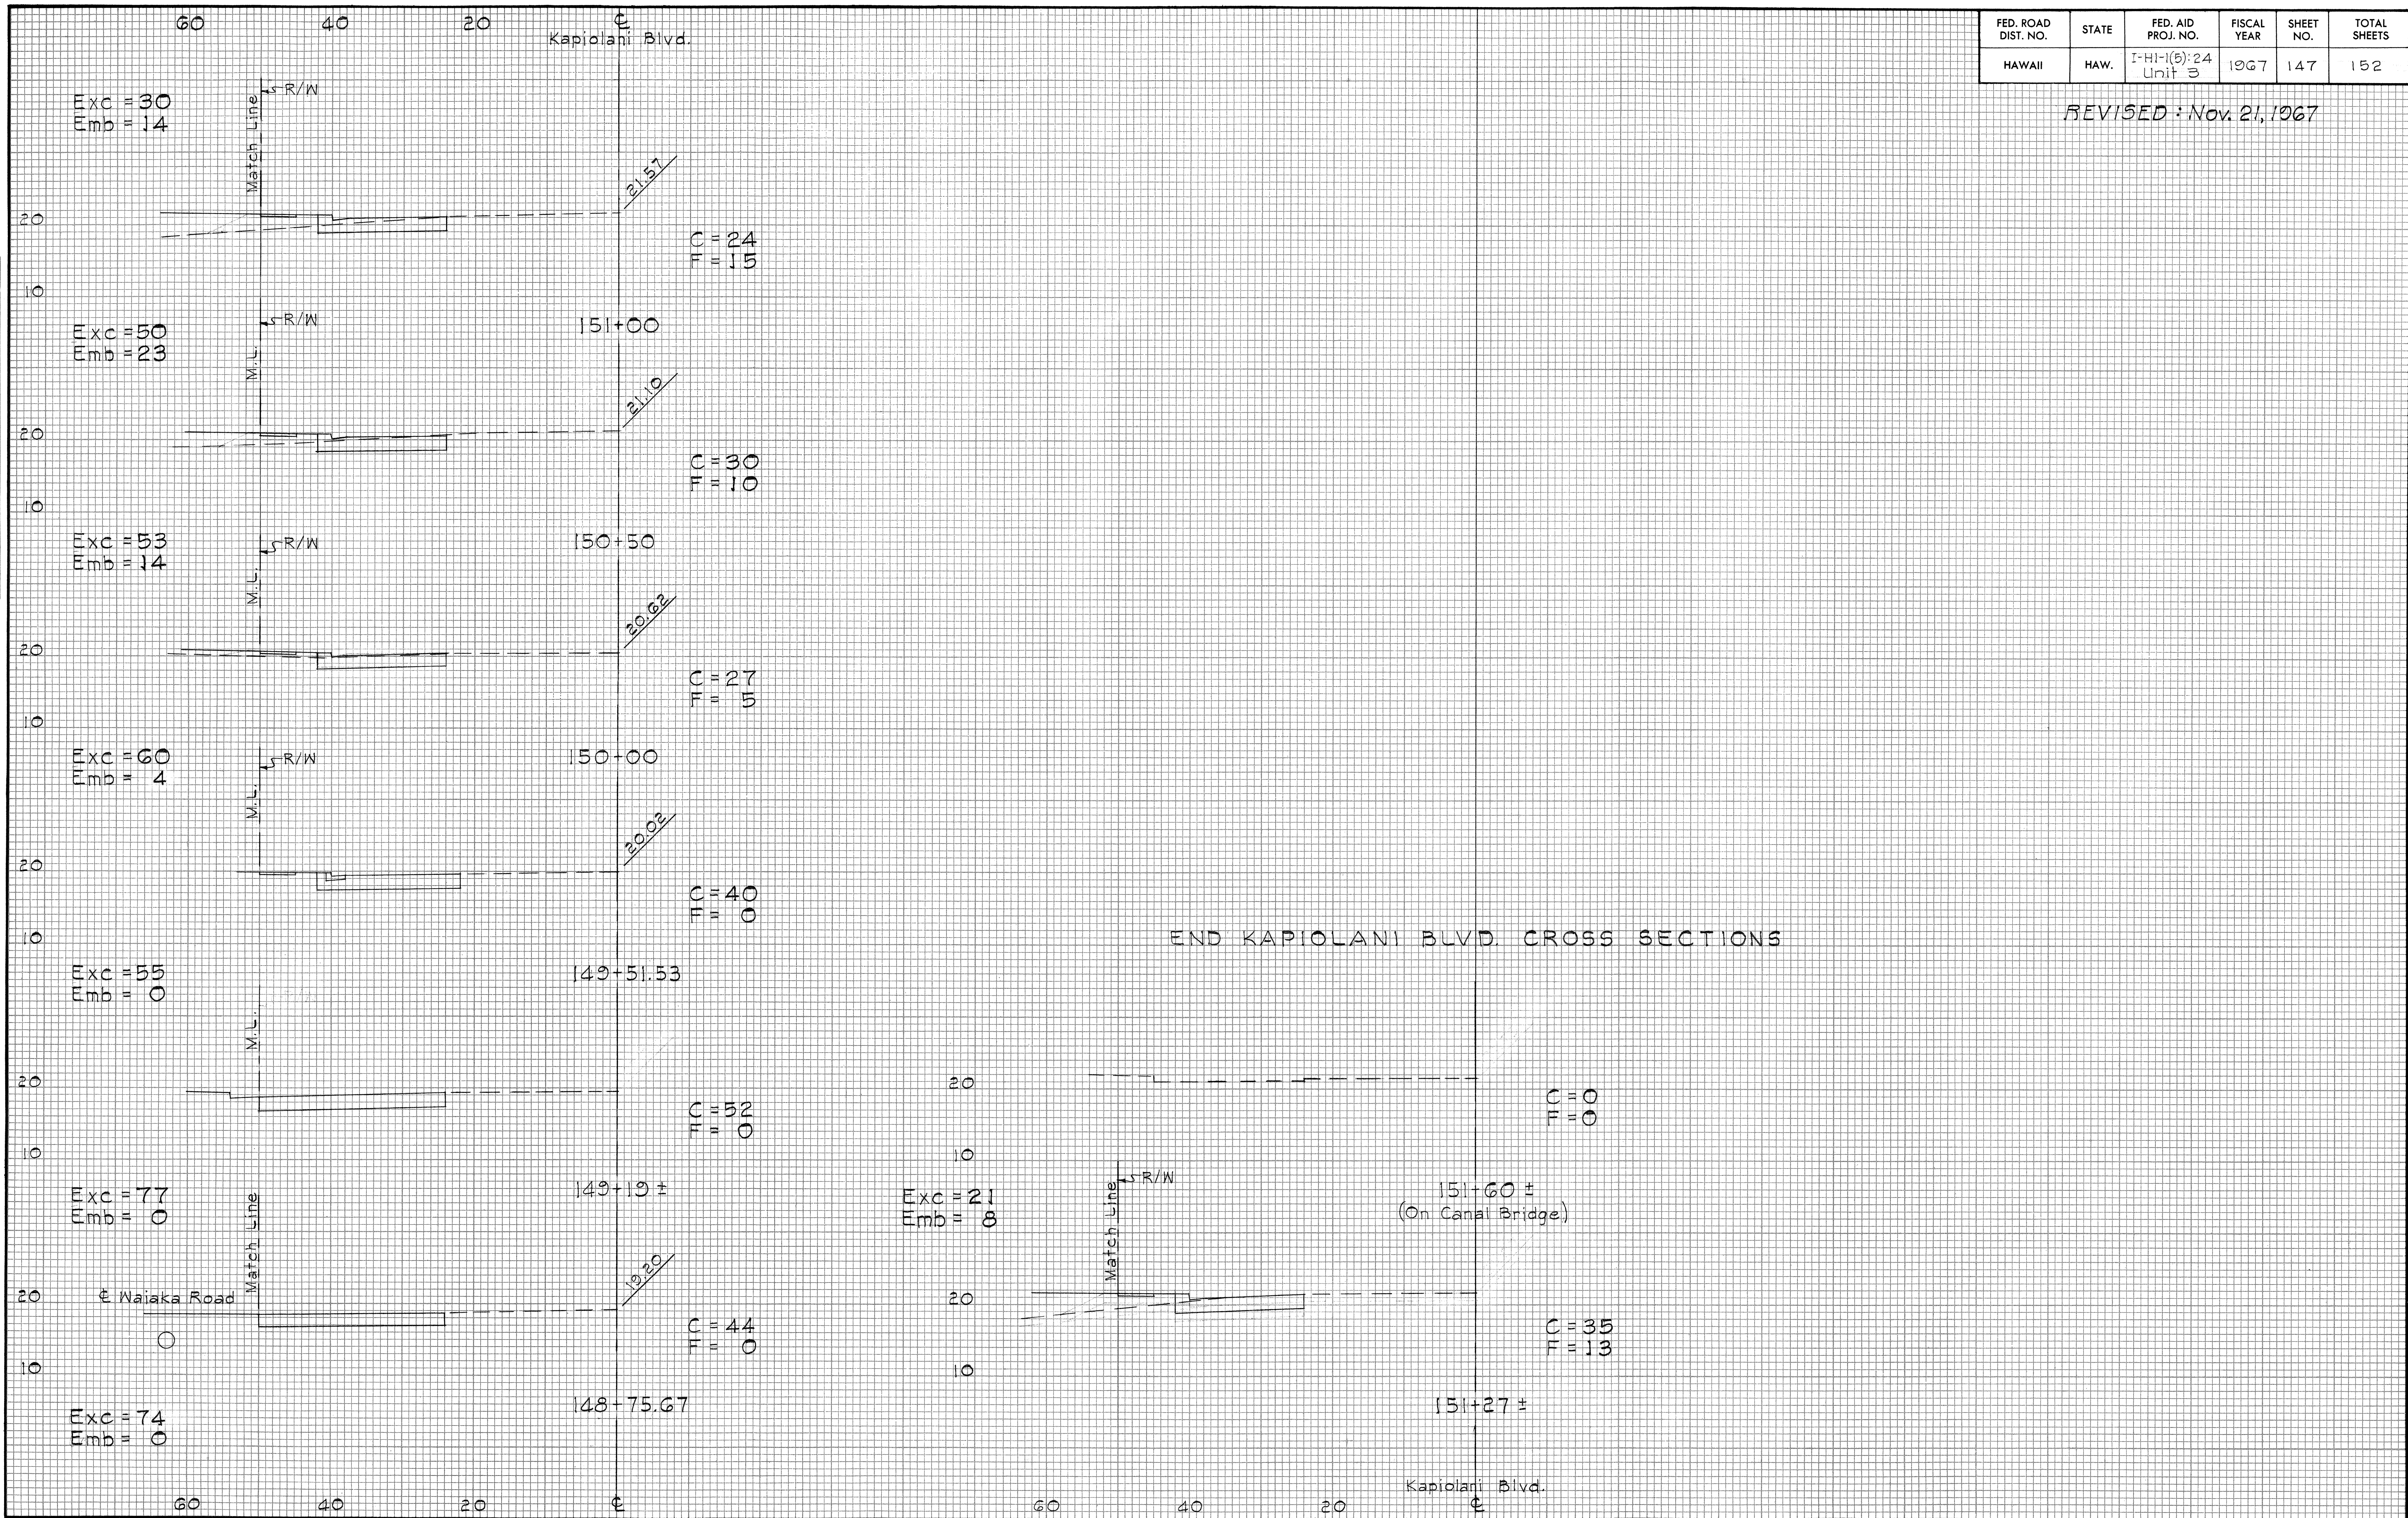


FED. ROAD DIST. NO.	STATE	FED. AID PROJ. NO.	FISCAL YEAR	SHEET NO.	TOTAL SHEETS
HAWAII	HAW.	I-HI-1(5):24 Unit 3	1967	149	152

REVISED: Nov. 21, 1967

DATE	BY	FINAL SURVEY	SURVEYED	PLOTTED	TEMPLATE	NOTE BOOK	AREAS CHECKED

DATE	BY	ORIGINAL SURVEY	SURVEYED	PLOTTED	TEMPLATE	NOTE BOOK	AREAS CHECKED

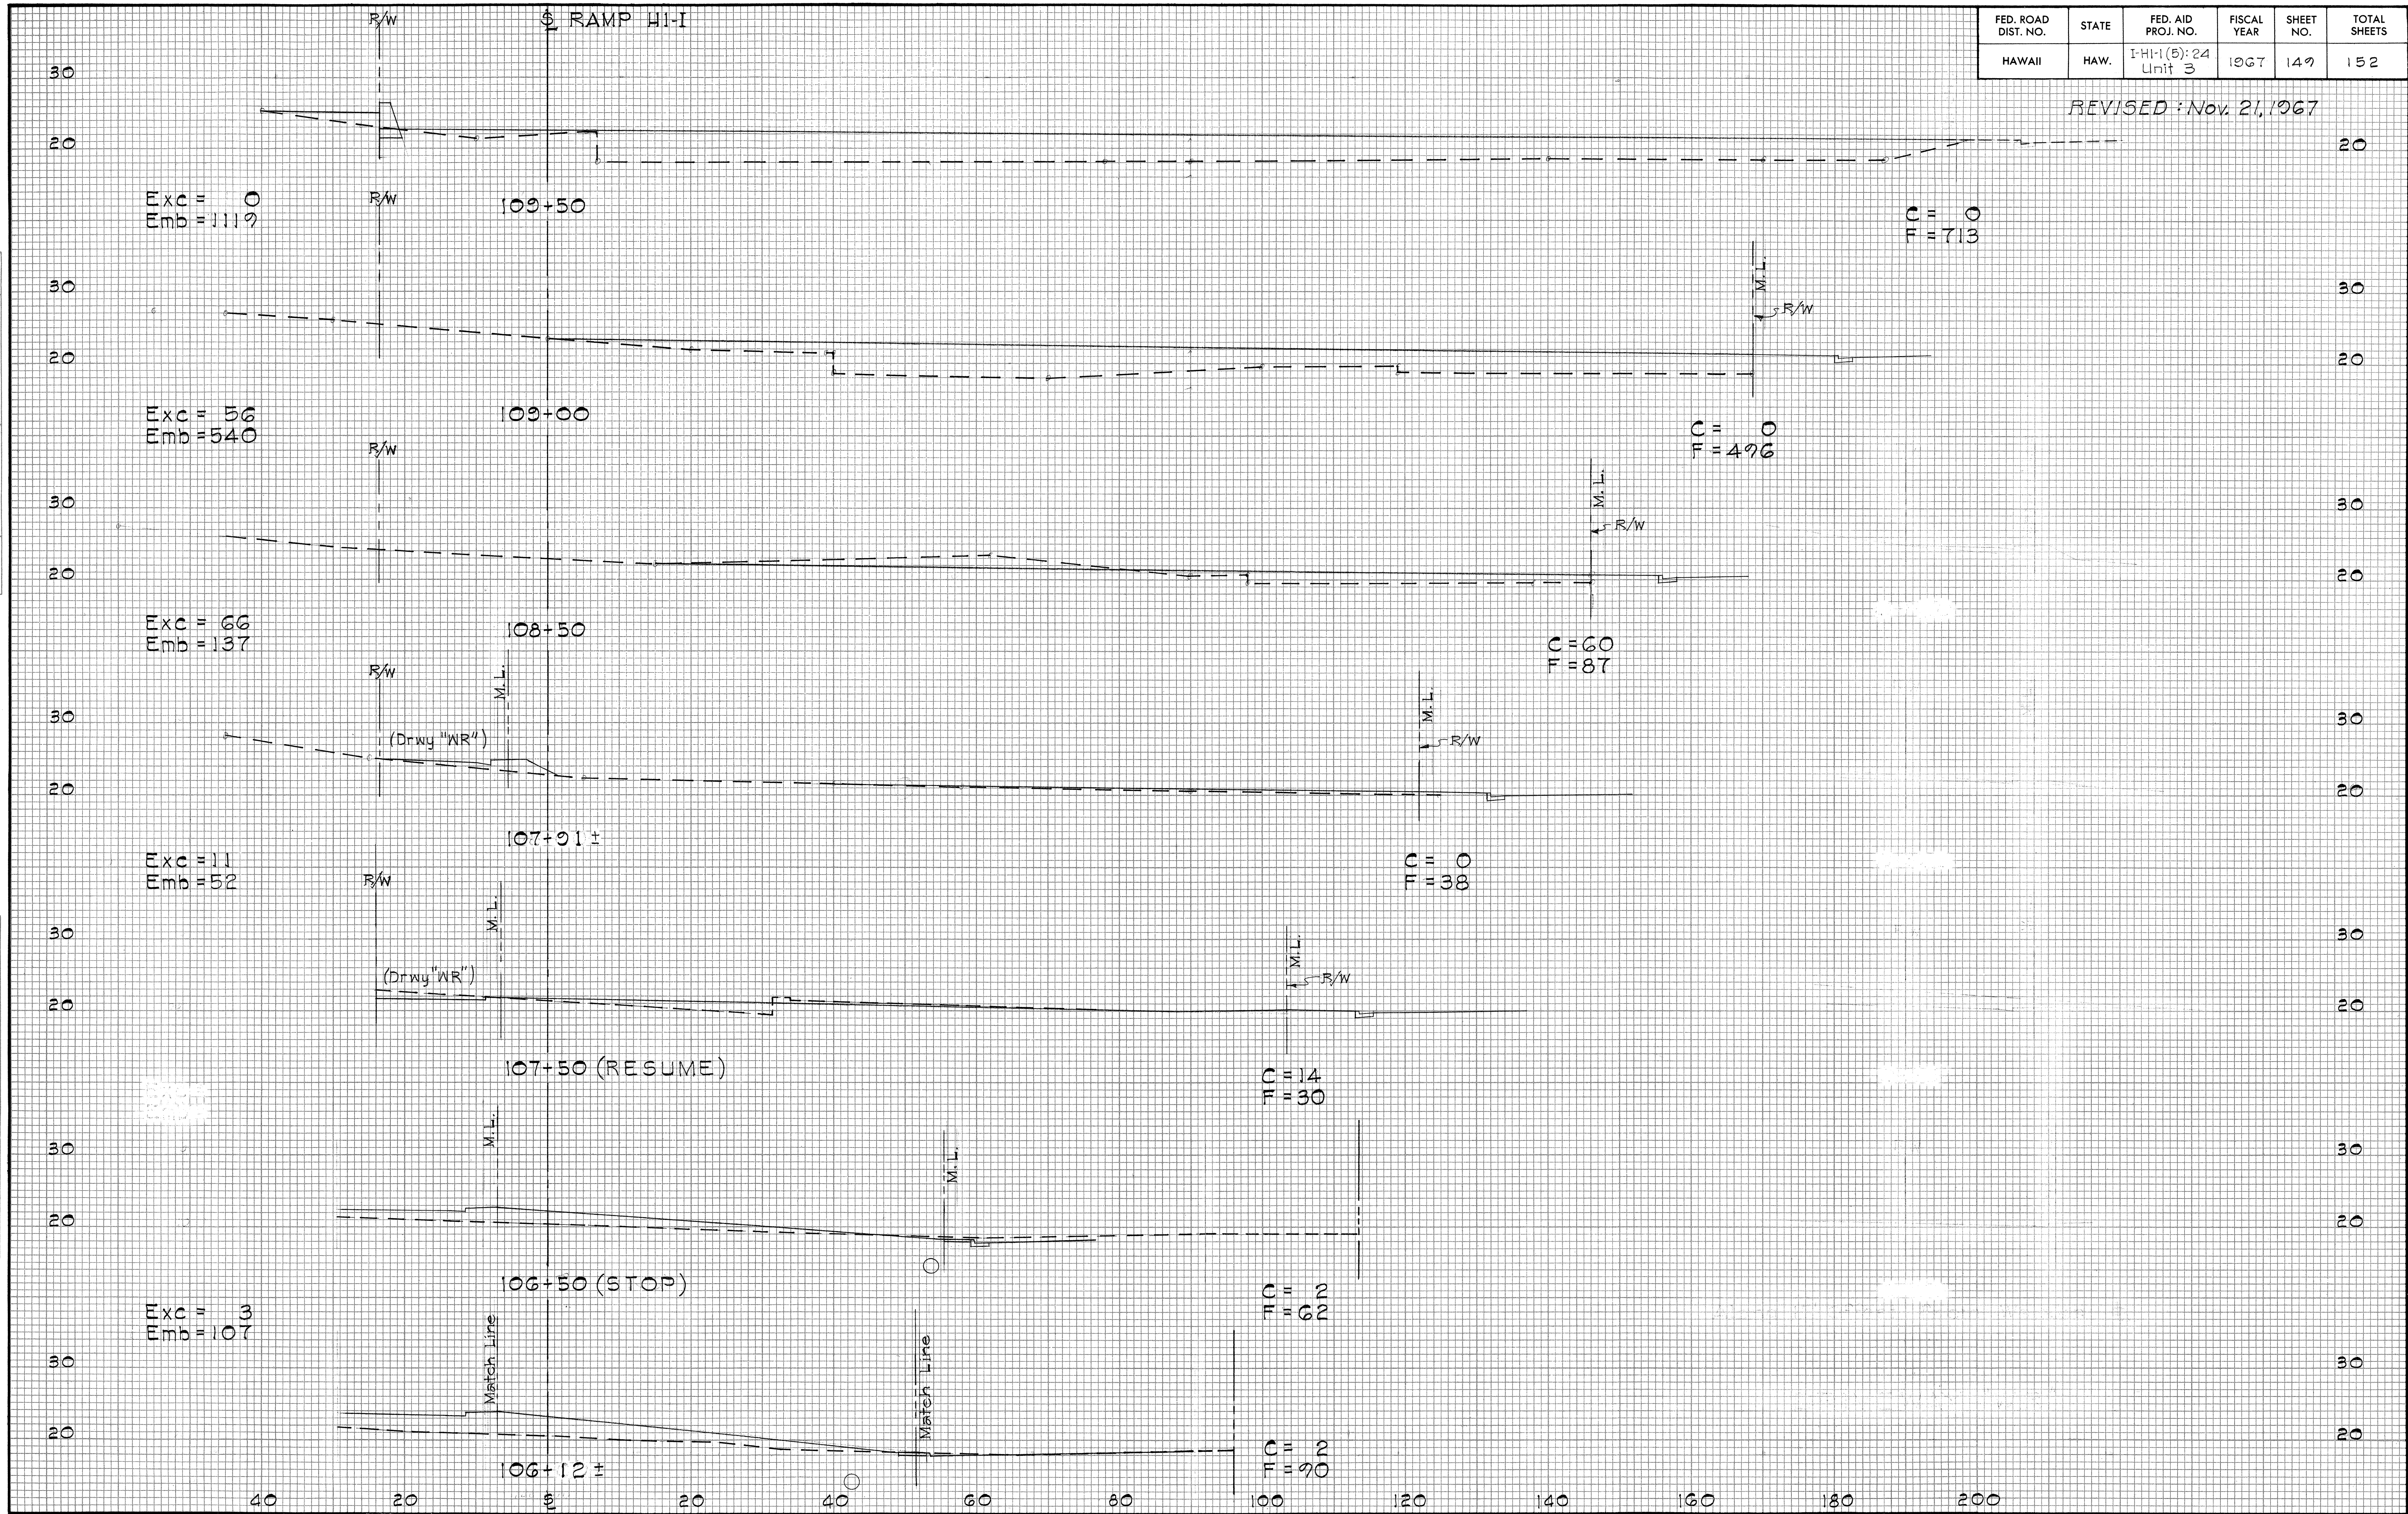


FED. ROAD DIST. NO.	STATE	FED. AID PROJ. NO.	FISCAL YEAR	SHEET NO.	TOTAL SHEETS
HAWAII	HAW.	I-HI-1(5):24 Unit 3	1967	150	152

FINAL SURVEY NOTE BOOK NO.	SURVEYED PLOTTED TEMPLATE AREAS CHECKED	BY	DATE

ORIGINAL SURVEY NOTE BOOK NO.	SURVEYED PLOTTED TEMPLATE AREAS CHECKED	BY	DATE

END RAMP HI-I CROSS SECTIONS

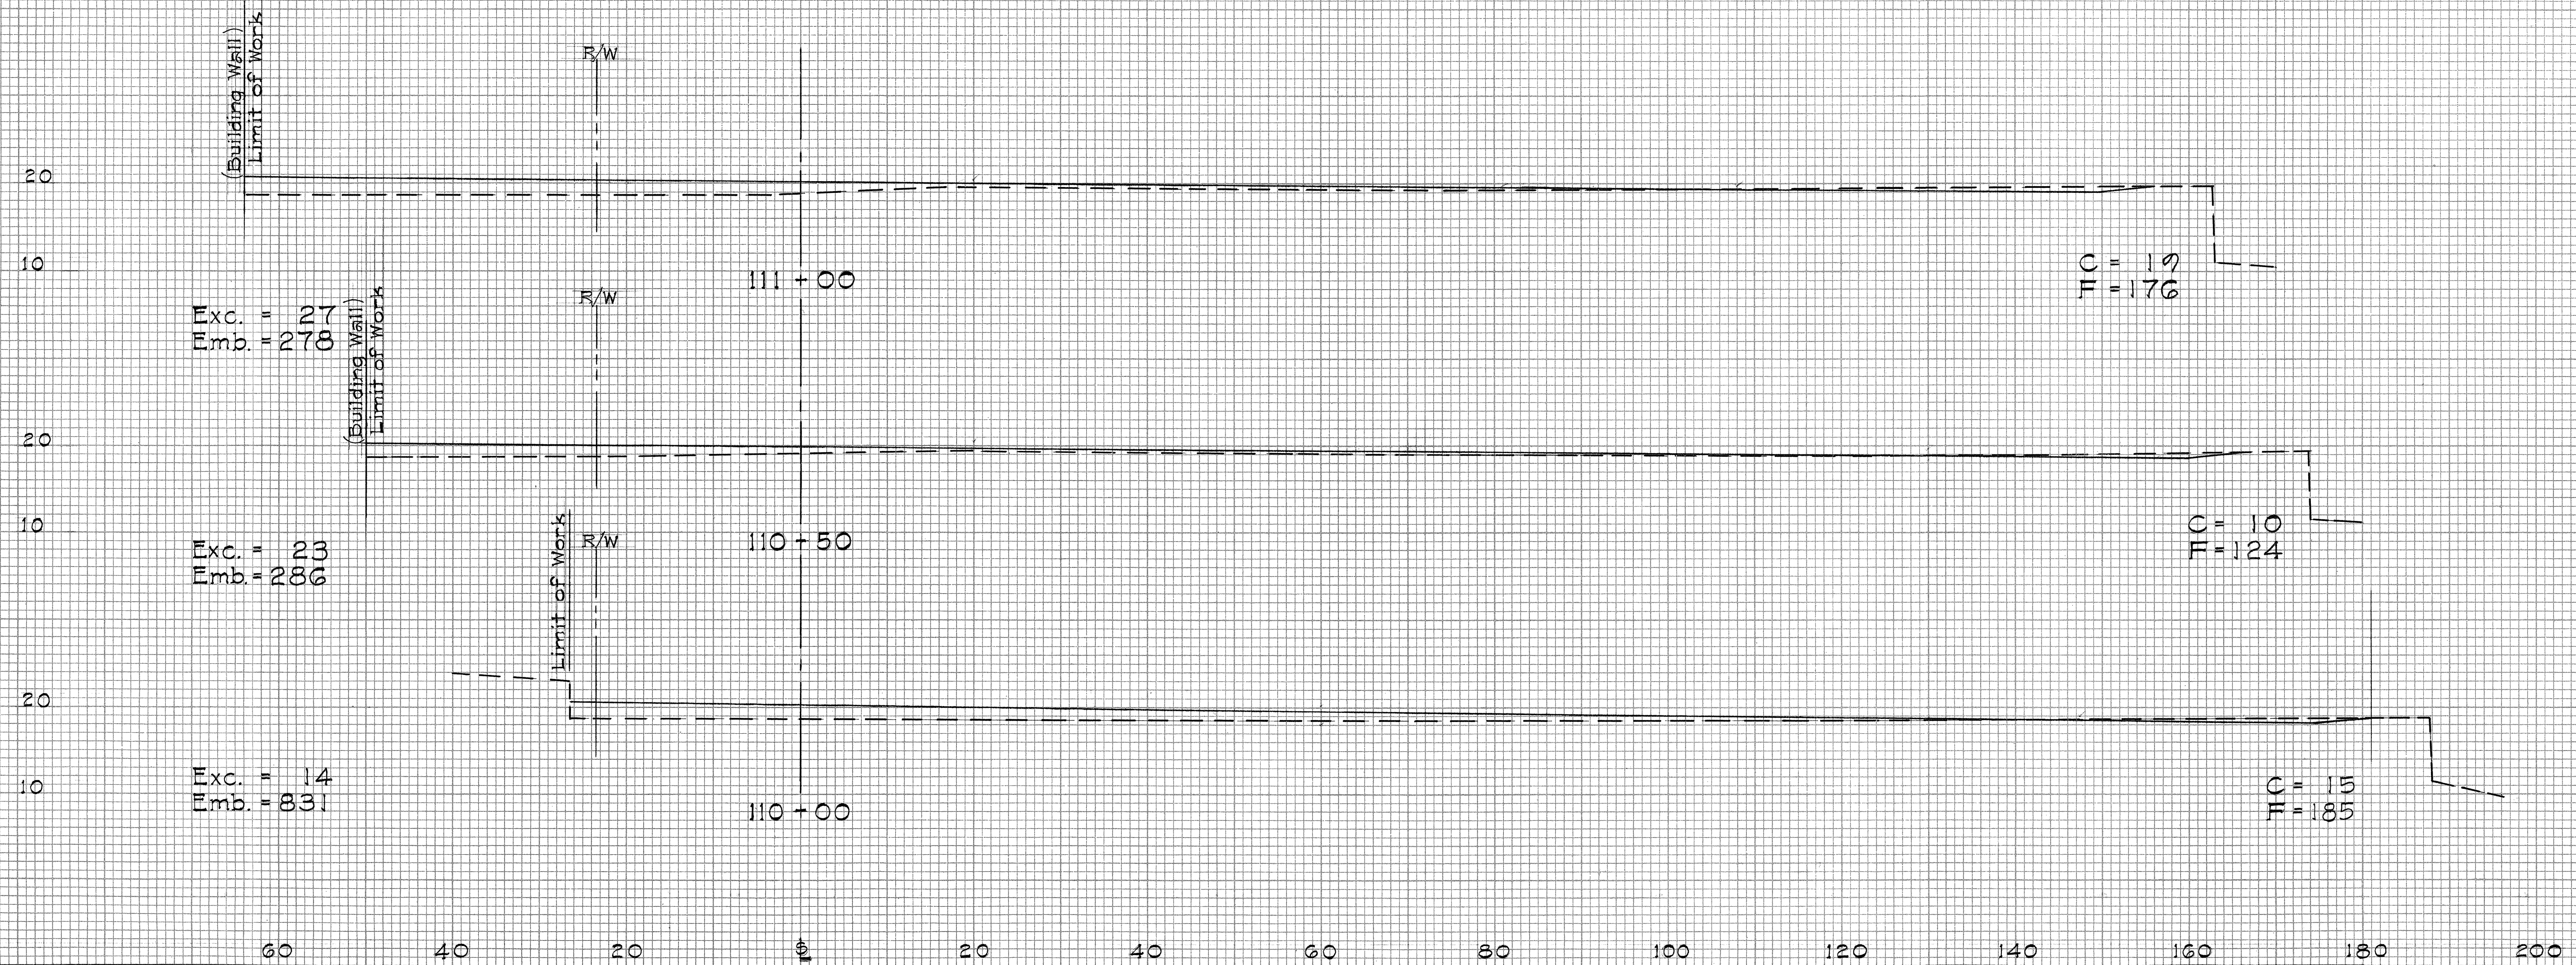


DATE
BY
SURVEYED
PLOTTED
NOTE BOOK
NO.

DATE
BY
SURVEYED
PLOTTED
NOTE BOOK
NO.

FED. ROAD DIST. NO.	STATE	FED. AID PROJ. NO.	FISCAL YEAR	SHEET NO.	TOTAL SHEETS
HAWAII	HAW.	I-HI-1(5):24 Unit 3	1967	151	152

REVISED: Nov. 21, 1967

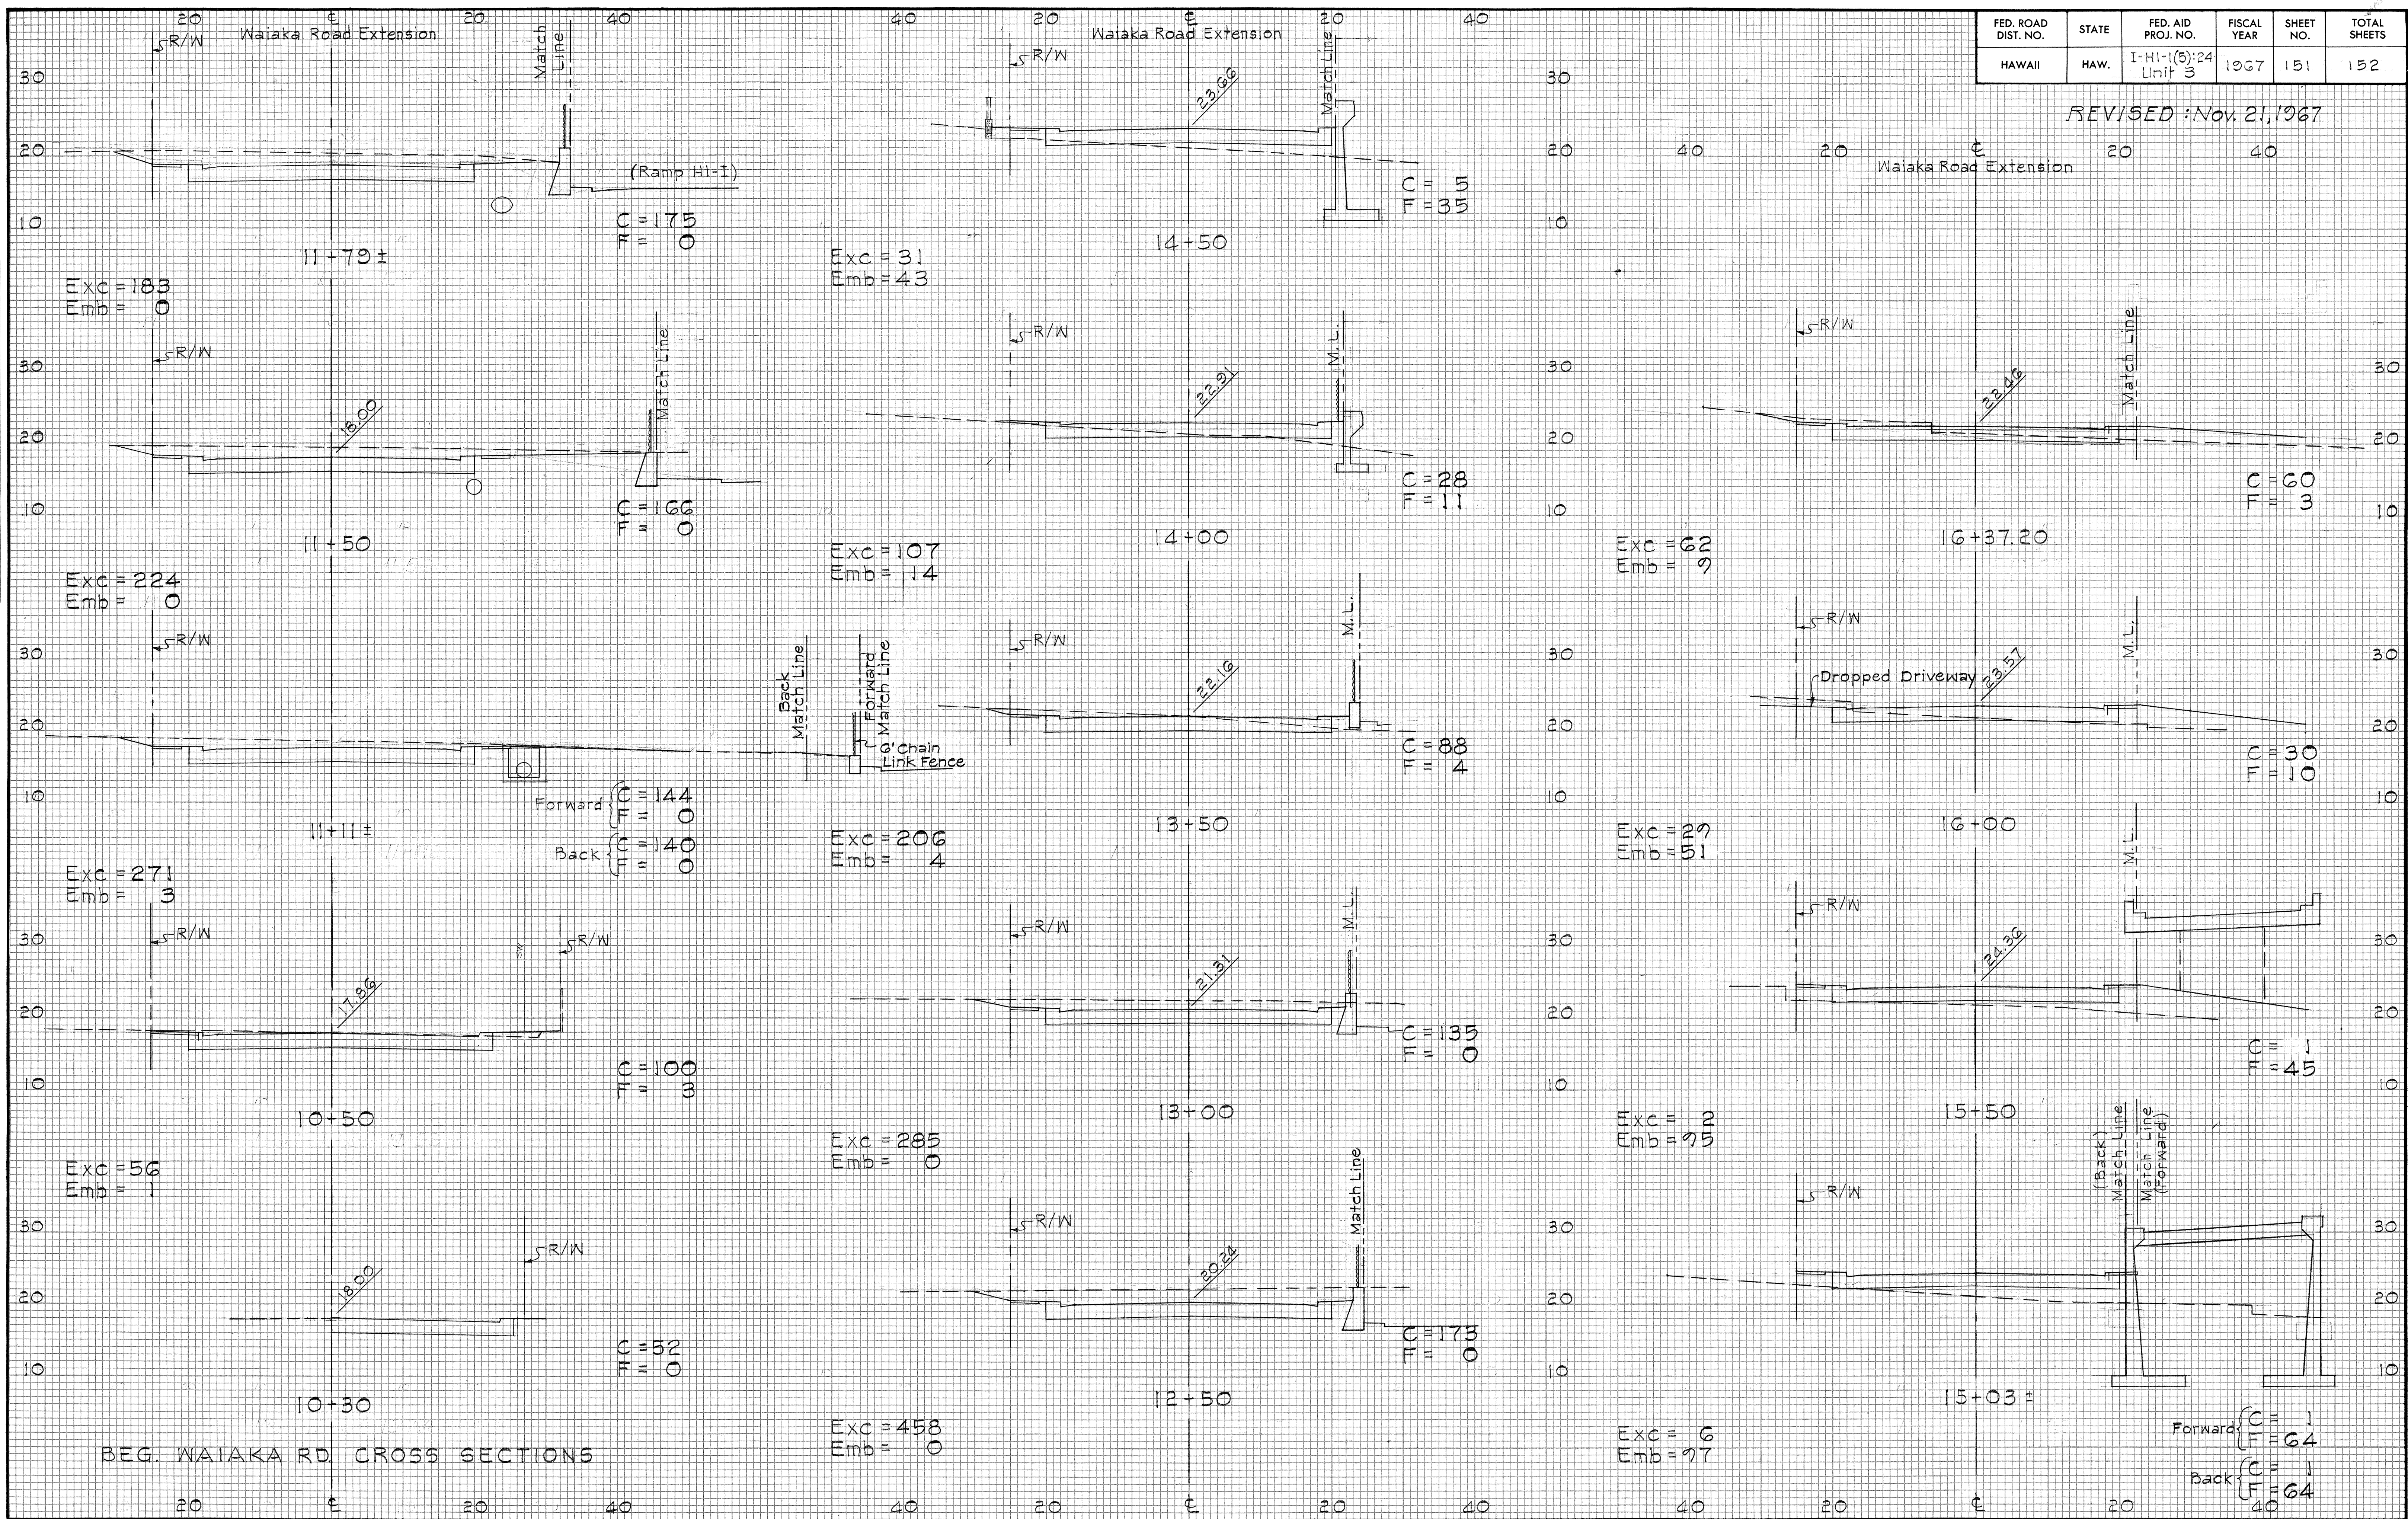

BEG. WAIAKA RD. CROSS SECTIONS

THIS SHT. SUPERSEDES SHT. No. 151

C 0 1 5 1

DATE	
BY	
FINAL SURVEY	SURVEYED
NOTE BOOK	PLOTTED
NO.	TEMPLATE
	AREAS CHECKED

DATE	
BY	
ORIGINAL SURVEY	SURVEYED
NOTE BOOK	PLOTTED
NO.	TEMPLATE
	AREAS CHECKED

FED. ROAD DIST. NO.	STATE	FED. AID PROJ. NO.	FISCAL YEAR	SHEET NO.	TOTAL SHEETS
HAWAII	HAW.	I-HI-1(5):24 Unit 3	1967	152	152

