

FED. ROAD DIST. NO.	STATE	FED. AID PROJ. NO.	FISCAL YEAR	SHEET NO.	TOTAL SHEETS
HAWAII	HAW.	1-1-1(5):24 Unit 3	1967	6	152

REVISED: Nov. 21, 1967

Jan. 5, 1968

Jan. 25, 1968


June 4, 1968

June 26, 1968

NOTES :

- 2 inch A.C. paved area and 2 inch A.C. sidewalk shall be A.C. Mix V and may be placed in one layer (Paid for under Item No. 39.05)
- 4" P.C.C. Pavement with 6" x 6" x #6 wire mesh reinforcement shall be paid for under Item No. 77.04
- Sta. 130+70 to 134+63 Landscape with Cynodon Dactylon between curb and sidewalk - 250 #
Top soil 18 cy.

TRUE NORTH
Scale: 1" = 20'

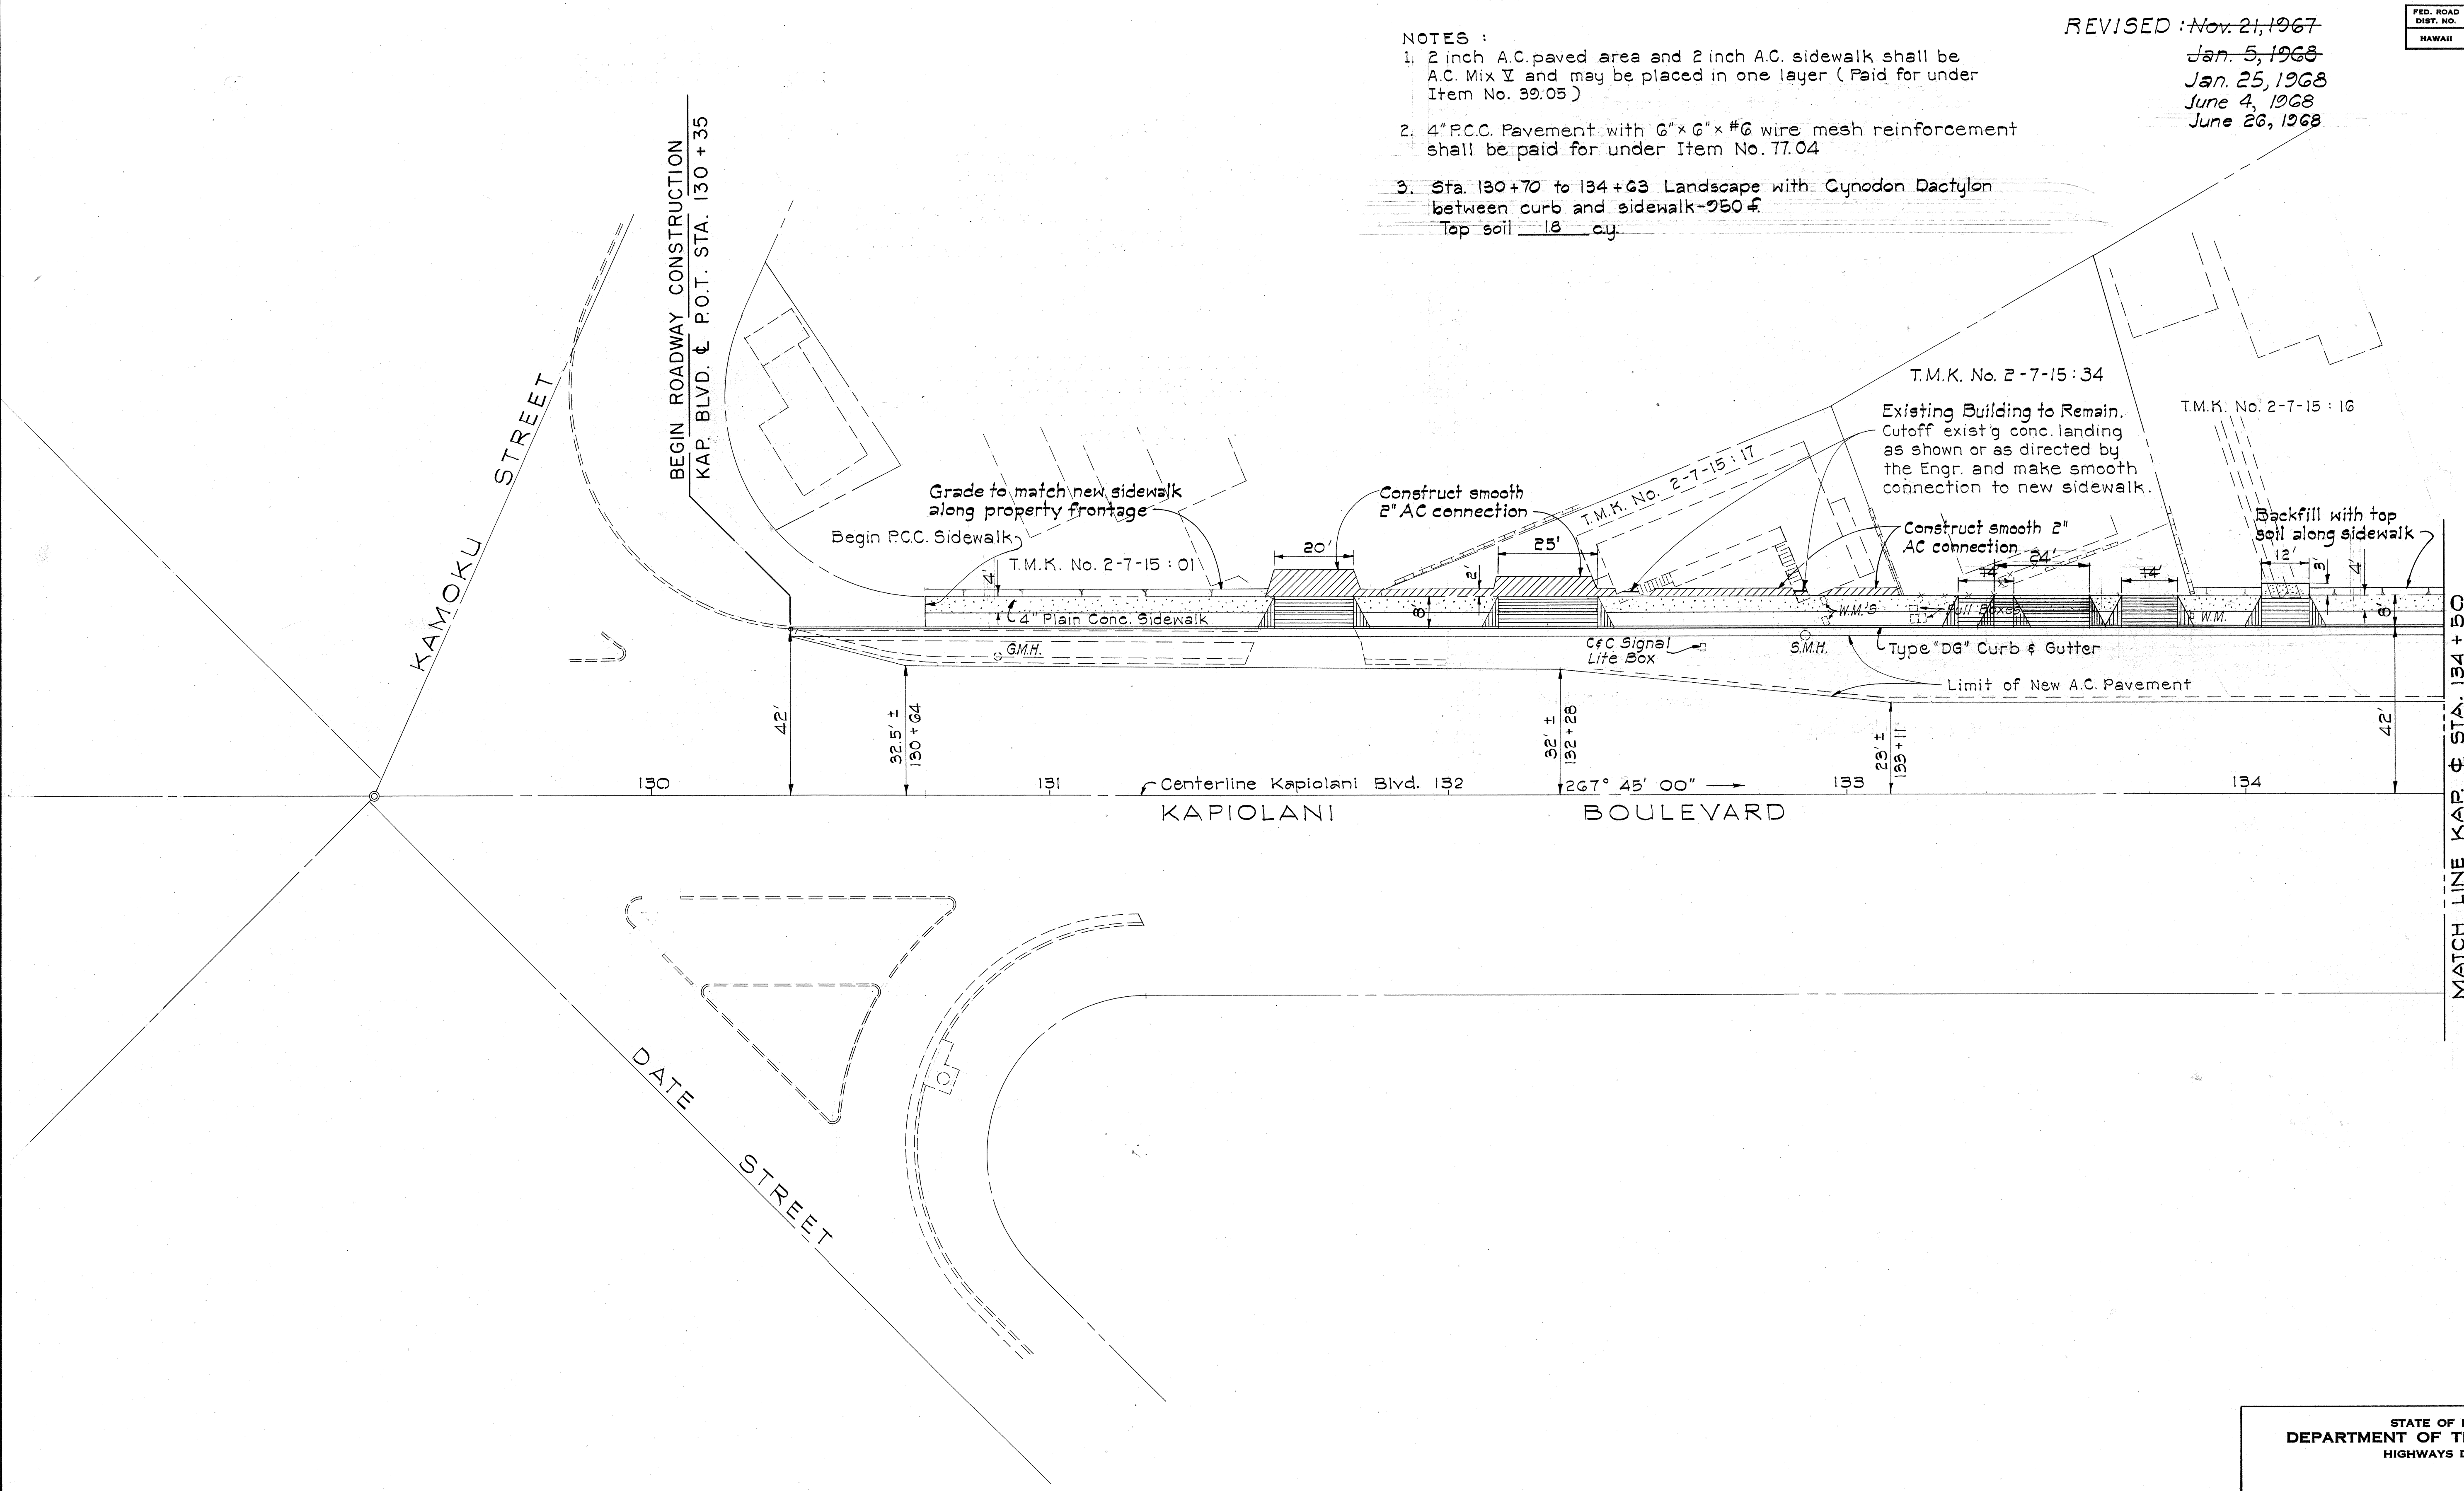

STATE OF HAWAII
DEPARTMENT OF TRANSPORTATION
HIGHWAYS DIVISION

DETAIL PLAN OF ROADWAY

INTERSTATE HIGHWAY (LUNALILO FRWY.)
F.A.I. Proj. No. I-HI-1(5):24, Unit 3

Scale: As Noted Date: June, 1967

SHEET No. 1 OF 5 SHEETS

THIS SHT. SUPERSEDES SHT. No. 6

(C) (1) (6)

ORIGINAL PLAN	DATE
DESIGNED BY	
CHECKED BY	
NO.	

FED. ROAD DIST. NO.	STATE	FED. AID PROJ. NO.	FISCAL YEAR	SHEET NO.	TOTAL SHEETS
HAWAII	HAW.	1-1-1(5)24	1967	7	152

NOTE:
Sta. 135+80 to 138+20
Landscape with Cynodon Dactylon
between curb and sidewalk-180 f.
Top soil 3 cy


CURVE DATA

	R-1	KAP
Δ	4°38'42"	8°59'00"
R	3958.00'	4000.00'
T	160.53'	314.22'
L	320.88'	627.16'

REVISED: Nov. 21, 1967

Jan. 5, 1968
Jan. 25, 1968
April 11, 1968
June 4, 1968
June 26, 1968

TRUE NORTH
Scale 1" = 20'

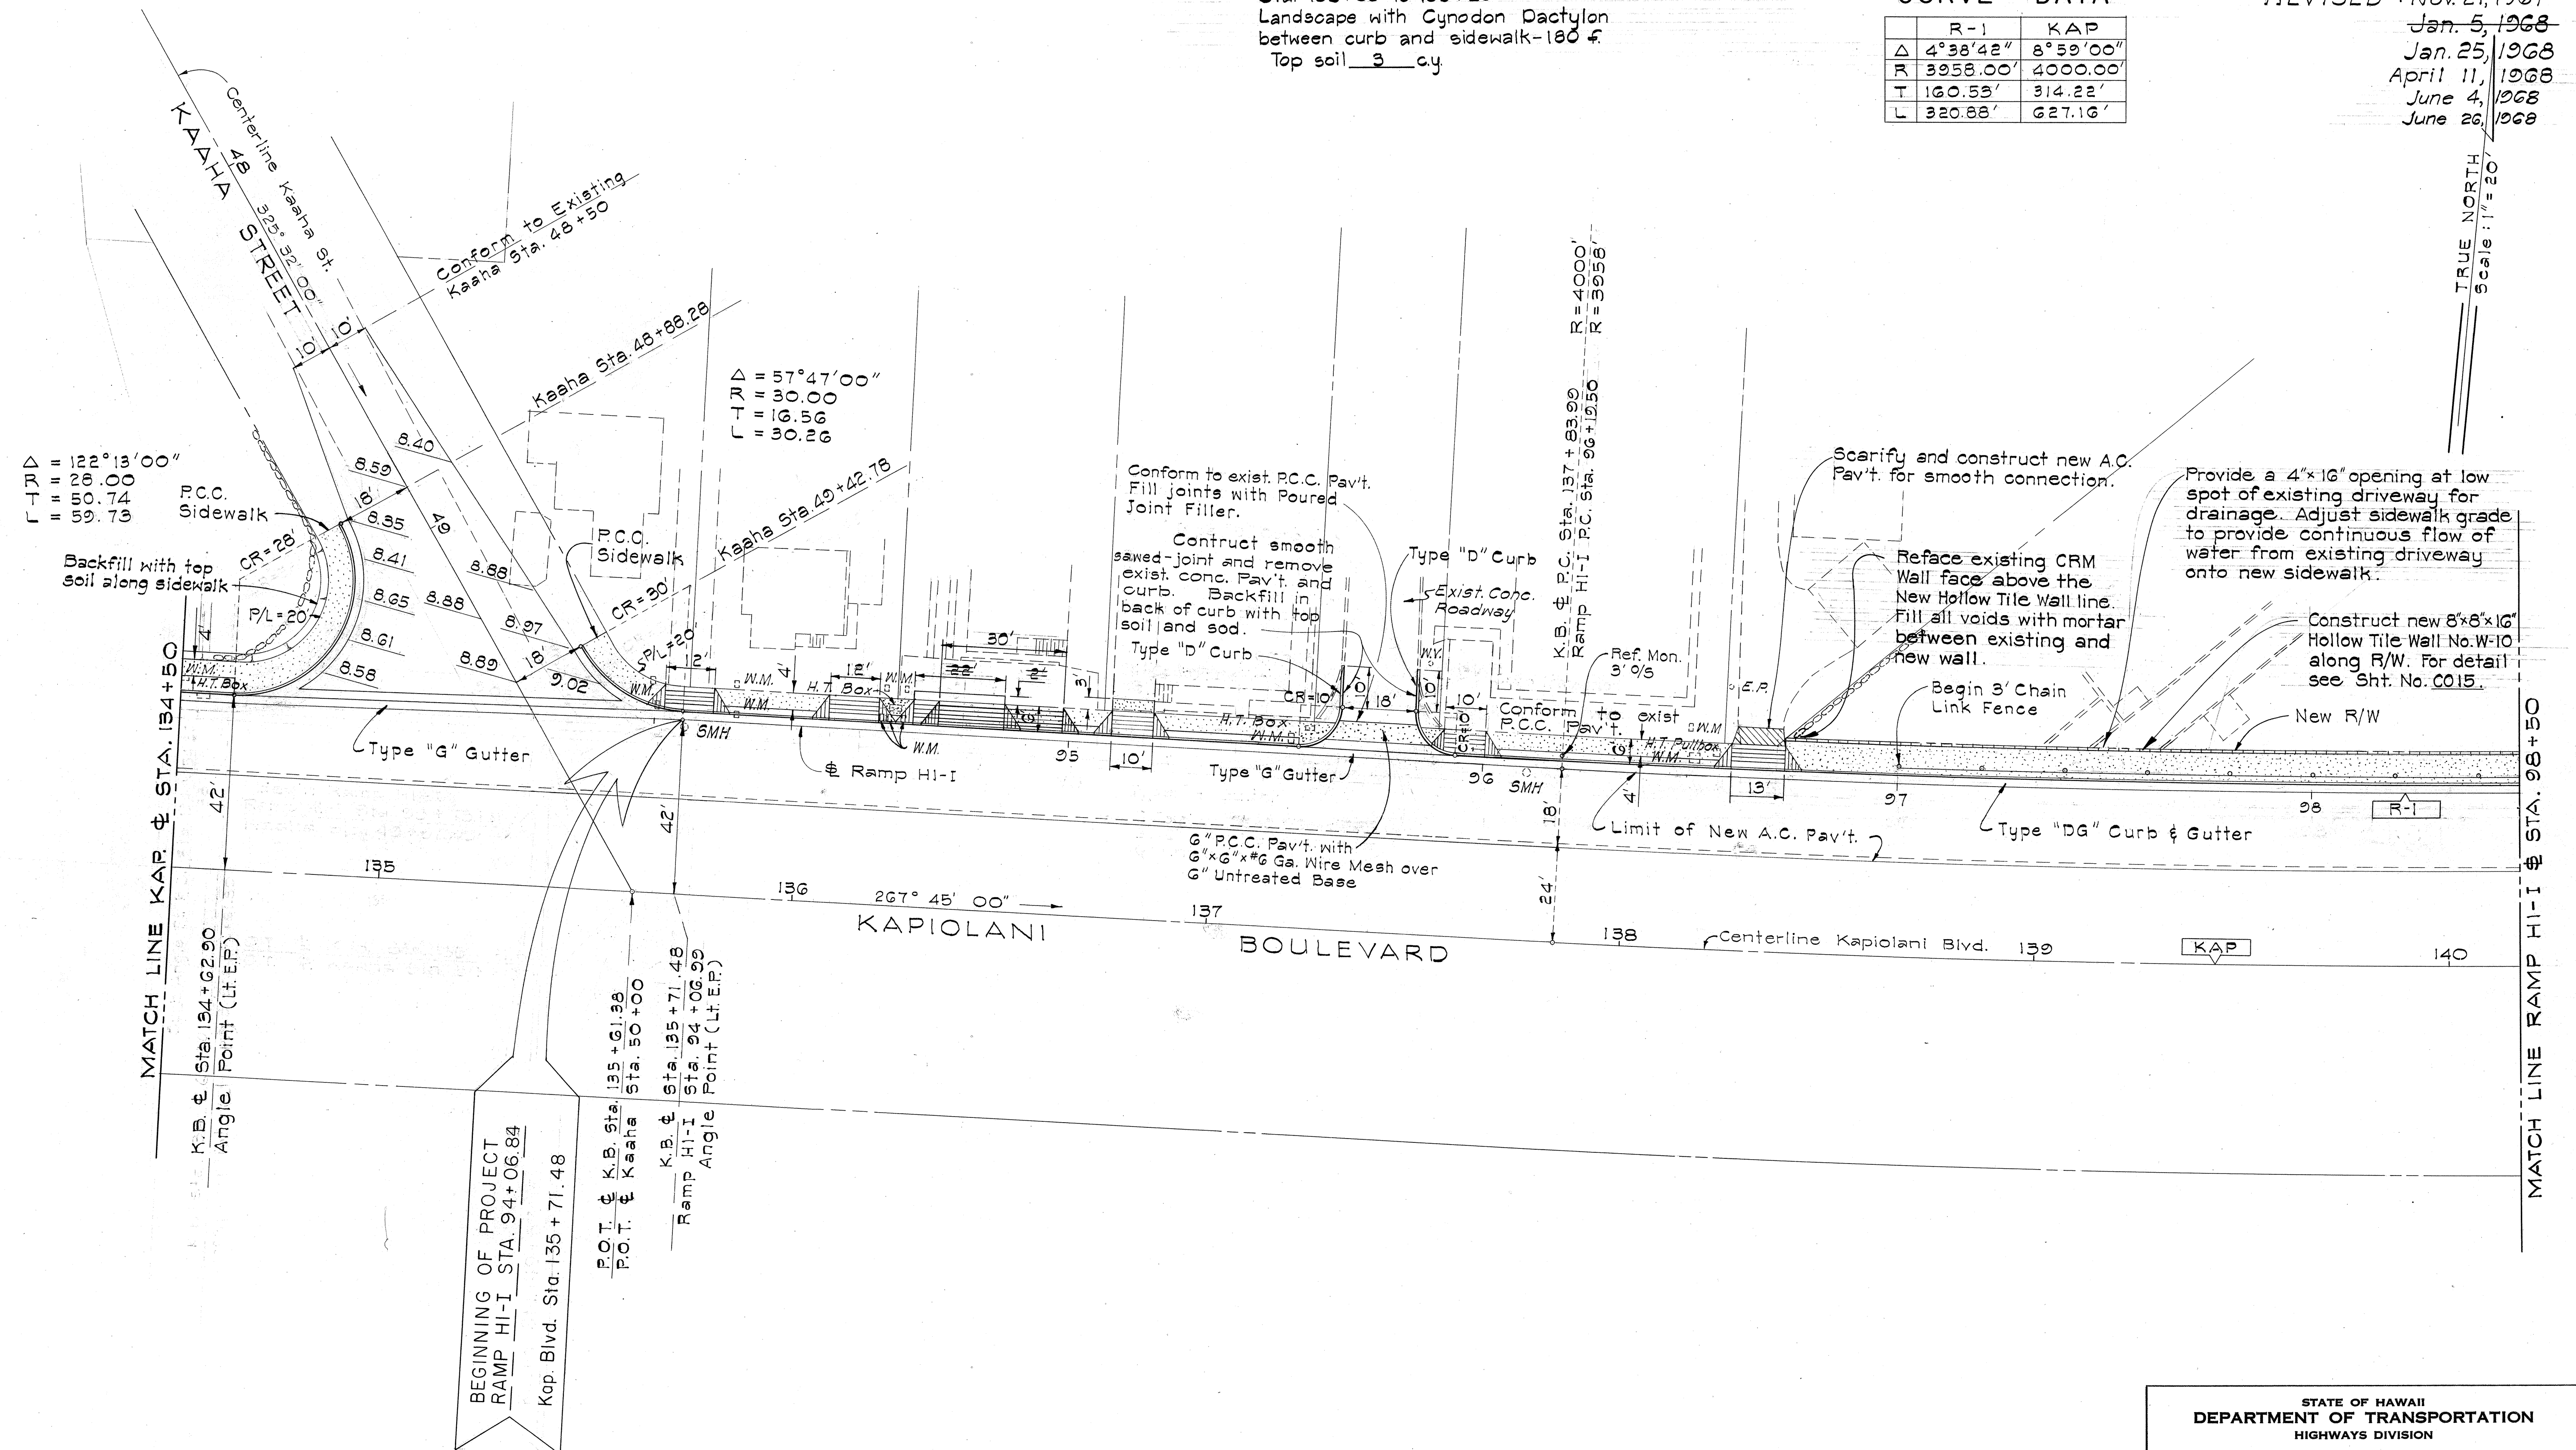

THIS SHT. SUPERSEDES SHT. No. 7

STATE OF HAWAII
DEPARTMENT OF TRANSPORTATION
HIGHWAYS DIVISION

DETAIL PLAN OF ROADWAY

INTERSTATE HIGHWAY (LUNALILO FRWY.)
F.A.I. Proj. No. I-HI-1(5):24, Unit 3

Scale: 1" = 20' Date: June, 1967

SHEET No. 2 OF 5 SHEETS


C O 7

FED. ROAD DIST. NO.	STATE	FED. AID PROJ. NO.	FISCAL YEAR	SHEET NO.	TOTAL SHEETS
HAWAII	HAW.	101-1024	1967	8	152

REVISED: Nov. 21, 1967
Jan. 5, 1968
April 11, 1968

CURVE DATA

	WR-1	R-2	KAP	R-1
Δ	63° 04' 00"	5° 15' 58"	8° 59' 00"	4° 38' 42"
R	212.00'	2214.20'	4,000'	3,958'
T	130.08'	101.83'	314.22'	160.53'
L	233.35'	203.51'	627.16'	320.88'

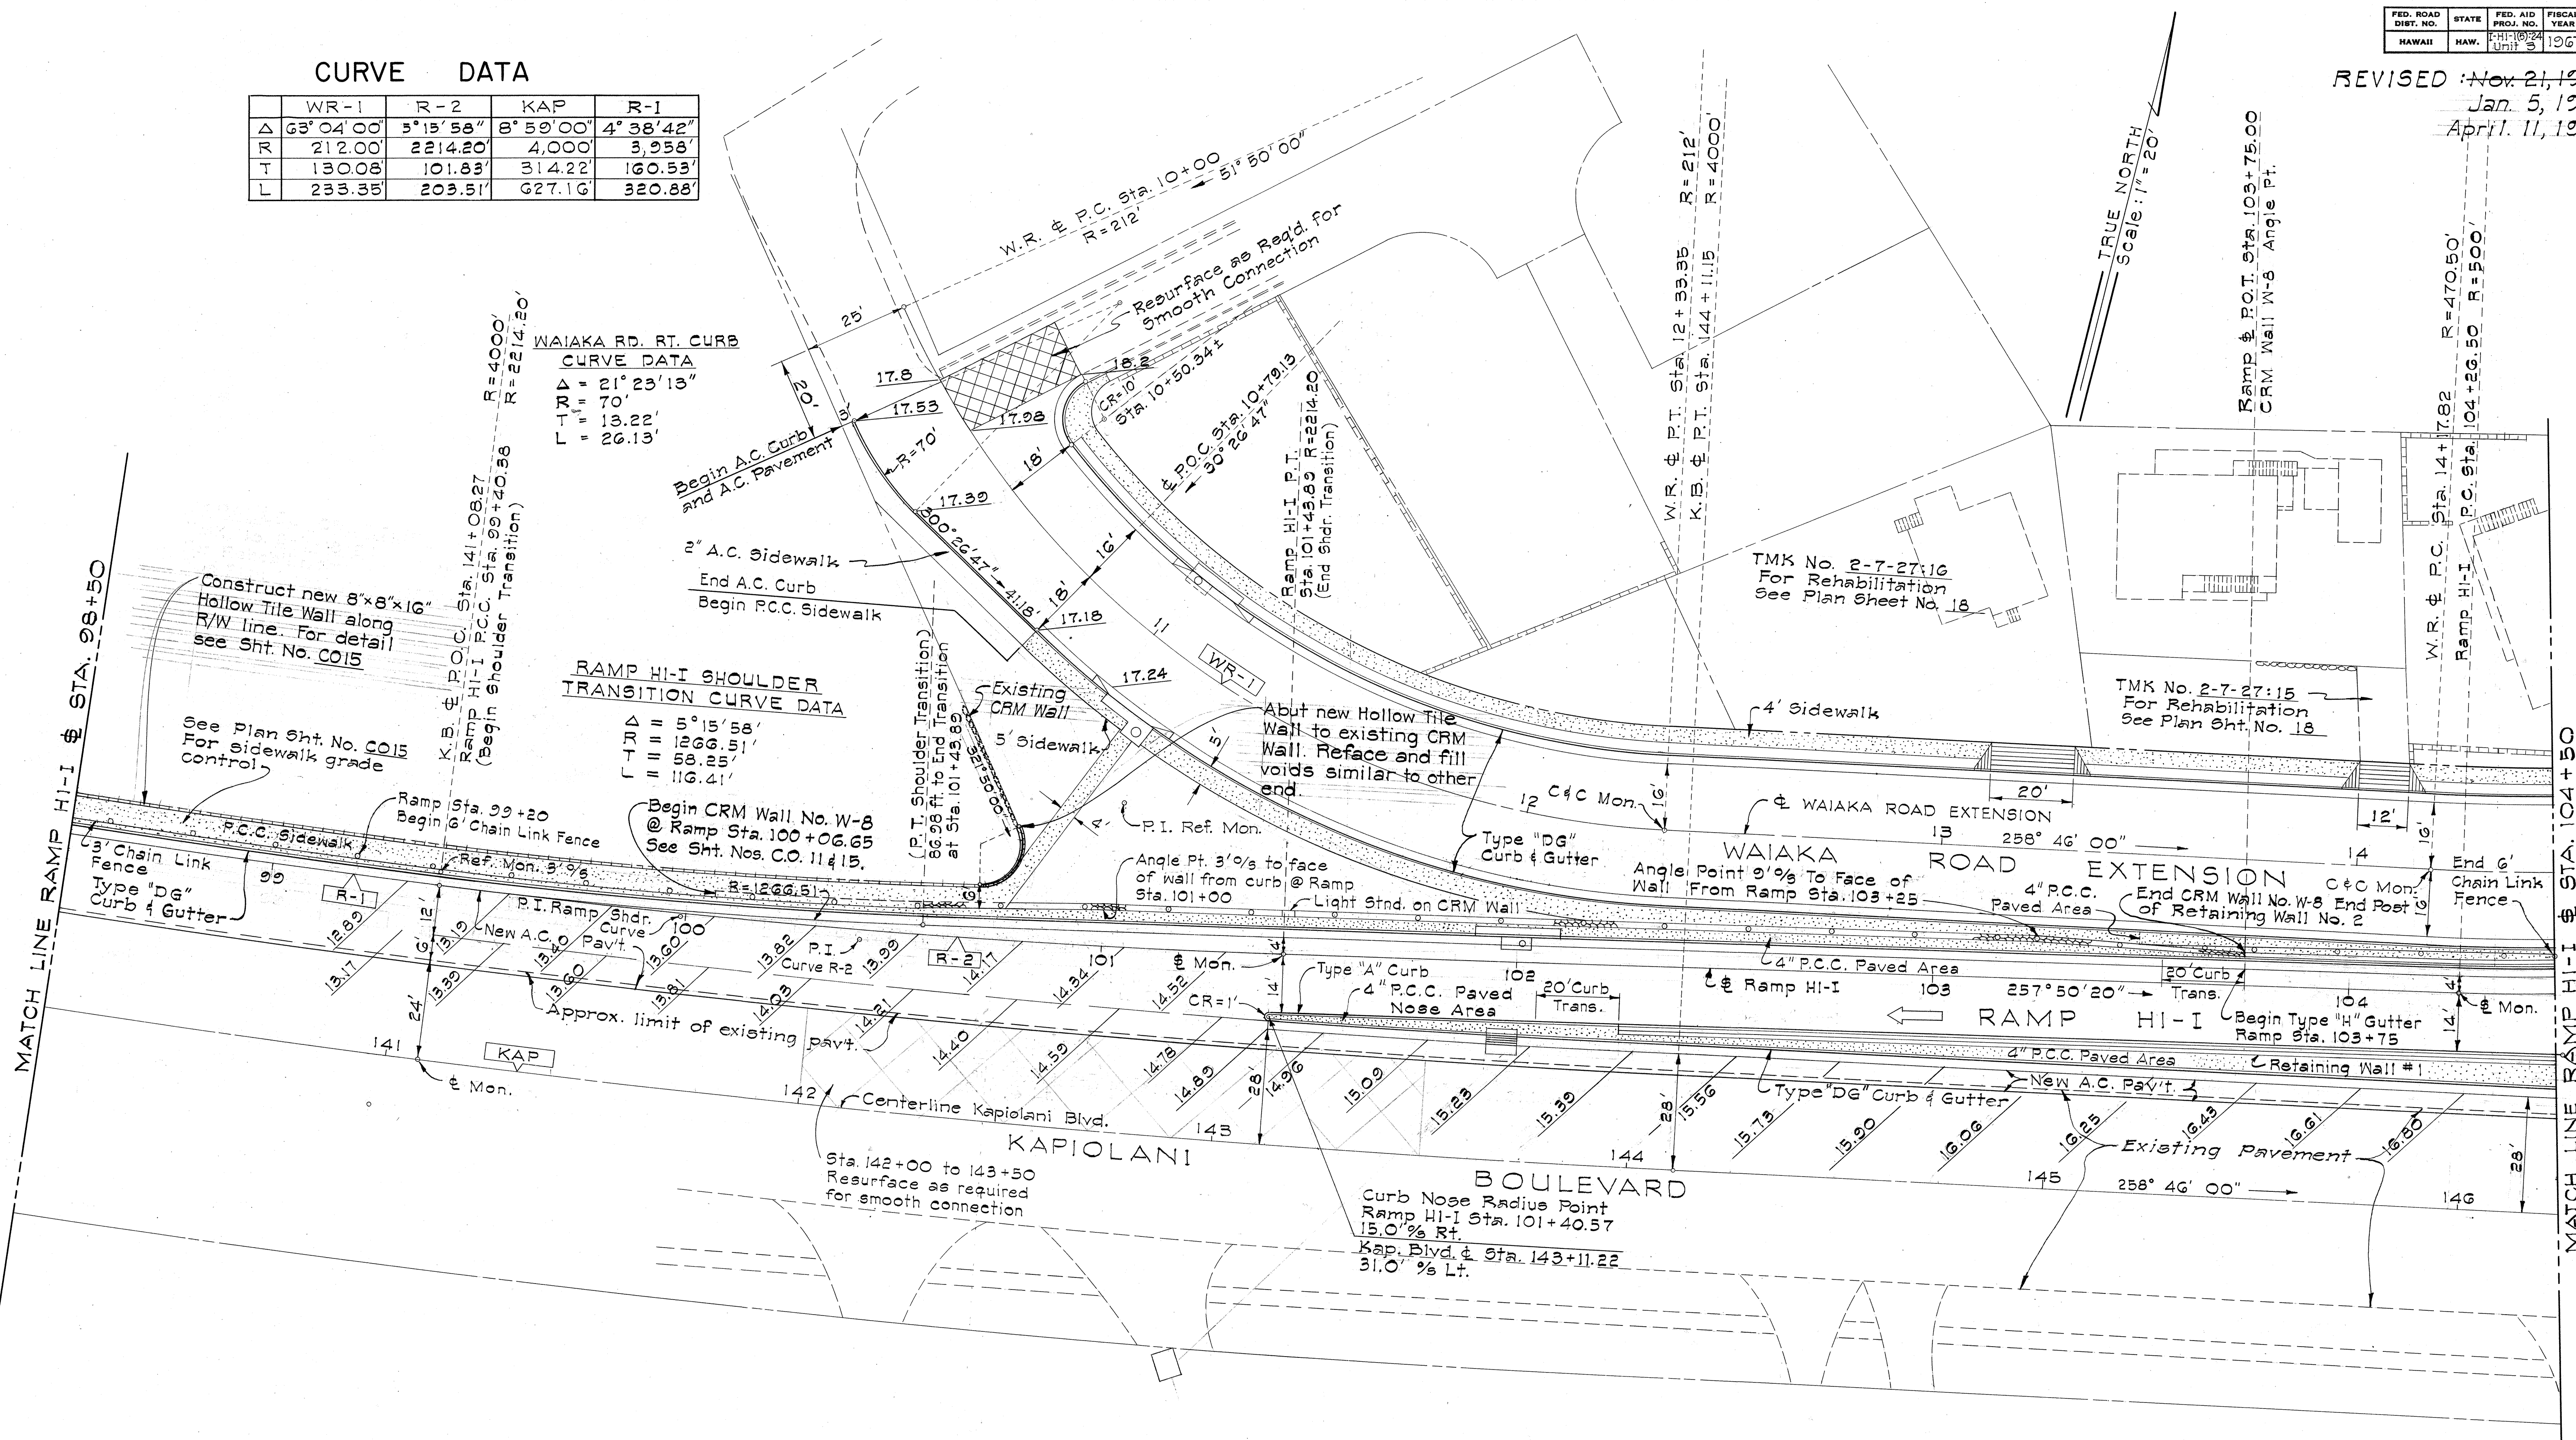

STATE OF HAWAII
DEPARTMENT OF TRANSPORTATION
HIGHWAYS DIVISION

DETAIL PLAN OF ROADWAY

INTERSTATE HIGHWAY (LUNALILO FRWY.)
F.A.I. Proj. No. I-HI-1(5): 24, Unit 3

Scale: 1"=20' Date: June, 1967


SHEET No. 3 OF 5 SHEETS

THIS SHEET SUPERSEDES SHT. No. 8

C O S

FED. ROAD DIST. NO.	STATE	FED. AID PROJ. NO.	FISCAL YEAR	SHEET NO.	TOTAL SHEETS
HAWAII	HAW.	111(6)24 Unit 5	1967	10	152

	R-4	R-5	FMB
Δ	5° 27' 24"	20° 16' 28"	38° 54' 35"
R	4,000'	892.00'	868.00'
T	190.62'	159.49'	306.61'
L	380.95'	315.64'	569.46'

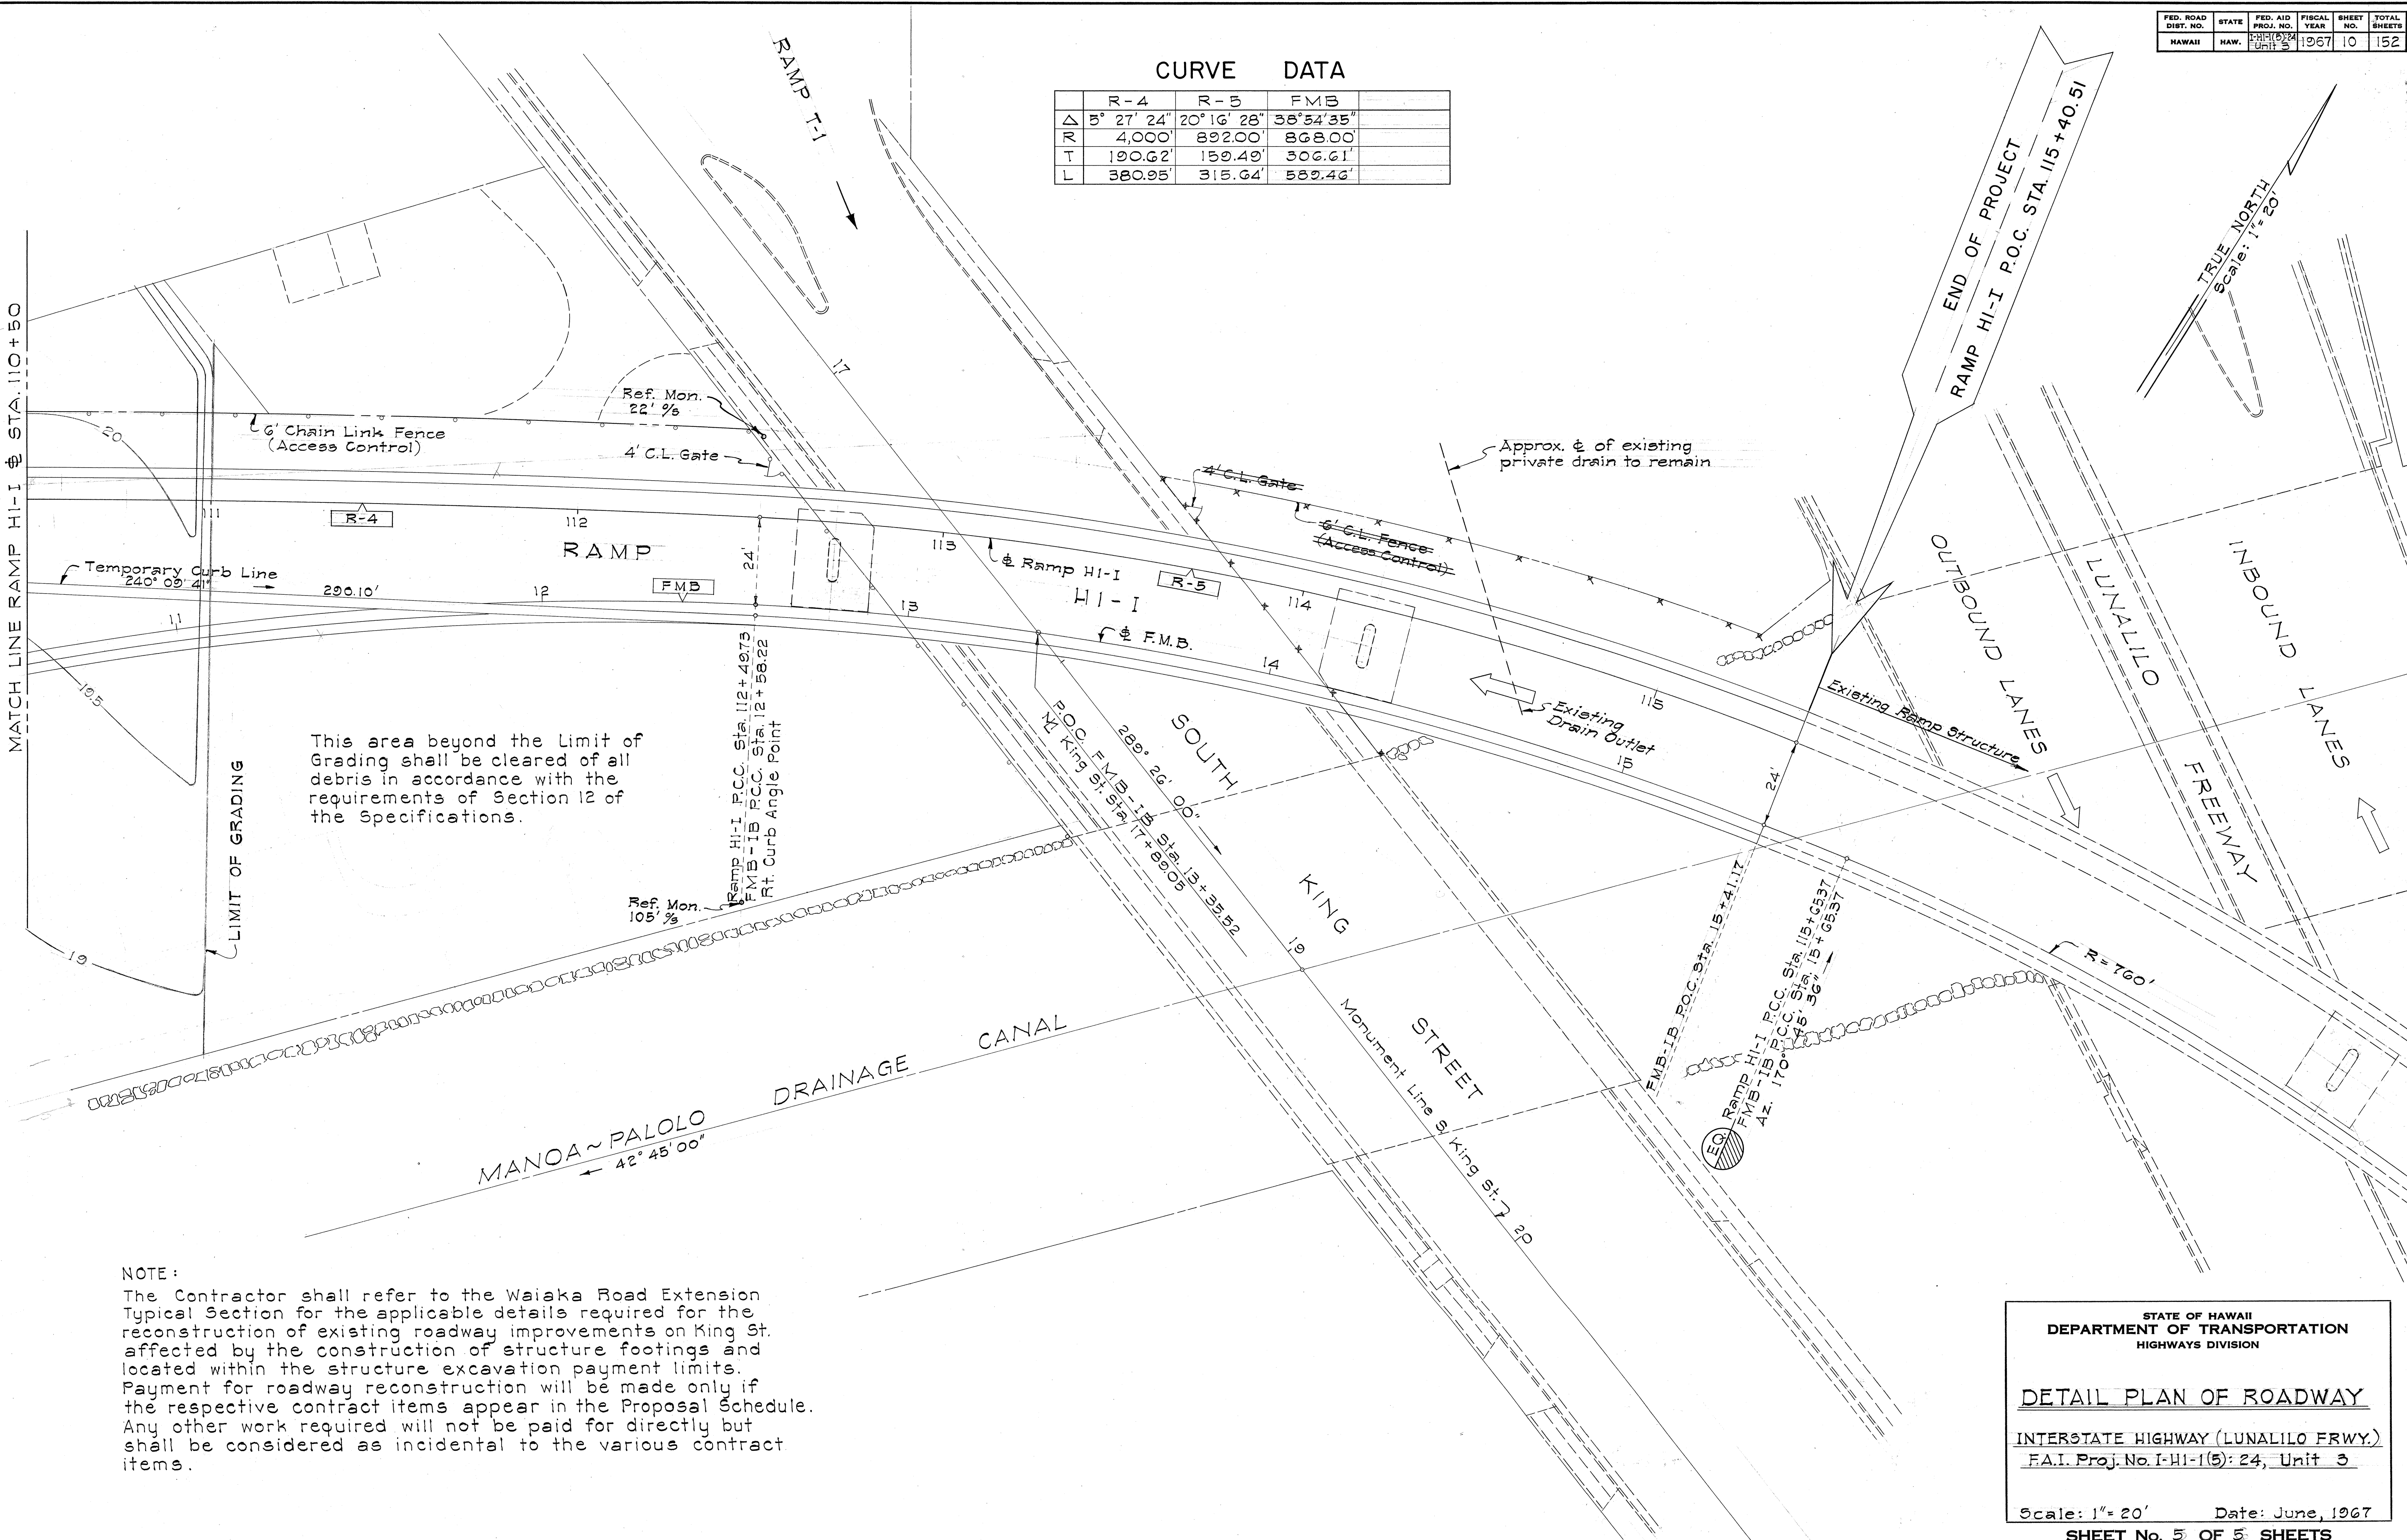

NOTE:
 The Contractor shall refer to the Waiaka Road Extension Typical Section for the applicable details required for the reconstruction of existing roadway improvements on King St. affected by the construction of structure footings and located within the structure excavation payment limits. Payment for roadway reconstruction will be made only if the respective contract items appear in the Proposal Schedule. Any other work required will not be paid for directly but shall be considered as incidental to the various contract items.

STATE OF HAWAII
 DEPARTMENT OF TRANSPORTATION
 HIGHWAYS DIVISION

DETAIL PLAN OF ROADWAY
 INTERSTATE HIGHWAY (LUNALILO FRWY.)
 F.A.I. Proj. No. I-HI-1(5): 24, Unit 3
 Scale: 1"=20' Date: June, 1967
 SHEET No. 5 OF 5 SHEETS

ORIGINAL PLAN	DATE
DESIGNED BY	
CHECKED BY	
NO.	