




FED. ROAD DIST. NO.	STATE	FED. AID PROJ. NO.	FISCAL YEAR	SHEET NO.	TOTAL SHEETS
HAWAII	HAW.	I-HI-1(2)-24 Unit 7	1967	18	152

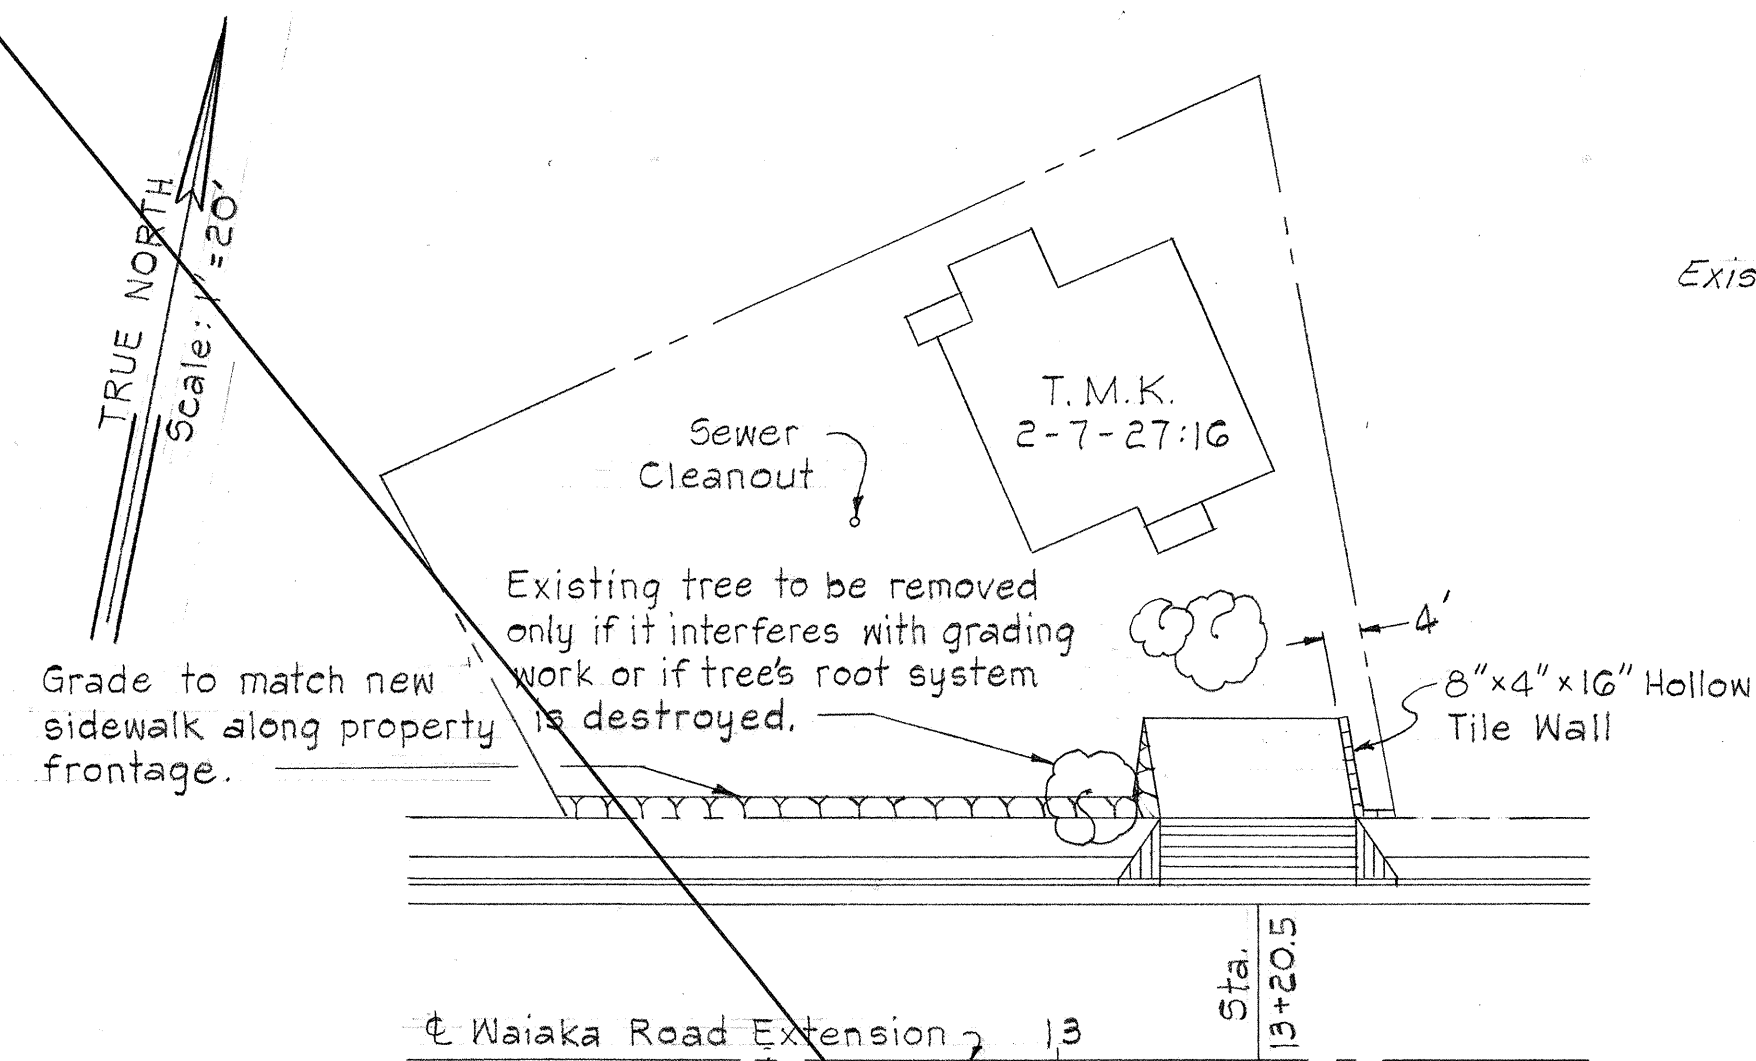

PLOT PLAN
Scale: 1"=20"

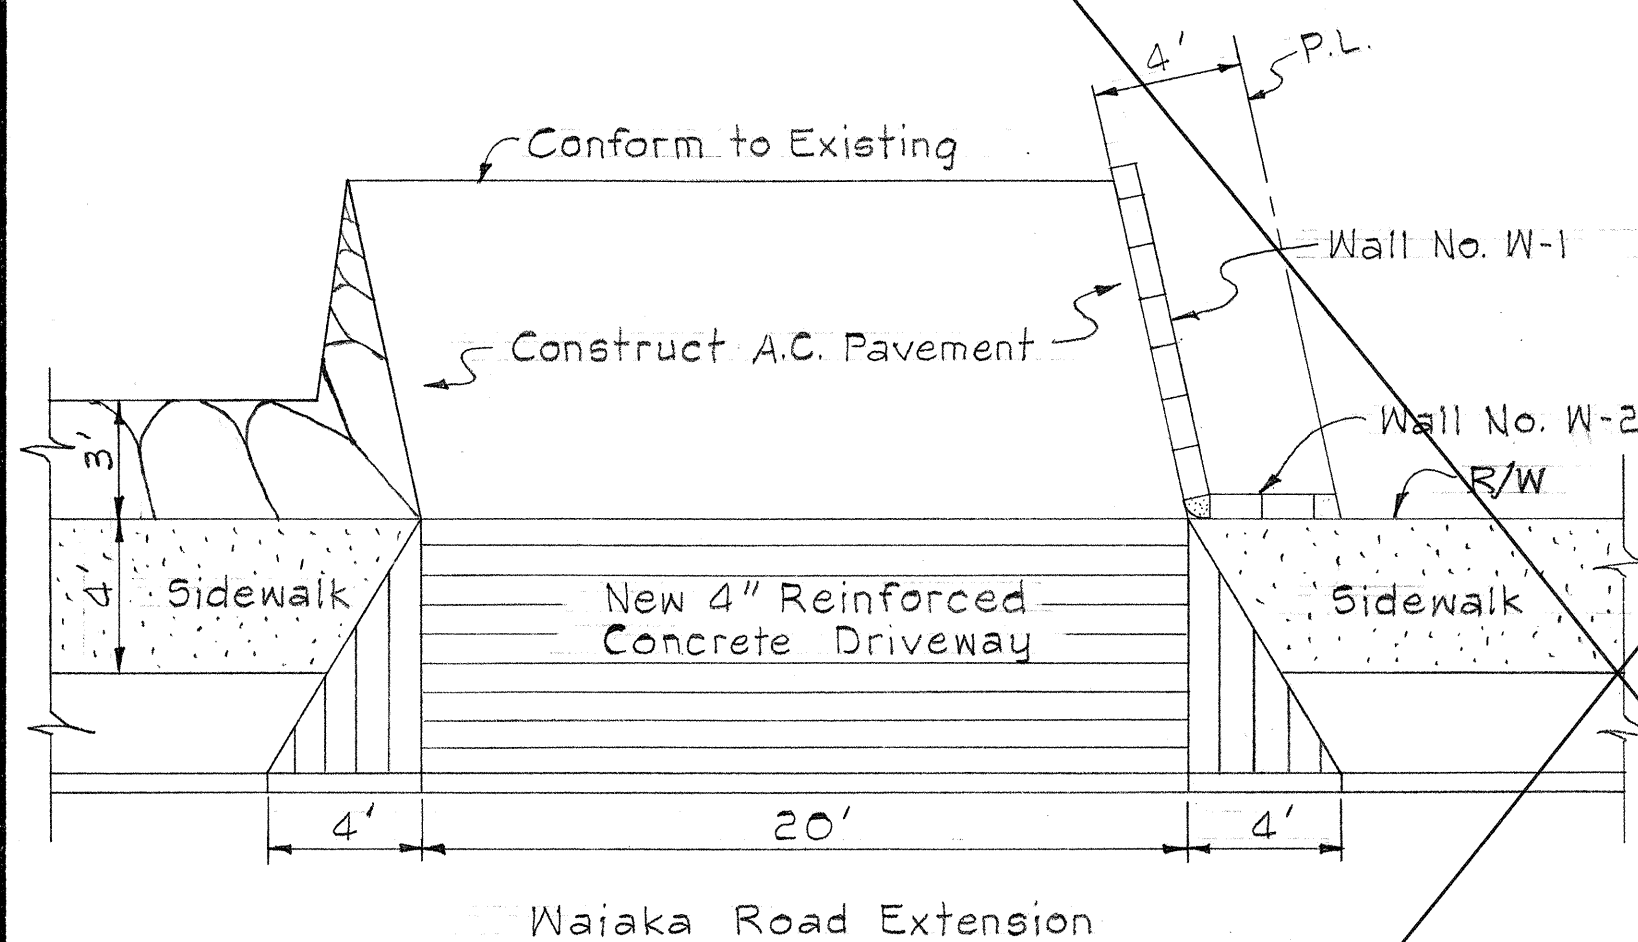


PLAN
Scale: 1"=5'

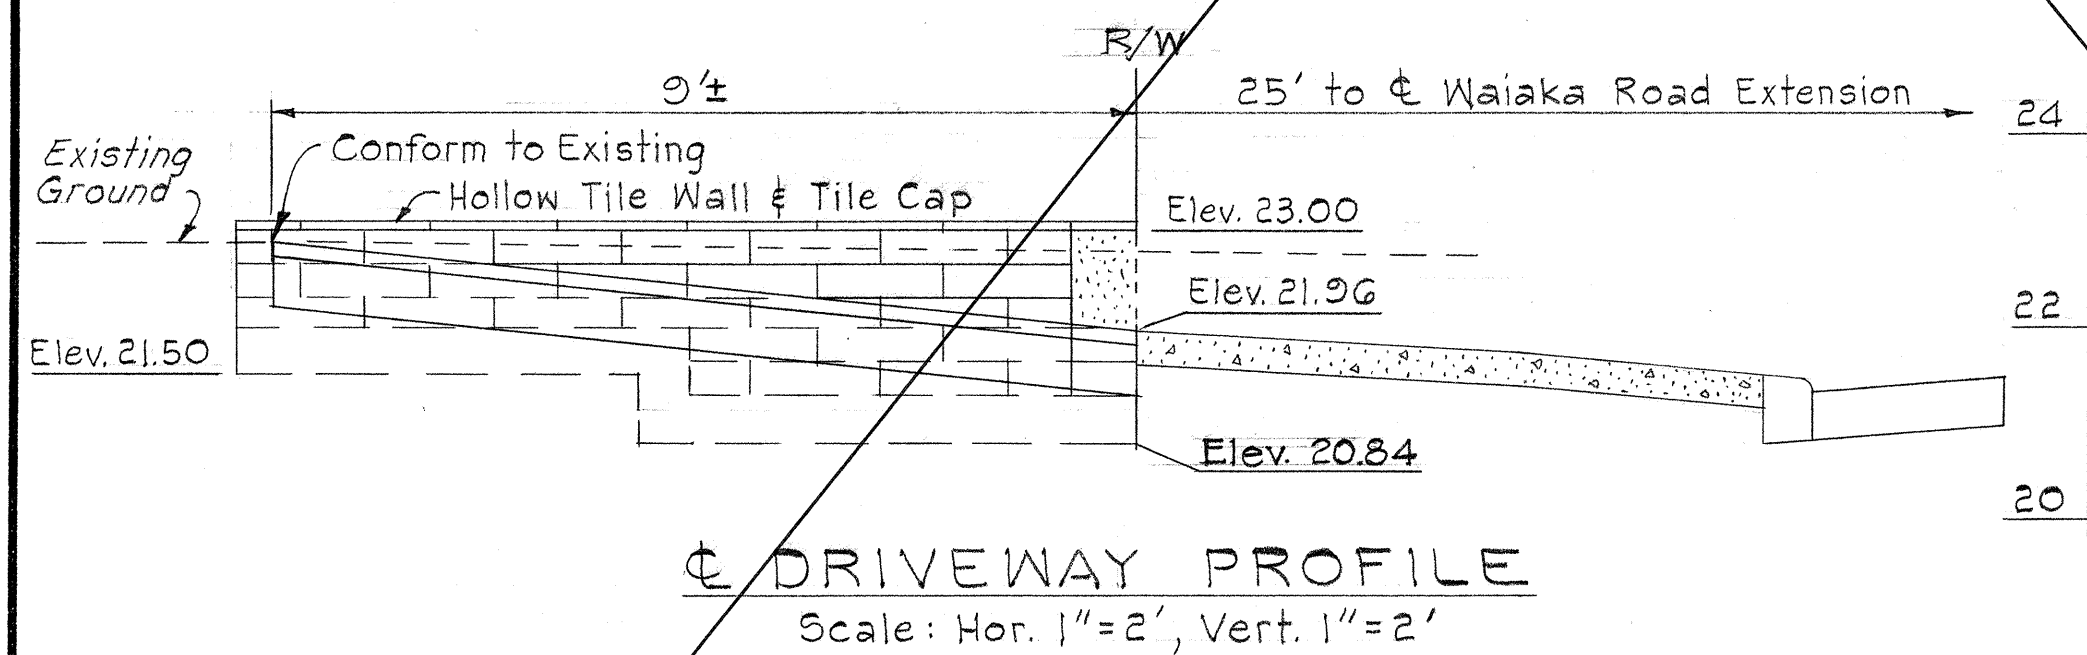

DRIVEWAY PROFILE
Scale: Hor. 1"=2', Vert. 1"=2'


CONTRACT ITEM NO. 123.A
REHABILITATION OF LOT
TAX MAP KEY No. 2-7-27:16
Scale: As Shown

NOTE: See Sht. No. 183

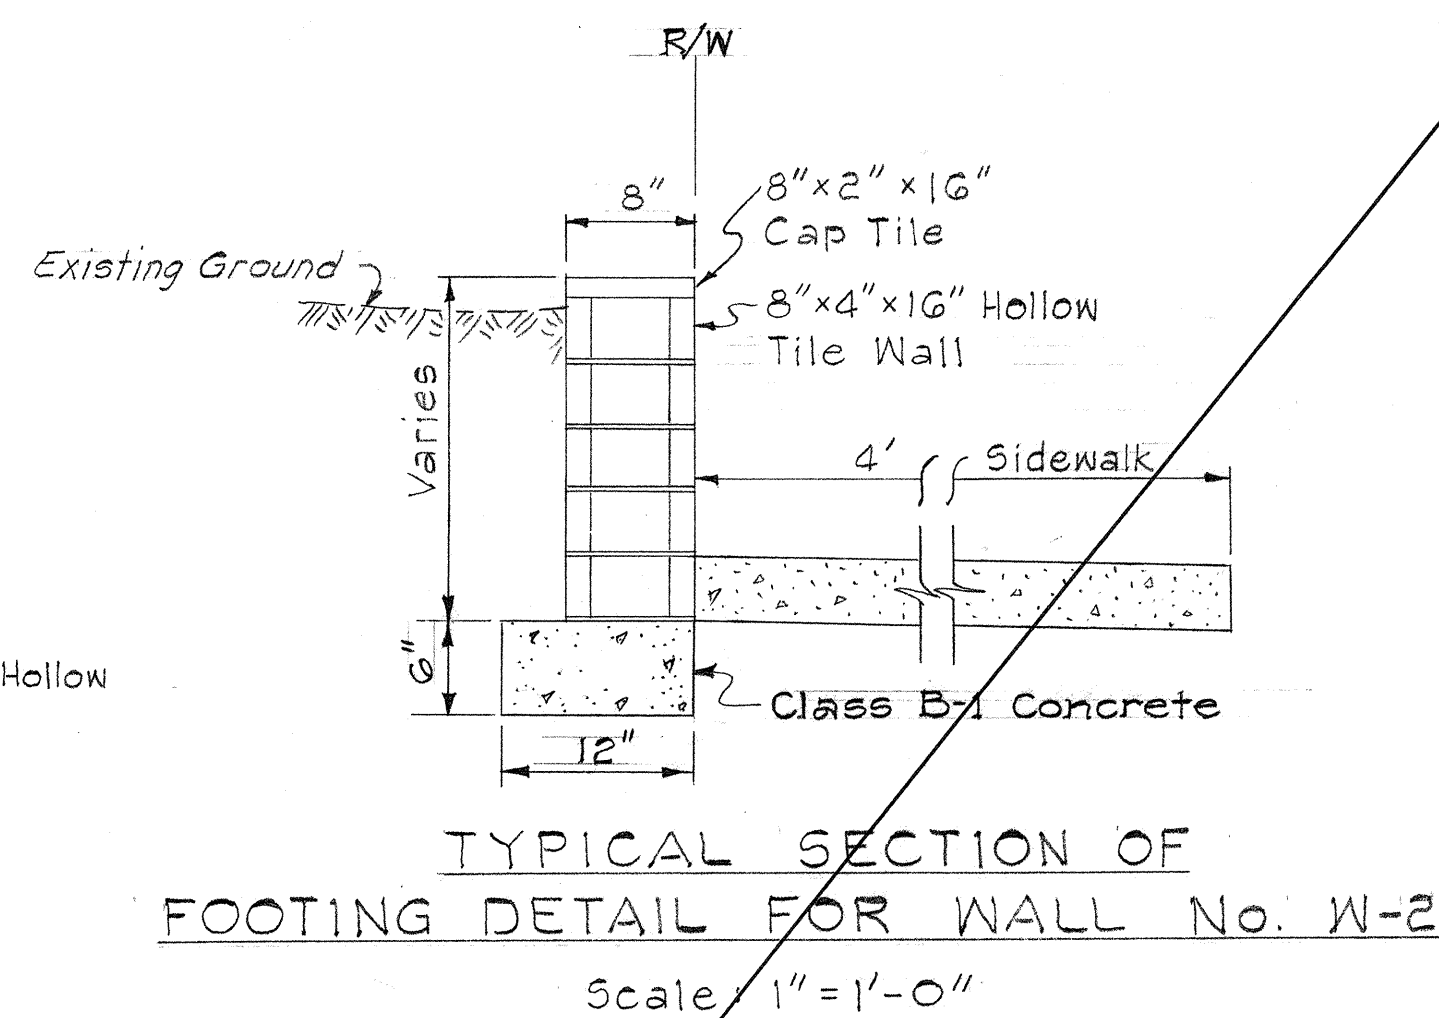

TYPICAL SECTION OF
FOOTING DETAIL FOR WALL No. W-2

Scale: 1"=1'-0"

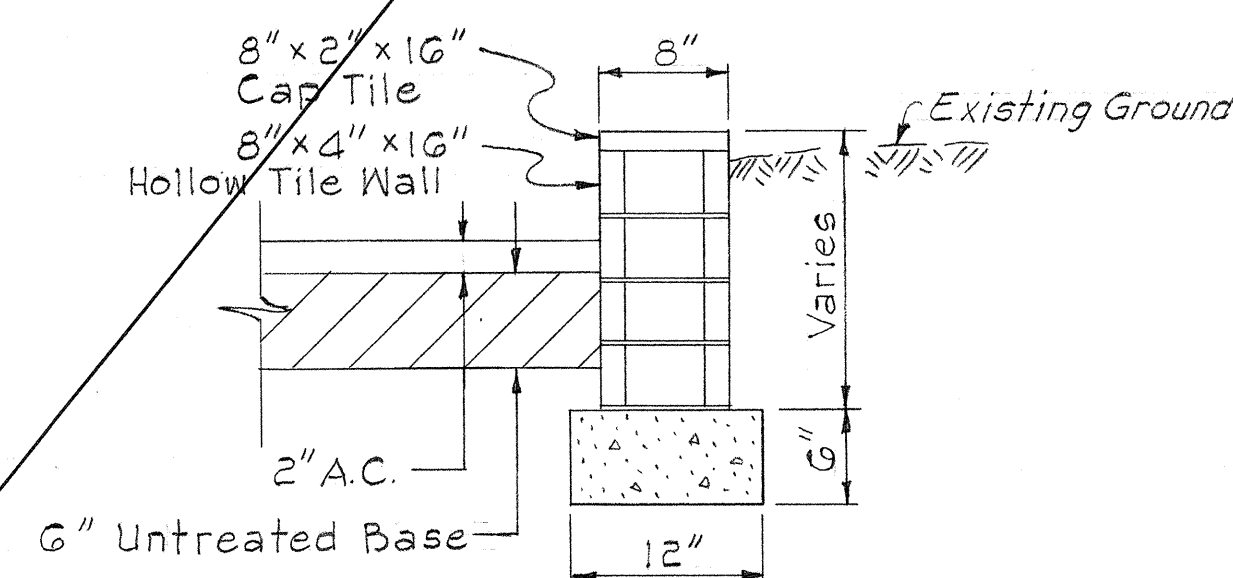


TYPICAL SECTION OF
FOOTING DETAIL FOR WALL No. W-1


Scale: 1"=1'-0"

NOTES:


1. Construct a new 2" A.C. driveway.
2. Construct new Hollow Tile Wall Nos. W-1 and W-2.
3. Grade along frontage, add 4" top soil and sodding.
4. Also refer to Sections 123 and 123 A for additional details and requirements.

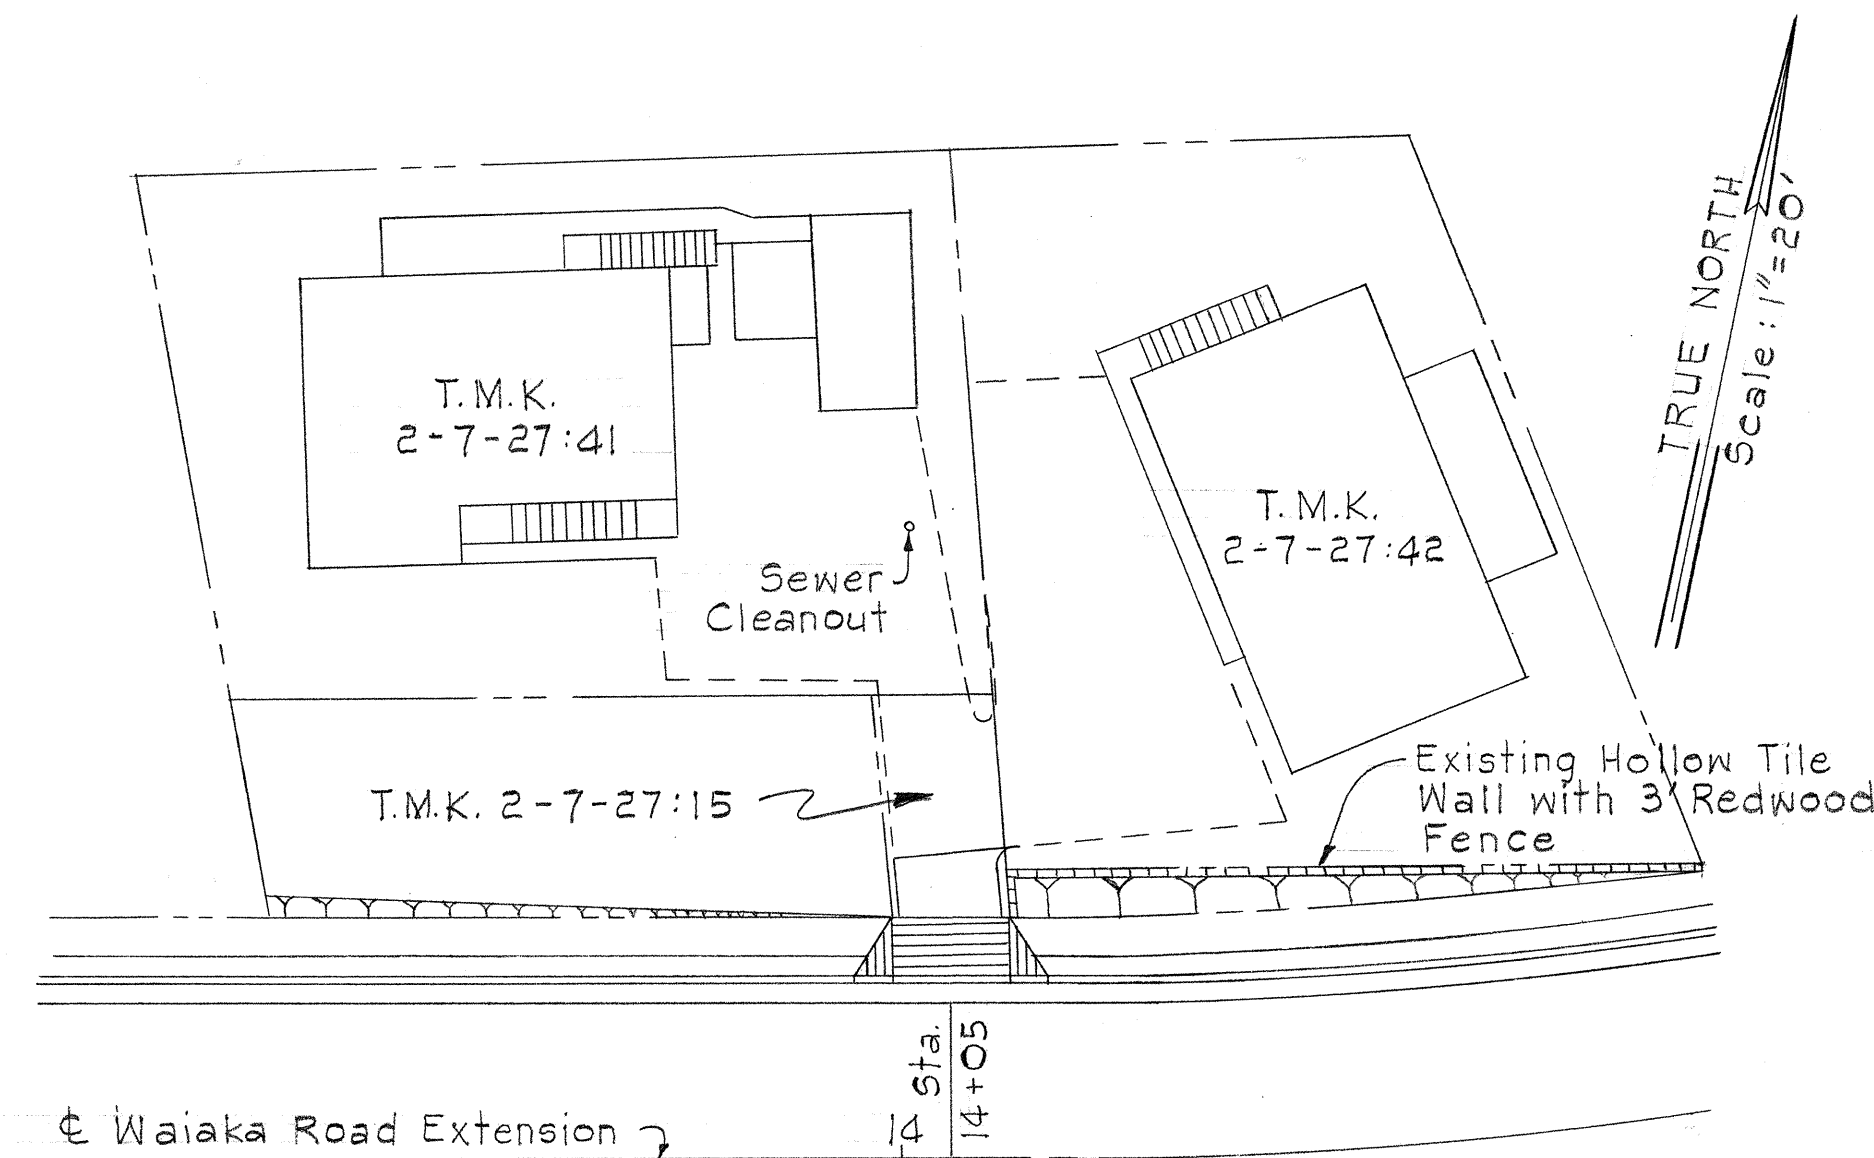

PLOT PLAN
Scale: 1"=20"

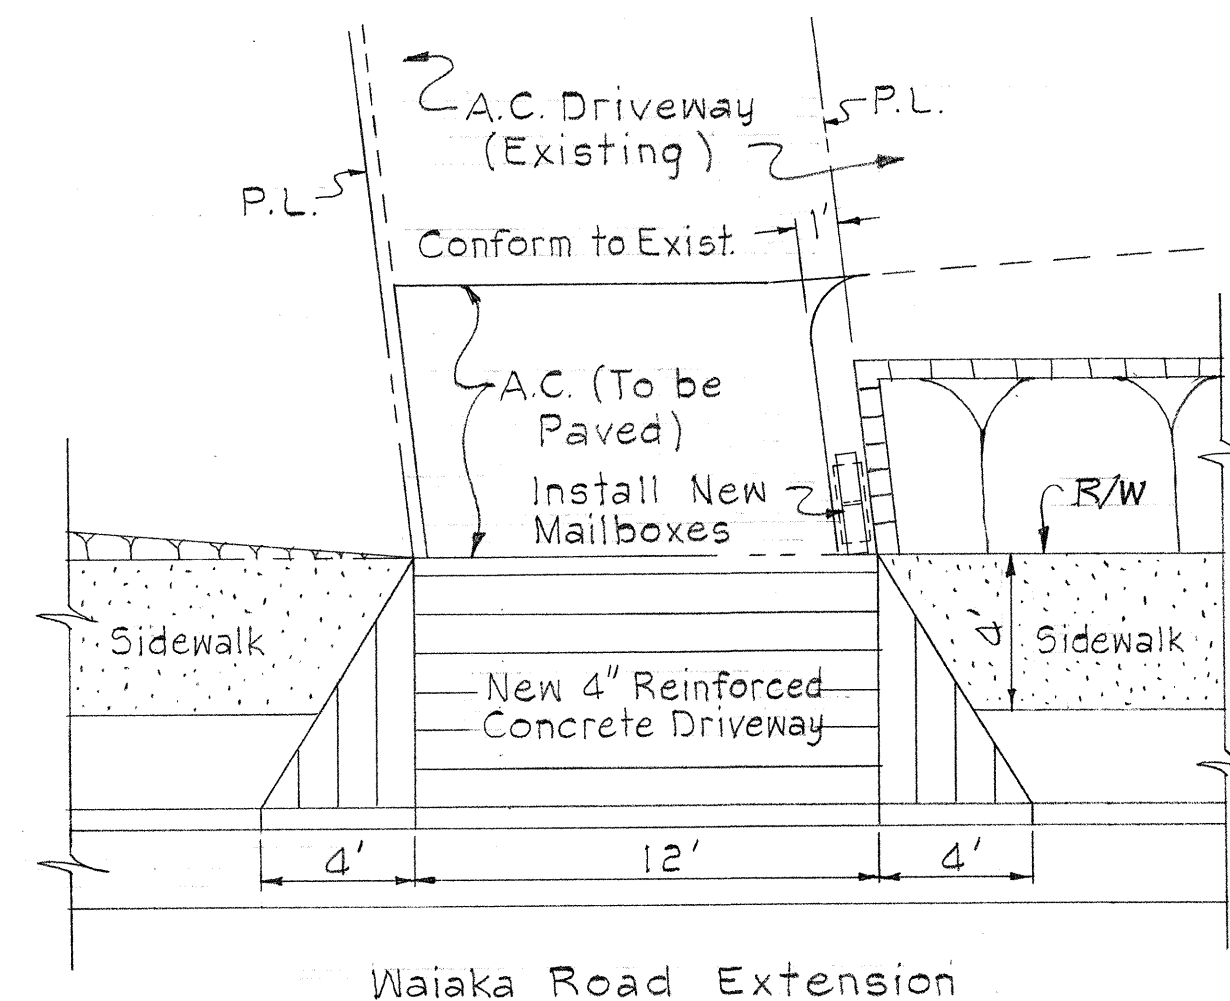


PLAN
Scale: 1"=5'

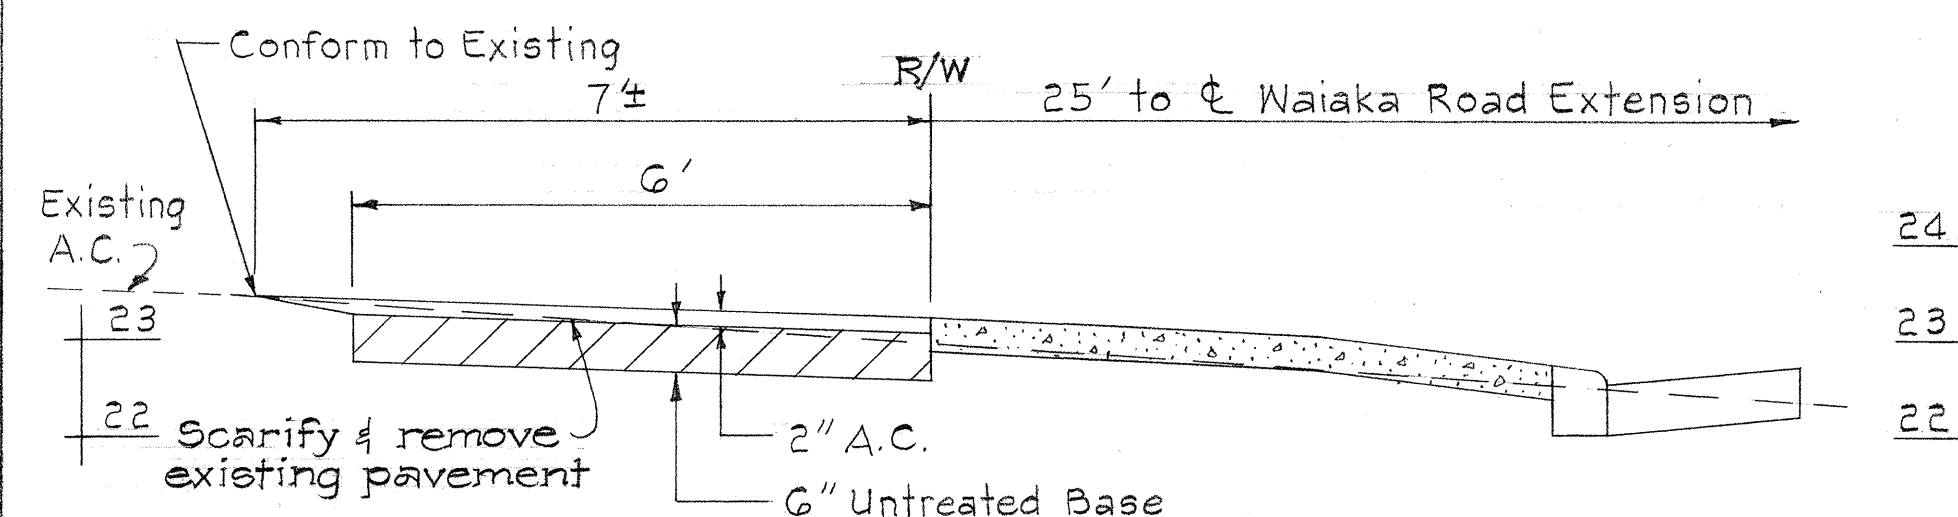

DRIVEWAY PROFILE
Scale: Hor. 1"=2', Vert. 1"=2'

CONTRACT ITEM NO. 123.B
REHABILITATION OF LOT
TAX MAP KEY No. 2-7-27:15
Scale: As Shown

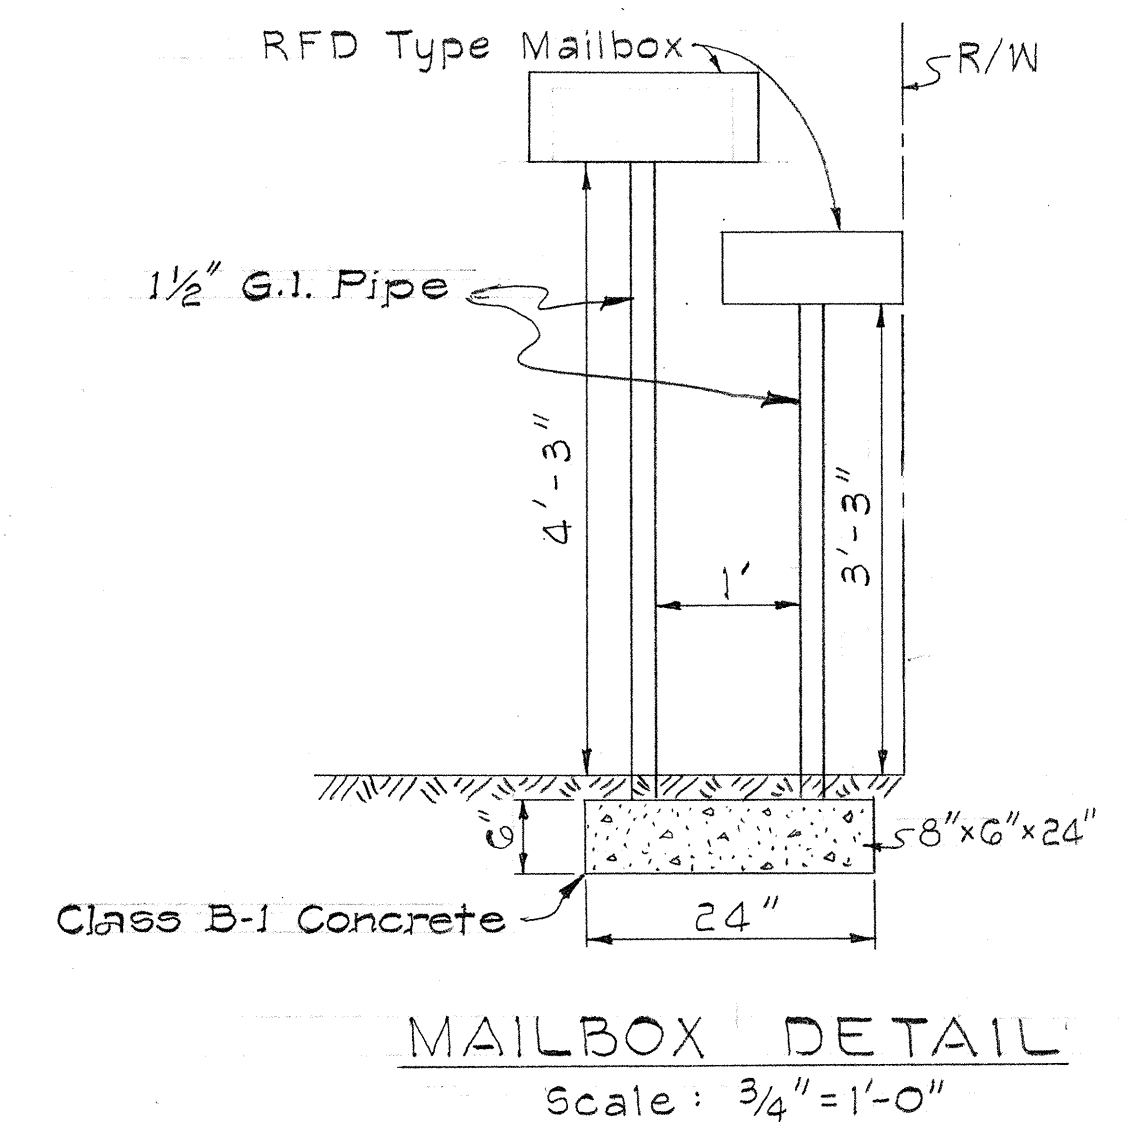

NOTES:

1. Construct a new 2" A.C. driveway.
2. Construct a smooth tie from existing A.C. driveway to new concrete drop driveway.
3. Furnish and install new mailboxes on right side of driveway as shown on detail.
4. Also refer to Sections 123 and 123 B for additional details and requirements.

STATE OF HAWAII
DEPARTMENT OF TRANSPORTATION
HIGHWAYS DIVISION

R/W ADJUSTMENTS


INTERSTATE HIGHWAY (LUNALILO FREEWAY)
F.A.I. Proj. No. I-HI-1(2)-24, Unit 7

Scale: As Noted Date: May, 1967


SHEET No. 1 OF 3 SHEETS

FED. ROAD DIST. NO.	STATE	FED. AID PROJ. NO.	FISCAL YEAR	SHEET NO.	TOTAL SHEETS
HAWAII	HAW.	I-HI-1(5):24 Unit 3	1970	185	152

LEGEND
Existing Grades 20.05
New Grades 21.5

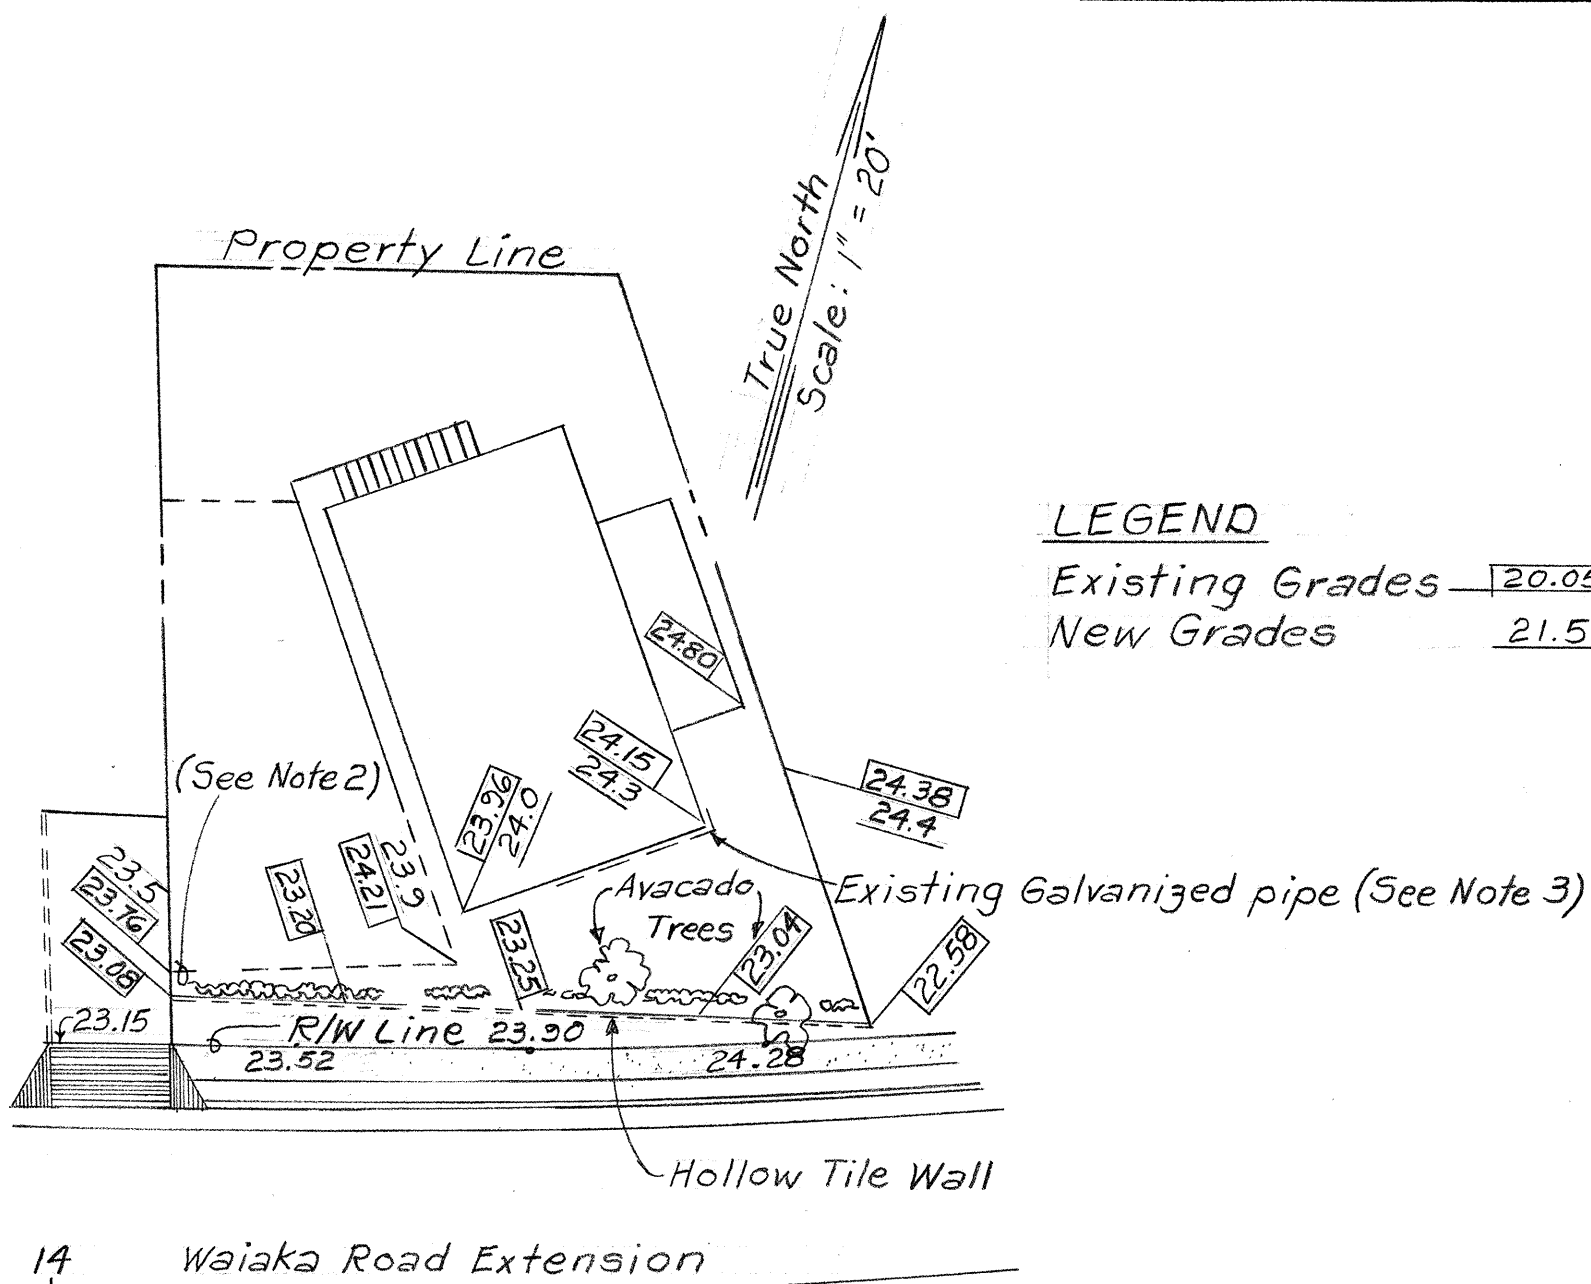

PLOT PLAN
Scale: 1" = 20'

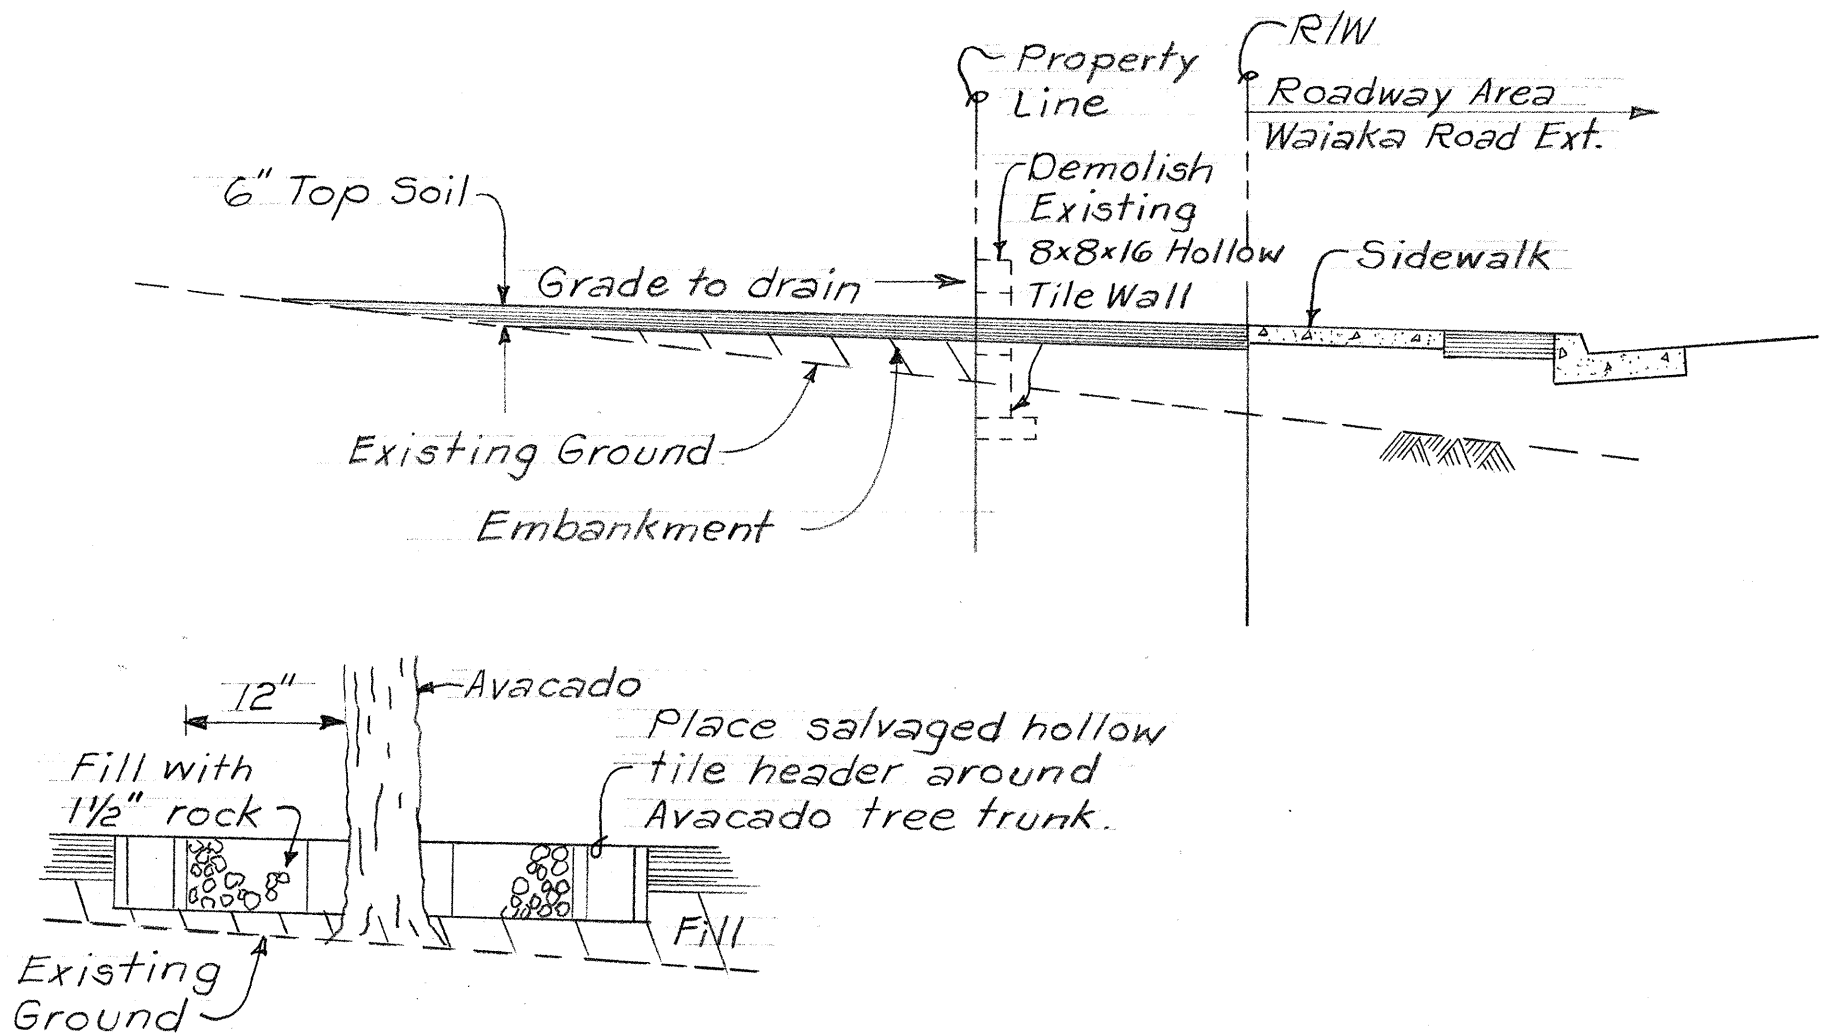

TYPICAL SECTIONS
Not to Scale

- NOTE:
- Shaded Area shall be filled and graded to drain.
 - Existing shrubs shall be removed and transplanted to new locations approved by the owner.
 - Do not cover existing galvanized pipe.


STATE OF HAWAII
DEPARTMENT OF TRANSPORTATION
HIGHWAYS DIVISION

R/W ADJUSTMENTS
INTERSTATE HIGHWAY (LUNALILO FREEWAY)
F.A.I. Proj. No. I-HI-1(5):24, Unit 3 &
F.A.I. Proj. No. I-HI-1(2):24, Unit 1
Scale: As Noted
October 1968


SHEET No. OF SHEETS

185

THIS SHEET IS
AN "AS BUILT" ADDITION

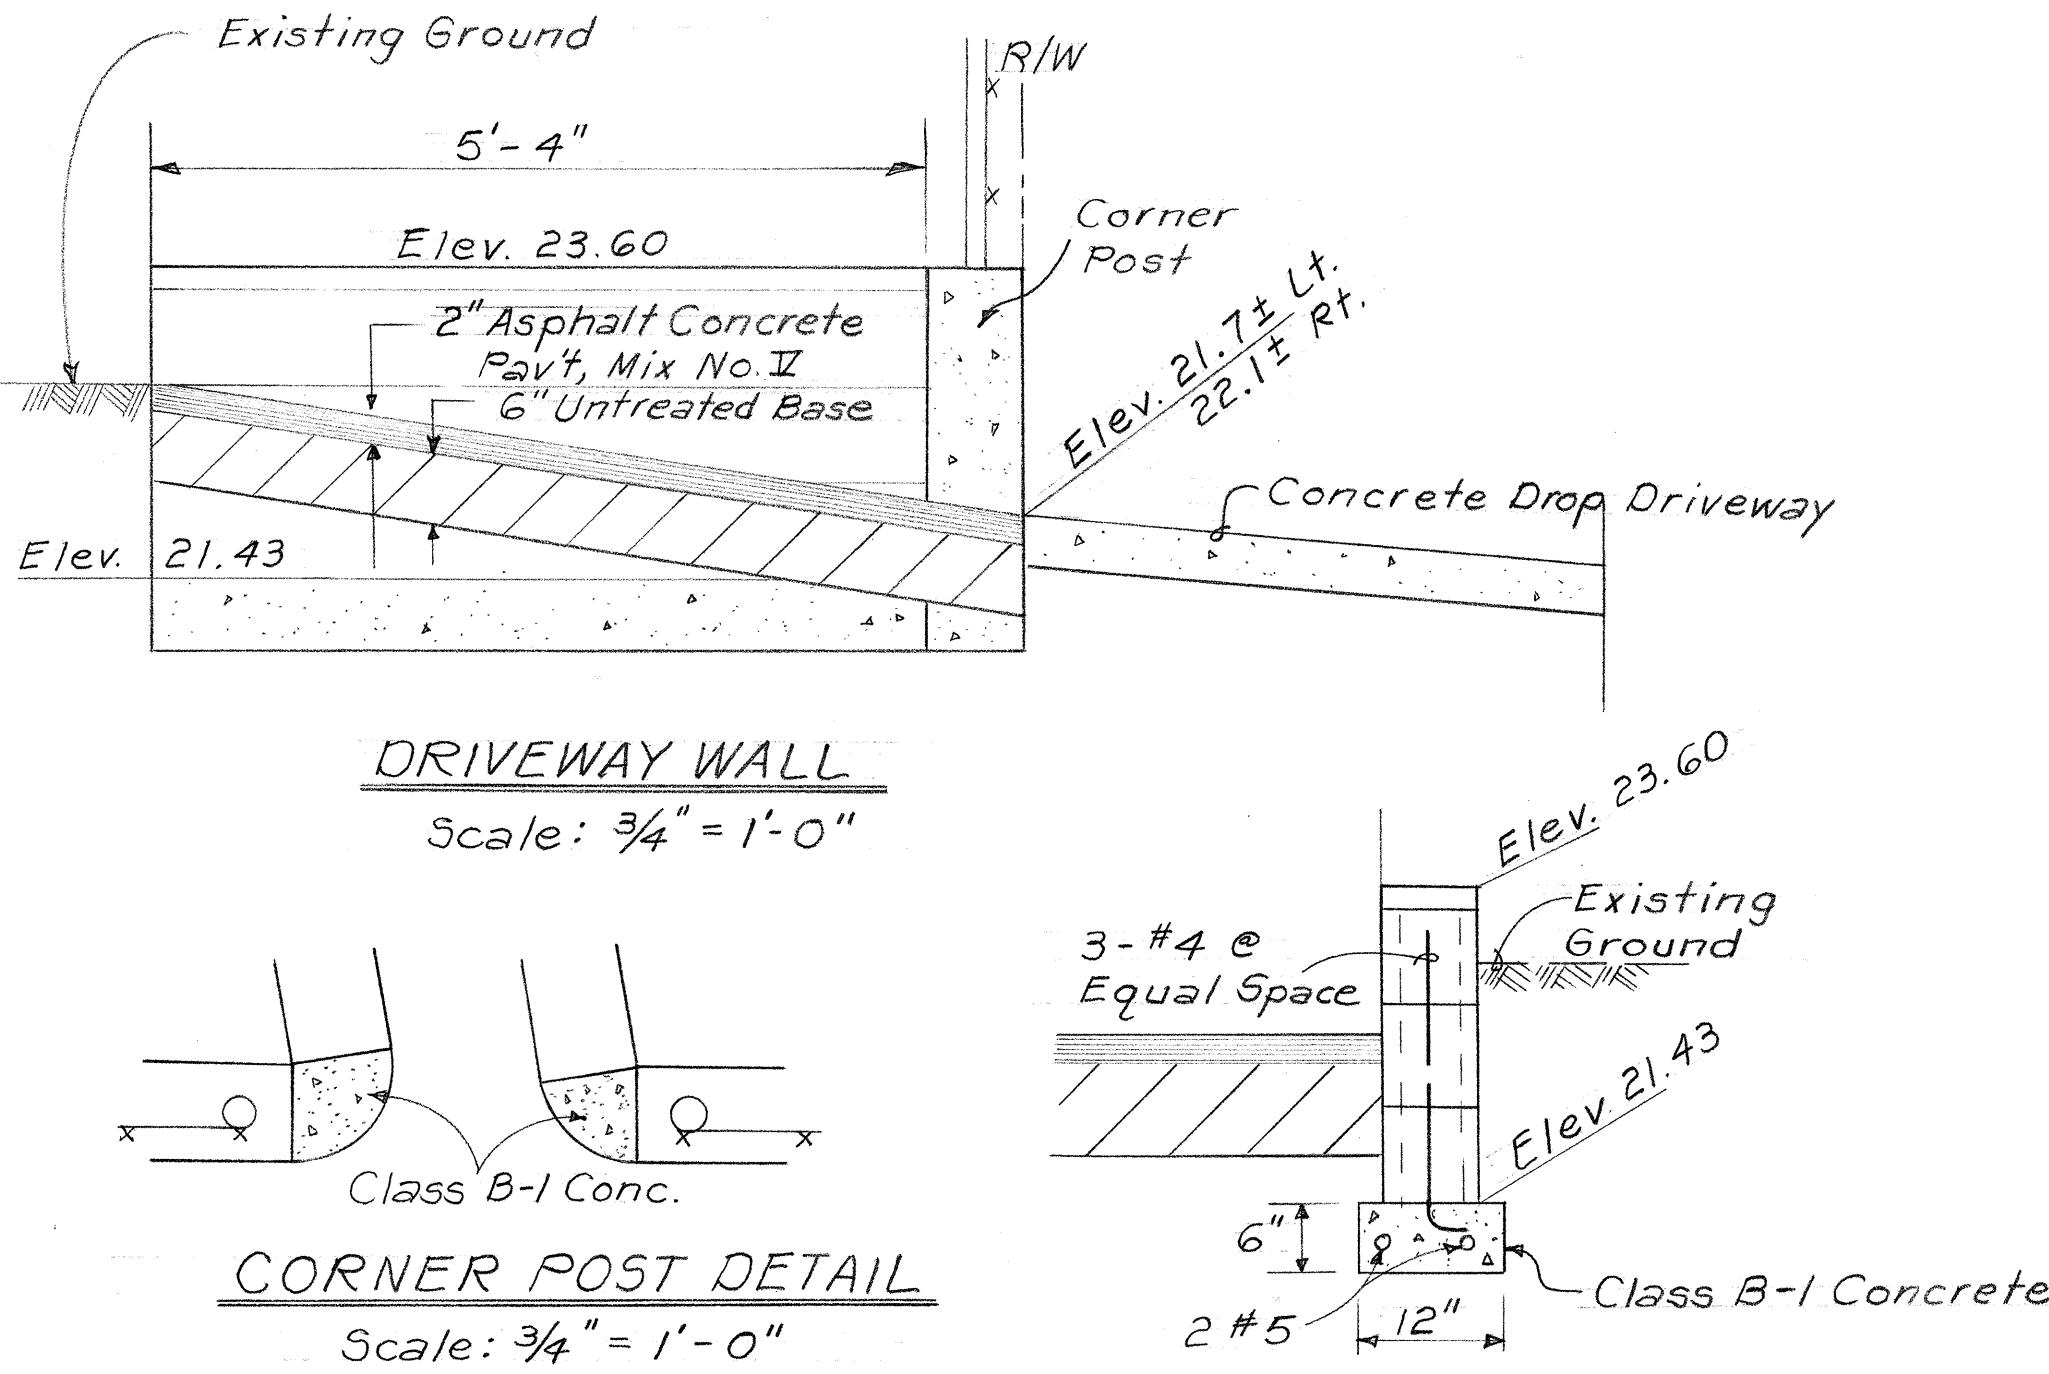


DRIVEWAY WALL
Scale: 3/4" = 1'-0"

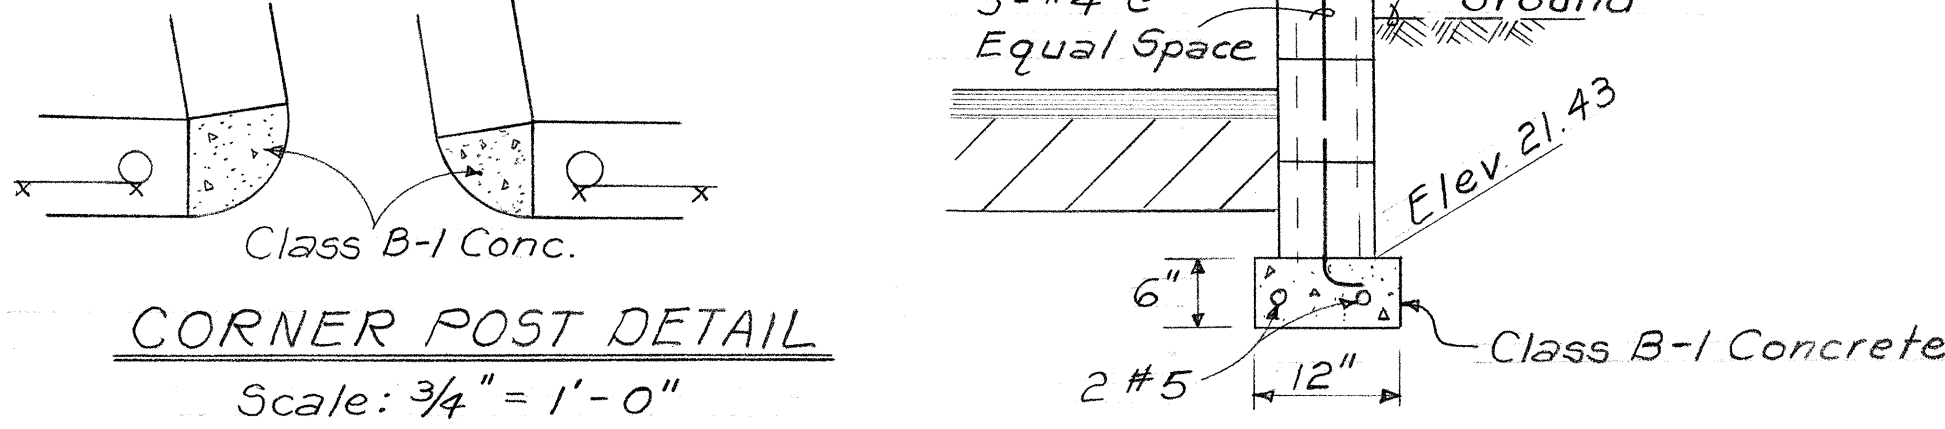


CORNER POST DETAIL
Scale: 3/4" = 1'-0"


TYPICAL DRWY WALL

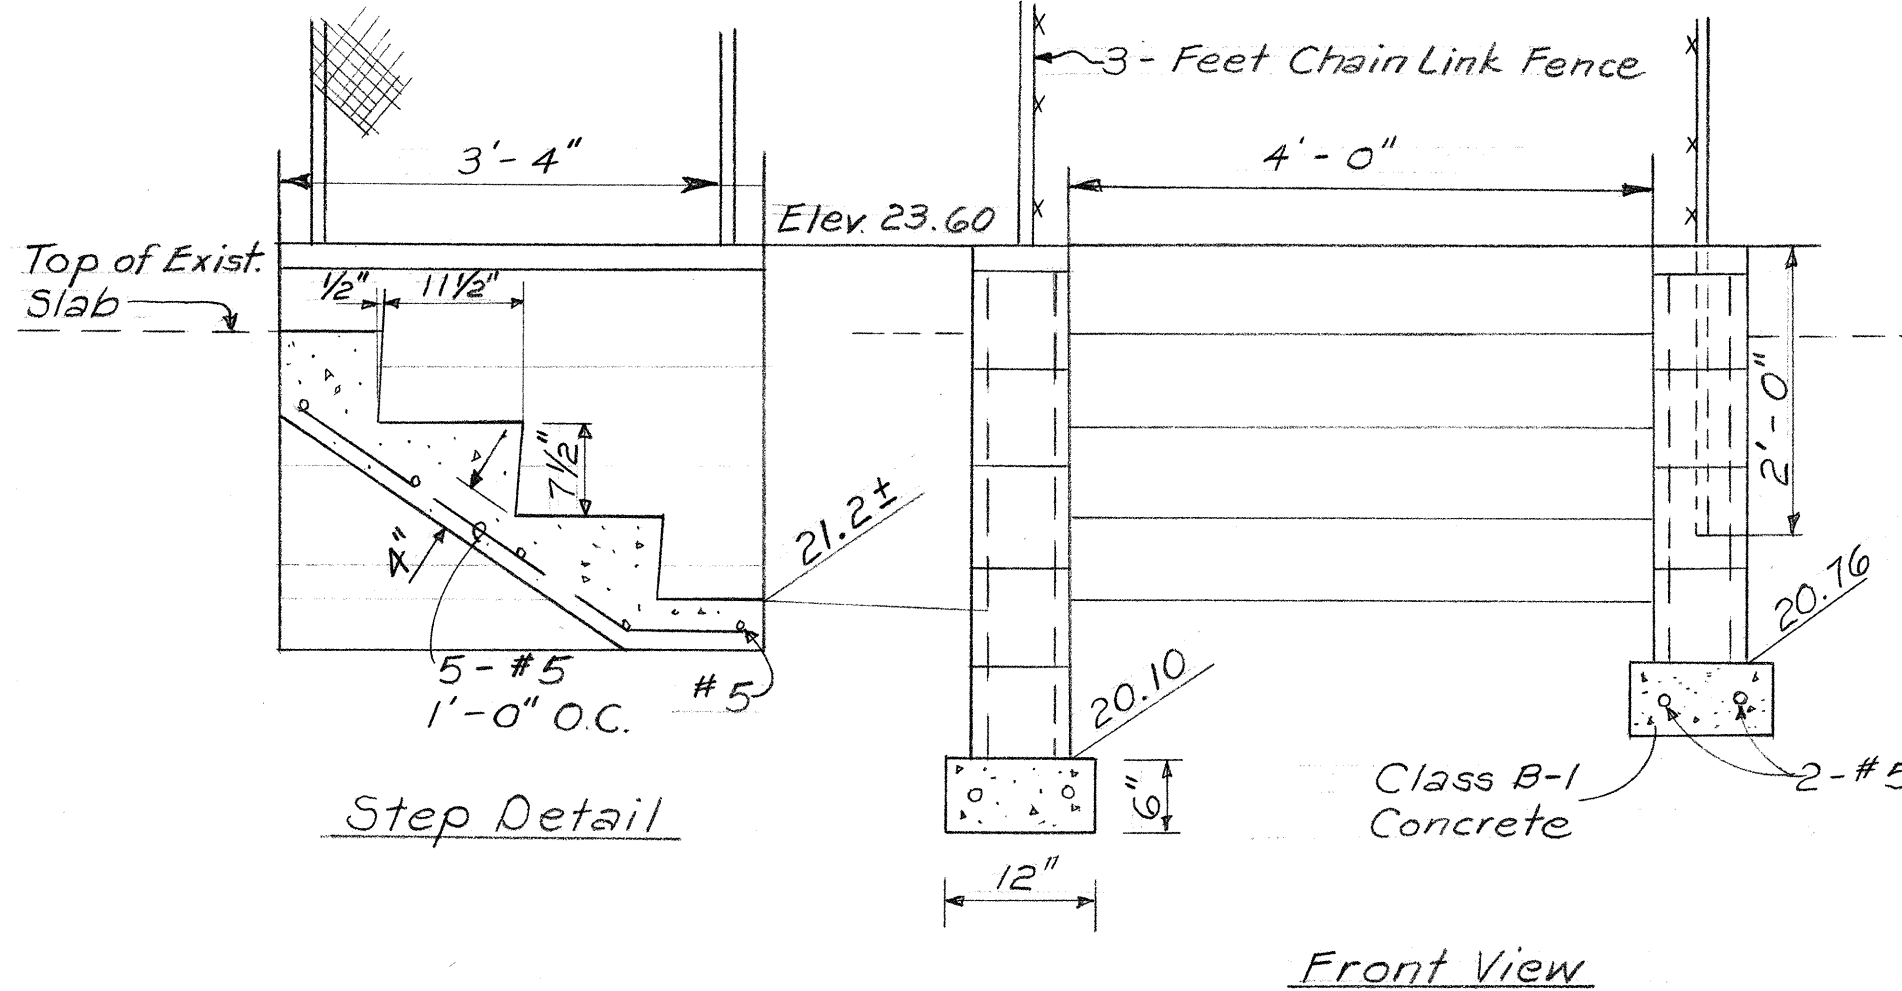


STAIRWAY DETAIL
Scale: 3/4" = 1'-0"

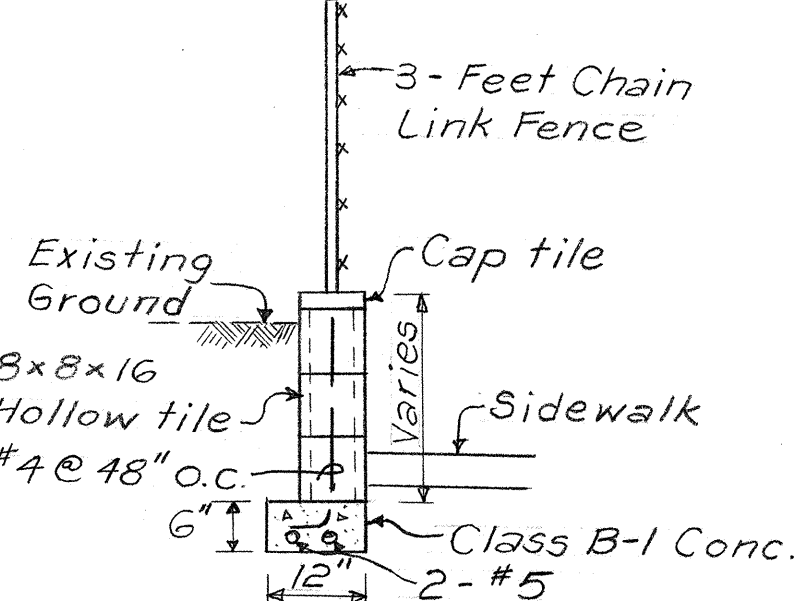

TYPICAL WALL SECTION
Along Waiaka Rd. Ext.
Scale: 1/2" = 1'-0"

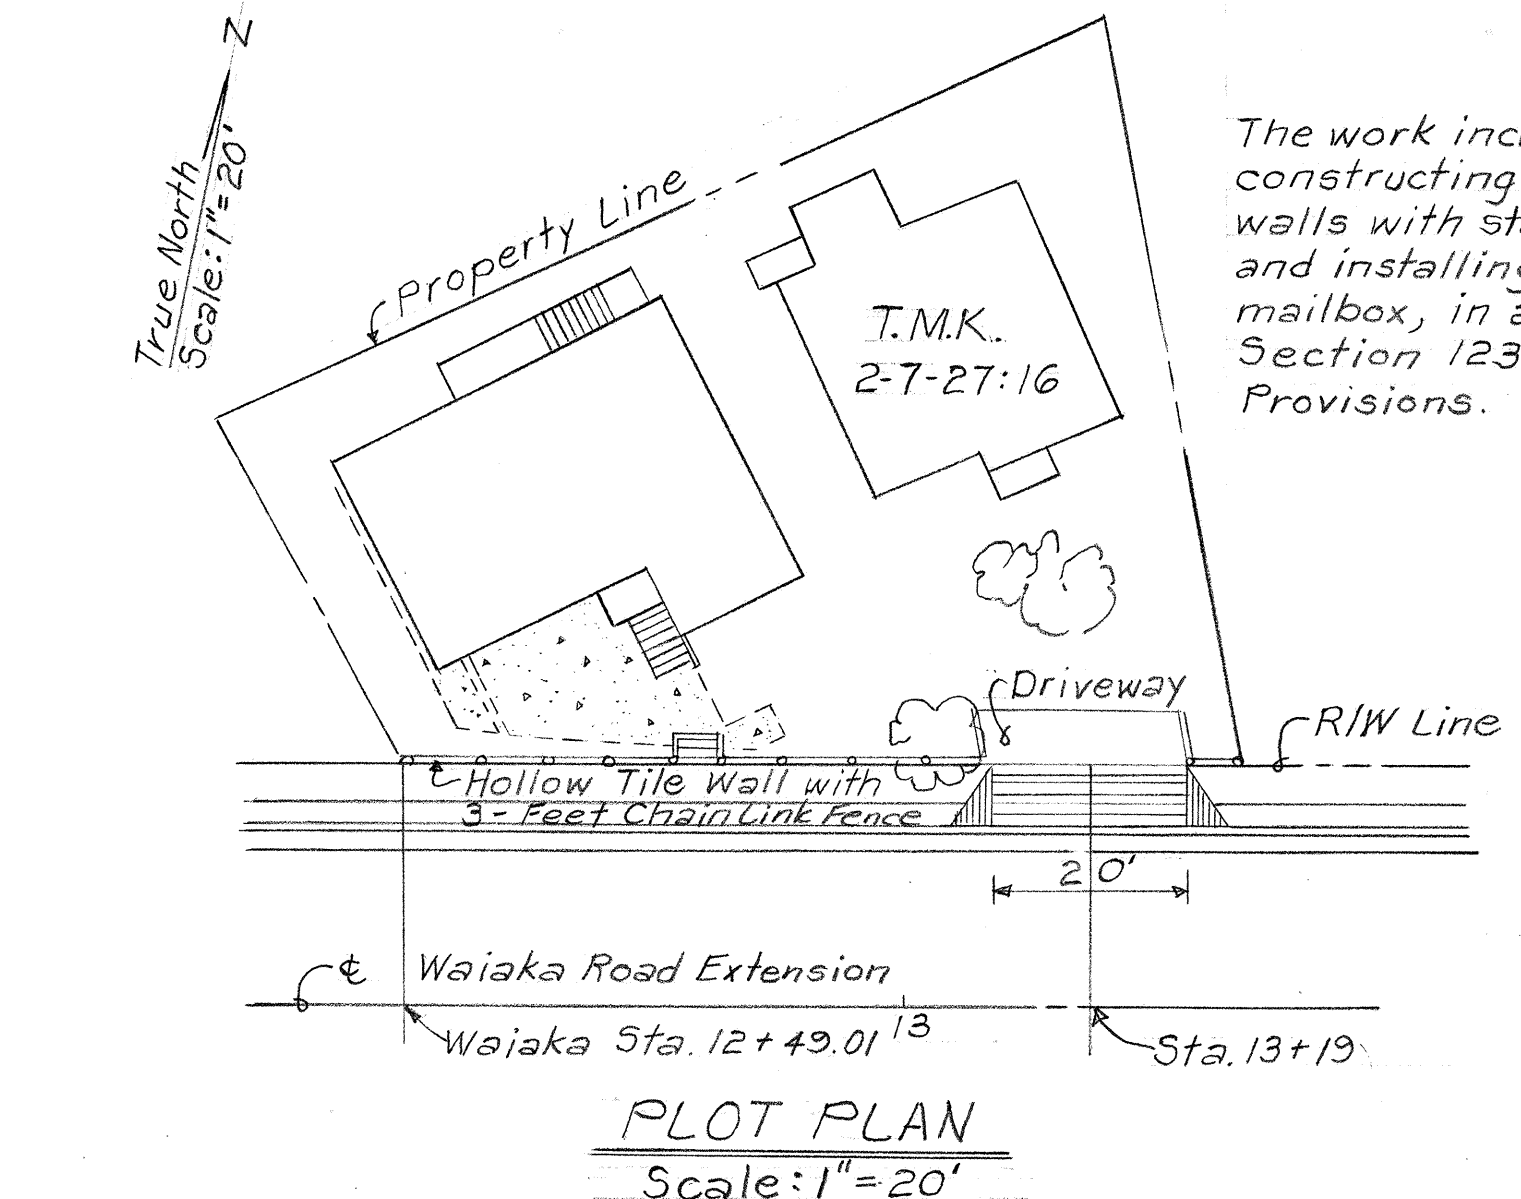

PLOT PLAN
Scale: 1" = 20'

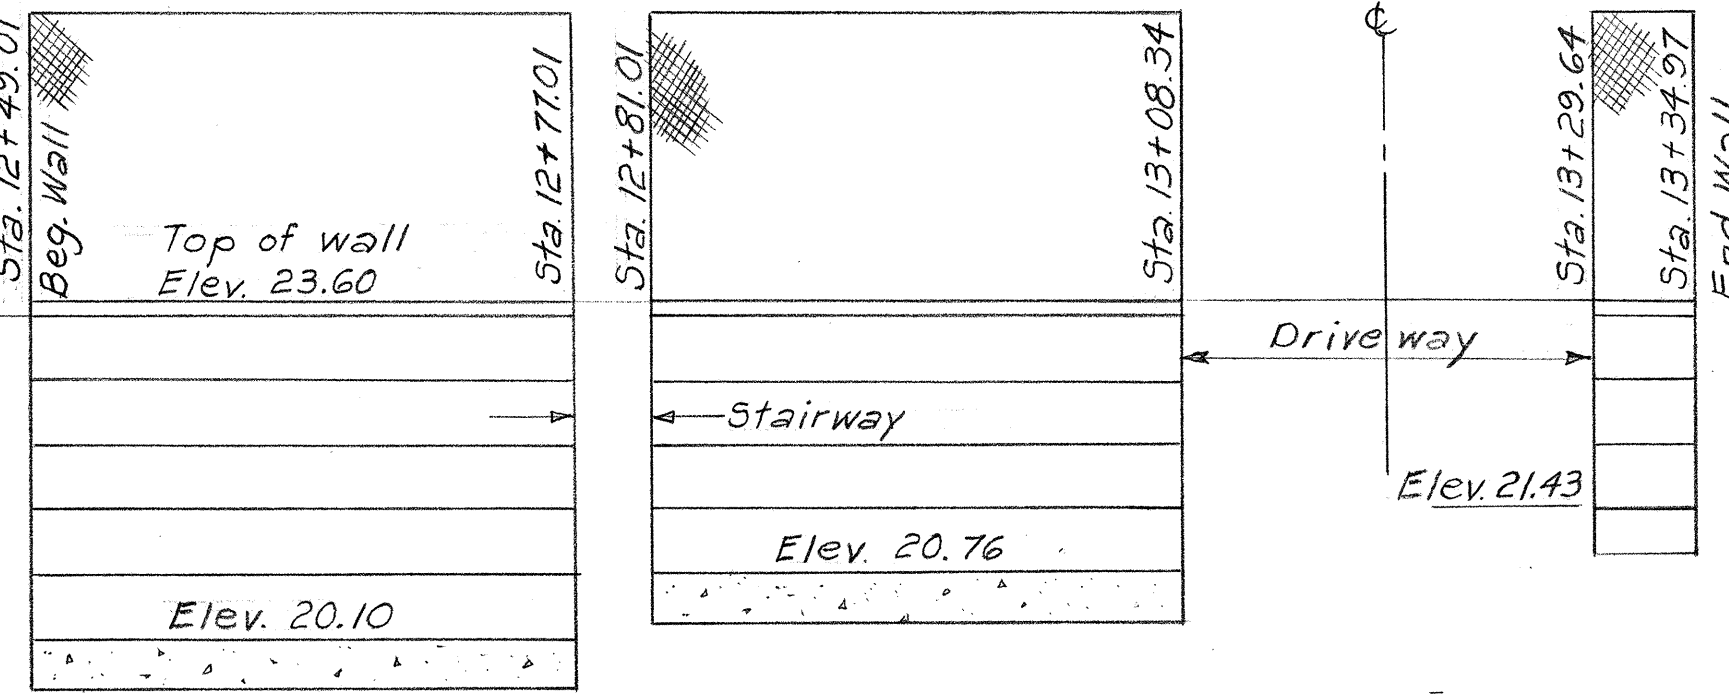


ELEVATION


Wall along Waiaka Road Extension
Scale: Vert. 1/2" = 1'-0"
Hor. 1" = 10'-0"

DATE	
DESIGNED BY	
CHECKED BY	
NOTED BY	
ORIGINAL PLAN	
NOTE BOOK	
No.	


FED. ROAD DIST. NO.	STATE	FED. AID PROJ. NO.	FISCAL YEAR	SHEET NO.	TOTAL SHEETS
HAWAII	HAW.	I-HI-1(2):24 Unit 7	1967	19	152

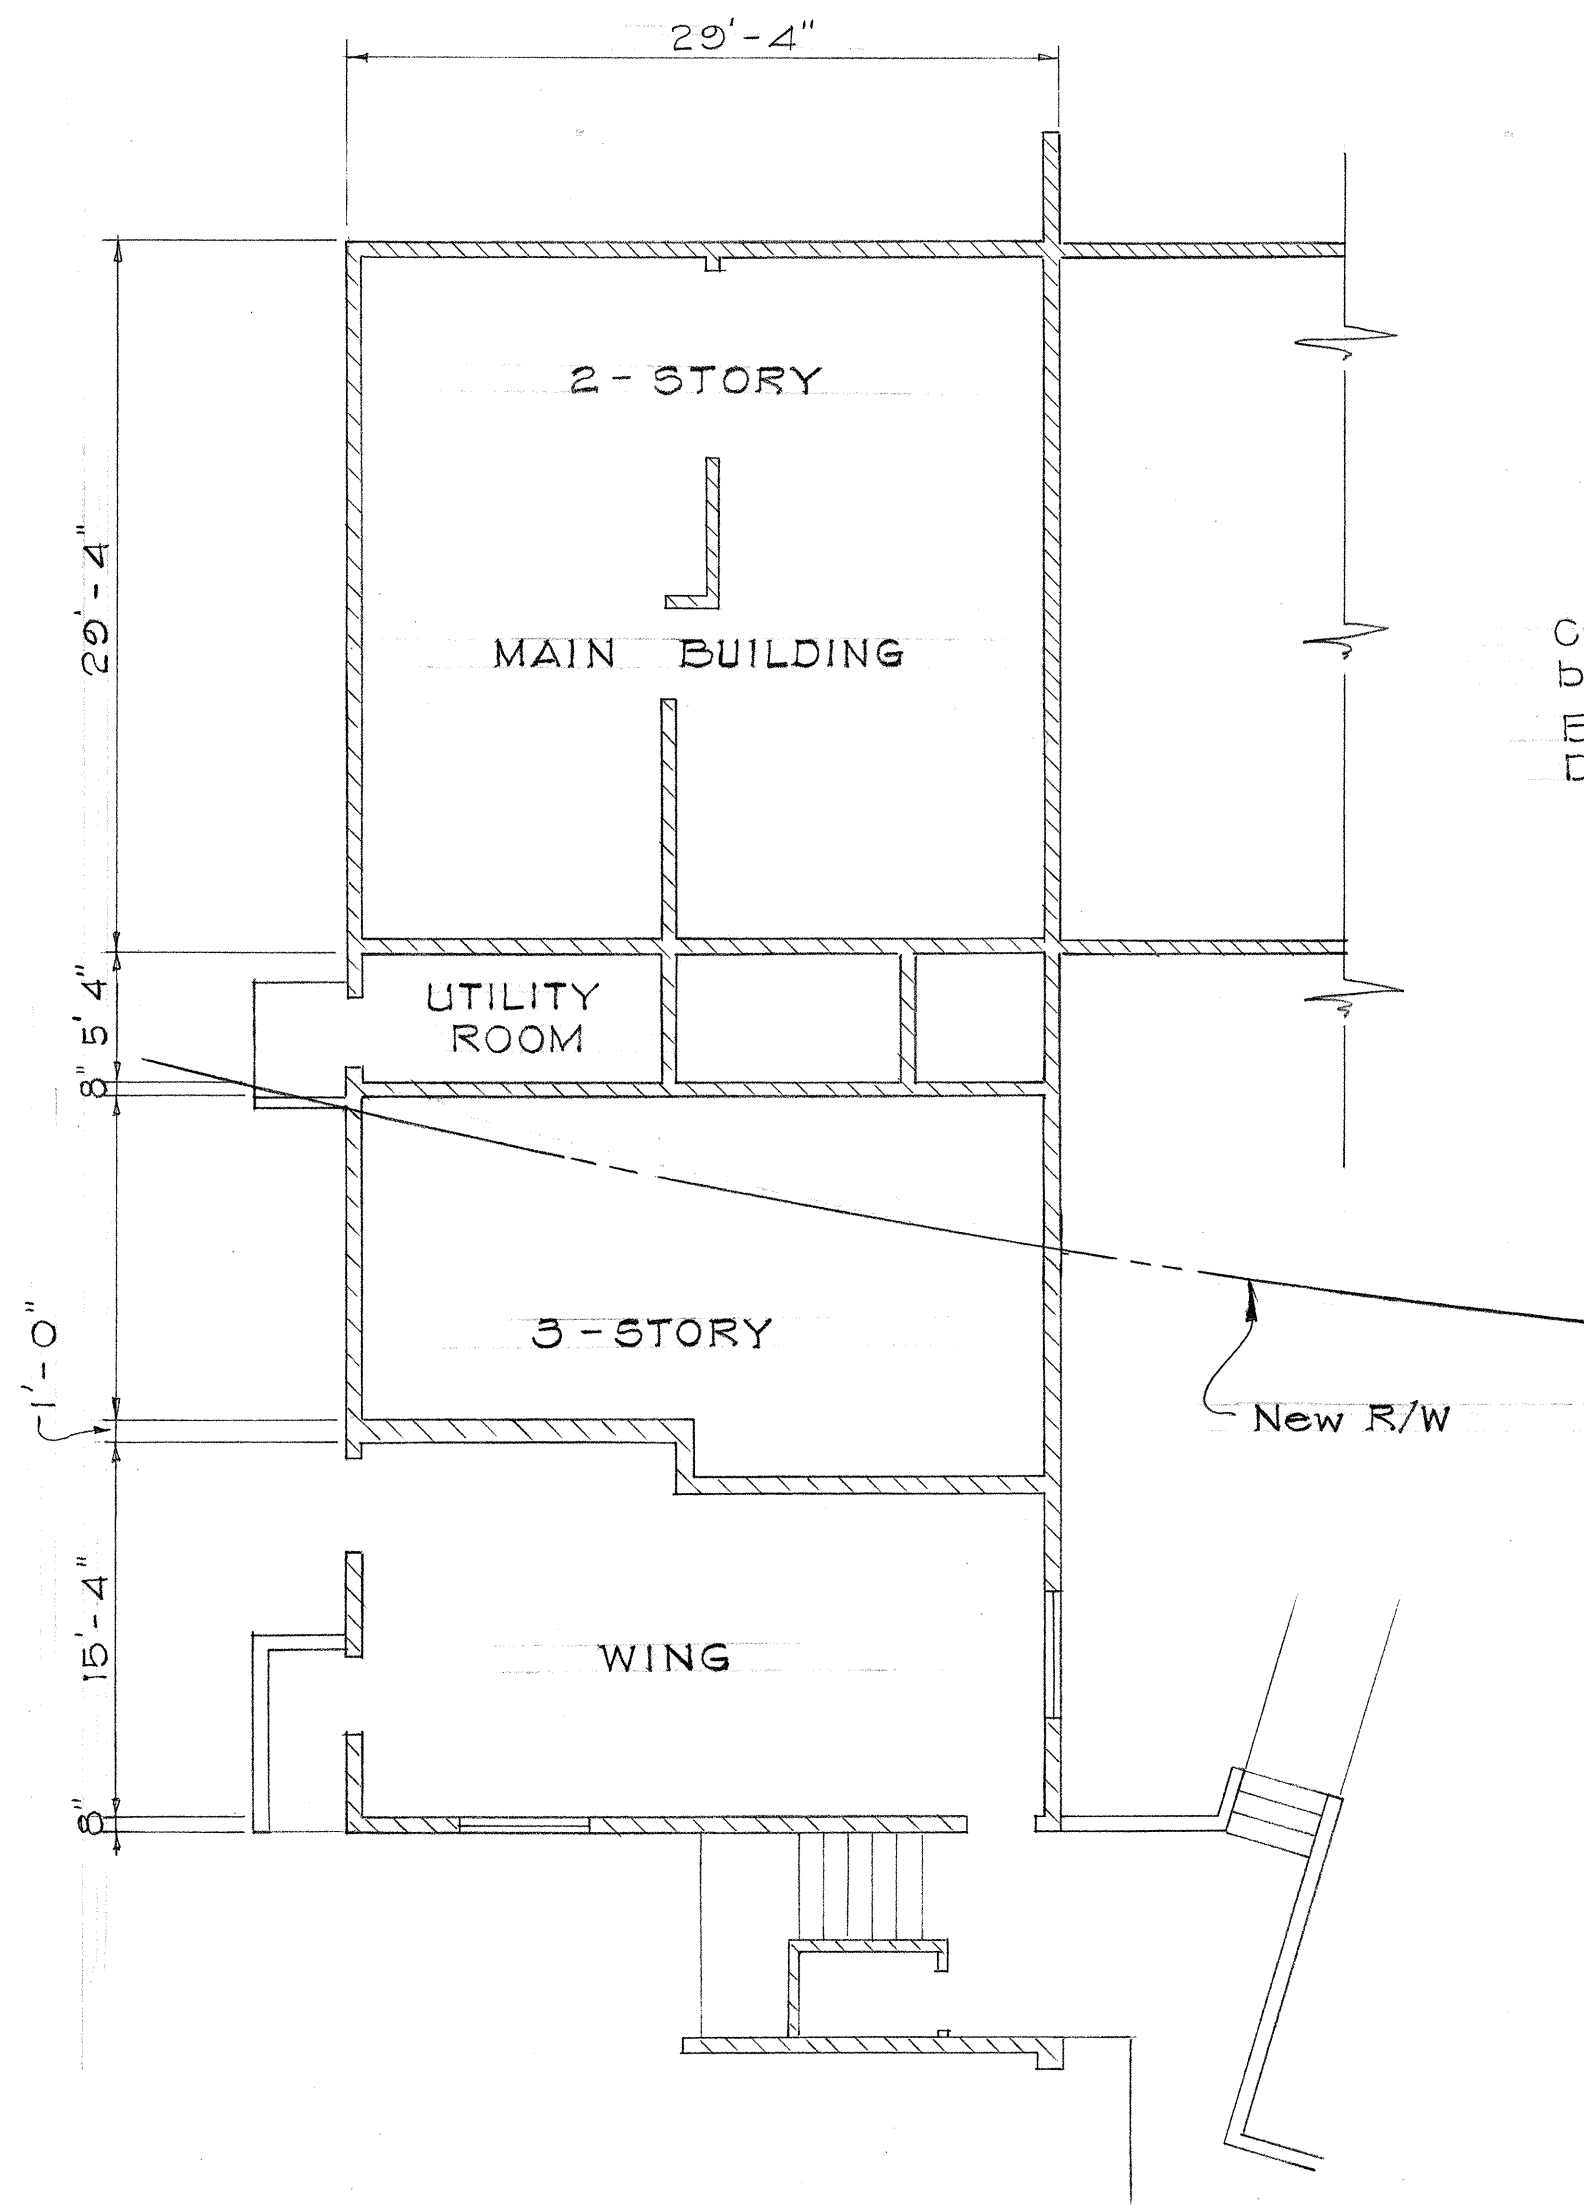


LAYOUT PLAN OF EXISTING WING OF APARTMENT BLDG.
Scale: 1/8"=1'-0"

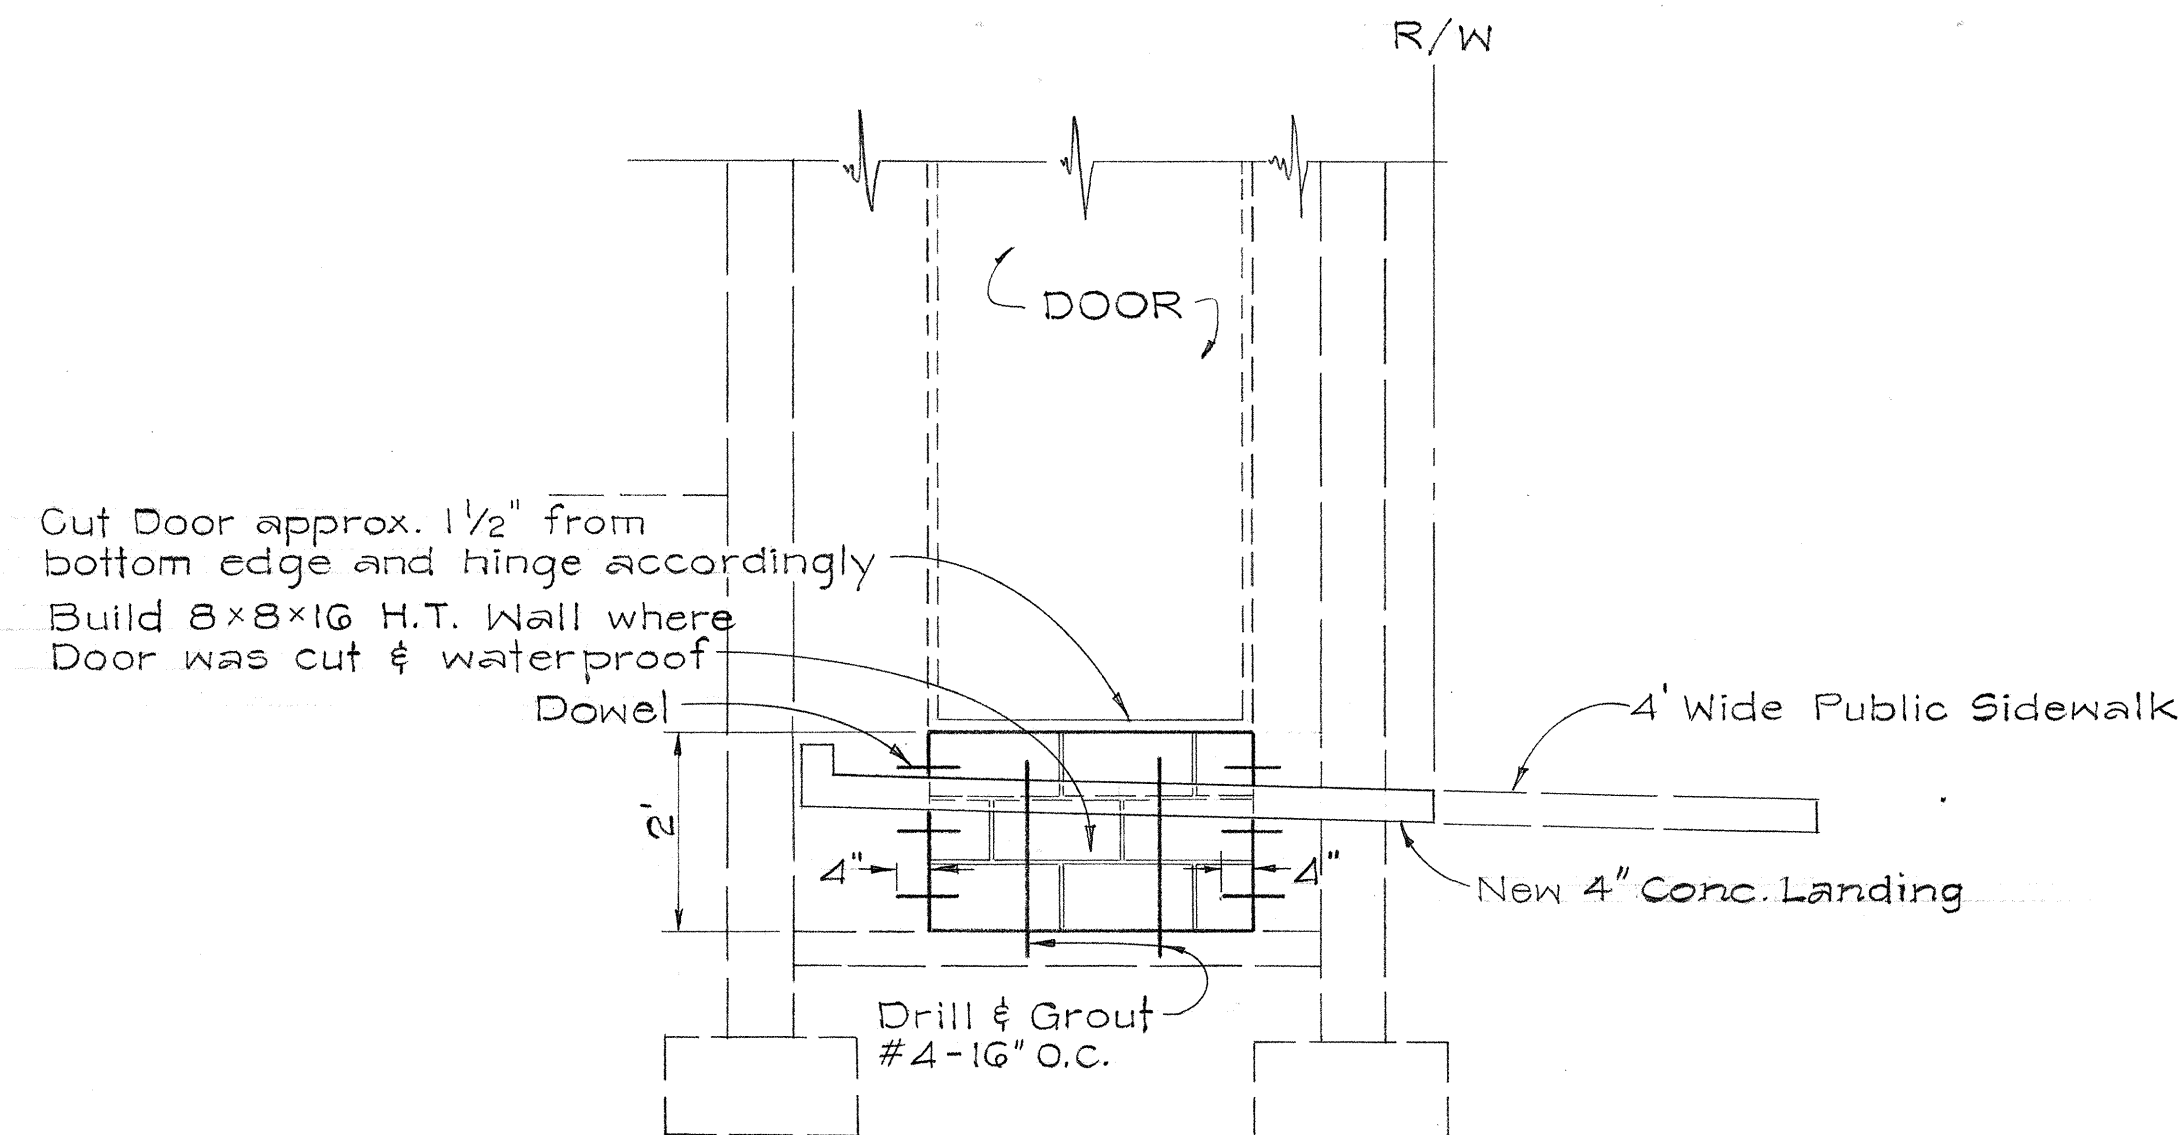


ELEVATION OF UTILITY ROOM DOORWAY
Scale: 1/2"=1'-0"

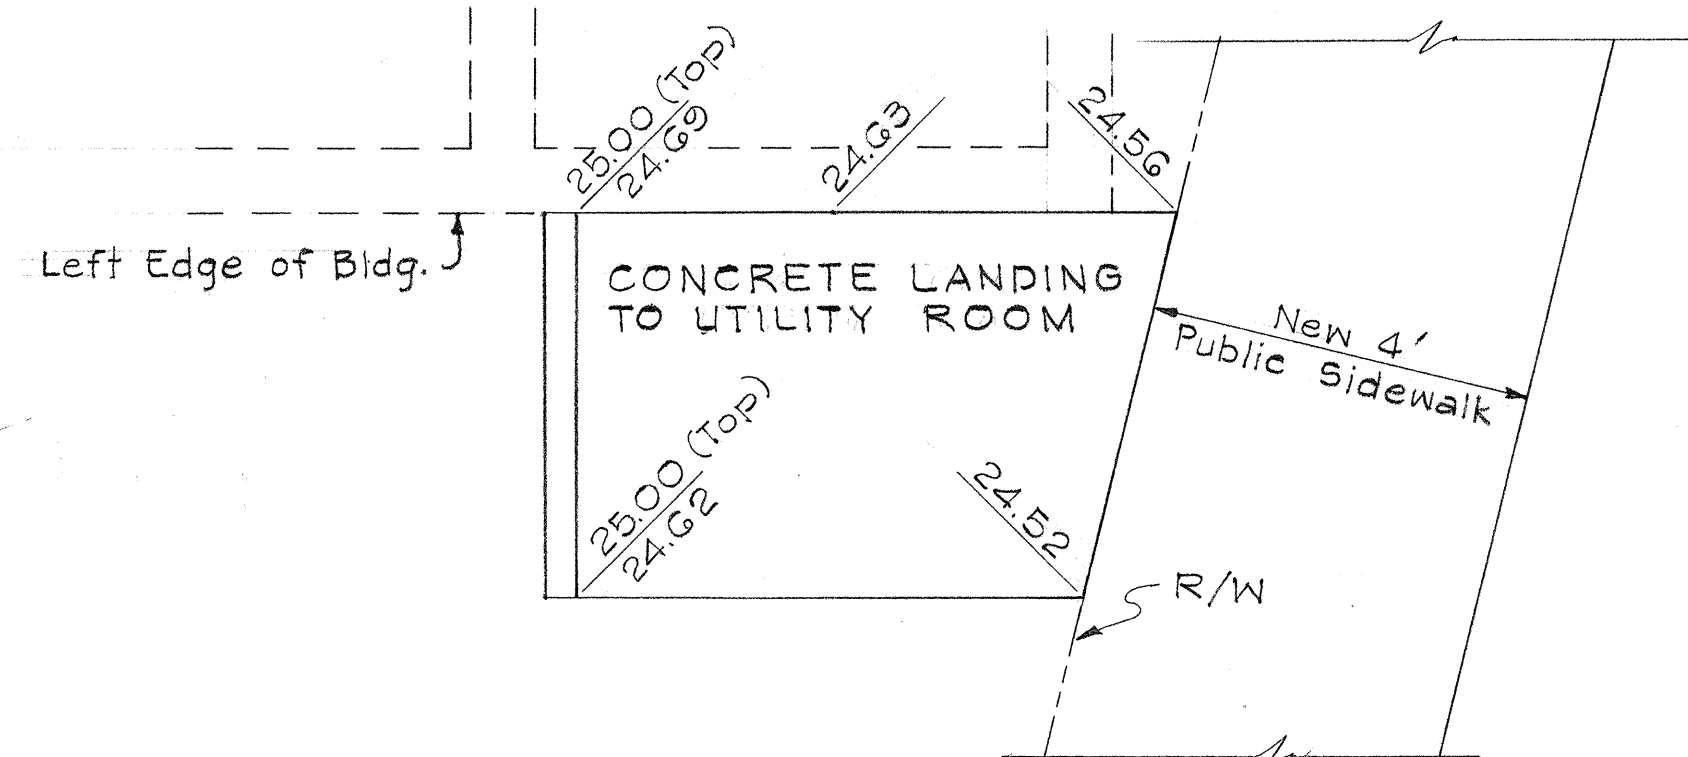

LANDING GRADE PLAN
Scale: 1/2"=1'-0"

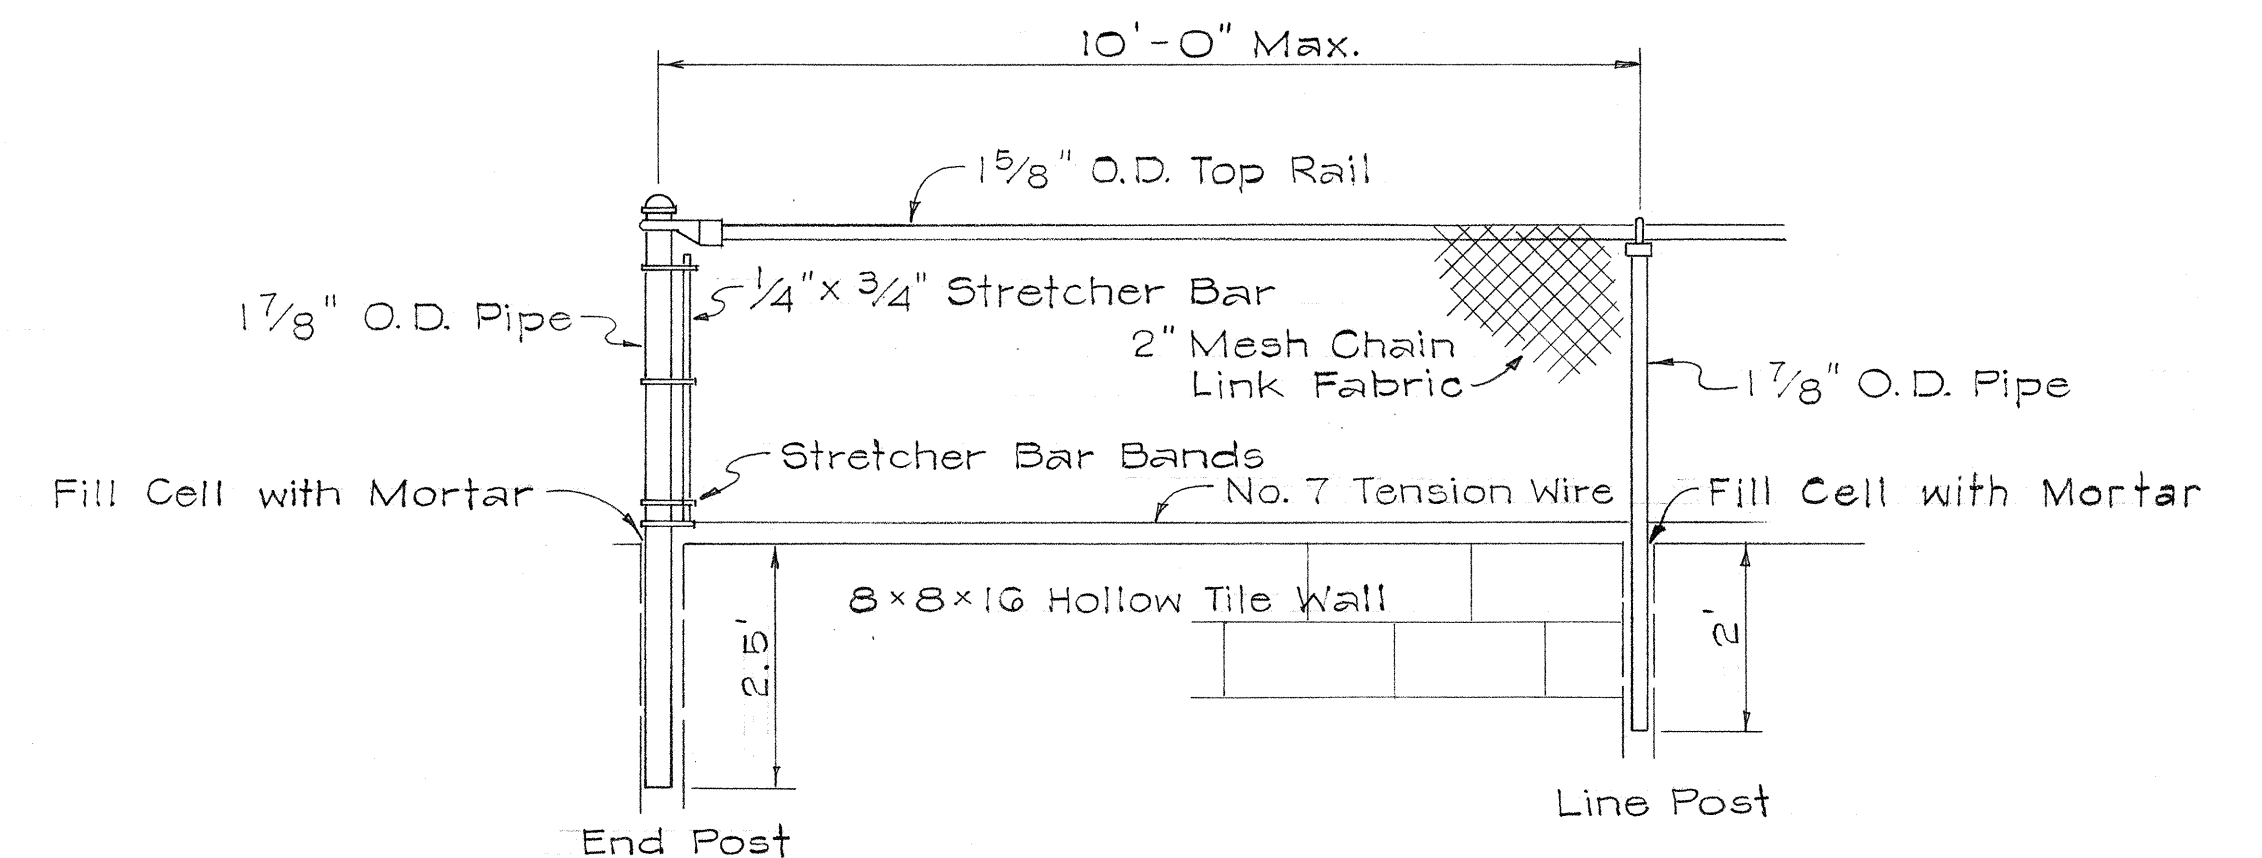

DETAIL OF 3' CHAIN LINK FENCE
Scale: 1"=2'-0"

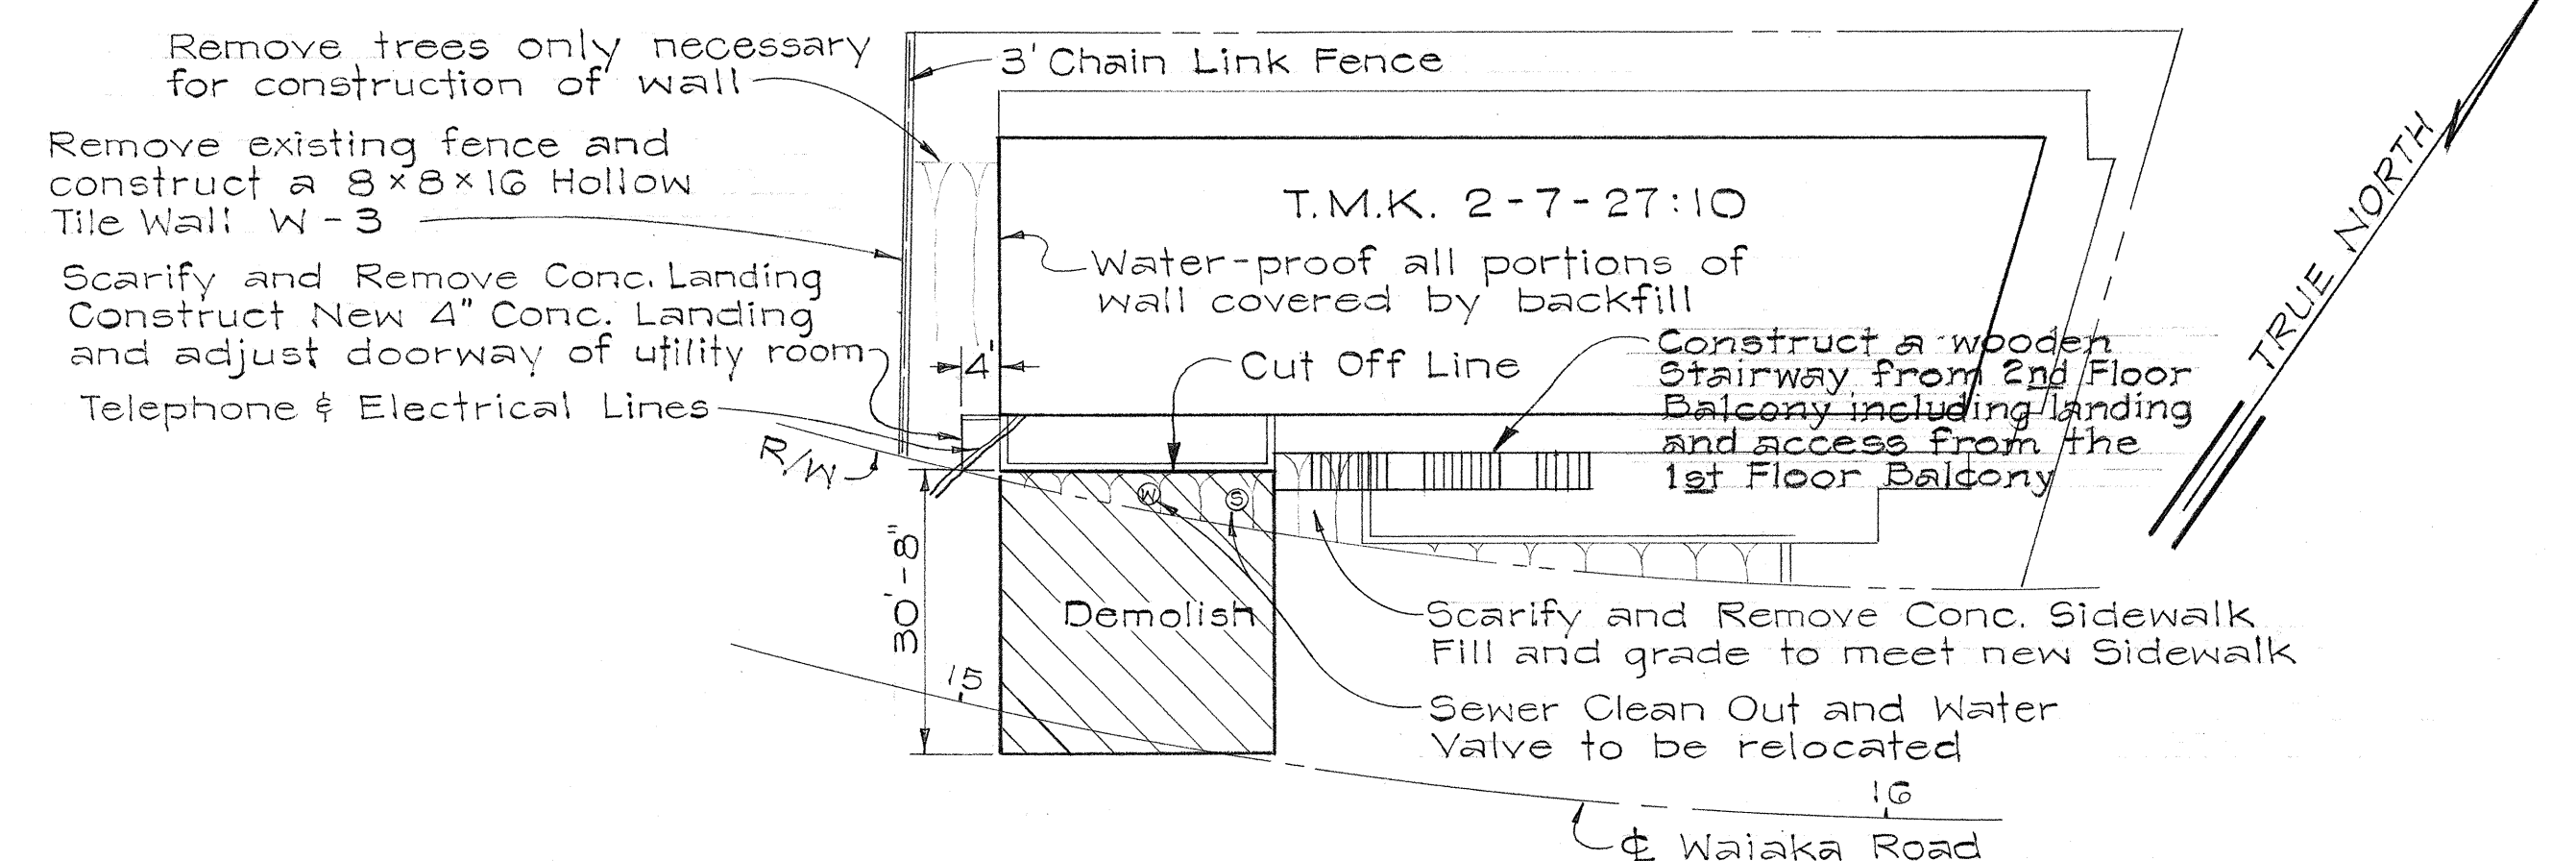

PLOT PLAN
Scale: 1"=20'

CONTRACT ITEM NO. 123.C REHABILITATION OF LOT TAX MAP KEY No. 2-7-27:10

NOTES:

1. Demolish Apartment Wing as indicated.
2. Construct wooden stairway from the remaining portion of the second floor balcony to the front garden.
3. Cut off all utilities to the apartment wing.
4. Construct Hollow Tile Wall W-3 with 3' Chain Link Fence.
5. Scarify and remove existing concrete sidewalks and landing.
6. Reconstruct utility room access doorway as indicated on Plan.
7. Backfill and grade to meet new grade along property frontage.
8. For additional details and requirements refer to Sections 123 and 123 C of the Special Provisions.

STATE OF HAWAII
DEPARTMENT OF TRANSPORTATION
HIGHWAYS DIVISION

R/W ADJUSTMENT

INTERSTATE HIGHWAY (LUNALILO FREEWAY)
F.A.I. Proj. No. I-HI-1(2):24, Unit 7

Scale: As Noted Date: June 1967


SHEET No. 2 OF 3 SHEETS

FED. ROAD DIST. NO.	STATE	FED. AID PROJ. NO.	FISCAL YEAR	SHEET NO.	TOTAL SHEETS
HAWAII	HAW.	I-HI-1(2):24 Unit 7	1967	0020	152

REVISED: Nov. 21, 1967


NOTES

1. The work to be done includes scarifying and removing asphalt concrete pavement, excavating, and grading the frontage, constructing a CRM Wall, constructing an asphalt concrete driveway and parking area, and furnishing and installing a new RFD type mailbox.
2. CRM shall conform to the applicable requirements of Section G2 of the specifications.
3. Also refer to Section 123 of the Special Provisions for additional details and requirements.

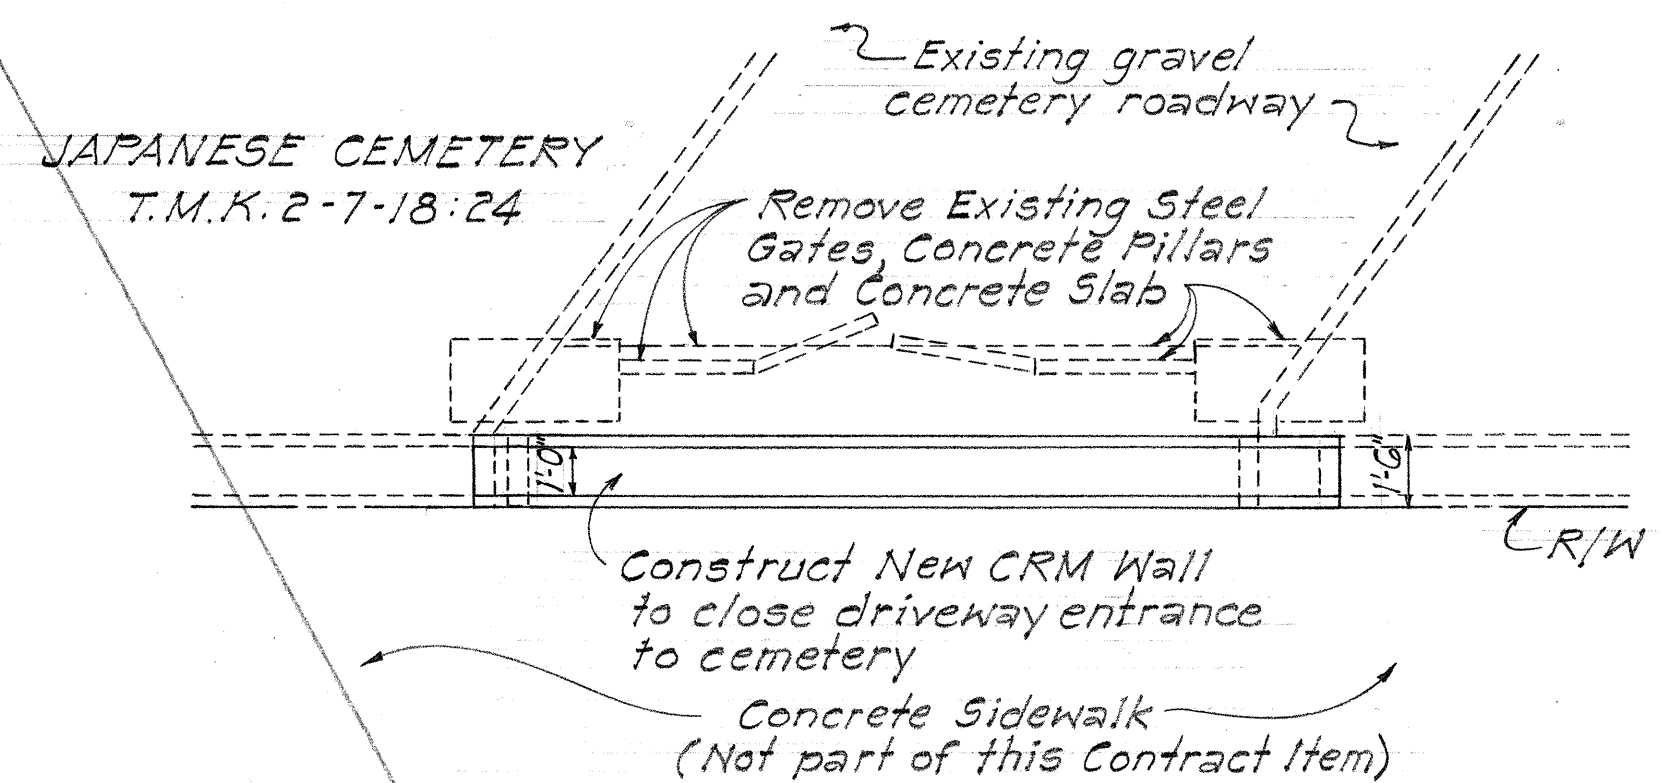


PLAN VIEW

Scale: 1/4"=1'-0"

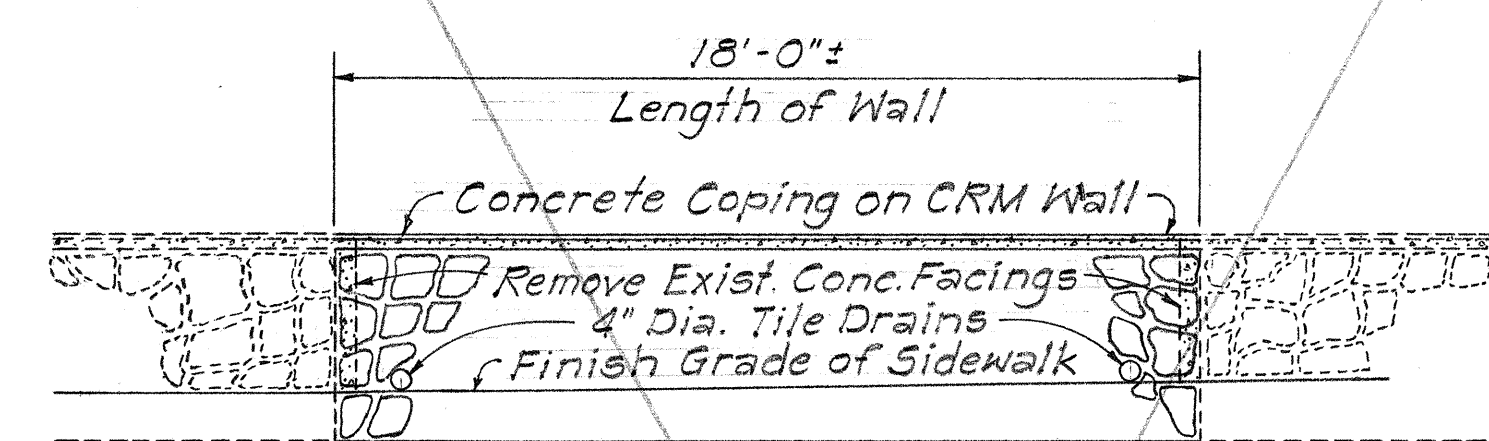

ELEVATION VIEW

Scale: 1/4"=1'-0"

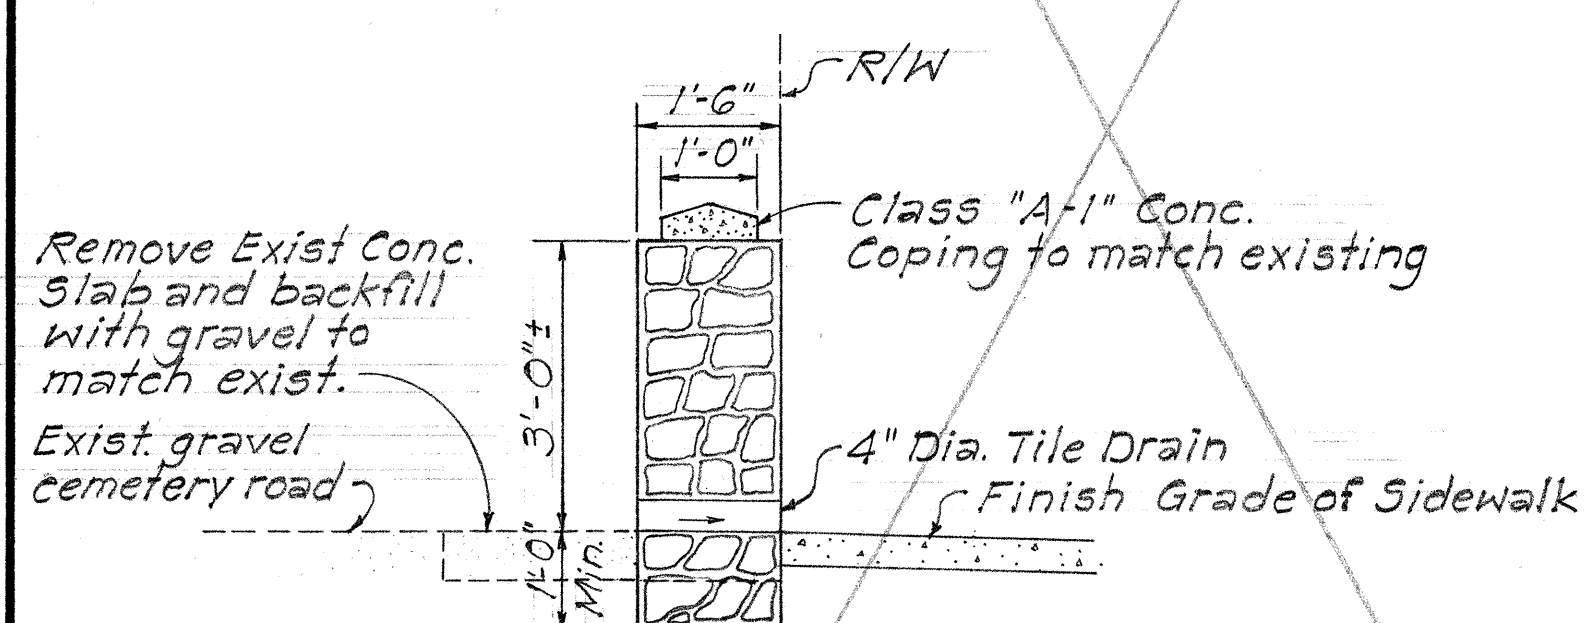


SECTION VIEW

Scale: 1/2"=1'-0"


NOTES

1. CRM shall conform to the applicable requirements of Section G2 of the specifications.
2. Also refer to Sections 123 & 123D of the Special Provisions for additional details and requirements.

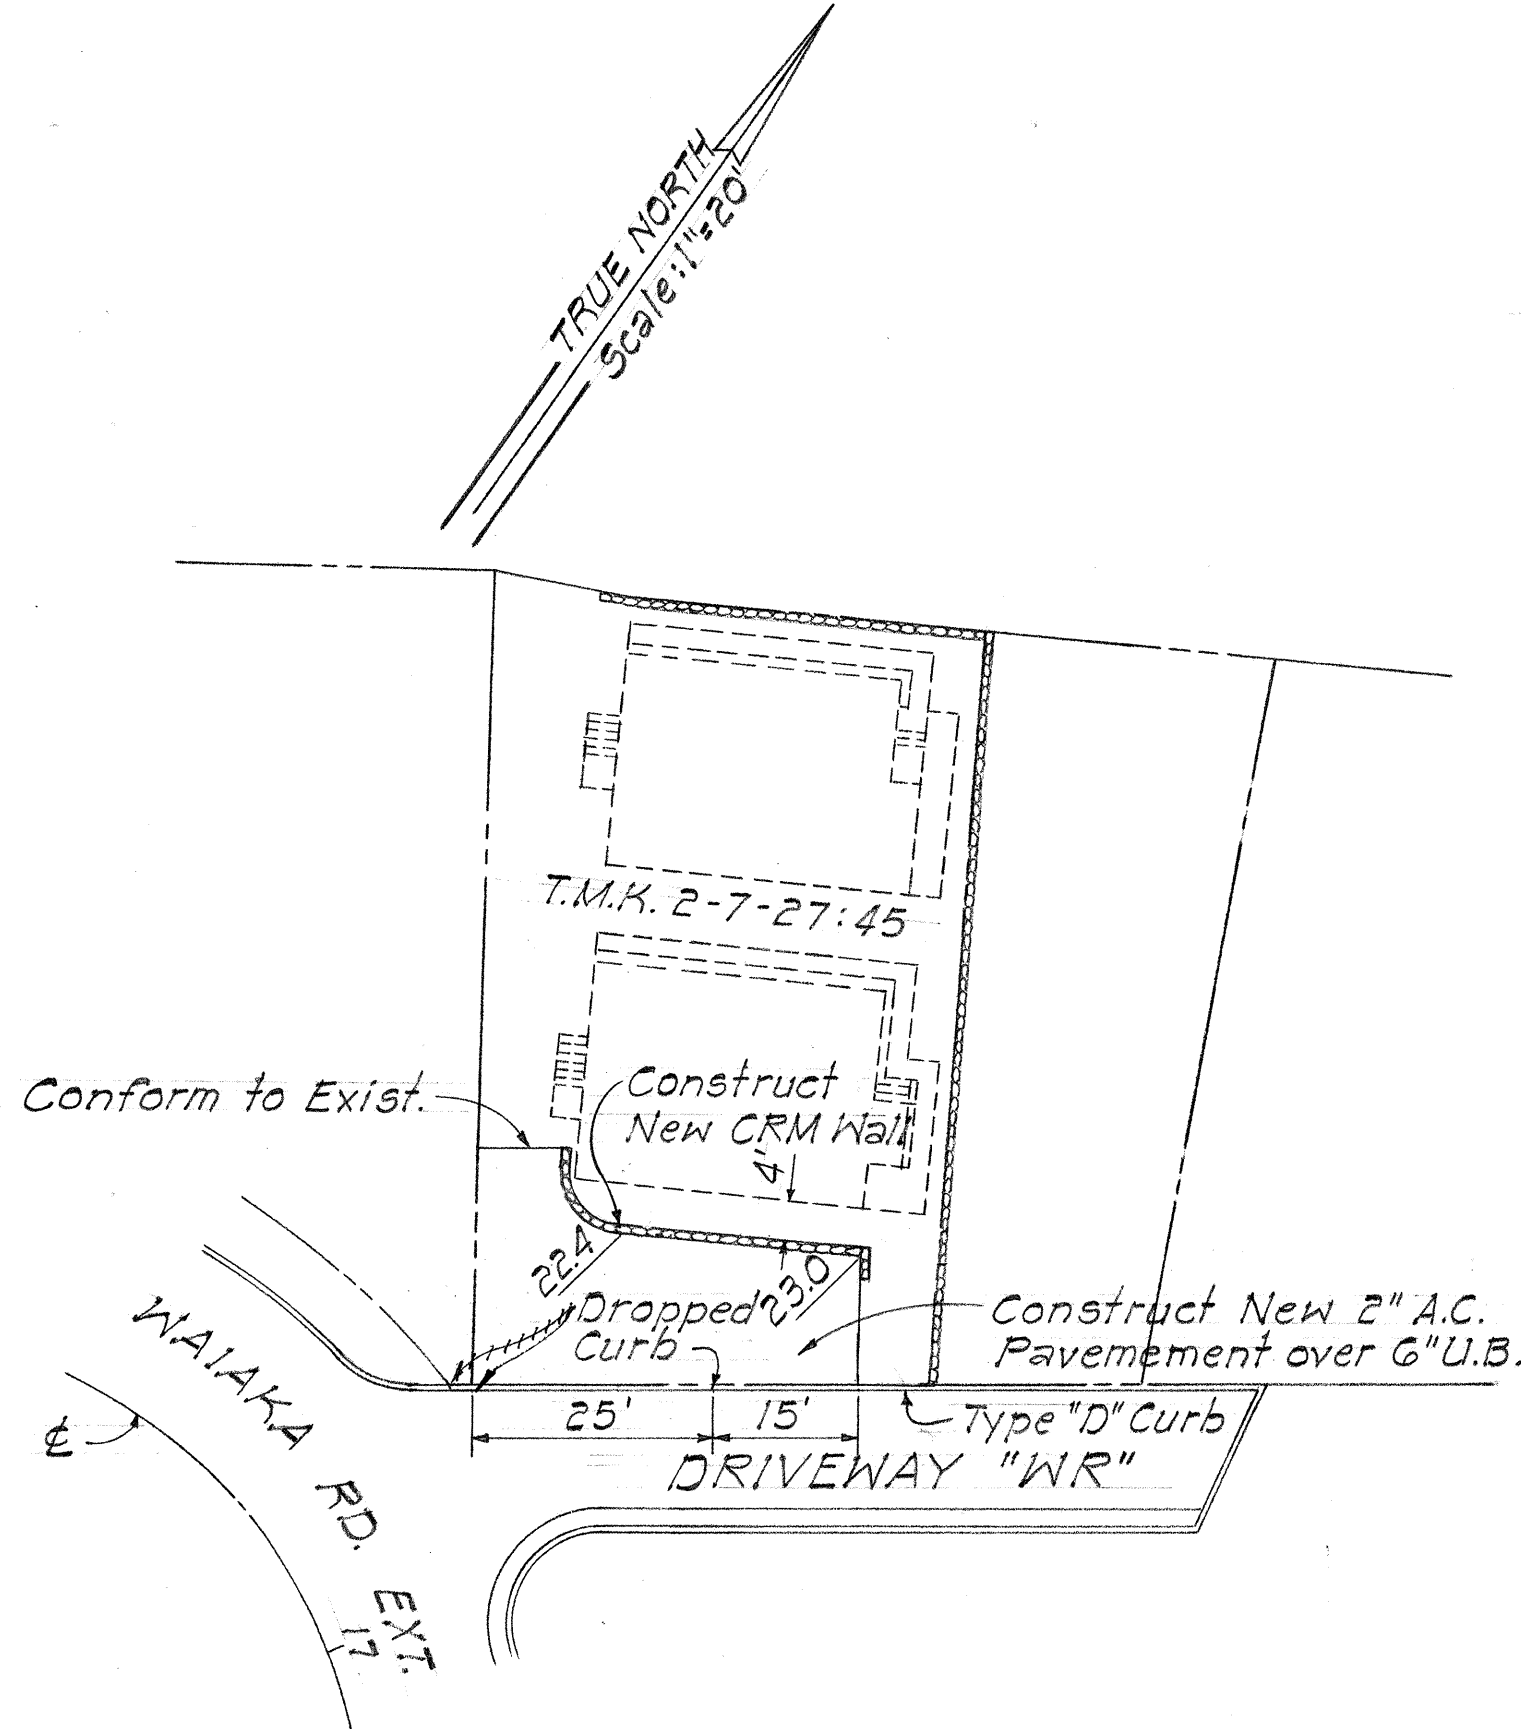


PLAN VIEW

Scale: 1"=20'

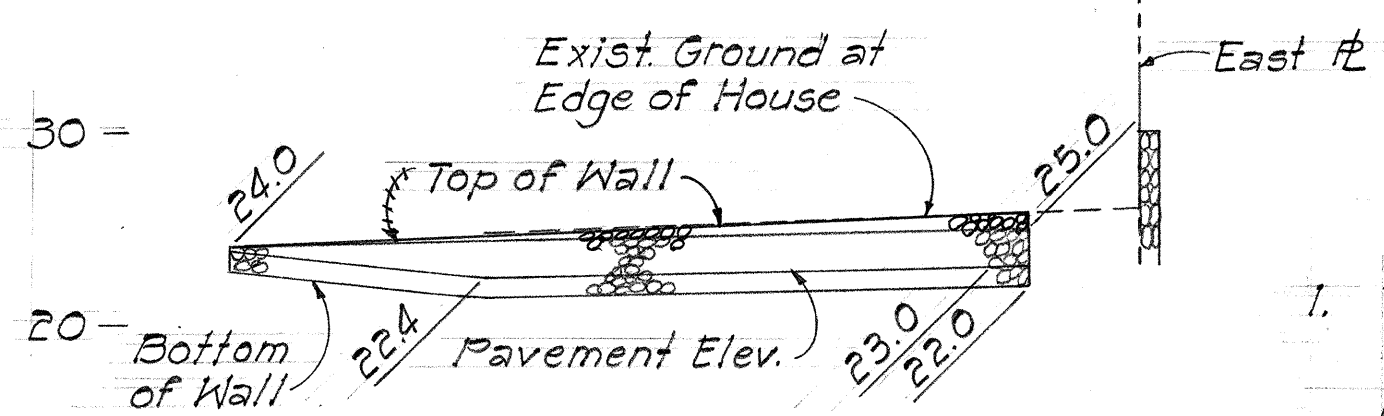

PROFILE ALONG CRM WALL

Scale: 1"=10'

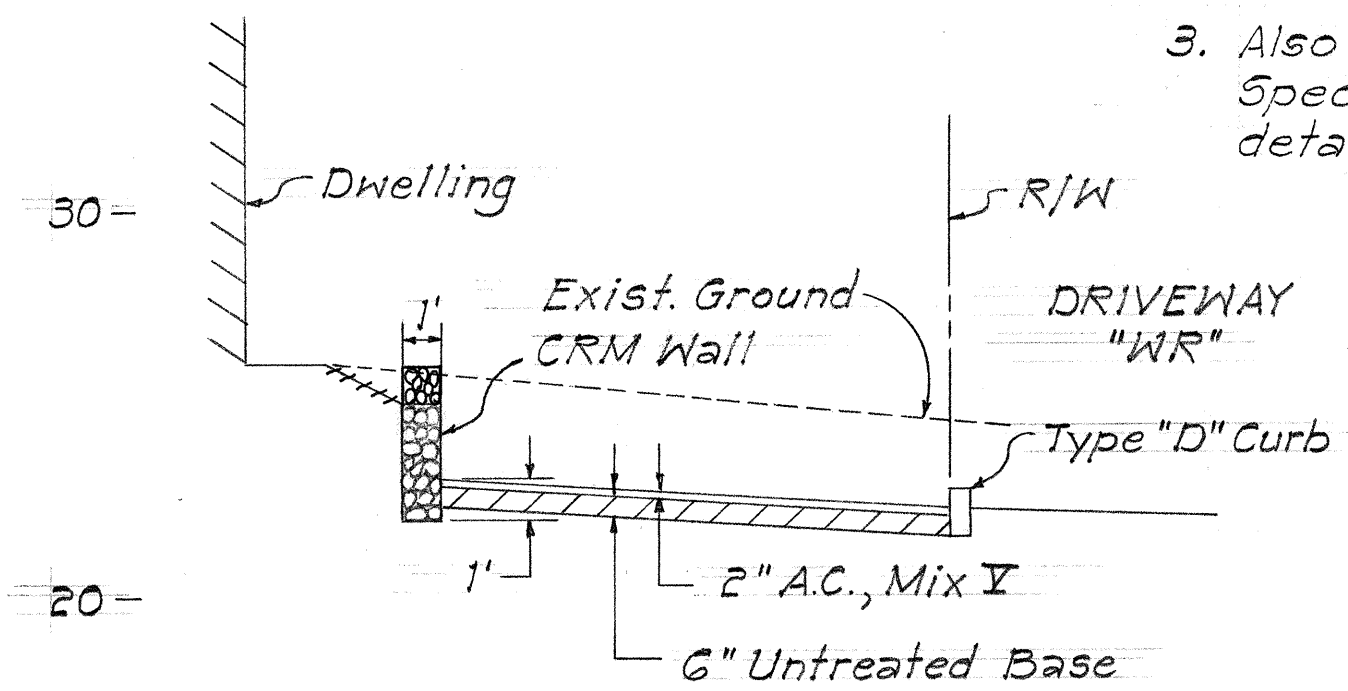

TYPICAL SECTION

Scale: 1"=5'

CONTRACT ITEM NO. 123D REHABILITATION OF EXISTING IMPROVEMENTS ON LOT TAX MAP KEY NO. 2-7-27:45

CONTRACT ITEM NO. 123F REHABILITATION OF EXISTING IMPROVEMENTS ON LOT TAX MAP KEY NO. 2-7-18:24

THIS SHEET SUPERSEDES
AND REPLACES SHEET NO. 20

STATE OF HAWAII
DEPARTMENT OF TRANSPORTATION
HIGHWAYS DIVISION

R/W ADJUSTMENT

INTERSTATE HIGHWAY (LUNALILO FREEWAY)
F.A.I. Proj. No. I-HI-1(2):24, Unit 7

Scale: As Noted Date: Aug. 24, 1967

SHEET No. 3 OF 3 SHEETS

0020