


PLAN
DATE
BY
SURVEYED
NOTES
NO. 1
NO. 2
NO. 3
NO. 100

PROFILE
DATE
BY
SURVEYED
NOTES
NO. 1
NO. 2
NO. 3
NO. 100

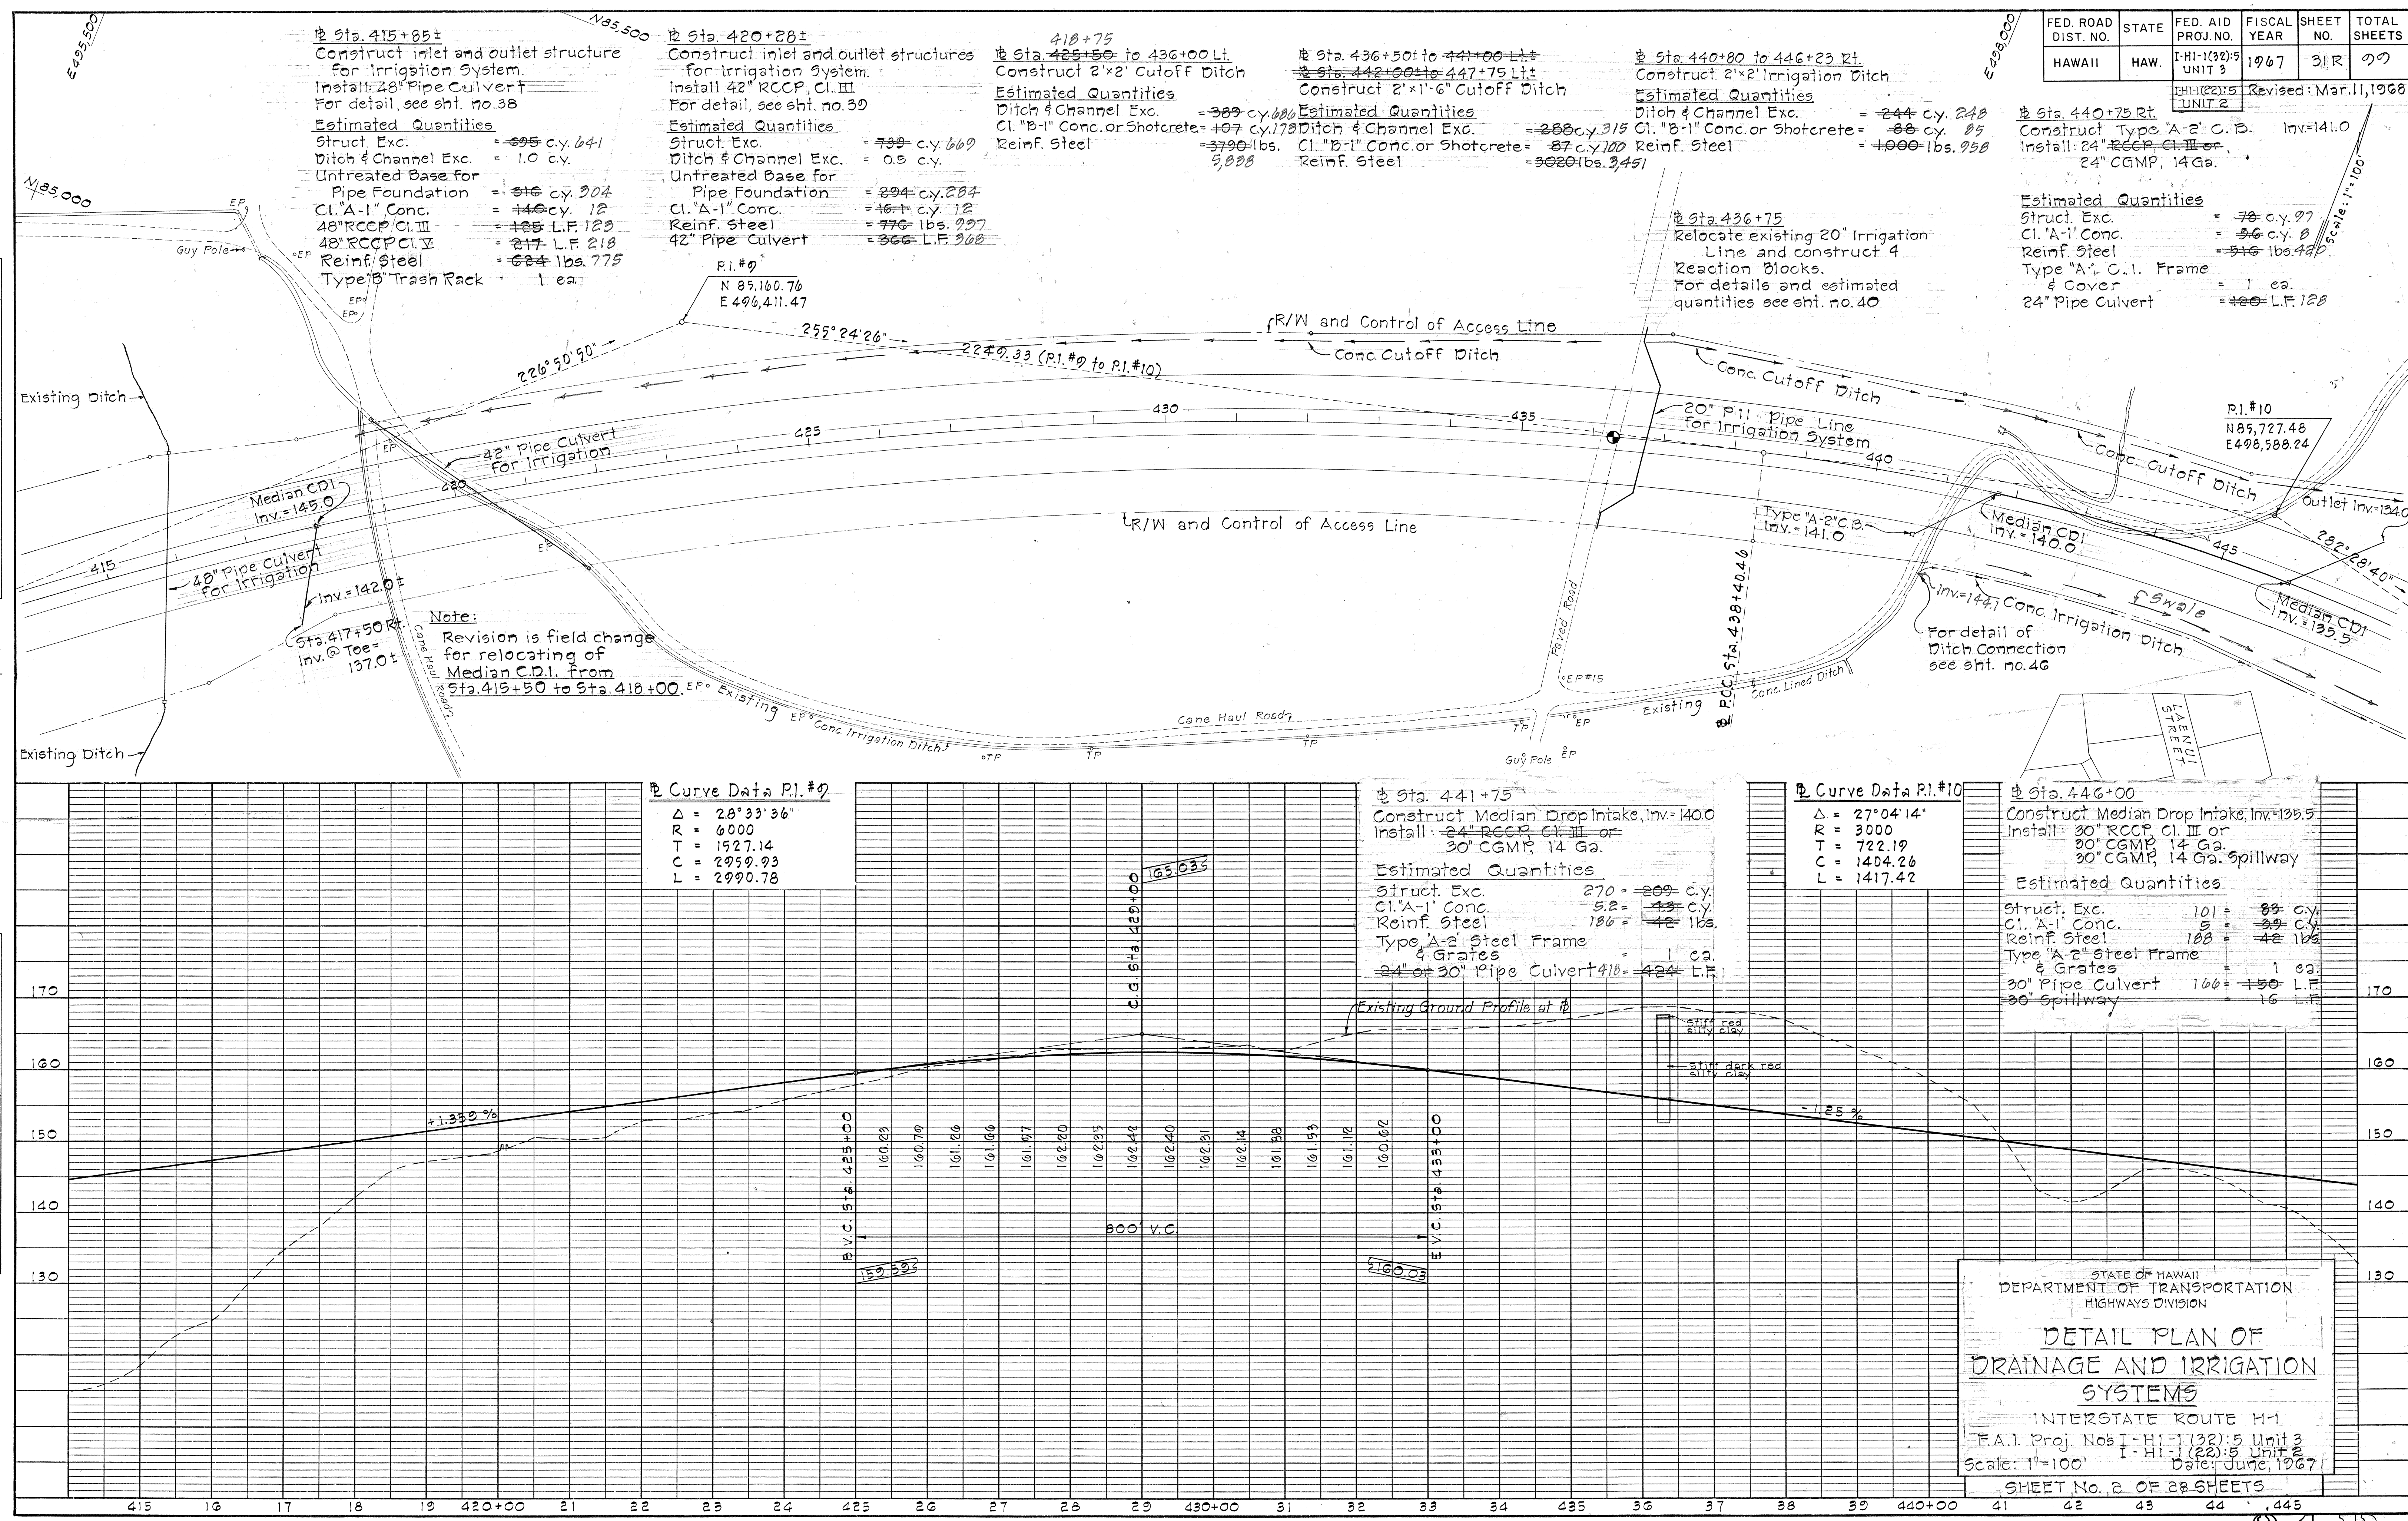

FED. ROAD DIST. NO.	STATE	FED. AID PROJ. NO.	FISCAL YEAR	SHEET NO.	TOTAL SHEETS
HAWAII	HAW.	I-HI-1(32):5 UNIT 3	1967	31 R	97

Revised: Mar. 11, 1968

STATE OF HAWAII
DEPARTMENT OF TRANSPORTATION
HIGHWAYS DIVISION

DETAIL PLAN OF
DRAINAGE AND IRRIGATION
SYSTEMS

INTERSTATE ROUTE H-1
F.A.I. Proj. Nos. I-HI-1(32):5 Unit 3
I-HI-1(22):5 Unit 3
Scale: 1"=100'
Date: June, 1967


SHEET NO. 2 OF 28 SHEETS

STATE OF HAWAII
DEPARTMENT OF TRANSPORTATION
HIGHWAYS DIVISION




DETAIL PLAN OF
DRAINAGE AND IRRIGATION
SYSTEMS

INTERSTATE ROUTE H-1
F.A.I. Proj. Nos I-H1-(32):5 Unit 3
I-H1-(22):5 Unit 2
Scale: 1" = 100' Date: June, 1967



SHEET No. 3 OF 28 SHEETS

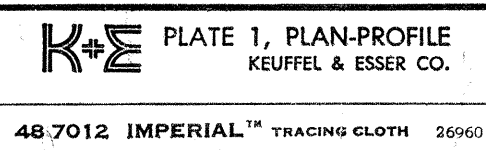



FED. ROAD DIST. NO.	STATE	FED. AID PROJ. NO.	FISCAL YEAR	SHEET NO.	TOTAL SHEETS
HAWAII	HAW.	I-HI-1(22)5 Unit 2	1967	34R	97

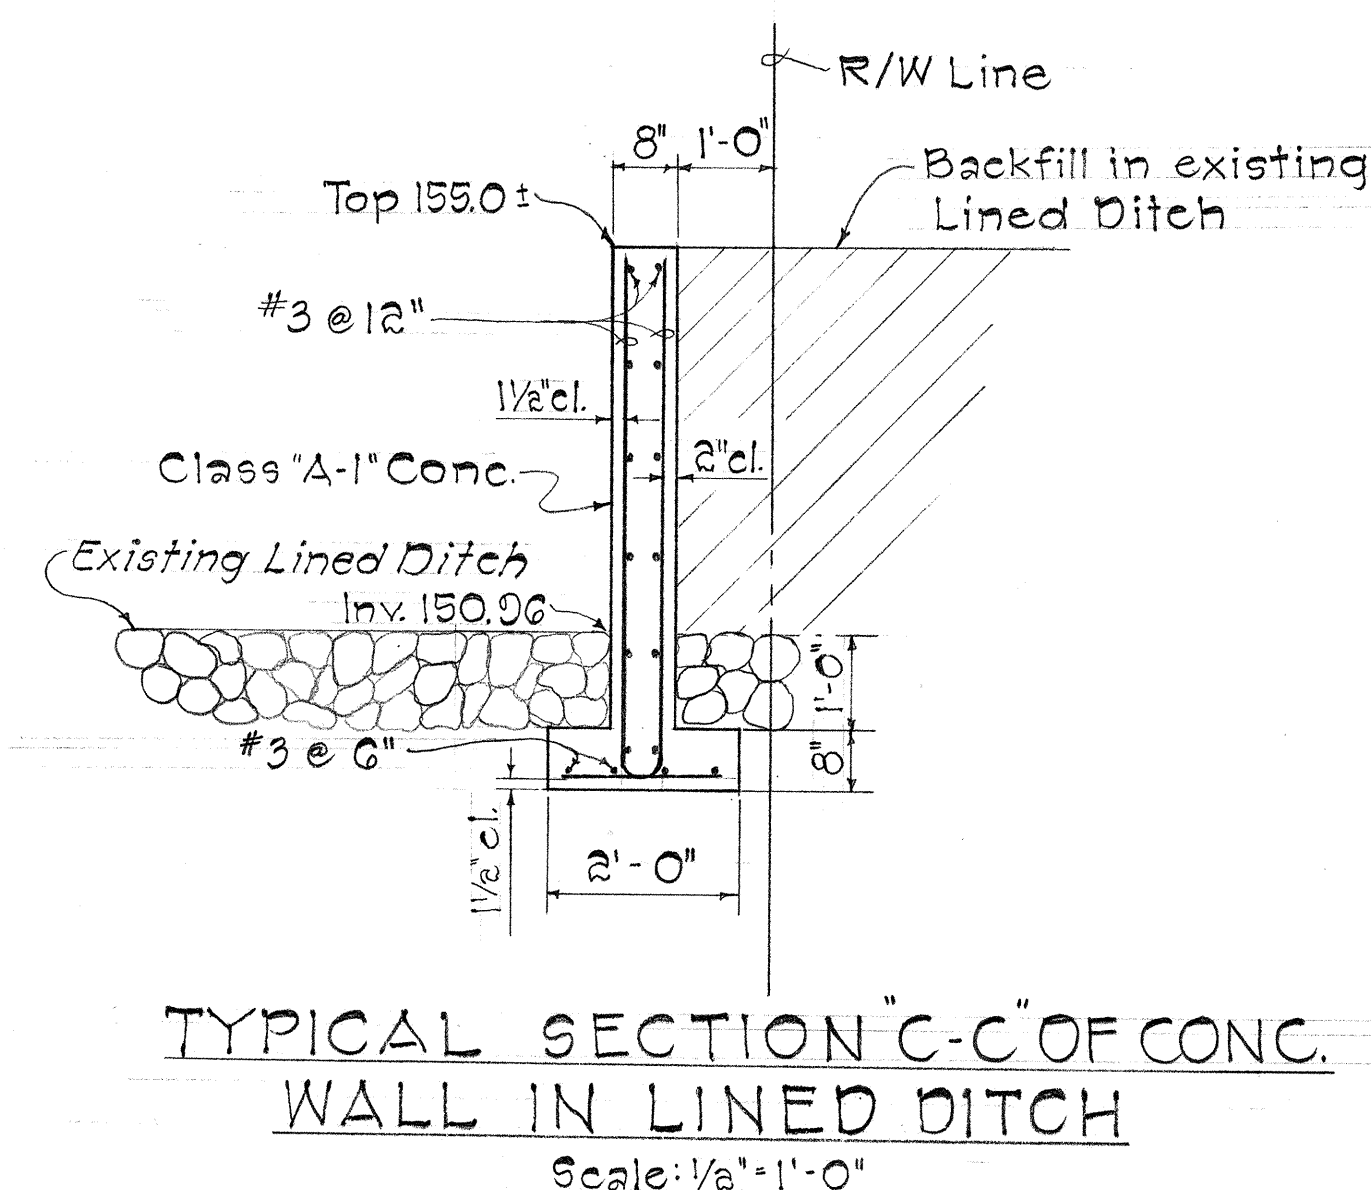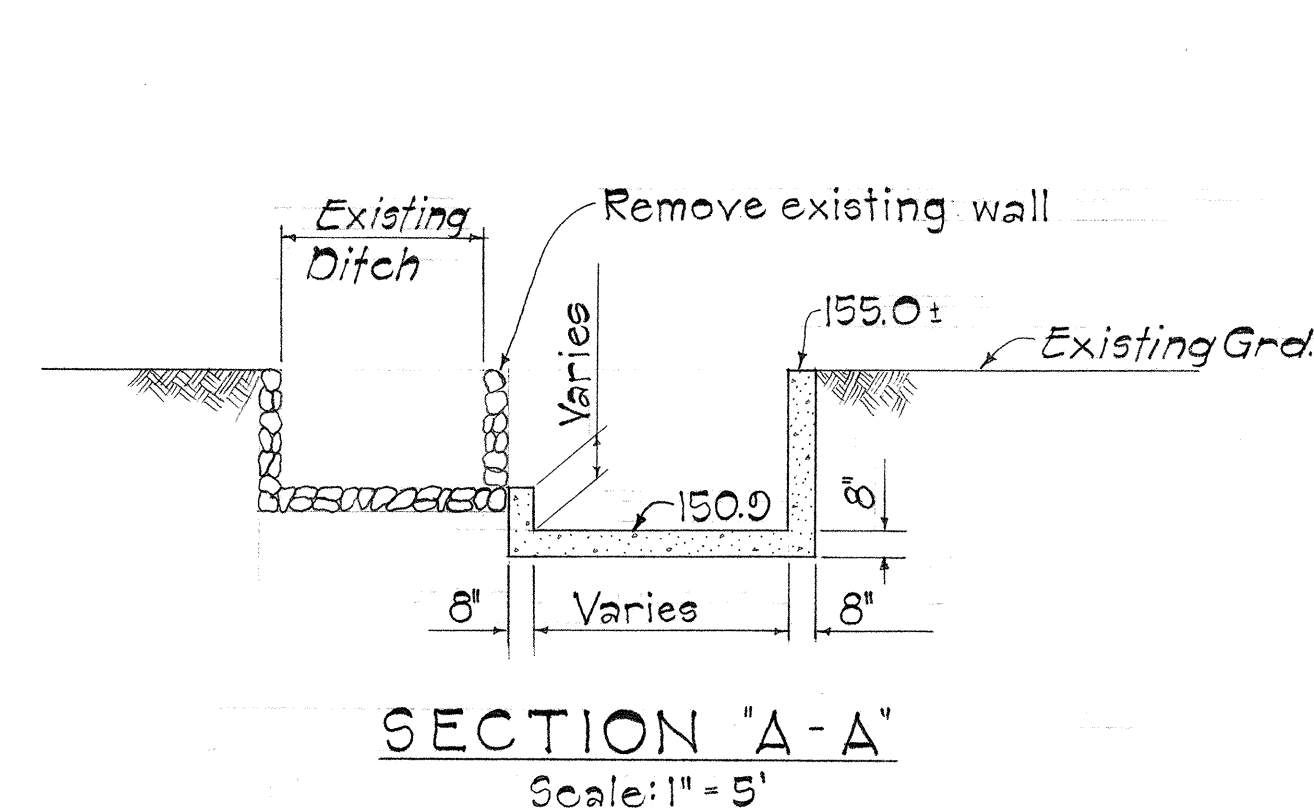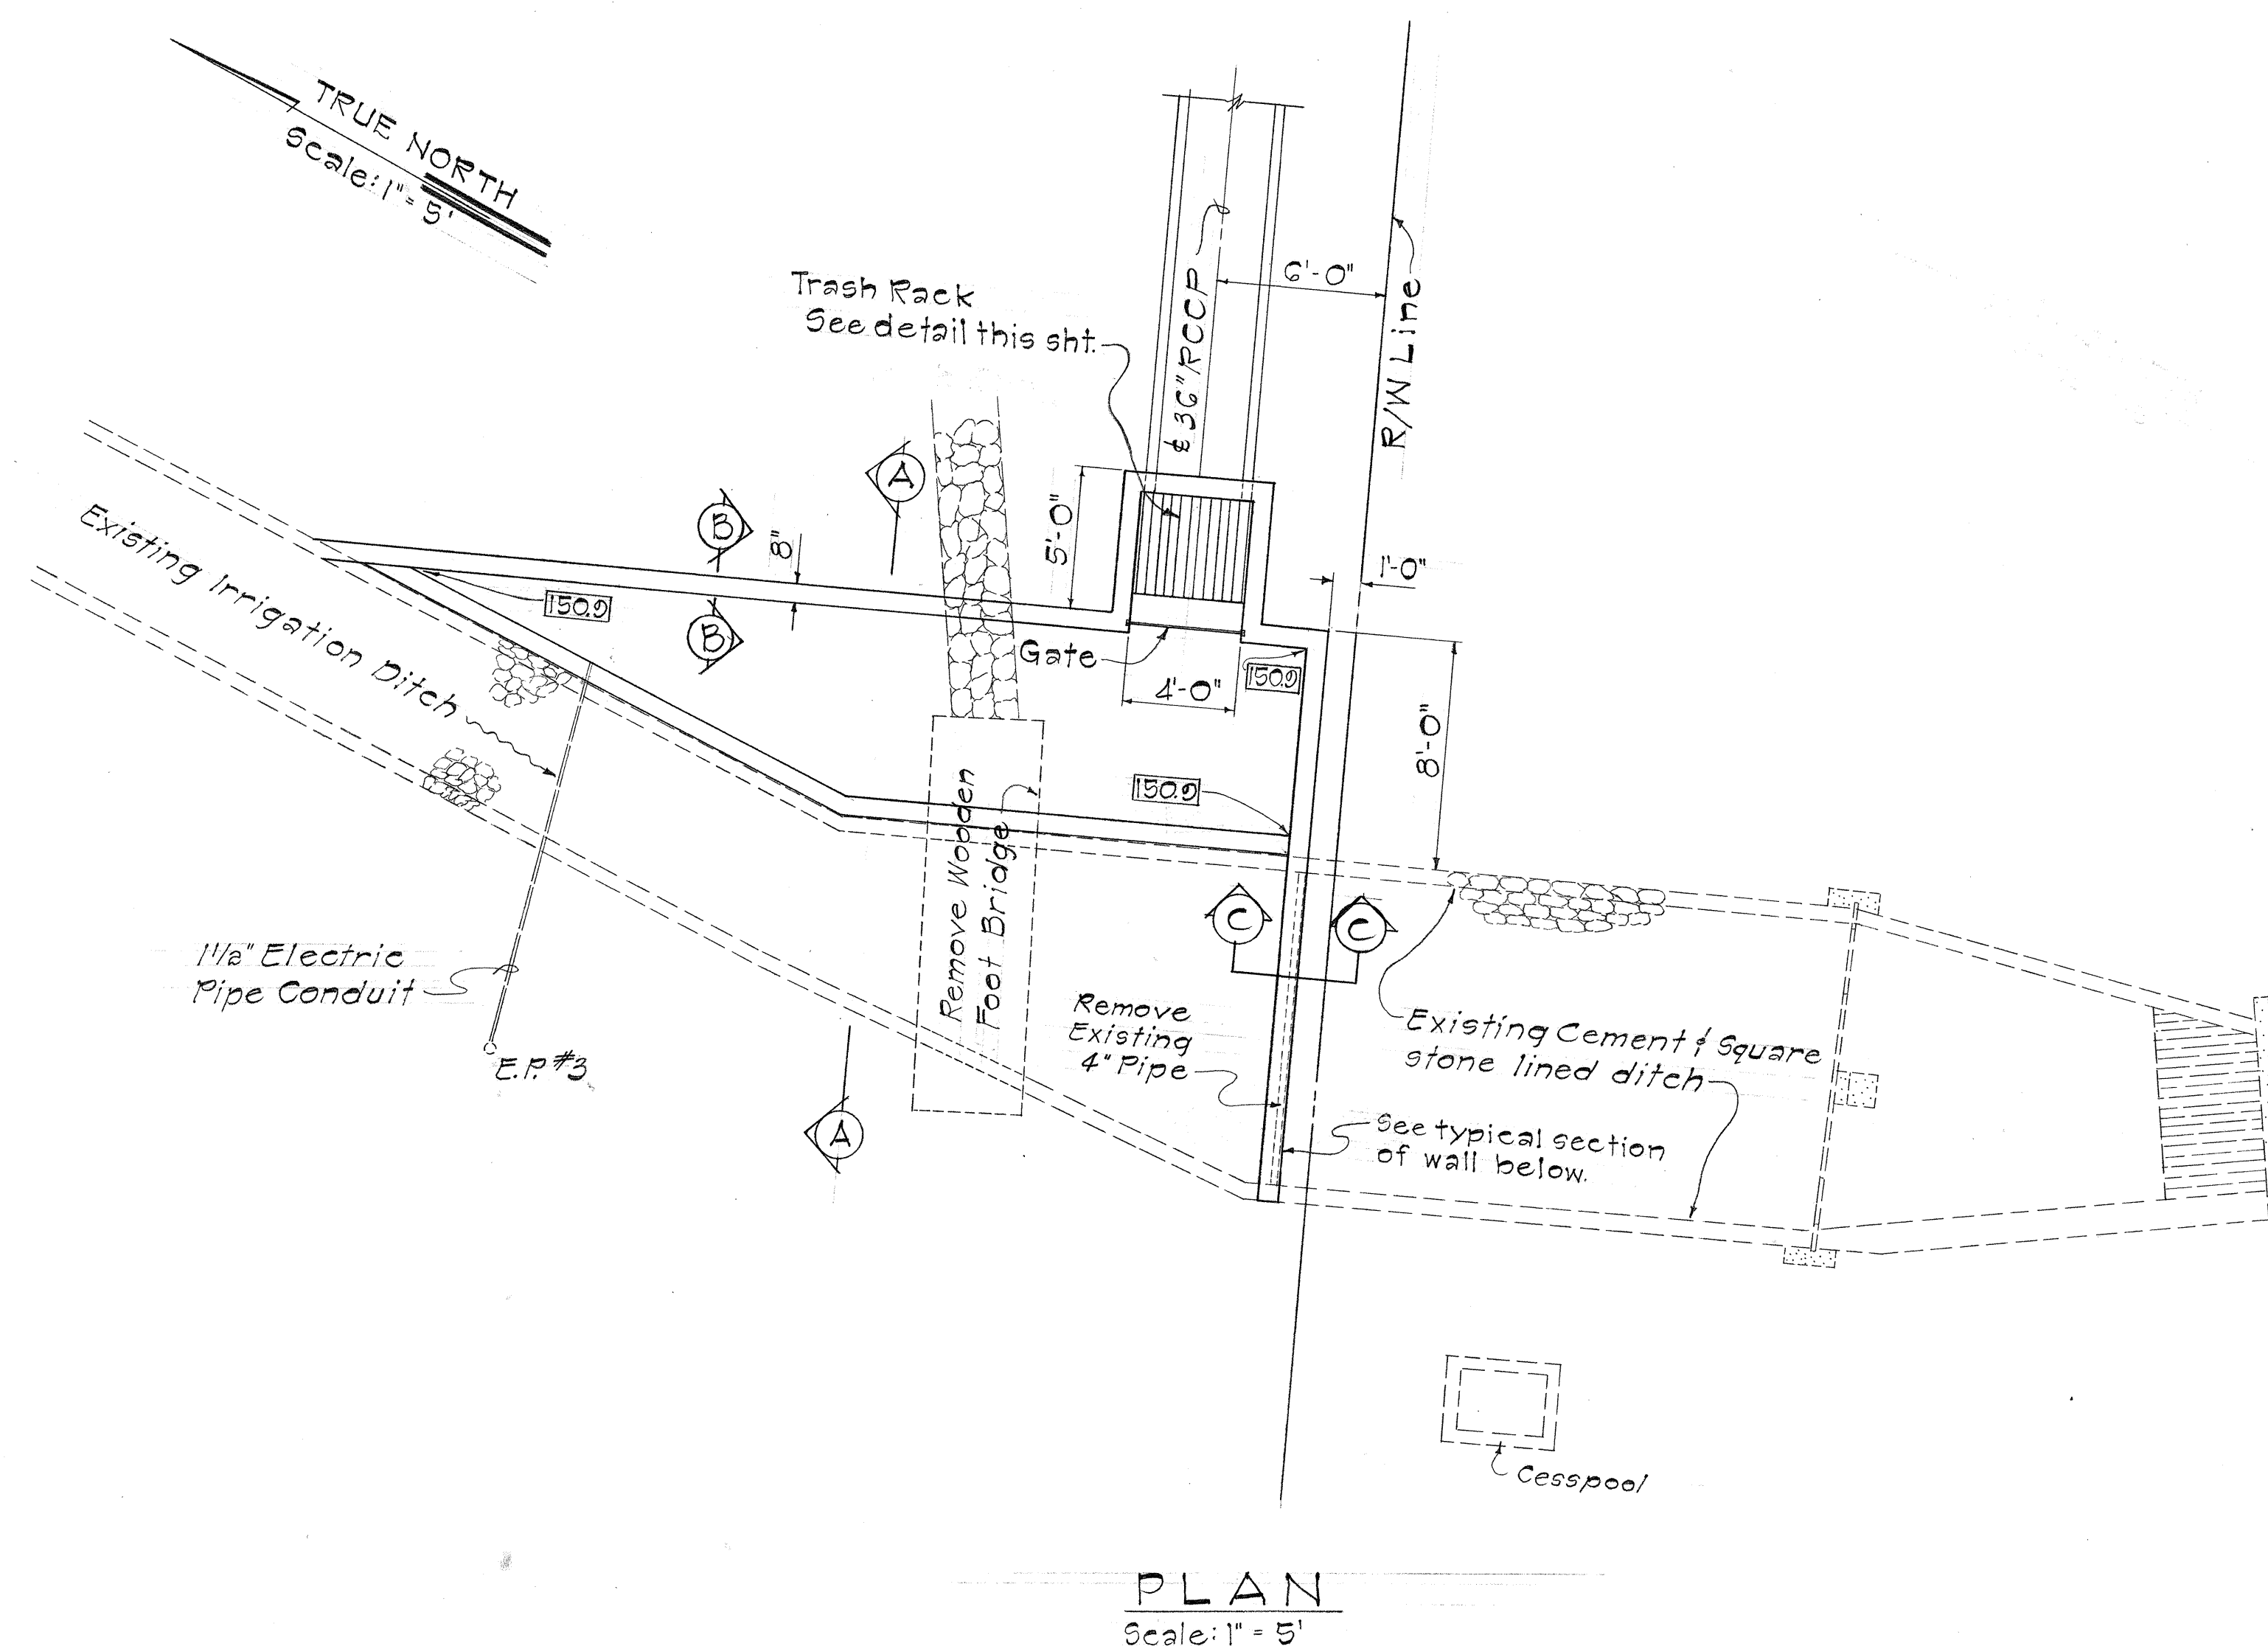

DETAILS OF STILLING BASIN AT STA. 386+65 ± LT.

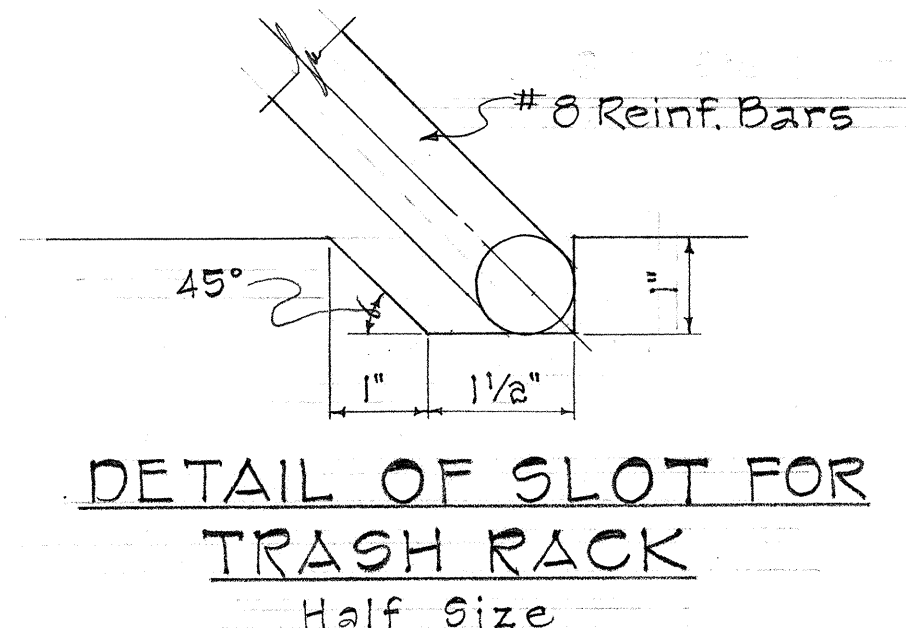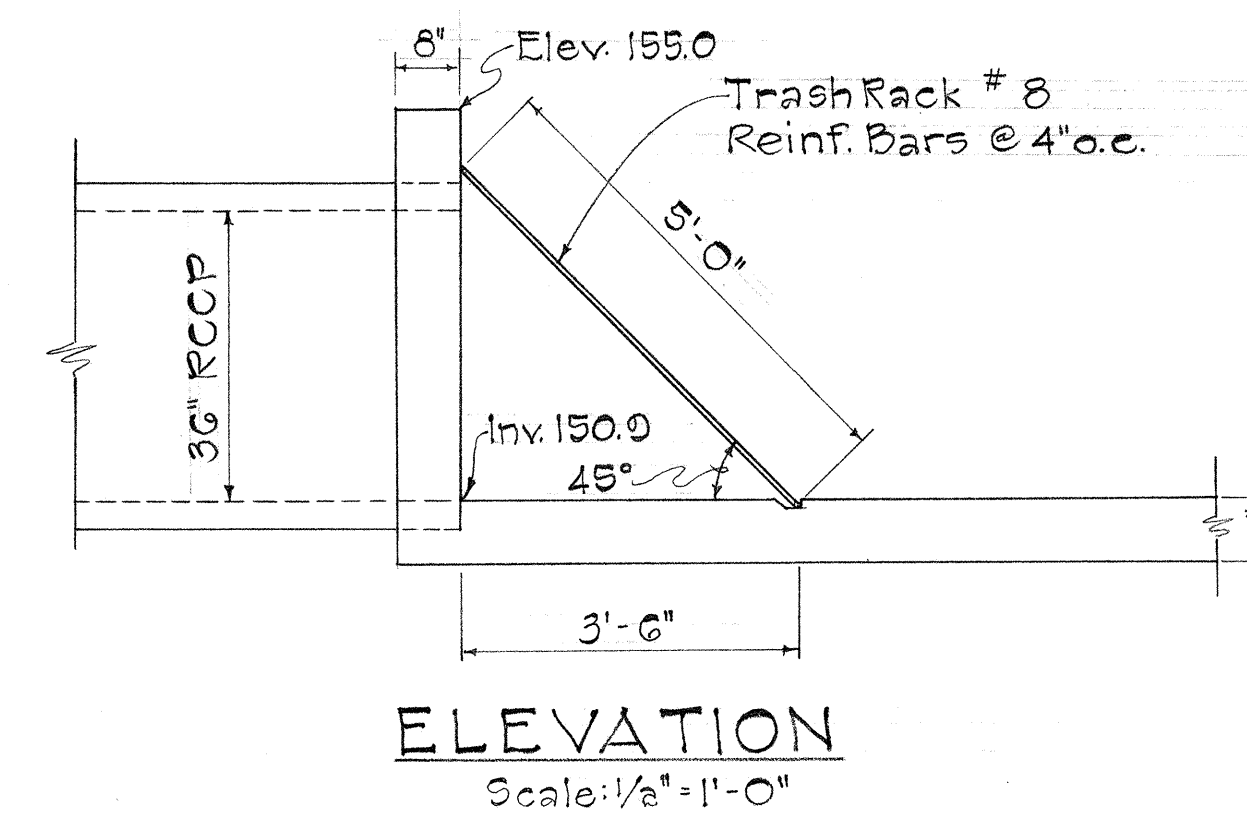


DETAIL OF TYPE "A" TRASH RACK Scale: As Shown

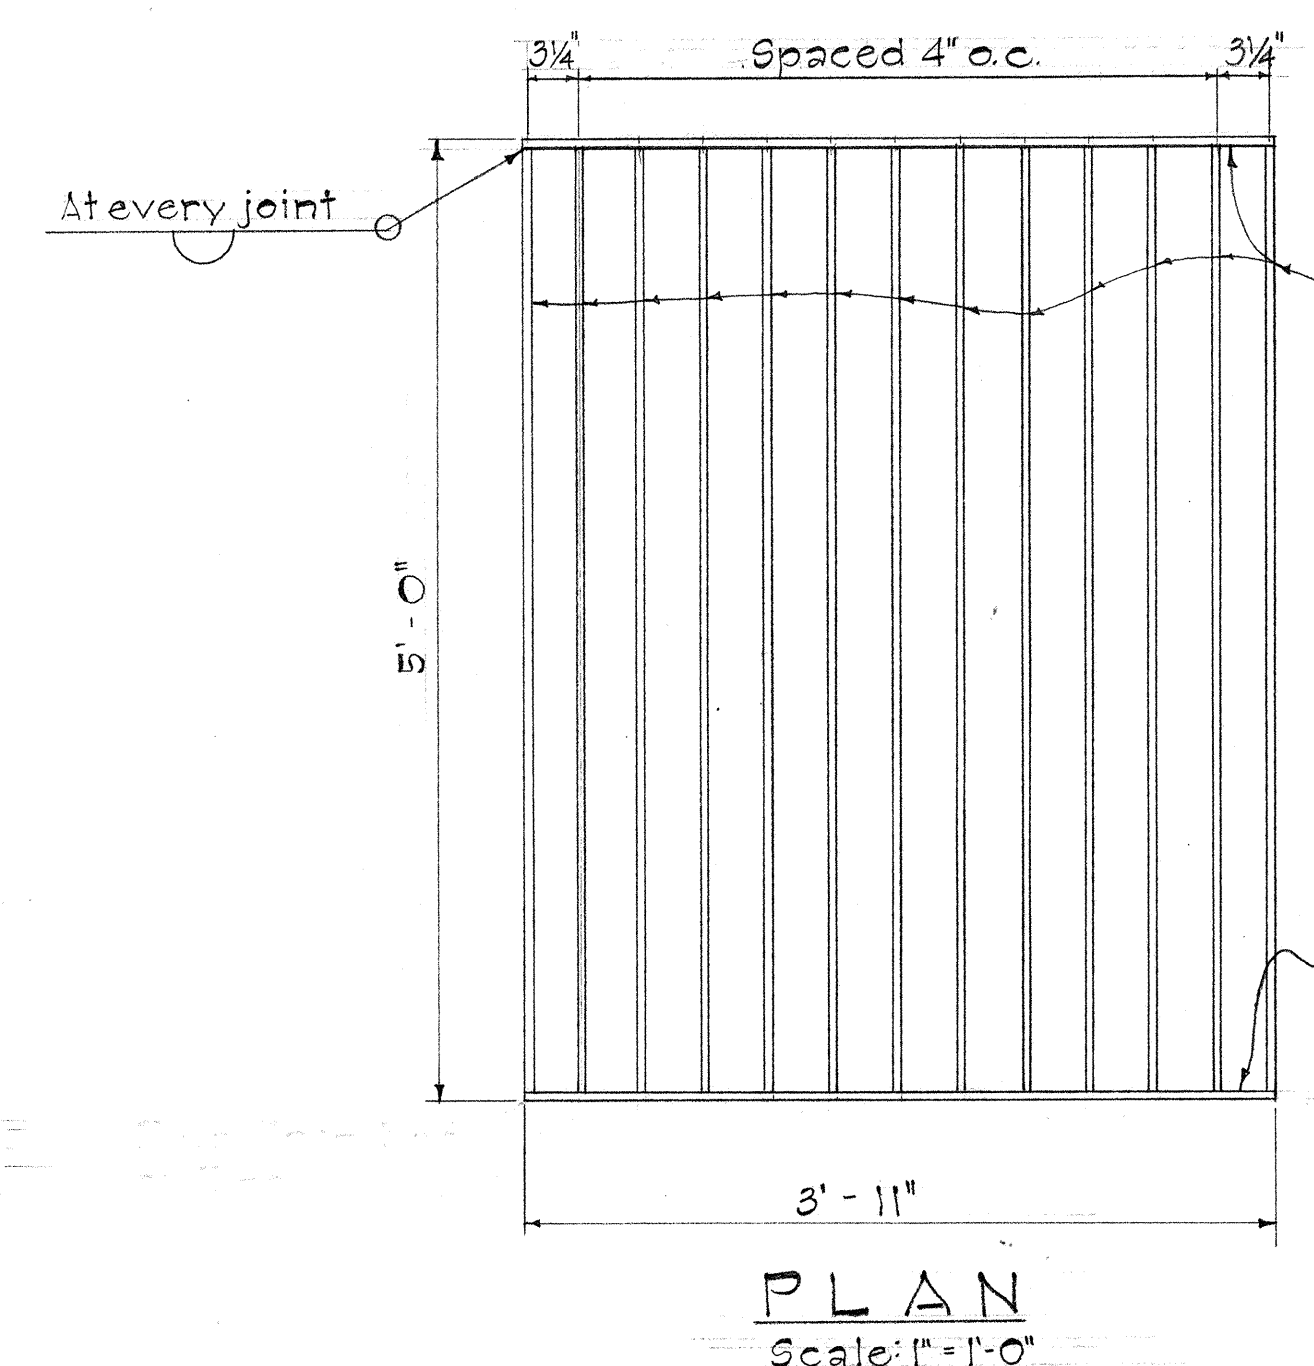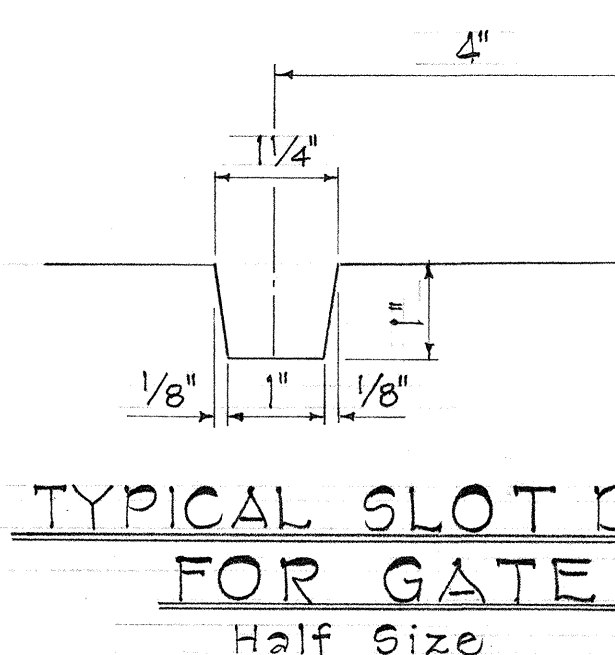


NOTE:
Redwood gate shall be constructed with 545 lumber and galvanized nails, and shall be considered as incidental to Class "B-1" Concrete.

Sta	H	W
386+65±	4'-0"	4'-1 1/2"
450+00	2'-0"	5'-1 1/2"
466+30	2'-0"	3'-1 1/2"

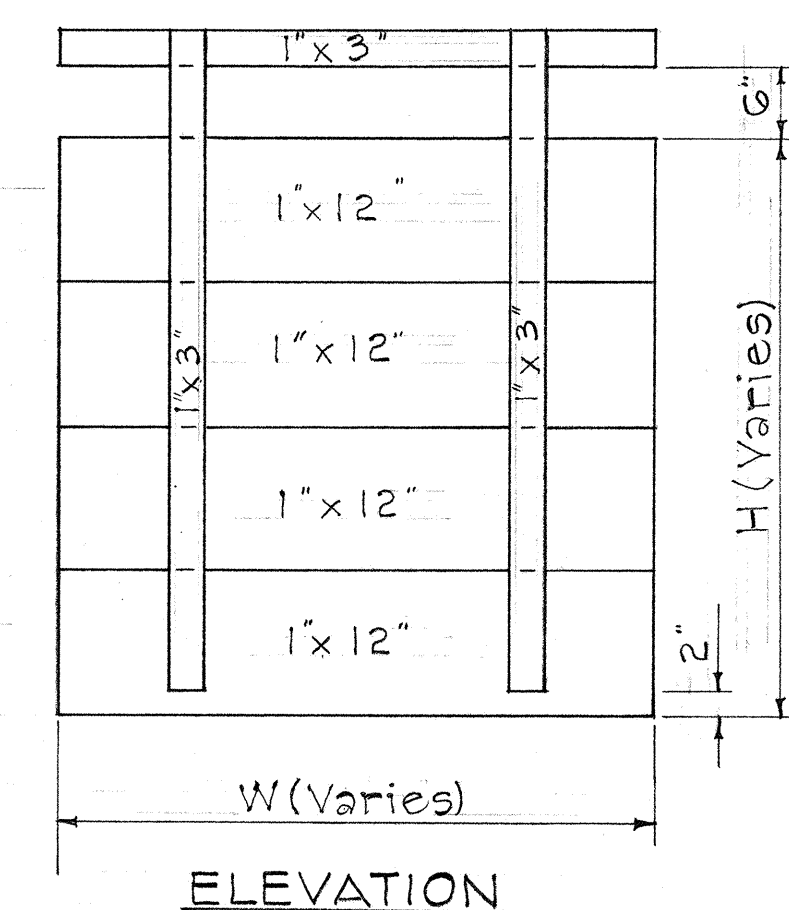

TYPICAL DETAIL OF WOODEN GATE Scale: 3/4" = 1'-0"

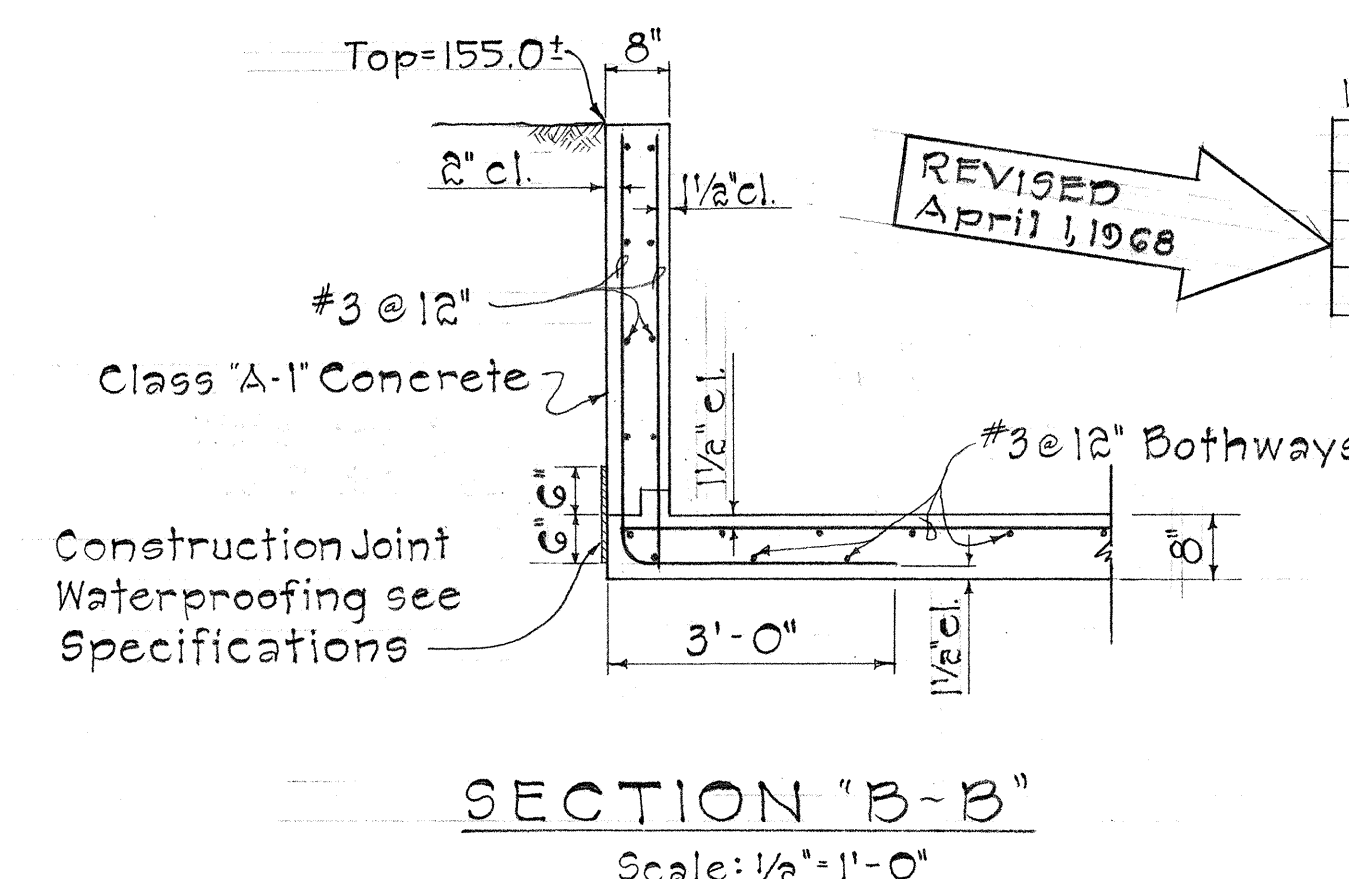


STATE OF HAWAII
DEPARTMENT OF TRANSPORTATION
HIGHWAYS DIVISION
IRRIGATION DETAILS
RELOCATION OF P3 DITCH
MODIFICATION OF EXISTING STILLING
BASIN @ STA. 386+65 ± LT.
INTERSTATE ROUTE H-1
F.A.I. PROJ. NO. I-HI-1(22)5, Unit 2
Scale: As Shown Date: June, 1967
SHEET No. 5 OF 28 SHEETS

April 1, 1968


341R

SURVEY PLOTTED BY	DATE
DESIGNED BY	
TRACED BY	
NOTED BY	
CHECKED BY	
ORIGINAL PLAN	
NOTE BOOK	
No.	


FED. ROAD DIST. NO.	STATE	FED. AID PROJ. NO.	FISCAL YEAR	SHEET NO.	TOTAL SHEETS
HAWAII	HAW.	I-HI-1(22):5 Unit 2	1967	35	77

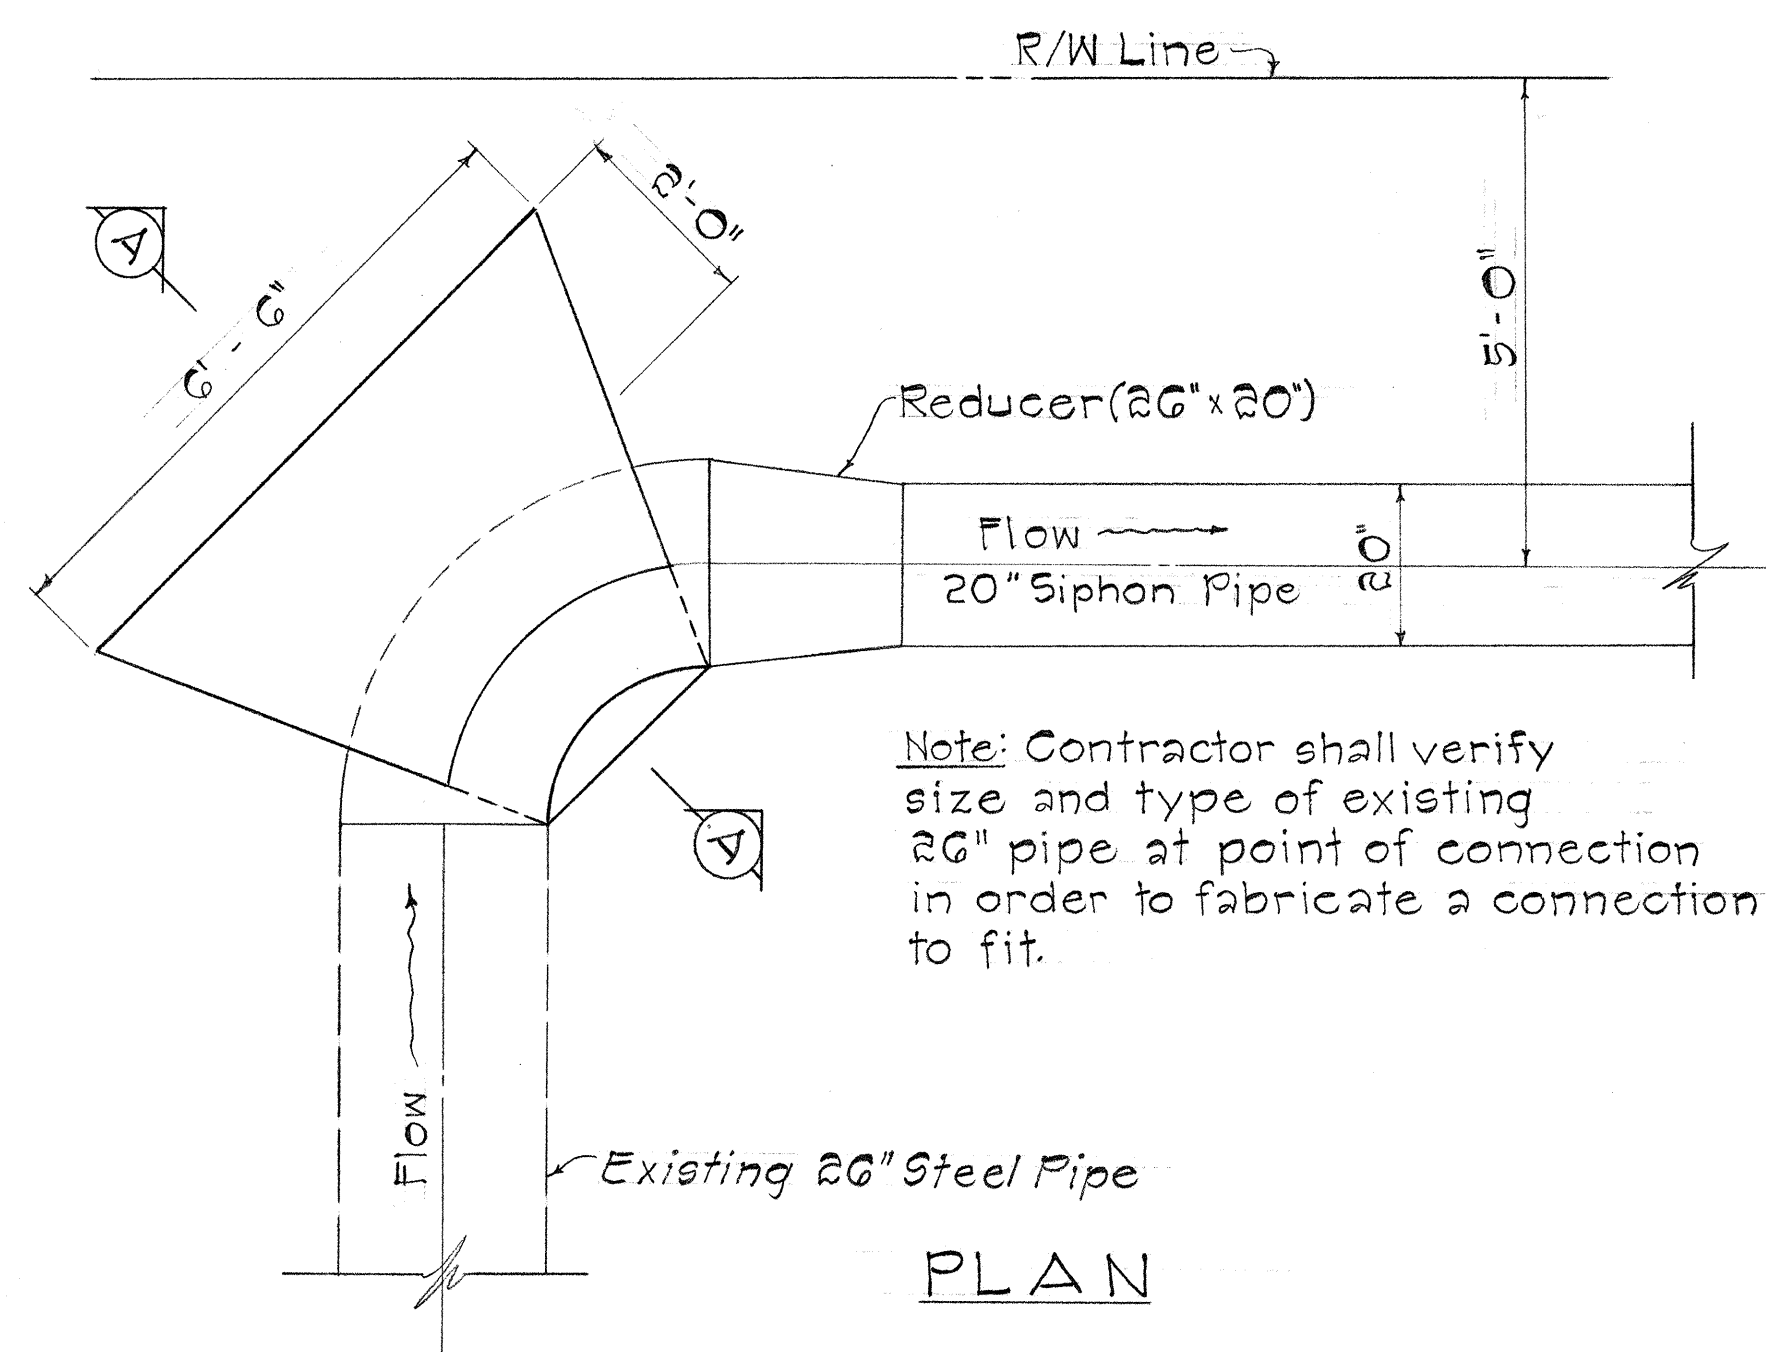


REACTION BLOCK @ STA. 388+63.1 RT.

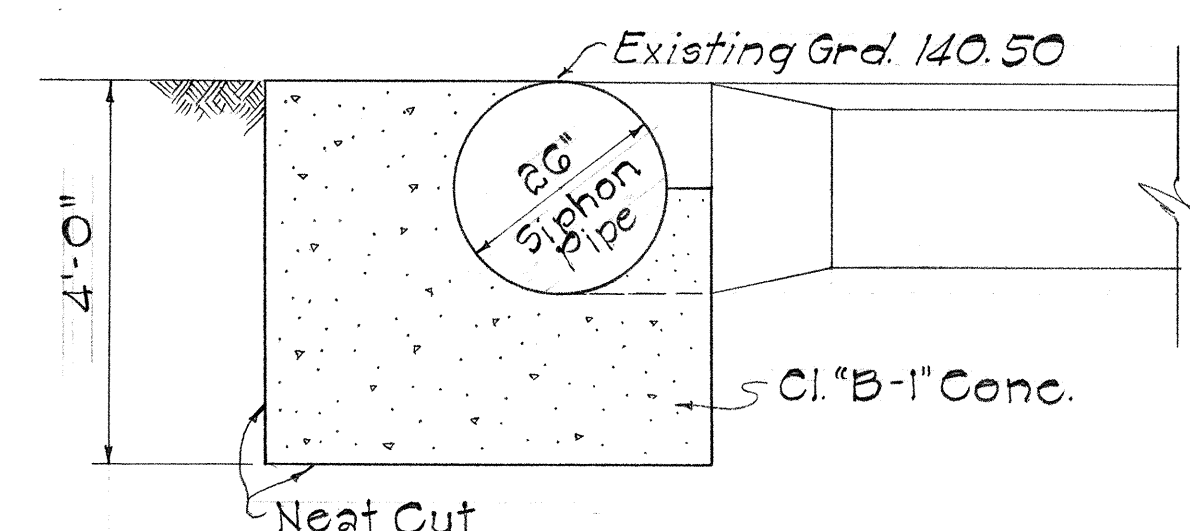

SECTION "A-A"

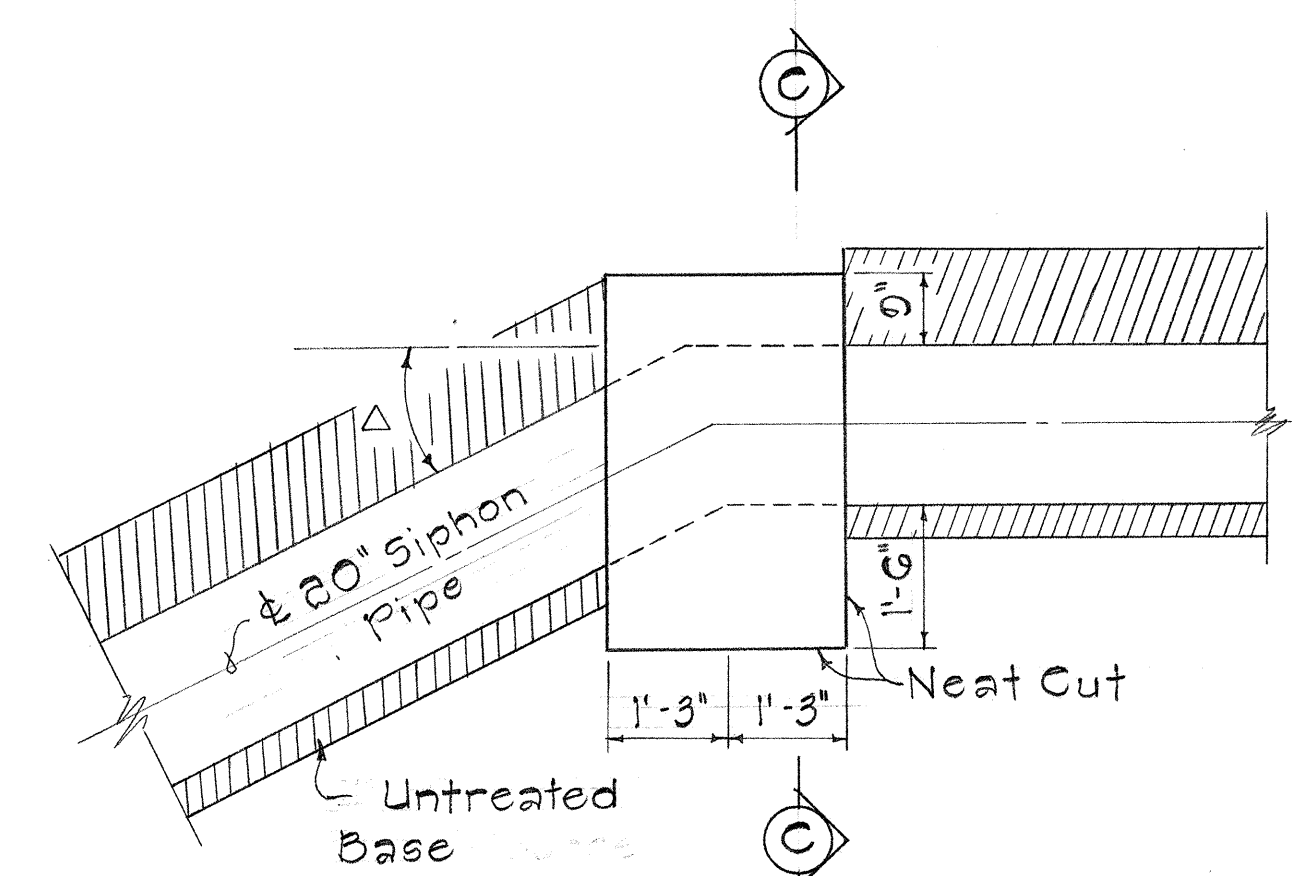


ELEVATION

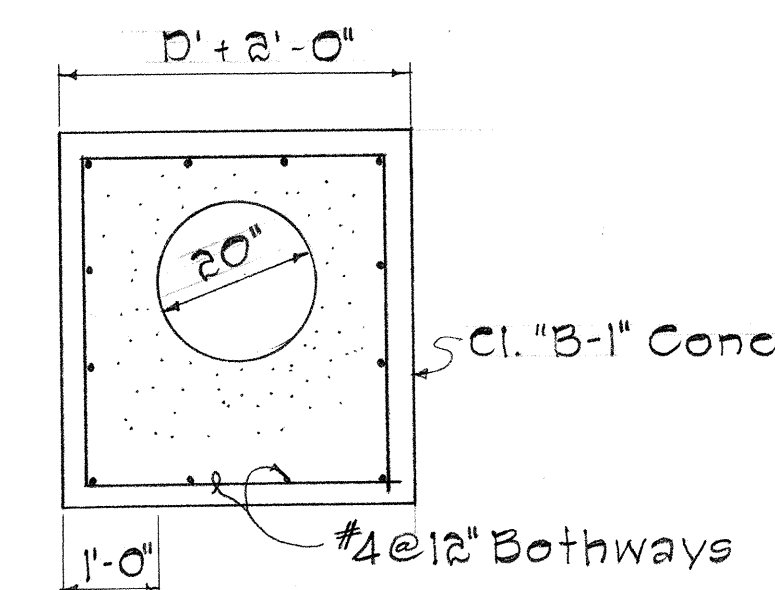


SECTION "C-C"

TYPICAL DETAIL OF REACTION BLOCK AT VERTICAL CROWN BEND FOR 20" PIPE


Scale: 1/8" = 1'-0"

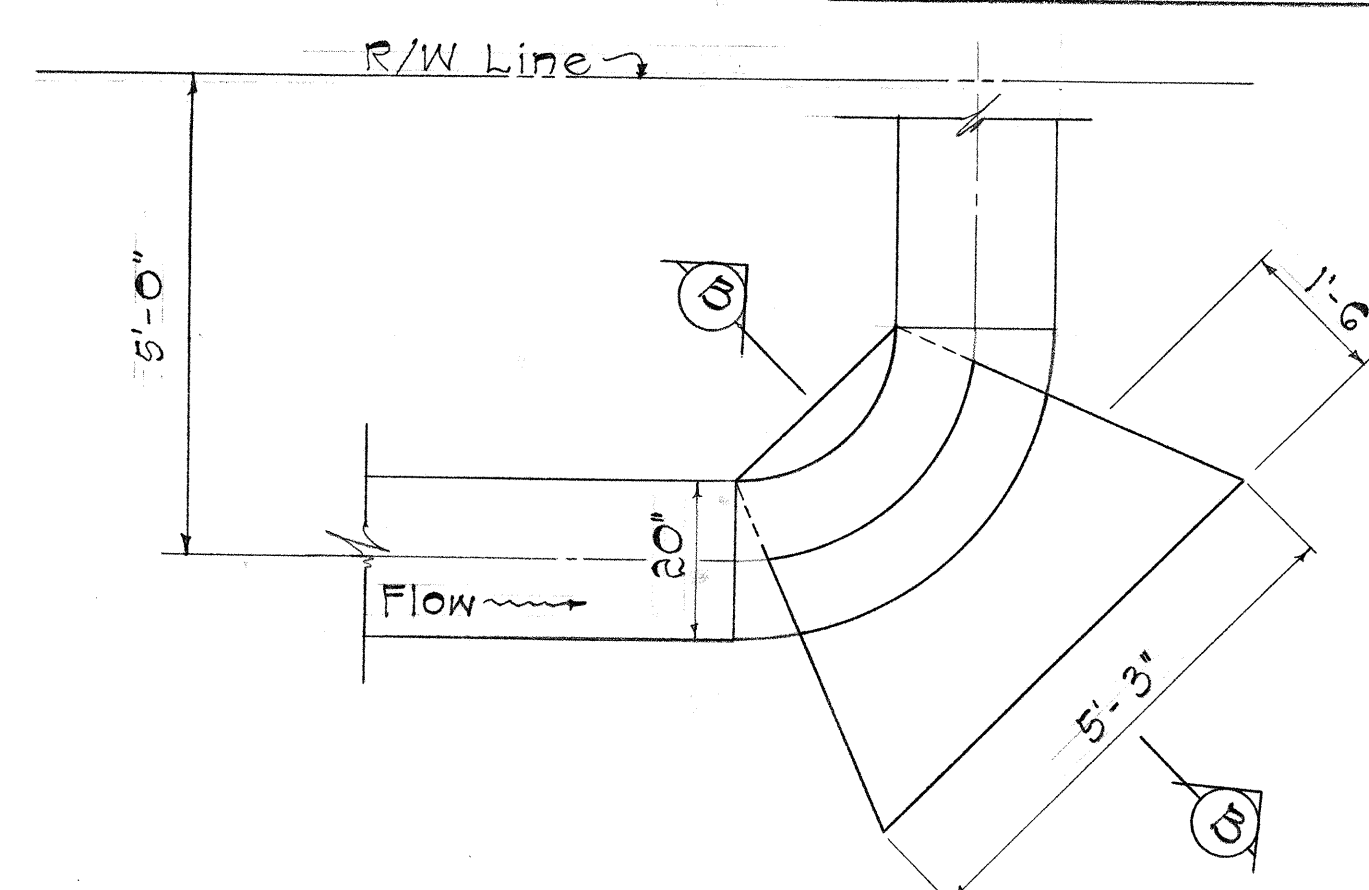


REACTION BLOCK @ STA. 389+00 RT.

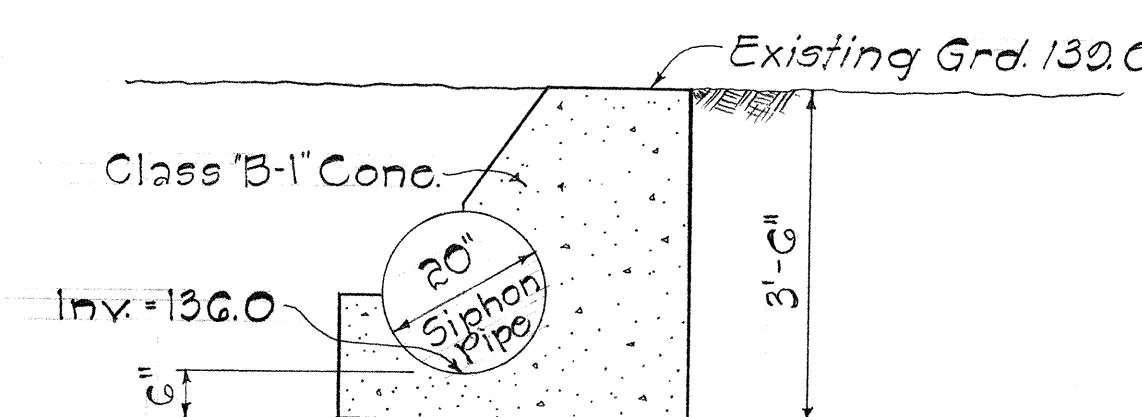

SECTION "B-B"

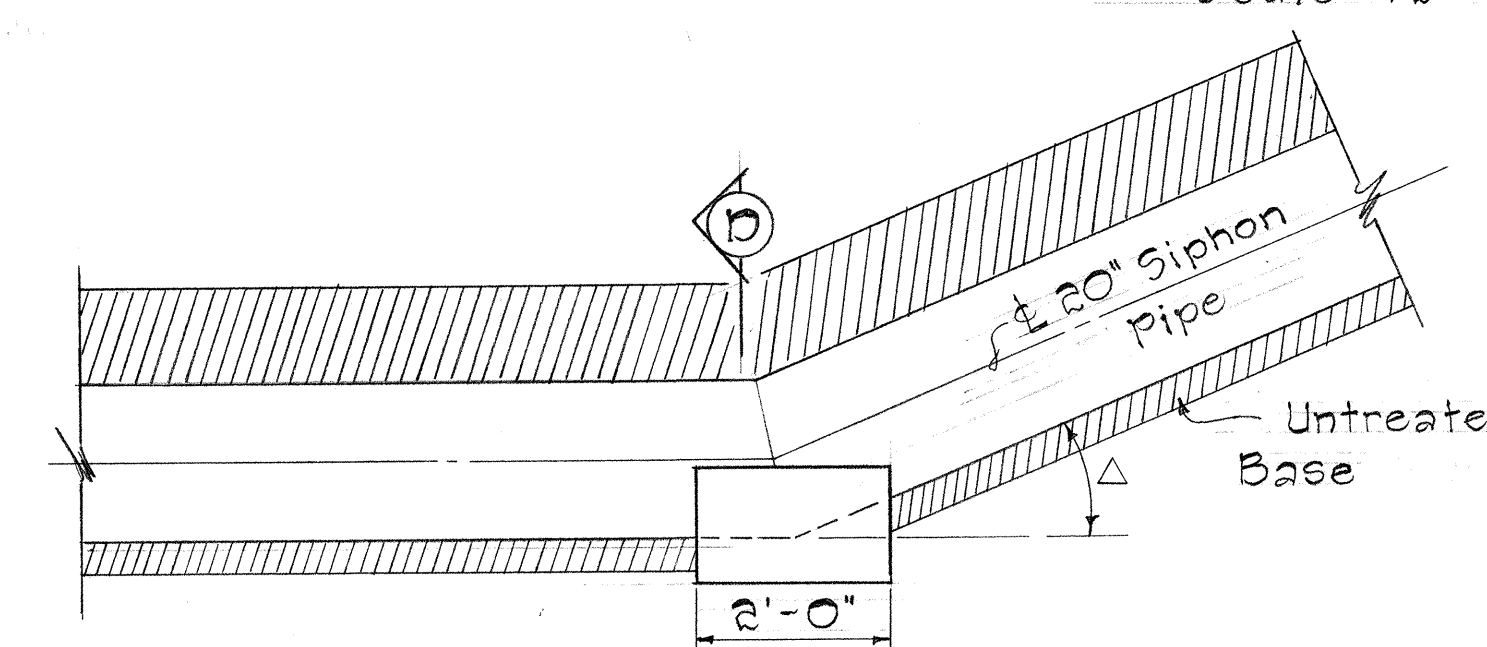

ELEVATION

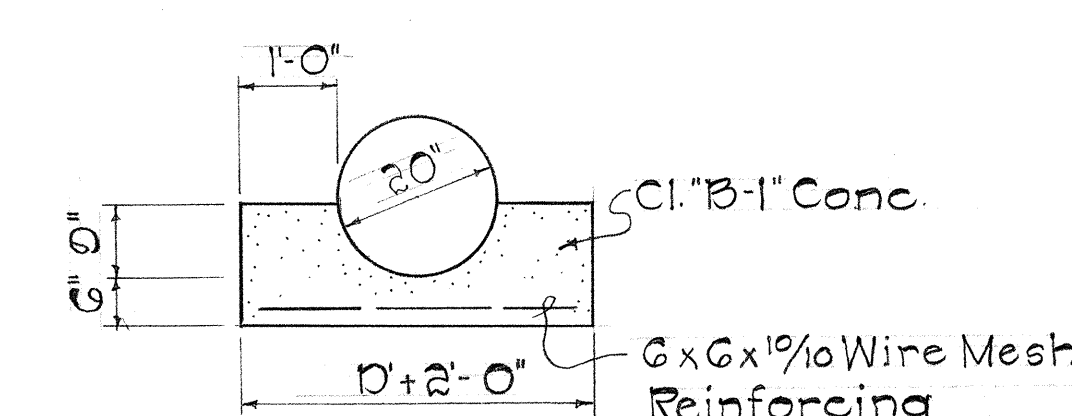


SECTION "D-D"

TYPICAL DETAIL OF REACTION BLOCK AT VERTICAL SAG BEND FOR 20" PIPE

Scale: 1/8" = 1'-0"

DETAIL OF UNTREATED BASE FOR PIPE FOUNDATION

Scale: 1/8" = 1'-0"

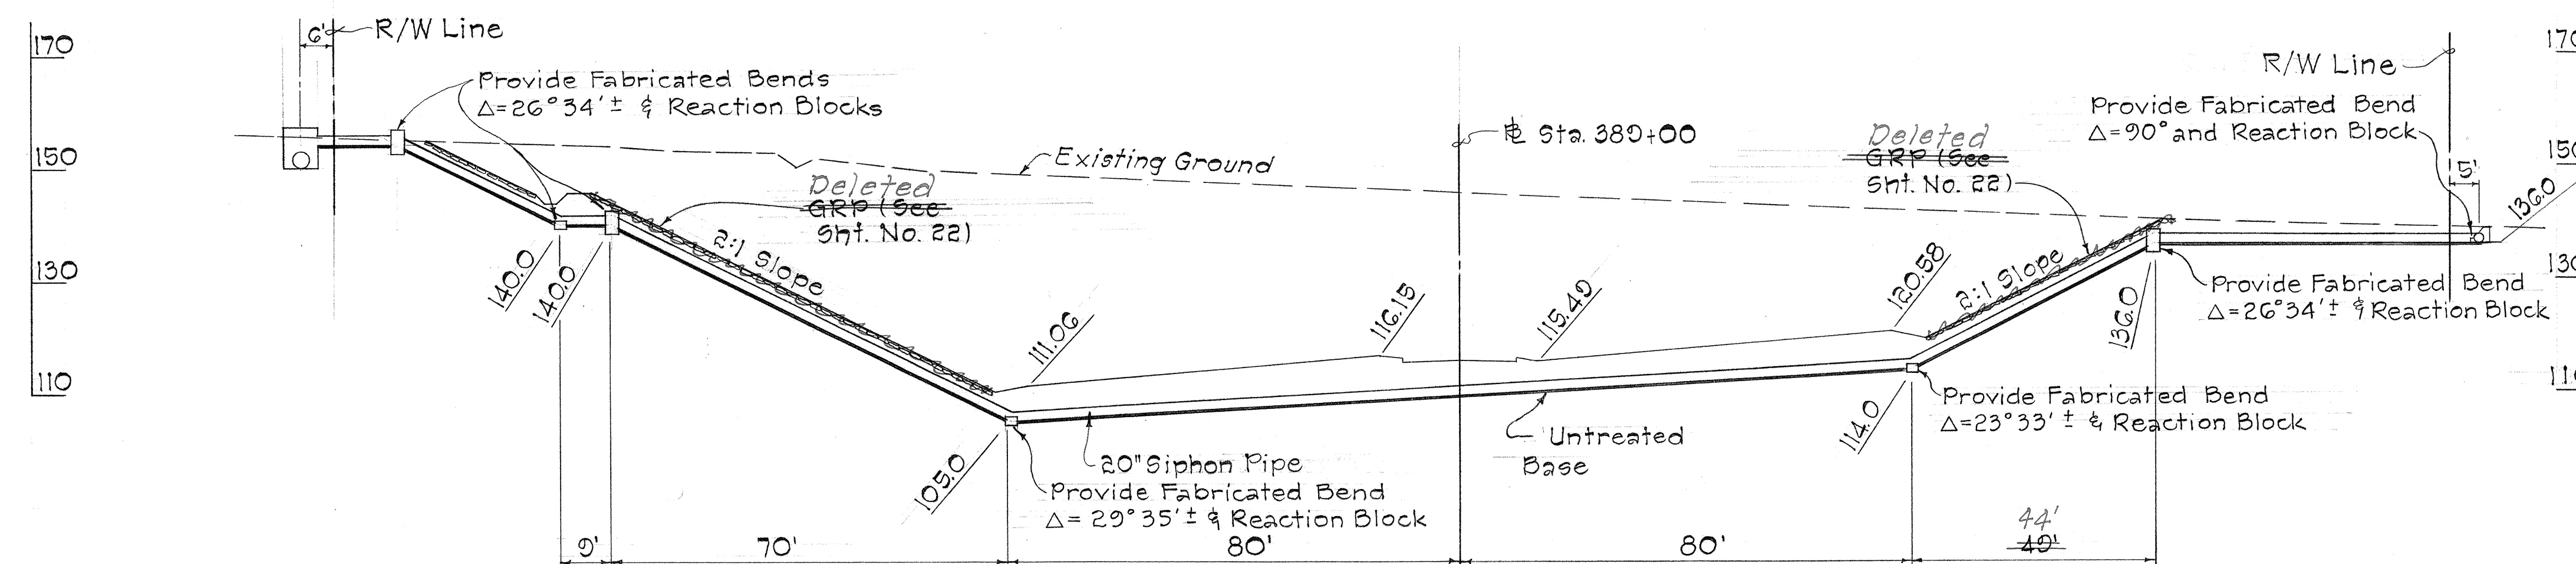

PROFILE ~ 20" P-8 PIPE LINE @ STA. 389+00

Scale: 1" = 20'




STATE OF HAWAII
DEPARTMENT OF TRANSPORTATION
HIGHWAYS DIVISION

IRRIGATION DETAILS
RELOCATION OF 20" P-8 PIPE LINE
AT STA. 389+00





INTERSTATE ROUTE H-1
F.A.I. PROJ. NO. I-HI-1(22):5, Unit 2
Scale: As Shown Date: June, 1967
SHEET No. 6 OF 28 SHEETS

SURVEY PLOTTED BY	DATE
DESIGNED BY	
NOTED BY	
CHECKED BY	
ORIGINAL PLAN	
NOTE BOOK	
REVISION	

FED. ROAD DIST. NO.	STATE	FED. AID PROJ. NO.	FISCAL YEAR	SHEET NO.	TOTAL SHEETS
HAWAII	HAW.	I-HI-1(22):5 Unit 2	1967	C.O.36	77

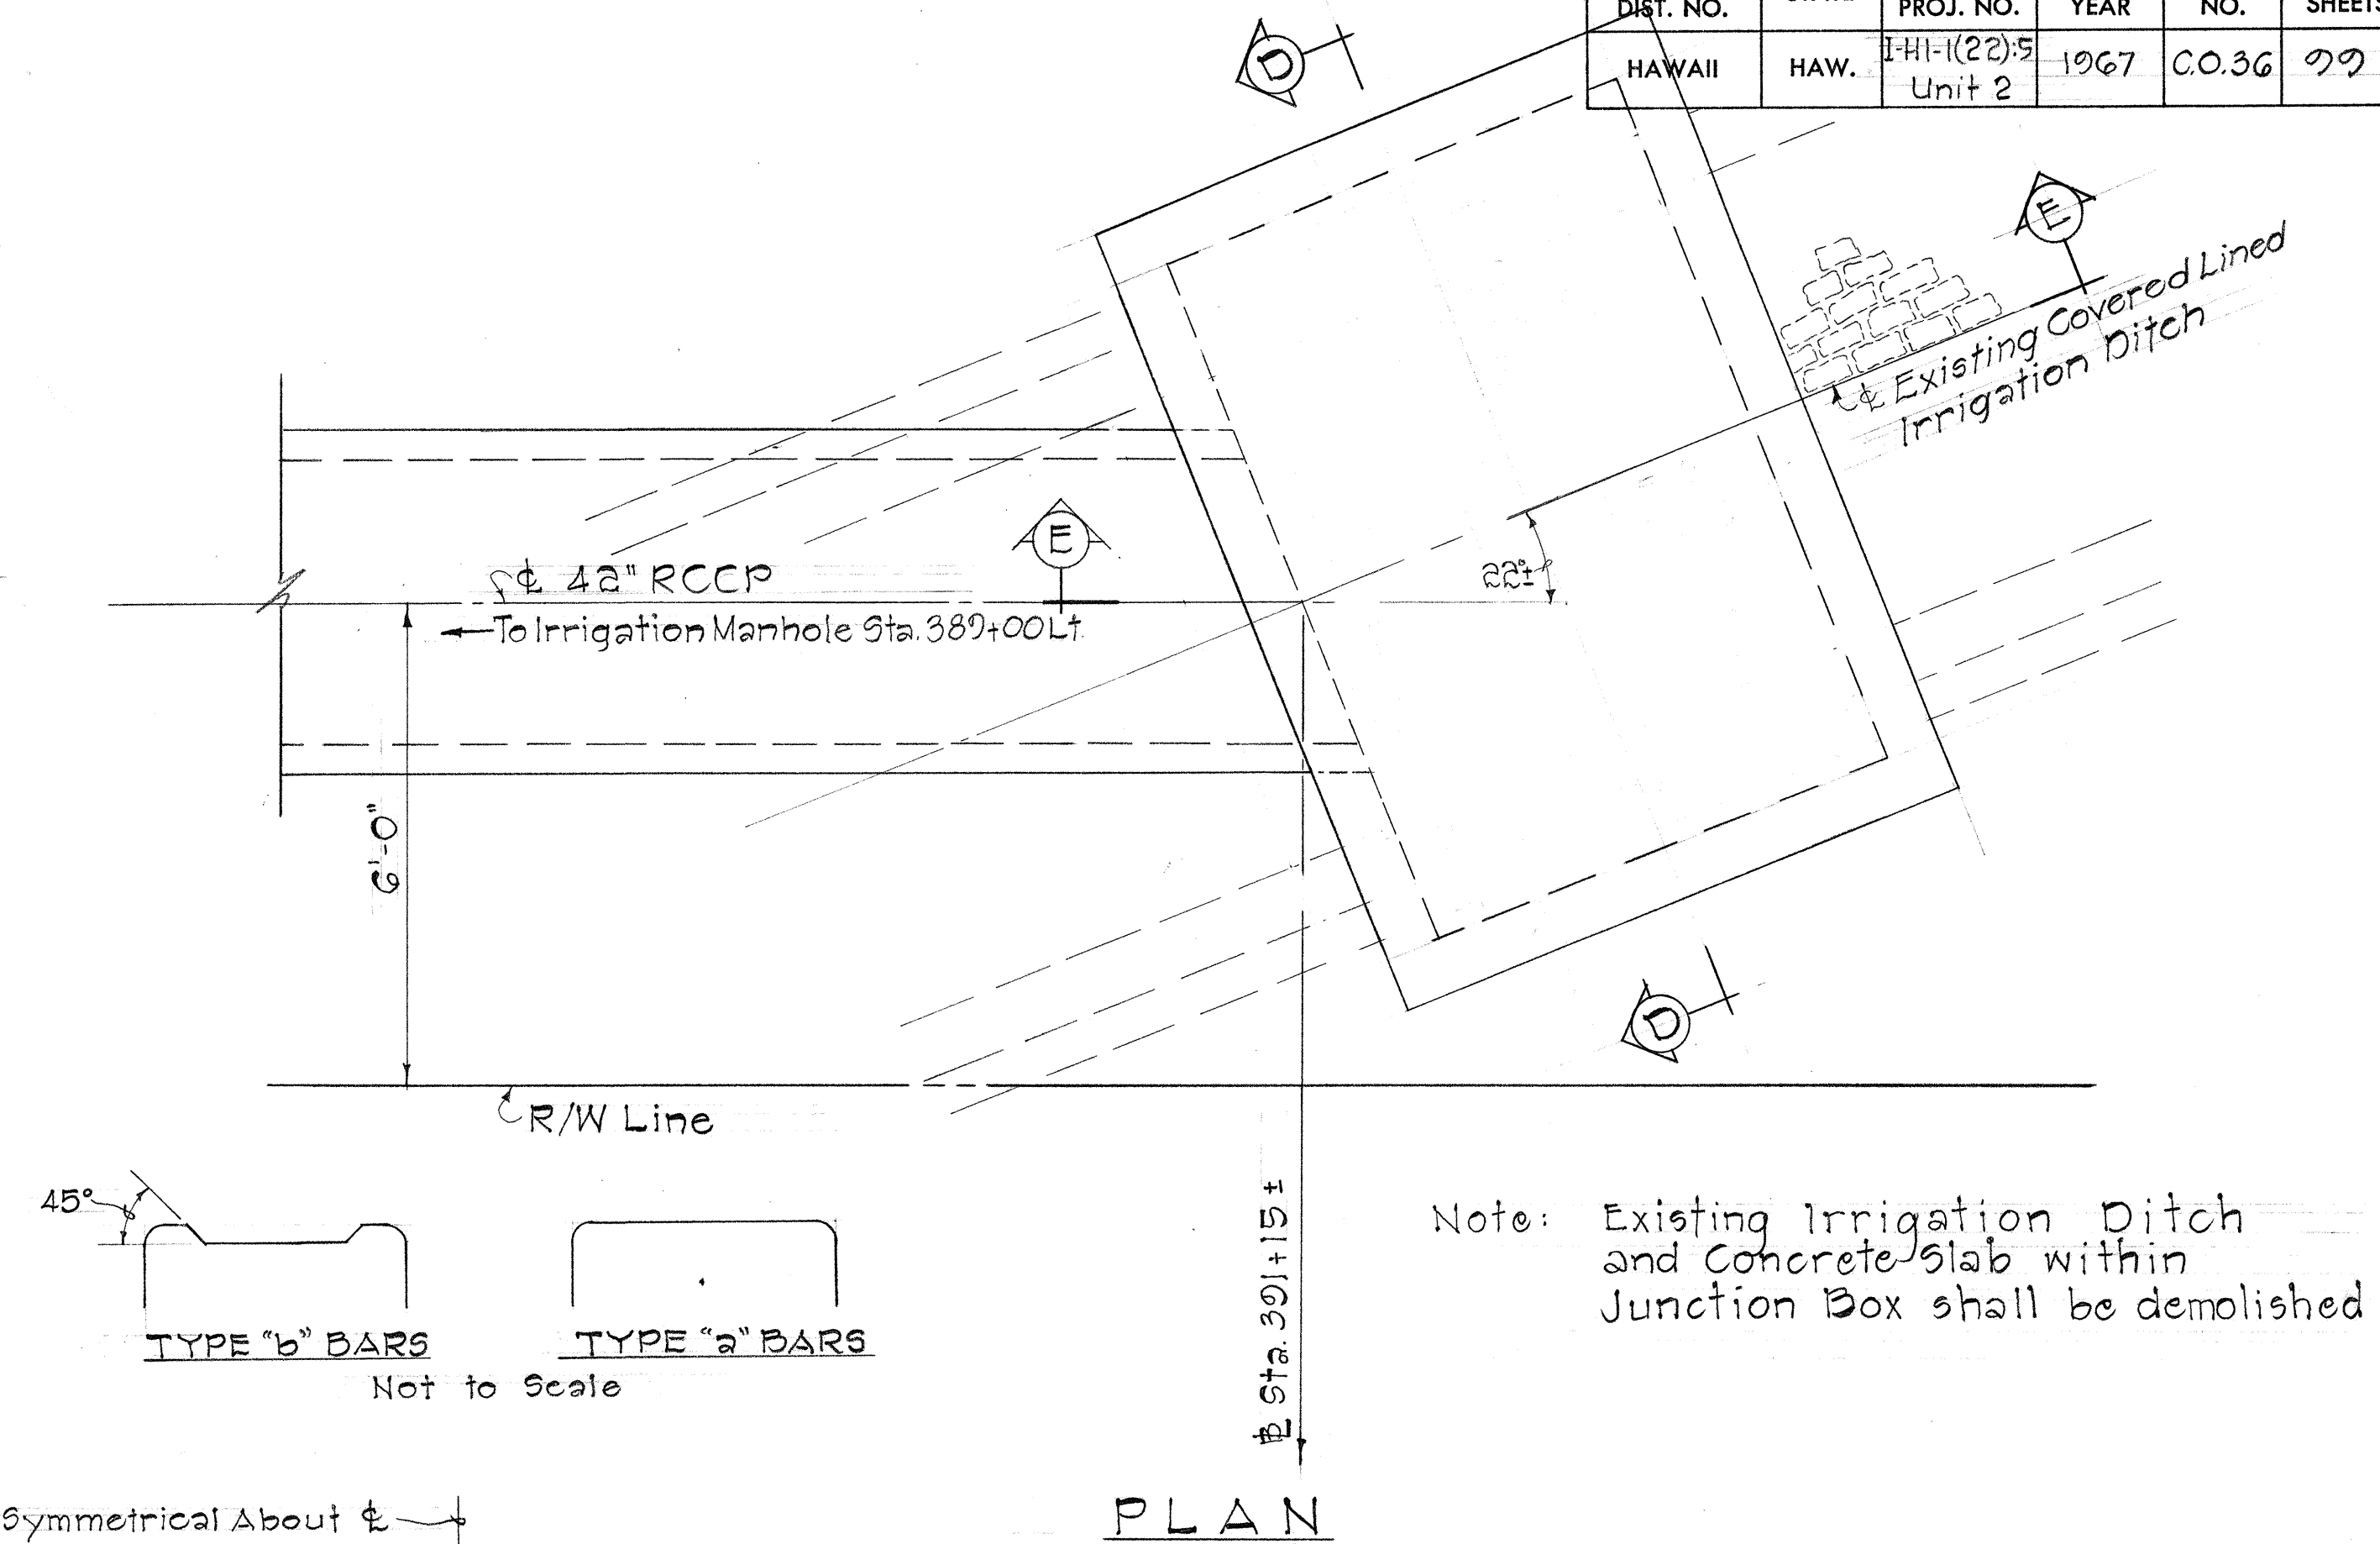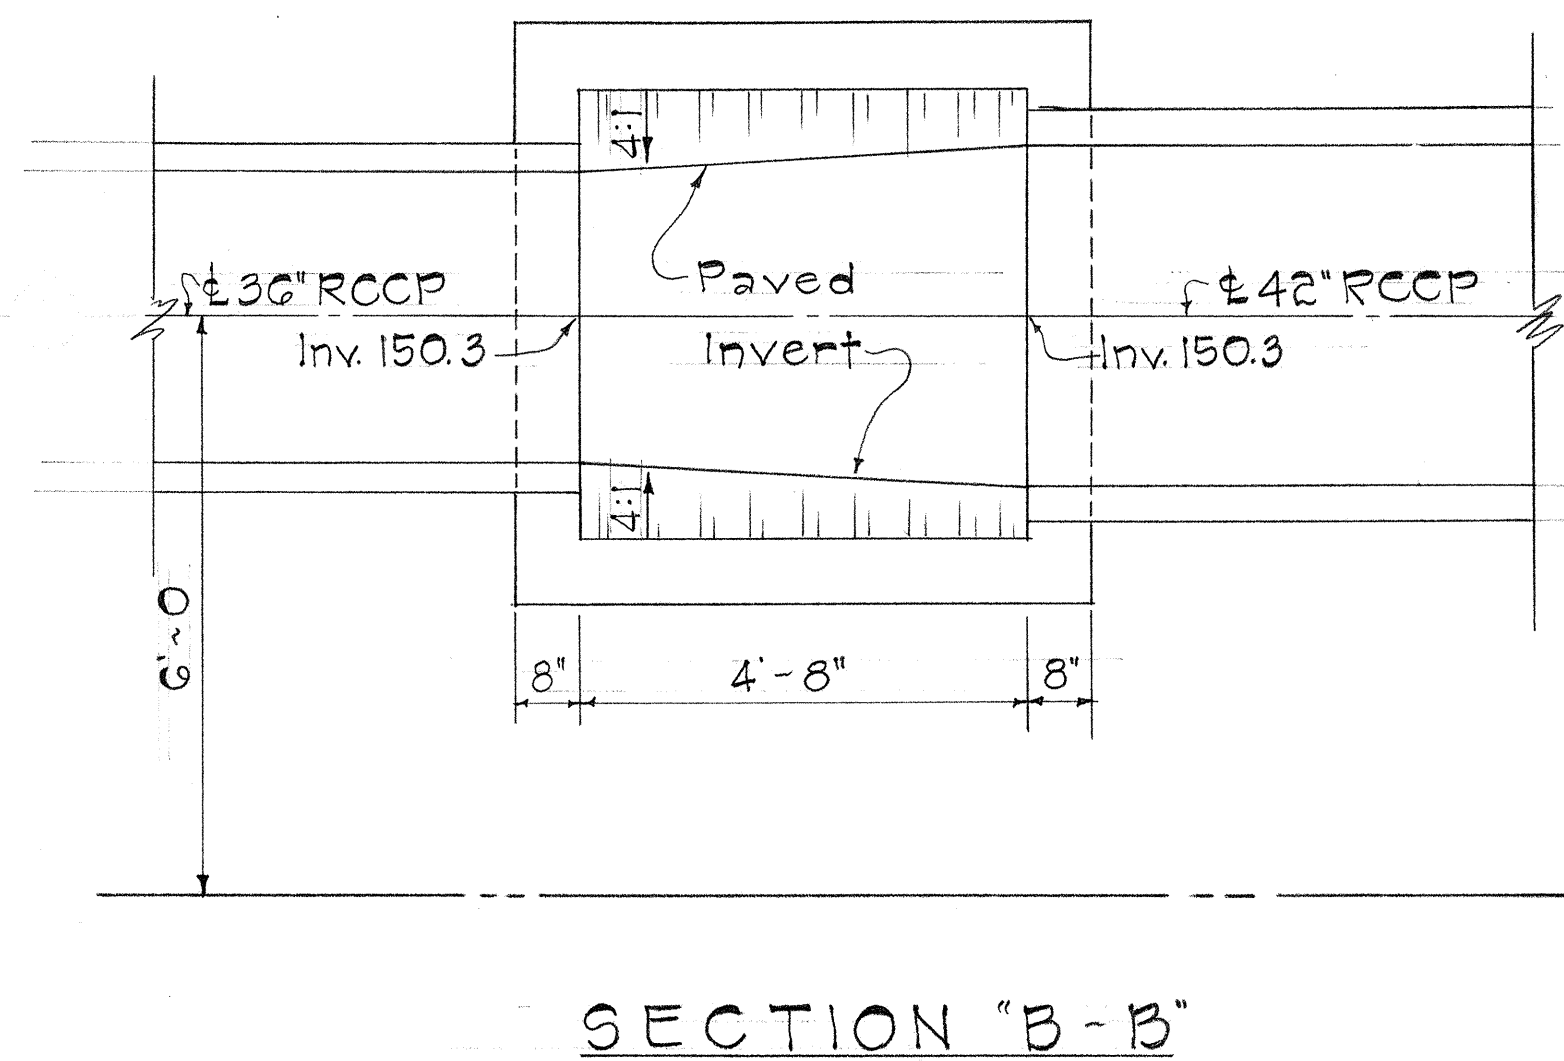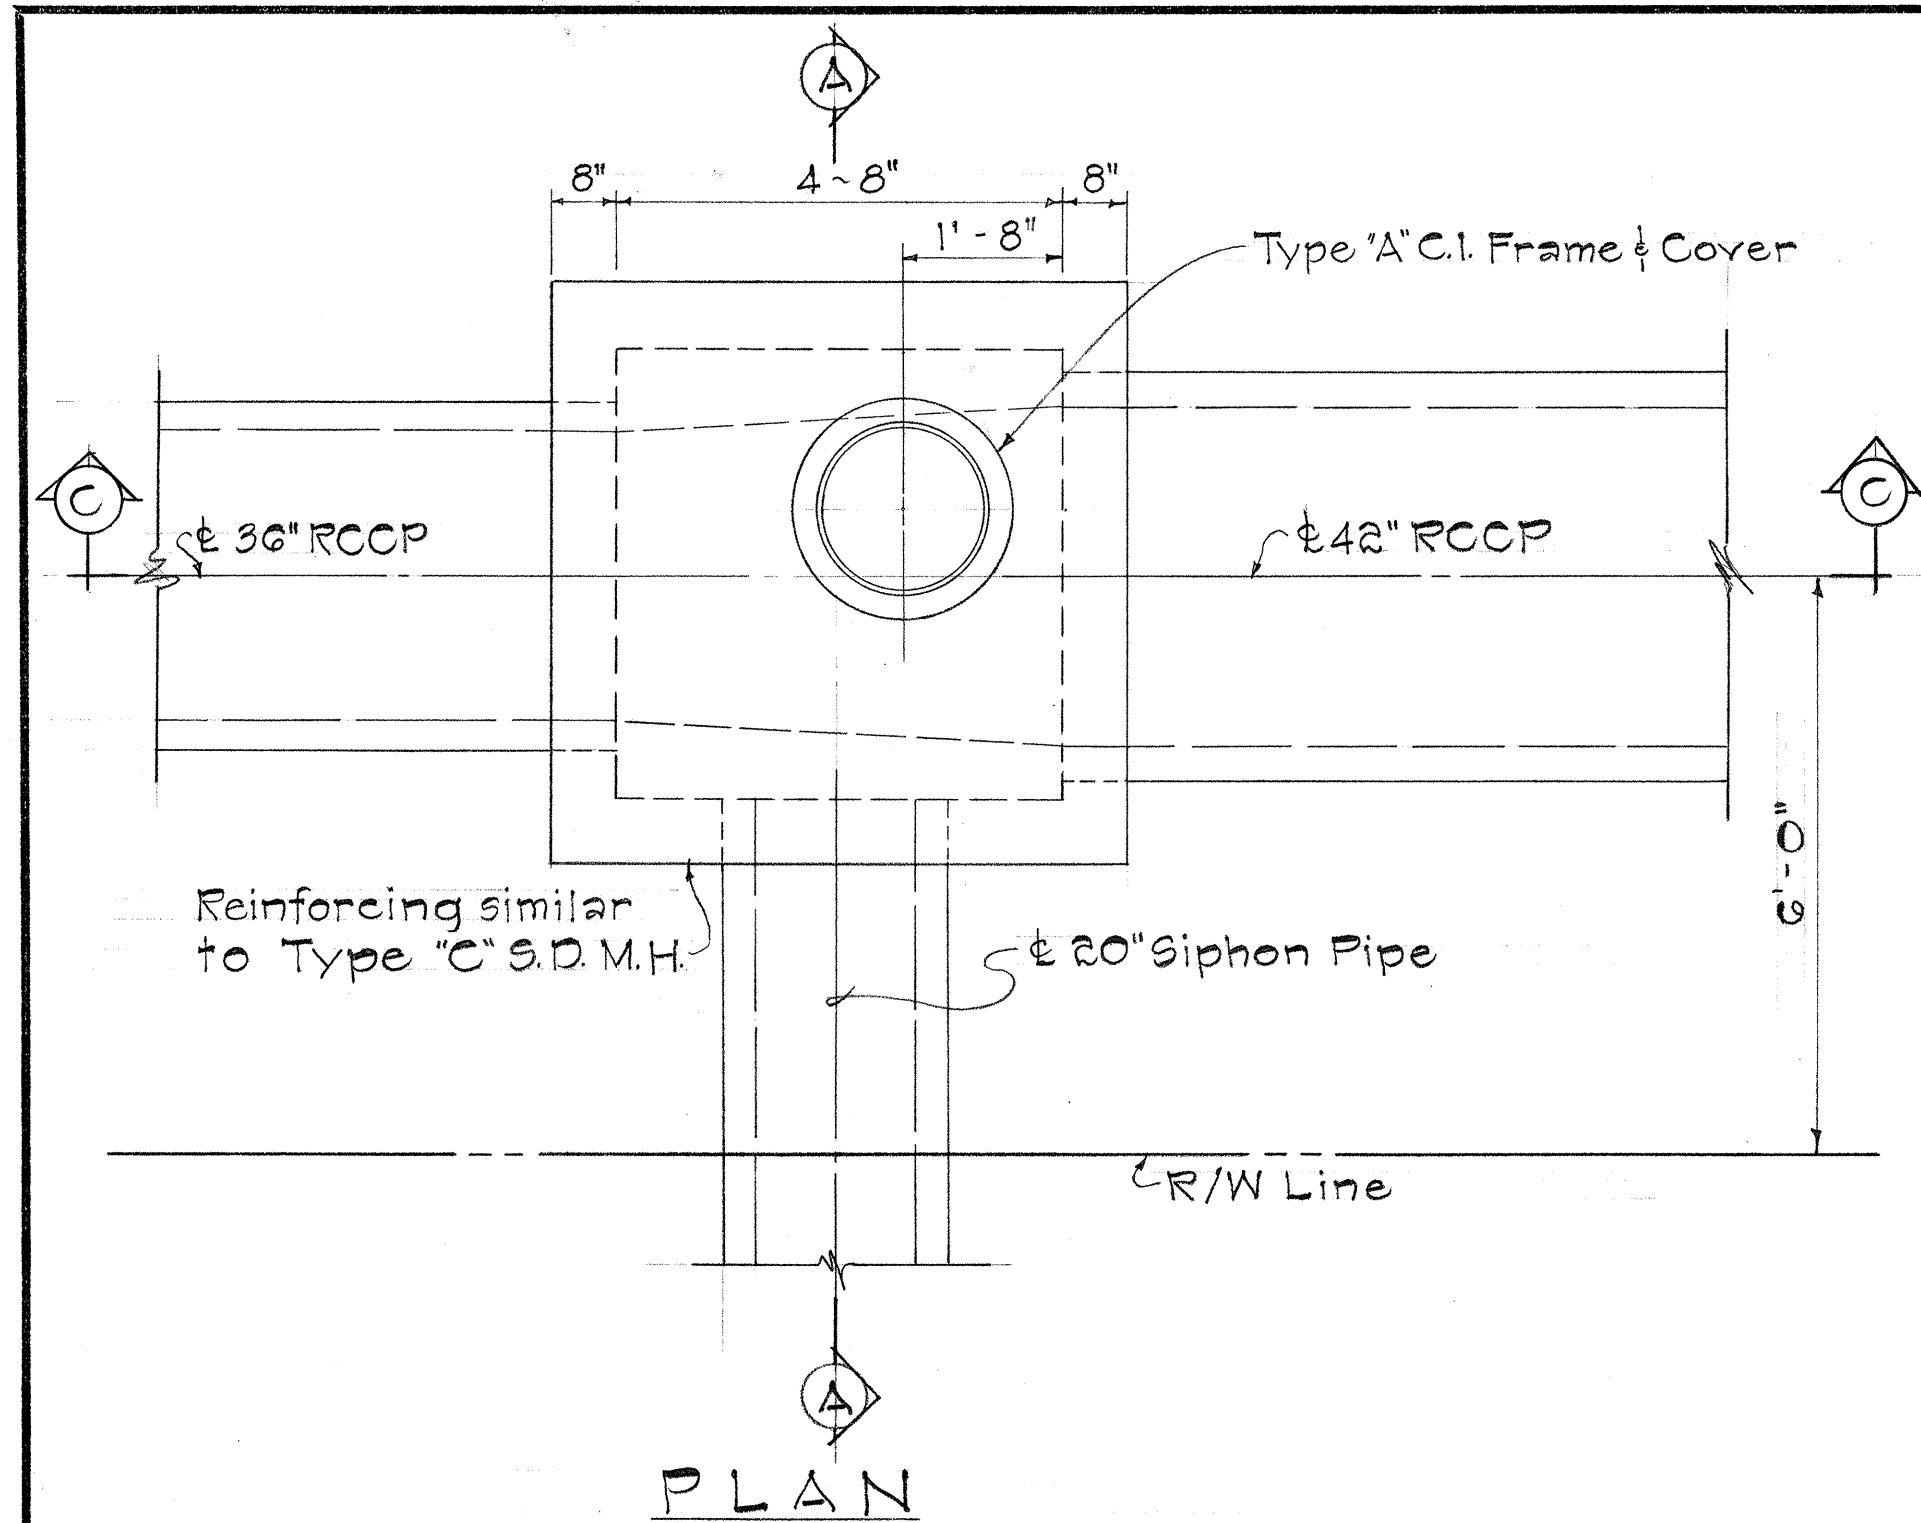

Note: Existing Irrigation Ditch and Concrete Slab within Junction Box shall be demolished

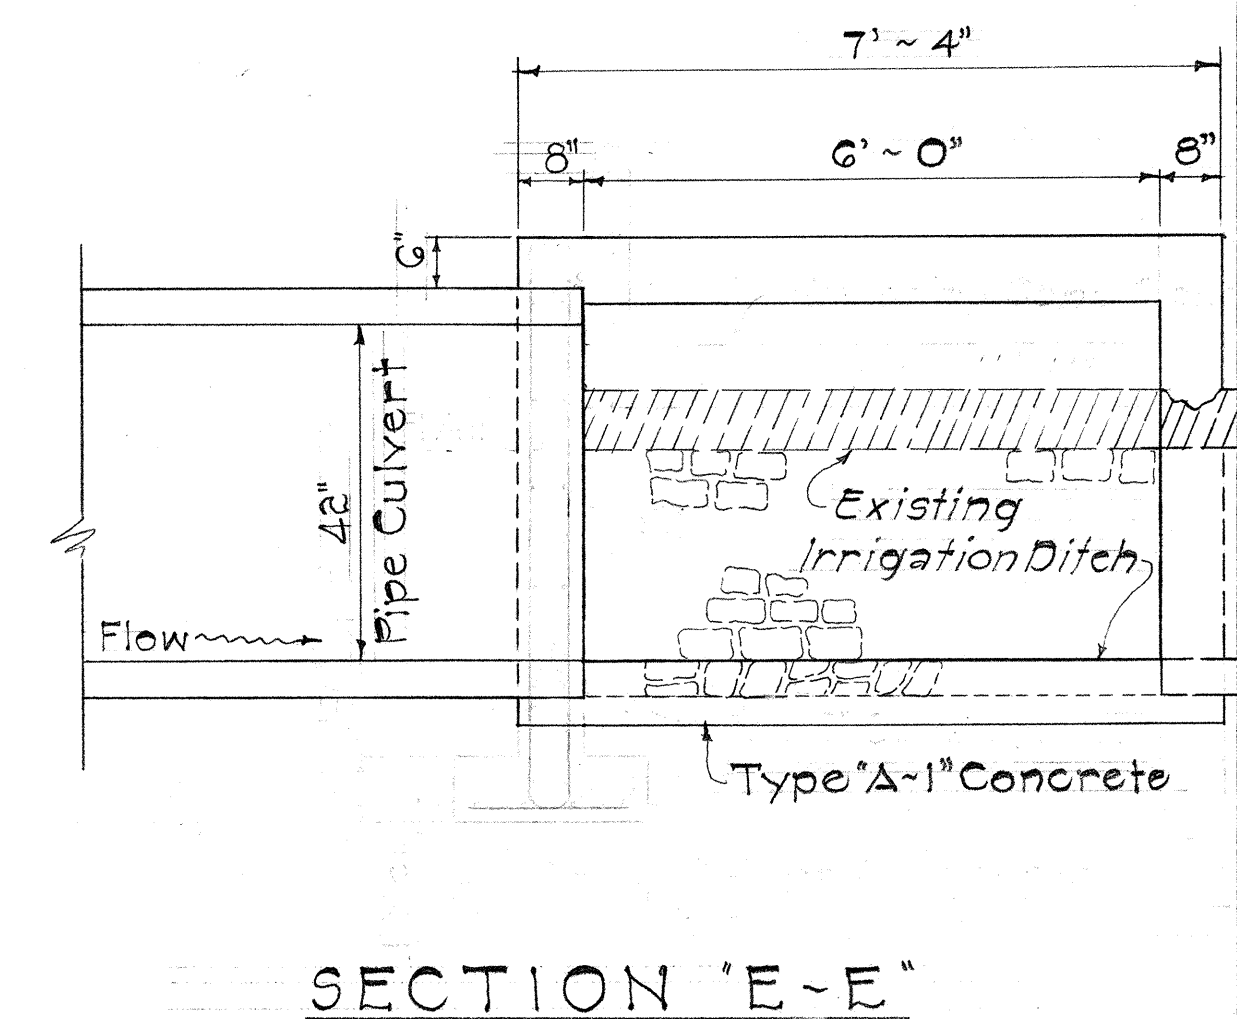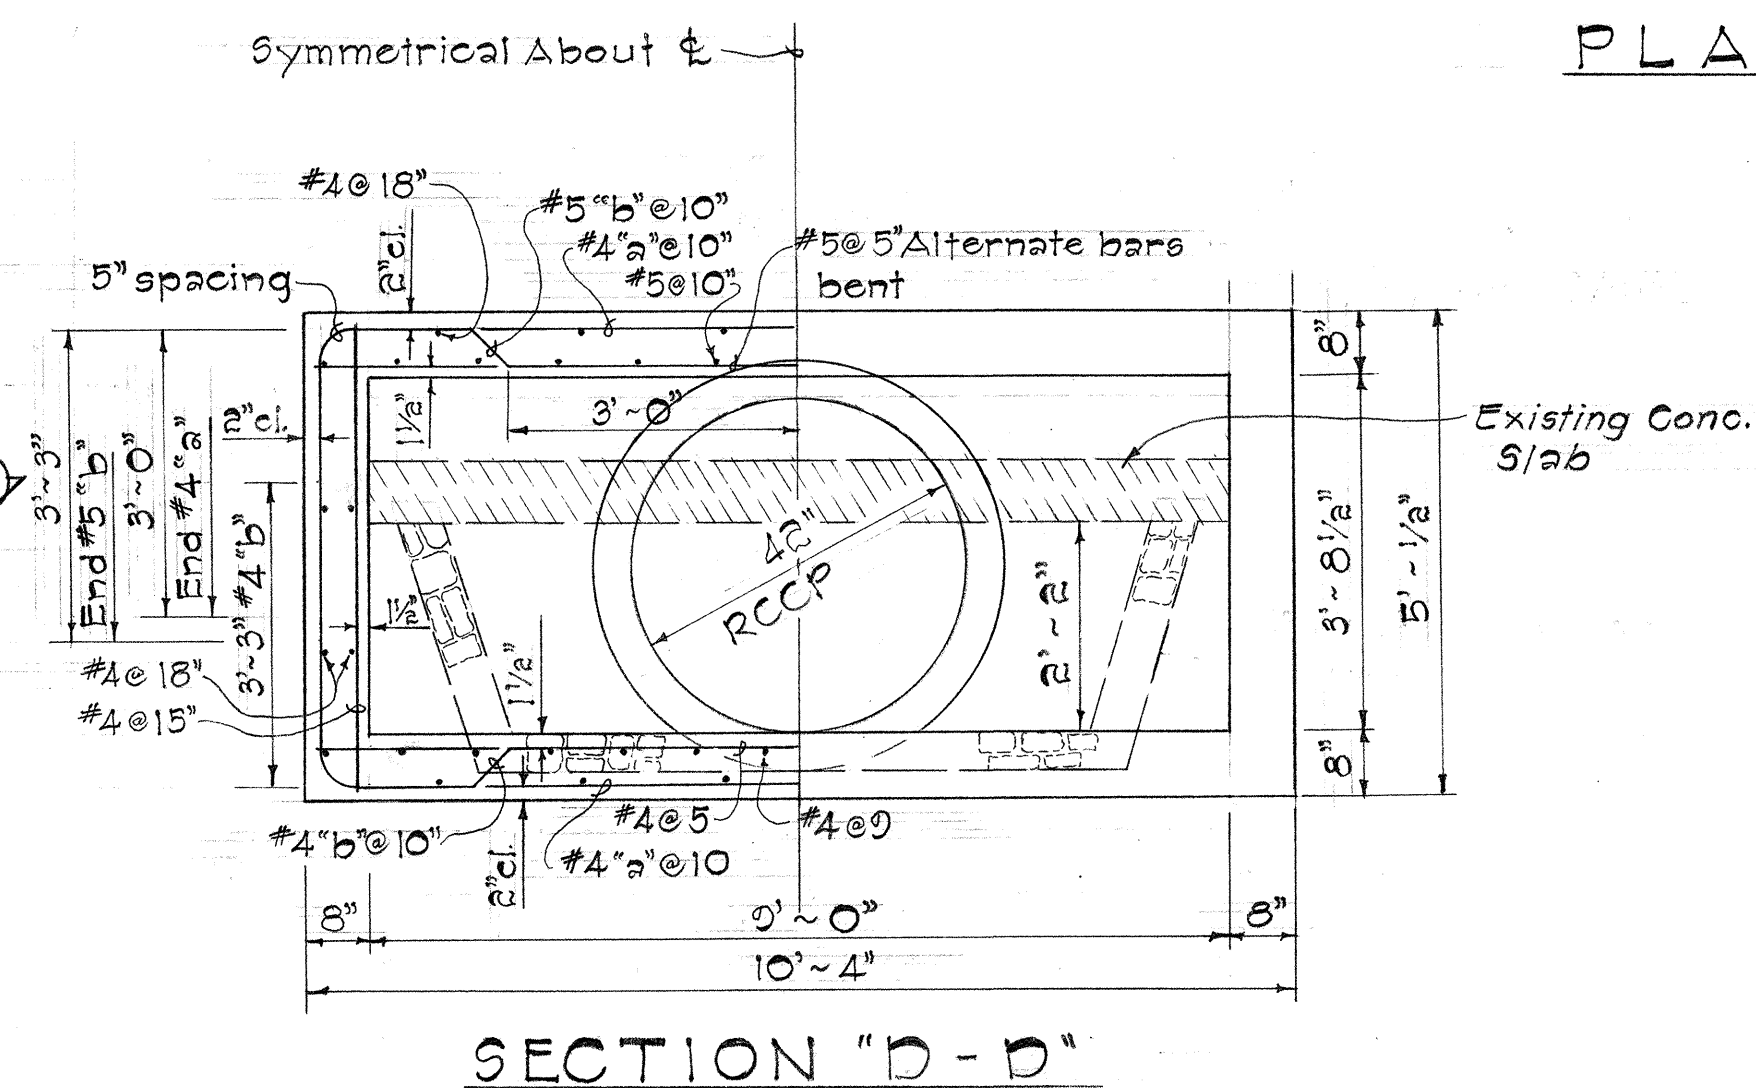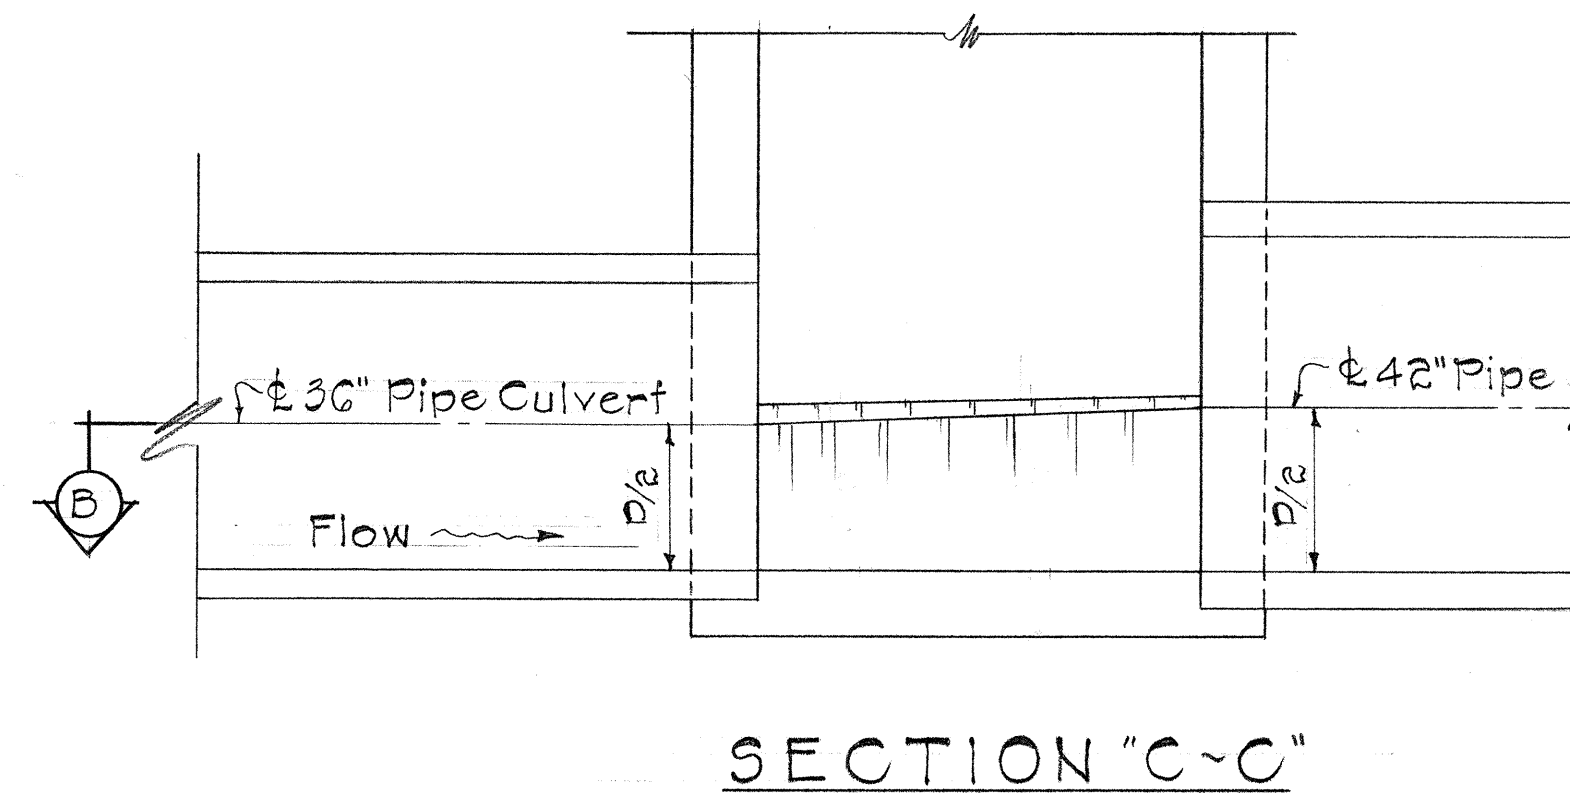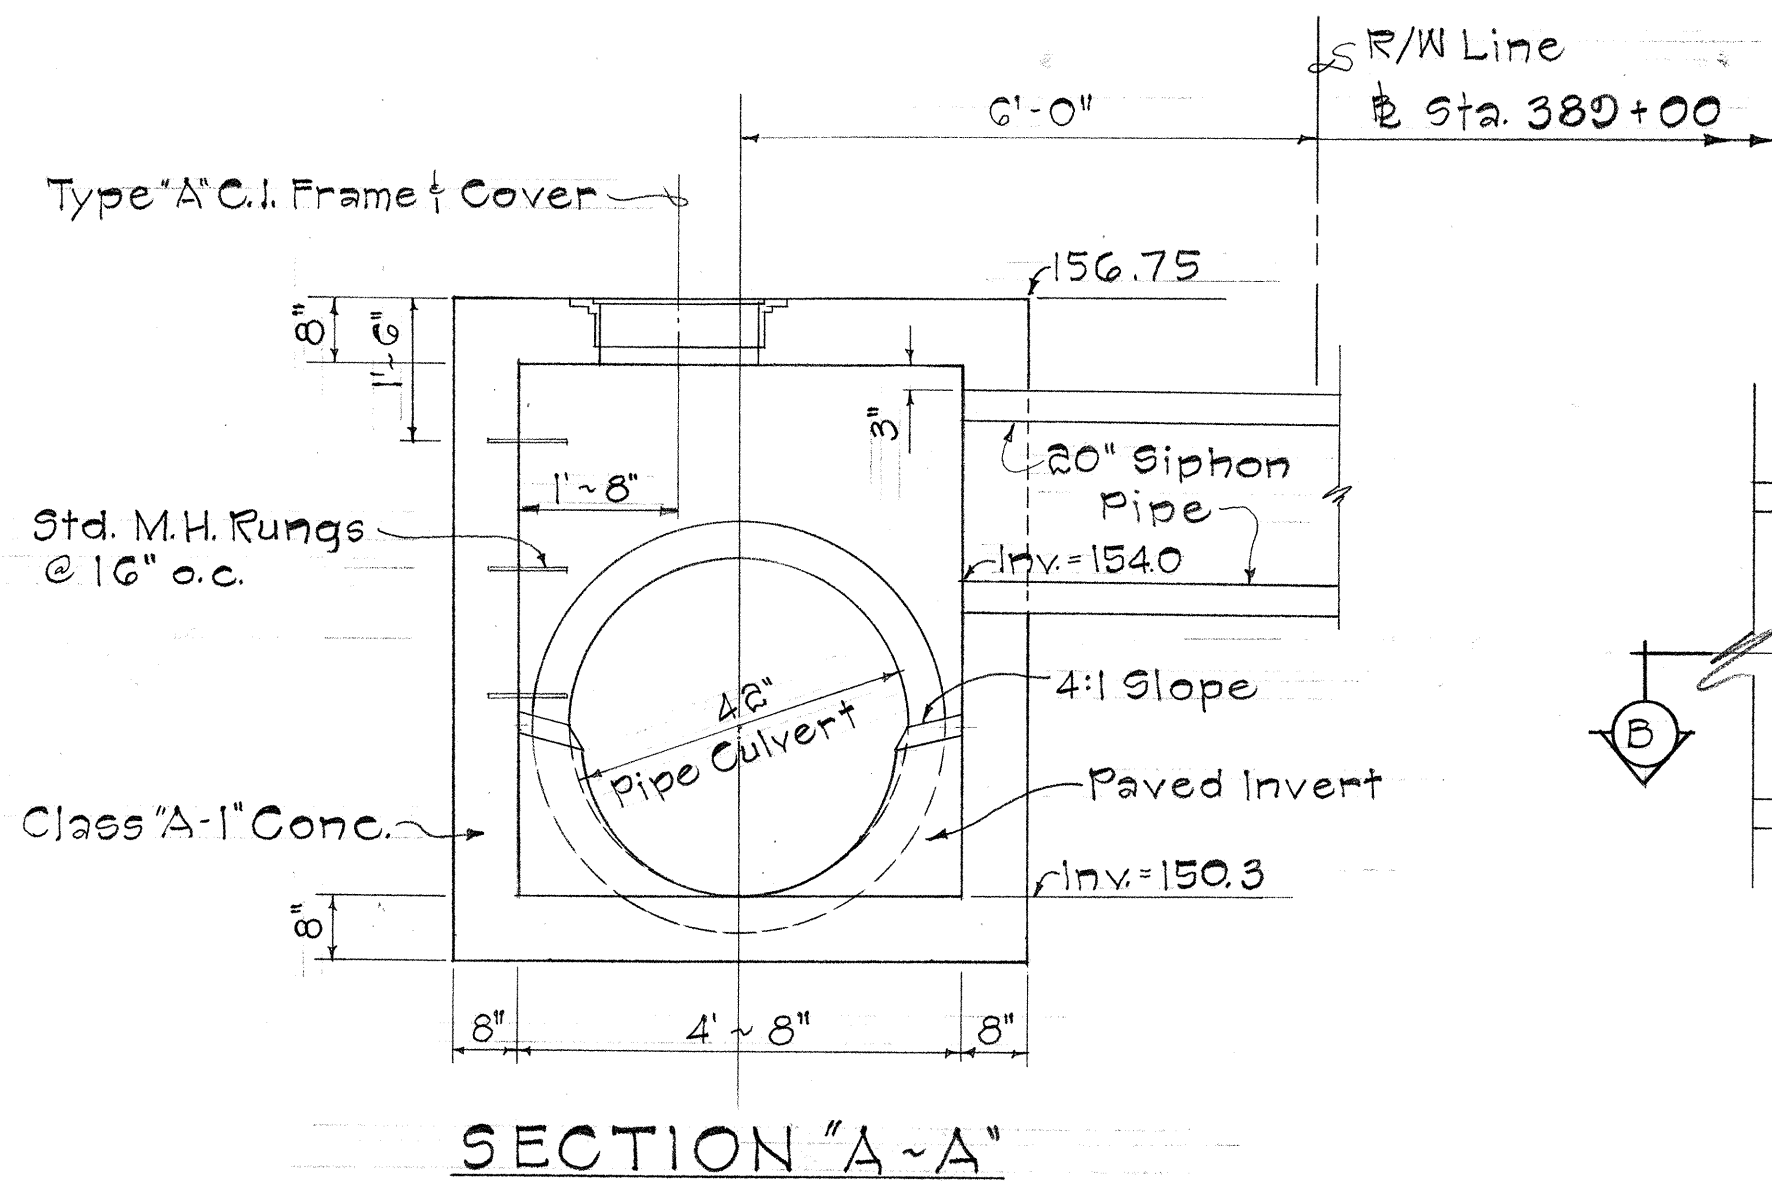

DETAILS OF IRRIGATION MANHOLE AT STA. 389+00 Lt.

Scale: 1/8" = 1'-0"

DETAIL OF CONNECTION OF 42" PIPE CULVERT TO EXISTING PUMP #3 DITCH AT STA. 391+15± Lt.


Scale: 1/2" = 1'-0"

STATE OF HAWAII
DEPARTMENT OF TRANSPORTATION
HIGHWAYS DIVISION
IRRIGATION DETAILS
RELOCATION OF P3 DITCH
M.H. @ STA. 389+00 Lt. AND
CONN. OF 42" RCCP TO EXISTING
P3 DITCH @ STA. 391+15± Lt.
INTERSTATE ROUTE H-1
F.A.I. PROJ. NO. I-HI-1(22):5 Unit 2
Scale: As Shown Date: June, 1967
SHEET No. 7 OF 28 SHEETS

April 2, 1968

C O 3 6

FED. ROAD DIST. NO.	STATE	FED. AID PROJ. NO.	FISCAL YEAR	SHEET NO.	TOTAL SHEETS
HAWAII	HAW.	I-HI-1(22)5 Unit 2	1967	37	99

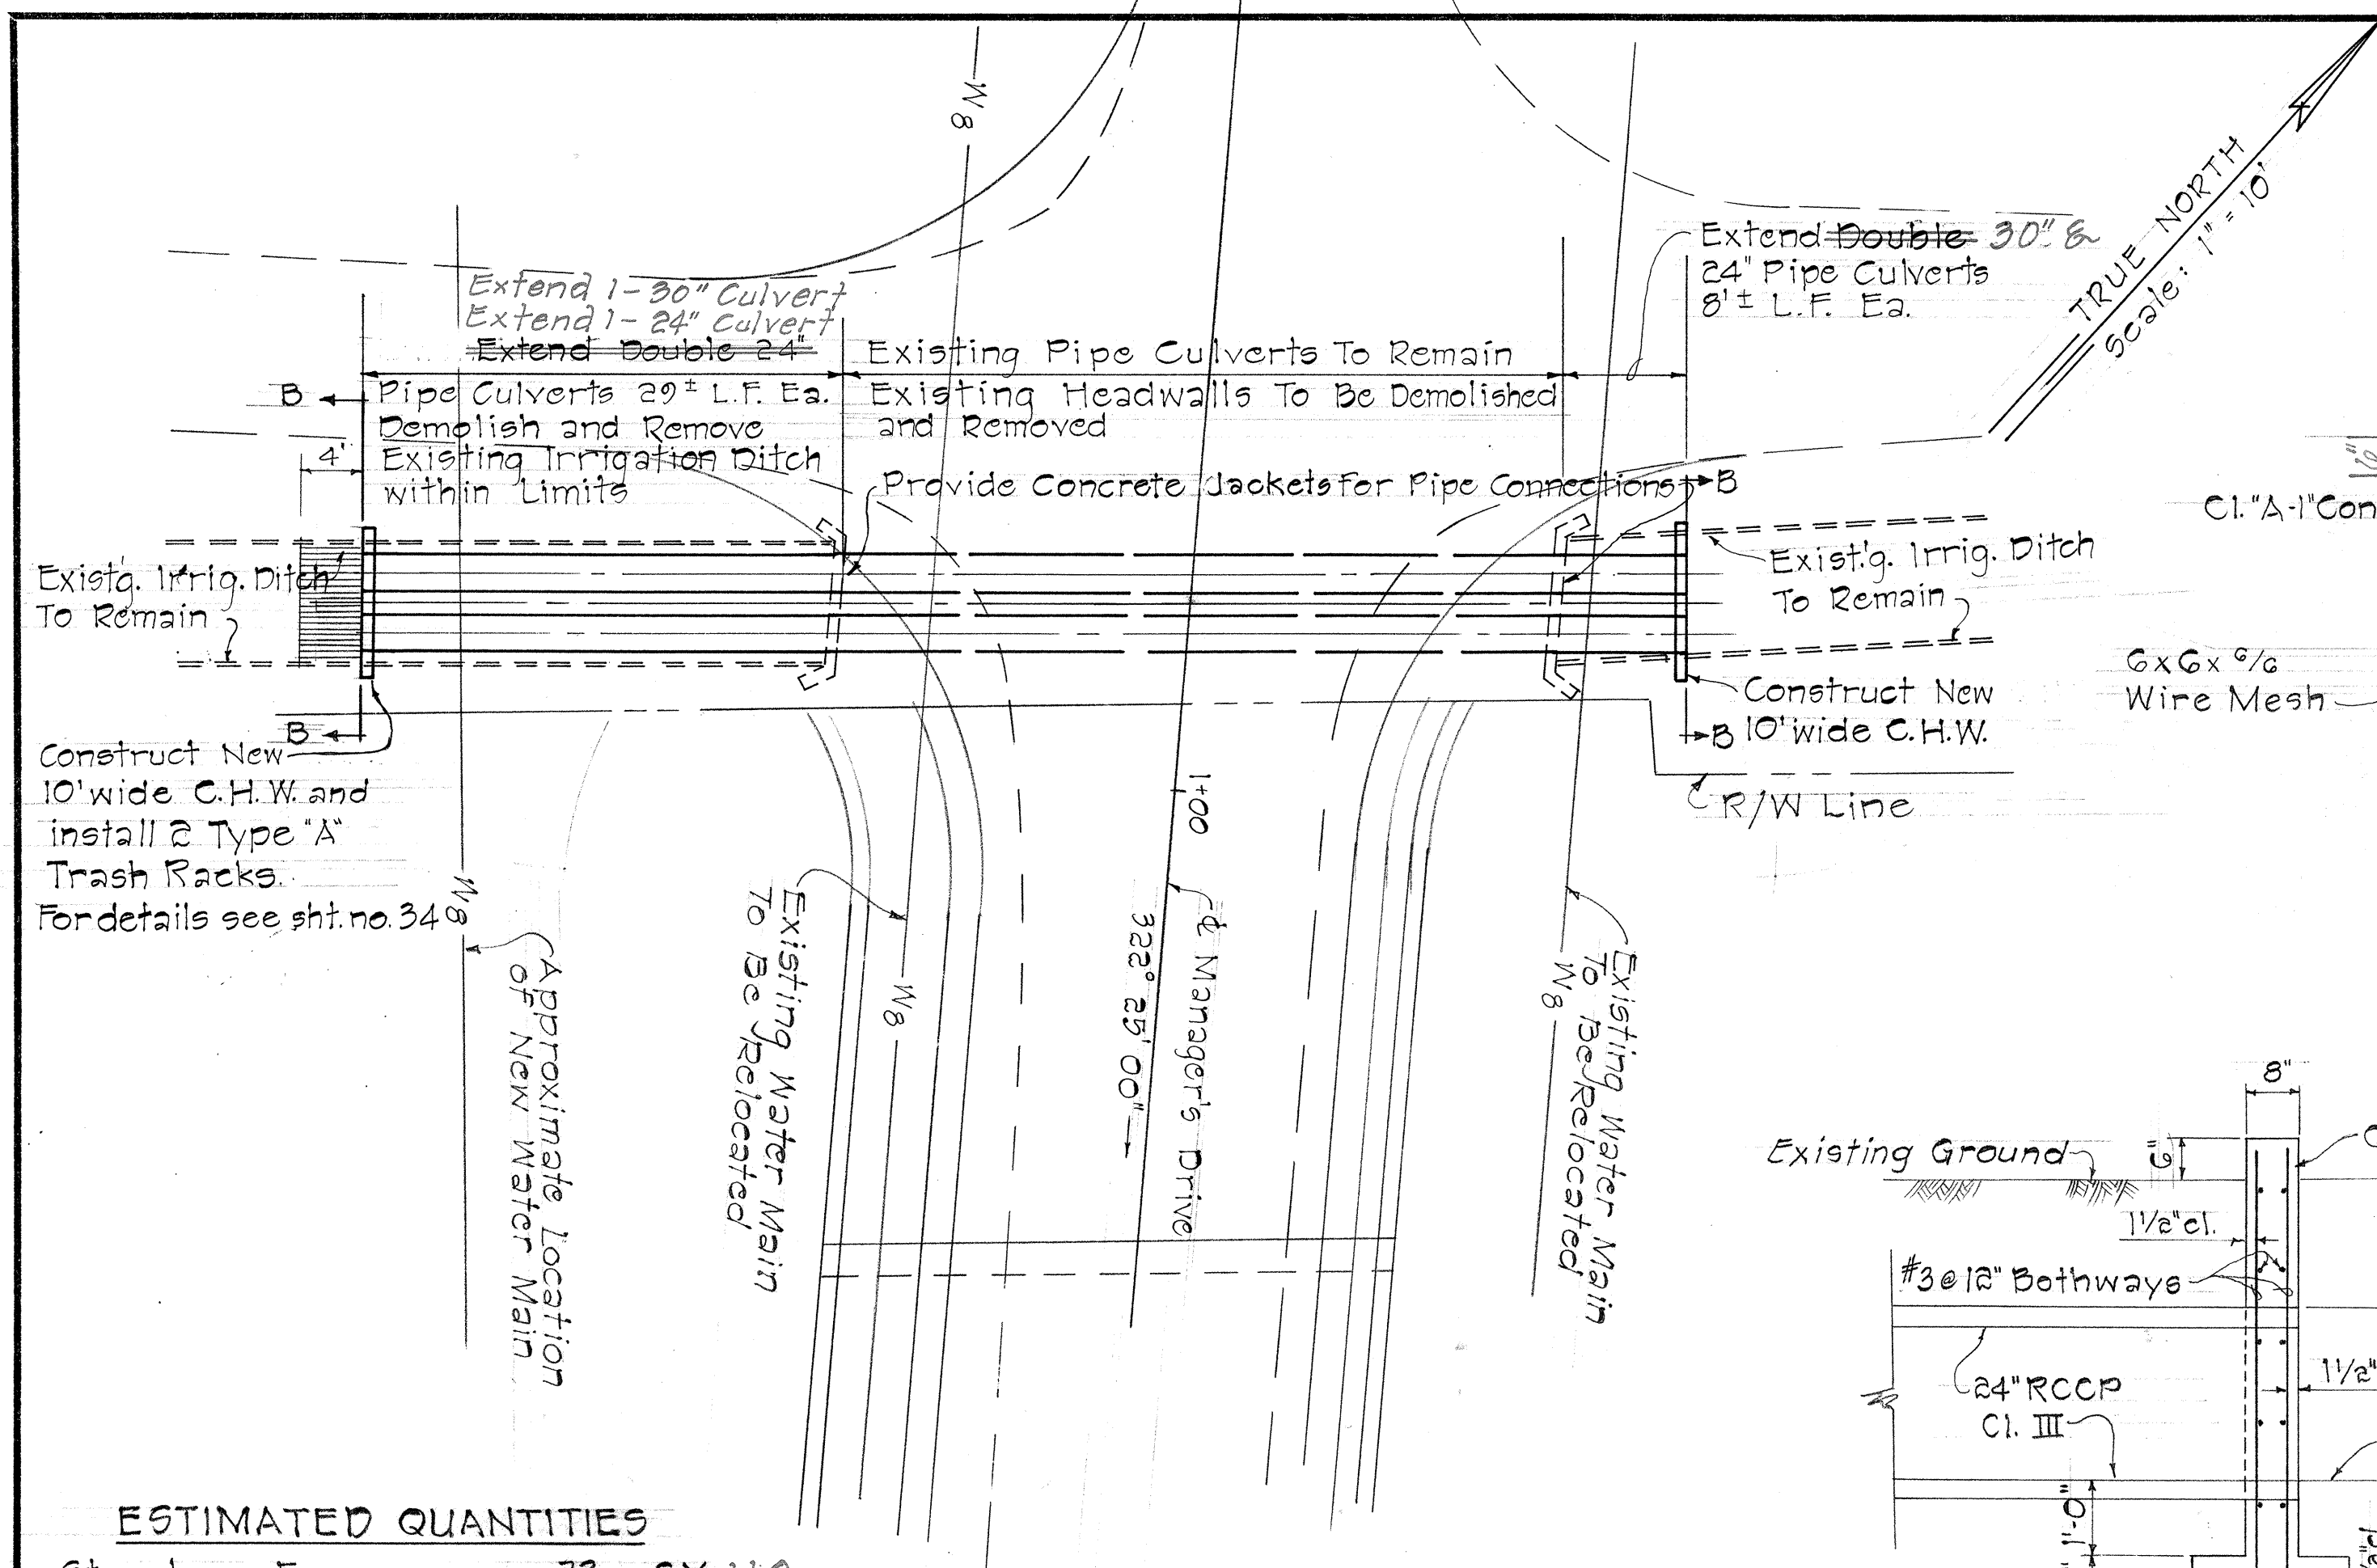


ESTIMATED QUANTITIES

Structure Exc.	=	73	C.Y. 110
Class "A-1" Concrete	=	240	C.Y. 22.4
Reinf. Steel	=	770	Lbs. 705
24" RCCP, Cl. III	=	76	L.F. 42
Type "A" Trash Rack	=	2	Ea.
30" RCCP, Class III	=	99	L.F.


PLAN

Scale: 1" = 10'

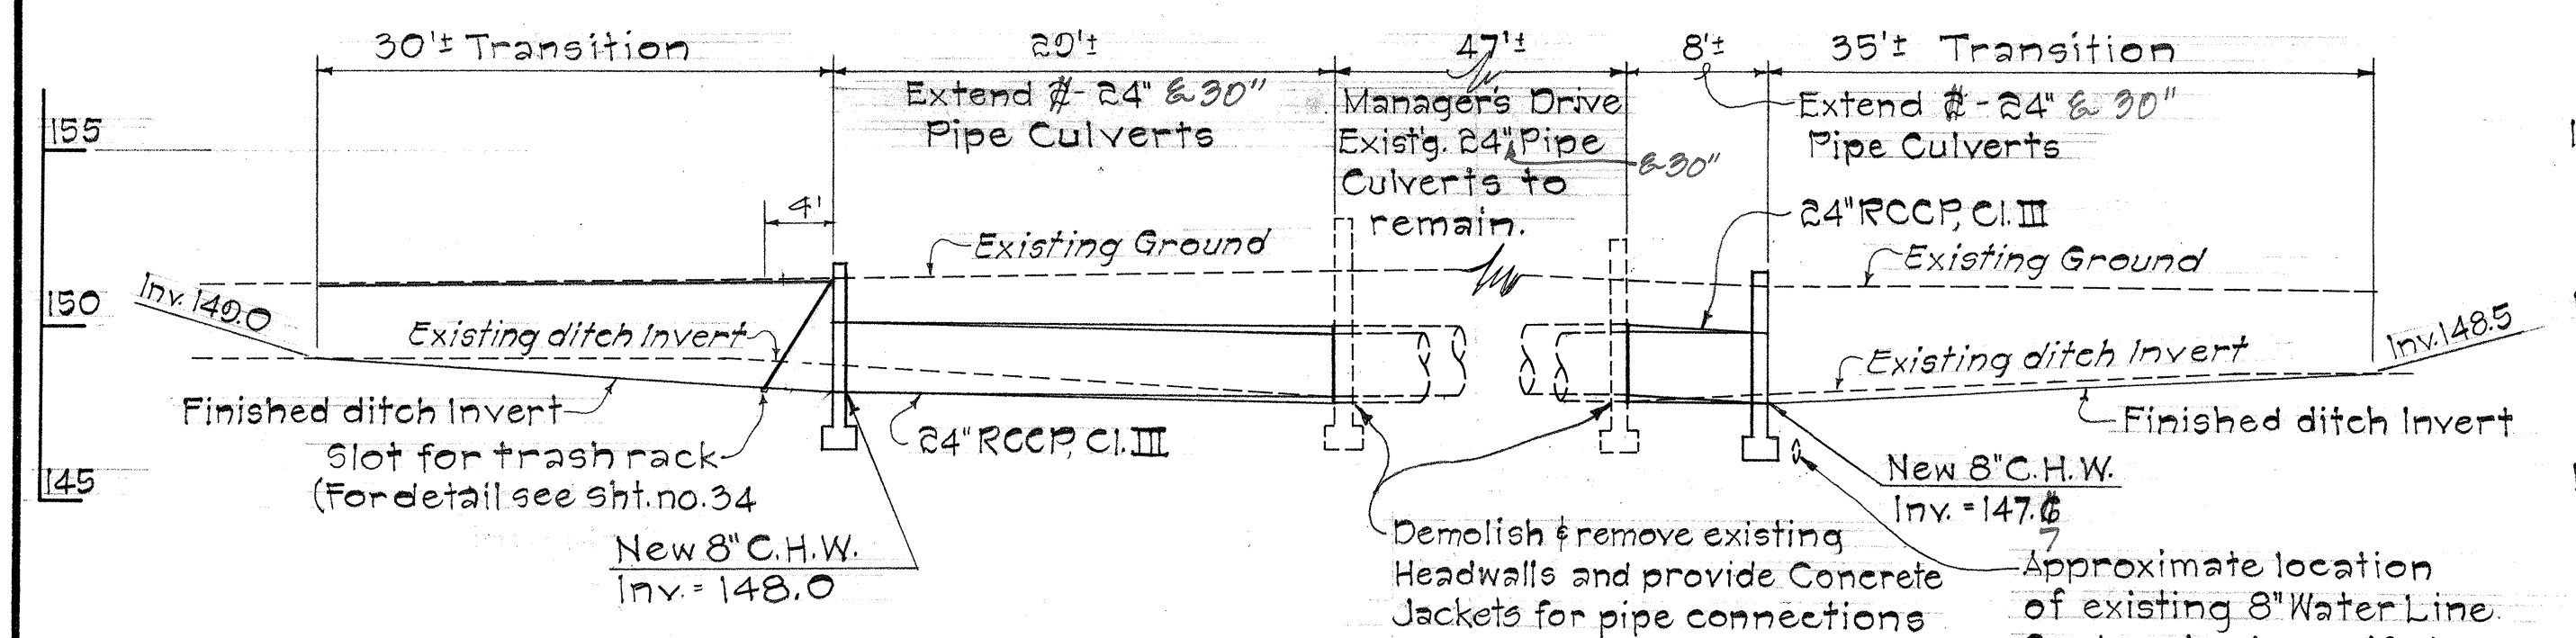


PROFILE ~ DOUBLE 24" PIPE CULVERTS AT STA. 397+96.21 LEFT

Scale: Horiz. 1" = 10'
Vert. 1" = 5'

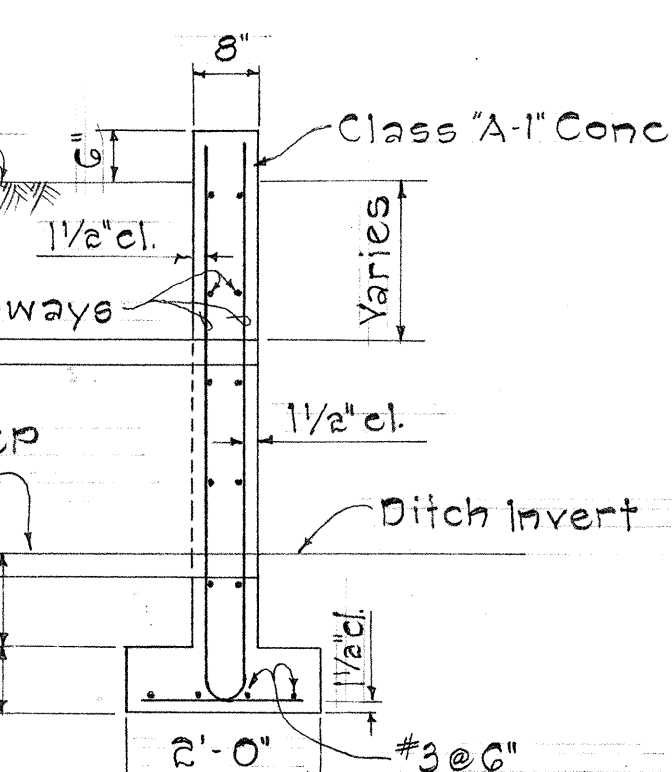

TYPICAL DETAIL OF CONC. HEADWALL FOR EXTENSION OF 24" PIPE CULVERTS


Scale: 1/2" = 1'-0"

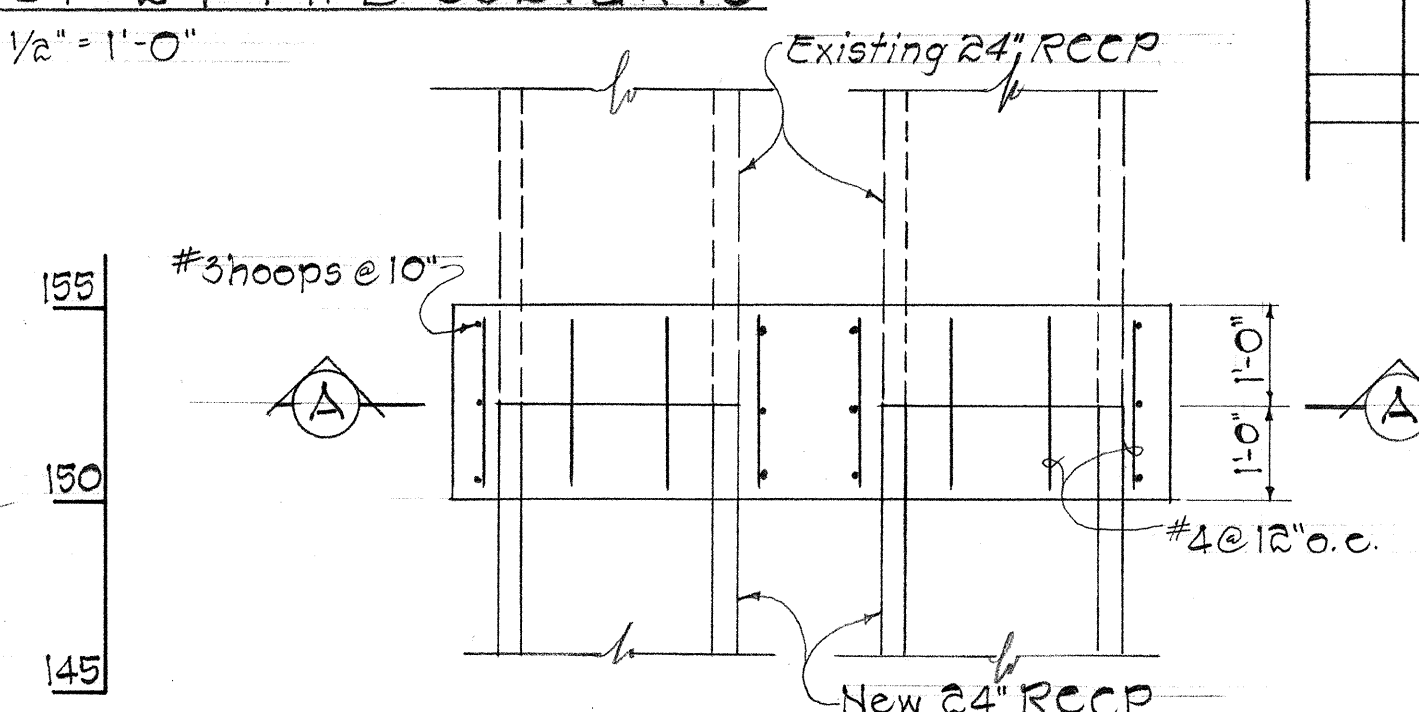

PLAN

TYPICAL DETAILS OF INLET AND OUTLET STRUCTURES FOR CULVERT AT STA. 411+40

Scale: 1" = 1'-0"

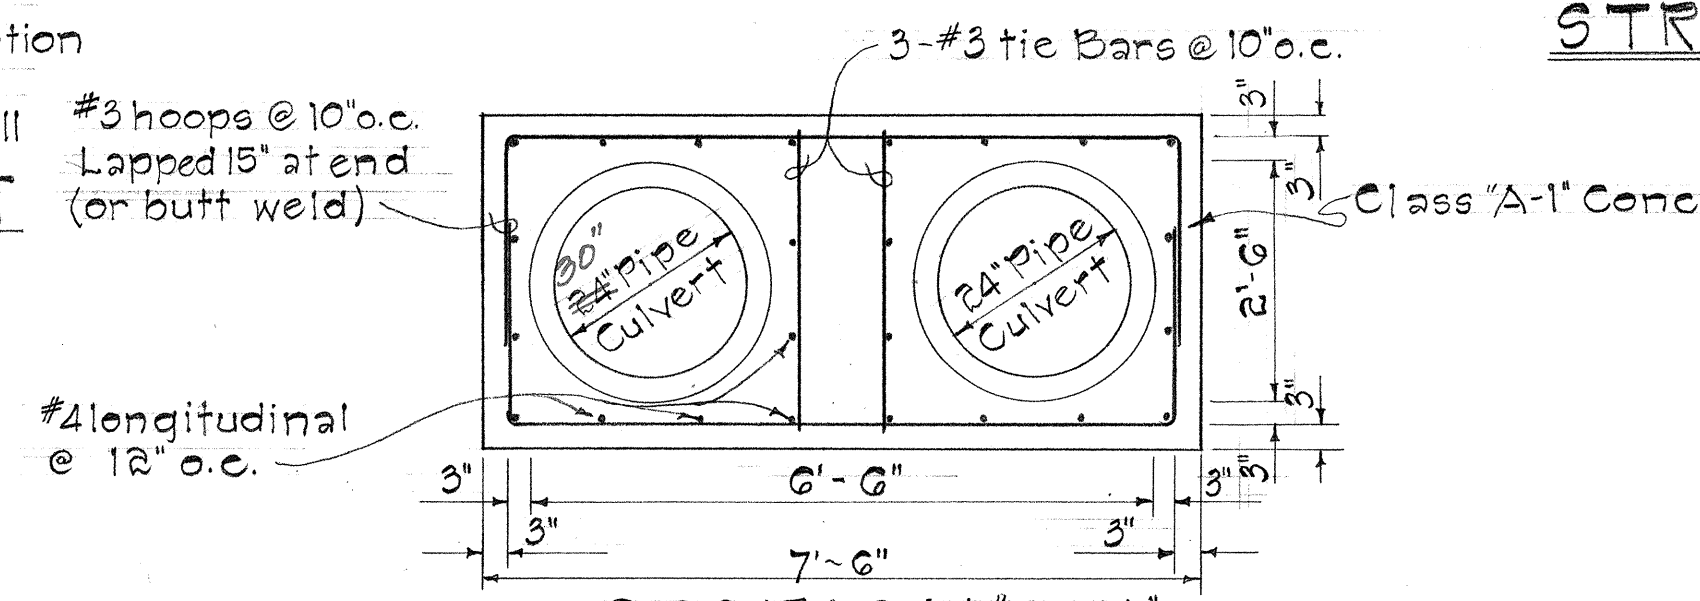

SECTION "A-A"

DETAIL OF CONCRETE JACKET


Scale: 1/2" = 1'-0"

DETAILS OF EXTENSION OF DOUBLE 24" PIPE CULVERTS AT STA. 397+96.21 LEFT

Scale: As Shown


STATE OF HAWAII DEPARTMENT OF TRANSPORTATION HIGHWAYS DIVISION	
IRRIGATION DETAILS	
EXTENSION OF DOUBLE 24" PIPE CULVERTS AT STA. 397+96.21 LT.	
INLET & OUTLET STRUCTURES AT STA. 411+40	
INTERSTATE ROUTE H-1	
F.A.I. PROJ. NO. I-HI-1(22)5 Unit 2	
Scale: As Shown	Date: June, 1967
SHEET No. 8 OF 28 SHEETS	

FED. ROAD DIST. NO.	STATE	FED. AID PROJ. NO.	FISCAL YEAR	SHEET NO.	TOTAL SHEETS
HAWAII	HAW.	I-HI-1(22):5 Unit 2	1967	38	77

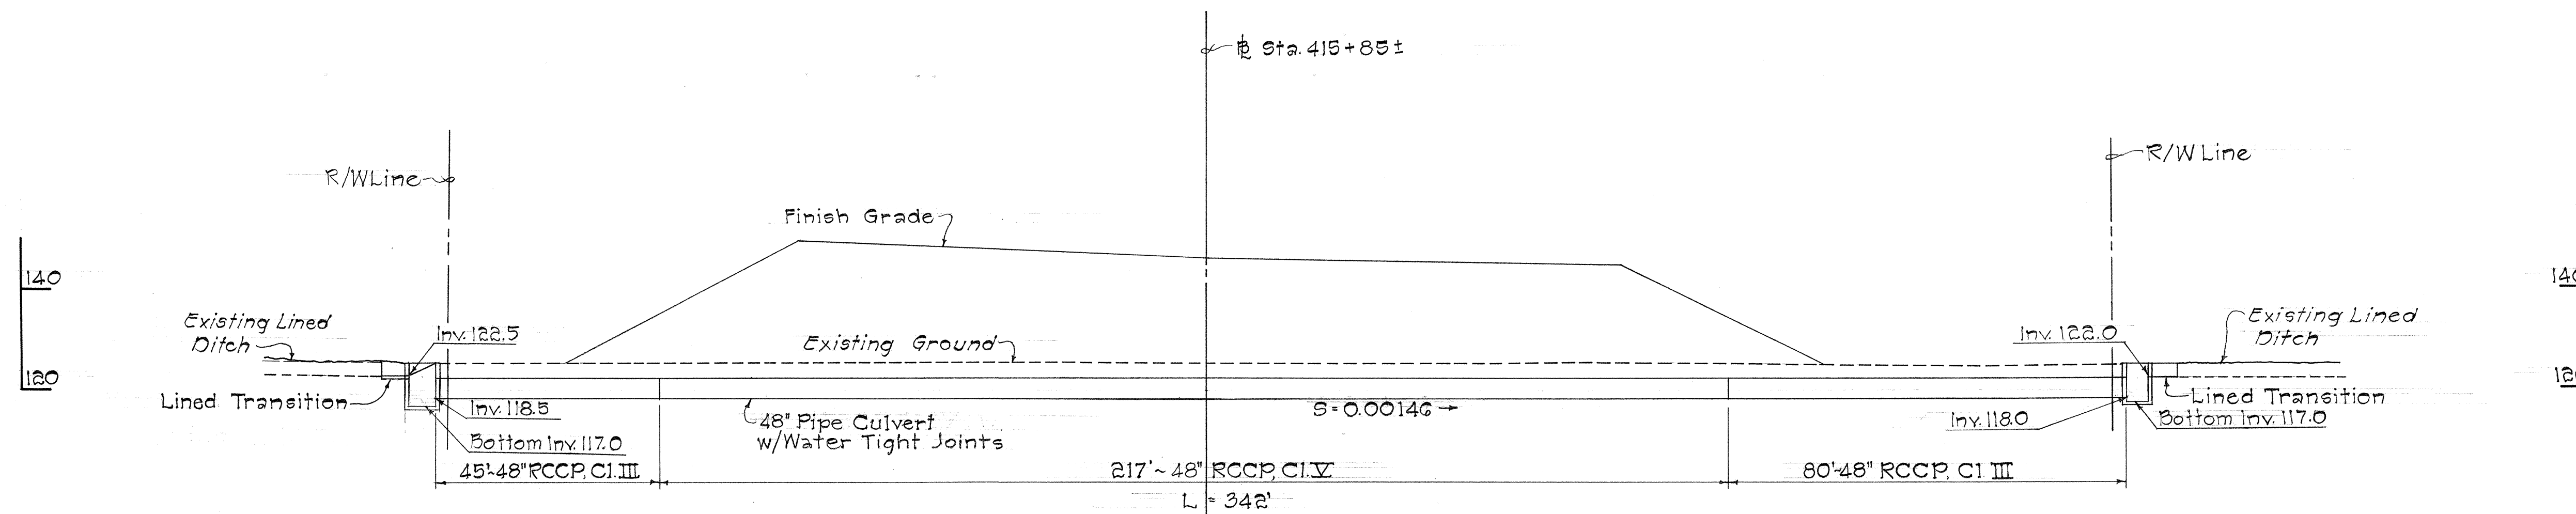

PROFILE OF 48" SIPHON @ STA. 415+85±


Scale: 1" = 20'

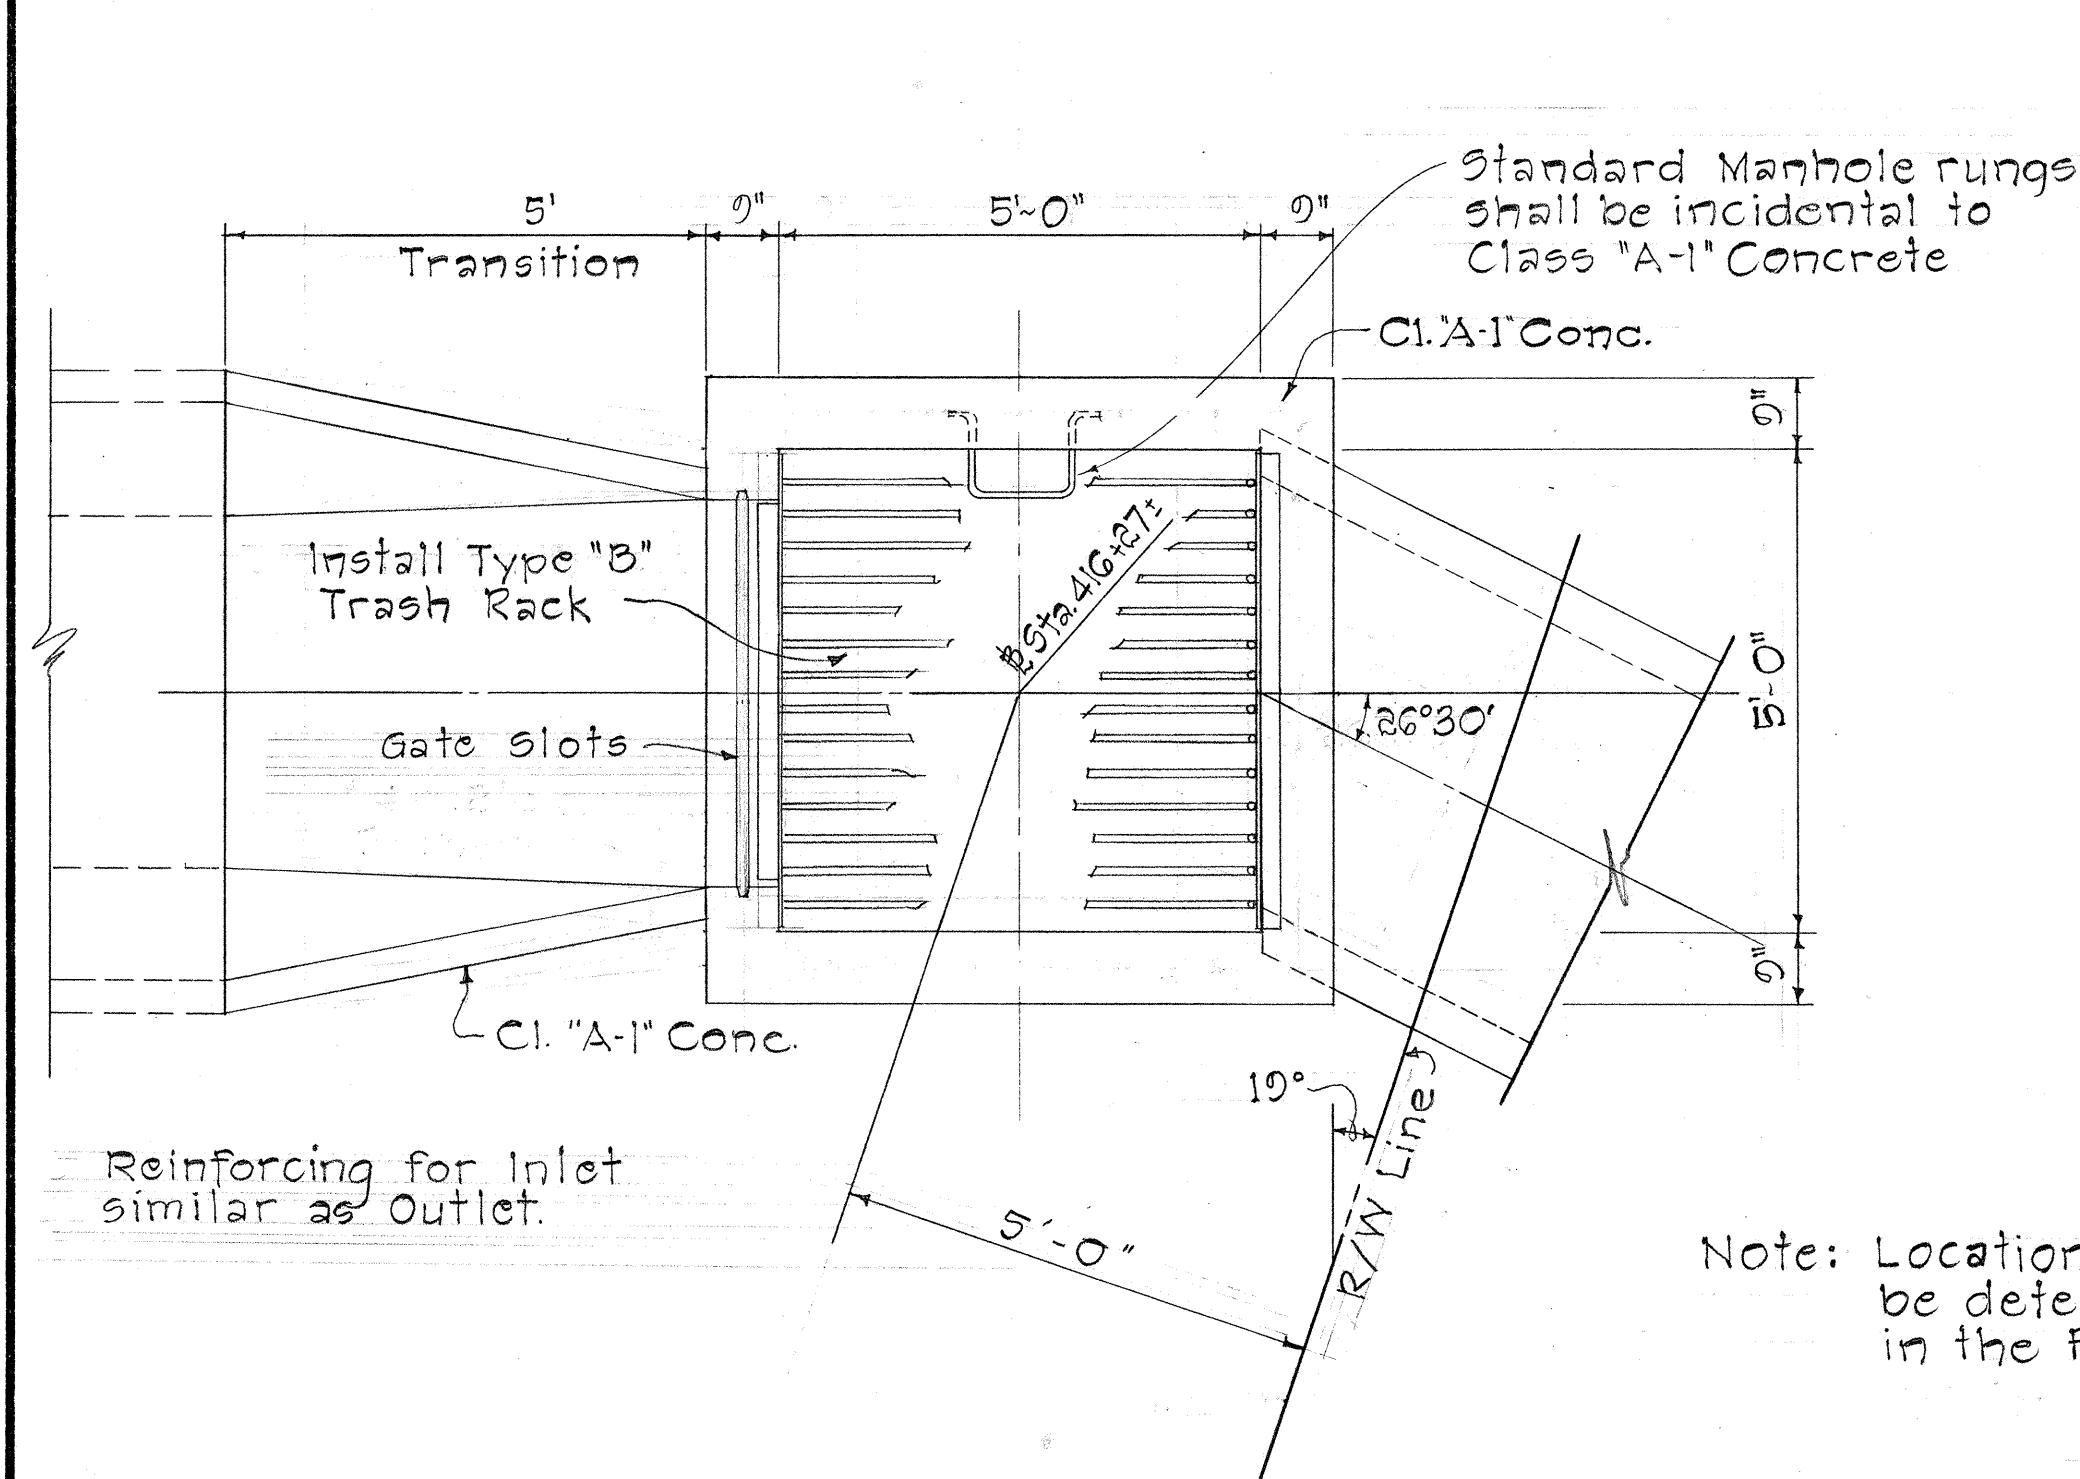

DETAIL OF INLET FOR SIPHON


Scale: 1/2" = 1'-0"

Standard Manhole rungs shall be incidental to Class "A-1" Concrete

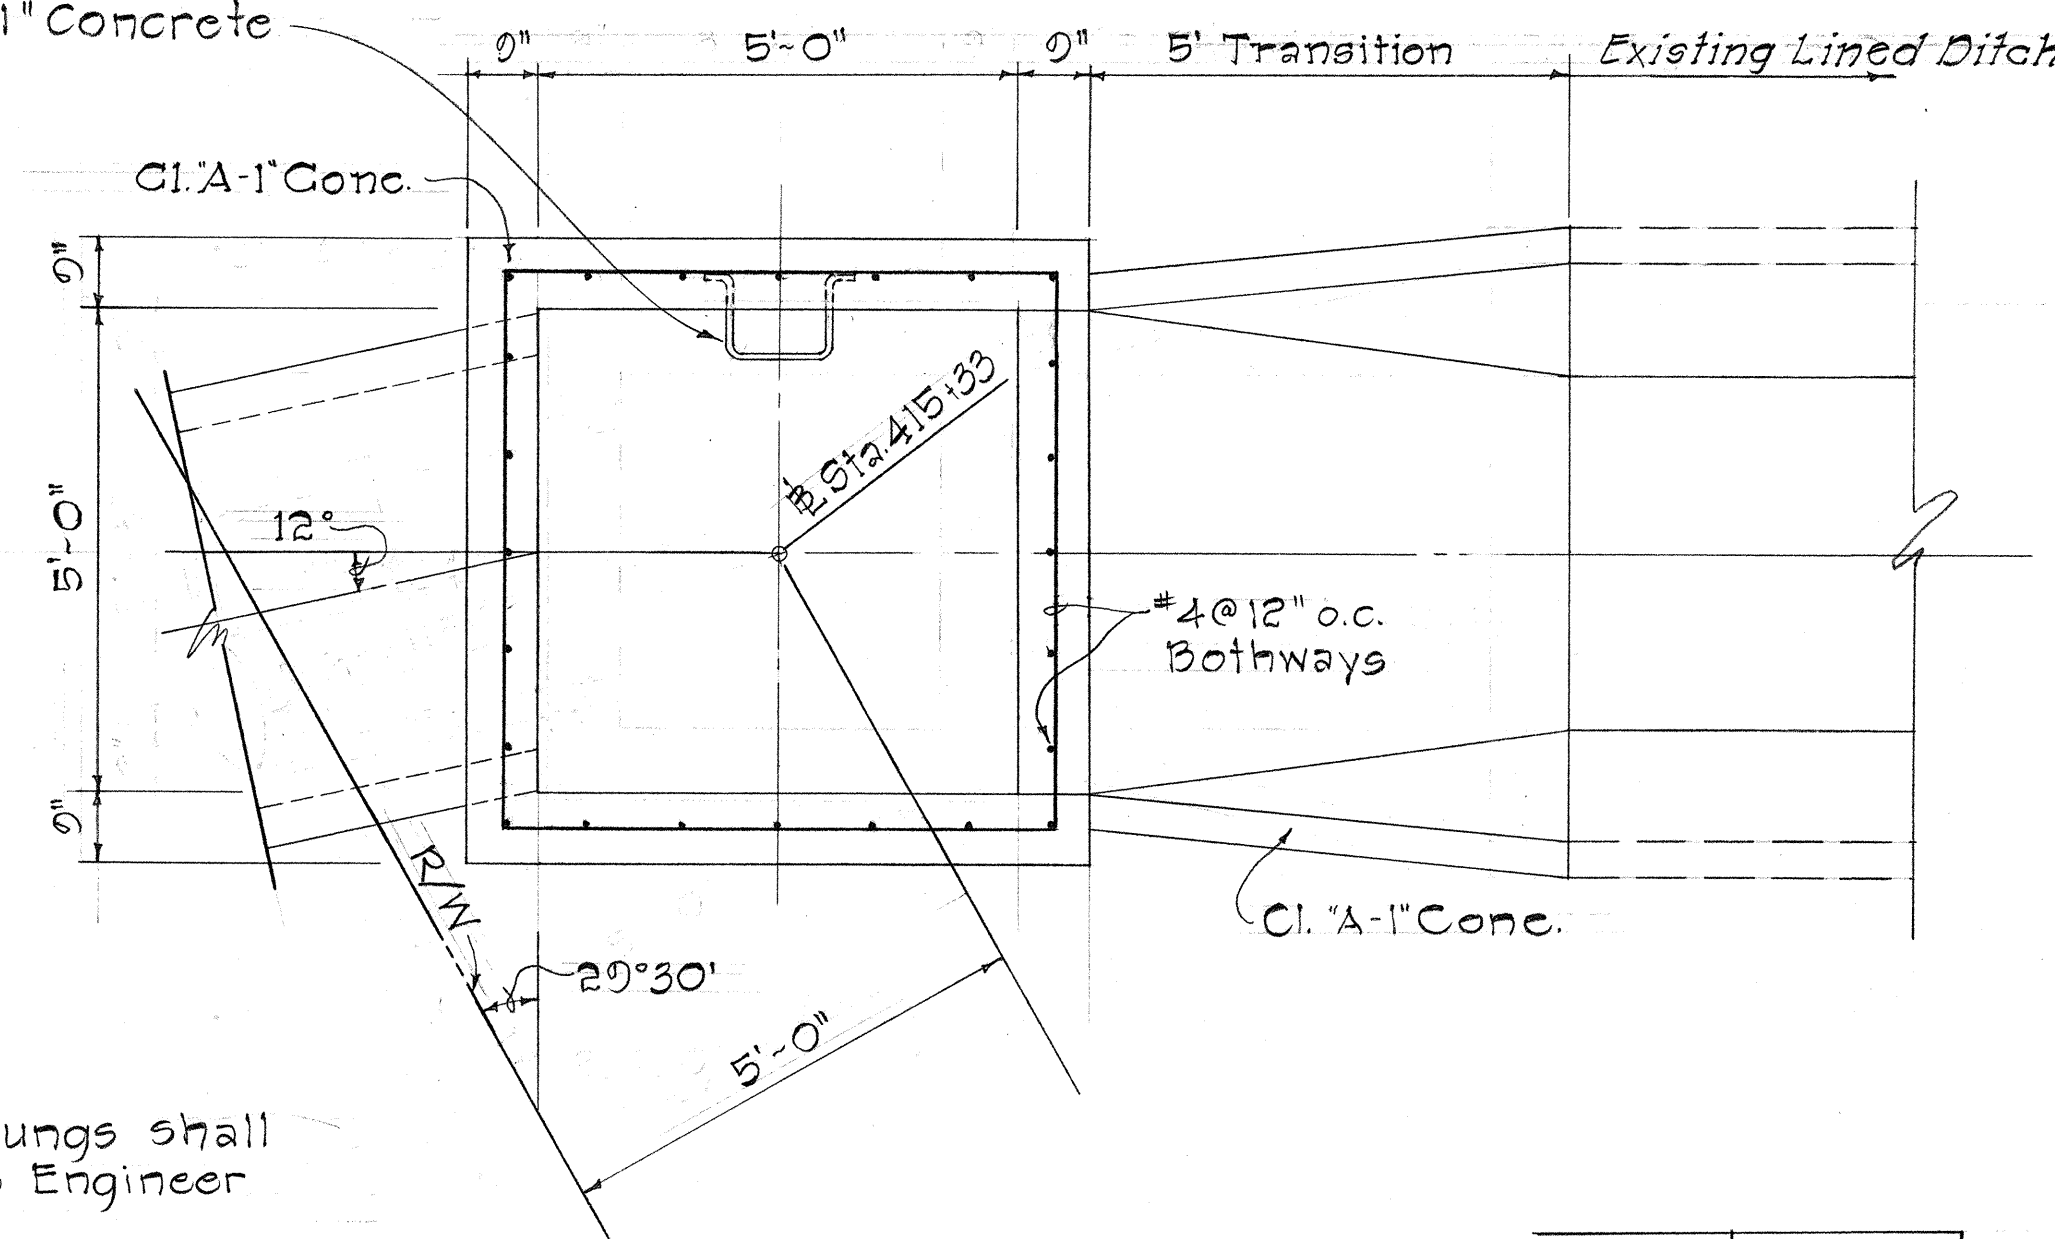


DETAIL OF OUTLET FOR SIPHON

Scale: 1/2" = 1'-0"

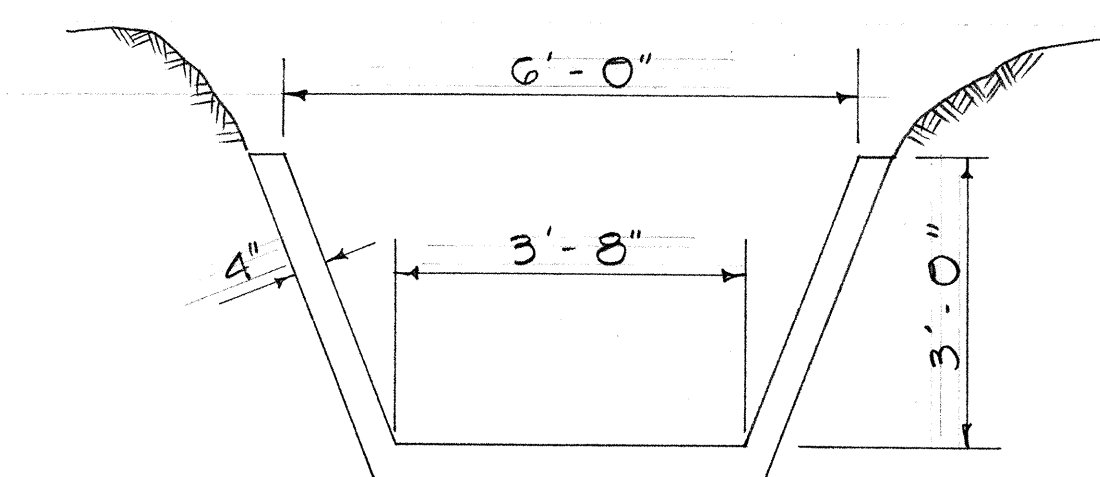

TYPICAL SECTION AT CONNECTION TO EXISTING LINED DITCH

Scale: 1/2" = 1'-0"

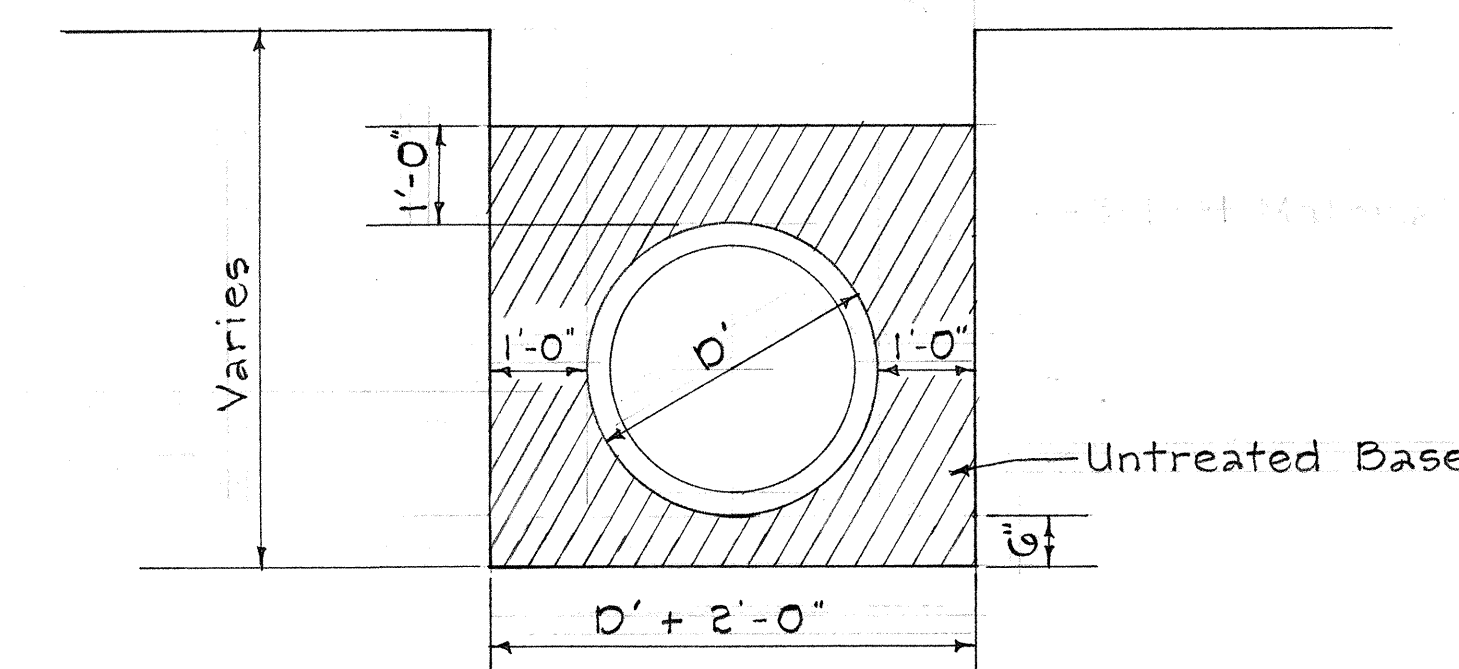



DETAIL OF UNTREATED BASE FOR PIPE FOUNDATION

Scale: 1/2" = 1'-0"





DETAILS OF 48" IRRIGATION SIPHON AT STA. 415 + 85±

STATE OF HAWAII	
DEPARTMENT OF TRANSPORTATION	
HIGHWAYS DIVISION	
IRRIGATION DETAILS	
48" IRRIGATION SIPHON	
AT STA. 415+85±	
INTERSTATE ROUTE H-1	
F.A.I. PROJ. NO. I-HI-1(22):5, Unit 2	
Scale: As Shown	Date: June, 1967
SHEET No. 9 OF 28 SHEETS	

FED. ROAD DIST. NO.	STATE	FED. AID PROJ. NO.	FISCAL YEAR	SHEET NO.	TOTAL SHEETS
HAWAII	HAW.	I-HI-1(22)-5 Unit 2	1967	39	99

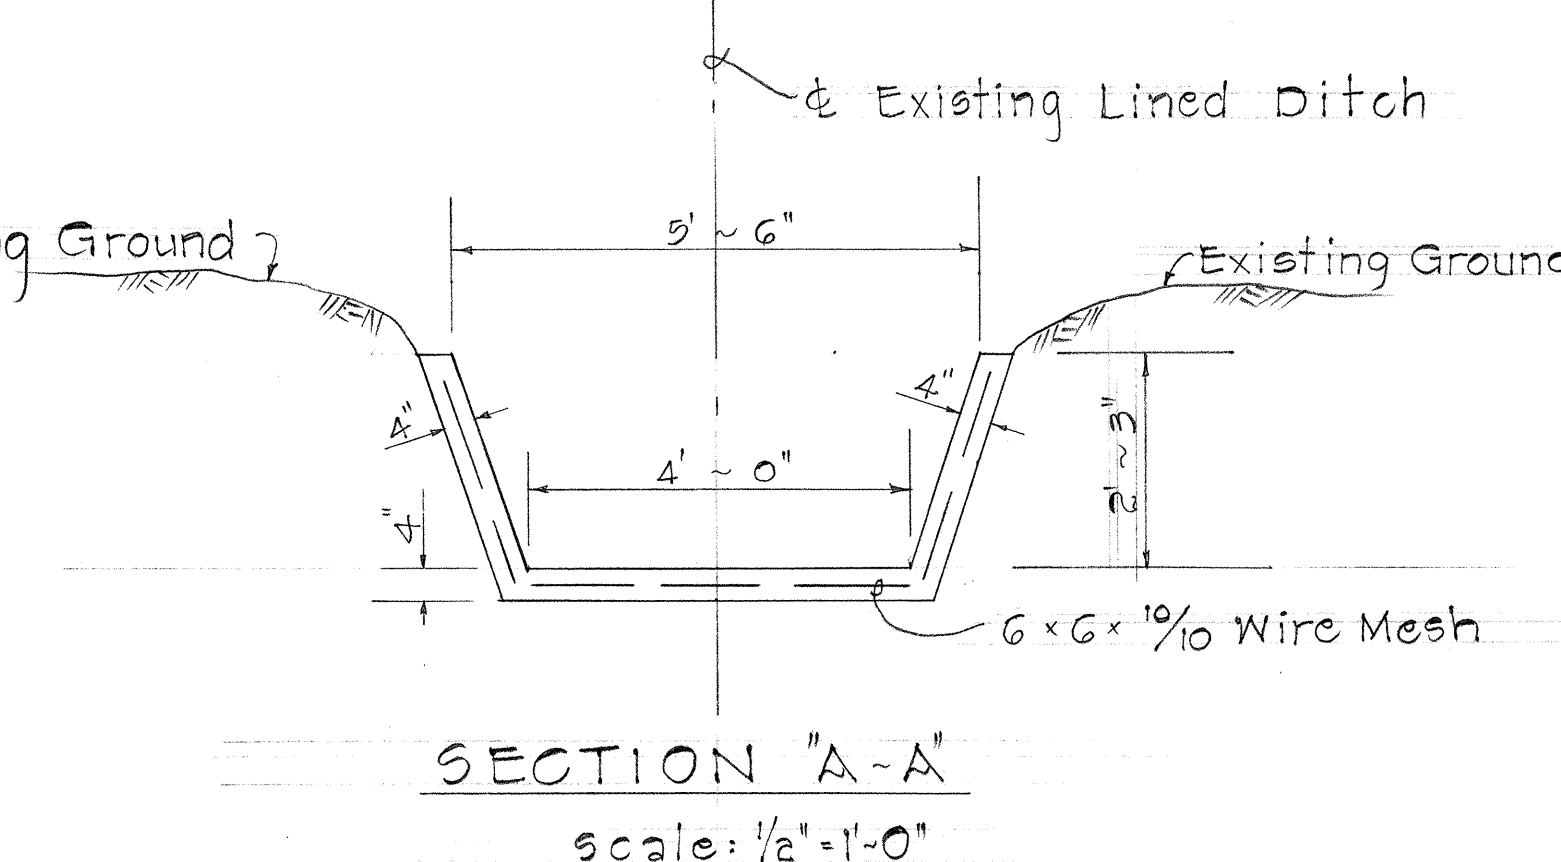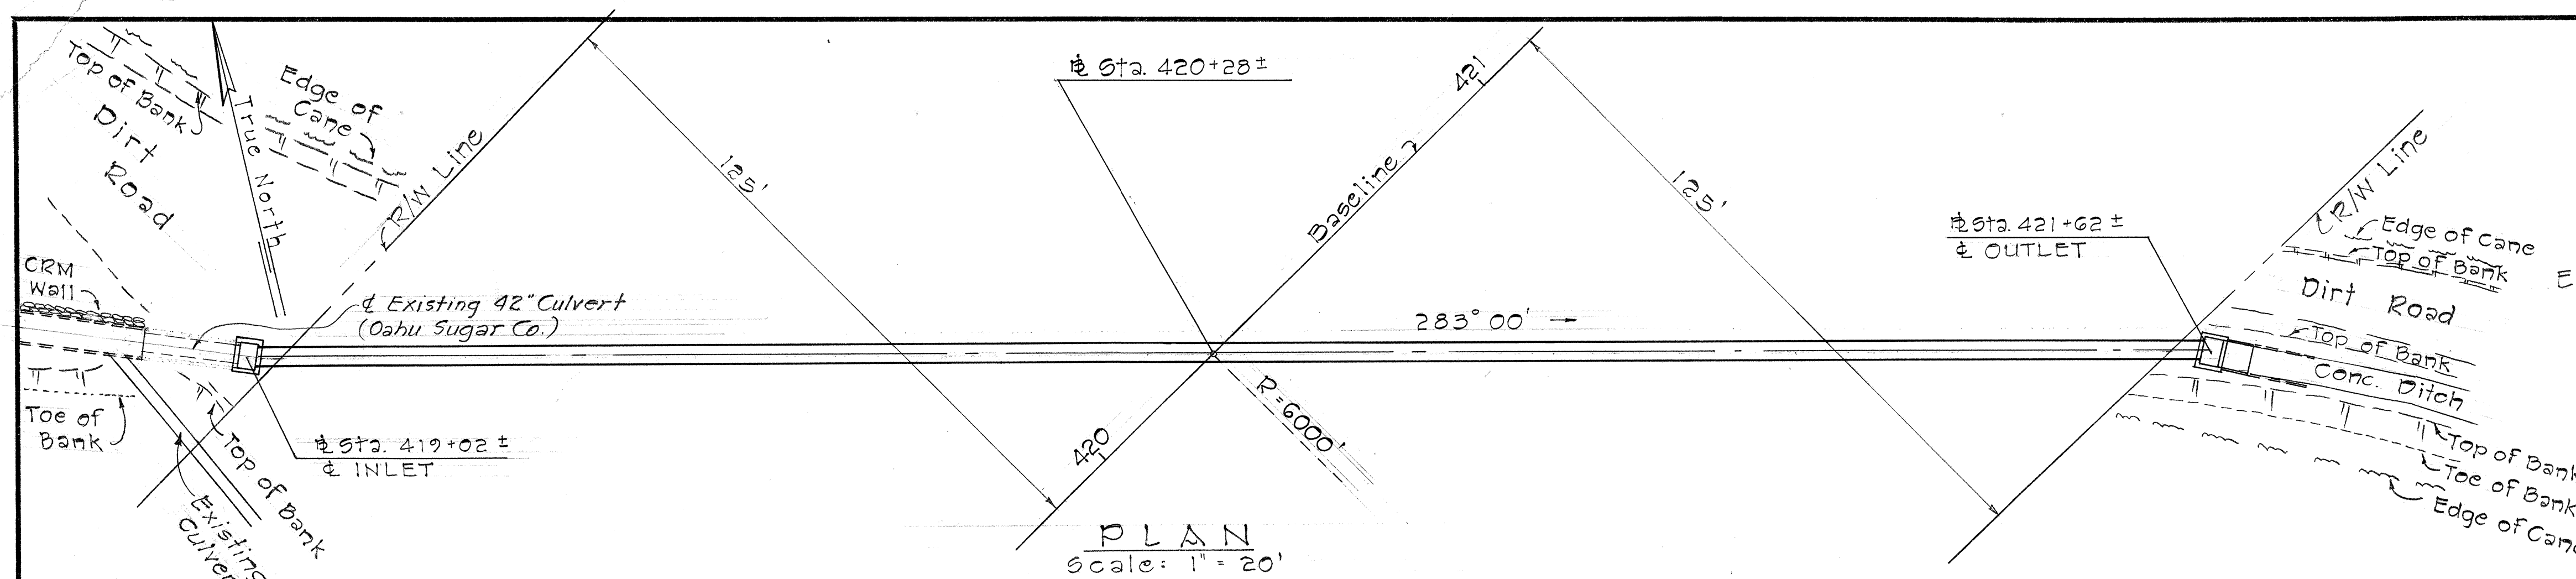


Note: Location of manhole rungs shall be determined by the Engineer in the field.

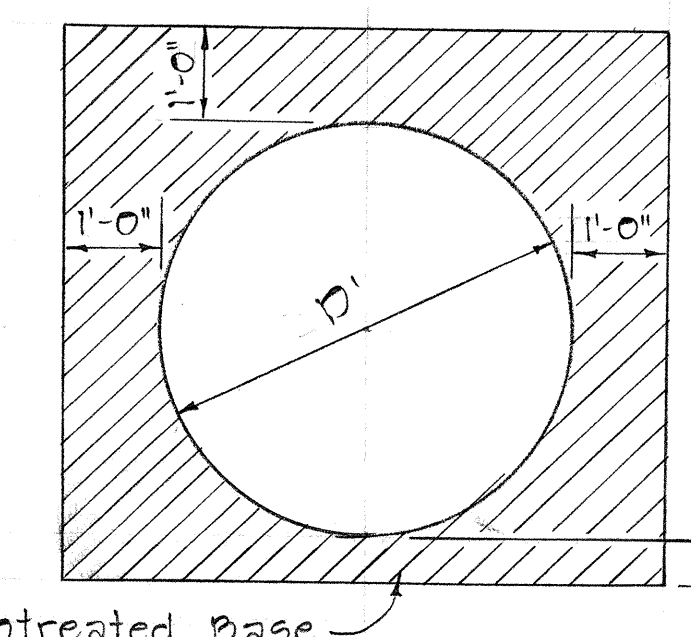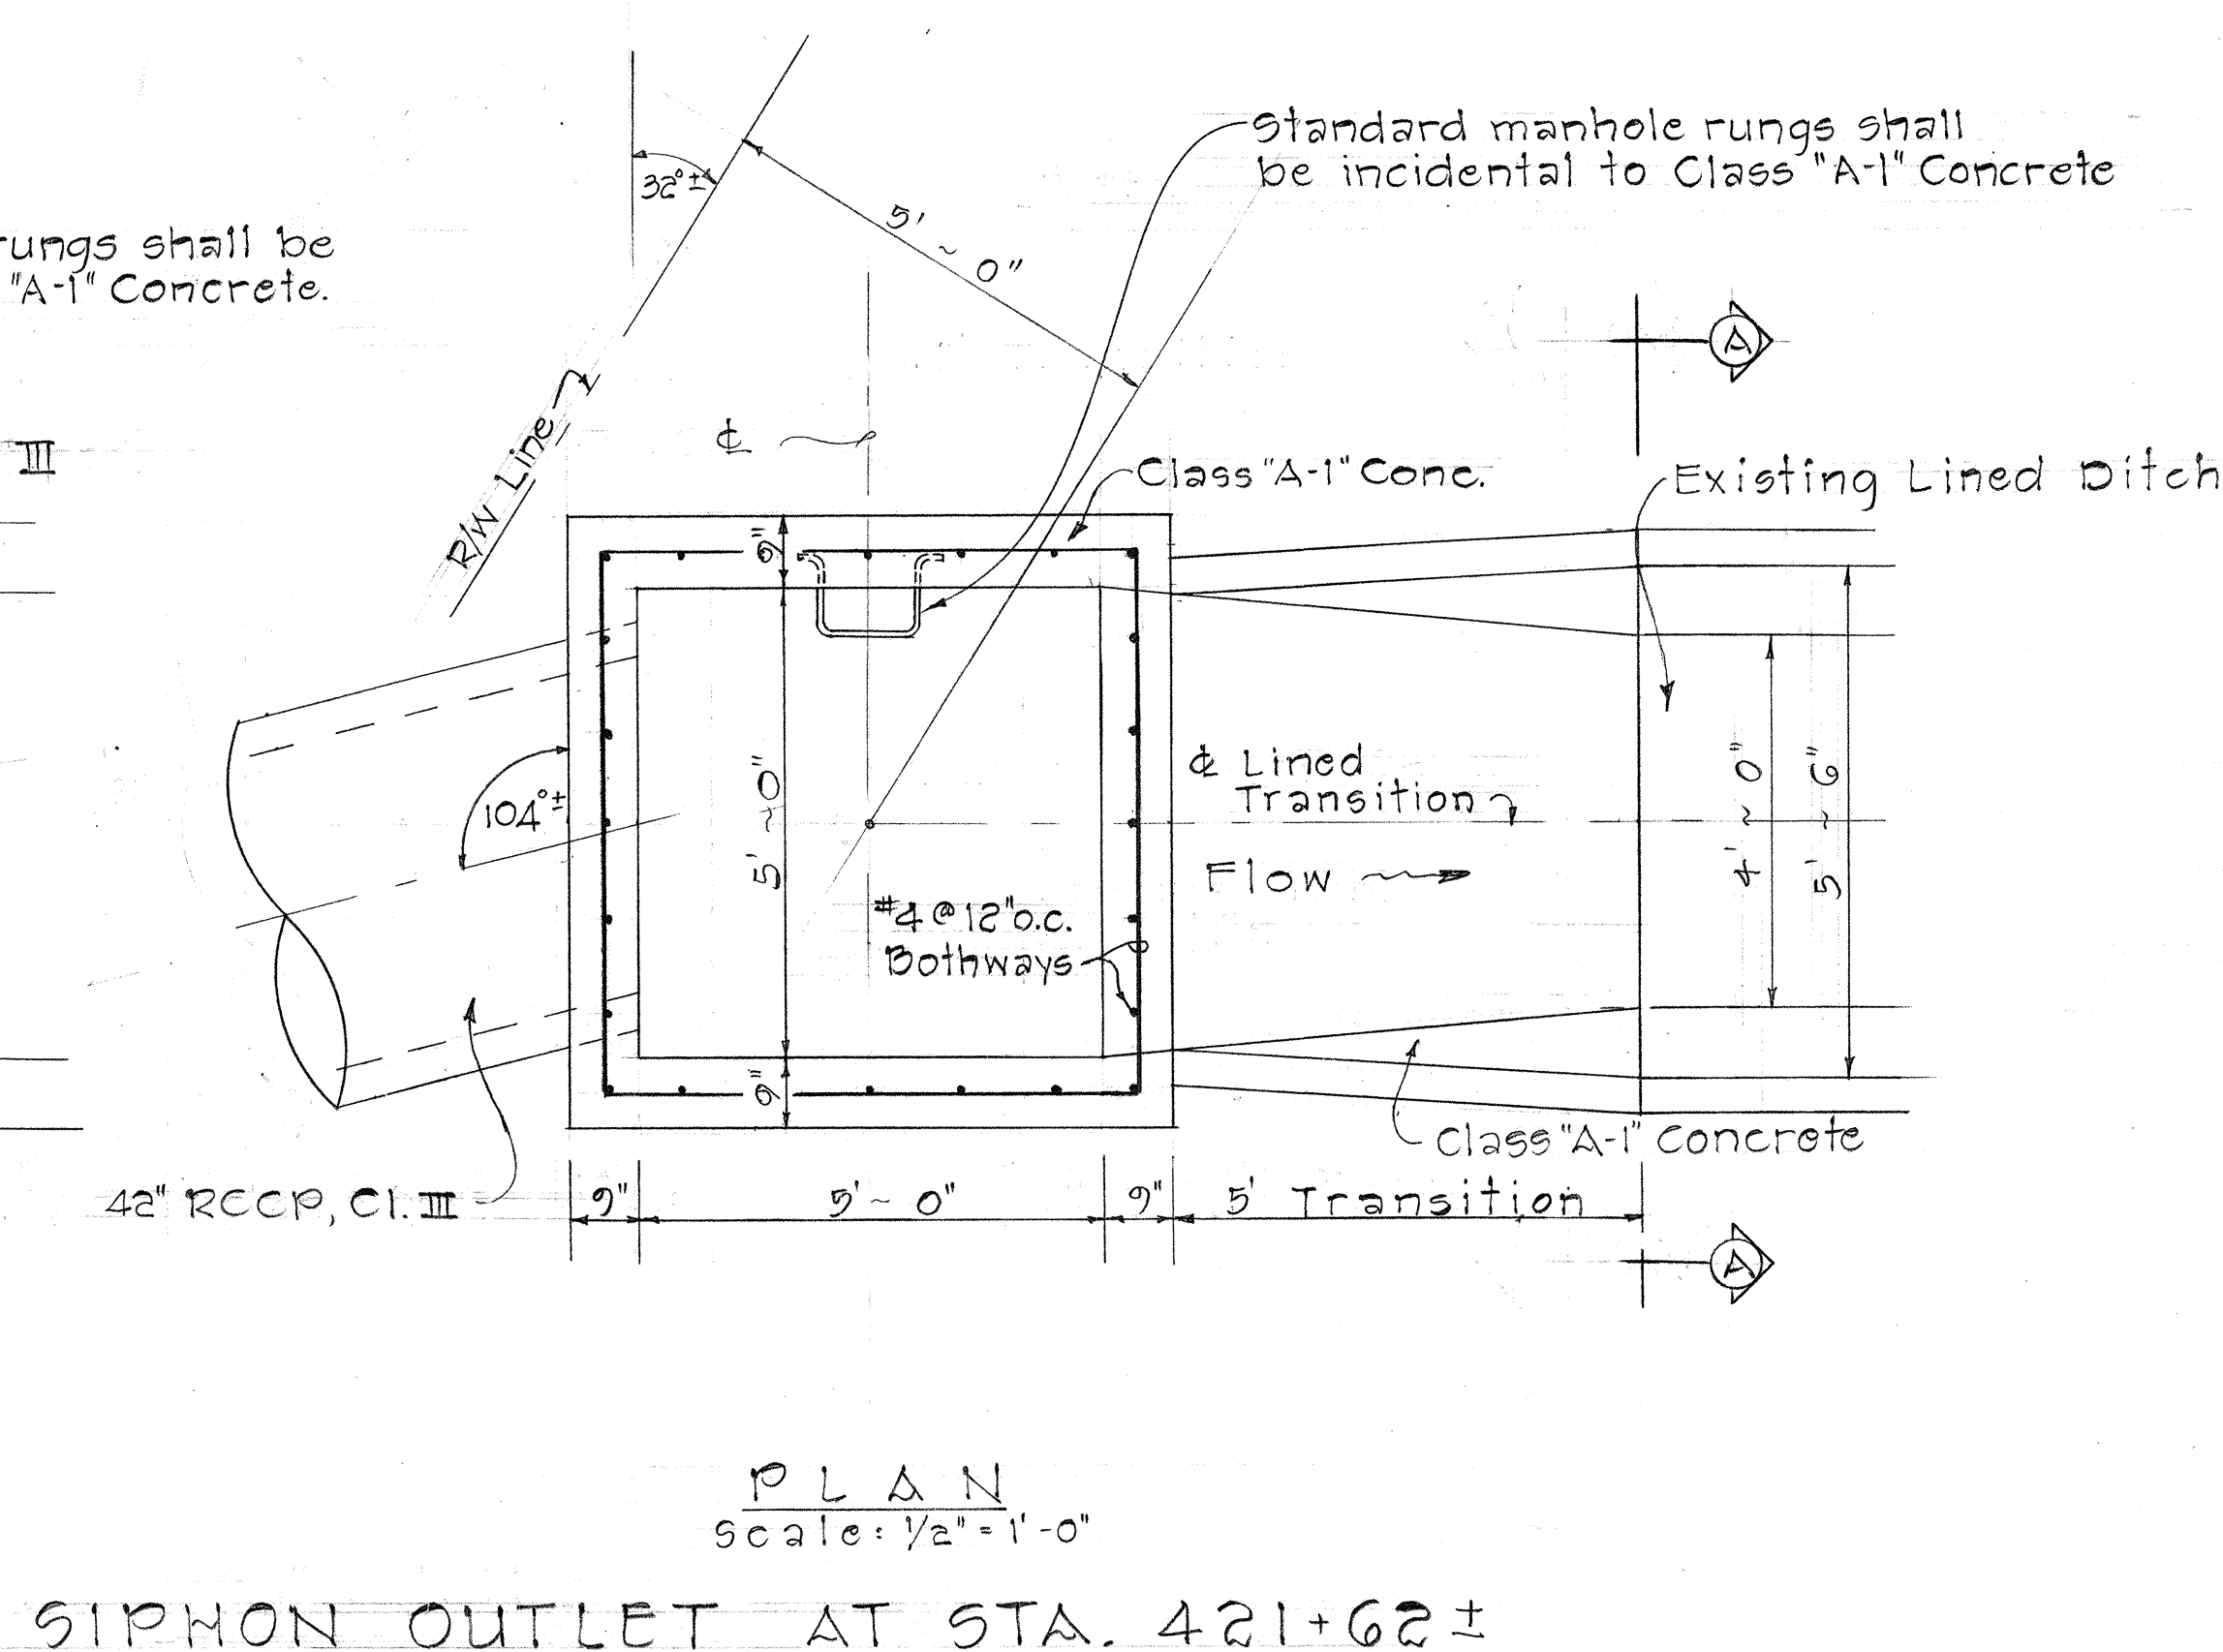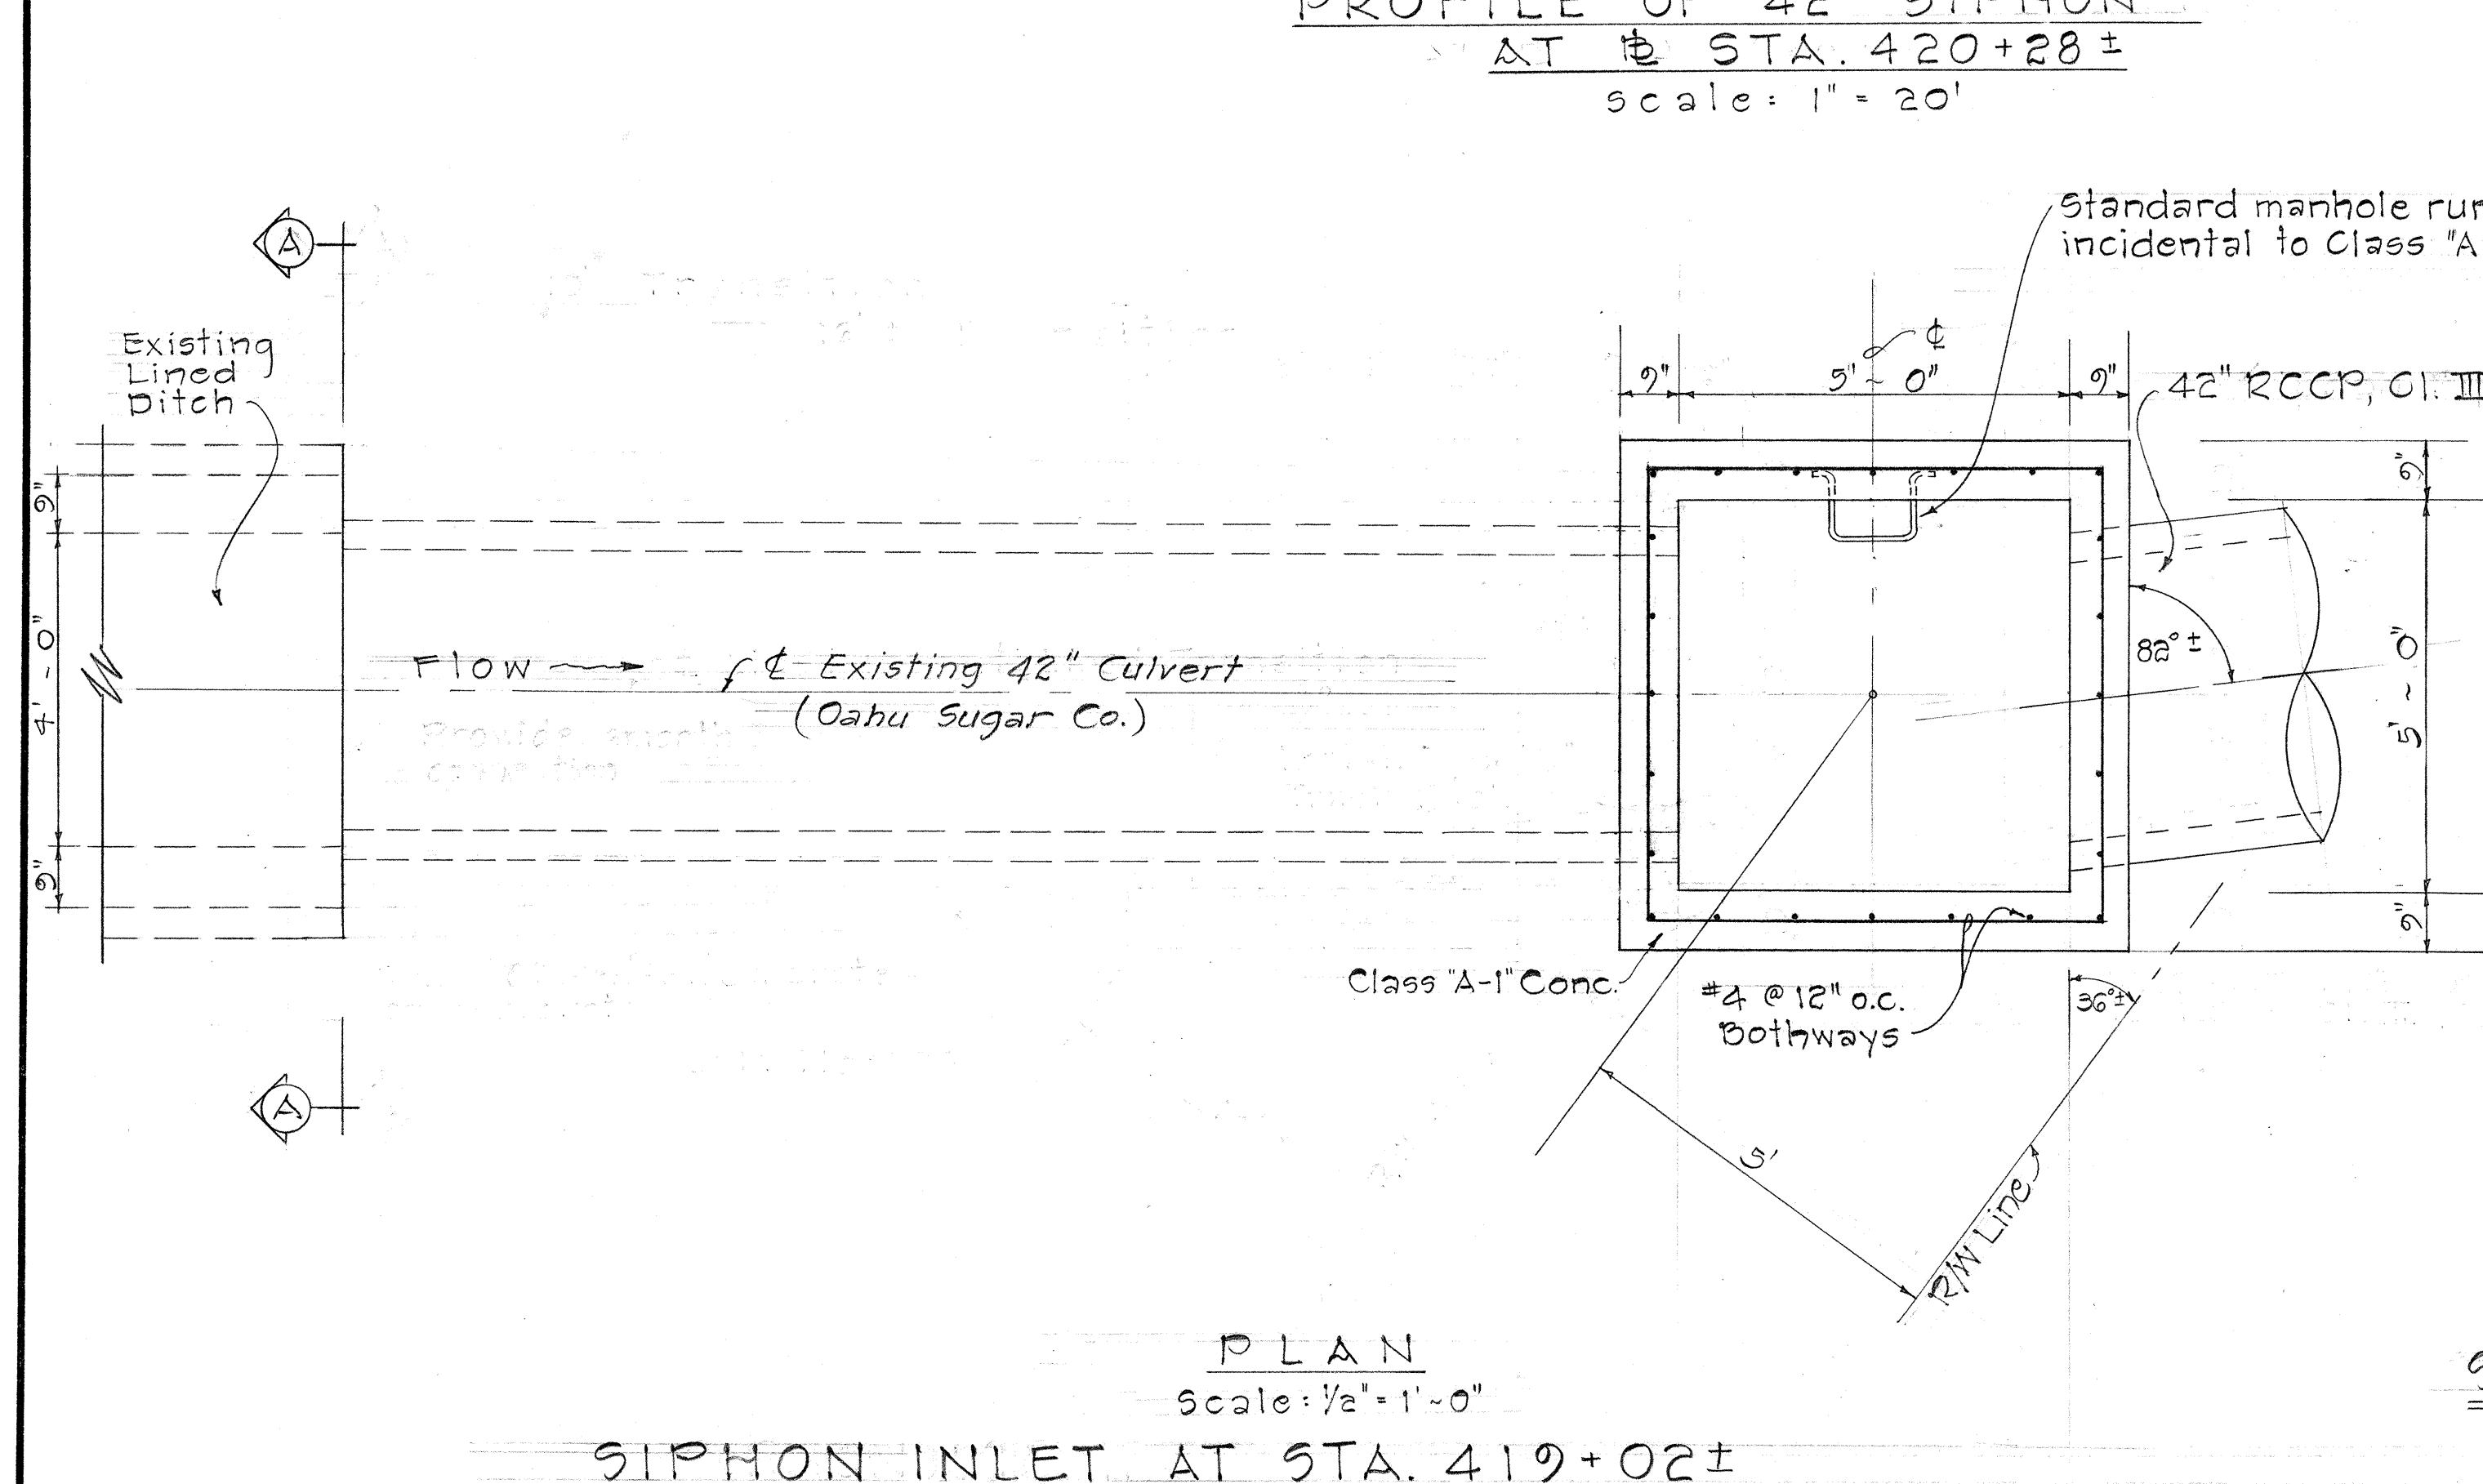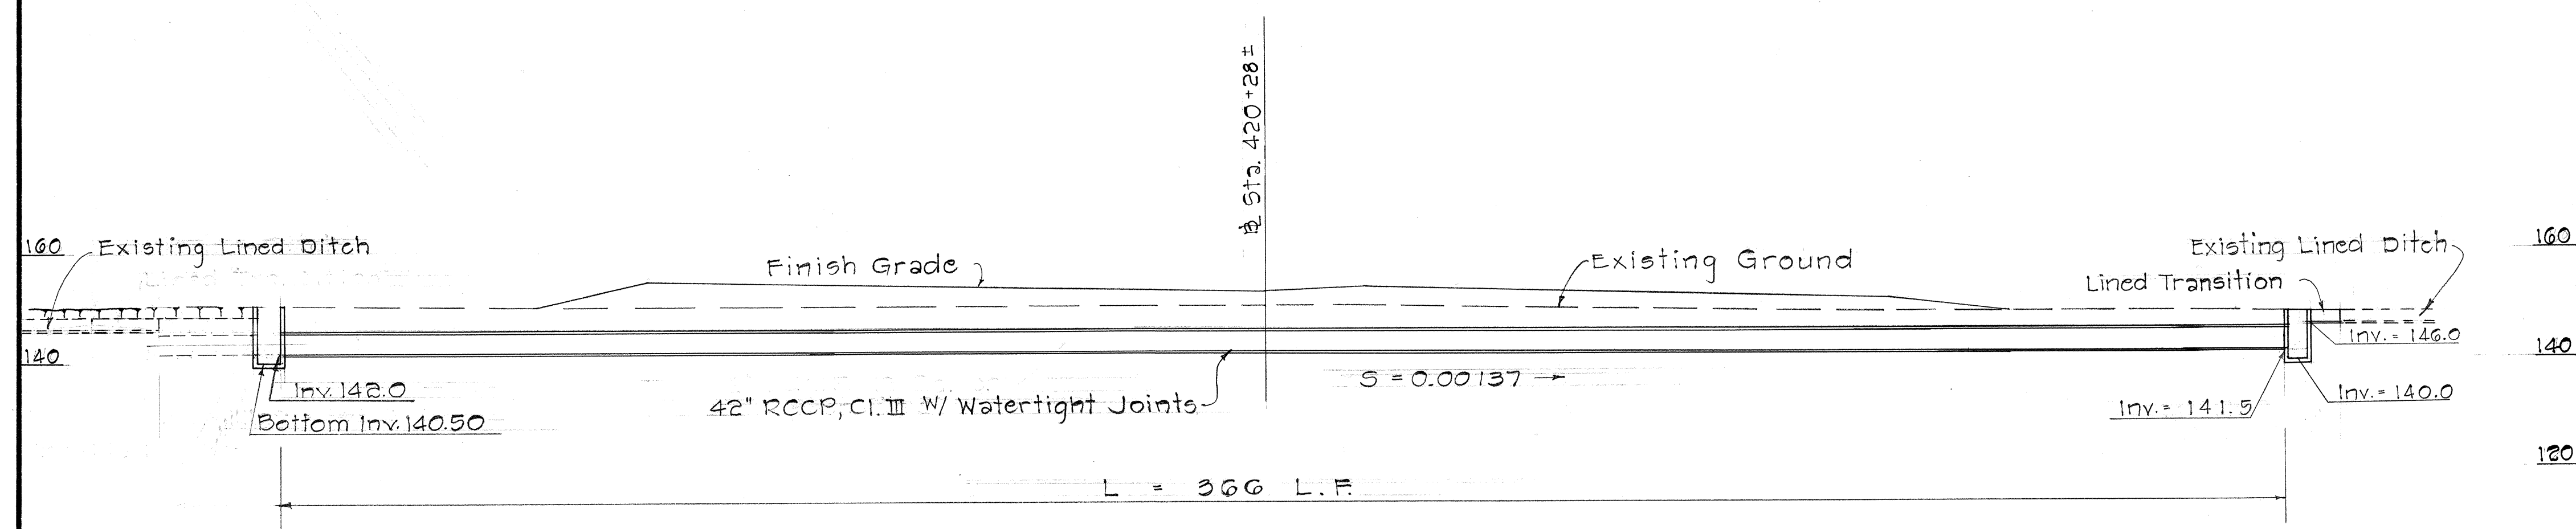

DETAIL OF UNTREATED BASE FOR PIPE FOUNDATION
Not to Scale

STATE OF HAWAII
DEPARTMENT OF TRANSPORTATION
HIGHWAYS DIVISION
IRRIGATION DETAILS
42-inch IRRIGATION SIPHON
AT STA. 420+28.2
INTERSTATE ROUTE H-1
F.A.1. PROJ. NO. I-HI-1(22)-5 Unit 2
Scale: As Shown Date: June, 1967
SHEET No. 10 OF 28 SHEETS

FED. ROAD DIST. NO.	STATE	FED. AID PROJ. NO.	FISCAL YEAR	SHEET NO.	TOTAL SHEETS
HAWAII	HAW.	I-HI-1(22)5 Unit 2	1967	40	77

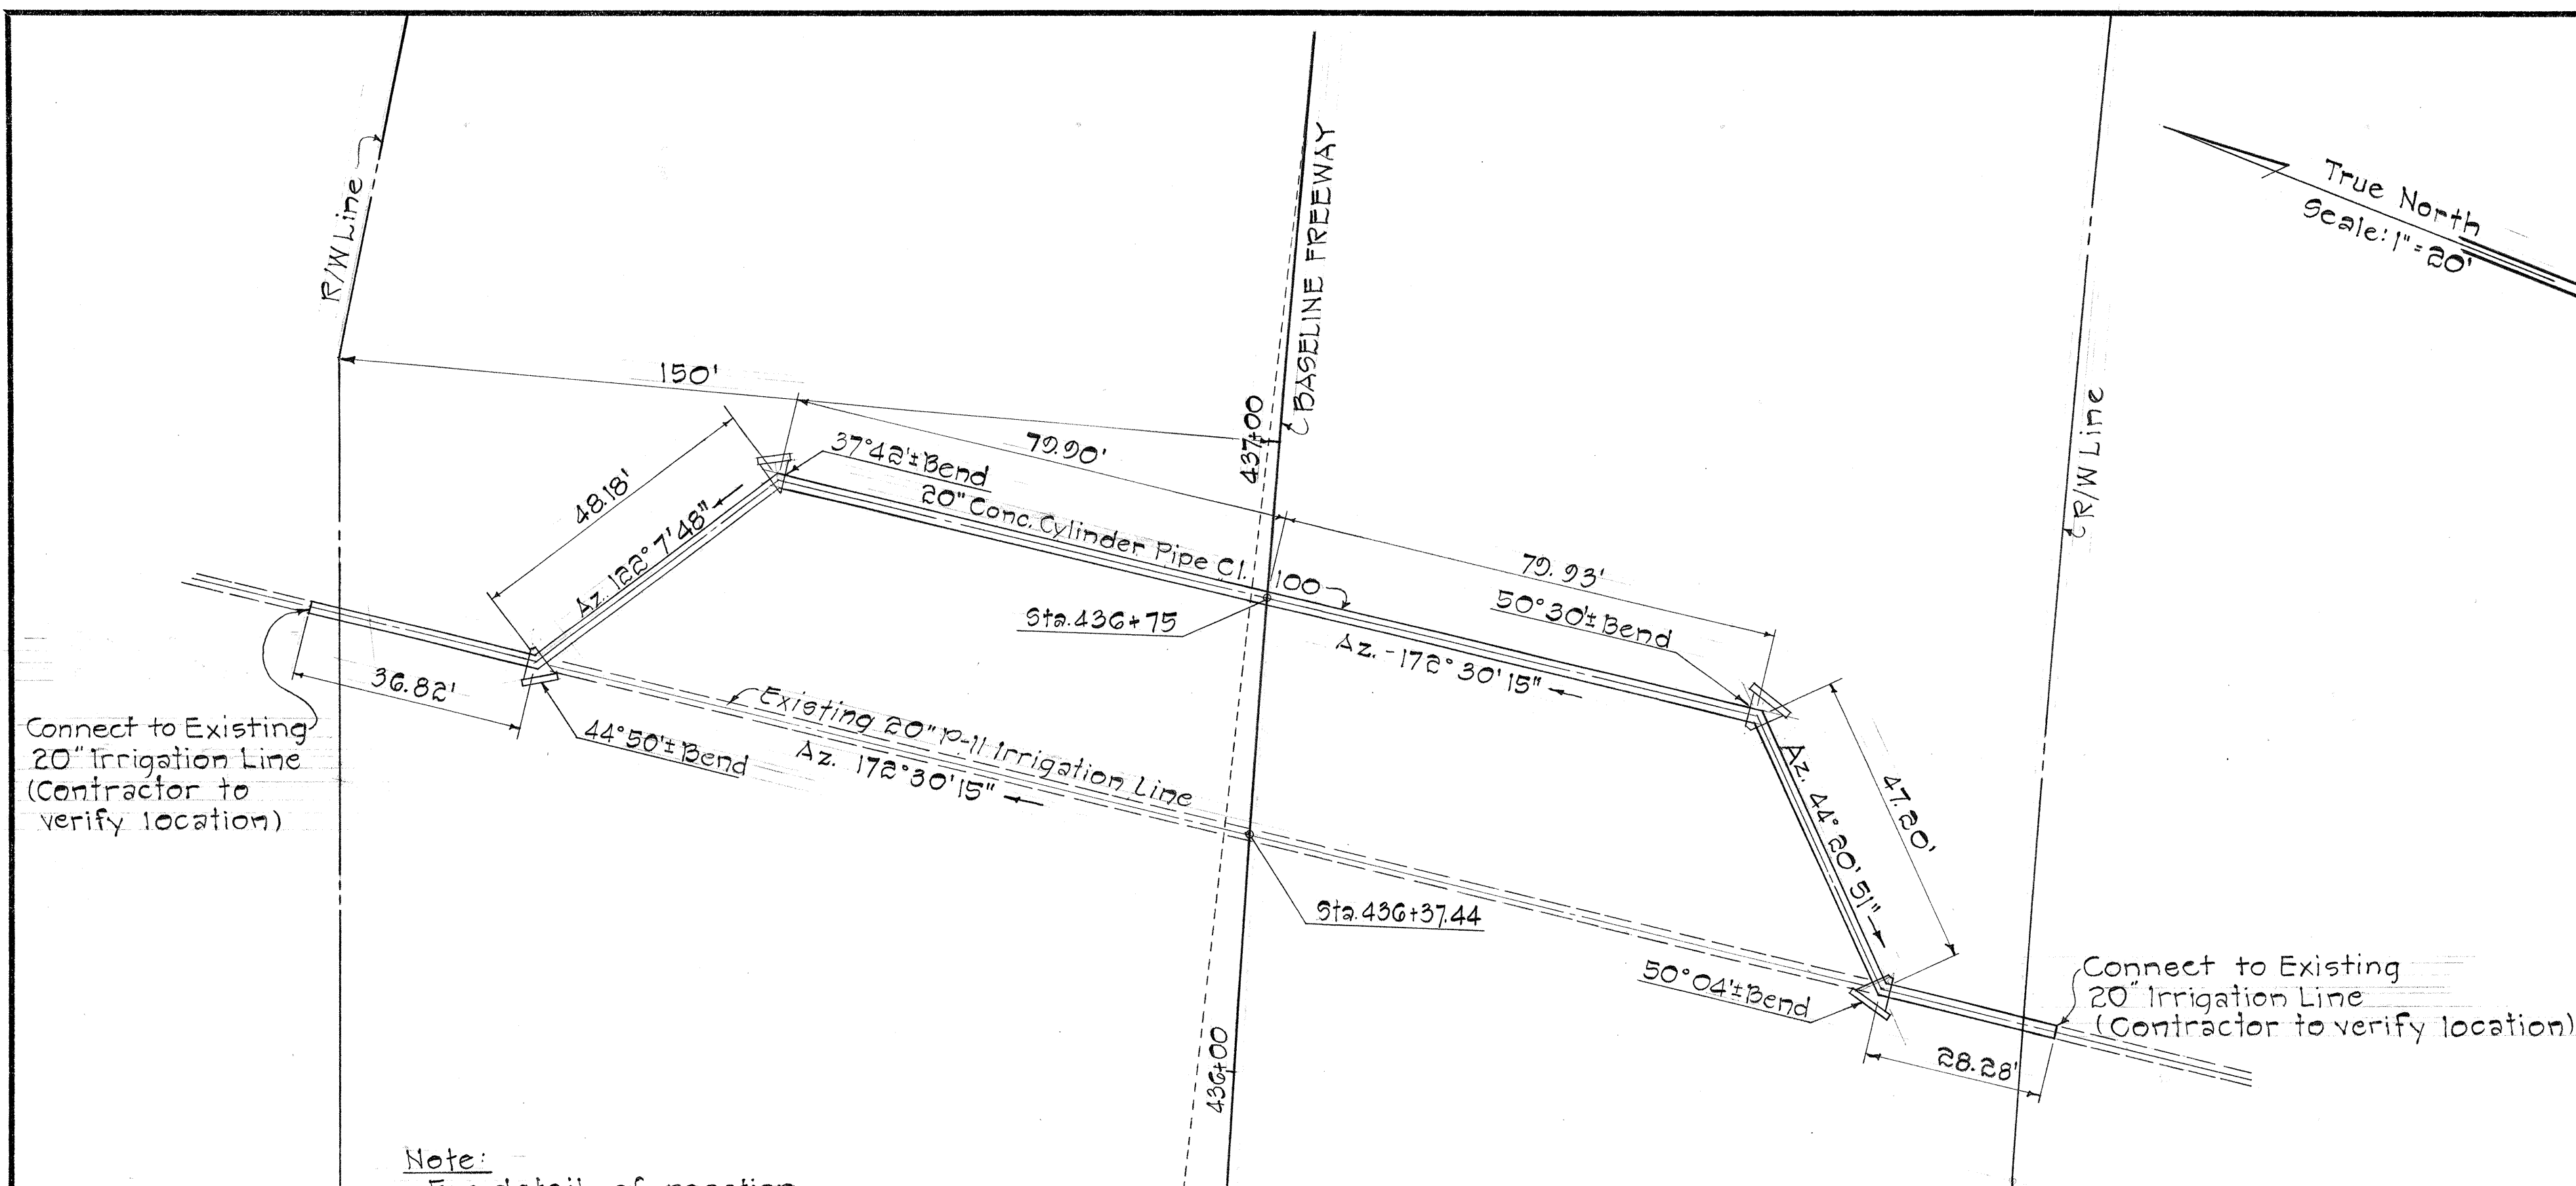


Note:
For detail of reaction
block see sht. no. 41

PLAN

ESTIMATED QUANTITIES

Structure Exc.	= 265 C.Y. 205
Class "B-1" Concrete	= 6± C.Y. 18.2
Reinforcing Steel	= 398 Lbs. 225
20" Conc. Cylinder Pipe, Cl. 100 (No Option)	= 300 L.F. 320
Untreated Base for Pipe Foundation	= 113± C.Y. 124
GRP	= 33 C.Y.

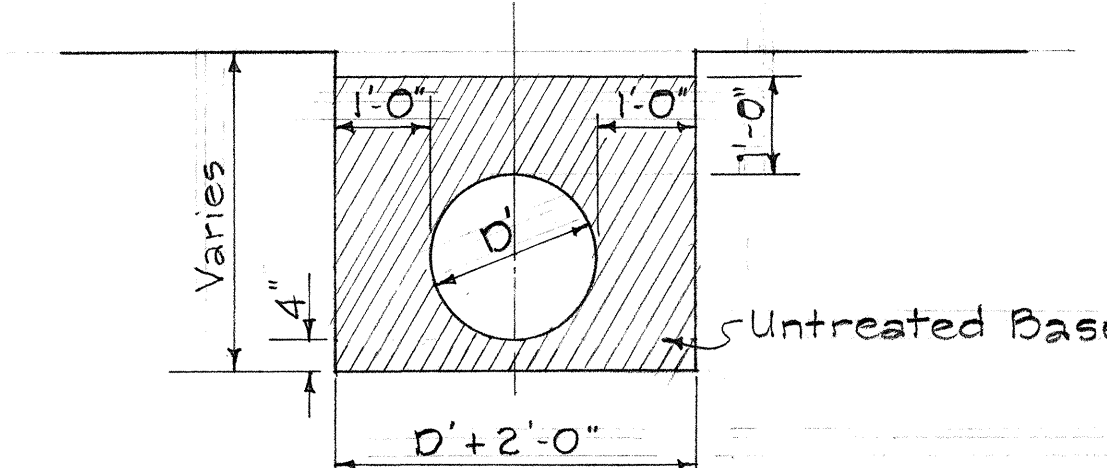


DETAIL OF UNTREATED BASE
FOR PIPE FOUNDATION

Scale: 1/2" = 1'-0"

NOTE:

Pipe tested at a hydrostatic
pressure of 100 p.s.i.

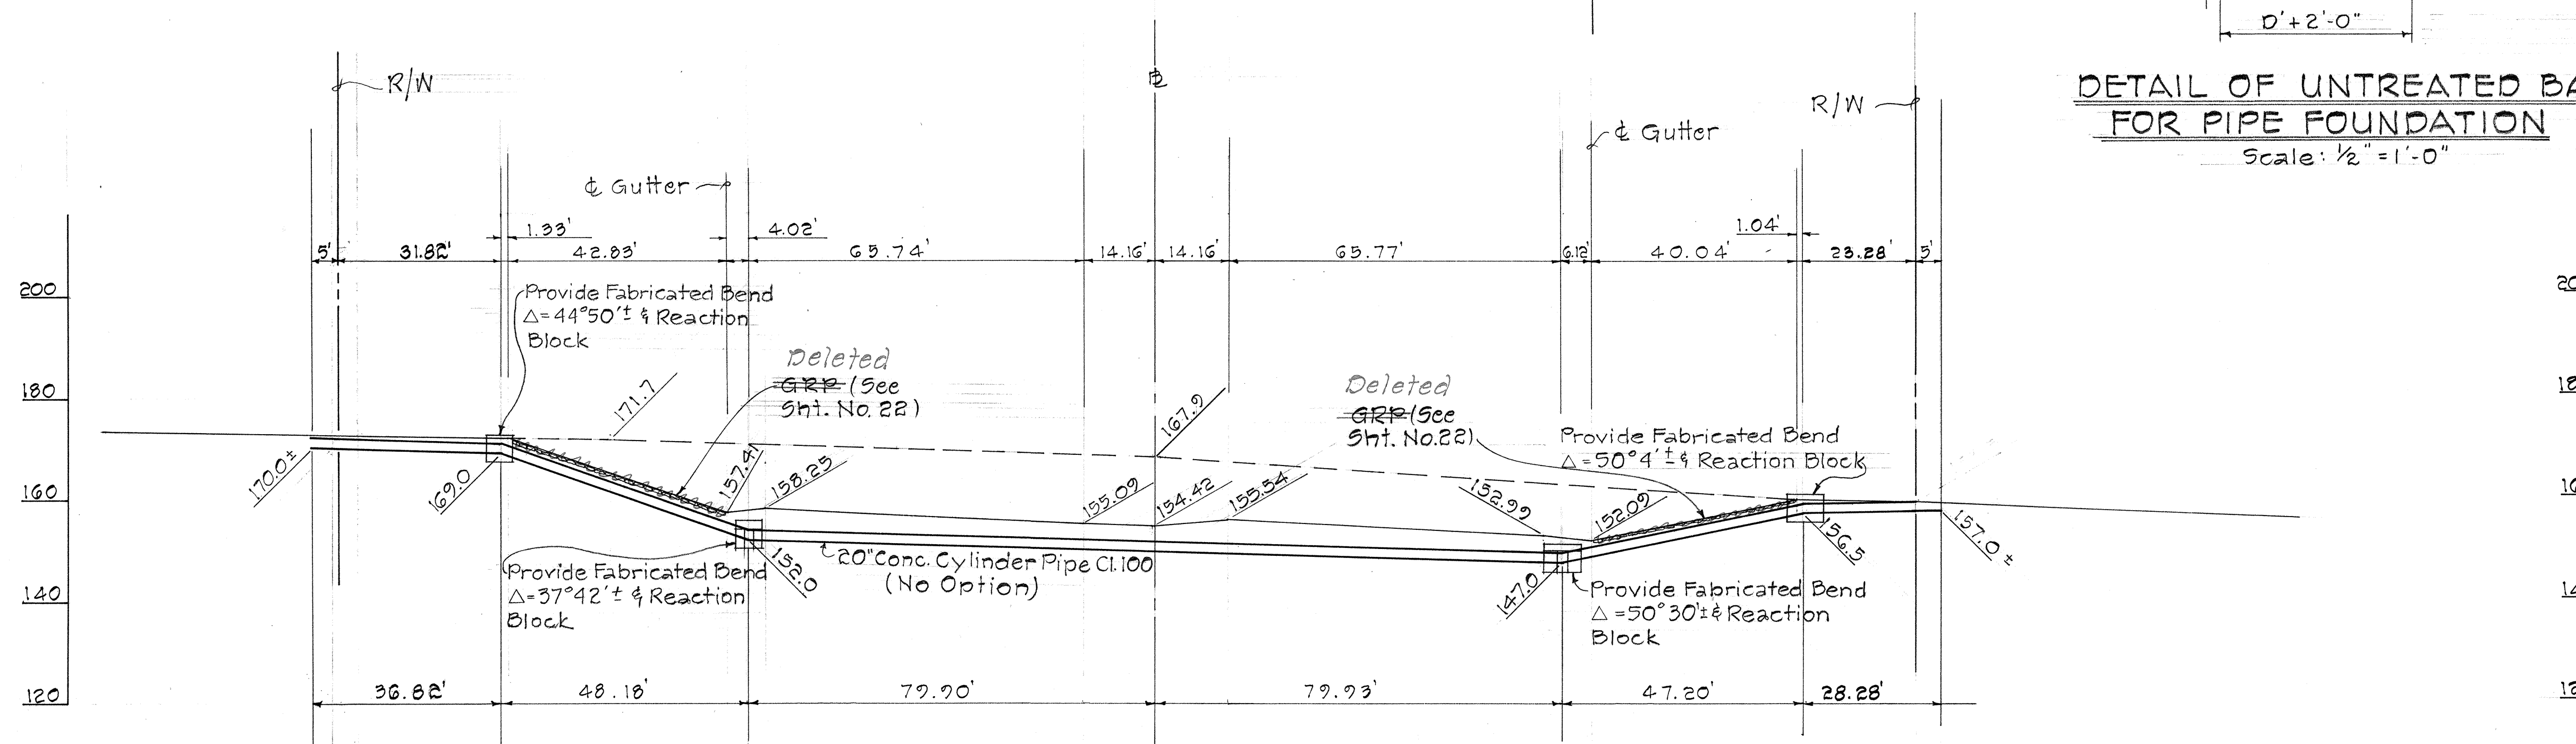

PROFILE OF 20 in. IRRIGATION PIPE LINE - P II ± STA. 436+75

Scale: 1" = 20'

STATE OF HAWAII
DEPARTMENT OF TRANSPORTATION
HIGHWAYS DIVISION

IRRIGATION DETAILS






RELOCATION OF P-II 20" IRRIGATION
PIPE AT STA. 436+75

INTERSTATE ROUTE H-1
F.A.I. PROJ. NO. I-HI-1(22)5 Unit 2

Scale: As Shown Date: June, 1967

SHEET No. 11 OF 28 SHEETS

FED. ROAD DIST. NO.	STATE	FED. AID PROJ. NO.	FISCAL YEAR	SHEET NO.	TOTAL SHEETS
HAWAII	HAW.	I-HI-1(22)S Unit 2	1967	41	77

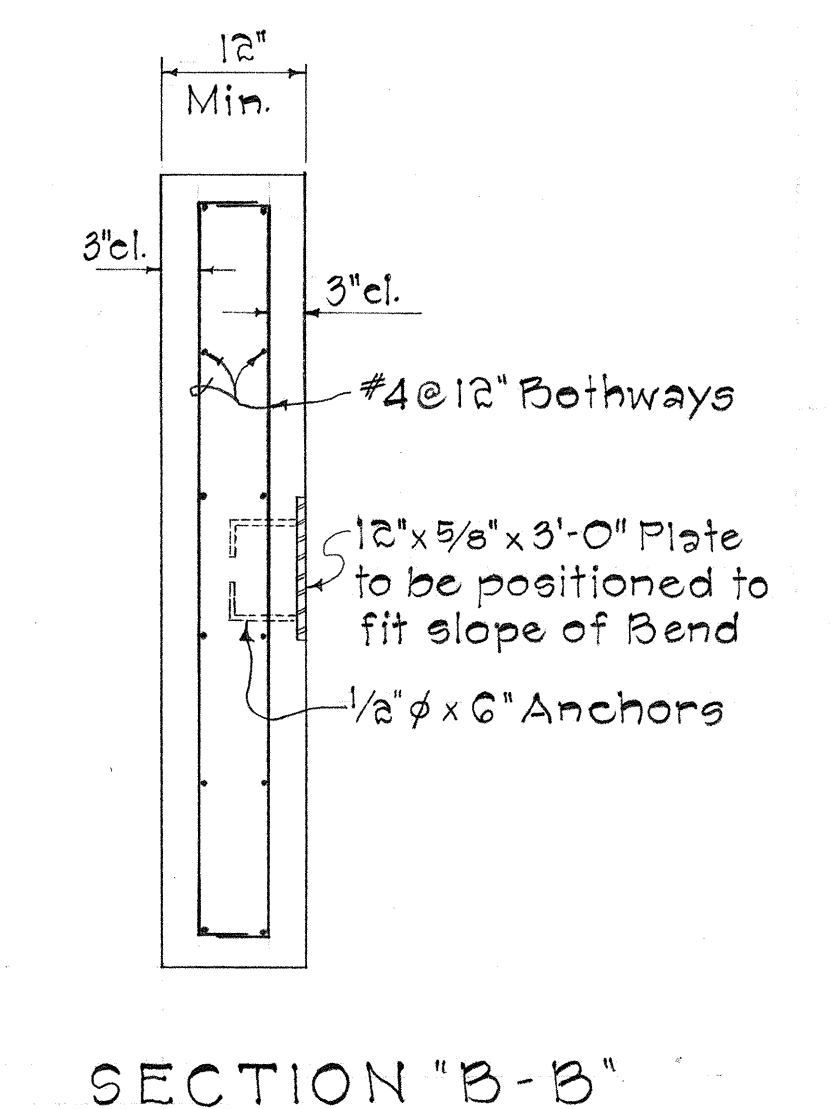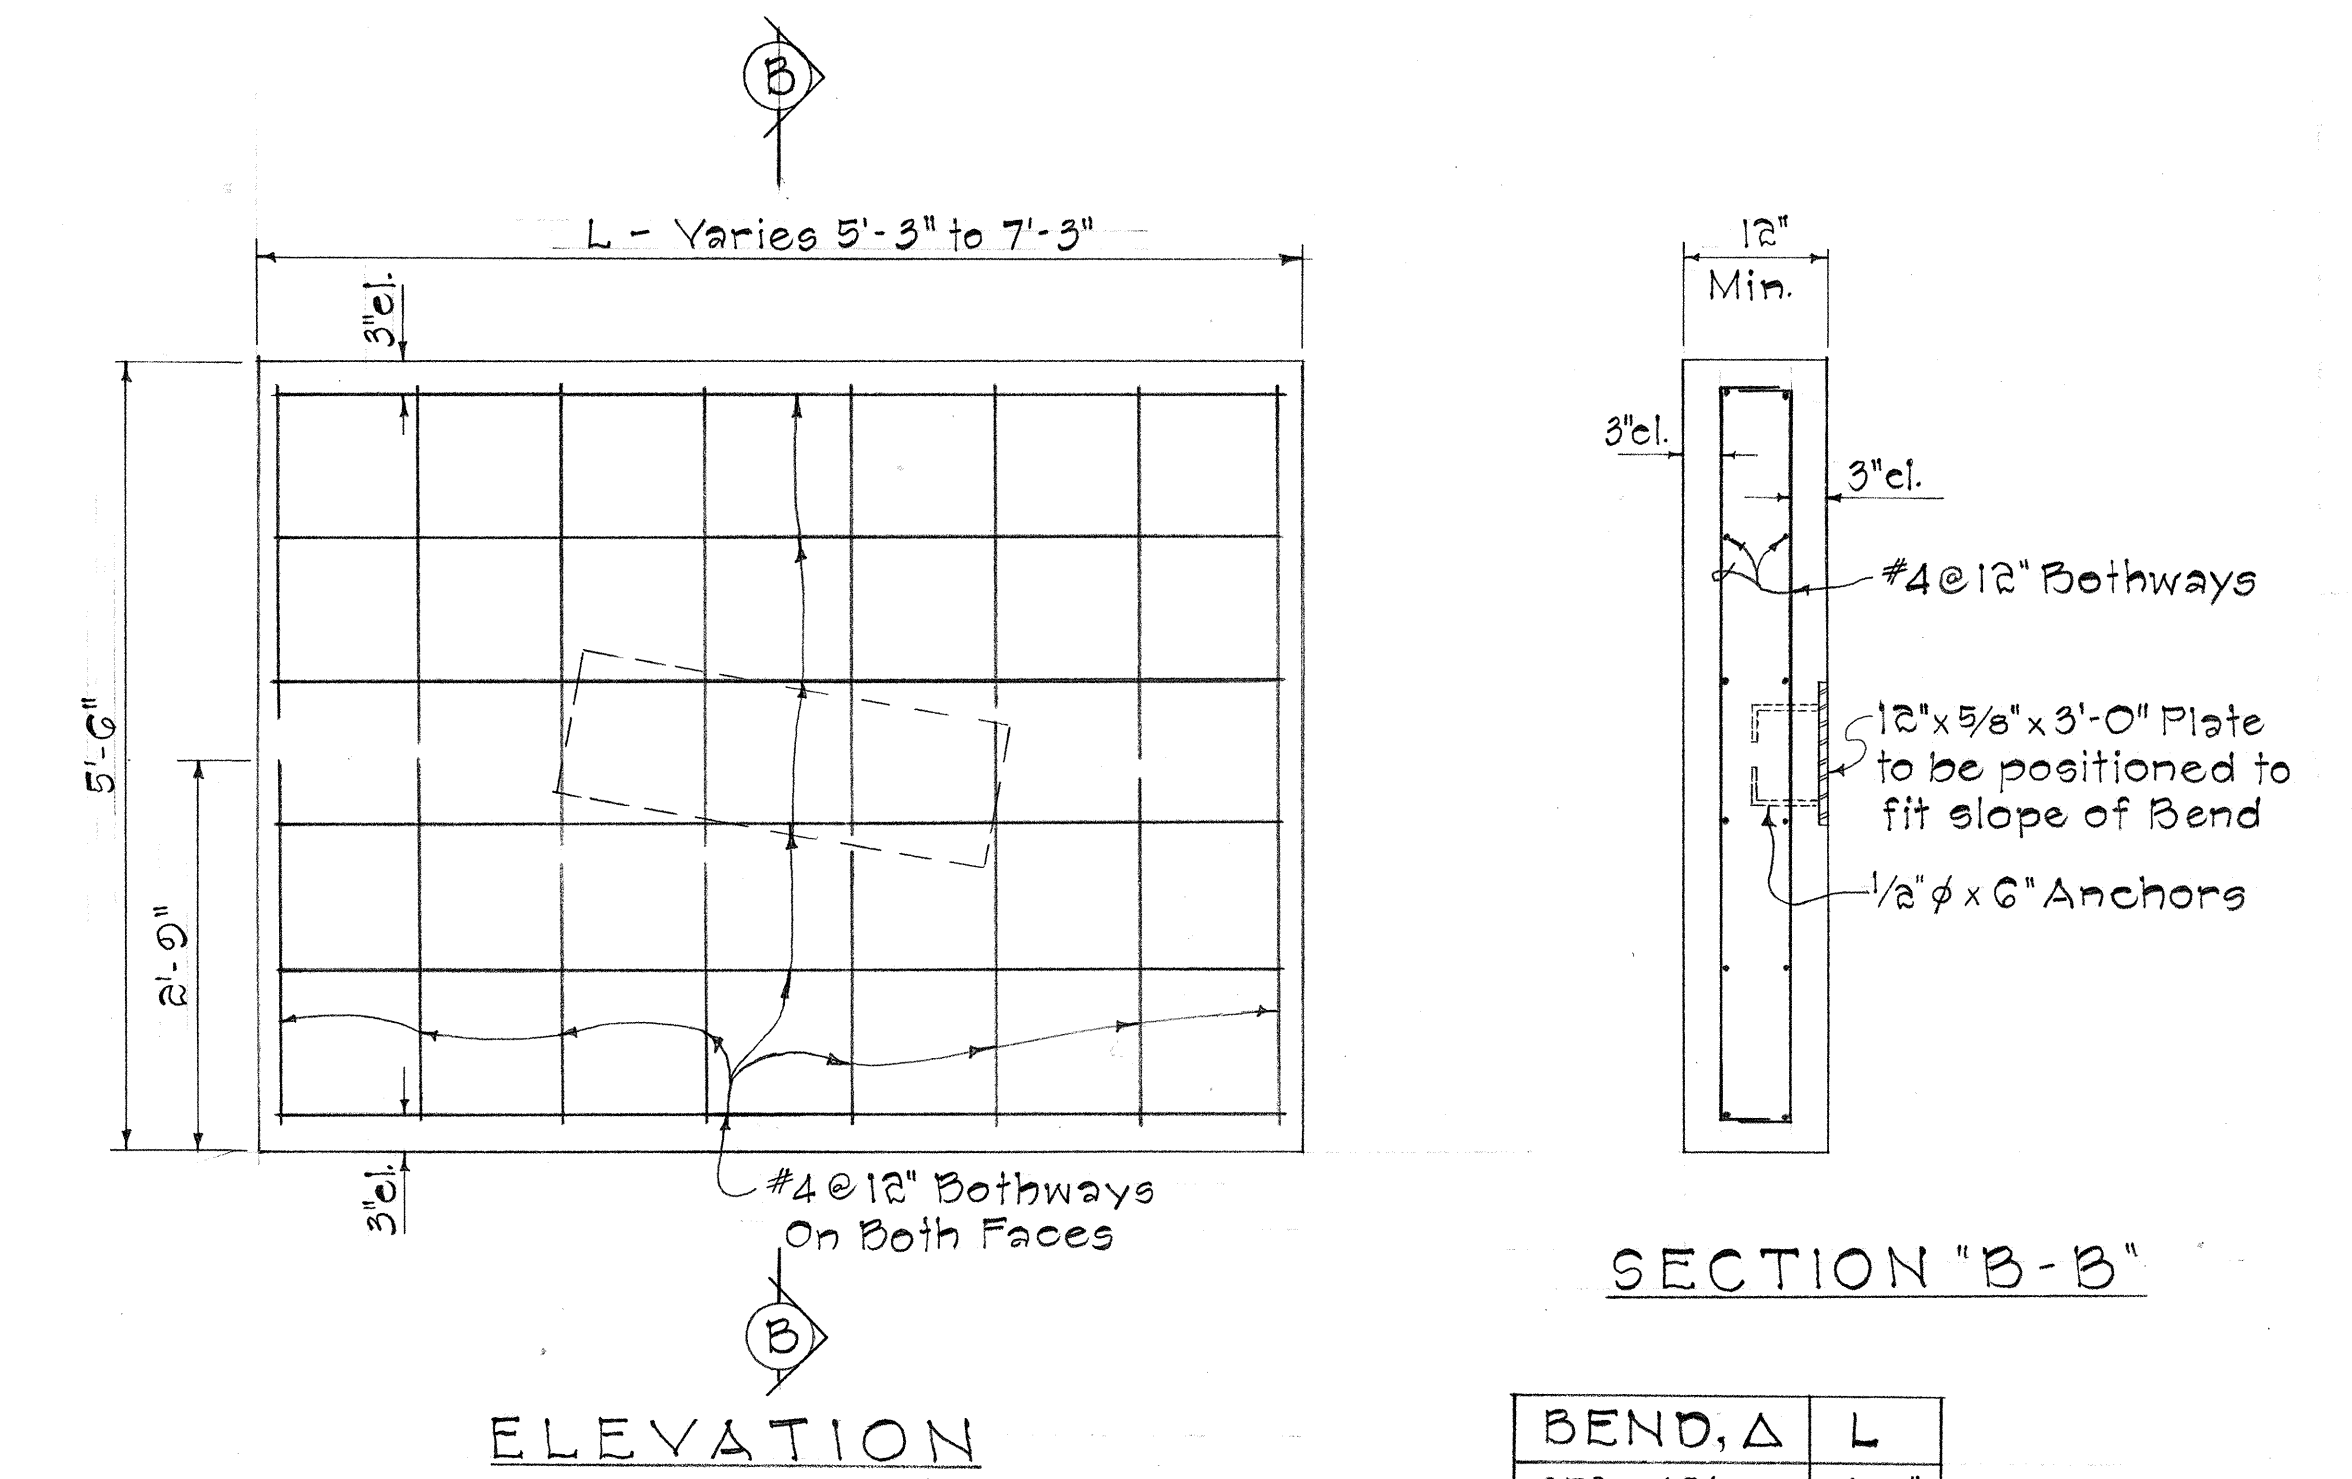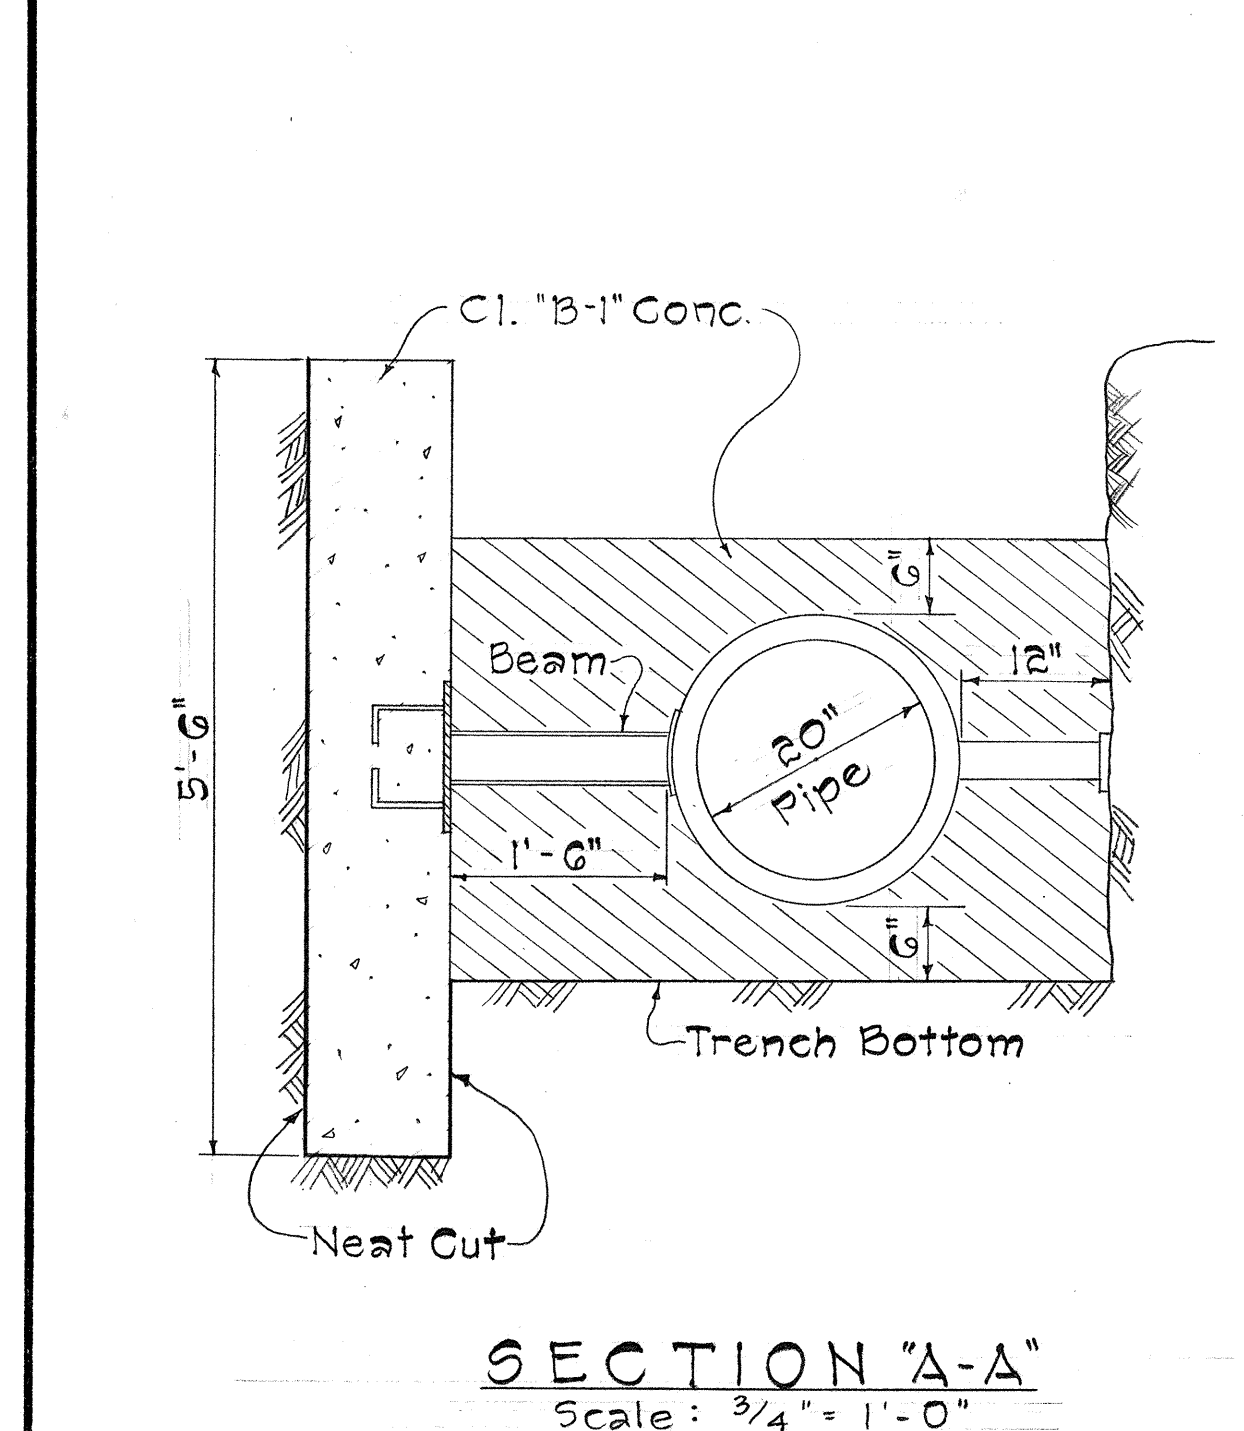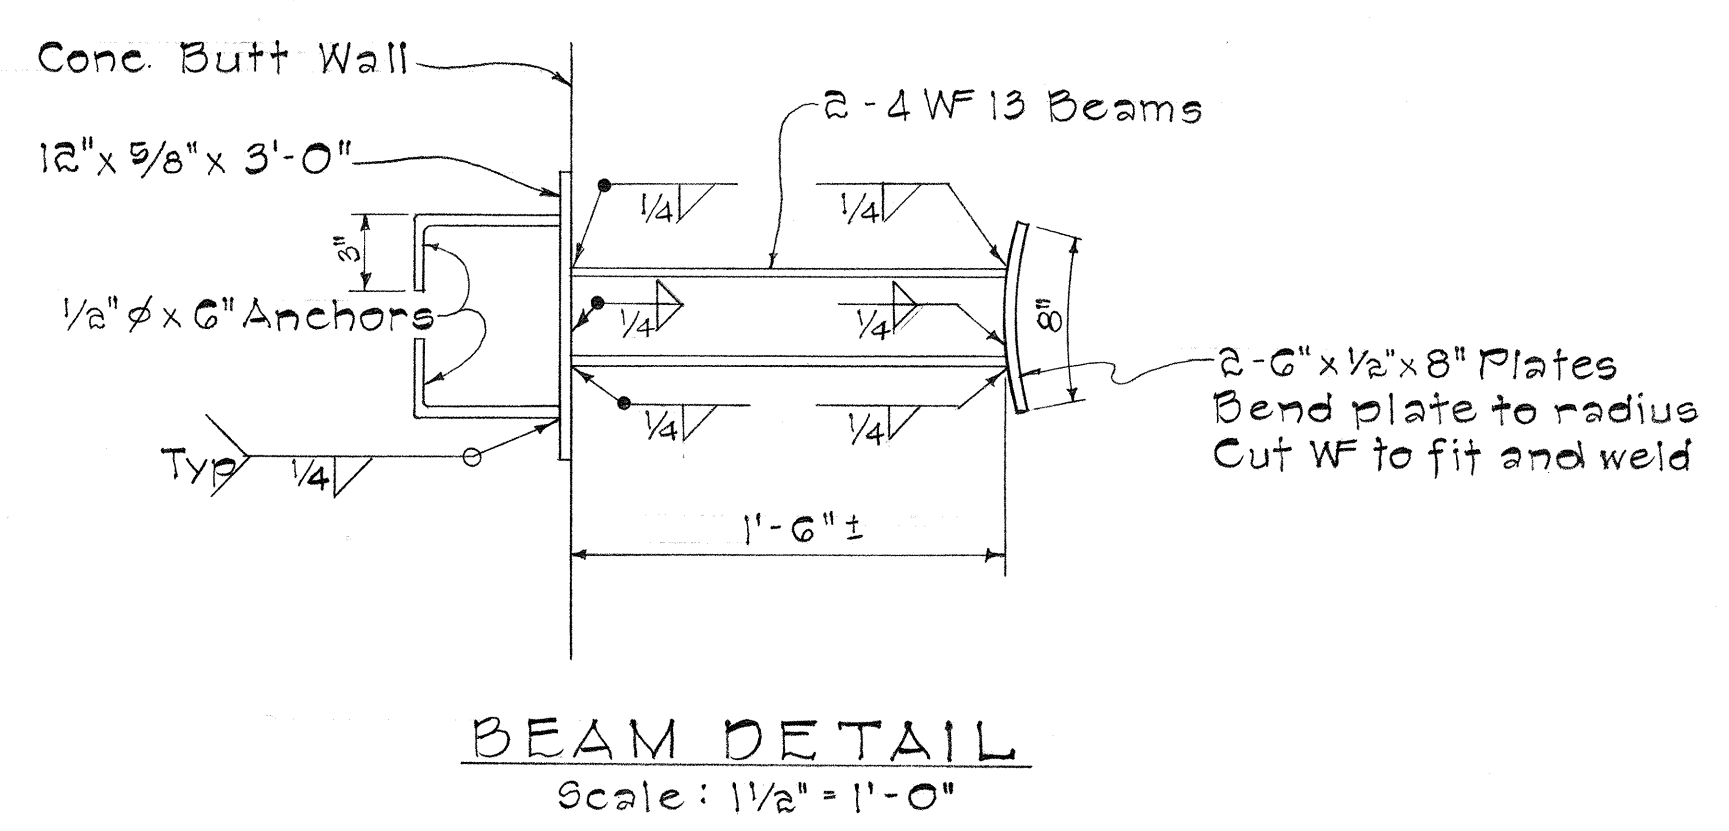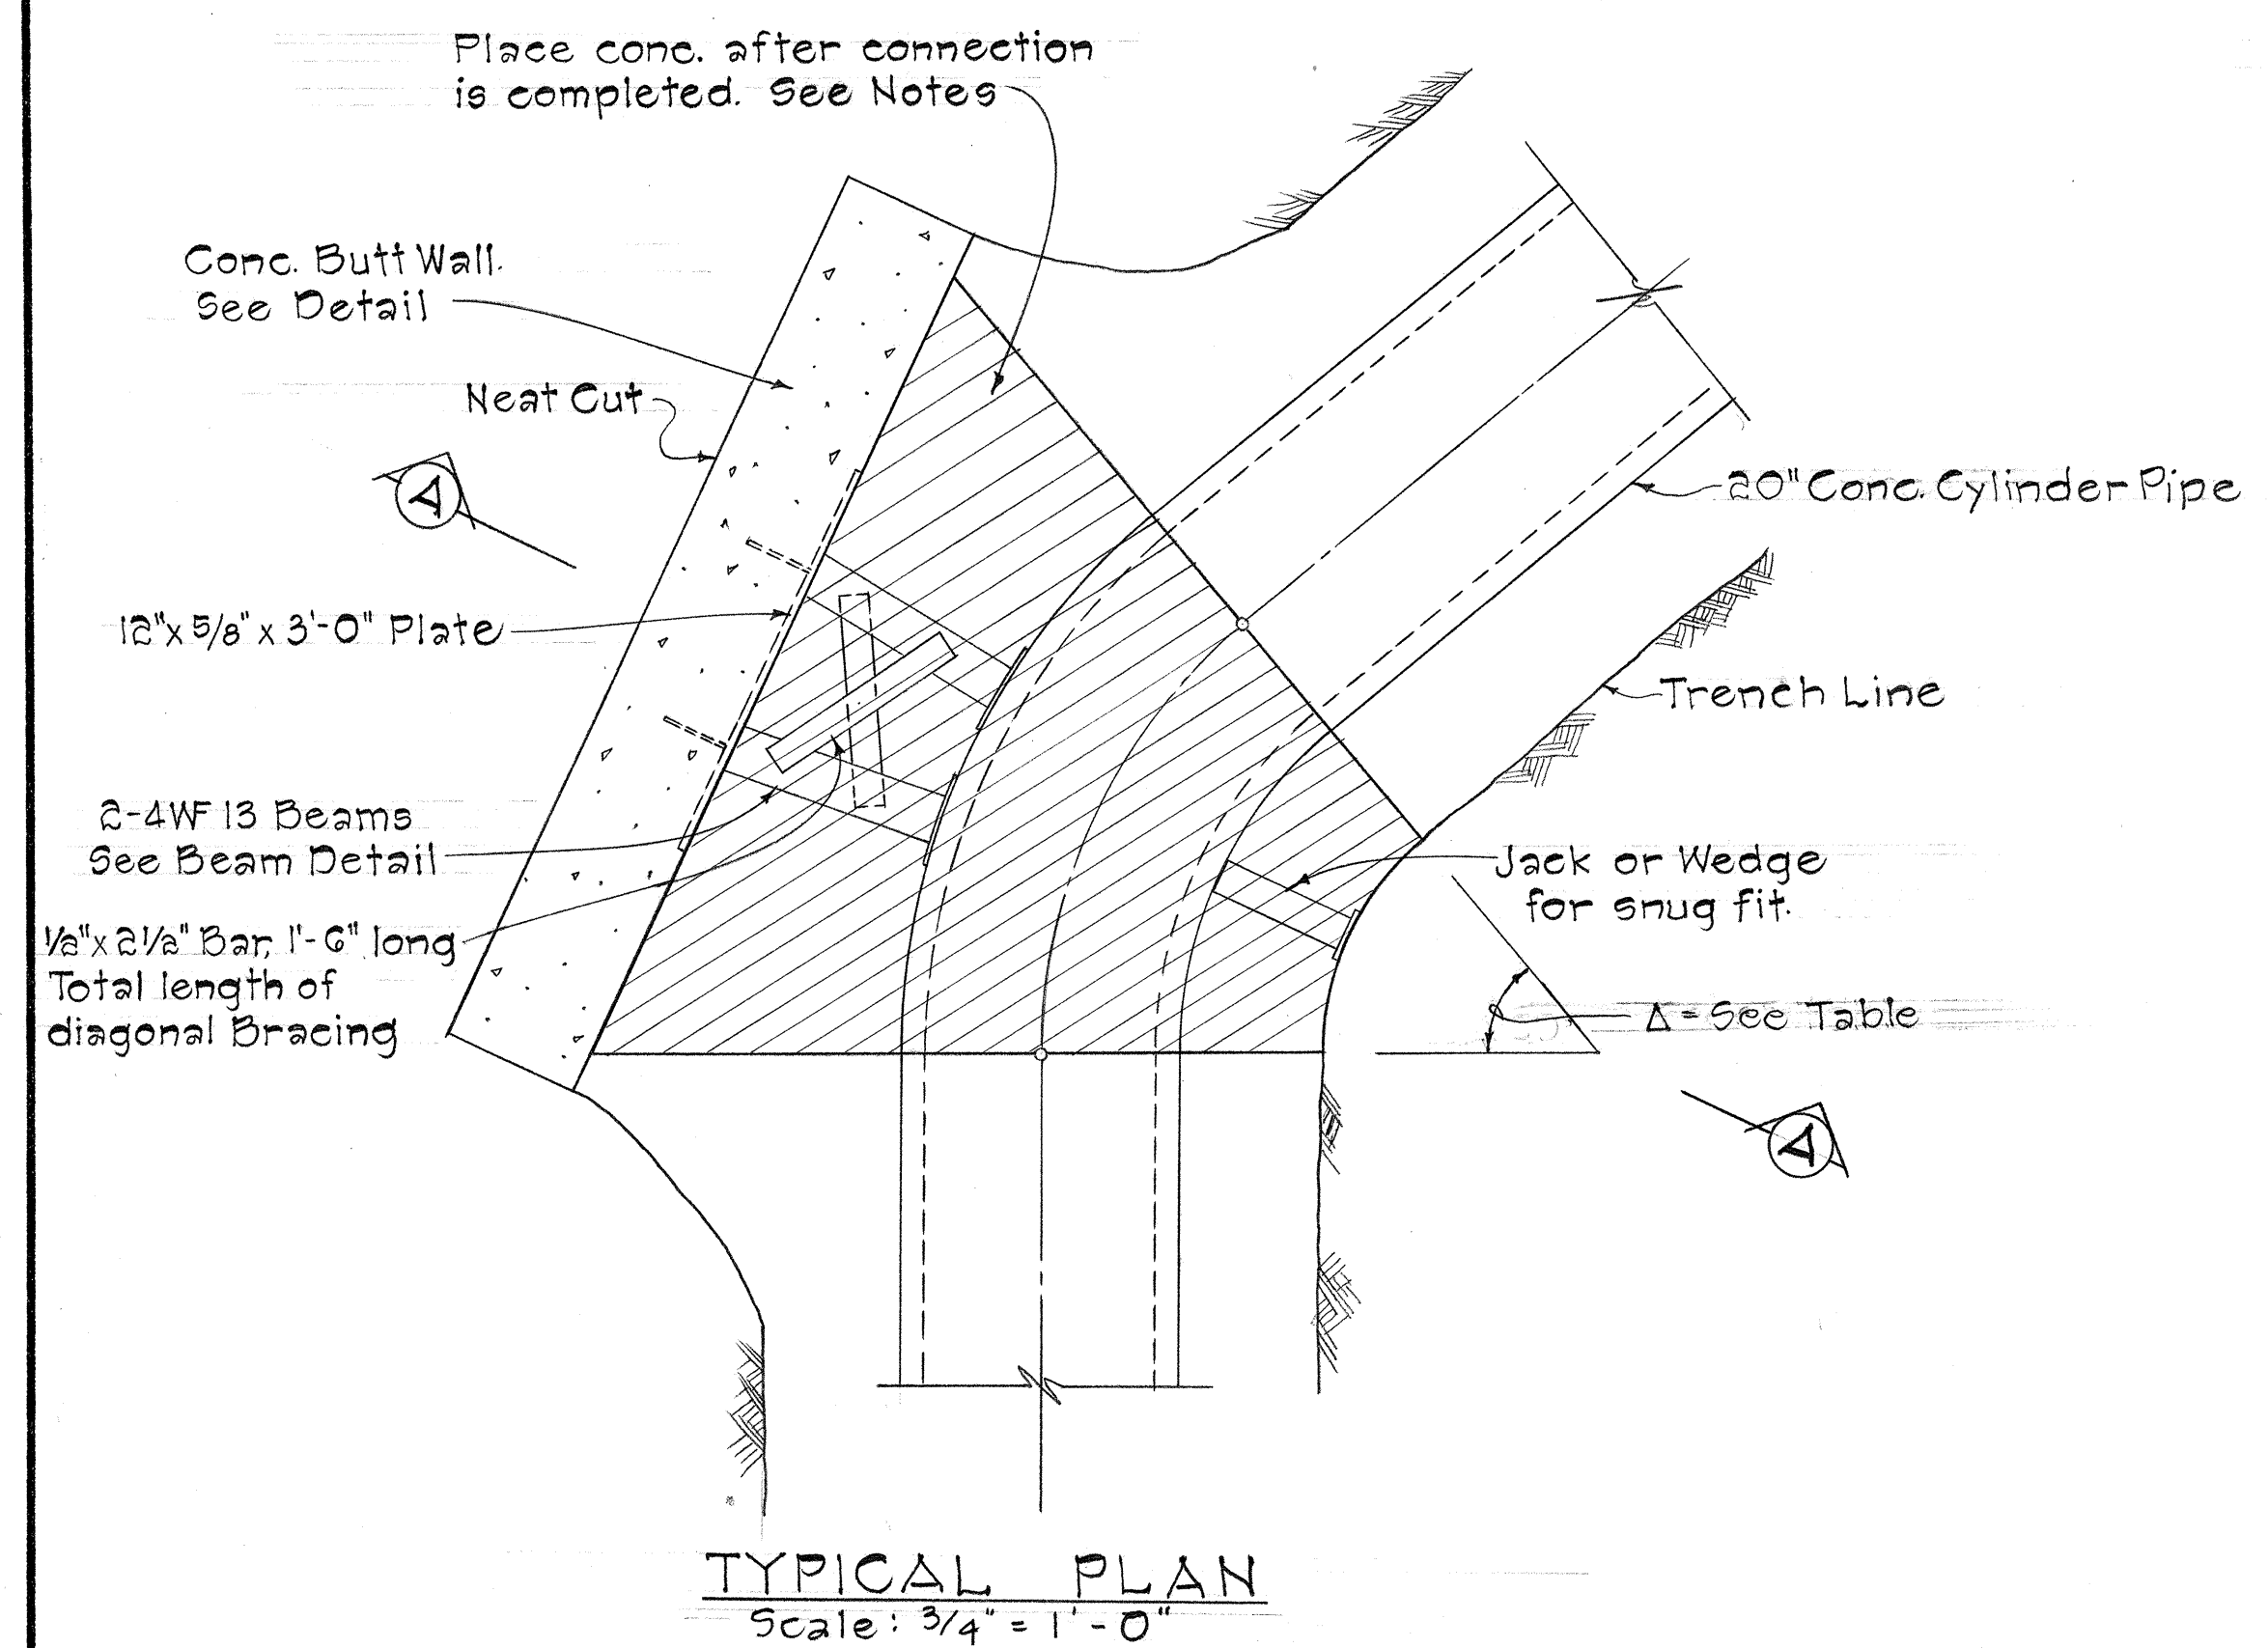

- NOTES:**
1. Minimum cover over reinf. shall be 3"
 2. Concrete shall be Class "B-1".
 3. Hatched area to be filled with concrete after connection is completed.
 4. Payment for structural steel, jack or wedge shall be incidental to Class "B-1" Concrete.

BEND, Δ	L
37° - 42° ±	5'-3"
44° - 50° ±	5'-6"
50° - 04° ±	6'-0"
50° - 30° ±	7'-3"

CONCRETE BUTT WALL DETAIL
Scale: 3/4" = 1'-0"

DETAIL OF CONCRETE REACTION BLOCK FOR 20" PIPELINE @ STA. 436 + 75

STATE OF HAWAII
DEPARTMENT OF TRANSPORTATION
HIGHWAYS DIVISION


IRRIGATION DETAILS

RELOCATION OF P-11 20" IRRIGATION PIPE AT STA. 436 + 75

INTERSTATE ROUTE H-1
F.A.I. Proj. No. I-HI-1(22)S Unit 2
Scale: As Shown Date: June, 1967

SHEET No. 12 OF 28 SHEETS

FED. ROAD DIST. NO.	STATE	FED. AID PROJ. NO.	FISCAL YEAR	SHEET NO.	TOTAL SHEETS
HAWAII	HAW.	I-HI-1(22)5 Unit 3	1967	00.42	99
		I-HI-1(22)5 Unit 2			

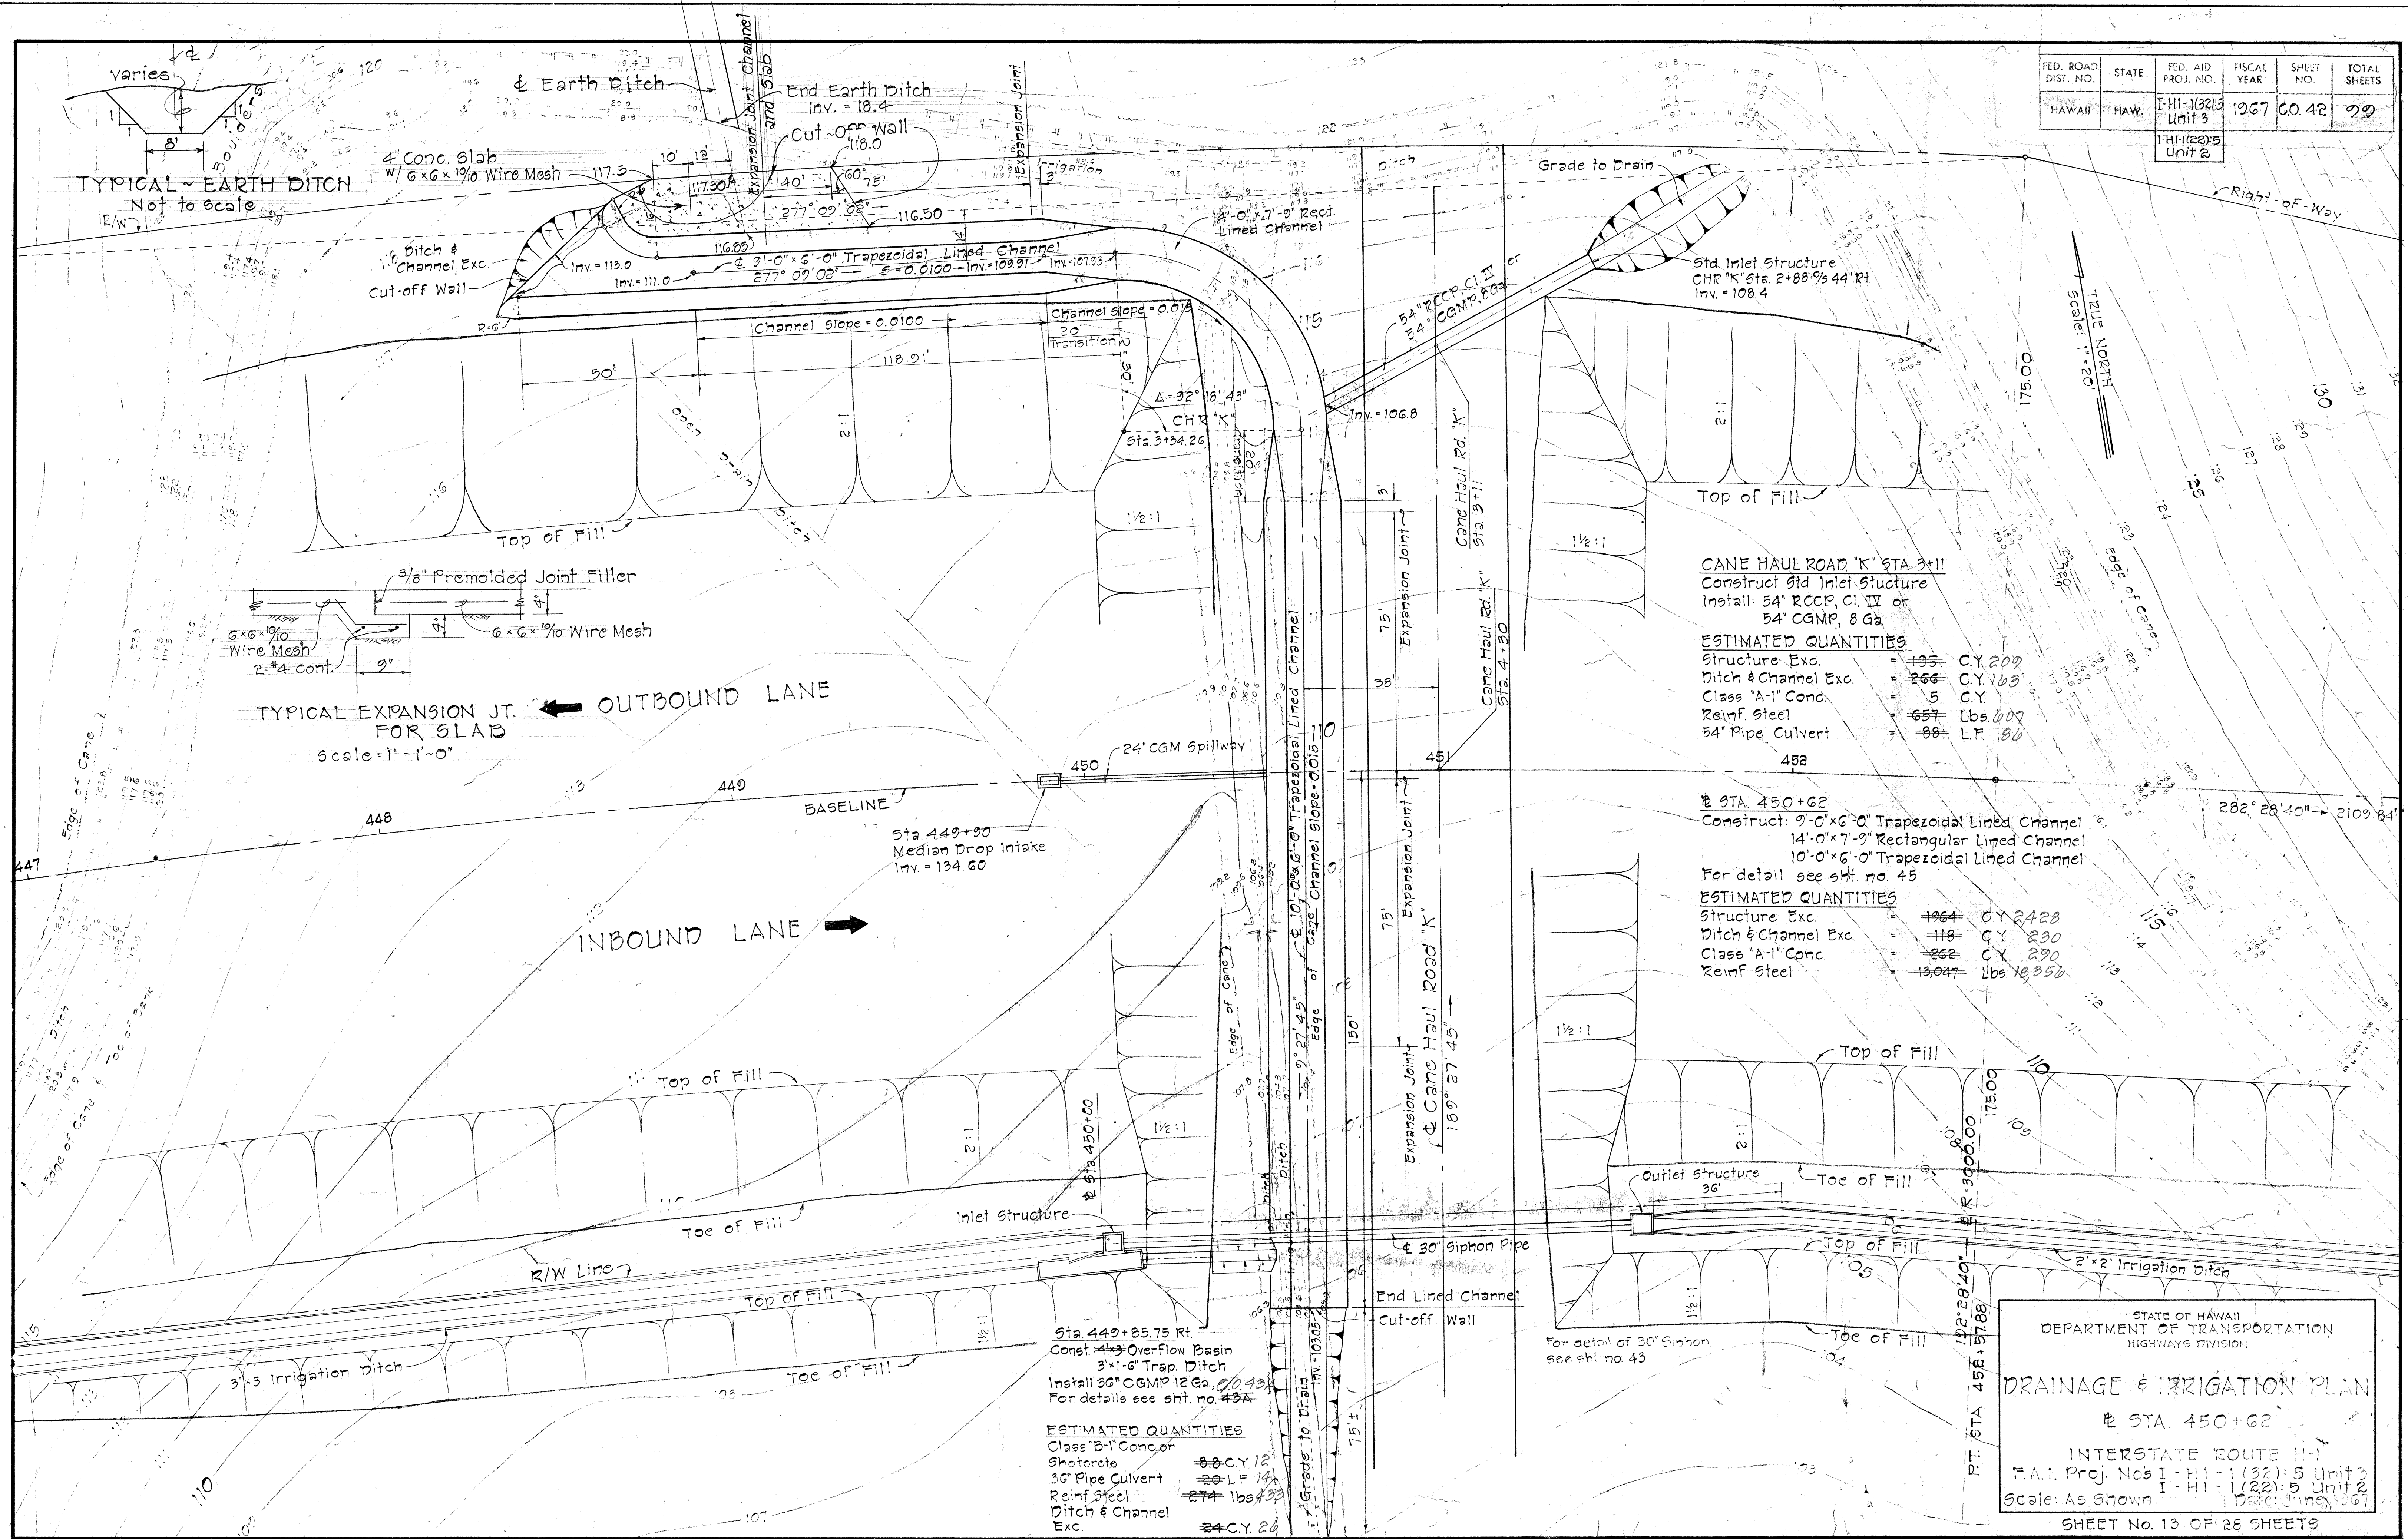

CANE HAUL ROAD "K" STA. 3+11
Construct 54" Inlet Structure
Install: 54" RCCP, Cl. IV or
54" CGMP, 8 Ga.

ESTIMATED QUANTITIES

Structure Exc.	= 195	C.Y. 209
Ditch & Channel Exc.	= 266	C.Y. 163
Class "A-1" Conc.	= 5	C.Y.
Reinf. Steel	= 657	Lbs. 607
54" Pipe Culvert	= 80	L.F. 80

STA. 450+62
Construct: 9'-0"x6'-0" Trapezoidal Lined Channel
14'-0"x7'-0" Rectangular Lined Channel
10'-0"x6'-0" Trapezoidal Lined Channel
For detail see sht. no. 45

ESTIMATED QUANTITIES

Structure Exc.	= 1064	C.Y. 2428
Ditch & Channel Exc.	= 118	C.Y. 230
Class "A-1" Conc.	= 262	C.Y. 290
Reinf. Steel	= 13047	Lbs. 18350

Sta. 449+85.75 Rt.
Const. 4'-3" Overflow Basin
3'-1'-6" Trap Ditch
Install 36" CGMP 12 Ga. 12043
For details see sht. no. 43A

ESTIMATED QUANTITIES

Class "B-1" Conc.	= 88	C.Y. 12
Shotcrete	= 20	C.Y. 14
36" Pipe Culvert	= 274	Lbs. 433
Reinf. Steel	= 274	Lbs. 433
Ditch & Channel Exc.	= 24	C.Y. 20

STATE OF HAWAII
DEPARTMENT OF TRANSPORTATION
HIGHWAYS DIVISION

DRAINAGE & IRRIGATION PLAN

STA. 450+62







INTERSTATE ROUTE 1
F.A.I. Proj. No. I-HI-1(22)5 Unit 3
I-HI-1(22)5 Unit 2
Scale: As Shown
Date: June 1967

SHEET No. 13 OF 28 SHEETS

February 5, 1968

00.42

FED. ROAD DIST. NO.	STATE	FED. AID PROJ. NO.	FISCAL YEAR	SHEET NO.	TOTAL SHEETS
HAWAII	HAW.	I-HI-1(22) Unit 2	1967	C.043	99

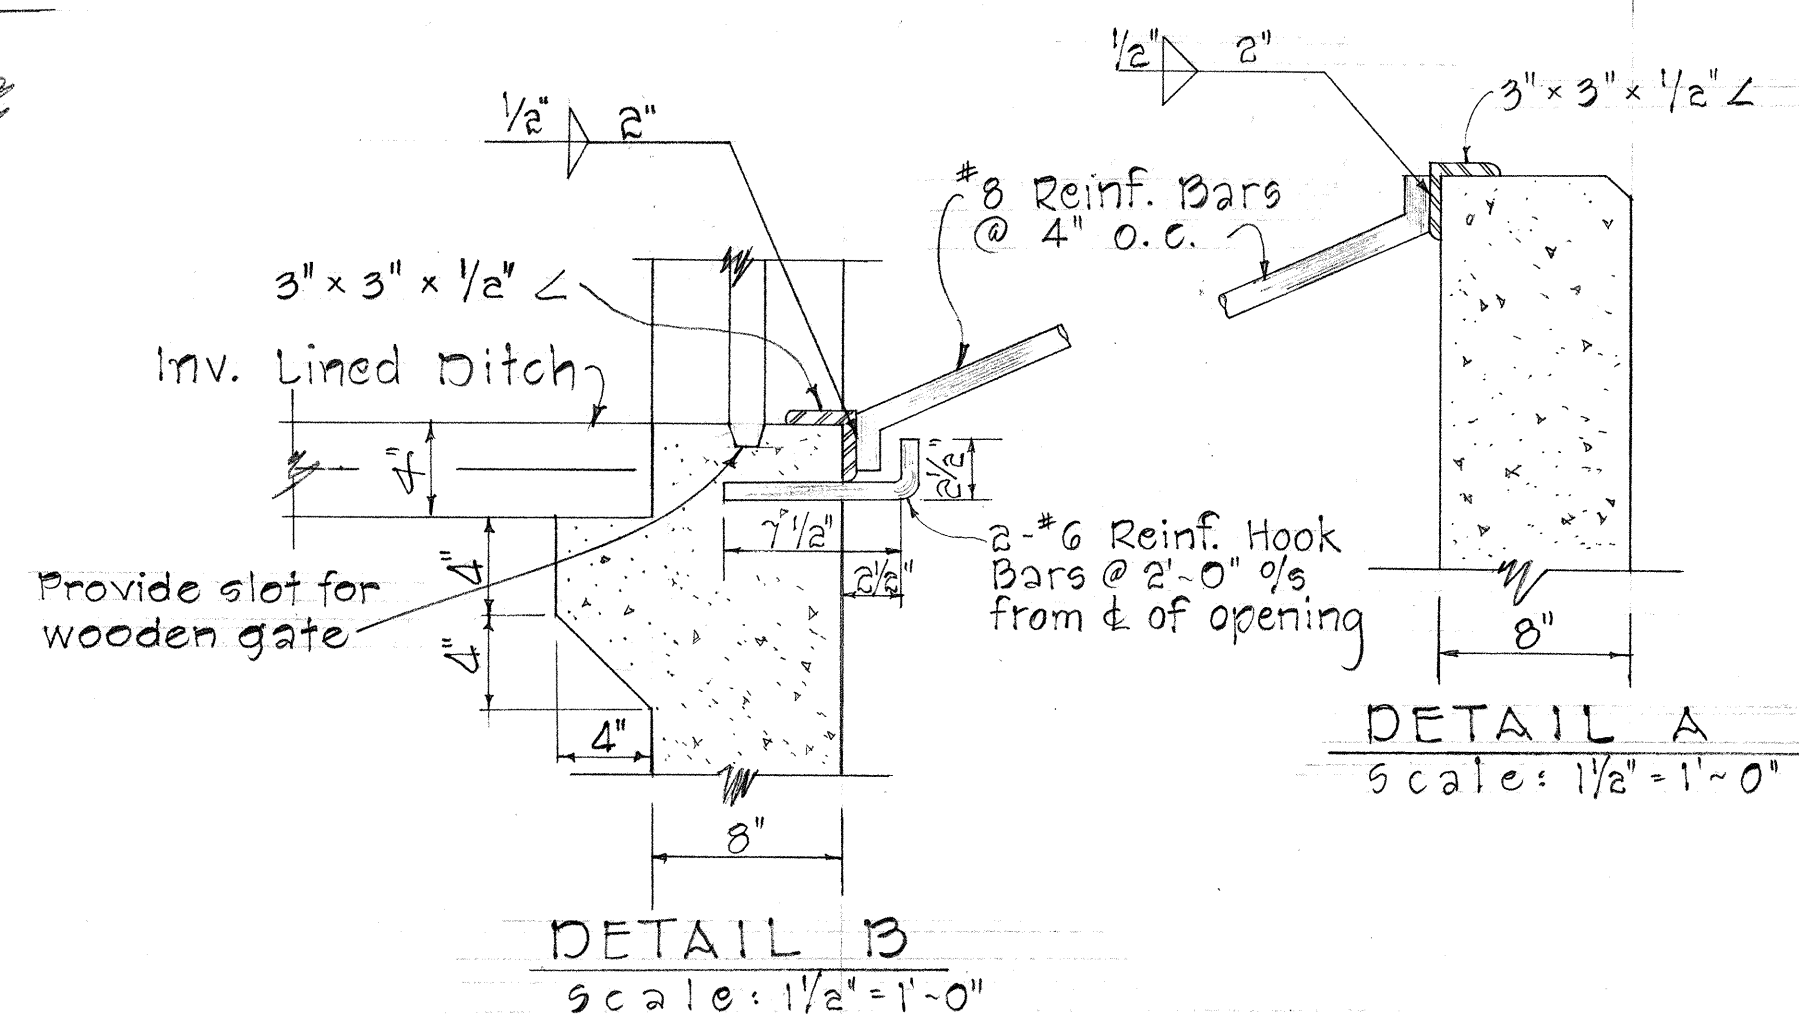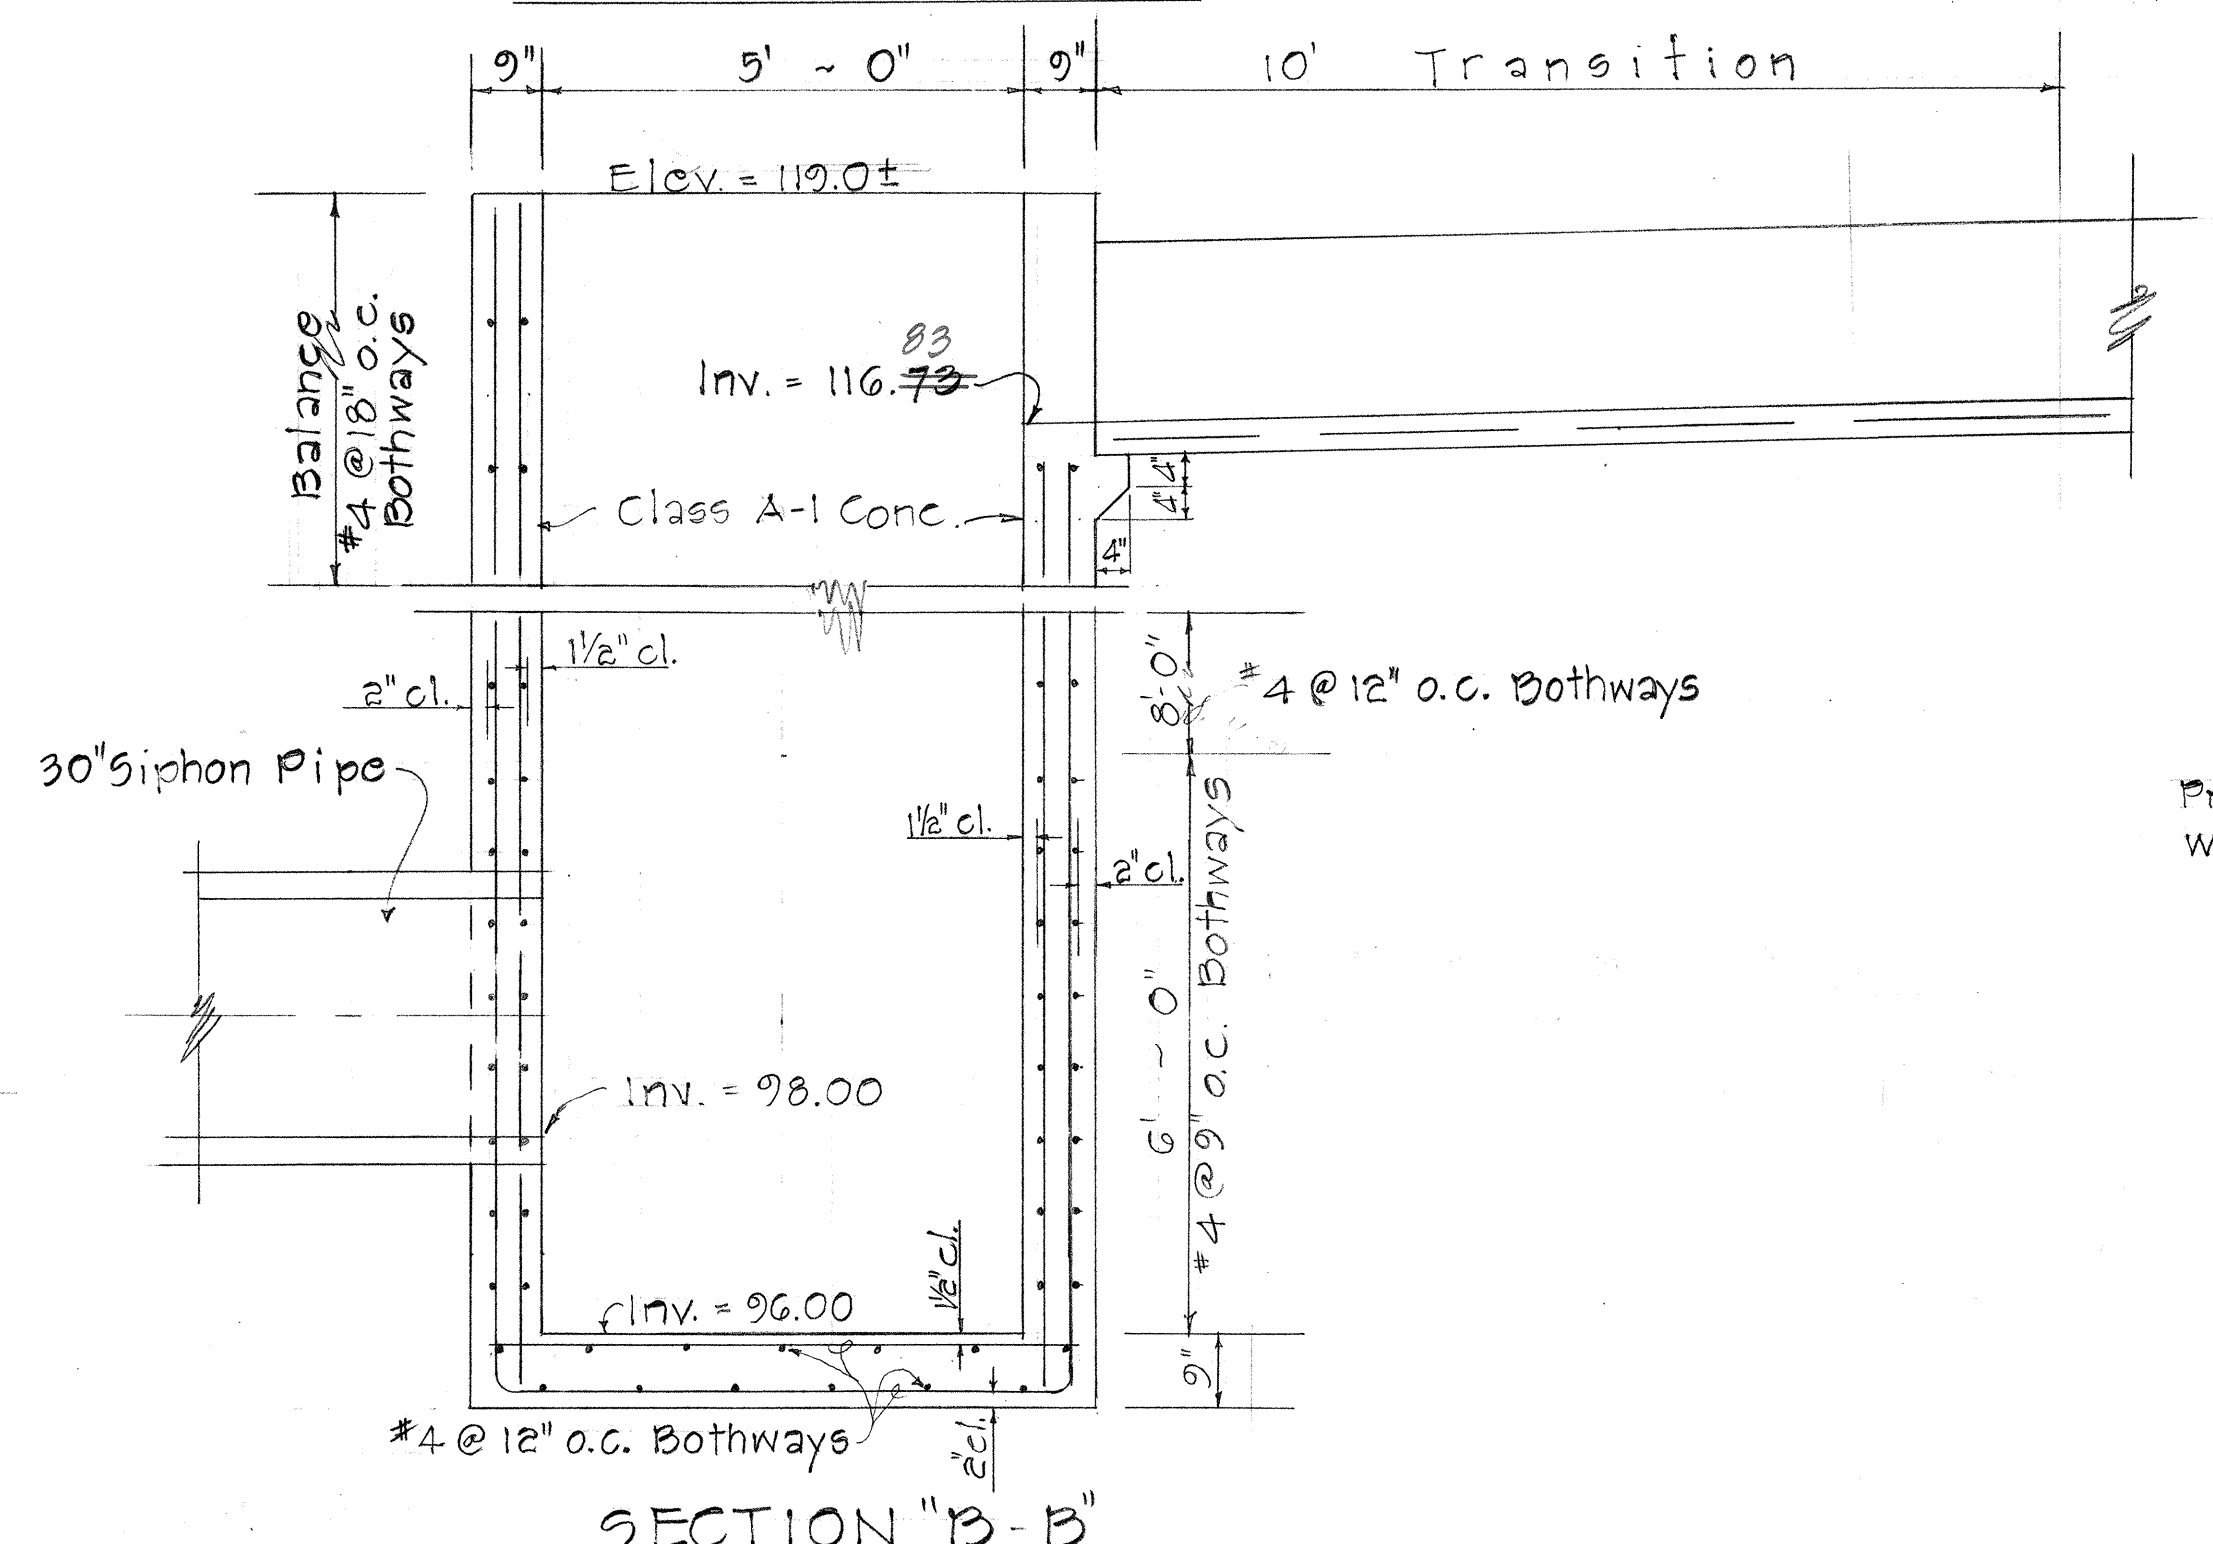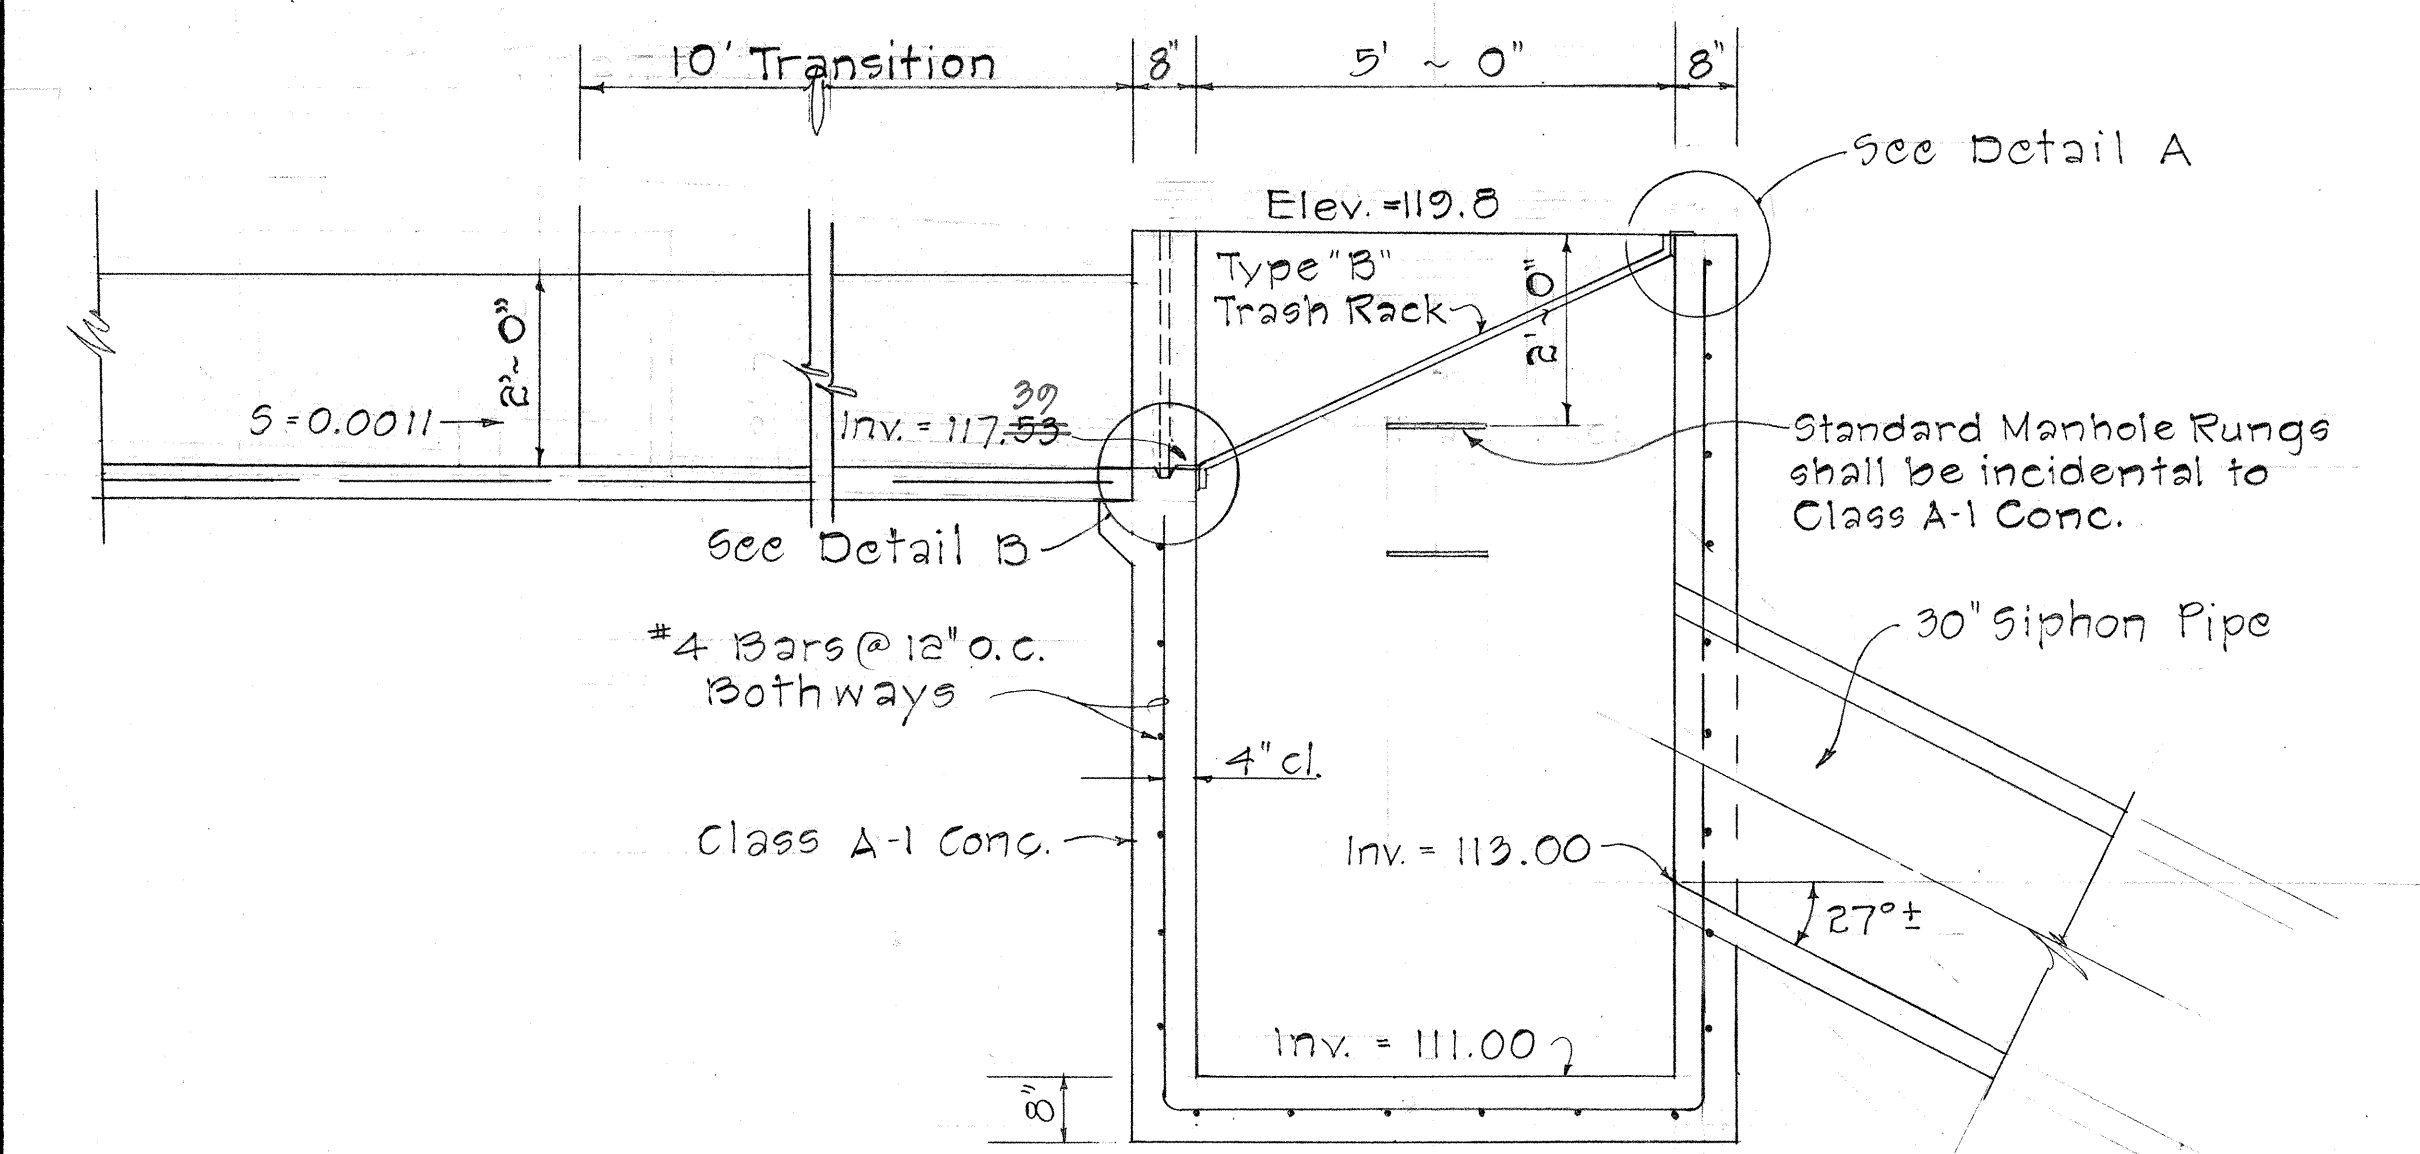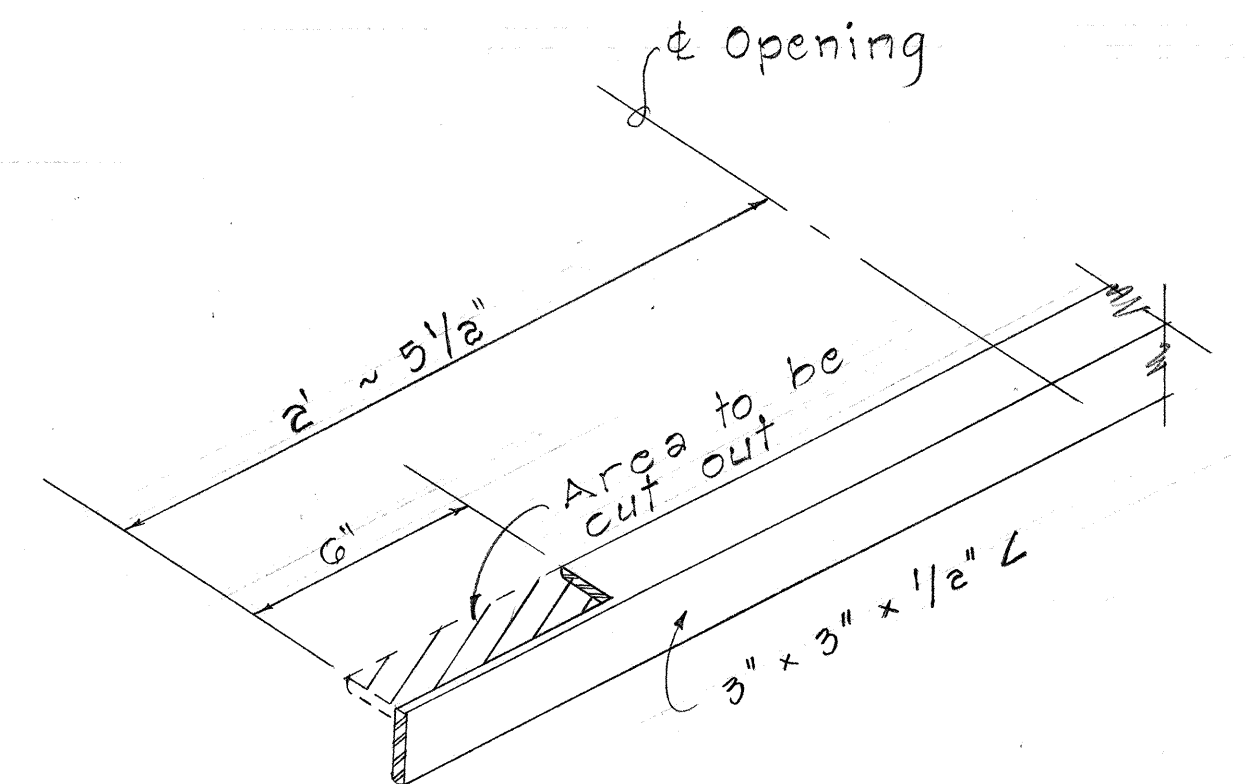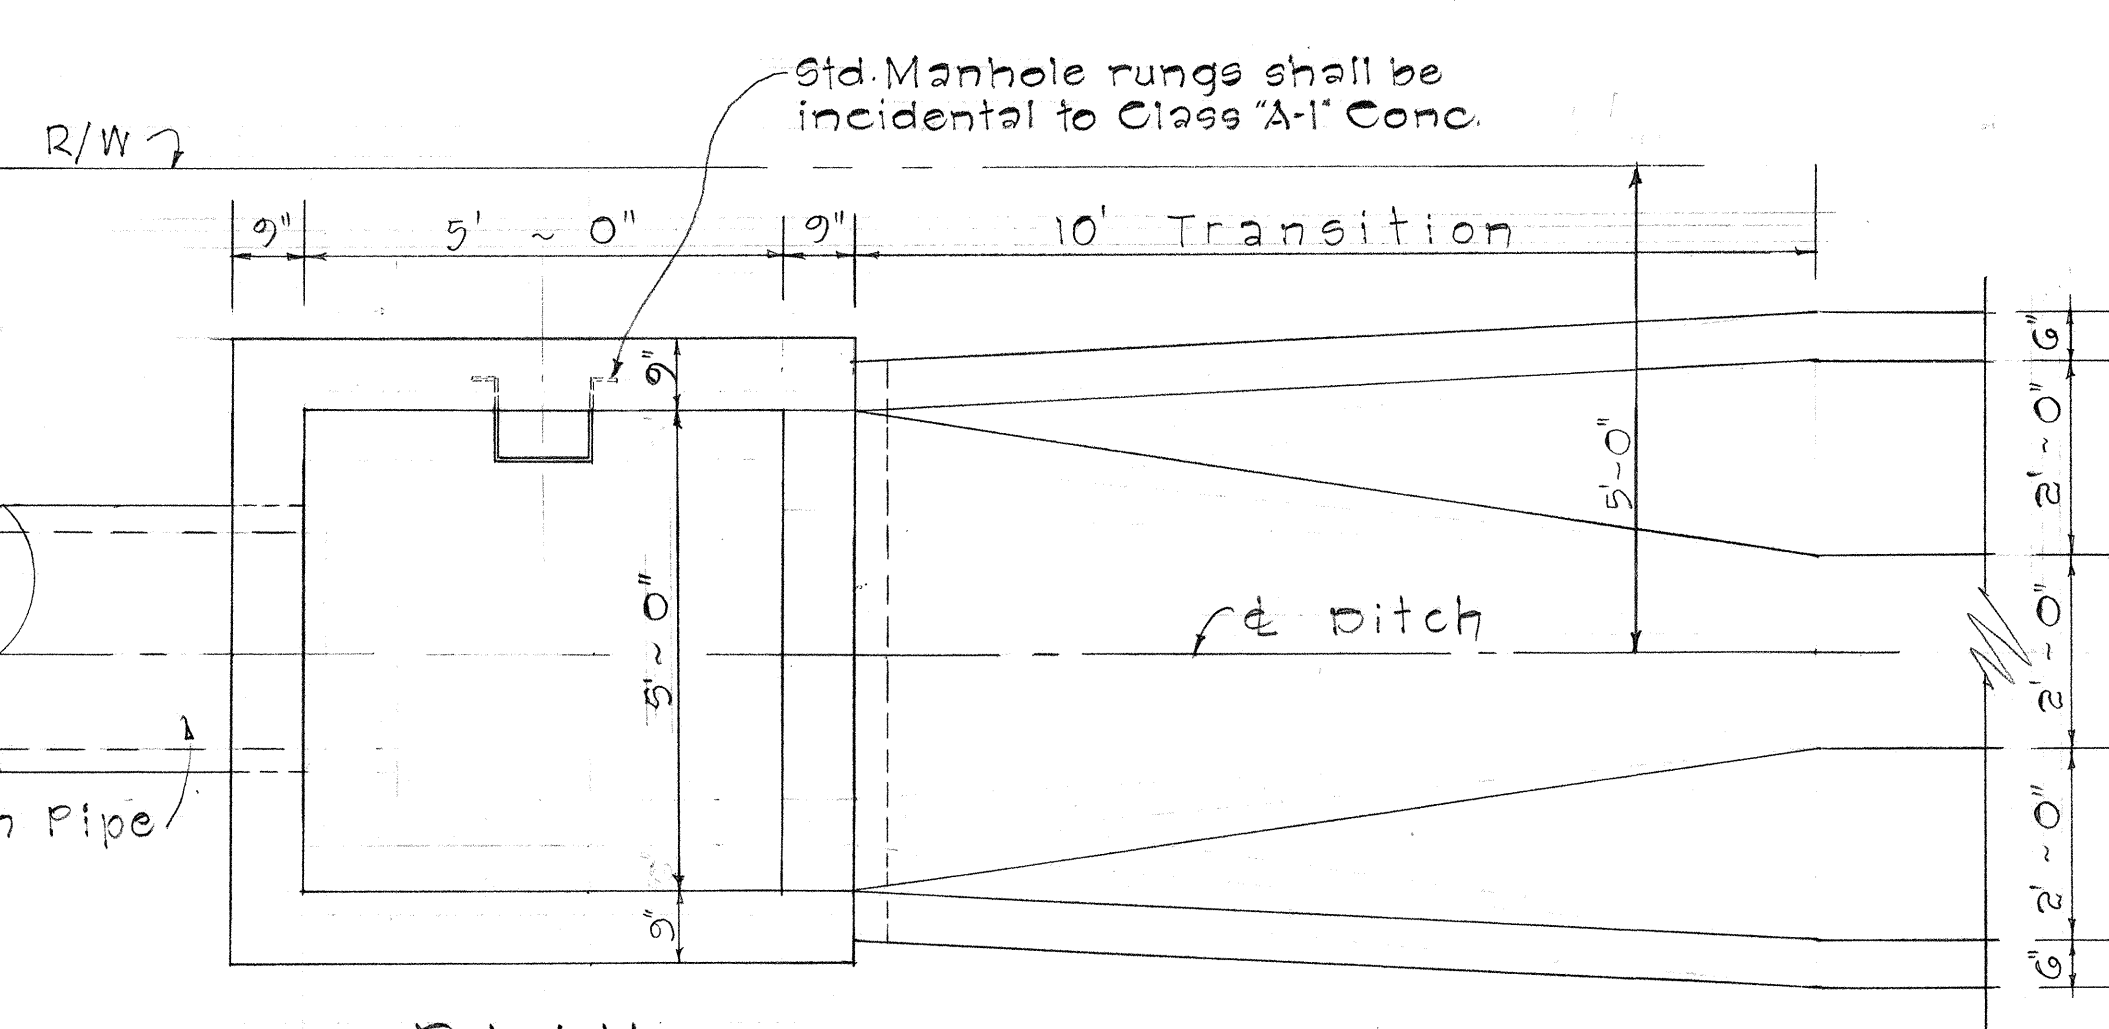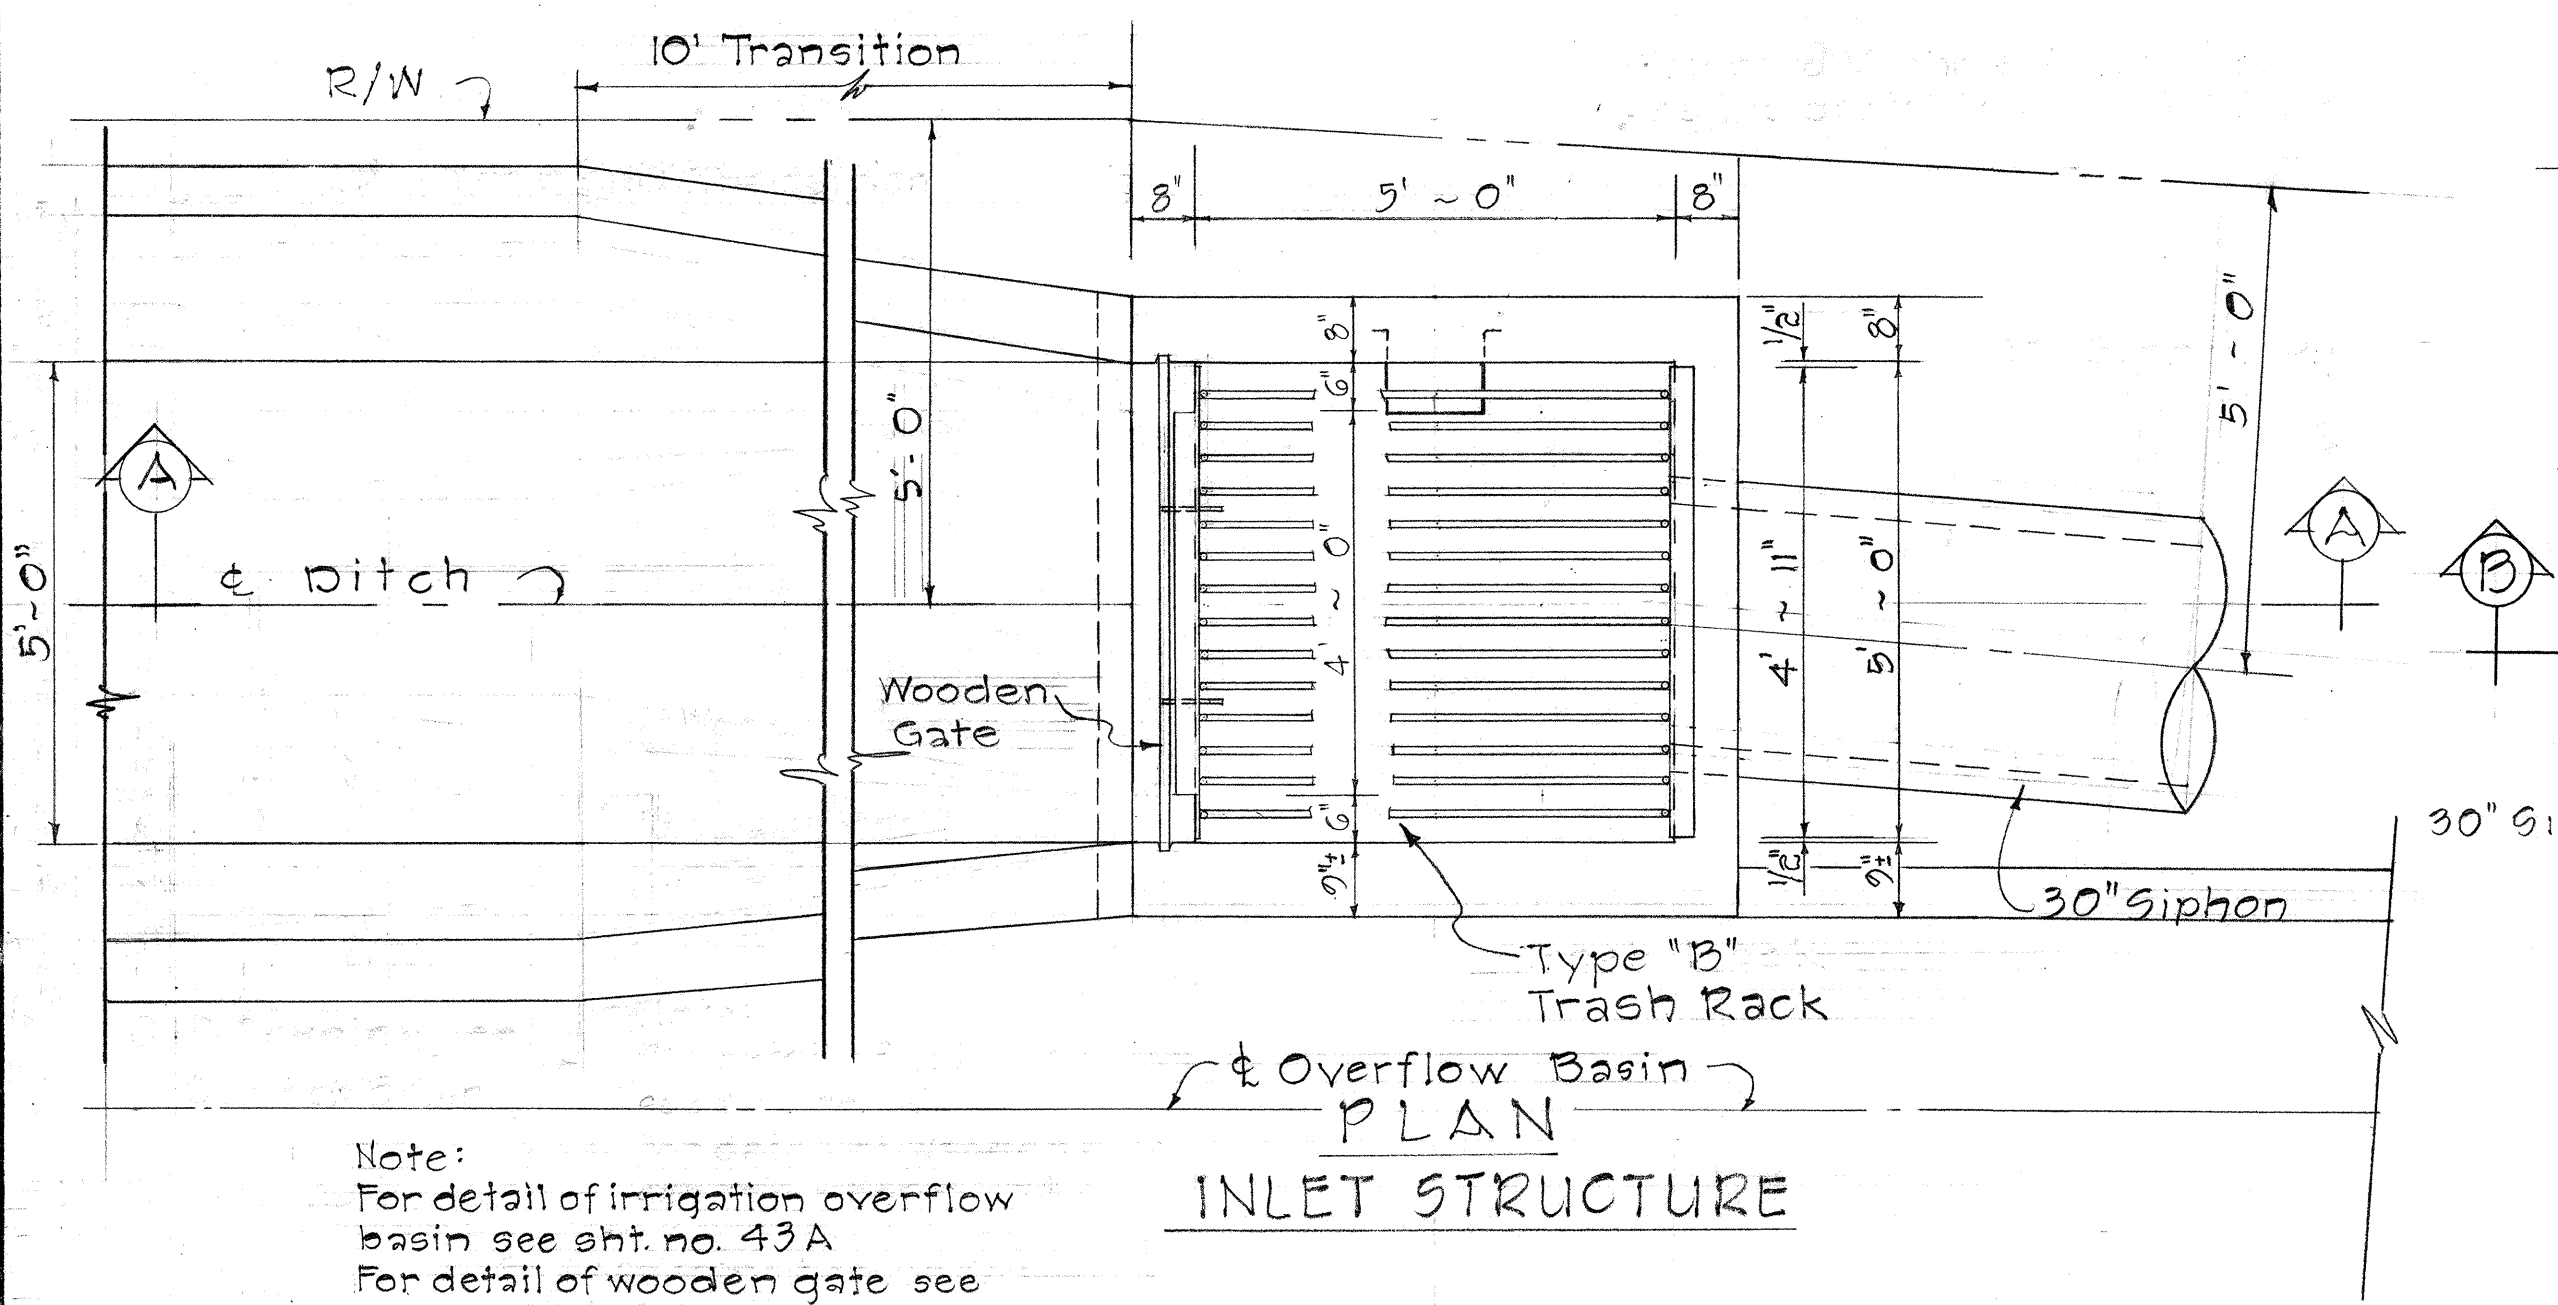


DETAILS OF TYPE "B" TRASH RACK

ESTIMATED QUANTITIES

Structure Exc.	=	193	C.Y. 217
Class "A-1" Concrete	=	21.2	C.Y.
Reinf. Steel	=	1824	Lbs. 1,866
GRP	=	3.8	C.Y.
30" Siphon Pipe	=	150	L.F. 147
Trash Rack	=	1	Ea.

Note: Location of manhole rungs shall be determined by the engineer in the field.

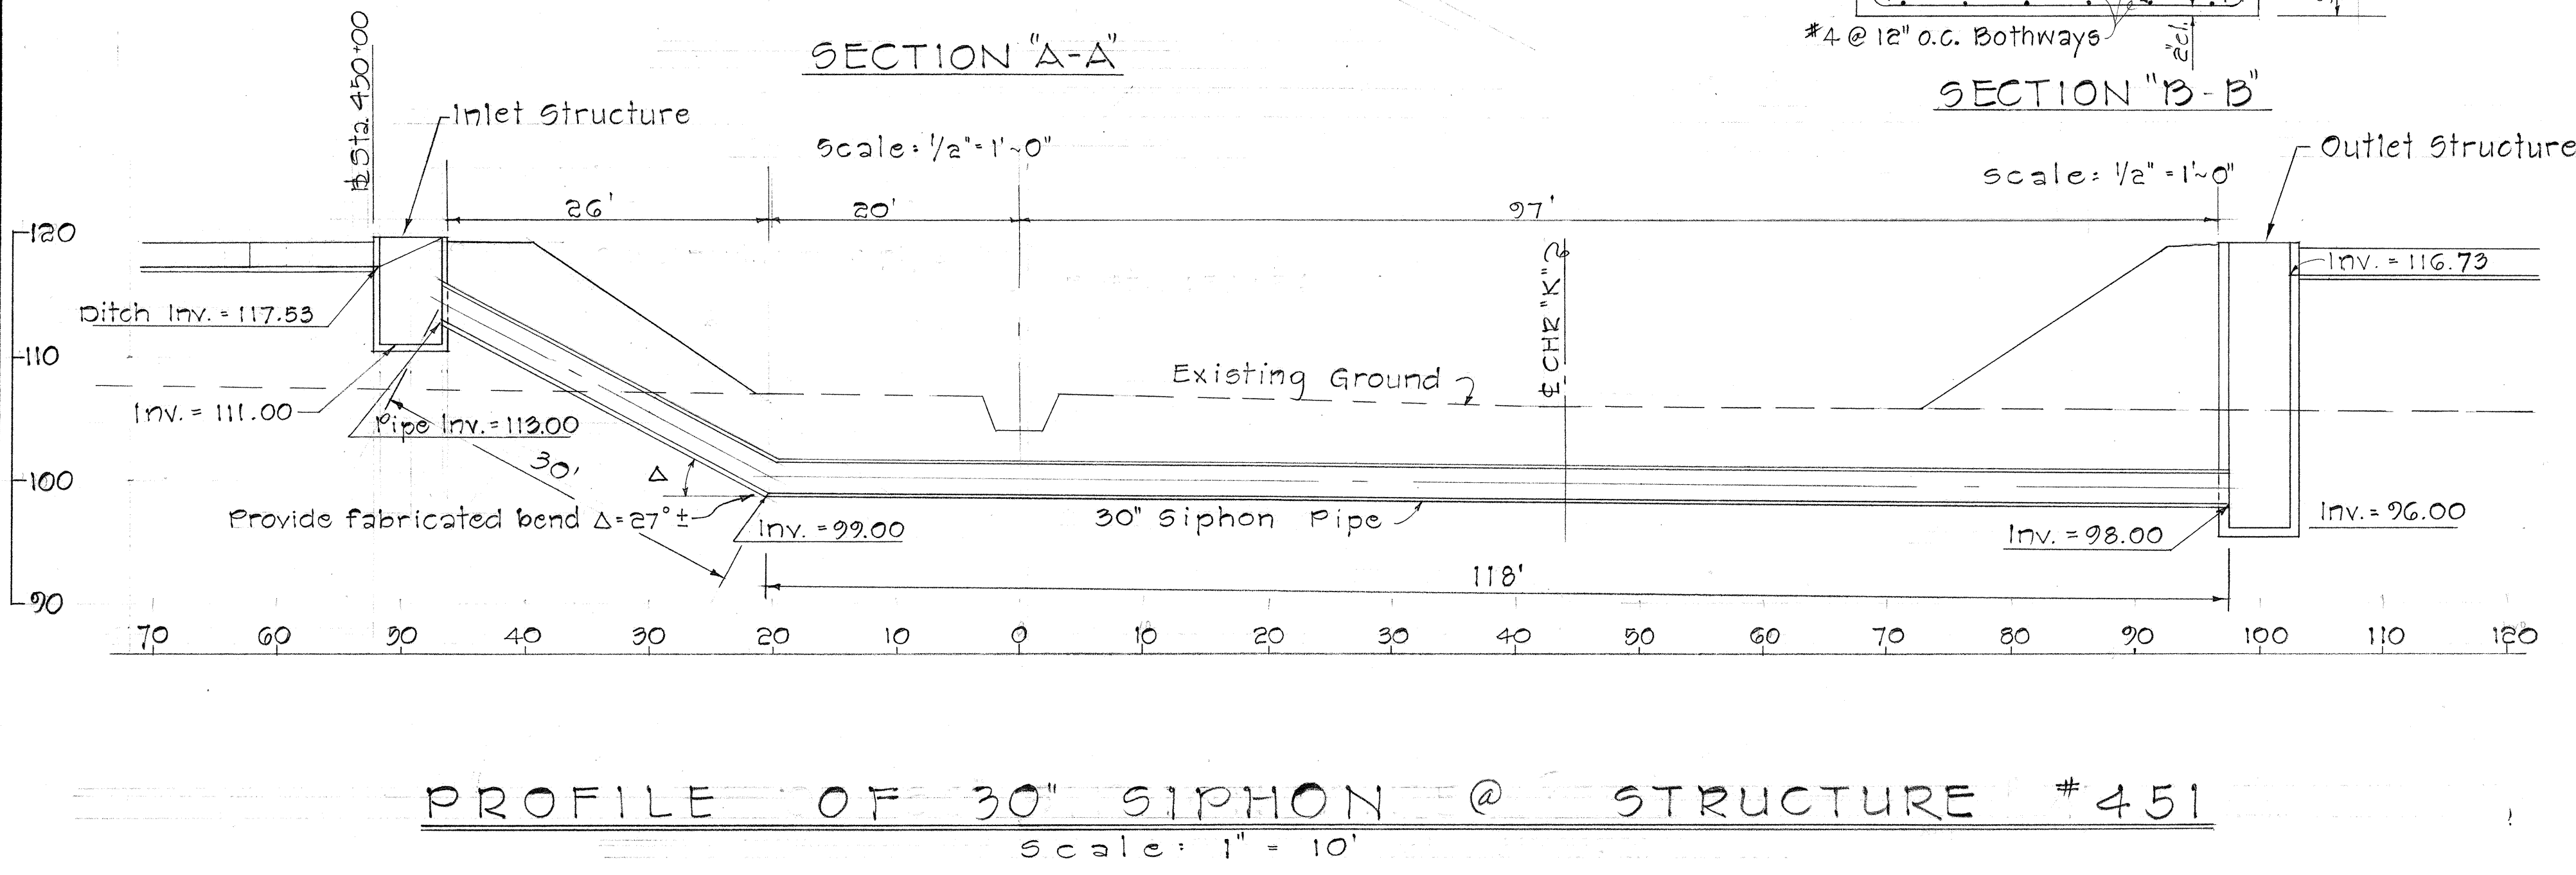

STATE OF HAWAII
DEPARTMENT OF TRANSPORTATION
HIGHWAYS DIVISION

IRRIGATION DETAILS
30" SIPHON AT STRUCTURE #451






INTERSTATE ROUTE H-1
F.A.I. Proj. No. I-HI-1(22):5 Unit 2
Scale: As Shown Date: June, 1967

SHEET No. 14 OF 28 SHEETS

April 1, 1968

C 0 41 3

FED. ROAD DIST. NO.	STATE	FED. AID PROJ. NO.	FISCAL YEAR	SHEET NO.	TOTAL SHEETS
HAWAII	HAW.	I-HI-1(22)5 Unit 3	1967	0043A	99
		I-HI-1(22)5 Unit 2			

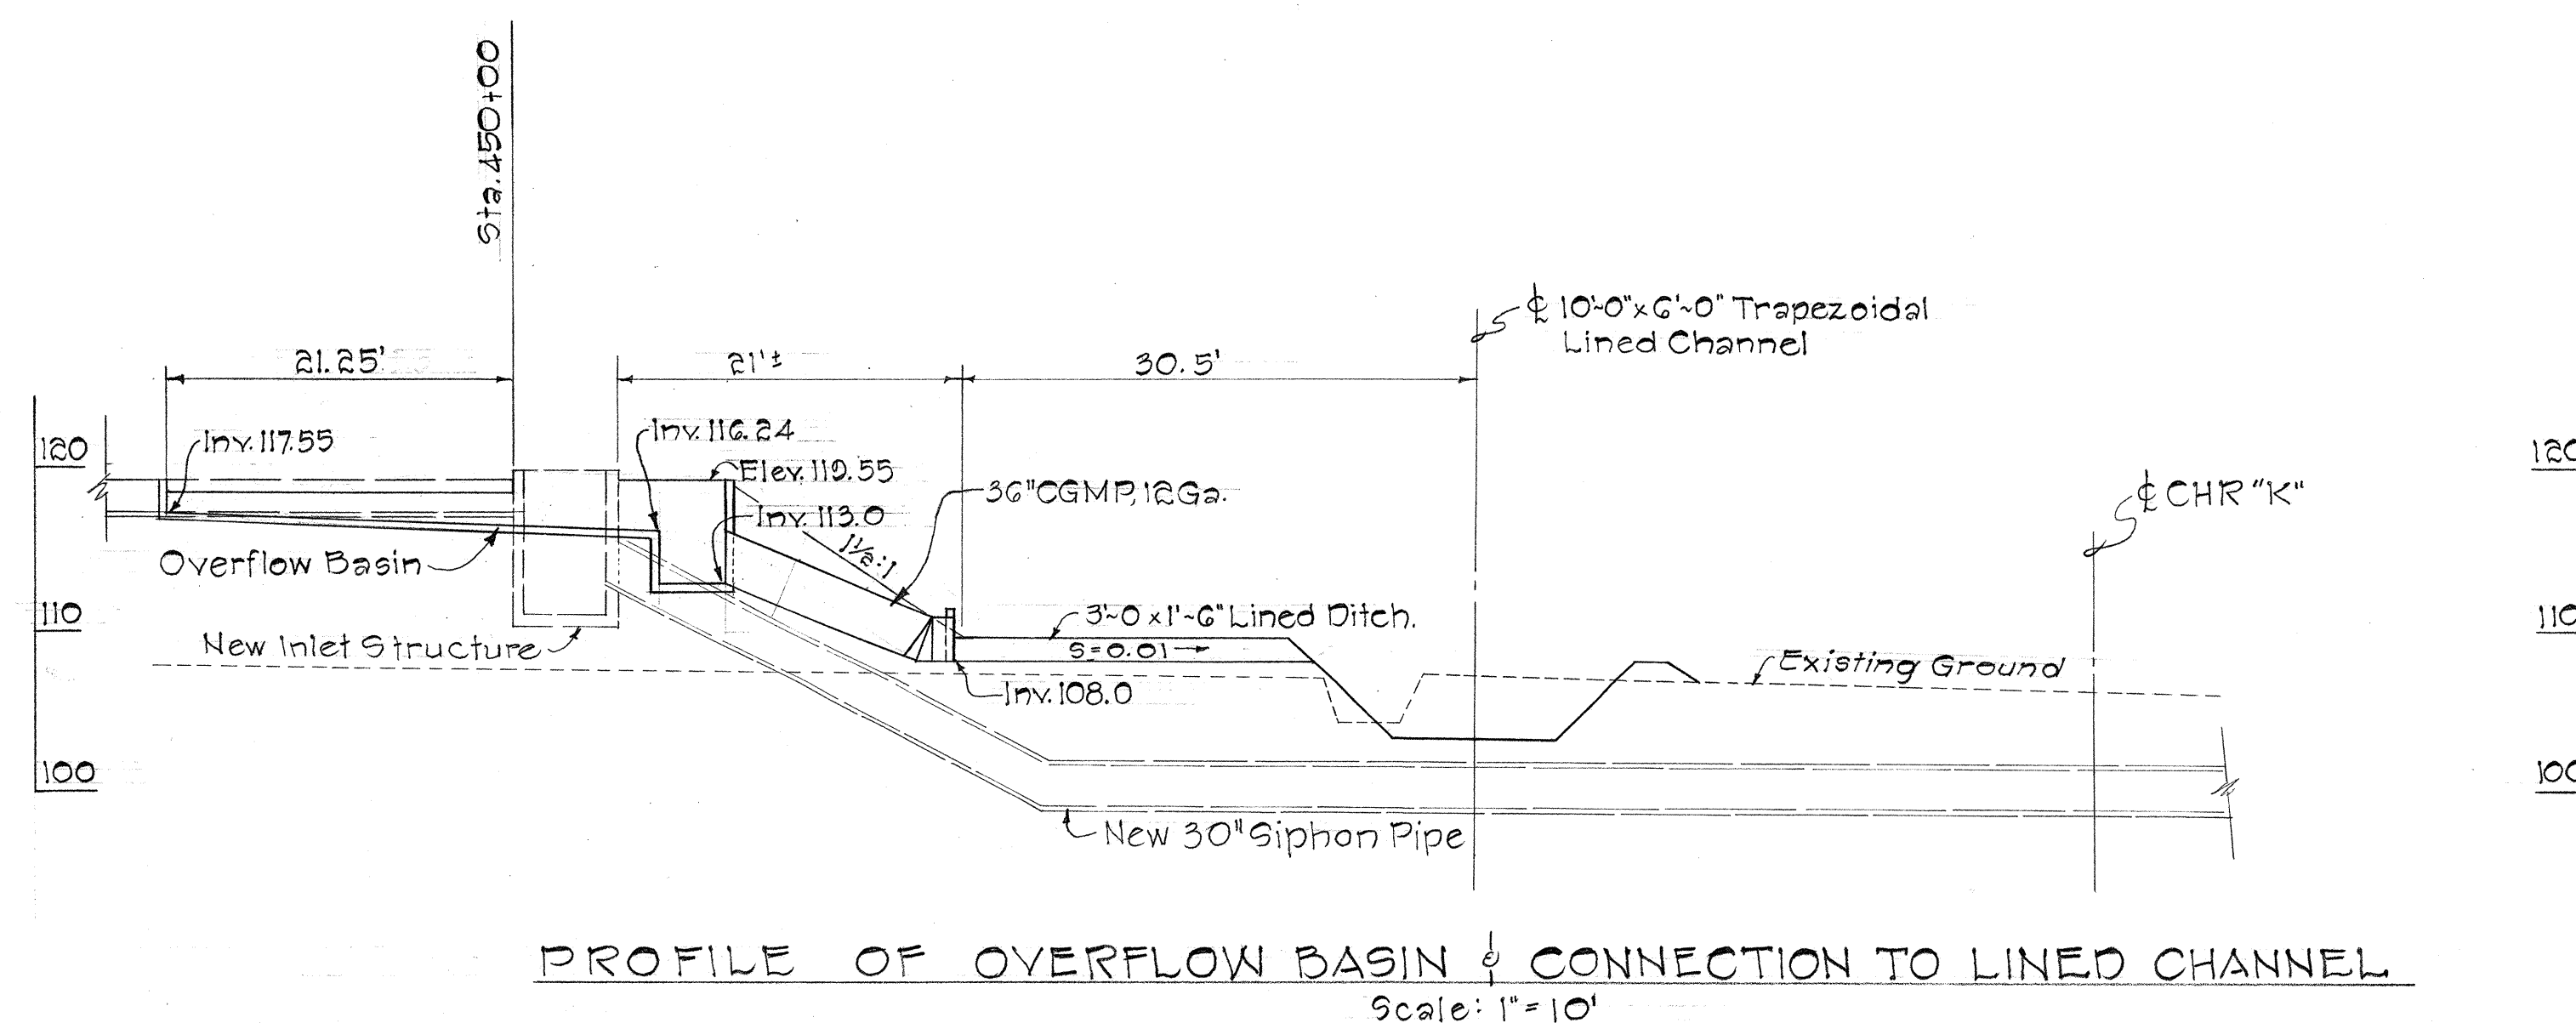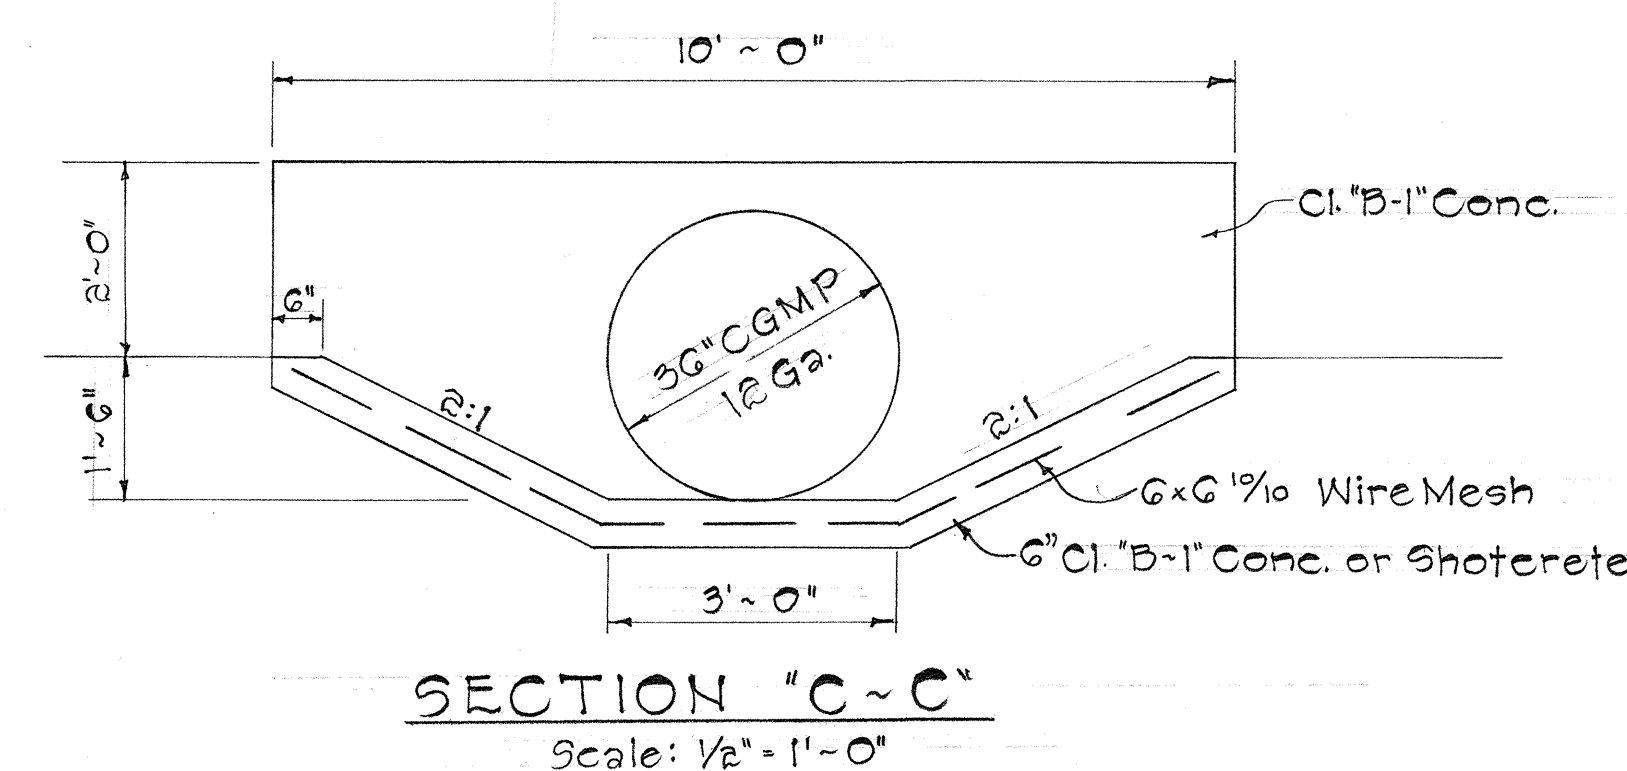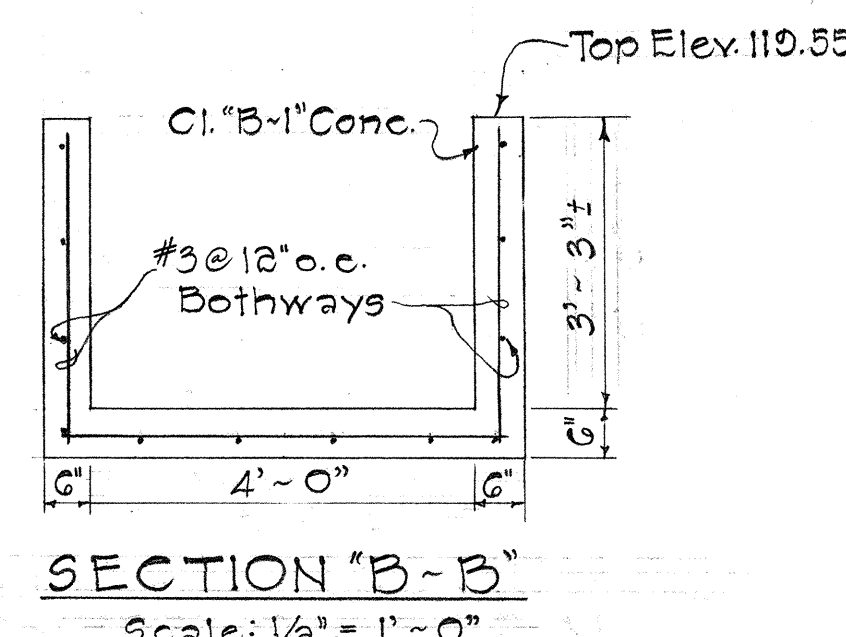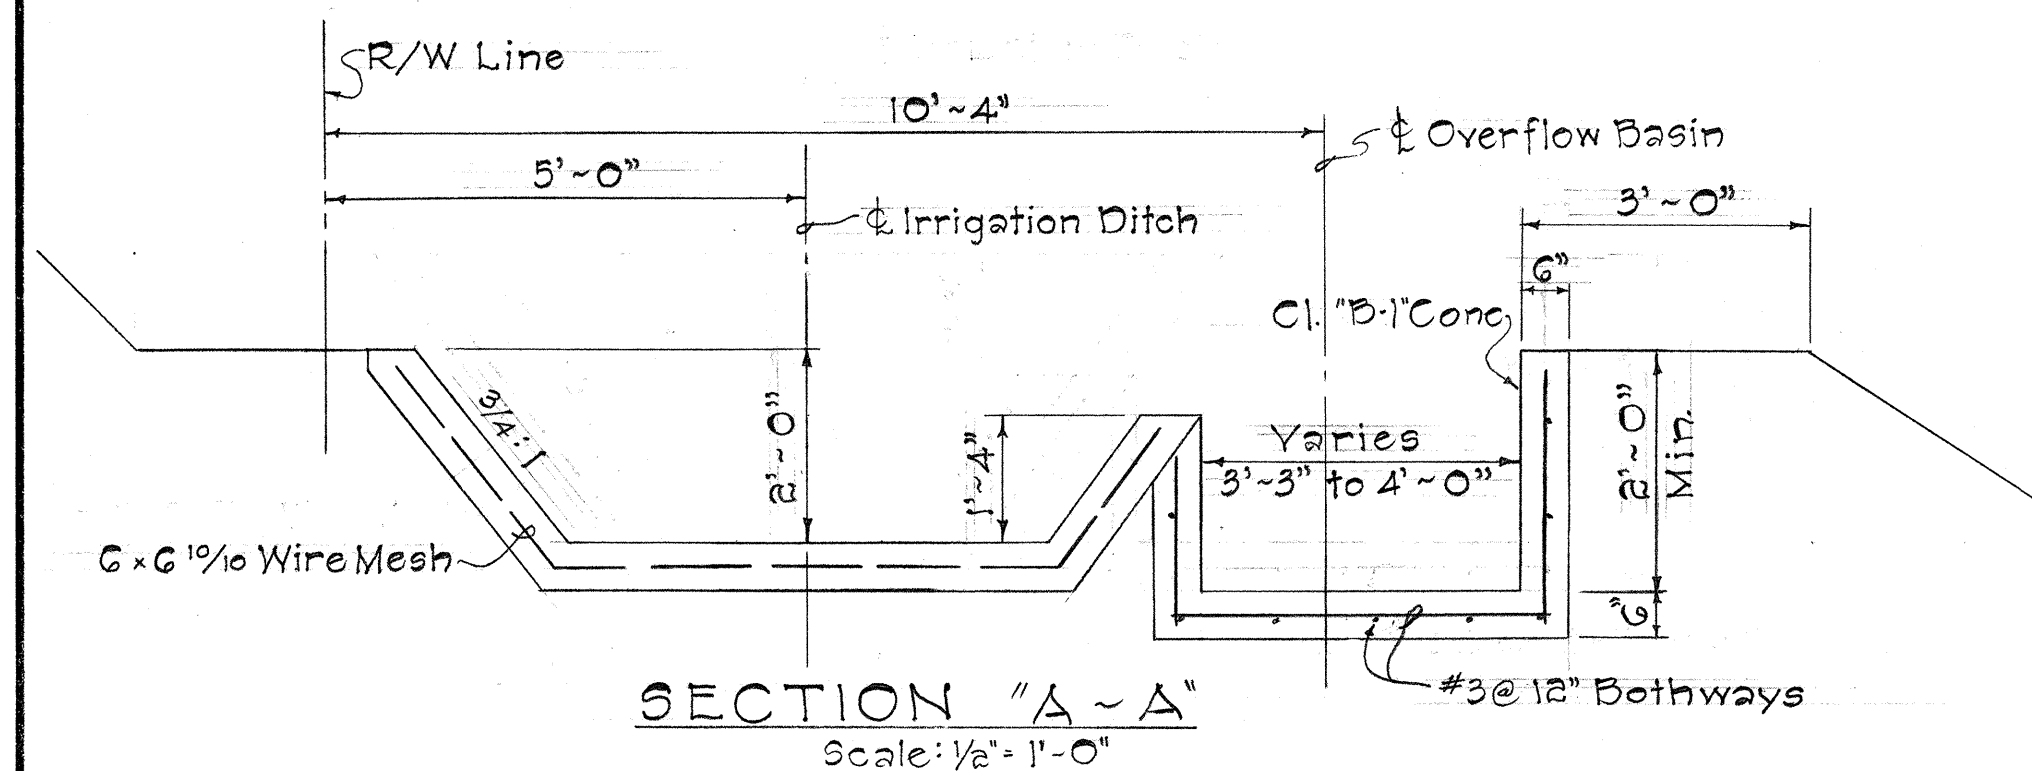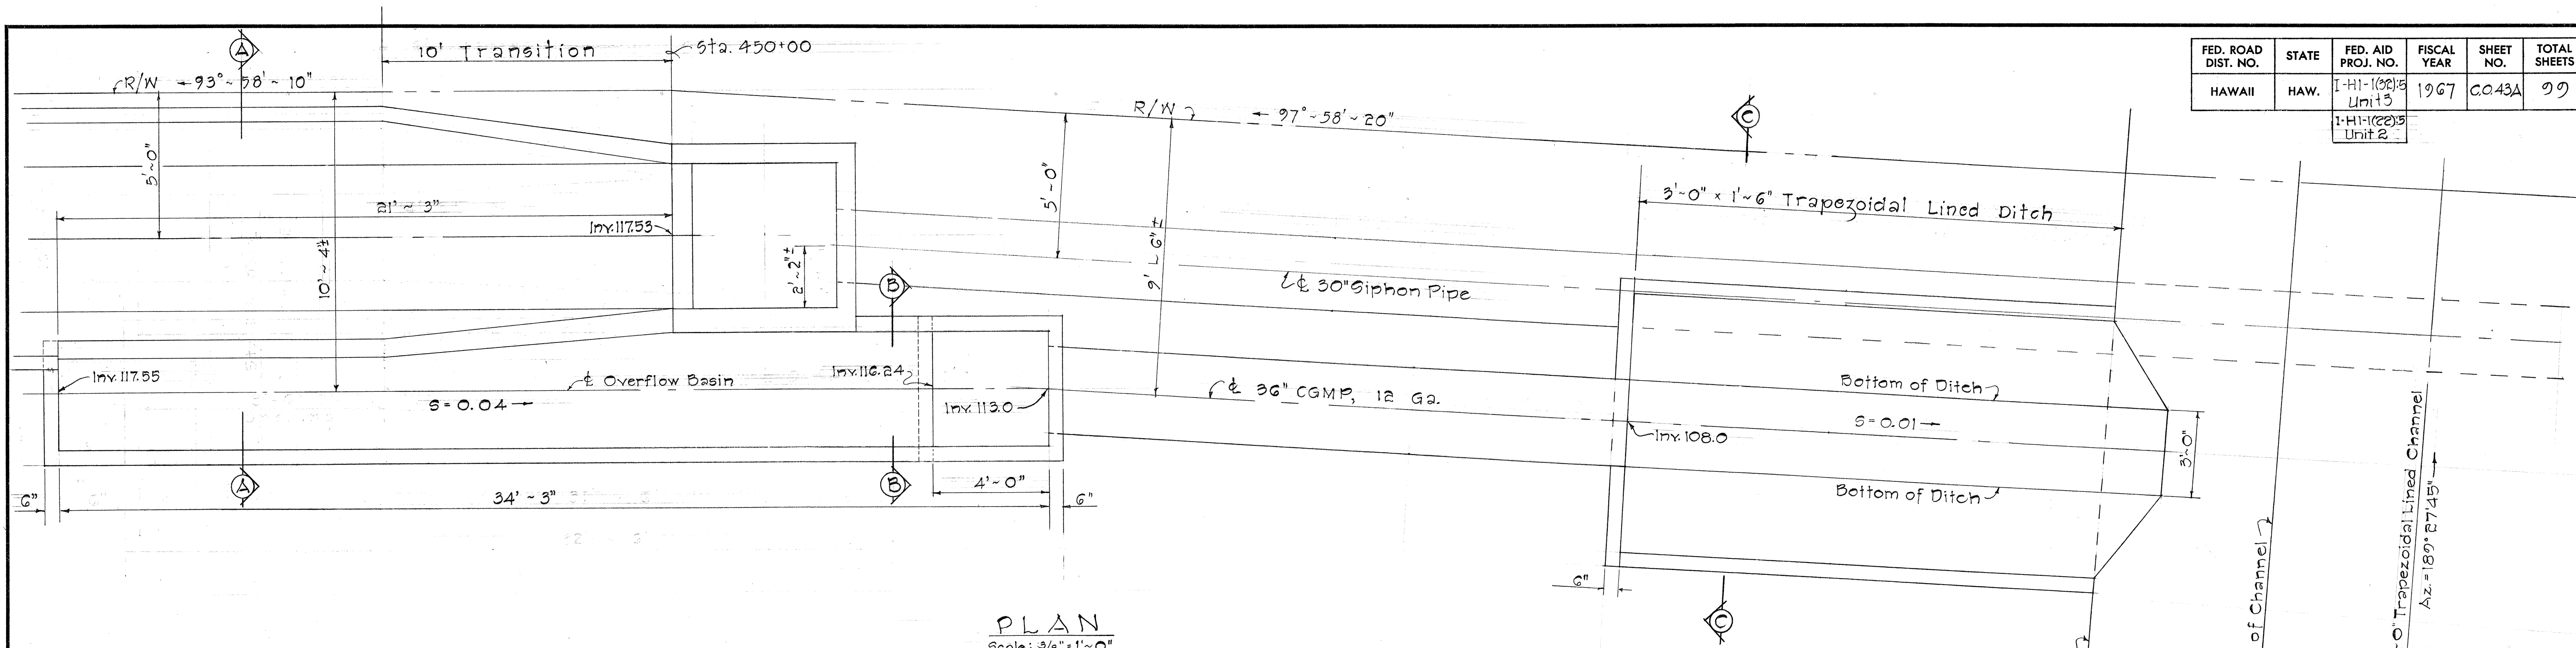

STATE OF HAWAII
DEPARTMENT OF TRANSPORTATION
HIGHWAYS DIVISION


IRRIGATION DETAILS
OVERFLOW BASIN AND
CONNECTION TO LINED CHANNEL
INTERSTATE ROUTE H-1
F.A.I. Proj. Nos I-HI-1(22)5 Unit 3
Scale: As shown Date: Sept, 1967

SHEET No. 14A OF 28 SHEETS


April 1, 1968

C 0 1 3 A


FED. ROAD DIST. NO.	STATE	FED. AID PROJ. NO.	FISCAL YEAR	SHEET NO.	TOTAL SHEETS
HAWAII	HAW.	I-H-1(22)5 Unit 2	1967	C.O.44	99

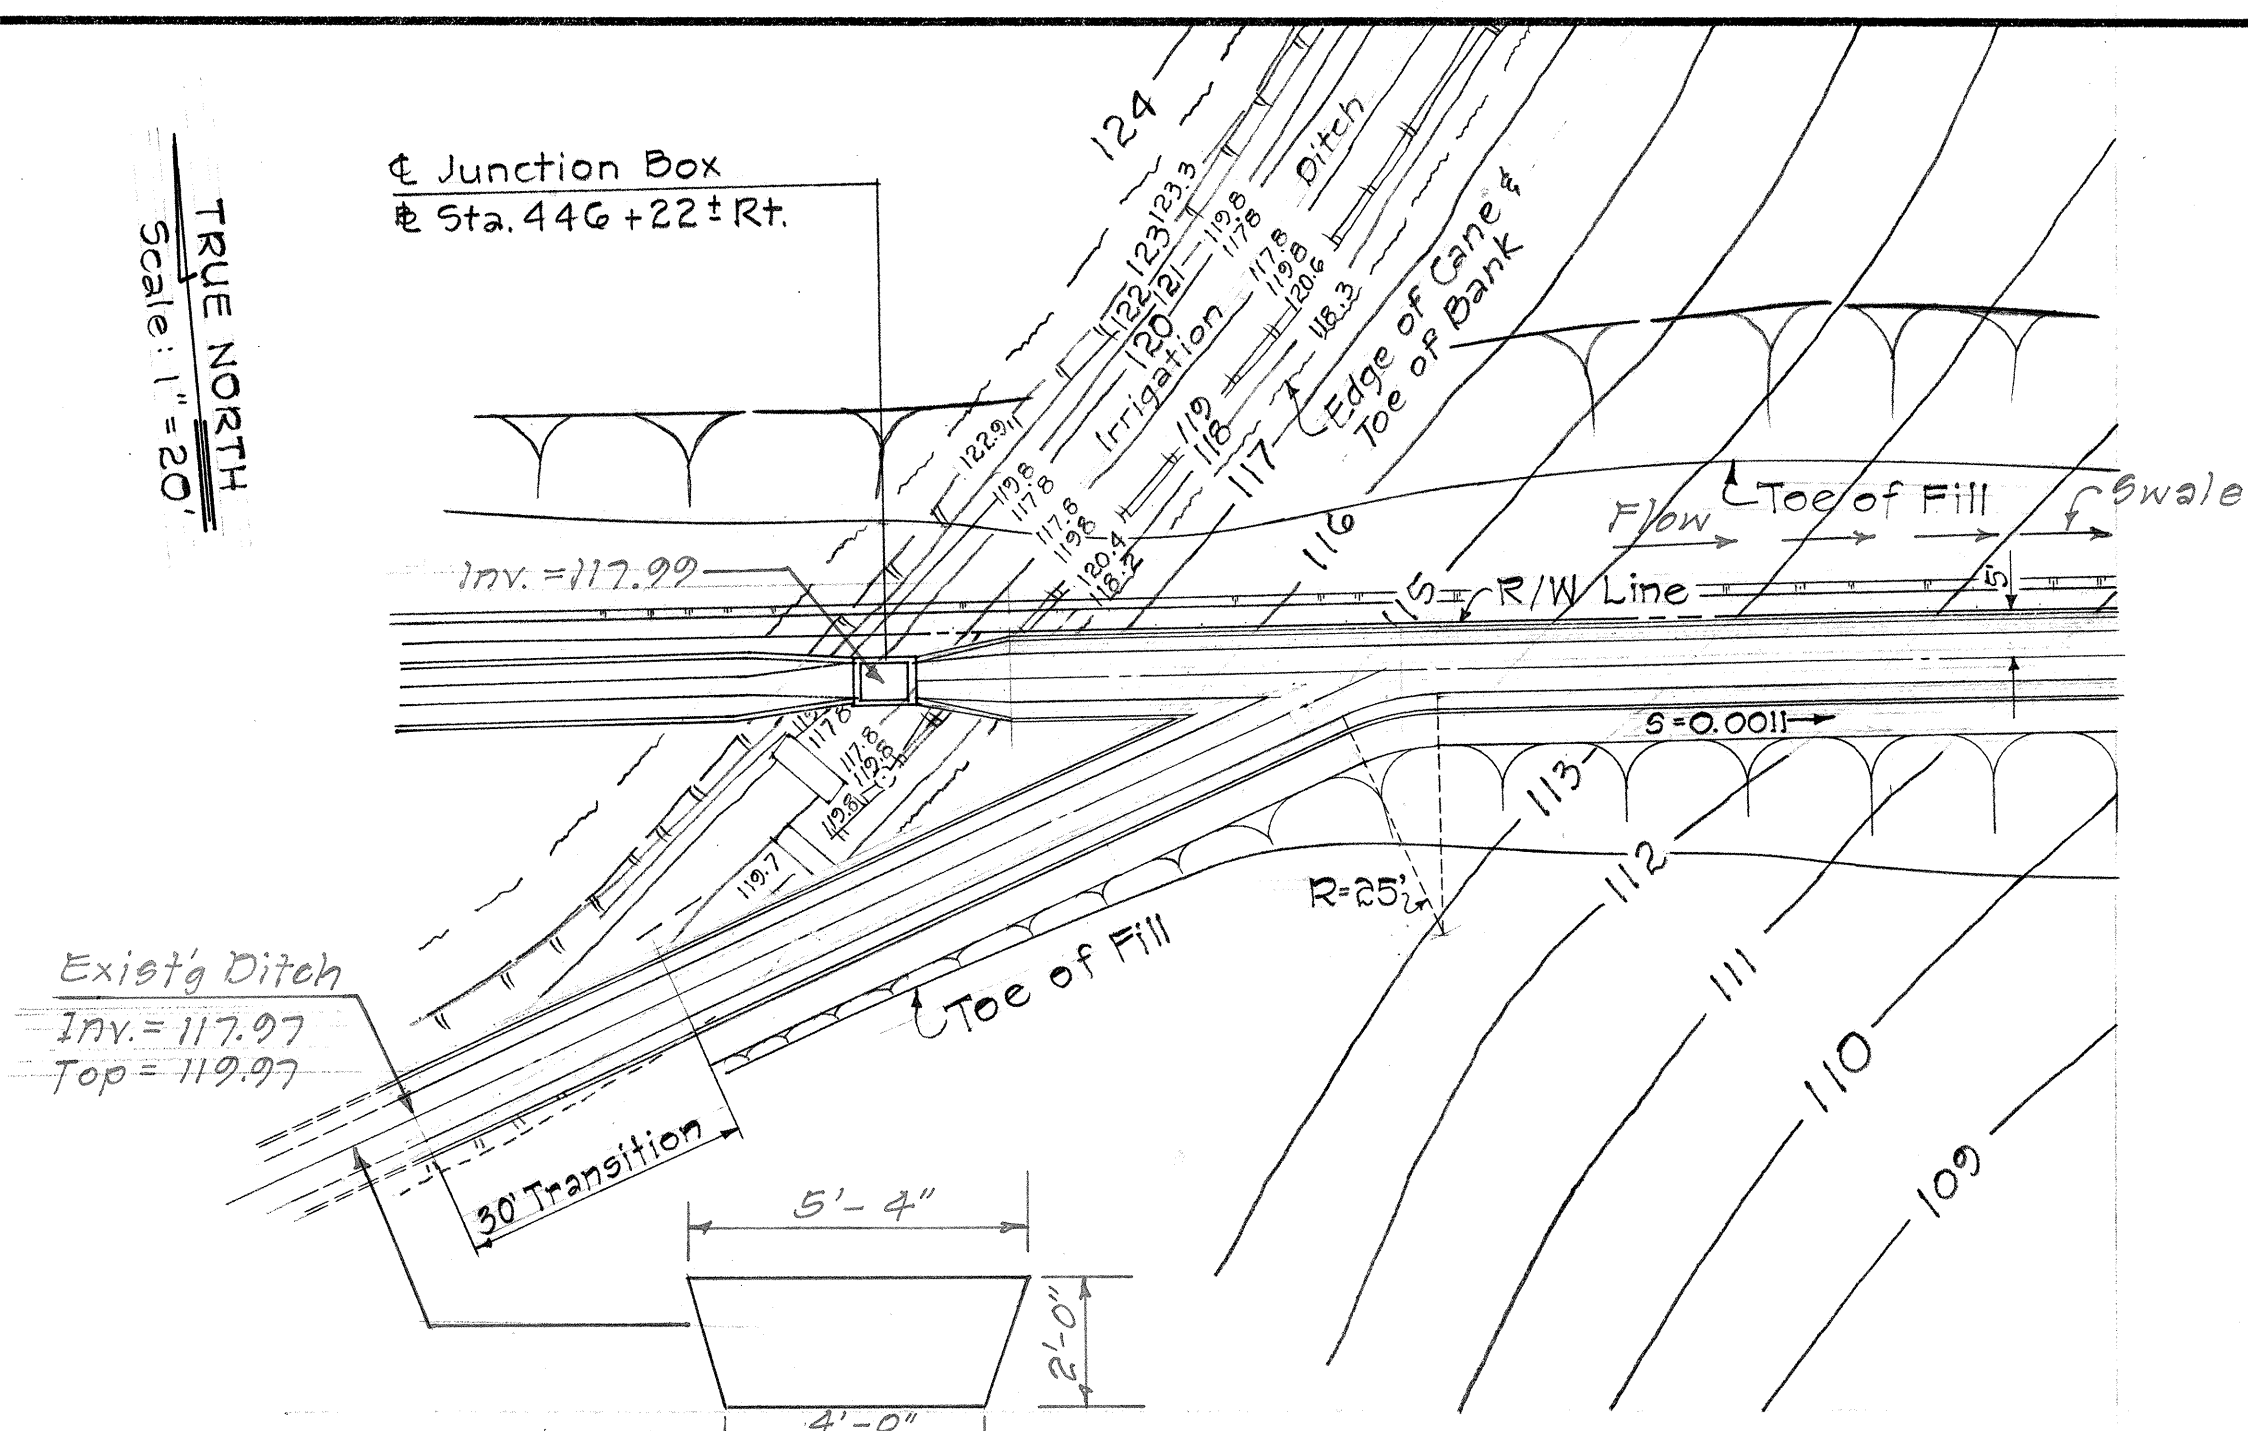


DETAIL OF DITCH CONNECTION AT STA. 446+70 ± RT.
Scale: 1" = 20'

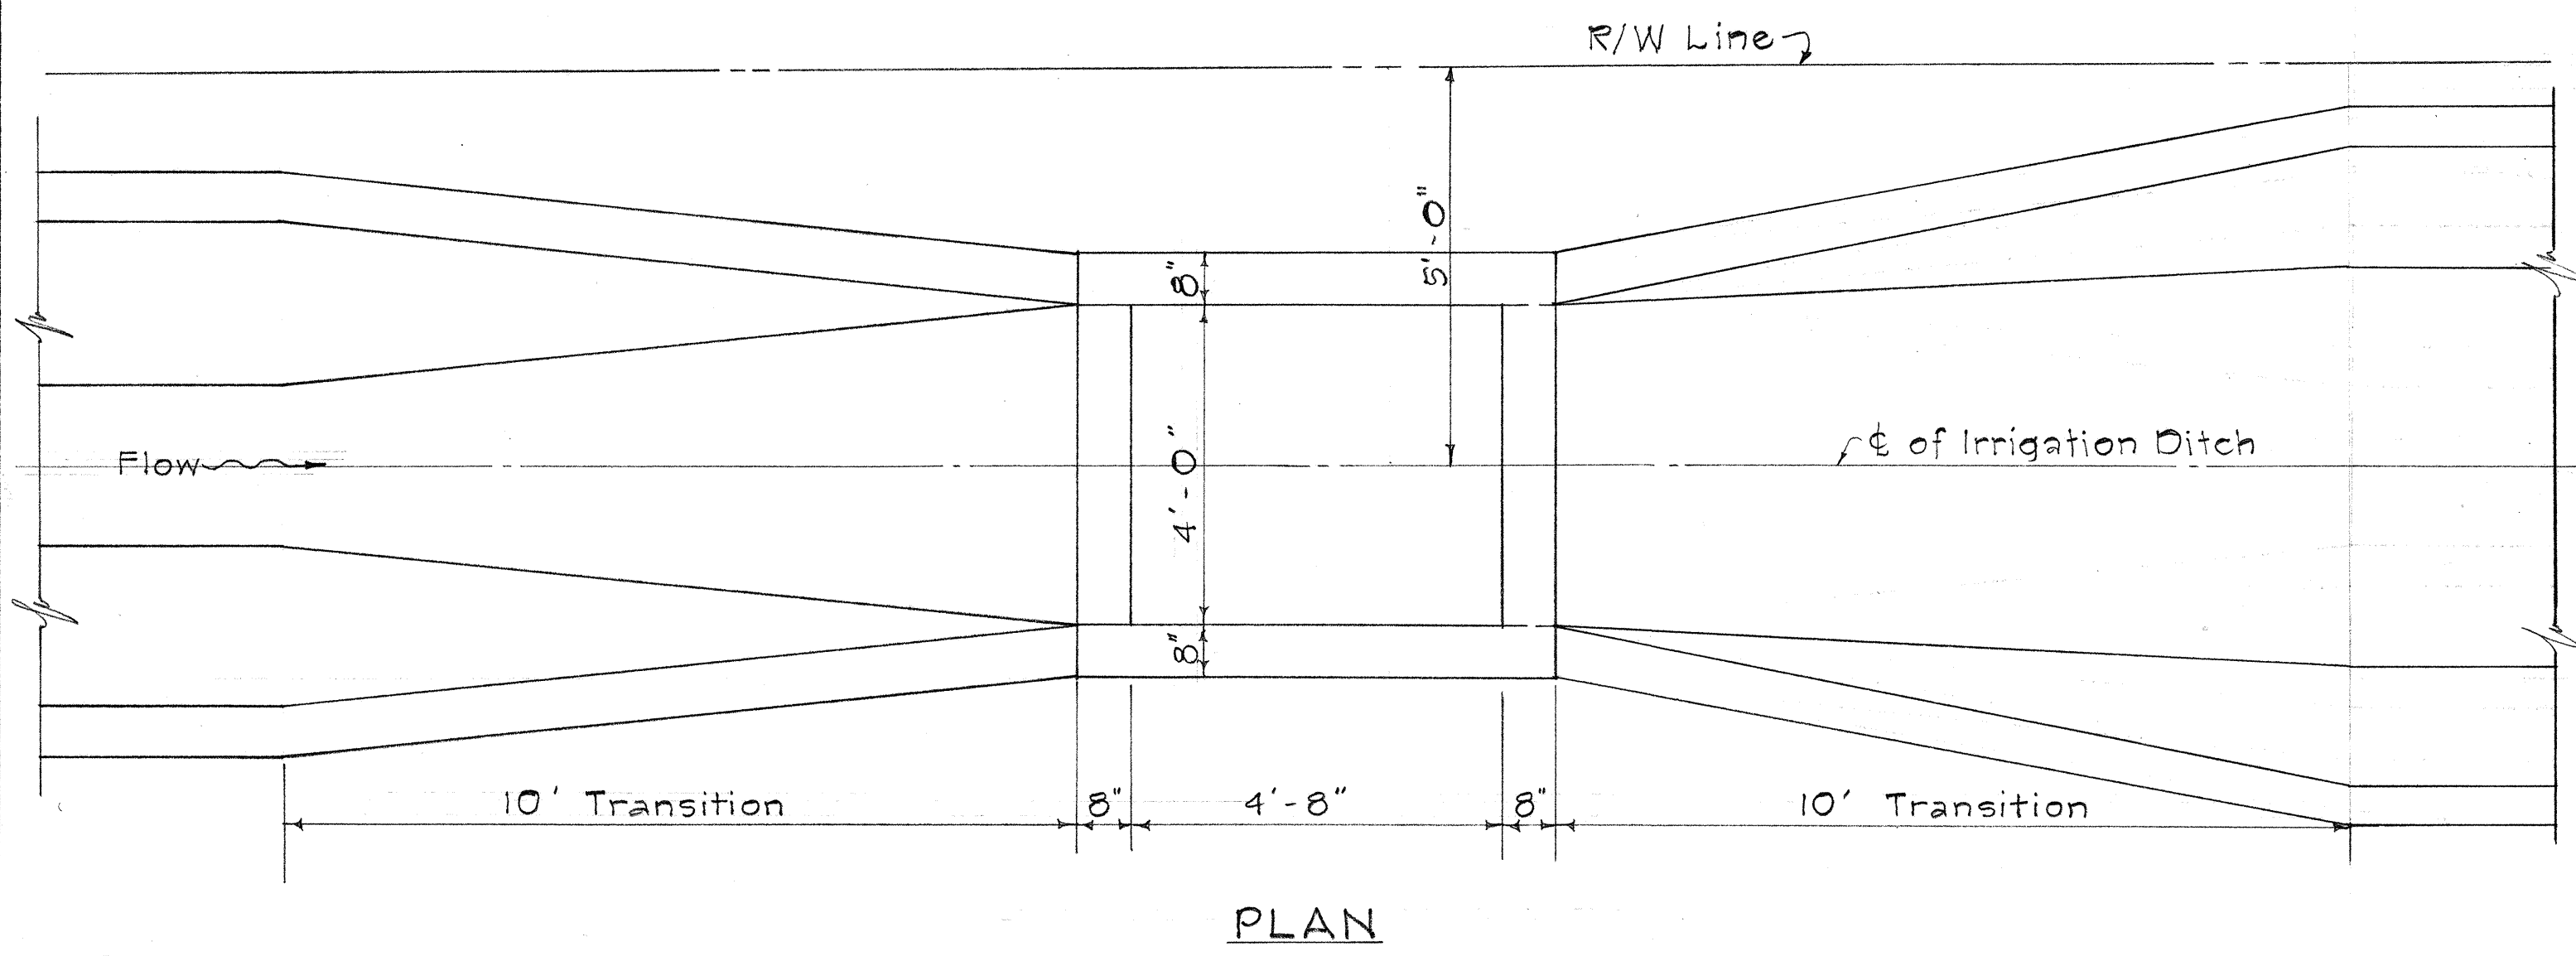

IRRIGATION JUNCTION BOX @ STA. 446+22 RT.
Scale: 1/2" = 1'-0"

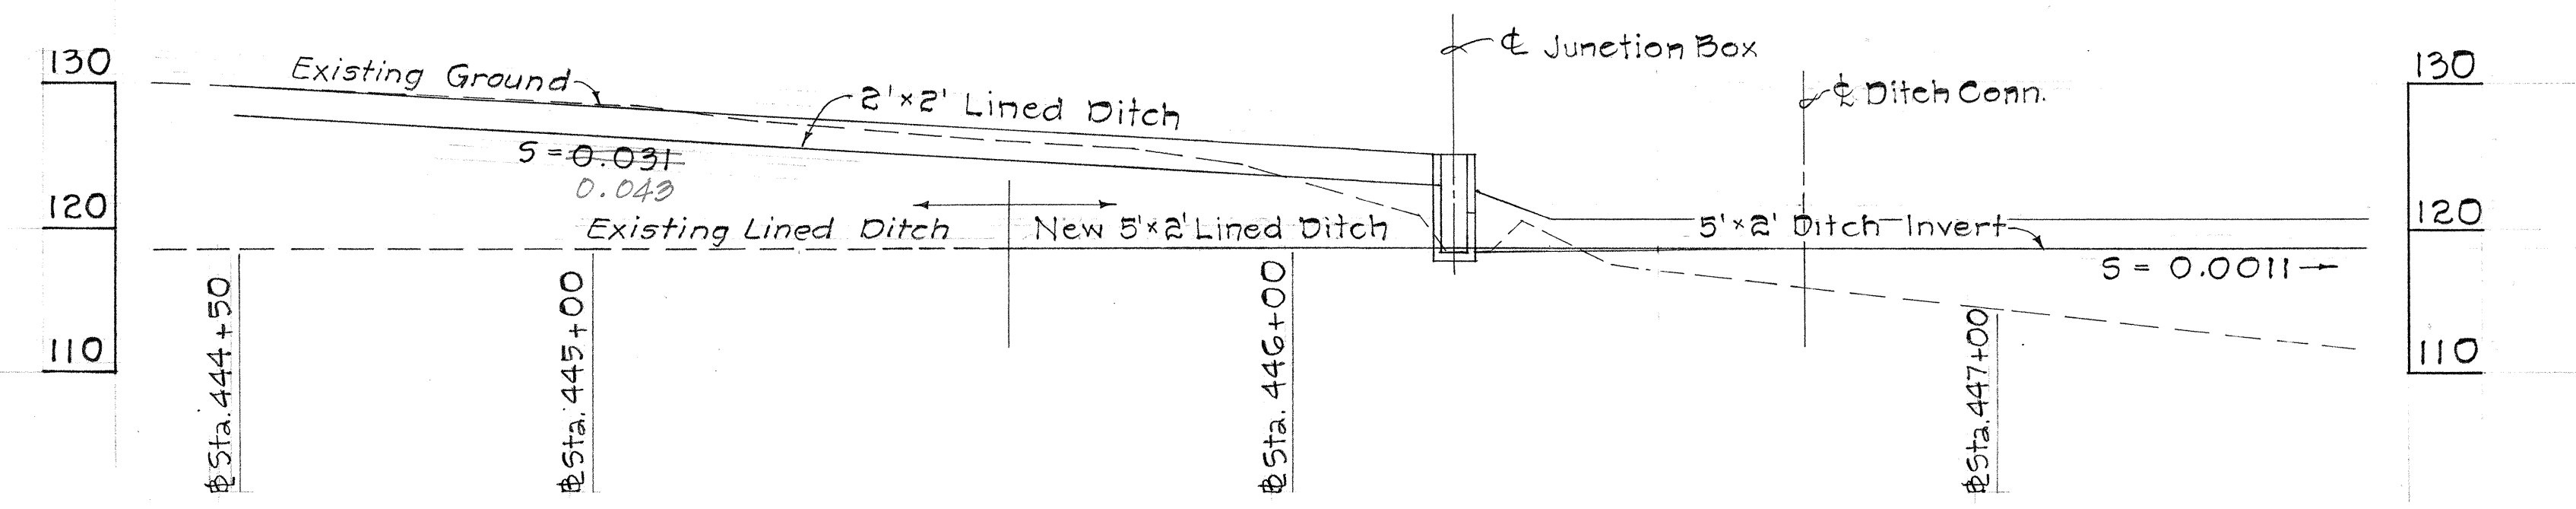


PROFILE OF IRRIGATION DITCH ALONG INBOUND LANE R/W
Scale: Horiz. 1" = 20'
Vert. 1" = 10'

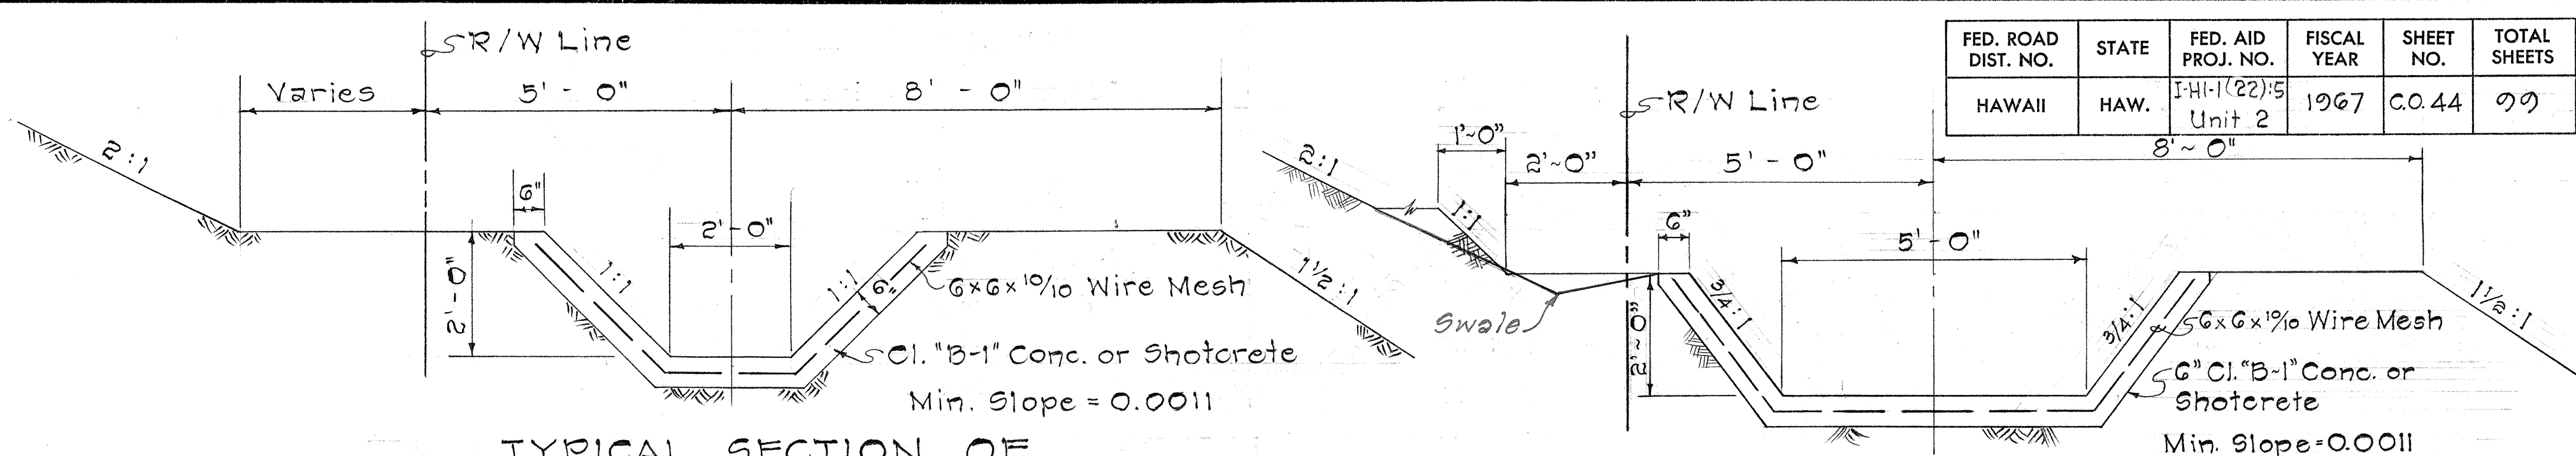


TYPICAL SECTION OF 2'x2' TRAPEZOIDAL IRRIGATION DITCH
Scale: 1/2" = 1'-0"


TYPICAL SECTION OF 5'x2' TRAPEZOIDAL IRRIGATION DITCH BETWEEN STA. 446+23 AND STA. 450+00
Scale: 1/2" = 1'-0"

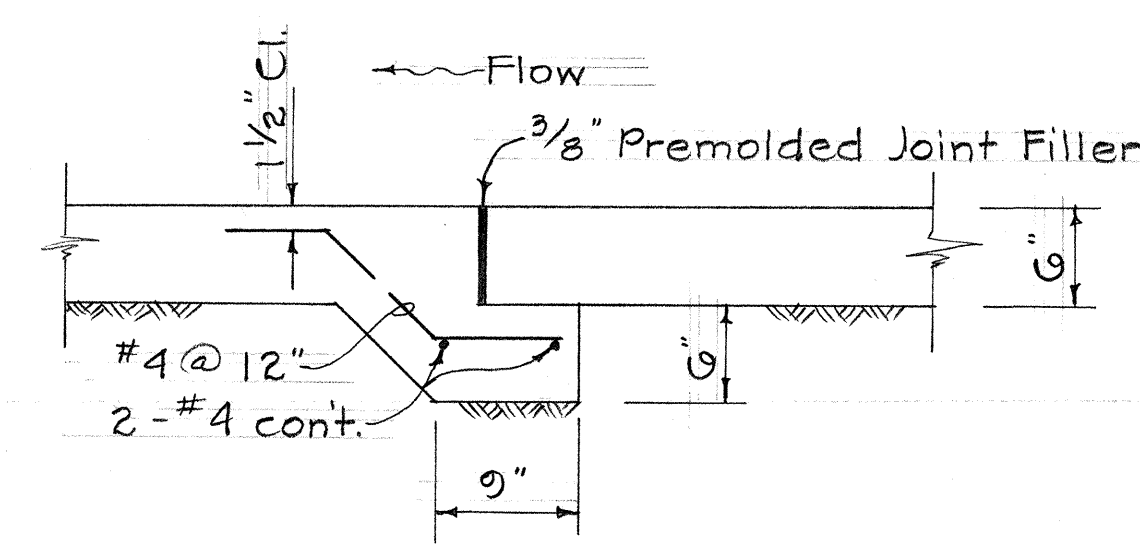

TYPICAL EXPANSION JOINT @ 90' o.c. FOR TRAPEZOIDAL LINED DITCH
Scale: 1" = 1'-0"

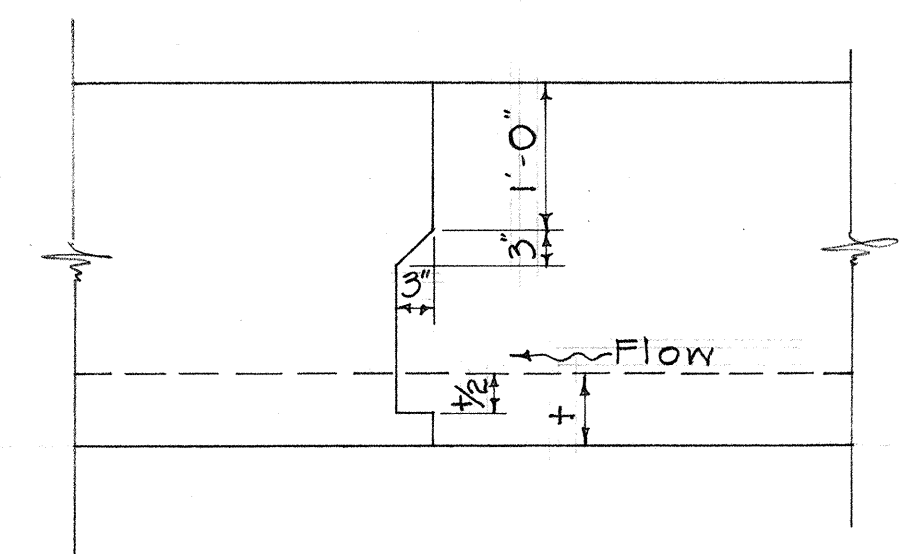

ELEVATION VIEW
TYPICAL CONSTRUCTION JOINT @ 30' o.c. FOR TRAPEZOIDAL LINED DITCH
Scale: 3/4" = 1'-0"

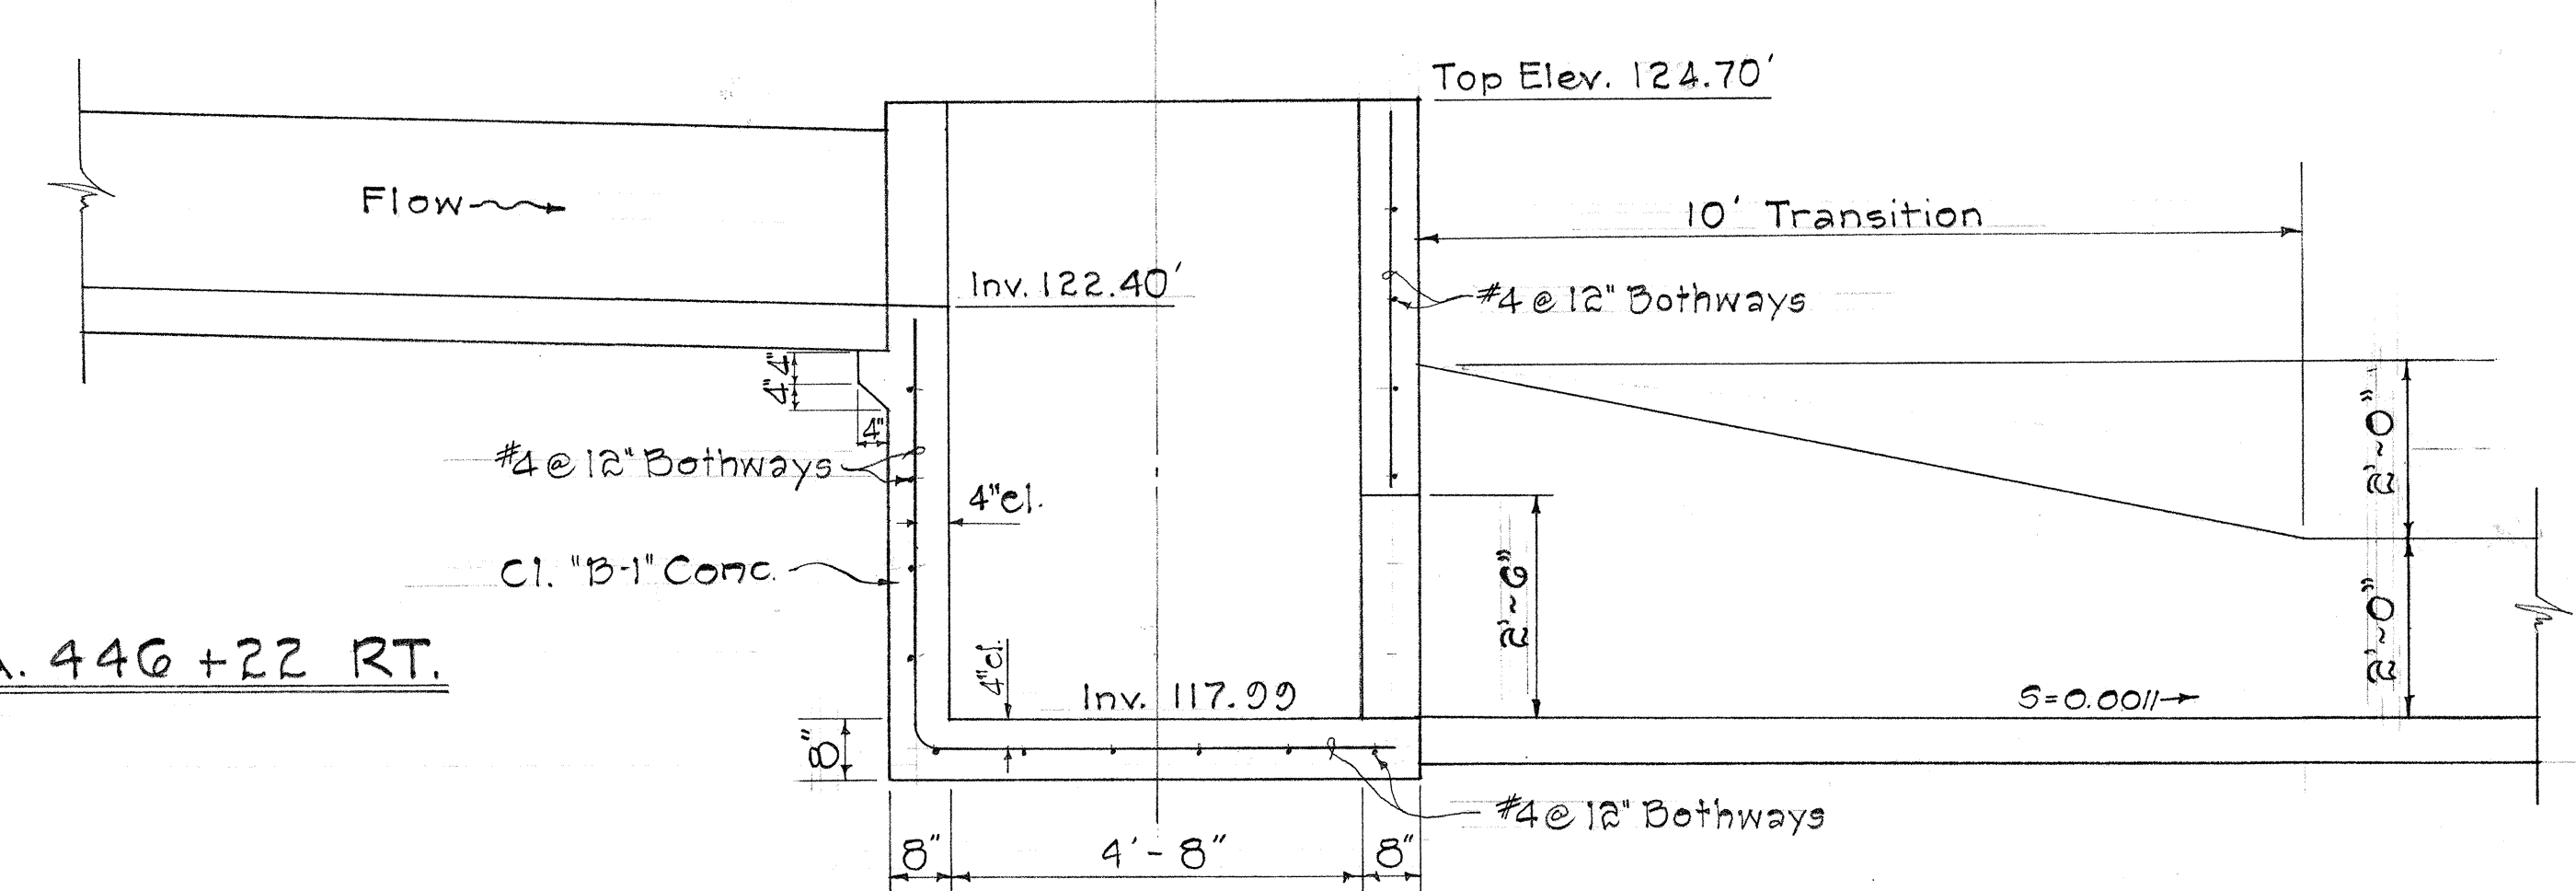

ELEVATION

STATE OF HAWAII
DEPARTMENT OF TRANSPORTATION
HIGHWAYS DIVISION

IRRIGATION DETAILS
DITCH CONNECTIONS AND IRRIGATION
JUNCTION BOX AT STA. 446+22 RT.
TYPICAL SECTION OF 2'x2' DITCH

INTERSTATE ROUTE H-1
F.A.I. PROJ. NO. I-H-1(22)5, Unit 2
Scale: As Shown Date: June, 1967


SHEET No. 15 OF 28 SHEETS

April 1, 1968


C O 4 4

DATE	
DESIGNED BY	
TRACED BY	
NOTED BY	
CHECKED BY	
ORIGINAL PLAN	
NOTE BOOK	
No.	


FED. ROAD DIST. NO.	STATE	FED. AID PROJ. NO.	FISCAL YEAR	SHEET NO.	TOTAL SHEETS
HAWAII	HAW.	I-HI-1(32):5 Unit 3	1967	45	77

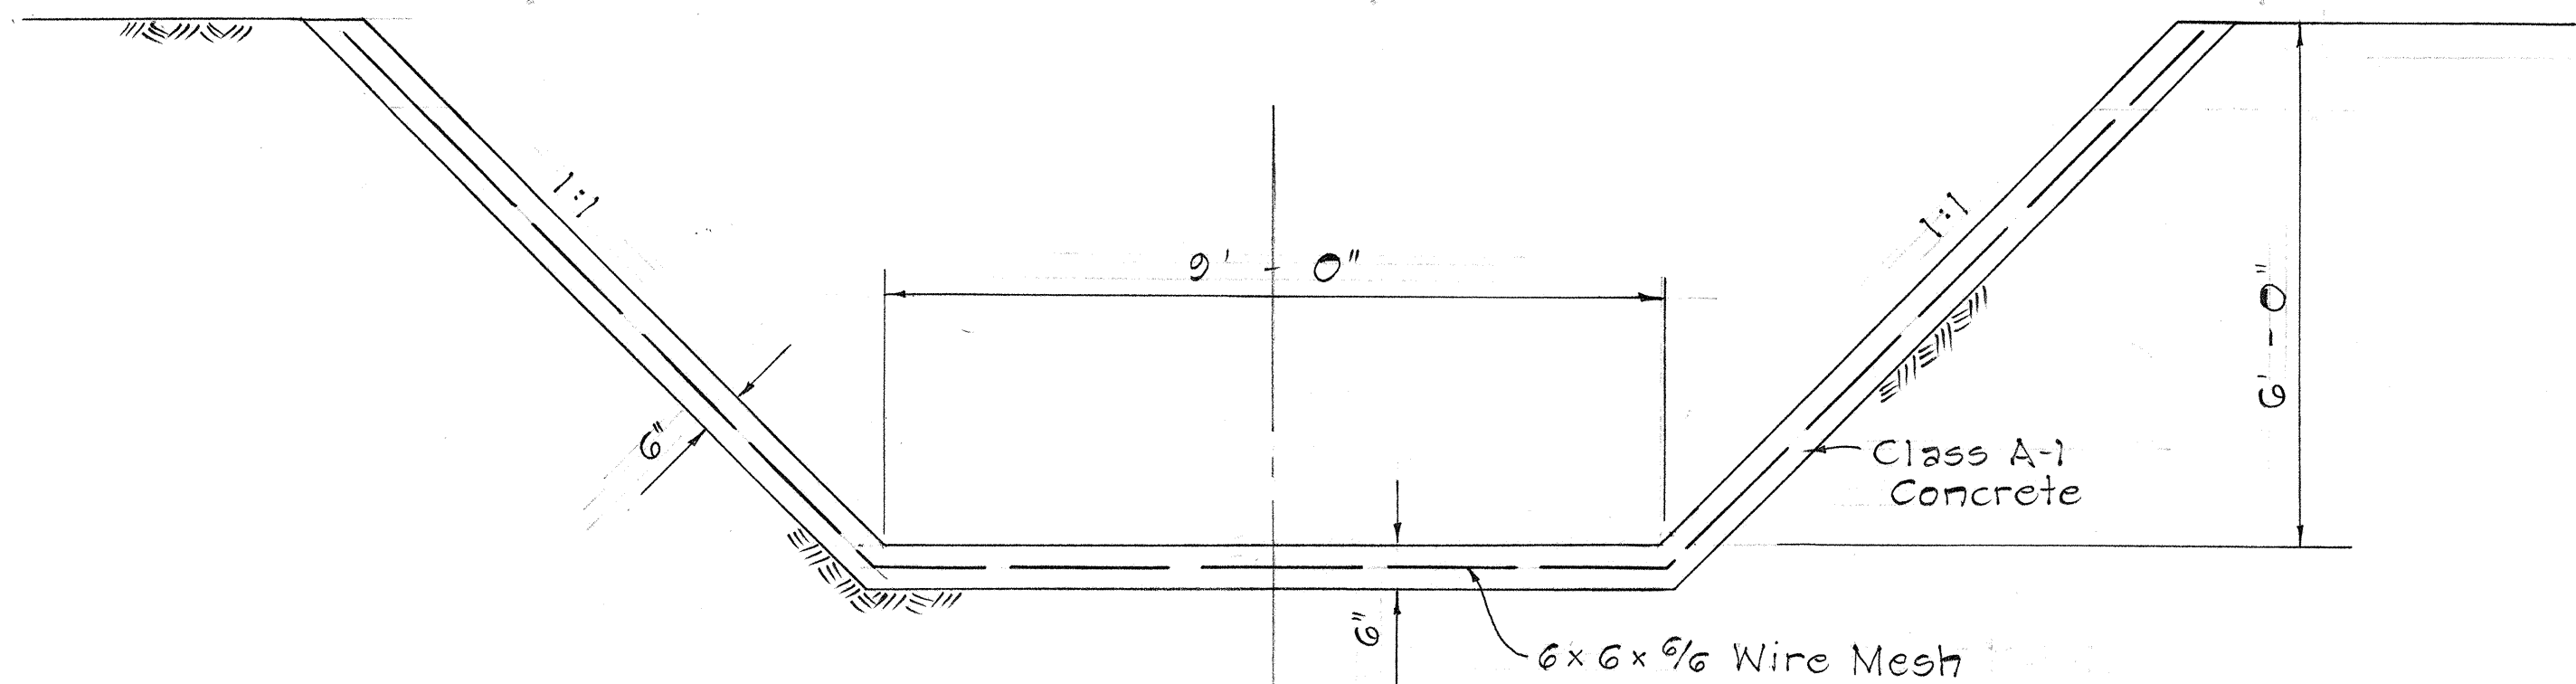


TYPICAL SECTION
9'-0" x 6'-0" TRAPEZOIDAL LINED CHANNEL
Scale: 1/2" = 1'-0"

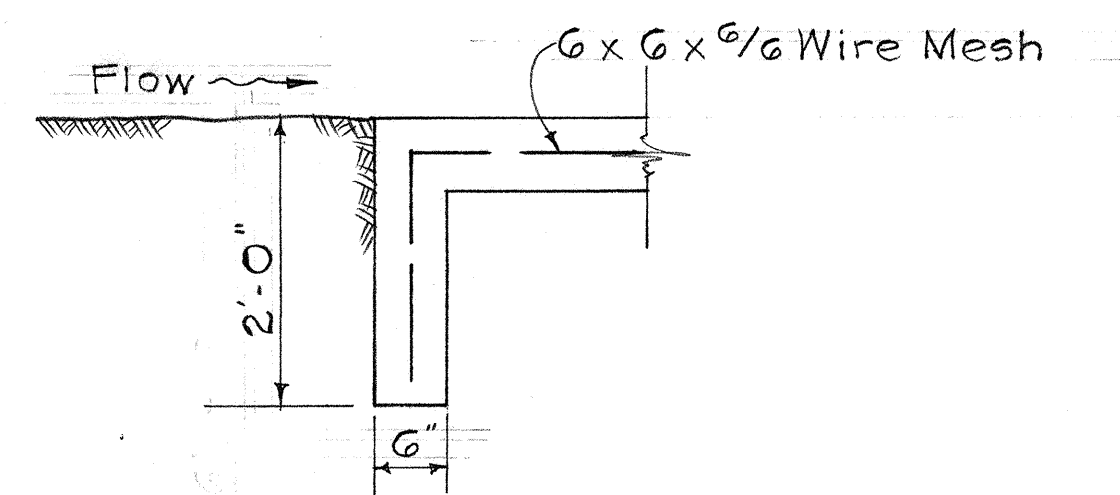


TYPICAL SECTION
CUT-OFF WALL FOR
TRAPEZOIDAL CHANNEL
Scale: 3/4" = 1'-0"

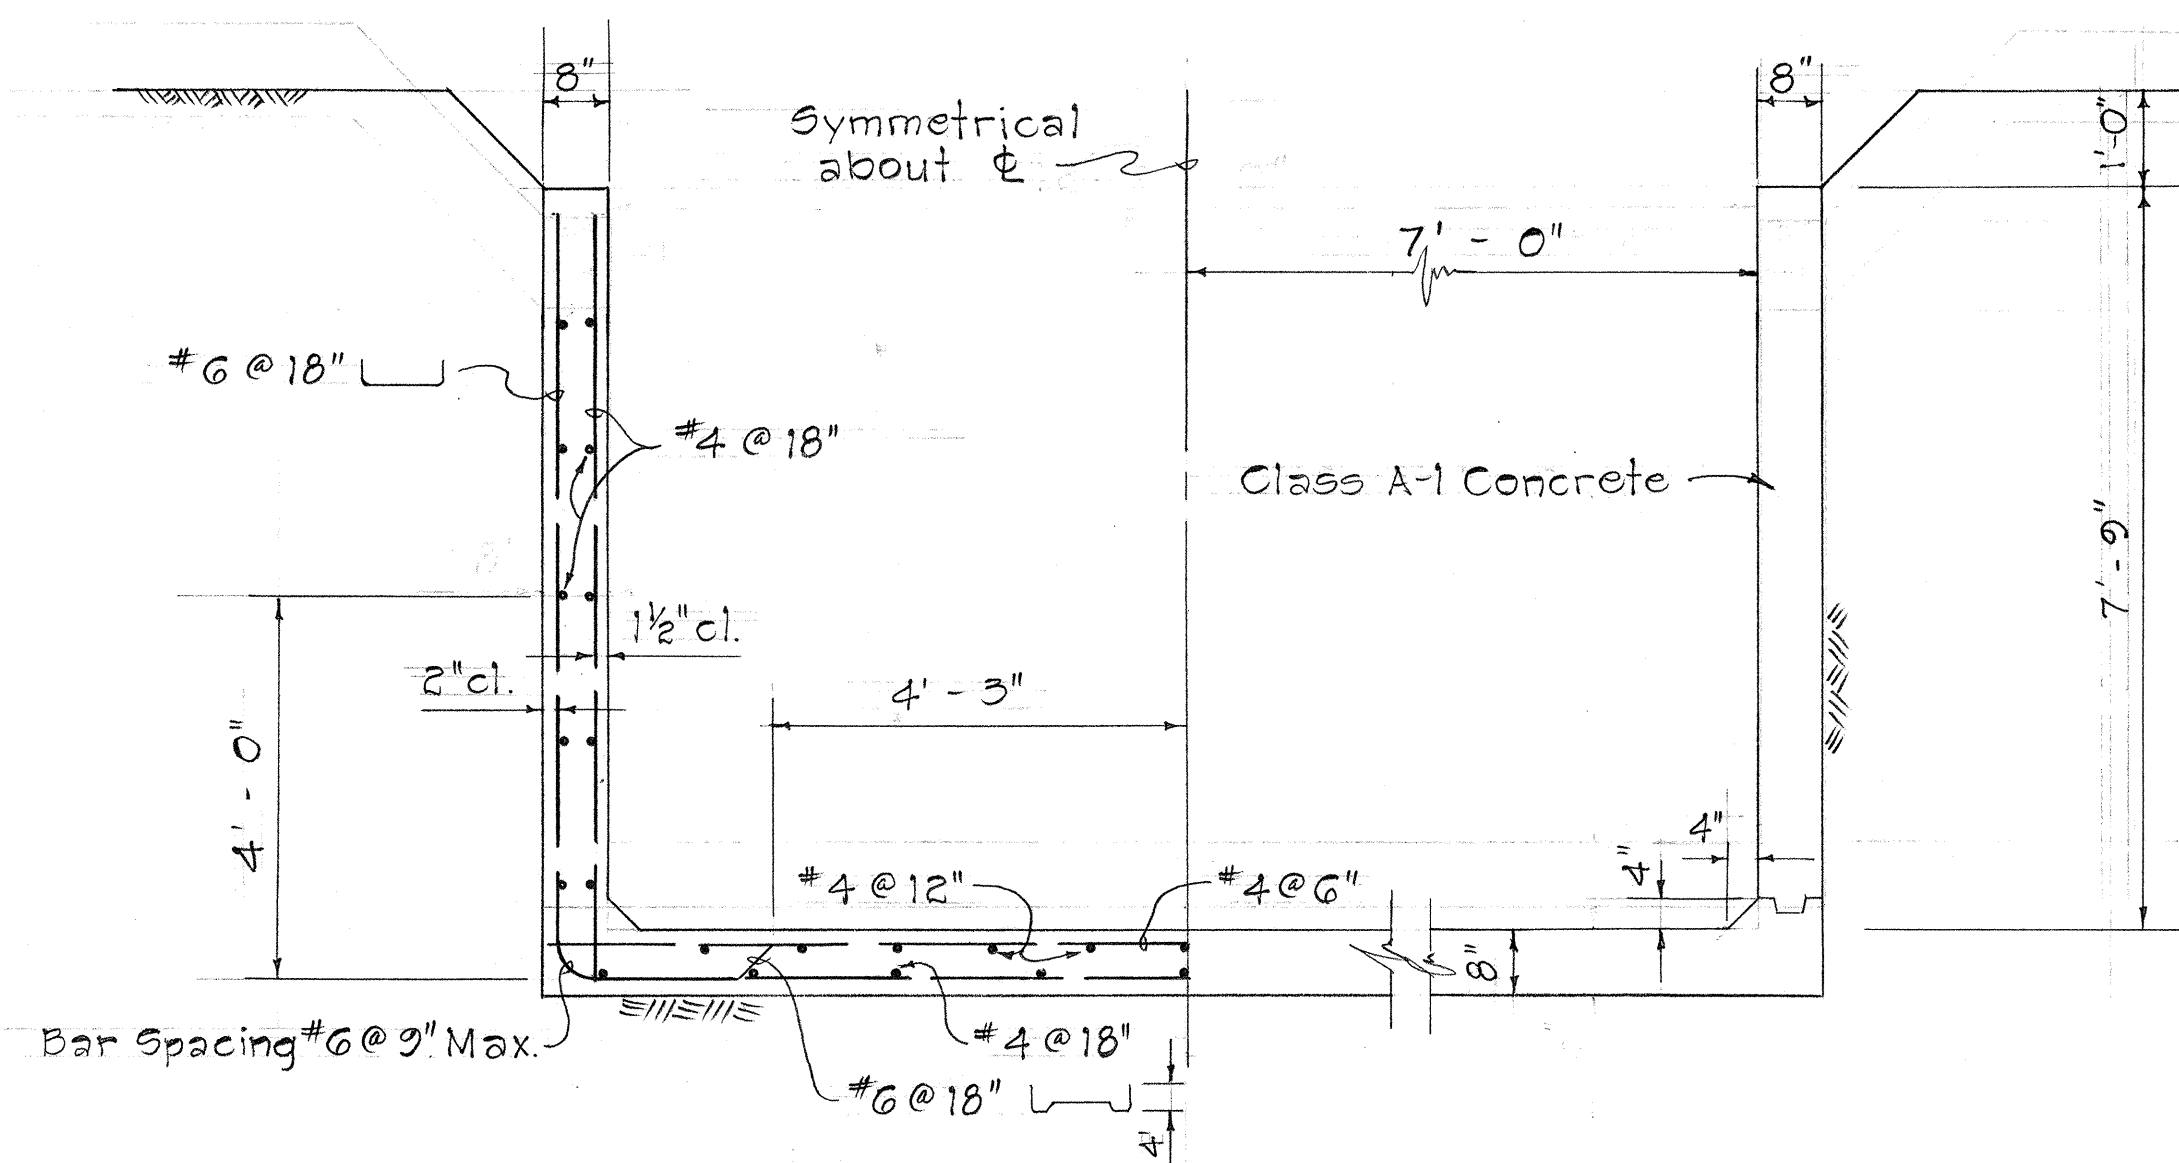


TYPICAL SECTION
14'-0" x 7'-9" RECTANGULAR LINED CHANNEL
Scale: 1/2" = 1'-0"

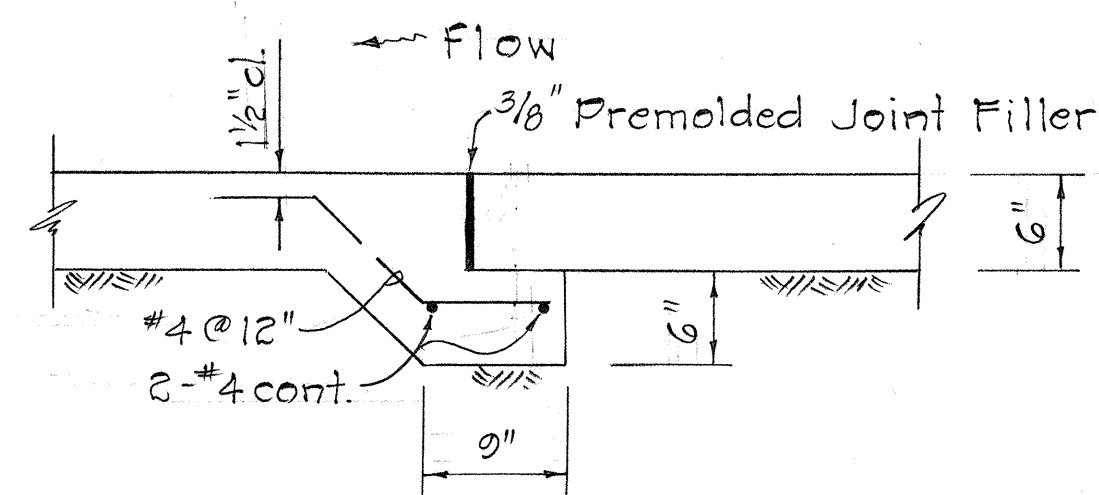


TYPICAL EXPANSION JOINT
FOR TRAPEZOIDAL LINED CHANNELS
(See Plan for Location)
Scale: 1" = 1'-0"

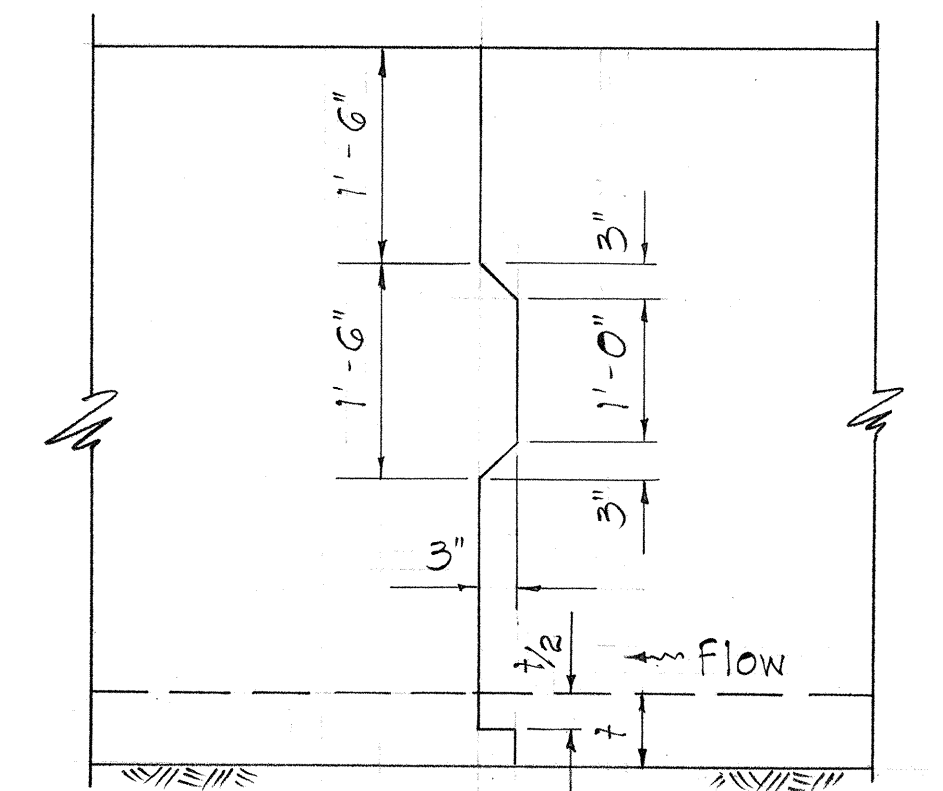

ELEVATION VIEW
TYPICAL CONSTRUCTION JOINT @ 30' o.c.
FOR TRAPEZOIDAL LINED CHANNELS
Scale: 3/4" = 1'-0"

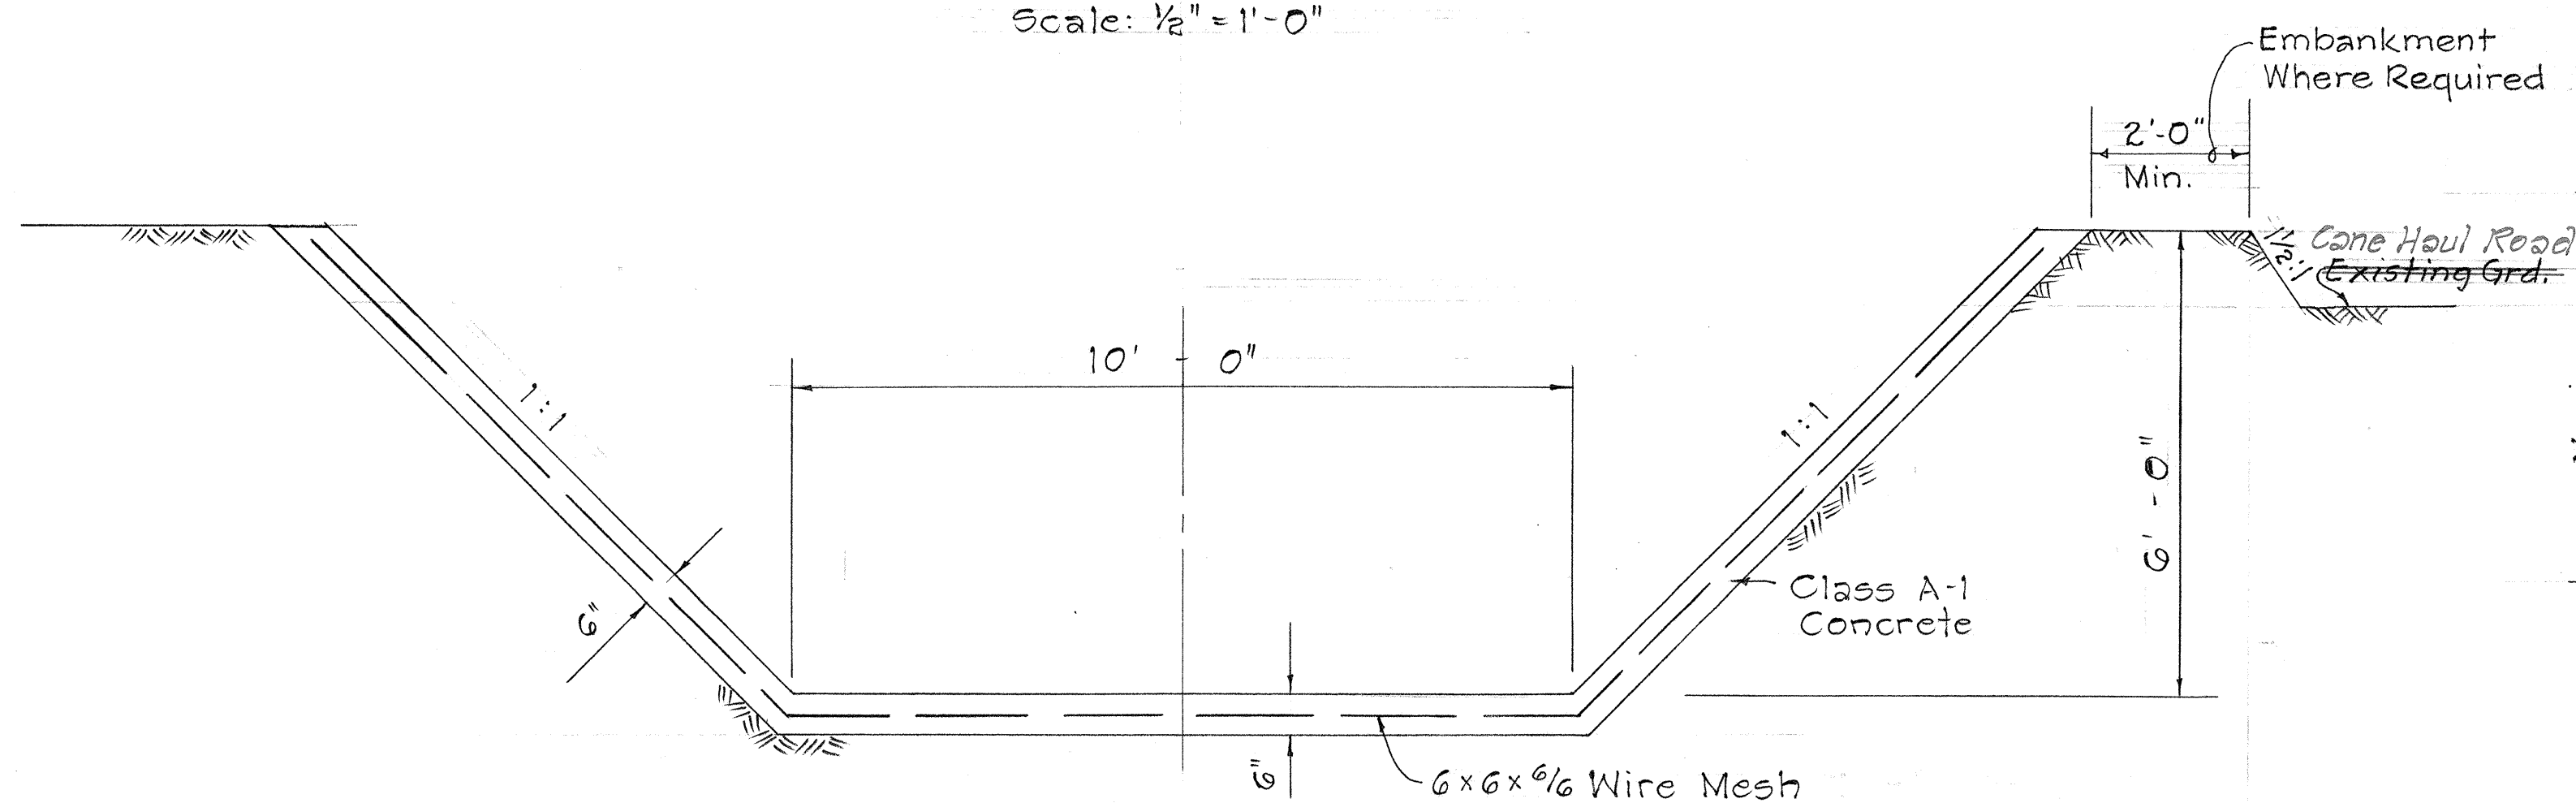

TYPICAL SECTION
10'-0" x 6'-0" TRAPEZOIDAL LINED CHANNEL
Scale: 1/2" = 1'-0"

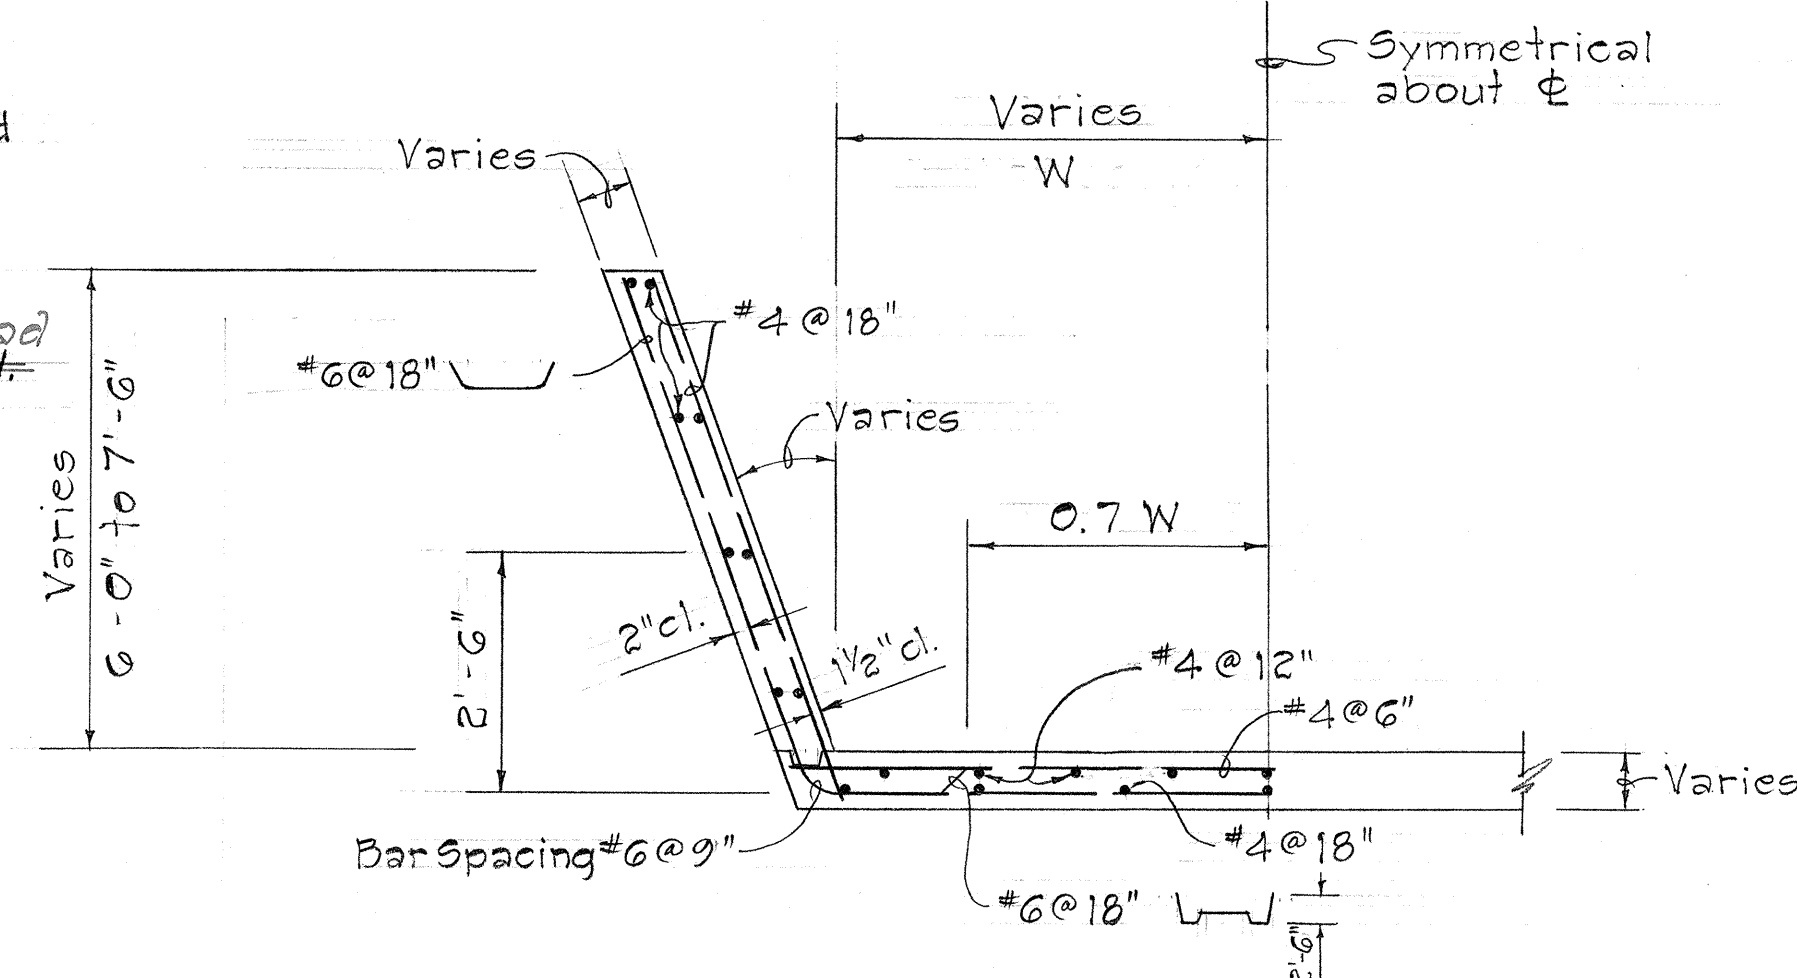

TYPICAL SECTION
TRANSITION BETWEEN TRAPEZOIDAL
AND RECTANGULAR LINED CHANNELS
Scale: 1/2" = 1'-0"


STATE OF HAWAII
DEPARTMENT OF TRANSPORTATION
HIGHWAYS DIVISION

DRAINAGE DETAILS
CONCRETE LINED CHANNEL
AT STA. 450+68


INTERSTATE ROUTE H-1
F.A.I. PROJ. NO. I-HI-1(32):5, Unit 3
Scale: As Shown Date: June, 1967

SHEET No. 16 OF 28 SHEETS

FED. ROAD DIST. NO.	STATE	FED. AID PROJ. NO.	FISCAL YEAR	SHEET NO.	TOTAL SHEETS
HAWAII	HAW.	IHI-1(22):5 Unit 2	1967	46	99

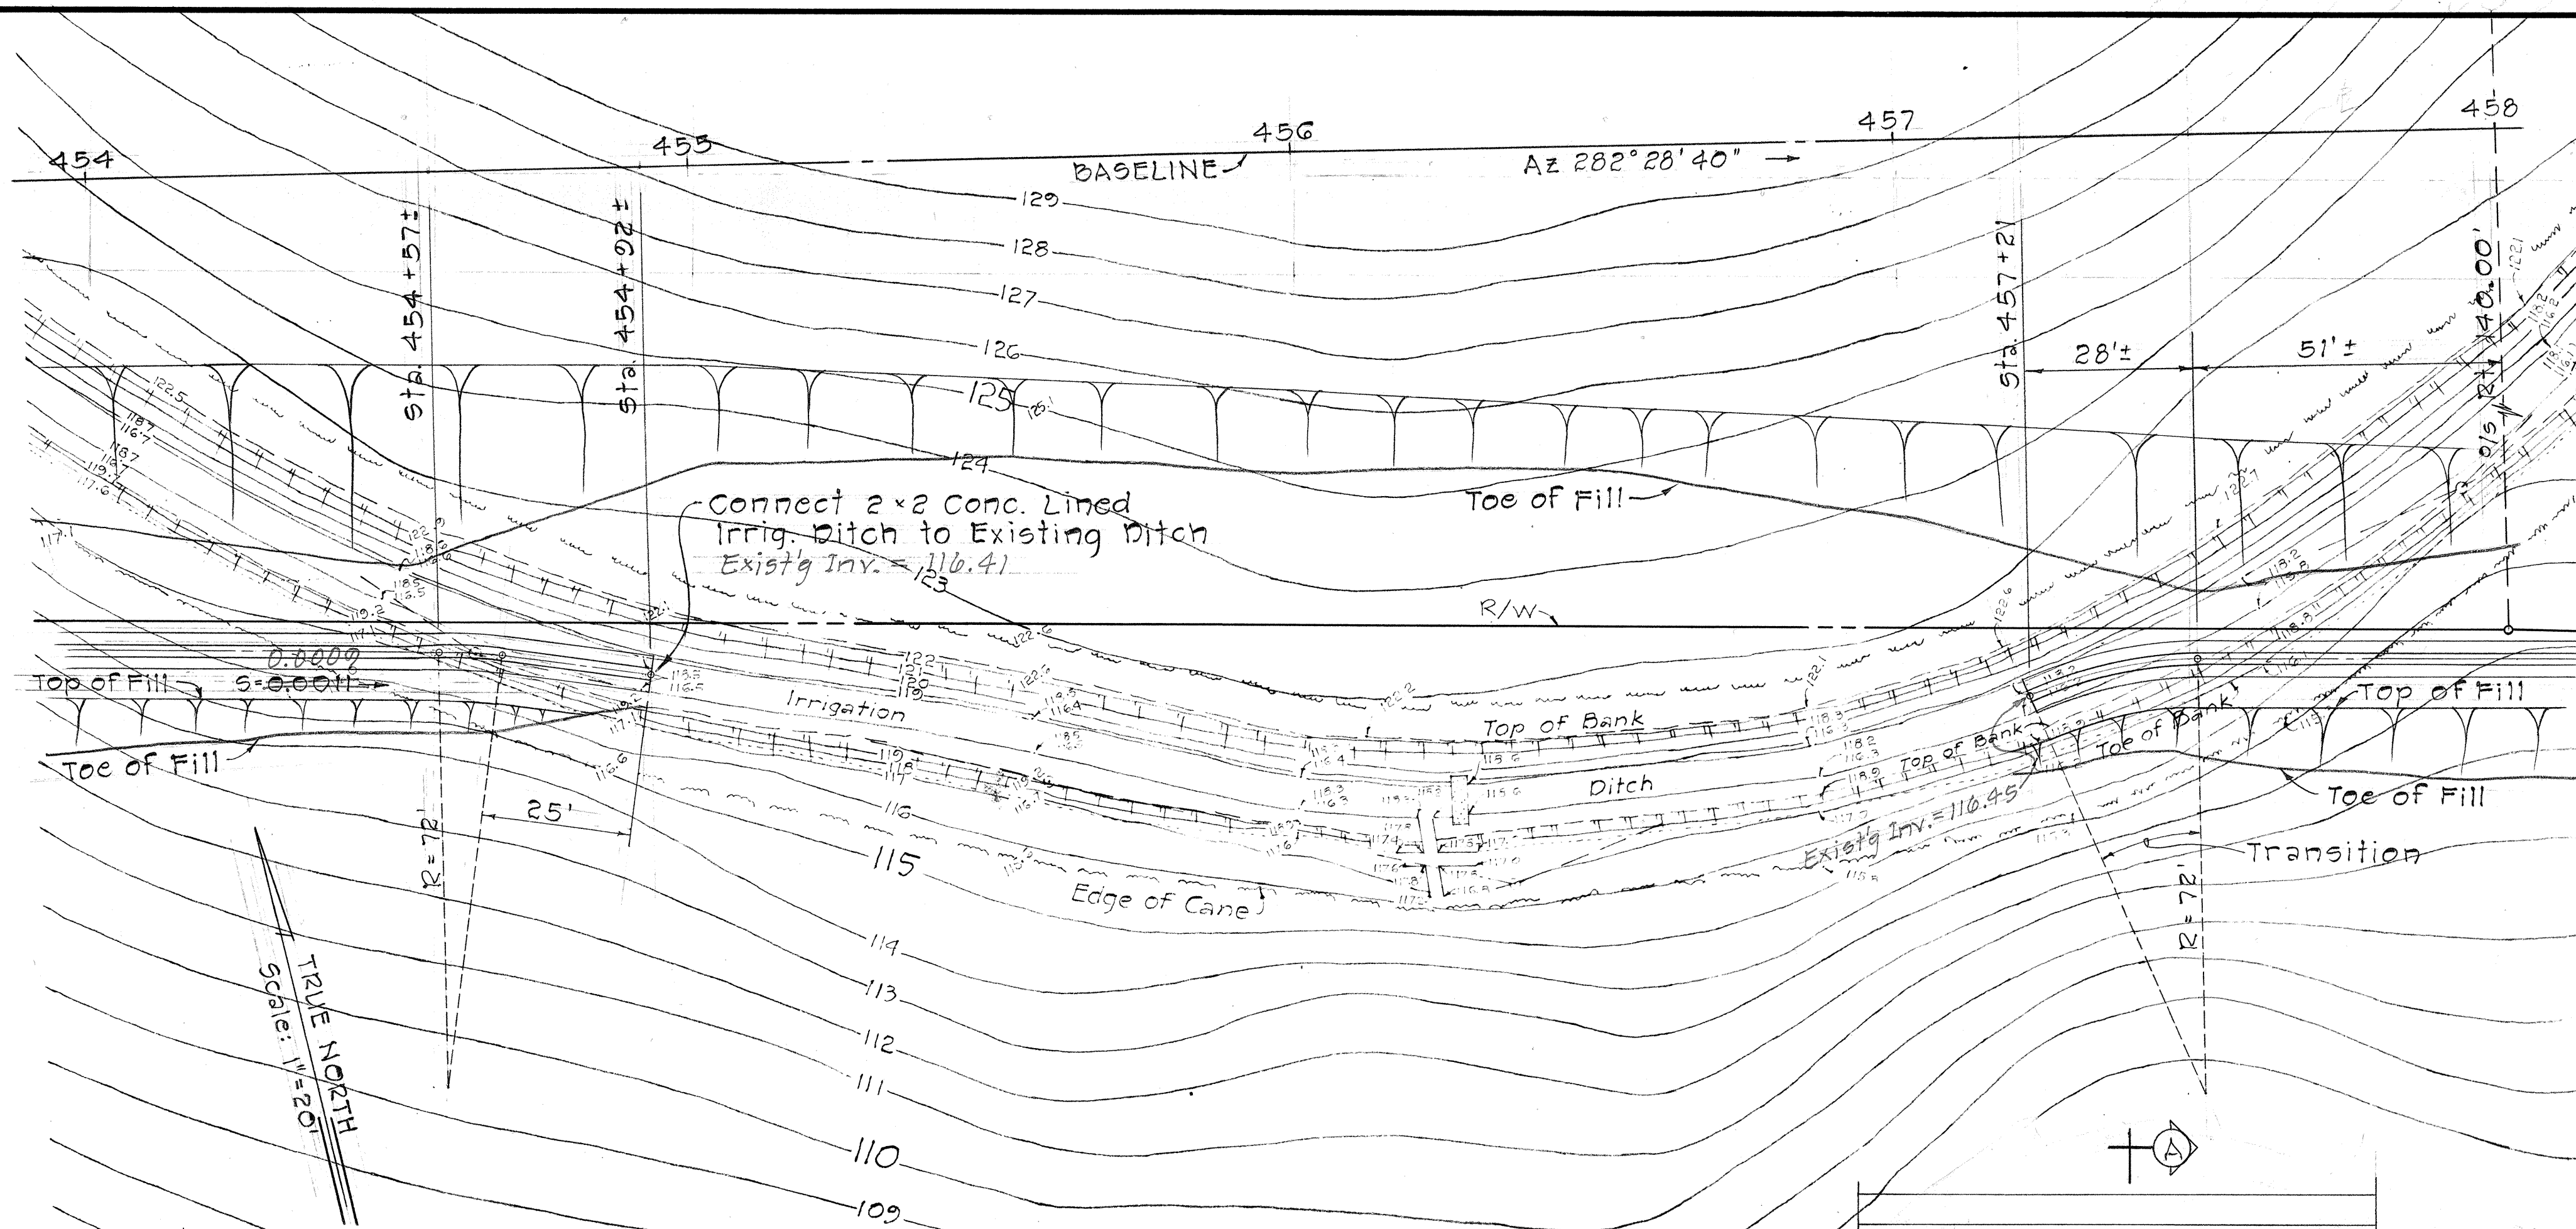


DETAIL OF DITCH CONNECTION
AT STA. 454+92± AND
AT STA. 457+21

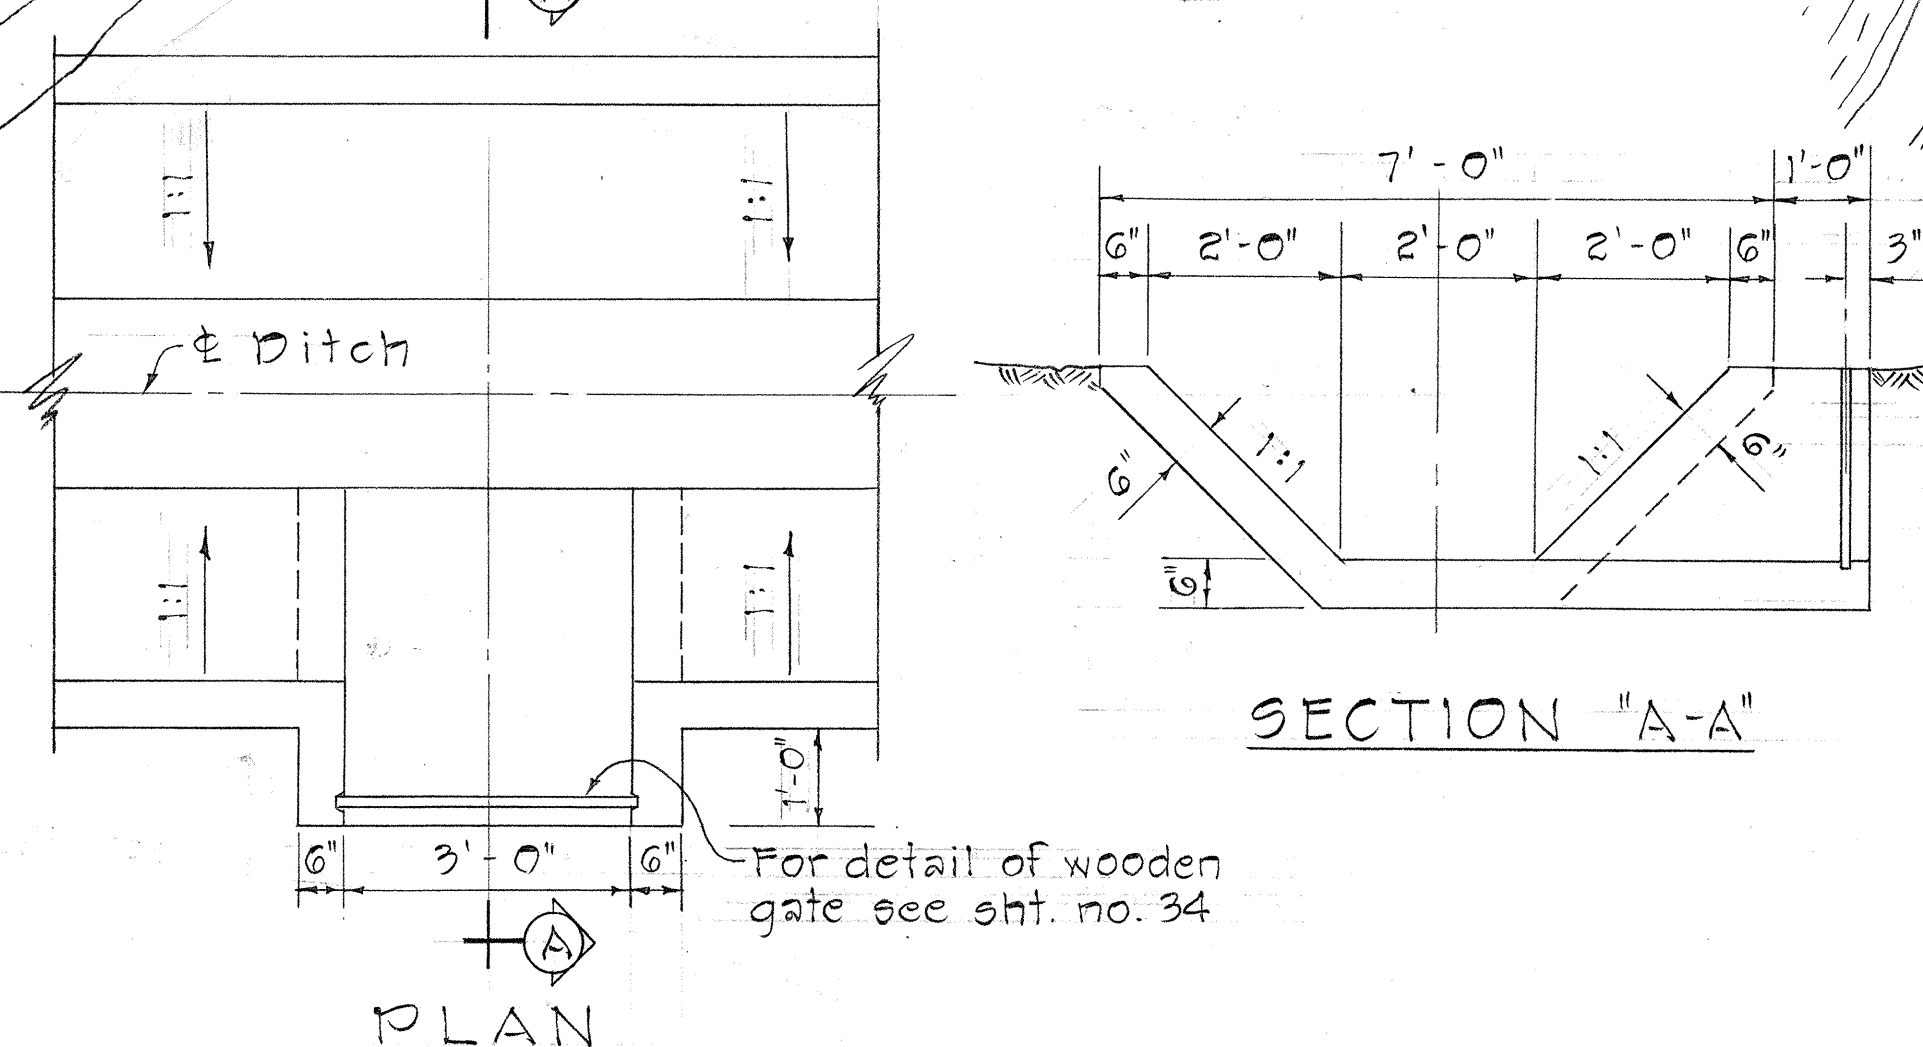


TYPICAL DETAIL OF SIDE OPENING
FOR 2'x2' IRRIGATION DITCH
Scale: 1/2" = 1'-0"

DETAIL OF DITCH CONNECTION
AT STA. 441+00

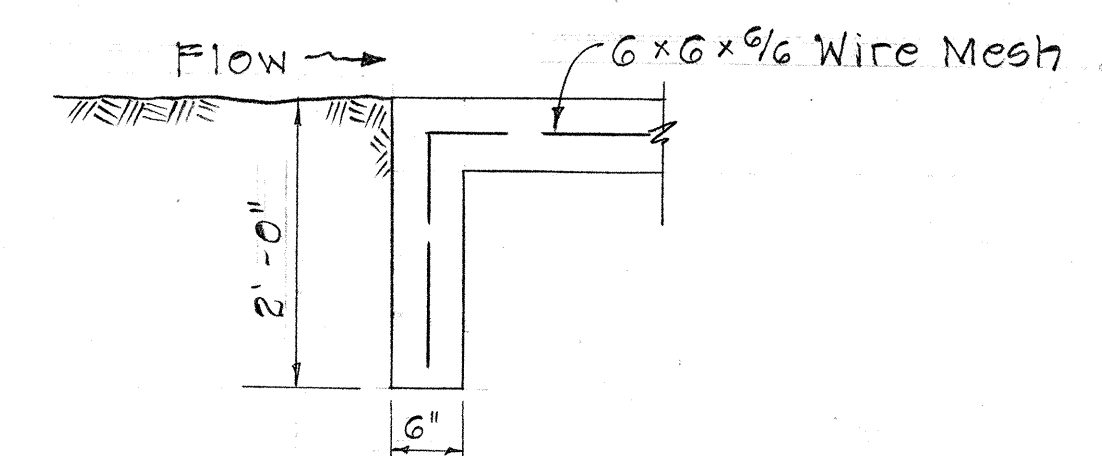










TYPICAL SECTION
CUT-OFF WALL FOR
TRAPEZOIDAL IRRIGATION DITCH
Scale: 3/4" = 1'-0"

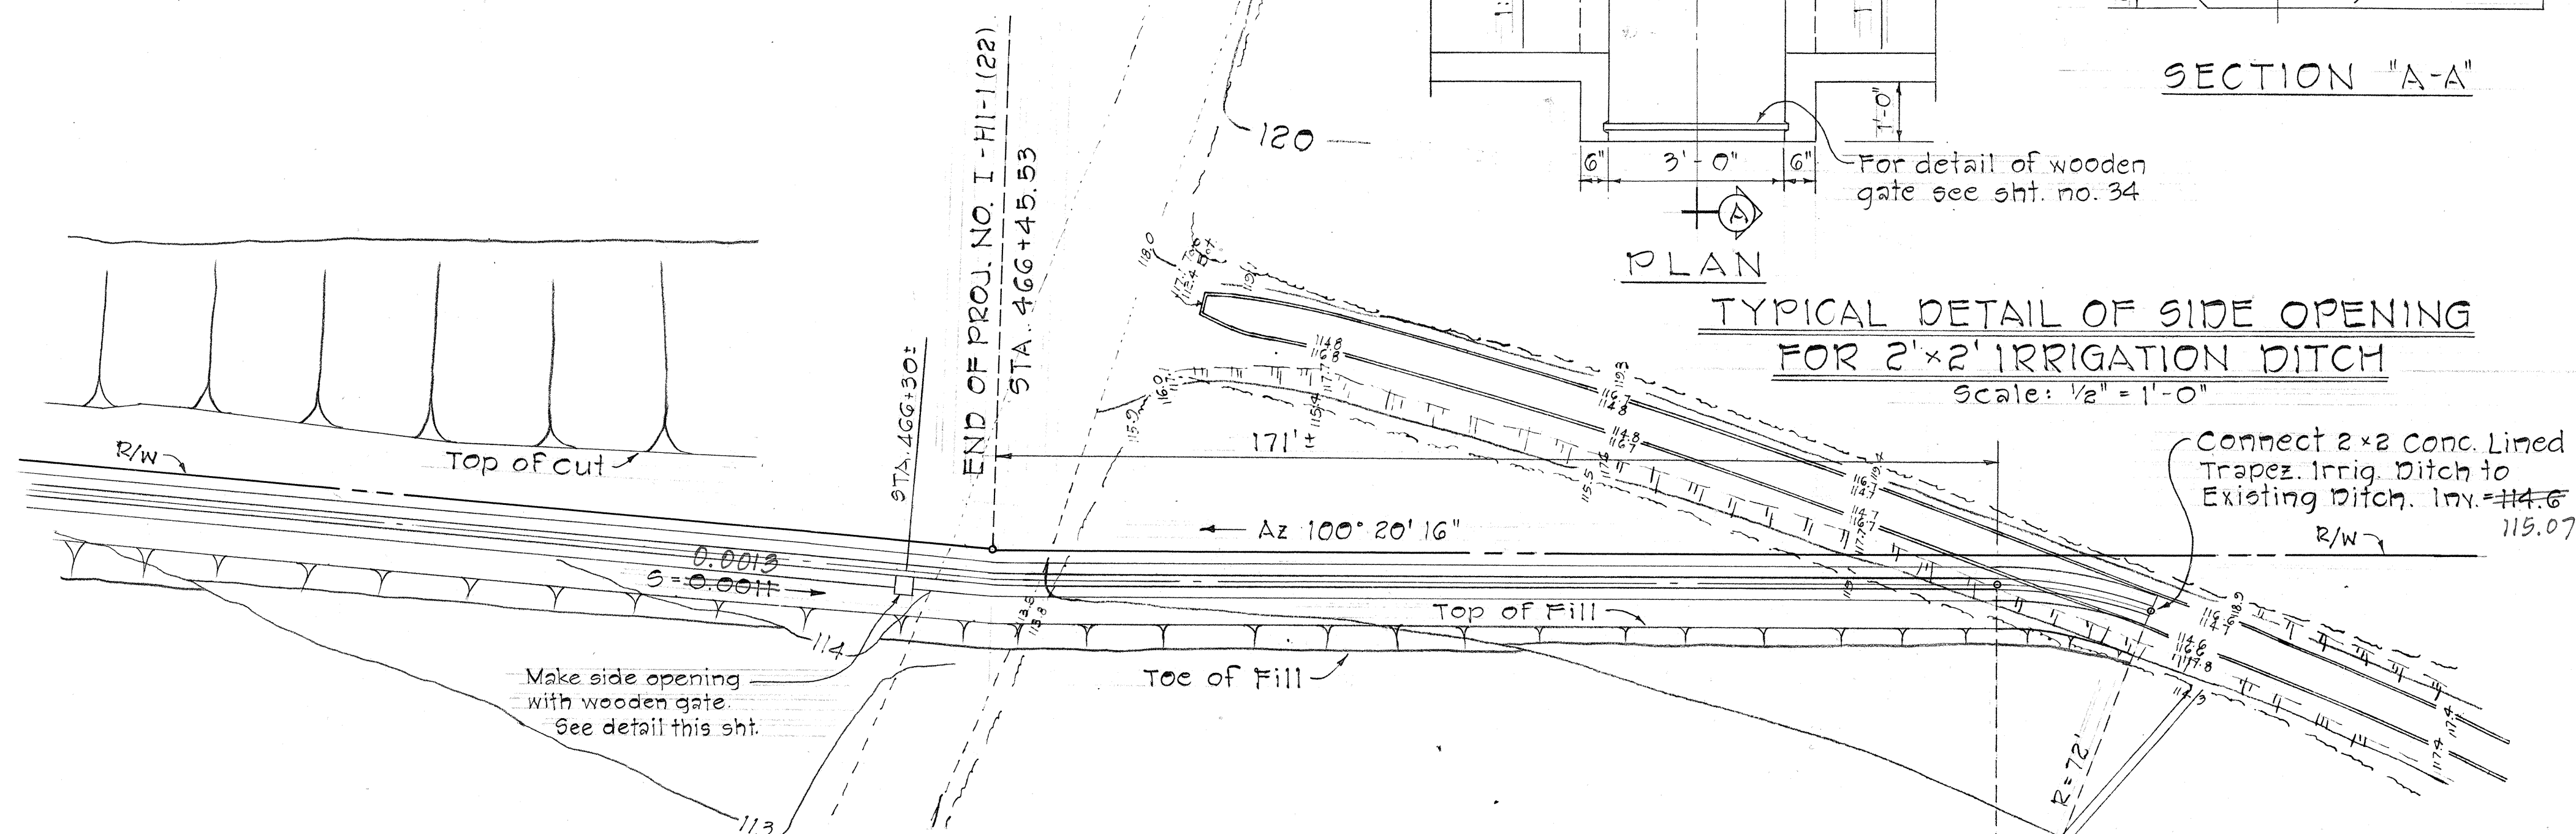

DETAIL OF DITCH CONNECTION AT END OF PROJECT

STATE OF HAWAII
DEPARTMENT OF TRANSPORTATION
HIGHWAYS DIVISION
IRRIGATION DETAILS
DETAILS OF DITCH CONNECTIONS
AT STA. 441+00; STA. 454+92± &
STA. 457+21; & END OF PROJECT
INTERSTATE ROUTE H-1
F.A.I. Proj. No. I-HI-1(22):5, Unit 2
Scale: As Shown Date: June, 1967
SHEET No. 17 OF 28 SHEETS


FED. ROAD DIST. NO.	STATE	FED. AID PROJ. NO.	FISCAL YEAR	SHEET NO.	TOTAL SHEETS
HAWAII	HAW.	I-HI-1(32)5 Unit 3	1967	47	99

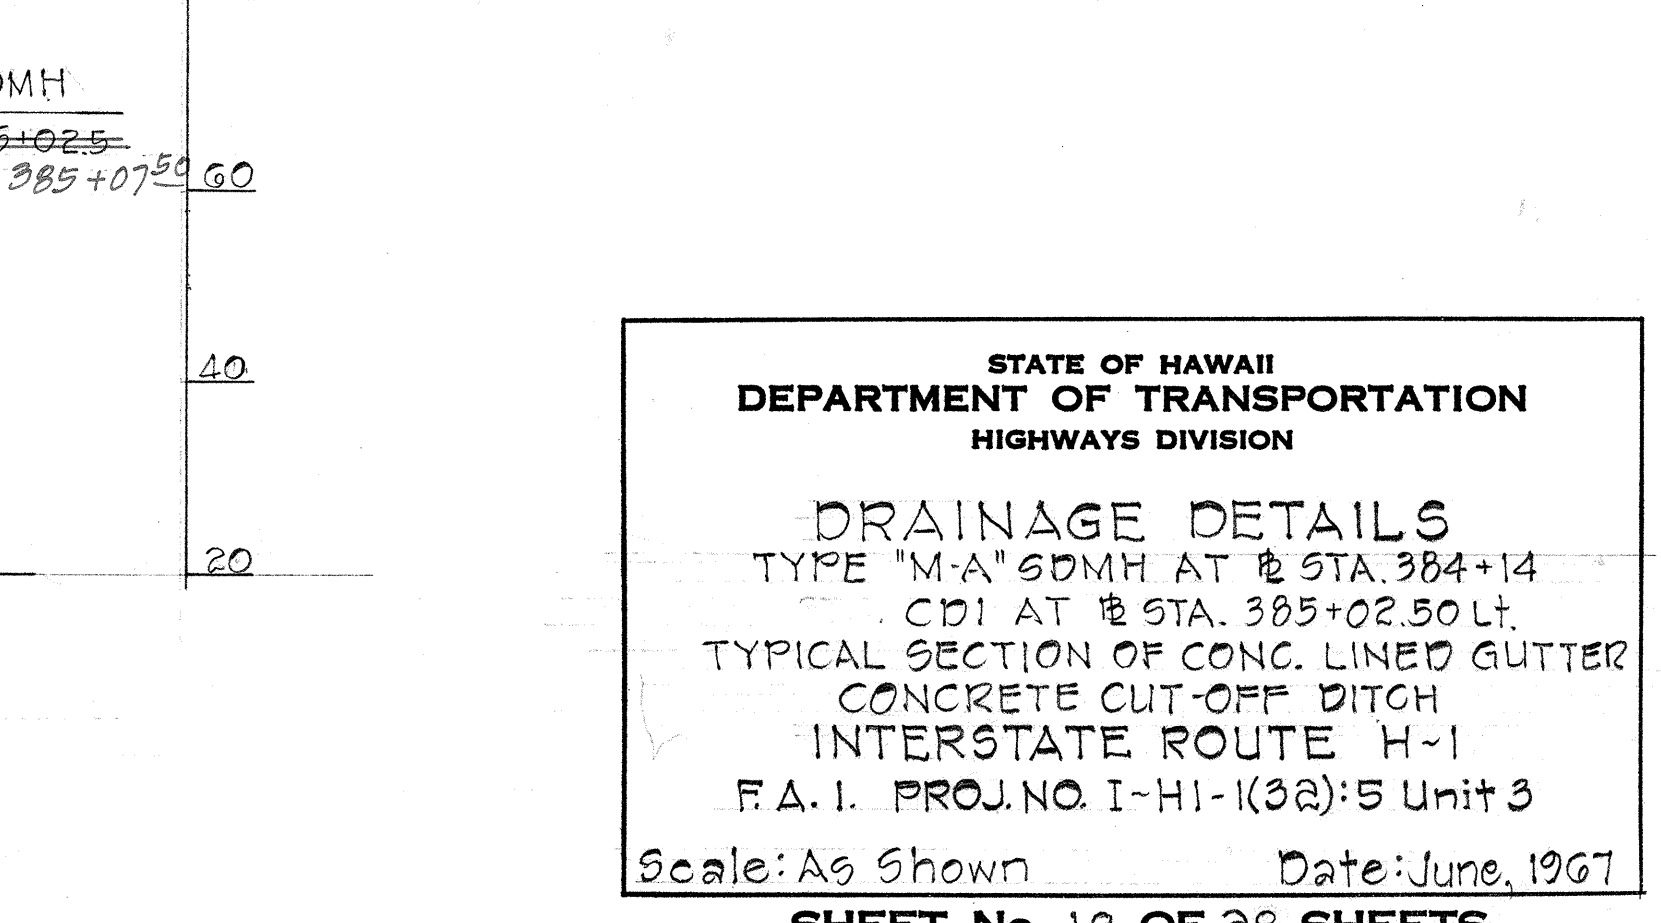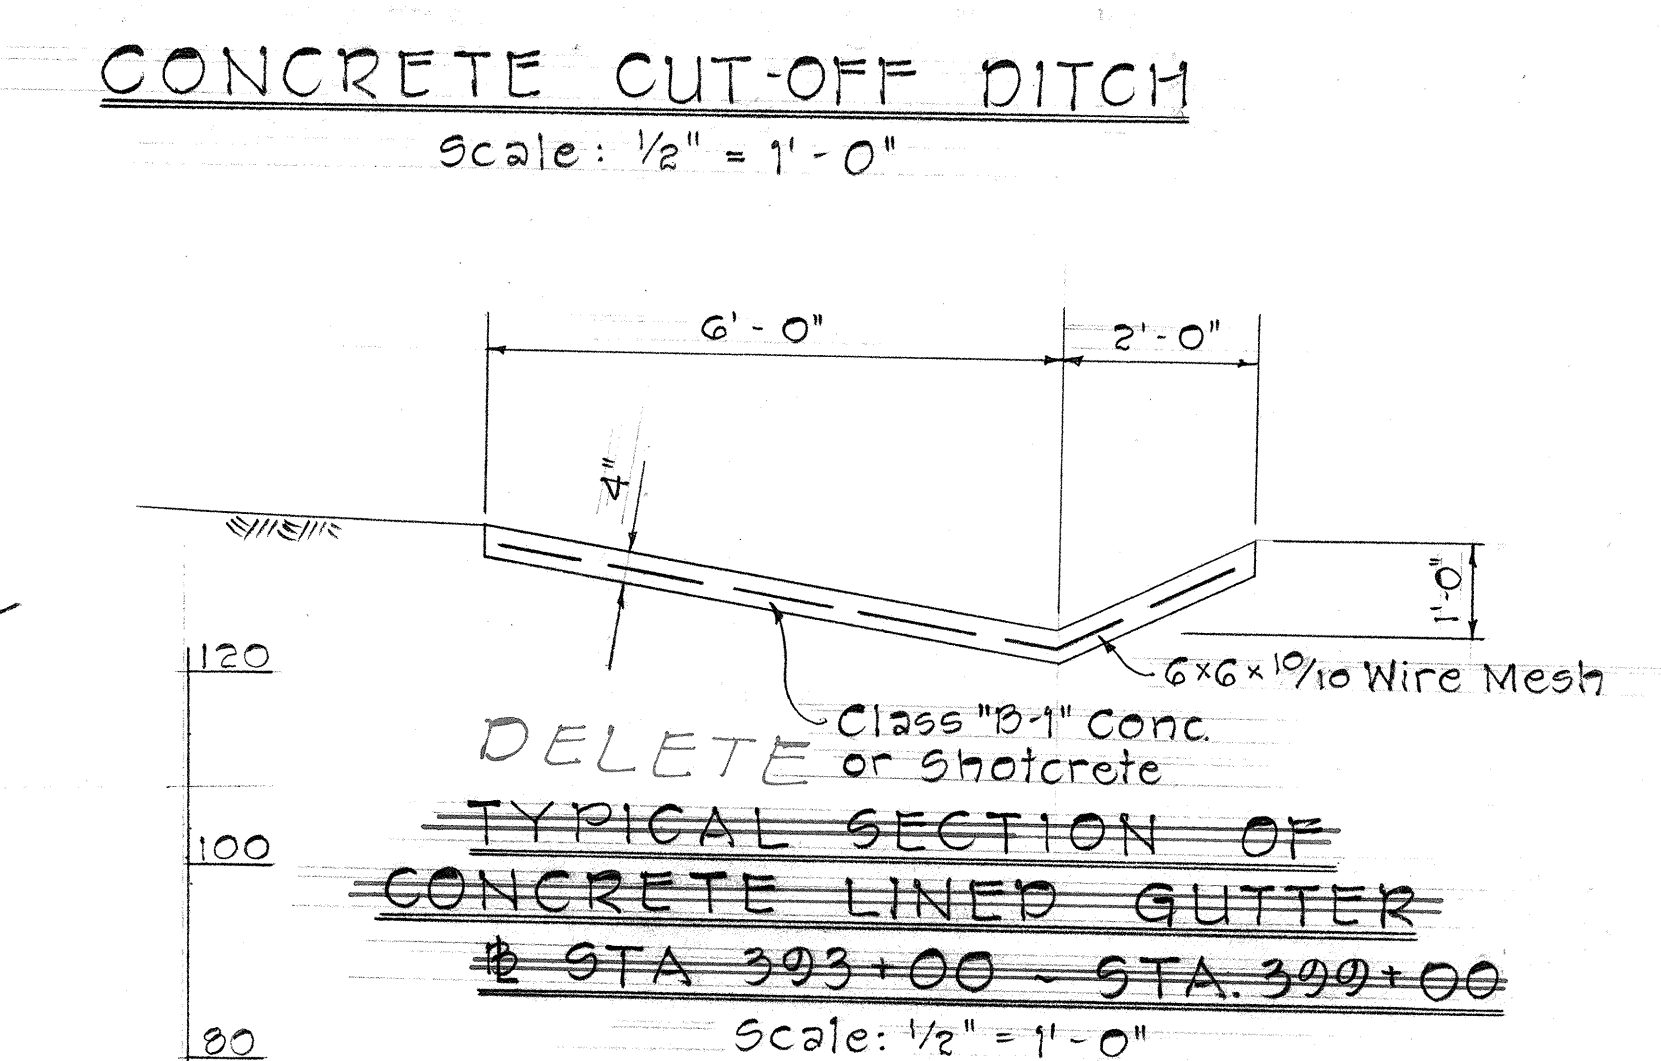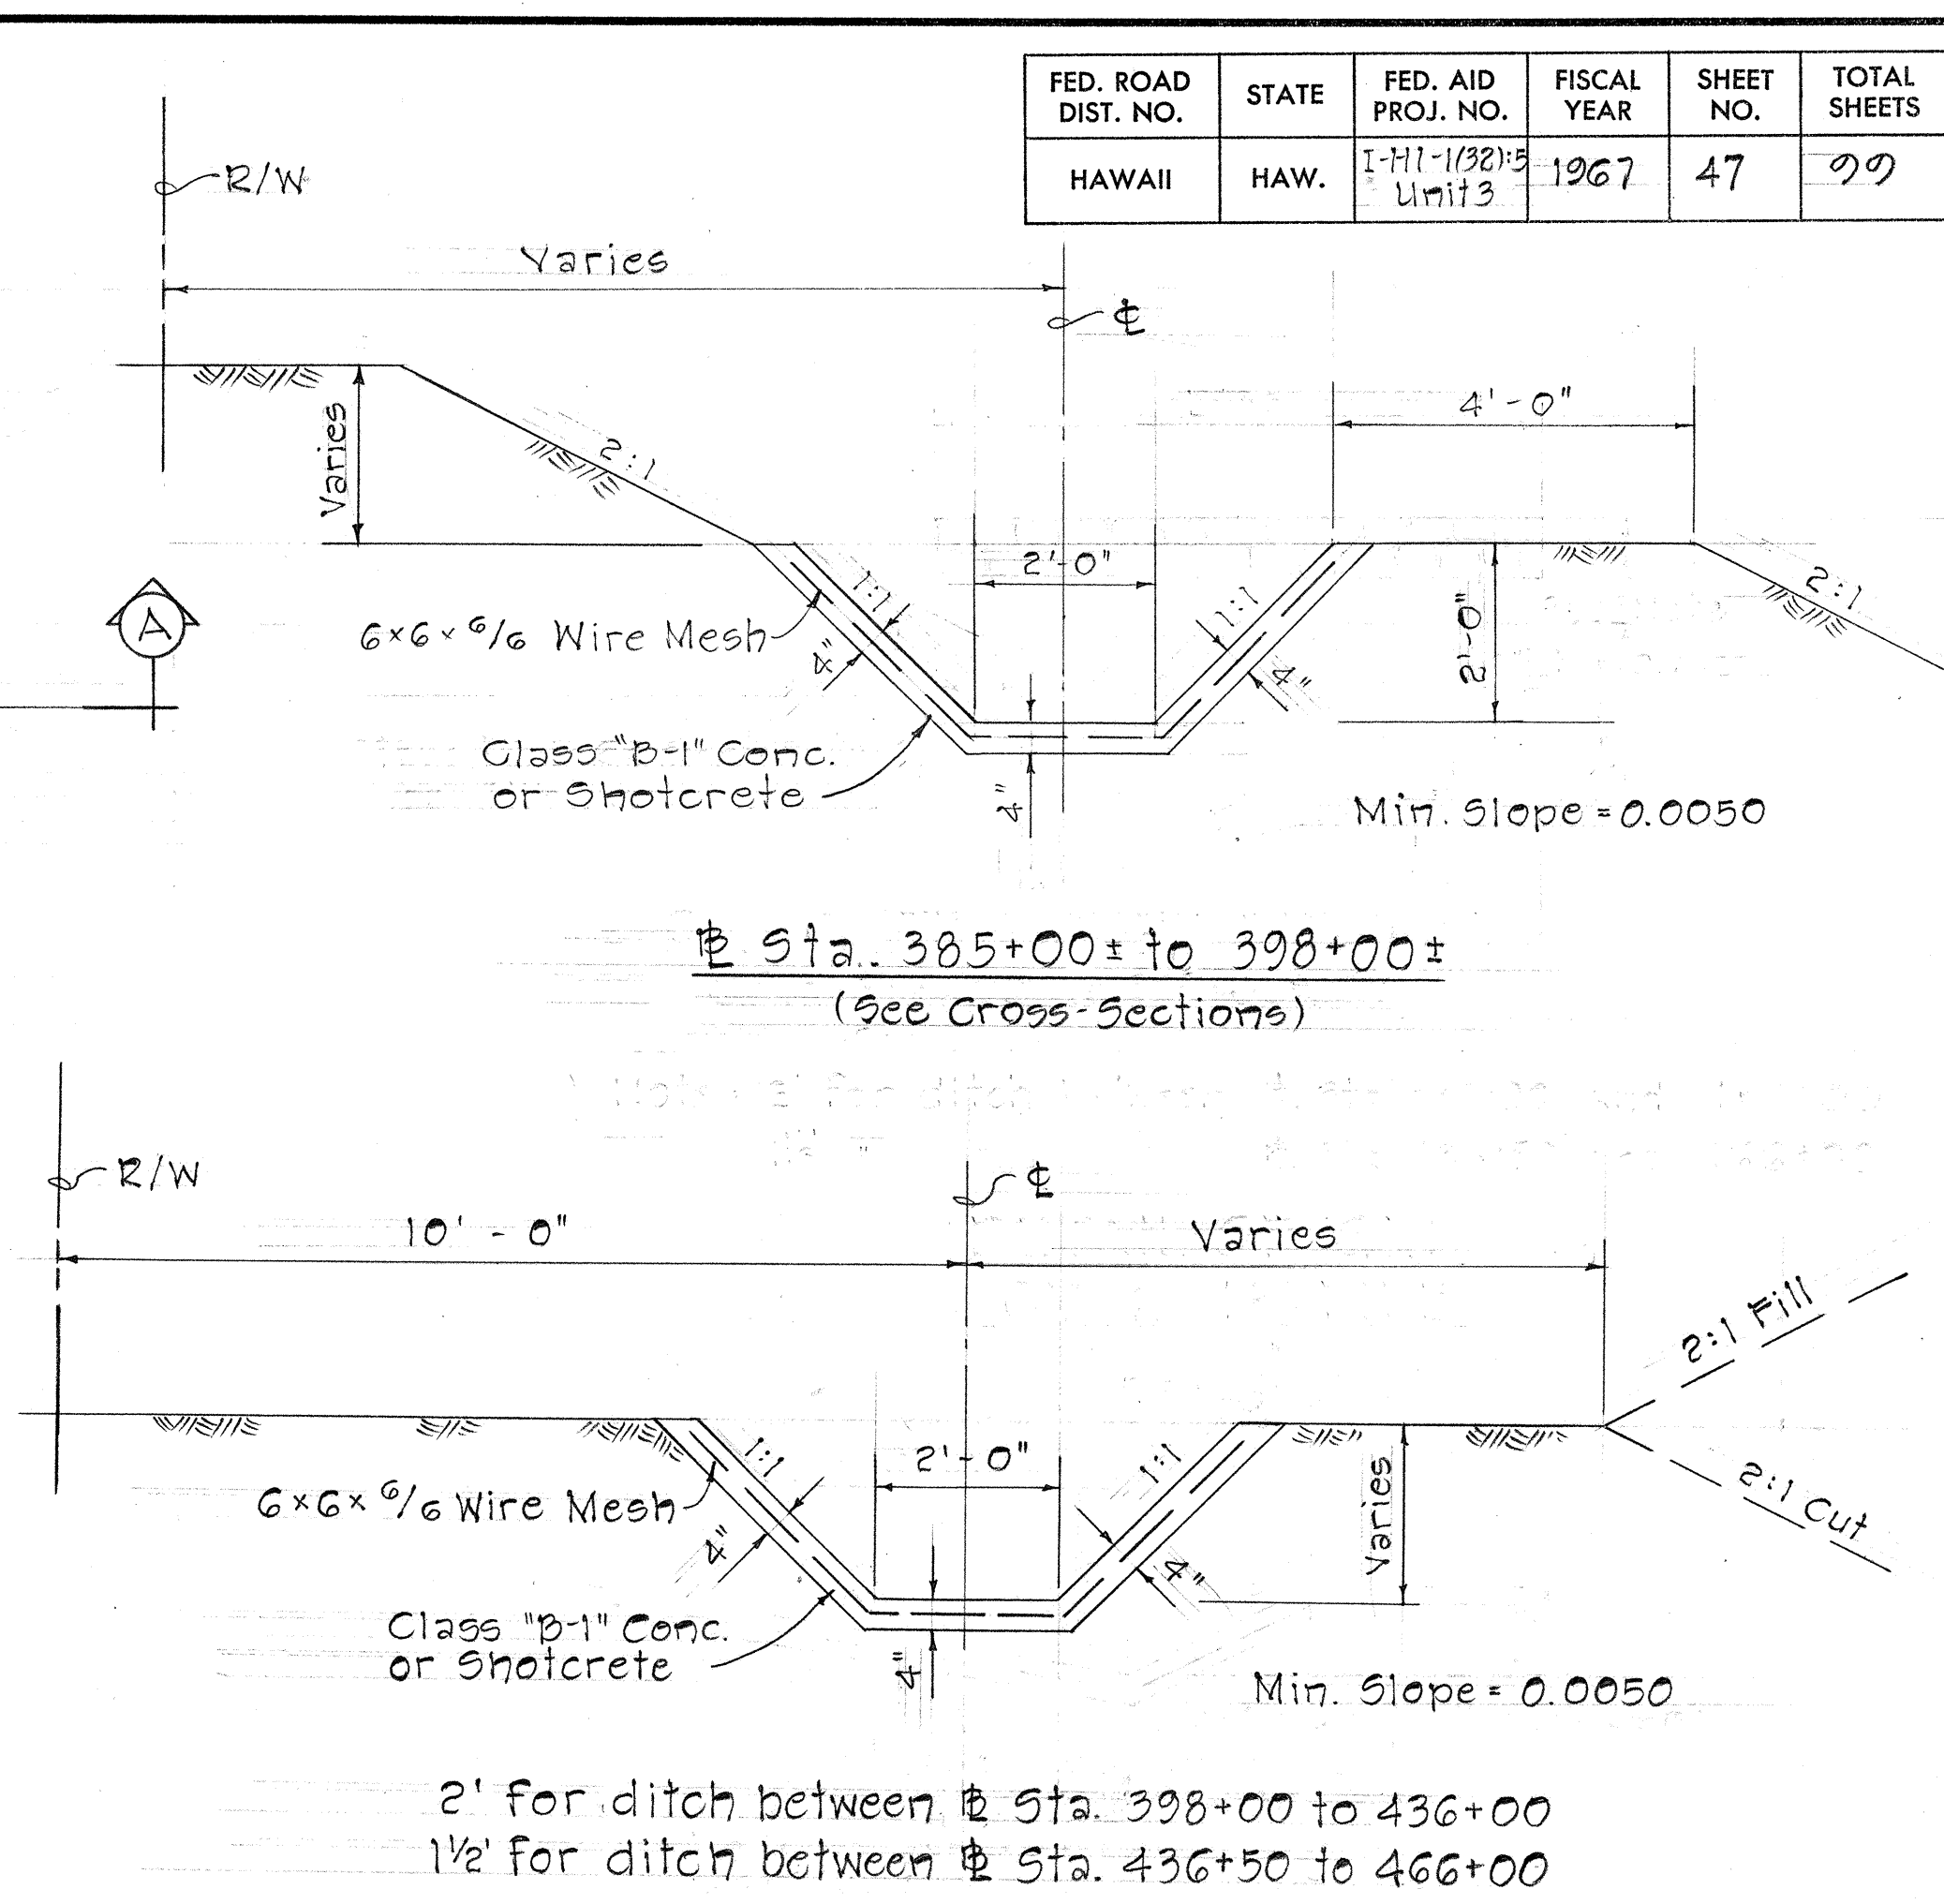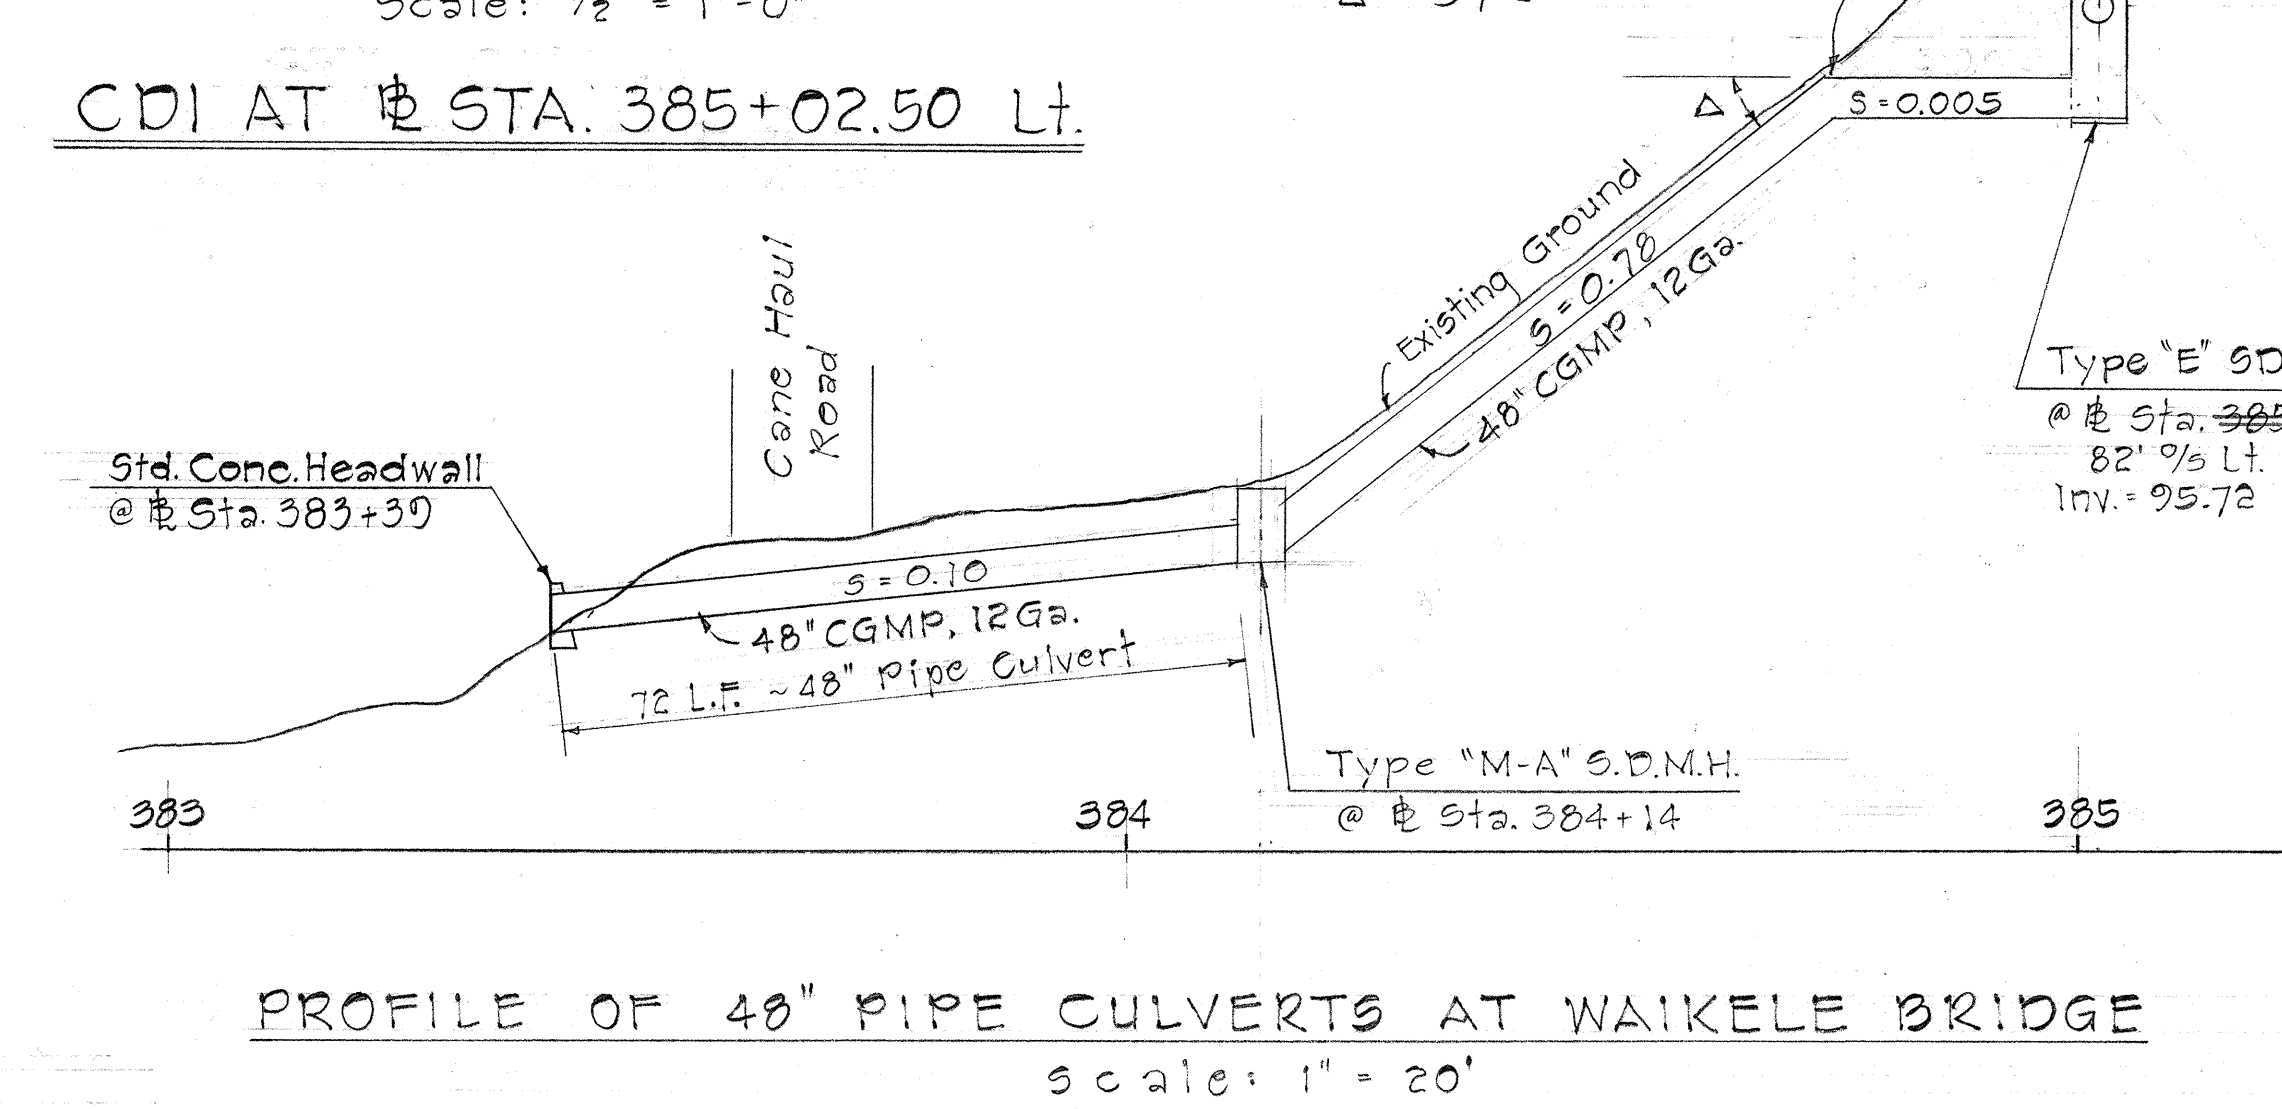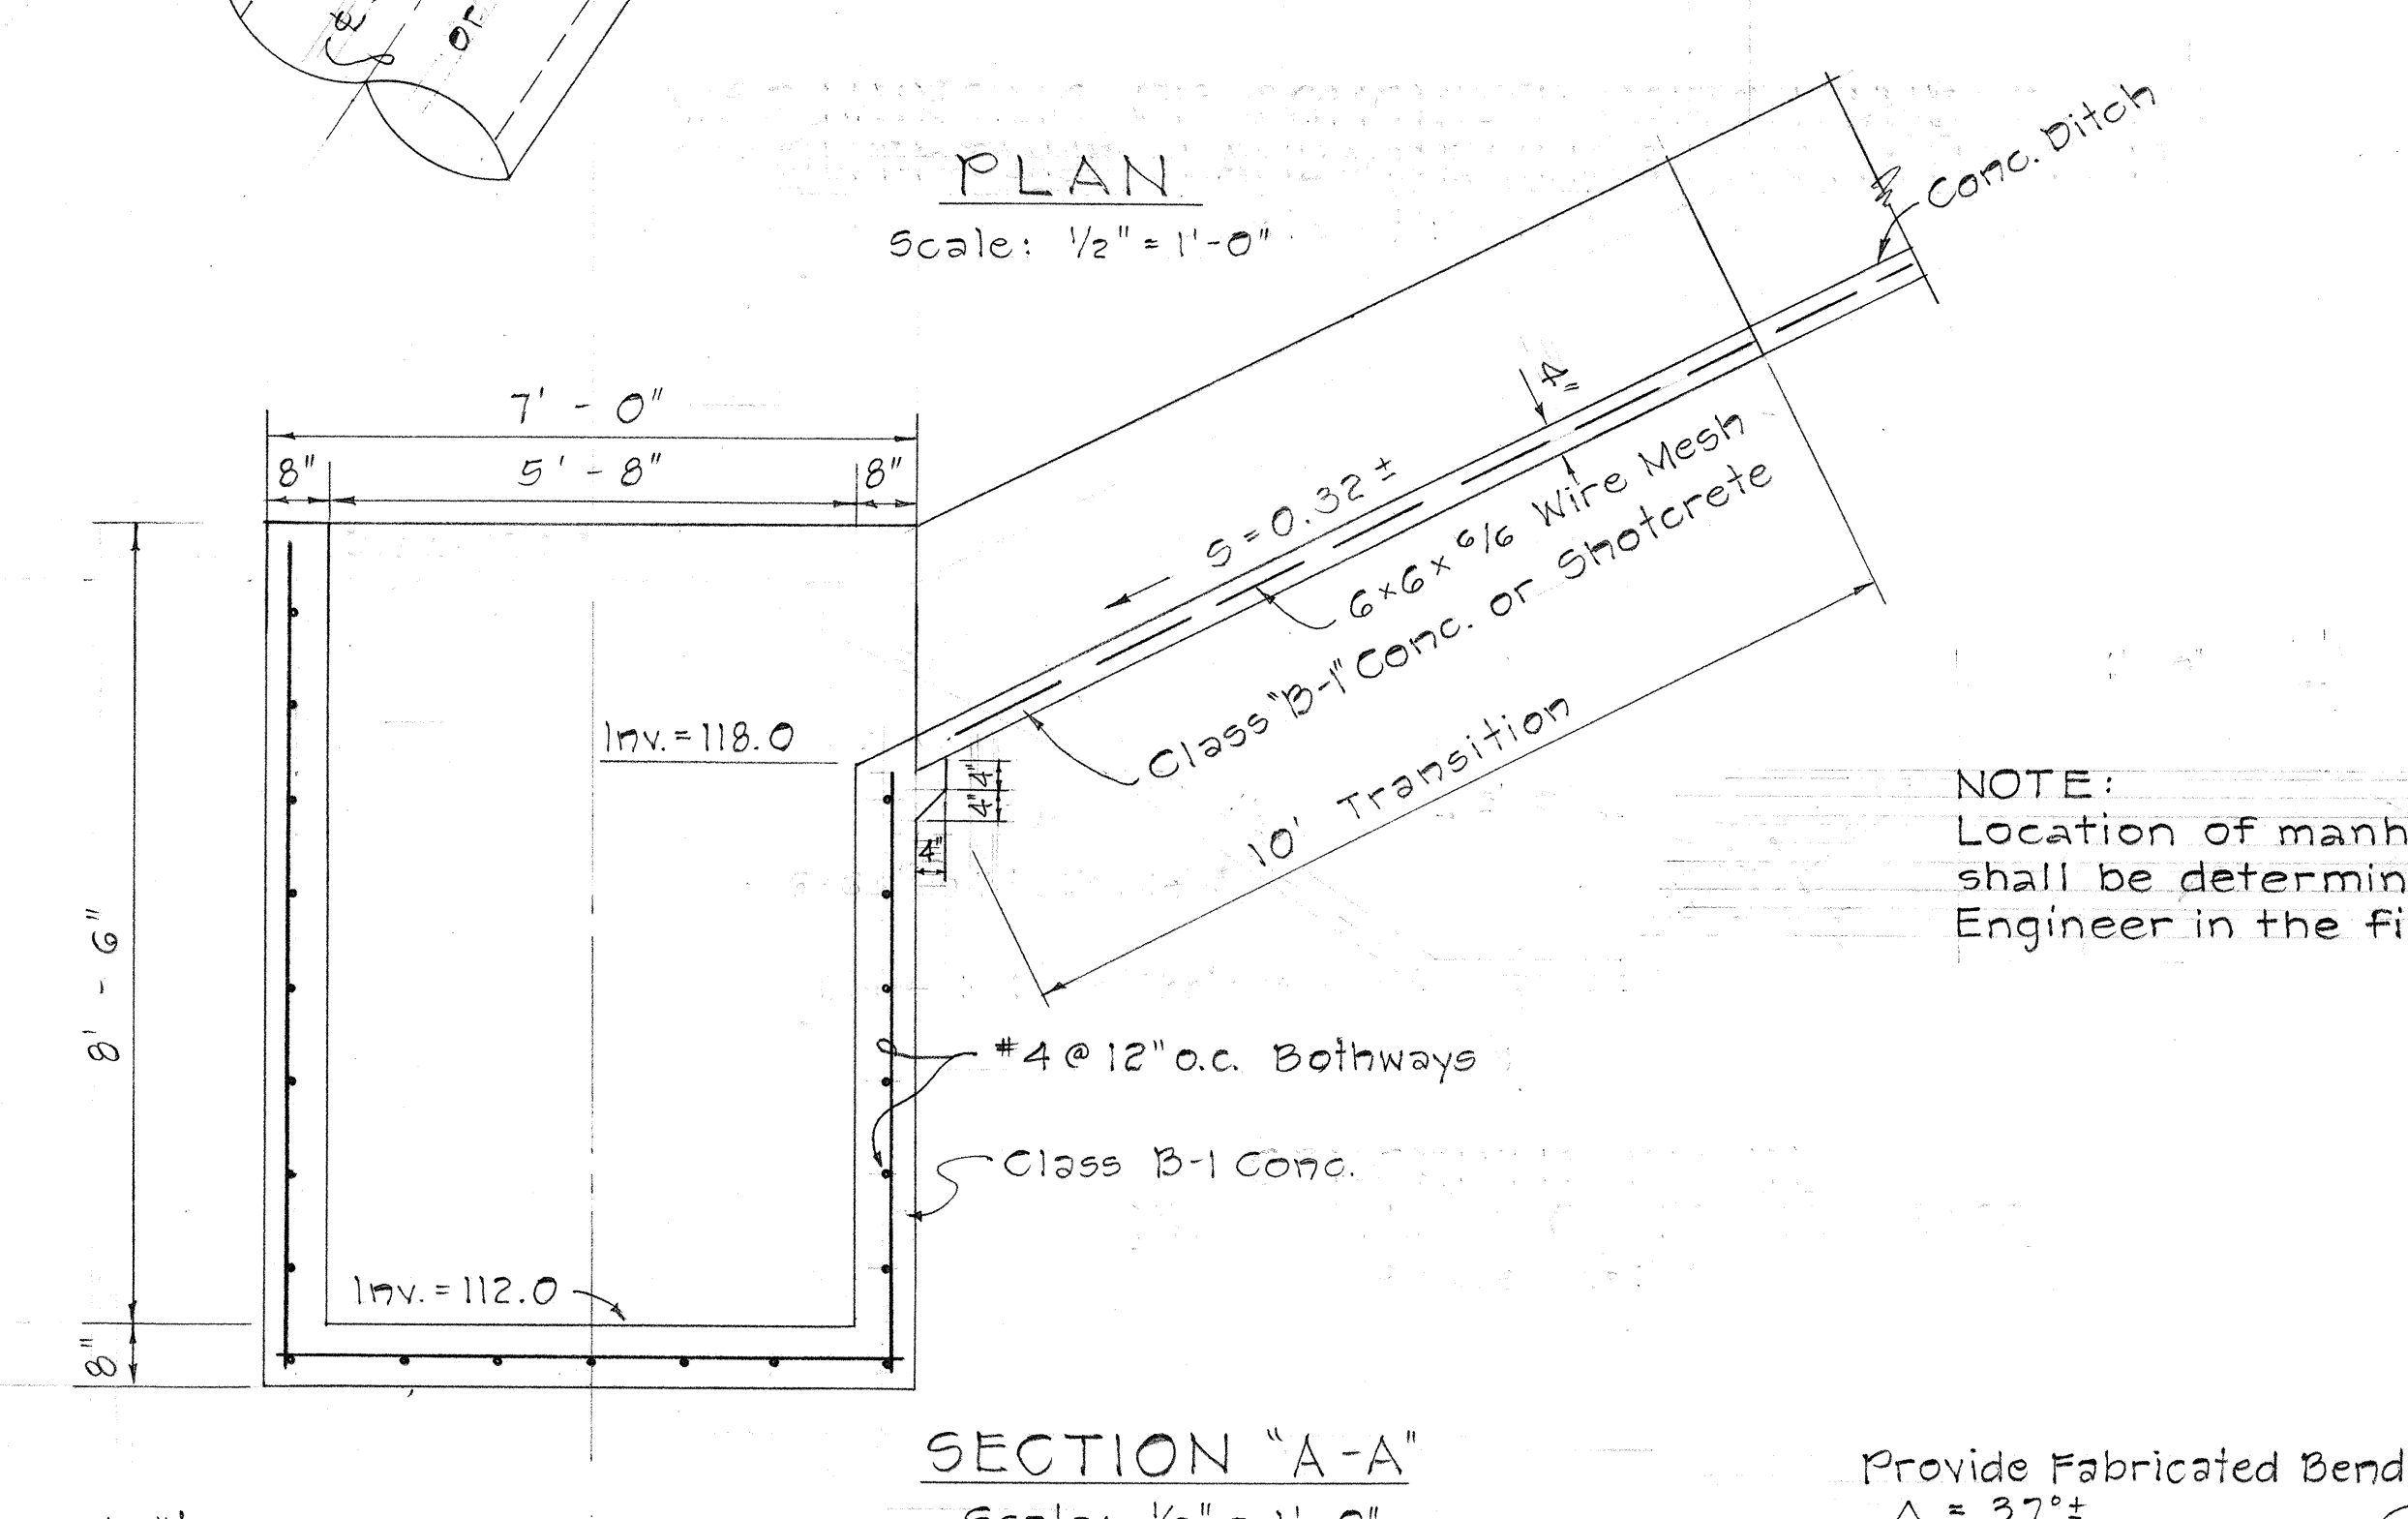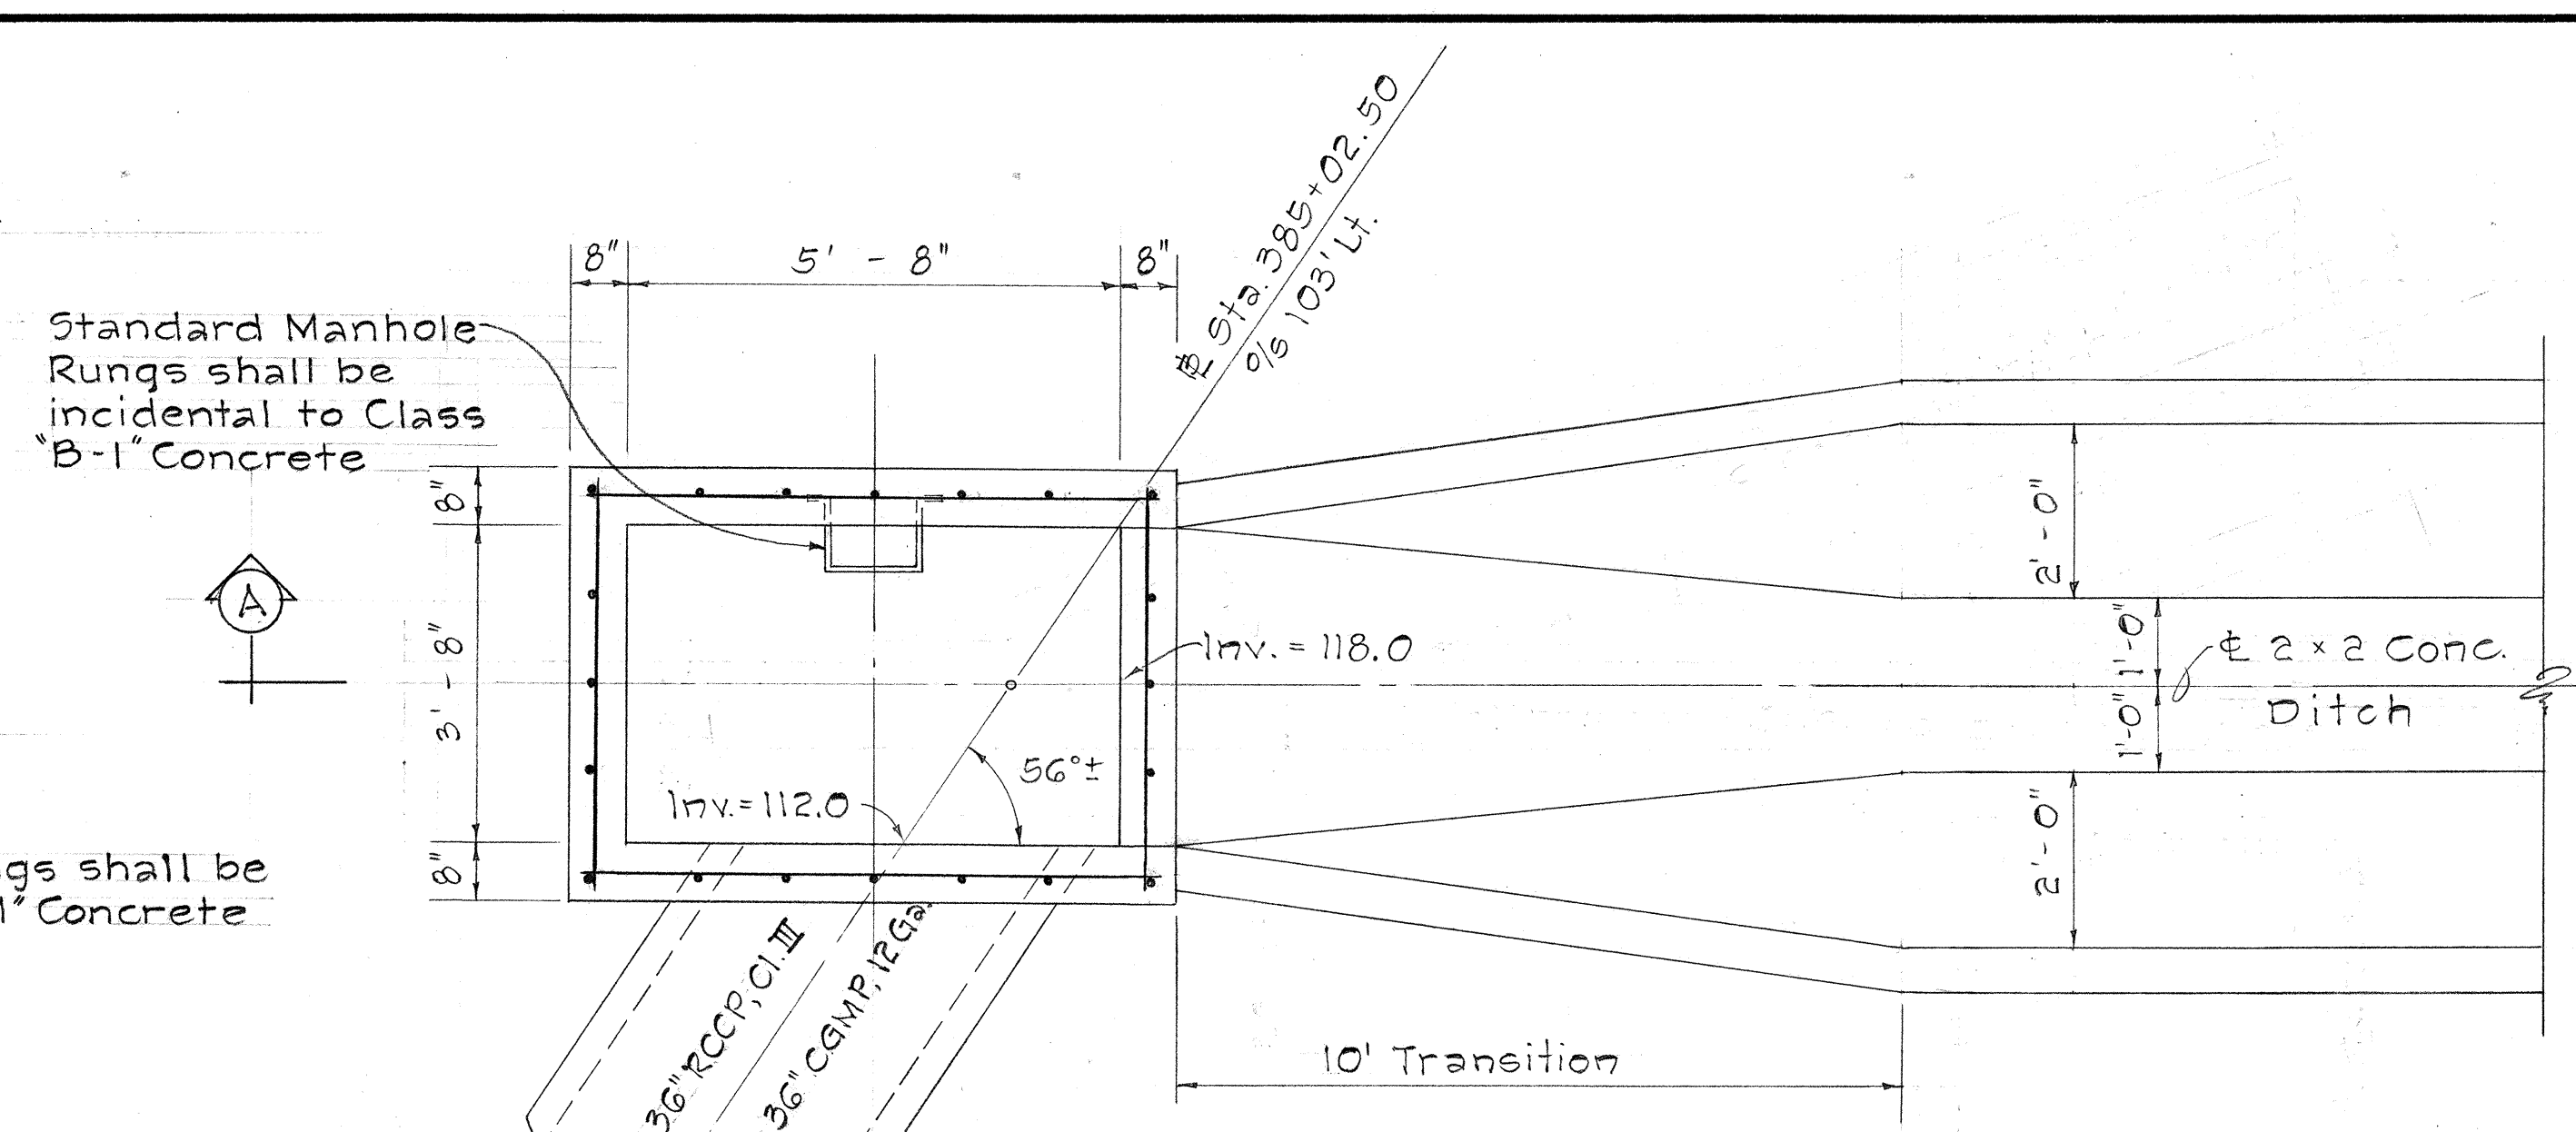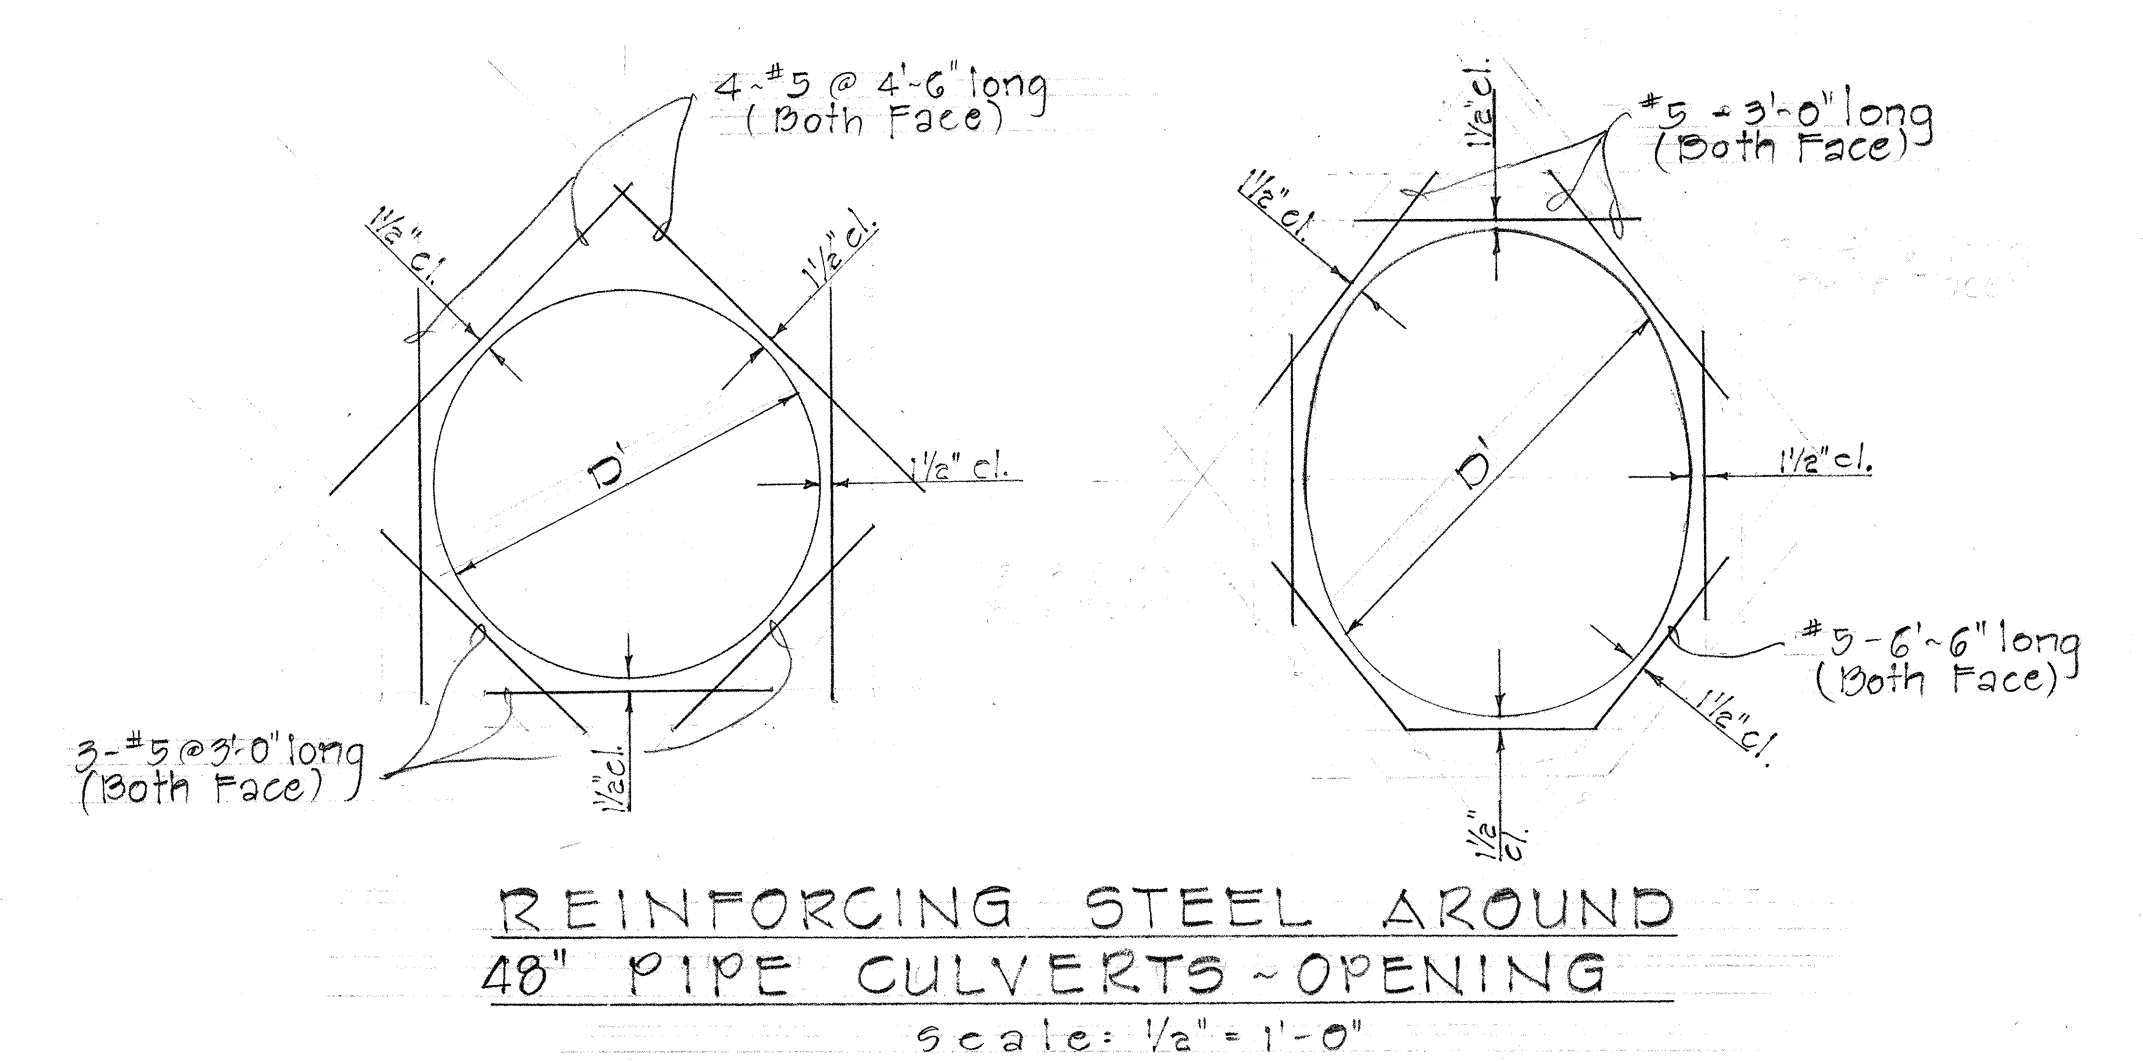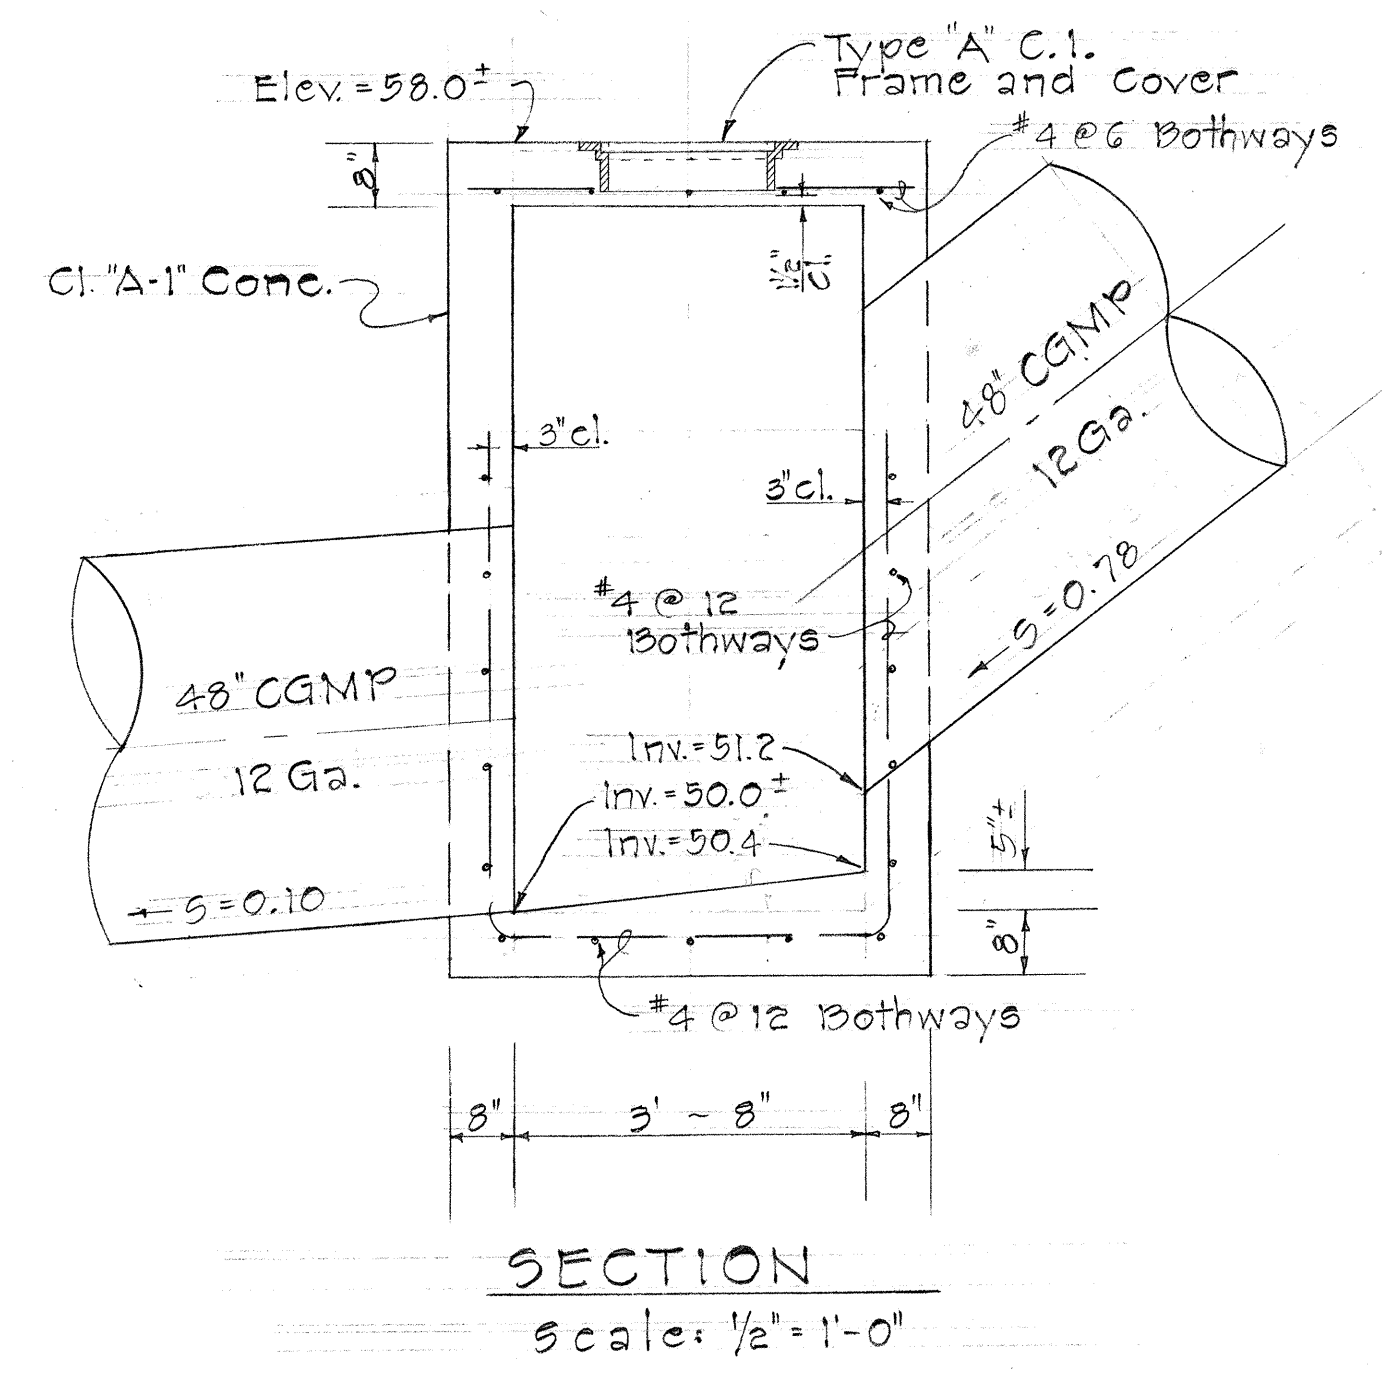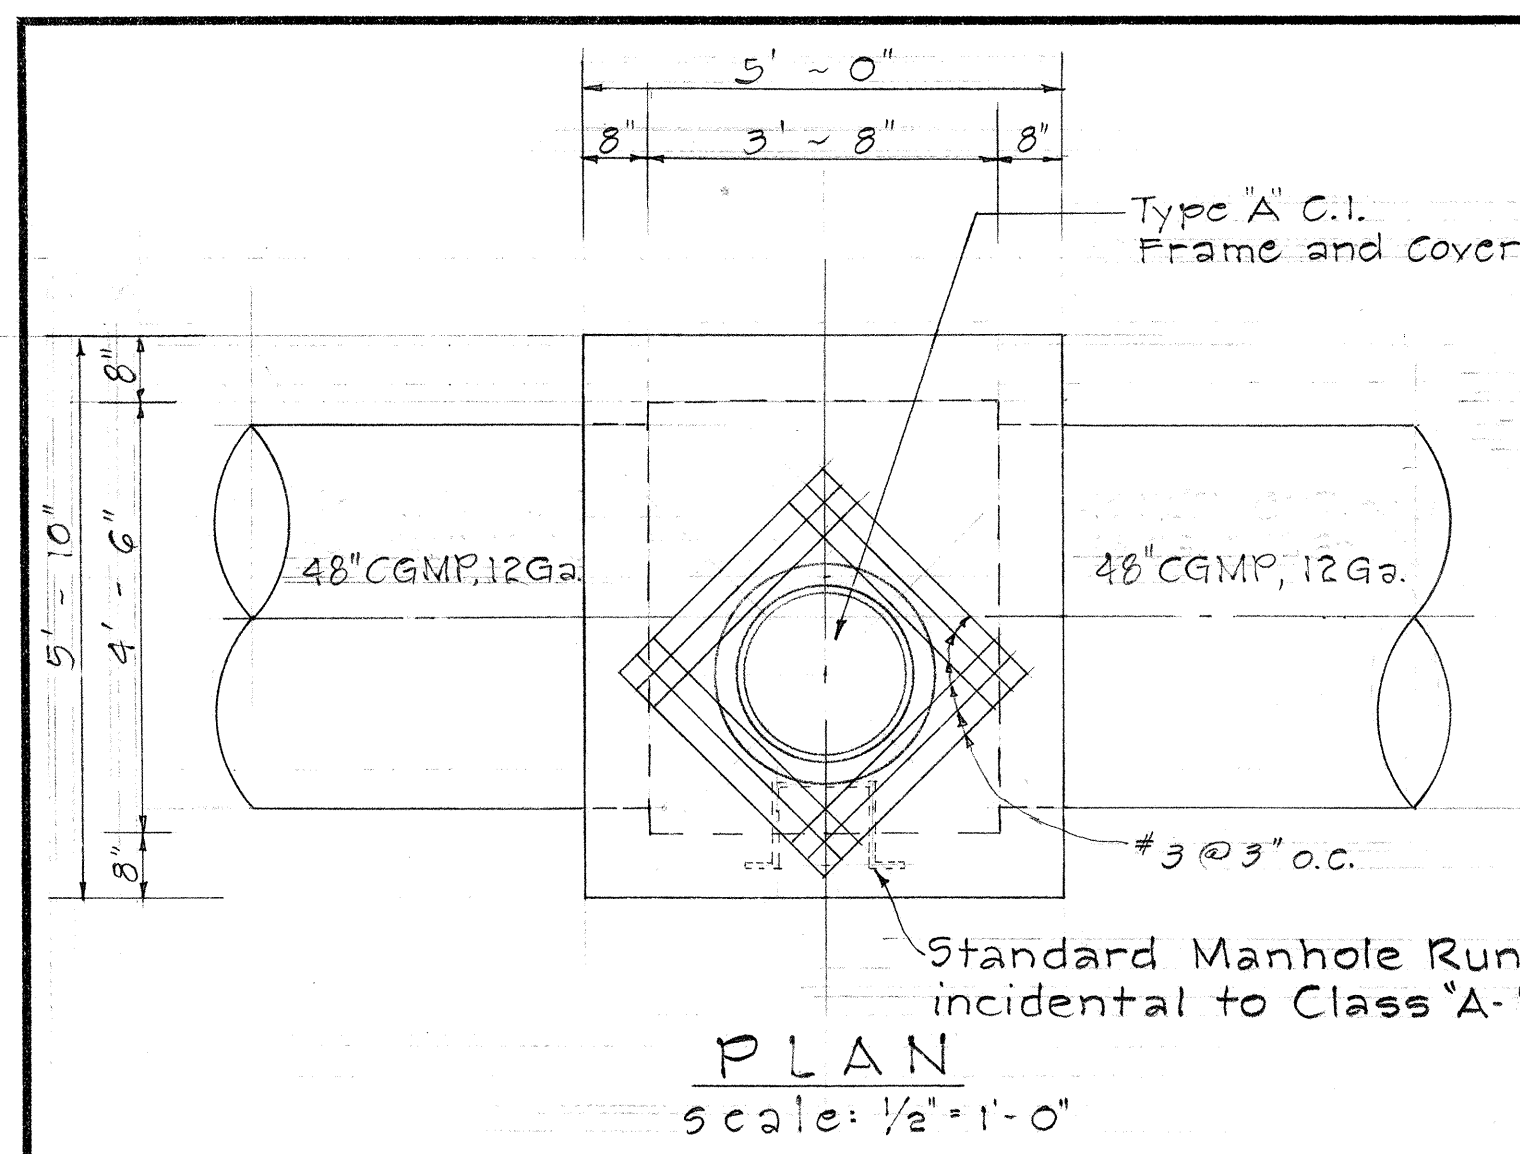


STATE OF HAWAII
DEPARTMENT OF TRANSPORTATION
HIGHWAYS DIVISION

DRAINAGE DETAILS
TYPE "M-A" S.D.M.H. AT STA. 384+14
CDI AT STA. 385+02.50 Lt.
TYPICAL SECTION OF CONC. LINED GUTTER
CONCRETE CUT-OFF DITCH
INTERSTATE ROUTE H-1
F.A.I. PROJ. NO. I-HI-1(32)5 Unit 3
Scale: As Shown Date: June, 1967
SHEET No. 18 OF 28 SHEETS


FED. ROAD DIST. NO.	STATE	FED. AID PROJ. NO.	FISCAL YEAR	SHEET NO.	TOTAL SHEETS
HAWAII	HAW.	I-HI-1(32)5 Unit 3	1967	48	99

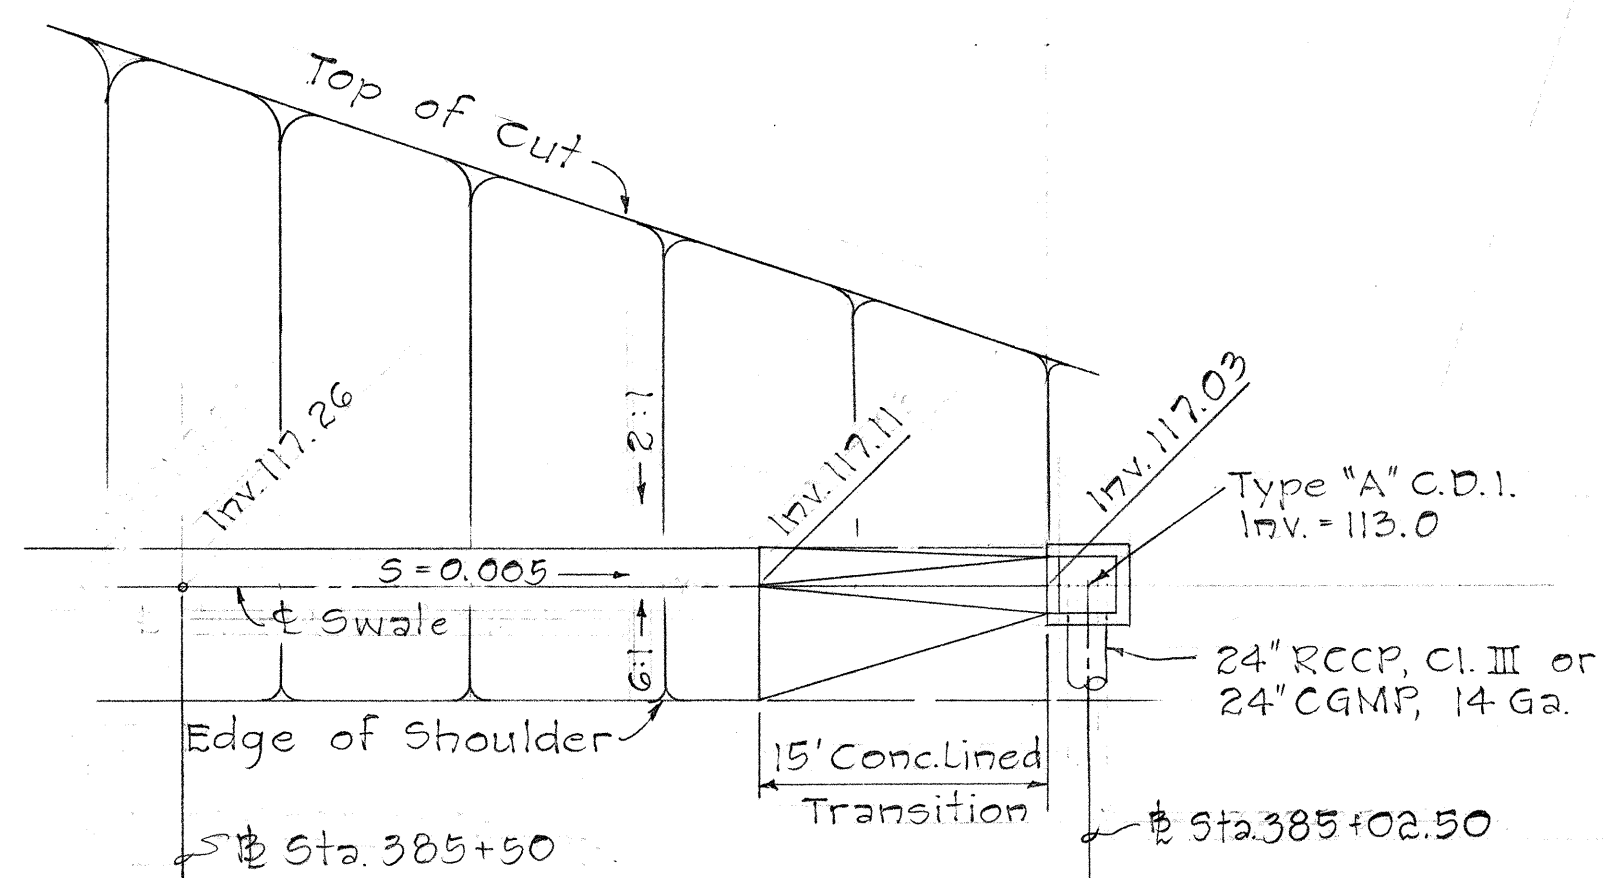


LAYOUT PLAN
Scale: 1" = 10'-0"

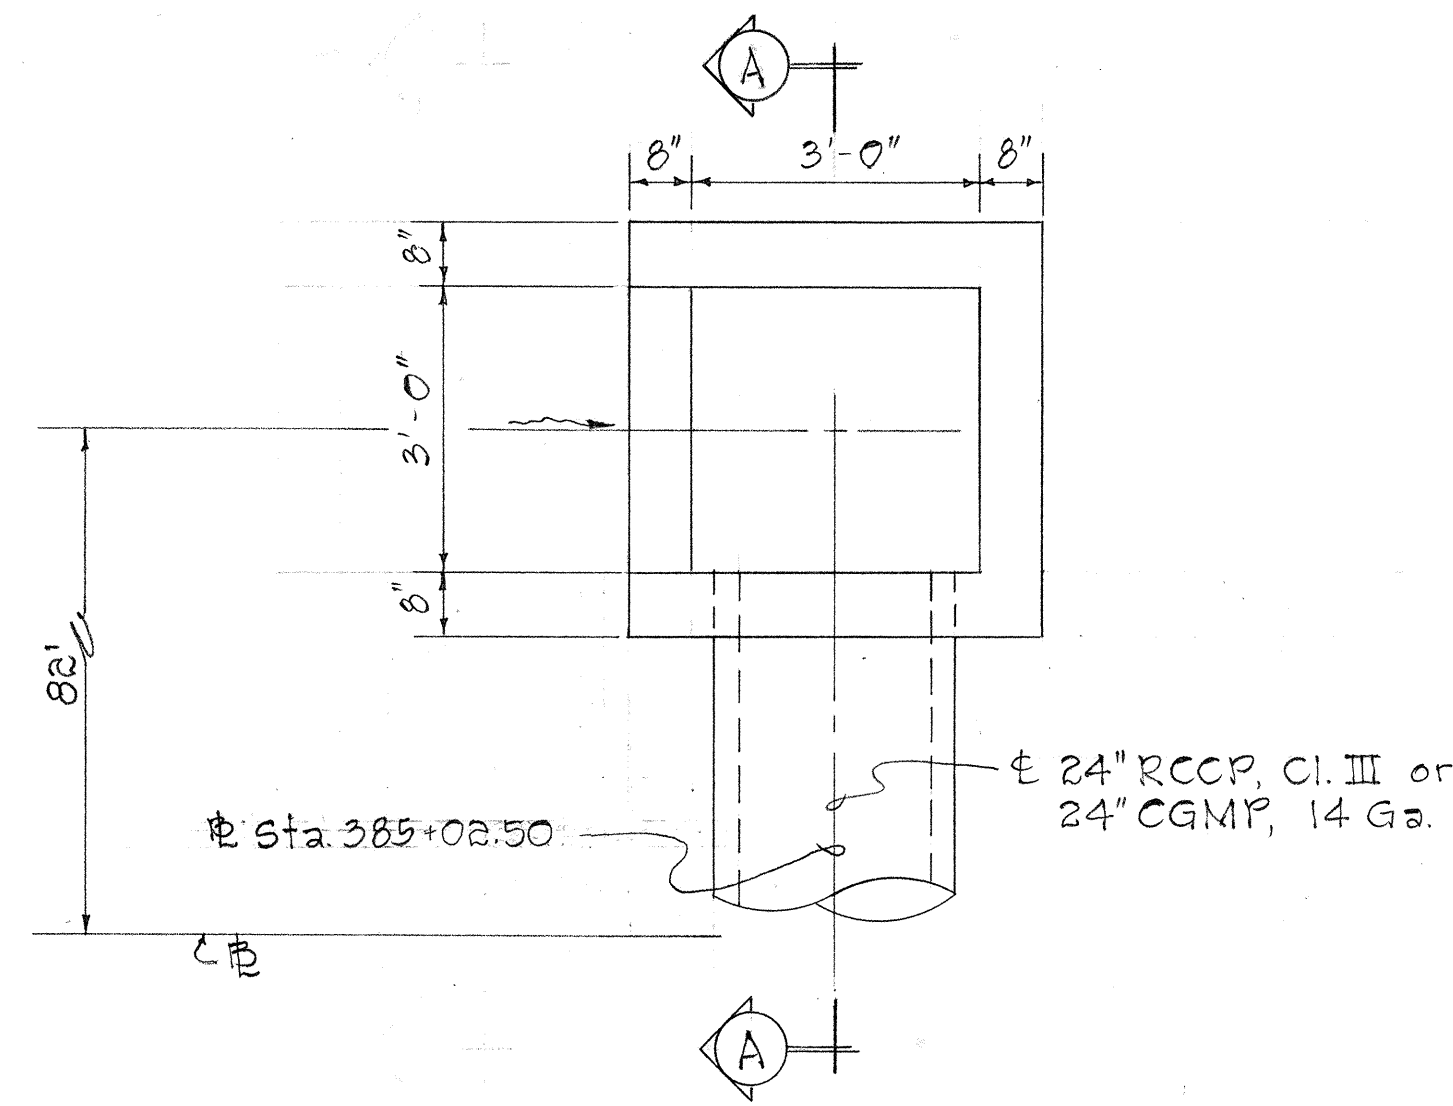


PLAN
Scale: 1/2" = 1'-0"

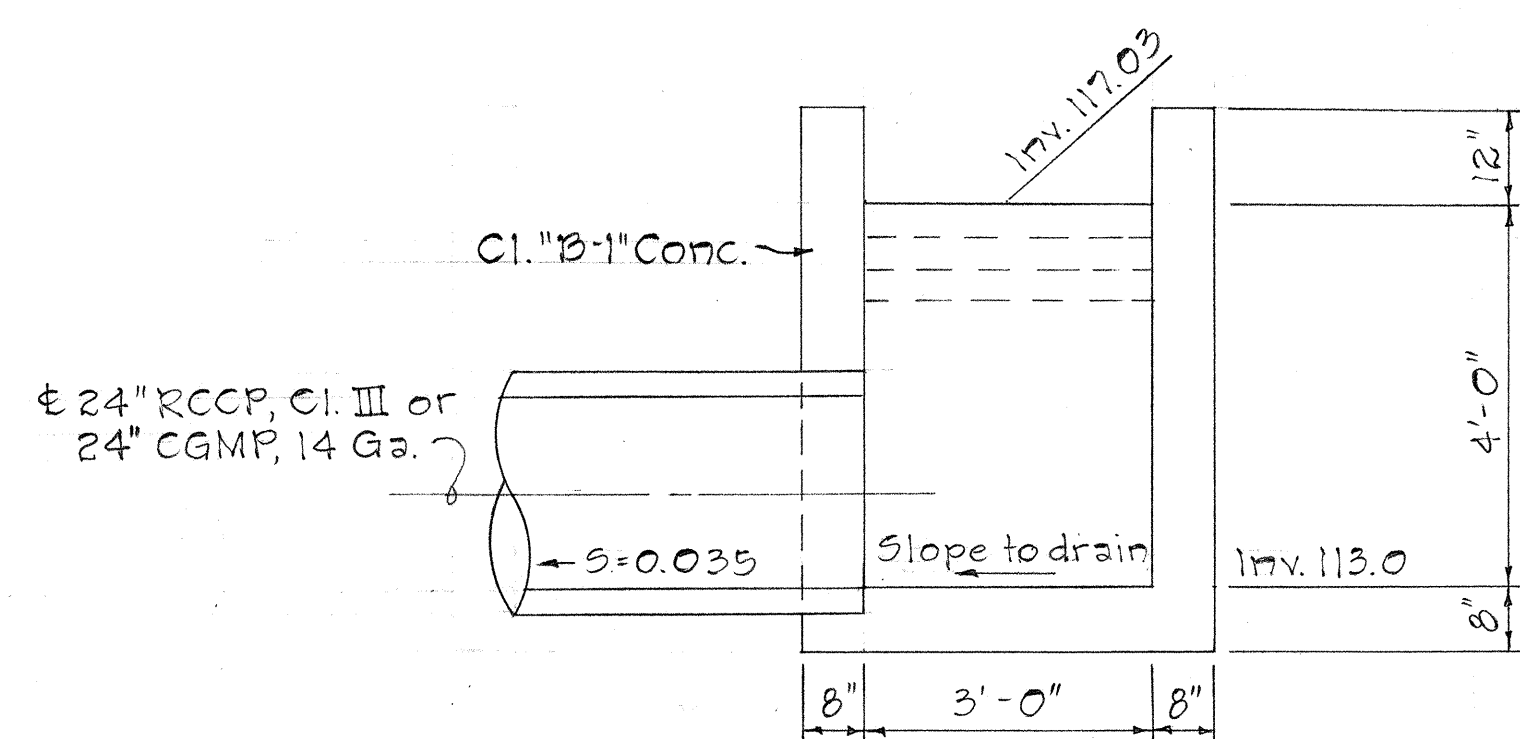


SECTION "A-A"
Scale: 1/2" = 1'-0"

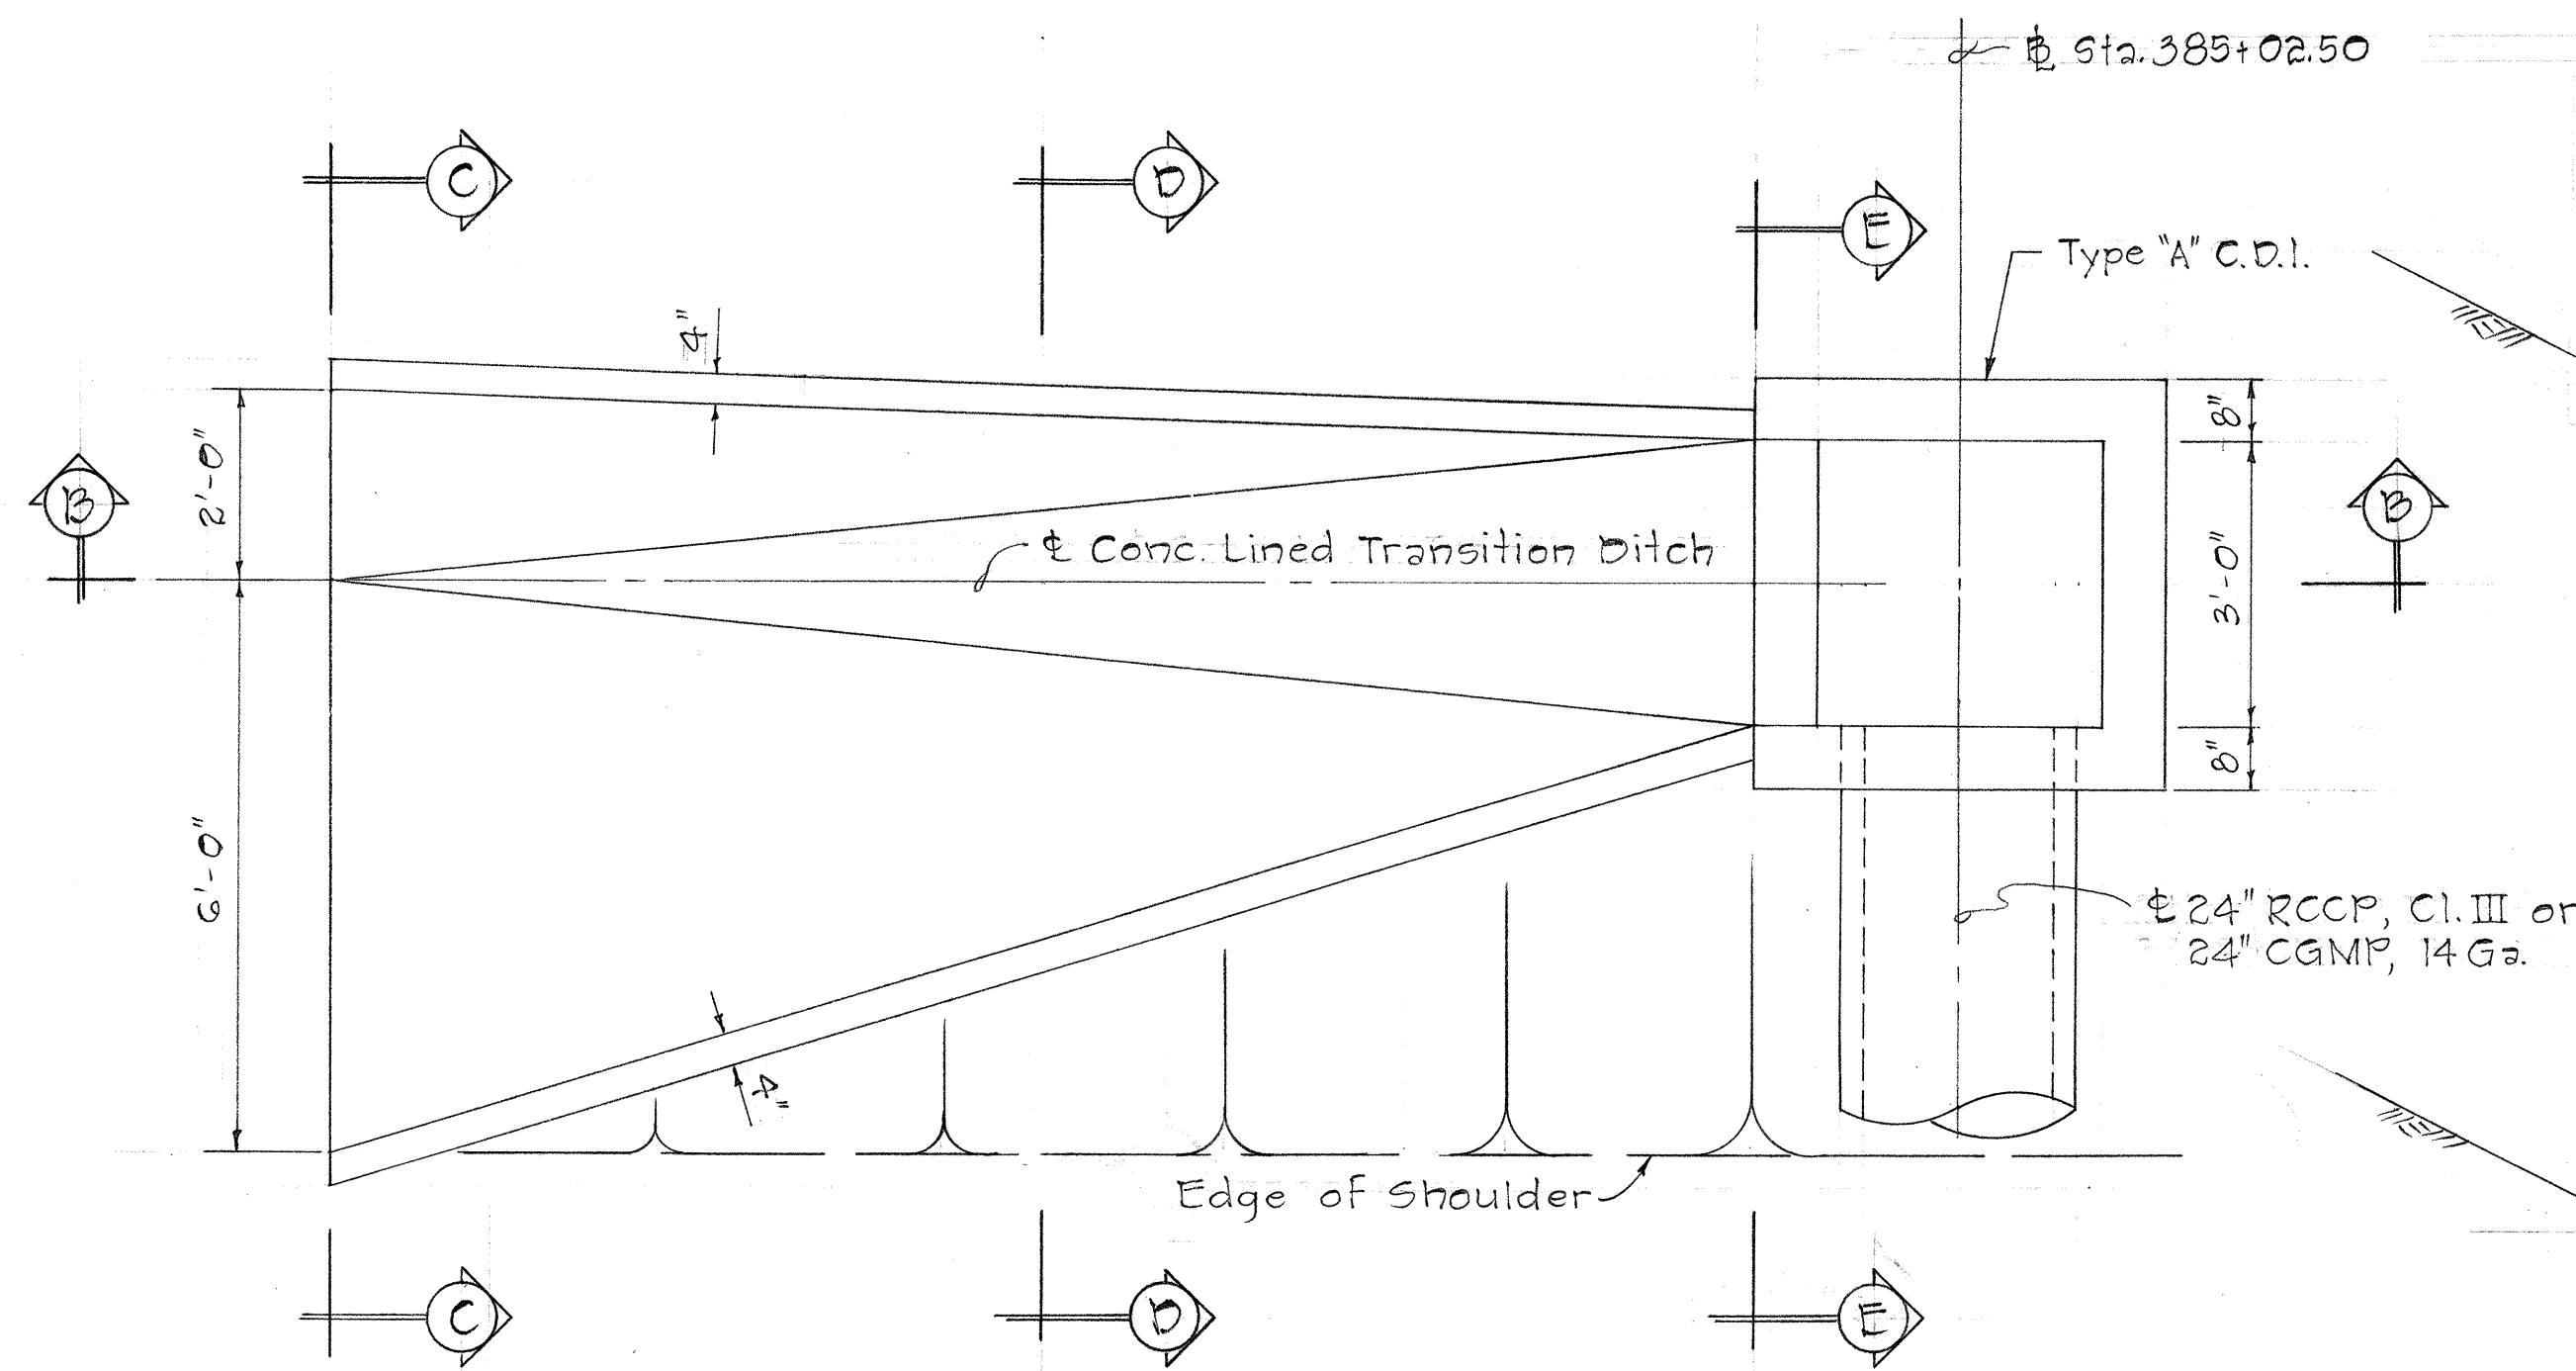


PLAN
Scale: 1/2" = 1'-0"

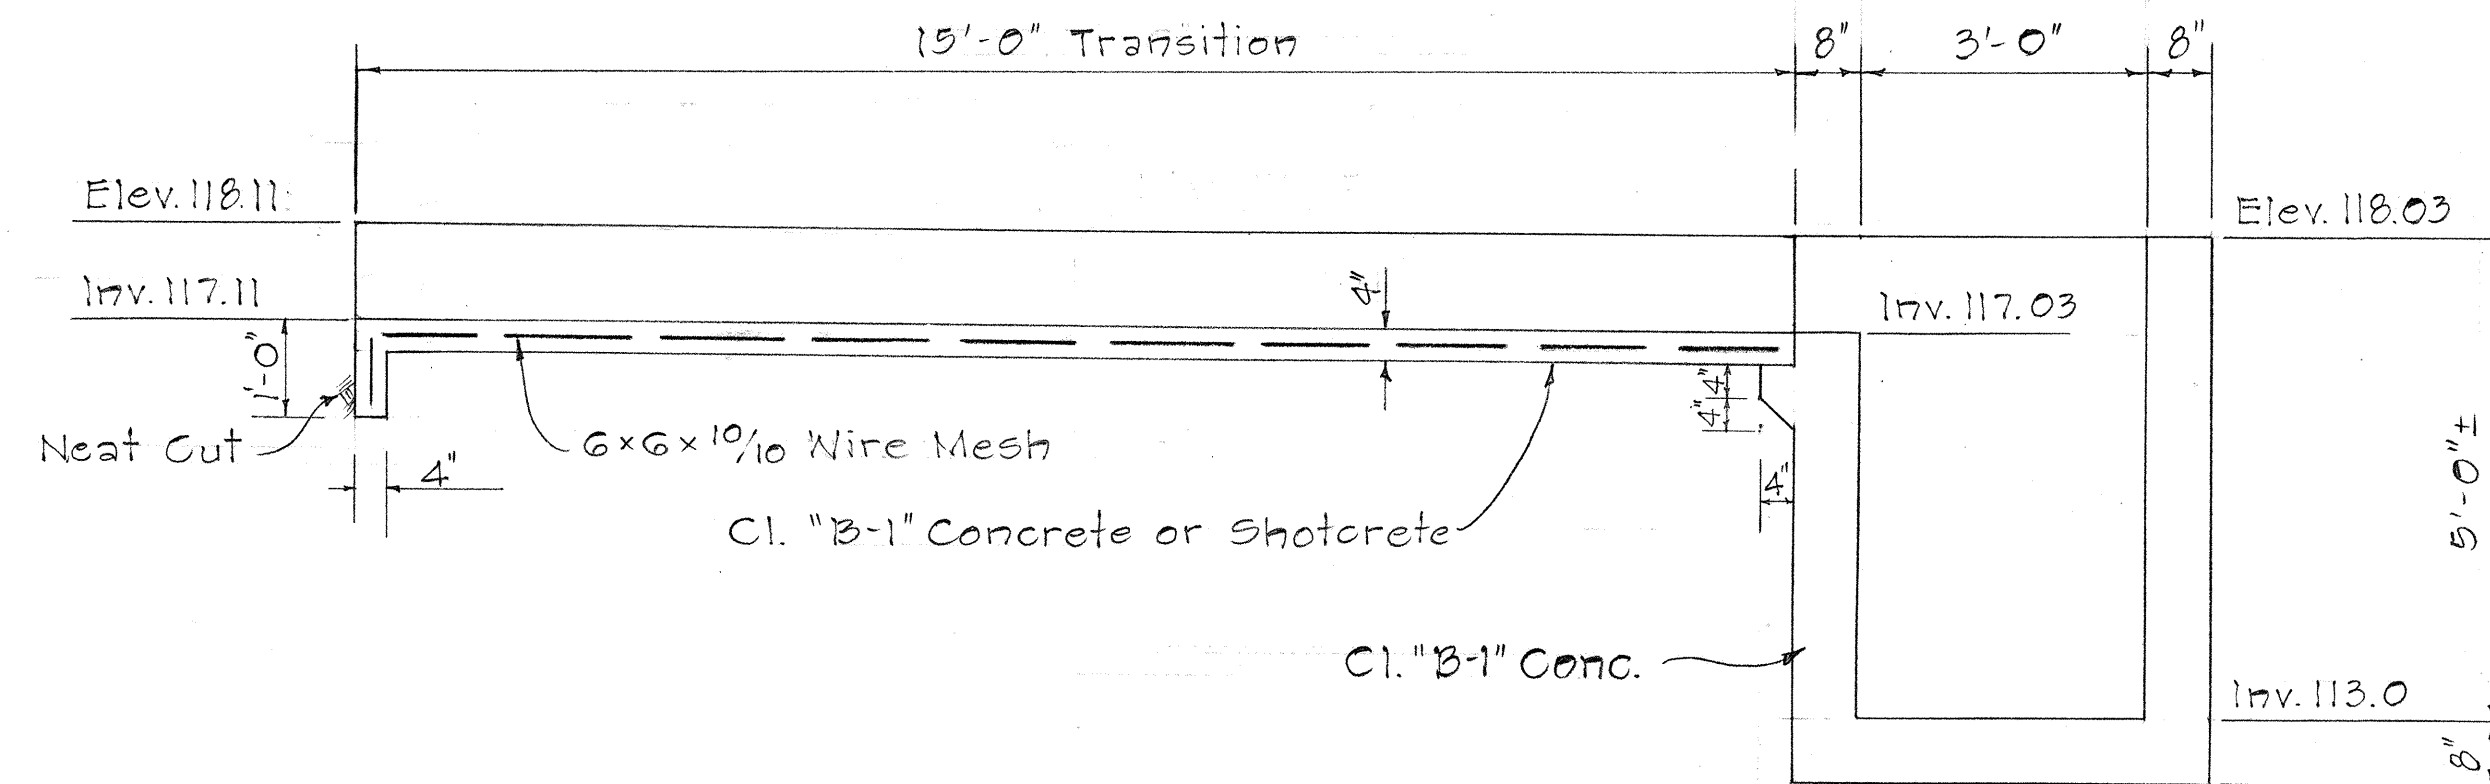


SECTION "B-B"
Scale: 1/2" = 1'-0"

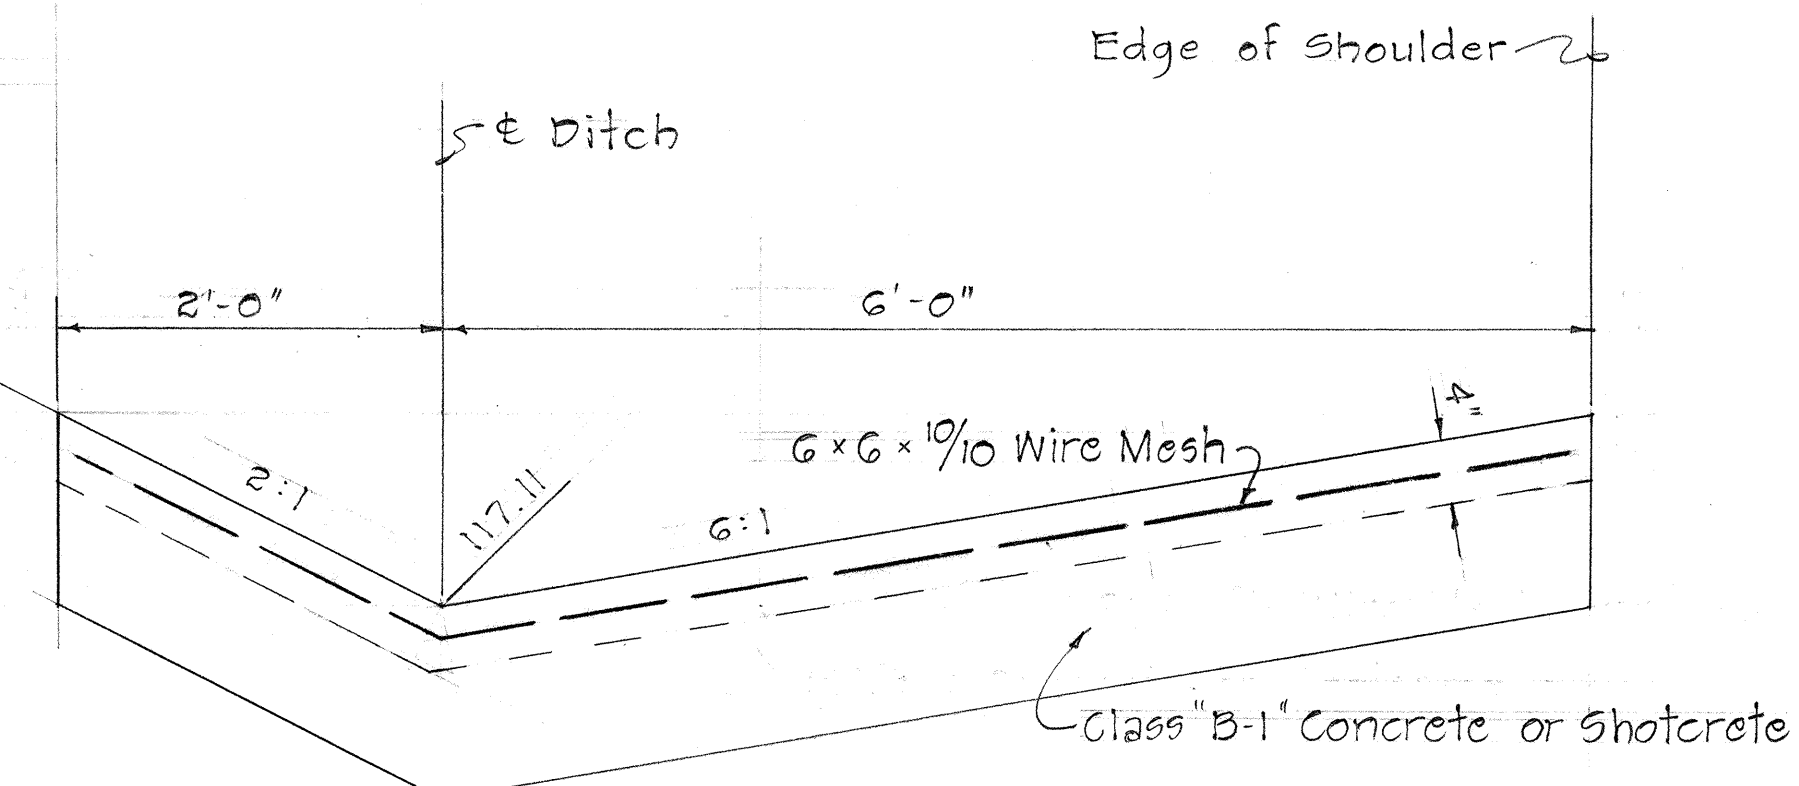

SECTION "C-C"
Scale: 1" = 1'-0"

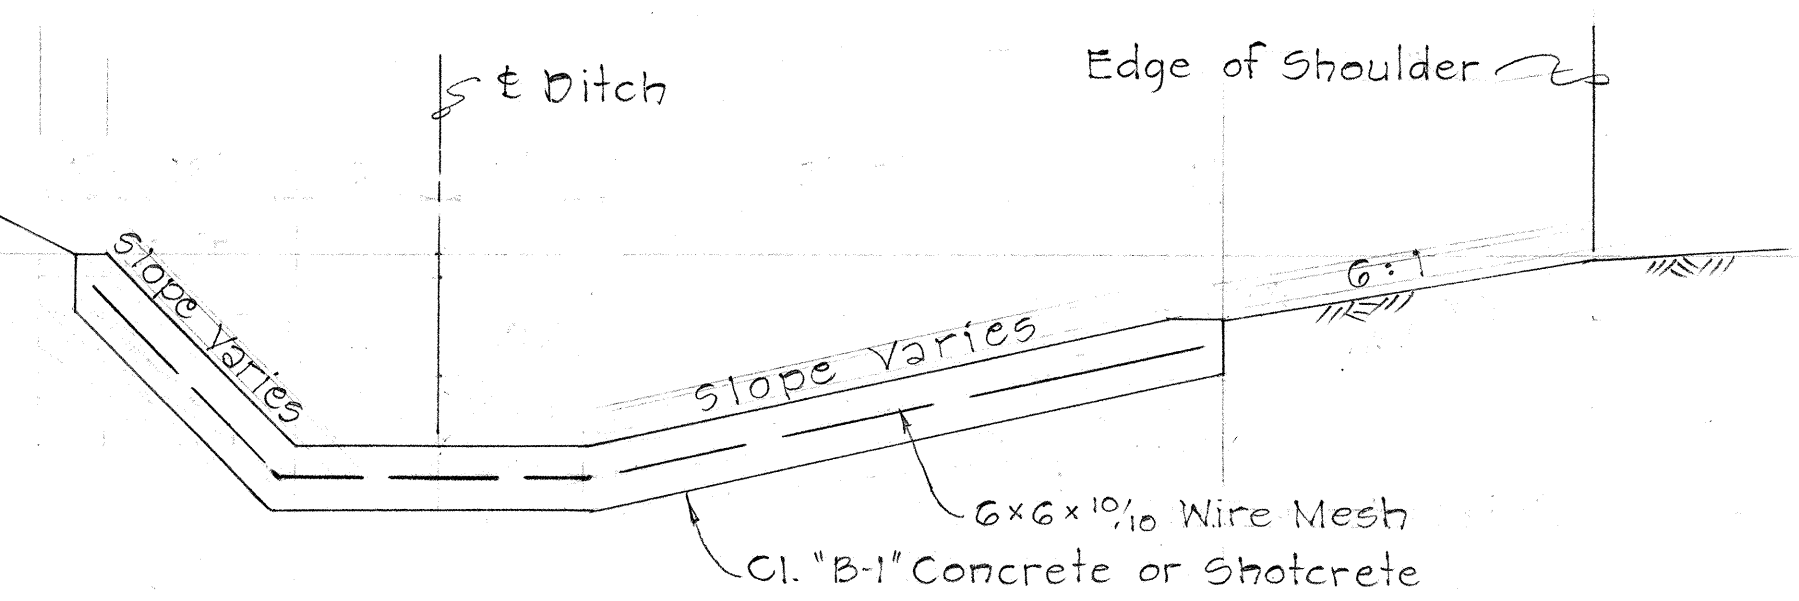

SECTION "D-D"
Scale: 1" = 1'-0"

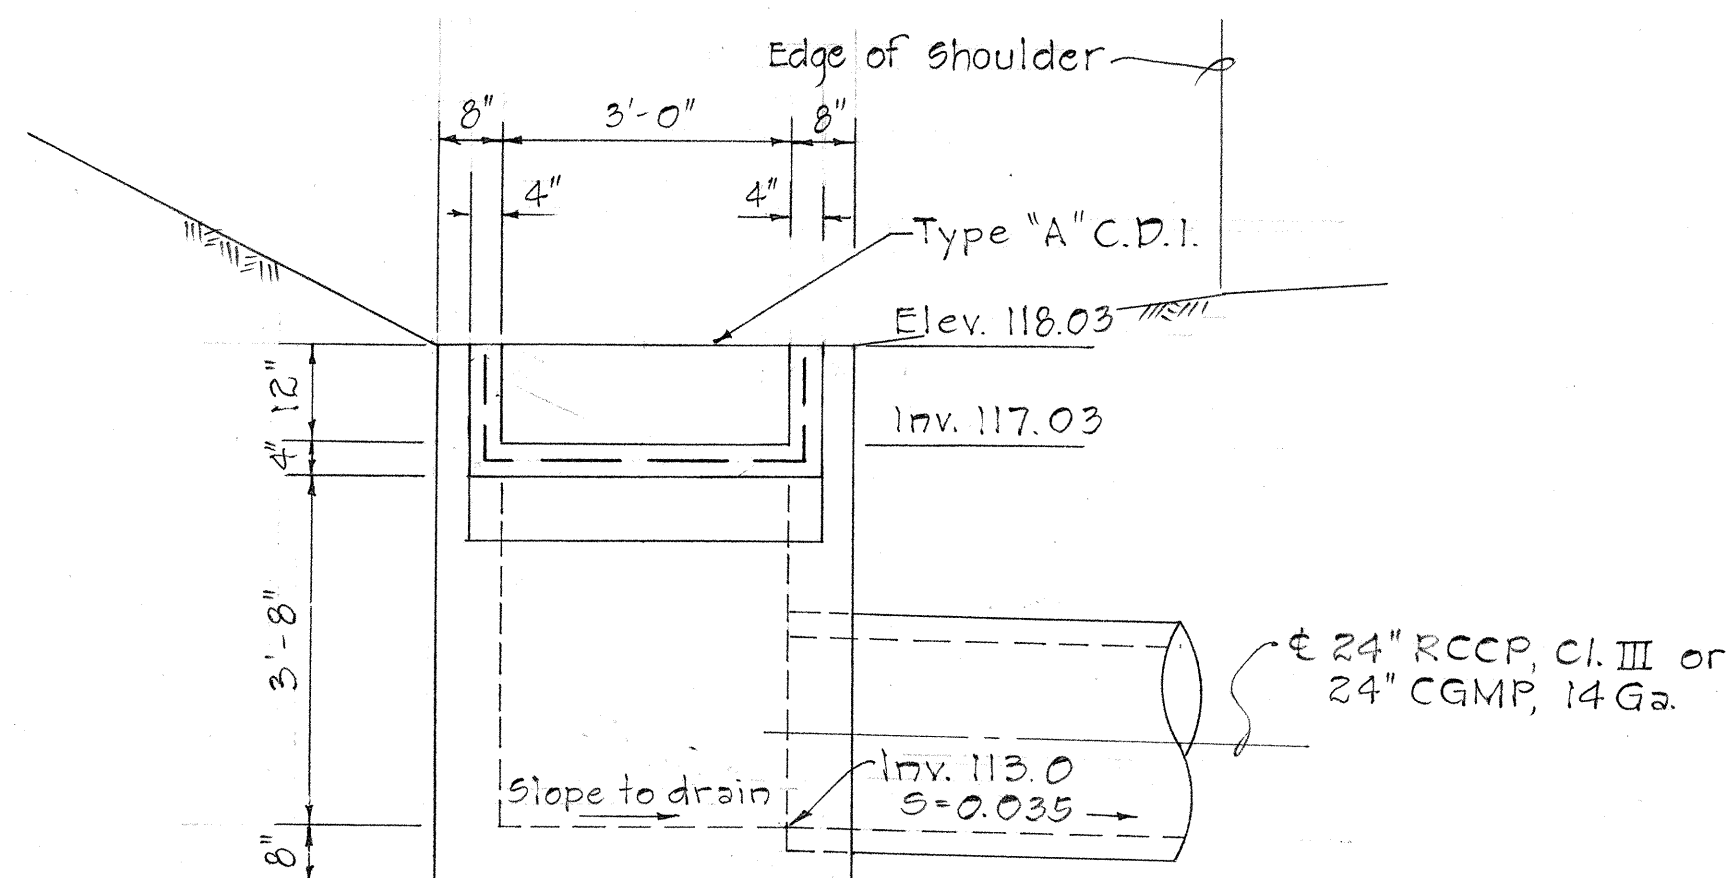

SECTION "E-E"
Scale: 1/2" = 1'-0"

DETAILS OF TYPE "A" CDI AT STA. 385+02.50 82 1/2% RT.

STATE OF HAWAII

DEPARTMENT OF TRANSPORTATION

HIGHWAYS DIVISION

DRAINAGE DETAILS

TYPE "A" CDI AT STA. 385+02.50 82 1/2% RT.


INTERSTATE ROUTE H-1

F.A.I. PROJ. NO. I-HI-1(32) 5 Unit 3


Scale: As Shown Date: June, 1967

SHEET No. 19 OF 28 SHEETS

FED. ROAD DIST. NO.	STATE	FED. AID PROJ. NO.	FISCAL YEAR	SHEET NO.	TOTAL SHEETS
HAWAII	HAW.	I-HI-1(32)-5 Unit 3	1967	C.O. 49 A	99
		I-HI-1(22)-5 Unit 2			

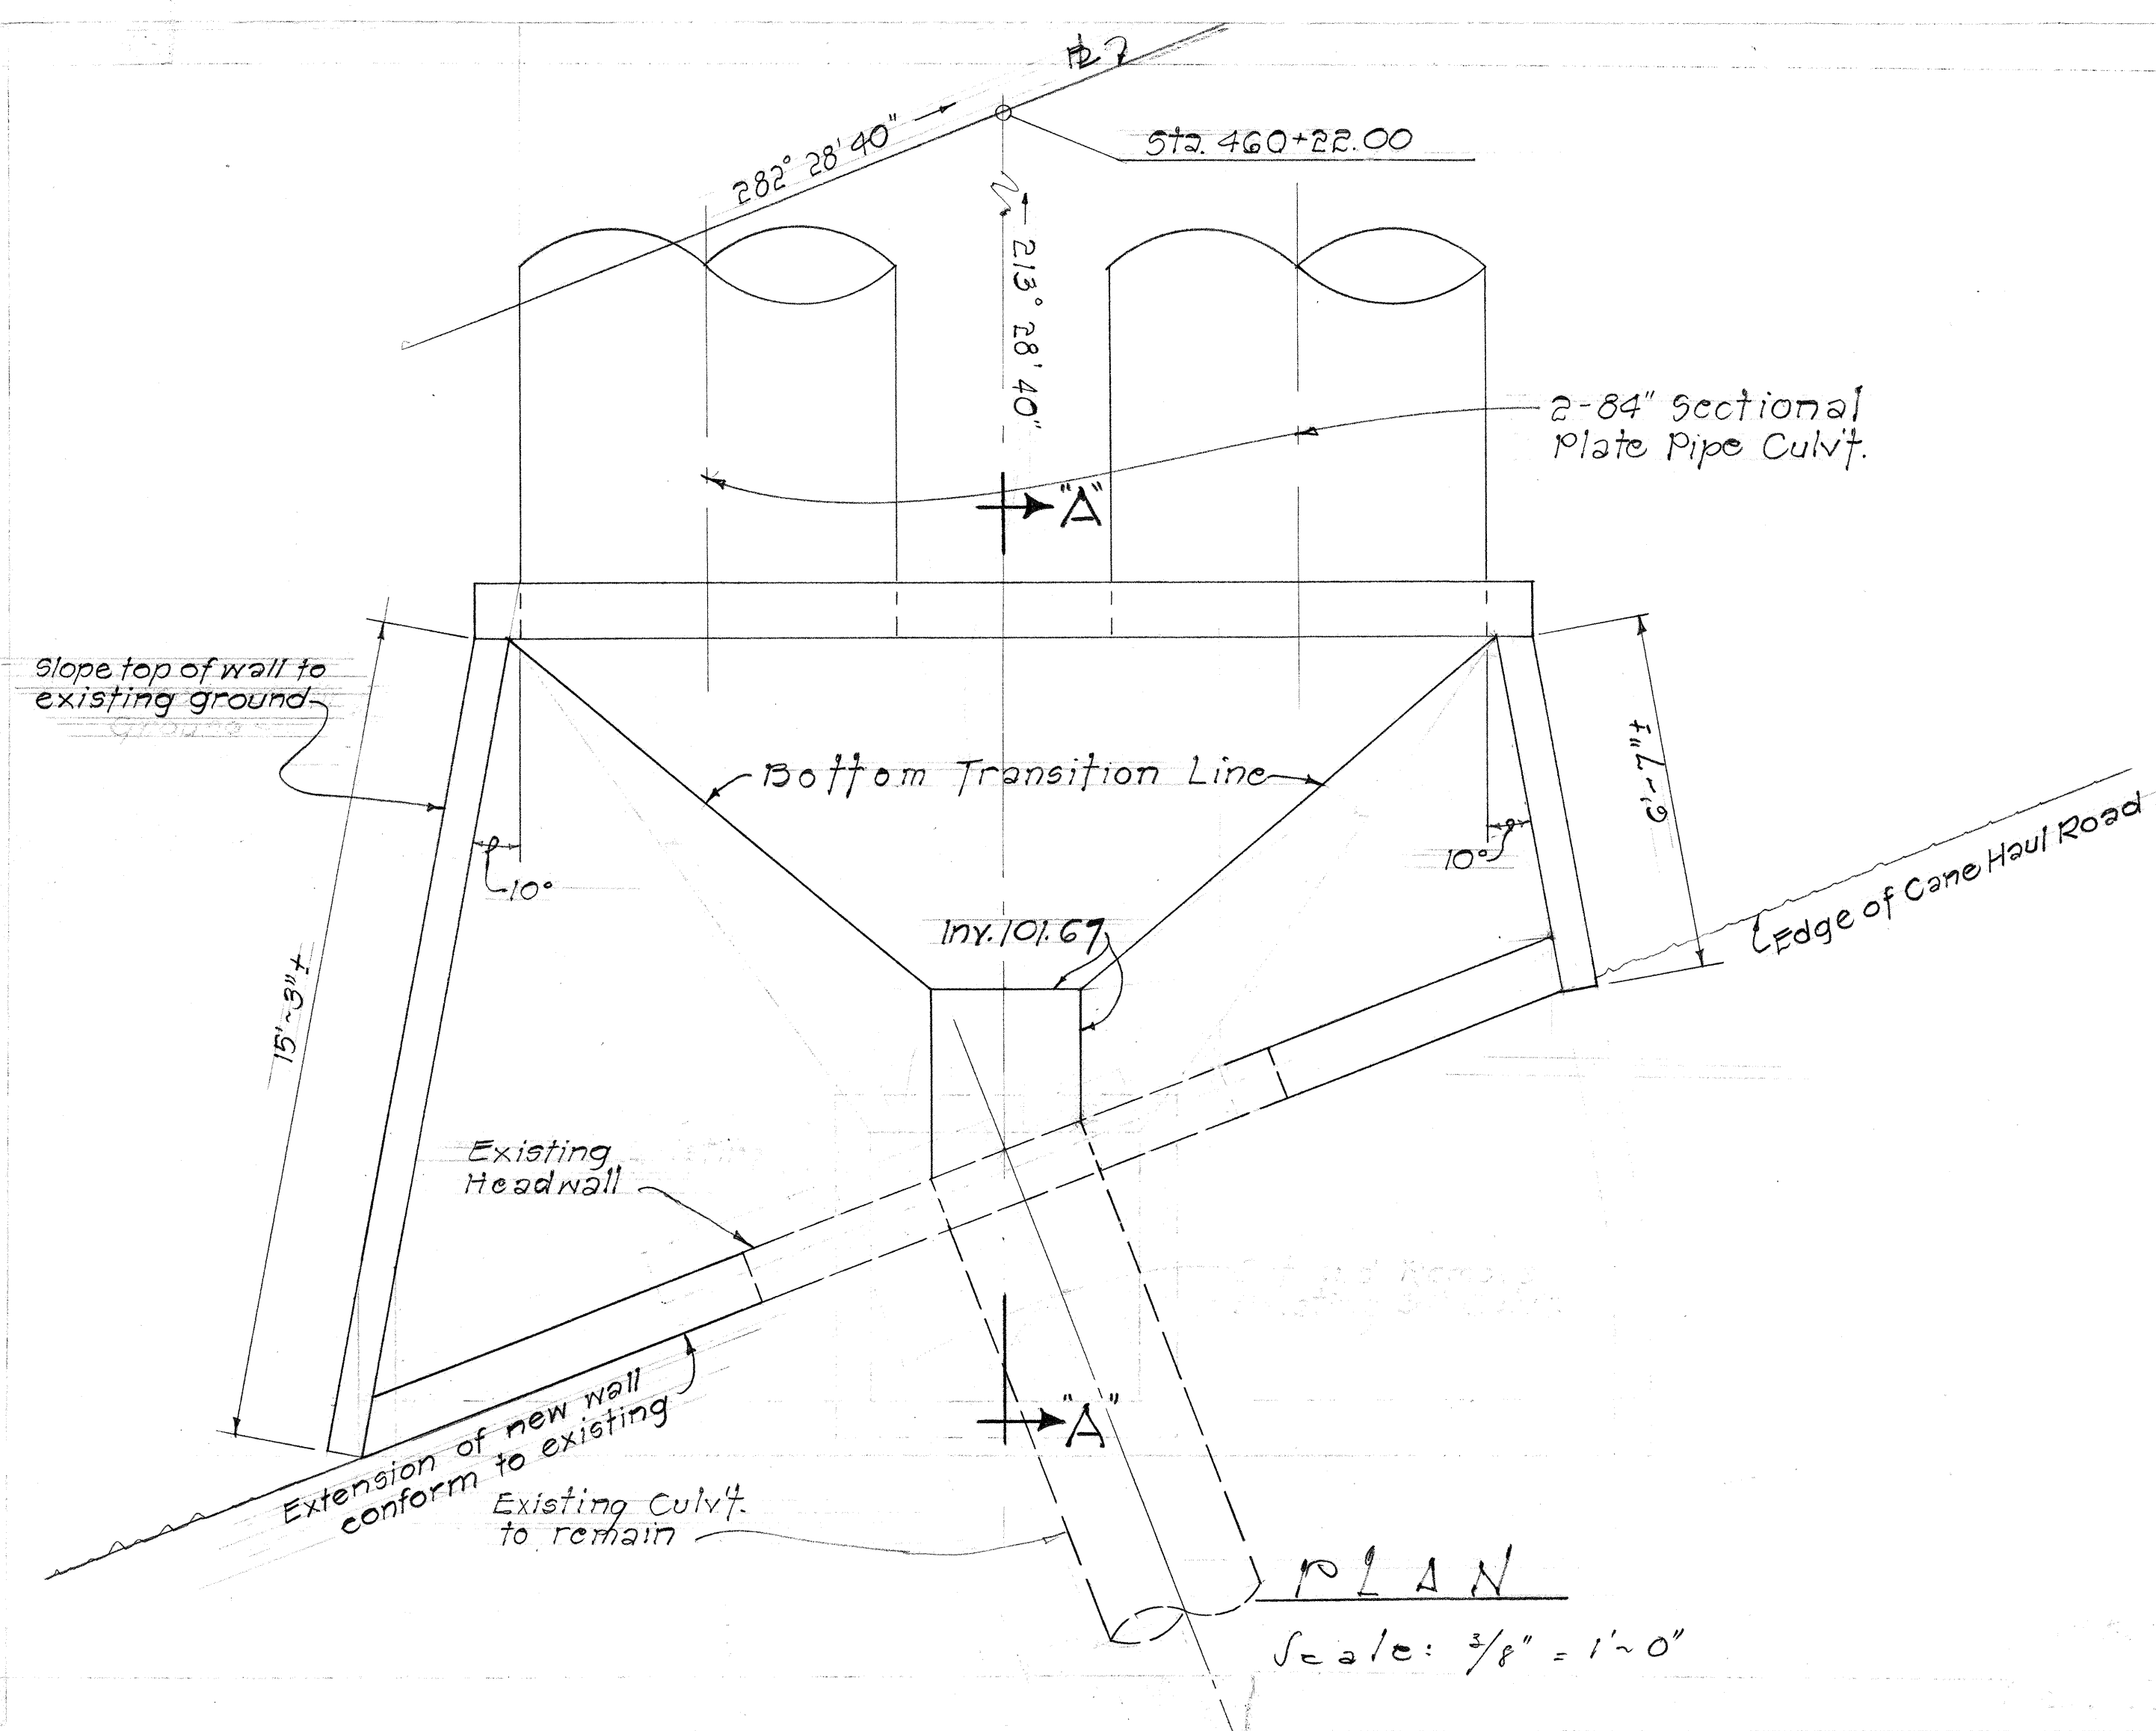

PLAN
Scale: 3/8" = 1'-0"

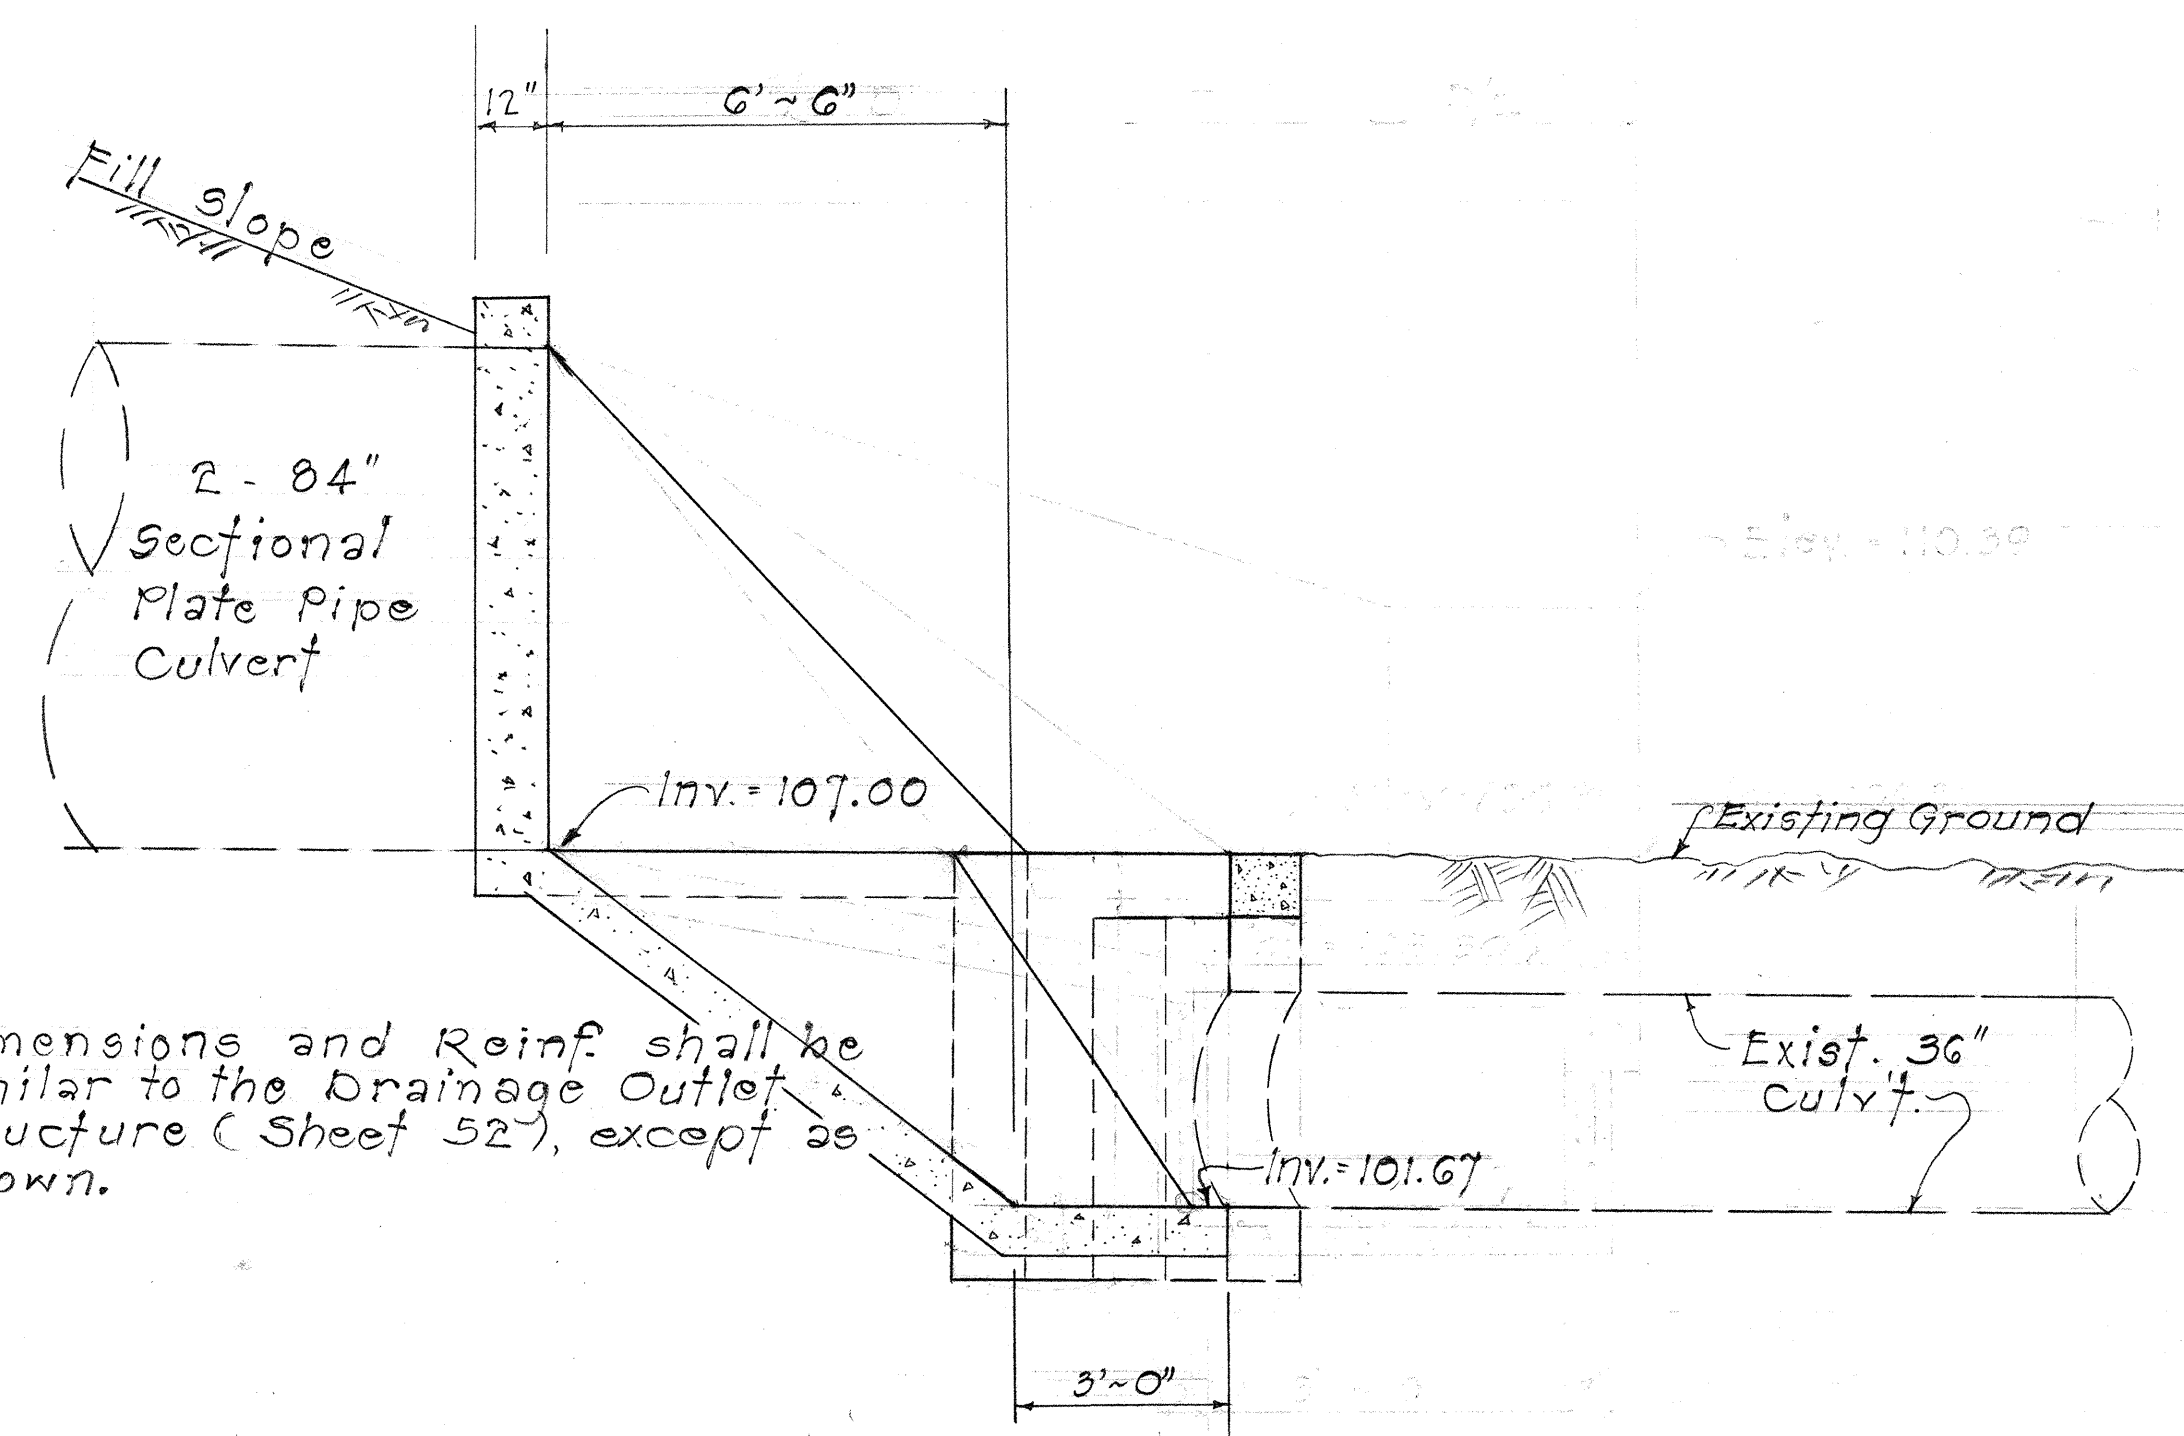

SECTION VIEW "A-A"
Scale 3/8" = 1'-0"

OUTLET STRUCTURE @ STA. 460 + 22 RT.

STATE OF HAWAII
DEPARTMENT OF TRANSPORTATION
HIGHWAYS DIVISION

DRAINAGE DETAILS

OUTLET STRUCTURE @
STA. 460 + 22 RT.

INTERSTATE ROUTE H-1
F.A.I. PROJ. NO. I-HI-1(32)-5, Unit 3

Scale: As Shown Date: June, 1967

SHEET No. OF SHEETS

February 5, 1968

C O 49 A

ORIGINAL	DATE
PLAN	
NOTE BOOK	
DESIGNED BY	
QUANTITIES BY	
CHECKED BY	

Technical drawing of a manhole structure, showing plan and elevation views with dimensions and material specifications.

Plan View (Top):

- Overall width: 28'-8"
- Overall depth: 4'-0"
- Horizontal dimensions from left to right: 4'-0", 6'-8", 8", 6'-0", 8", 6'-8", 4'-0"
- Vertical dimensions from top to bottom: 2'-0", 2'-0", 4'-0"
- Labels for concrete lining: "Top of Concrete Lining" and "4" Concrete Lining"
- Label for frame and cover: "Type 'A' C.I. Frame and Cover"
- Label for ditch: "Ditch"
- Label for pipe culvert: "Pipe Culvert"
- Label for edge of shoulder: "Edge of Shoulder"

Elevation View (Bottom):

- Overall width: 28'-8"
- Overall depth: 4'-0"
- Horizontal dimensions from left to right: 4'-0", 6'-8", 8", 6'-0", 8", 6'-8", 4'-0"
- Vertical dimensions from top to bottom: 2'-0", 2'-0", 4'-0"
- Labels for concrete lining: "Top of Concrete Lining" and "4" Concrete Lining"
- Label for frame and cover: "Type 'A' C.I. Frame and Cover"
- Label for ditch: "Ditch"
- Label for pipe culvert: "Pipe Culvert"
- Label for edge of shoulder: "Edge of Shoulder"

Material Specifications:

- Standard M.H. Rungs @ 16" o.c. (incidental to Class "A-1" Concrete)
- #3 @ 3' o.c.

[illegible]

Hand-drawn cross-section diagram of a concrete structure with a pipe culvert. The diagram shows a rectangular concrete box with a circular pipe culvert at the bottom. The structure is reinforced with steel bars and stirrups. Dimensions are given in feet and inches. Labels include 'Cut Slope as per plan on Structure w/ 6x6x1% Wire Mesh Reinforcing #3 @ 6" Bothways', 'See Plans for Top Elev.', 'Edge of Shoulder', 'Ditch', 'Pipe Culvert', 'See Plans for Inv.', and various reinforcement details like '#4 Bars 3" oc.', '#4 @ 12" Bothways', '#5 @ 6"', '#5 Dowels @ 12" in three (3) walls bend as required', '3-#4 tie bars @ 12" in three (3) walls.', '#4 Closed Stirrup @ 12"', and '#5 @ 9"'. The overall width is 4'-0" and the height is 2'-5".

SECTION "C-C"
Scale: 1" = 1'-0"

STATE OF HAWAII
DEPARTMENT OF TRANSPORTATION
HIGHWAYS DIVISION

DRAINAGE DETAILS

TYPE "A2", "B2", "C2" AND "D2"
CATCH BASIN

INTERSTATE ROUTE H-1
F.A. 1. PROJ. NO. I-H1-1(32); 5, Unit 3

Scale: As Shown Date: June, 1967

SHEET No. 21 OF 28 SHEETS

FED. ROAD DIST. NO.	STATE	FED. AID PROJ. NO.	FISCAL YEAR	SHEET NO.	TOTAL SHEETS
HAWAII	HAW.	1-HI-1(32-5) Unit 3	1967	51	99


GENERAL NOTES

- Concrete: All concrete shall be Class A-1.
- Cutoff Wall: The depth of wall shown on the plan may be reduced if rock is encountered at a higher elevation.
- Multiple Pipe Installations: To permit careful placing and tamping of back fill material, clear spacing for multiple pipe installations shall be not less than one-half the diameter of the larger pipe between sides of adjacent pipes, but not required to exceed three feet.
- Anchor Bolts: Anchor bolts are not required for concrete pipe.

SUMMARY OF QUANTITIES


Culvert Dia.	Concrete	Reinf. Steel
inches	Cu. Yd.	Lbs.
48		
54		
60		
72		
84		
96		
108		
120		
144		
180		

Note: Quantities shown are for C.G.M.P. culvert.

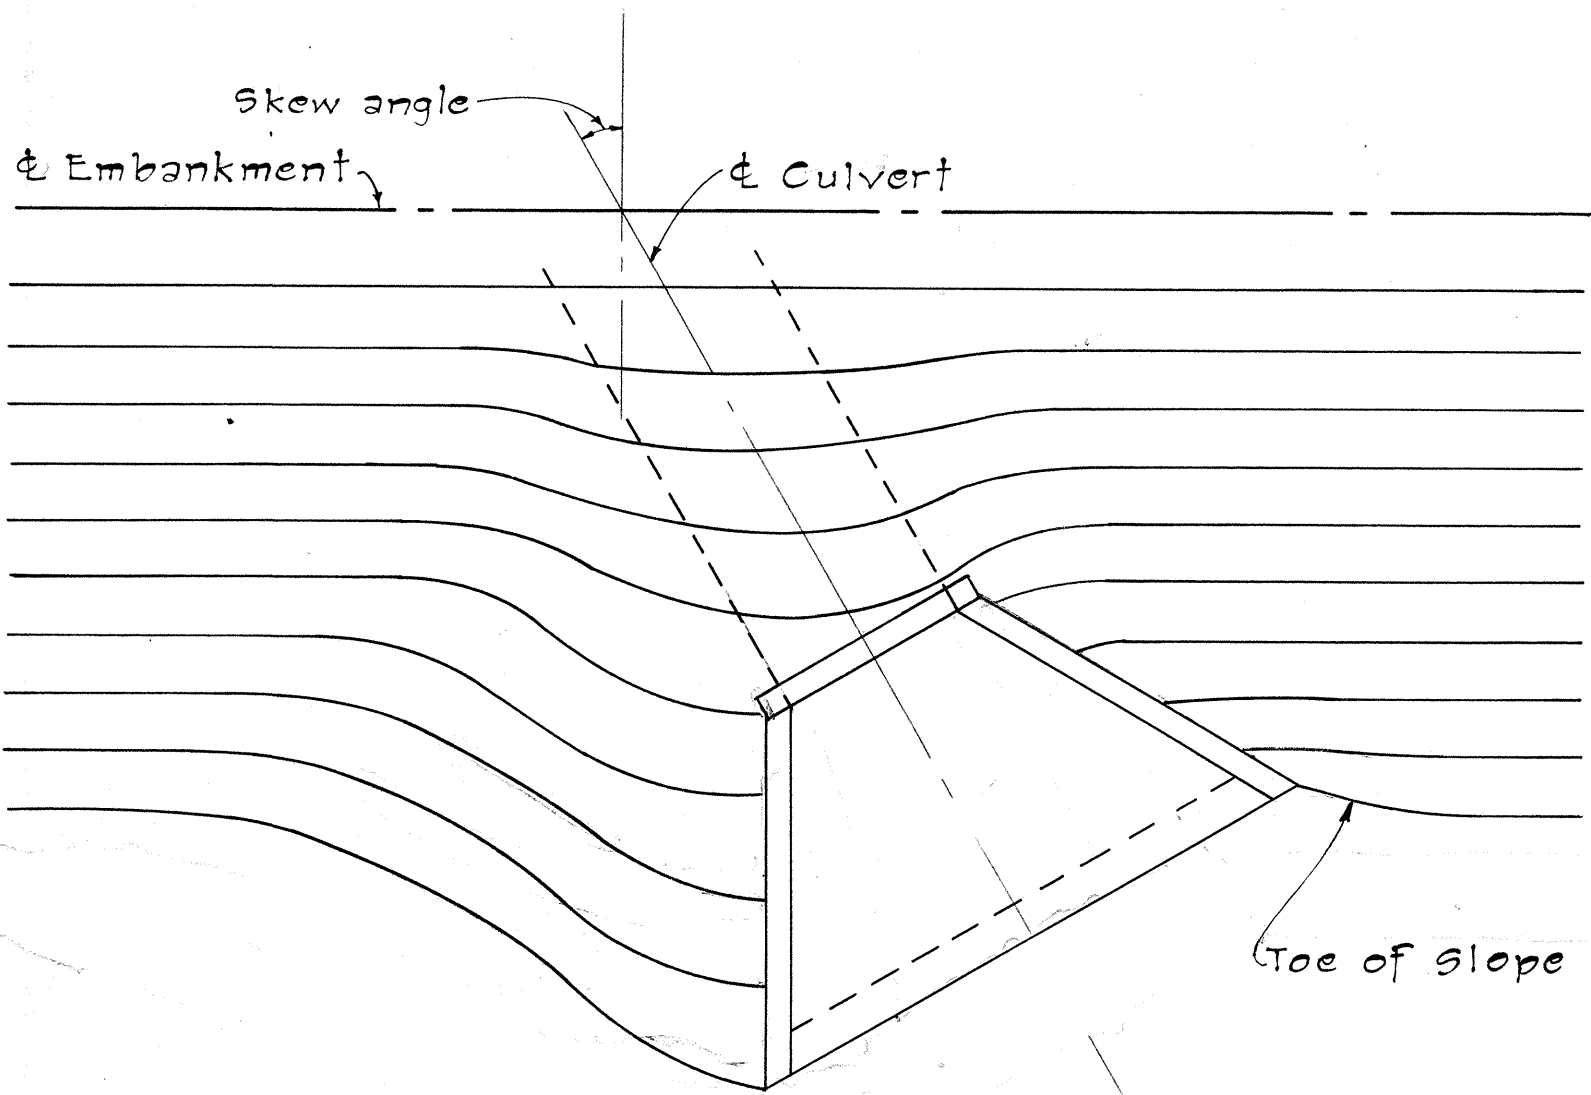


EMBANKMENT CONTOURS FOR SKEWED INLET


When inlet is skewed to embankment slope, the embankment may be contoured to cover the exposed section of wall and pipe.

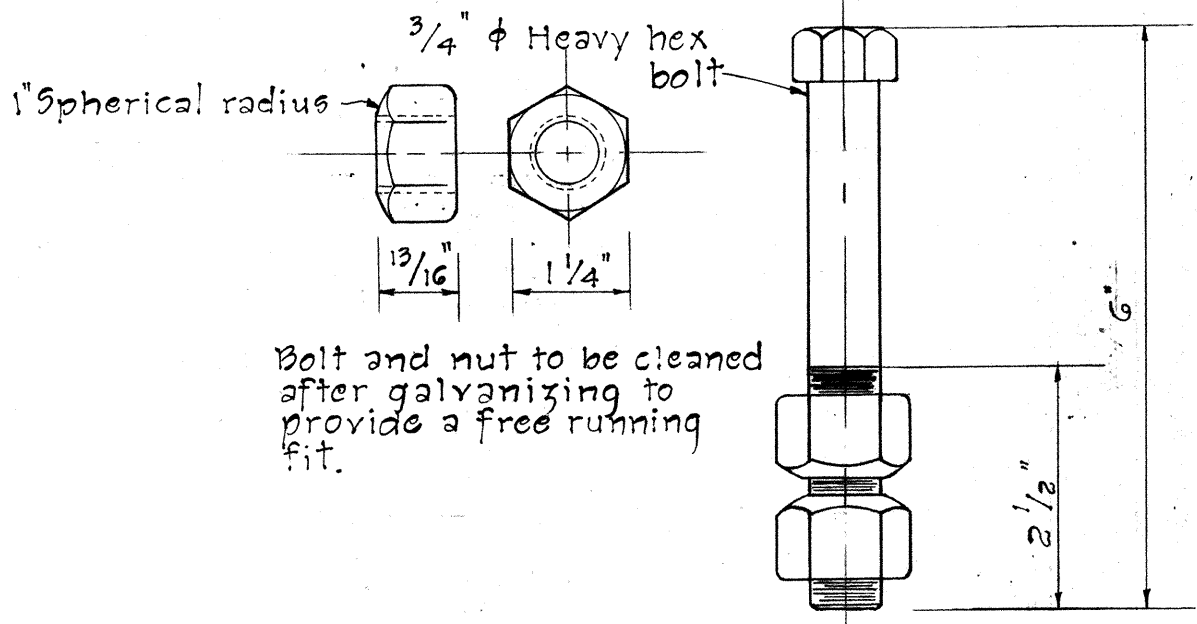

ANCHOR BOLT DETAIL

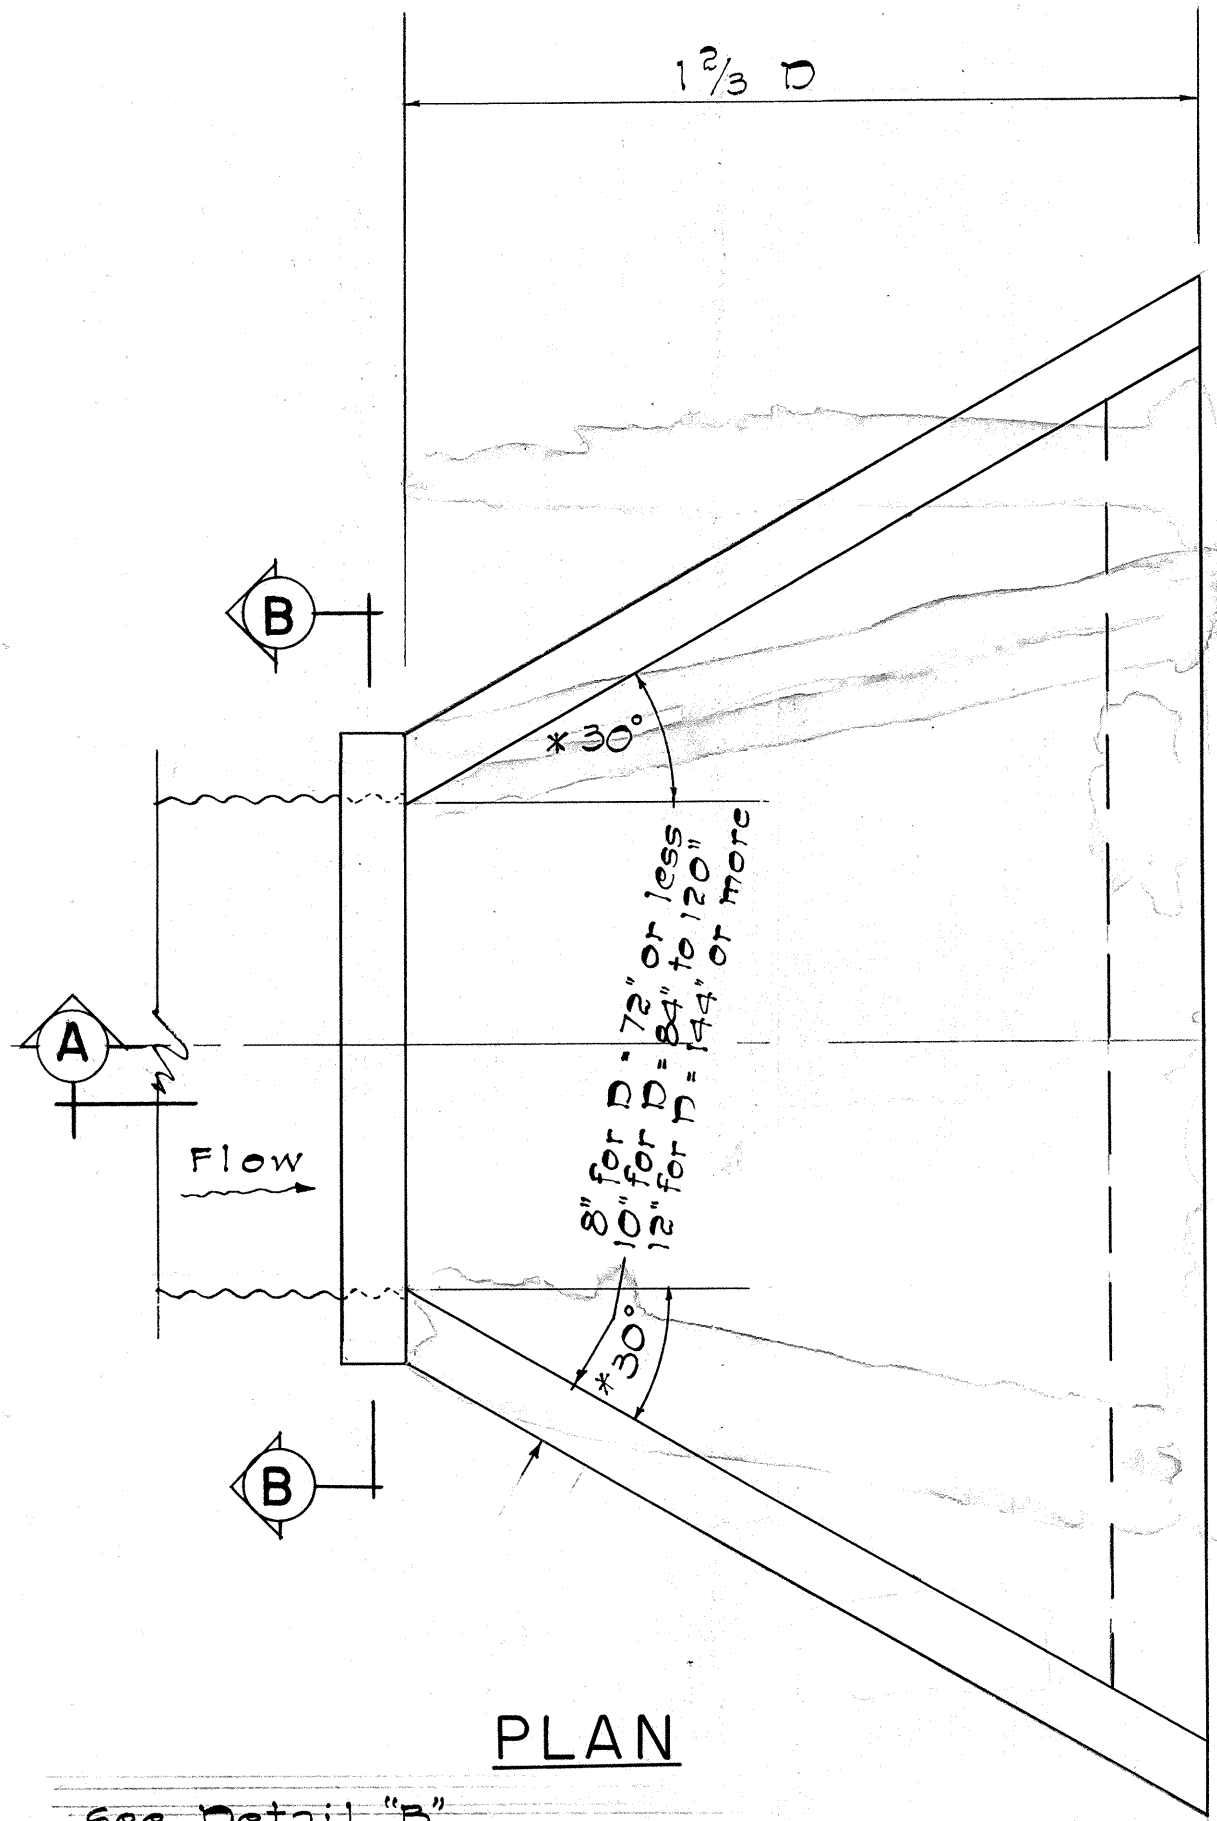


PLAN

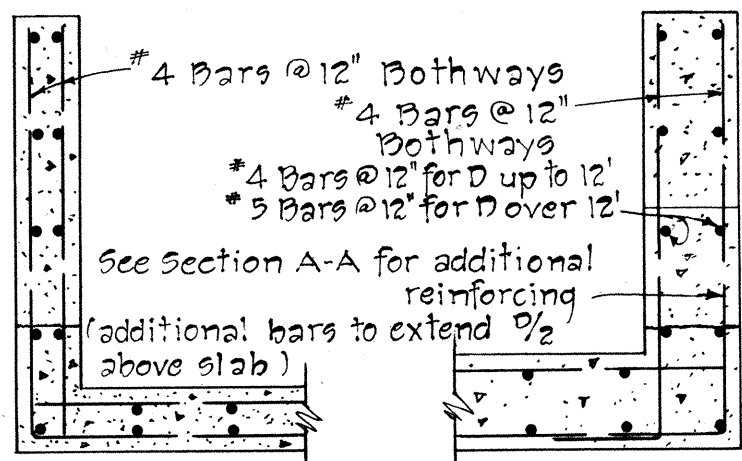


8" WING WALL 10" TO 12" WING WALLS


SECTION C-C

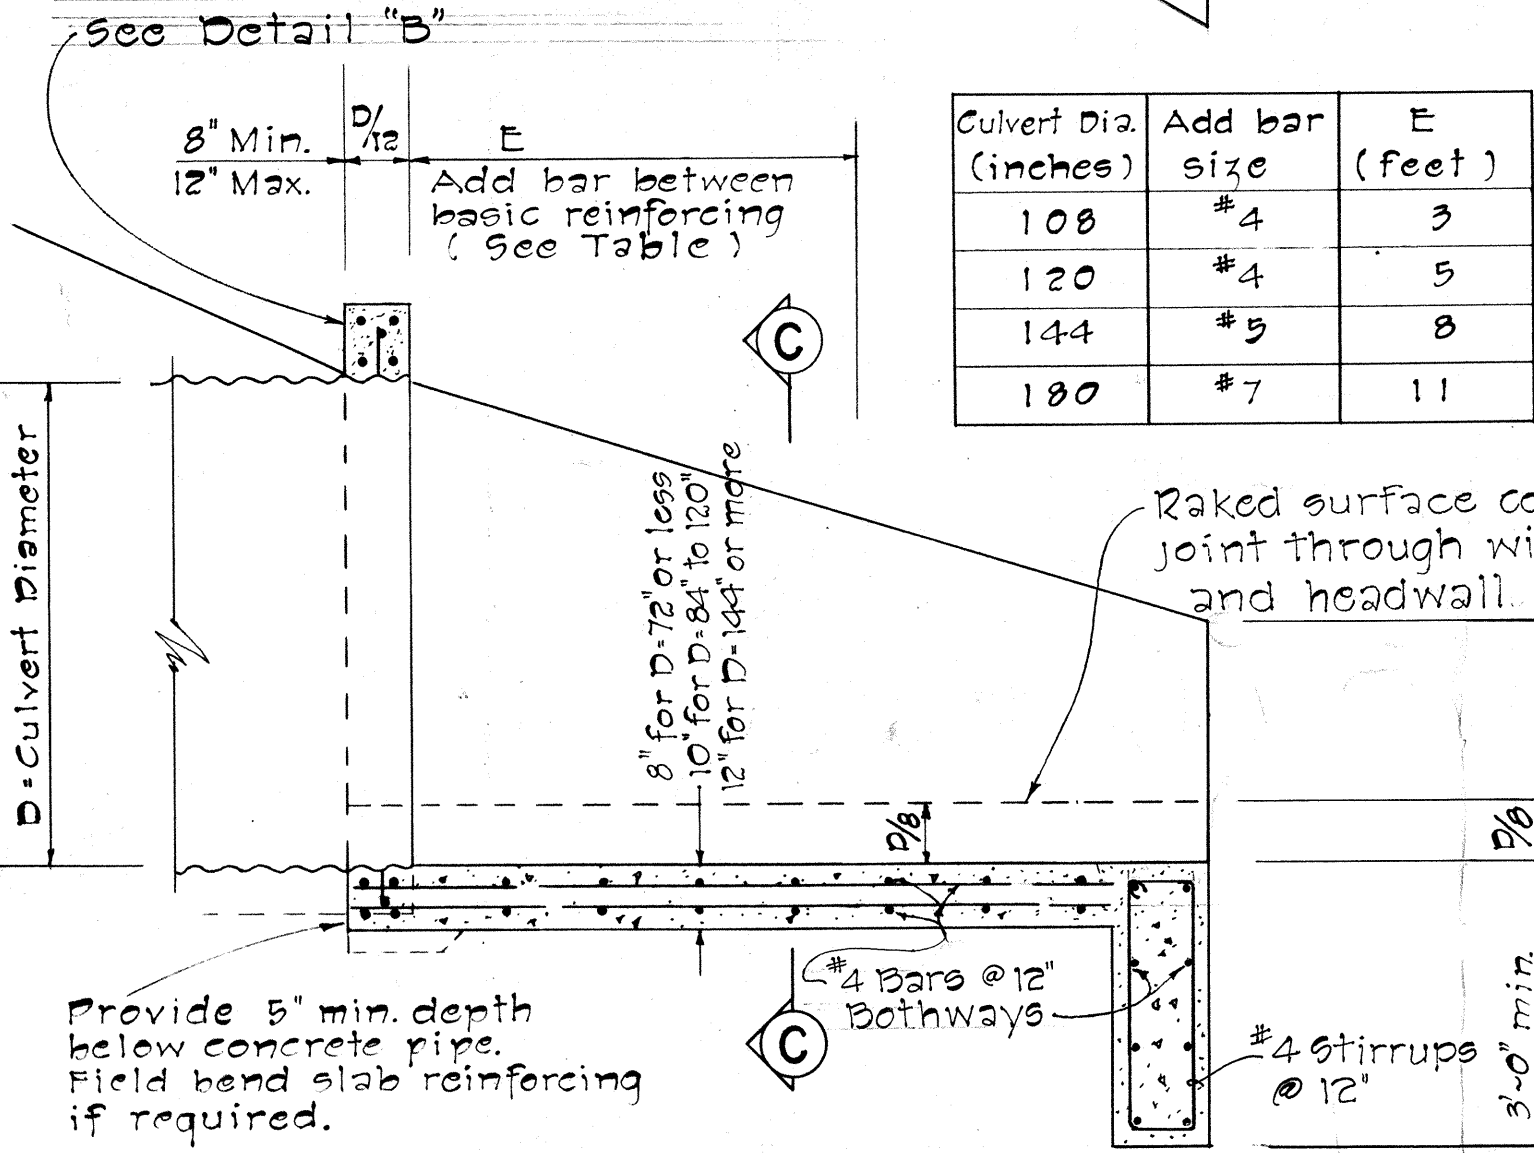


SECTION A-A

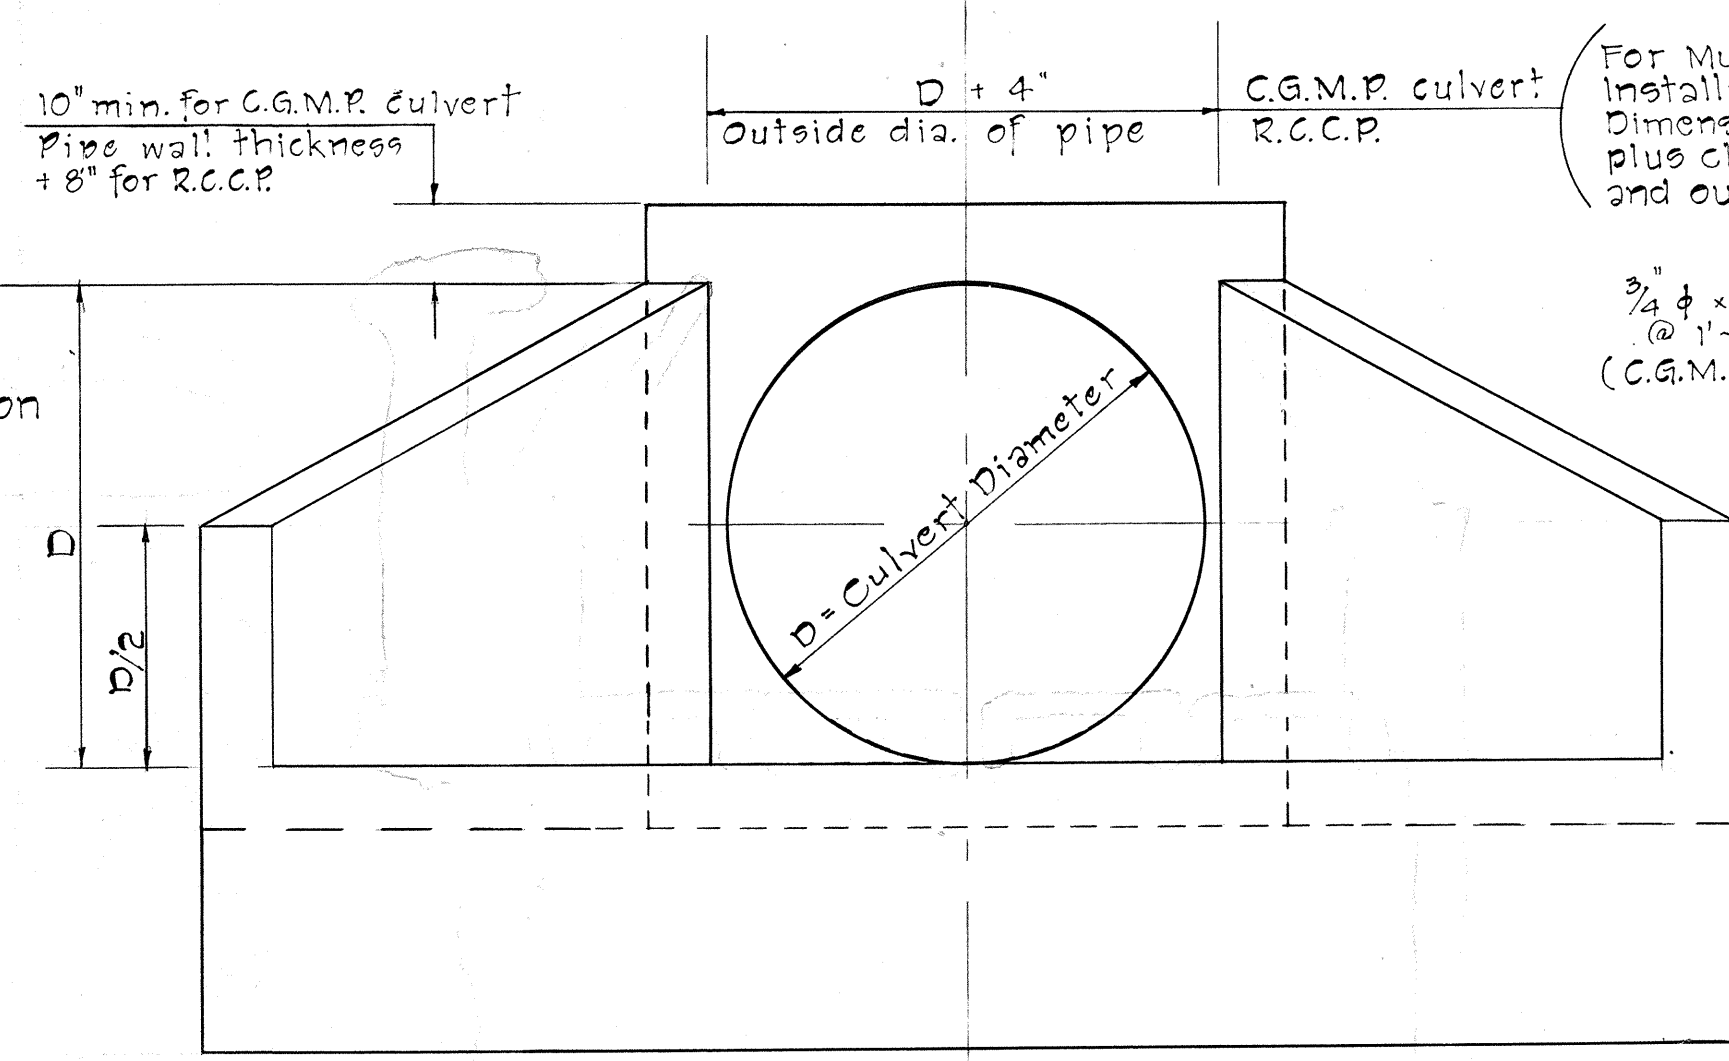

FRONT ELEVATION

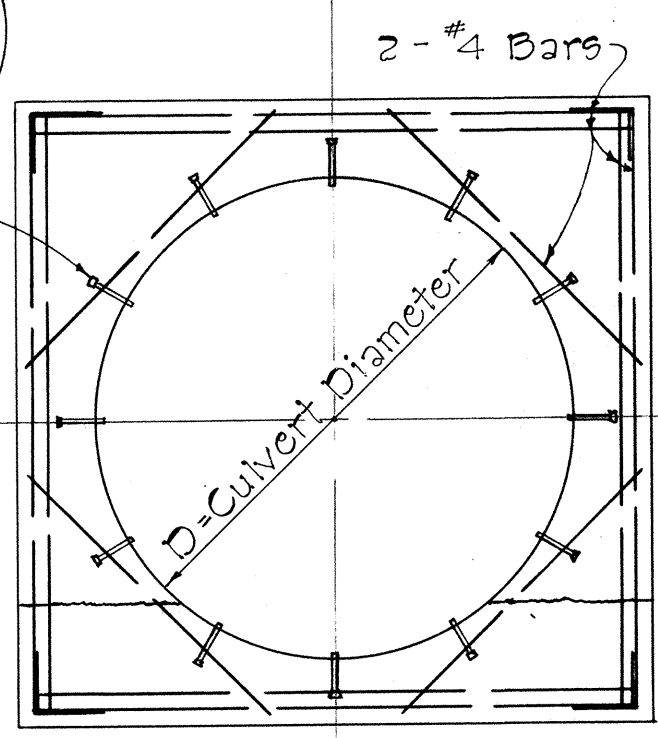

SECTION B-B

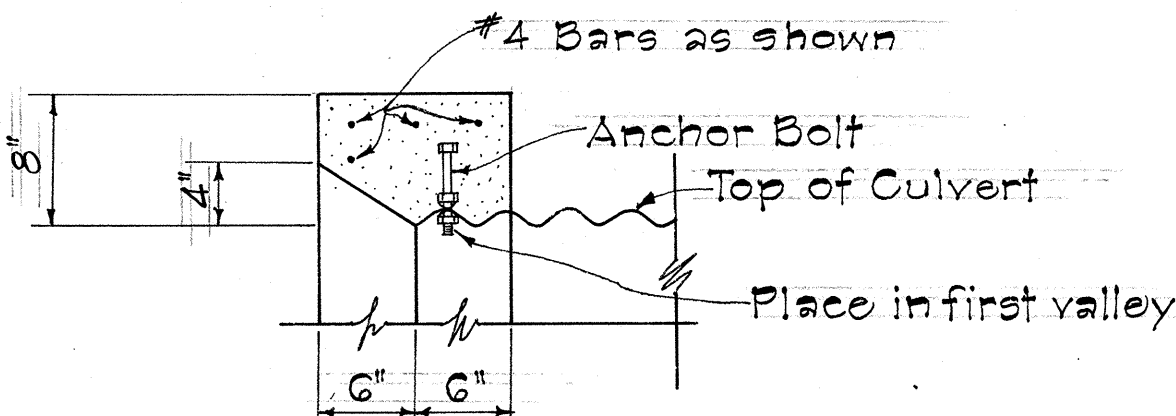

DETAIL "B"

Scale: 1" = 1'-0"

STATE OF HAWAII
DEPARTMENT OF TRANSPORTATION
HIGHWAYS DIVISION

DRAINAGE DETAILS
INLET STRUCTURES

FOR
CONCRETE AND CORRUGATED METAL
CULVERTS SIZES 48 IN. TO 180 IN.

NOT TO SCALE MAY 1967

SHEET No. 22 OF 28 SHEETS

FED. ROAD DIST. NO.	STATE	FED. AID PROJ. NO.	FISCAL YEAR	SHEET NO.	TOTAL SHEETS
HAWAII	HAW.	I-HI-(32)5 Unit 3	1967	52	99

GENERAL NOTES

Concrete: All concrete shall be Class A-1.

Cutoff Wall: The depth of wall shown on the plan may be reduced if rock is encountered at a higher elevation.


Multiple Pipe Installations: To permit careful placing and tamping of back fill material, clear spacing for multiple pipe installations shall be not less than one-half the diameter of the larger pipe between sides of adjacent pipes, but not required to exceed three feet.

Anchor Bolts: Anchor bolts are not required for concrete pipe.

SUMMARY OF QUANTITIES


Culvert Dia.	Concrete	Reinf. Steel
inches	Cu. Yd.	Lbs.
48		
54		
60		
72		
84	12.7	1270
96	16.2	1570
108	20.3	2010
120	24.8	2460
144	41.8	3610
180	63.8	7090

Note: Quantities shown are for C.G.M.P. culvert.

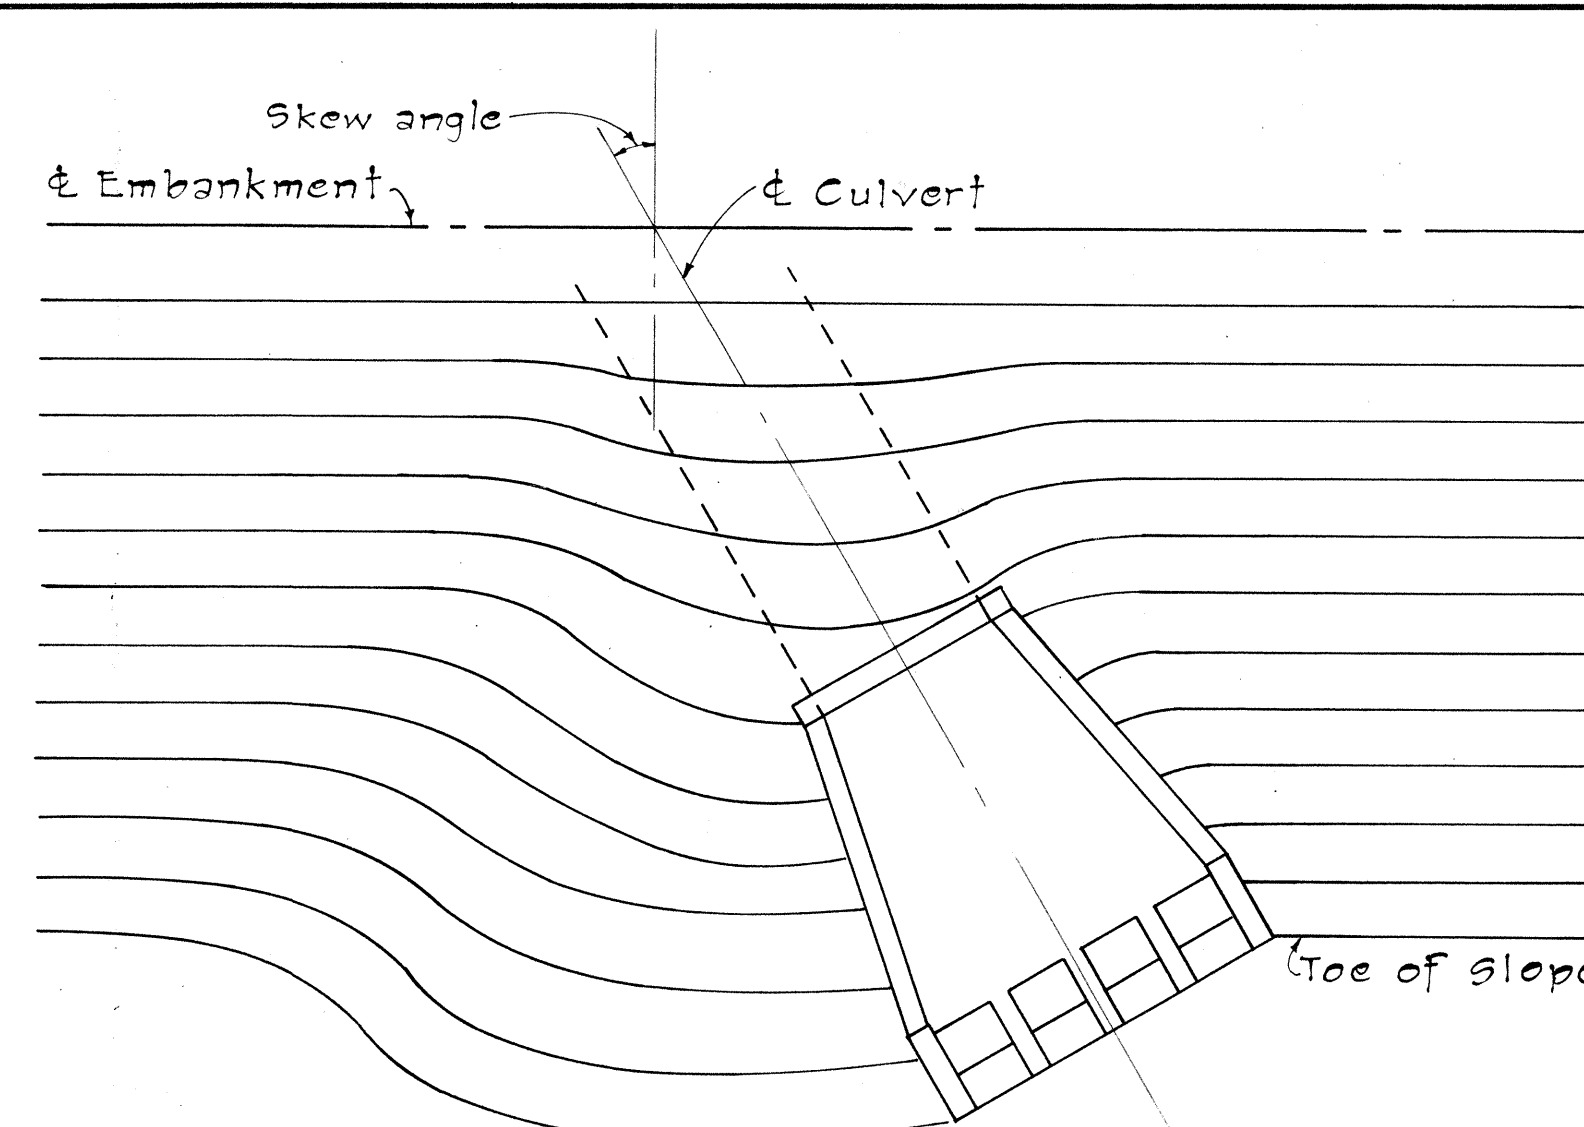


EMBANKMENT CONTOURS FOR SKEWED OUTLET

When outlet is skewed to embankment slope, the embankment may be contoured to cover the exposed section of wall and pipe.

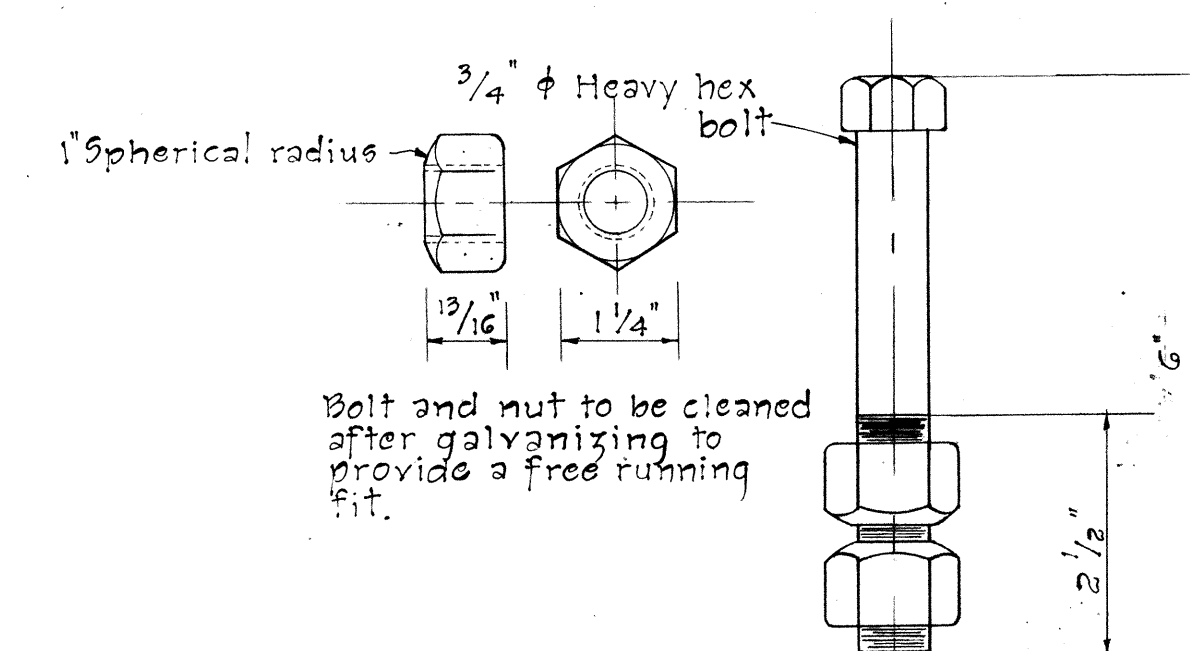



ANCHOR BOLT DETAIL

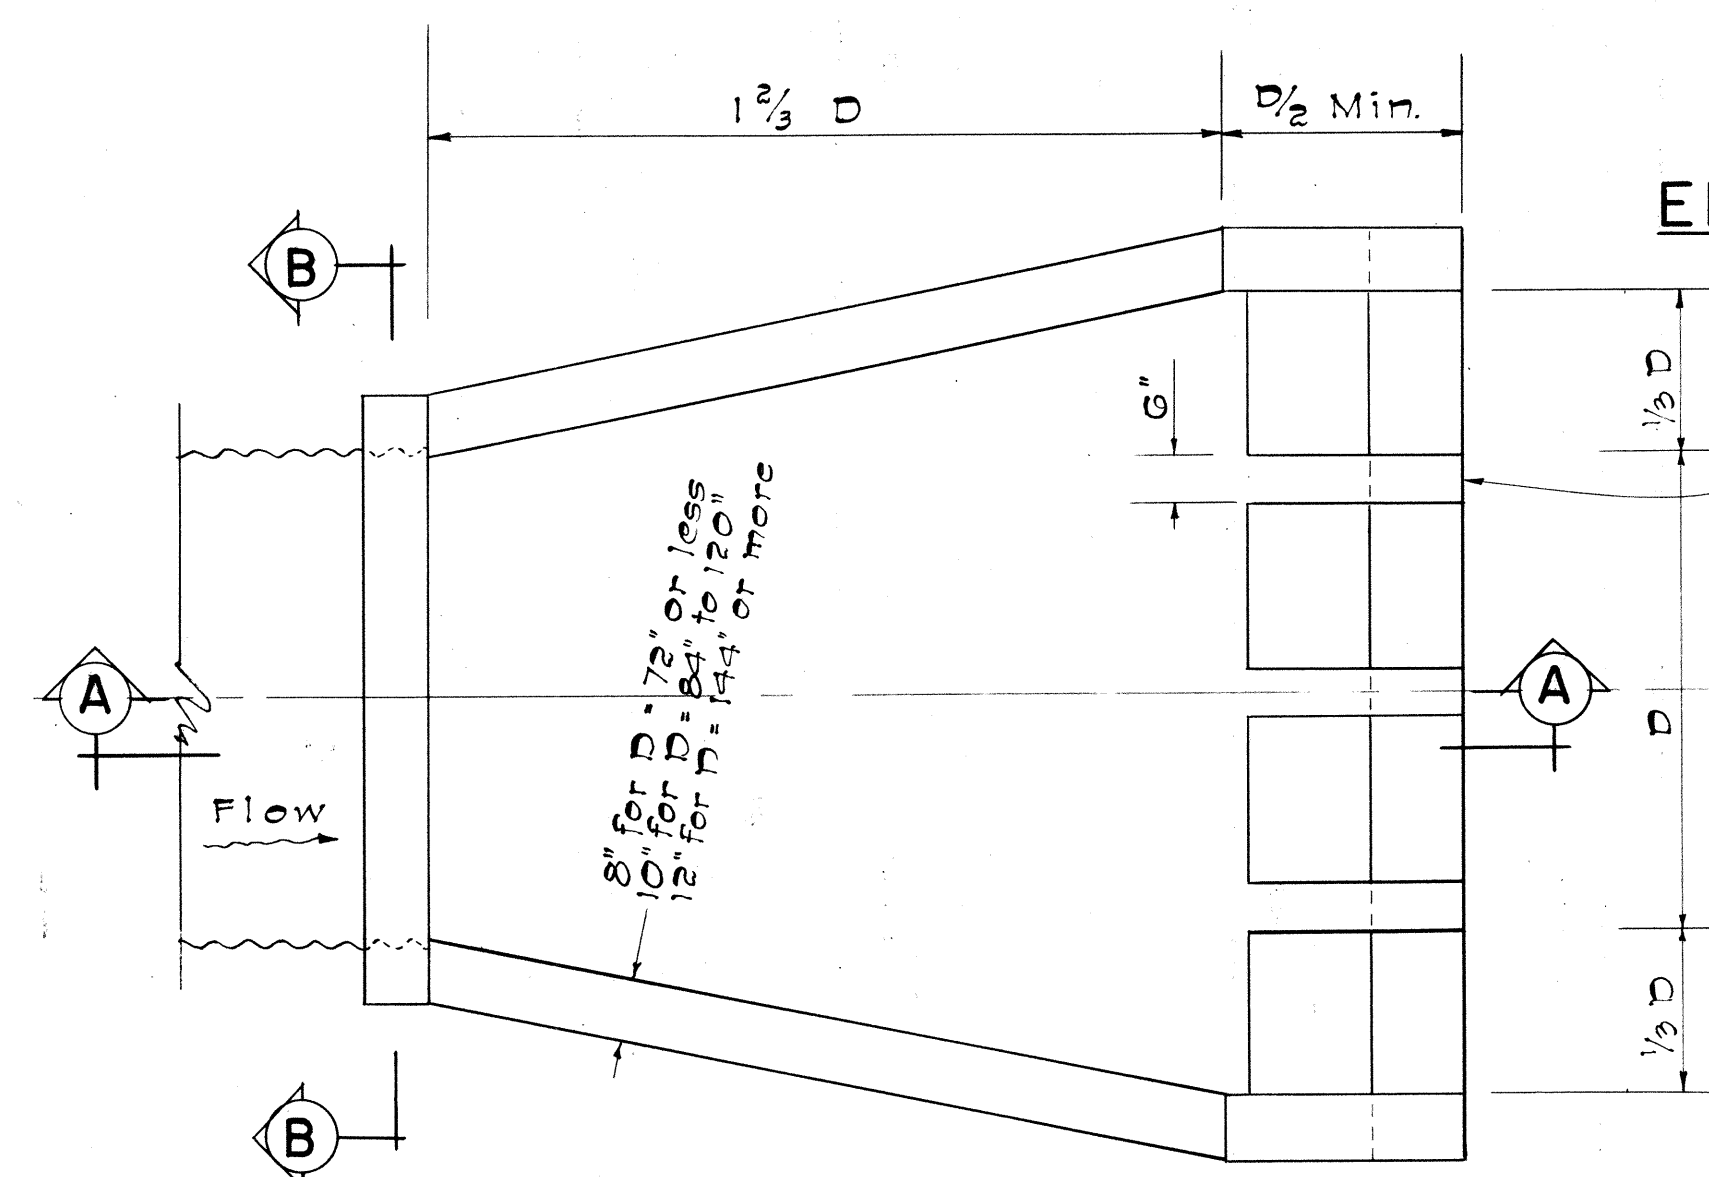

PLAN

8" WING WALL 10" TO 12" WING WALLS


SECTION C-C

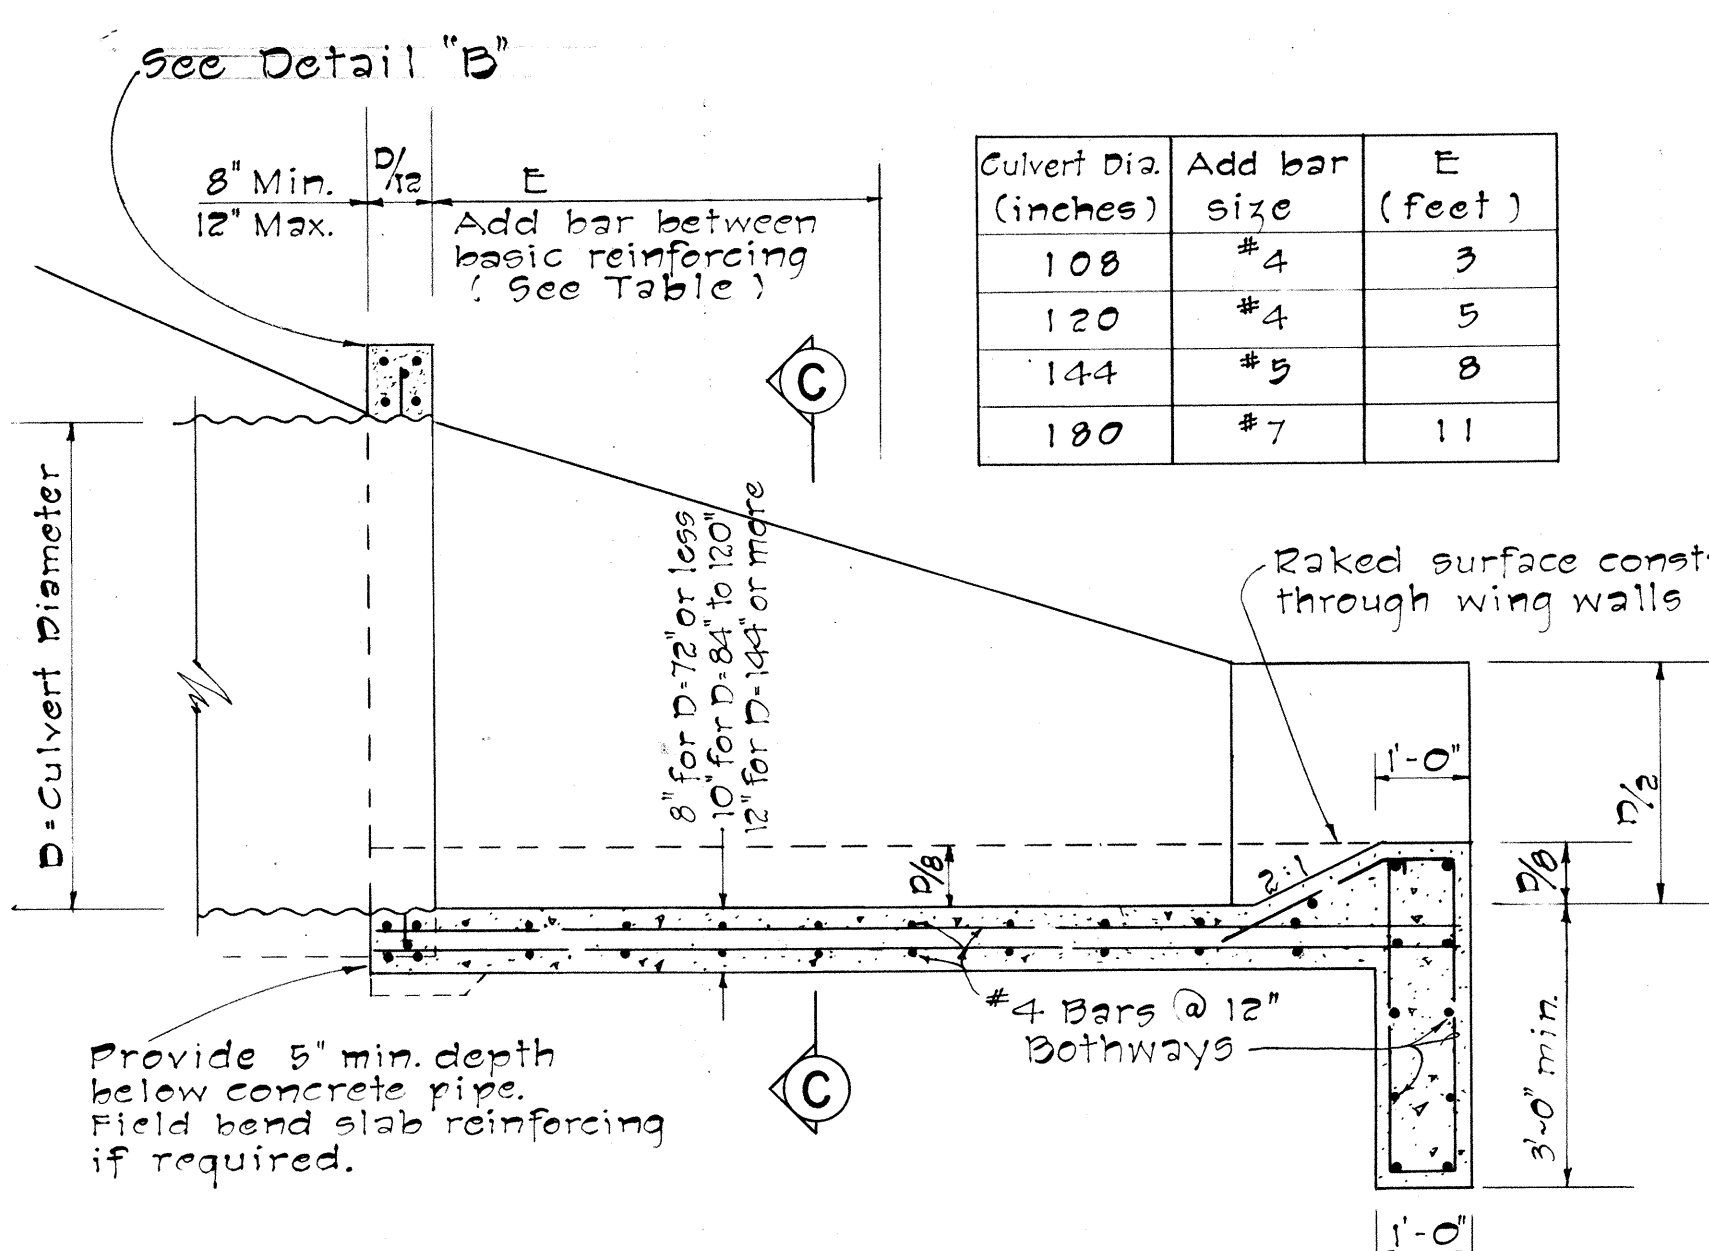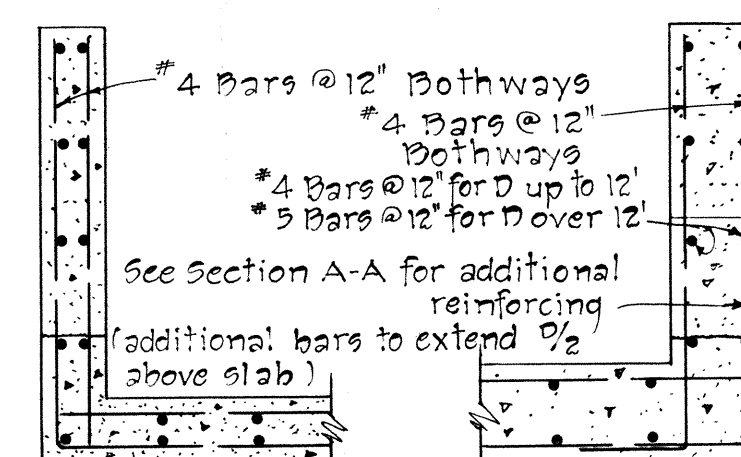

SECTION A-A

OUTLET STRUCTURE FOR CULVERT SIZES 48 IN. TO 180 IN. DIAMETER


10" min. for C.G.M.P. culvert
Pipe wall thickness + 8" for R.C.C.P.

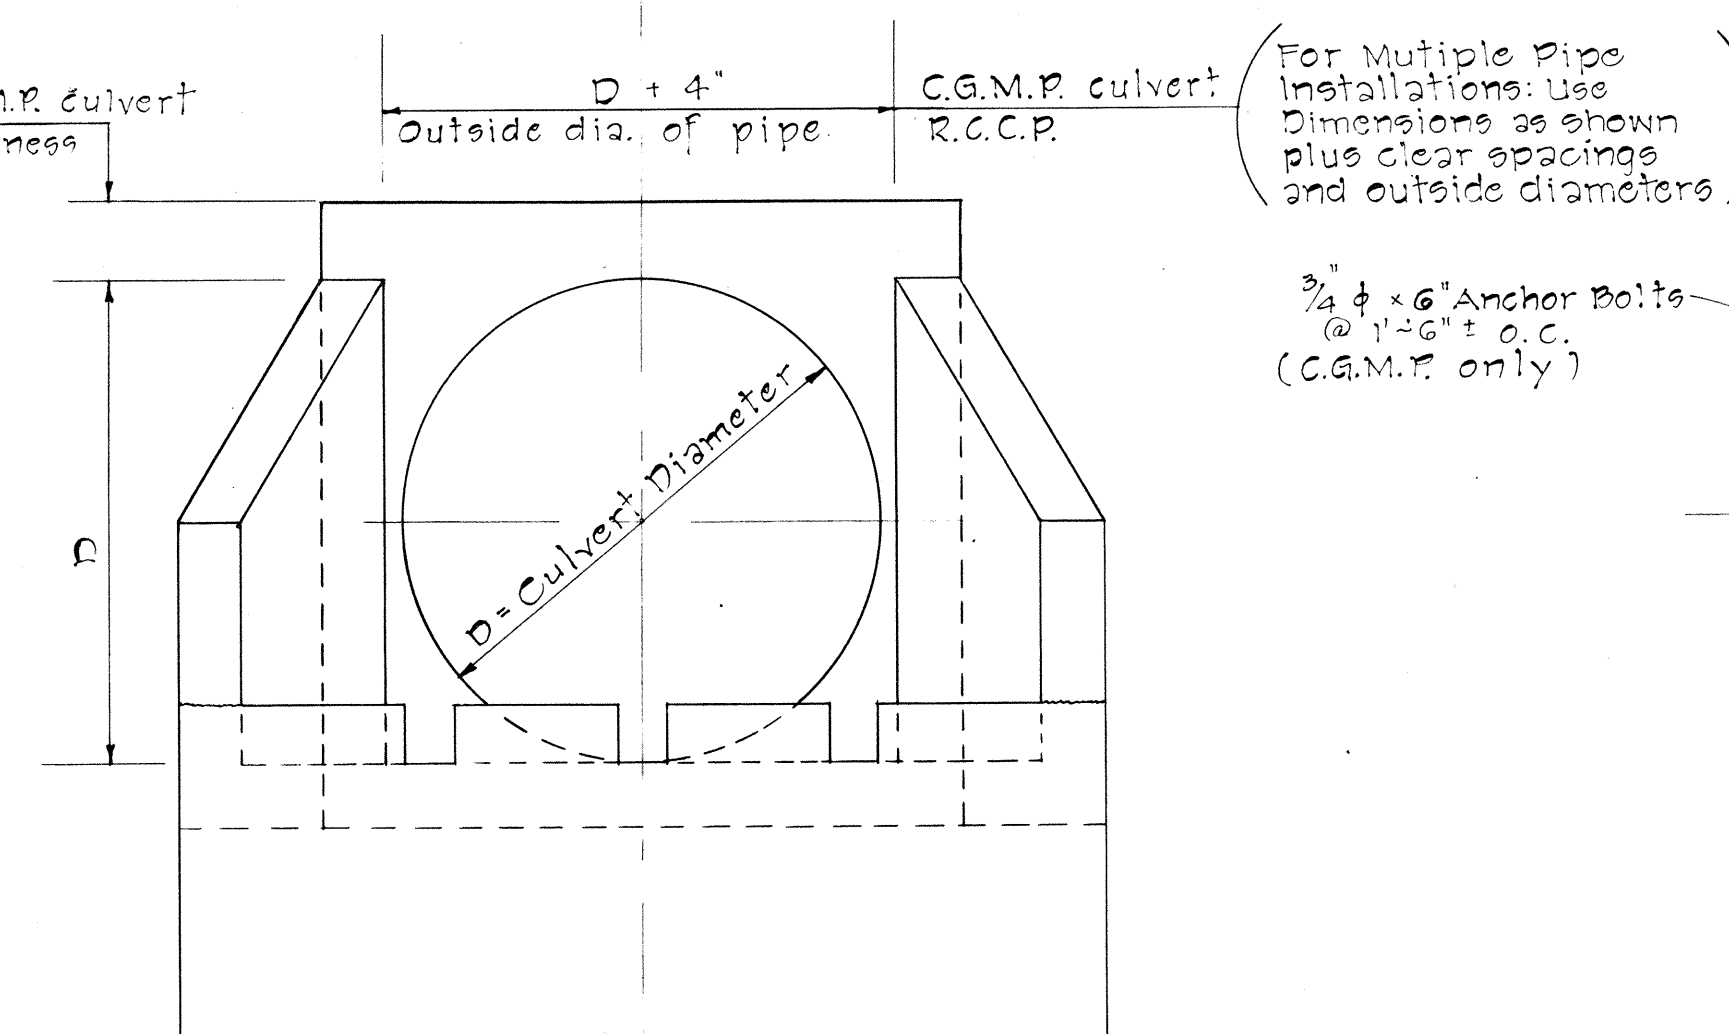


FRONT ELEVATION

For Multiple Pipe Installations: Use Dimensions as shown plus clear spacings and outside diameters

3/4 inch x 6 inch Anchor Bolts @ 12 inch o.c. (C.G.M.P. only)

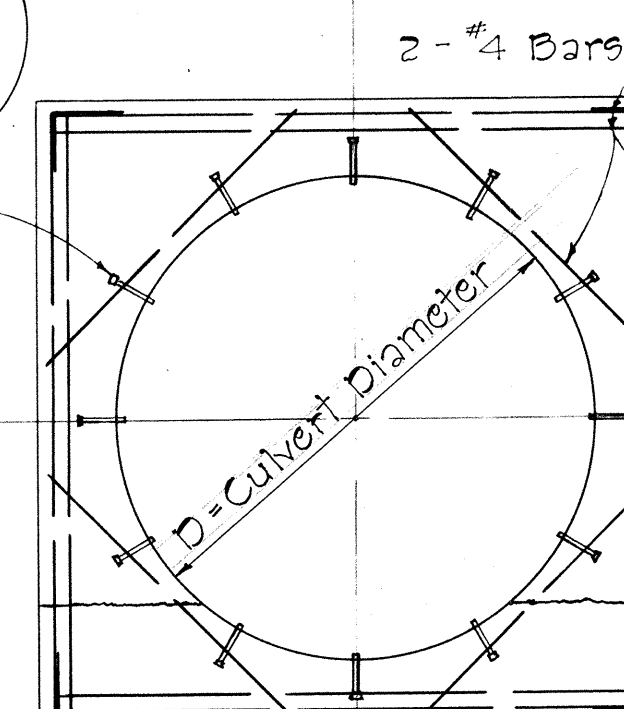

SECTION B-B

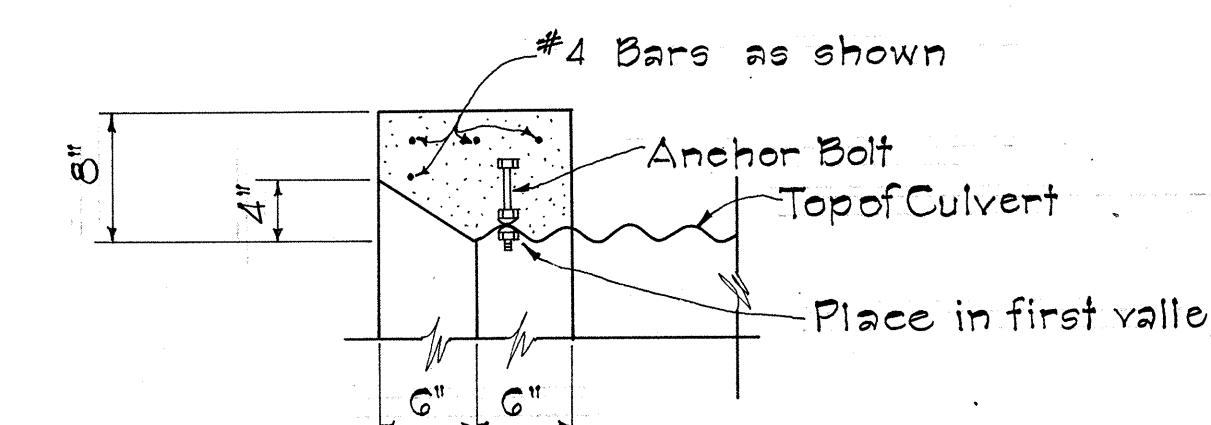

DETAIL "B"

Scale: 1" = 1'-0"

STATE OF HAWAII
DEPARTMENT OF TRANSPORTATION
HIGHWAYS DIVISION

DRAINAGE DETAILS OUTLET STRUCTURES

FOR
CONCRETE AND CORRUGATED METAL
CULVERTS SIZES 48 IN. TO 180 IN.


NOT TO SCALE

MAY 1967


SHEET No. 23 OF 28 SHEETS

52


FED. ROAD DIST. NO.	STATE	FED. AID PROJ. NO.	FISCAL YEAR	SHEET NO.	TOTAL SHEETS
HAWAII	HAW.	I-HI-1(32):5 Unit 3	1967	53	99

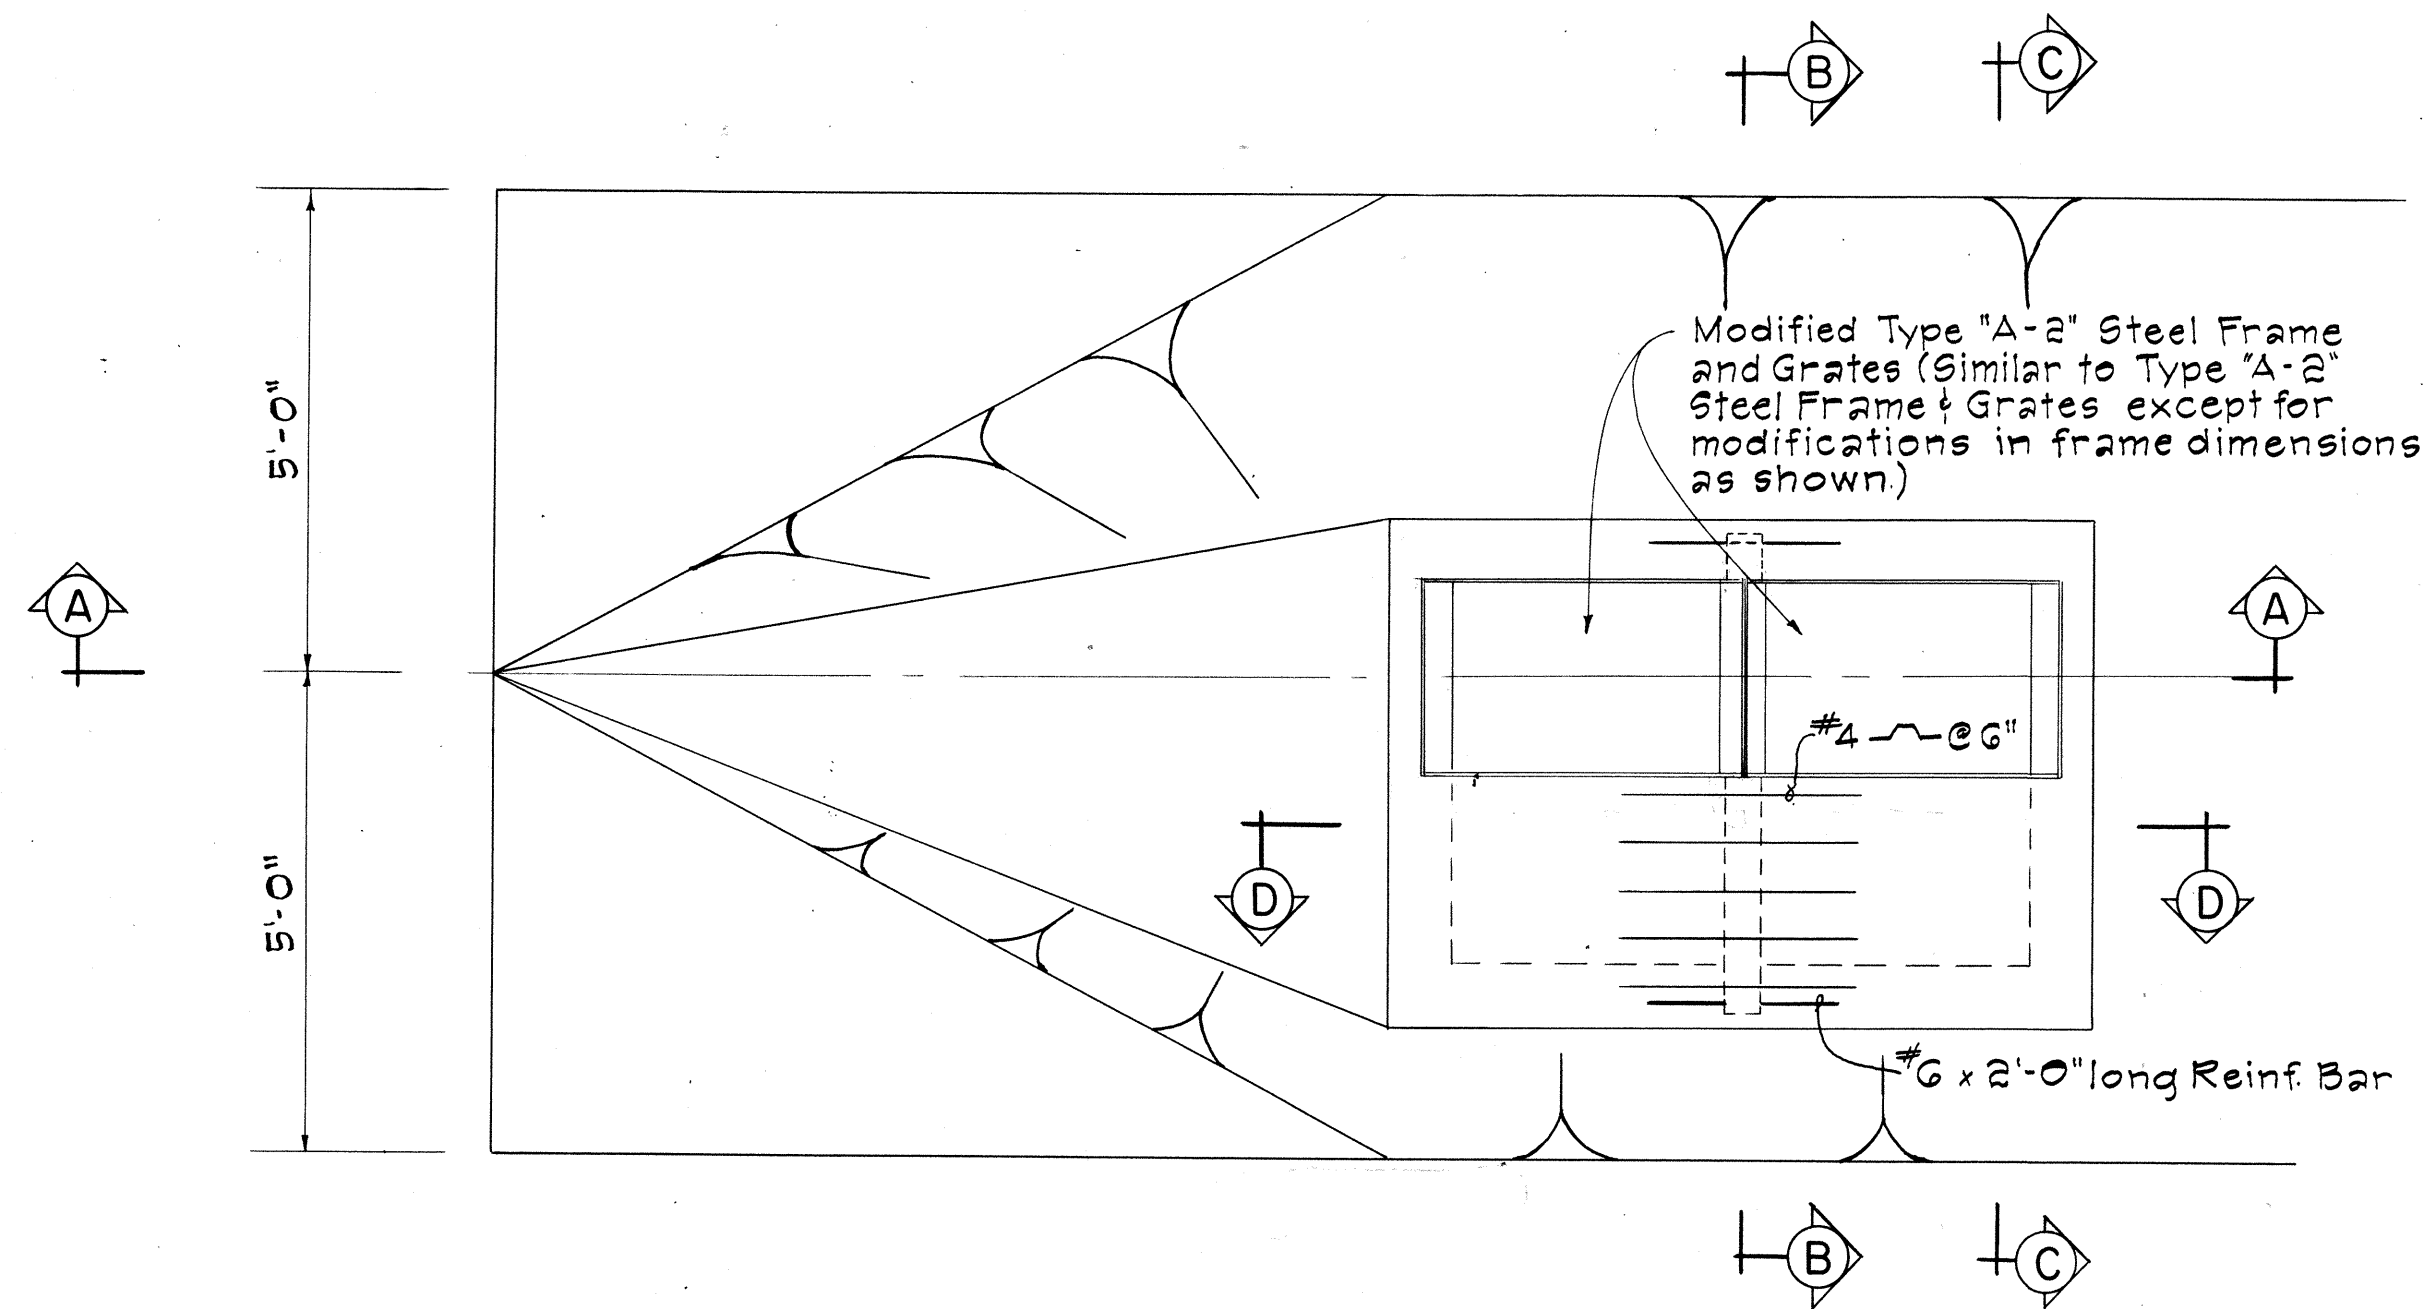


PLAN
Scale: 1/2" = 1'-0"

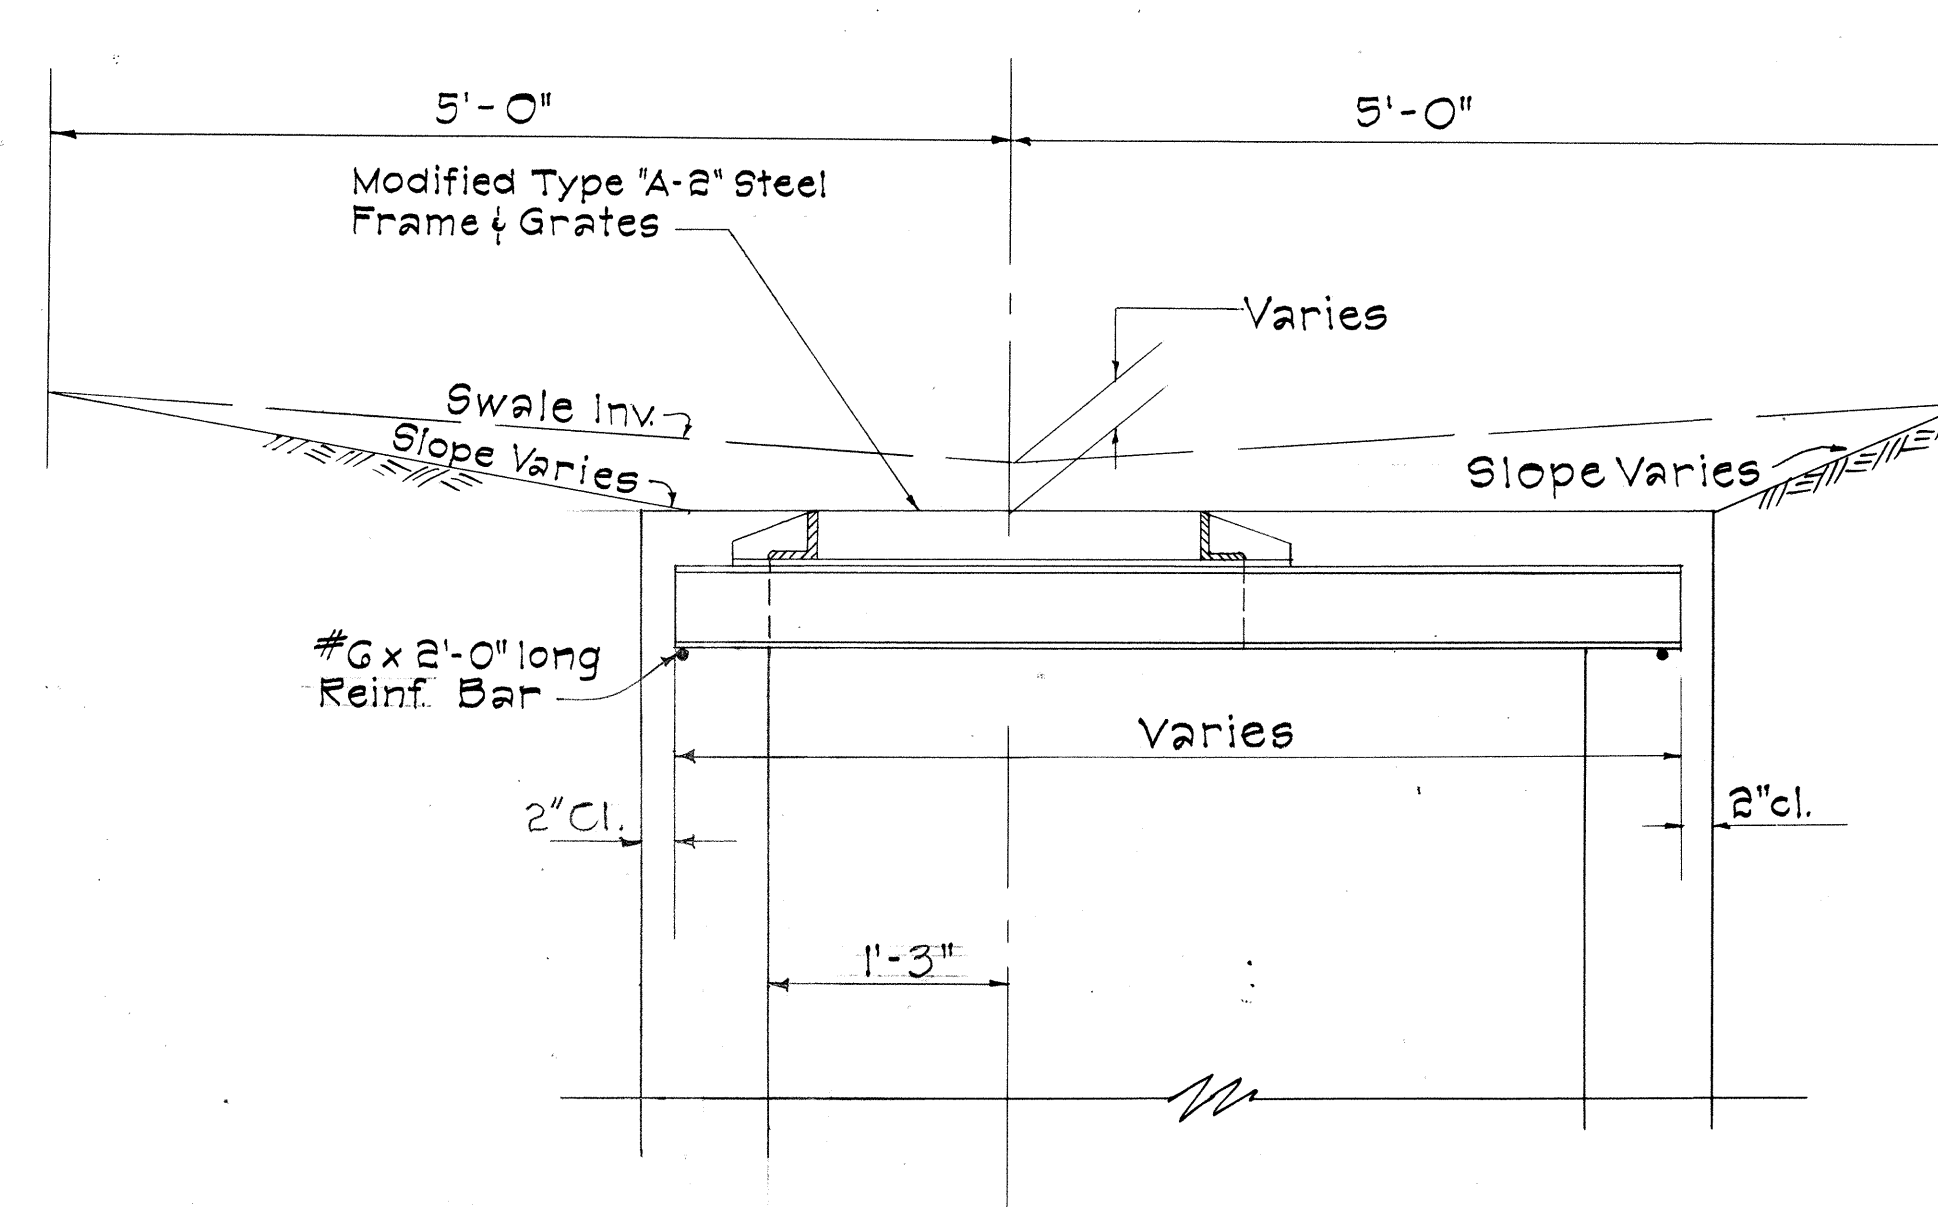


SECTION B-B
Scale: 1" = 1'-0"

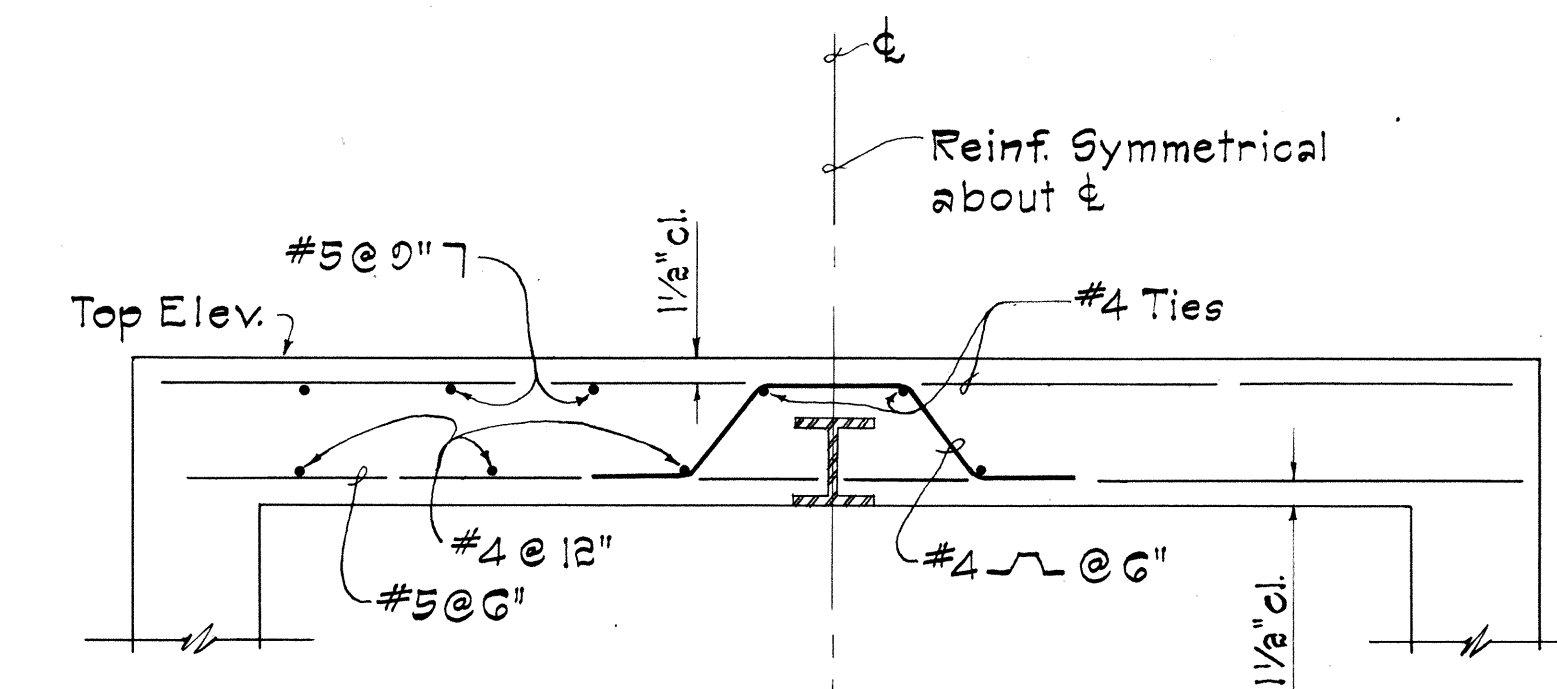

SECTION D-D
Scale: 1" = 1'-0"

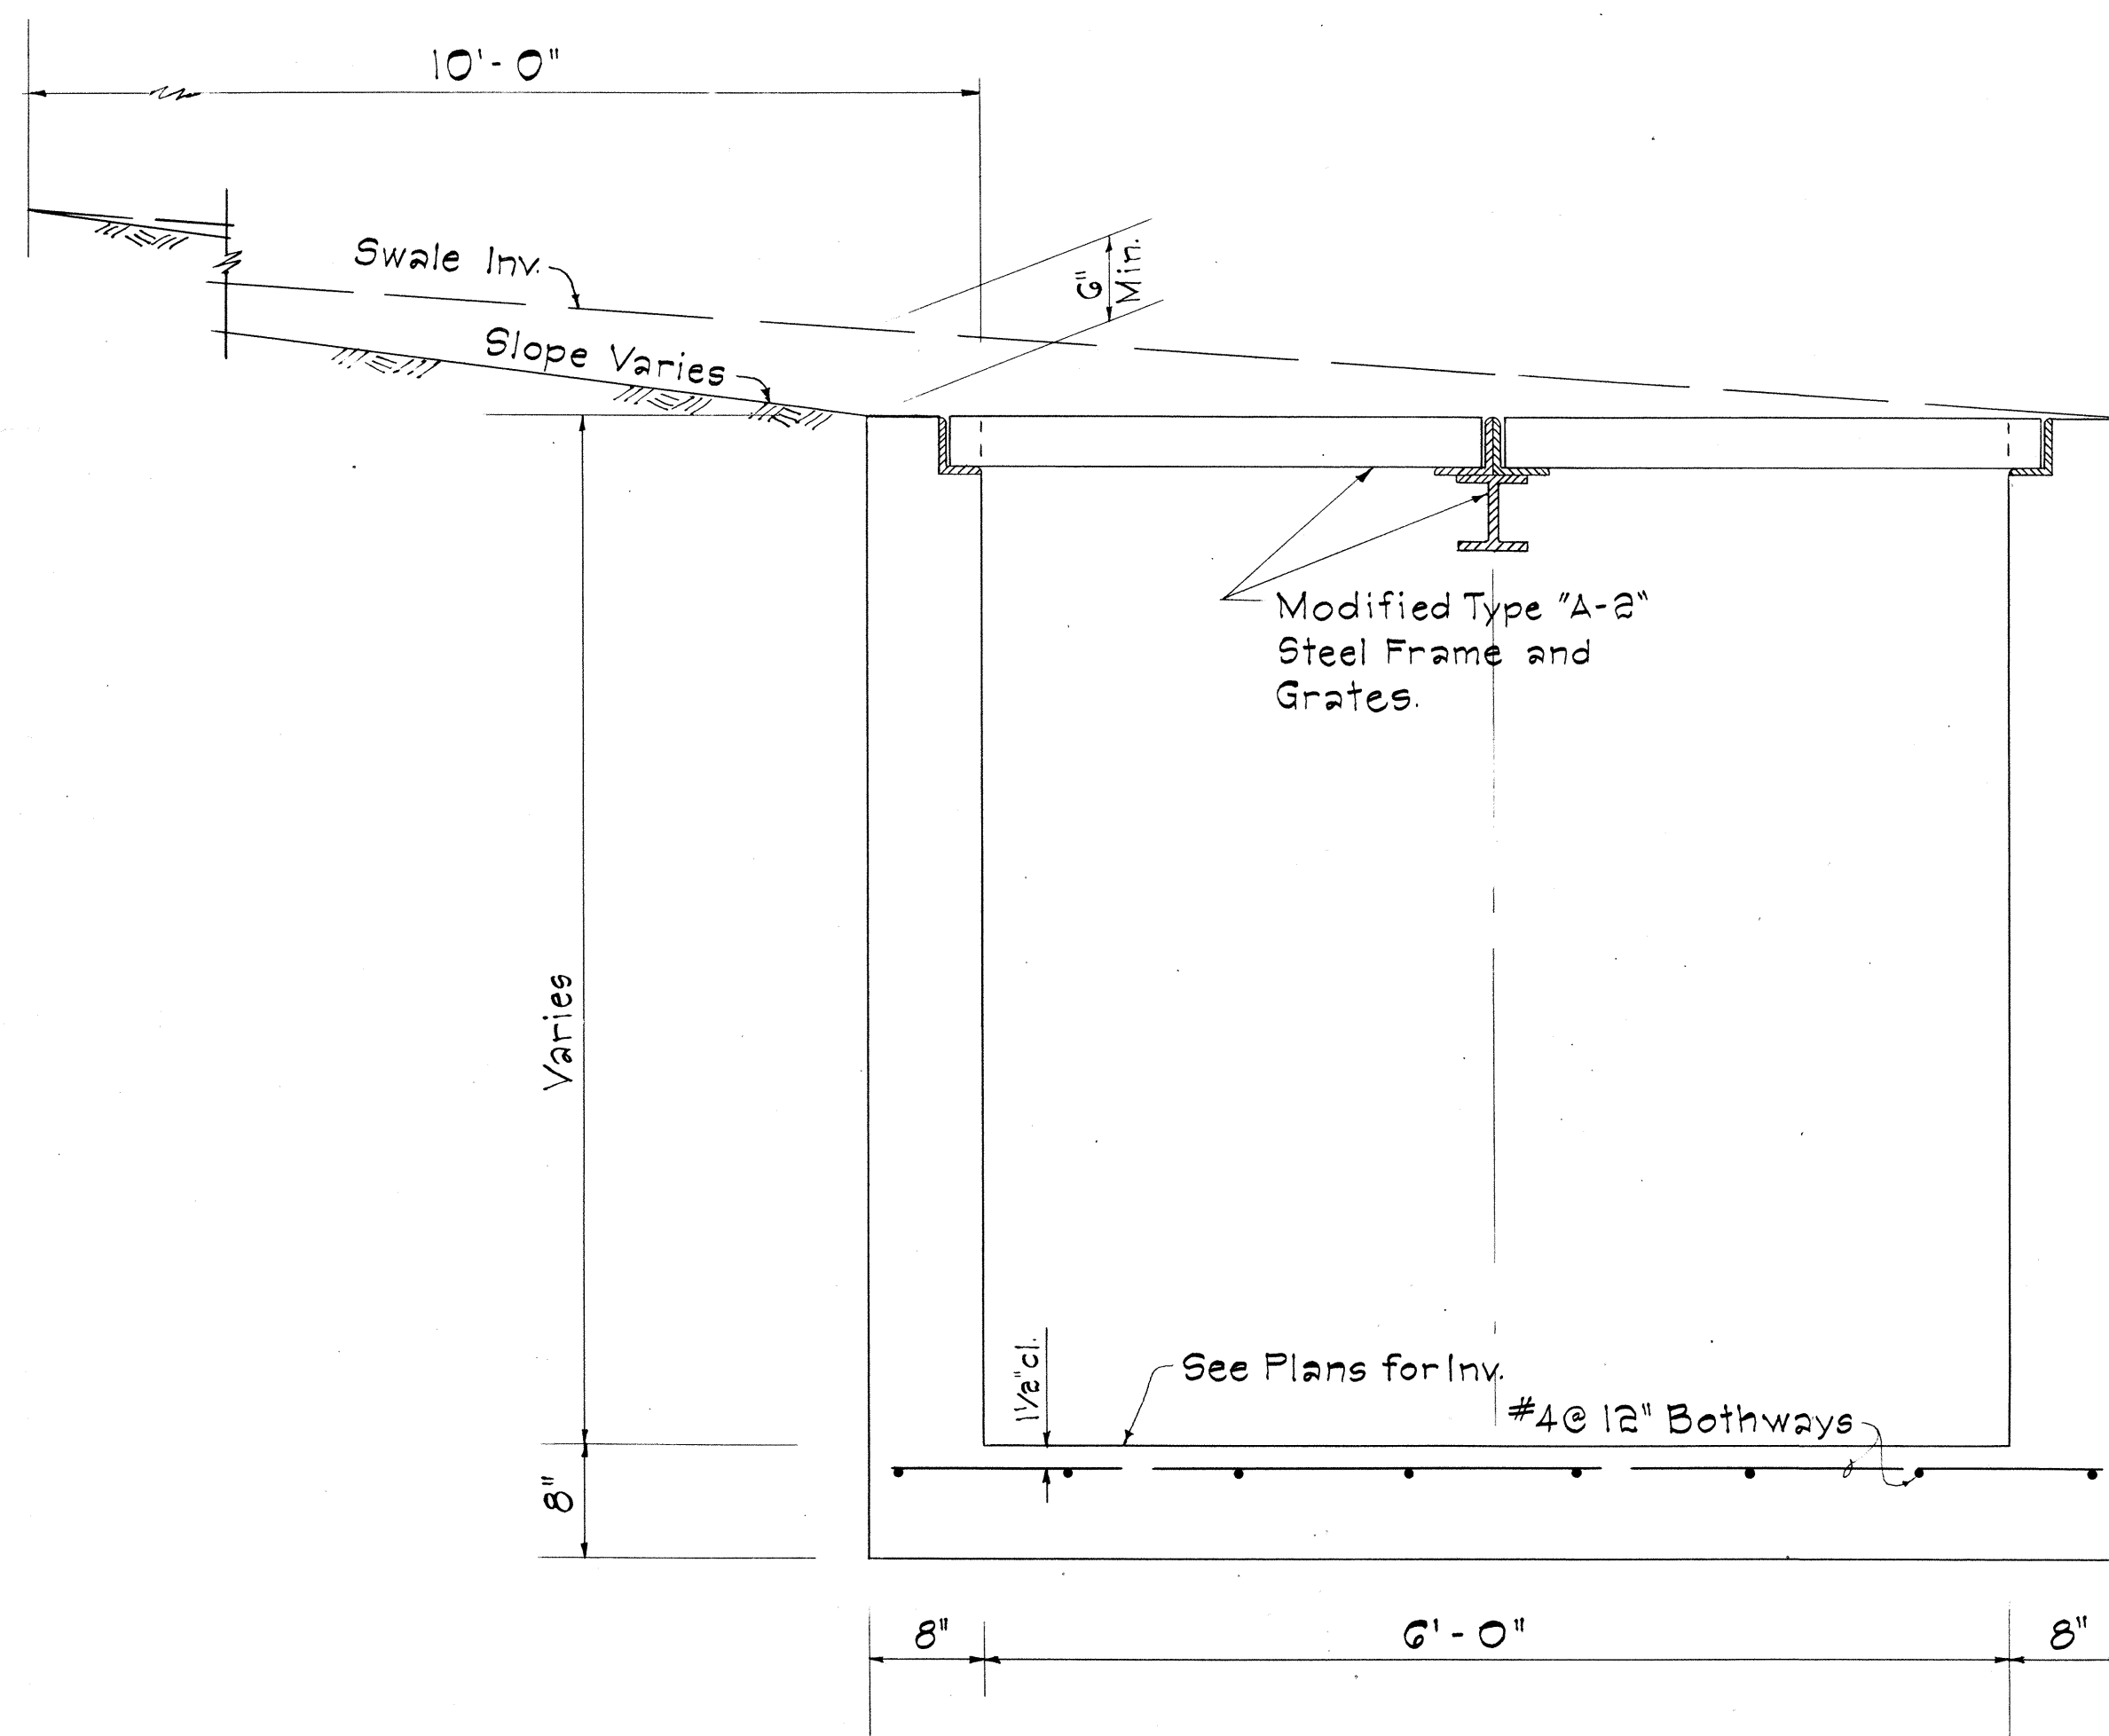

SECTION A-A
Scale: 1" = 1'-0"

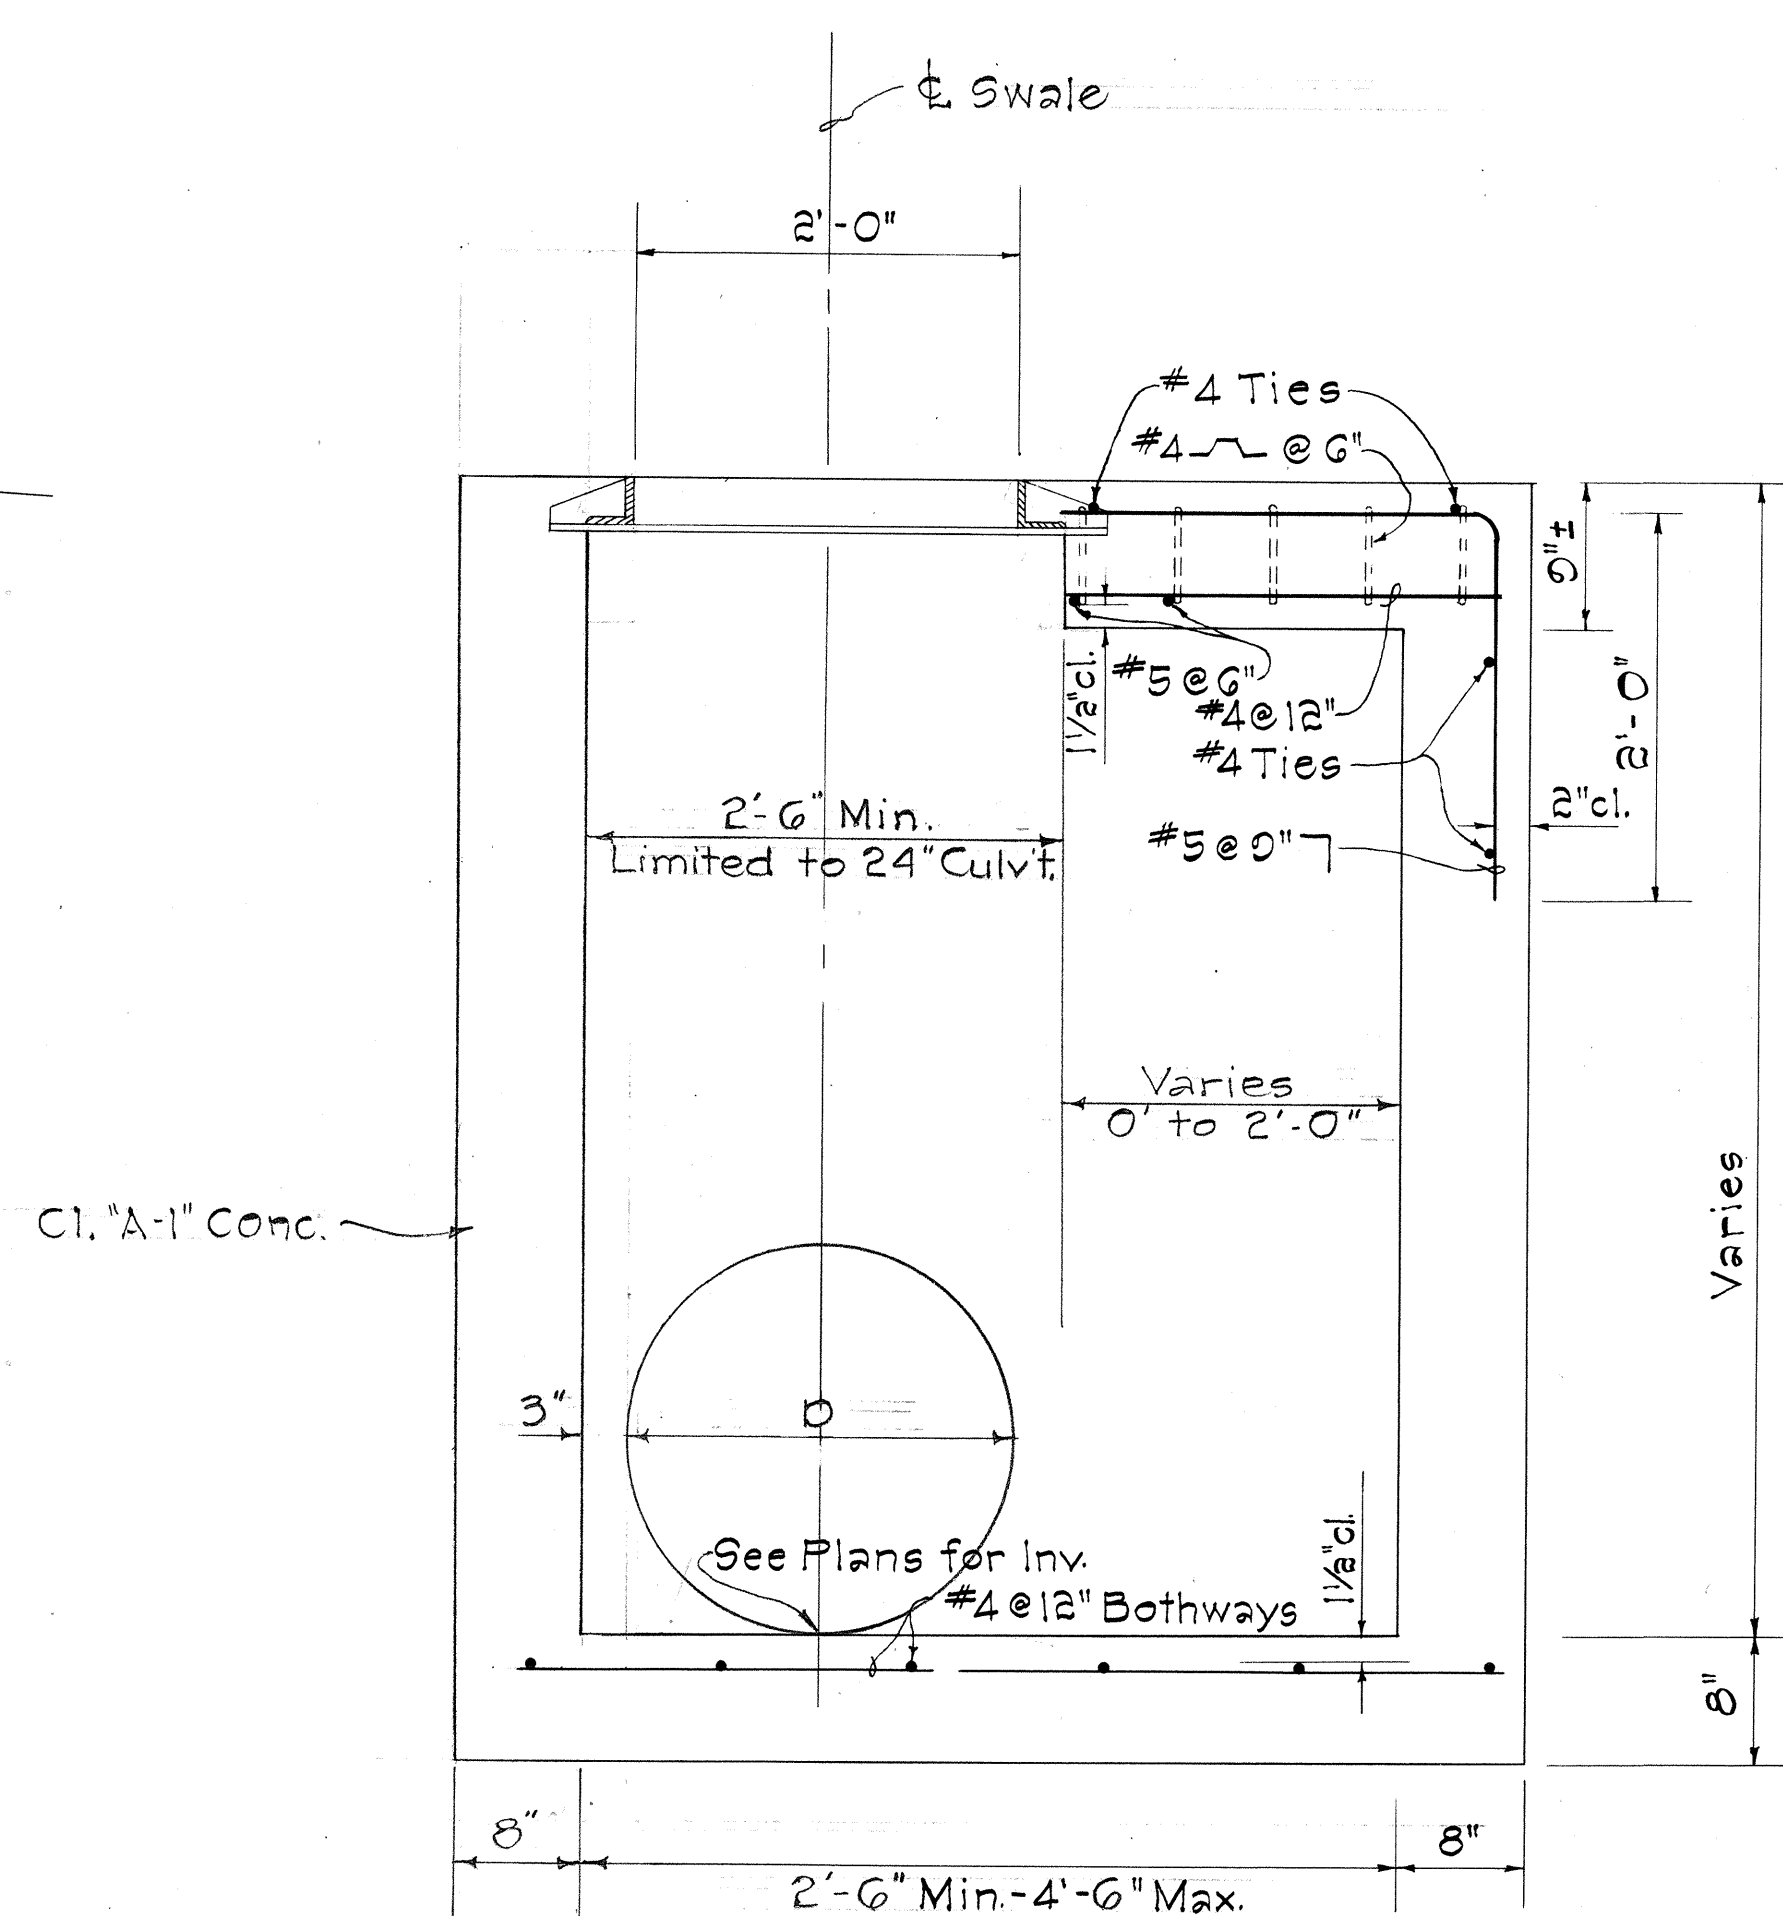

SECTION C-C
Scale: 1" = 1'-0"

STATE OF HAWAII
DEPARTMENT OF TRANSPORTATION
HIGHWAYS DIVISION
DRAINAGE DETAILS
MEDIAN DROP INTAKE

INTERSTATE ROUTE H-1
F.A.I. PROJ. NO. I-HI-1(32):5, Unit 3

Scale: As Shown Date: June, 1967

SHEET No. 24 OF 28 SHEETS

53

FED. ROAD DIST. NO.	STATE	FED. AID PROJ. NO.	FISCAL YEAR	SHEET NO	TOTAL SHEETS
HAWAII	HAW.	1-HI-1(38)5 Unit 3	1967	54	99

Revised: June 1965
Revised: August 1967

D	W	H	T+W+H
18"	24"	2'-0"	4'-0"
24"	30"	2'-0"	4'-6"
30"	36"	2'-0"	5'-0"
36"	42"	2'-0"	5'-6"


DETAIL OF OUTLET DITCH

Scale: 1/2" = 1'-0"


D	D	L+D+G	Cu. Yds.	Where Variables Equal
23"	18"	2'-5"	3.02	4'-6"
30"	24"	3'-0"	3.61	5'-0"
37"	30"	3'-7"	4.21	5'-6"
44"	36"	4'-2"	4.85	6'-0"

NOTE:
Dimension "X" is assumed as 2'-4"
in figuring the above quantities.

DATA - MASONRY HEADWALL				CRM For RCCP	CRM For CGMP
D	H	B	L	Cu. Yds.	Cu. Yds.
18"	4'-6"	1'-0"	6'-0"	1.24	1.29
24"	5'-0"	2'-0"	7'-6"	1.83	1.92
30"	5'-6"	2'-3"	9'-0"	2.56	2.70
36"	6'-0"	2'-6"	10'-6"	3.45	3.66

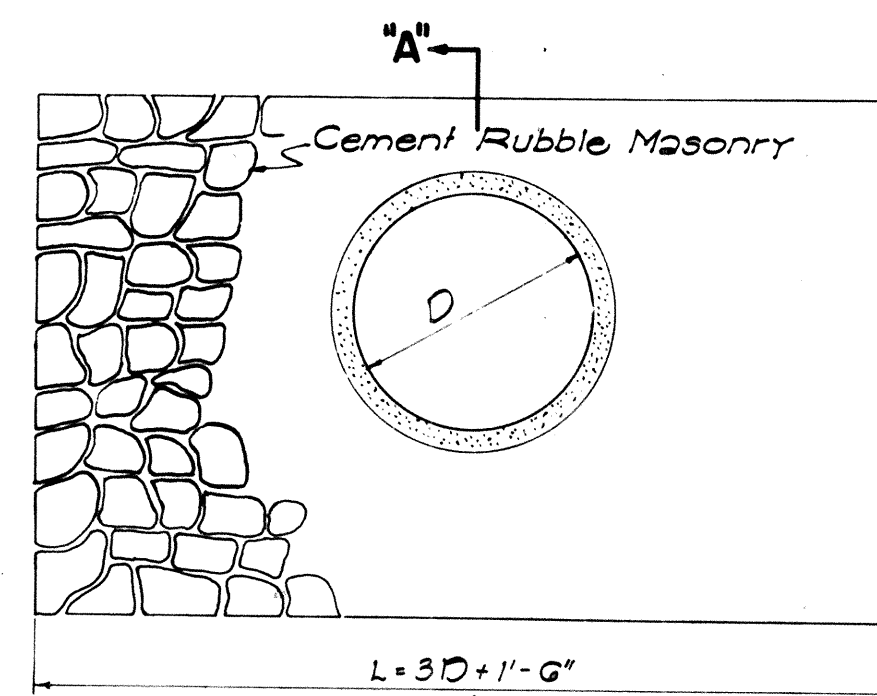


ELEVATION

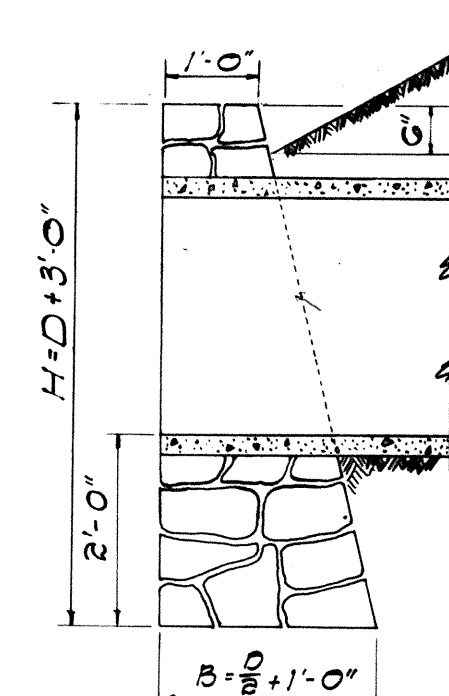

SECTION "A-A"

DETAIL OF MASONRY HEADWALL


Scale: 1/2" = 1'-0"

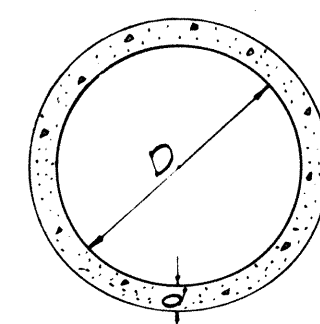

SECTION


CONC. PIPE CULVERT

NOTE:
Thickness 'd', reinforcing, and
Concrete used, are to conform
with the approved design as
provided by the Specifications.

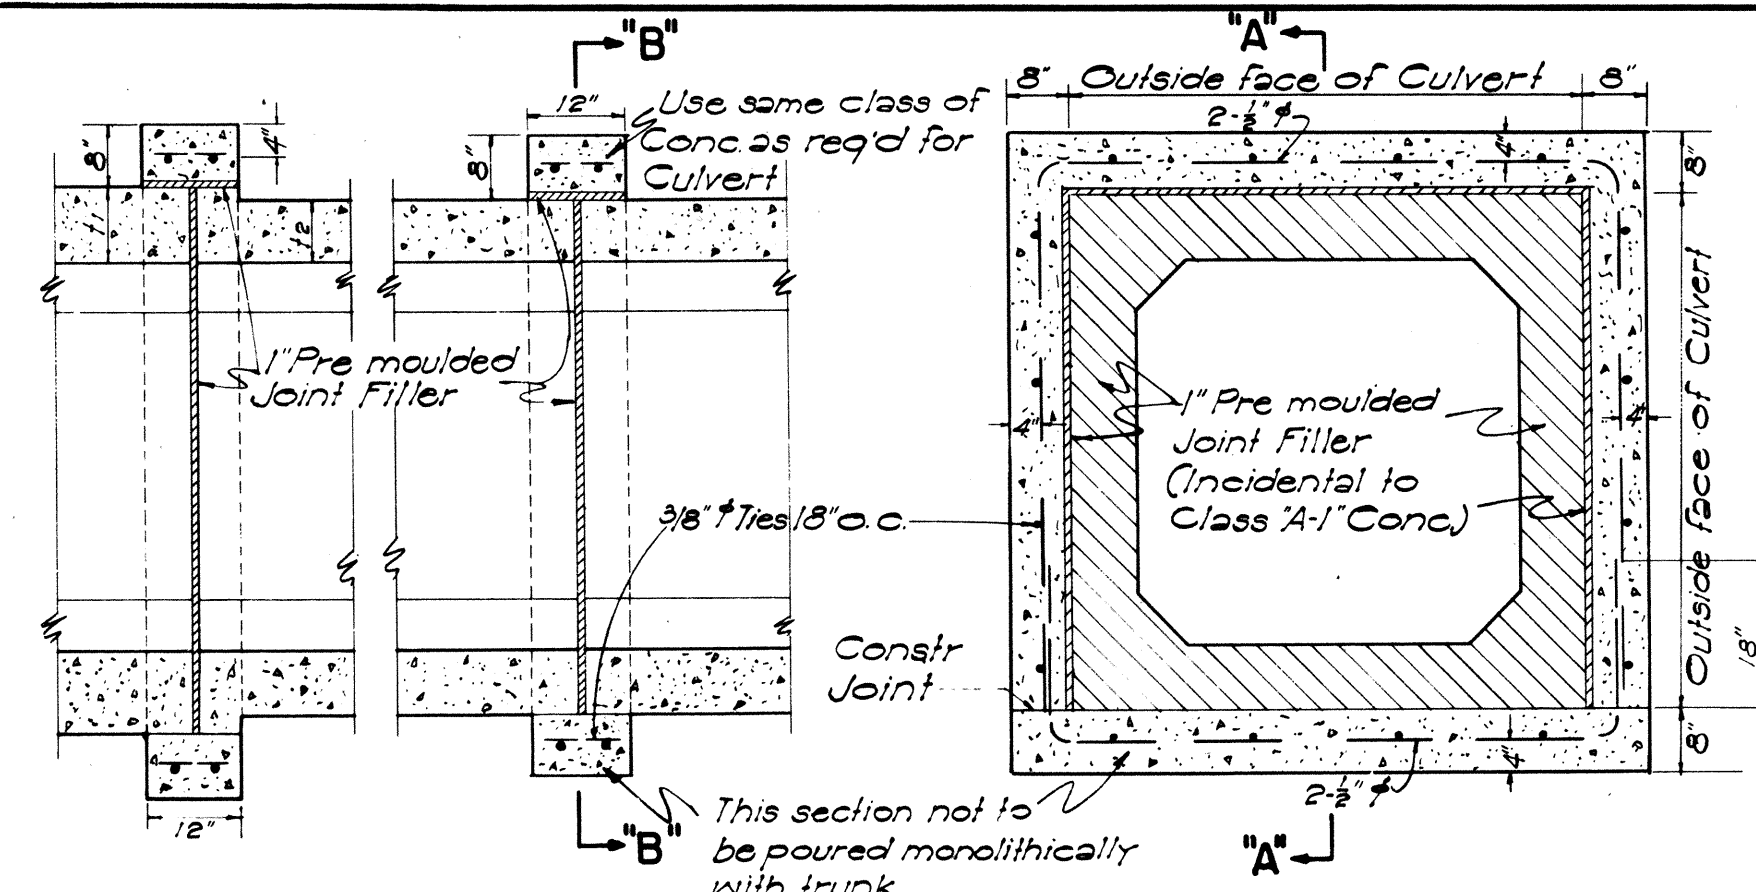


SECTION "A-A" SECTION "B-B" CONC. COLLAR FOR CONC. BOX CULVERT

Scale: 1/2" = 1'-0"

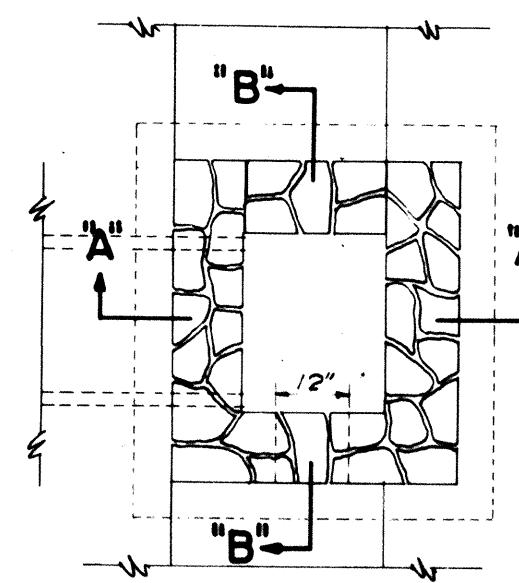

DETAIL OF MASONRY DROP INTAKE


Scale: 3/8" = 1'-0"

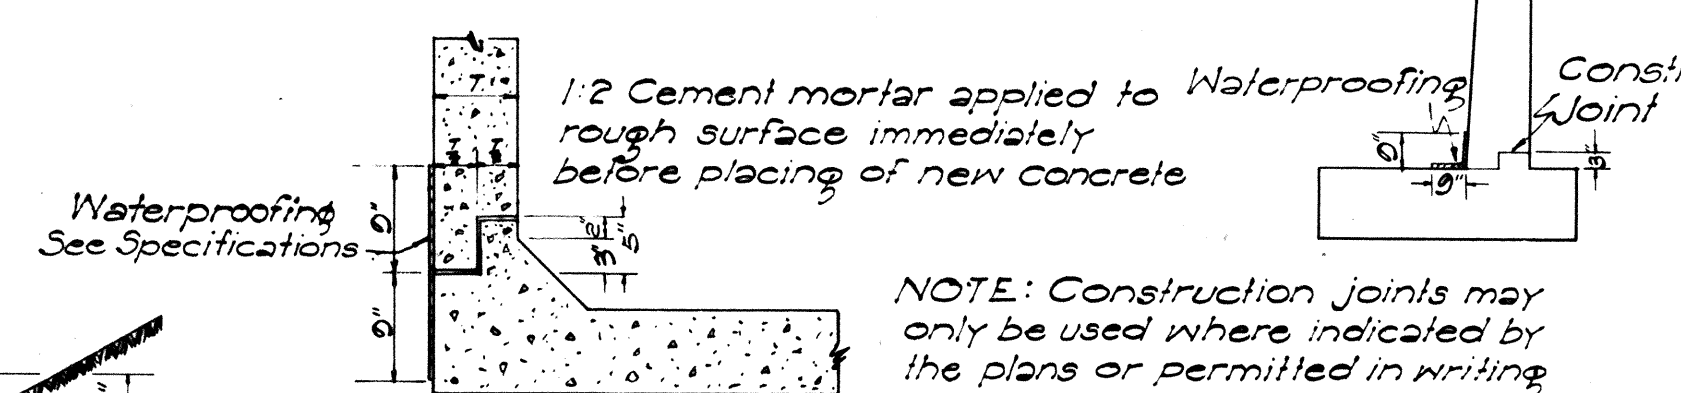


CONSTR. JOINT DETAILS

NOTE: Construction joints may
only be used where indicated by
the plans or permitted in writing
by the Engineer

Note:
When subgrade is below
top of jacket, it shall be
fully compacted to this
line and then re-excavated
(struck) to proper sub-
grade. This surface shall be
rolled again.

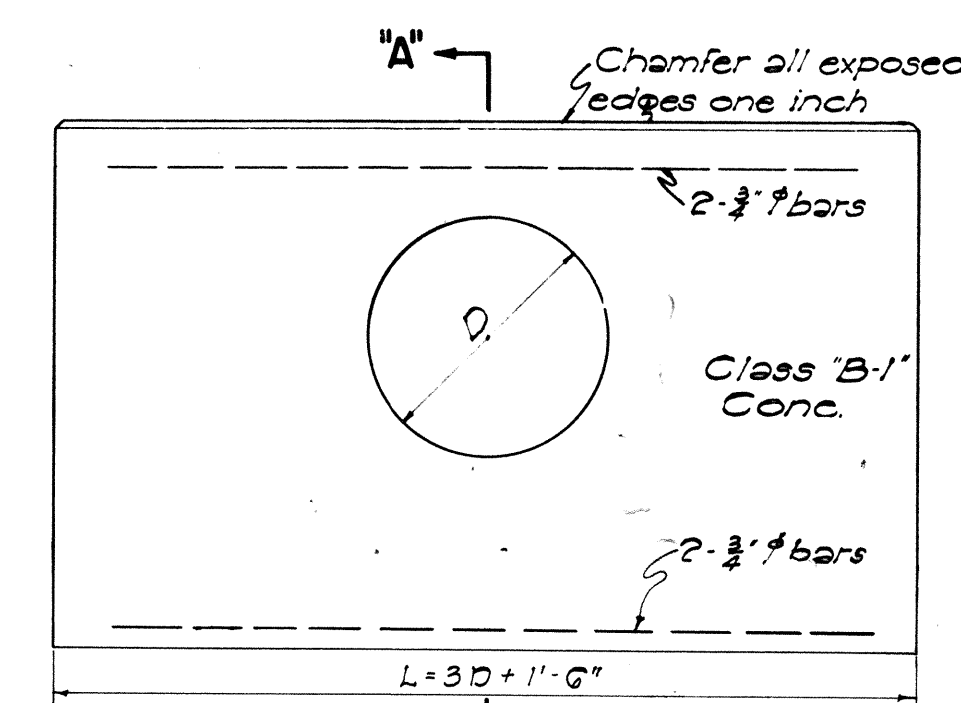

ELEVATION

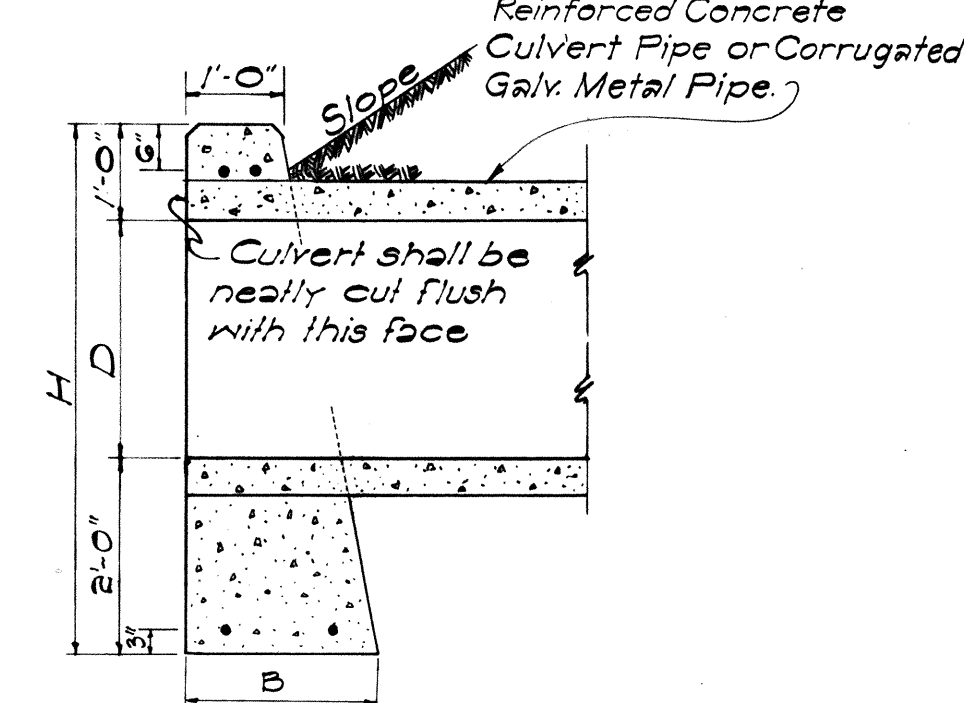


SECTION "A-A"


DATA FOR CONC. HEADWALL				Class 'B-1' Conc. For RCCP	Class 'B-1' Conc. For CGMP	Steel For One Headwall		
D	B	L	H	Cu. Yds.	Cu. Yds.	No. of Bars	Size	Length
18"	1'-0"	6'-0"	4'-6"	1.12	1.17	4	3/4"	5'-6"
24"	1'-6"	7'-6"	5'-0"	1.52	1.60	4	3/4"	7'-0"
30"	2'-0"	9'-0"	5'-6"	2.36	2.49	4	3/4"	8'-6"
36"	2'-6"	10'-6"	6'-0"	2.94	3.13	4	3/4"	10'-0"
42"	2'-6"	12'-0"	6'-6"	4.19	4.47	4	3/4"	11'-6"
48"	2'-6"	13'-6"	7'-0"	5.01	5.36	4	3/4"	13'-0"

DETAIL OF CONCRETE HEADWALL

Scale: 1/2" = 1'-0"

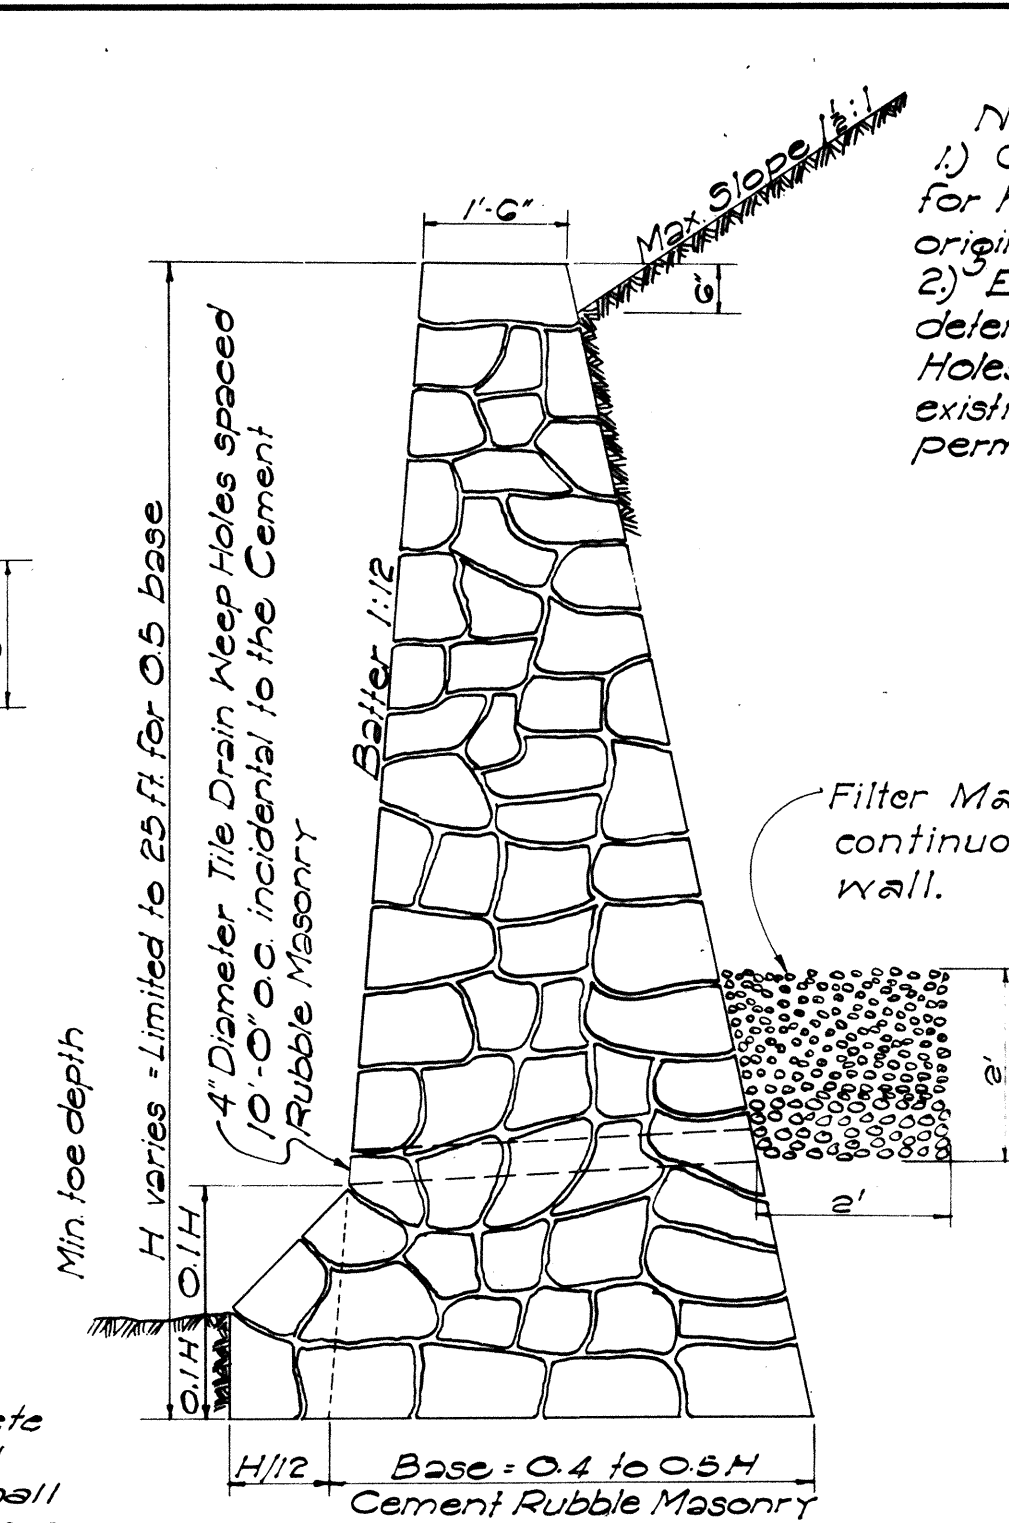

SECTION OF HIGH CEMENT RUBBLE MASONRY RETAINING WALL OR SEAWALL

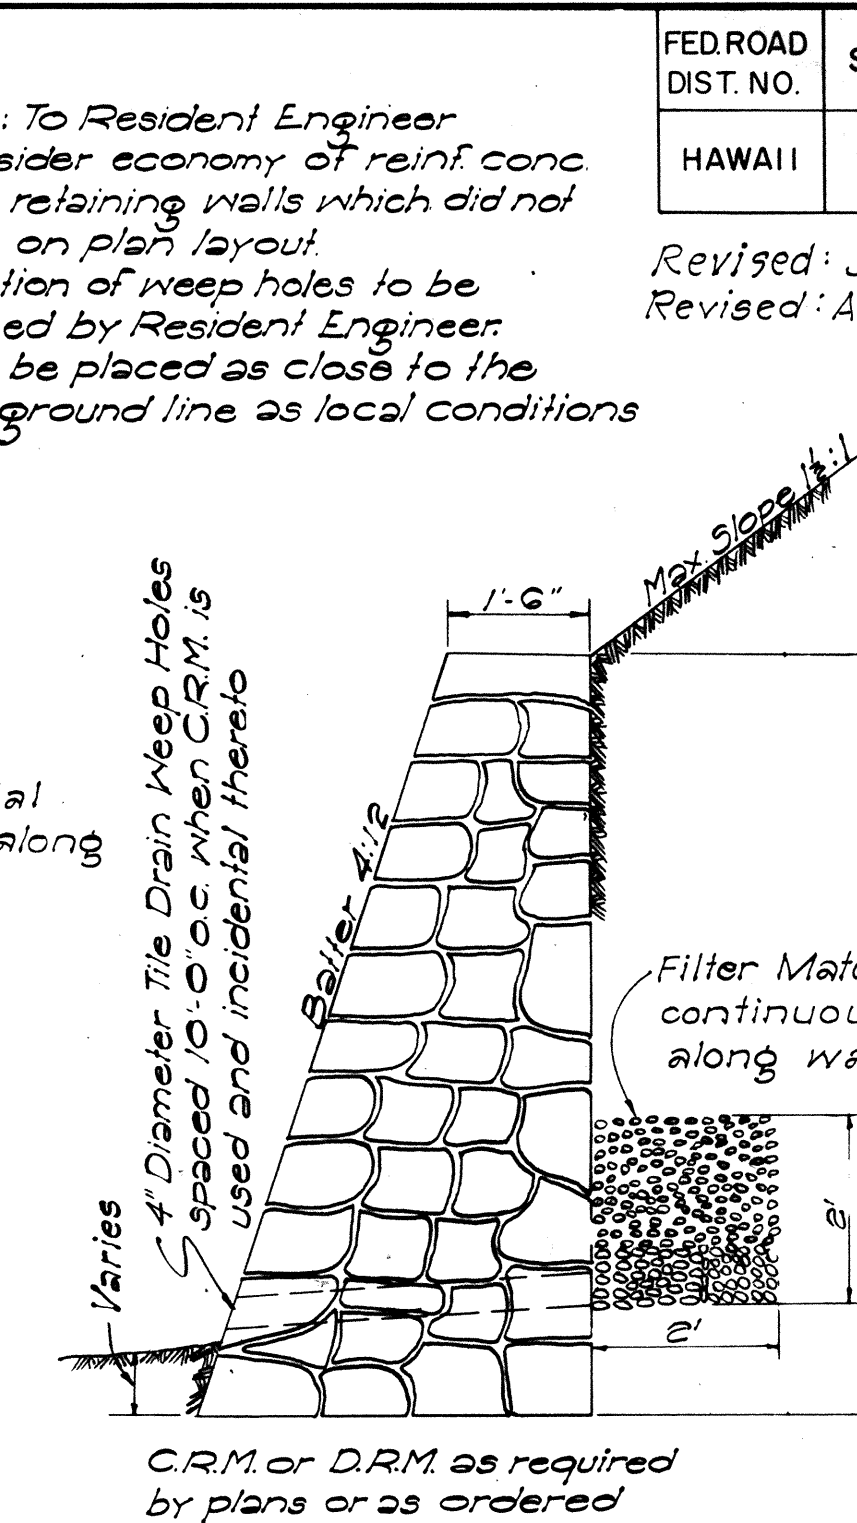


SECTION OF LOW MASONRY RETAINING WALL OR SEAWALL


D	D	L+D+G	S	Cu. Yds.	Where Variables Equal
23"	18"	2'-5"	8"	1.41	4'-6"
30"	24"	3'-0"	8"	1.72	5'-0"
37"	30"	3'-7"	9"	2.32	5'-6"
44"	36"	4'-2"	9"	2.73	6'-0"
51"	42"	4'-9"	10"	3.54	6'-6"
58"	48"	5'-4"	10"	4.01	7'-0"

Note: Dimension "X" is assumed as
2'-4" in figuring the above quantities

Note: This type of structure
shall also be used for the
Drop Intakes of Siphons
connected with Irrigation
Ditches or Flumes with appro-
priate changes to dimensions.
In this case all joints must be
made water tight.

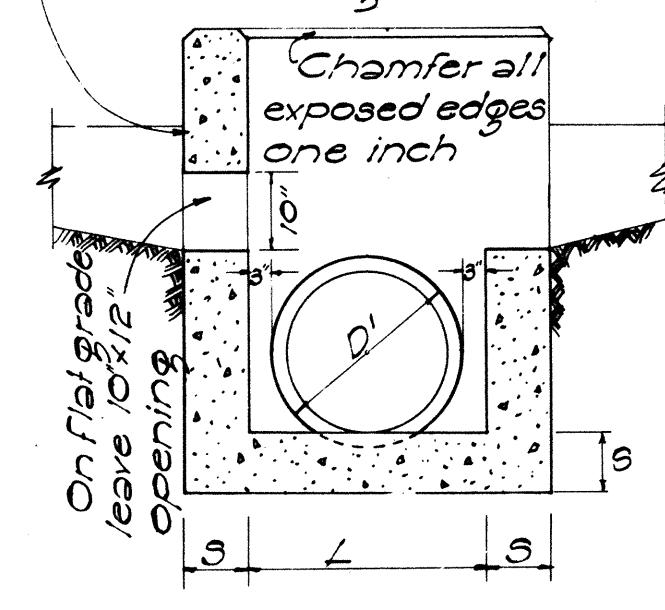


SECTION "B-B"

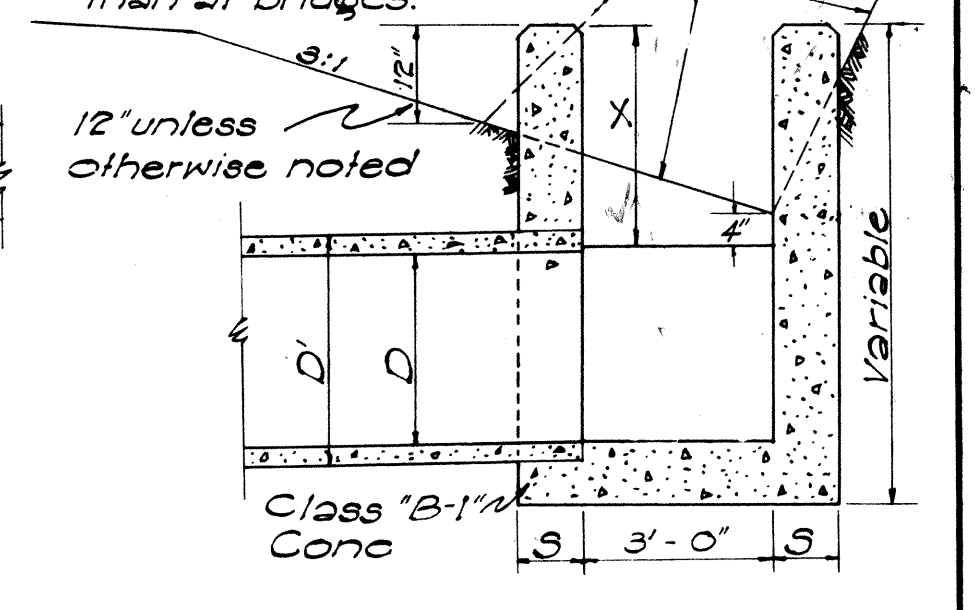

SECTION "A-A"

DETAIL OF CONCRETE DROP INTAKE

Scale: 1/2" = 1'-0"

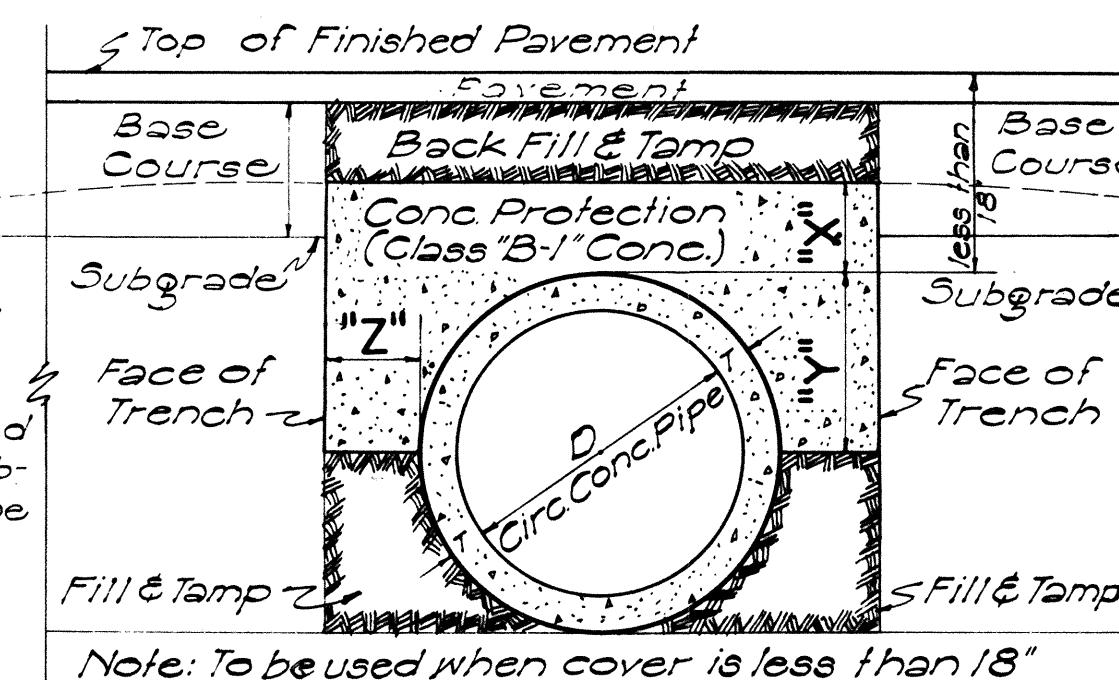

DATA FOR CONCRETE PROTECTION OVER CULVERTS		
X	Y	Z
6" for 18"D		Z must be from Pipe to face of trench
7" " 24"D		
8" " 30"D	D/2 + T	Minimum = X
9" " 36"D		Maximum pay quantity will be Z = 12"
10" " 42"D		
11" " 48"D		
12" " 54"D		

SECT. OF CULVERT WITH CONC. PROTECTION

Scale: 1" = 1'-0"

STATE OF HAWAII
DEPARTMENT OF TRANSPORTATION
HIGHWAYS DIVISION


STANDARD DETAILS
DROP INTAKES, RETAINING WALLS,
HEADWALLS, CONSTRUCTION JOINTS
SCALES AS NOTED

SHEET No 25 OF 28 SHEETS


Revised: Jan. 25, 1967

NOTE:


1. All welds $\frac{3}{8}$ " unless otherwise noted.
2. All steel shall be structural grade.
3. Grates and Frame shall be hot dip galvanized after fabrication in accordance with Section 44(H) of the Standard Specifications.
4. Detail of Types "A-1" and "A-2" Steel Frame and Grates are identical except for the thickness of end spacers and number of grate bars. See Table of End Spacer Thickness.

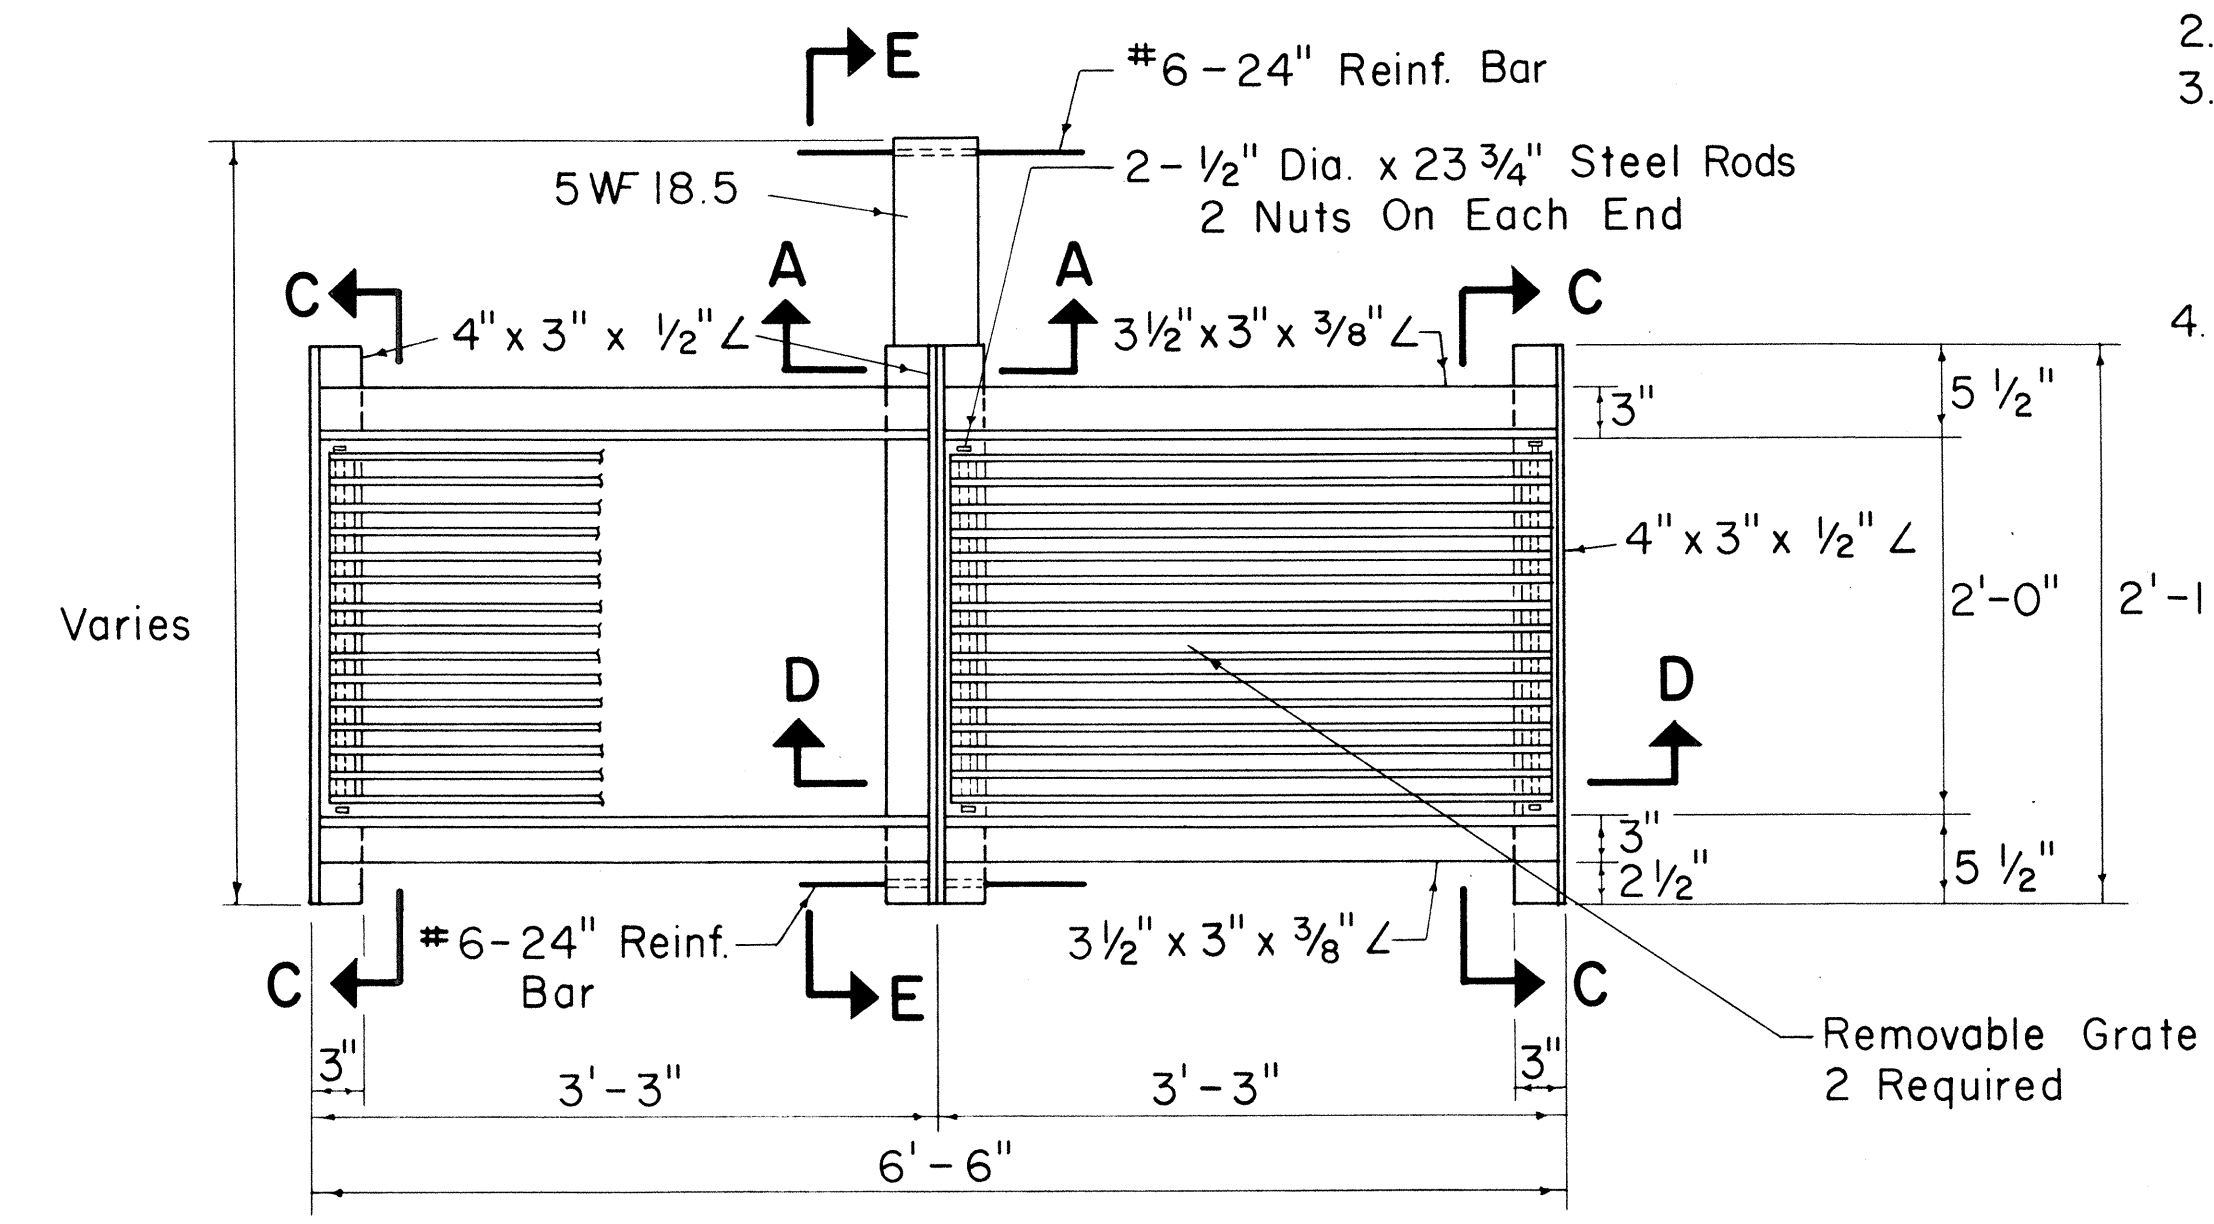

PLAN

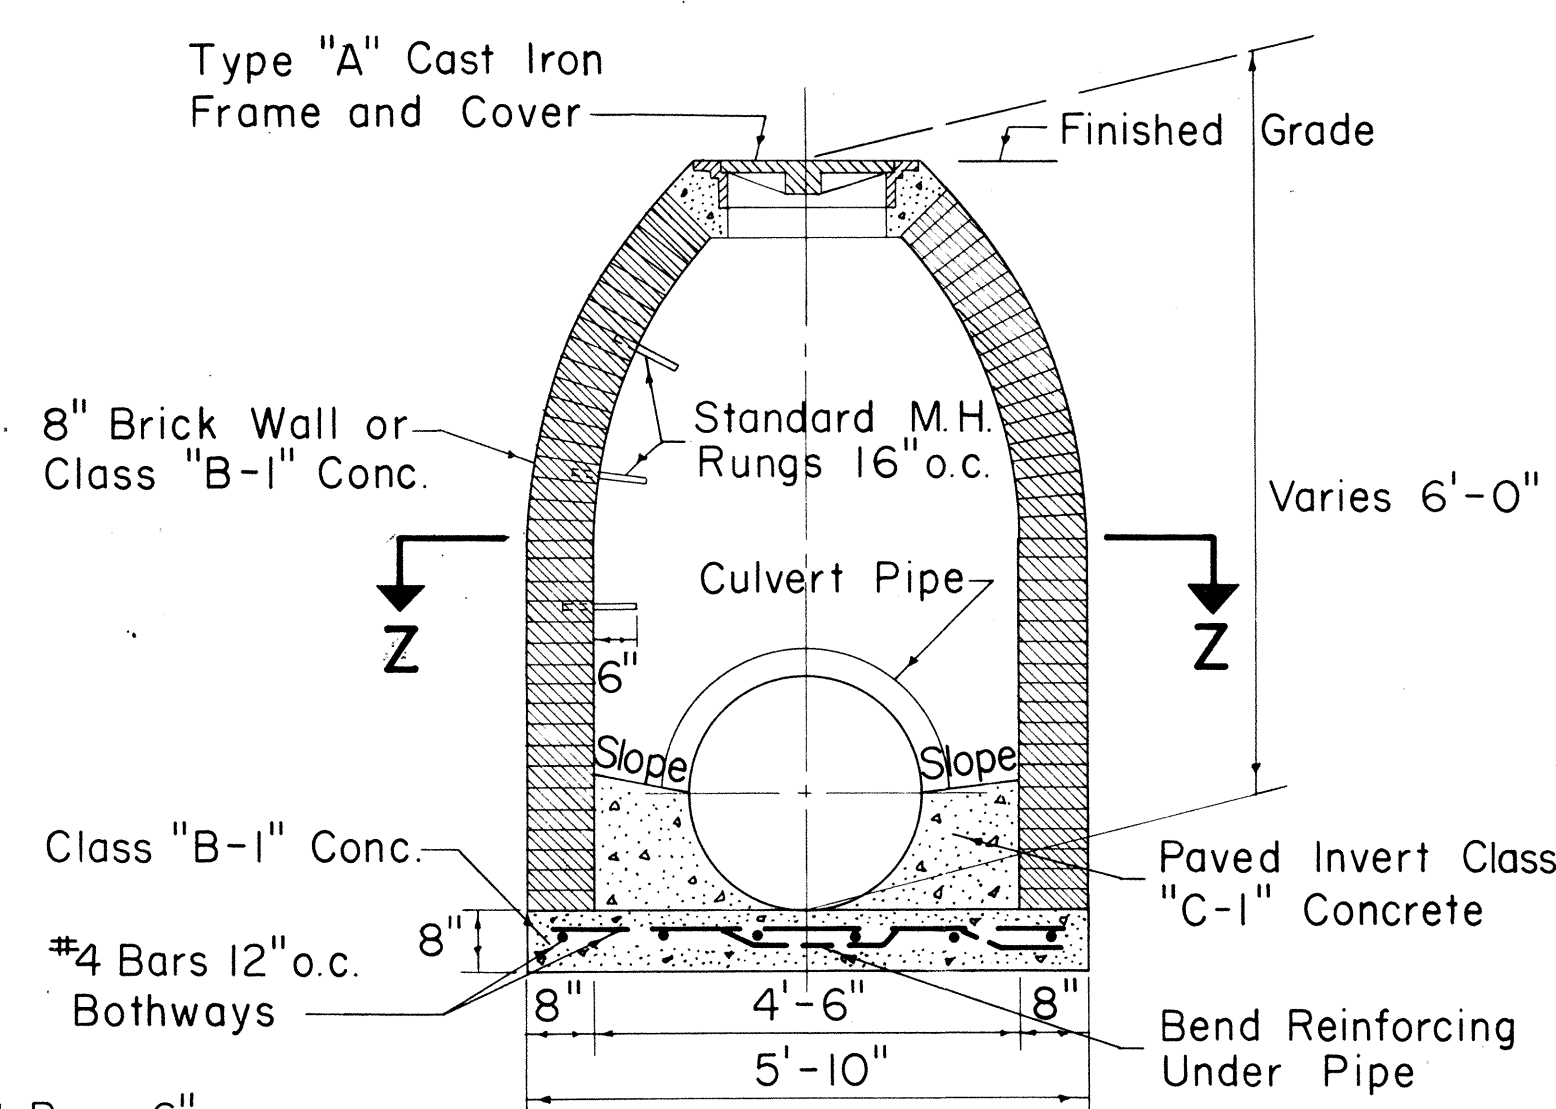

SECTION Y-Y

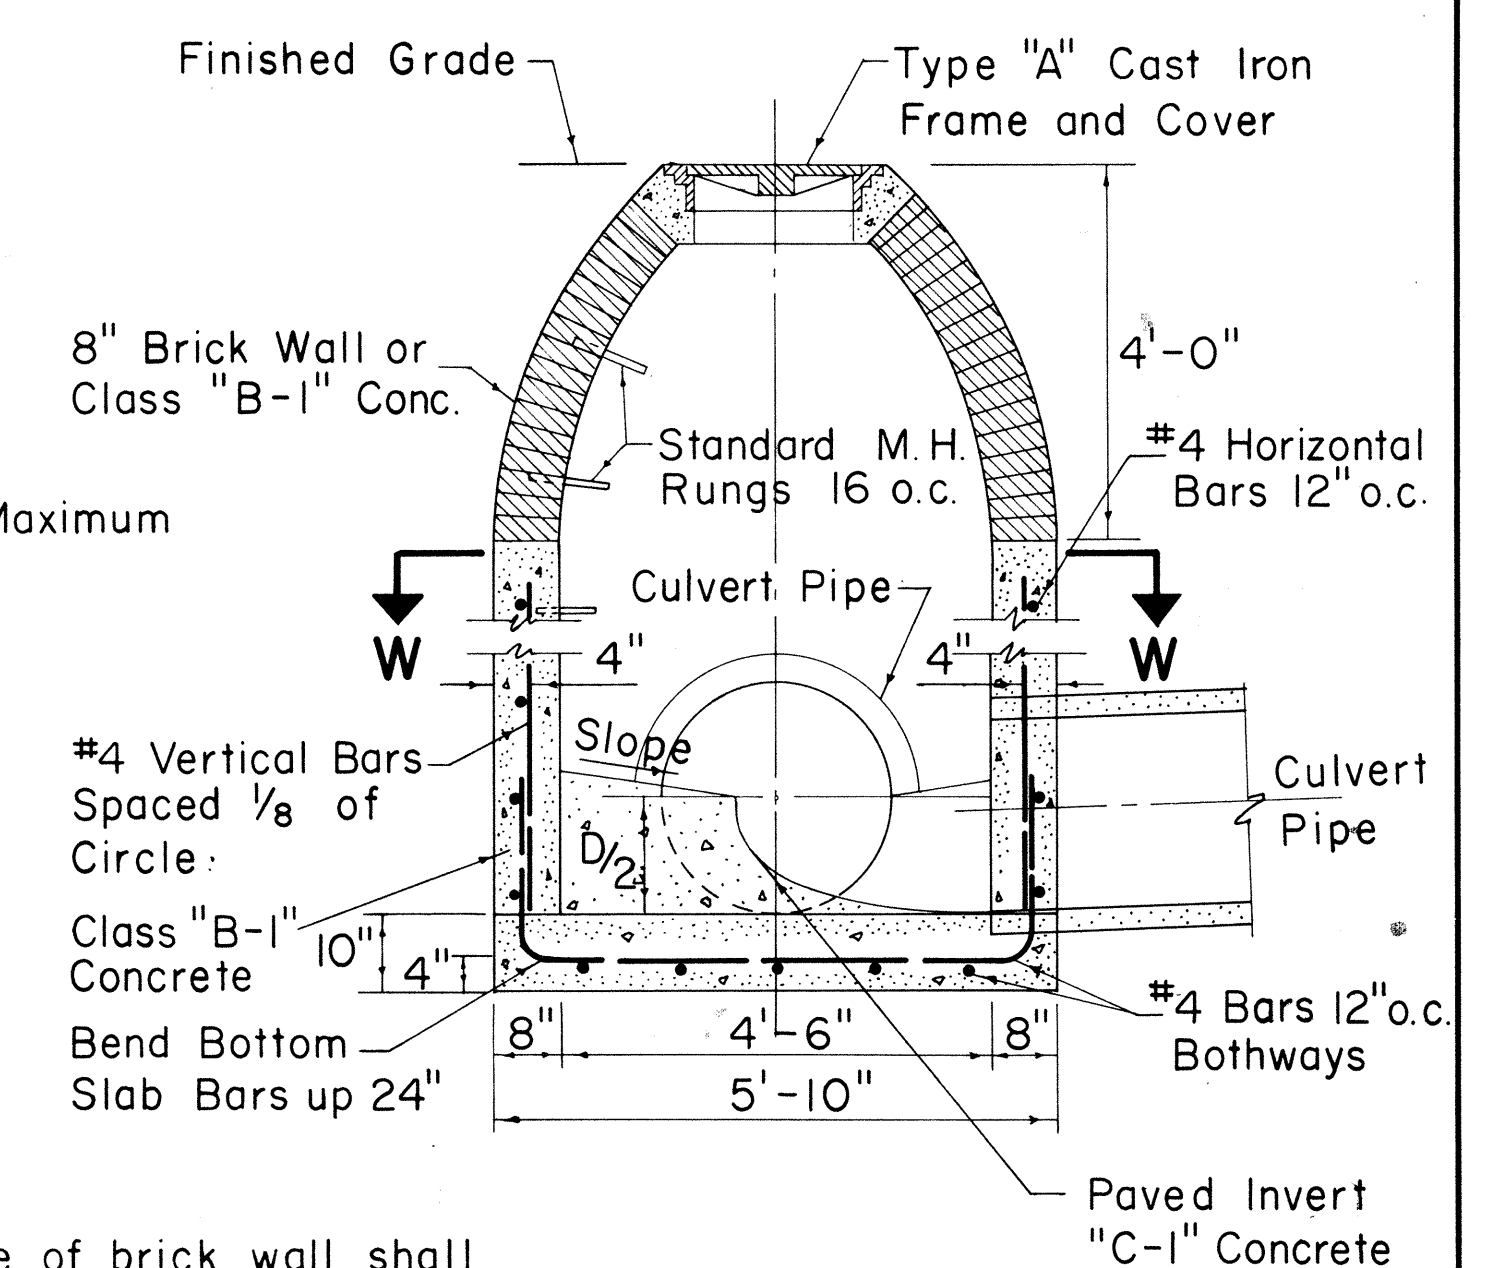

SECTION X-X


NOTE:

1. Exterior surface of brick wall shall be plastered with 1" thickness of 1:2 Cement Mortar.
2. Number size and direction of culvert pipes at manhole to be as shown on plans.
3. Paved invert not required at drop manholes.
4. All Class "C-1" Concrete to be incidental to Class "B-1" Concrete.


SECTION A-A

TABLE OF END SPACER THICKNESS


TYPE FRAME & GRATES	"T" (in.)
A-1	1
A-2	1 3/8

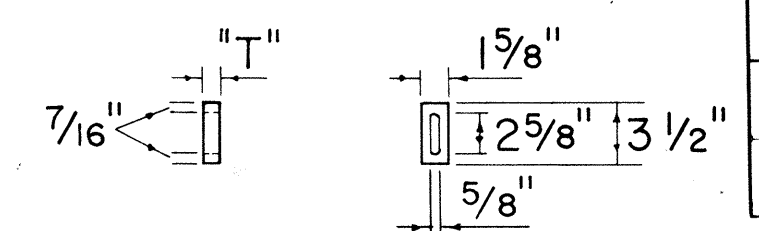


END SPACER

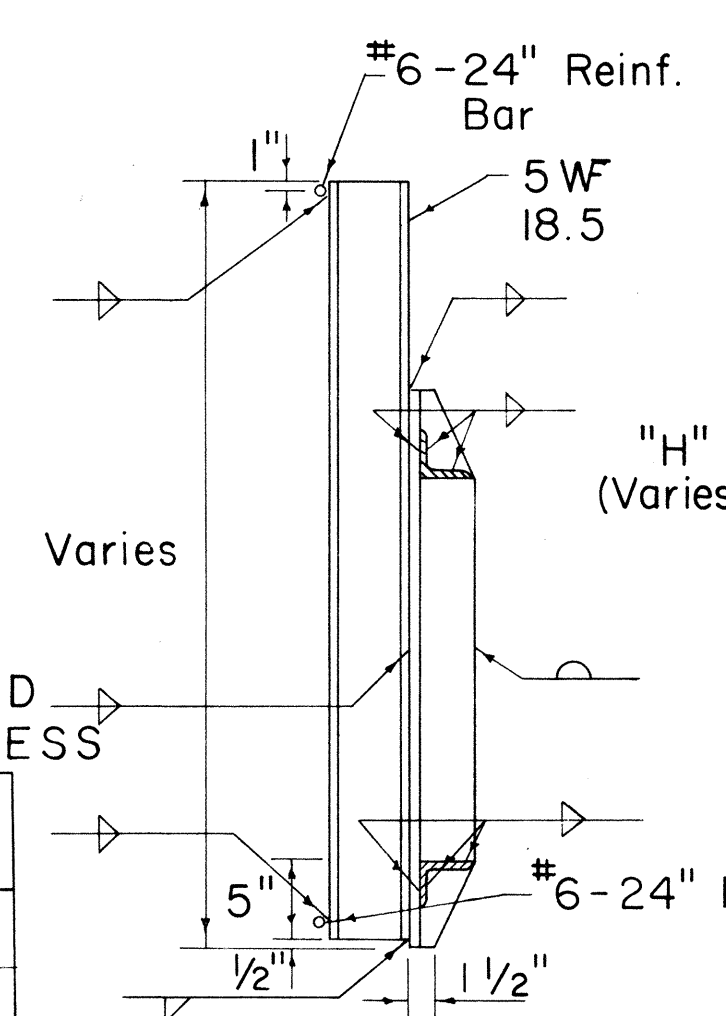


SECTION E-E

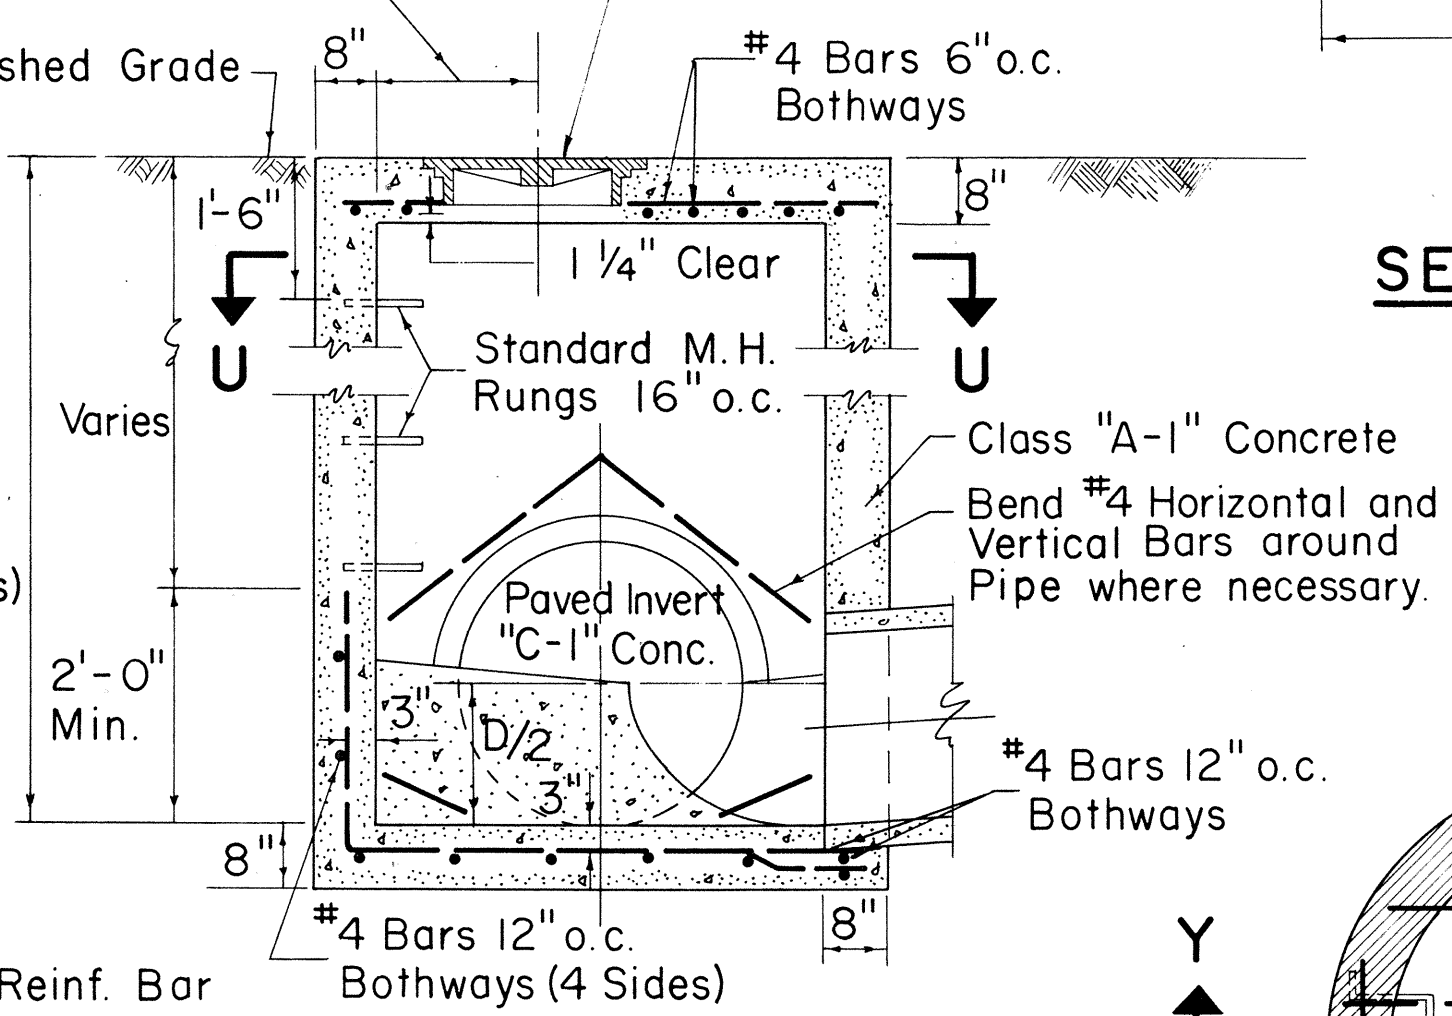

SECTION V-V

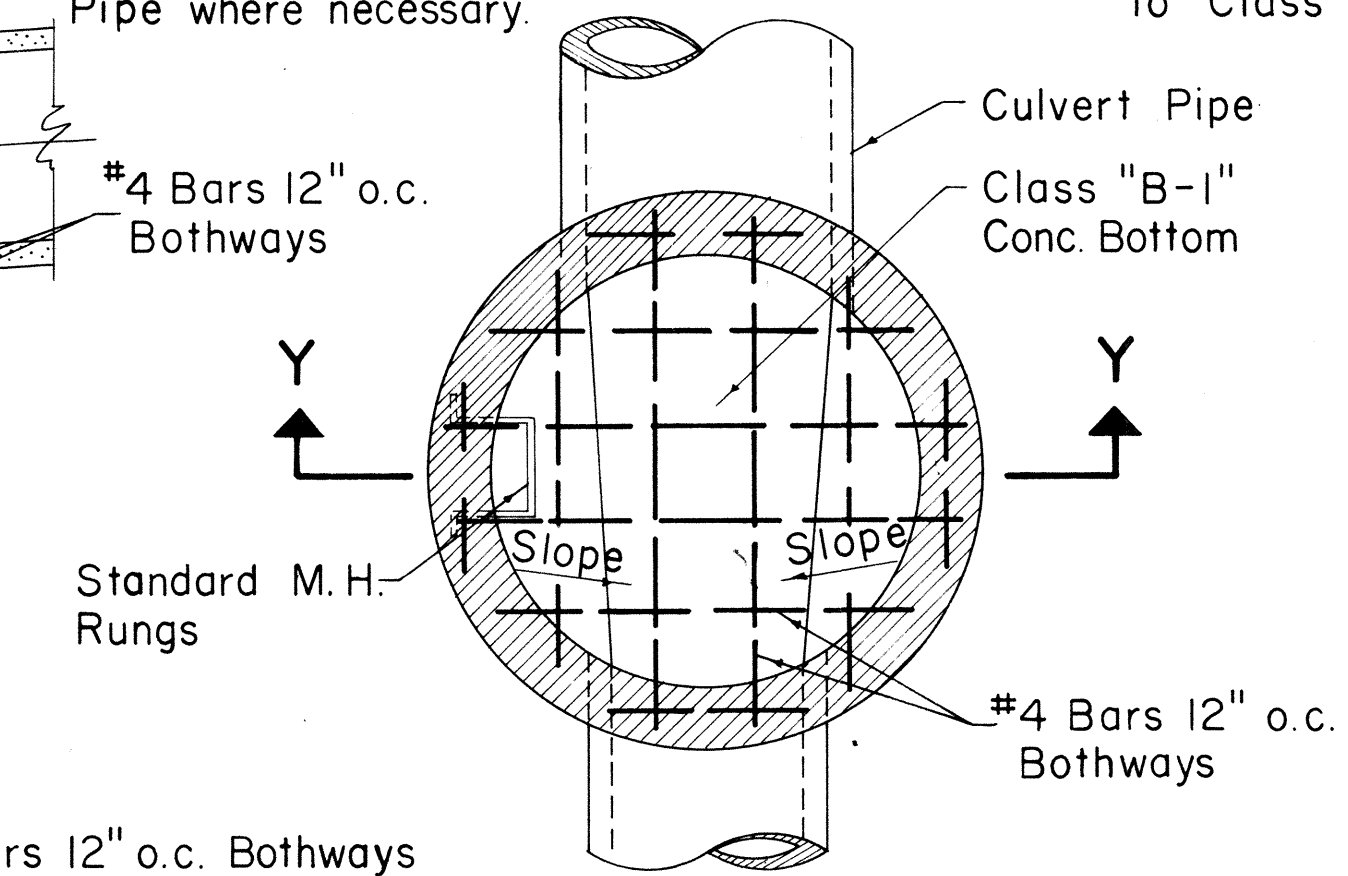

SECTION Z-Z

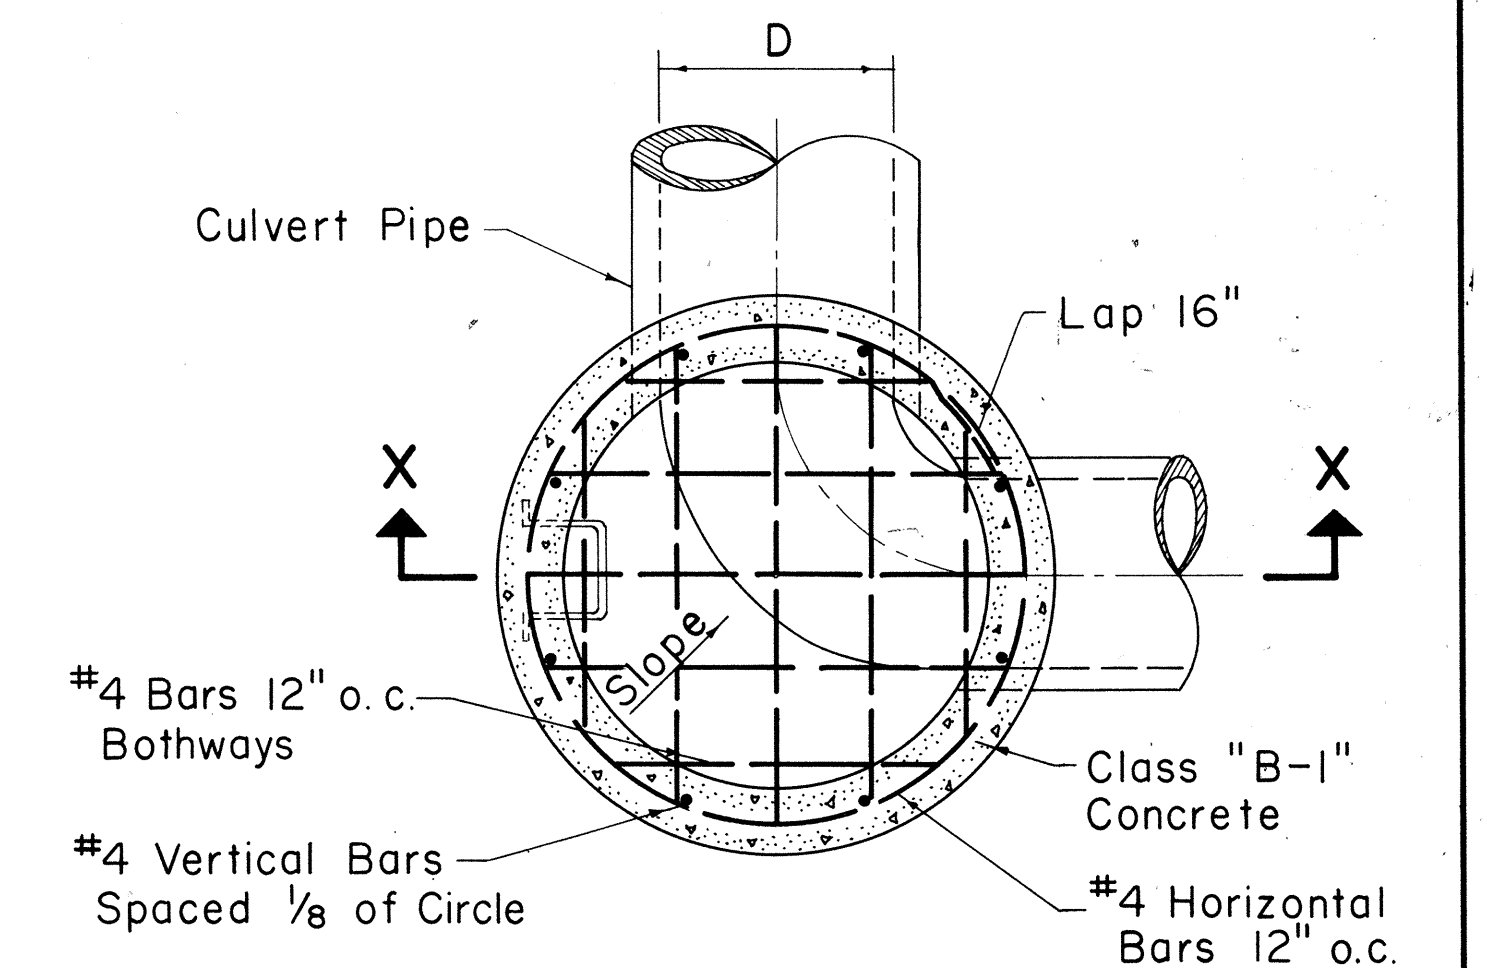

SECTION W-W

TYPE "D" STORM DRAIN MANHOLE

Scale: $\frac{1}{2}$ " = 1'-0"

TYPE "E" STORM DRAIN MANHOLE


Scale: $\frac{1}{2}$ " = 1'-0"

SECTION U-U


TYPE "A", "B", & "C"

S.D.M.H.

Scale: $\frac{1}{2}$ " = 1'-0"

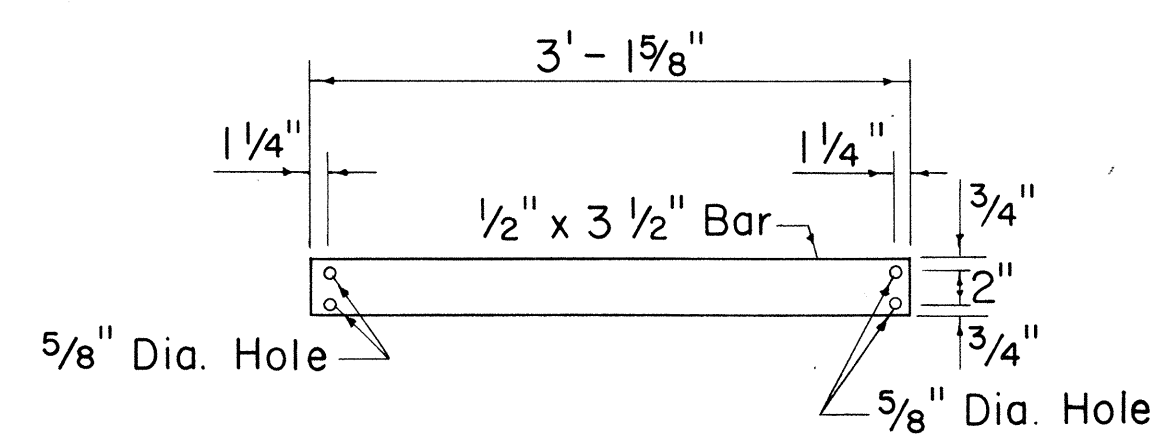

GRATE BARS

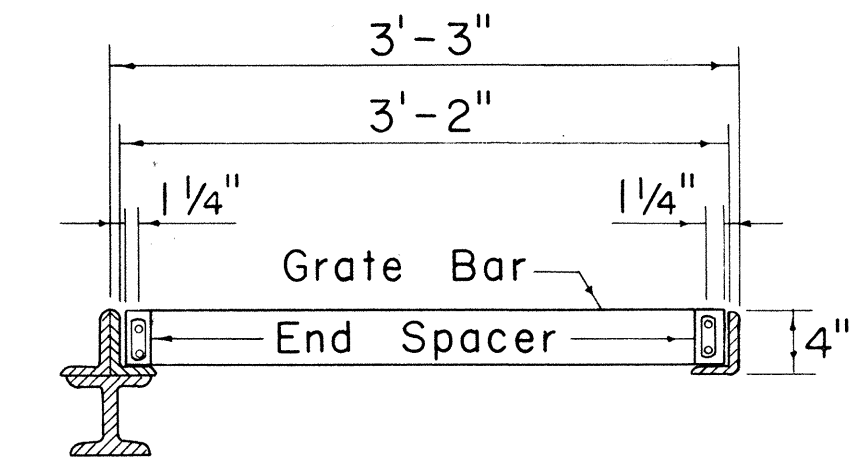

SECTION D-D

DETAIL OF TYPE "A-1" & "A-2" STEEL FRAME AND GRATES

Scale: 1" = 1'-0"

STATE OF HAWAII
DEPARTMENT OF TRANSPORTATION
HIGHWAYS DIVISION

STANDARD DETAILS

STEEL FRAME AND GRATES
AND STORM DRAIN MANHOLES


Scales: As Noted Date: June, 1967

SHEET NO. 26 OF 28 SHEETS


2/17/50
8,14,50

FED. ROAD DIST. NO.	STATE	FED. AID PROJ. NO.	FISCAL YEAR	SHEET NO.	TOTAL SHEETS
HAWAII	HAW	141-1025	1947	56	99
August 1957					Unit 3


NOTE: Stock Pattern From Novelty Foundry ~ Honolulu

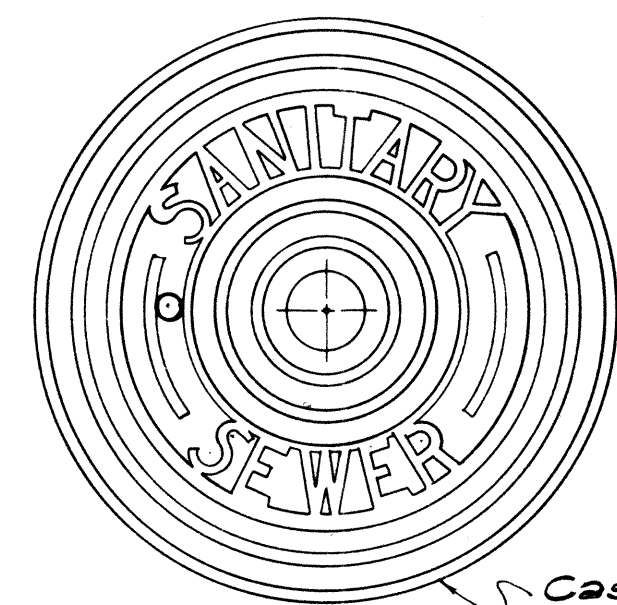


TOP VIEW OF COVER

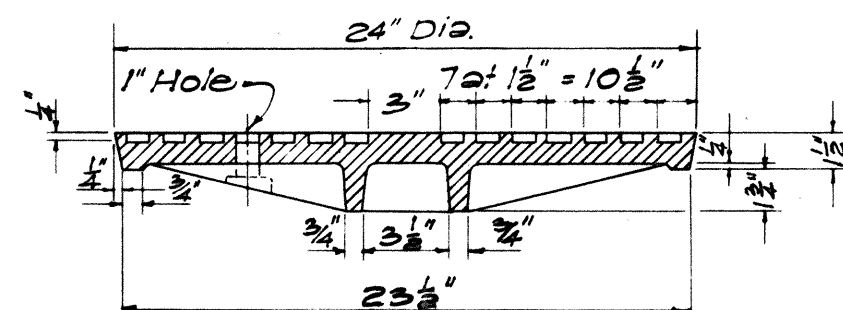


SECTION

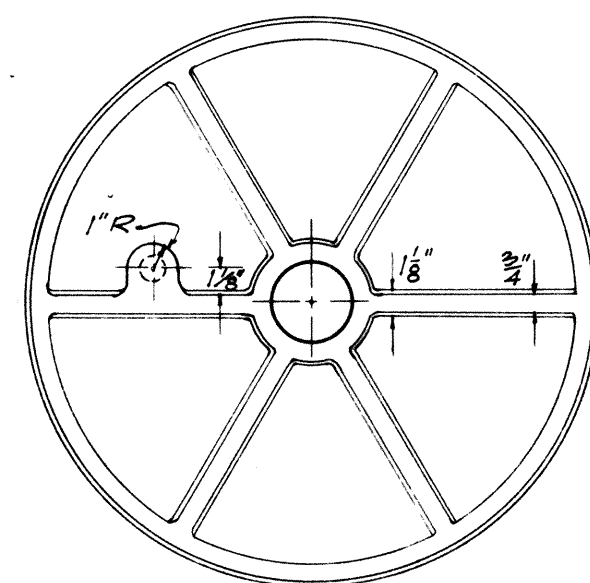


BOTTOM VIEW OF COVER

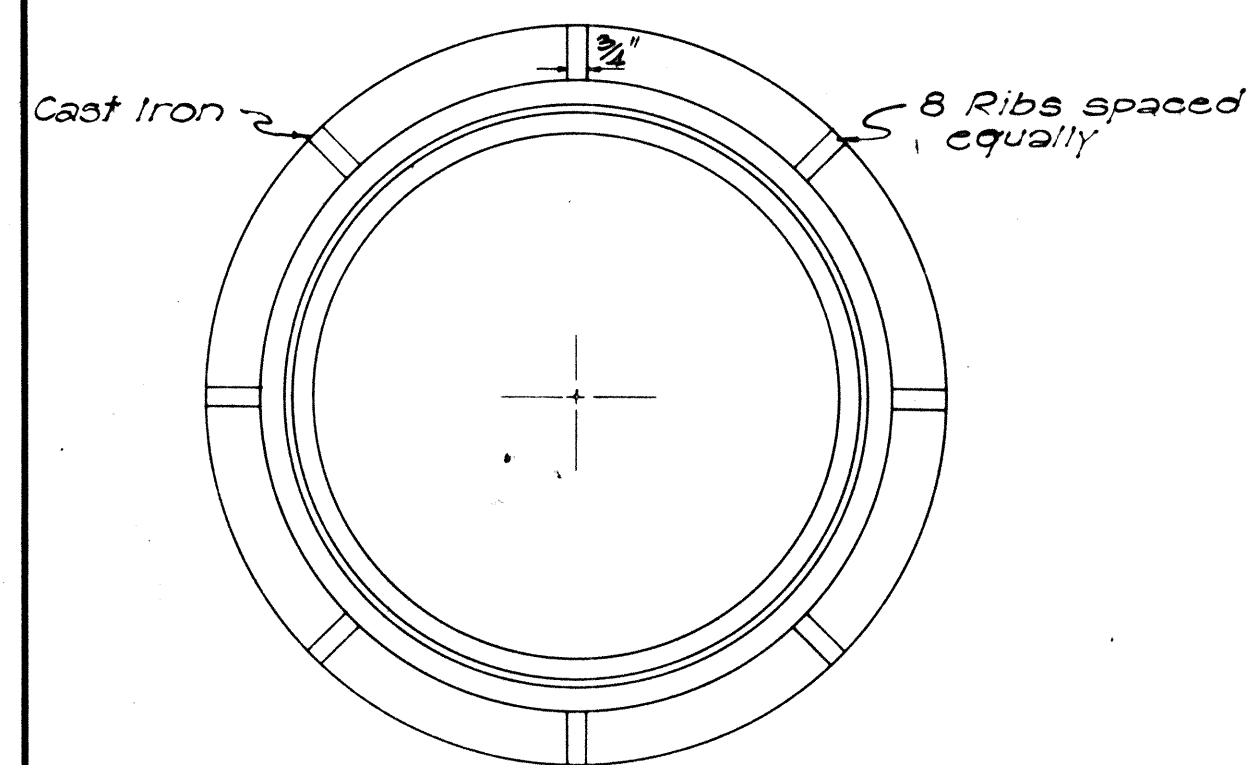


PLAN OF RIM

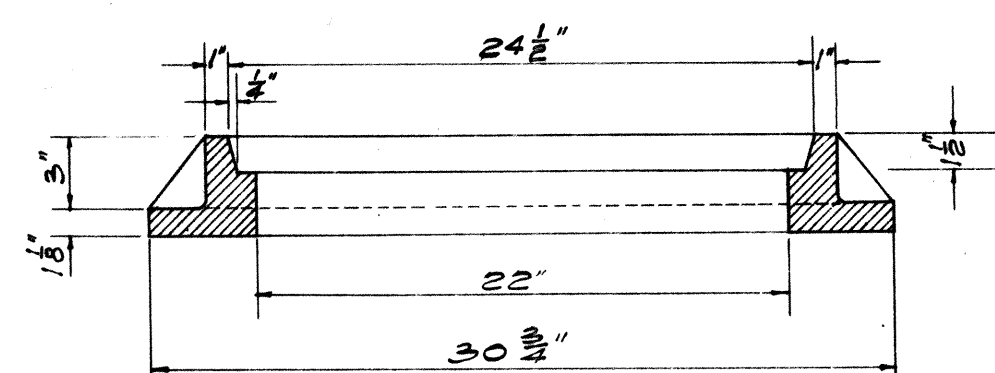


SECTION OF RIM
DETAILS OF TYPE "S"
CAST IRON FRAME AND COVER
SCALE: 1-1/2" = 1'-0"

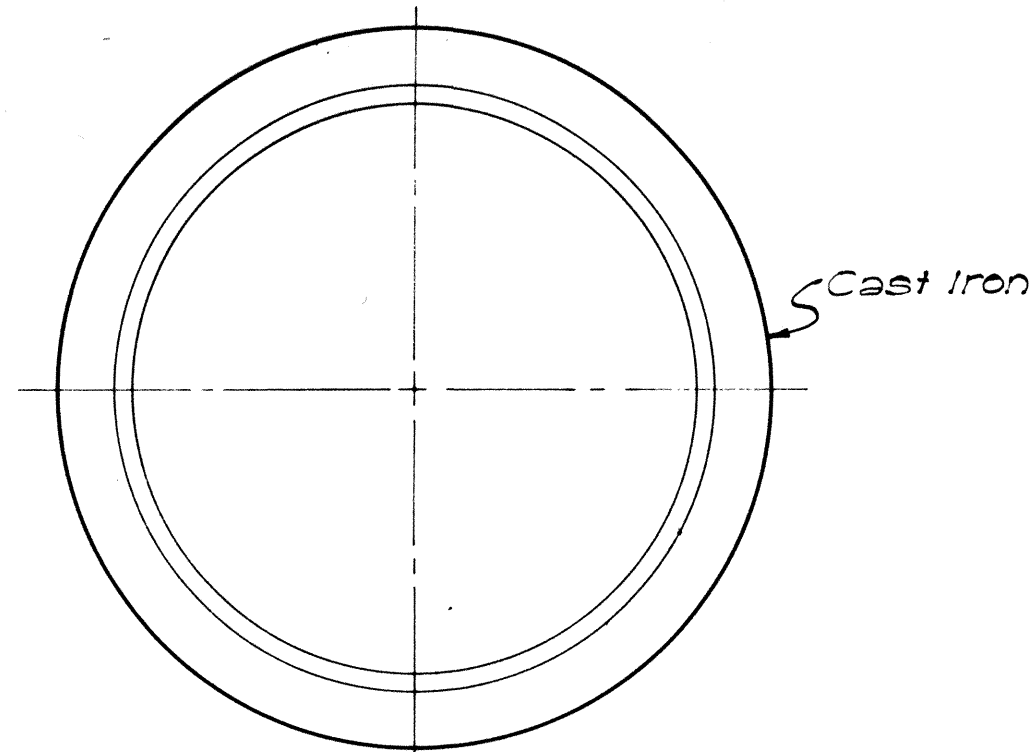


PLAN OF RIM

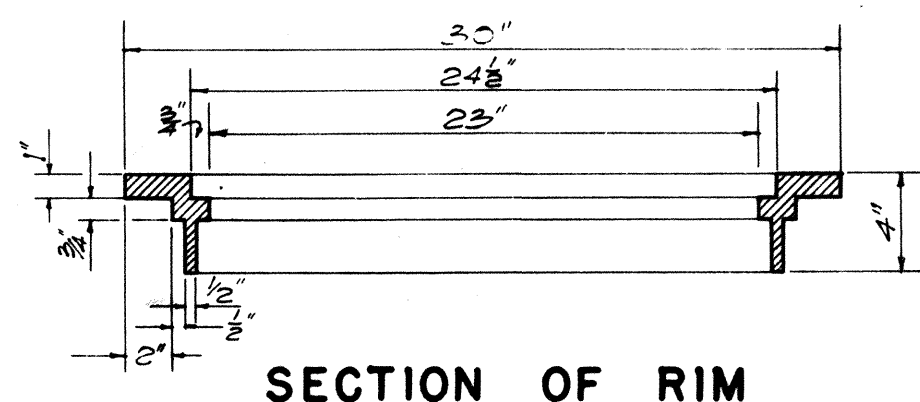


SECTION OF RIM

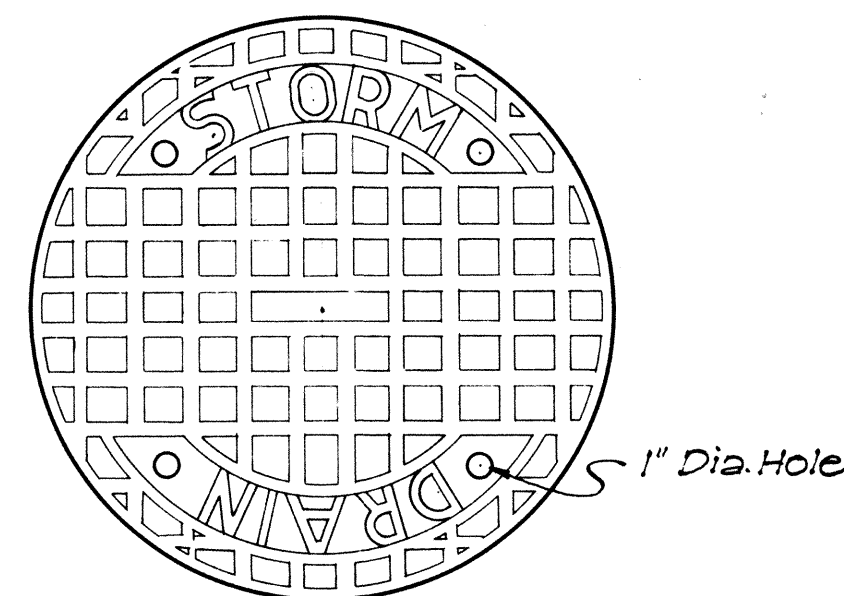

TOP VIEW OF COVER

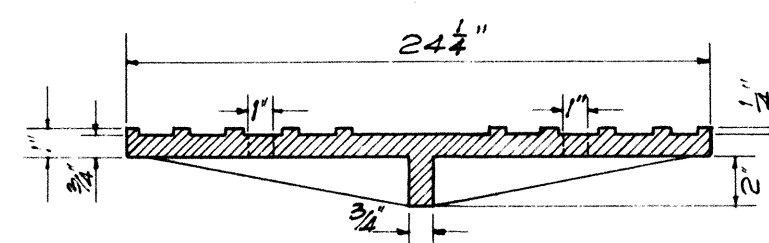


SECTION

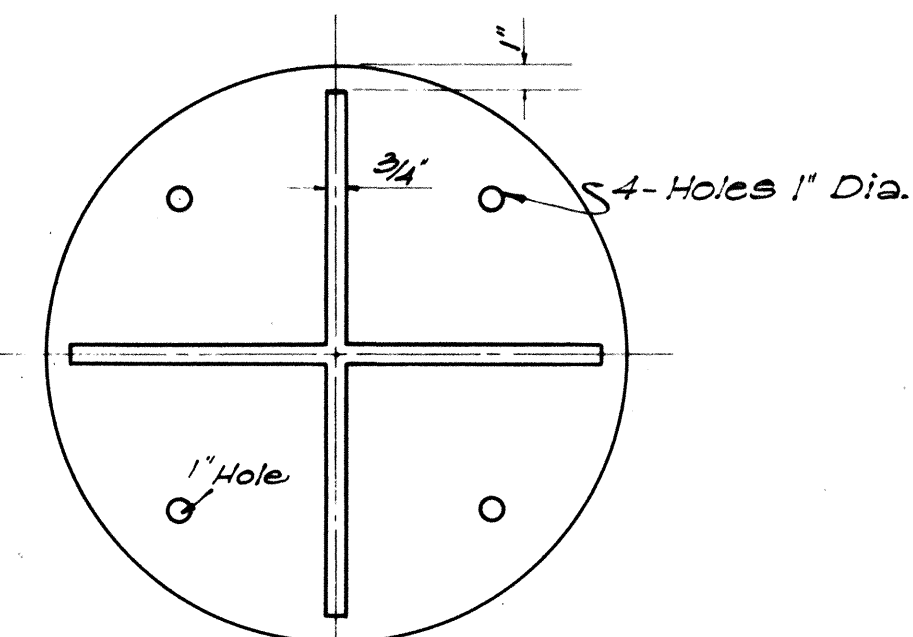


BOTTOM VIEW OF COVER


DETAILS OF TYPE "B"
CAST IRON FRAME AND COVER
SCALE: 1-1/2" = 1'-0"

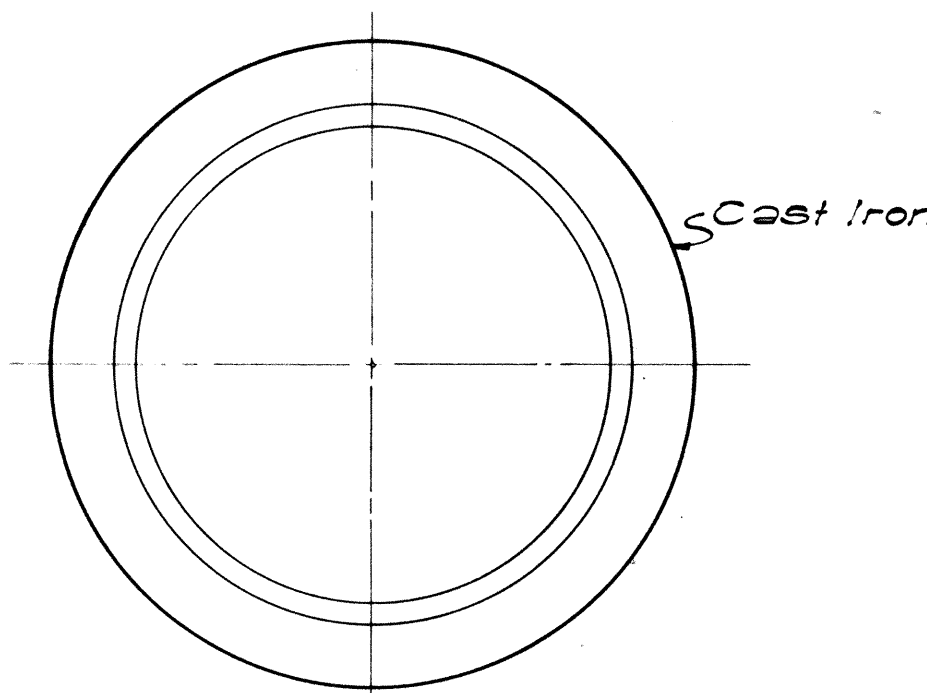


PLAN OF RIM

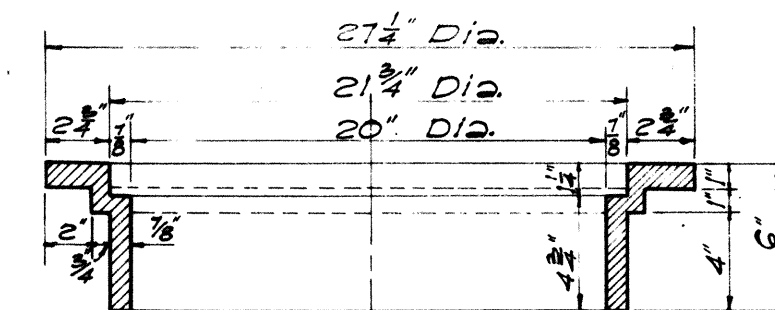


SECTION OF RIM

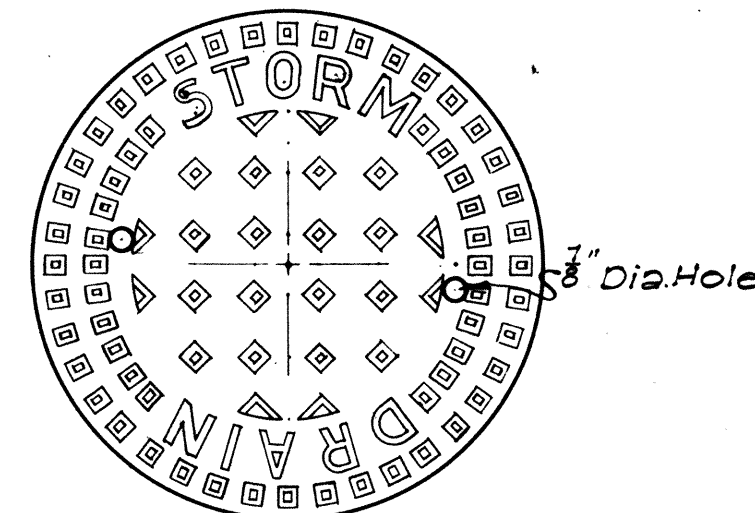

TOP VIEW OF COVER

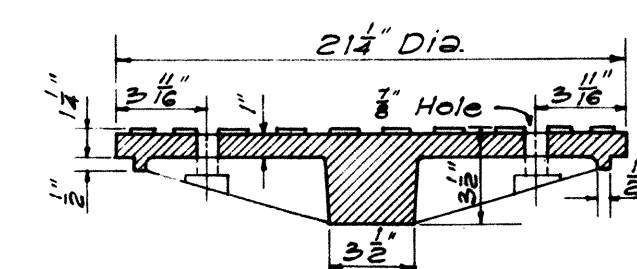


SECTION

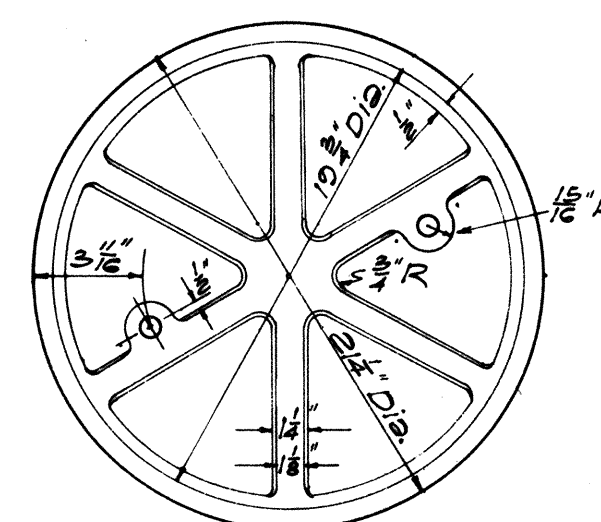


BOTTOM VIEW OF COVER


DETAILS OF TYPE "A"
CAST IRON FRAME AND COVER
SCALE: 1-1/2" = 1'-0"

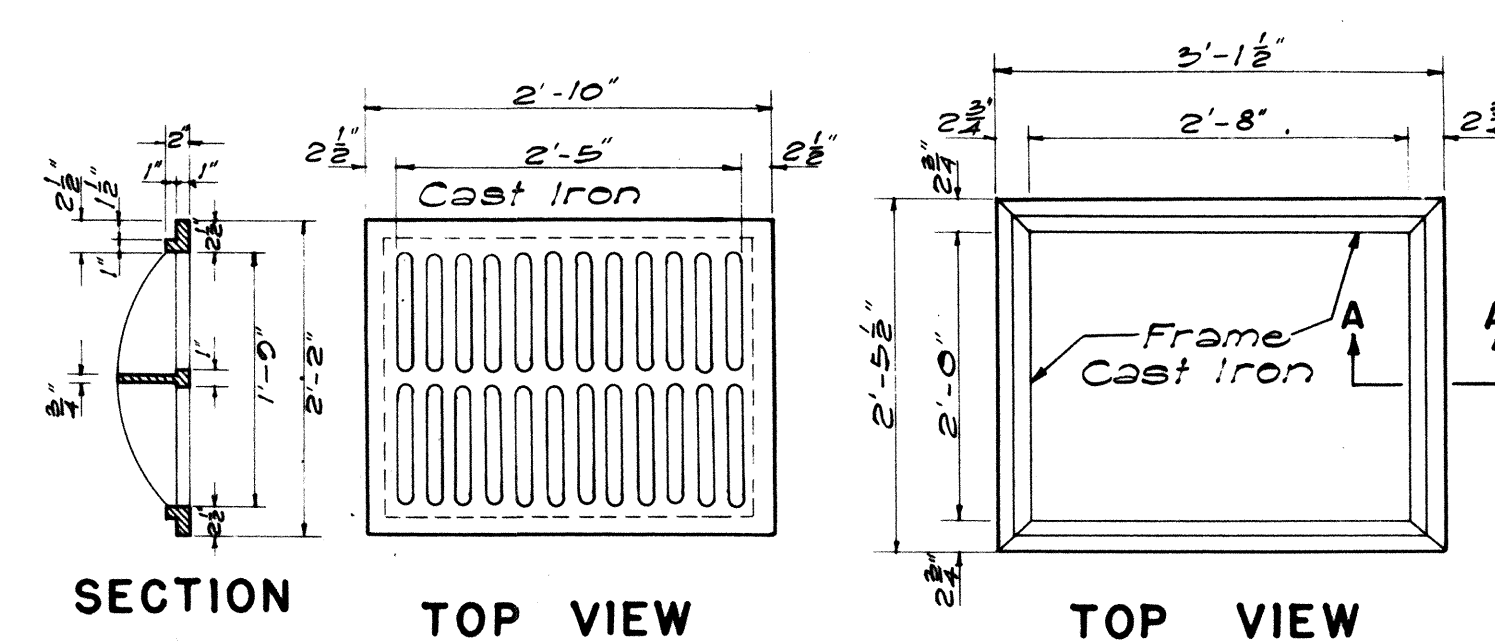


TYPE C C.I. FRAME AND GRATING
SCALE: 3/4" = 1'-0"

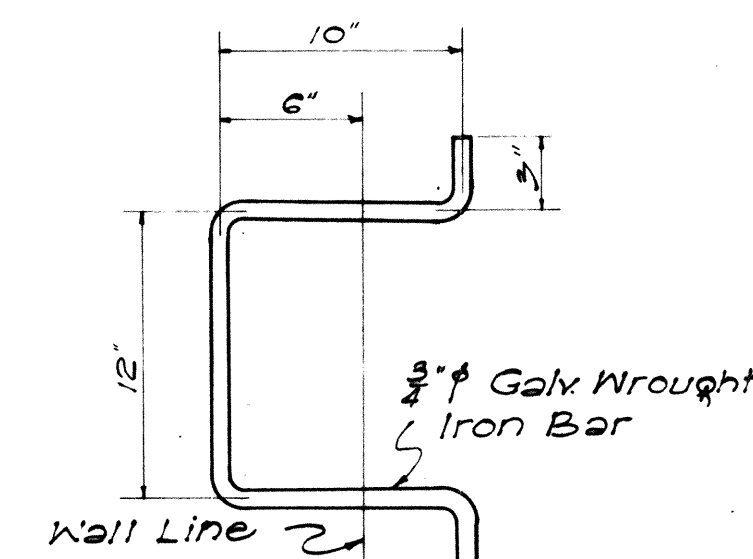


MANHOLE RUNG
SCALE: 1-1/2" = 1'-0"

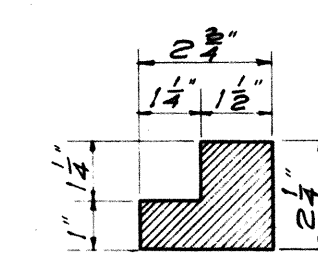


SECTION "A-A"
SCALE 3" = 1'-0"

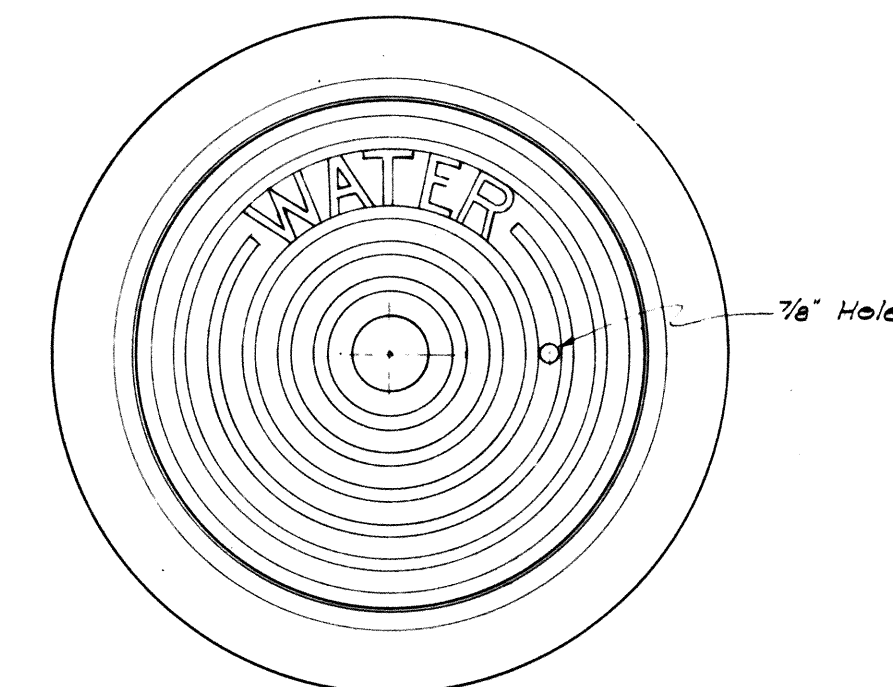

PLAN OF FRAME AND COVER

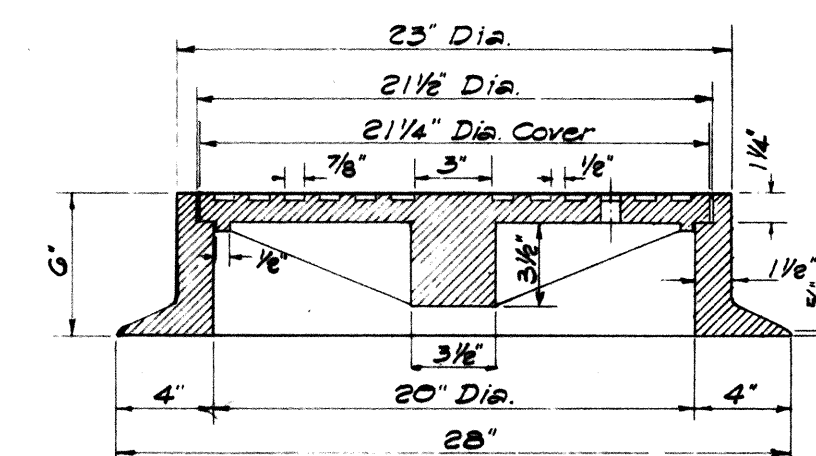

SECTION OF FRAME AND COVER

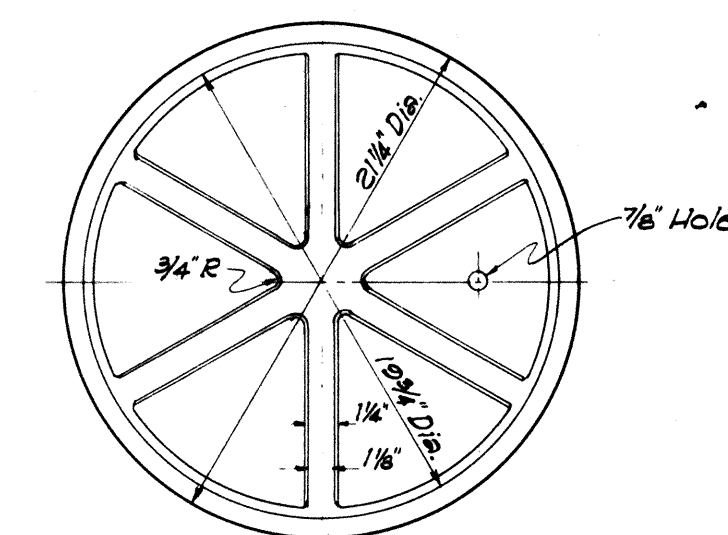

BOTTOM VIEW OF COVER

DETAILS OF TYPE "W"
CAST IRON FRAME AND COVER
SCALE: 1-1/2" = 1'-0"

NOTE:

THE TYPE "S" CAST IRON FRAME AND COVER SHOWN ON THIS SHEET IS EQUIVALENT TO THE CITY AND COUNTY OF HONOLULU, DIVISION OF SEWERS' TYPE "A" CAST IRON MANHOLE FRAME AND COVER.









THE TYPE "W" CAST IRON FRAME AND COVER SHOWN ON THIS SHEET IS EQUIVALENT TO THE CITY AND COUNTY OF HONOLULU, BOARD OF WATER SUPPLY'S CAST IRON MANHOLE FRAME AND COVER, 20" SIZE.

STATE OF HAWAII
DEPARTMENT OF TRANSPORTATION
HIGHWAYS DIVISION

STANDARD DETAILS
CATCH BASIN AND
MANHOLE CASTINGS
SCALES AS NOTED

SHEET NO 27 OF 28 SHEETS

5 6

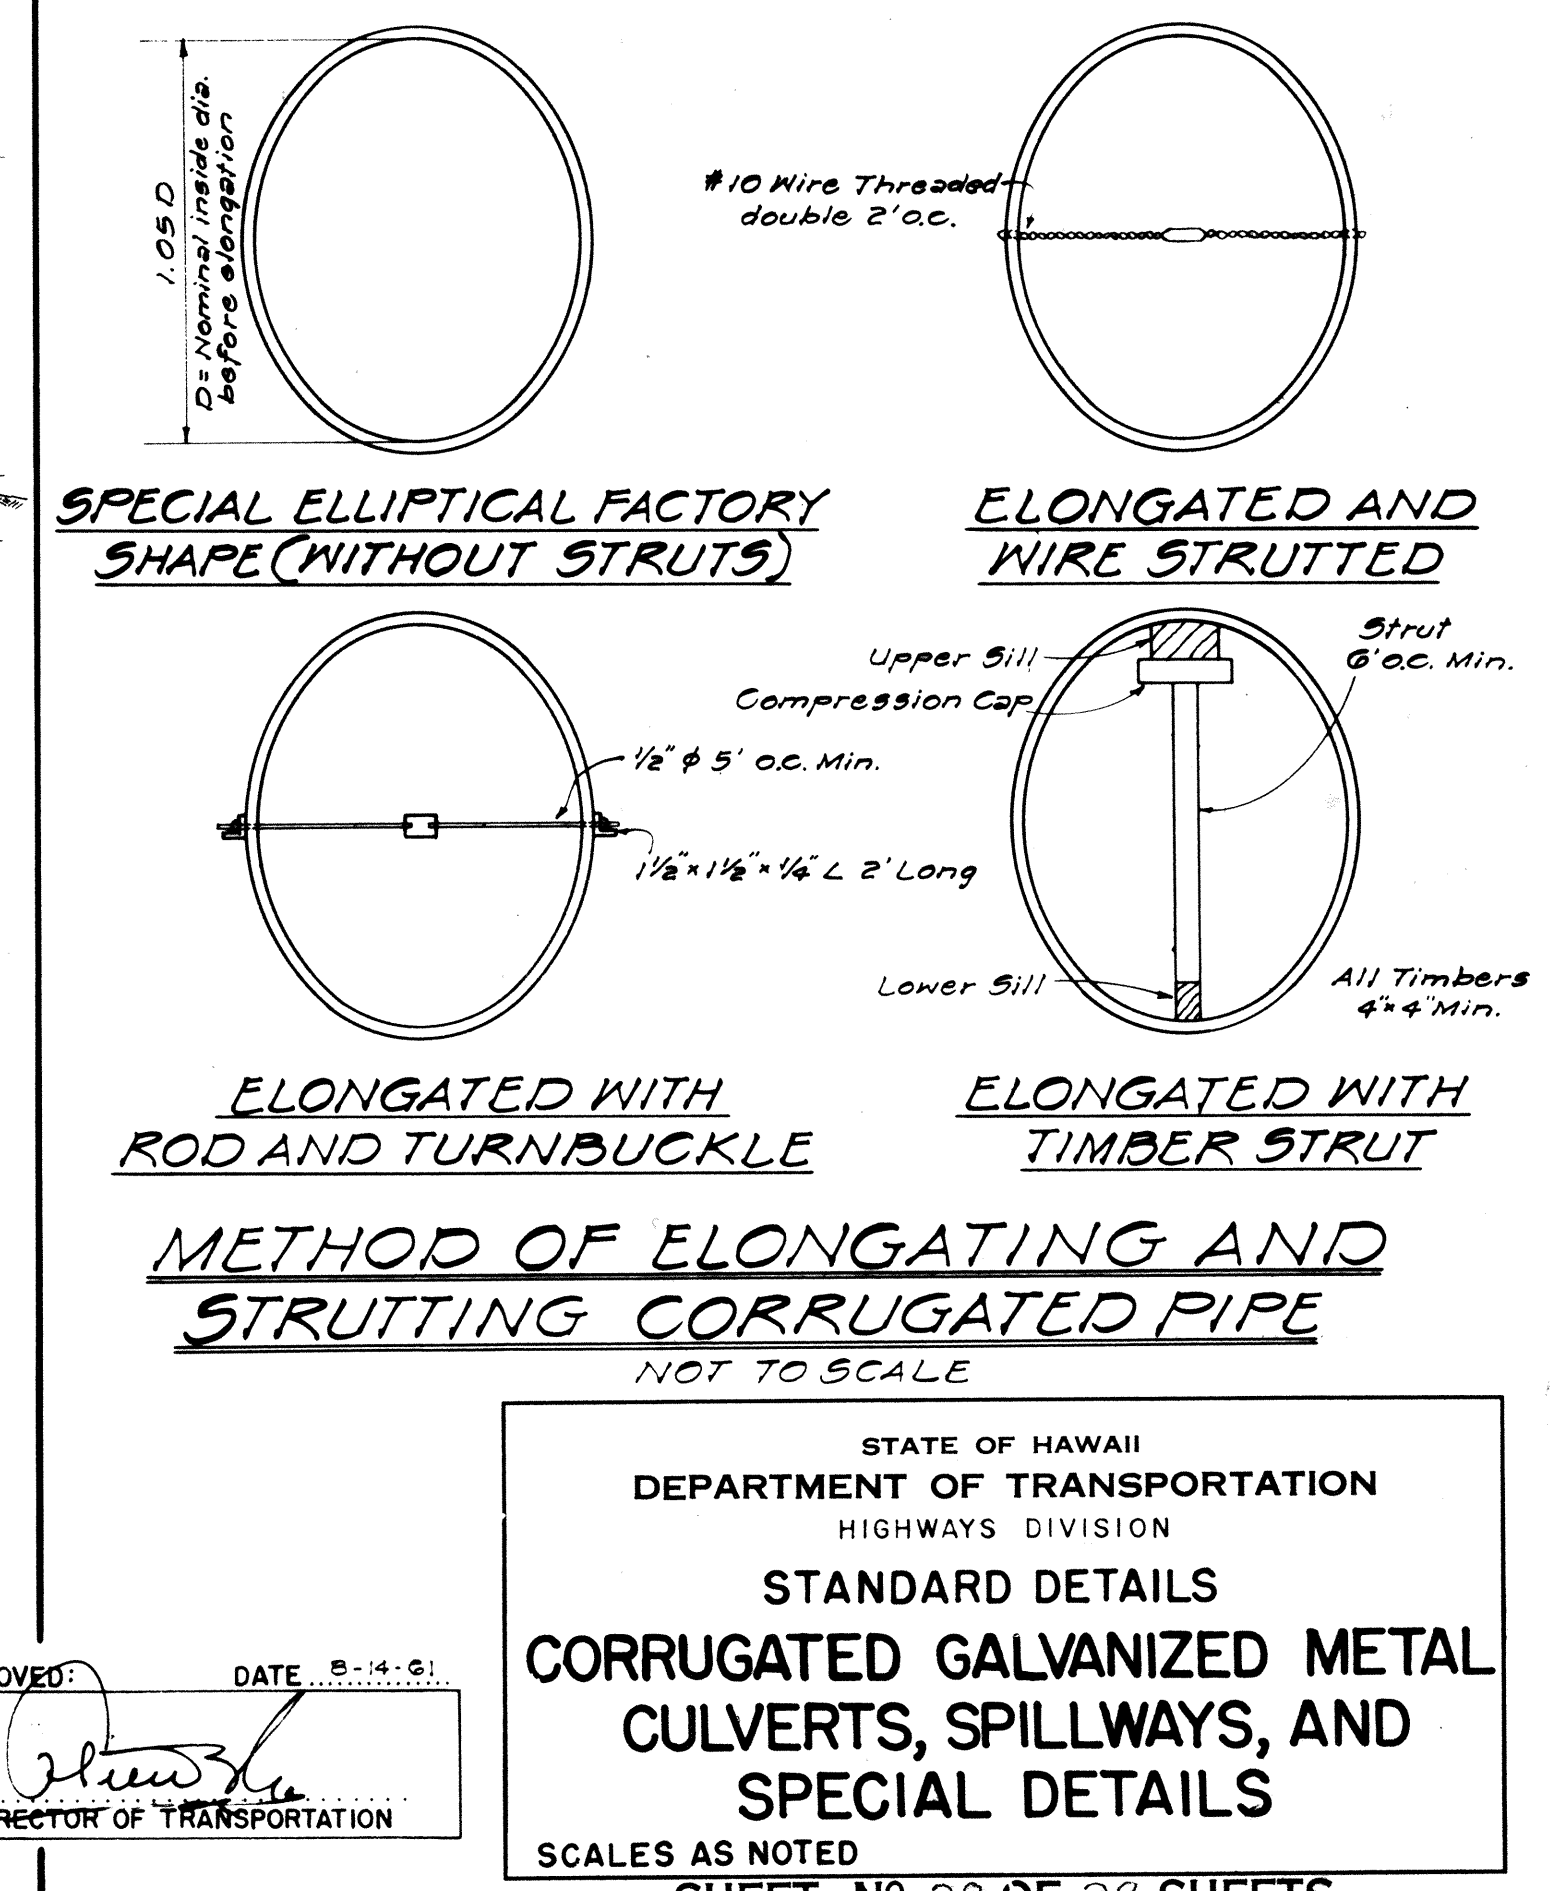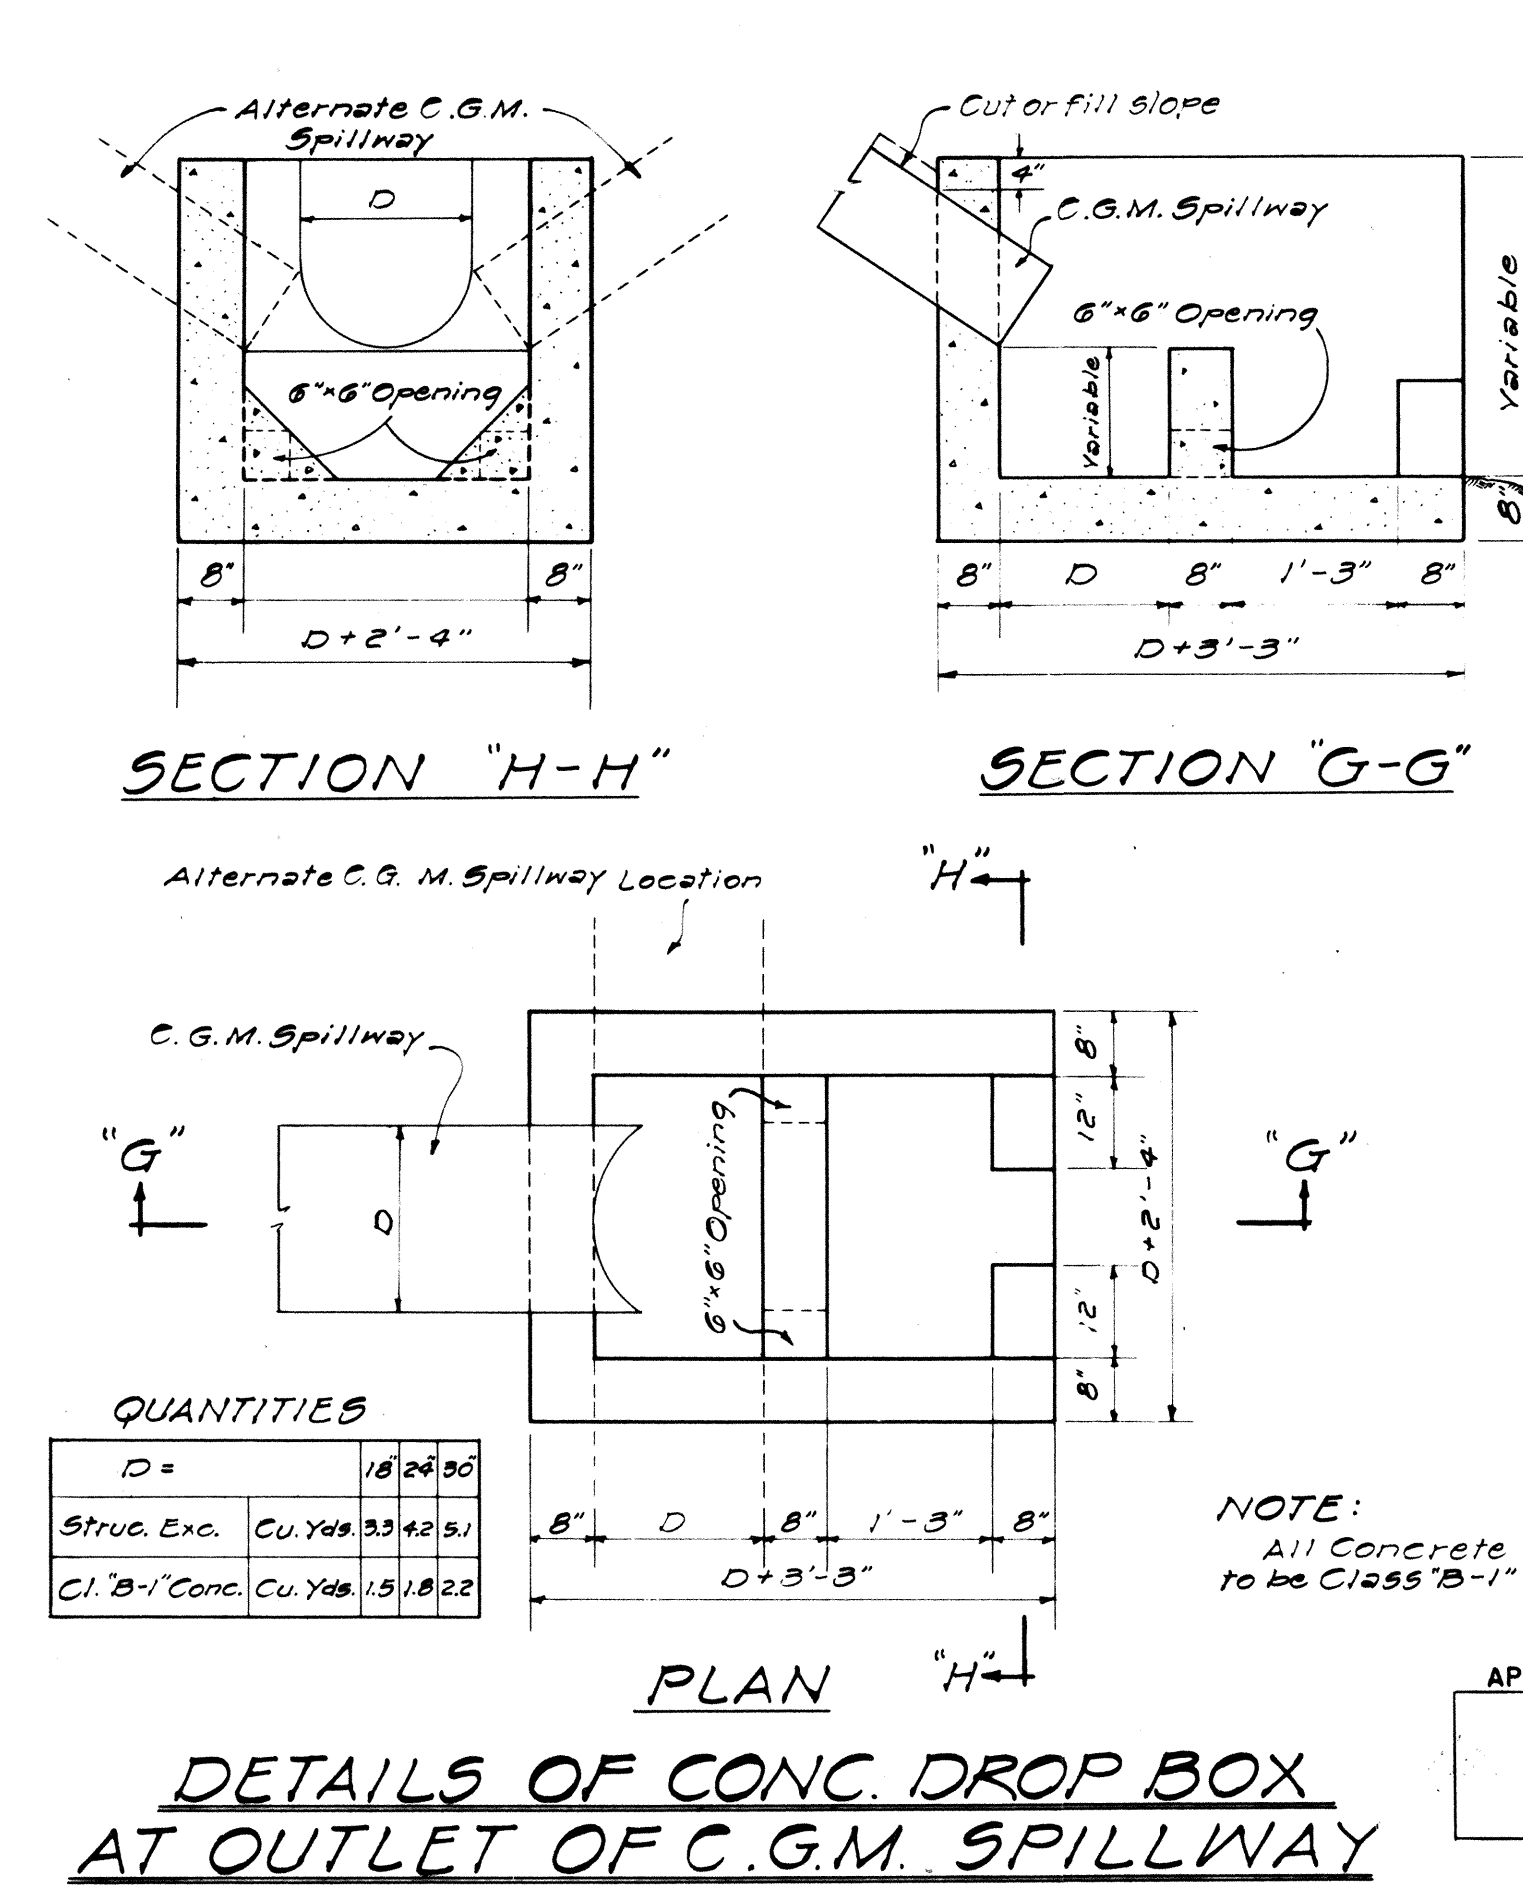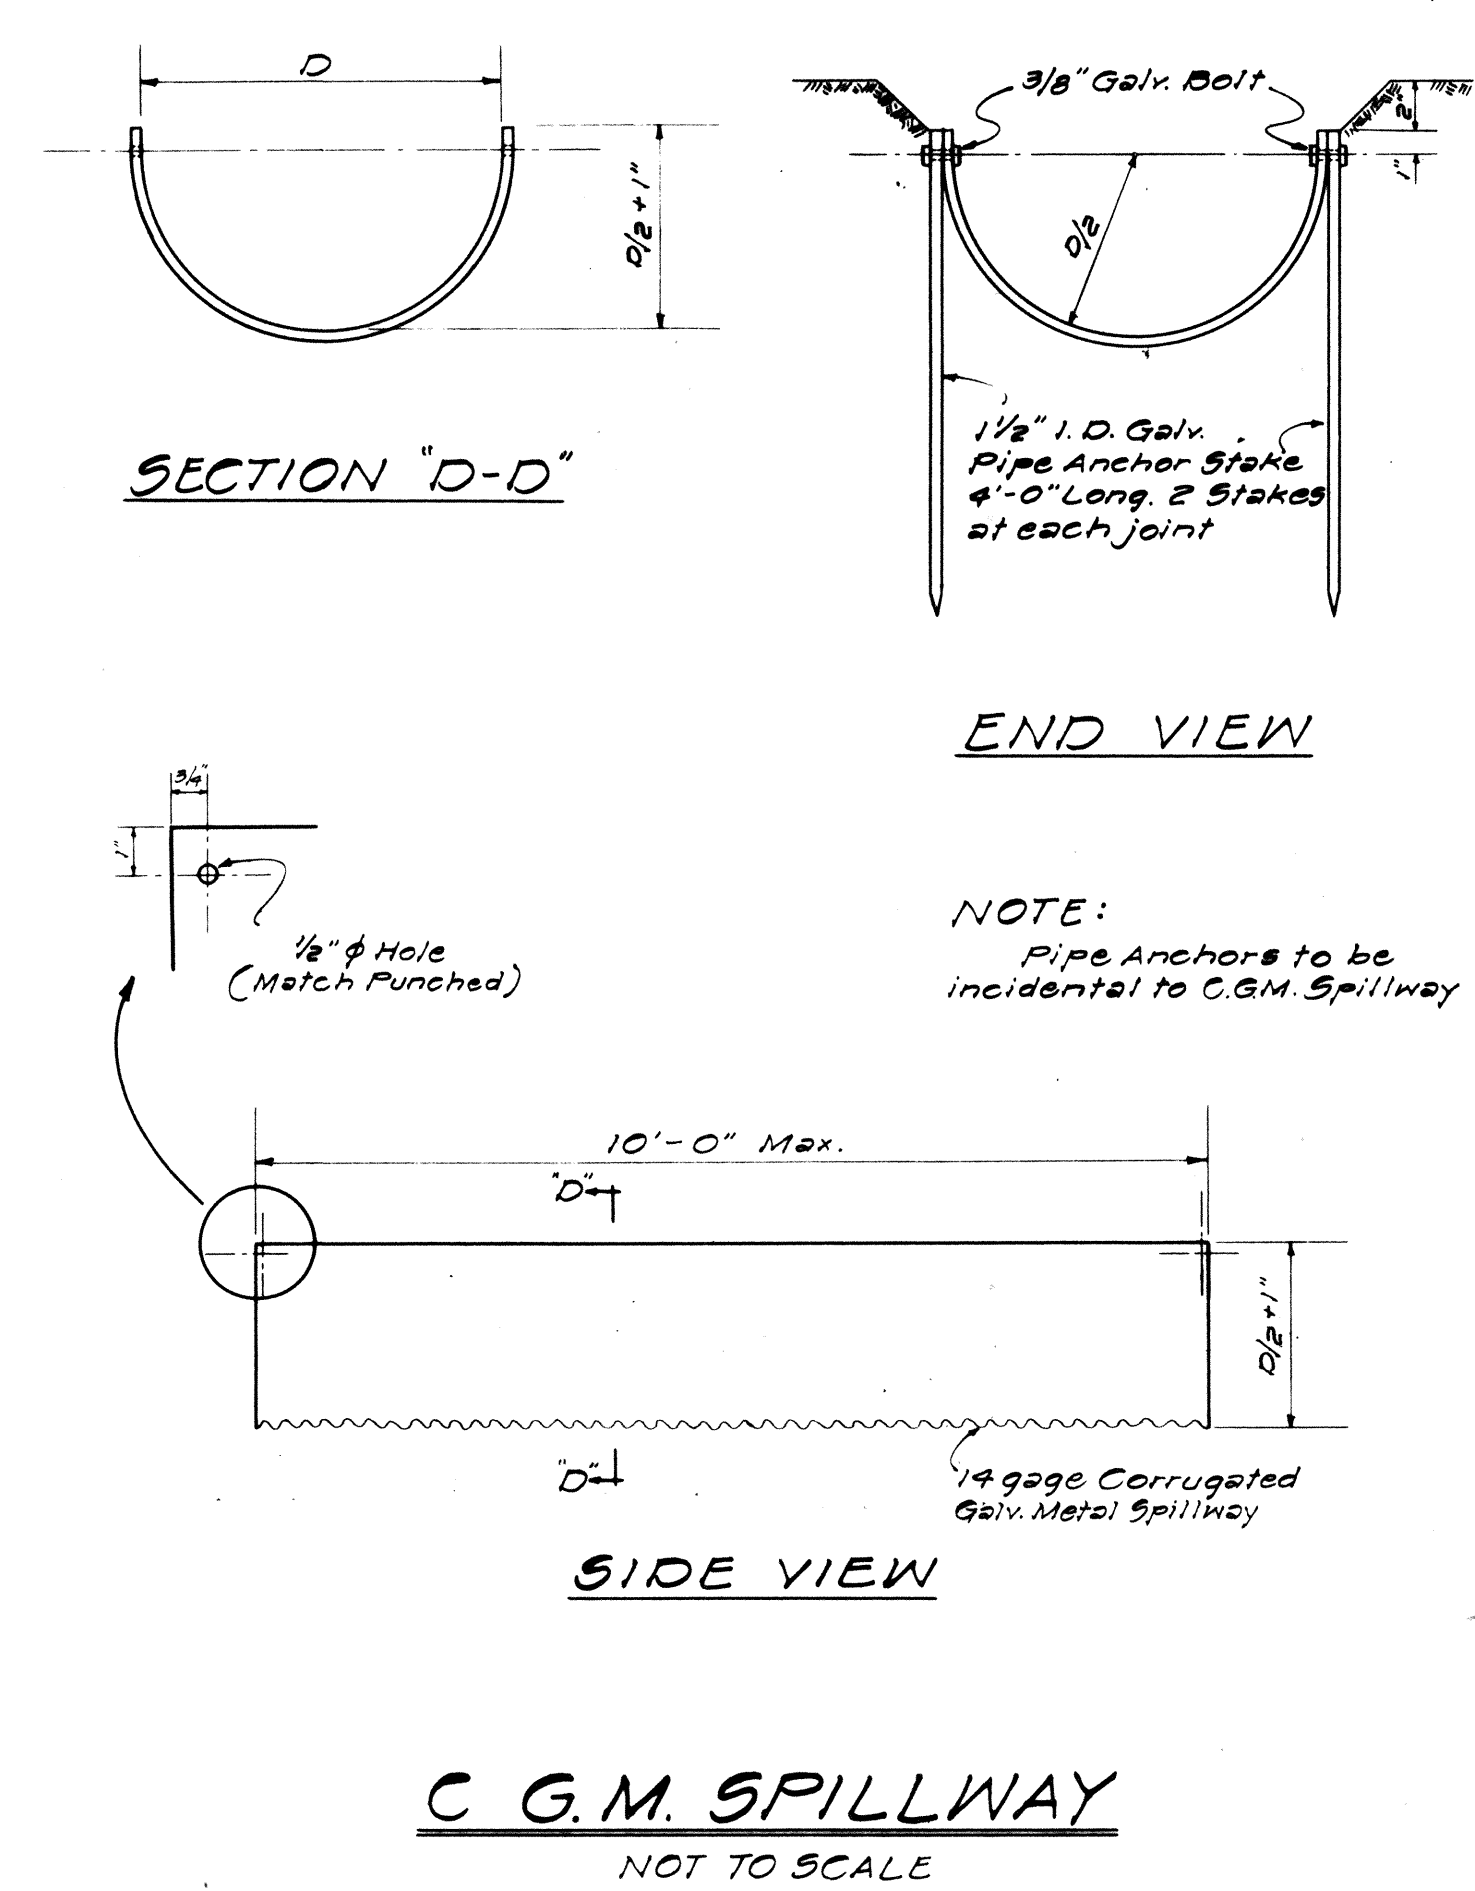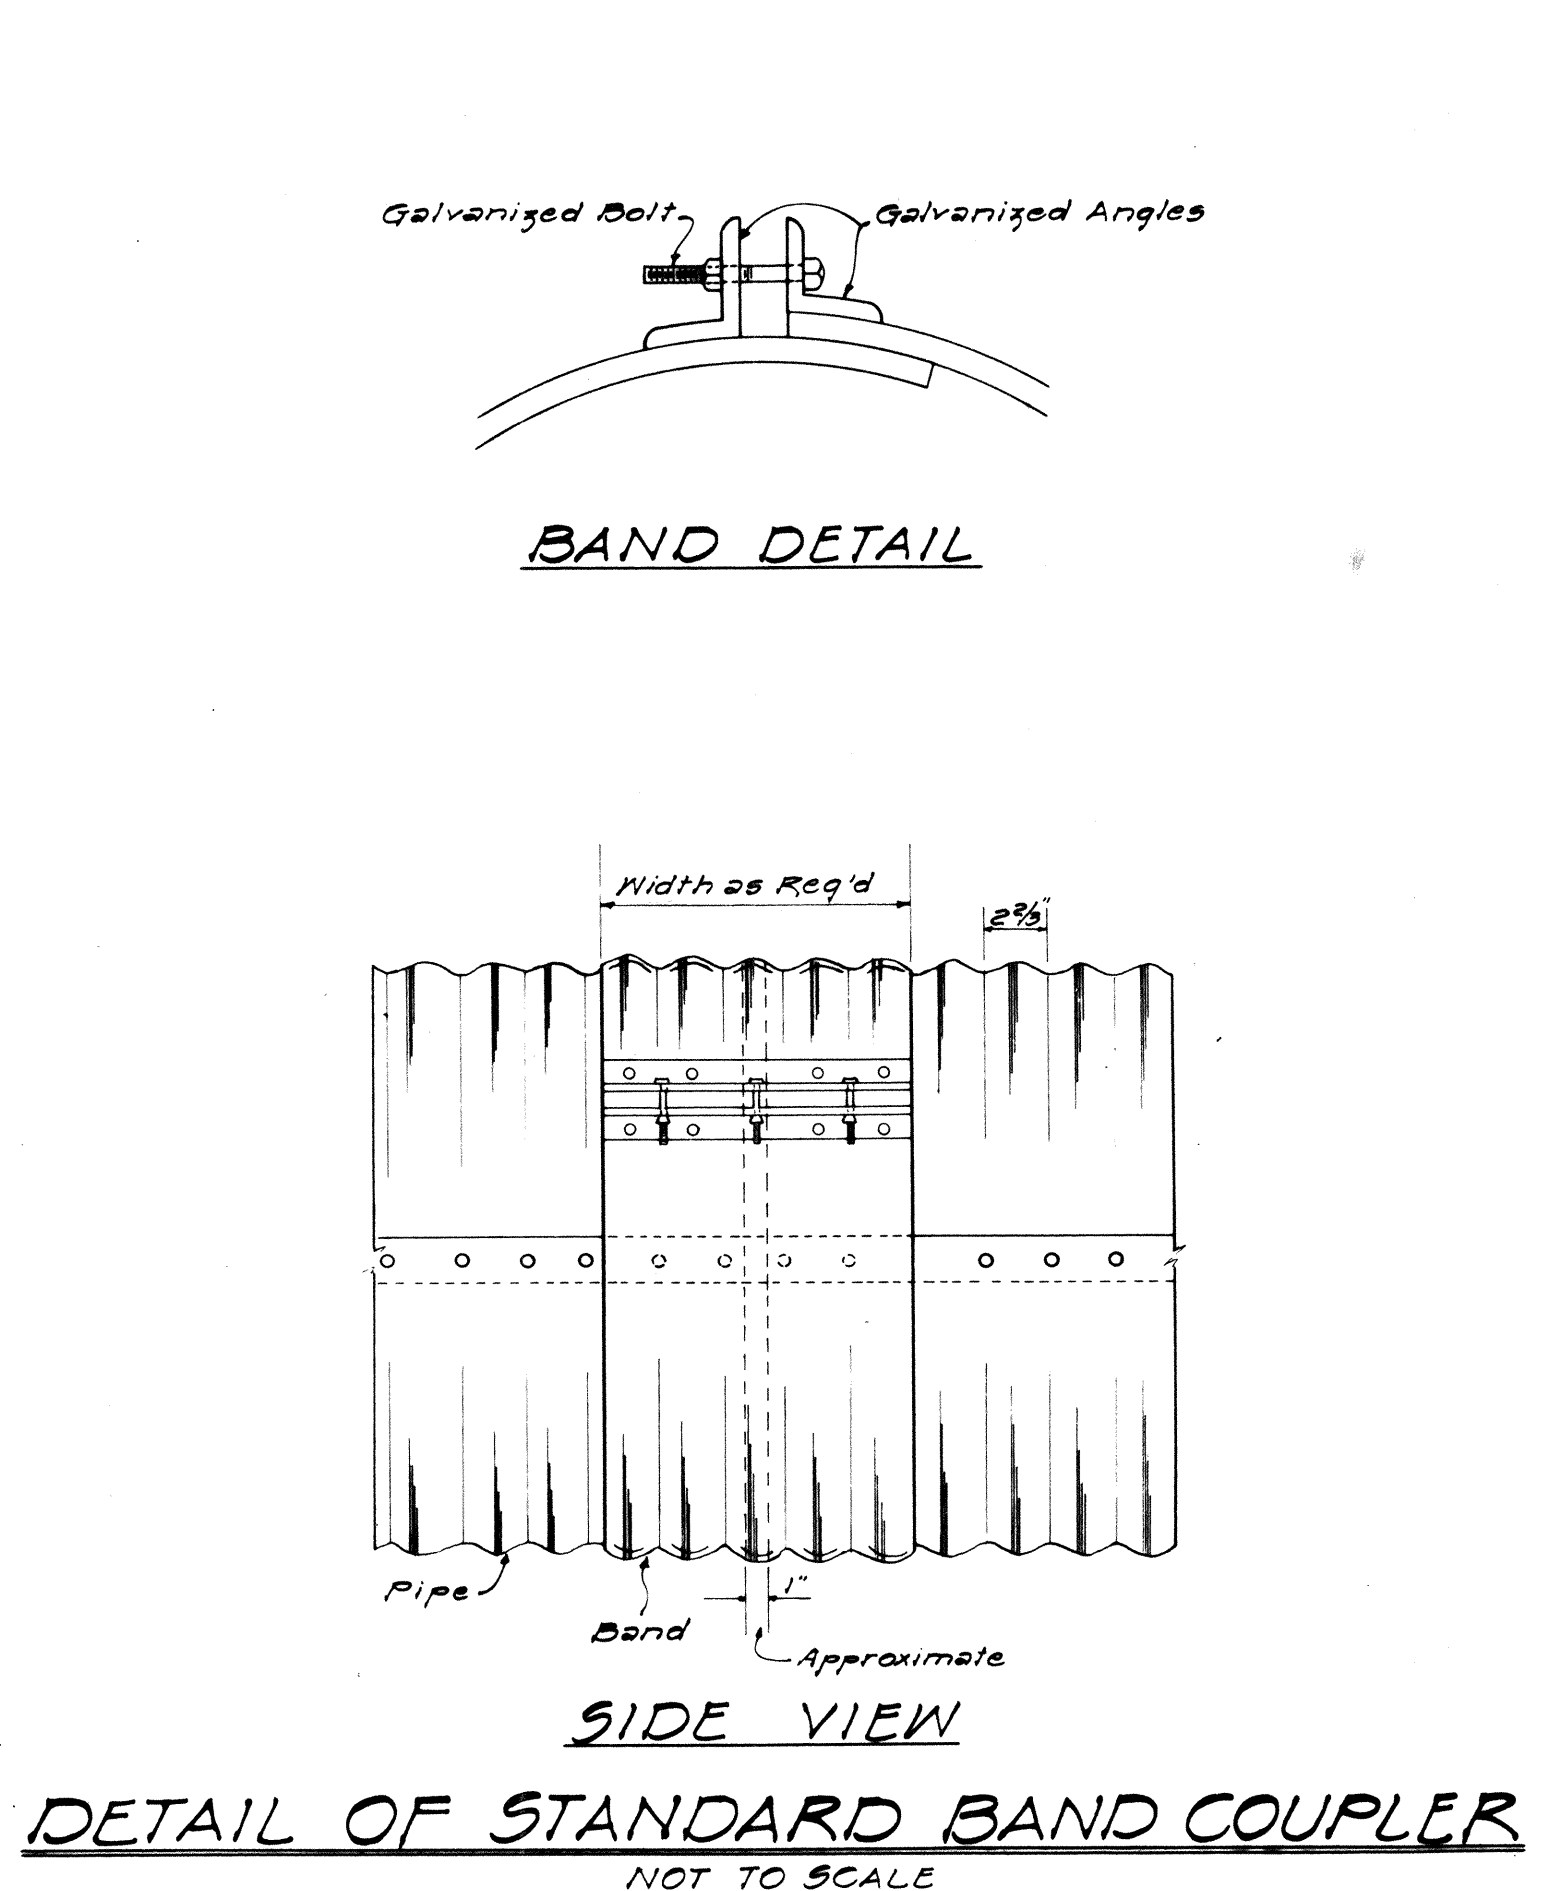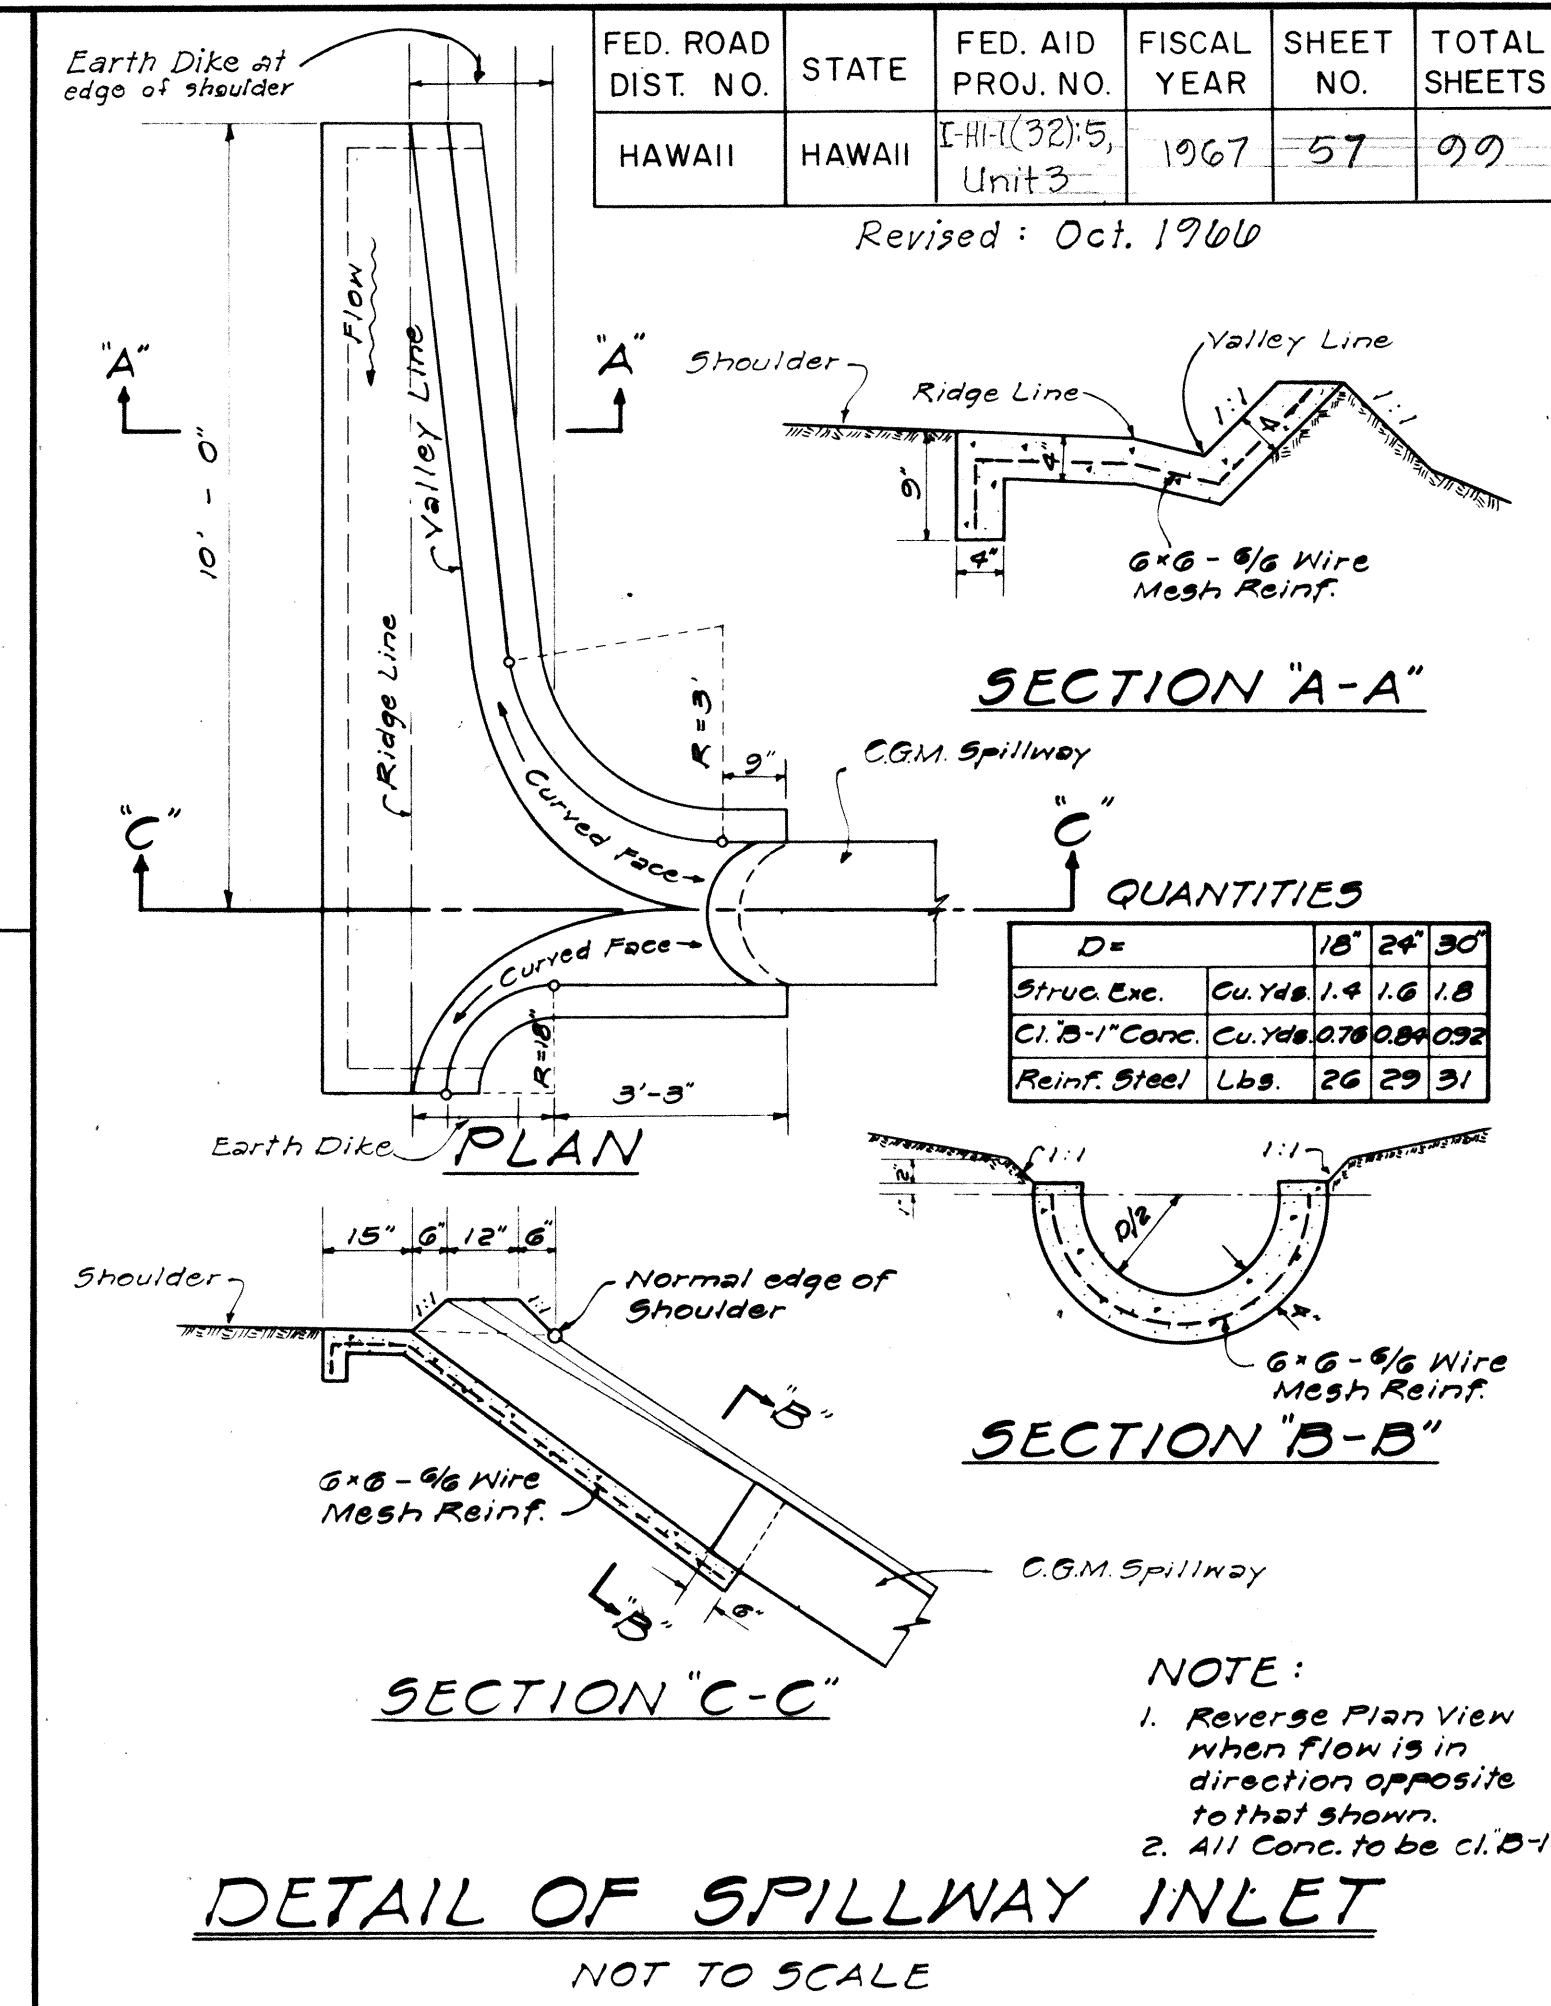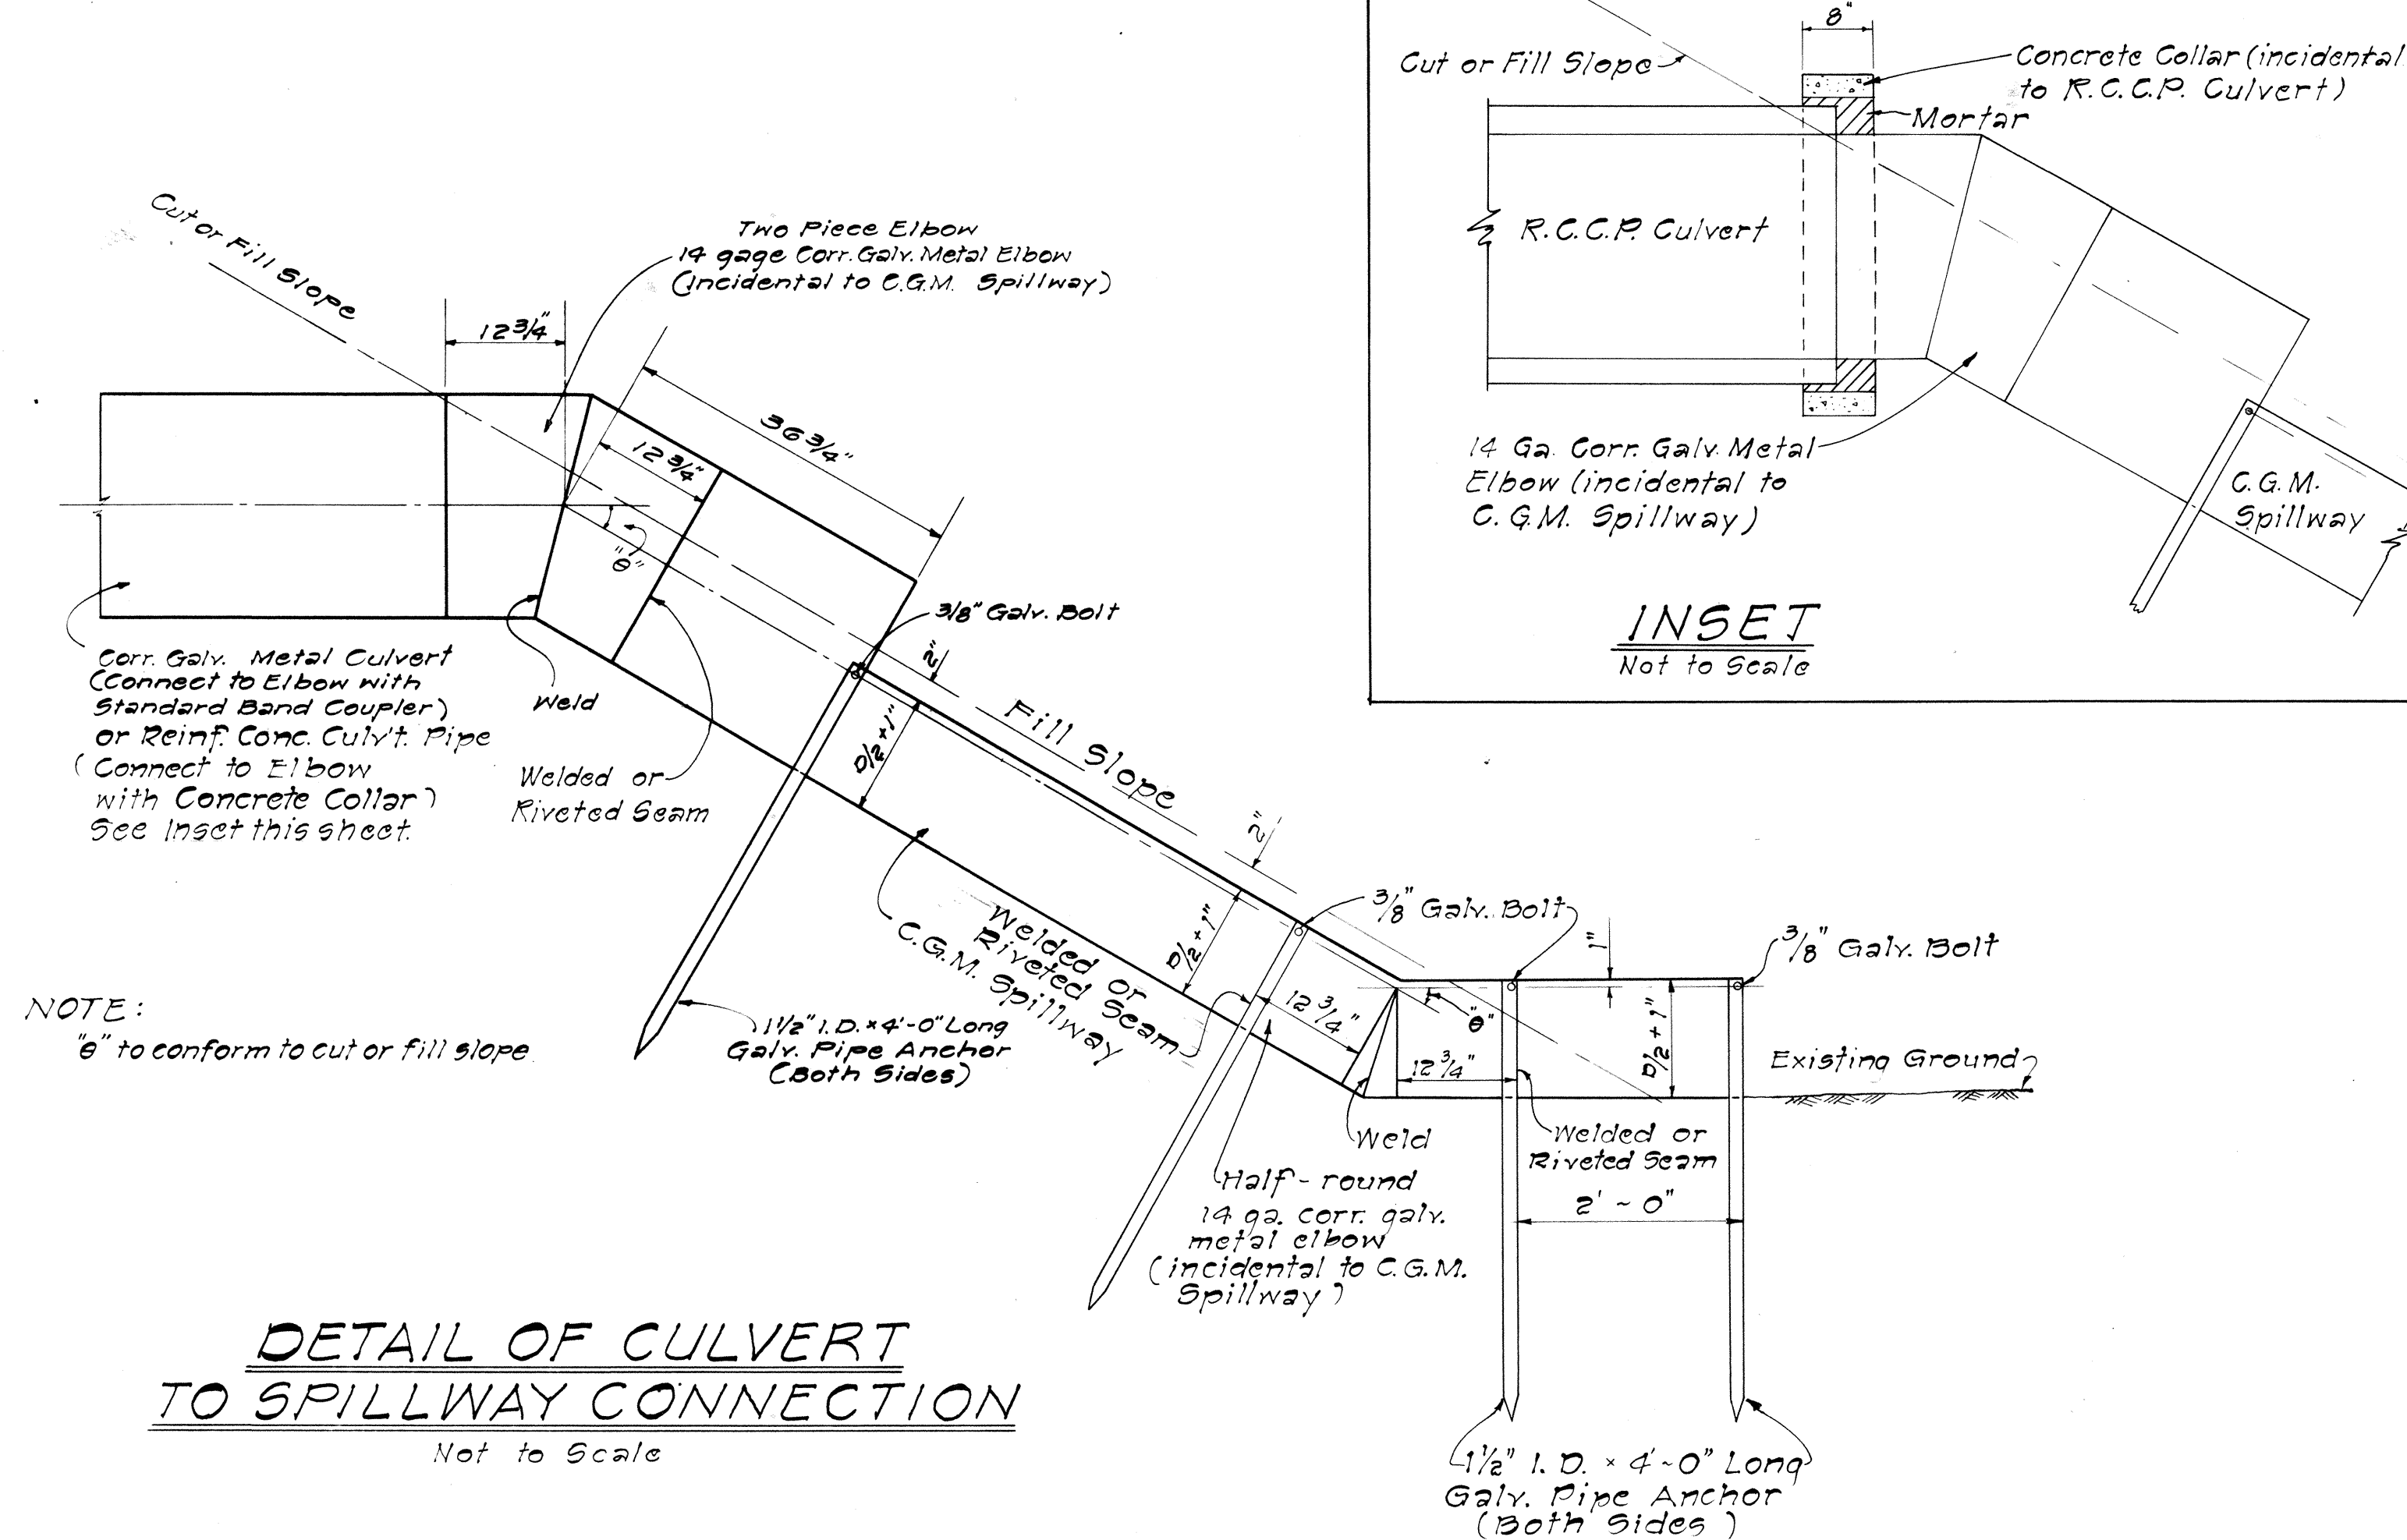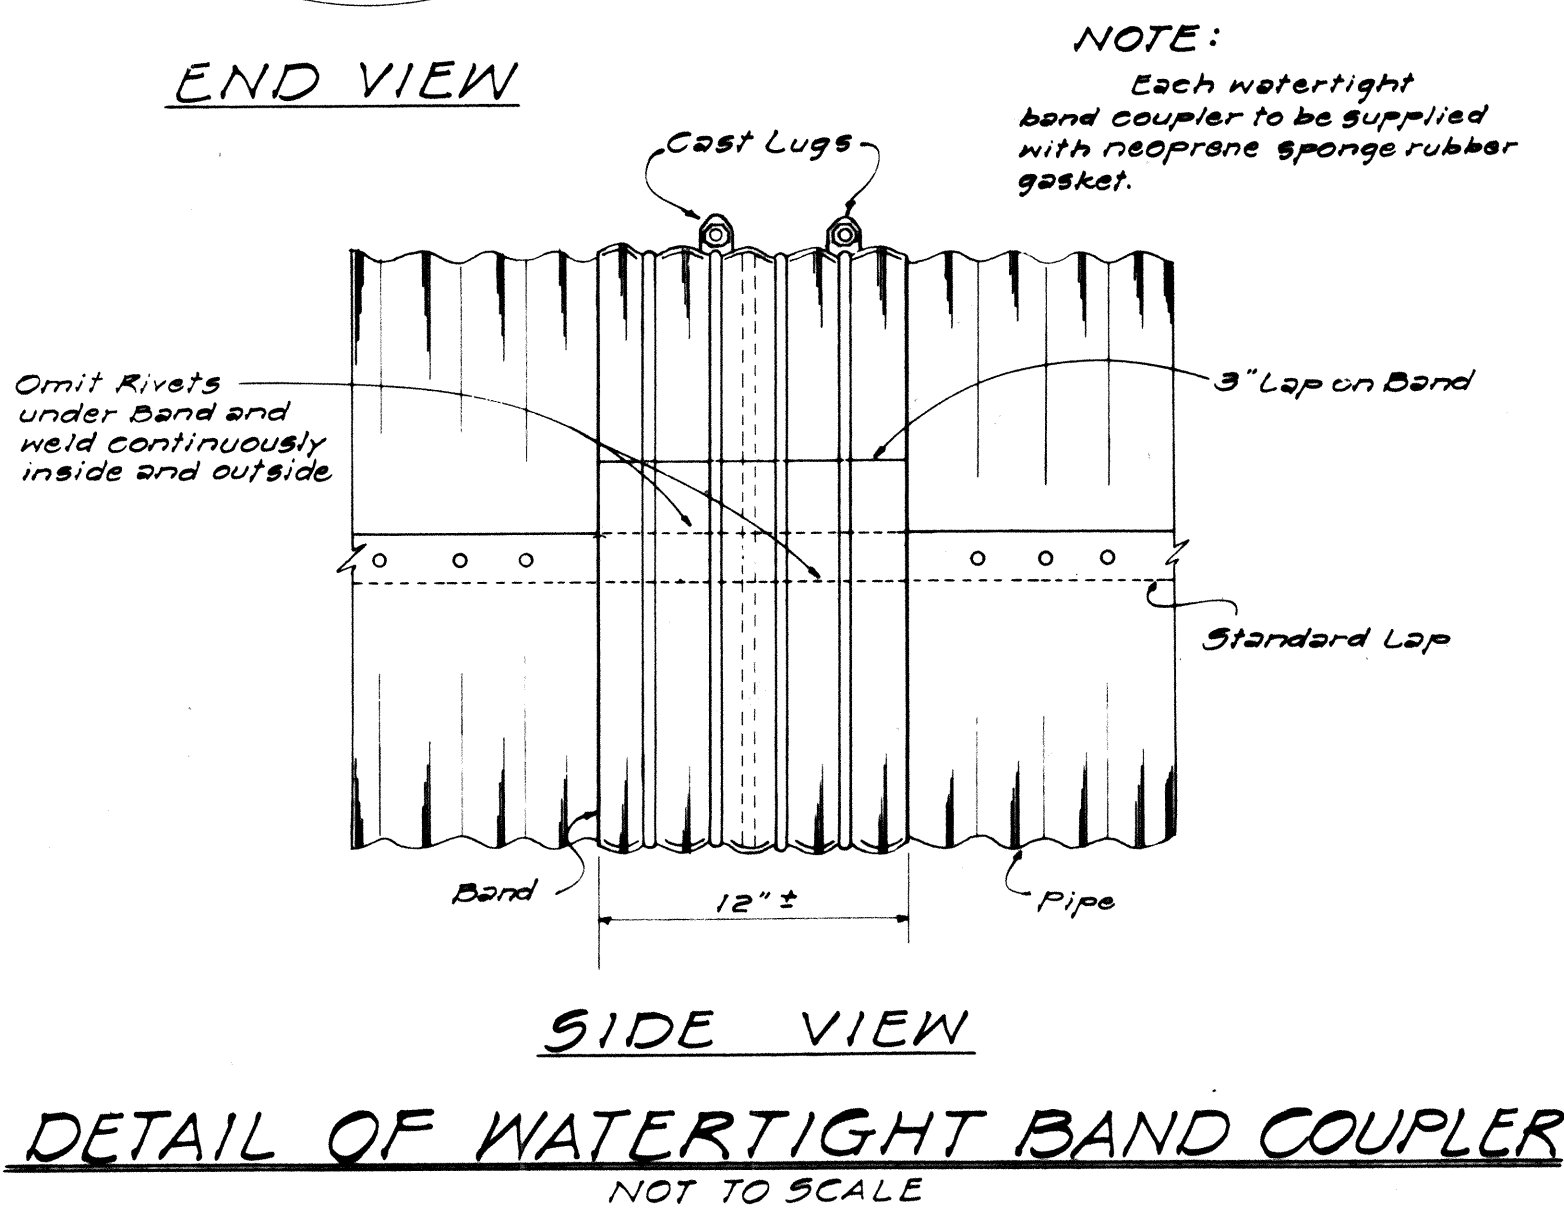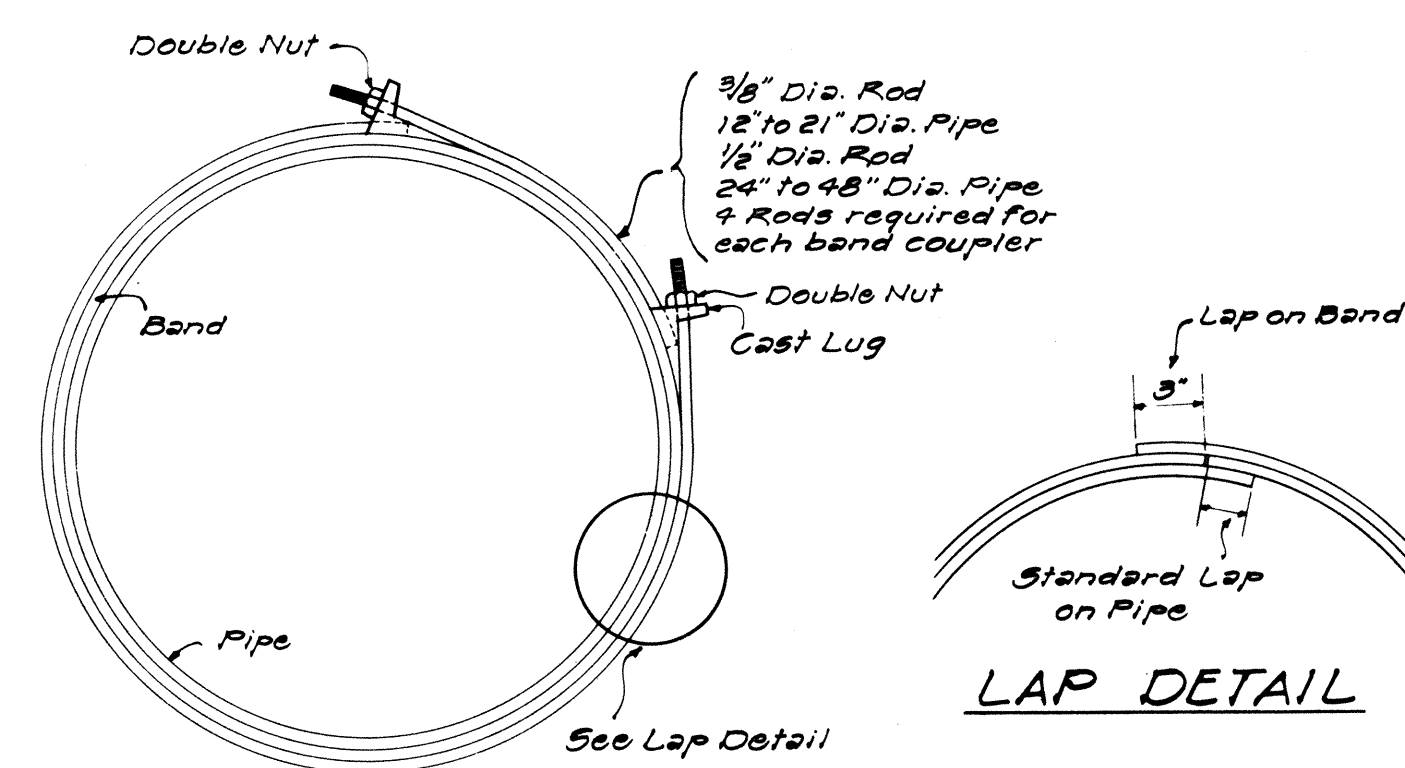

SURVEY PLOTTED BY	DATE
DRAWN BY	5-22-64
TRACED BY	Y
CHECKED BY	OM
NOTE BOOK	5-24-64
NO.	