


FED. ROAD DIST. NO.	STATE	FED. AID PROJ. NO.	FISCAL YEAR	SHEET NO.	TOTAL SHEETS
HAWAII	HAW.	I-HI-1(38)	1967	2	5

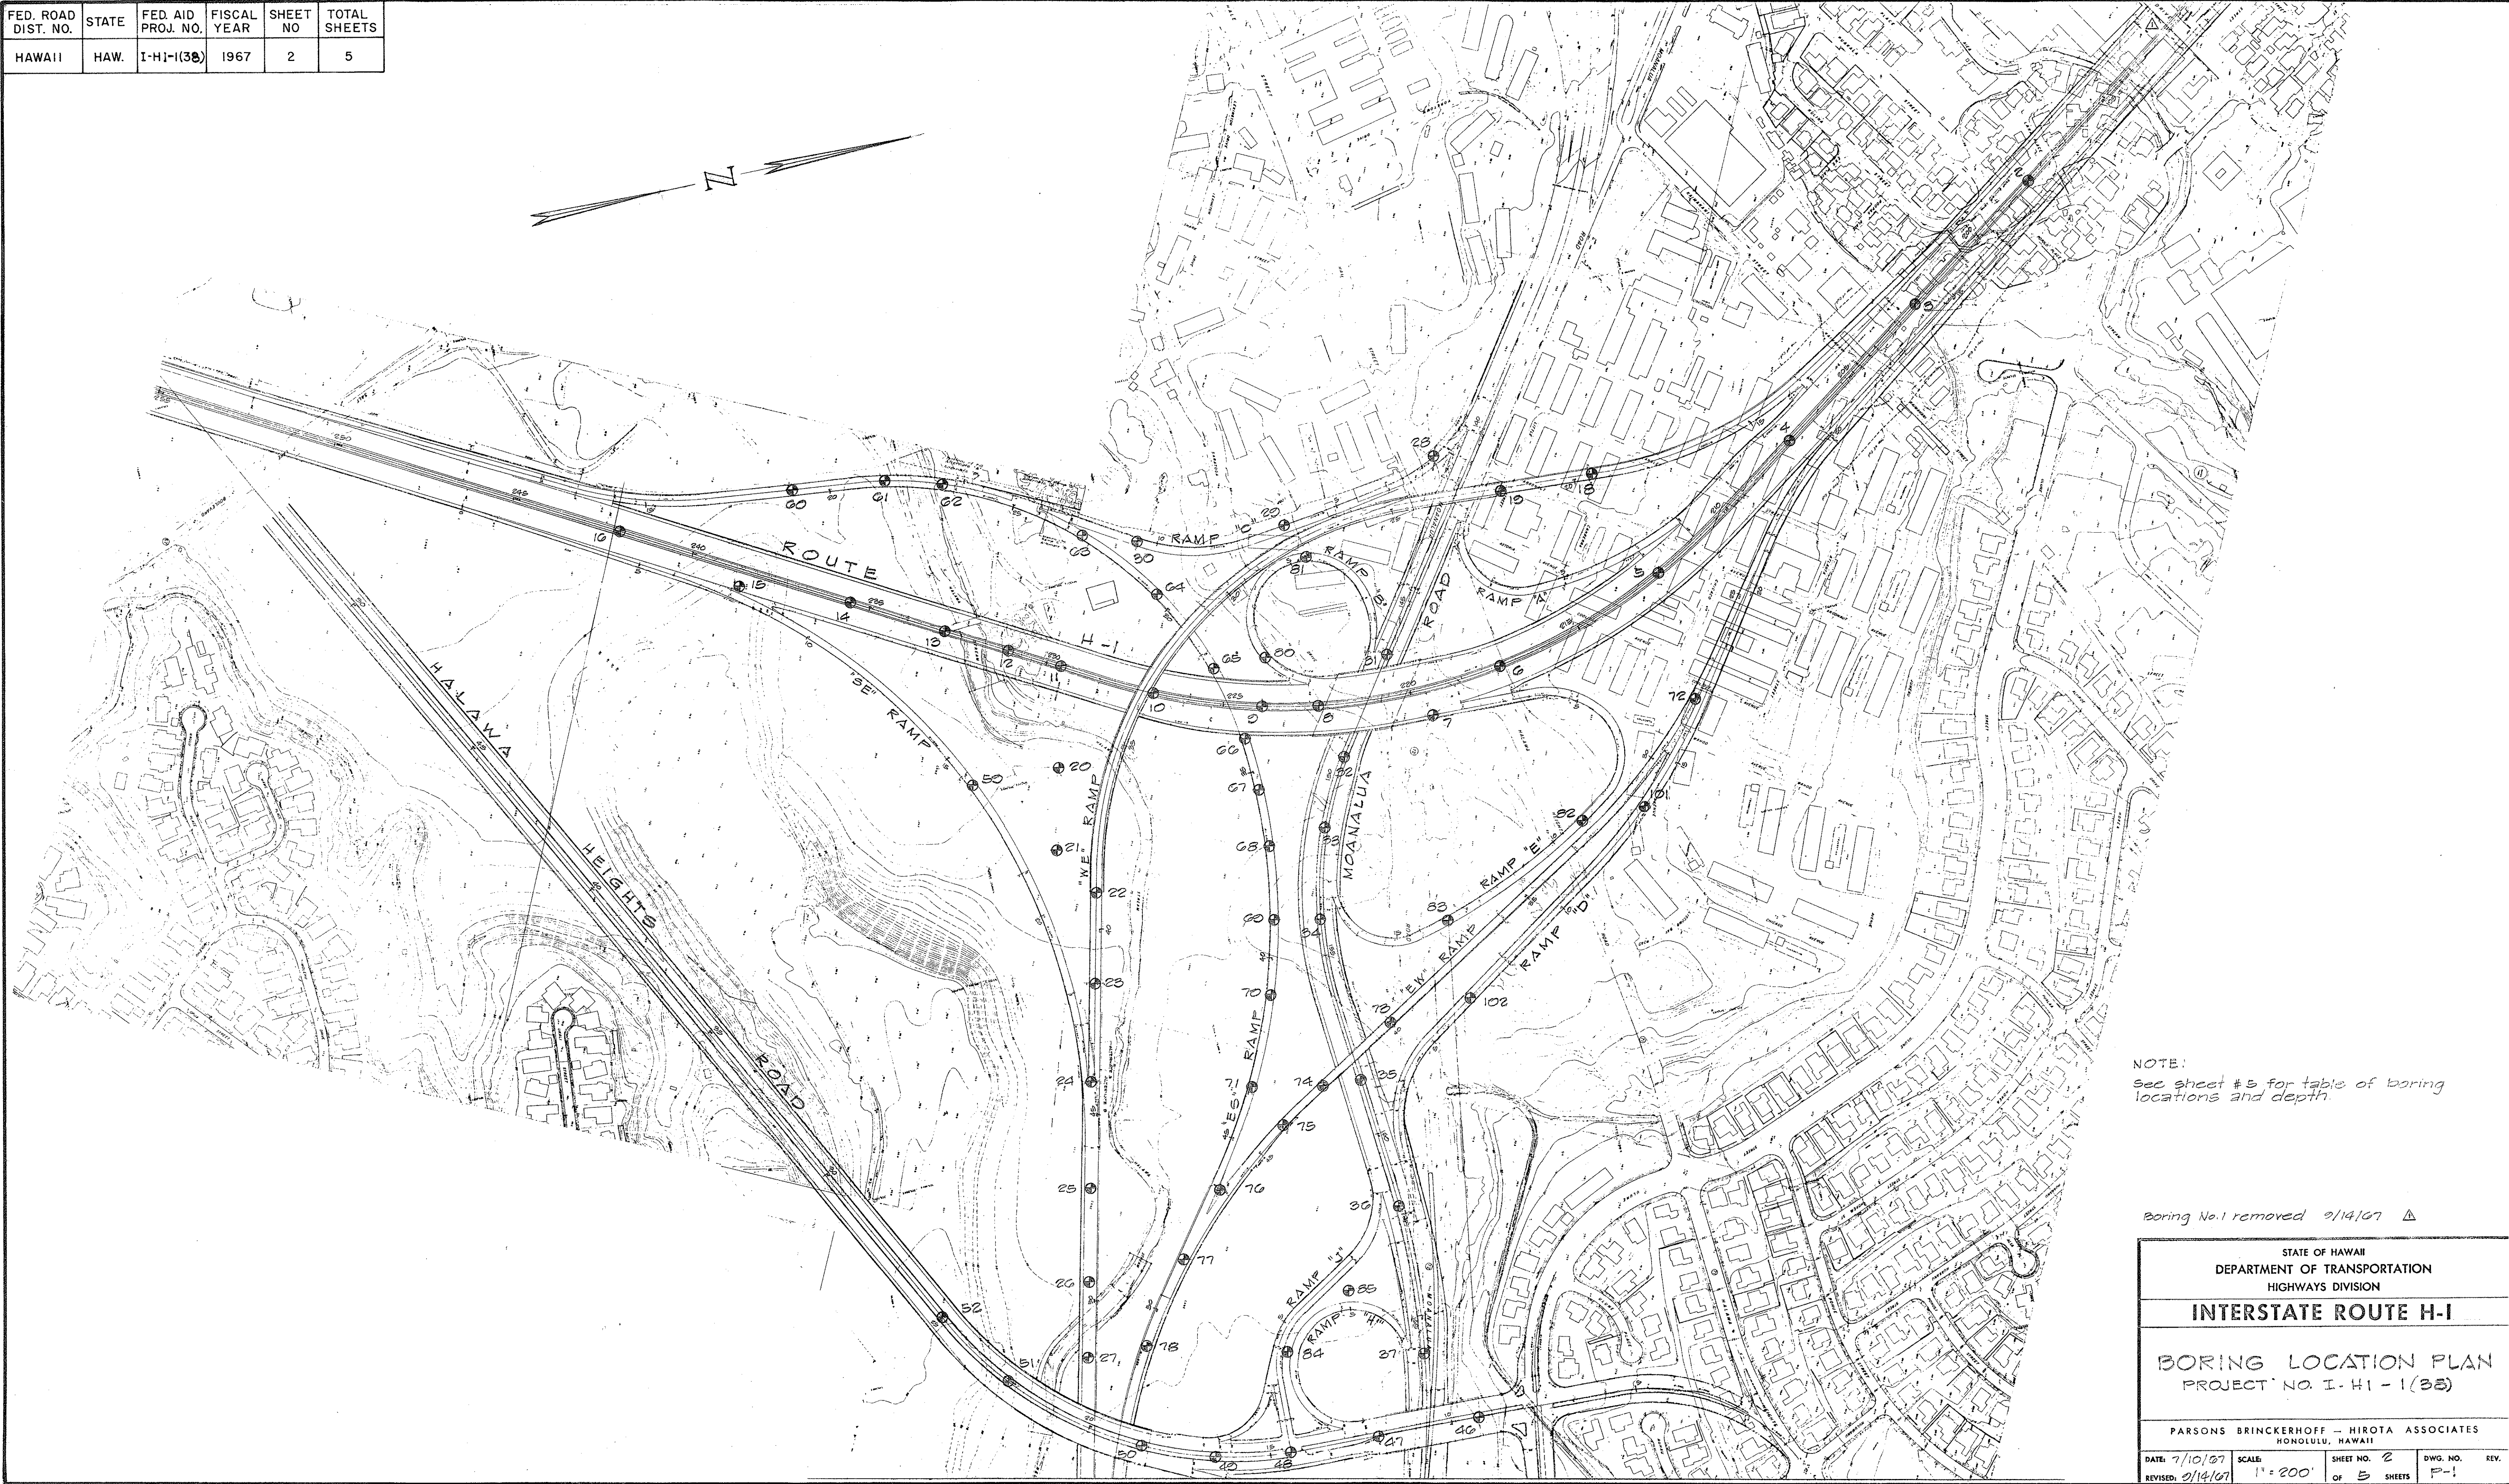


NOTE:
See sheet #3 for table of boring
locations and depth.

Boring No.1 removed 9/14/67

STATE OF HAWAII DEPARTMENT OF TRANSPORTATION HIGHWAYS DIVISION			
INTERSTATE ROUTE H-1			
BORING LOCATION PLAN PROJECT NO. I-HI-1(38)			
PARSONS BRINCKERHOFF - HIROTA ASSOCIATES HONOLULU, HAWAII			
DATE: 7/10/67 REVISED: 9/14/67	SCALE: 1" = 200'	SHEET NO. 2 OF 5 SHEETS	DWG. NO. P-1 REV.

MATCH LINE SEE SHEET NO. 3

FED. ROAD DIST. NO.	STATE	FED. AID PROJ. NO.	FISCAL YEAR	SHEET NO.	TOTAL SHEETS
HAWAII	HAW.	I-H3-1(3)	1967	4	5

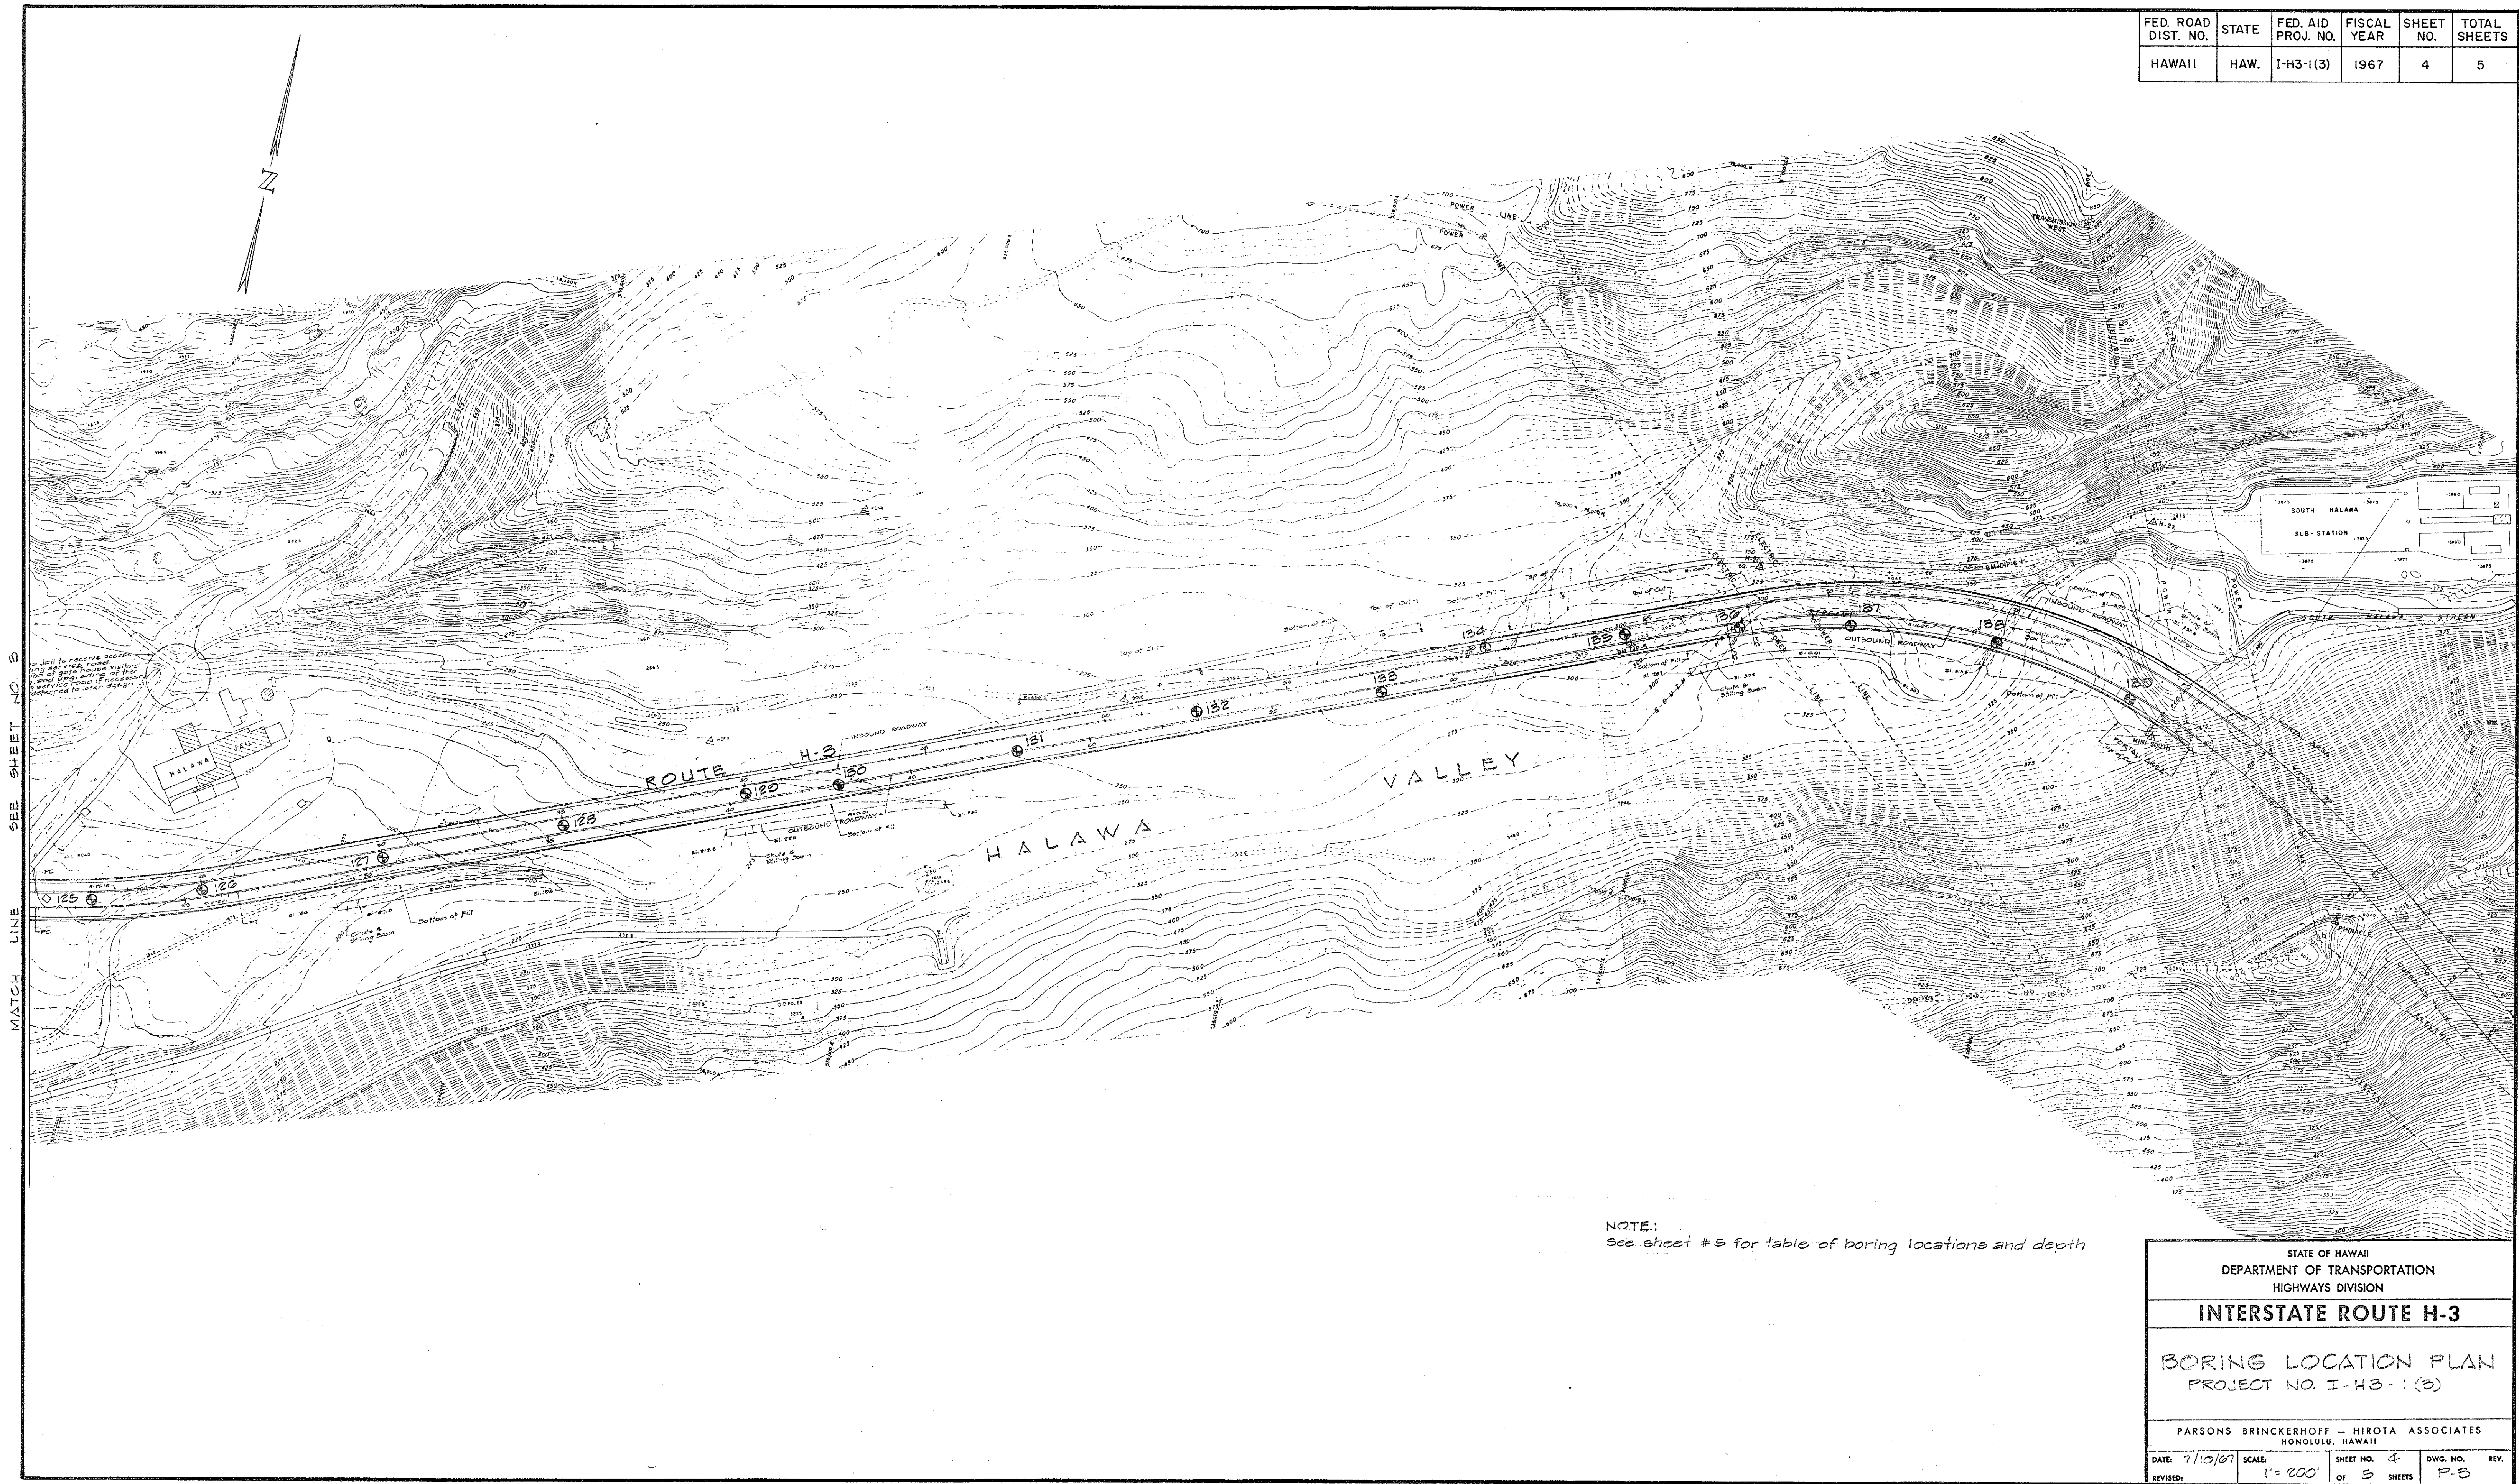

NOTE:
See sheet #5 for table of boring locations and depth

STATE OF HAWAII
DEPARTMENT OF TRANSPORTATION
HIGHWAYS DIVISION

INTERSTATE ROUTE H-3

BORING LOCATION PLAN
PROJECT NO. I-H3-1(3)

PARSONS BRINCKERHOFF - HIROTA ASSOCIATES
HONOLULU, HAWAII

DATE: 7/10/67
REVISED:

SCALE: 1" = 200'

SHEET NO. 4
OF 5 SHEETS

DWG. NO. P-3
REV.