

Ramp "D" @ Sta. 4+55 (Rt.)
Construct Inlet #1 (Type "B")
Install 39 L.F. 24" RCCP C.I. III or
24" CGMR, 14 Ga.

ESTIMATED QUANTITIES
Structure Excavation = 42 CY
Cl. "A-1" Concrete = 5 CY
Reinf. Steel = 200 lbs.
Modified Type "A-2" Steel
Frame & Grates = 1 ea.
24" RCCP C.I. III or
24" CGMR, 14 Ga. = 39 L.F.
Untreated Base = 3 CY

H-1 Inbound @ Sta. 4+76+60 (Rt.)
Construct Inlet #2 (Type "B")
Install 81 L.F. 24" RCCP C.I. III or
24" CGMR, 14 Ga.

ESTIMATED QUANTITIES
Structure Excavation = 108 CY
Cl. "A-1" Concrete = 9 CY
Reinf. Steel = 200 lbs.
Modified Type "A-2" Steel
Frame & Grates = 1 ea.
24" RCCP C.I. III or
24" CGMR, 14 Ga. = 81 L.F.
Untreated Base = 8 CY

H-1 Inbound to H-2 Outbound
@ Sta. 4+76+95 (Lt.)
Construct Inlet #3 (Type "B")
Install 65 L.F. 24" RCCP C.I. III or
24" CGMR, 14 Ga.

ESTIMATED QUANTITIES
Structure Excavation = 75 CY
Cl. "A-1" Concrete = 5 CY
Reinf. Steel = 200 lbs.
Modified Type "A-2" Steel
Frame & Grates = 1 ea.
24" RCCP C.I. III or
24" CGMR, 14 Ga. = 65 L.F.
Untreated Base = 9 CY

H-2 Inbound to H-1 Outbound
@ Sta. 4+77+30 (Lt.)
Construct Inlet #4 (Type "B")
Install 95 L.F. 24" RCCP C.I. III or
24" CGMR, 14 Ga.

ESTIMATED QUANTITIES
Structure Excavation = 144 CY
Cl. "A-1" Concrete = 9 CY
Reinf. Steel = 200 lbs.
Modified Type "A-2" Steel
Frame & Grates = 1 ea.
24" RCCP C.I. III or
24" CGMR, 14 Ga. = 95 L.F.
Untreated Base = 9 CY

H-2 Inbound to H-1 Outbound
@ Sta. 4+80+60 (Lt.)
Construct Inlet #5 (Type "B")
Install 122 L.F. 24" RCCP C.I. III or
24" CGMR, 14 Ga.


ESTIMATED QUANTITIES
Structure Excavation = 218 CY
Cl. "A-1" Concrete = 9 CY
Reinf. Steel = 200 lbs.
Modified Type "A-2" Steel
Frame & Grates = 1 ea.
24" RCCP C.I. III or
24" CGMR, 14 Ga. = 122 L.F.
Untreated Base = 13 CY

Ramp "M" @ Sta. 3+70 (Lt.)
Construct Inlet "A"
Install 75 L.F. 24" RCCP C.I. IV or
24" CGMR, 14 Ga.

ESTIMATED QUANTITIES
Structure Excavation = 59 CY
Cl. "A-1" Concrete = 2 CY
Reinf. Steel = 75 lbs.
24" RCCP C.I. IV or
24" CGMR, 14 Ga. = 75 L.F.
Untreated Base = 8 CY

H-1 Inbound to H-2 Outbound
@ Sta. 4+83+45 (Lt.)
Construct Inlet #9 (Type "B")
Install 64 L.F. 36" RCCP C.I. III or
36" CGMR, 12 Ga.

ESTIMATED QUANTITIES
Structure Excavation = 100 CY
Cl. "A-1" Concrete = 6 CY
Reinf. Steel = 200 lbs.
Modified Type "A-2" Steel
Frame & Grates = 1 ea.
36" RCCP C.I. III or
36" CGMR, 12 Ga. = 64 L.F.
Untreated Base = 8 CY

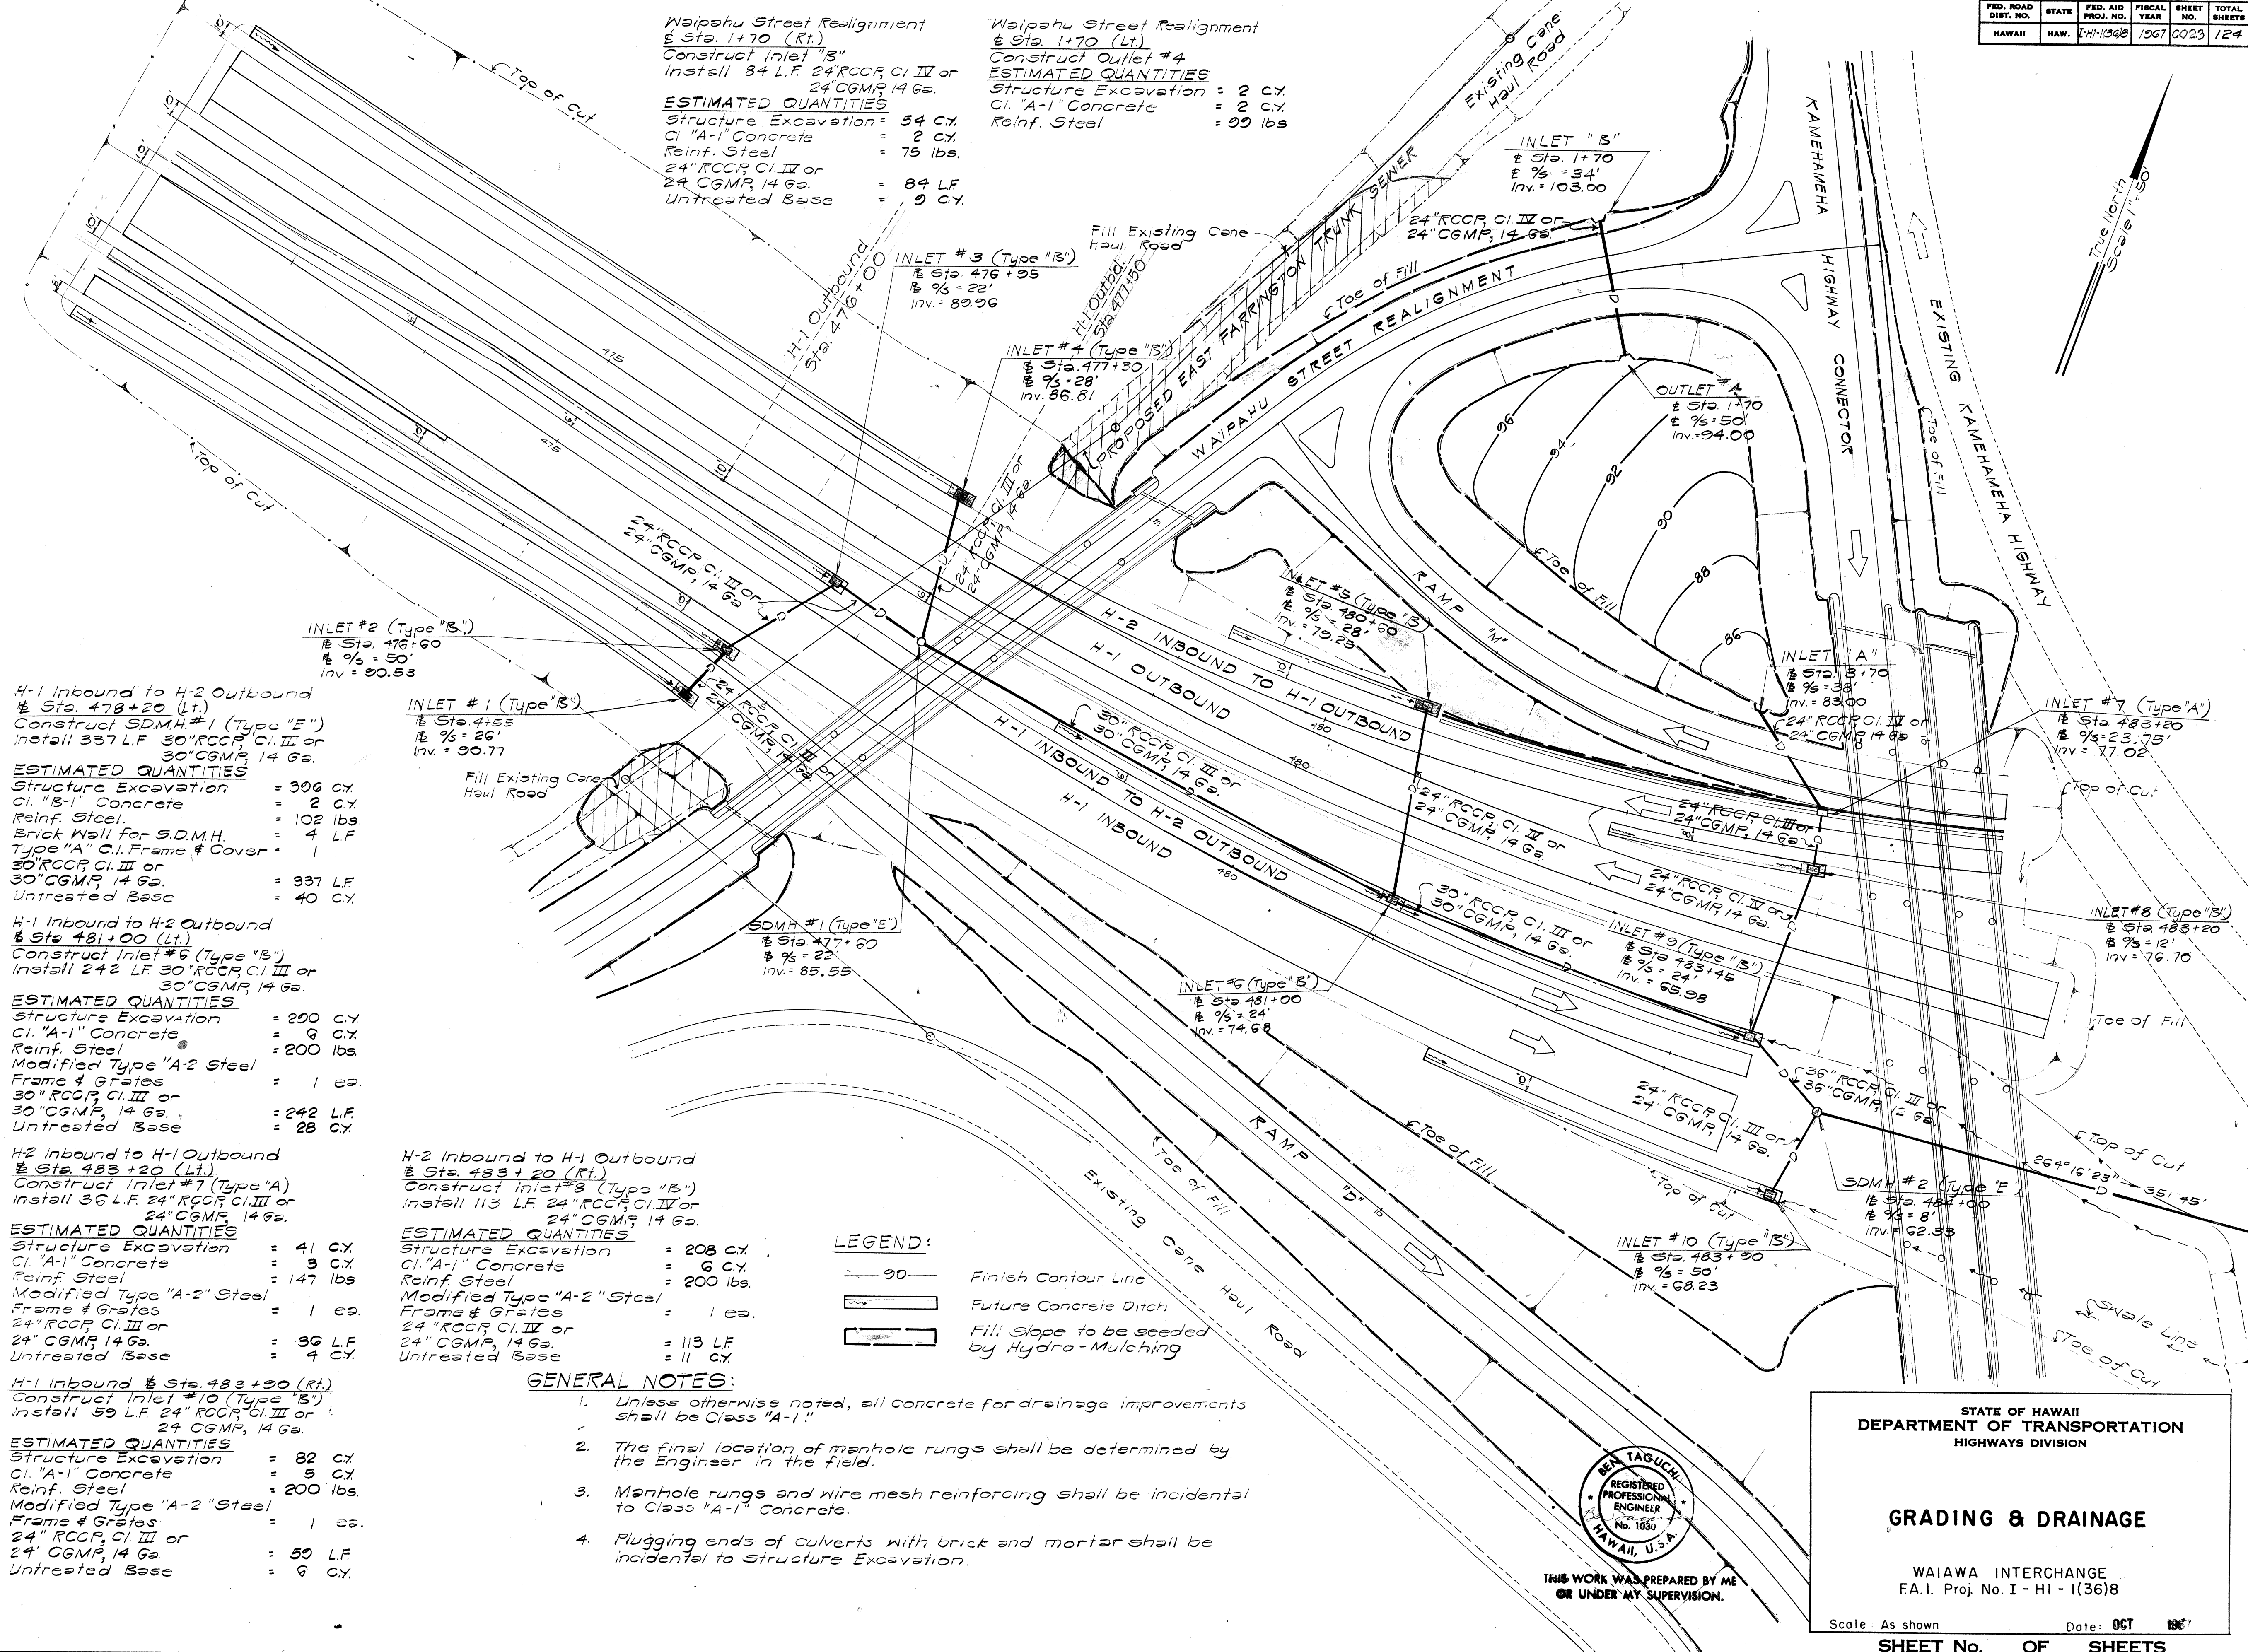

Waipahu Street Realignment
@ Sta. 1+70 (Rt.)
Construct Inlet #3
Install 84 L.F. 24" RCCP C.I. IV or
24" CGMR, 14 Ga.

ESTIMATED QUANTITIES
Structure Excavation = 54 CY
Cl. "A-1" Concrete = 2 CY
Reinf. Steel = 75 lbs.
24" RCCP C.I. IV or
24" CGMR, 14 Ga. = 84 L.F.
Untreated Base = 9 CY

Waipahu Street Realignment
@ Sta. 1+70 (Lt.)
Construct Outlet #4
ESTIMATED QUANTITIES
Structure Excavation = 2 CY
Cl. "A-1" Concrete = 2 CY
Reinf. Steel = 90 lbs

H-1 Inbound to H-2 Outbound
@ Sta. 4+78+20 (Lt.)
Construct S.D.M.H. #1 (Type "E")
Install 337 L.F. 30" RCCP C.I. III or
30" CGMR, 14 Ga.

ESTIMATED QUANTITIES
Structure Excavation = 396 CY
Cl. "B-1" Concrete = 2 CY
Reinf. Steel = 102 lbs.
Brick Wall For S.D.M.H.
Type "A" C.I. Frame & Cover = 1
30" RCCP C.I. III or
30" CGMR, 14 Ga. = 337 L.F.
Untreated Base = 40 CY

H-1 Inbound to H-2 Outbound
@ Sta. 4+81+00 (Lt.)
Construct Inlet #6 (Type "B")
Install 242 L.F. 30" RCCP C.I. III or
30" CGMR, 14 Ga.

ESTIMATED QUANTITIES
Structure Excavation = 290 CY
Cl. "A-1" Concrete = 9 CY
Reinf. Steel = 200 lbs.
Modified Type "A-2" Steel
Frame & Grates = 1 ea.
30" RCCP C.I. III or
30" CGMR, 14 Ga. = 242 L.F.
Untreated Base = 28 CY

H-2 Inbound to H-1 Outbound
@ Sta. 4+83+20 (Lt.)
Construct Inlet #7 (Type "A")
Install 36 L.F. 24" RCCP C.I. III or
24" CGMR, 14 Ga.

ESTIMATED QUANTITIES
Structure Excavation = 41 CY
Cl. "A-1" Concrete = 9 CY
Reinf. Steel = 147 lbs.
Modified Type "A-2" Steel
Frame & Grates = 1 ea.
24" RCCP C.I. III or
24" CGMR, 14 Ga. = 36 L.F.
Untreated Base = 4 CY

H-1 Inbound to H-2 Outbound
@ Sta. 4+83+90 (Rt.)
Construct Inlet #10 (Type "B")
Install 59 L.F. 24" RCCP C.I. III or
24" CGMR, 14 Ga.

ESTIMATED QUANTITIES
Structure Excavation = 82 CY
Cl. "A-1" Concrete = 5 CY
Reinf. Steel = 200 lbs.
Modified Type "A-2" Steel
Frame & Grates = 1 ea.
24" RCCP C.I. III or
24" CGMR, 14 Ga. = 59 L.F.
Untreated Base = 9 CY

H-2 Inbound to H-1 Outbound
@ Sta. 4+83+20 (Rt.)
Construct Inlet #8 (Type "B")
Install 113 L.F. 24" RCCP C.I. IV or
24" CGMR, 14 Ga.


ESTIMATED QUANTITIES
Structure Excavation = 208 CY
Cl. "A-1" Concrete = 6 CY
Reinf. Steel = 200 lbs.
Modified Type "A-2" Steel
Frame & Grates = 1 ea.
24" RCCP C.I. IV or
24" CGMR, 14 Ga. = 113 L.F.
Untreated Base = 11 CY

GENERAL NOTES:

- Unless otherwise noted, all concrete for drainage improvements shall be Class "A-1".
- The final location of manhole rungs shall be determined by the Engineer in the field.
- Manhole rungs and wire mesh reinforcing shall be incidental to Class "A-1" Concrete.
- Plugging ends of culverts with brick and mortar shall be incidental to Structure Excavation.

LEGEND:

- 90 — Finish Contour Line
- Future Concrete Ditch
- Fill Slope to be seeded by Hydro-Mulching

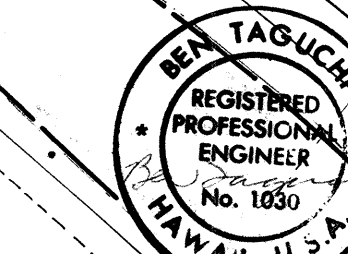

THIS WORK WAS PREPARED BY ME
OR UNDER MY SUPERVISION.

STATE OF HAWAII
DEPARTMENT OF TRANSPORTATION
HIGHWAYS DIVISION


GRADING & DRAINAGE

WAIAWA INTERCHANGE
F.A.I. Proj. No. I - HI - 1(36)8

Scale: As shown Date: OCT 1967

SHEET No. OF SHEETS







0023

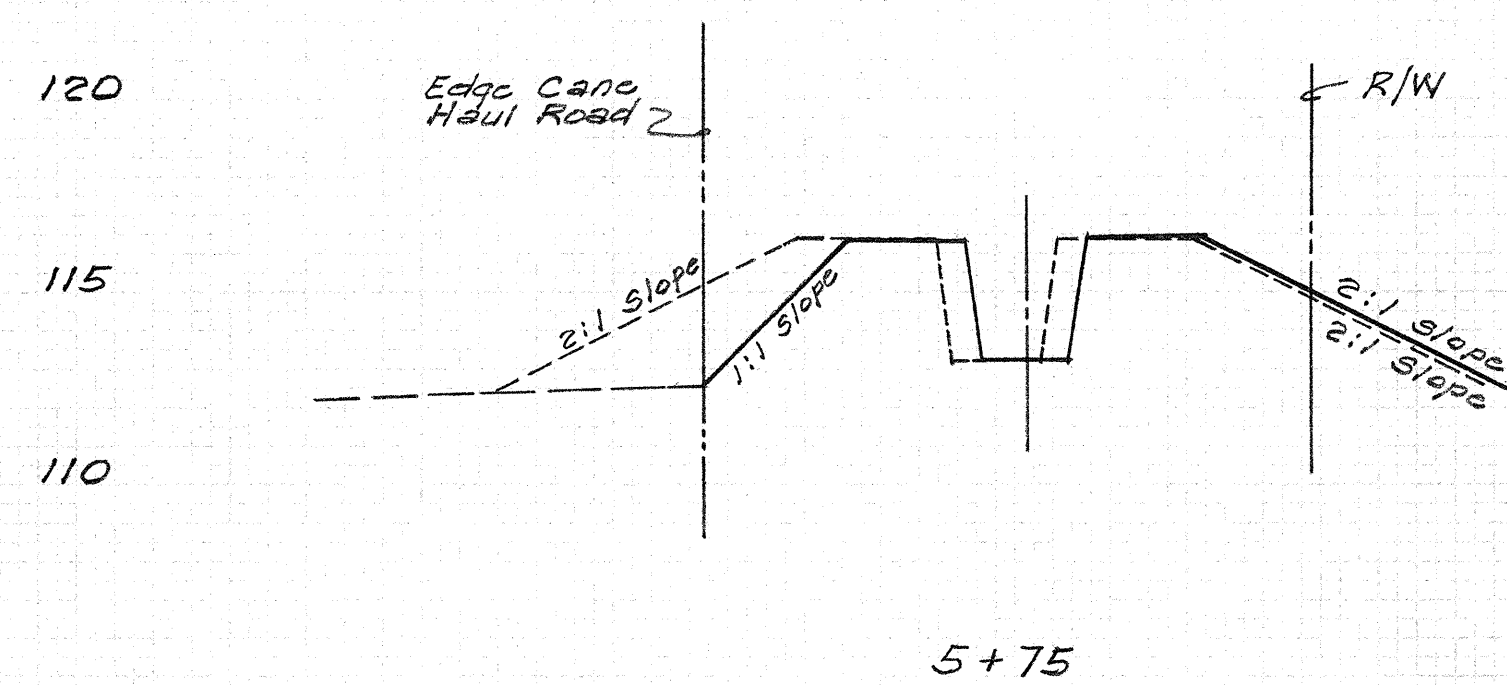

NOTE:

Sections shown with broken lines denote channel sections as per original plan.


Sections shown with solid lines denote proposed revision.

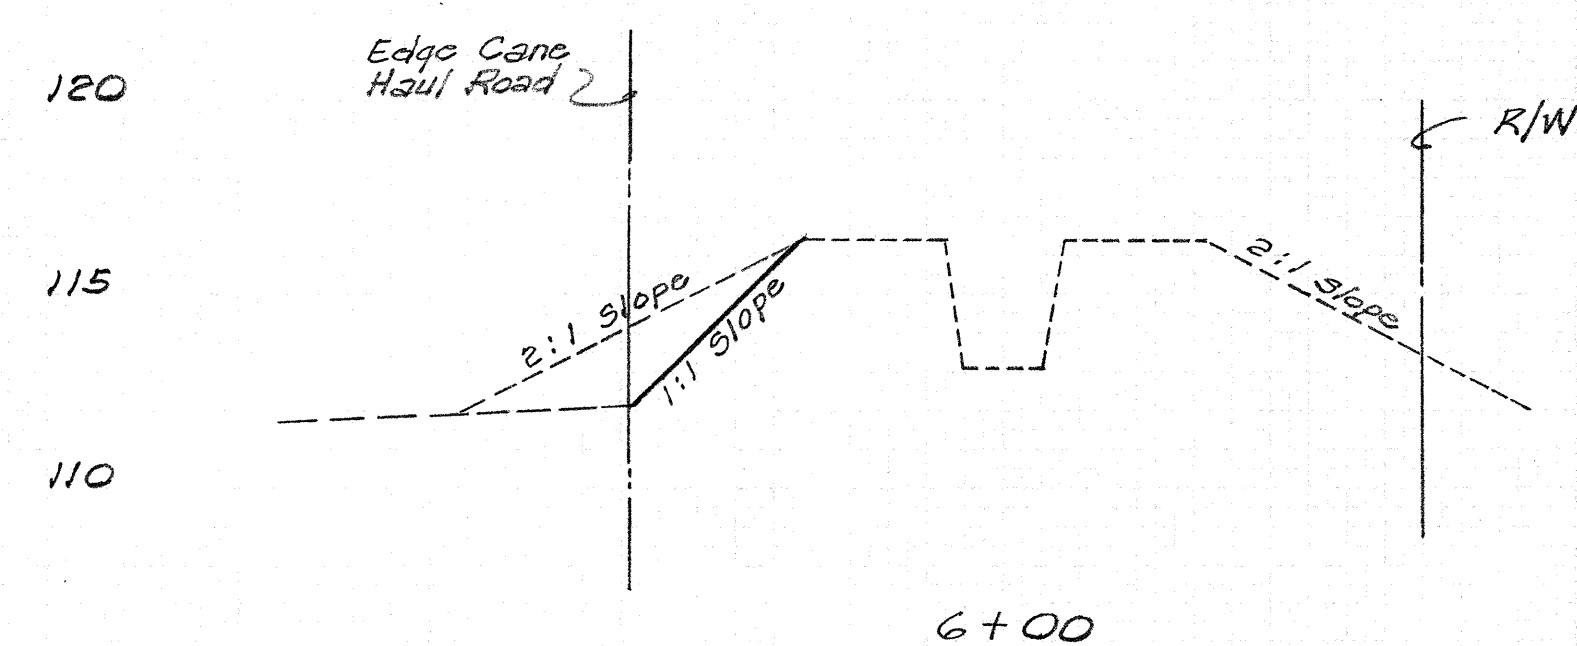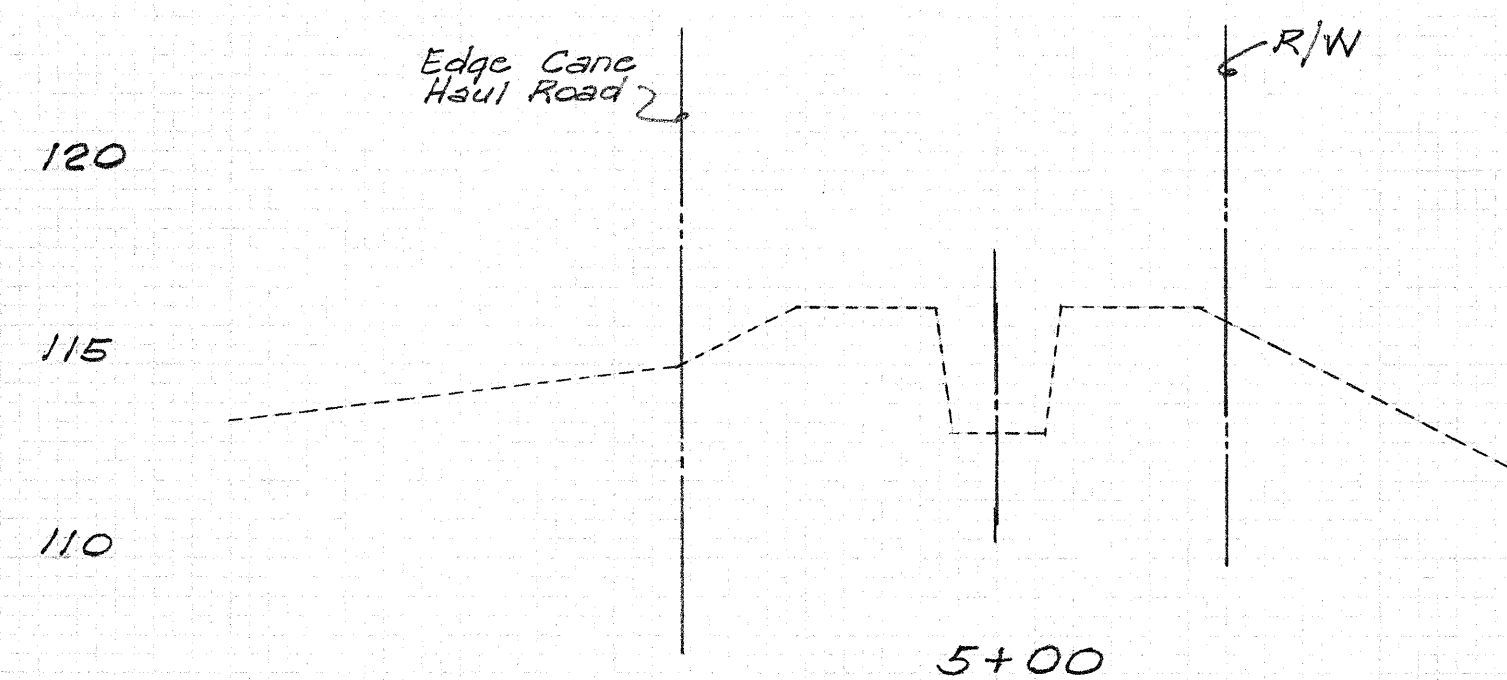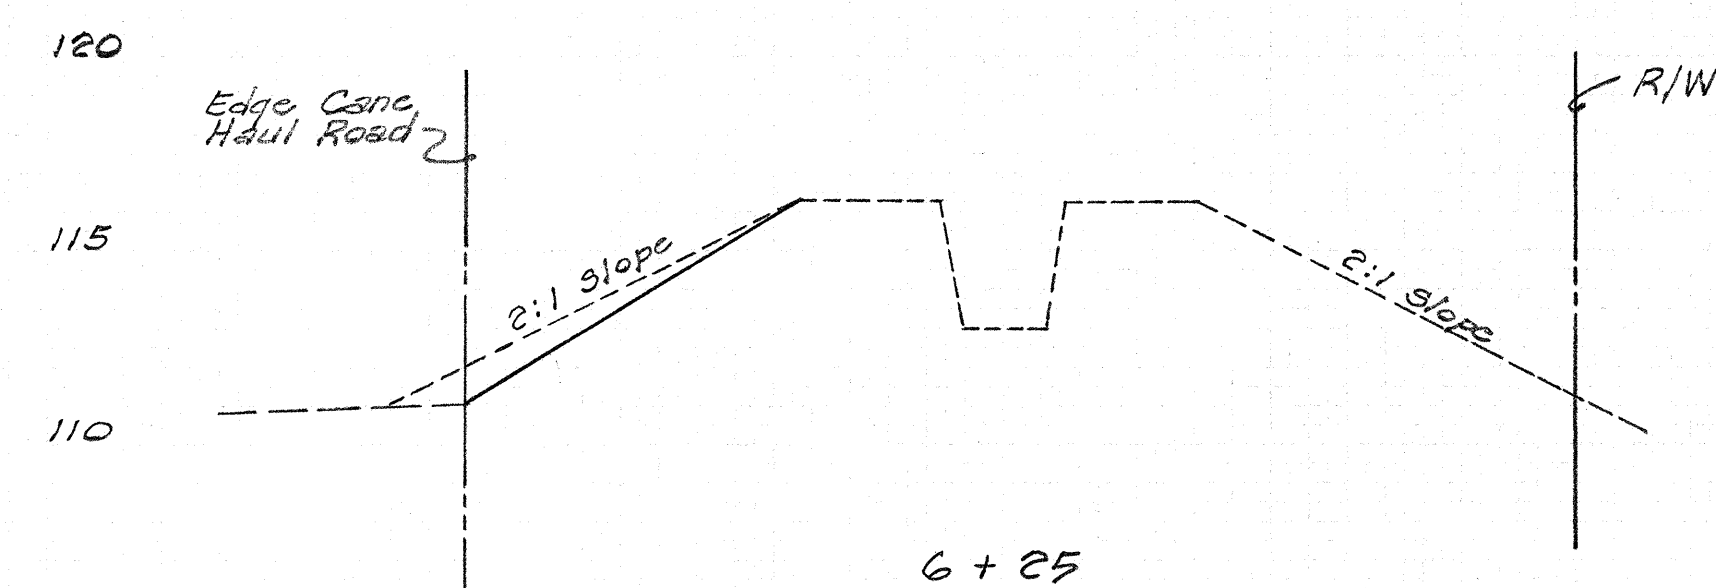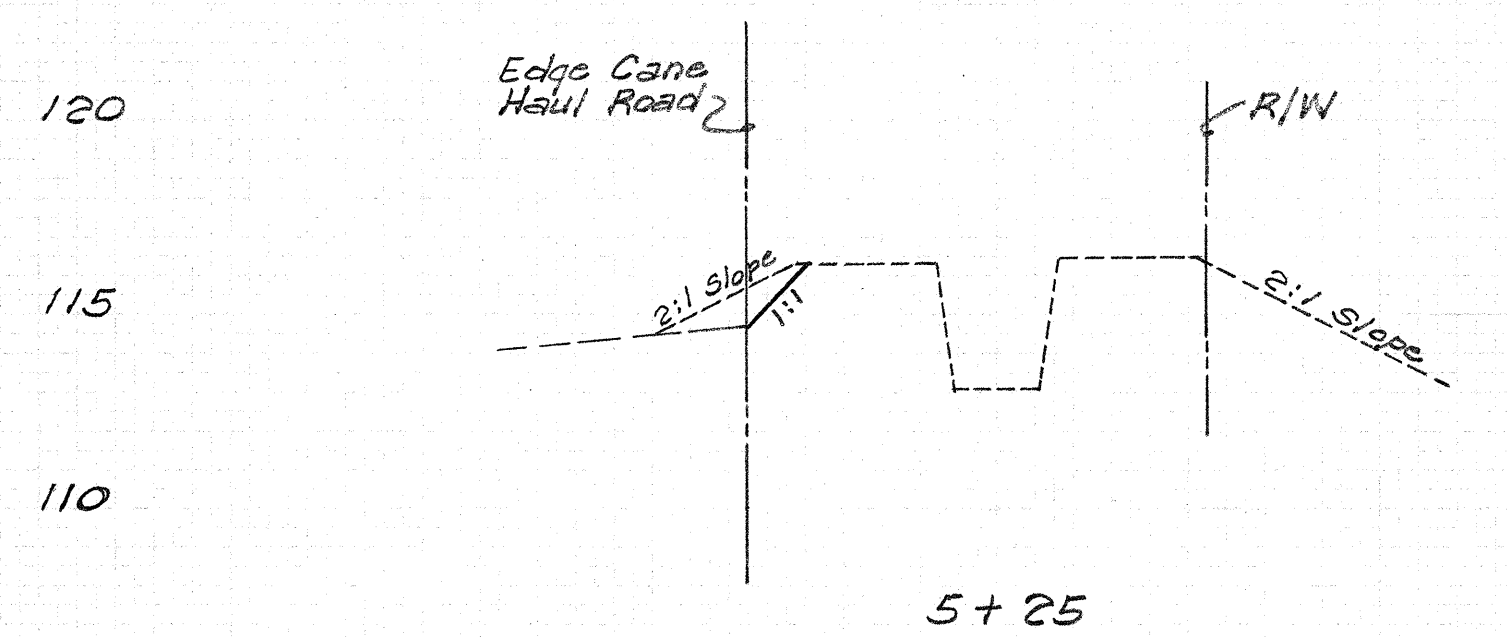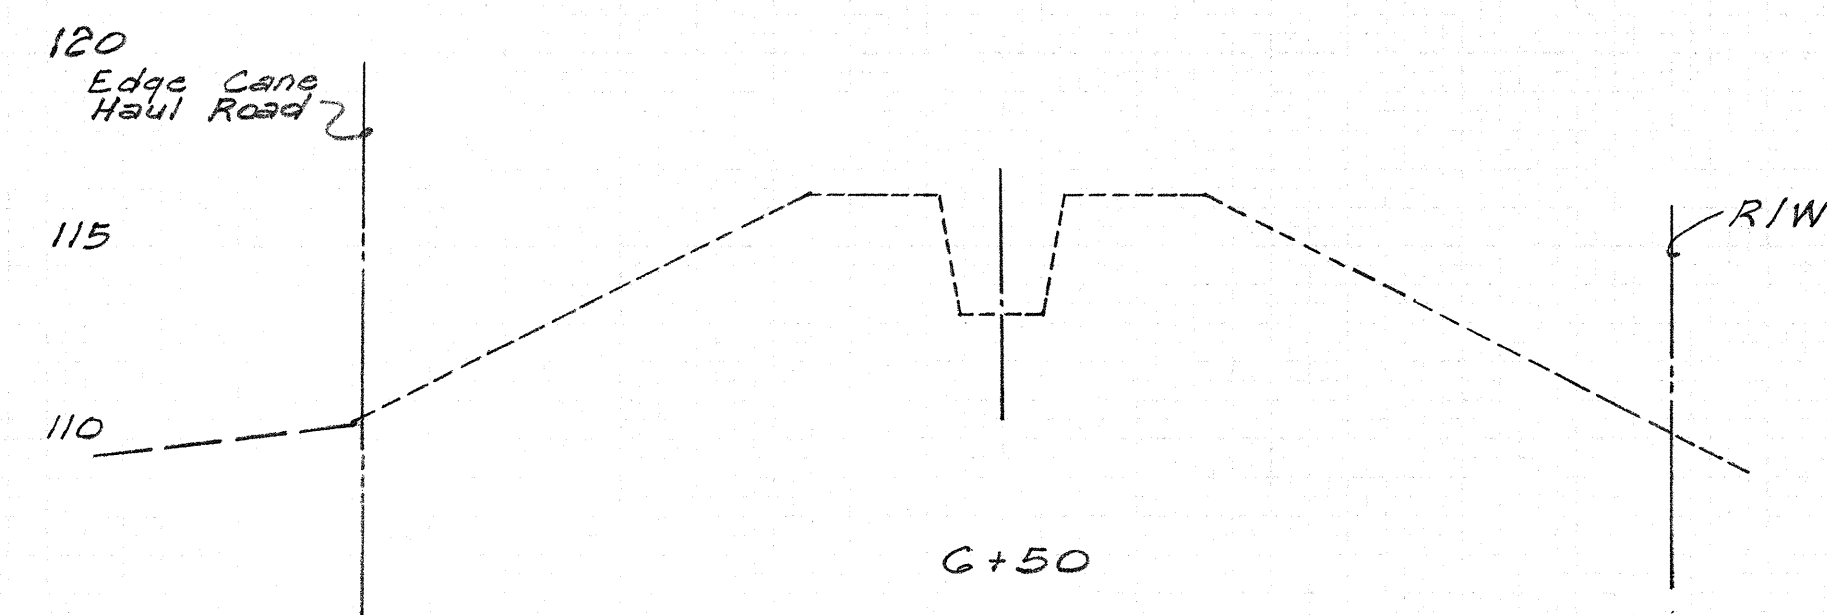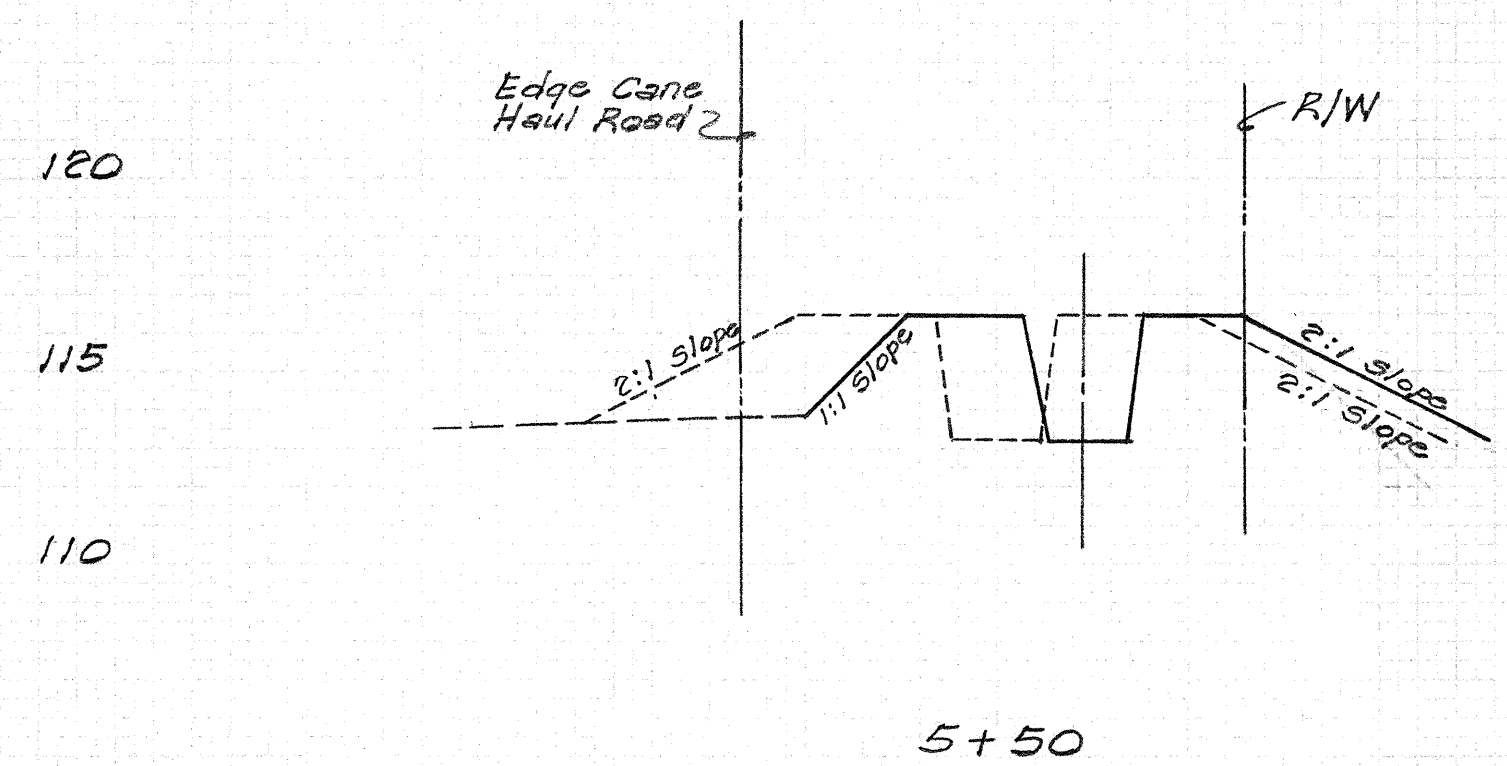

PROPOSED REVISION TO CONCRETE
TRAPEZOIDAL CHANNEL
STA. 5+00 TO STA. 6+50

WAIAWA INTERCHANGE
PROJECT NO. I-HI-1(36):B

MARCH 5, 1968

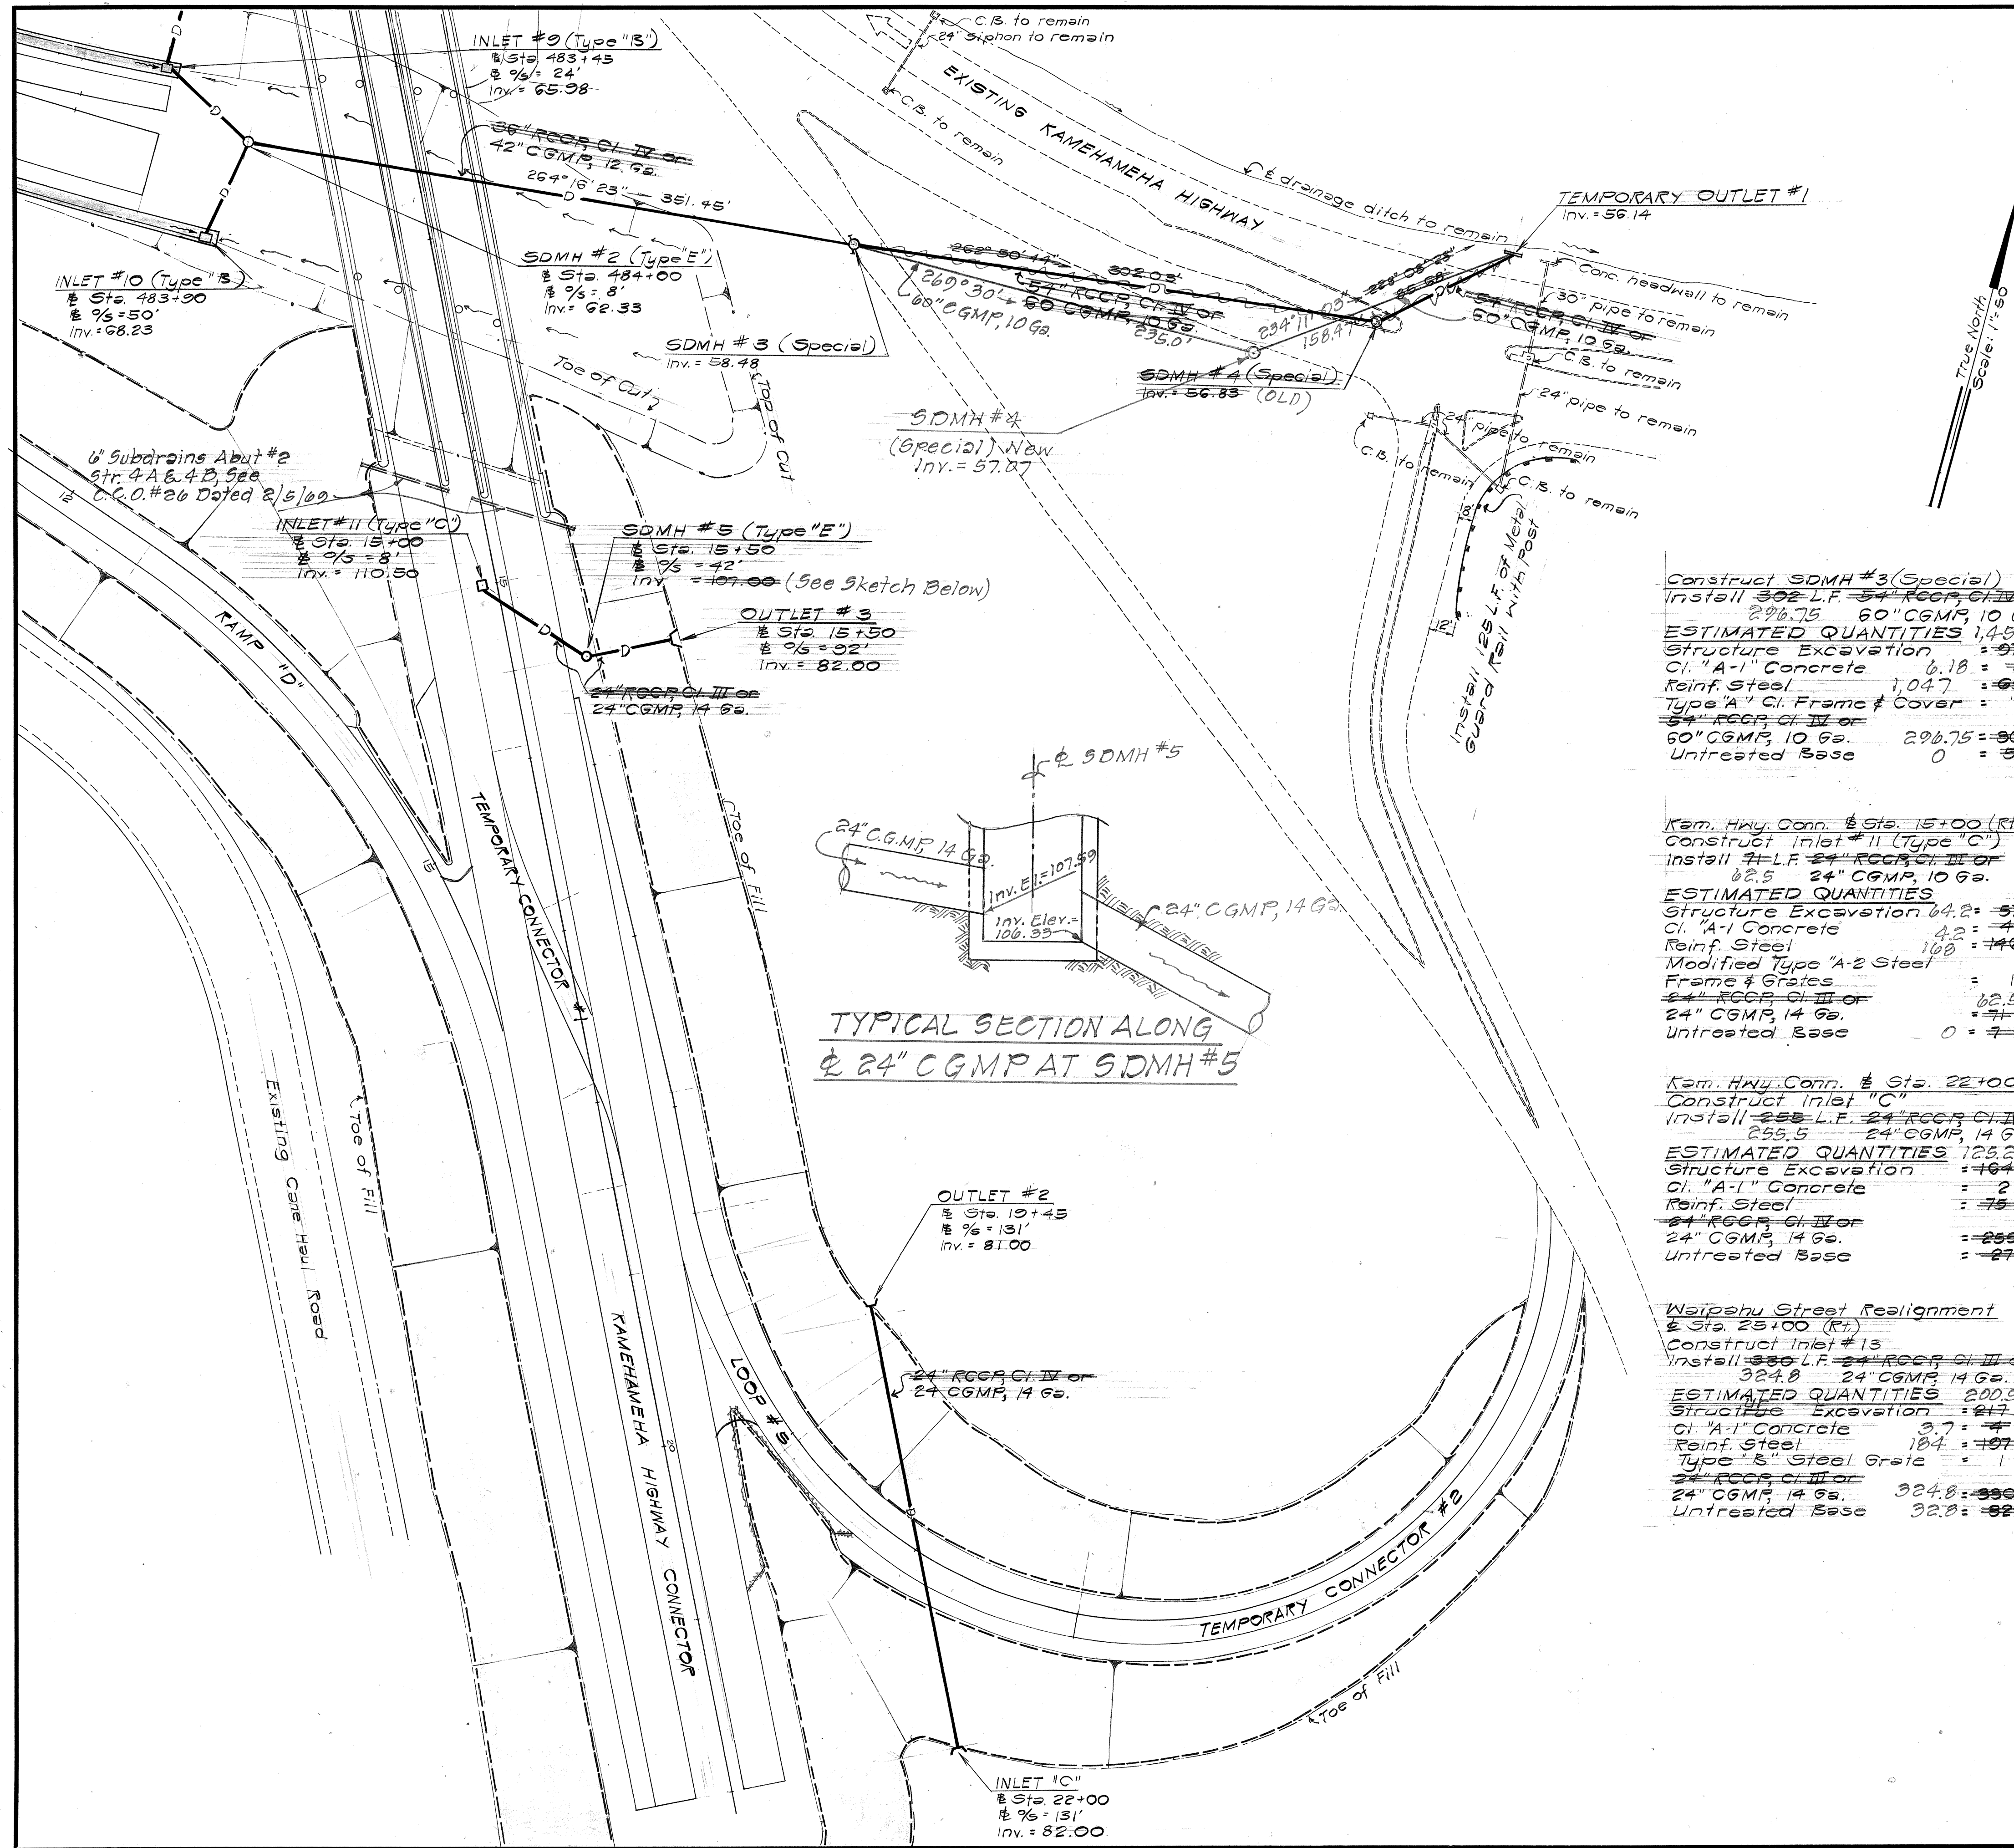

True North
Scale: 1"=50'

H-1 Inbound @ Sta. 484+00 (Lt.)
Construct S.D.M.H. #2 (Type "E")
Install 347.20 L.F. 42" CGMP, 12 Ga.
ESTIMATED QUANTITIES 1,183.7
Structure Excavation 1,183.7 c.y.
Cl. "B-1" Concrete 2.6 = 3 c.y.
Reinf. Steel 138 = 138 lbs.
Brick Wall for S.D.M.H. 3.2 = 4 L.F.
Type "A" C.I. Frame & Cover = 1 ea.
34" R.C.C.P. CH. III or
42 CGMP, 12 Ga. 347.20 = 347 L.F.
Untreated Base 0 = 43 c.y.

Construct S.D.M.H. #3 (Special)
Install 302 L.F. 60" CGMP, 10 Ga.
ESTIMATED QUANTITIES 1,454.40
Structure Excavation 1,454.40 c.y.
Cl. "A-1" Concrete 6.18 = 5 c.y.
Reinf. Steel 1,047 = 999 lbs.
Type "A" C.I. Frame & Cover = 1 ea.
54" R.C.C.P. CH. III or
60" CGMP, 10 Ga. 296.75 = 302 L.F.
Untreated Base 0 = 54 c.y.

Construct S.D.M.H. #4 (Special)
Install 86.34 L.F. 60" CGMP, 10 Ga.
ESTIMATED QUANTITIES 437.40
Structure Excavation 437.40 c.y.
Cl. "A-1" Concrete 8.82 = 5 c.y.
Reinf. Steel 1,465 = 920 lbs.
Type "A" C.I. Frame & Cover = 1 ea.
54" R.C.C.P. CH. III or
60" CGMP, 10 Ga. 86.34 = 86 L.F.
Untreated Base 0 = 15 c.y.

Construct Temporary Outlet #1
ESTIMATED QUANTITIES 48 c.y. 45.1
Structure Excavation 48 c.y. 45.1
Cement Rubble Masonry 48 c.y. 14

Kam. Hwy. Conn. @ Sta. 15+00 (Rt.)
Construct Inlet #11 (Type "C")
Install 71 L.F. 24" R.C.C.P. CH. III or
62.5 24" CGMP, 14 Ga.
ESTIMATED QUANTITIES 57 c.y.
Structure Excavation 57 c.y.
Cl. "A-1" Concrete 4.2 = 4 c.y.
Reinf. Steel 160 = 144 lbs.
Modified Type "A-2" Steel
Frame & Grates = 1 ea.
24" R.C.C.P. CH. III or
24" CGMP, 14 Ga. 62.5 = 71 L.F.
Untreated Base 0 = 7 c.y.

Kam. Hwy. Conn. @ Sta. 15+50 (Lt.)
Construct S.D.M.H. #5 (Type "E")
Install 55.1 L.F. 24" R.C.C.P. CH. III or
55.1 24" CGMP, 14 Ga.
ESTIMATED QUANTITIES 55.1 c.y.
Structure Excavation 55.1 c.y.
Cl. "B-1" Concrete 2.2 = 2 c.y.
Reinf. Steel 185 = 99 lbs.
Brick Wall for S.D.M.H. 3.4 = 4 L.F.
Type "A" C.I. Frame & Cover = 1 ea.
24" R.C.C.P. CH. III or
24" CGMP, 14 Ga. 55.1 = 55 L.F.
Untreated Base 0 = 5 c.y.

Kam. Hwy. Conn. @ Sta. 15+50 (Lt.)
Construct Outlet #3
ESTIMATED QUANTITIES 2 c.y.
Structure Excavation 2 c.y.
Cl. "A-1" Concrete 2.02 = 2 c.y.
Reinf. Steel 96 = 99 lbs.


Kam. Hwy. Conn. @ Sta. 22+00 (Lt.)
Construct Inlet #13
Install 255.5 L.F. 24" R.C.C.P. CH. III or
255.5 24" CGMP, 14 Ga.
ESTIMATED QUANTITIES 255.5 c.y.
Structure Excavation 255.5 c.y.
Cl. "A-1" Concrete 2.2 = 2 c.y.
Reinf. Steel 185 = 99 lbs.
Type "A" C.I. Frame & Cover = 1 ea.
24" R.C.C.P. CH. III or
24" CGMP, 14 Ga. 255.5 = 255 L.F.
Untreated Base 0 = 27 c.y.

Kam. Hwy. Conn. @ Sta. 19+45 (Lt.)
Construct Outlet #2
ESTIMATED QUANTITIES 2 c.y.
Structure Excavation 2 c.y.
Cl. "A-1" Concrete 1.6 = 2 c.y.
Reinf. Steel 96 = 99 lbs.


Waipahu Street Realignment
@ Sta. 24+75 (Lt.)
Construct Inlet #12
Install 48.8 L.F. 24" R.C.C.P. CH. III or
48.8 24" CGMP, 14 Ga.
ESTIMATED QUANTITIES 48.8 c.y.
Structure Excavation 48.8 c.y.
Cl. "A-1" Concrete 2.5 = 3 c.y.
Reinf. Steel 119 = 104 lbs.
Type "B" Steel Grate = 1 ea.
24" R.C.C.P. CH. III or
24" CGMP, 14 Ga. 48.8 = 48 L.F.
Untreated Base 4.5 = 4 c.y.

Waipahu Street Realignment
@ Sta. 28+00 (Rt.)
Construct Inlet #15
Install 324.8 L.F. 24" R.C.C.P. CH. III or
324.8 24" CGMP, 14 Ga.
ESTIMATED QUANTITIES 324.8 c.y.
Structure Excavation 324.8 c.y.
Cl. "A-1" Concrete 3.7 = 4 c.y.
Reinf. Steel 184 = 107 lbs.
Type "B" Steel Grate = 1 ea.
24" R.C.C.P. CH. III or
24" CGMP, 14 Ga. 324.8 = 324 L.F.
Untreated Base 32.8 = 32 c.y.

Waipahu Street Realignment
@ Sta. 28+30 (Rt.)
Construct S.D.M.H. #6 (Type "D")
Install 39.3 L.F. 24" R.C.C.P. CH. III or
39.3 24" CGMP, 14 Ga.
ESTIMATED QUANTITIES 39.3 c.y.
Structure Excavation 39.3 c.y.
Cl. "B-1" Concrete 0.8 = 1 c.y.
Reinf. Steel 32 = 28 lbs.
Brick Wall for S.D.M.H. 3.9 = 5 L.F.
Type "A" C.I. Frame & Cover = 1 ea.
24" R.C.C.P. CH. III or
24" CGMP, 14 Ga. 39.3 = 39 L.F.
Untreated Base 3.9 = 4 c.y.

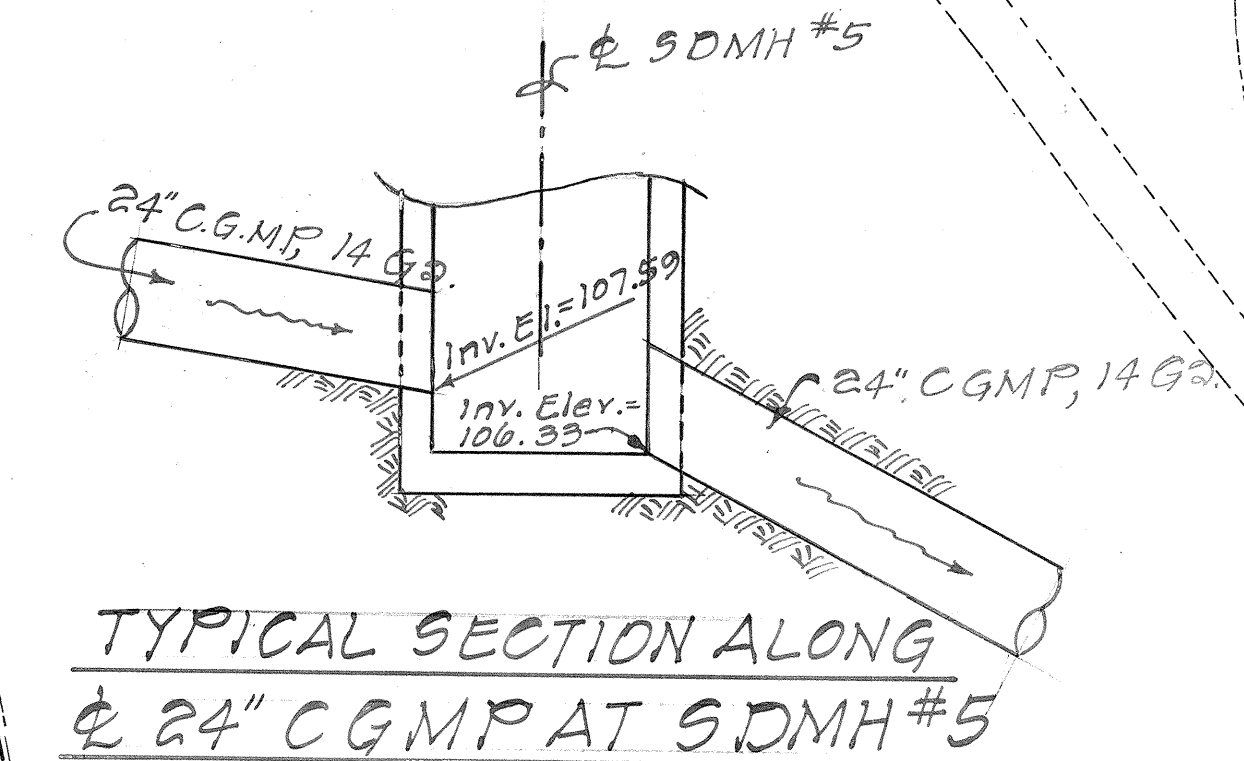

DATE	_____
SURVEY PLOTTED BY	_____
DRAWN BY	_____
DESIGNED BY	_____
QUANTITIES BY	_____
CHECKED BY	_____
ORIGINAL PLAN	_____
NOTE BOOK	_____
No.	_____

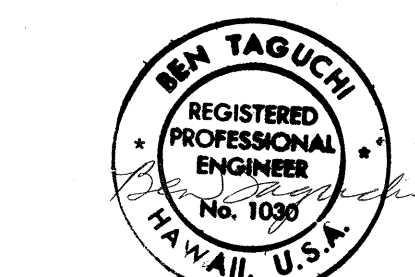

THIS WORK WAS PREPARED BY ME
OR UNDER MY SUPERVISION.






STATE OF HAWAII
DEPARTMENT OF TRANSPORTATION
HIGHWAYS DIVISION

GRADING & DRAINAGE

WAIAPAHU INTERCHANGE
F.A.I. Proj. No. 1 - HI - 1(36)B






Scale: As shown Date: OCT 1967

SHEET No. OF SHEETS

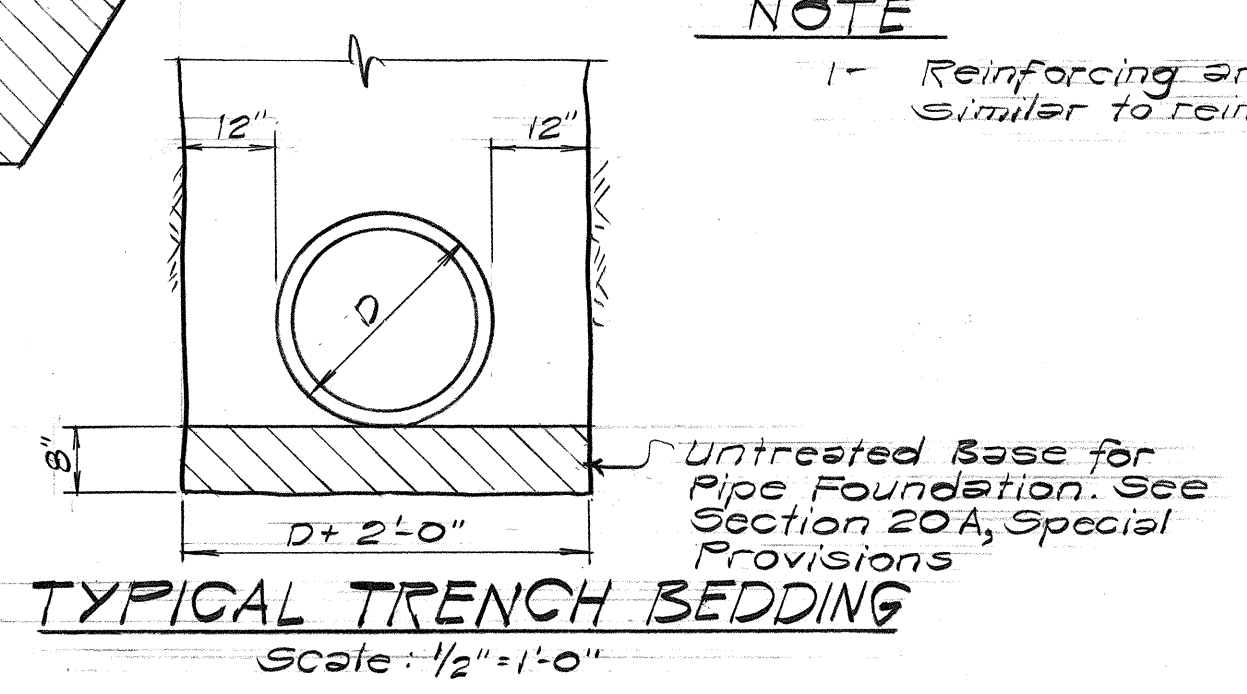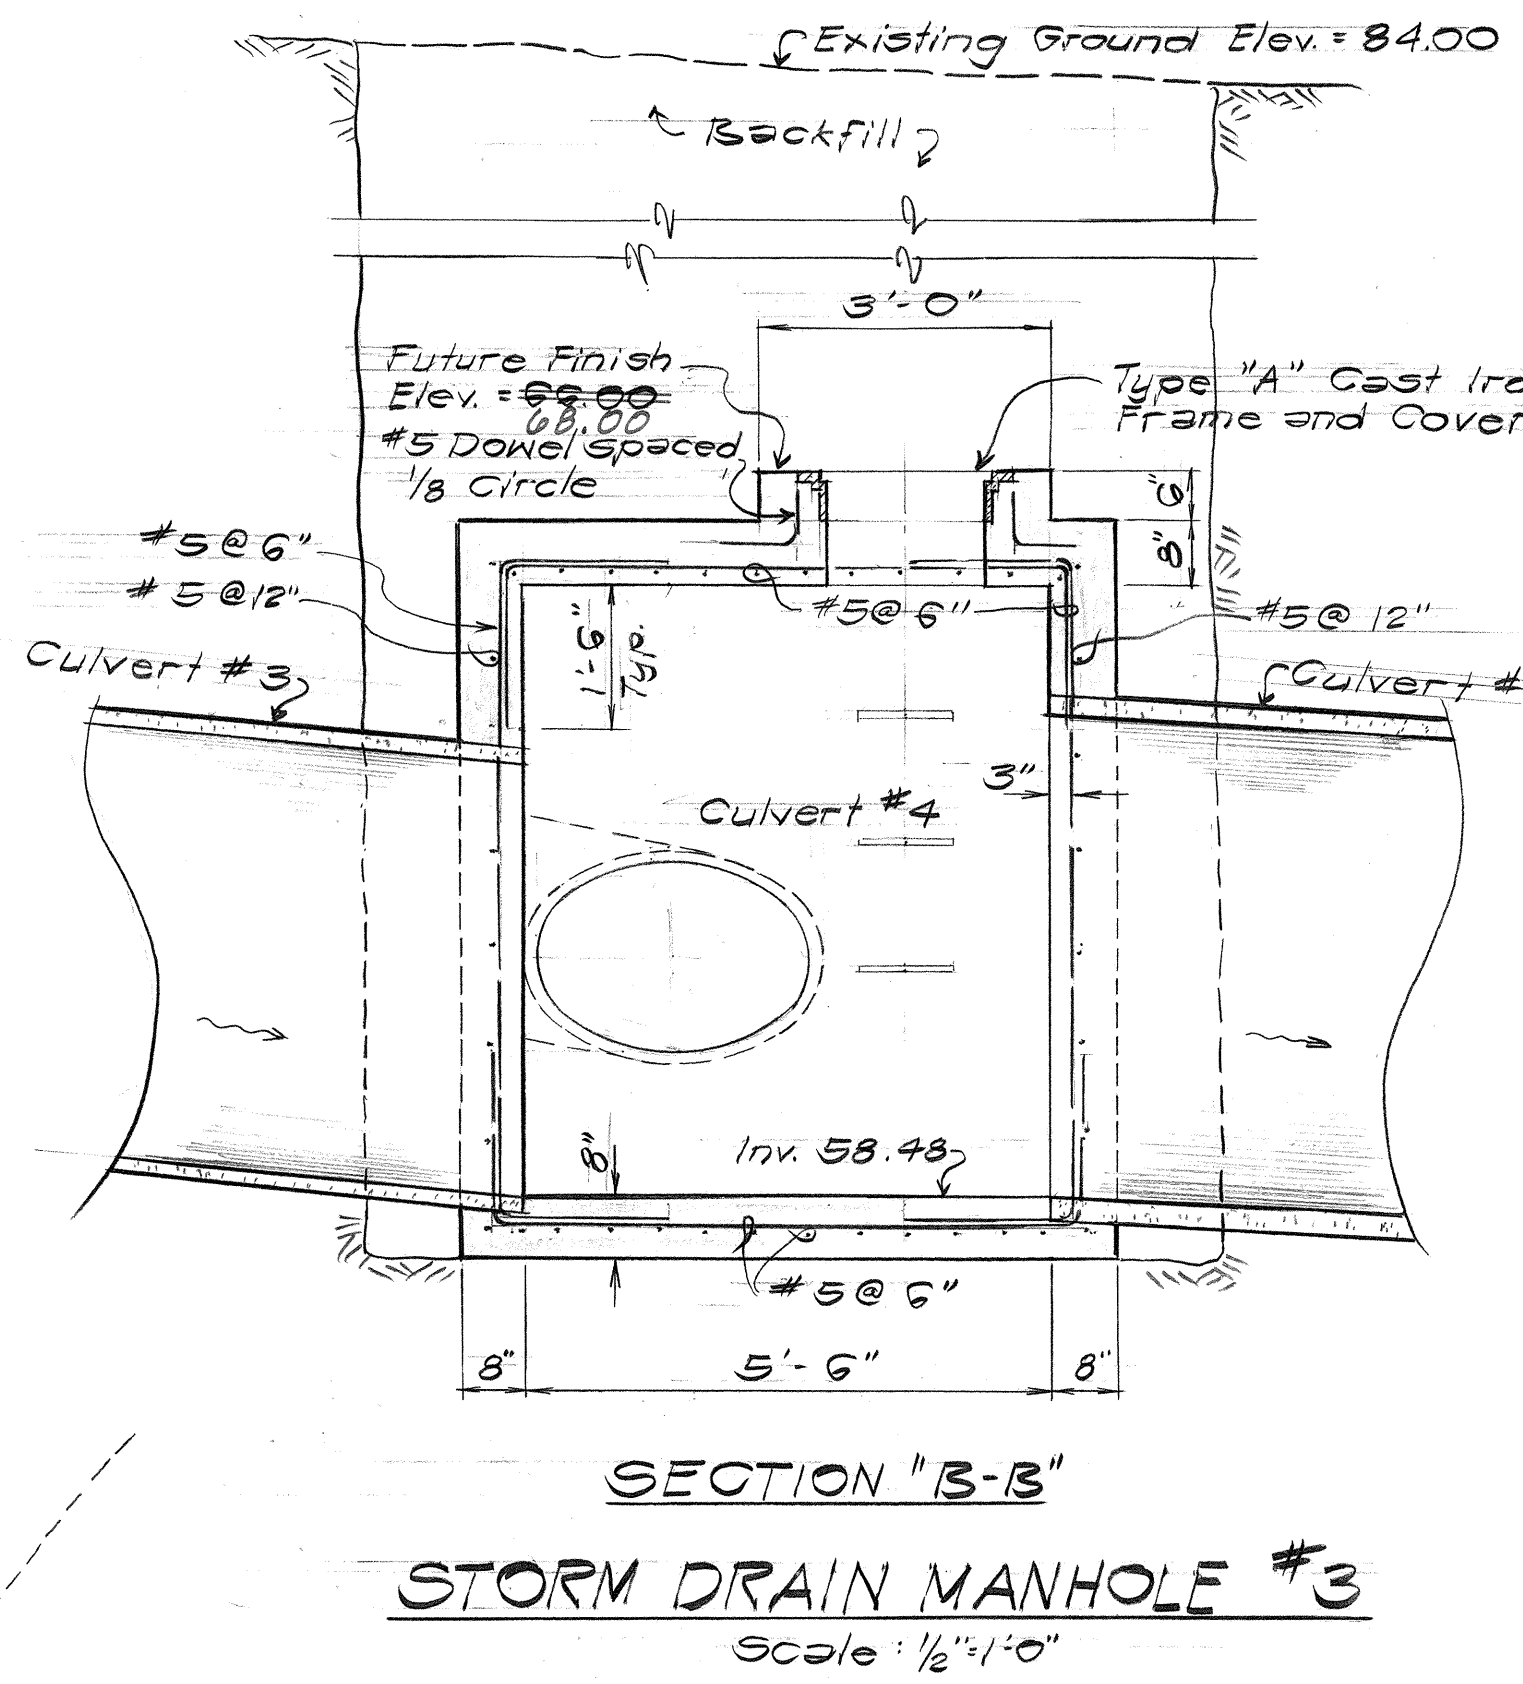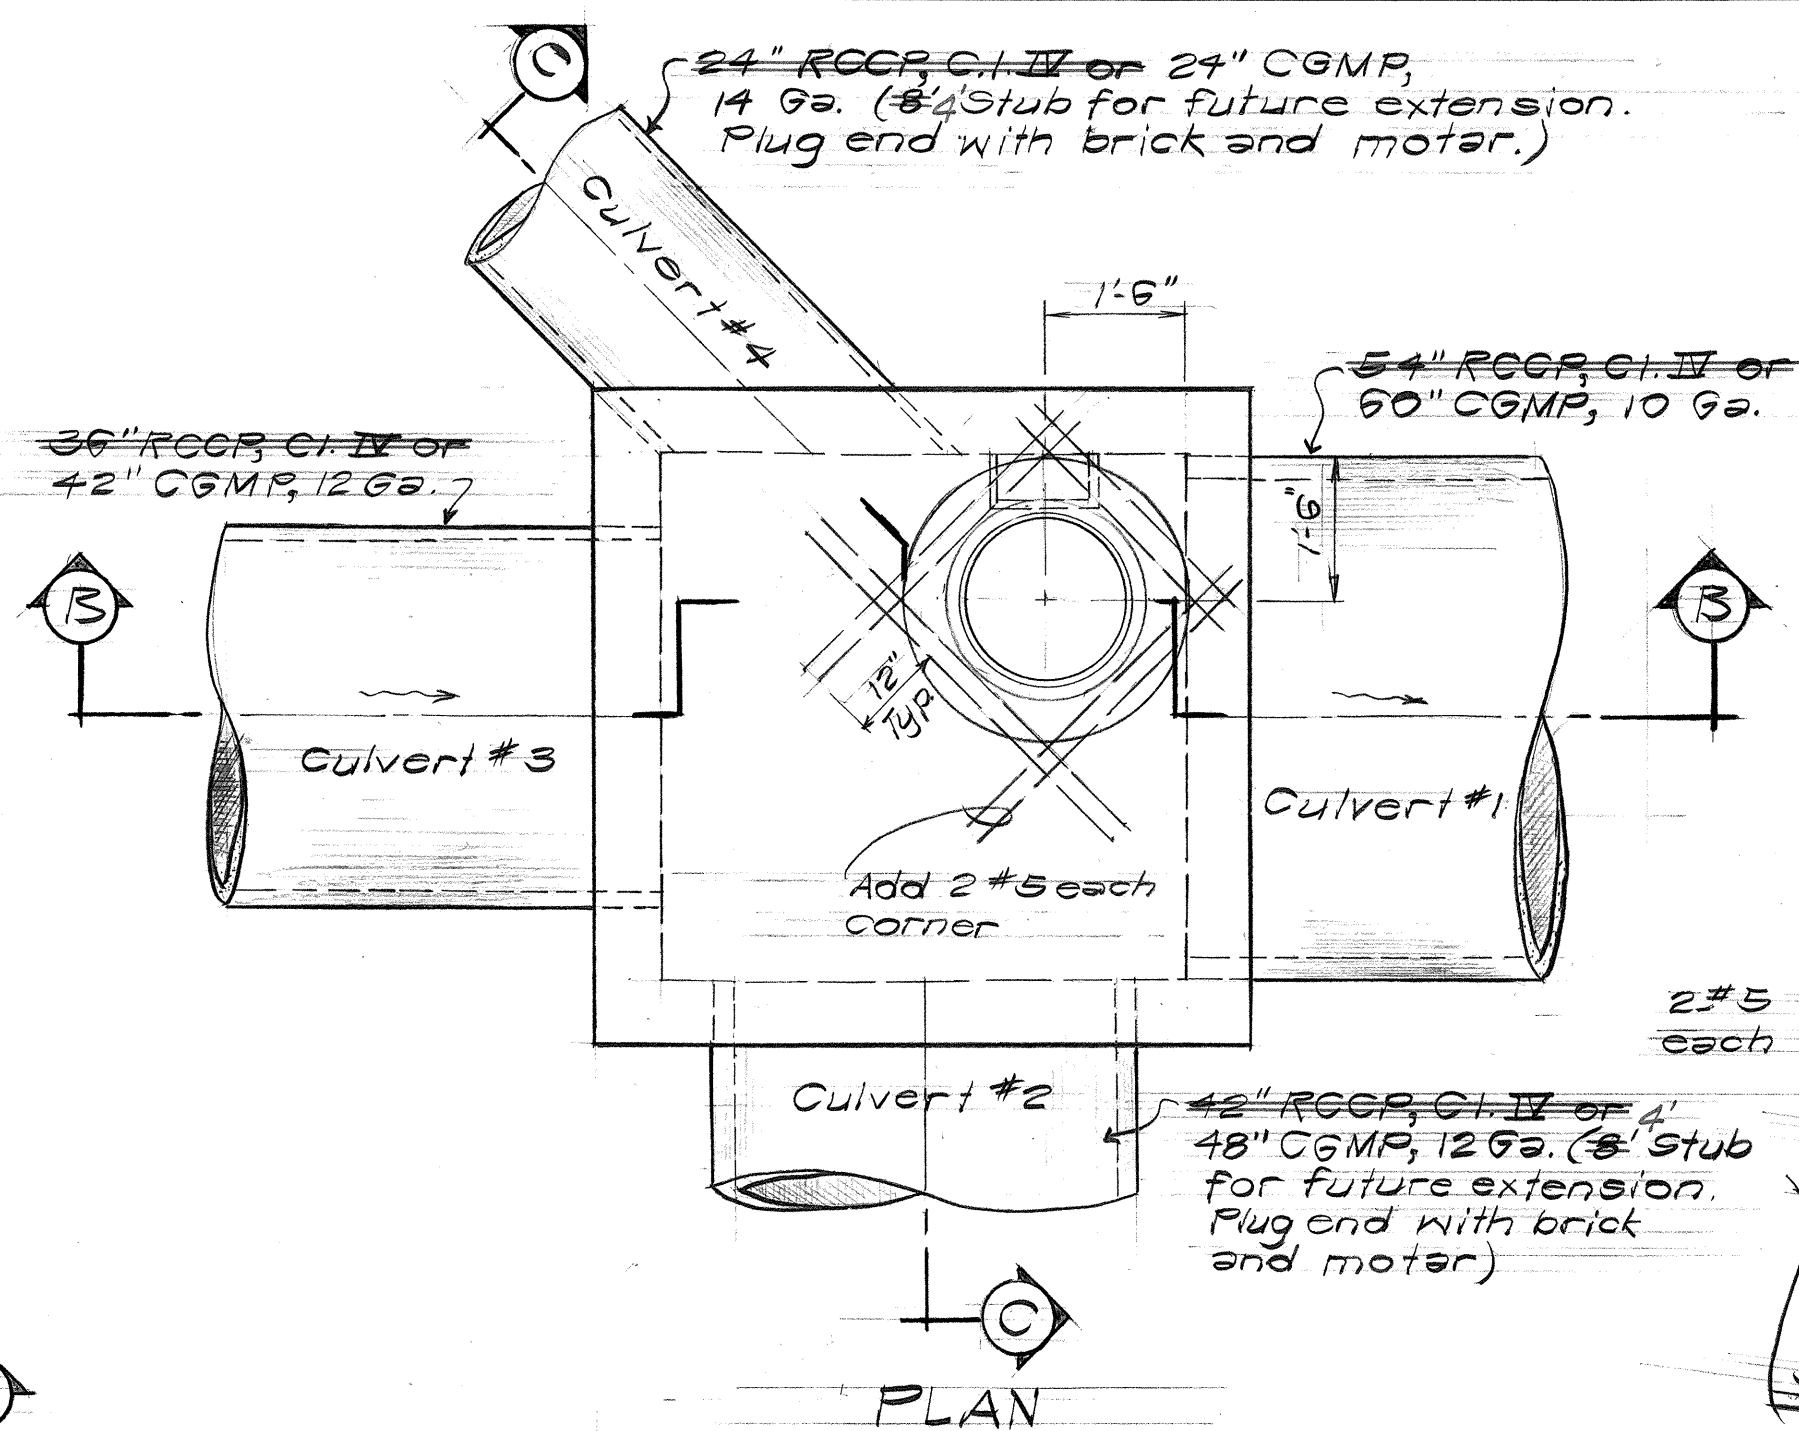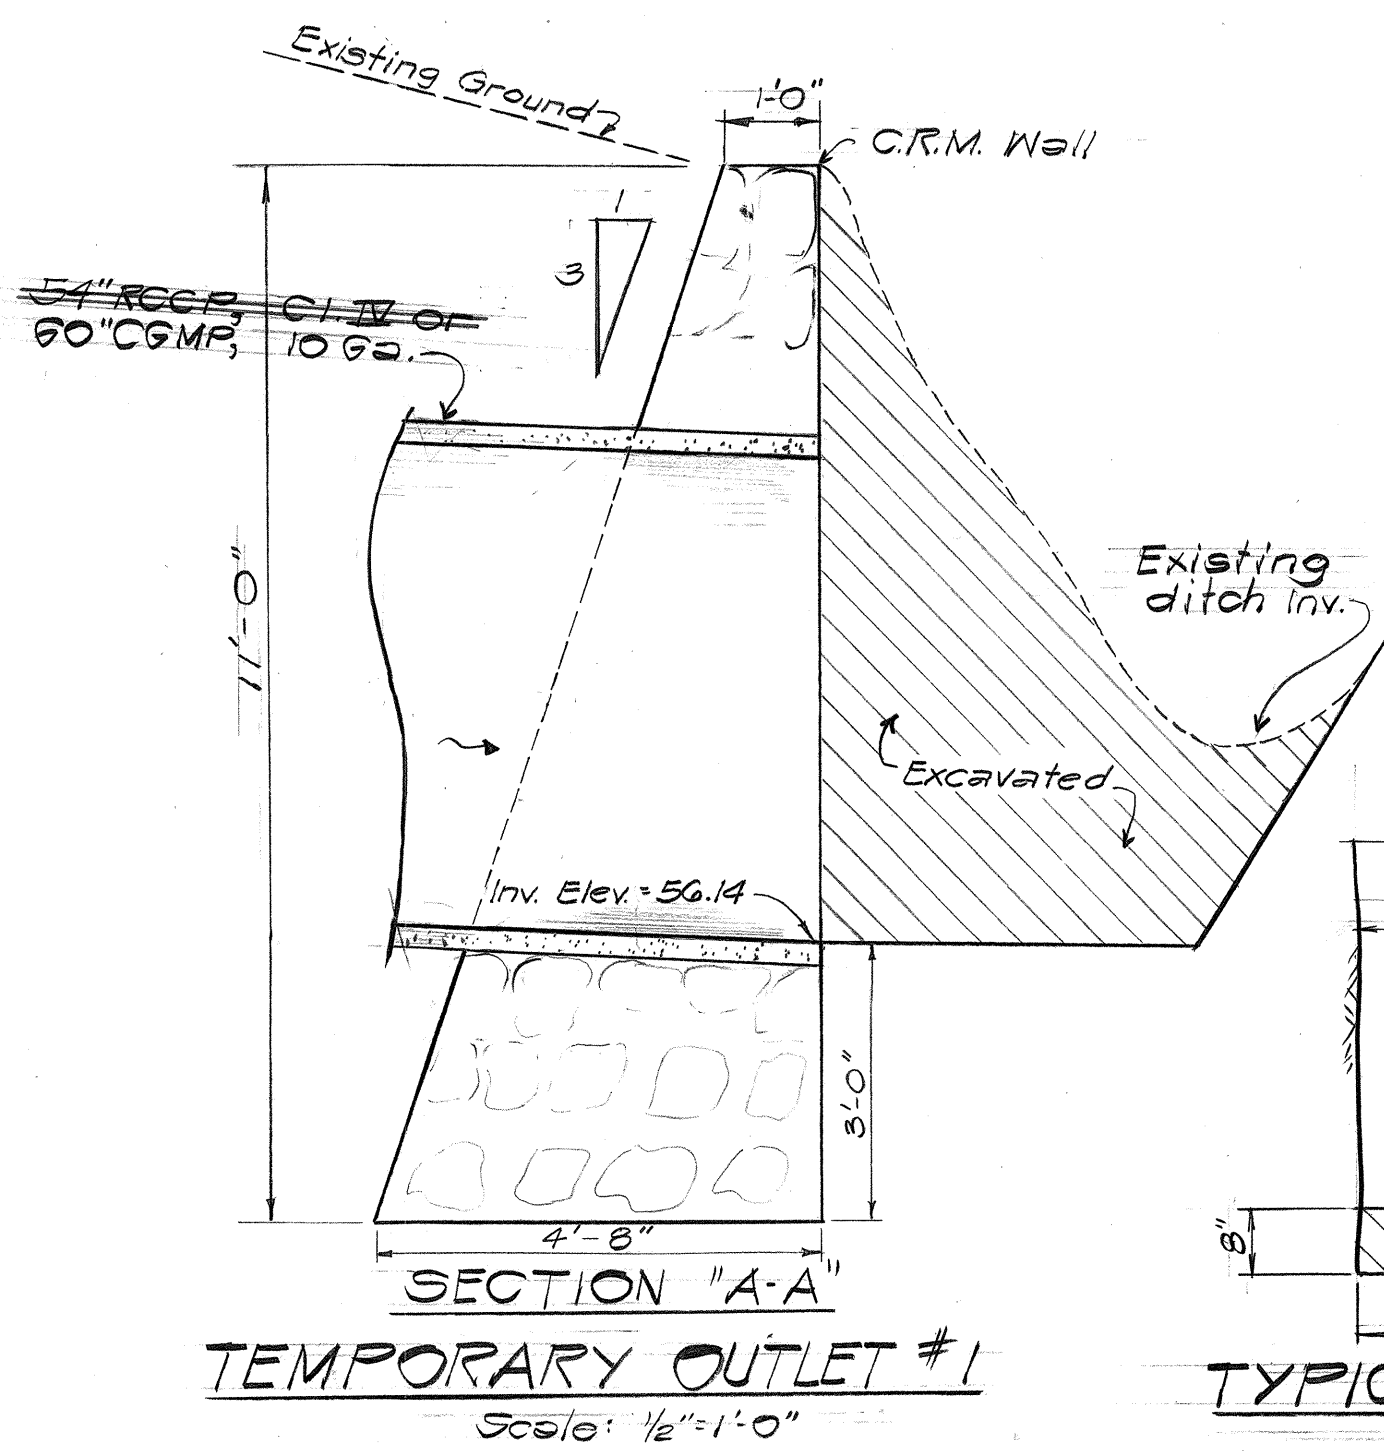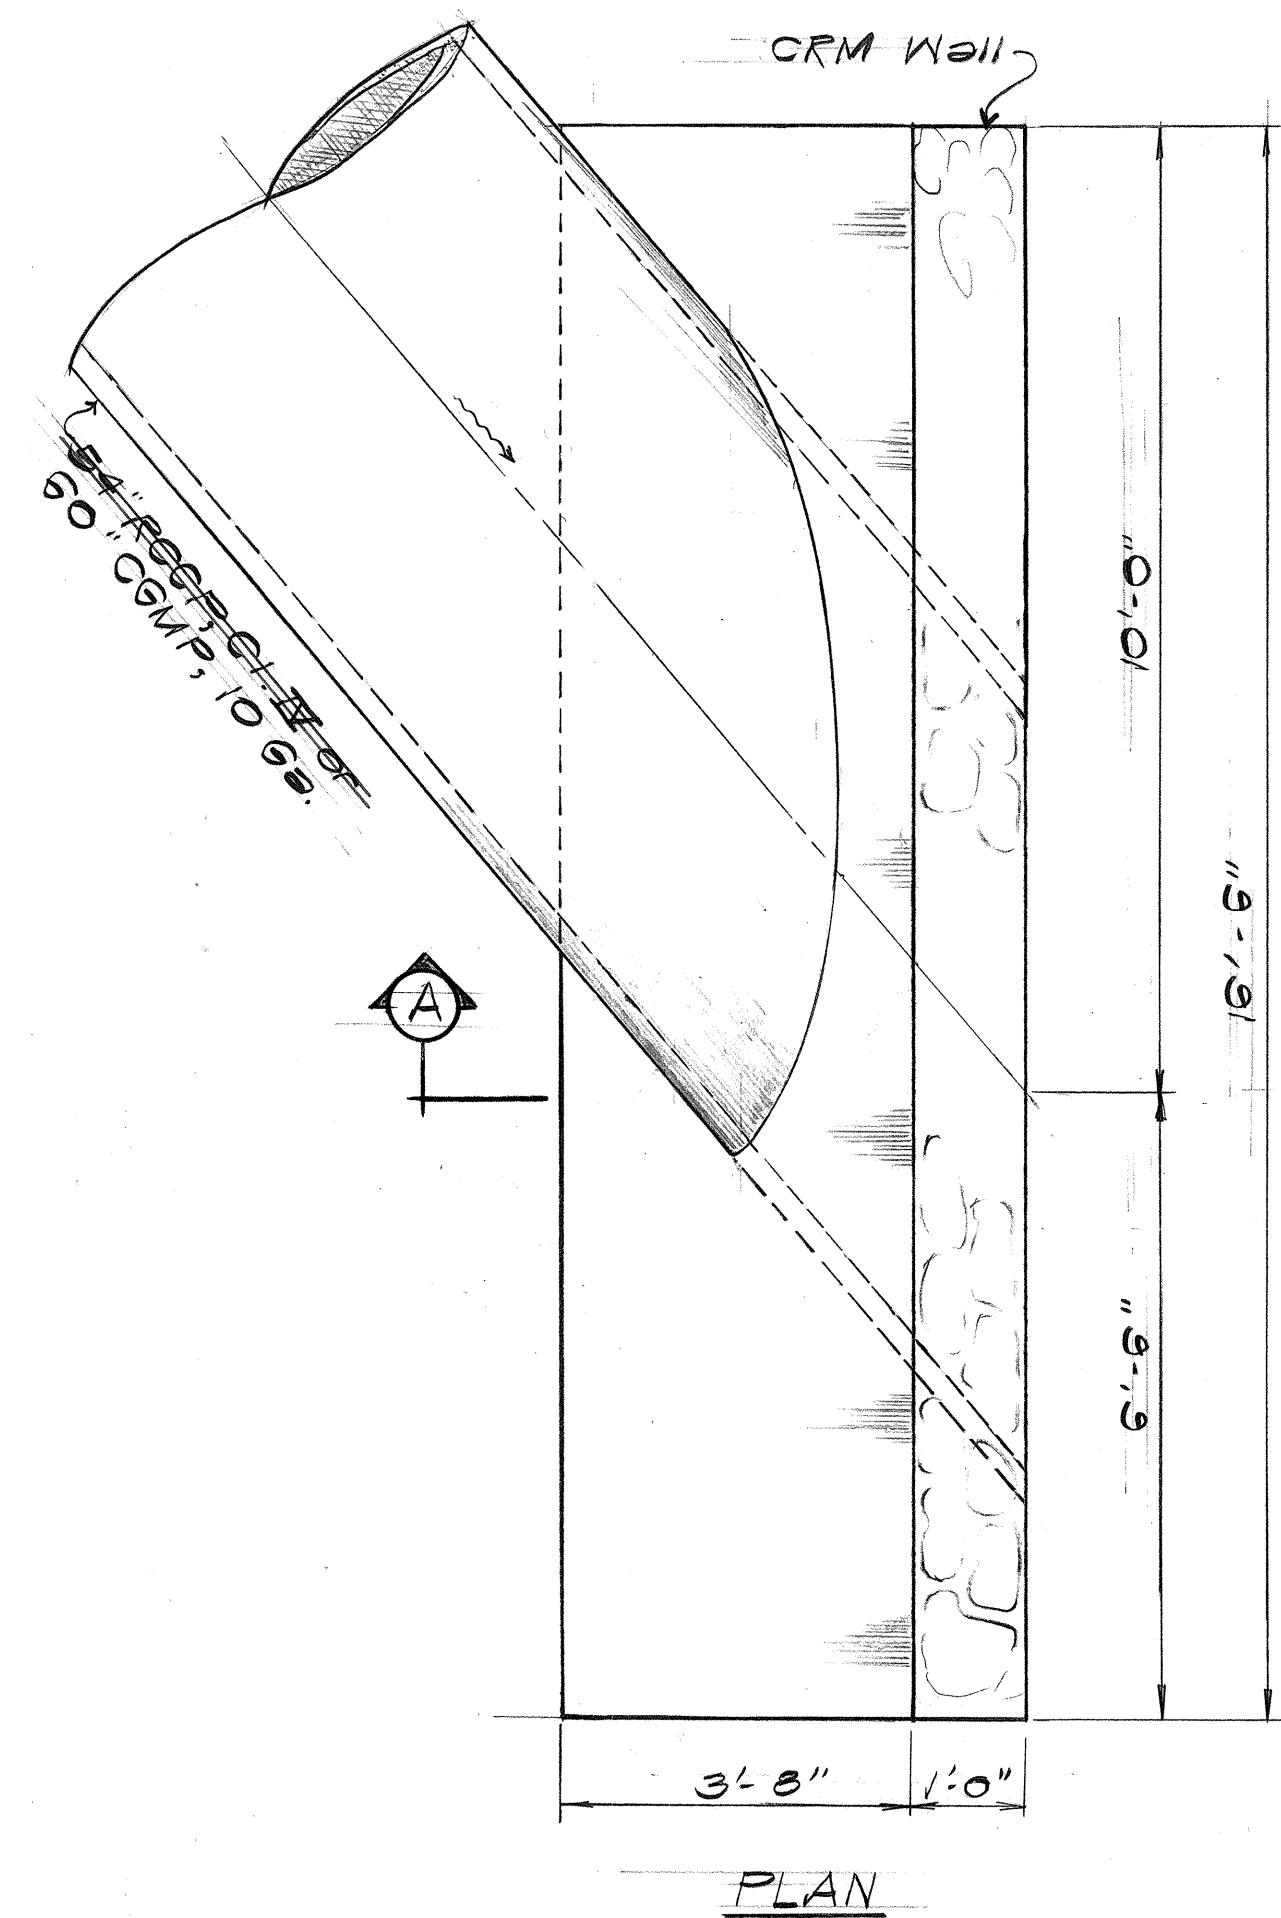

NOTE

1- Reinforcing around all culverts shall be similar to reinforcing around Culvert #1 & #6.

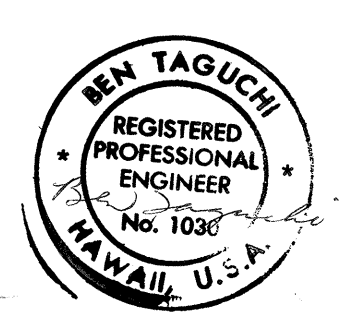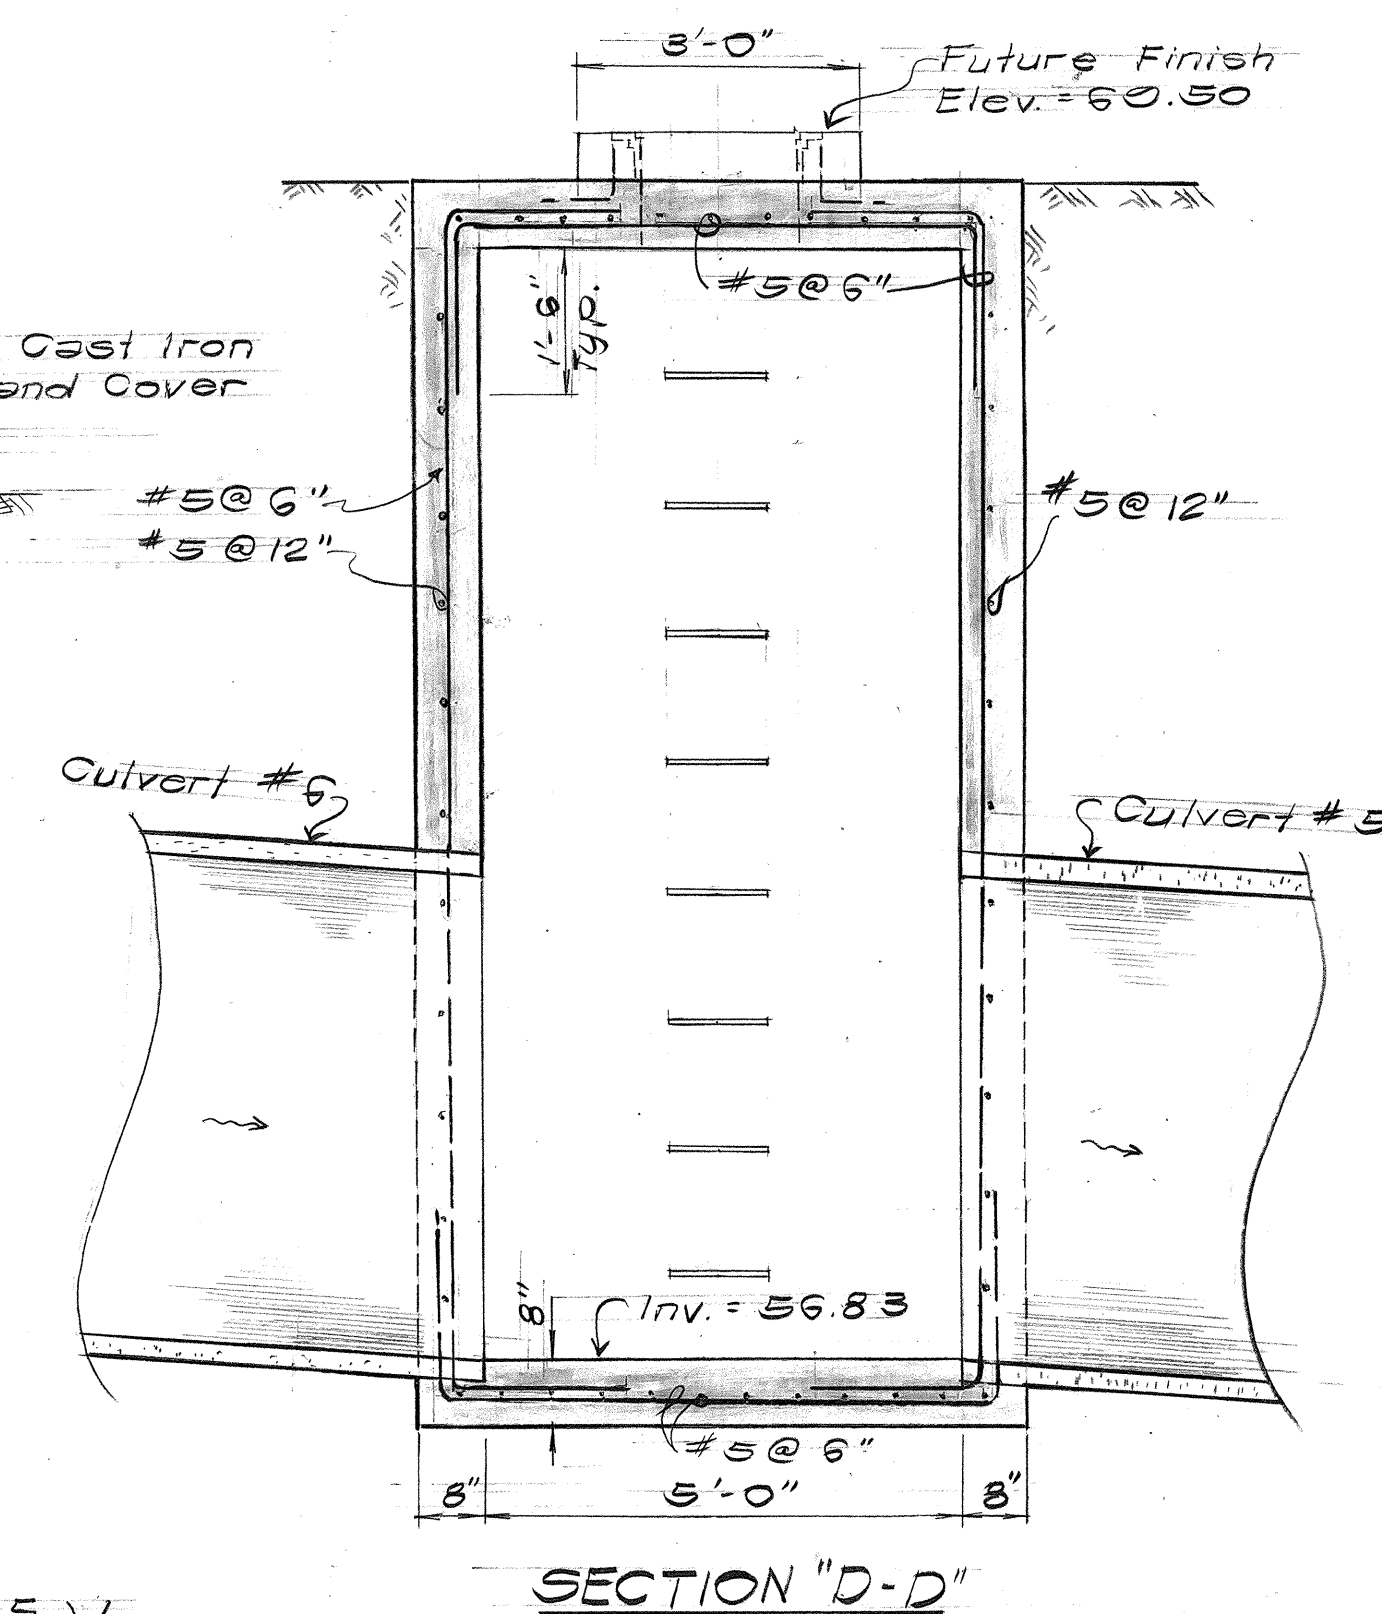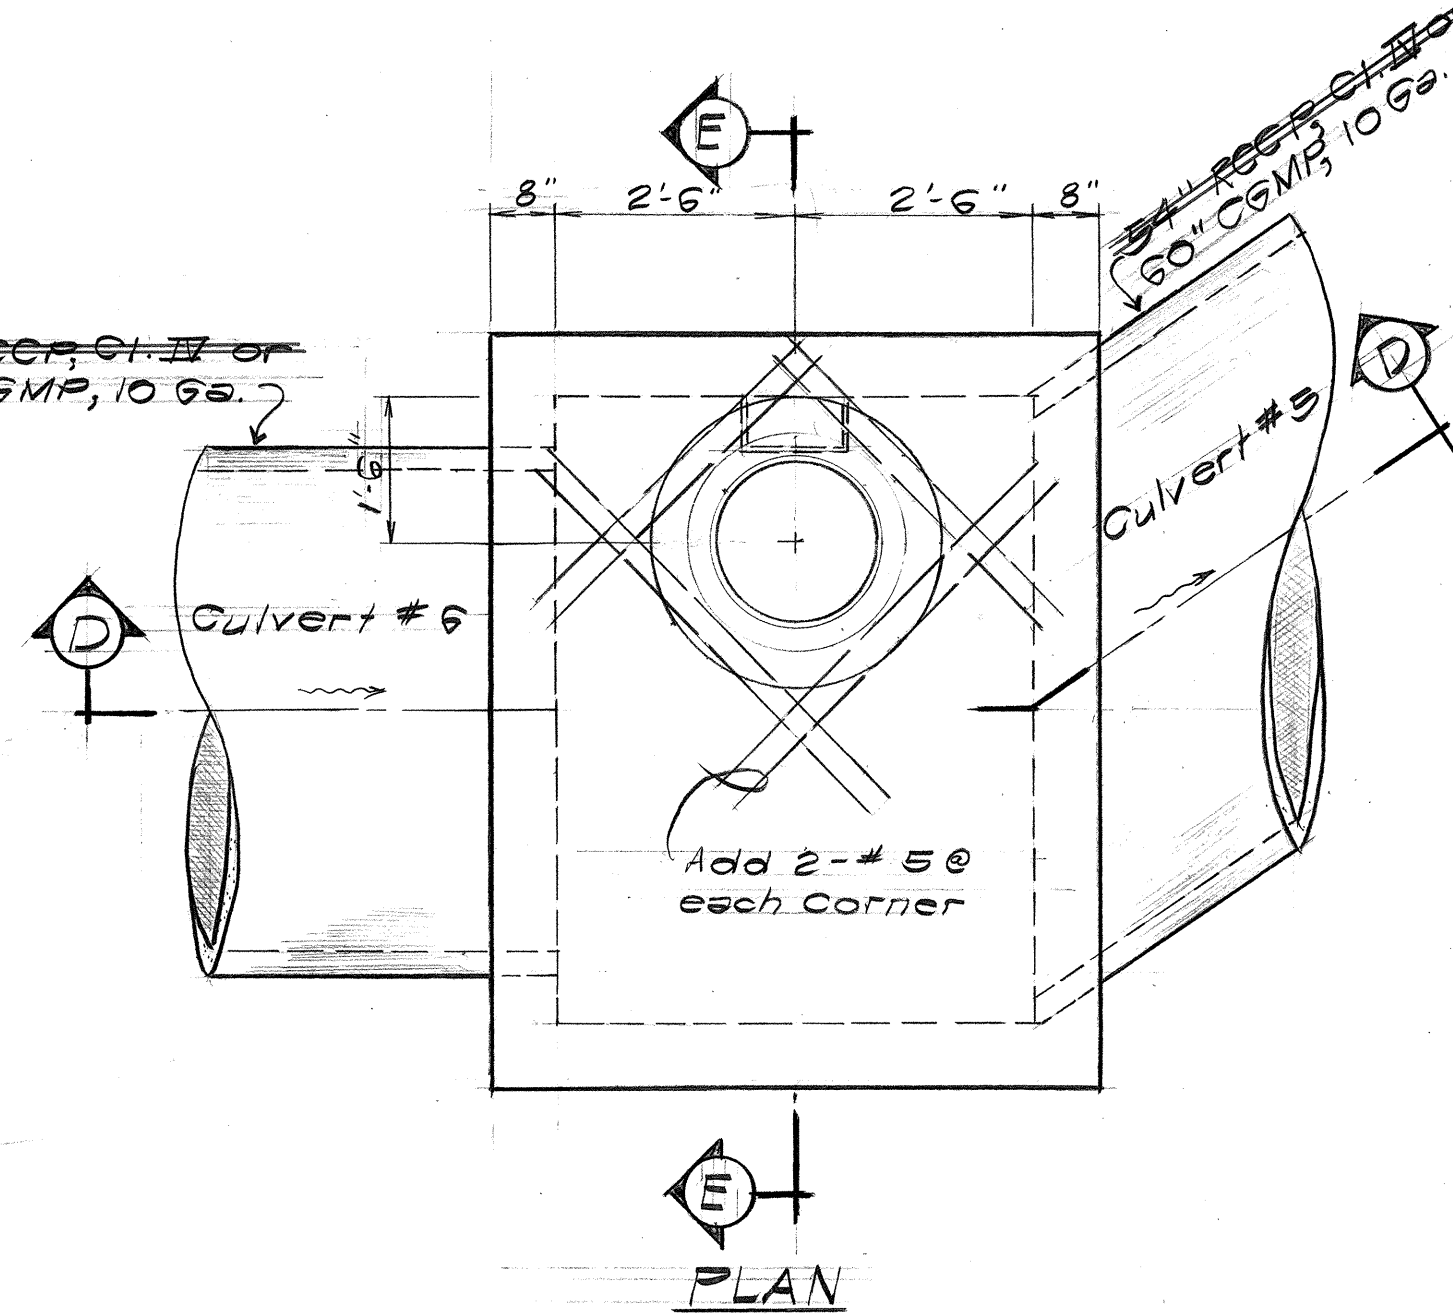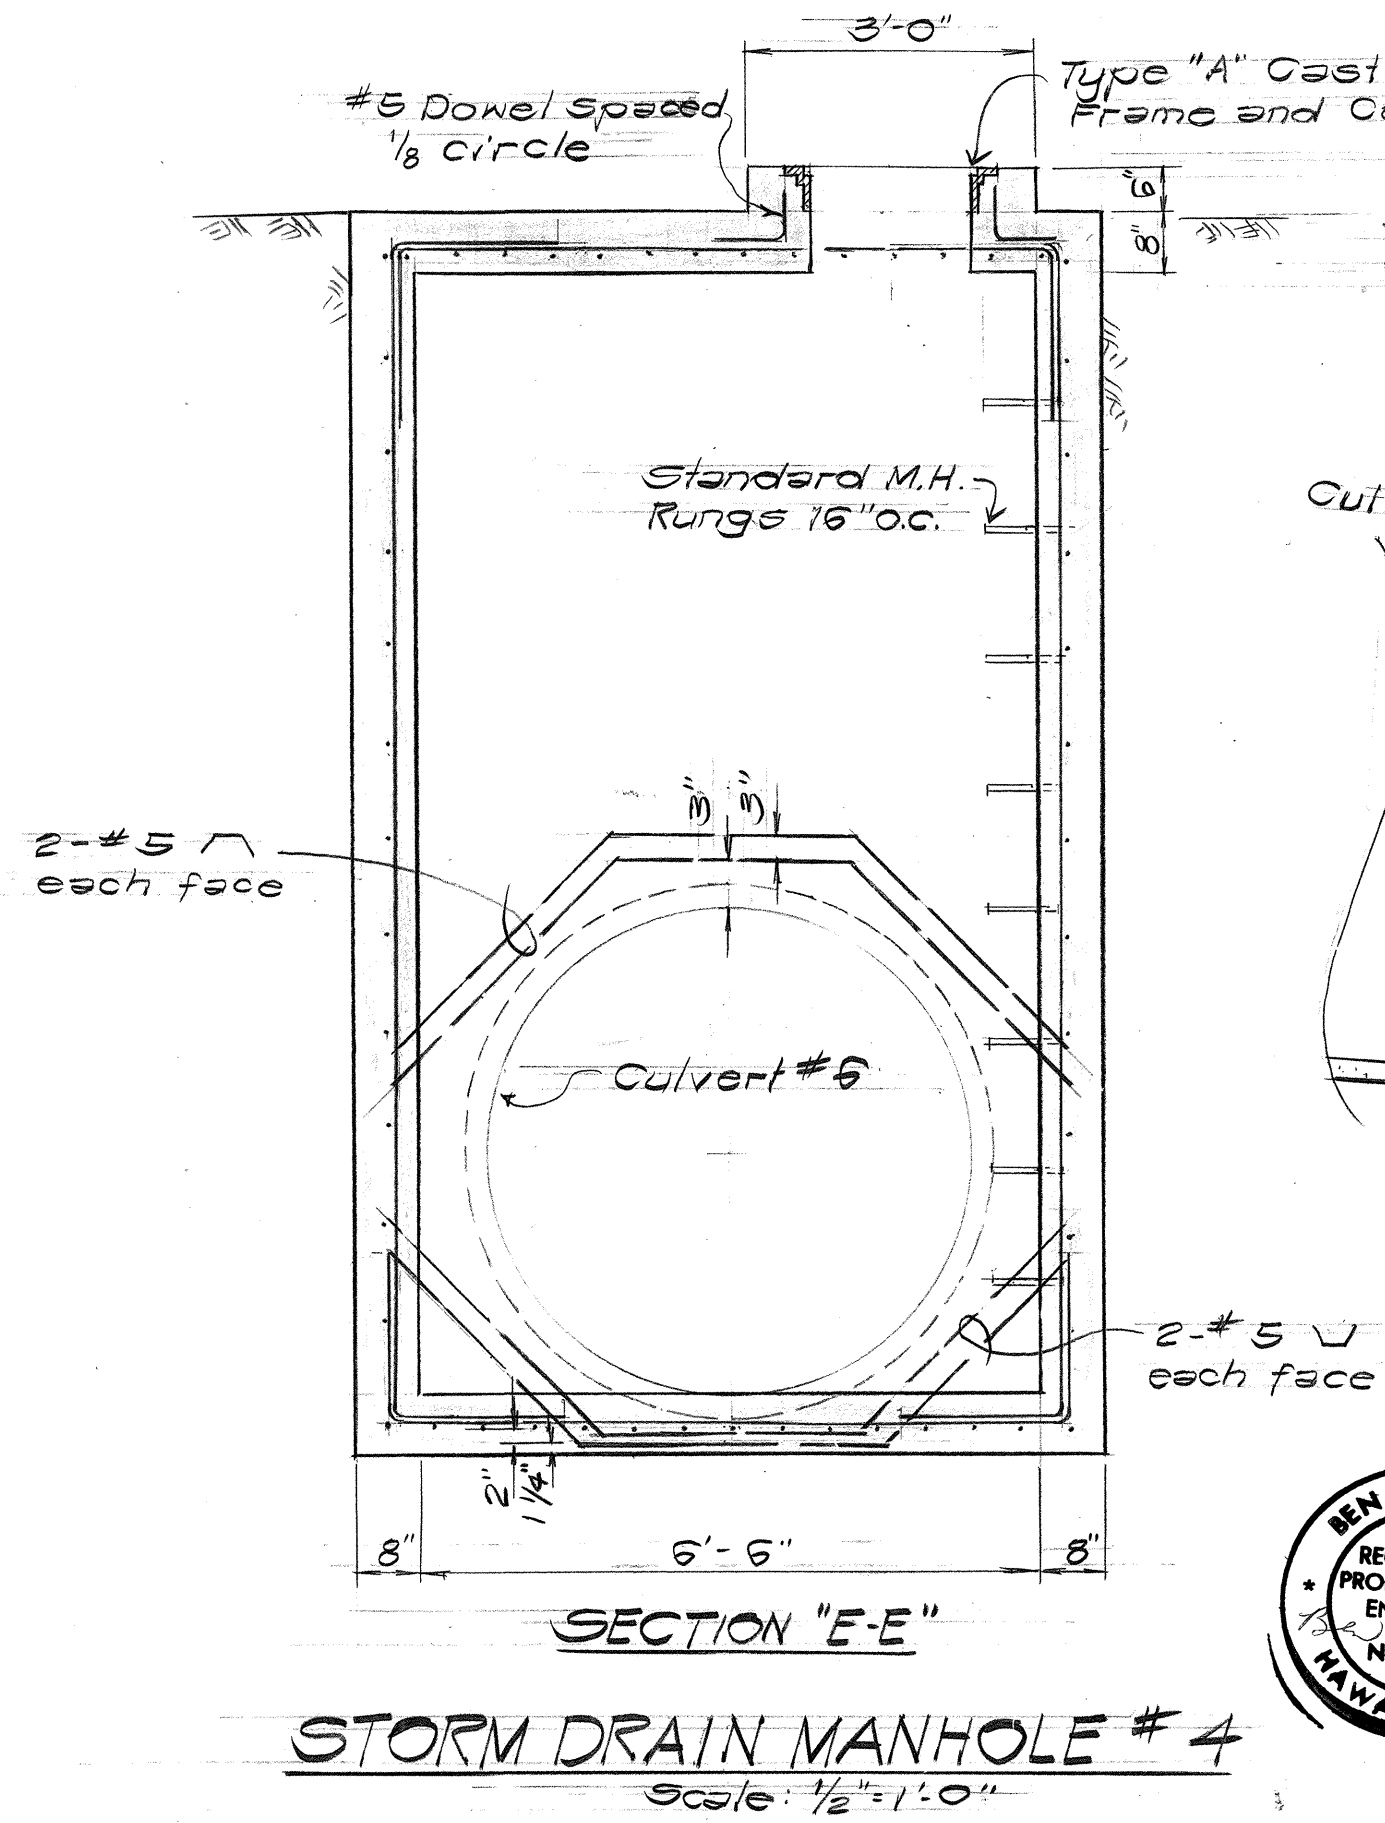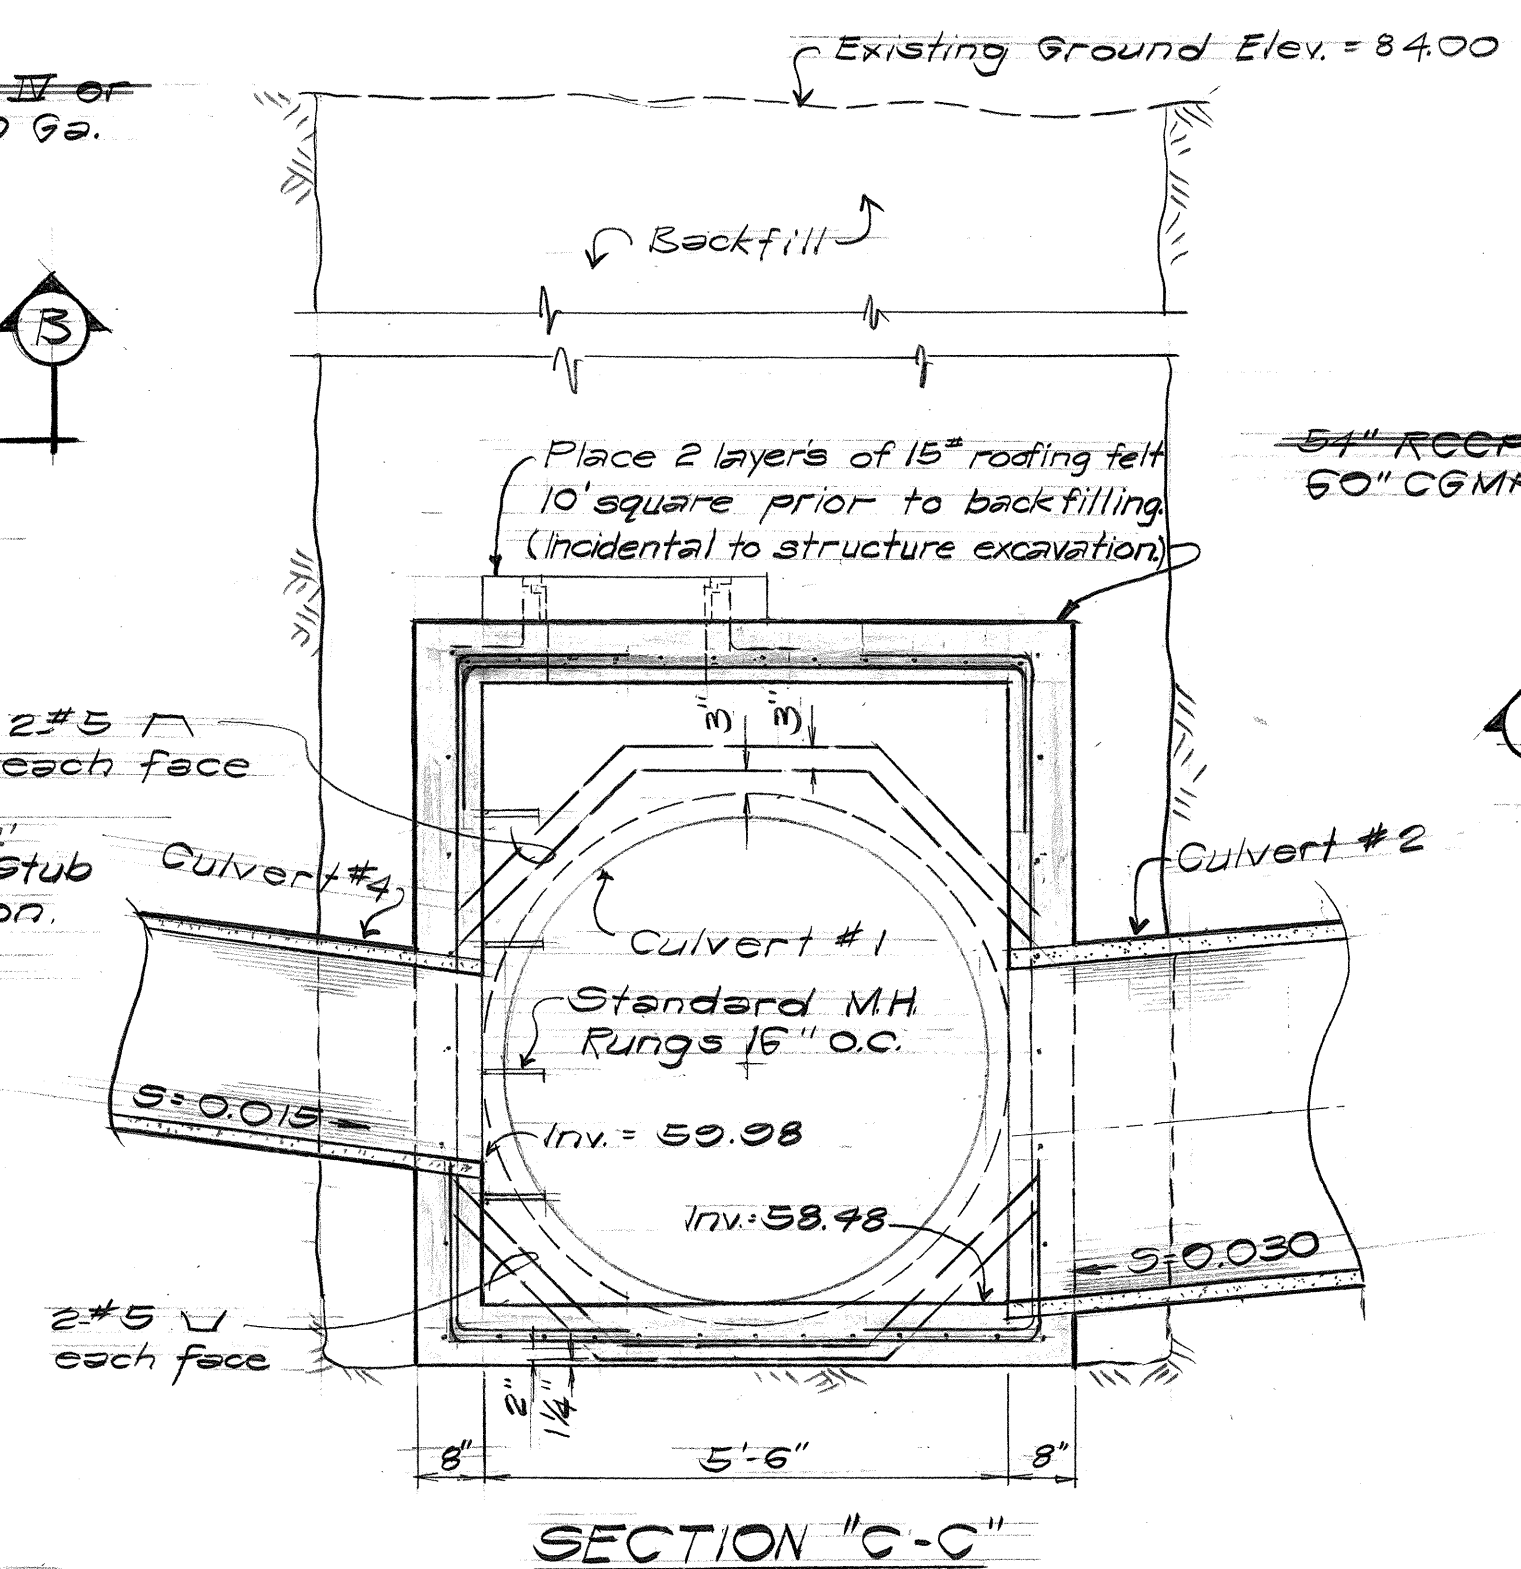

THIS WORK WAS PREPARED BY ME OR UNDER MY SUPERVISION.


STATE OF HAWAII
DEPARTMENT OF TRANSPORTATION
HIGHWAYS DIVISION

DRAINAGE DETAILS


WAIAWA INTERCHANGE
F.A.I. Proj. No. I-HI-1(36)8

Scale: As shown Date: OCT 1957


SHEET No. OF SHEETS

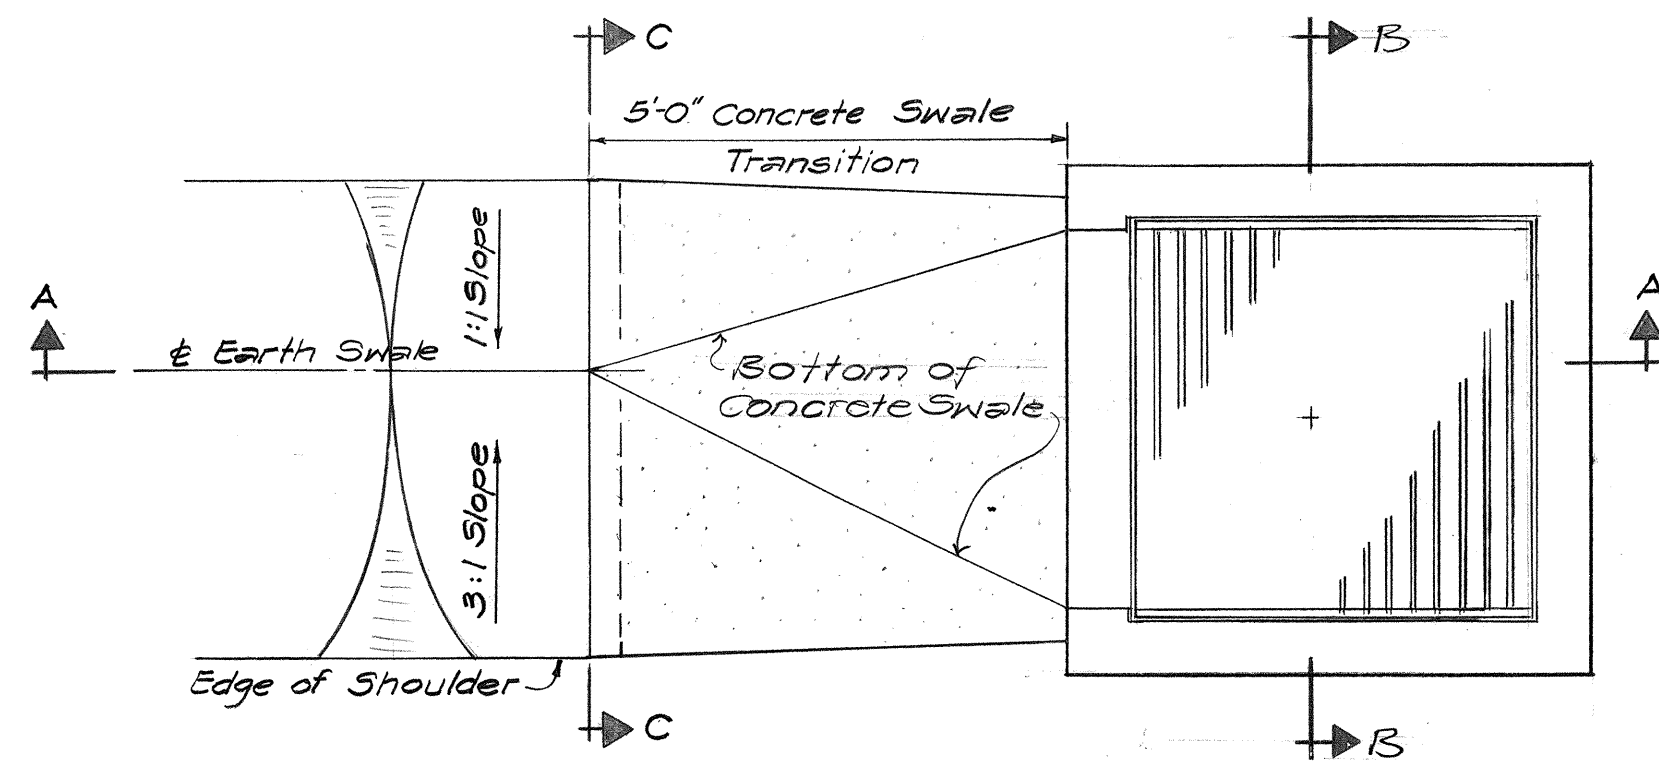


PLAN-INLETS #12 & #13
Scale: 1/8"=1'-0"

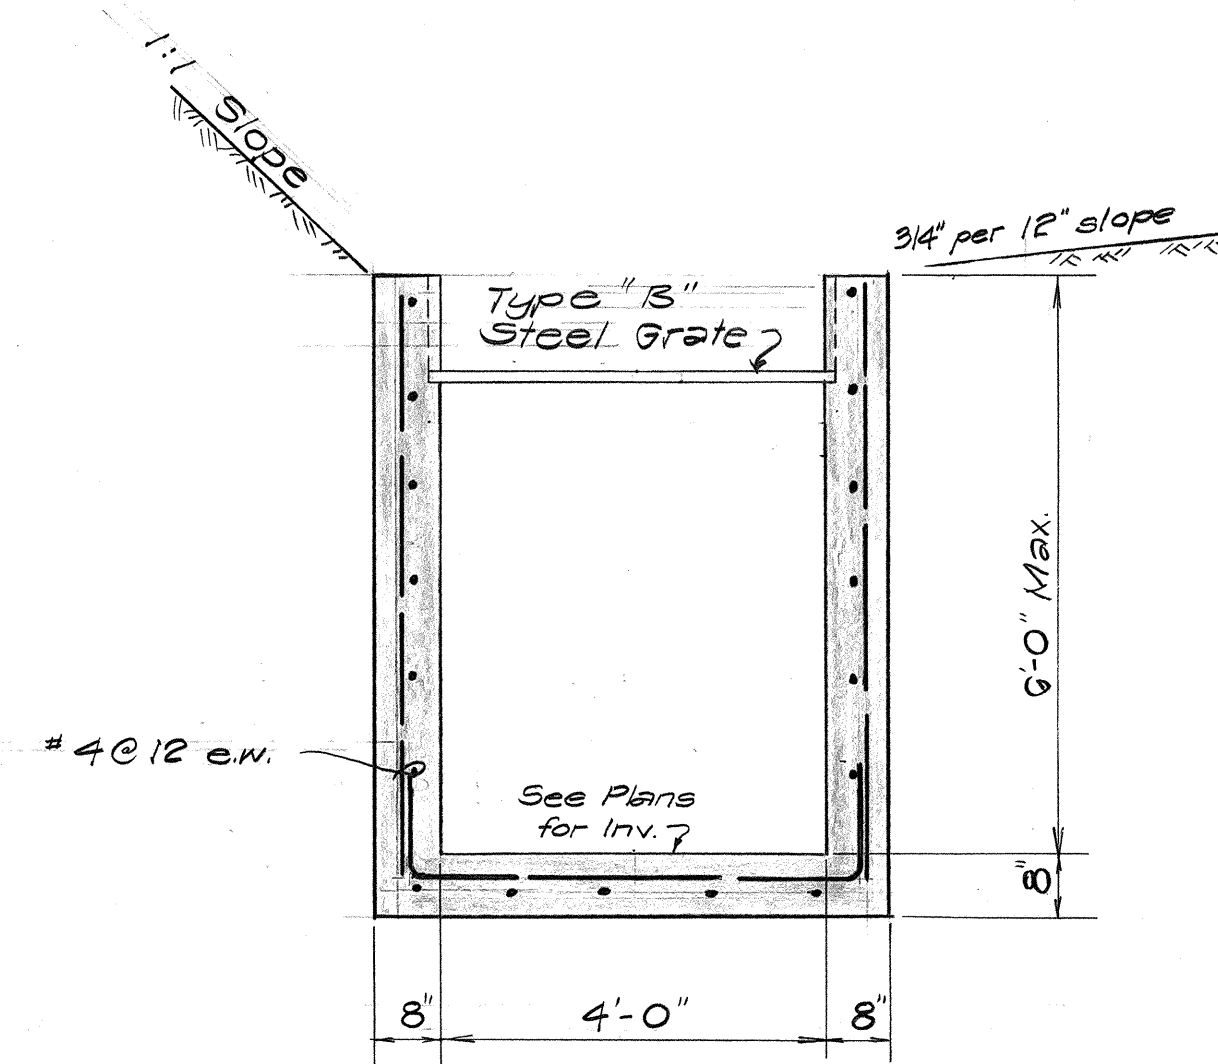


SECTION B-B
Scale: 1/8"=1'-0"

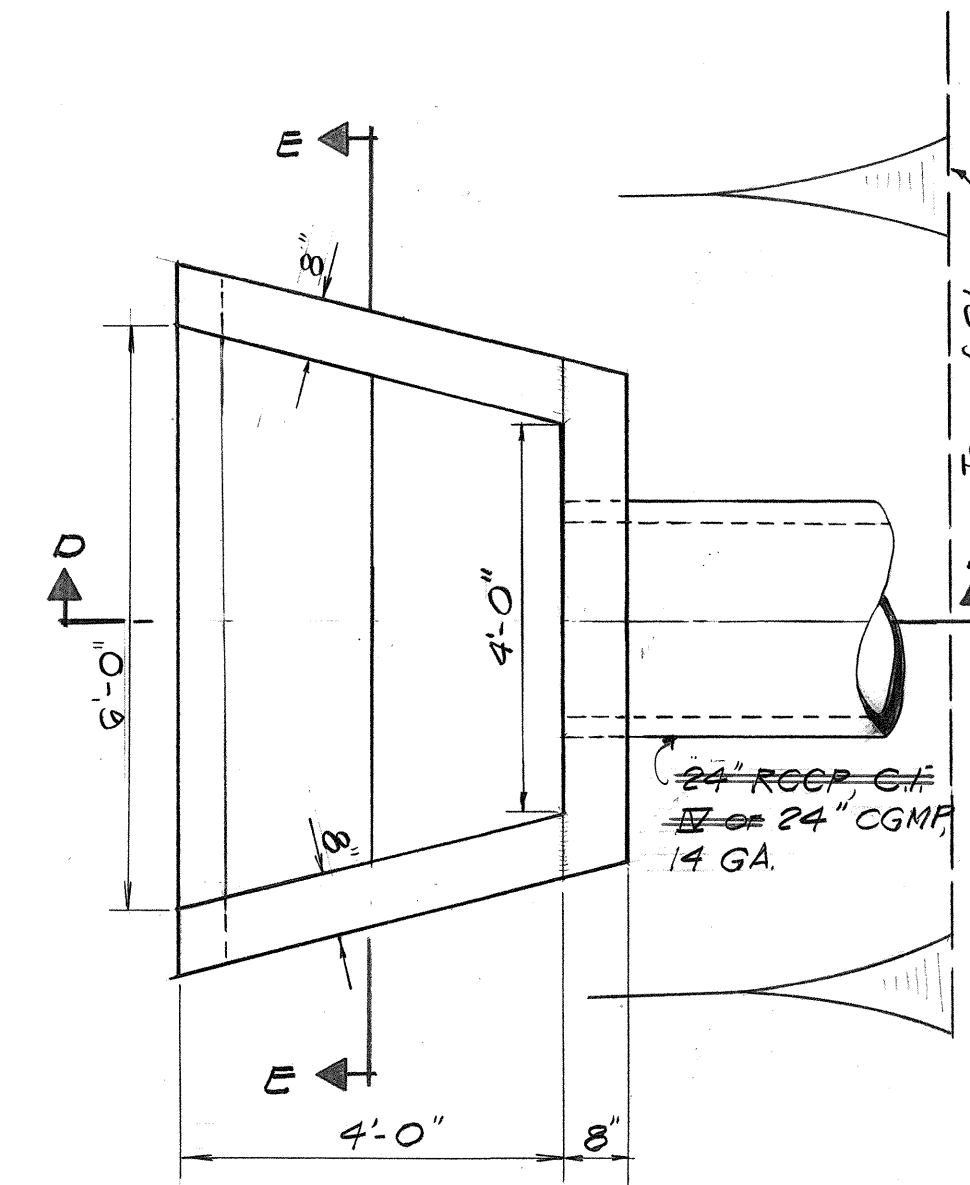


PLAN-INLETS A, B & C
Scale: 1/8"=1'-0"

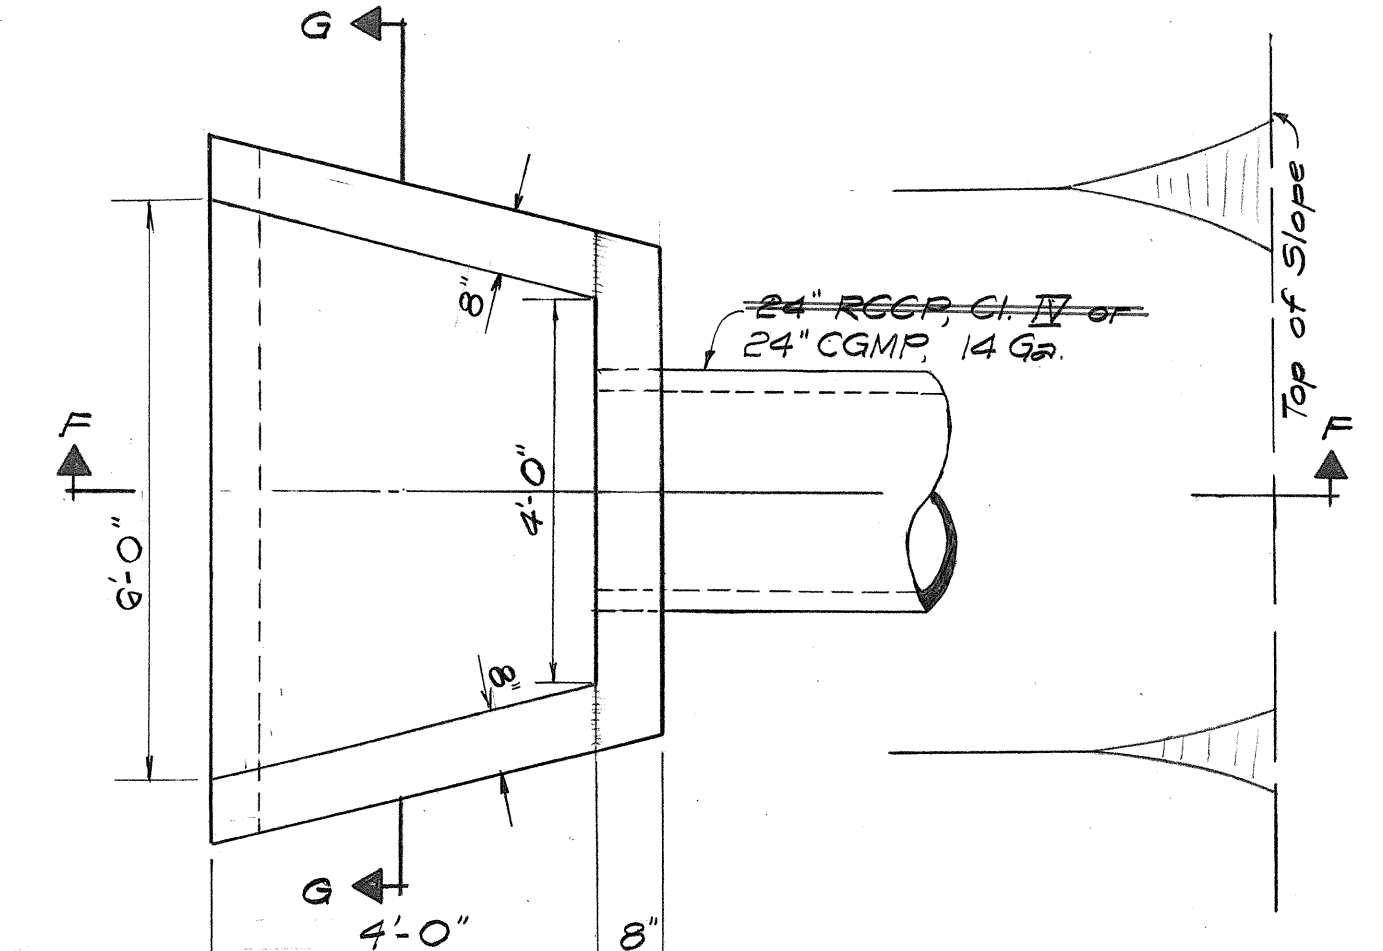


PLAN-OUTLETS #2, #3 & #4
Scale: 1/8"=1'-0"

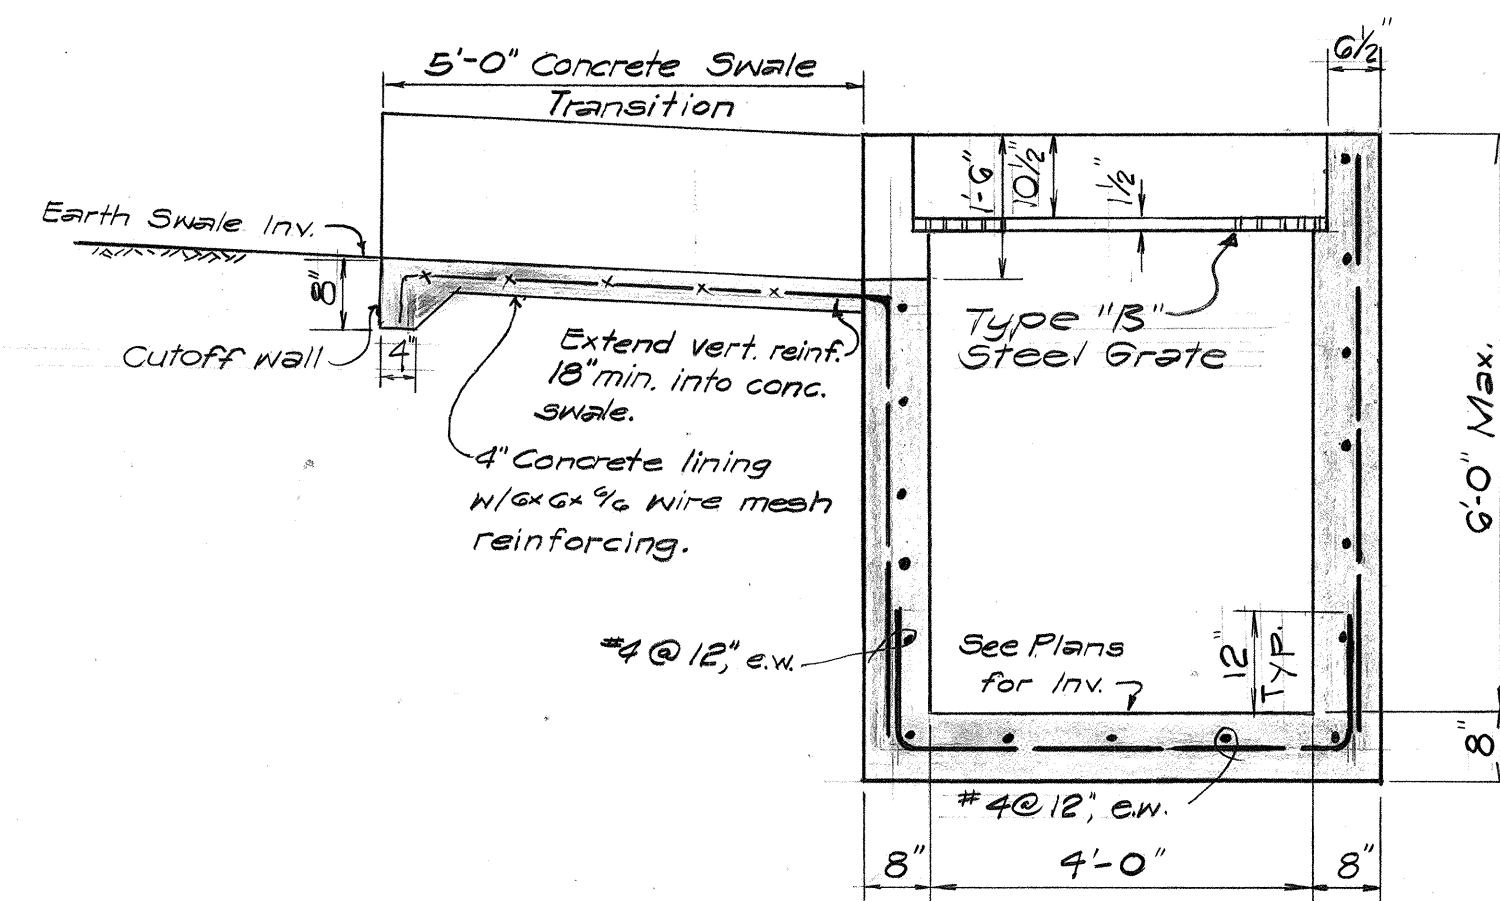


SECTION A-A
Scale: 1/8"=1'-0"

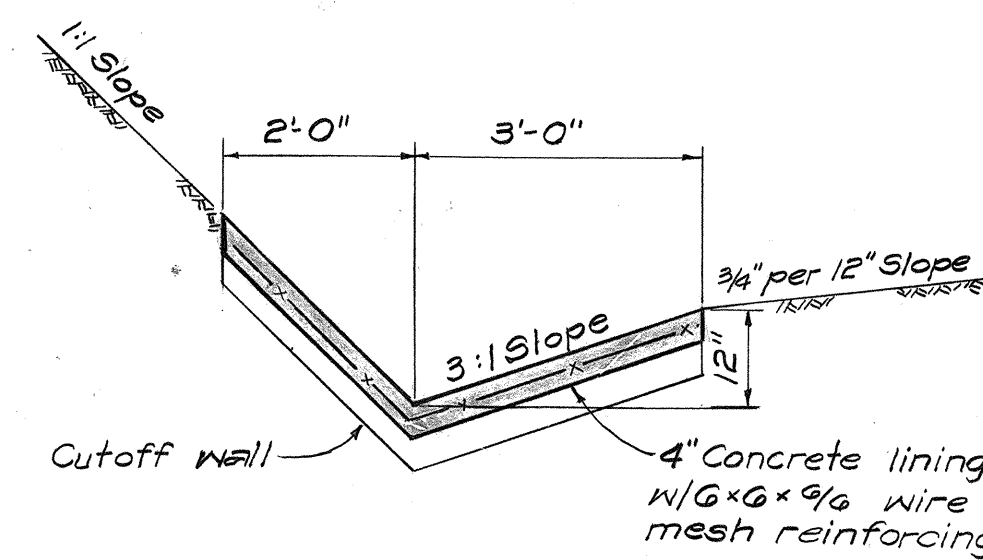


SECTION C-C
Scale: 1/8"=1'-0"

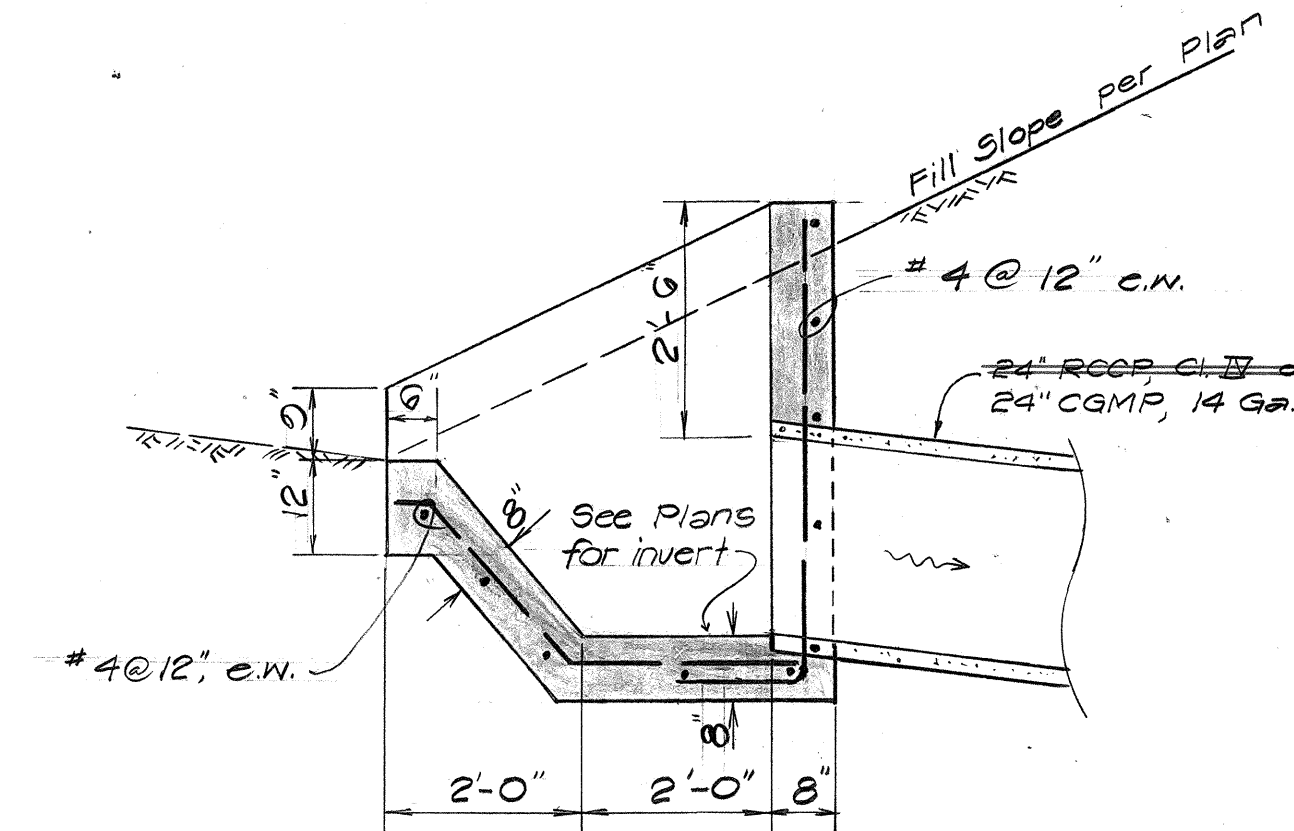

SECTION D-D
Scale: 1/8"=1'-0"

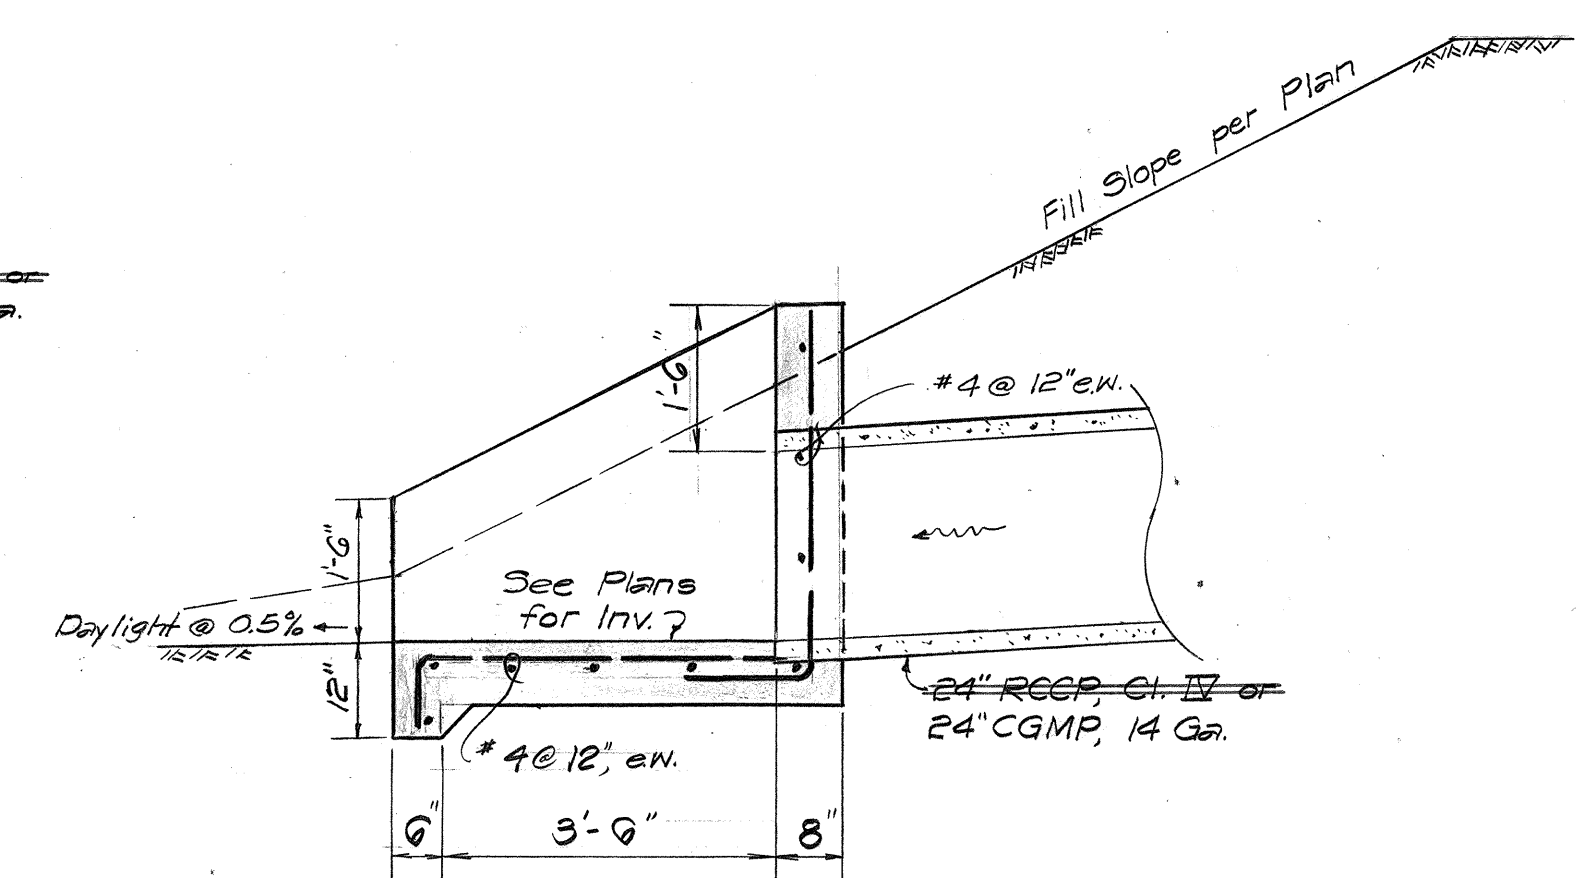


SECTION F-F
Scale: 1/8"=1'-0"

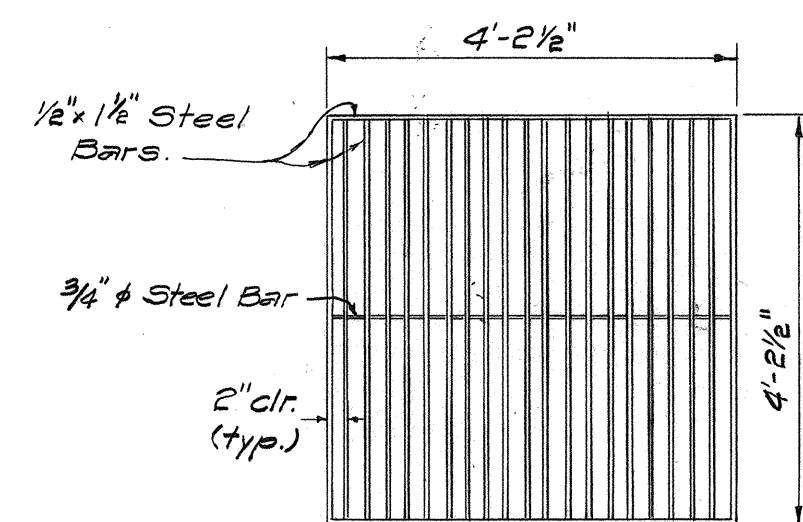


TYPE 'B' STEEL GRATE DETAIL
Scale: 1/8"=1'-0"

- NOTES:
1. All bar connections shall be arc-welded.
 2. Entire grate shall be galvanized.

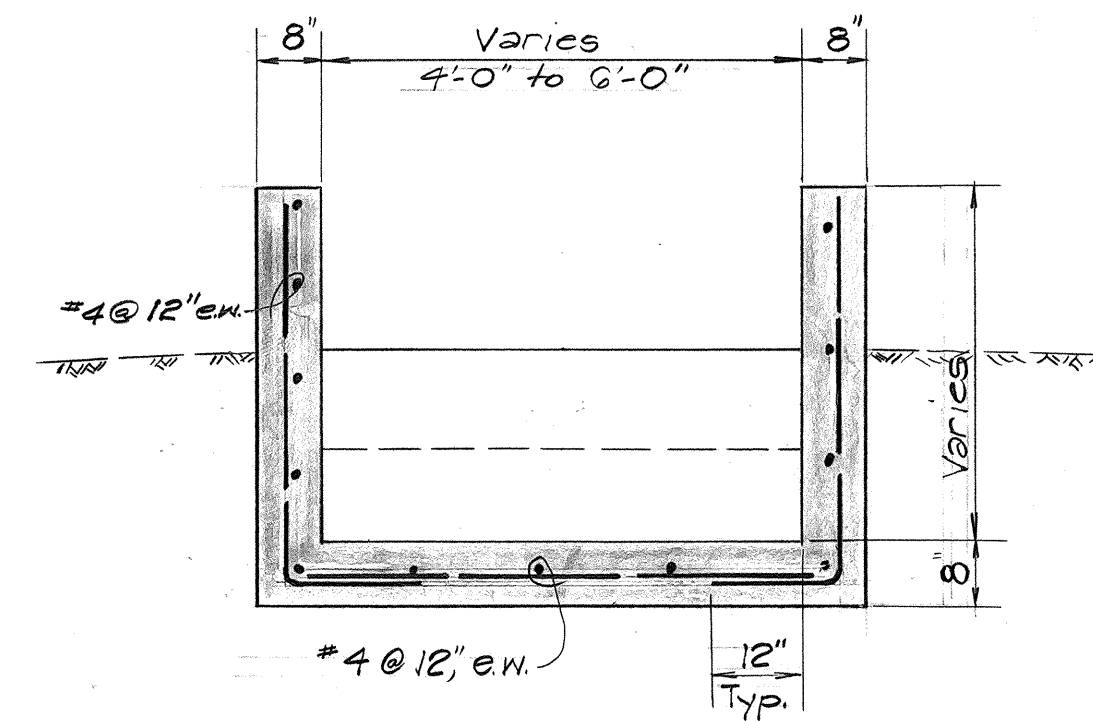

SECTION E-E
Scale: 1/8"=1'-0"

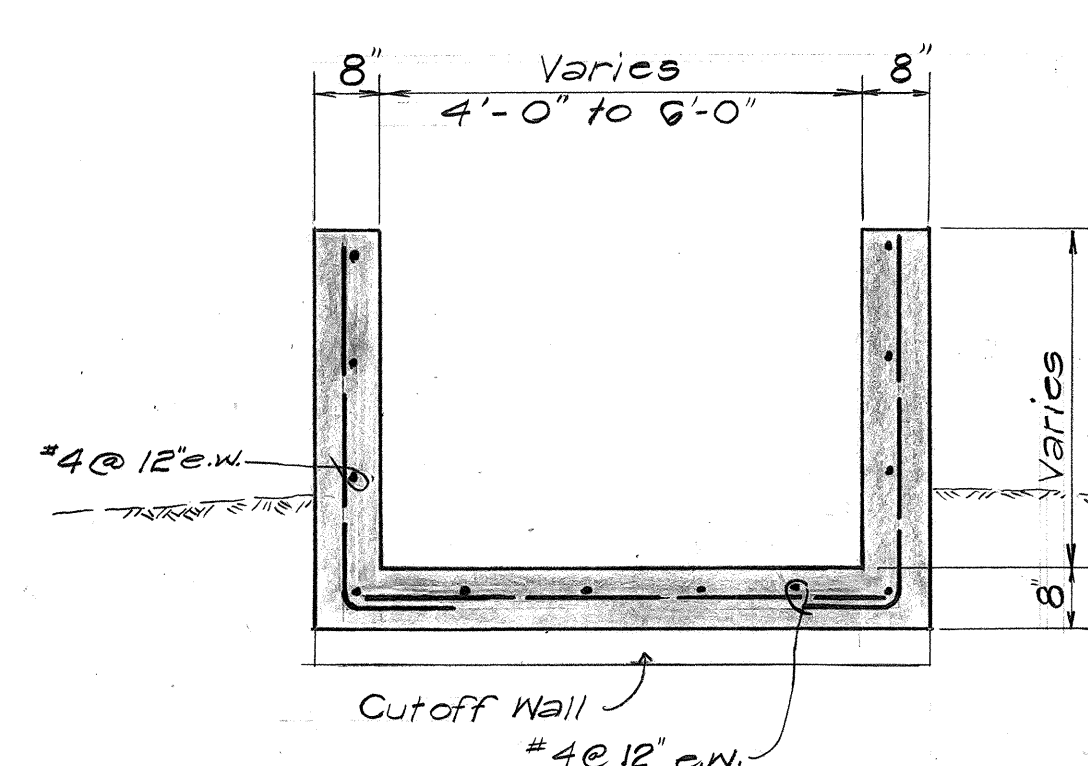

SECTION G-G
Scale: 1/8"=1'-0"



THIS WORK WAS PREPARED BY ME
OR UNDER MY SUPERVISION.


STATE OF HAWAII
DEPARTMENT OF TRANSPORTATION
HIGHWAYS DIVISION

DRAINAGE DETAILS

WAIAWA INTERCHANGE
F.A.I. Proj. No. I - HI - 1(36)8


Scale: As shown Date: OCT 1967
SHEET No. OF SHEETS

FED. ROAD DIST. NO.	STATE	FED. AID PROJ. NO.	FISCAL YEAR	SHEET NO.	TOTAL SHEETS
HAWAII	HAW.	I-HI-1(36)8	1967	28	124

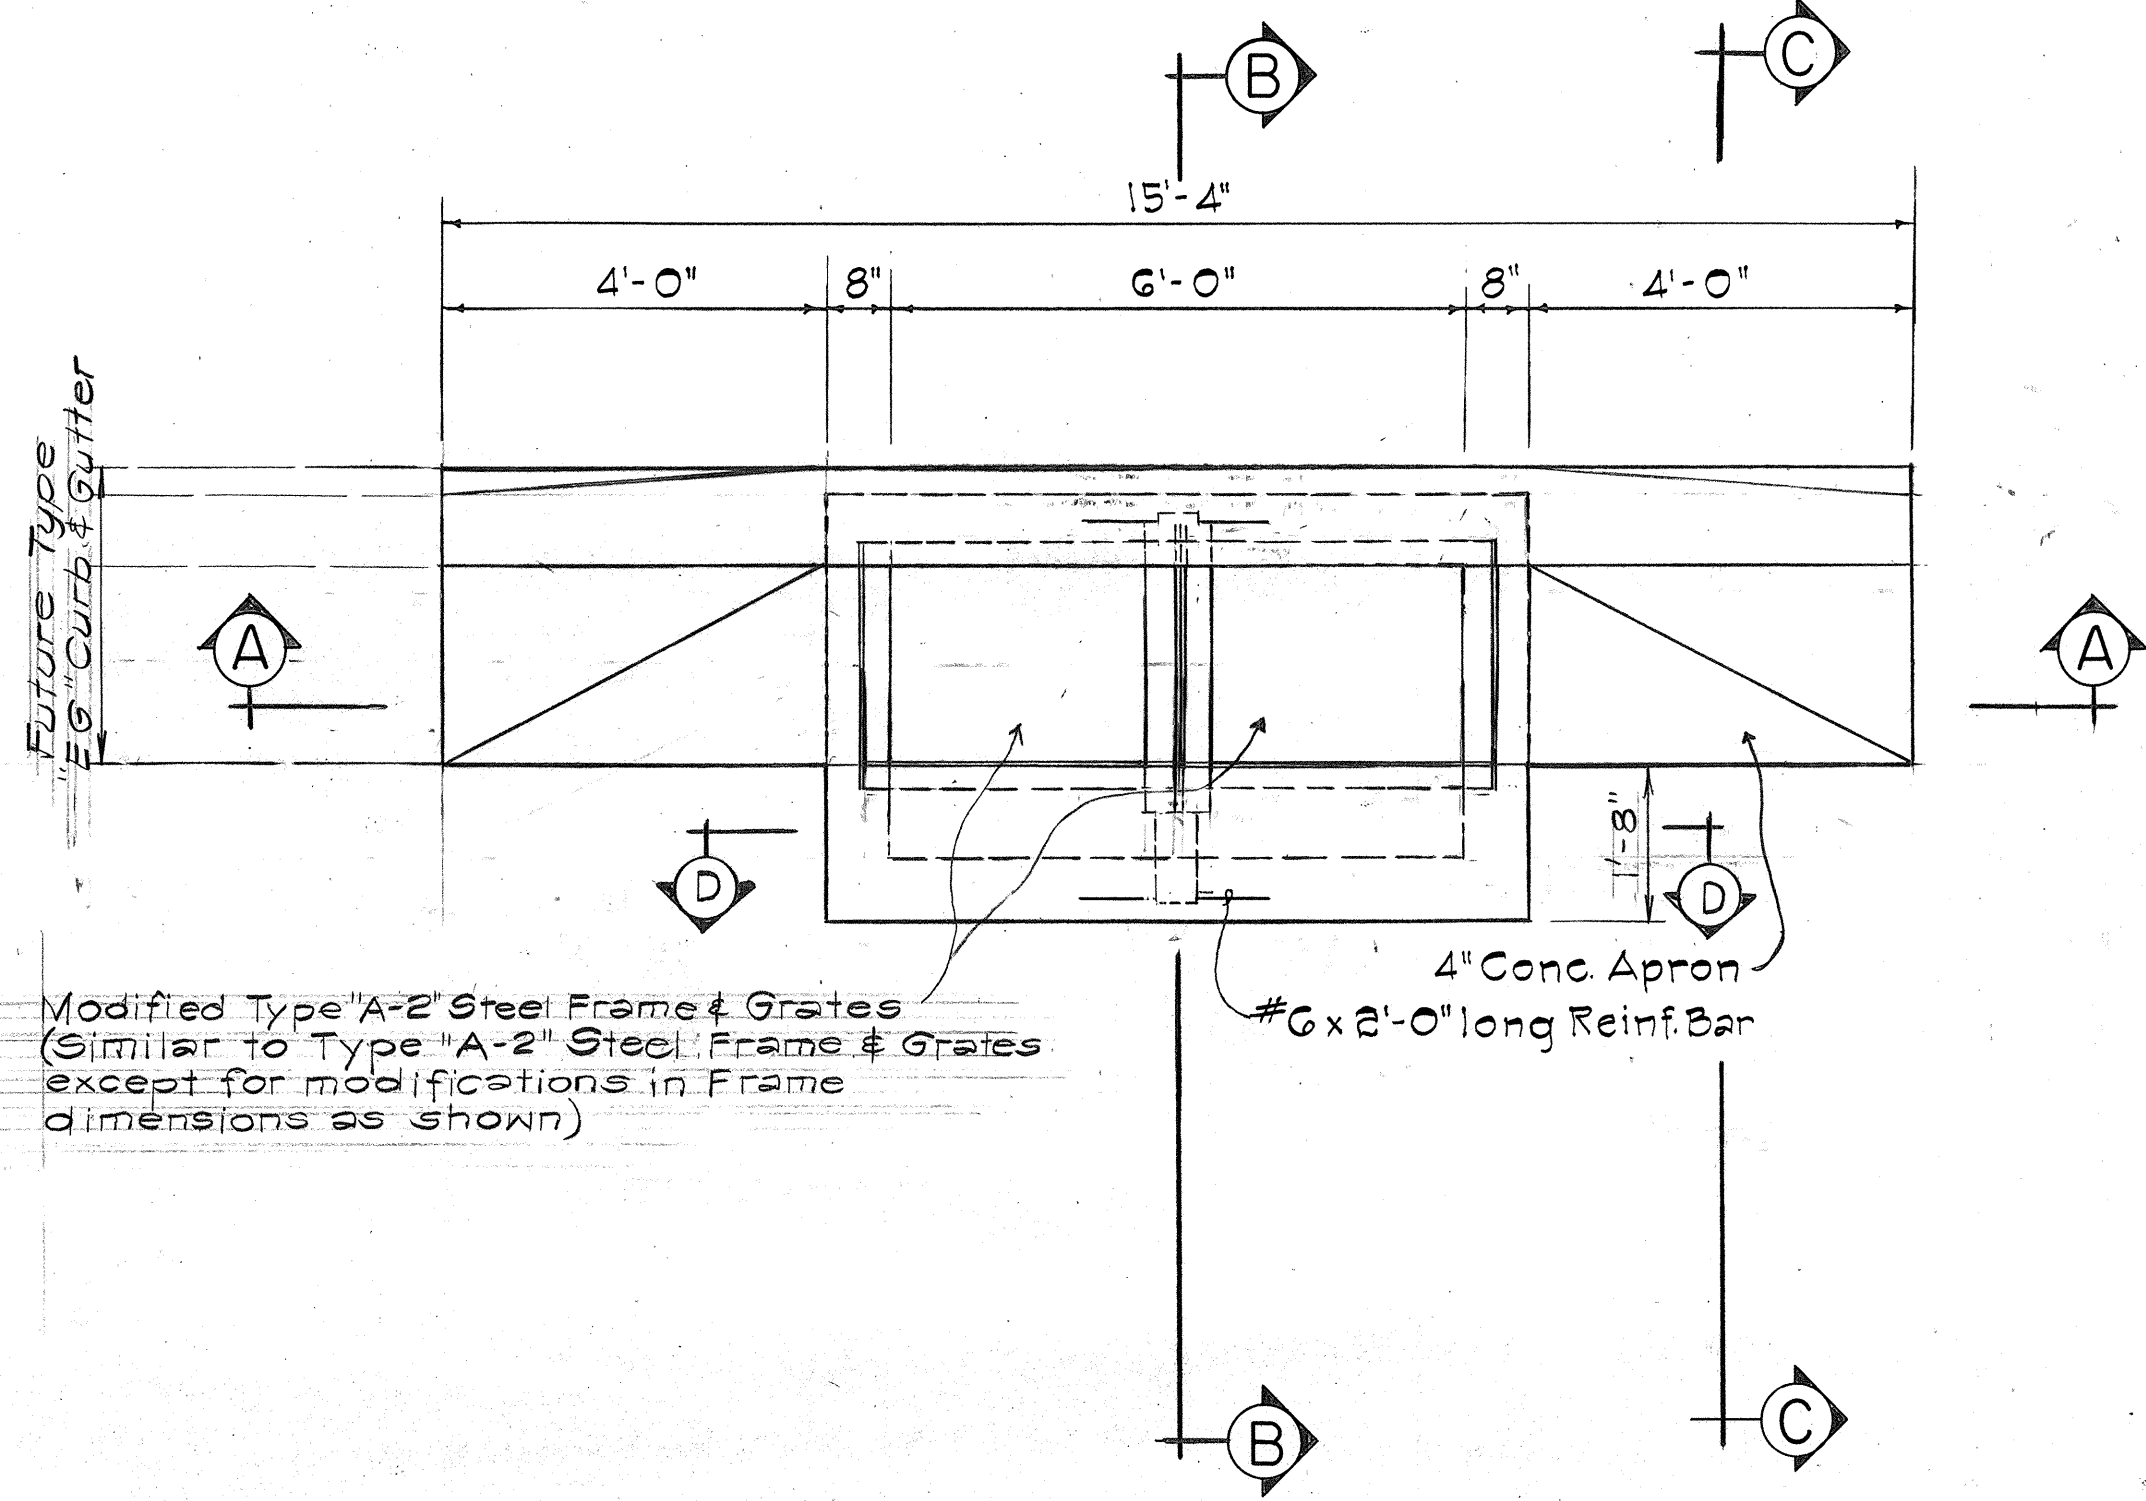


Modified Type "A-2" Steel Frame & Grates (Similar to Type "A-2" Steel Frame & Grates except for modifications in Frame dimensions as shown)


PLAN
Scale: 1/2" = 1' - 0"

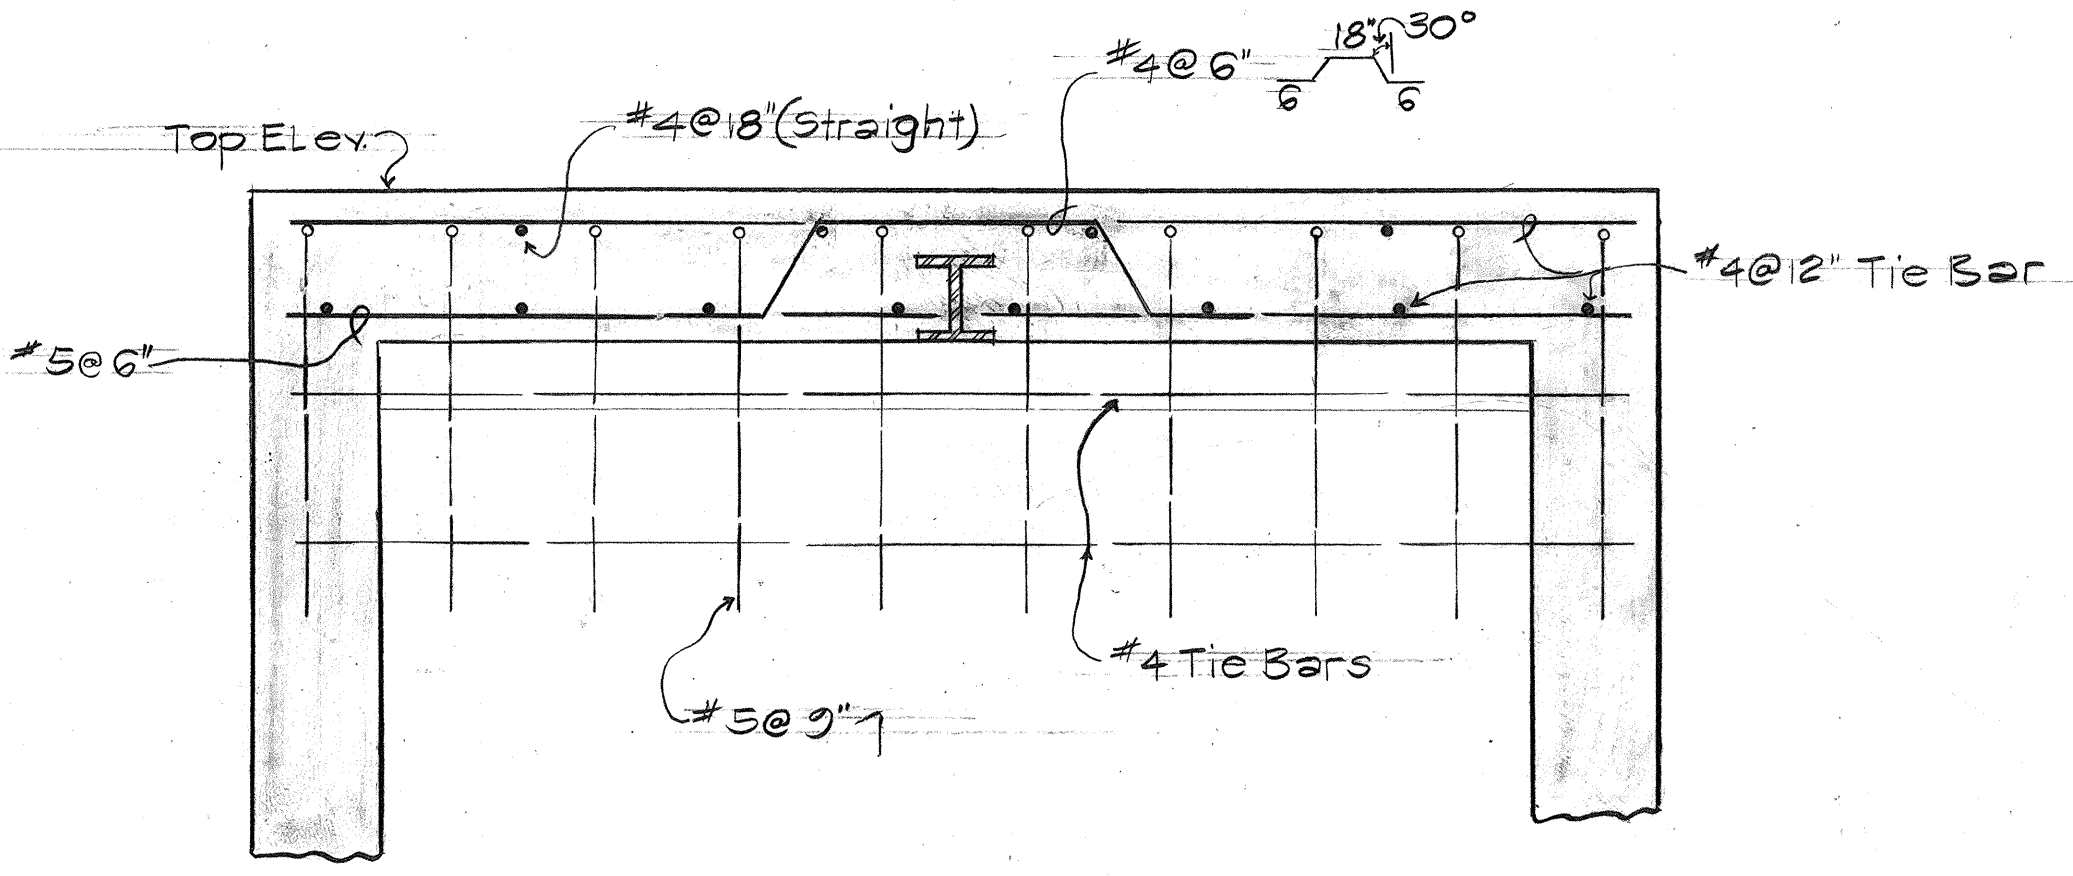


SECTION D-D
Scale: 1" = 1' - 0"

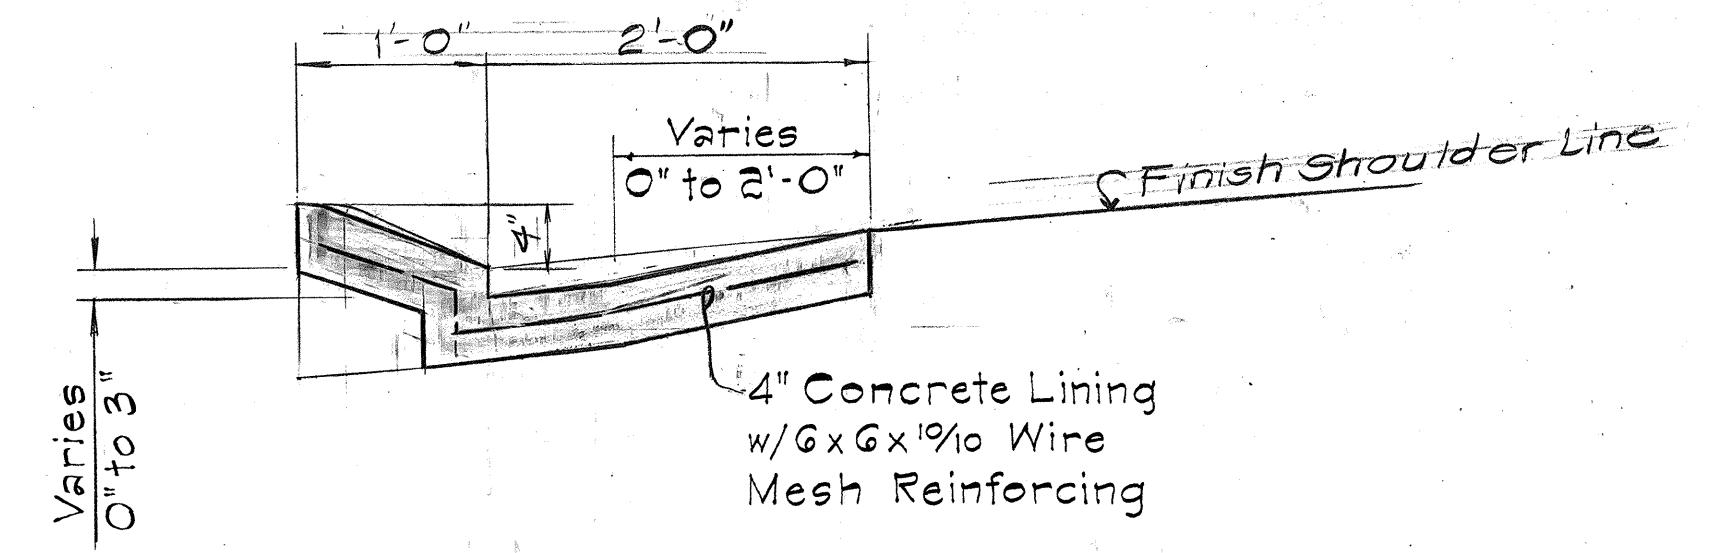

SECTION C-C
Scale: 1" = 1' - 0"

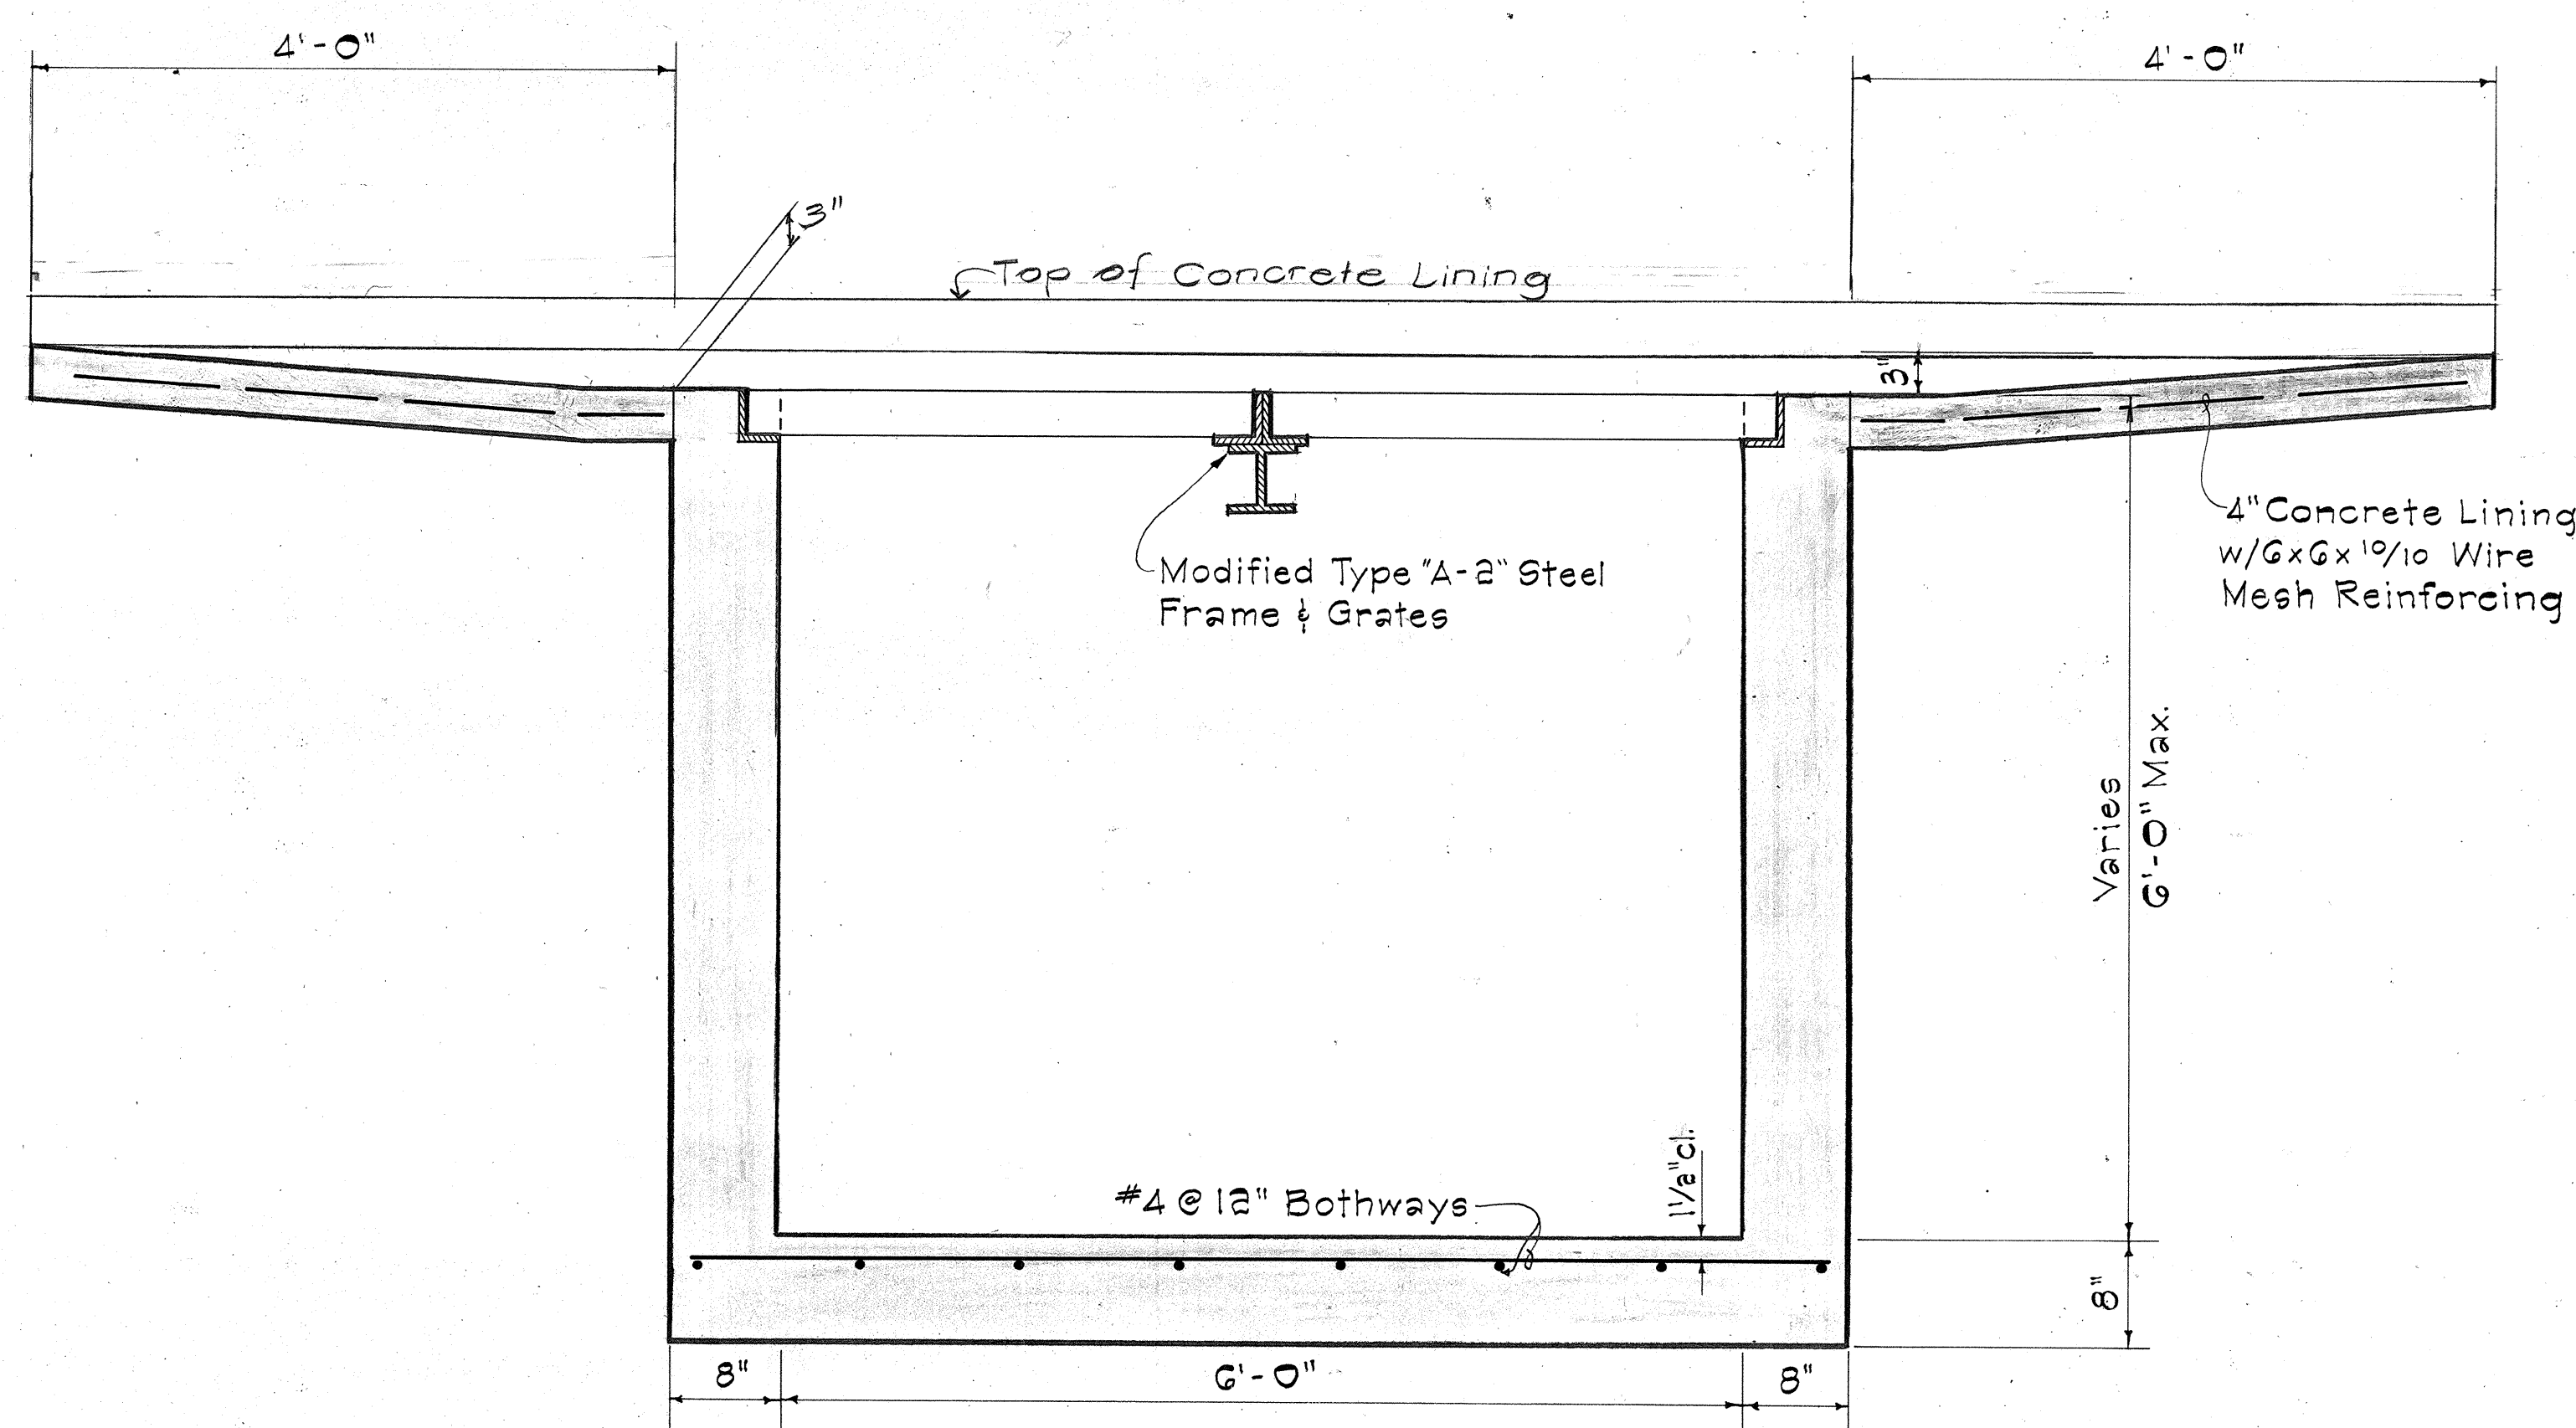


SECTION A-A
Scale: 1" = 1' - 0"

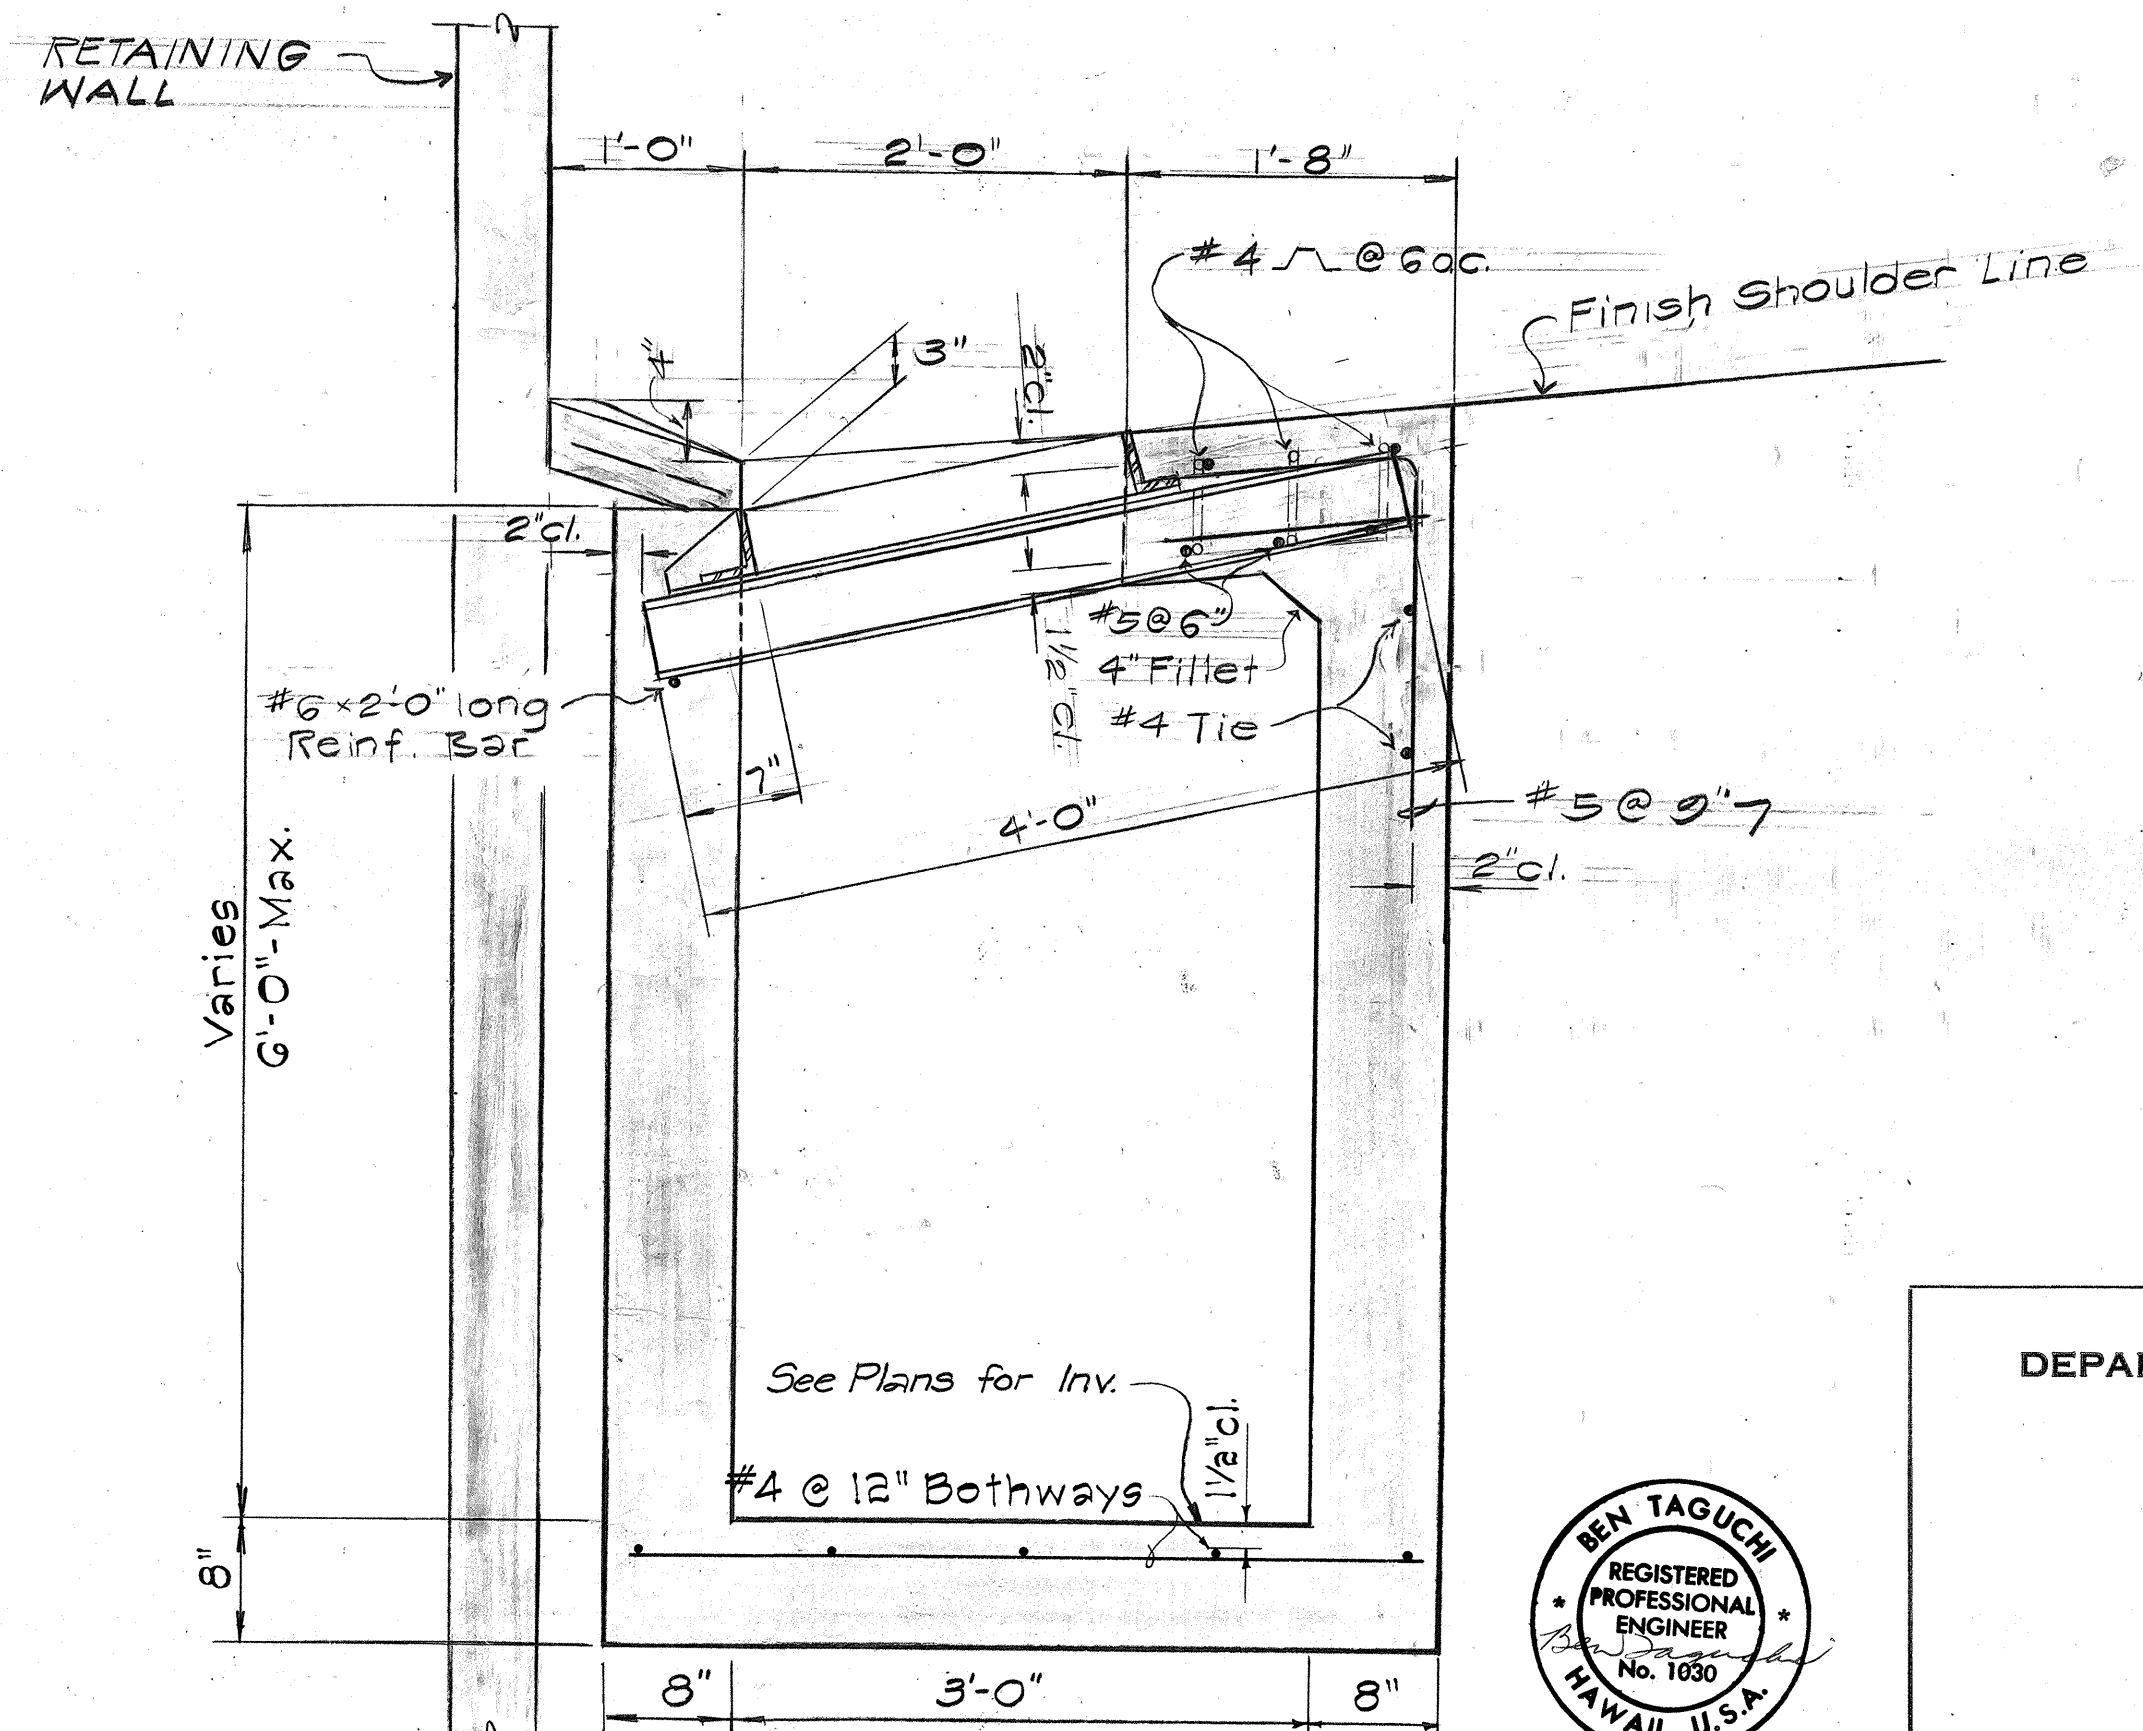

SECTION B-B
Scale: 1" = 1' - 0"

ORIGINAL PLAN	DATE
DESIGNED BY	
TRACED BY	
NOTE BOOK	
QUANTITIES BY	
CHECKED BY	

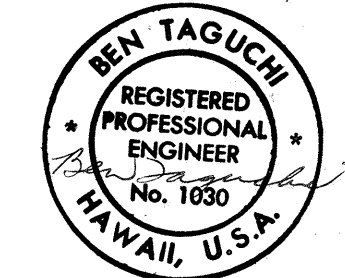

STATE OF HAWAII
DEPARTMENT OF TRANSPORTATION
HIGHWAYS DIVISION


**DRAINAGE DETAILS
(TYPE "A" INLET)**

WAIAWA INTERCHANGE
F.A.I. Proj. No. I - HI - 1(36)8


Scale: As shown Date: OCT 1967

SHEET No. OF SHEETS


FED. ROAD DIST. NO.	STATE	FED. AID PROJ. NO.	FISCAL YEAR	SHEET NO.	TOTAL SHEETS
HAWAII	HAW.	I-HI-1(36)8	1967	23	124

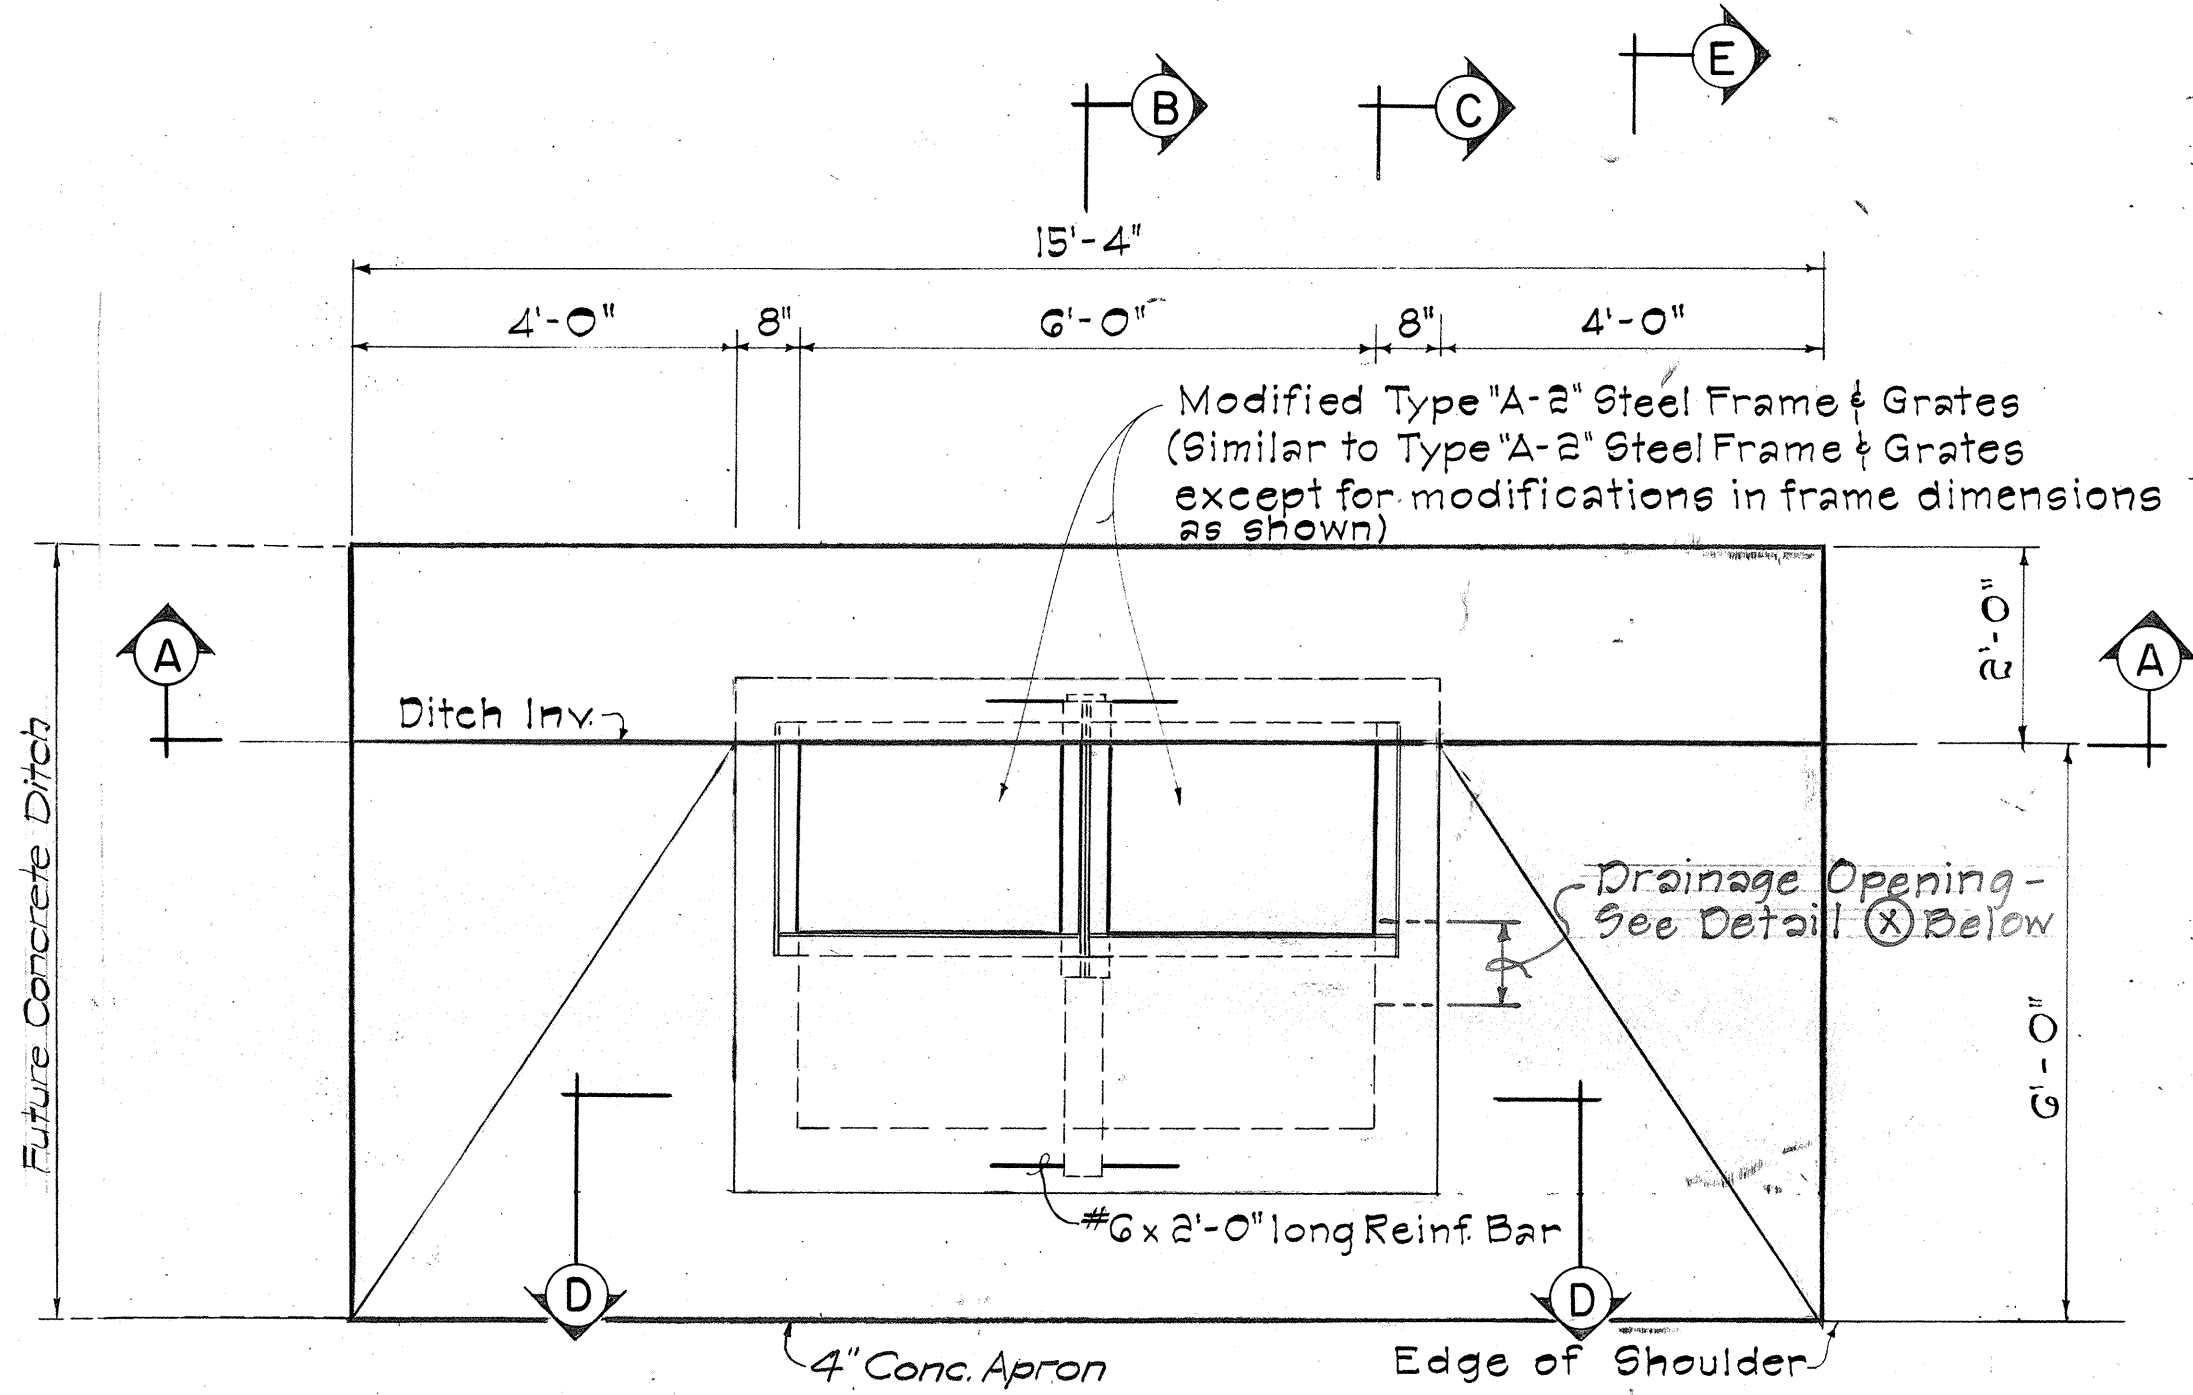


PLAN
Scale: 1/2" = 1'-0"

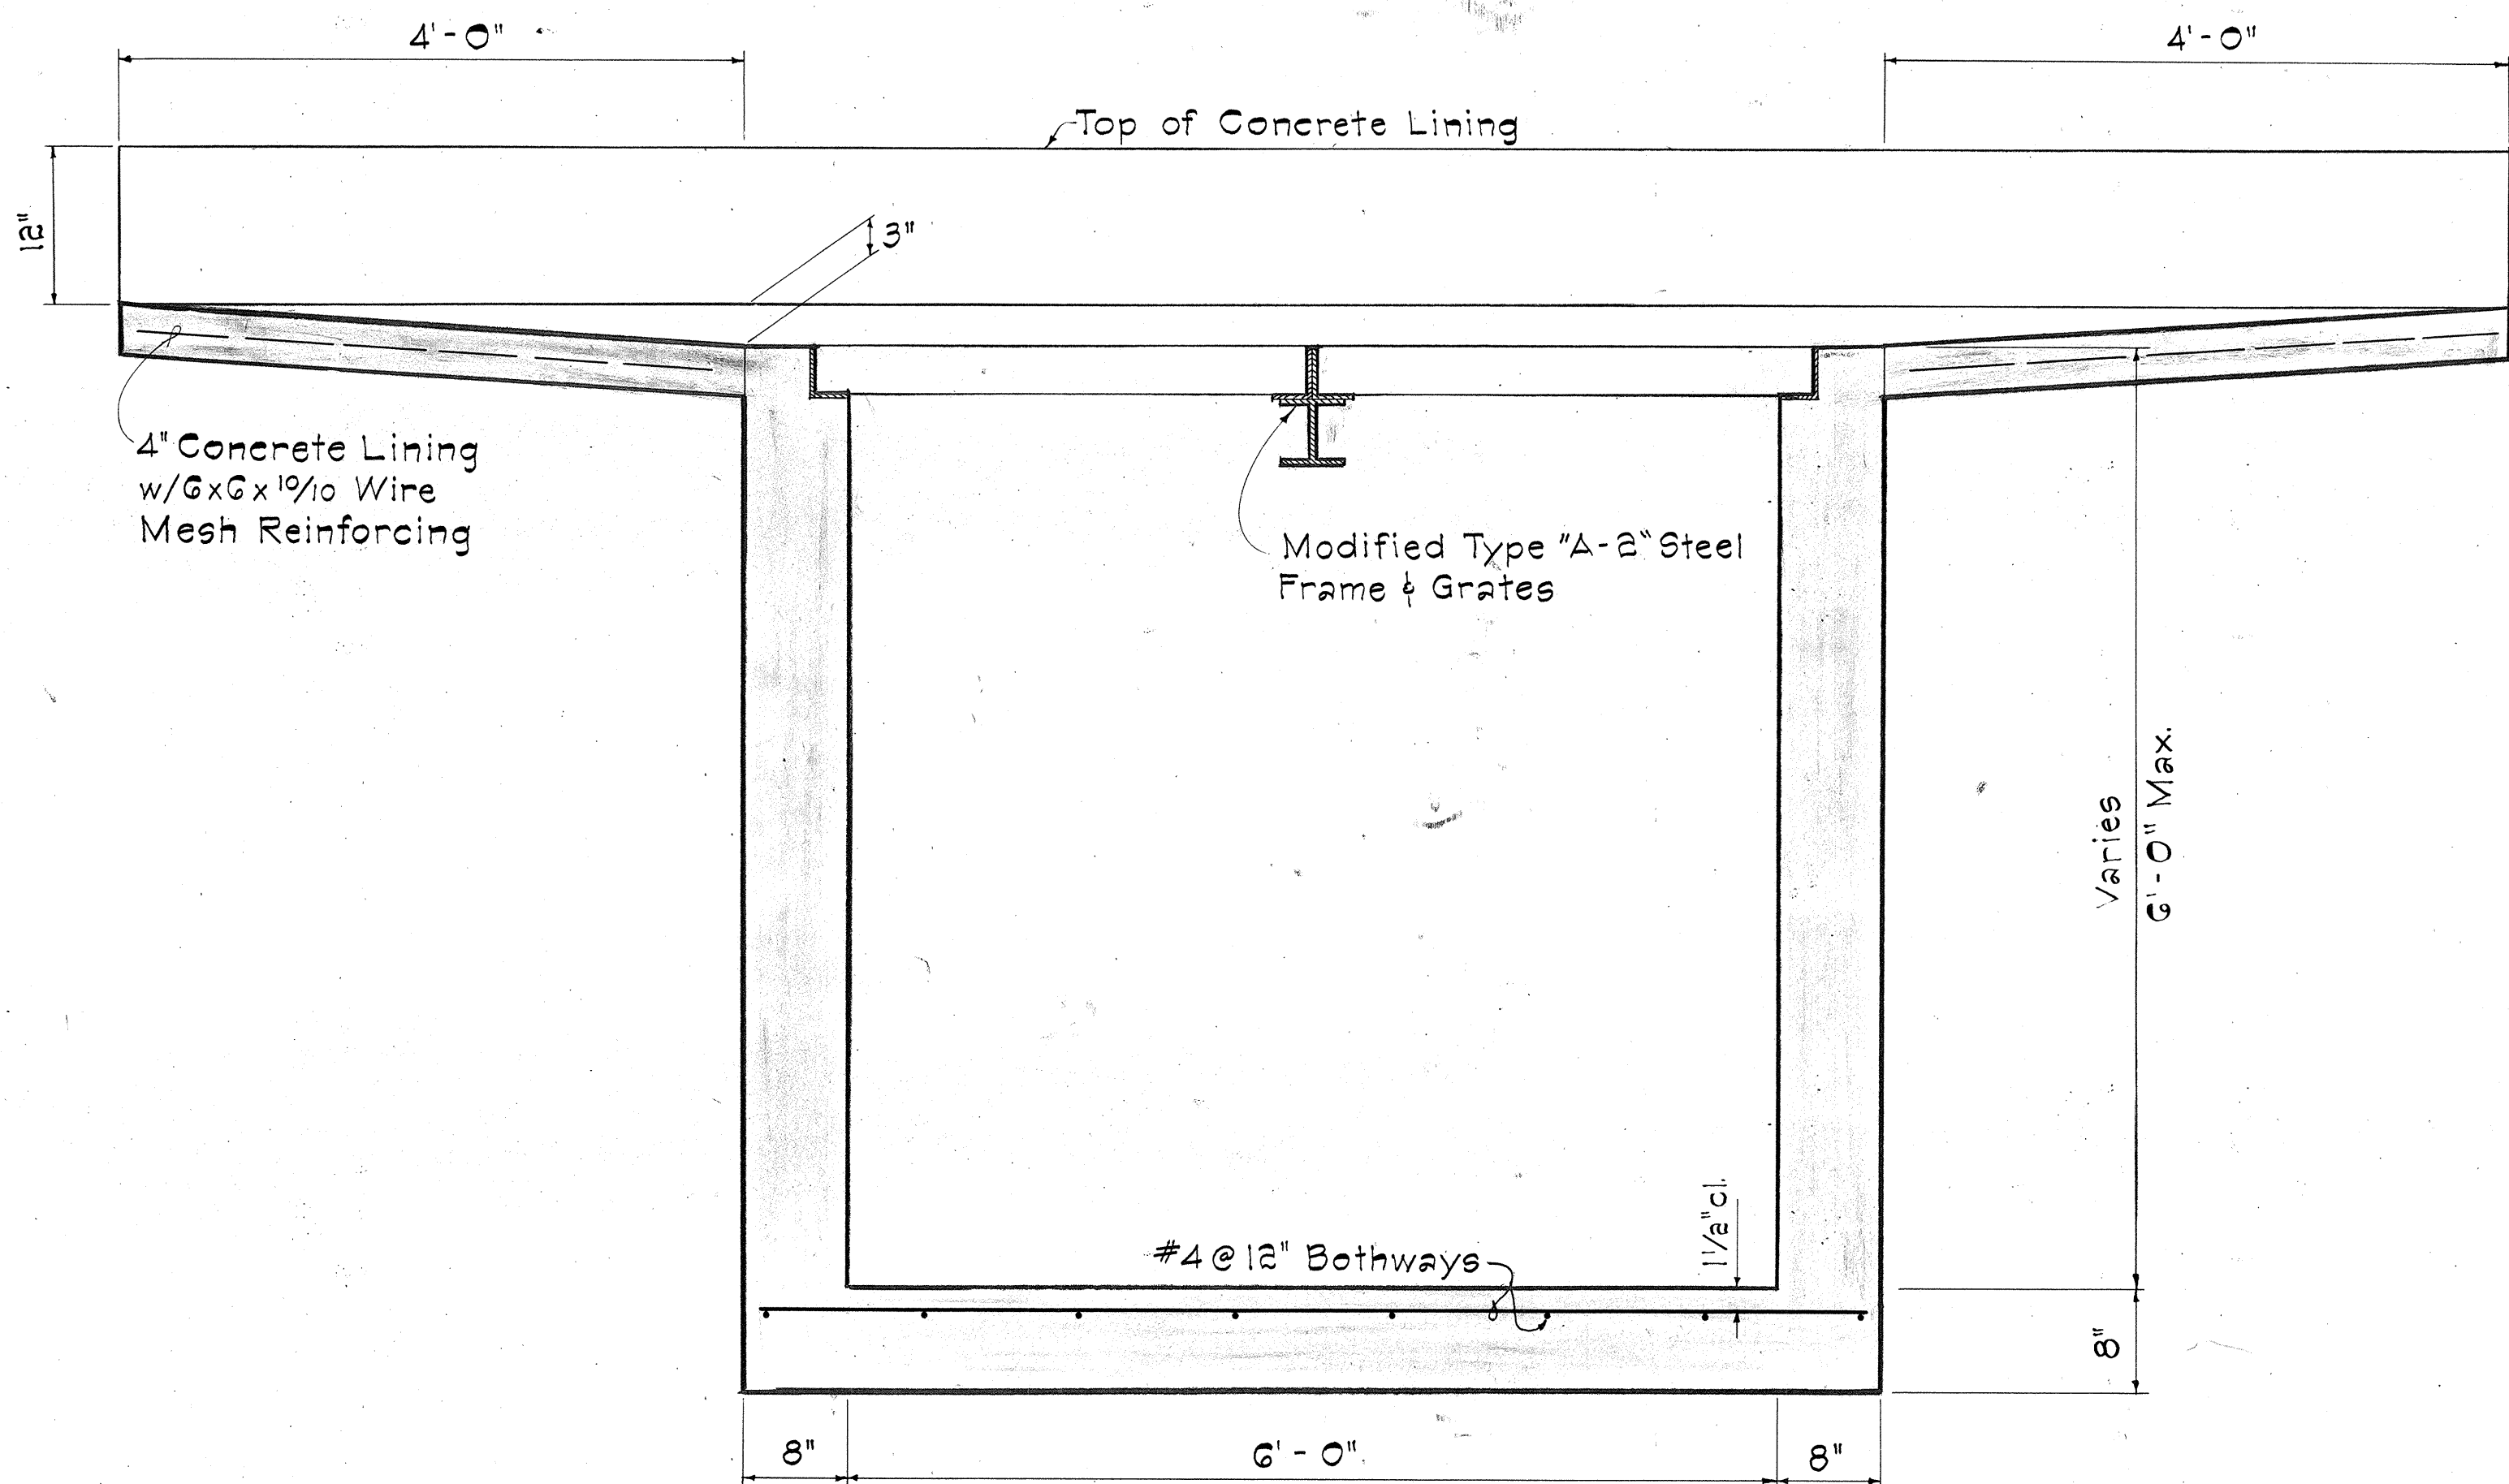


SECTION A-A
Scale: 1" = 1'-0"

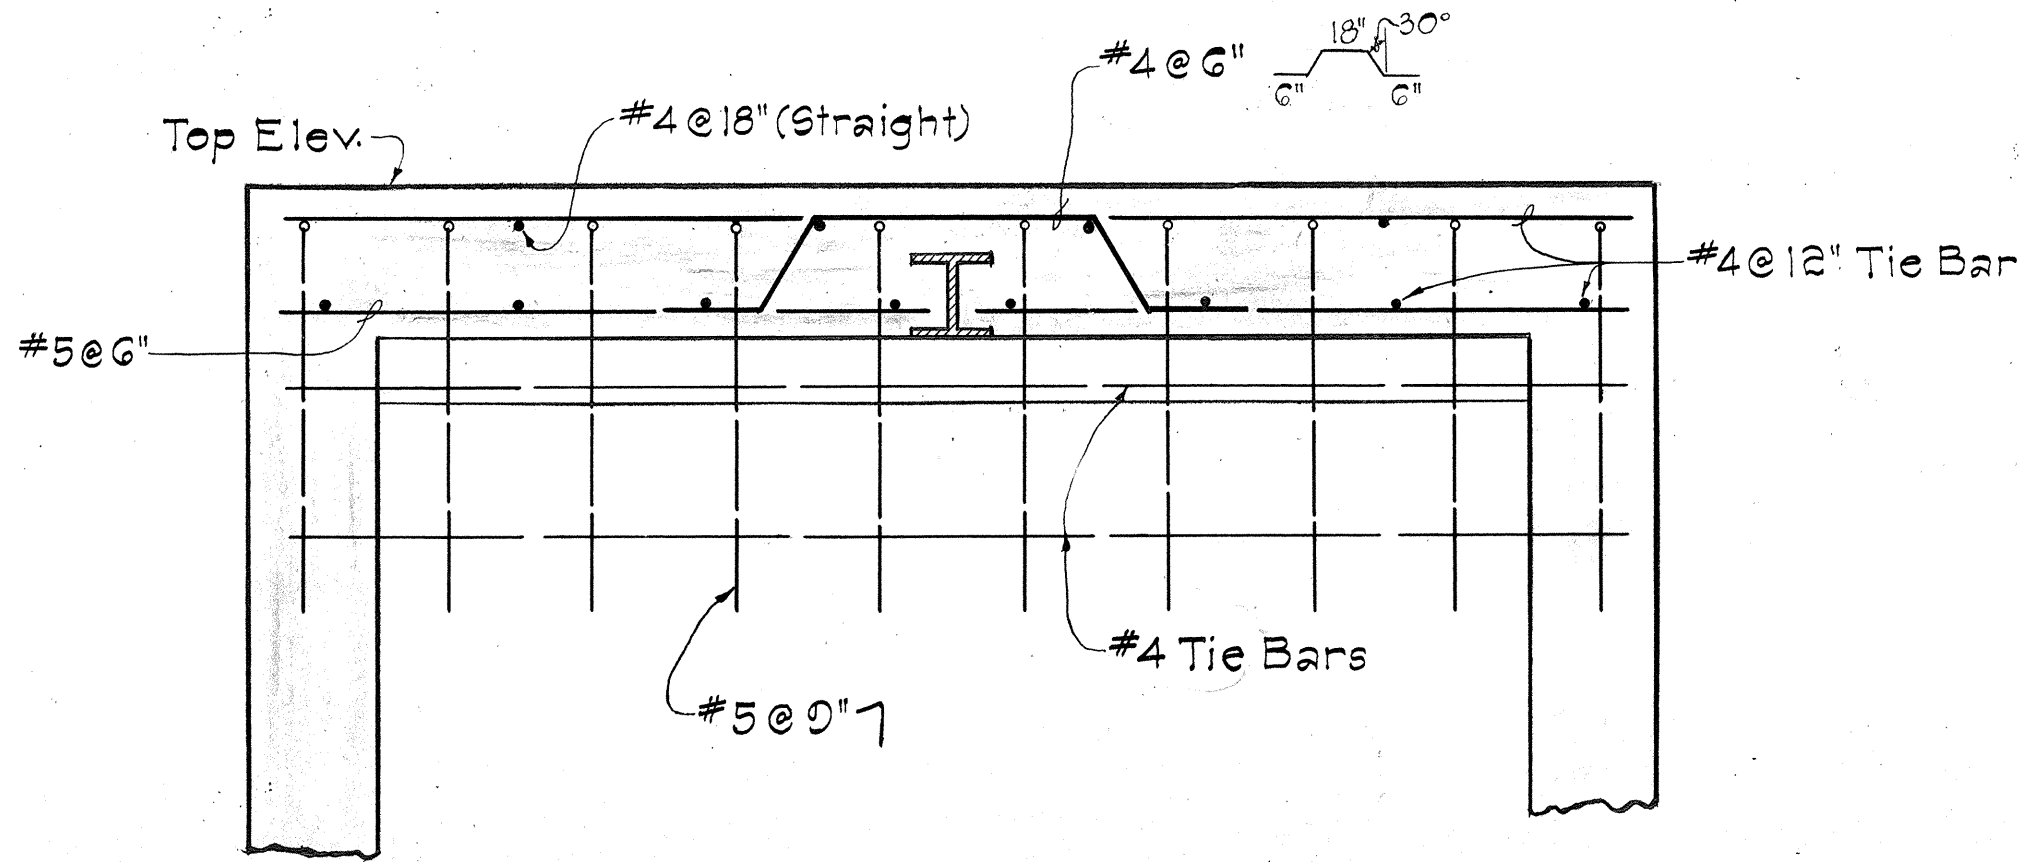


SECTION D-D
Scale: 1" = 1'-0"

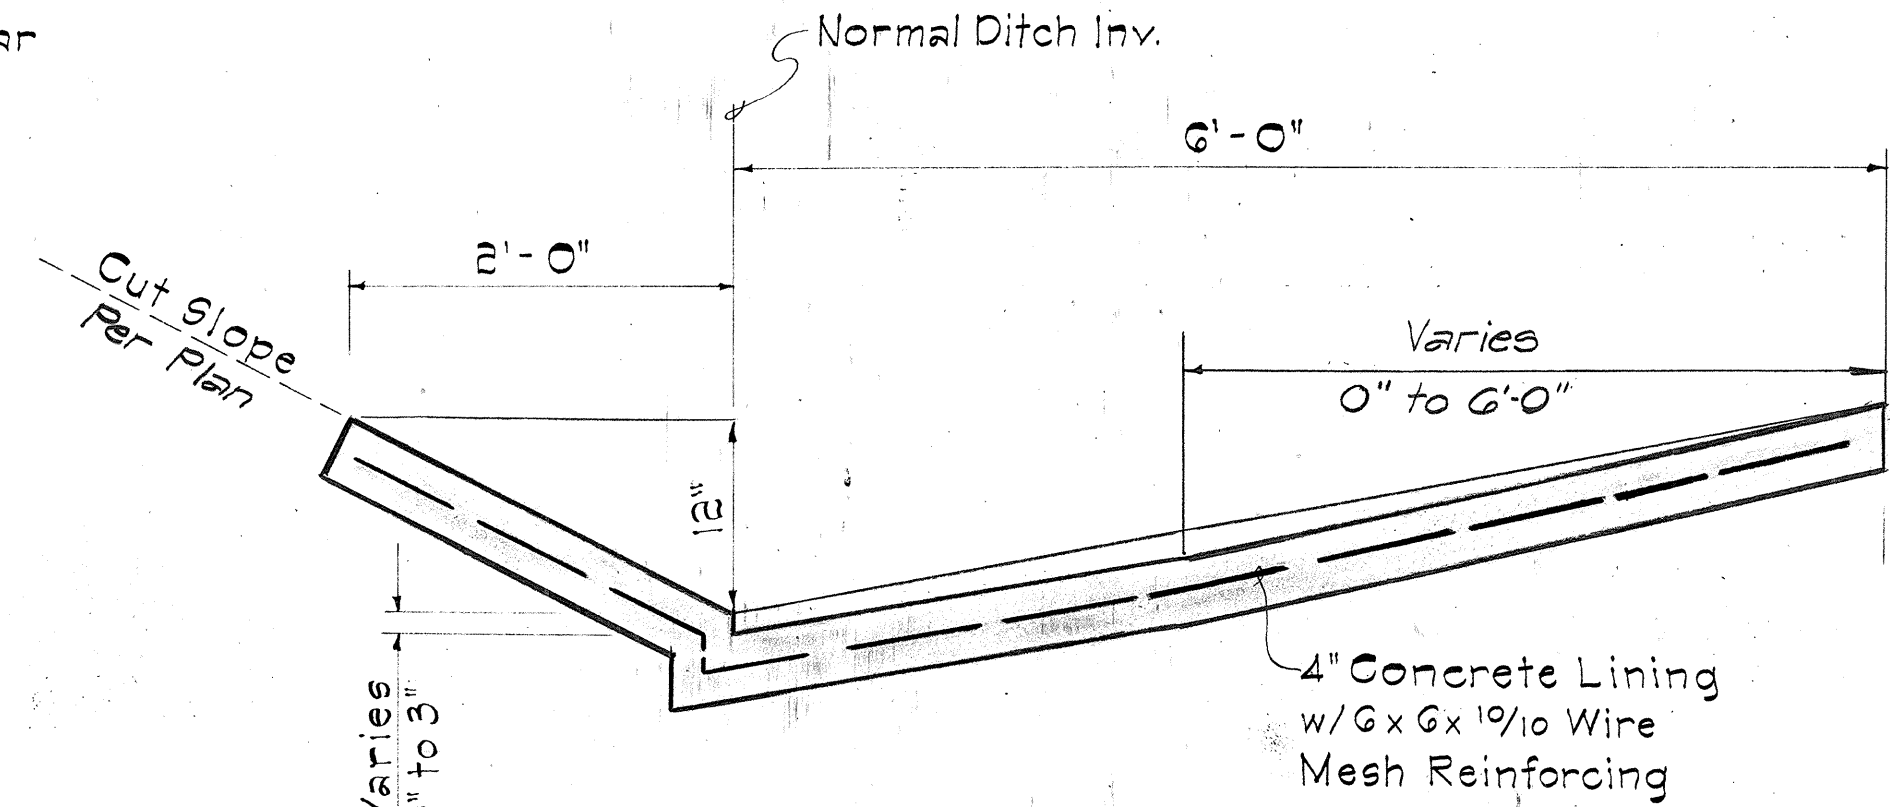


SECTION E-E
Scale: 1" = 1'-0"

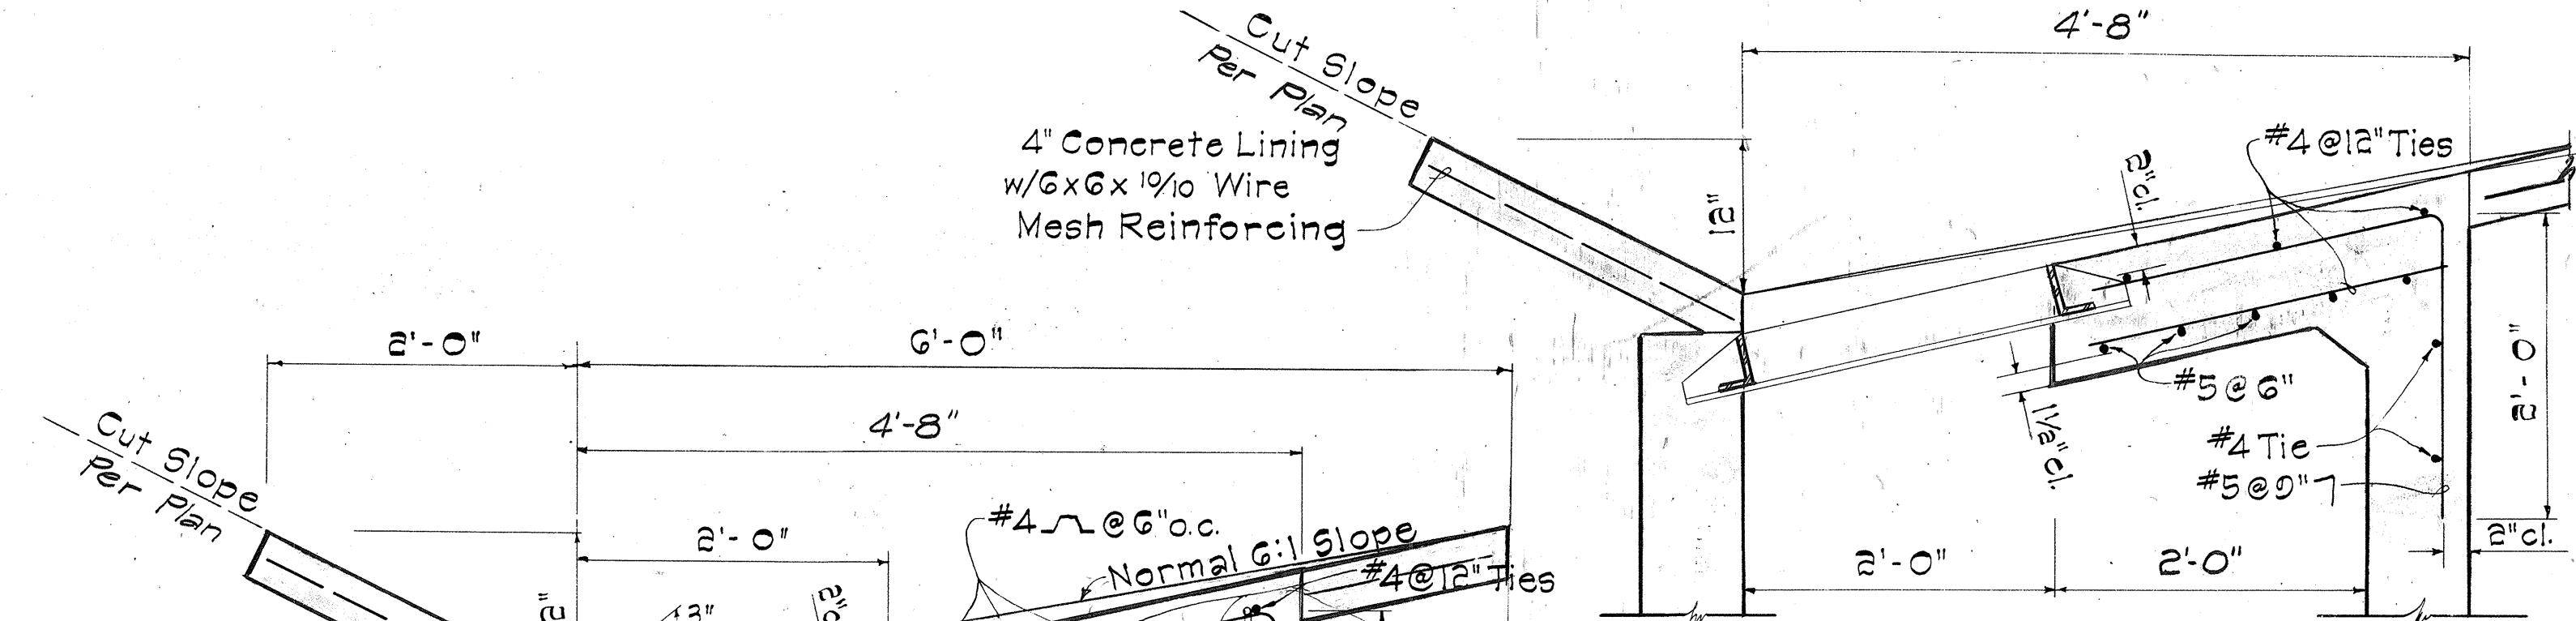

SECTION C-C
Scale: 1" = 1'-0"

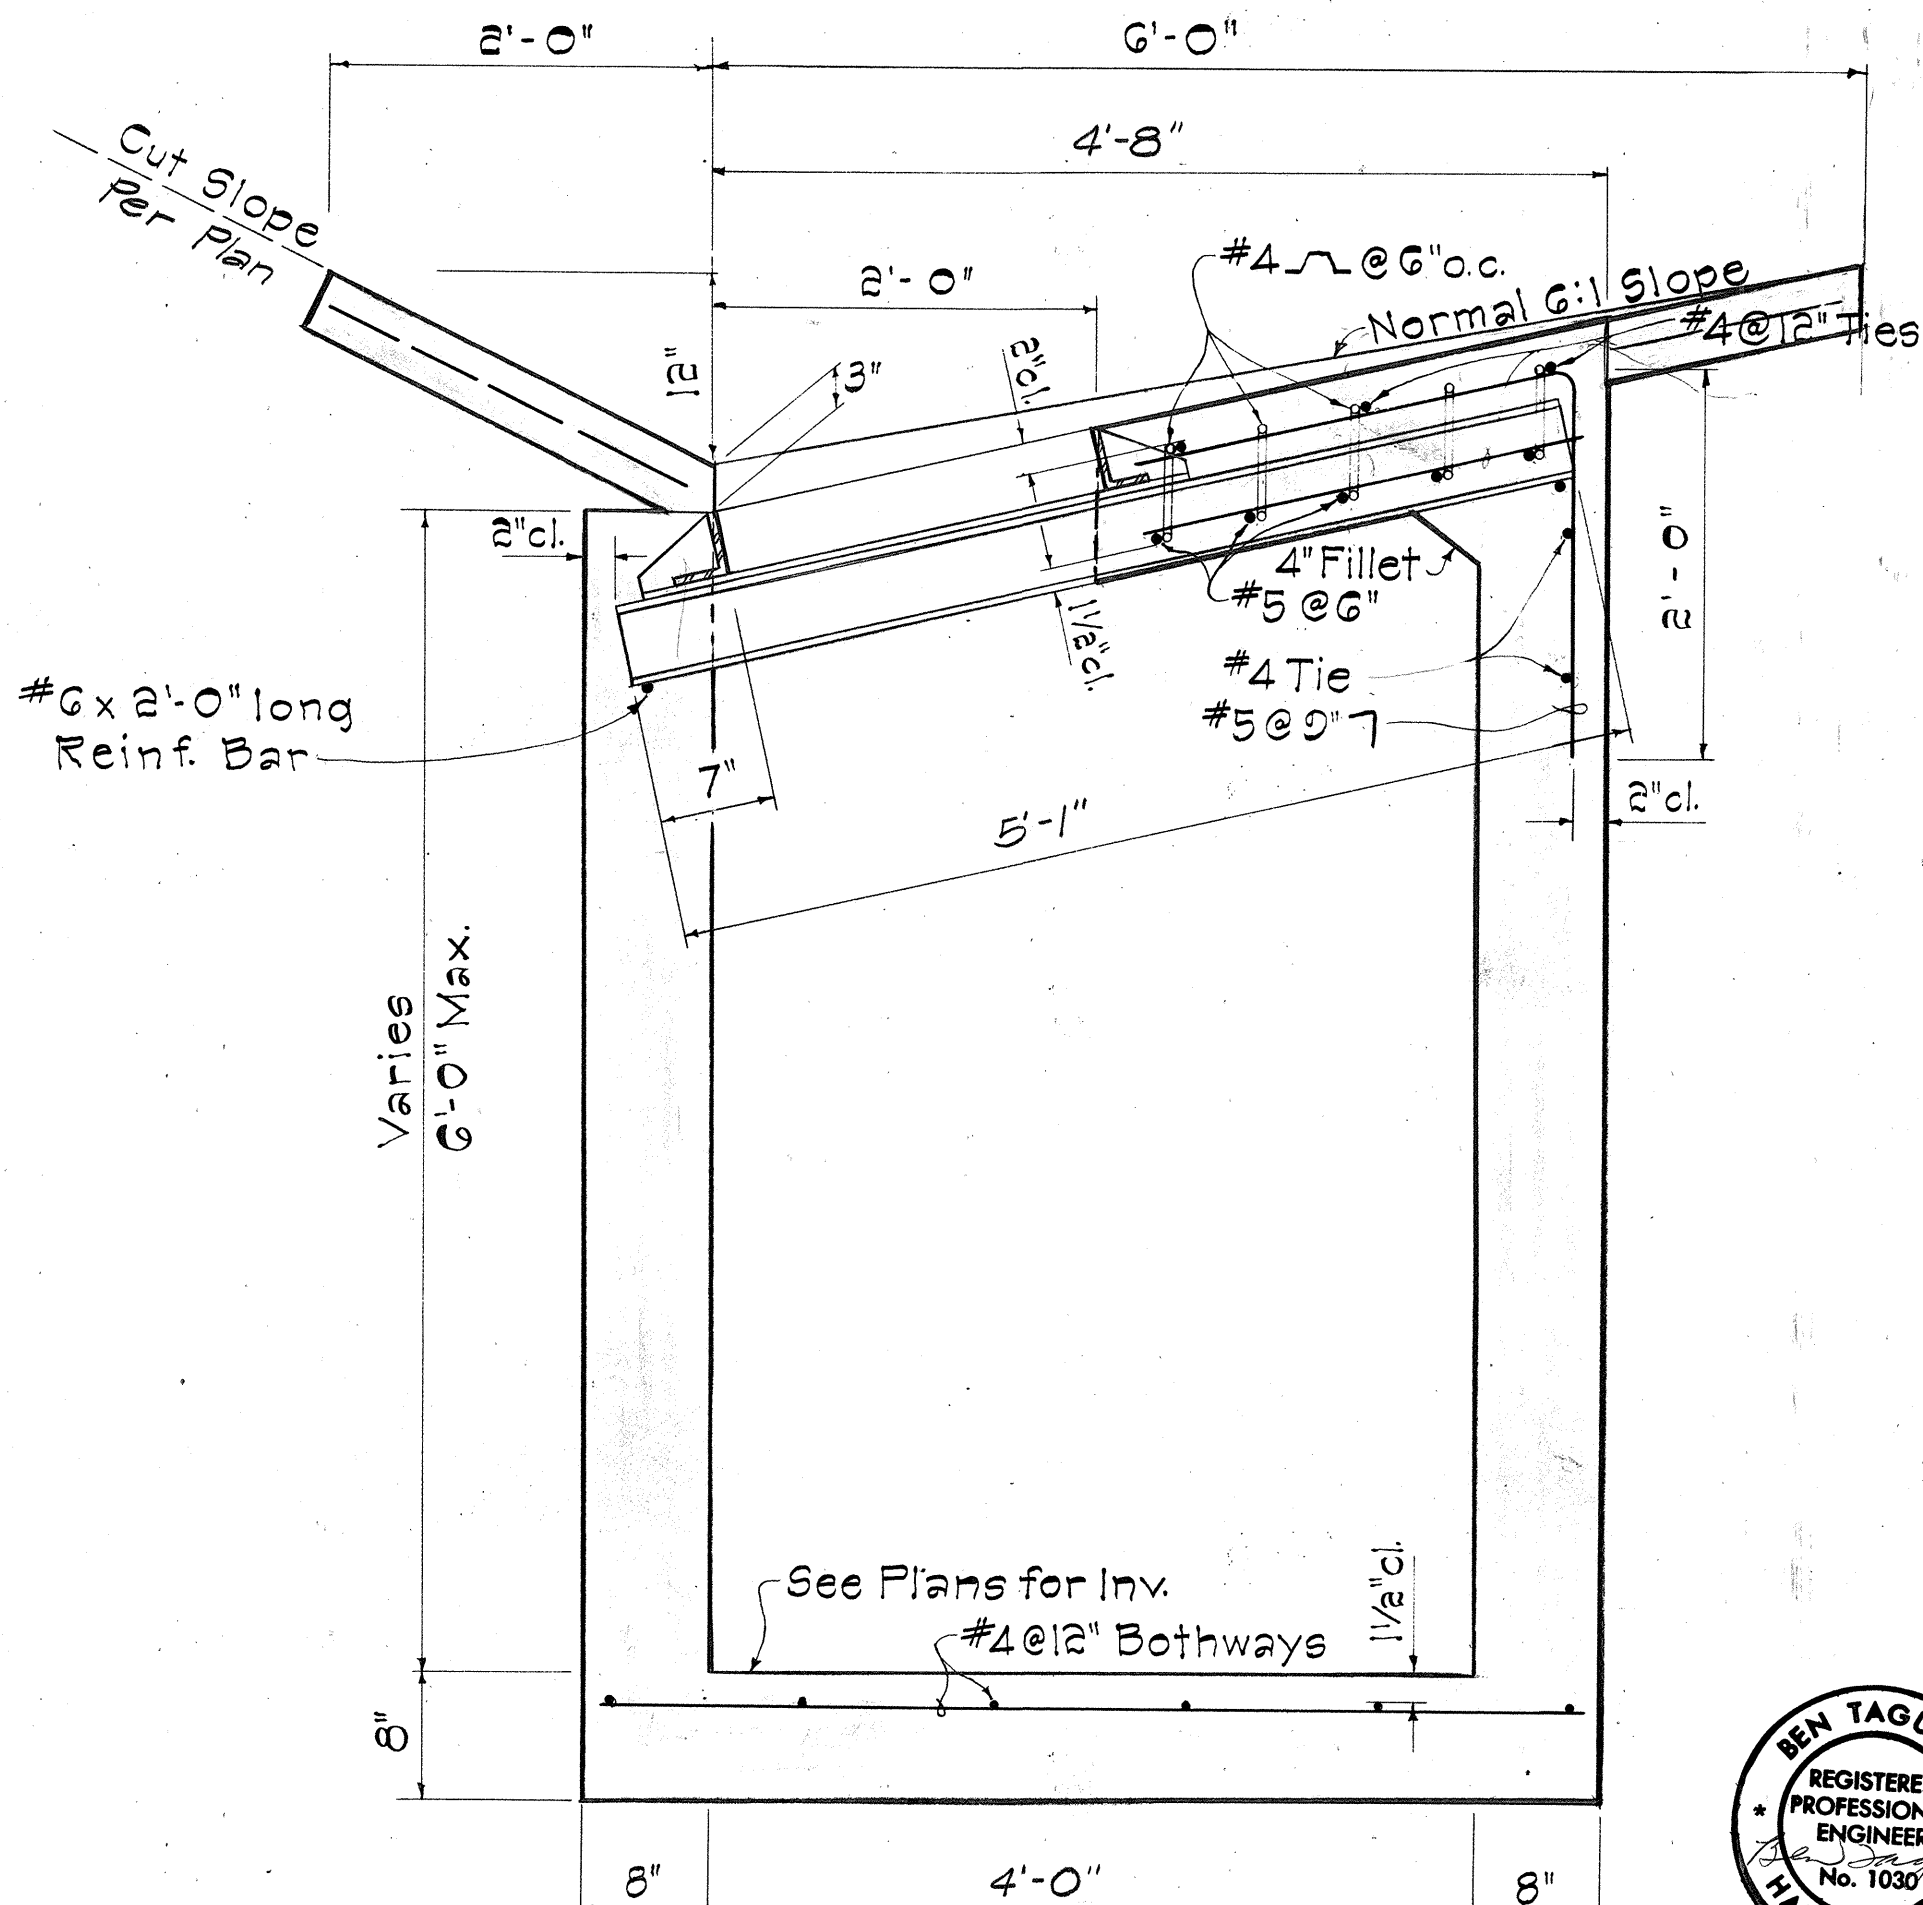


SECTION B-B
Scale: 1" = 1'-0"

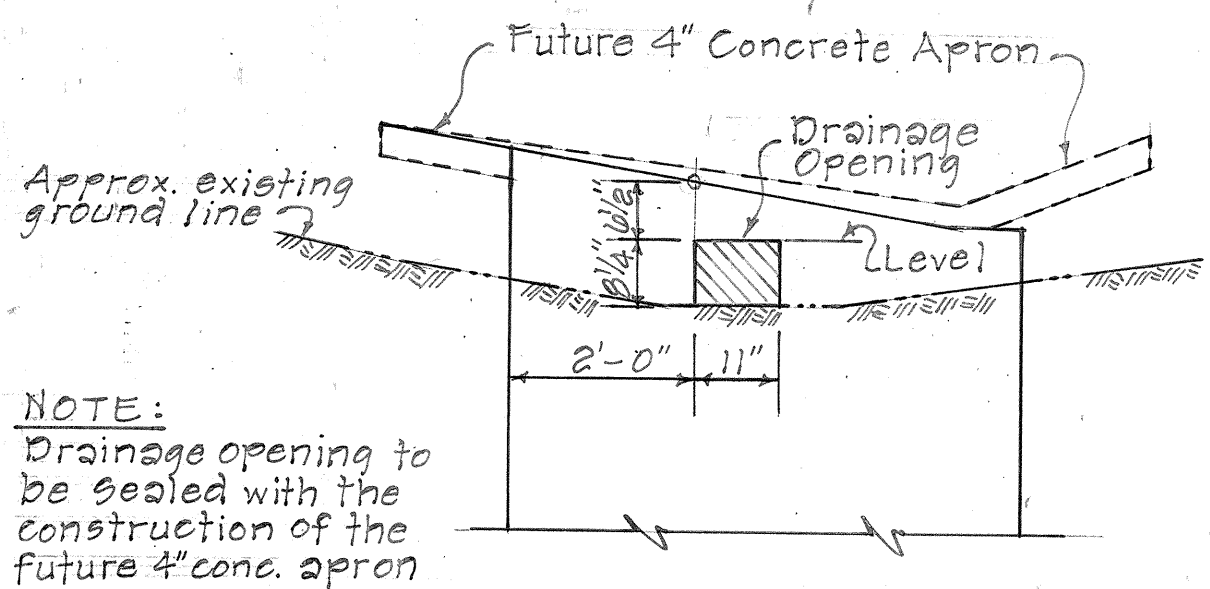

DETAIL (X)
(AT INLET #1 ONLY)
Scale: 1/2" = 1'-0"

NOTE:
Drainage opening to be sealed with the construction of the future 4' conc. apron

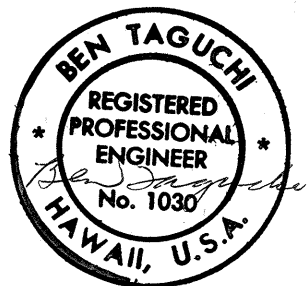

THIS WORK WAS PREPARED BY ME
OR UNDER MY SUPERVISION.

STATE OF HAWAII
DEPARTMENT OF TRANSPORTATION


DRAINAGE DETAILS
(TYPE "B" INLET)

WAI'AWA INTERCHANGE
F.A.I. Proj. No. I-HI-1(36)8


Scale: As shown Date: OCT 1967
SHEET No. OF SHEETS

ORIGINAL PLAN	SURVEY PLOTTED BY	DATE
DESIGNED BY	DRAWN BY	" "
CHECKED BY	NOTED BY	" "
NO.	CHECKED BY	" "


FED. ROAD DIST. NO.	STATE	FED. AID PROJ. NO.	FISCAL YEAR	SHEET NO.	TOTAL SHEETS
HAWAII	HAW.	I-H-1(36)8	1967	30	124

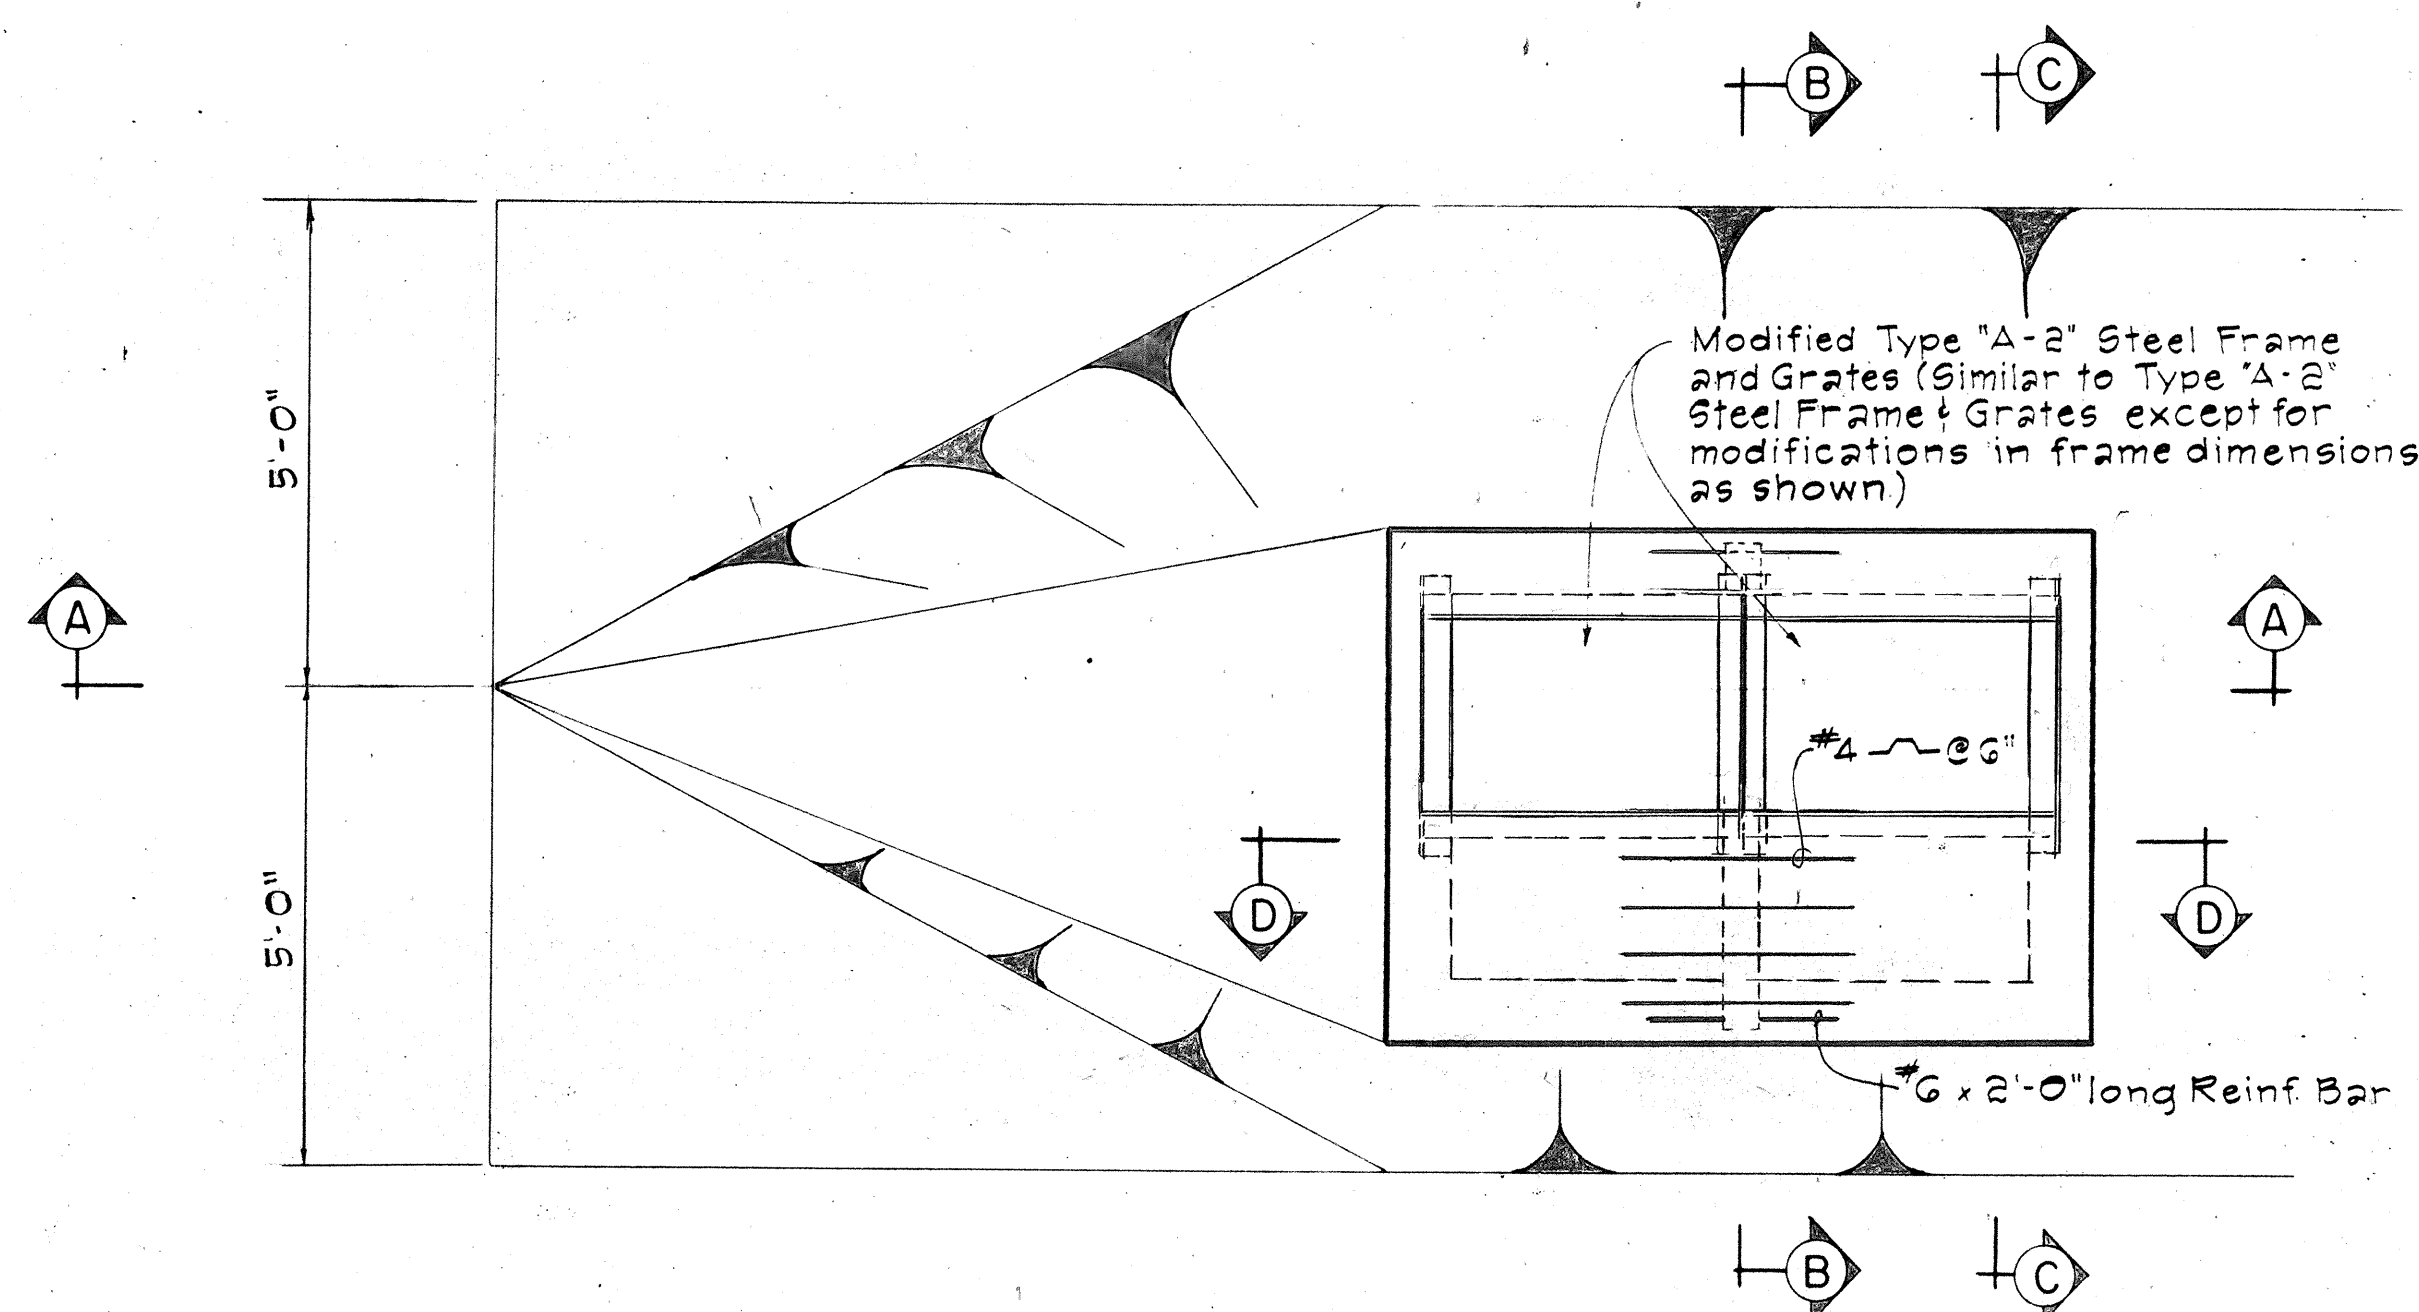


PLAN
Scale: 1/2" = 1'-0"

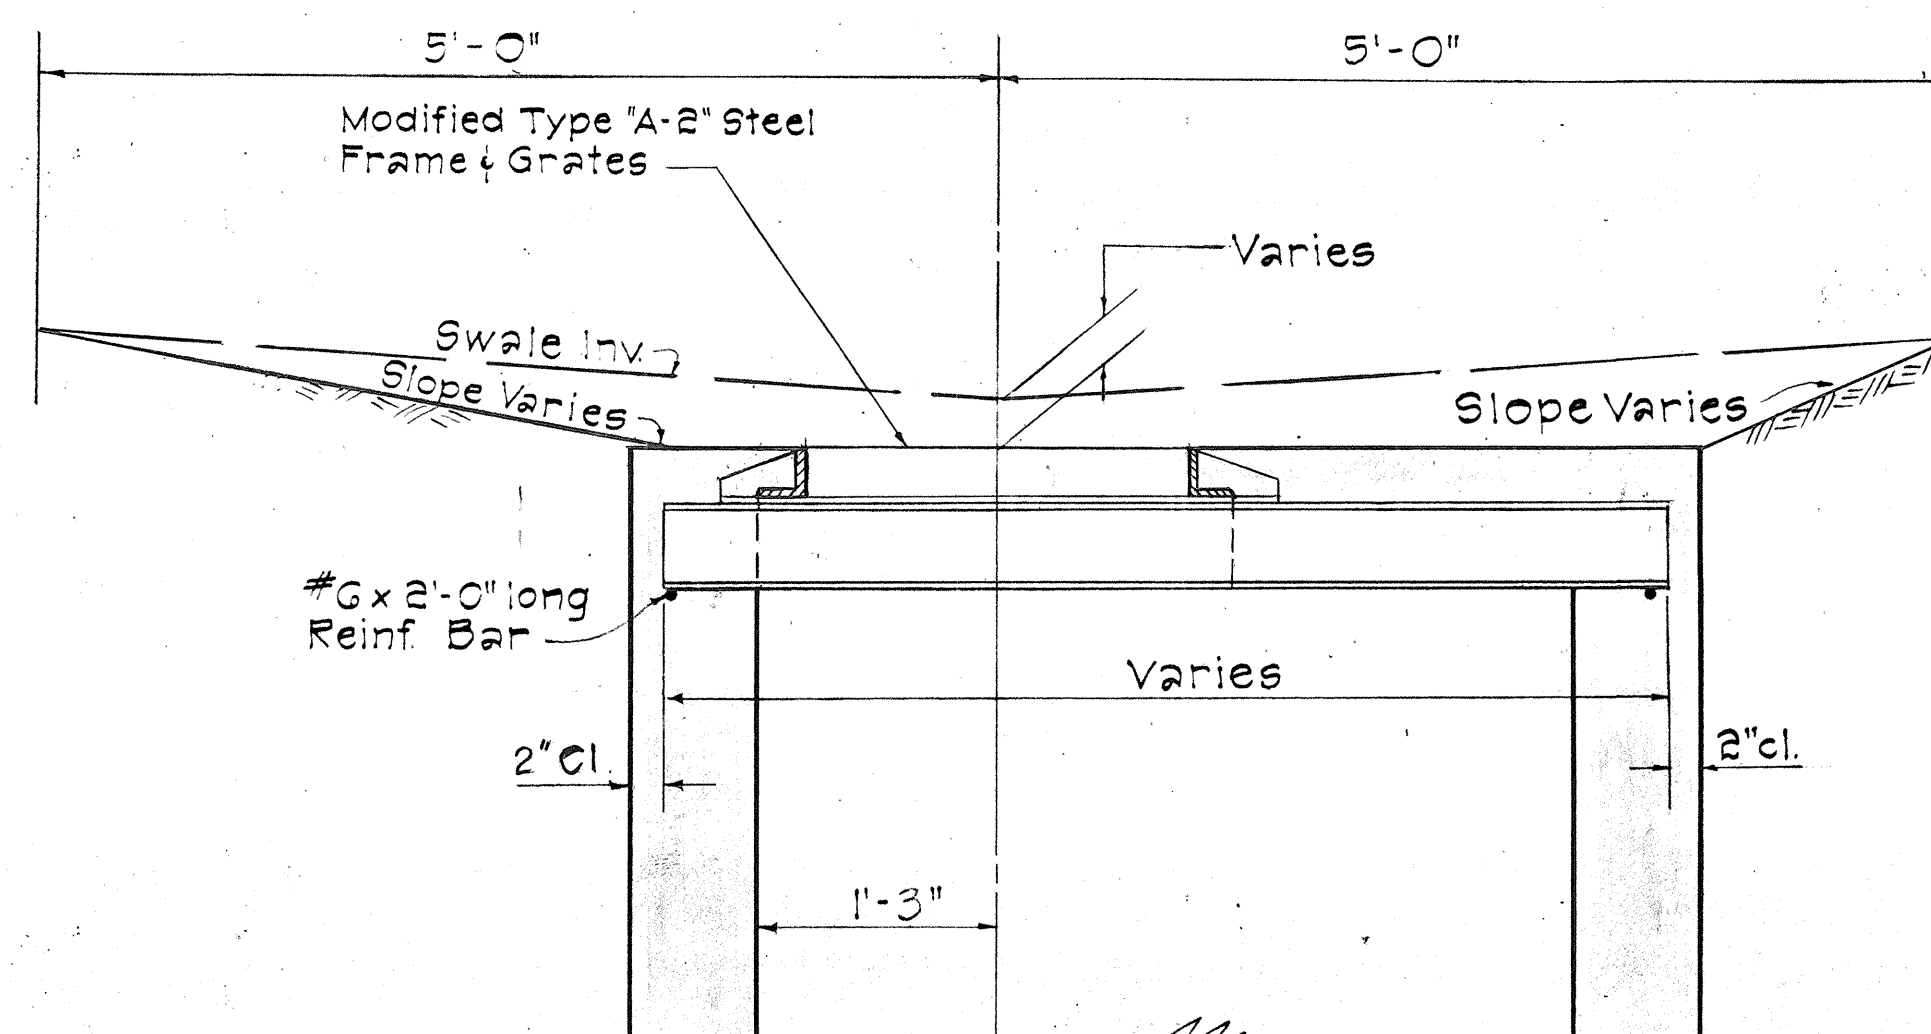


SECTION B-B
Scale: 1" = 1'-0"

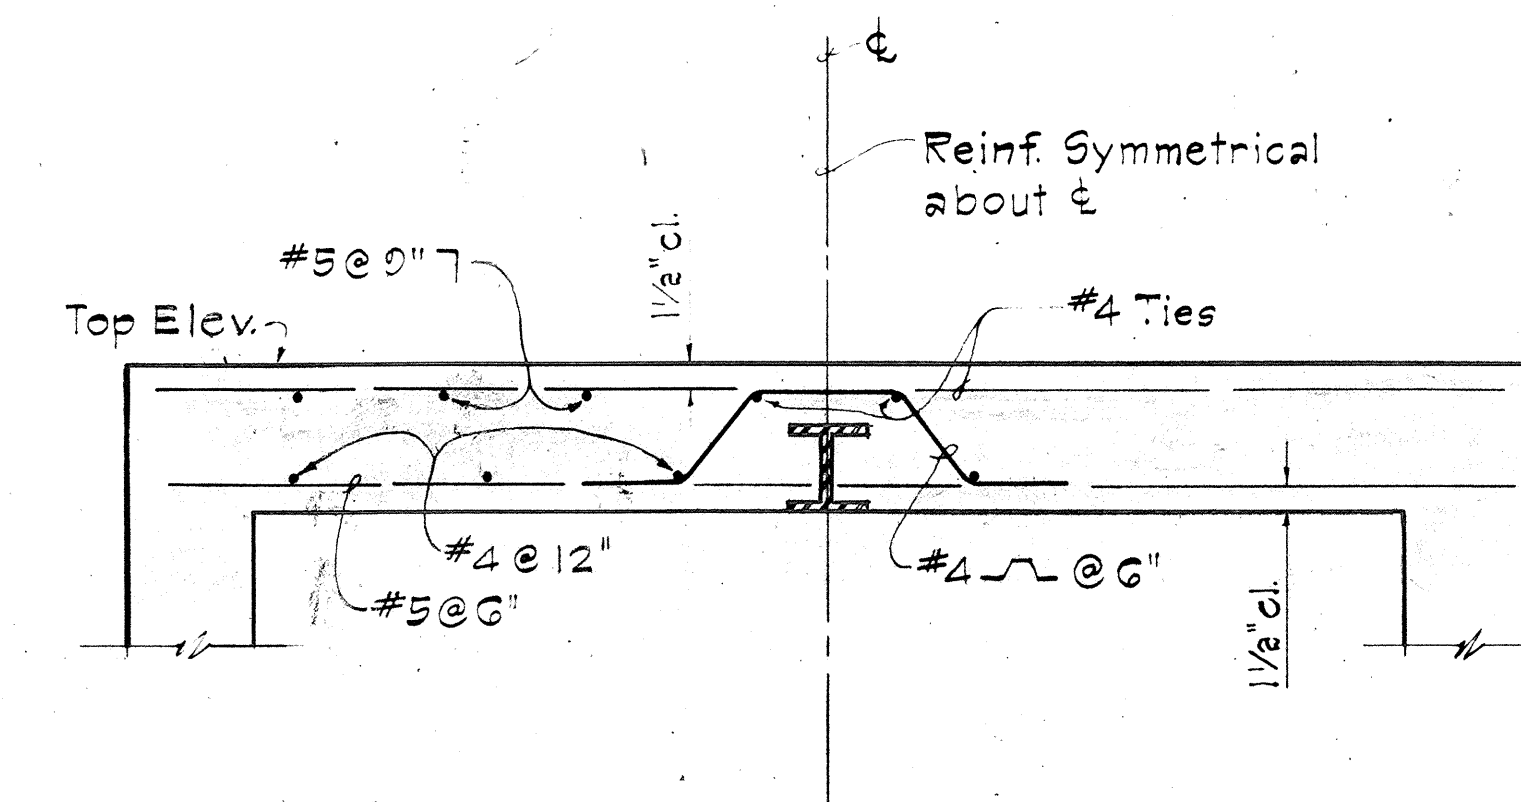


SECTION D-D
Scale: 1" = 1'-0"

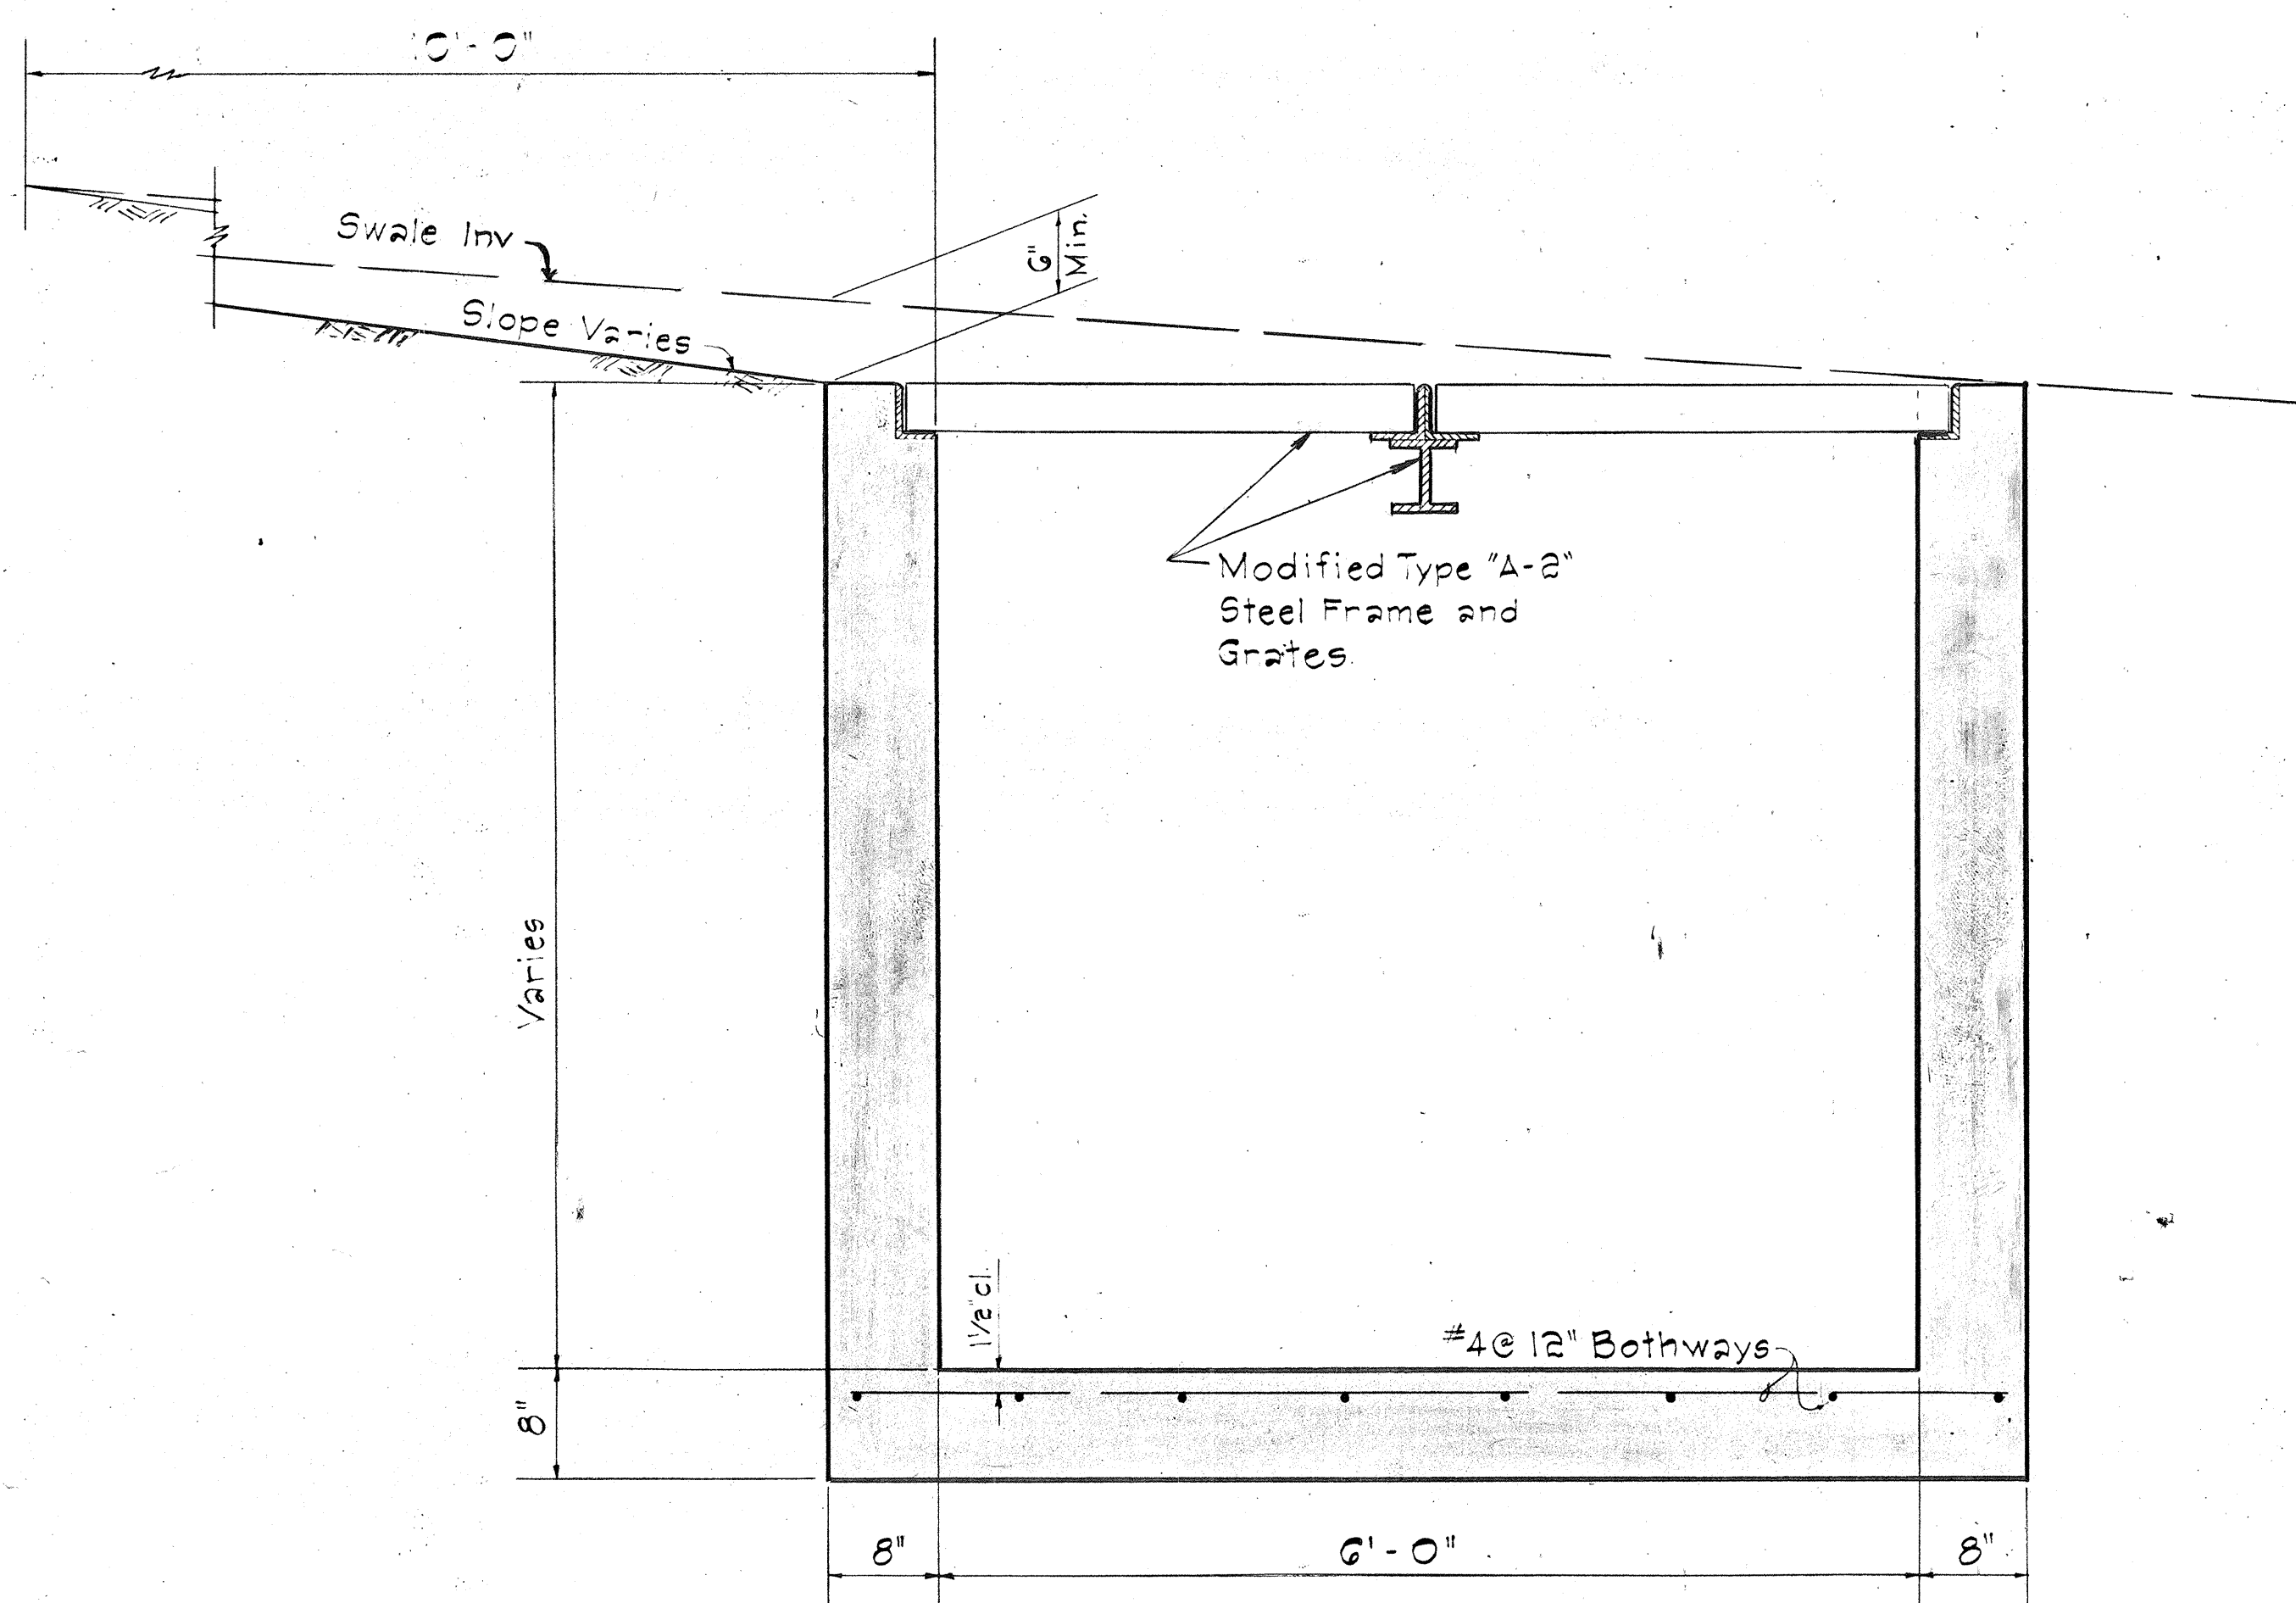

SECTION A-A
Scale: 1" = 1'-0"

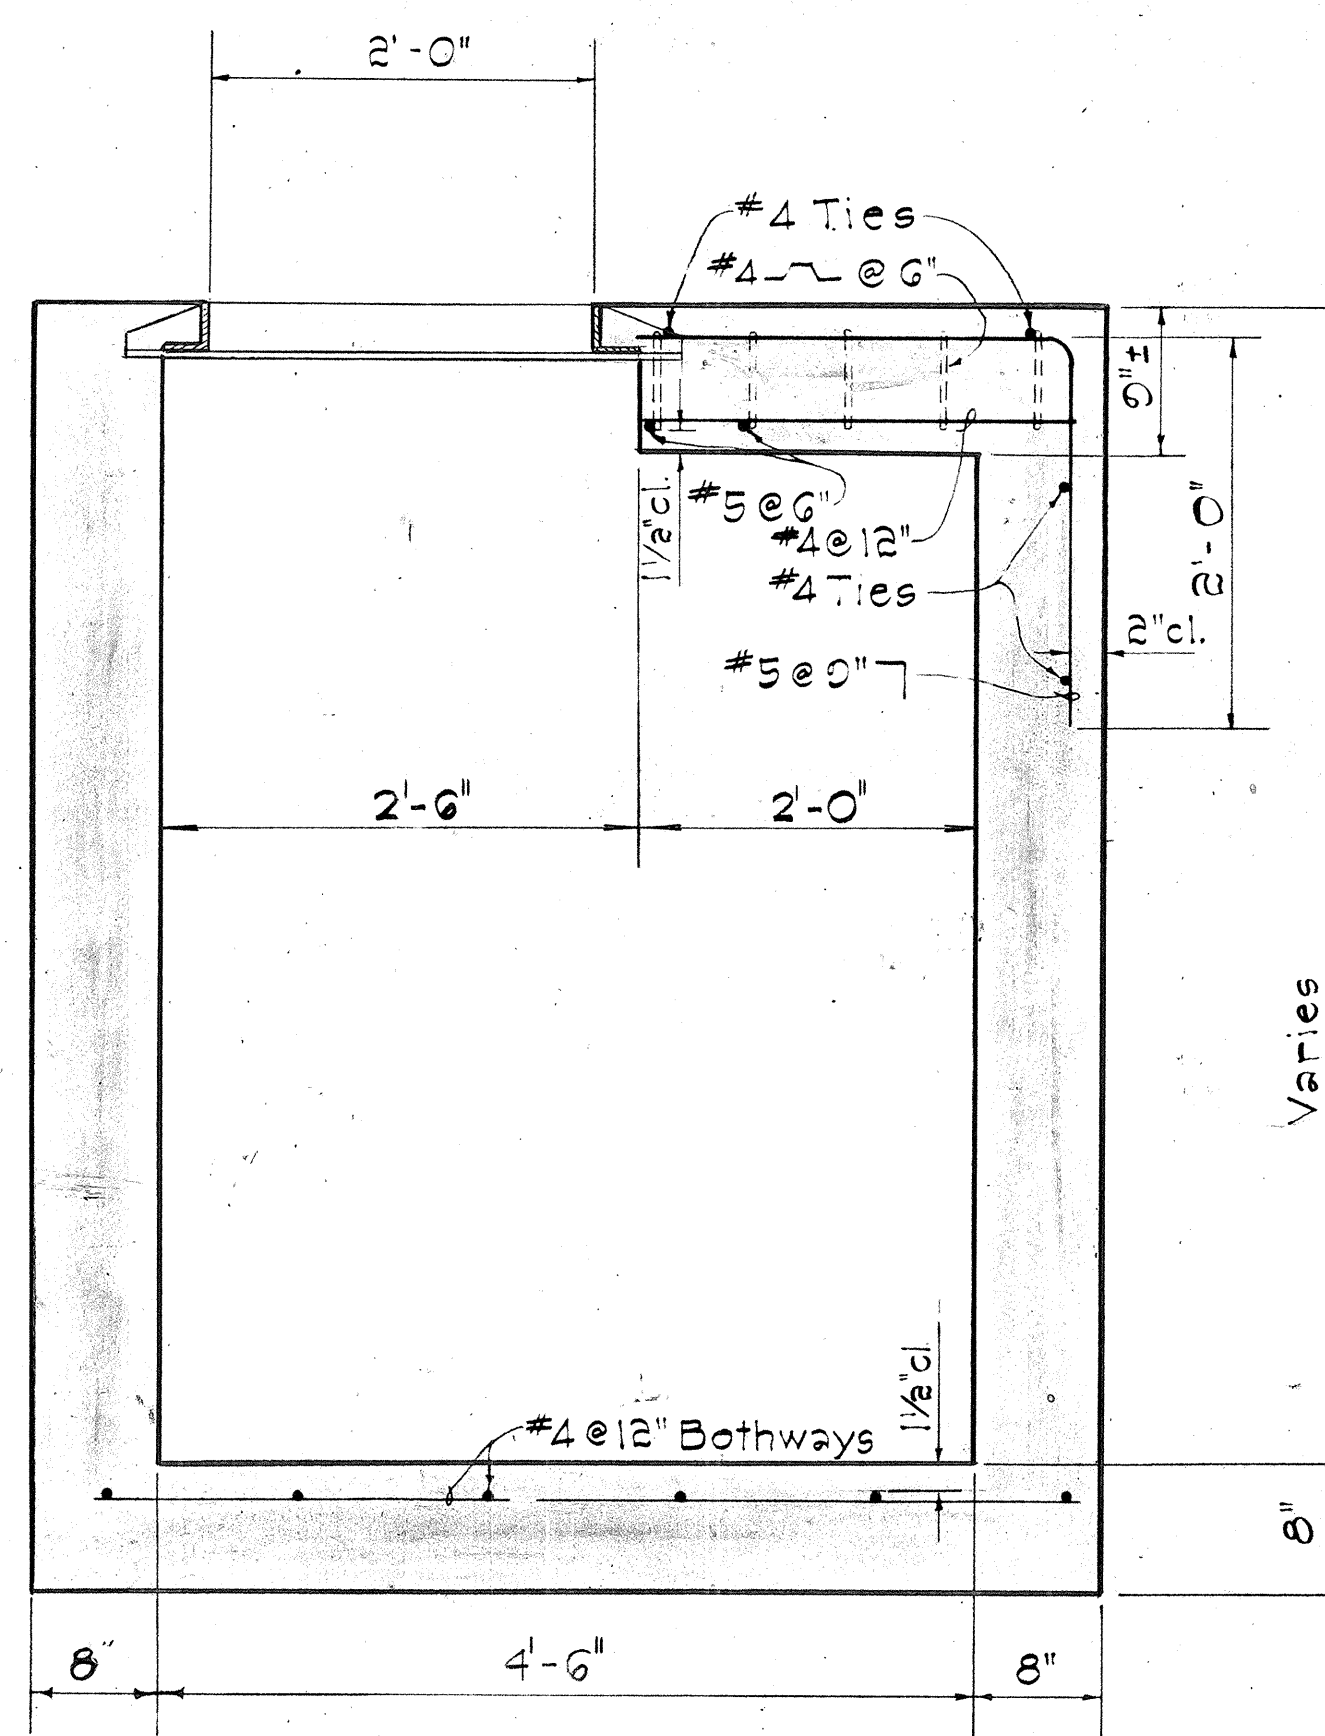

SECTION C-C
Scale: 1" = 1'-0"

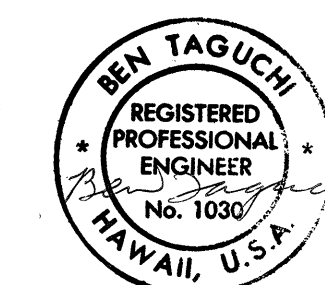

THIS WORK WAS PREPARED BY ME
OR UNDER MY SUPERVISION.

STATE OF HAWAII
DEPARTMENT OF TRANSPORTATION
HIGHWAYS DIVISION

**DRAINAGE DETAILS
(TYPE "C" INLET)**

WAIKAWA INTERCHANGE
F.A.I. Proj. No. I-H-1(36)8

Scale: As shown Date: OCT 1967

SHEET No. OF SHEETS


30

ORIGINAL	DATE
SURVEY PLOTTED BY	
DRAWN BY	
TRACED BY	
NOTED BY	
CHECKED BY	
No.	


Revised: Jan. 25, 1967

NOTE:


1. All welds $\frac{3}{8}$ " unless otherwise noted.
2. All steel shall be structural grade.
3. Grates and Frame shall be hot dip galvanized after fabrication in accordance with Section 44(H) of the Standard Specifications.
4. Detail of Types "A-1" and "A-2" Steel Frame and Grates are identical except for the thickness of end spacers and number of grate bars. See Table of End Spacer Thickness.

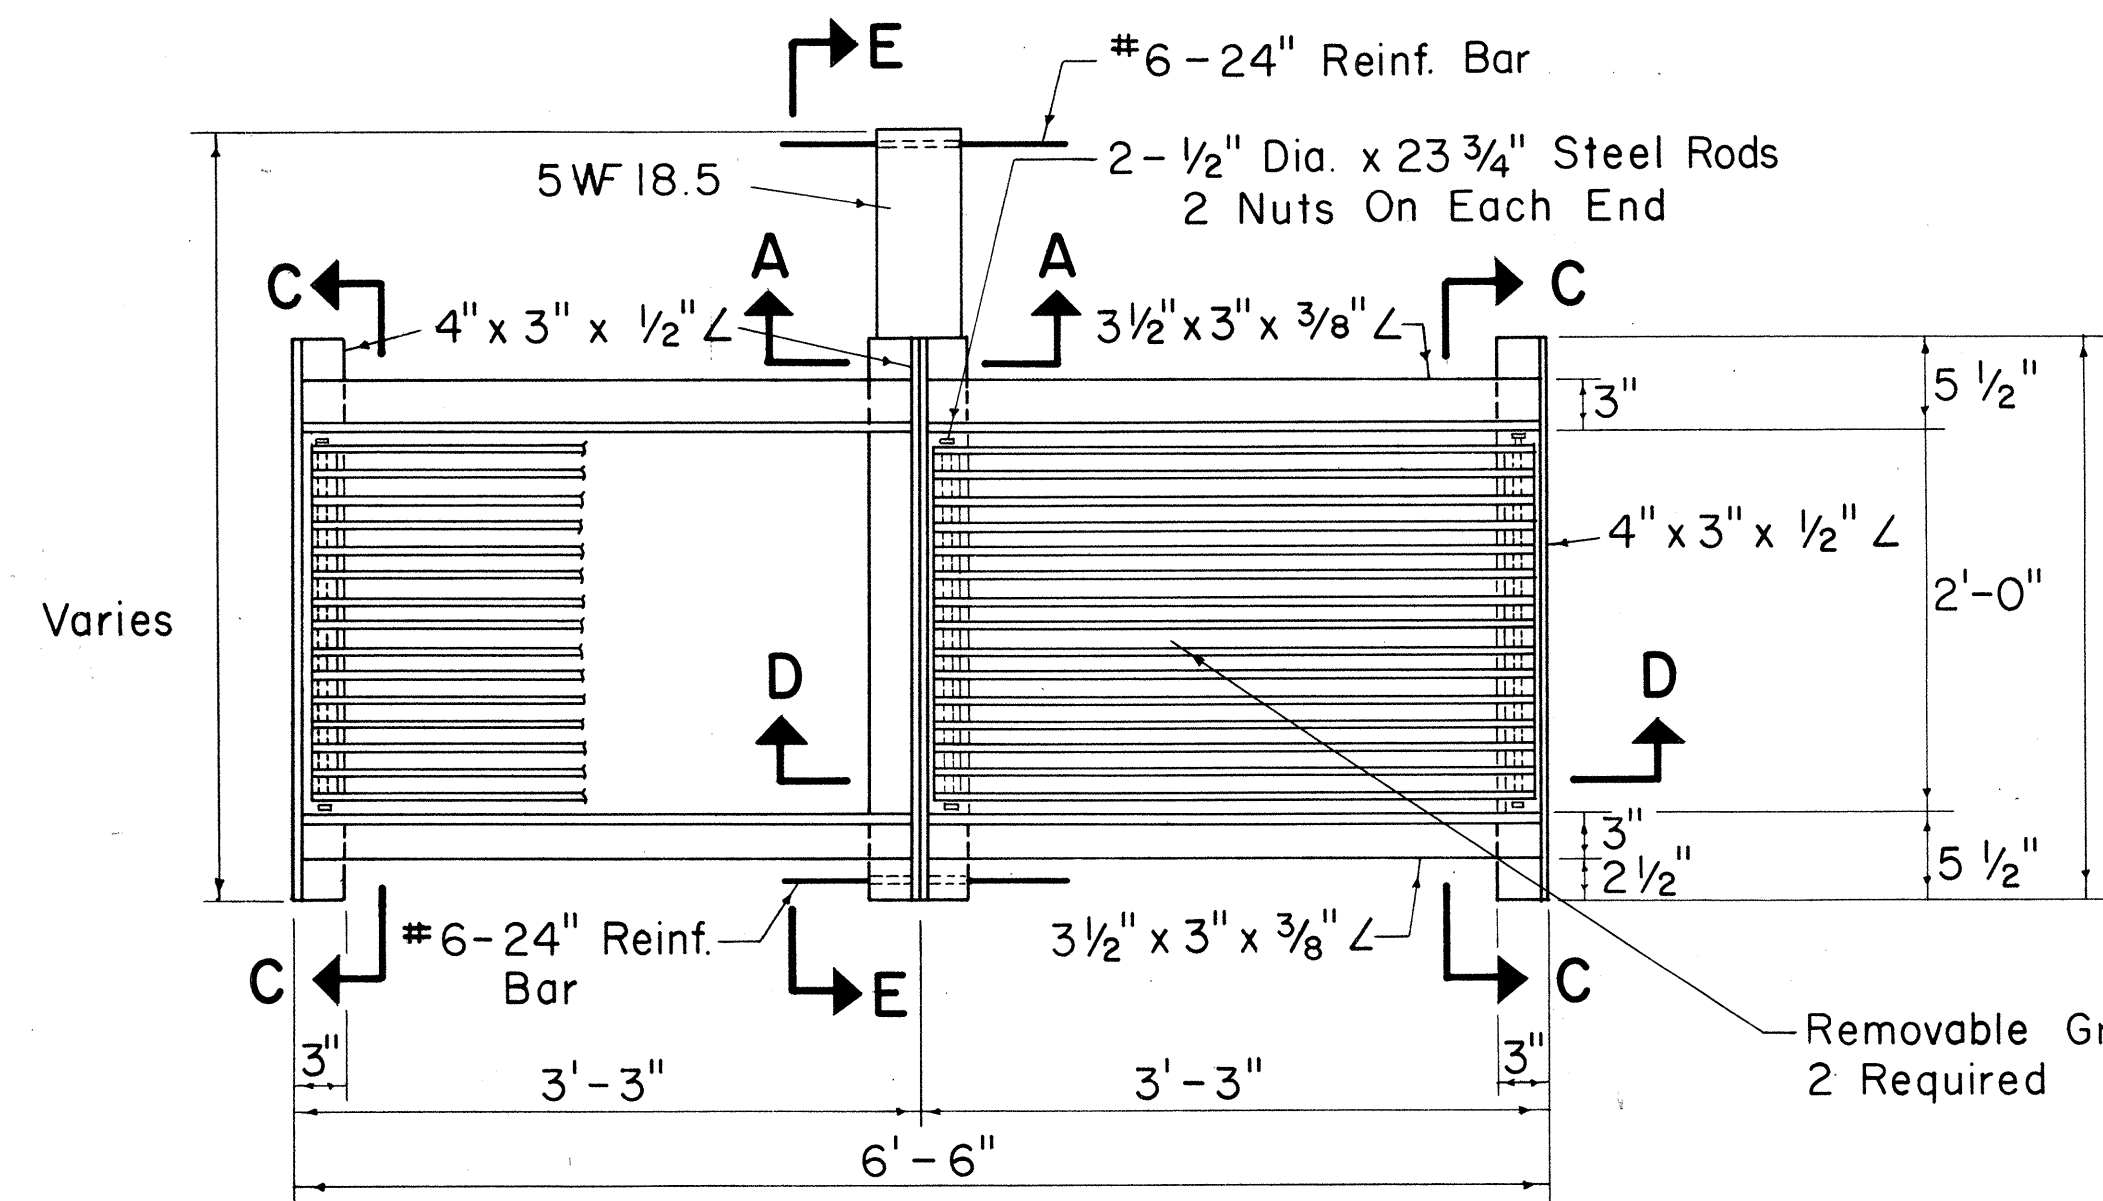

PLAN

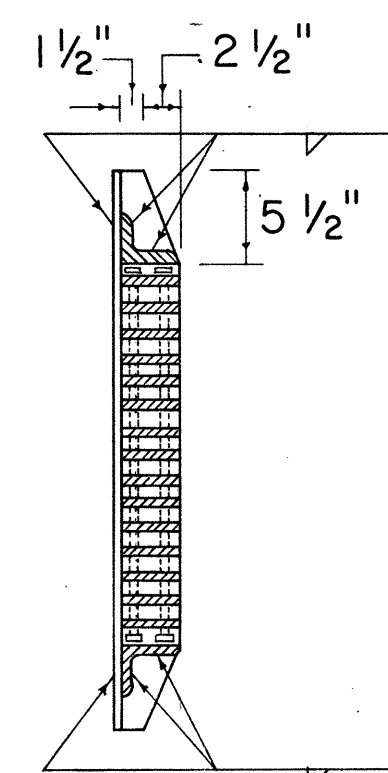

SECTION C-C

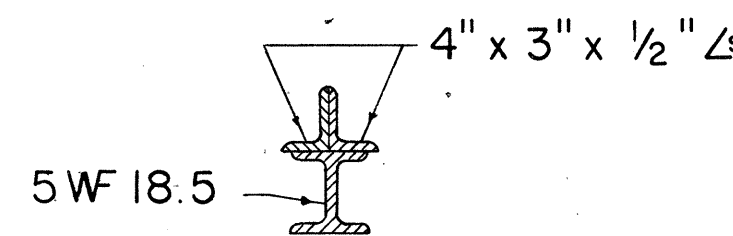


SECTION A-A


TABLE OF END SPACER THICKNESS

TYPE FRAME & GRATES	"T" (in.)
A-1	1
A-2	1 3/8


END SPACER

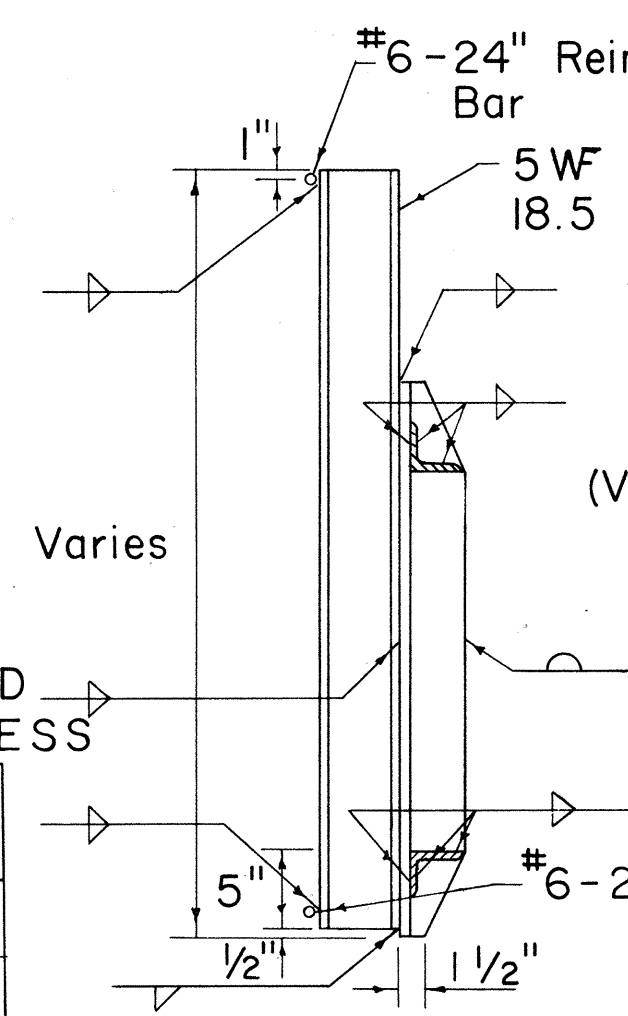


SECTION E-E

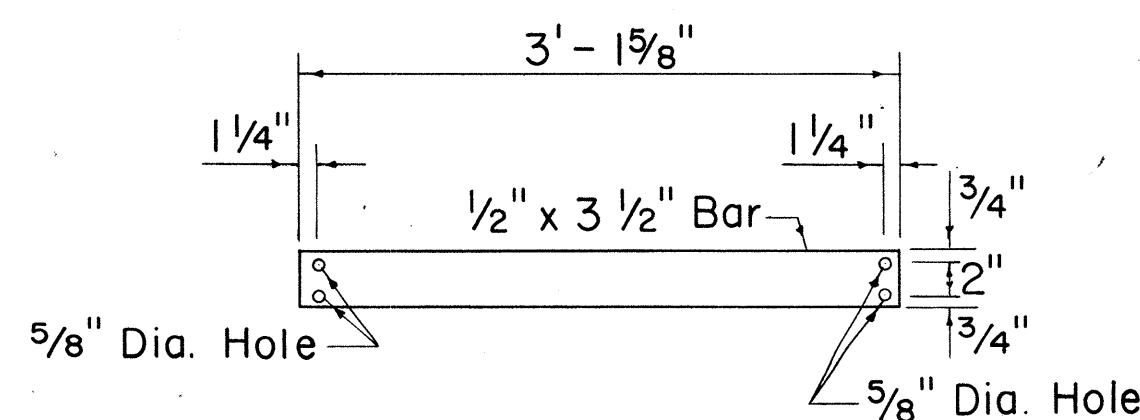

GRATE BARS

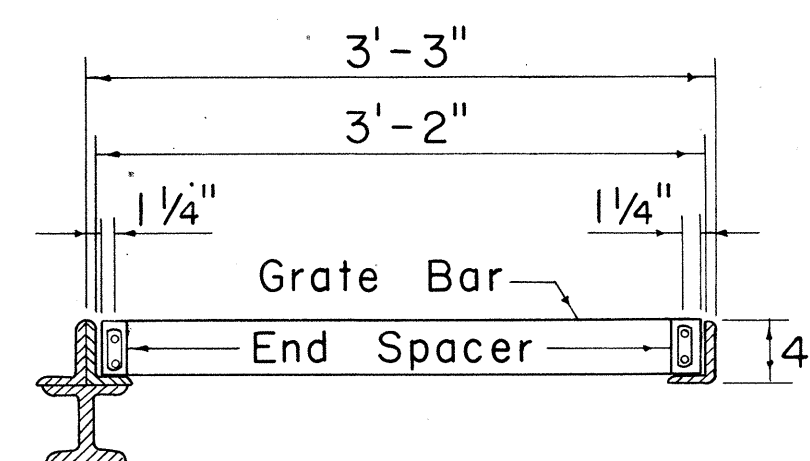


SECTION D-D

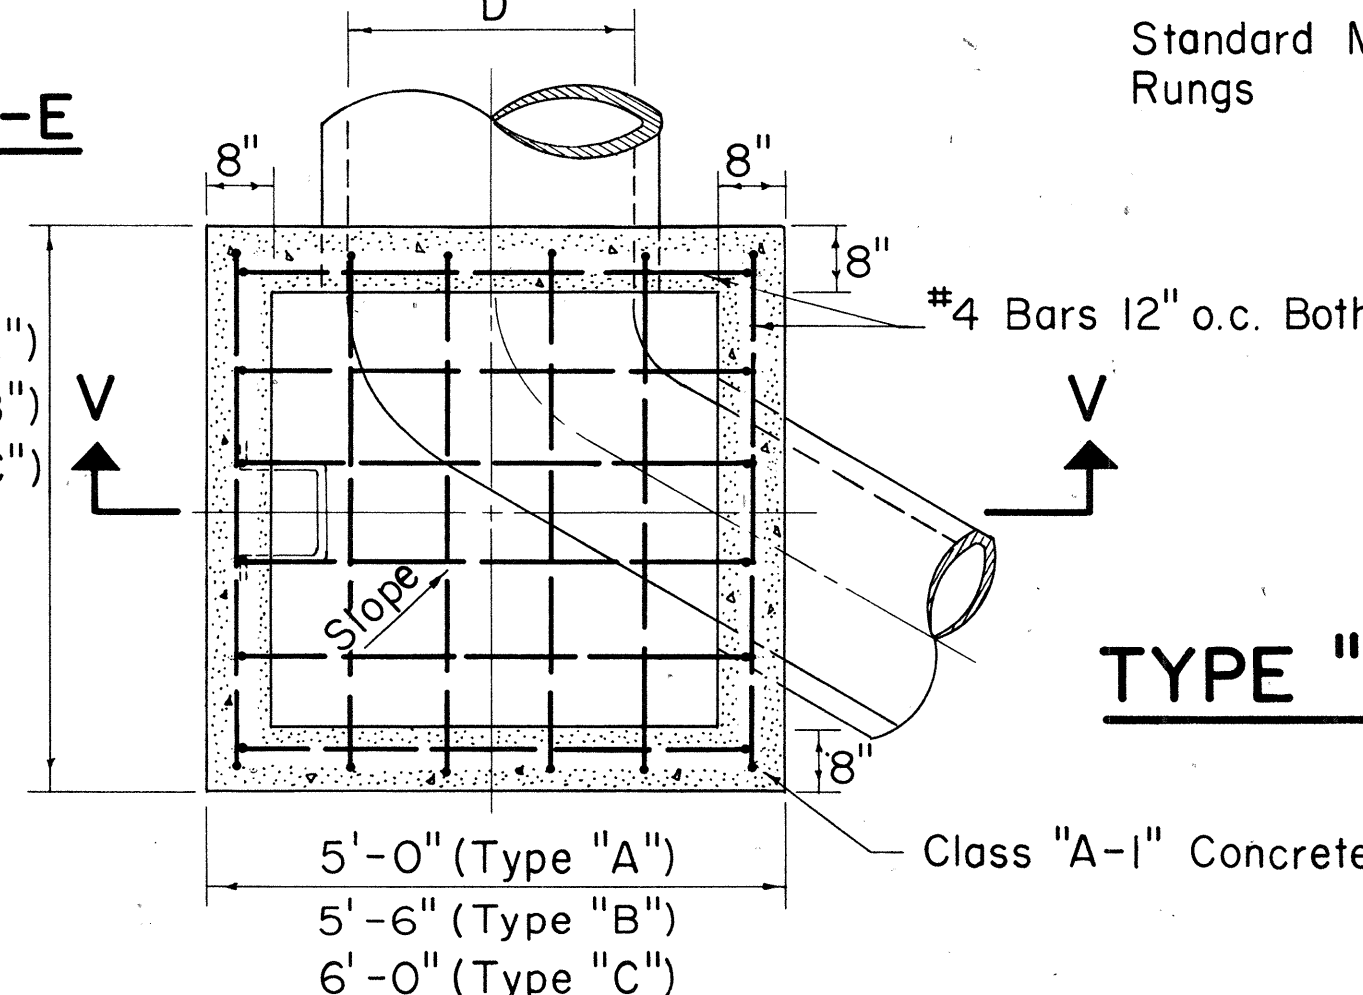


SECTION U-U
TYPE "A", "B", & "C"

S.D.M.H.

Scale: 1/2" = 1'-0"

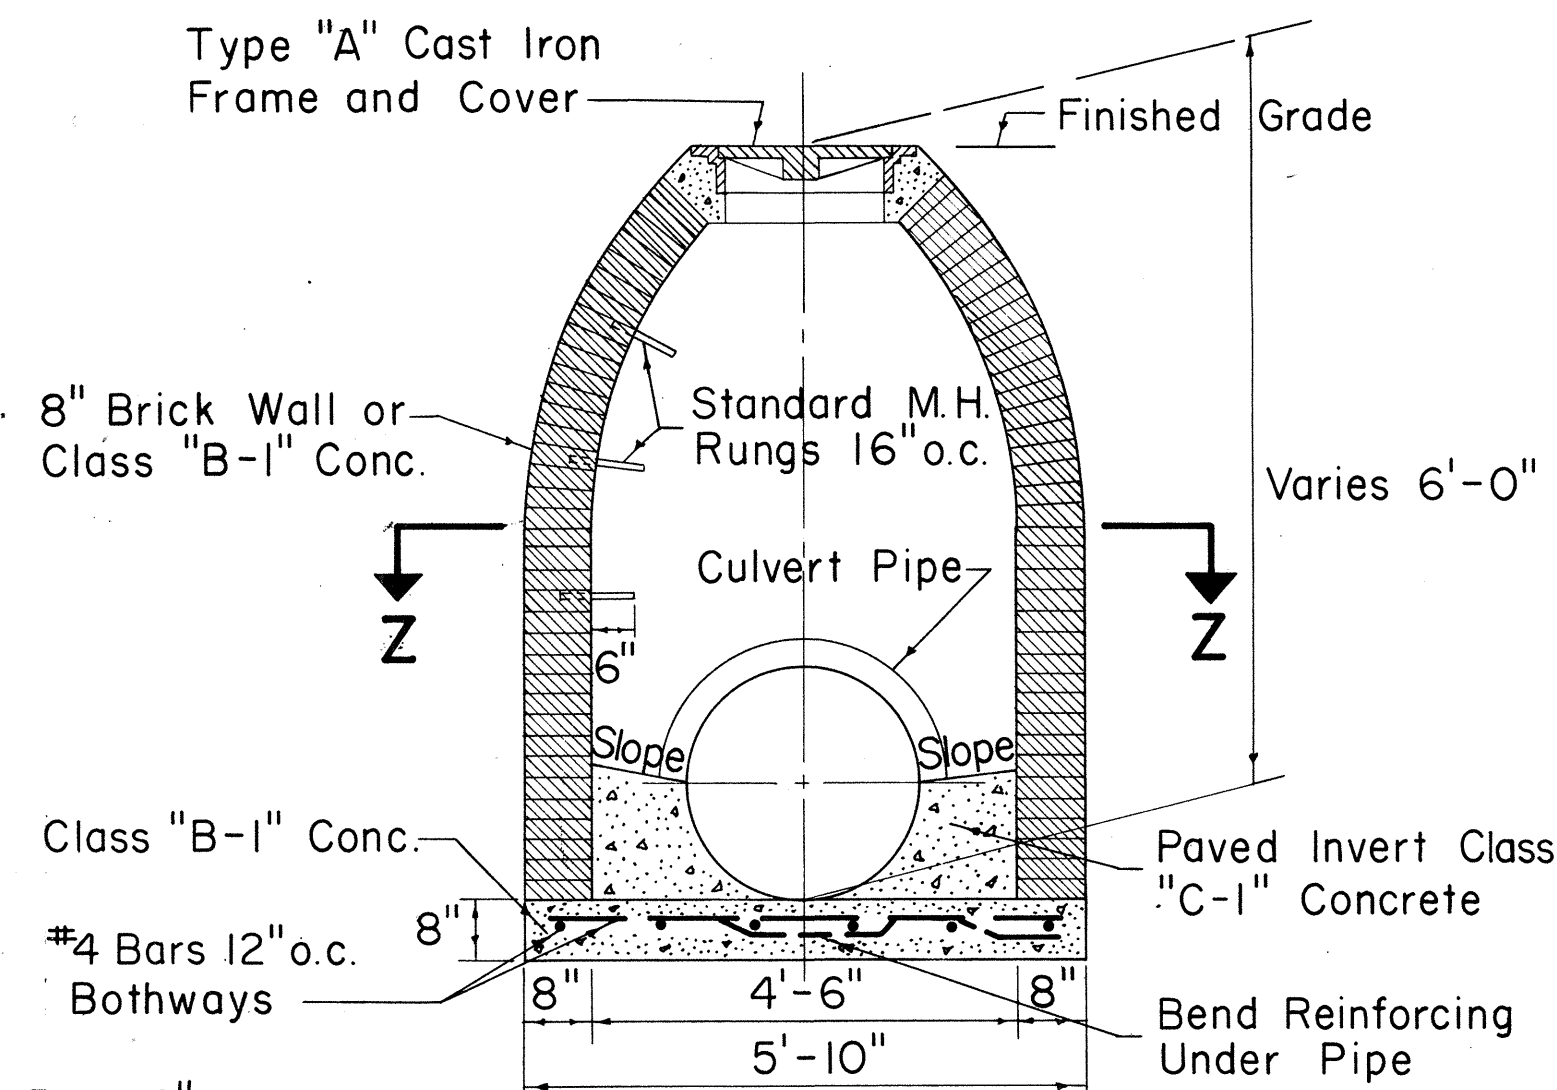


SECTION Y-Y

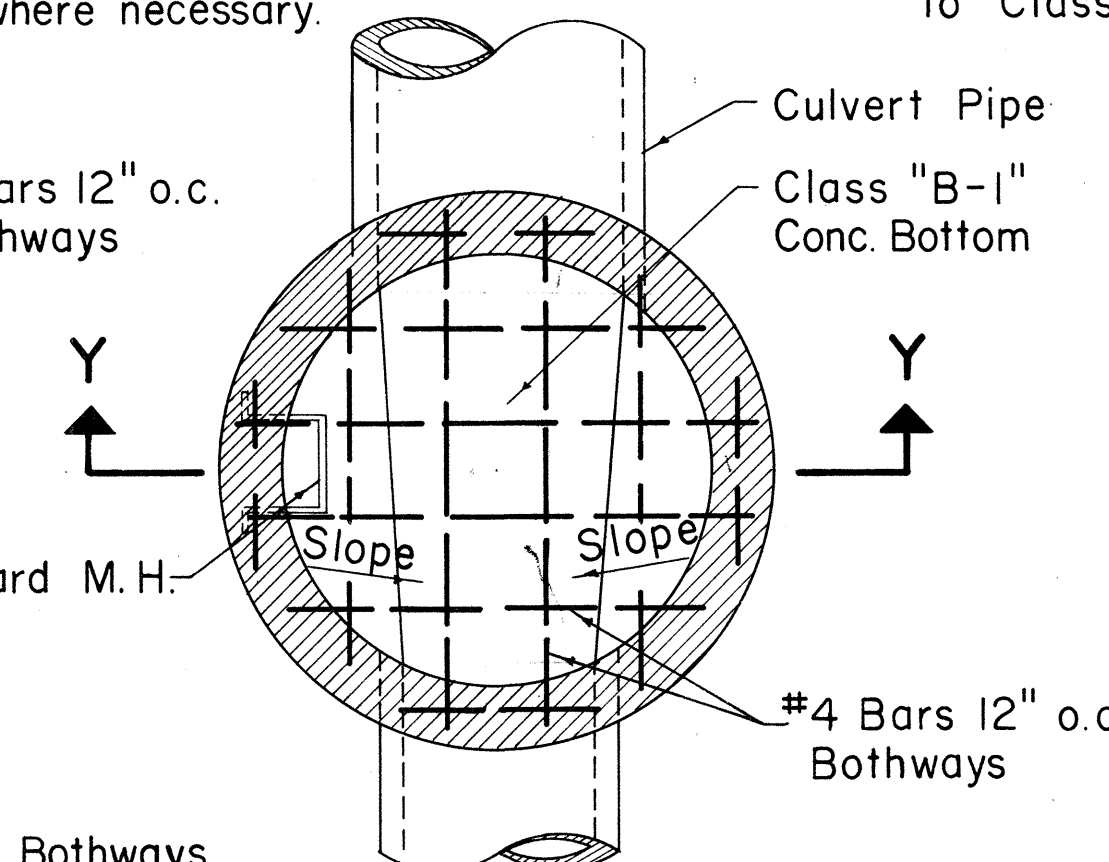


SECTION Z-Z

TYPE "D" STORM DRAIN MANHOLE

Scale: 1/2" = 1'-0"

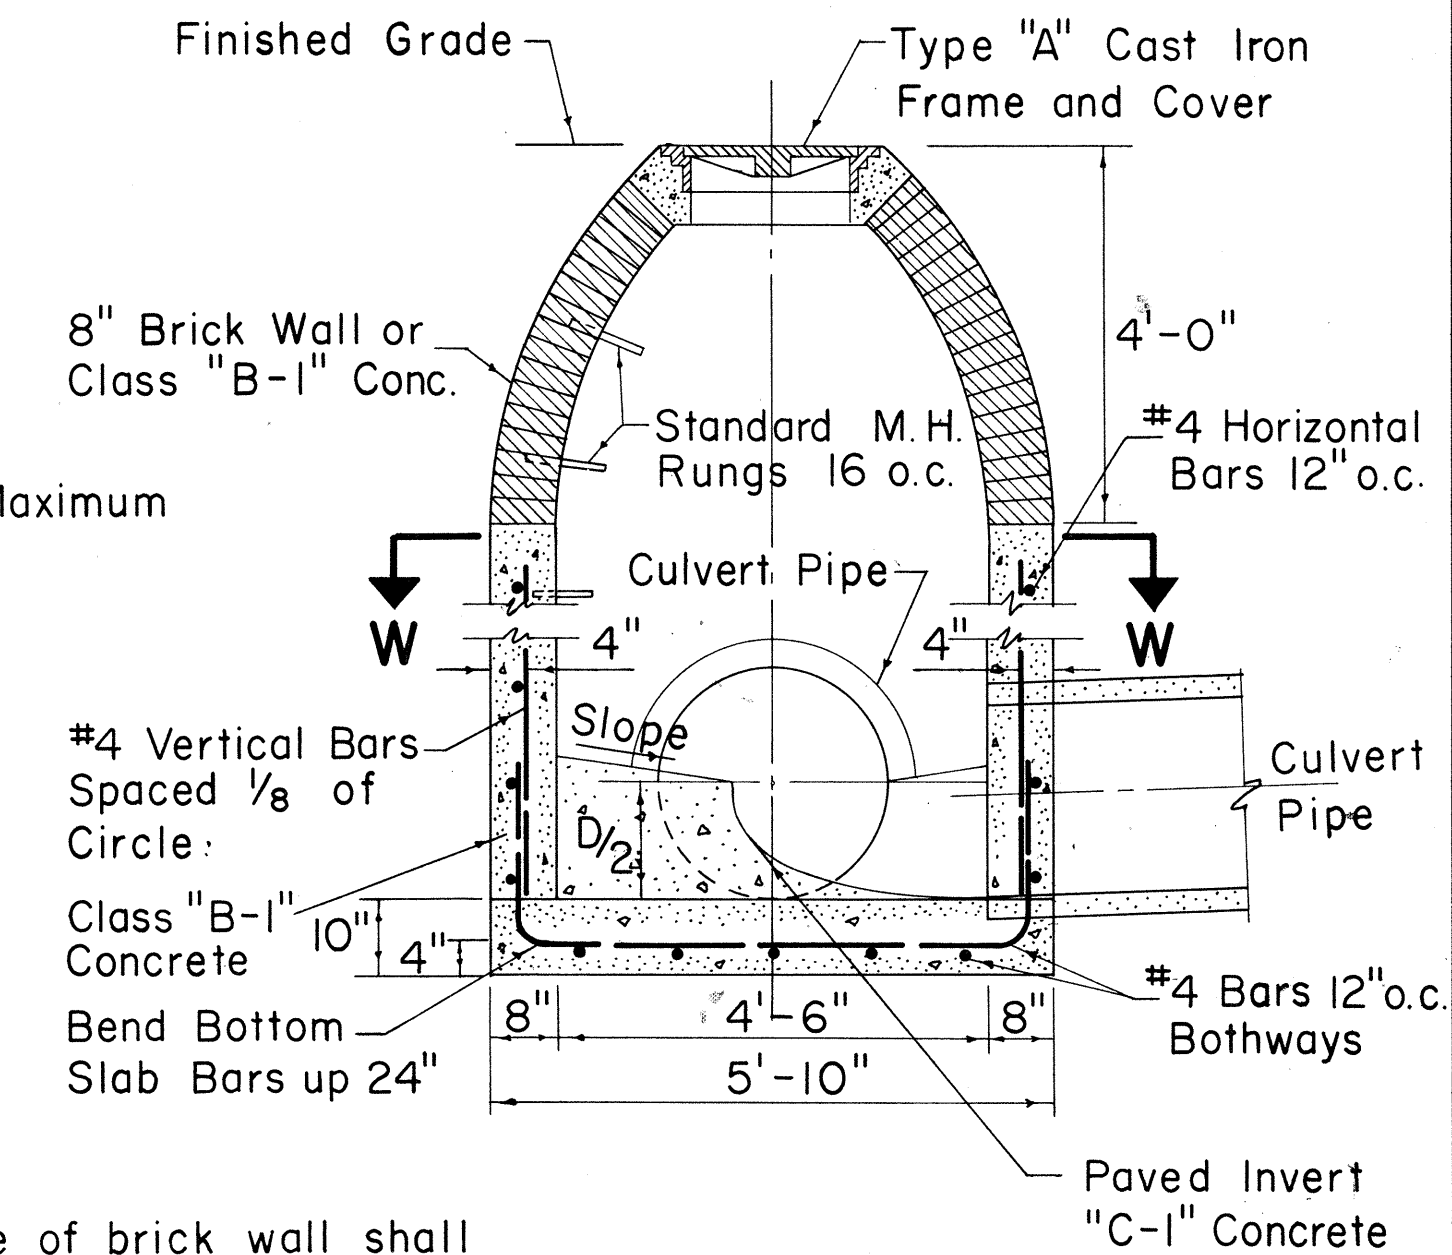

SECTION X-X

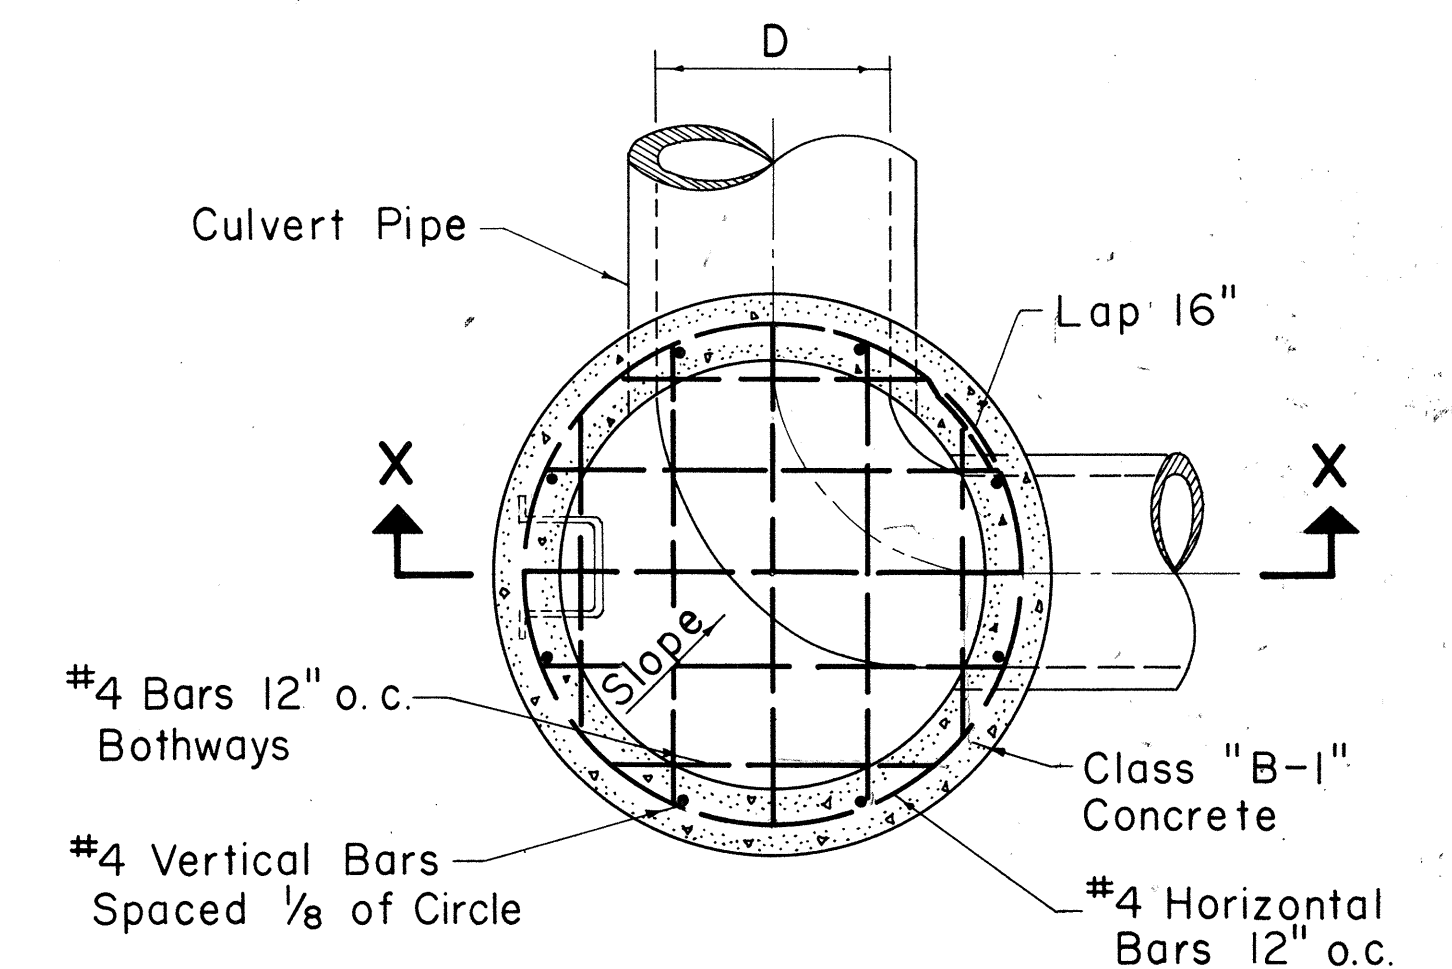

SECTION W-W

TYPE "E" STORM DRAIN MANHOLE

Scale: 1/2" = 1'-0"

APPROVED:


DIRECTOR OF TRANSPORTATION DATE

STATE OF HAWAII
DEPARTMENT OF TRANSPORTATION
HIGHWAYS DIVISION

STANDARD DETAILS
STEEL FRAME AND GRATES
AND STORM DRAIN MANHOLES


Scales: As Noted Date Oct. 1967

SHEET NO. OF SHEETS

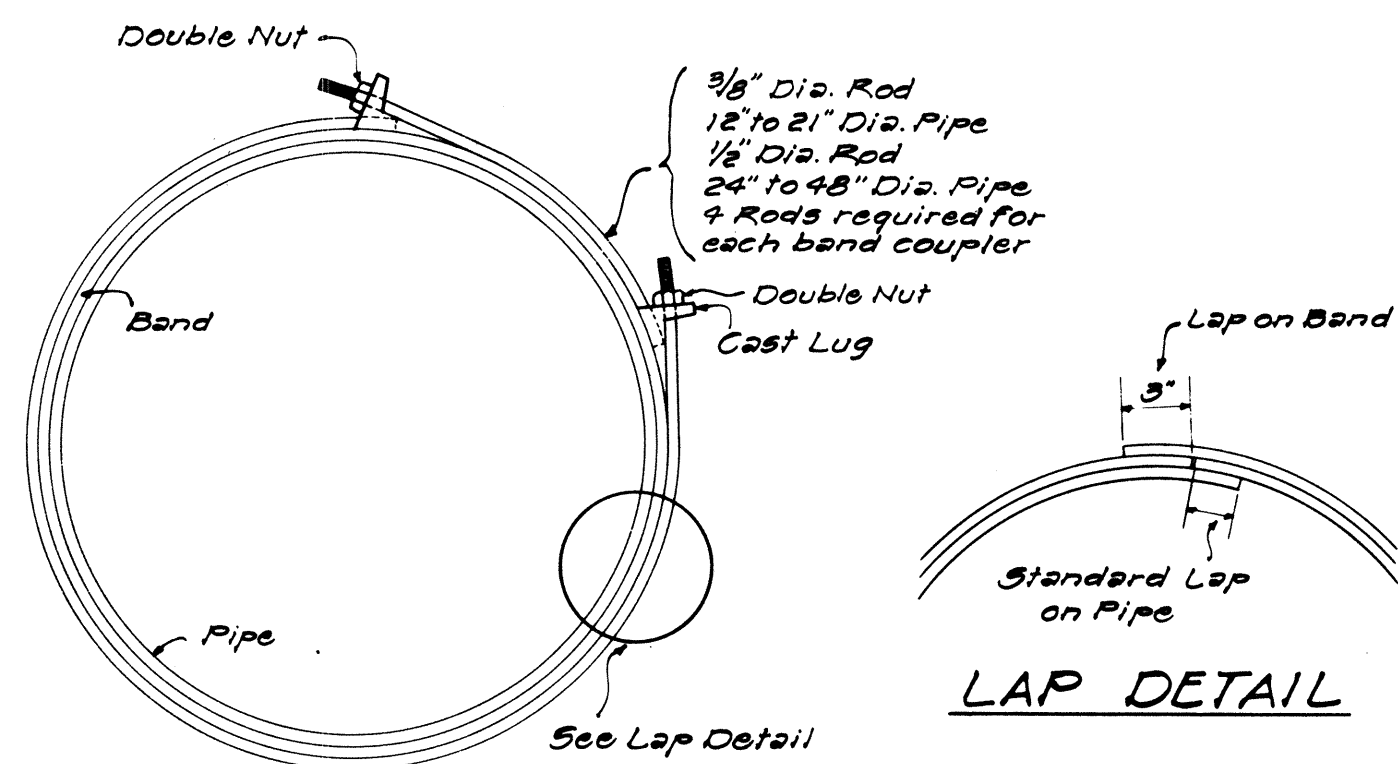


END VIEW

NOTE:
Each watertight band coupler to be supplied with neoprene sponge rubber gasket.

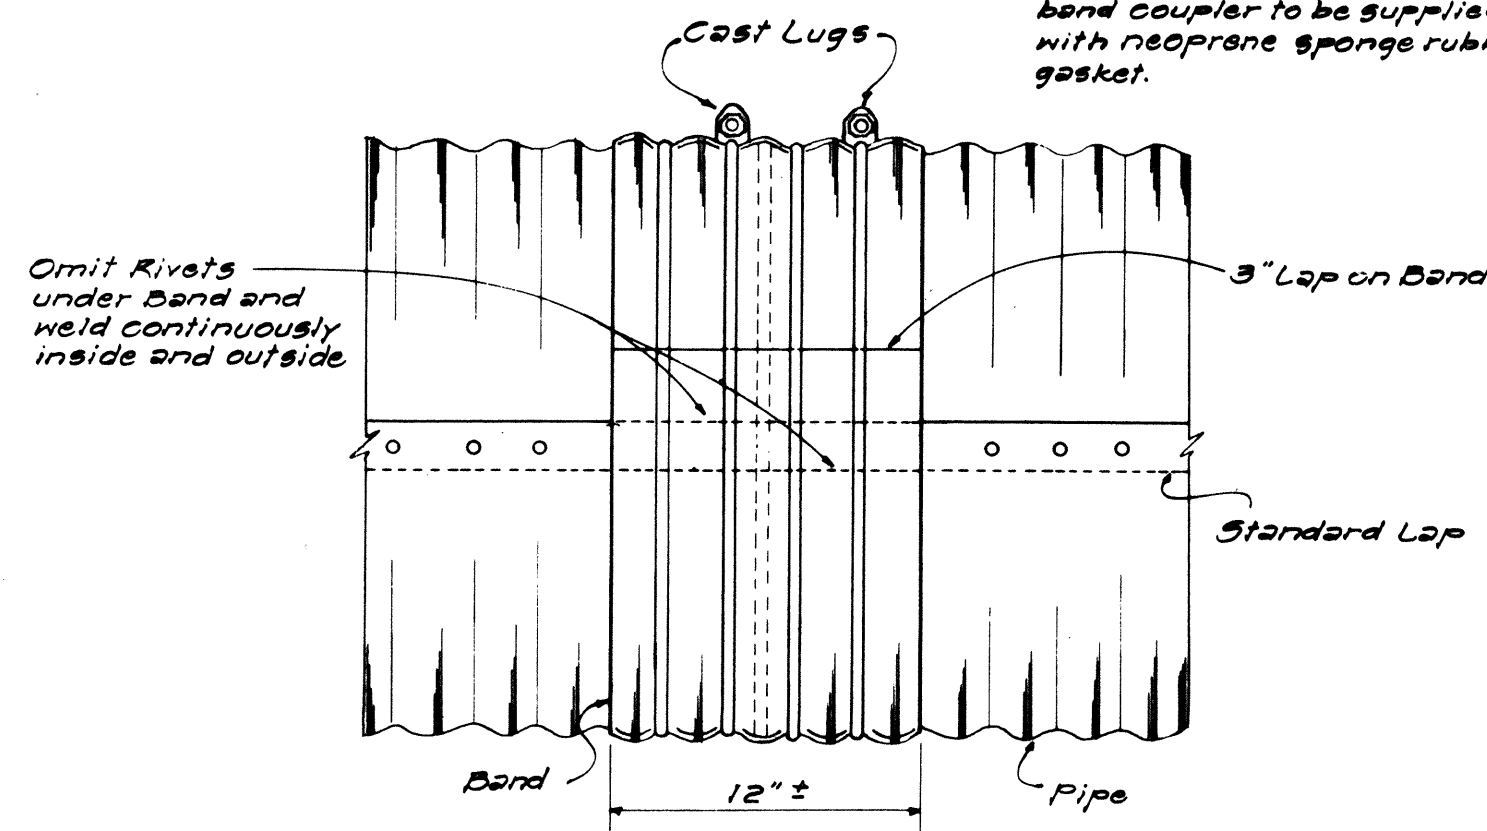


SIDE VIEW

DETAIL OF WATERTIGHT BAND COUPLER
NOT TO SCALE

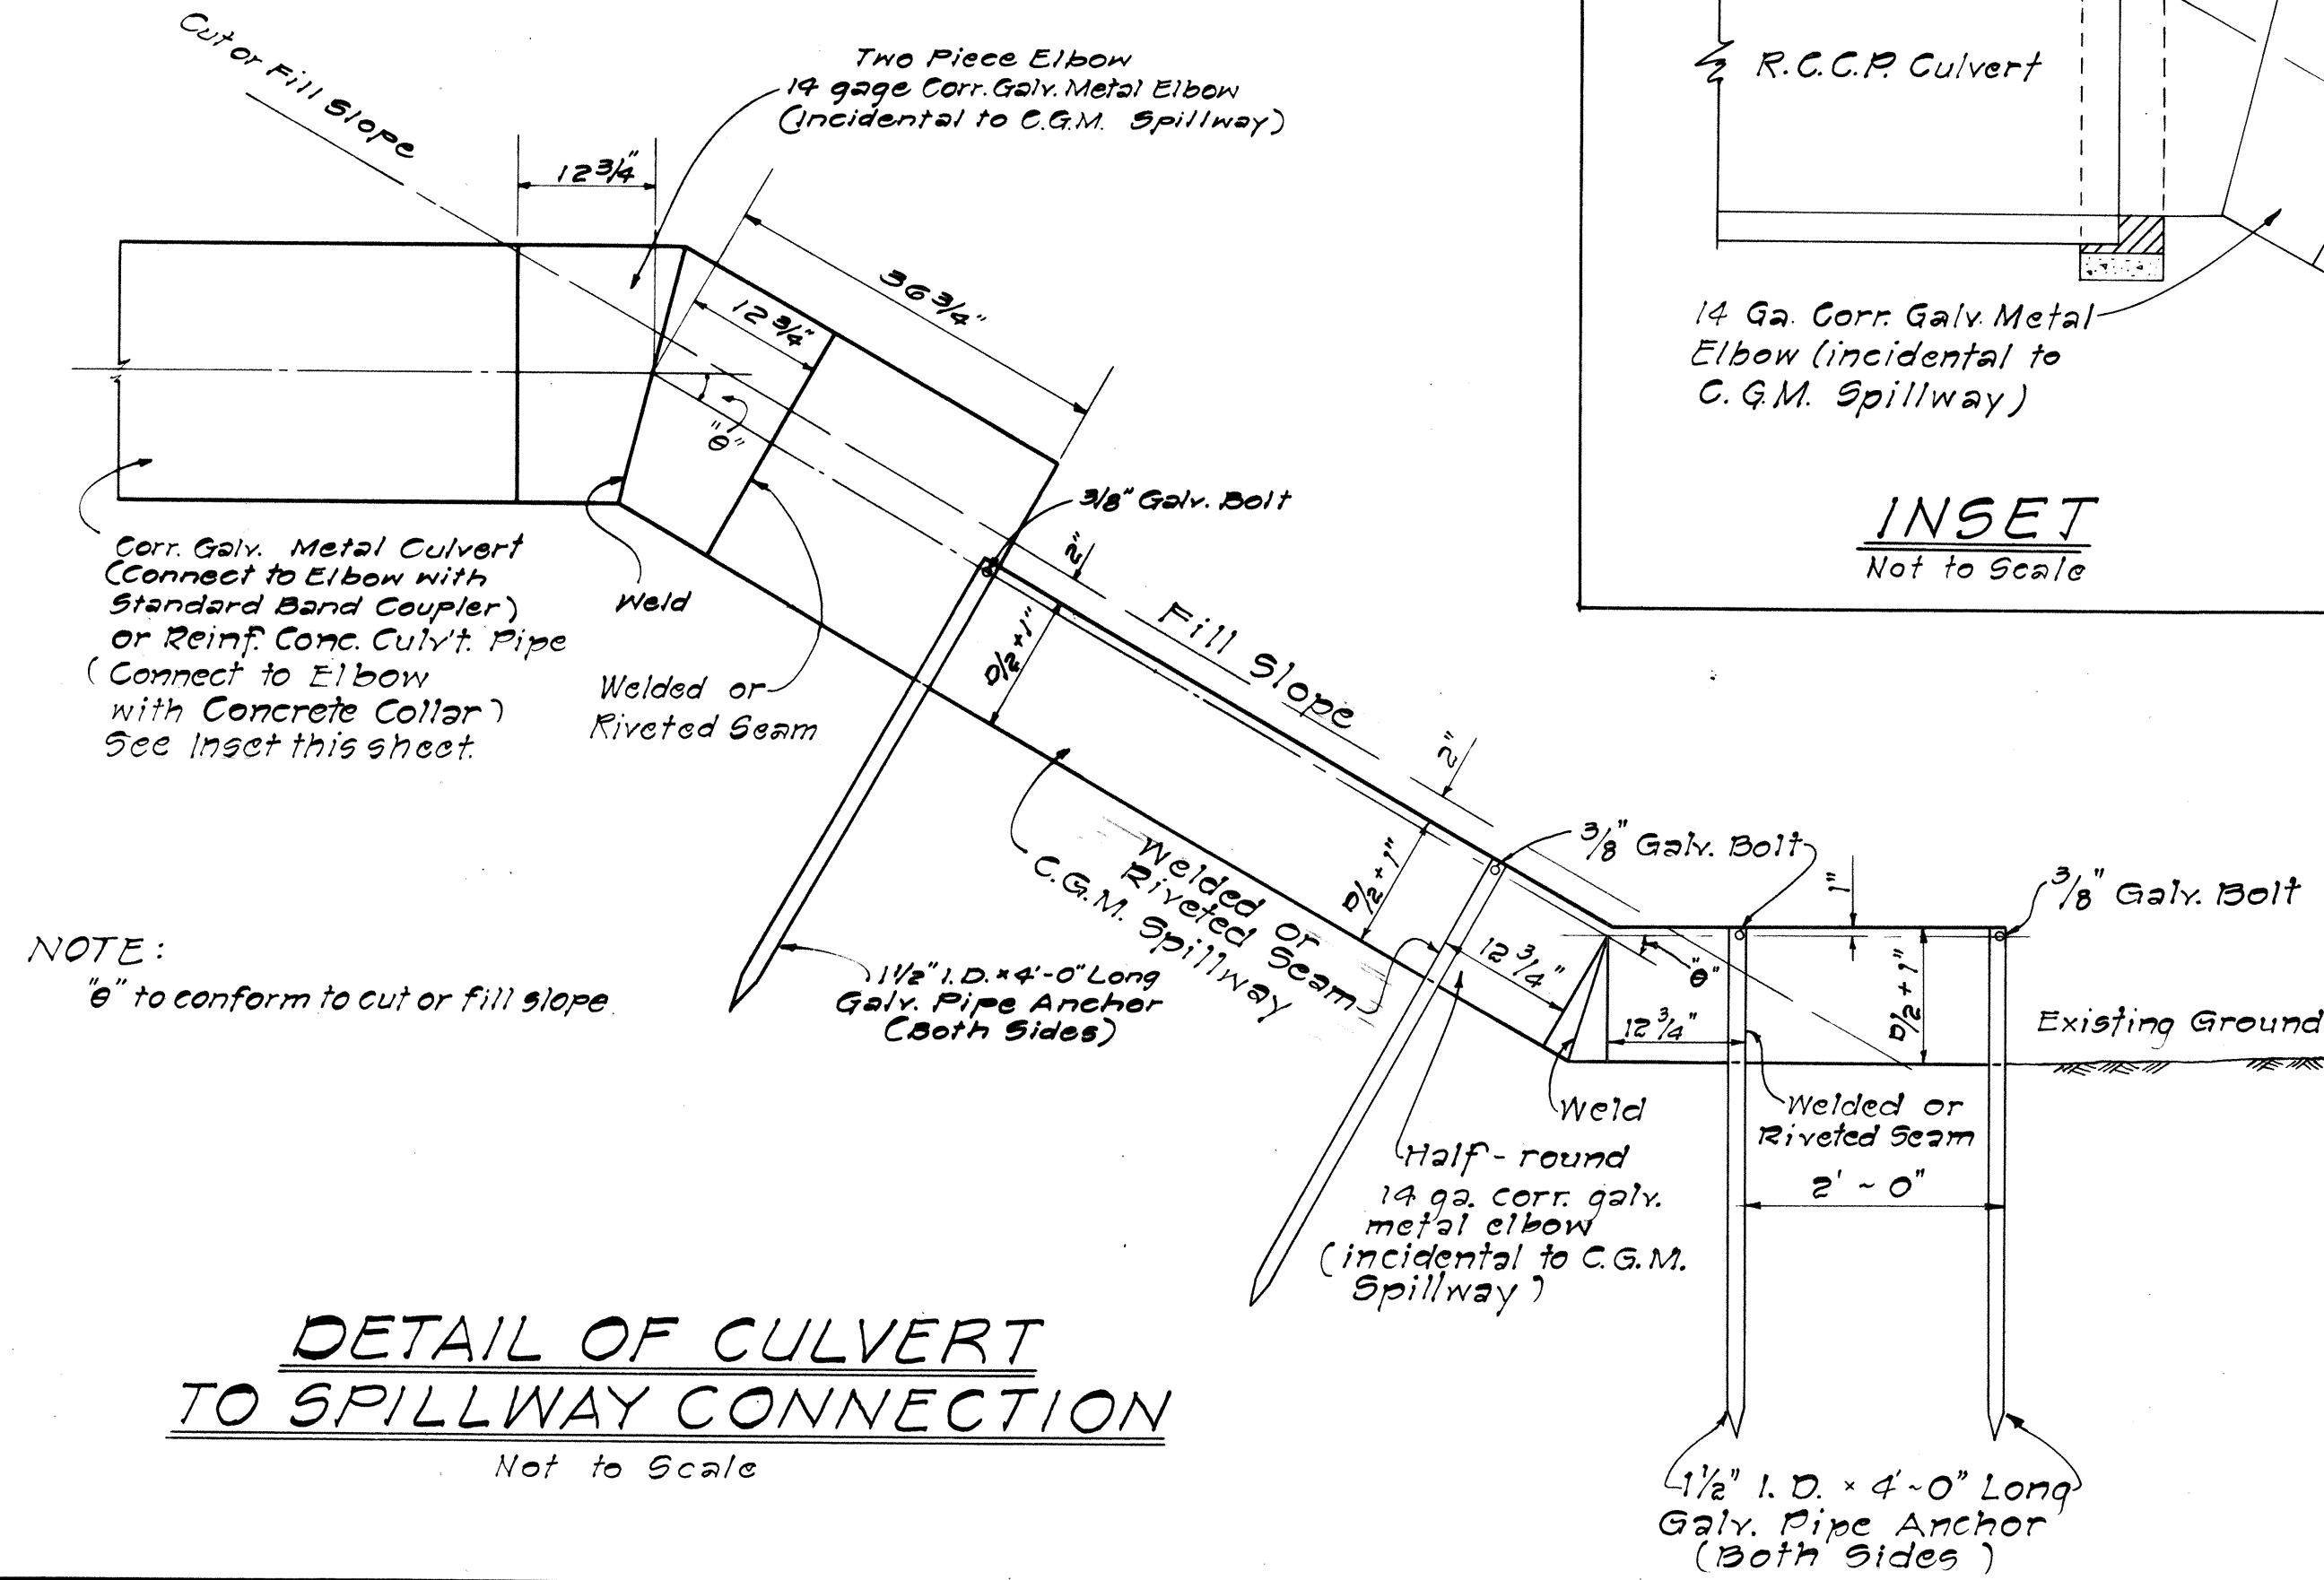


NOTE:
"6" to conform to cut or fill slope.

DETAIL OF CULVERT
TO SPILLWAY CONNECTION
NOT TO SCALE

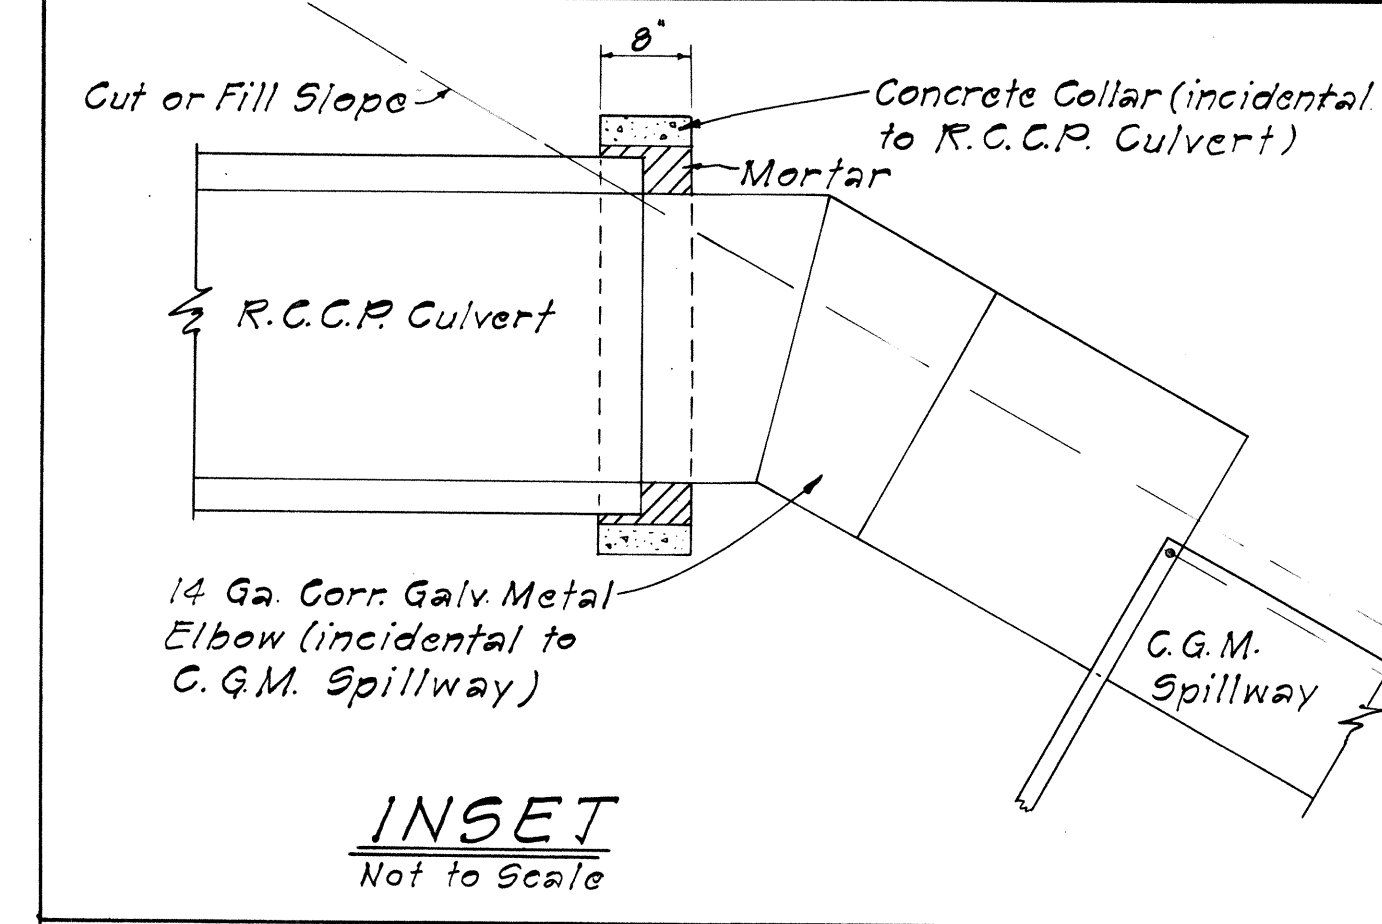


INSET
Not to Scale

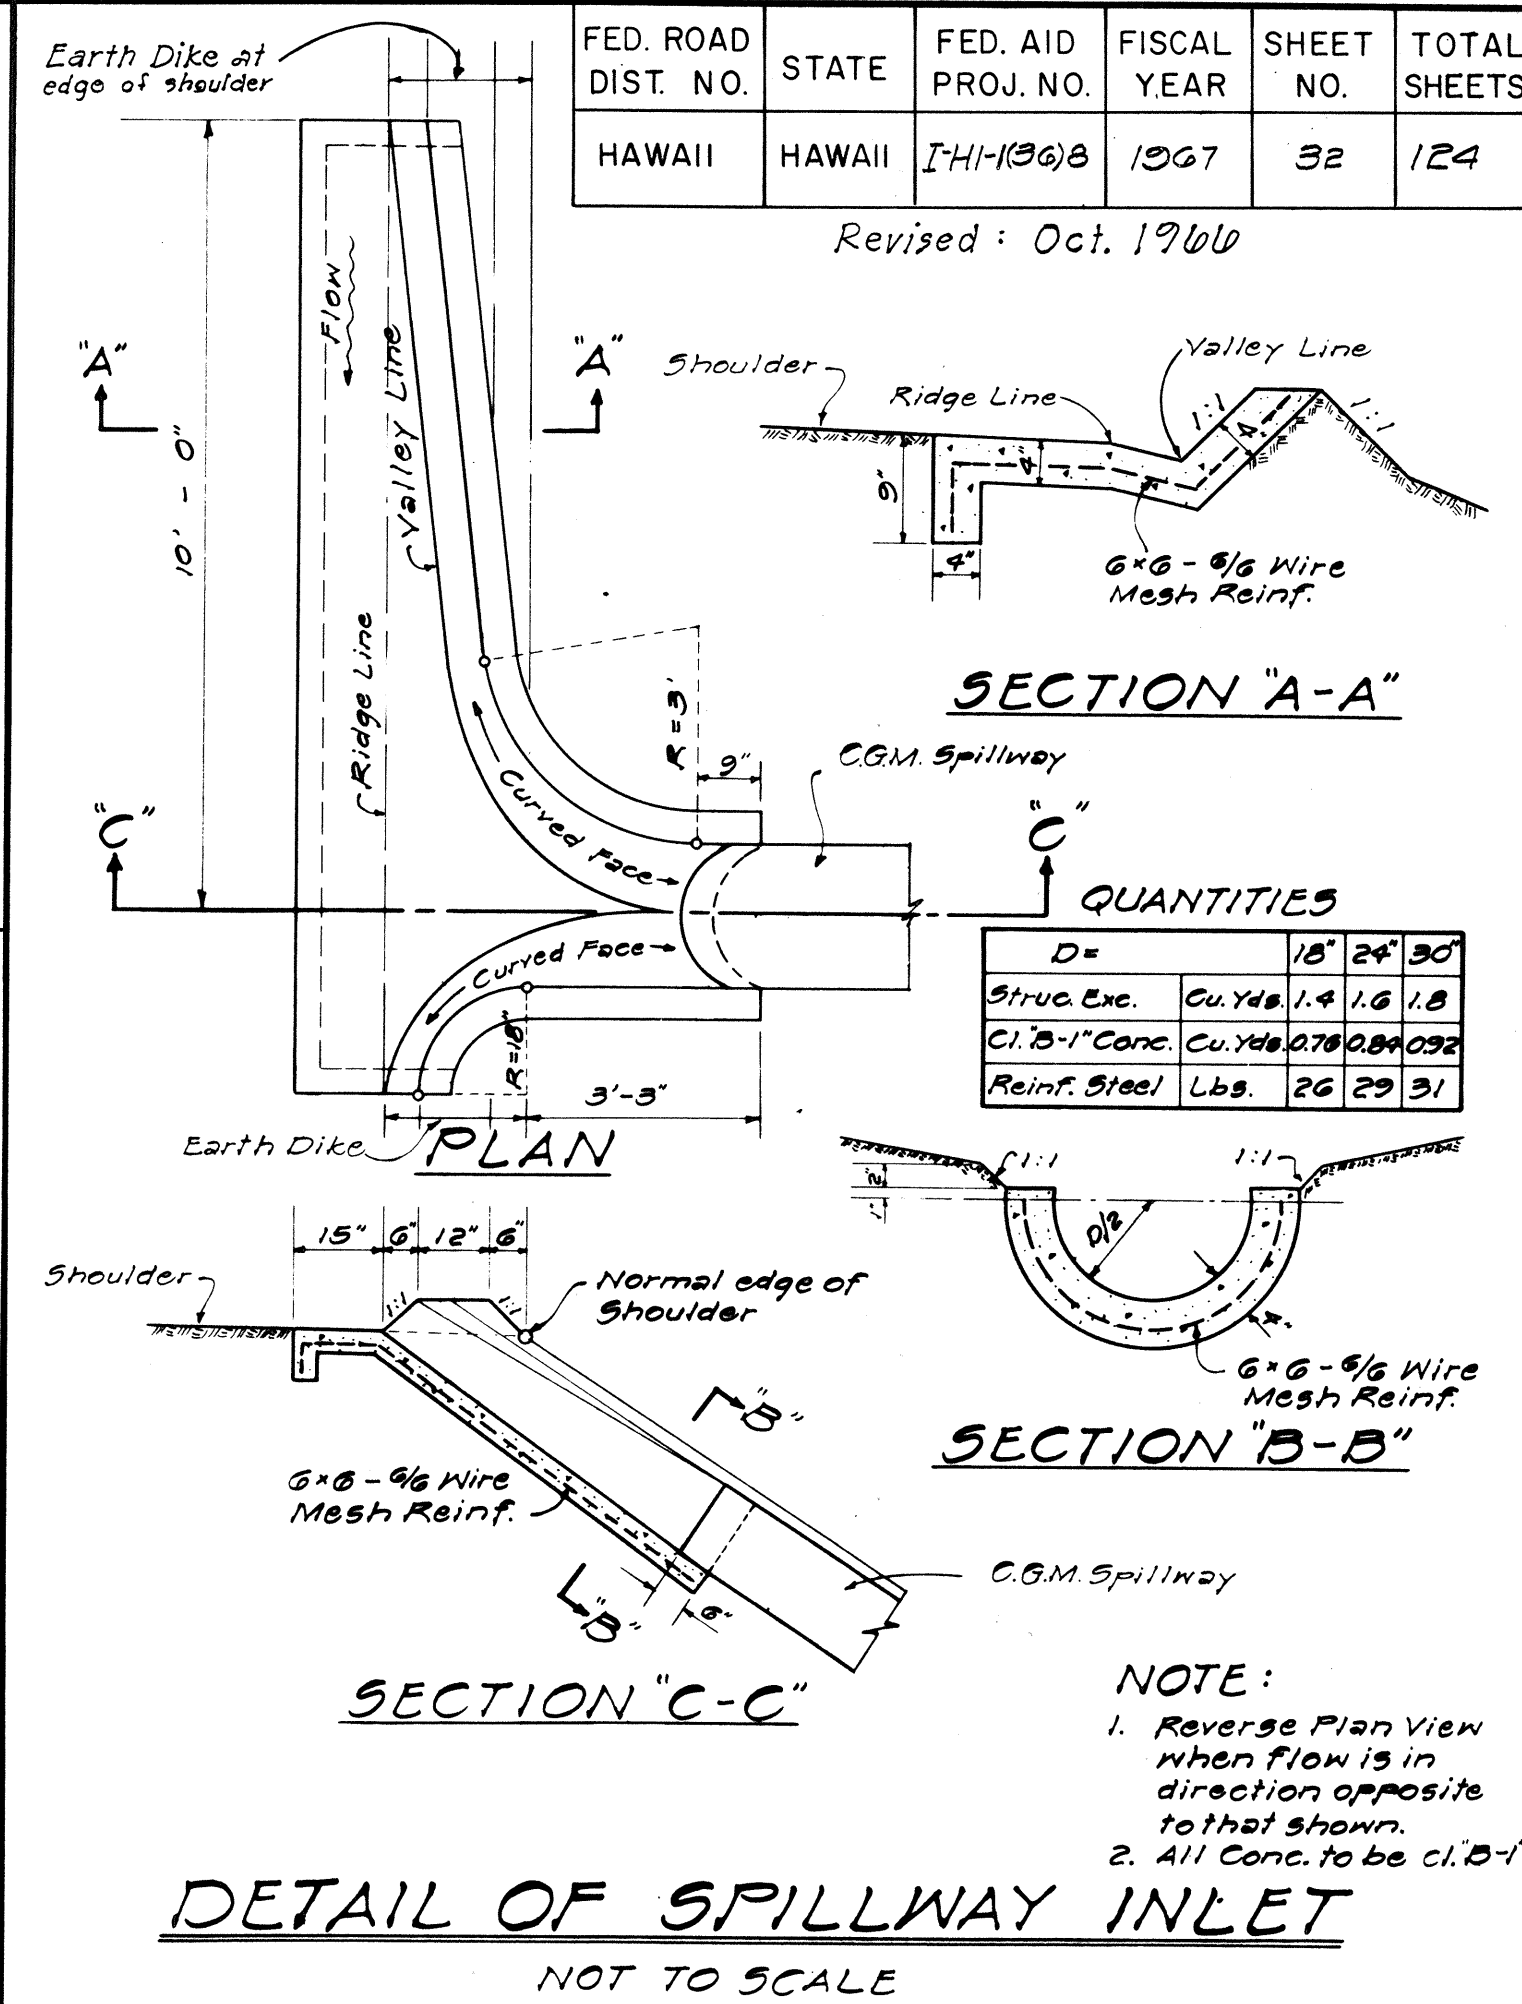


QUANTITIES					
D =	18"	24"	30"		
Struc. Exc.	Cu. Yds. 1.4	1.6	1.8		
Cl. B-1 Conc.	Cu. Yds. 0.78	0.84	0.92		
Reinf. Steel	Lbs. 26	29	31		

NOTE:
1. Reverse Plan View when flow is in direction opposite to that shown.
2. All Conc. to be Cl. B-1

DETAIL OF SPILLWAY INLET
NOT TO SCALE

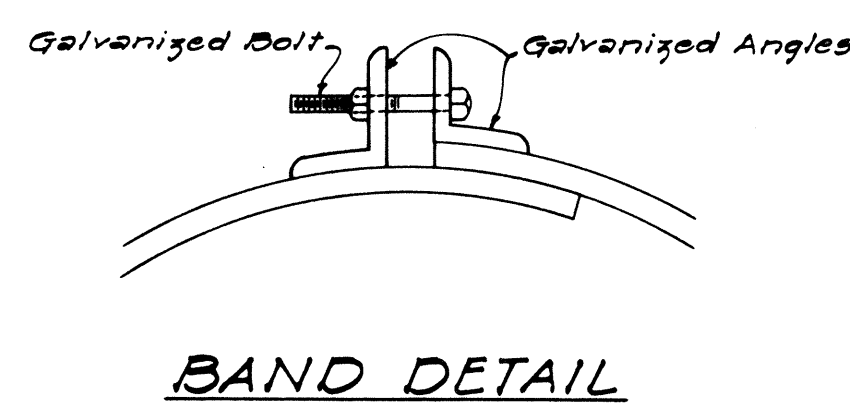


BAND DETAIL

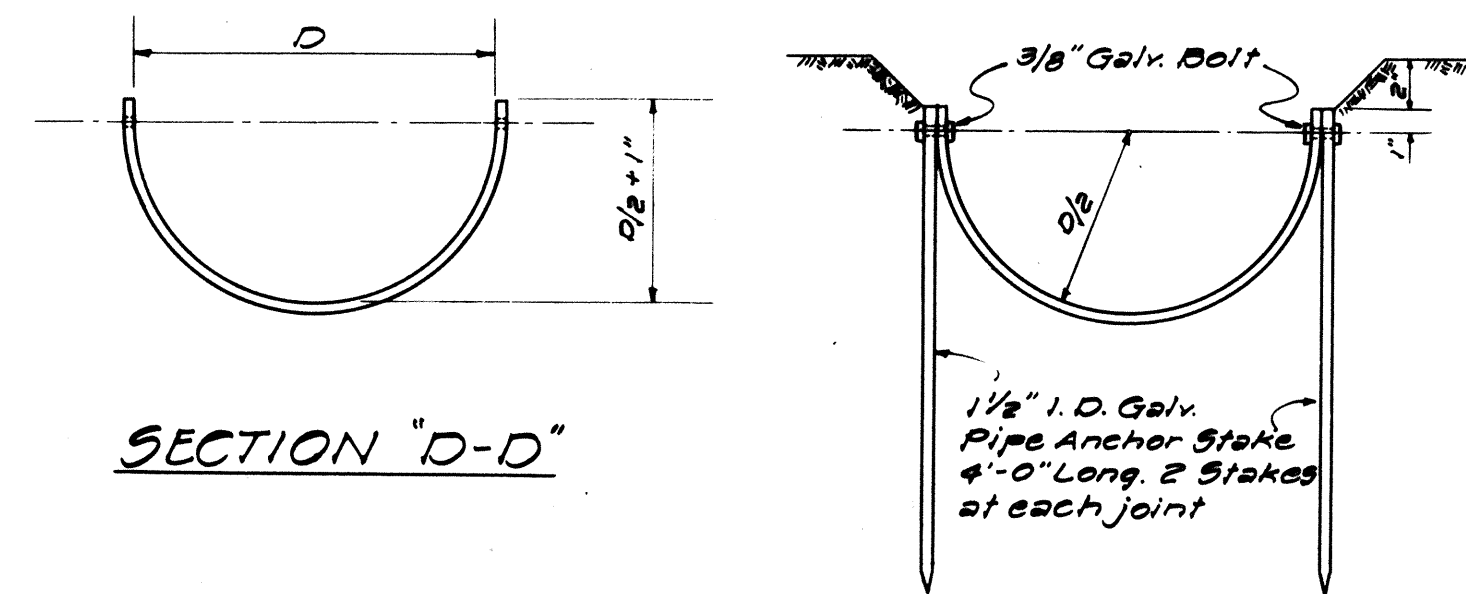


SECTION "D-D"

END VIEW

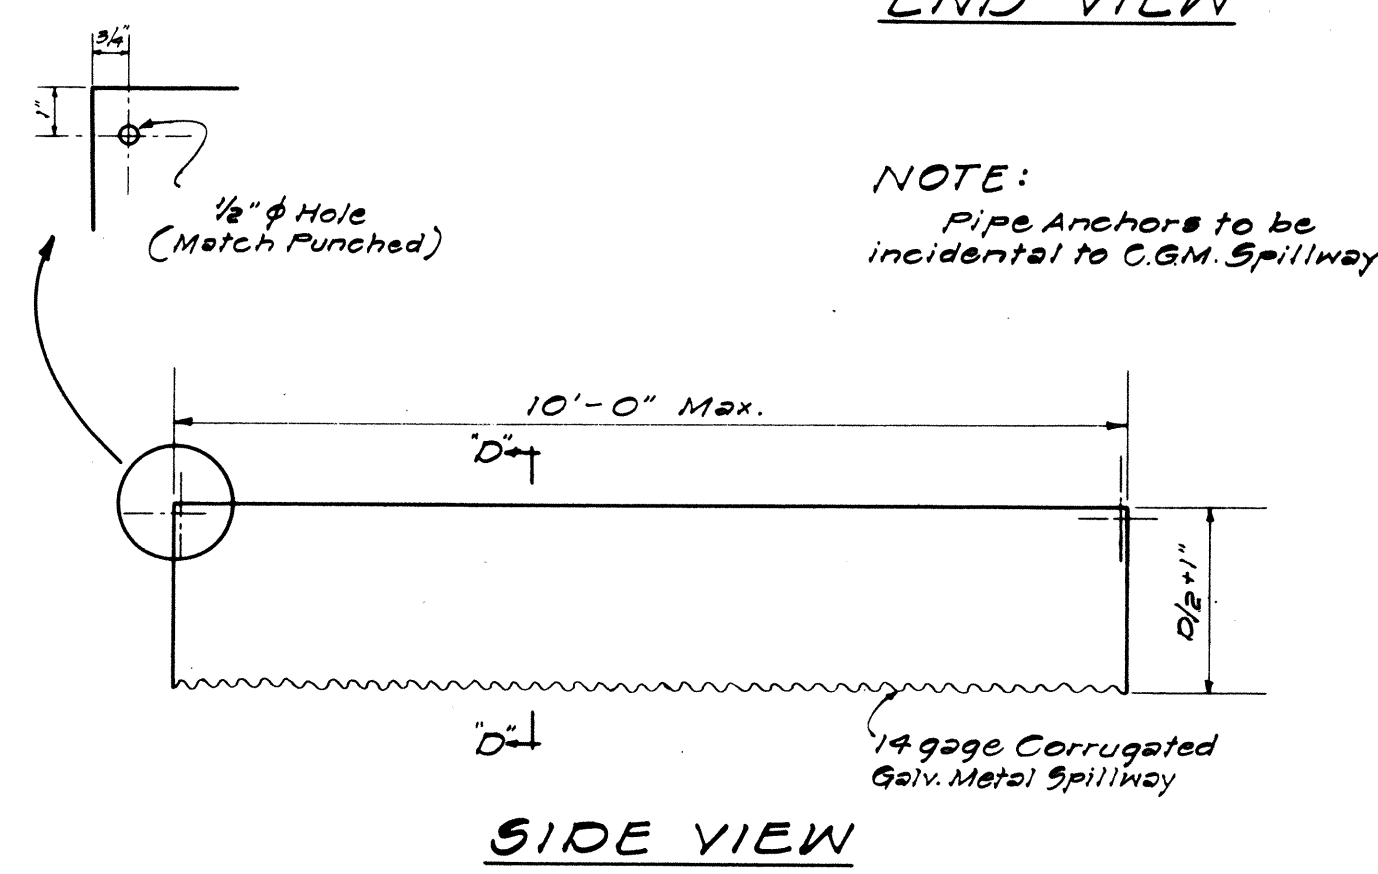

SIDE VIEW

C G. M. SPILLWAY
NOT TO SCALE

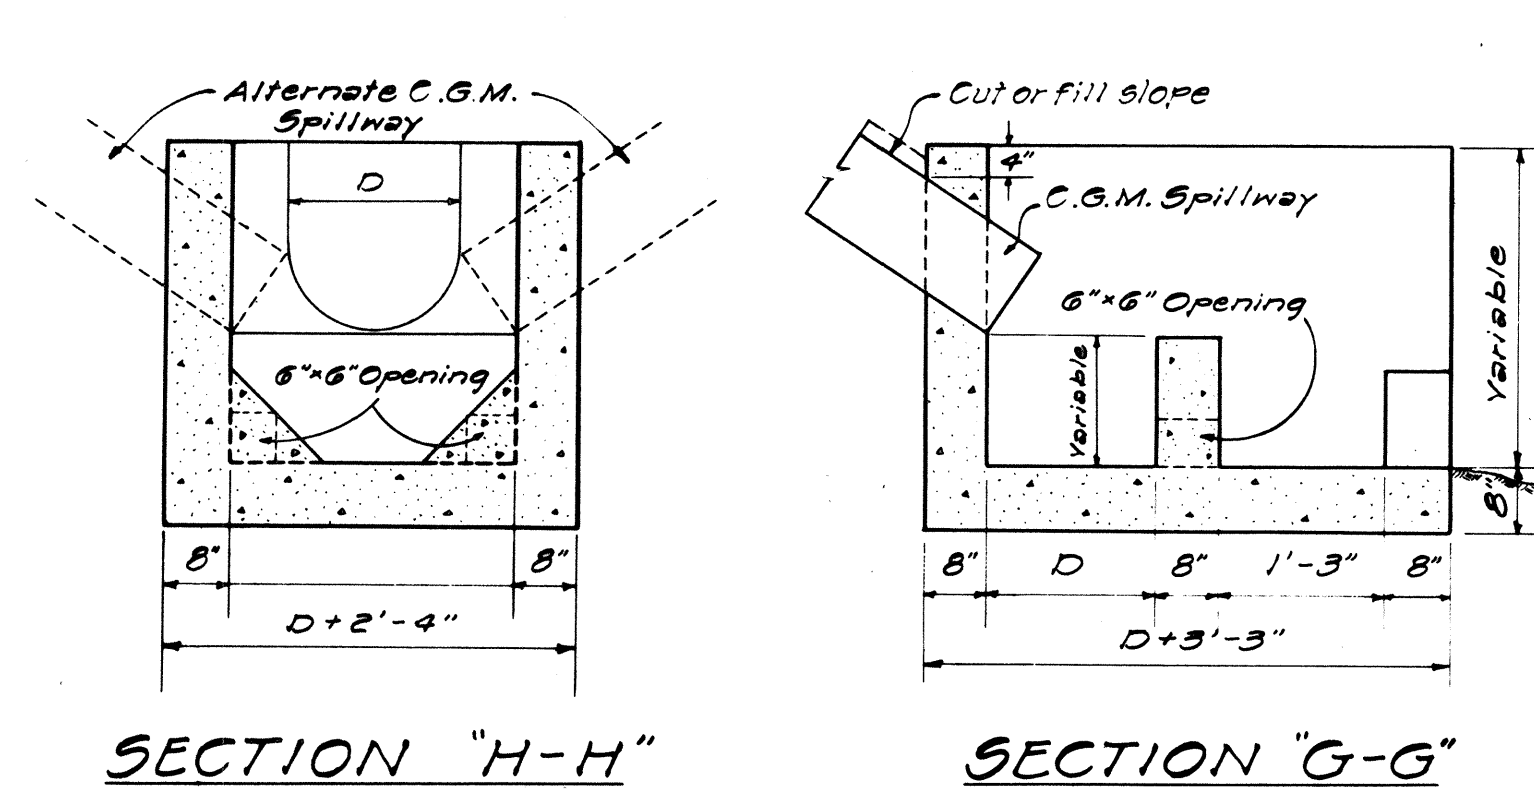


SECTION "H-H"

SECTION "G-G"

QUANTITIES			
D =	18"	24"	30"
Struc. Exc.	Cu. Yds. 3.3	4.2	5.1
Cl. B-1 Conc.	Cu. Yds. 1.5	1.8	2.2

NOTE:
All Concrete to be Cl. B-1

DETAILS OF CONC. DROP BOX
AT OUTLET OF C.G.M. SPILLWAY
NOT TO SCALE

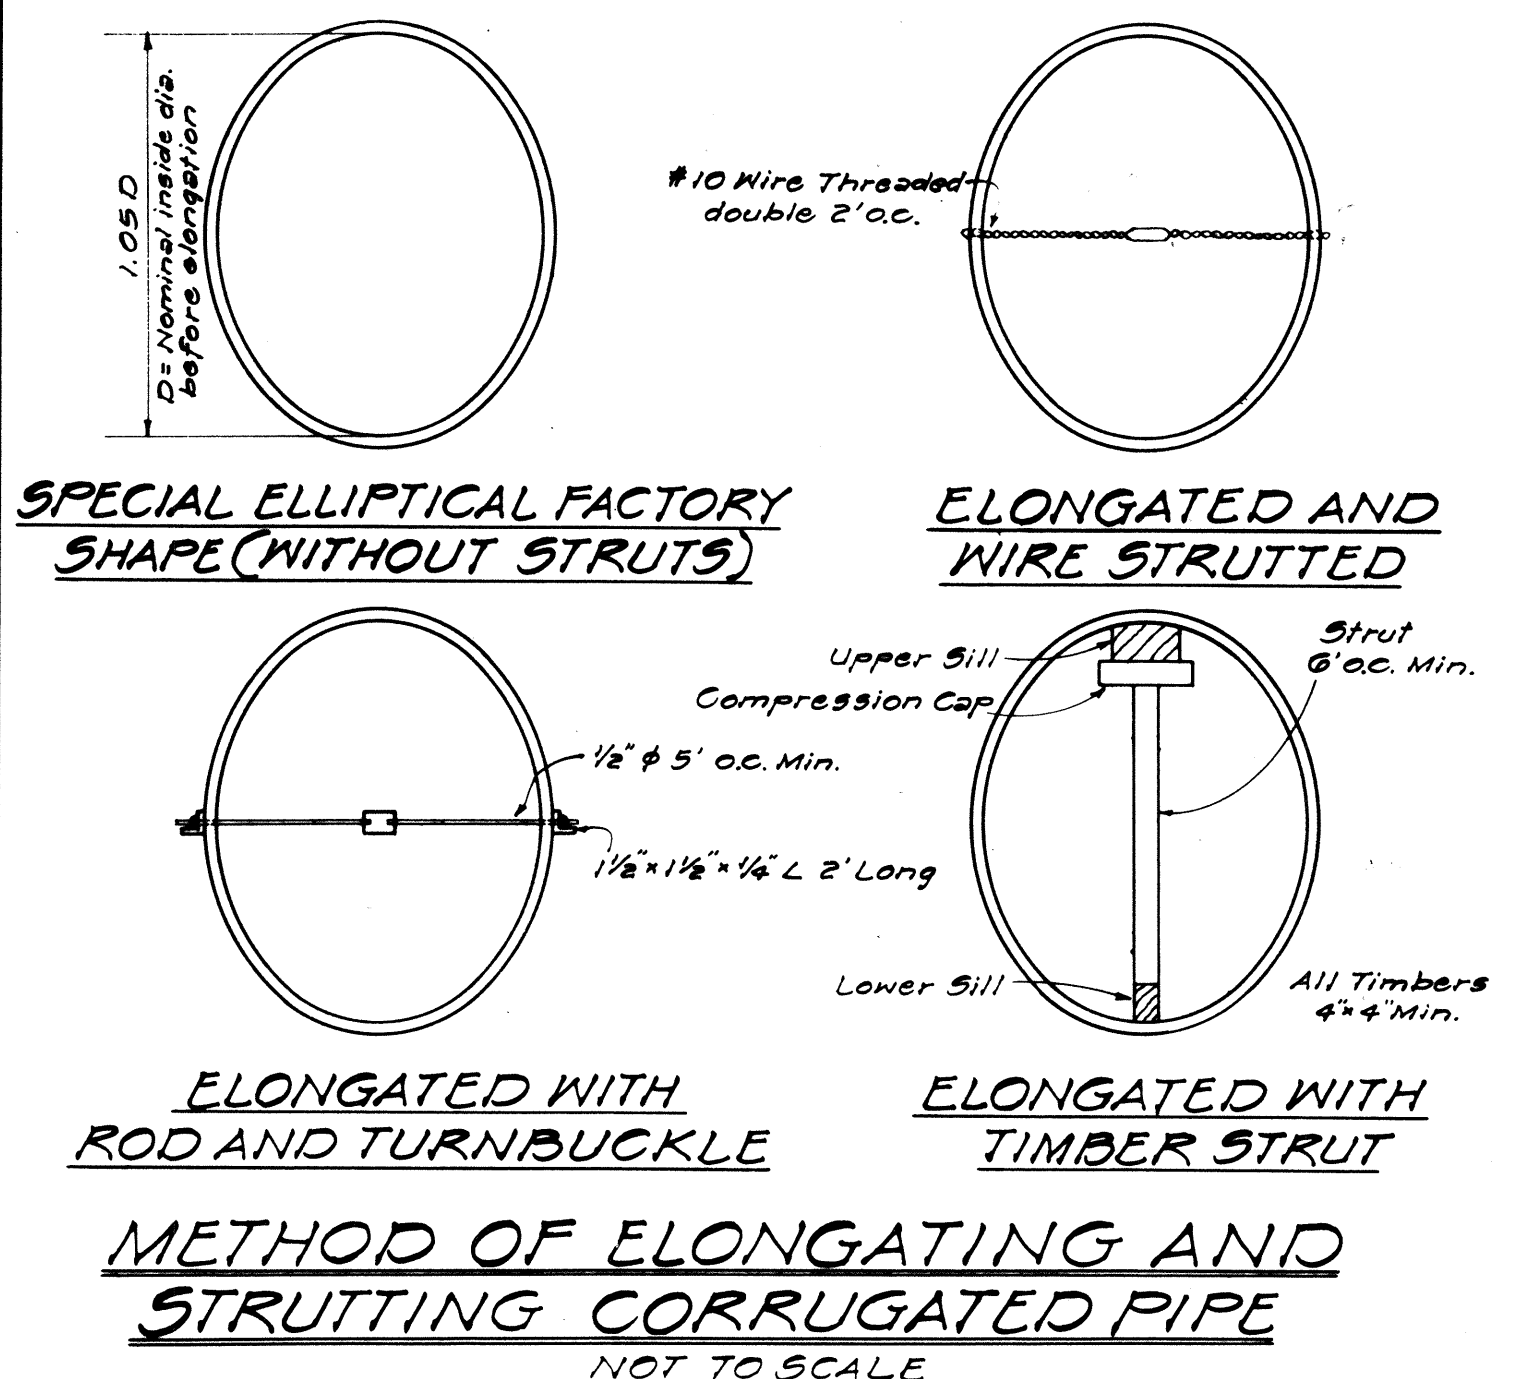

SPECIAL ELLIPTICAL FACTORY
SHAPE (WITHOUT STRUTS)

ELONGATED AND
WIRE STRUTTED

ELONGATED WITH
ROD AND TURNBUCKLE

ELONGATED WITH
TIMBER STRUT

METHOD OF ELONGATING AND
STRUTTING CORRUGATED PIPE
NOT TO SCALE


STATE OF HAWAII
DEPARTMENT OF TRANSPORTATION
HIGHWAYS DIVISION
STANDARD DETAILS
CORRUGATED GALVANIZED METAL
CULVERTS, SPILLWAYS, AND
SPECIAL DETAILS
SCALES AS NOTED
SHEET NO. OF SHEETS

SURVEY PLOTTED BY	DATE
PLAN	5-24-64
DRAWN BY	
DESIGNED BY	
CHECKED BY	
NO.	


2/17/57
3/14/50

FED. ROAD DIST. NO.	STATE	FED. AID PROJ. NO.	FISCAL YEAR	SHEET NO.	TOTAL SHEETS
HAWAII	HAWAII	1-111/1000	1957	33	124
August 1957					


NOTE: Stock Pattern From Novelty Foundry ~ Honolulu

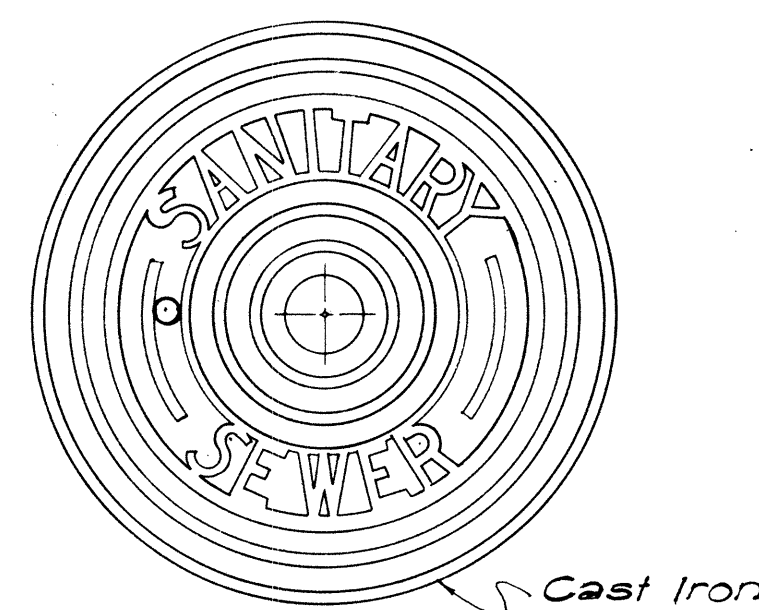


TOP VIEW OF COVER

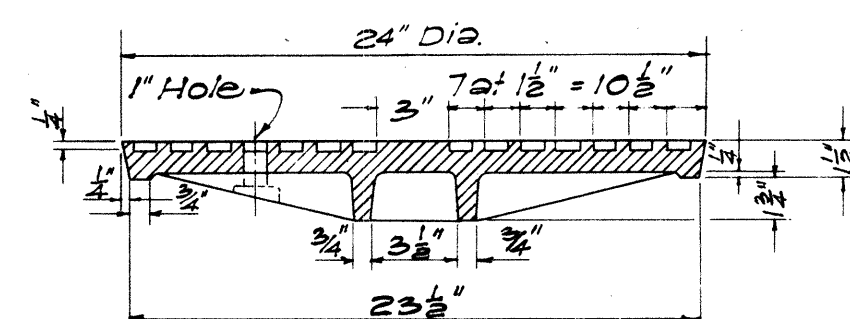


SECTION

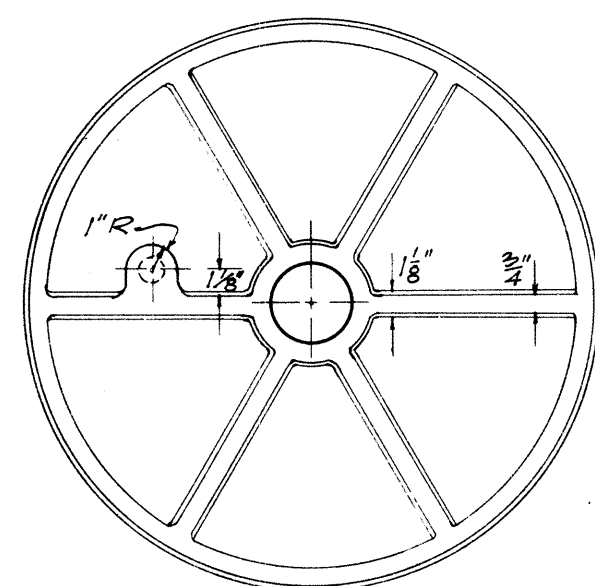


BOTTOM VIEW OF COVER

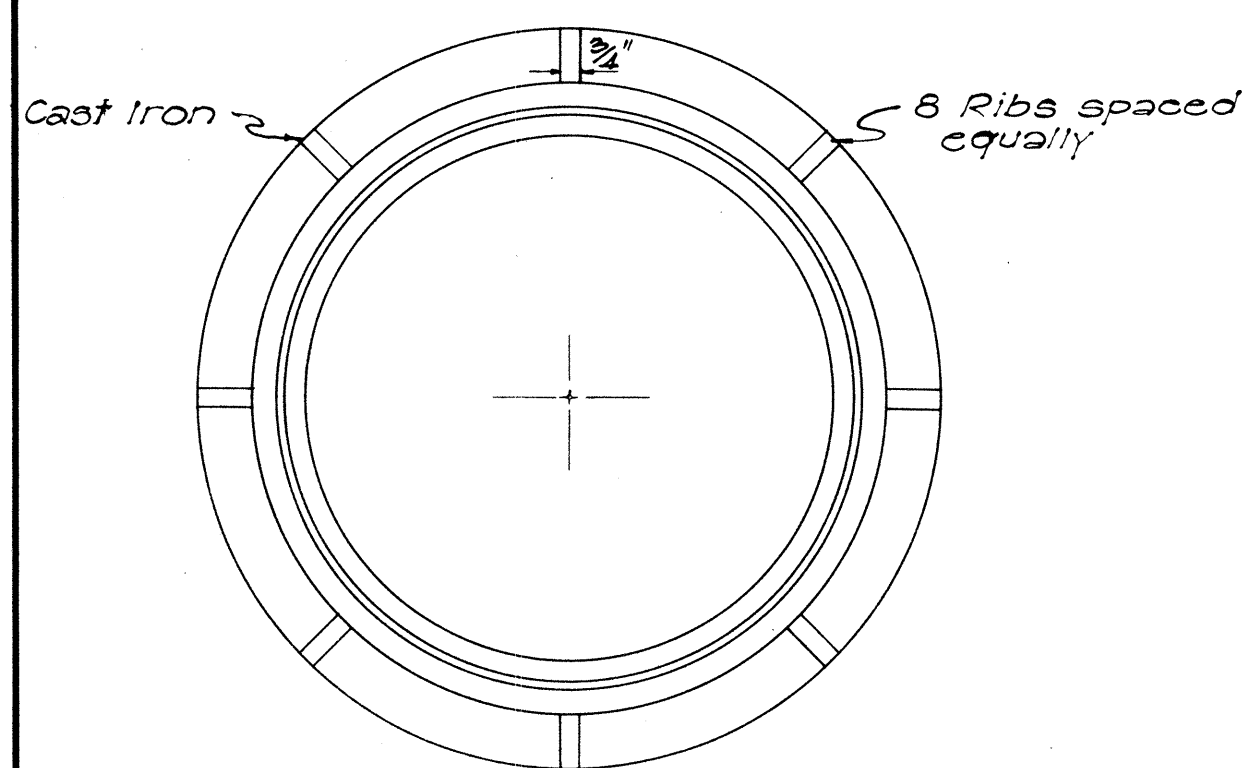


PLAN OF RIM

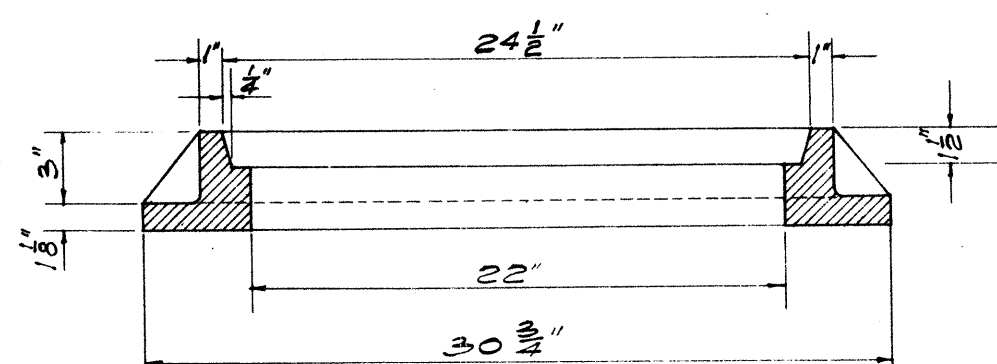


SECTION OF RIM
DETAILS OF TYPE "S"
CAST IRON FRAME AND COVER
SCALE: 1-1/2" = 1'-0"

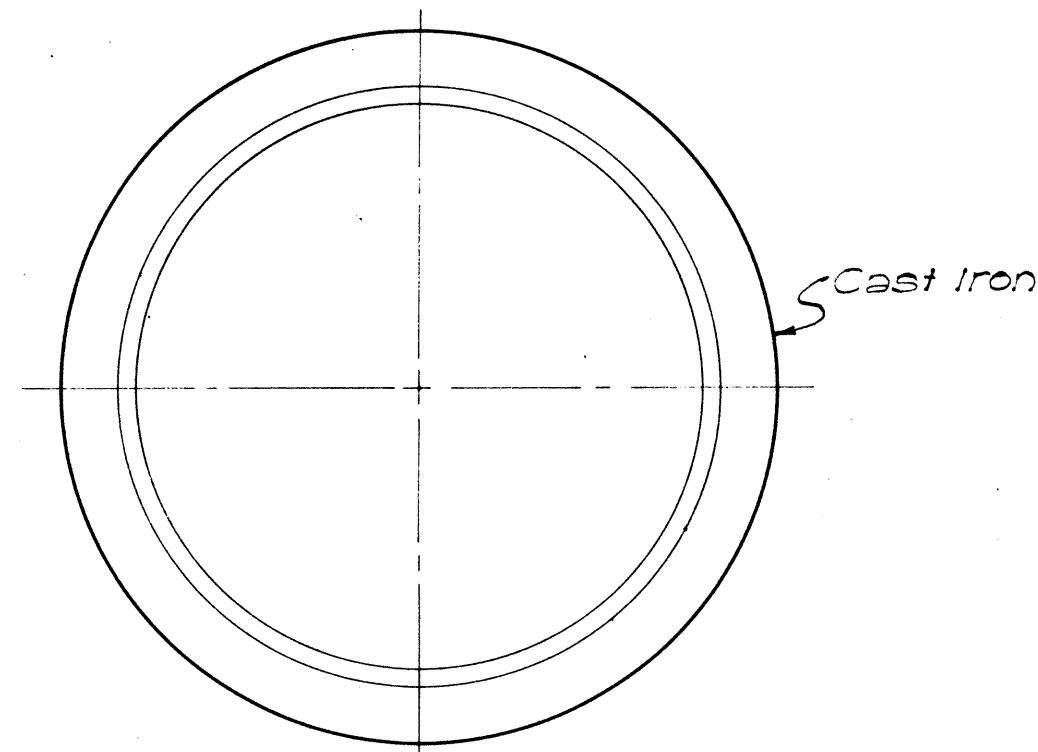


PLAN OF RIM

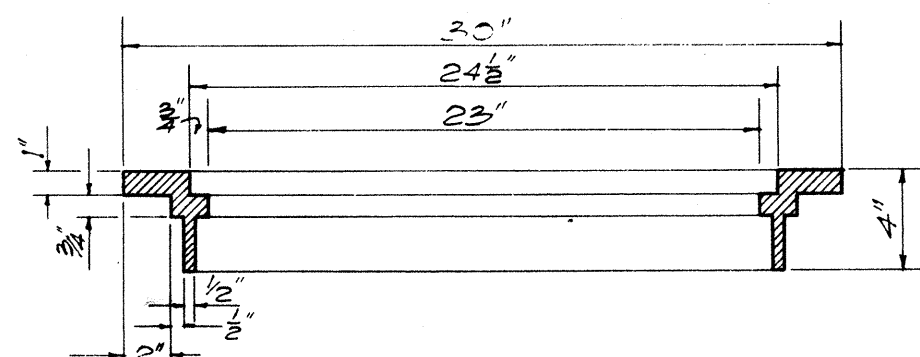


SECTION OF RIM

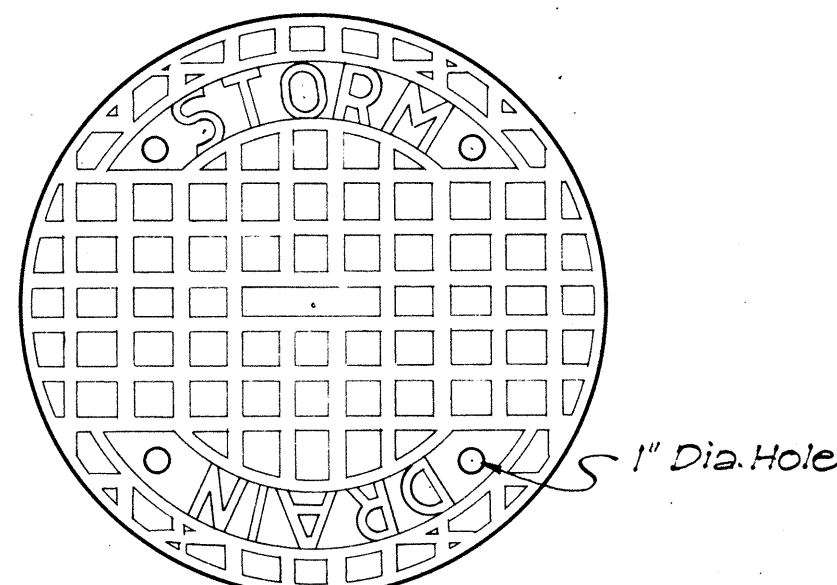

TOP VIEW OF COVER

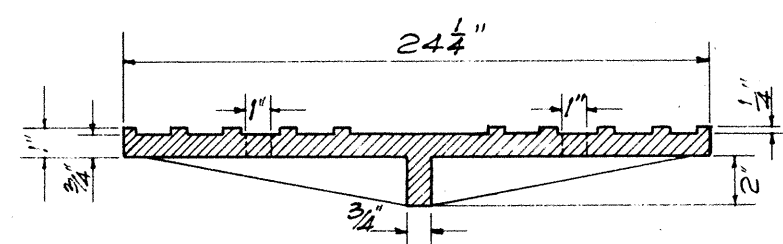


SECTION

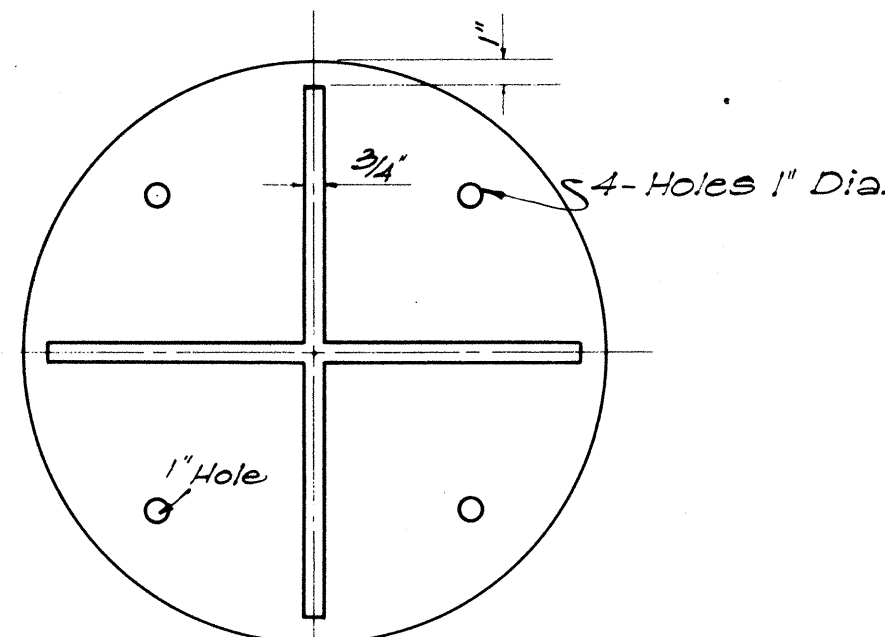


BOTTOM VIEW OF COVER


DETAILS OF TYPE "B"
CAST IRON FRAME AND COVER
SCALE: 1-1/2" = 1'-0"

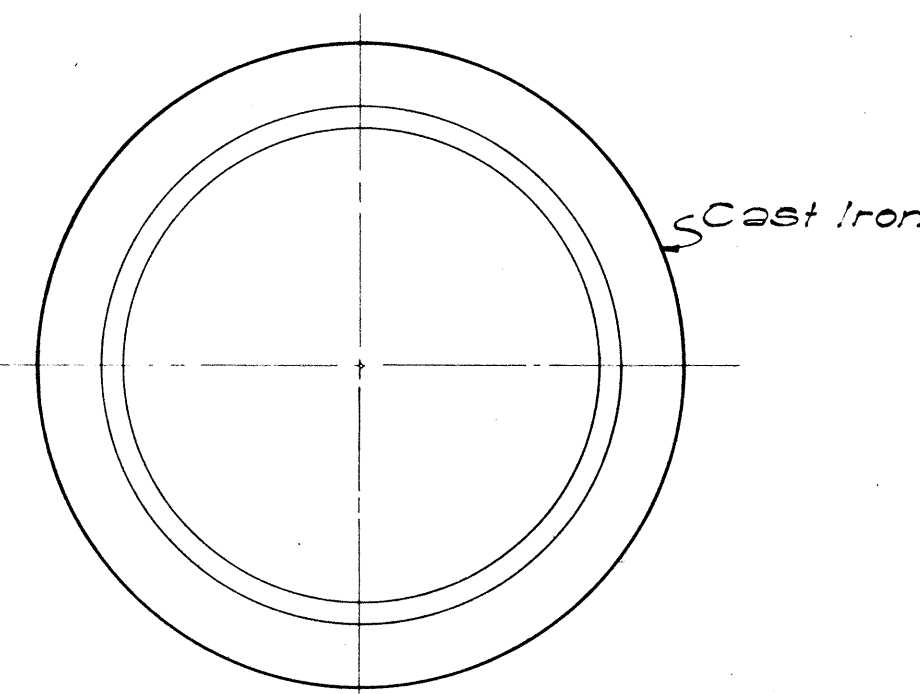


PLAN OF RIM

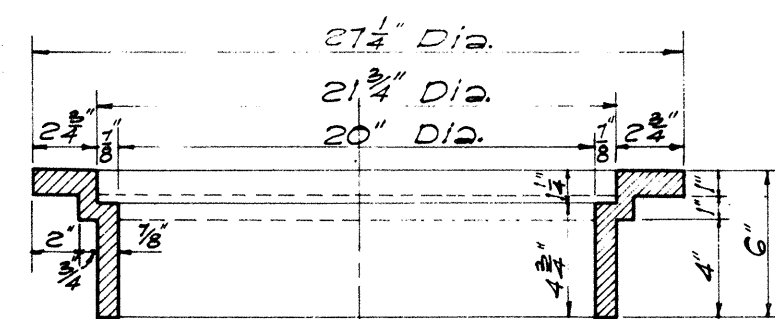


SECTION OF RIM

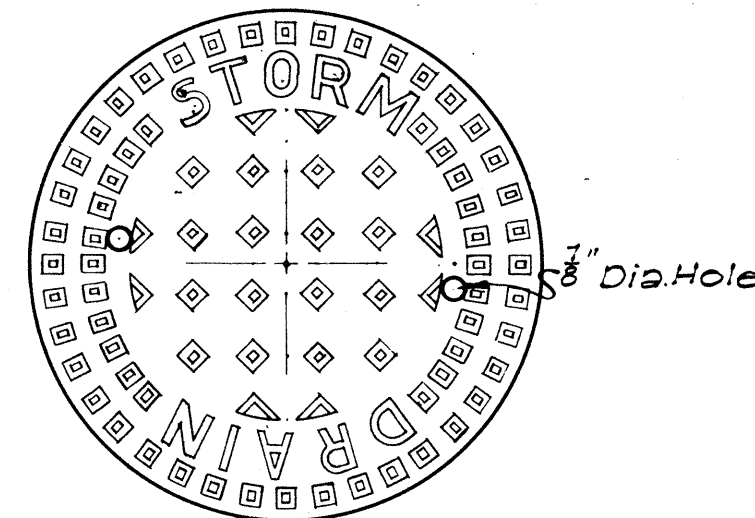

TOP VIEW OF COVER

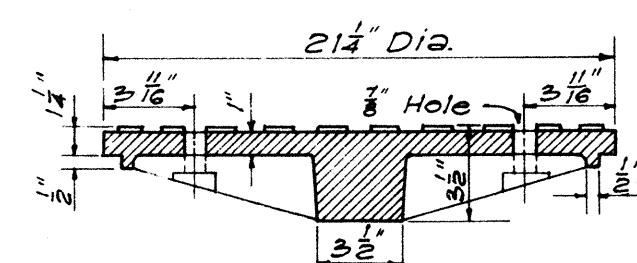


SECTION

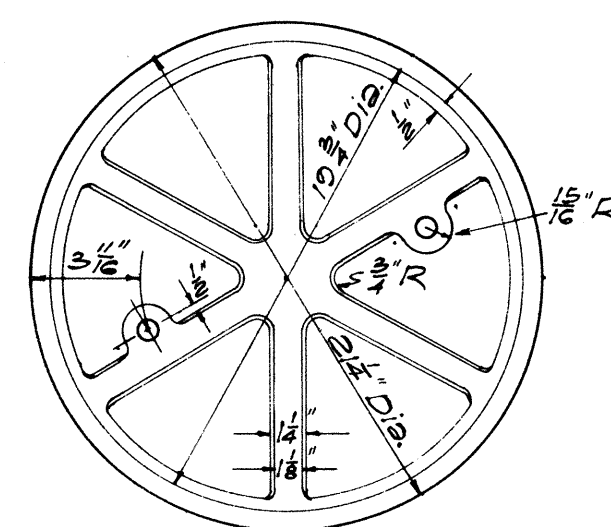


BOTTOM VIEW OF COVER

DETAILS OF TYPE "A"
CAST IRON FRAME AND COVER
SCALE: 1-1/2" = 1'-0"

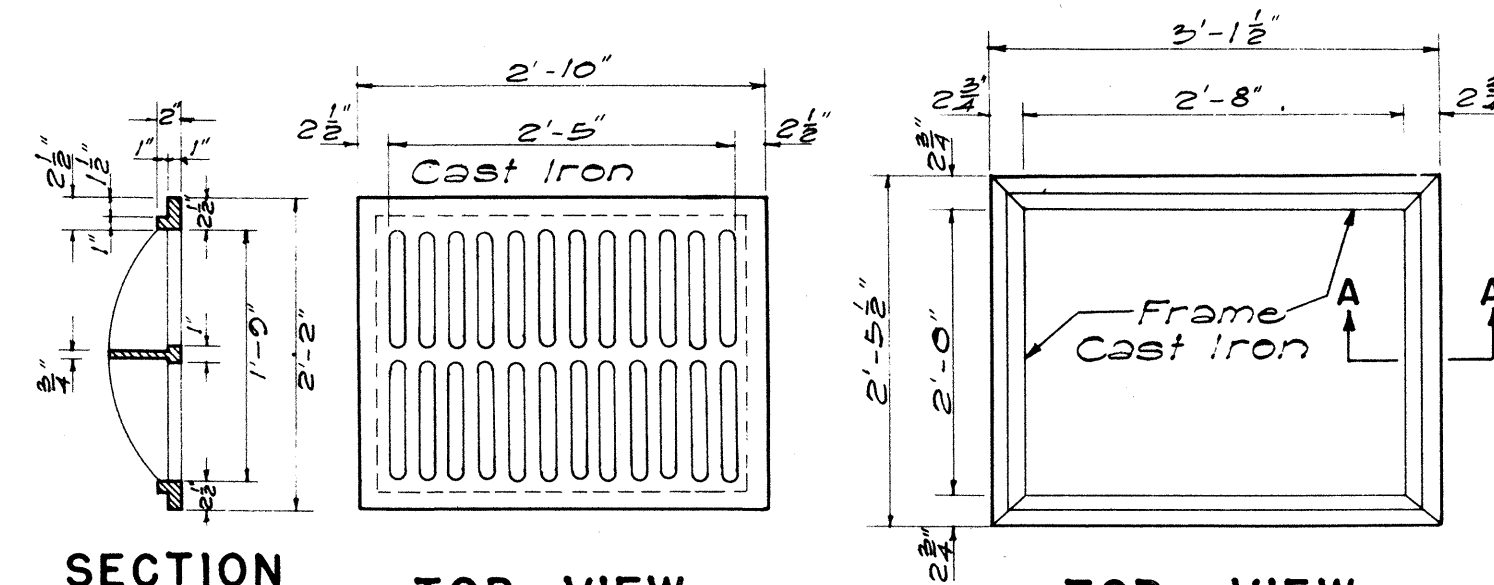


SECTION

TOP VIEW

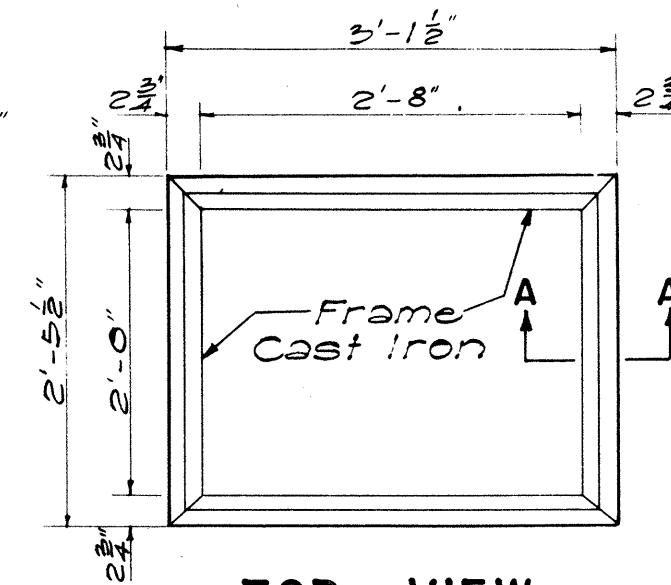


TOP VIEW


TYPE C C.I. FRAME AND GRATING
SCALE: 3/4" = 1'-0"

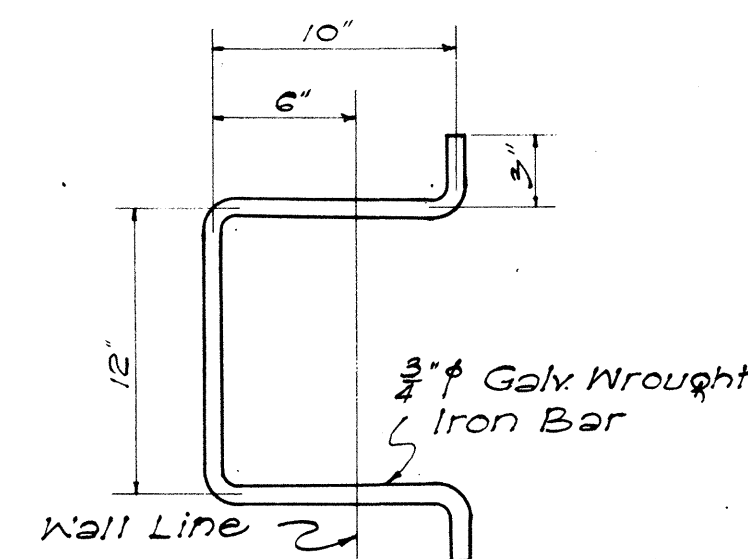


MANHOLE RUNG
SCALE: 1-1/2" = 1'-0"

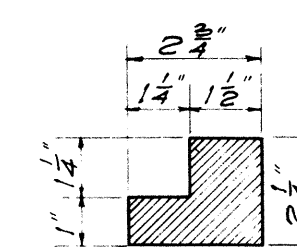


SECTION "A-A"
SCALE 3" = 1'-0"

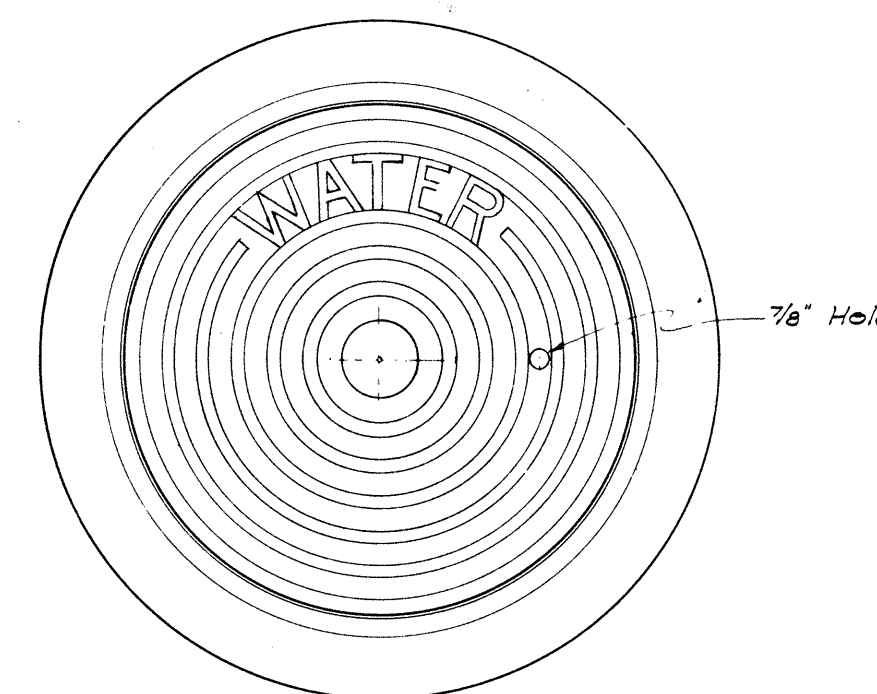

PLAN OF FRAME AND COVER

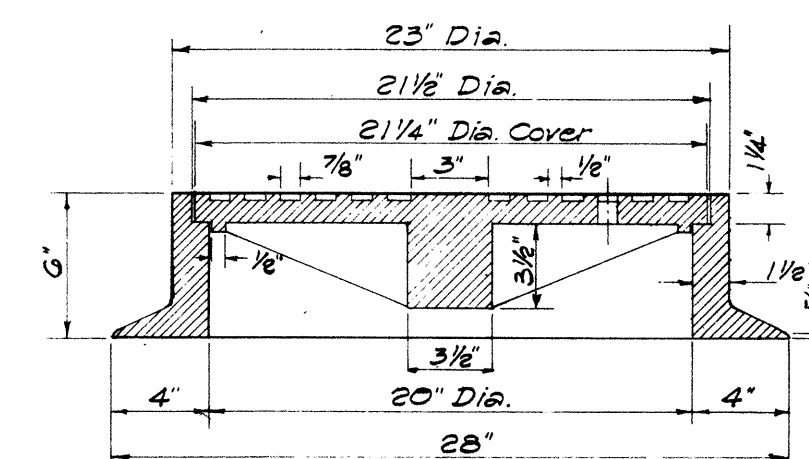

SECTION OF FRAME AND COVER

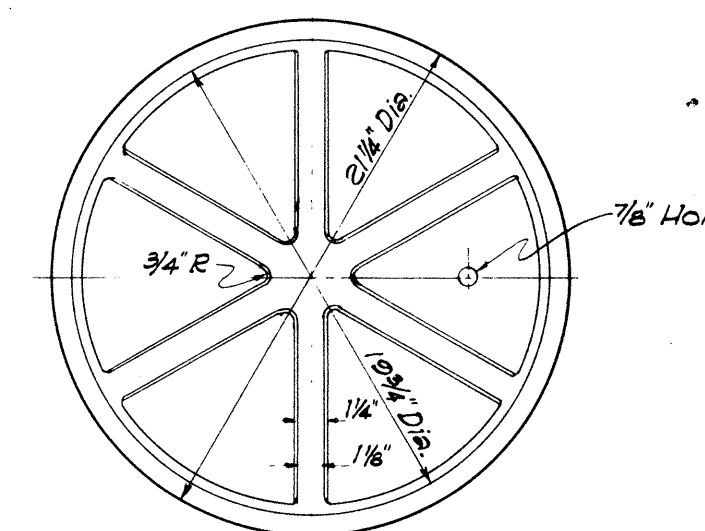

BOTTOM VIEW OF COVER

DETAILS OF TYPE "W"
CAST IRON FRAME AND COVER
SCALE: 1-1/2" = 1'-0"

NOTE:

THE TYPE "S" CAST IRON FRAME AND COVER SHOWN ON THIS SHEET IS EQUIVALENT TO THE CITY AND COUNTY OF HONOLULU, DIVISION OF SEWERS' TYPE "A" CAST IRON MANHOLE FRAME AND COVER.

THE TYPE "W" CAST IRON FRAME AND COVER SHOWN ON THIS SHEET IS EQUIVALENT TO THE CITY AND COUNTY OF HONOLULU, BOARD OF WATER SUPPLY'S CAST IRON MANHOLE FRAME AND COVER, 20" SIZE.

STATE OF HAWAII
DEPARTMENT OF TRANSPORTATION
HIGHWAYS DIVISION

STANDARD DETAILS
CATCH BASIN AND
MANHOLE CASTINGS
SCALES AS NOTED

SHEET NO. OF SHEETS