


FED. ROAD DIST. NO.	STATE	FED. AID PROJ. NO.	FISCAL YEAR	SHEET NO.	TOTAL SHEETS
HAWAII	HAW.	I-HI-1(37)	1967	3	58

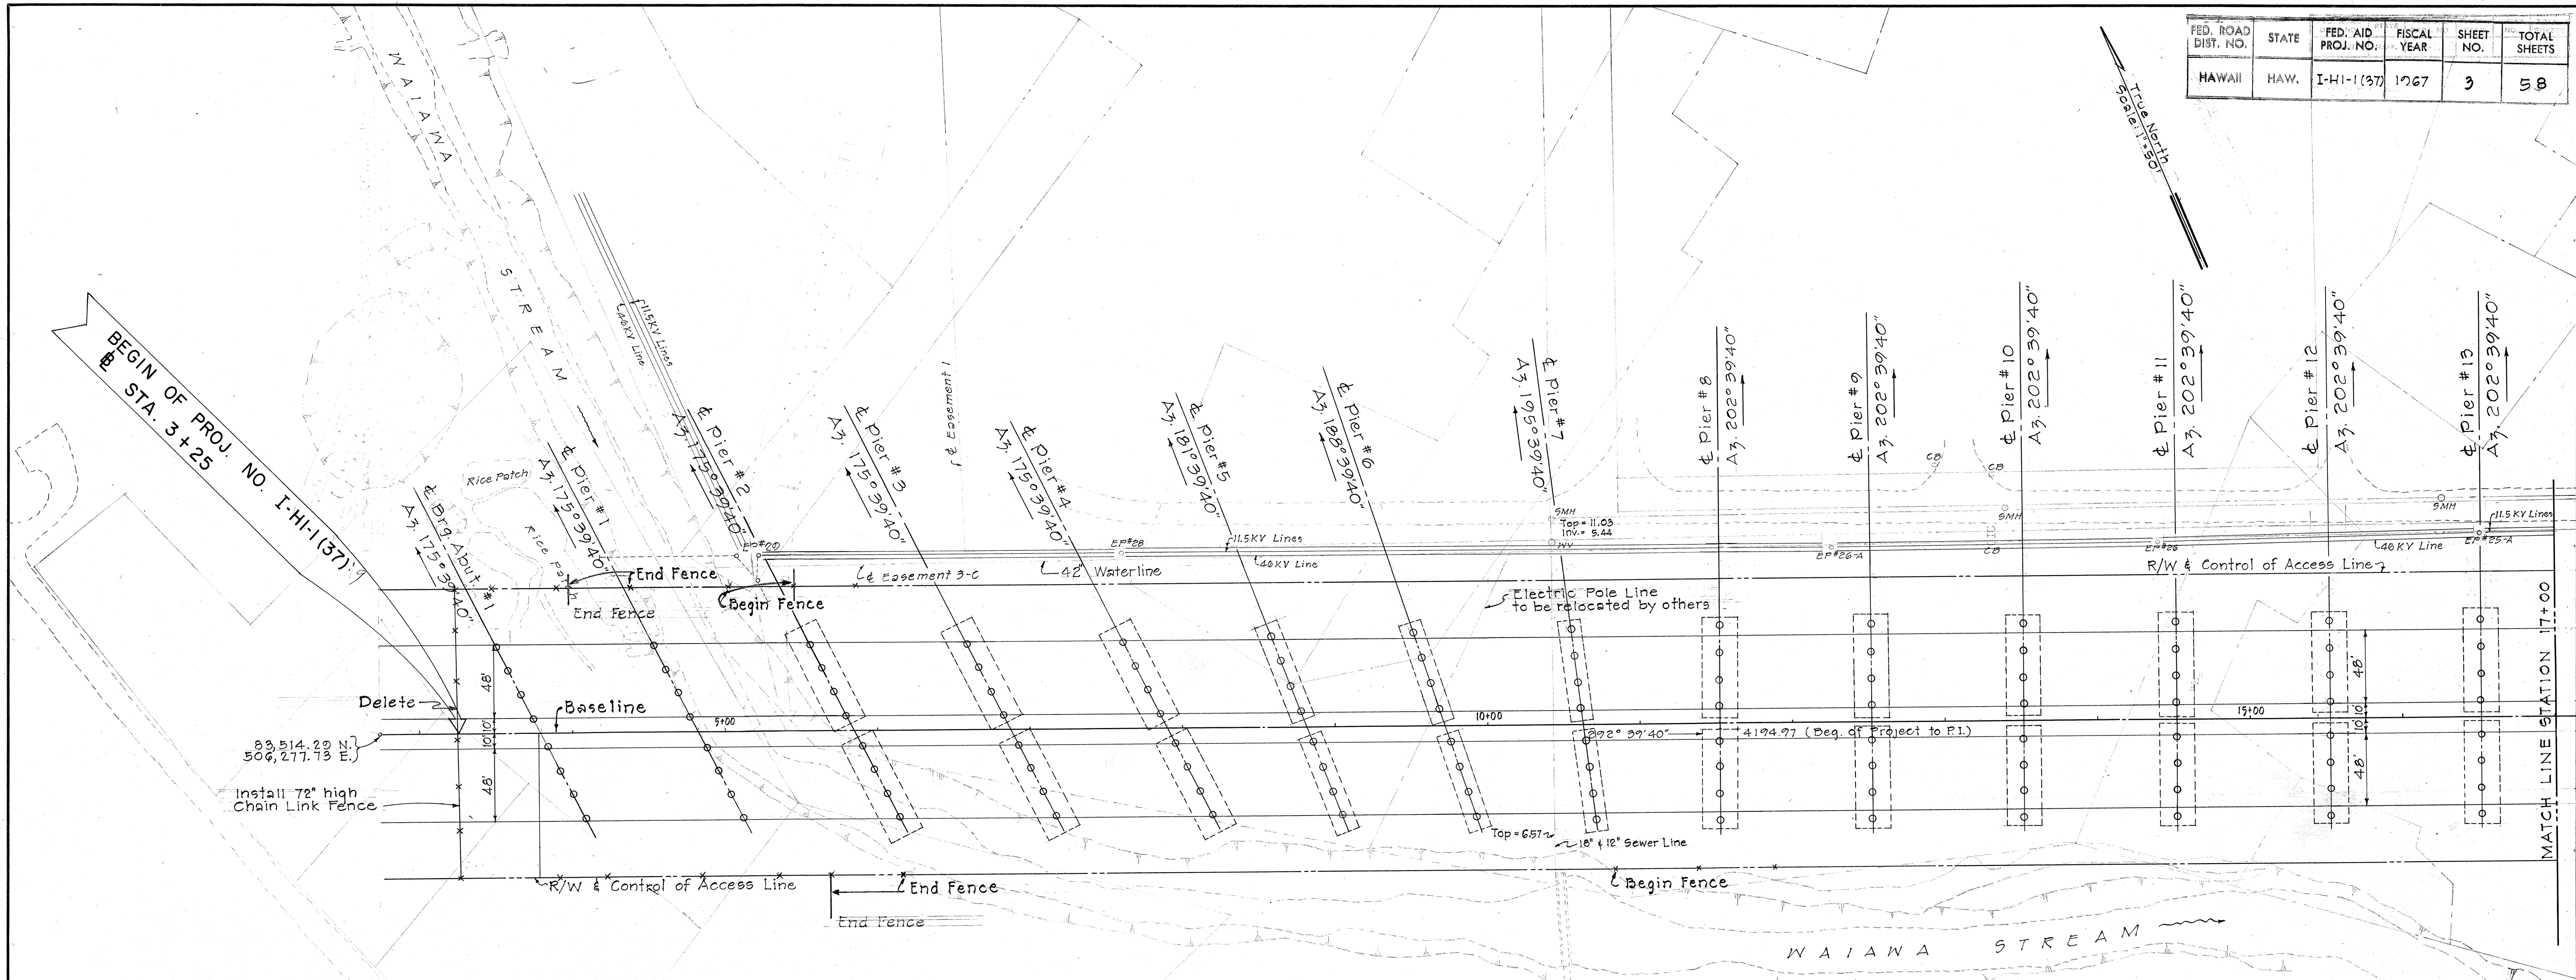

- Sta. 3+25 to Hugh Street R/W Lt.
Install Chain Link Fence 6' high
1,945 Lin. Ft.
- Hugh St. between R/W Lines
Install 6' high chain link fence 185 lin. ft.
Install 6' high 4' wide chain link gate
- Sta. 3+25 between R/W Lines
Install 6' high chain link fence 184 lin. ft.
Install 6' high 4' wide chain link gate
- Sta. 3+25 to 6+10 R/W Line Rt.
Sta. 10+80 to Hugh St. R/W Line Rt.
Install 6' high chain link fence 1,500 lin. ft.
- Sta. 18+20 and 19+20 between R/W Lines
Install 6' high chain link fence 380 lin. ft.

Note: All Electric & Telephone Pole Lines within the R/W will be relocated by the respective utility companies.

ORIGINAL PLAN	SURVEY PLOTTED BY	DATE
NOTE BOOK	DRAWN BY	
	DESIGNED BY	
	CHECKED BY	

STATE OF HAWAII
DEPARTMENT OF TRANSPORTATION
HIGHWAYS DIVISION

DETAIL PLAN OF ROADWAY

INTERSTATE ROUTE H-1
F.A.I. PROJ. NO. I-HI-1(37)


SCALE: 1" = 50'
October, 1967

SHEET No. 1 OF 2 SHEETS

FED. ROAD DIST. NO.	STATE	FED. AID PROJ. NO.	FISCAL YEAR	SHEET NO.	TOTAL SHEETS
HAWAII	HAWAII	I-HI-1(37)	1967	4	58

ORIGINAL PLAN	DATE
SURVEY PLOTTED BY	
DRAWN BY	
DESIGNED BY	
CHECKED BY	
NOTE BOOK	
No.	

DS-2-1

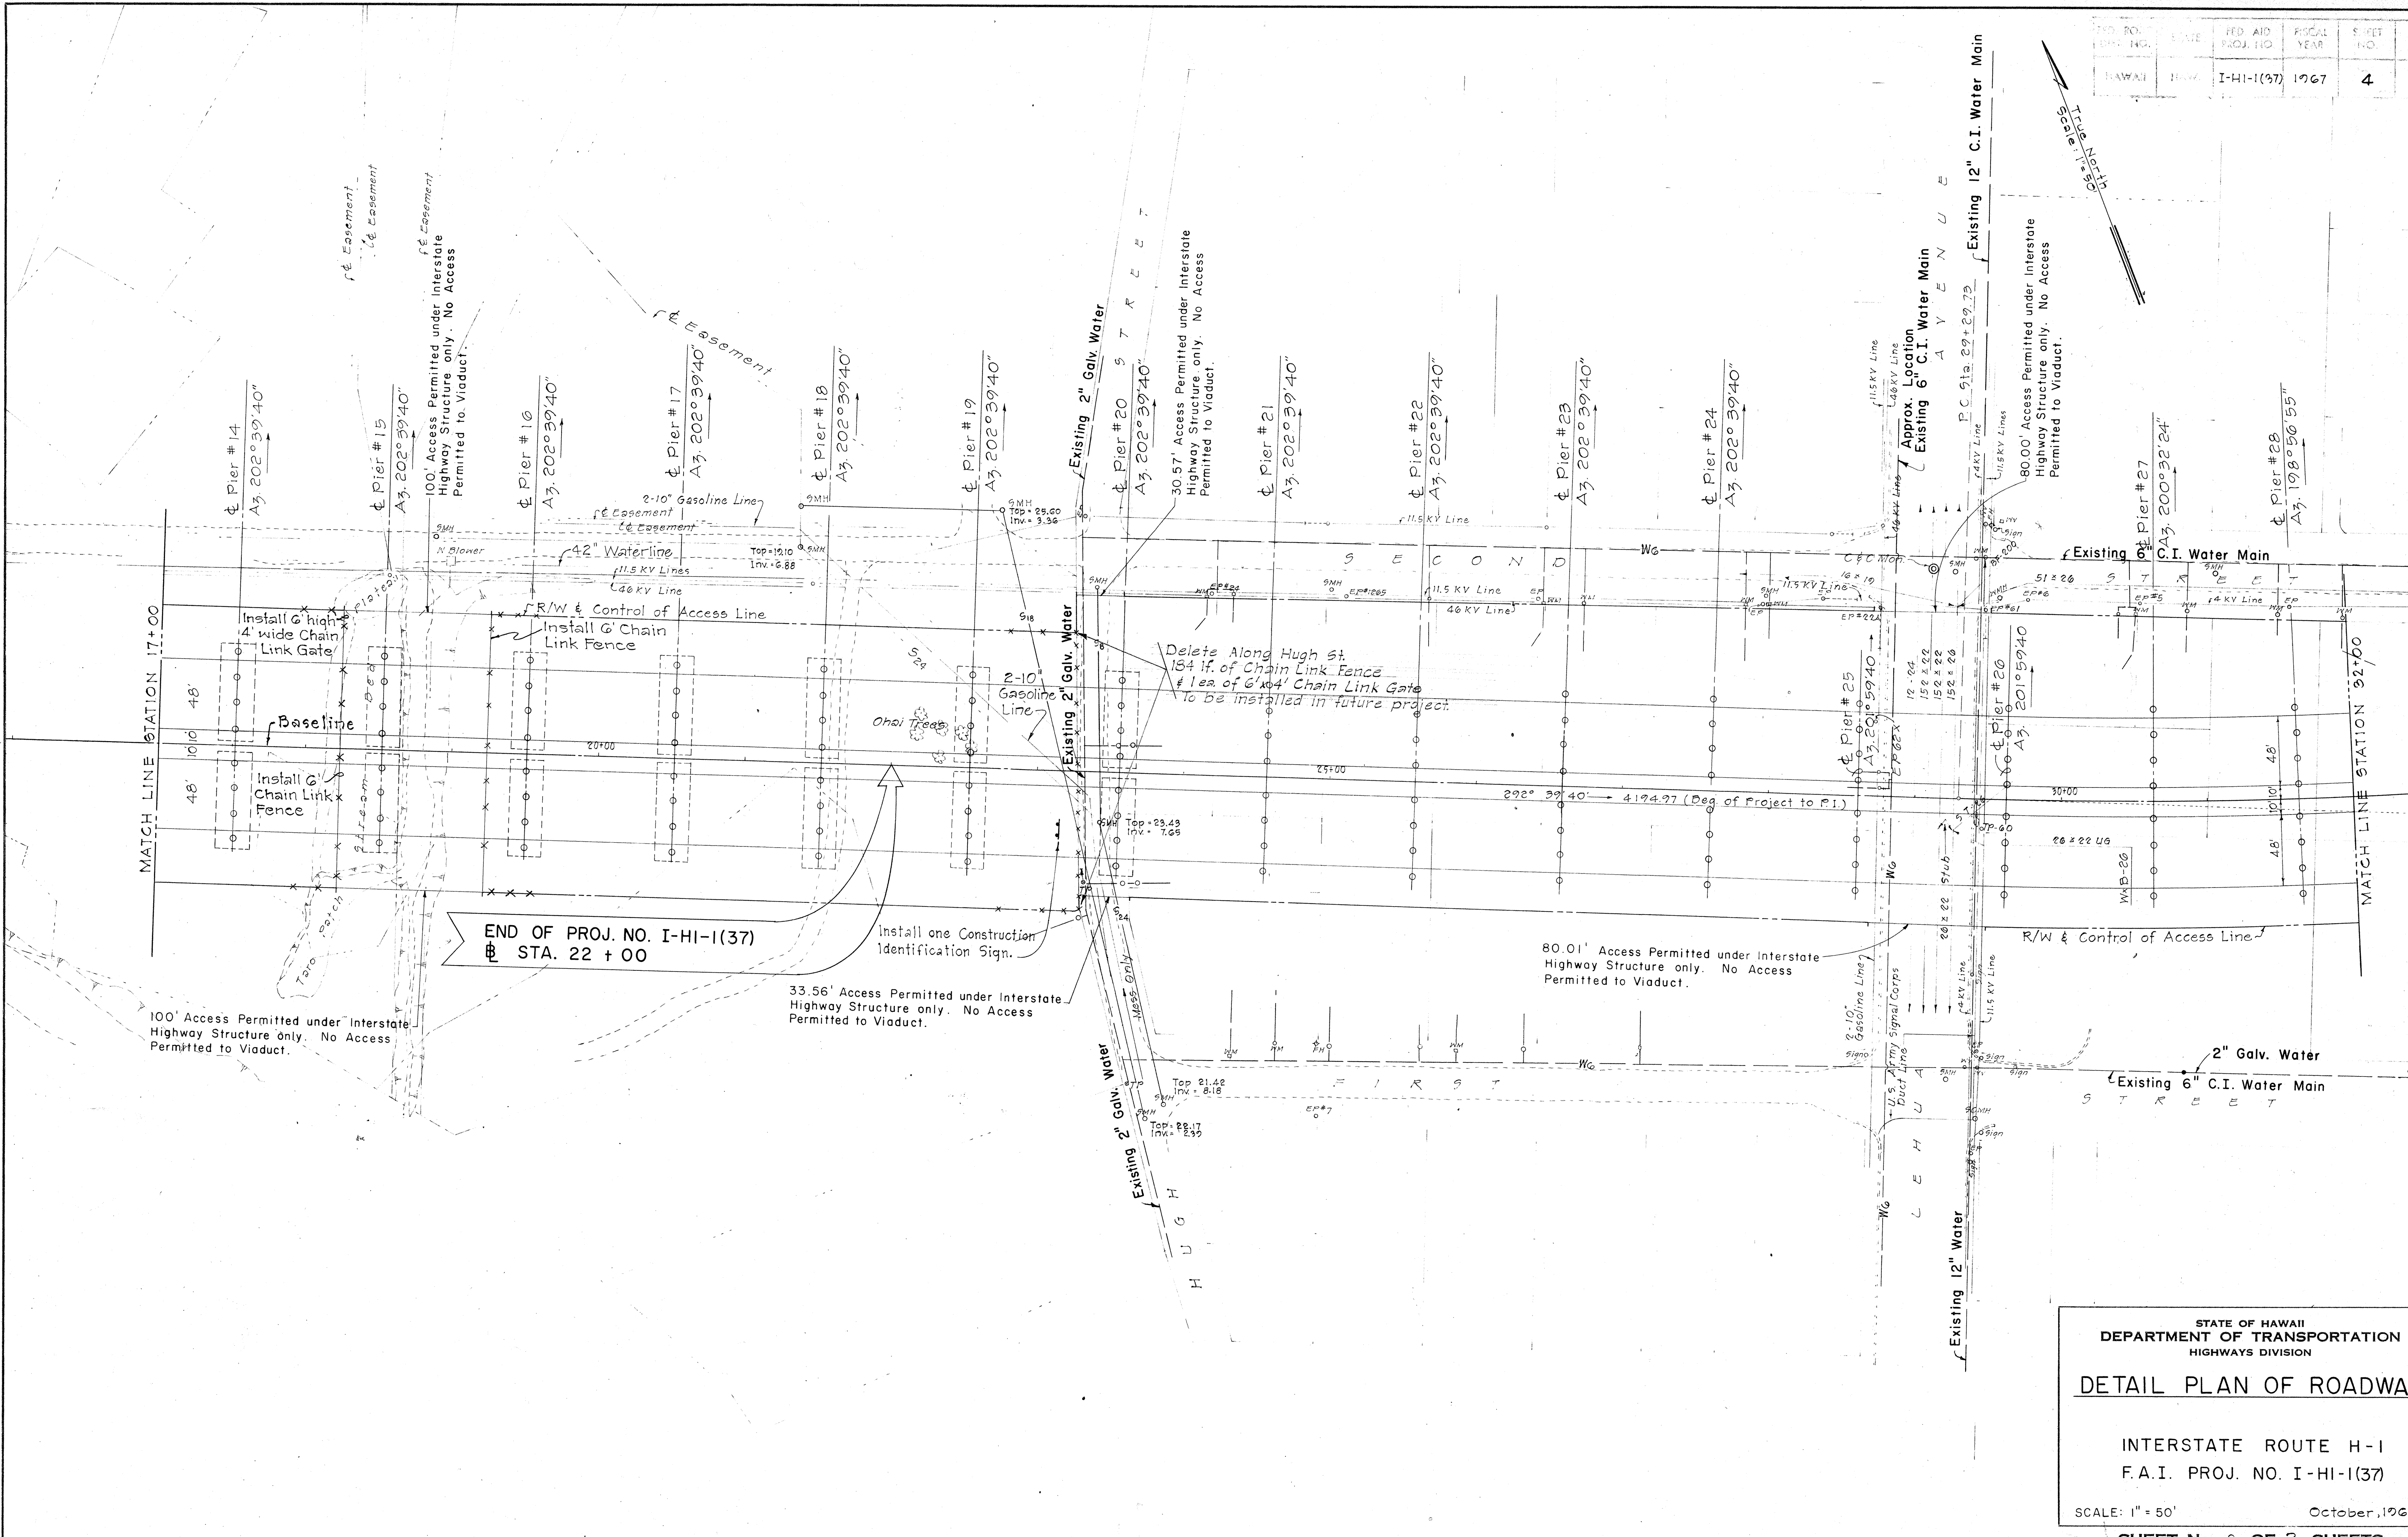

STATE OF HAWAII
DEPARTMENT OF TRANSPORTATION
HIGHWAYS DIVISION

DETAIL PLAN OF ROADWAY

INTERSTATE ROUTE H-1
F.A.I. PROJ. NO. I-HI-1(37)
SCALE: 1" = 50'
October, 1967

SHEET No. 2 OF 2 SHEETS