

INDEX TO DRAWINGS	
SHT. NO.	DESCRIPTION
1	TITLE SHEET
2	PLAN AND PROFILE
3 - 4	DETAIL PLAN OF ROADWAY
5	CHAIN LINK FENCE DETAILS
6-54	PEARL CITY VIADUCT
55-56	LIGHTING PLAN AND DETAILS
57-58	PROJECT IDENTIFICATION SIGN

STATE OF HAWAII

DEPARTMENT OF TRANSPORTATION

HIGHWAYS DIVISION

HONOLULU, HAWAII

"AS BUILT" PLANS OF

INTERSTATE ROUTE H-1

WAIAWA STREAM TO WEST OF WAI'AU INTERCHANGE

(WAIAWA STREAM TO HUGH STREET)

FEDERAL AID INTERSTATE PROJECT NO. I-HI-1(37):9

DISTRICT OF EWA

ISLAND OF OAHU



PLAN -----

1 INCH = 100 FT.

PROFILE -----

HOR. 1 INCH = 100 FT.

VER. 1 INCH = 10 FT.

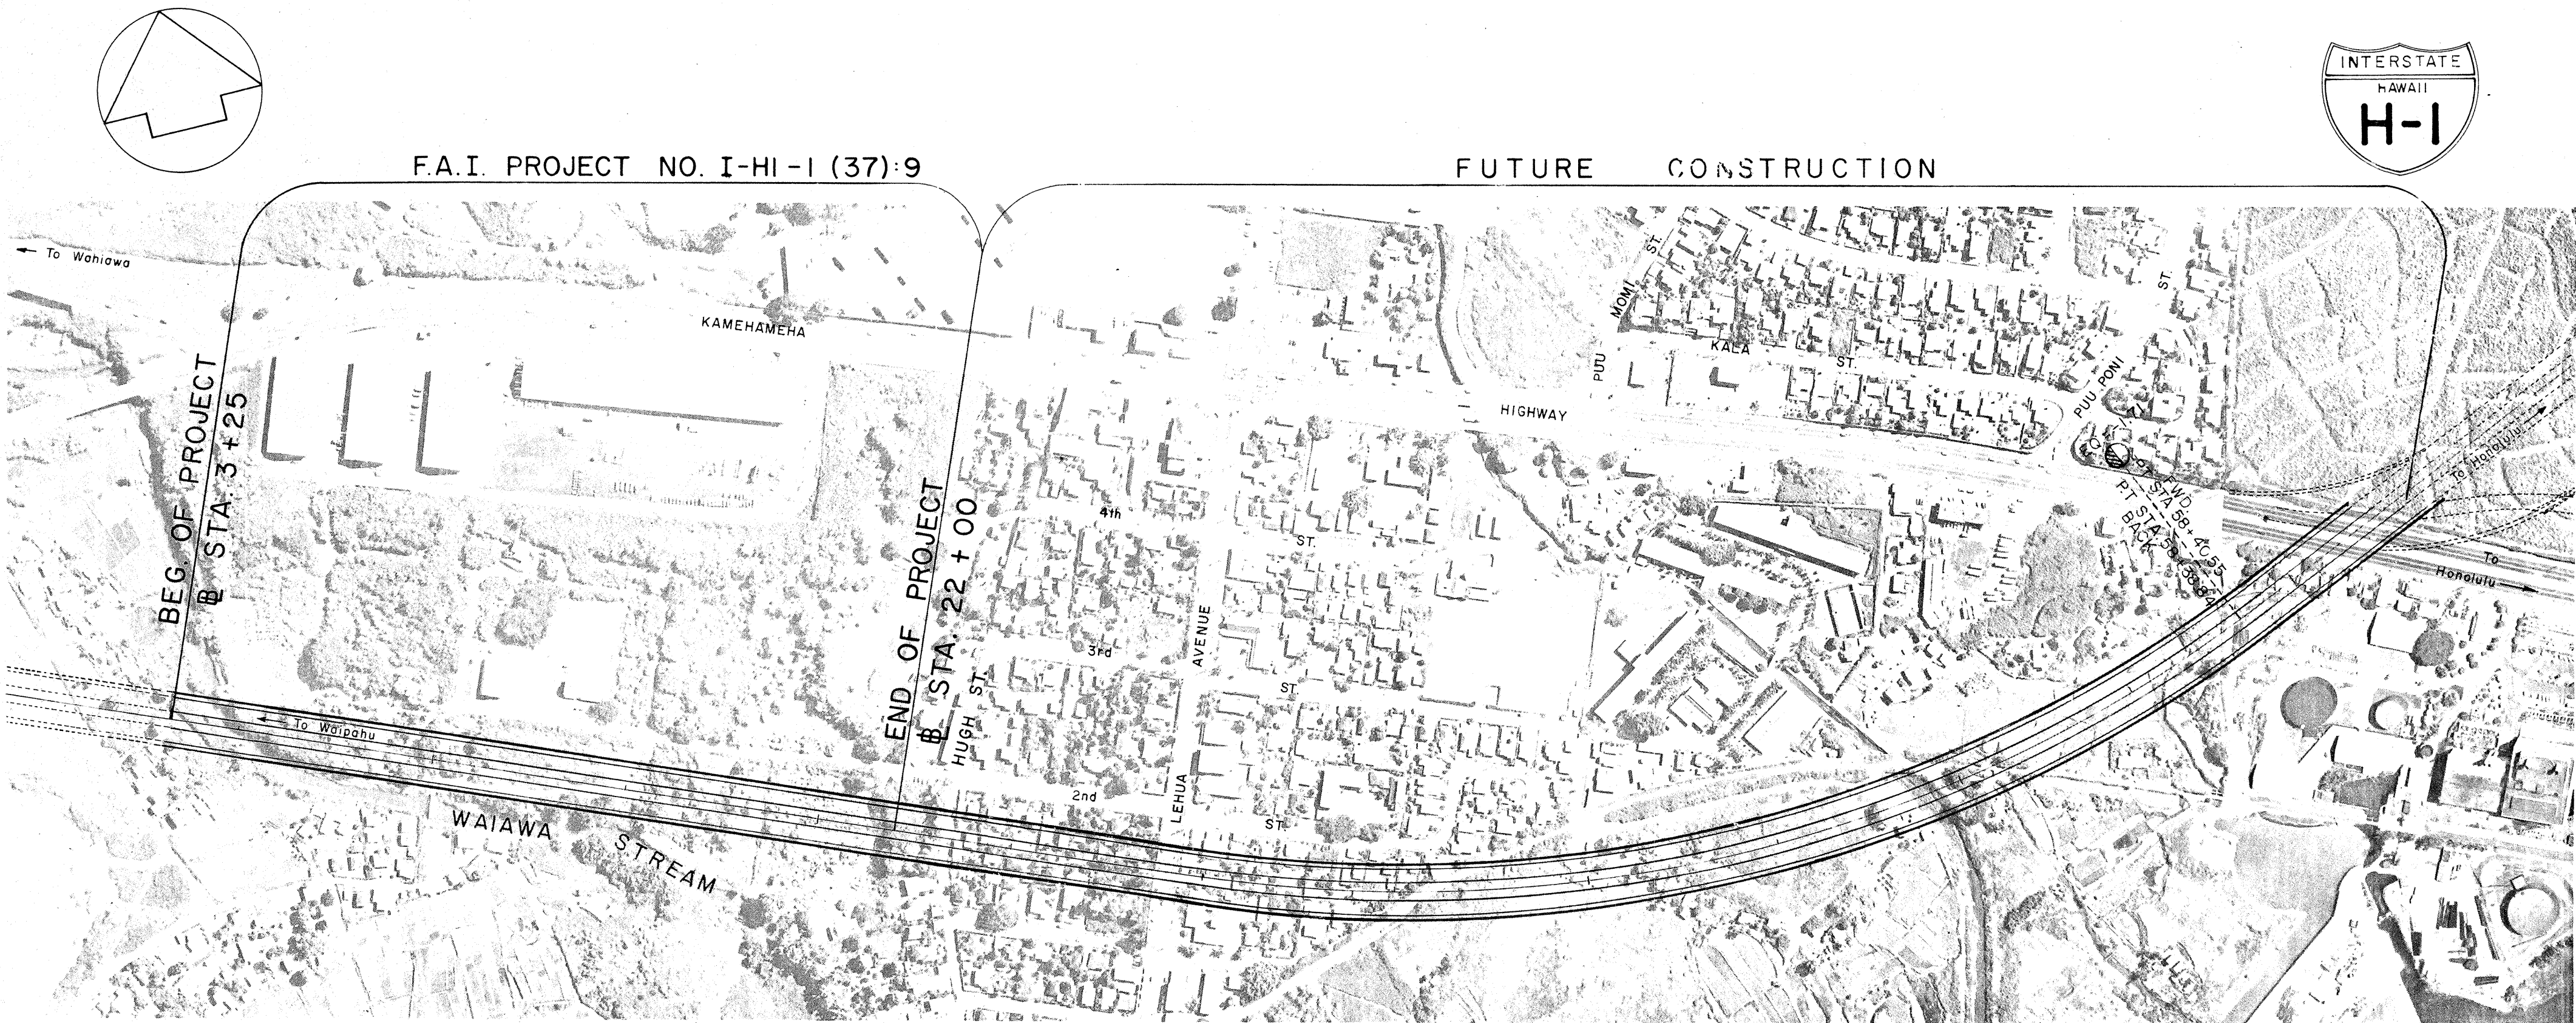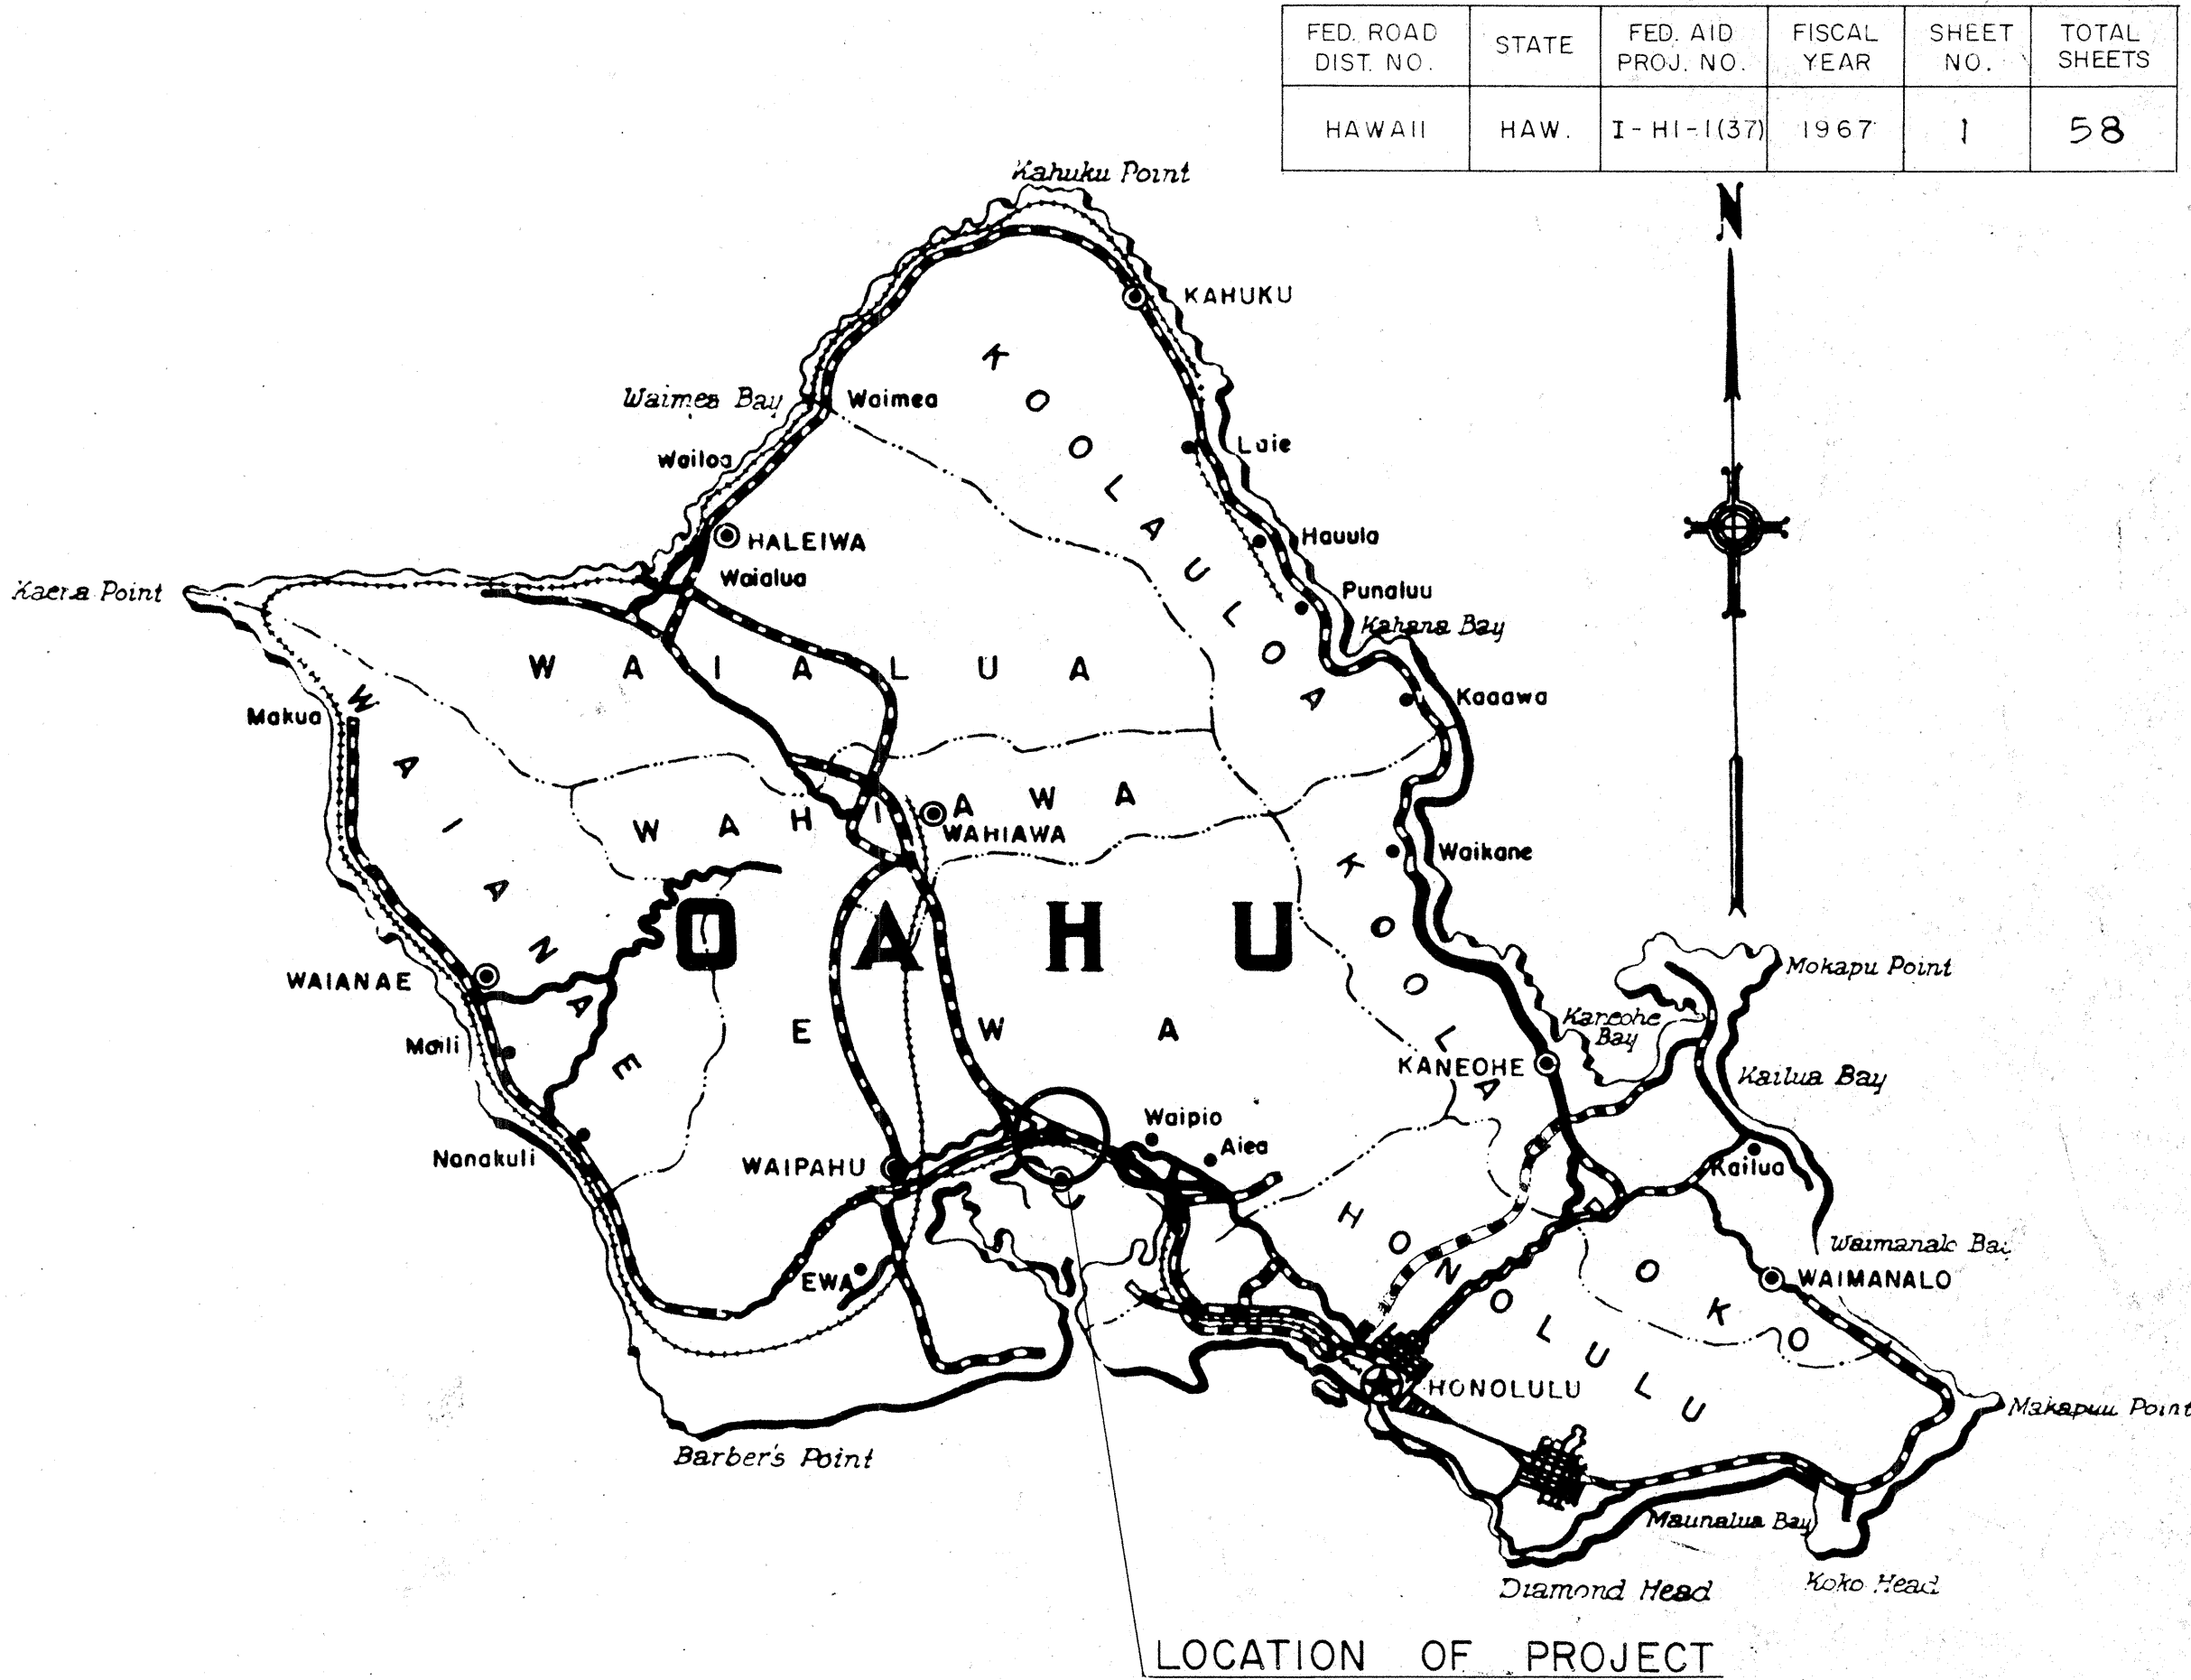

DESIGN CLASSIFICATION

ADT (1965)	0
ADT (1988)	80,900
D	65 35
DHV	10.5 %
T	4.0 %
T24	6.0 %
V	70 M.P.H.

NOTE:

ALL CHANGES MADE DURING CONSTRUCTION

HAVE BEEN NOTED IN RED ON THESE TRACINGS

AND CHECKED BY:

George J. Kato

PROJECT ENGINEER

9/21/71

DATE

APPROVED: DATE

Director of Transportation

DEPARTMENT OF TRANSPORTATION

BUREAU OF PUBLIC ROADS

APPROVED:

FOR DIVISION ENGINEER

DATE

SURVEY PLOTTED BY	DATE
PLAN	Aug 1971
NOTE BOOK	
QUANTITIES CHECKED BY	
CHECKED BY	

LENGTH OF PROJECT

= 0.355 MILE

STRUCTURE

= 0.335 MILE