


PROJECT AND SUBJECT	SPACE	FED. AID PROJ. NO.	FISCAL YEAR	SHEET NO.	TOTAL SHEETS
SEAWALL	SEAW.	I-HI-1(43)	1967	3R	43

Baseline Curve Data

$$\begin{aligned} \Delta &= 45^{\circ} 18' 00'' \\ \frac{\Delta}{2} &= 22^{\circ} 09' 00'' \\ R &= 3,600.00 \\ L &= 1,537.24 \\ C &= 2,030.61 \\ LC &= 2,902.11 \end{aligned}$$

Note: All Electric Pole Lines in the way of the Structure will be relocated by Hawaiian Electric Co., Ltd.

True North
Scale 1"=50'

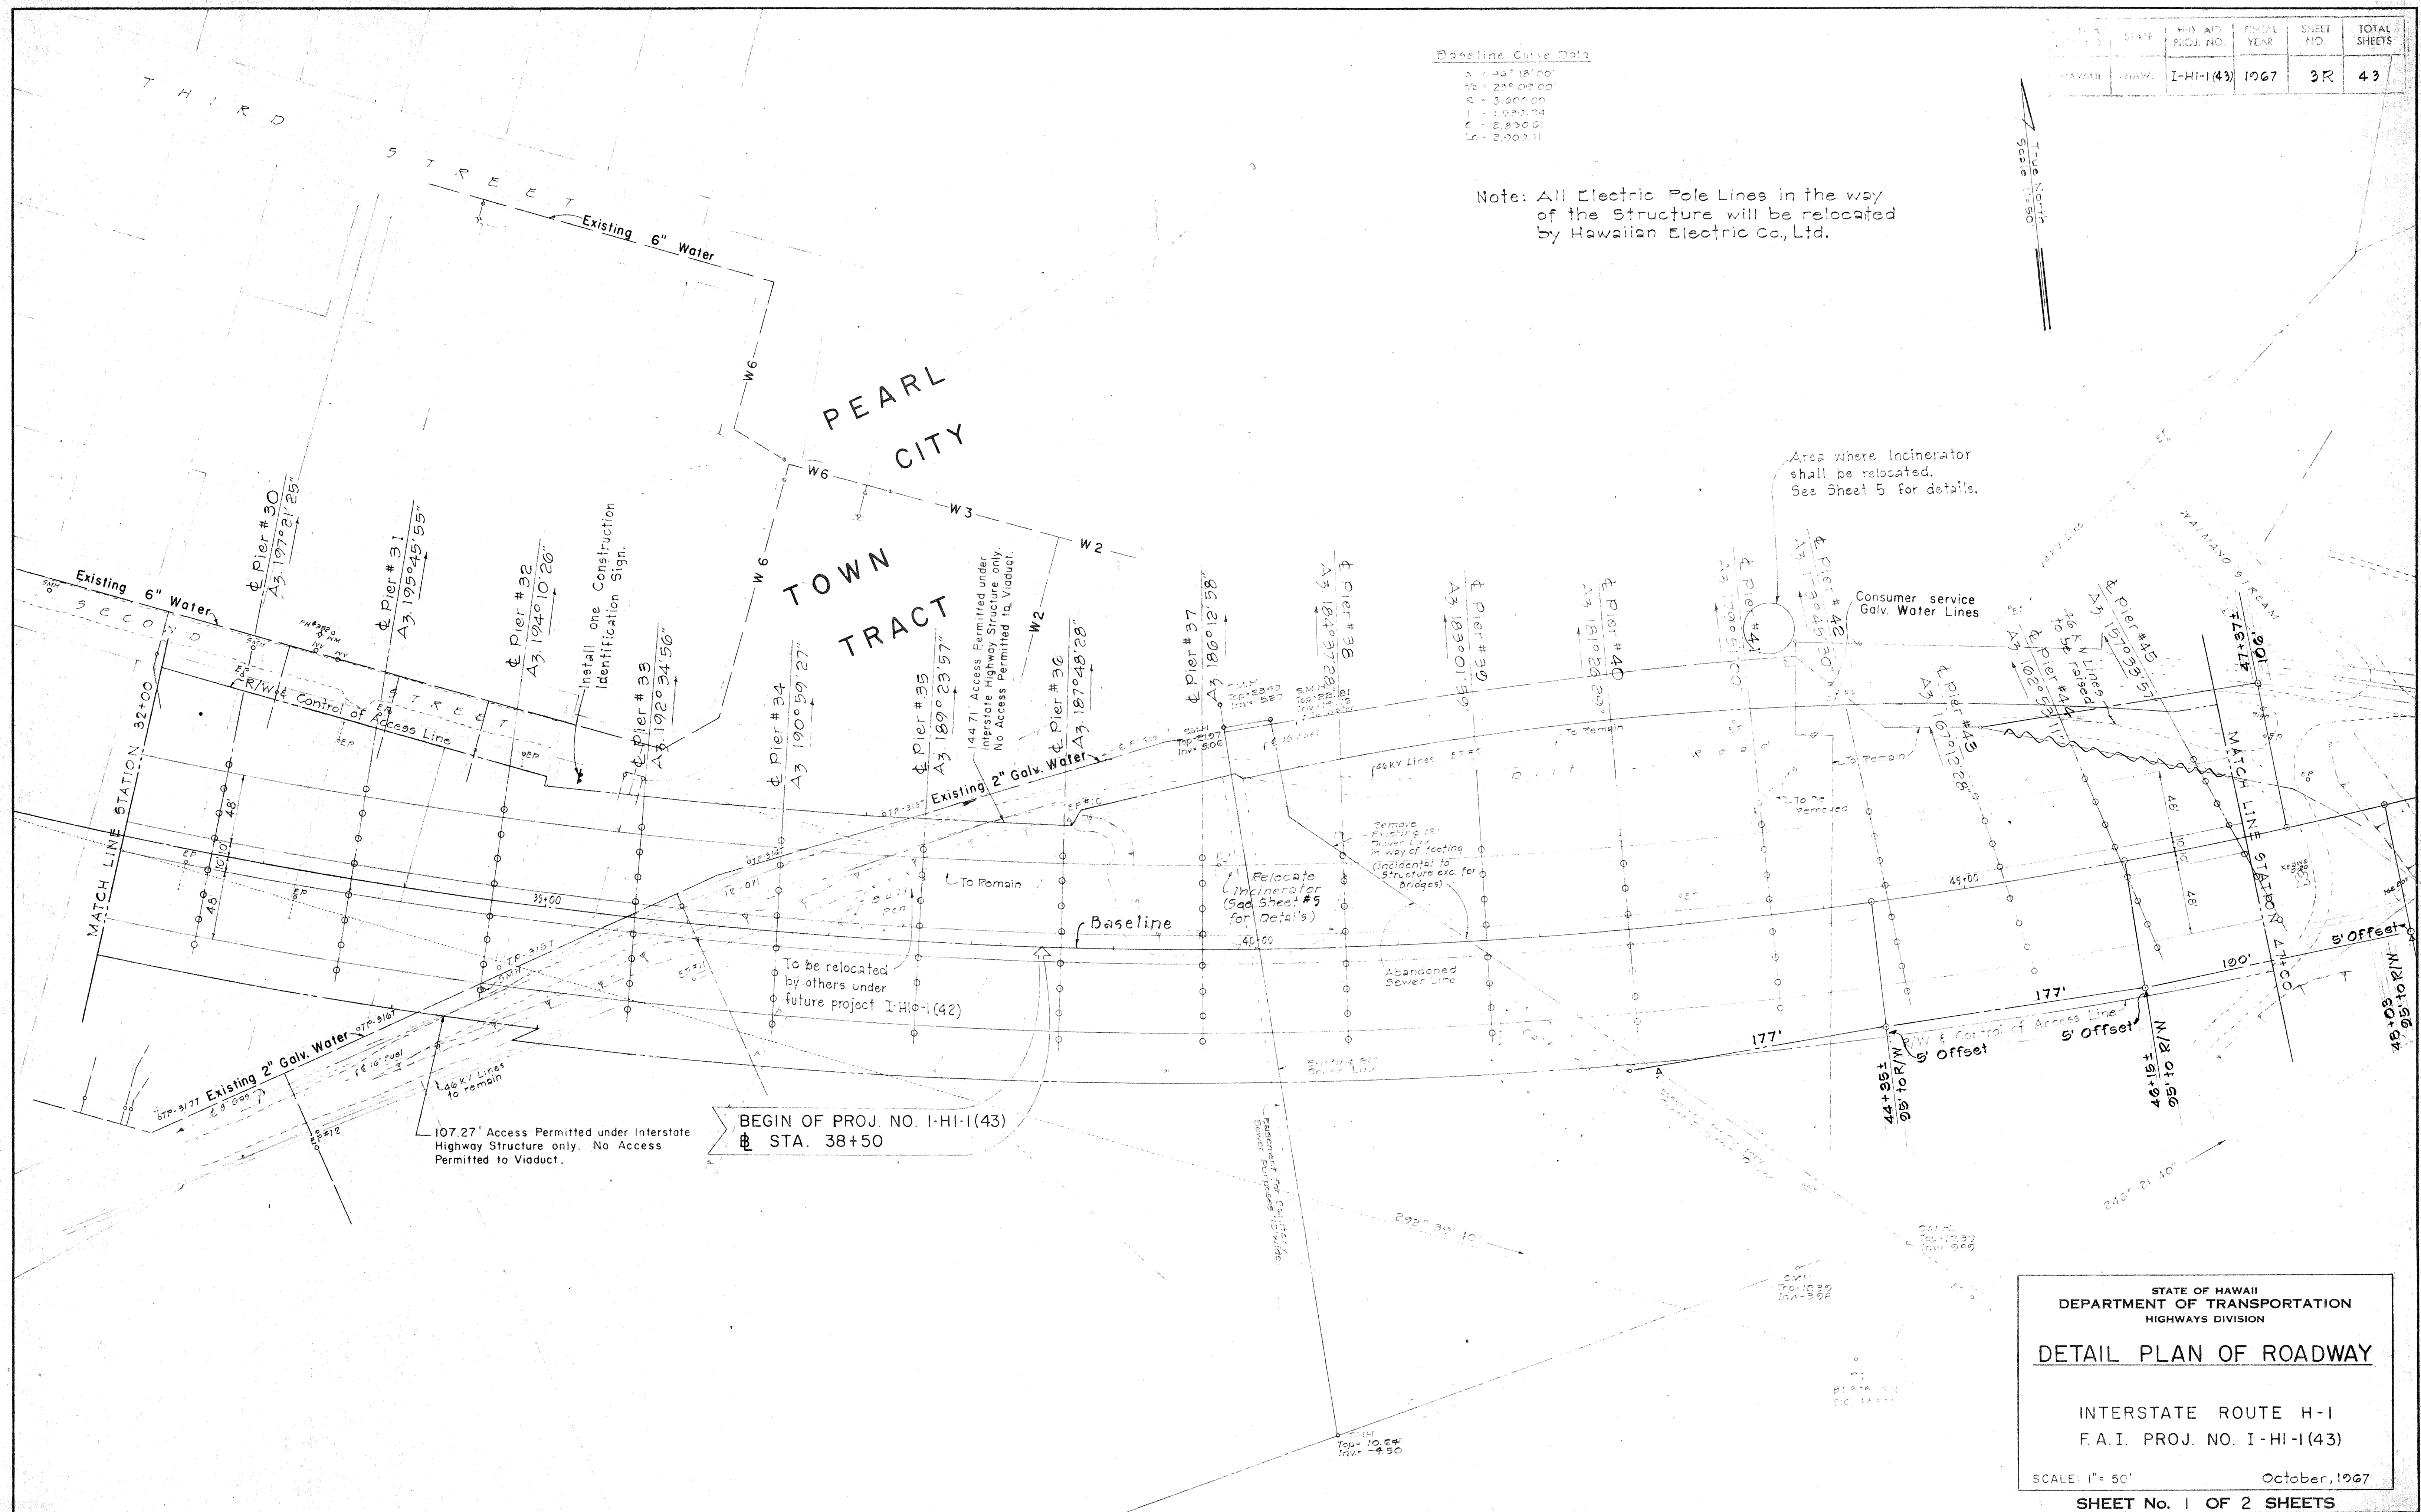

STATE OF HAWAII
DEPARTMENT OF TRANSPORTATION
HIGHWAYS DIVISION

DETAIL PLAN OF ROADWAY

INTERSTATE ROUTE H-1
F.A.I. PROJ. NO. I-HI-1(43)

SCALE: 1" = 50'



October, 1967

SHEET No. 1 OF 2 SHEETS

March 4, 1968

3 IR

STATE	FED. AID PROJ. NO.	FISCAL YEAR	SHEET NO.	TOTAL SHEETS
HAWAII	I-HI-1(43)	1967	42	43

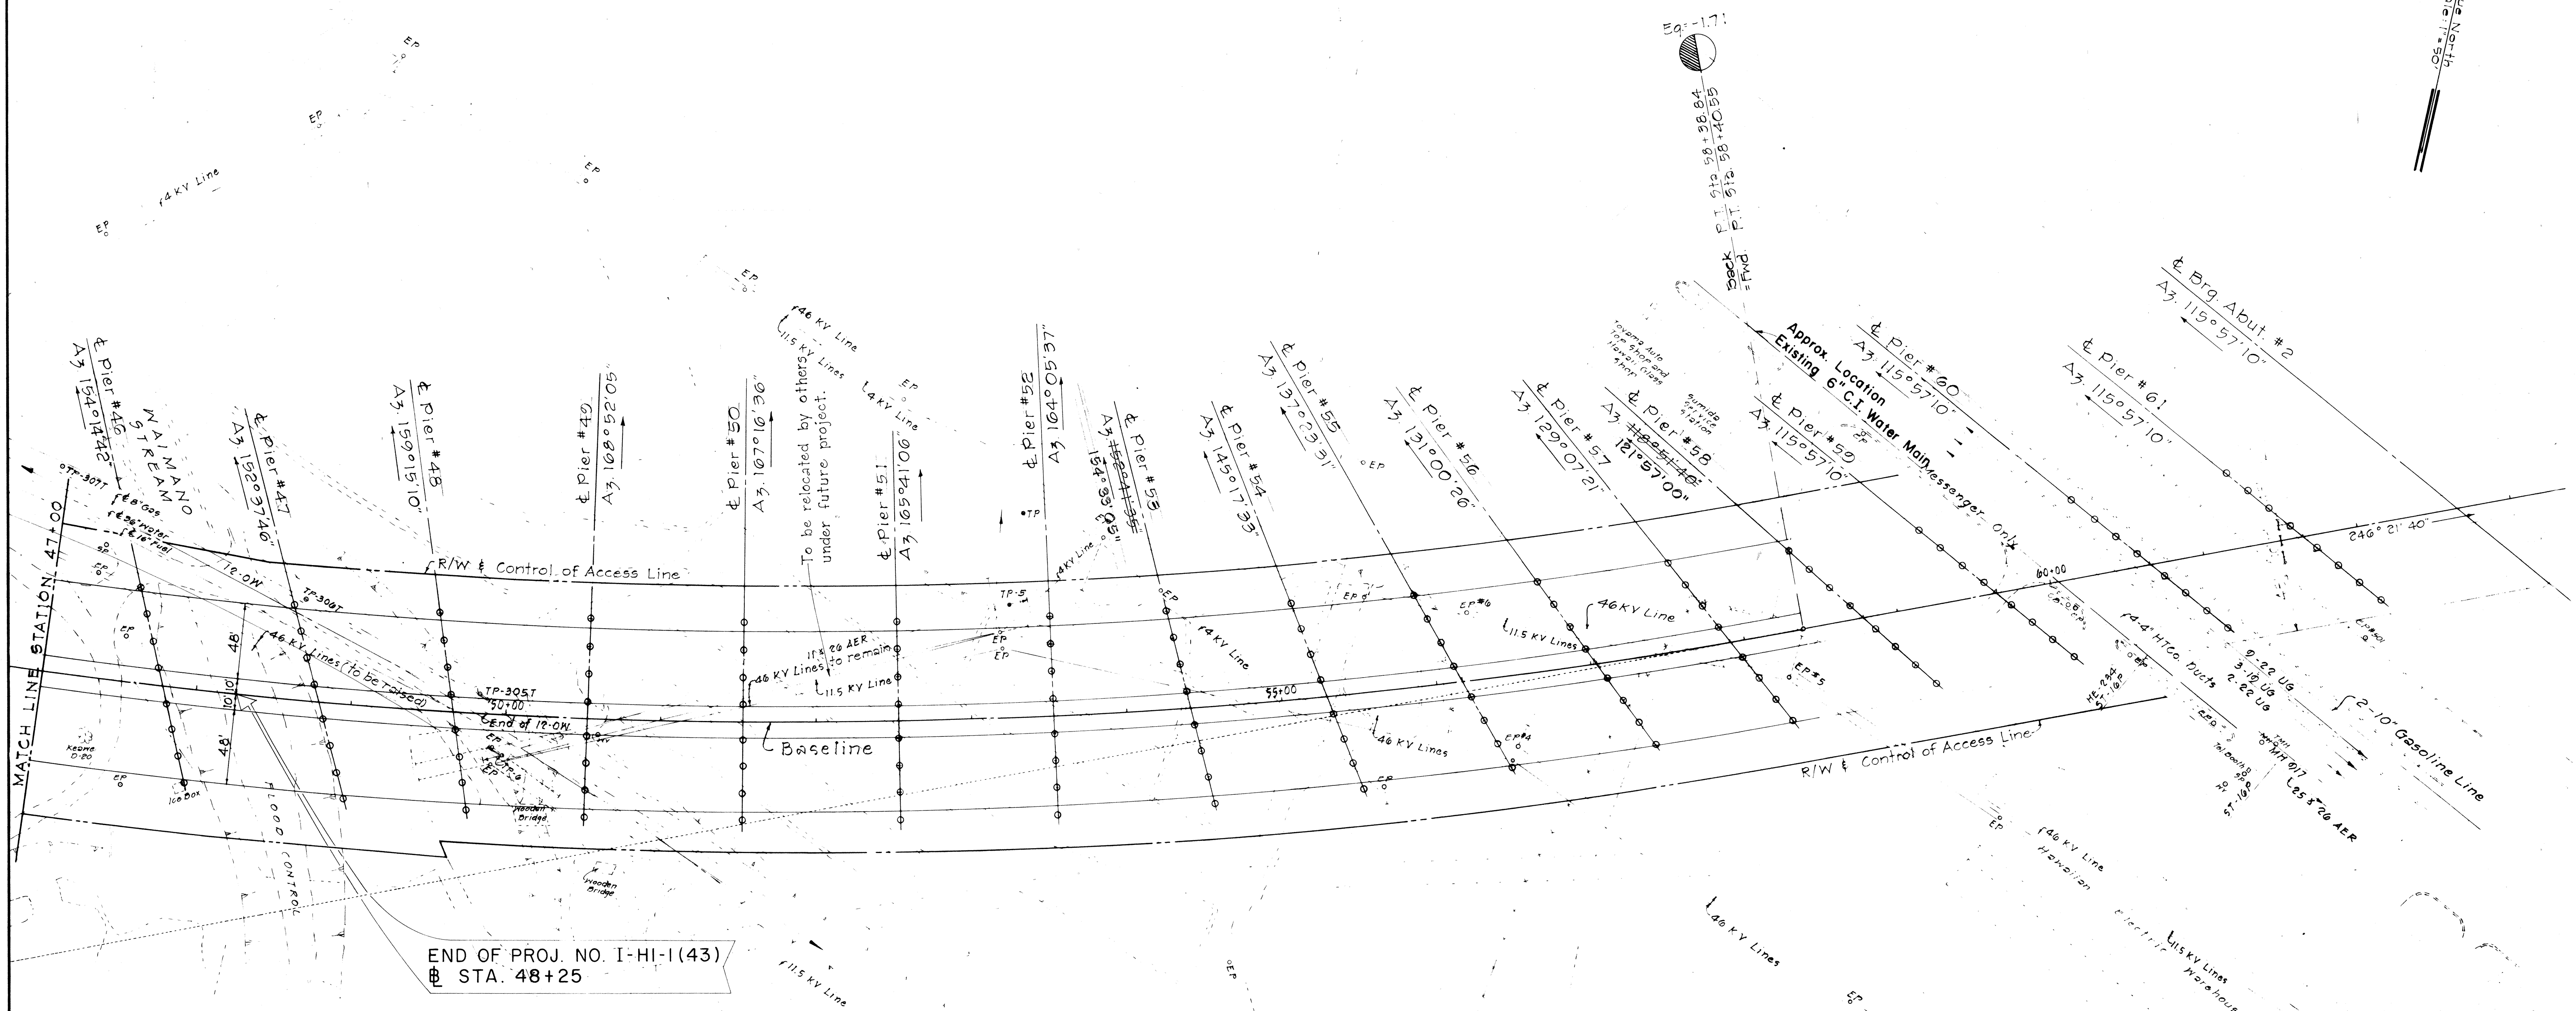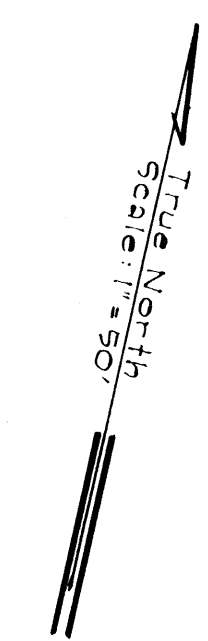

END OF PROJ. NO. I-HI-1(43)
 STA. 48+25

DATE	
DESIGNED BY	
TRACED BY	
NOTED BY	
CHECKED BY	

STATE OF HAWAII
DEPARTMENT OF TRANSPORTATION
HIGHWAYS DIVISION

DETAIL PLAN OF ROADWAY

INTERSTATE ROUTE H-1
F.A.I. PROJ. NO. I-HI-1(43)

SCALE: 1" = 50'
October, 1967

SHEET No. 2 OF 2 SHEETS

March 4, 1968

41 RR