



FED. ROAD DIST. NO.	STATE	FED. AID PROJ. NO.	FISCAL YEAR	SHEET NO.	TOTAL SHEETS
HAWAII	HAW.	I-HI-1(43)	1967	5R	43

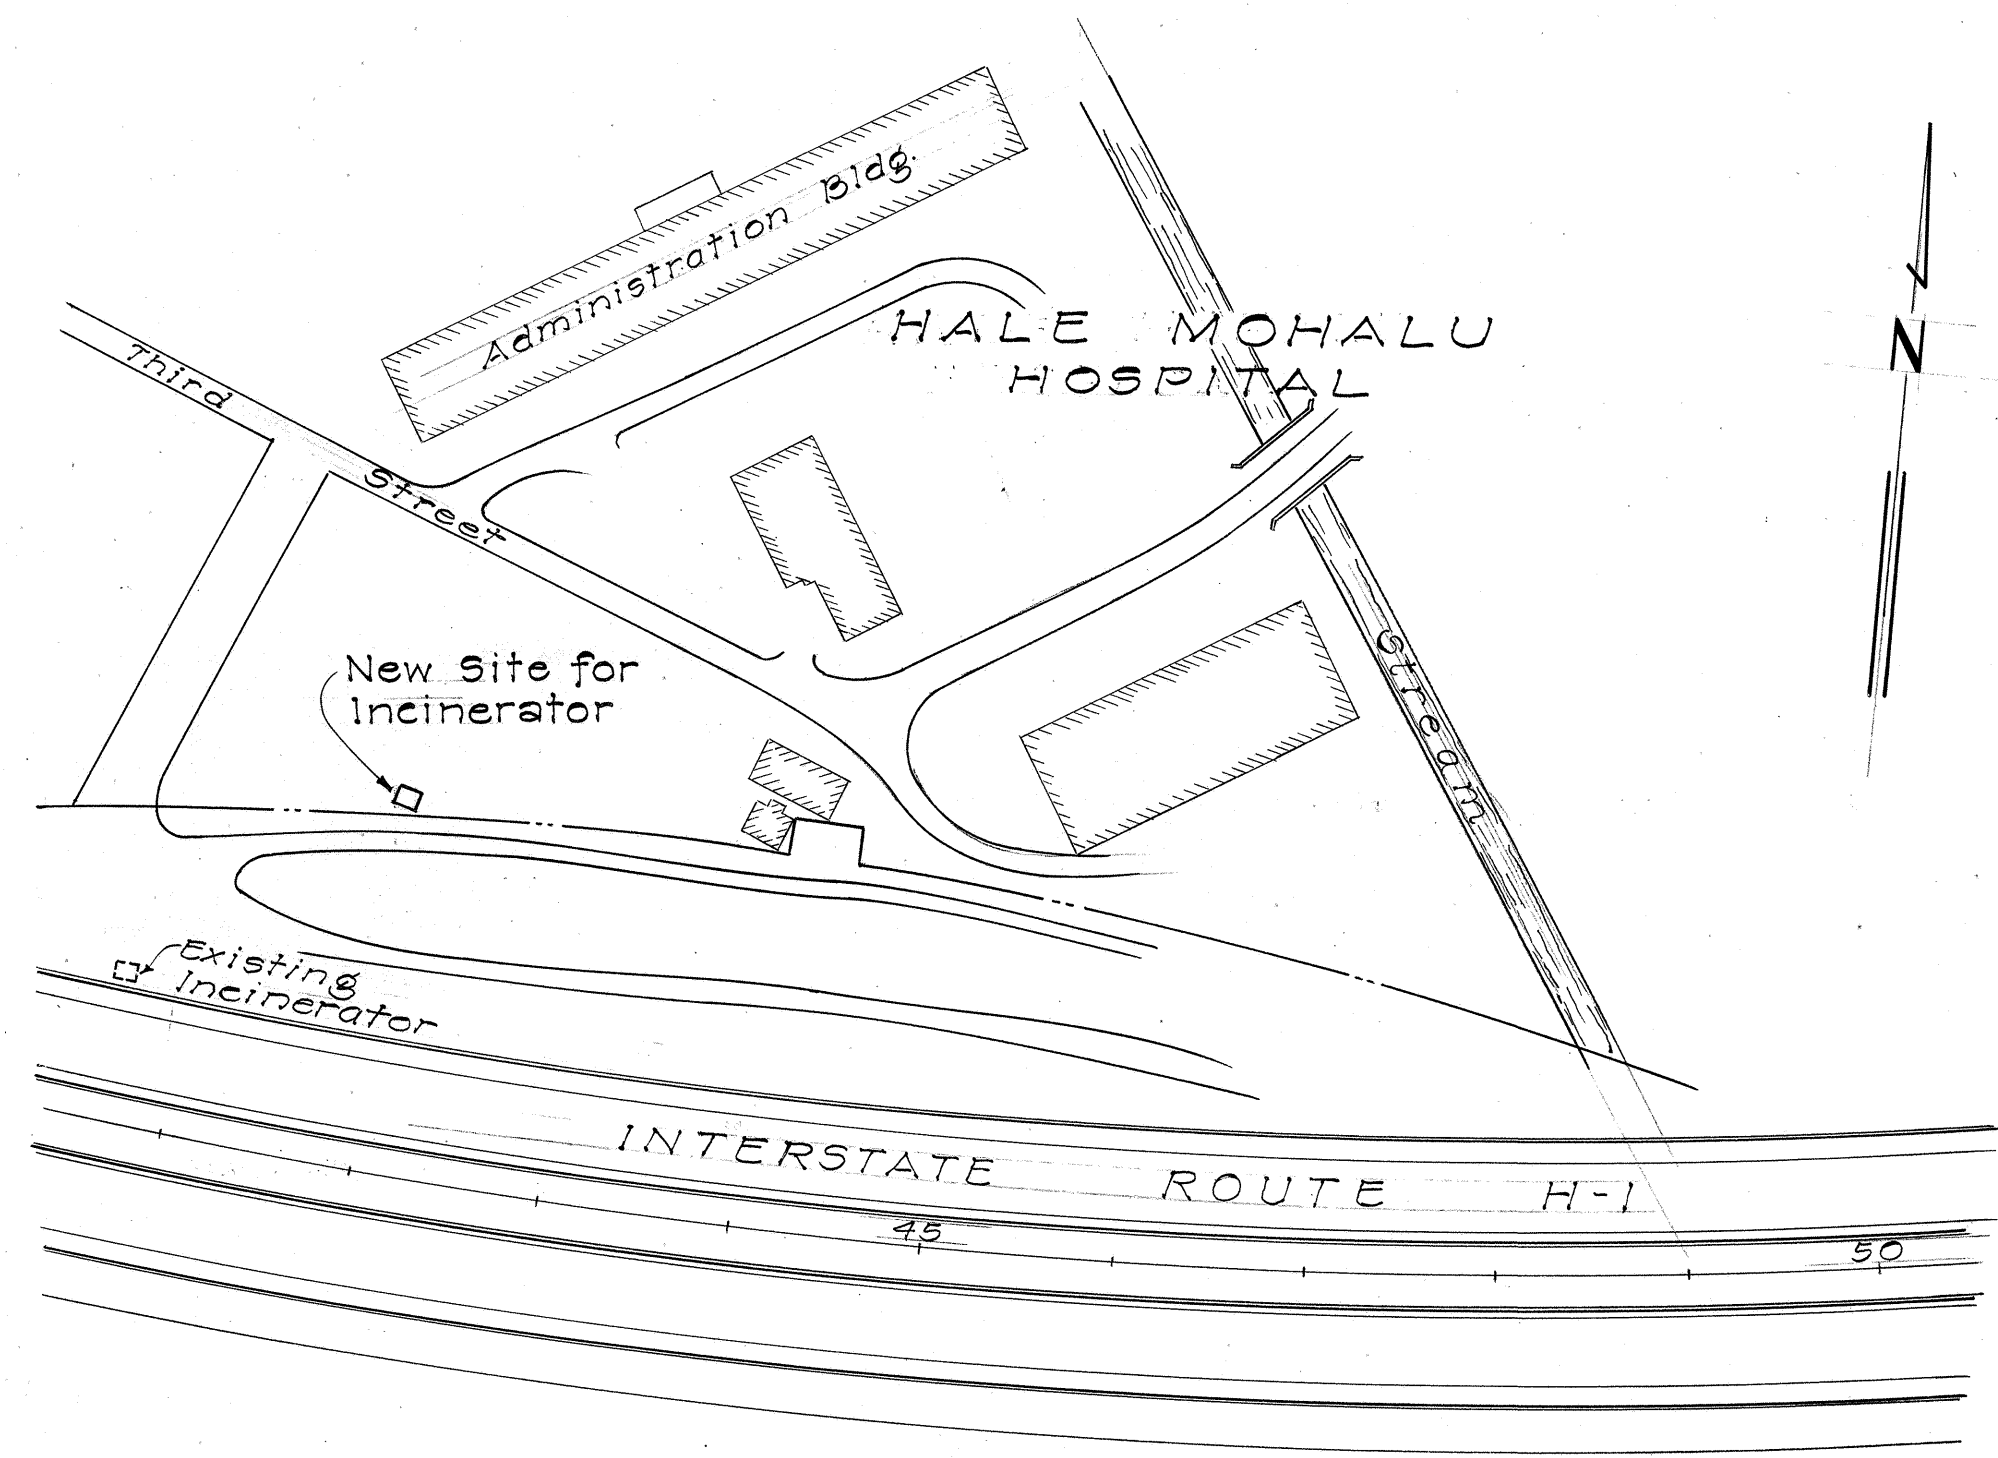


LAYOUT PLAN
Scale: 1" = 100'

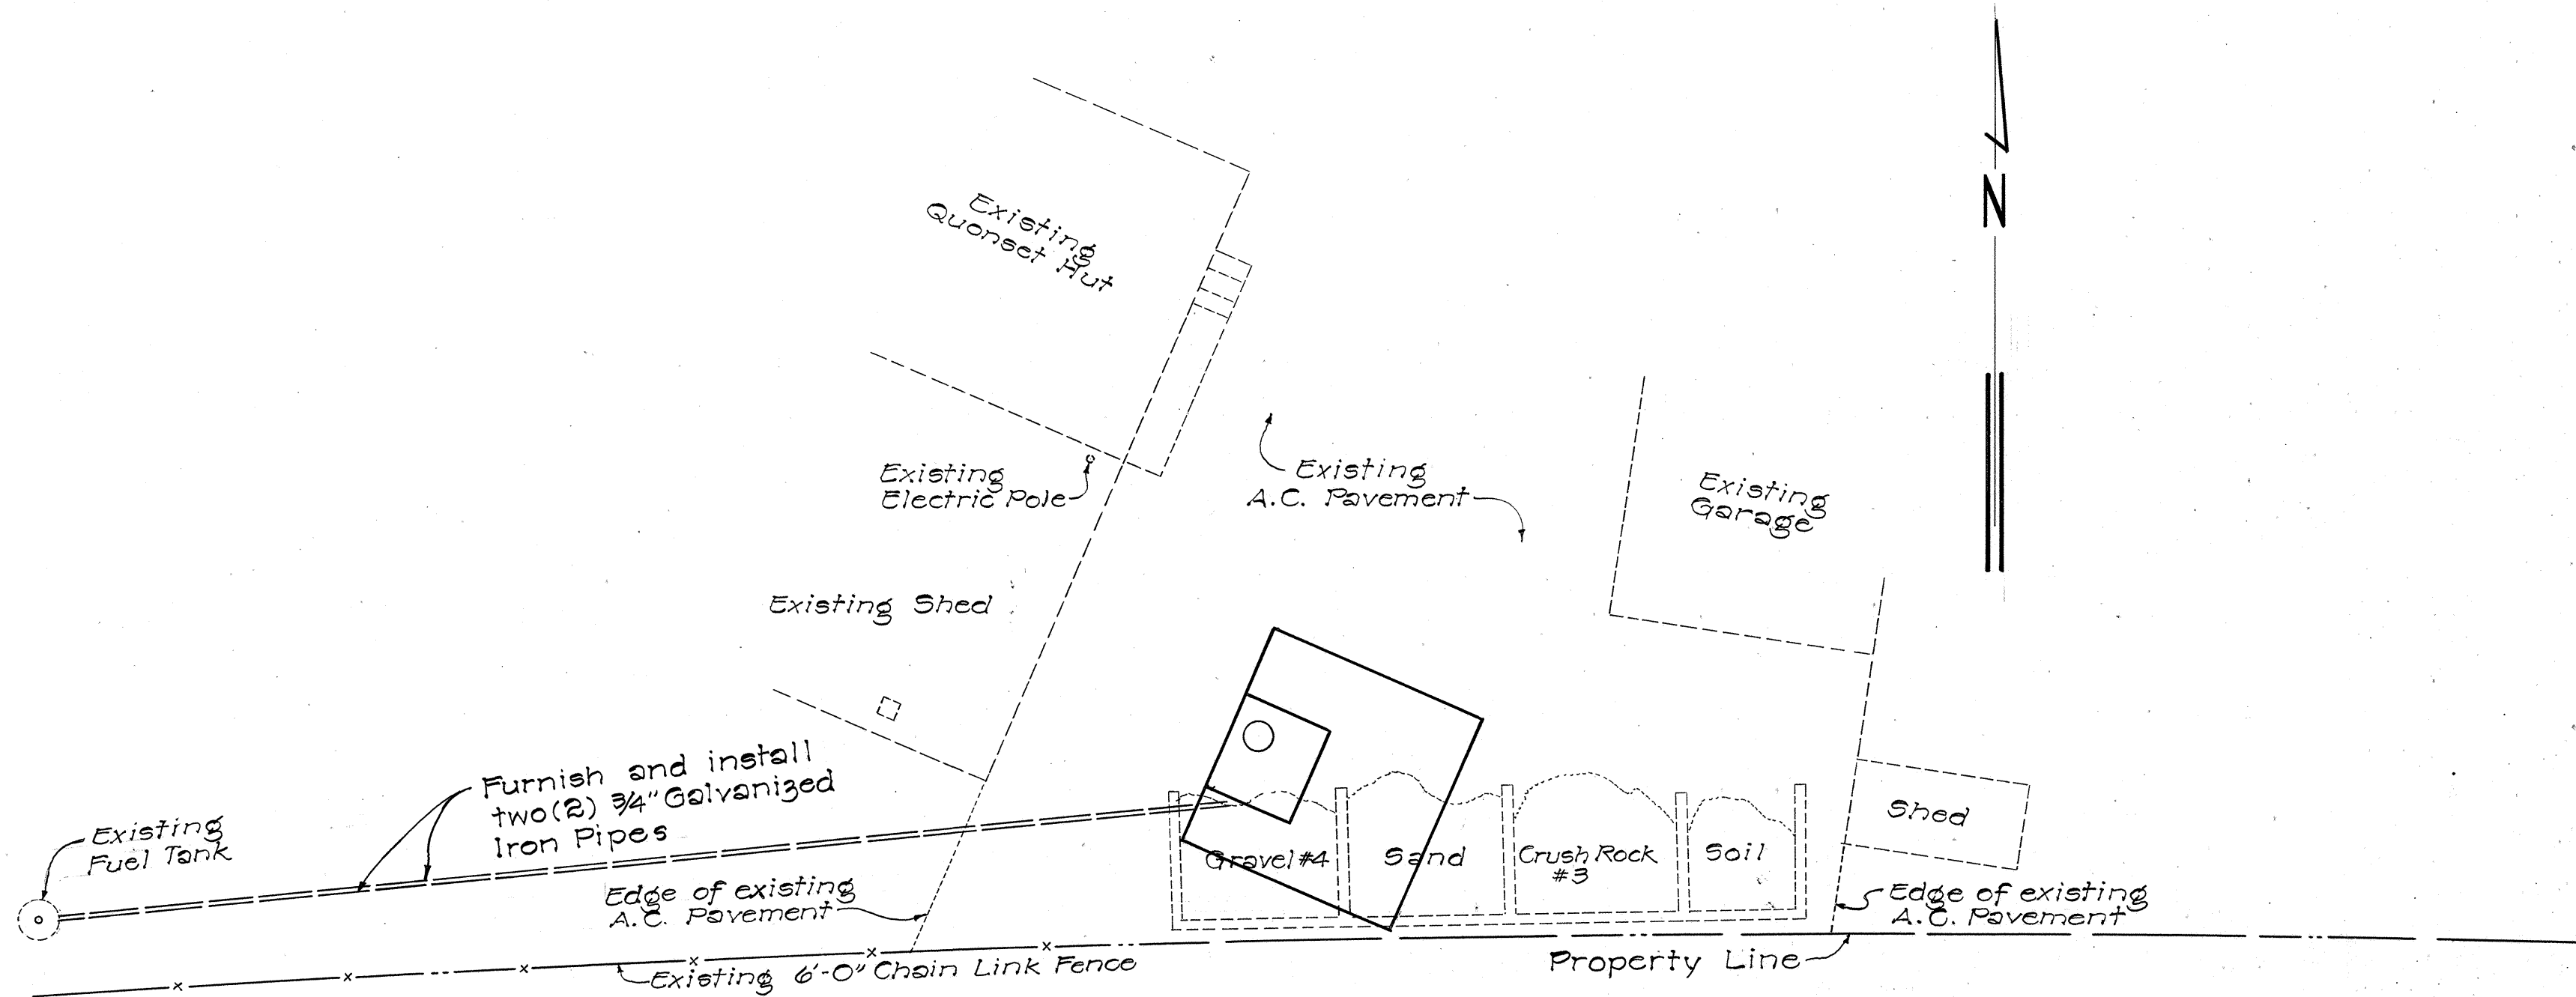

PLOT PLAN
Scale: 1" = 10'

- SCOPE OF WORK
1. Construct 10' x 10' Concrete Base.
 2. Relocate Incinerator complete in place.
 3. Install all service lines necessary for the operation of the incinerator.
 4. Remove existing Hollow Tile walls for bins containing Gravel #4 and Crush Rock #3.

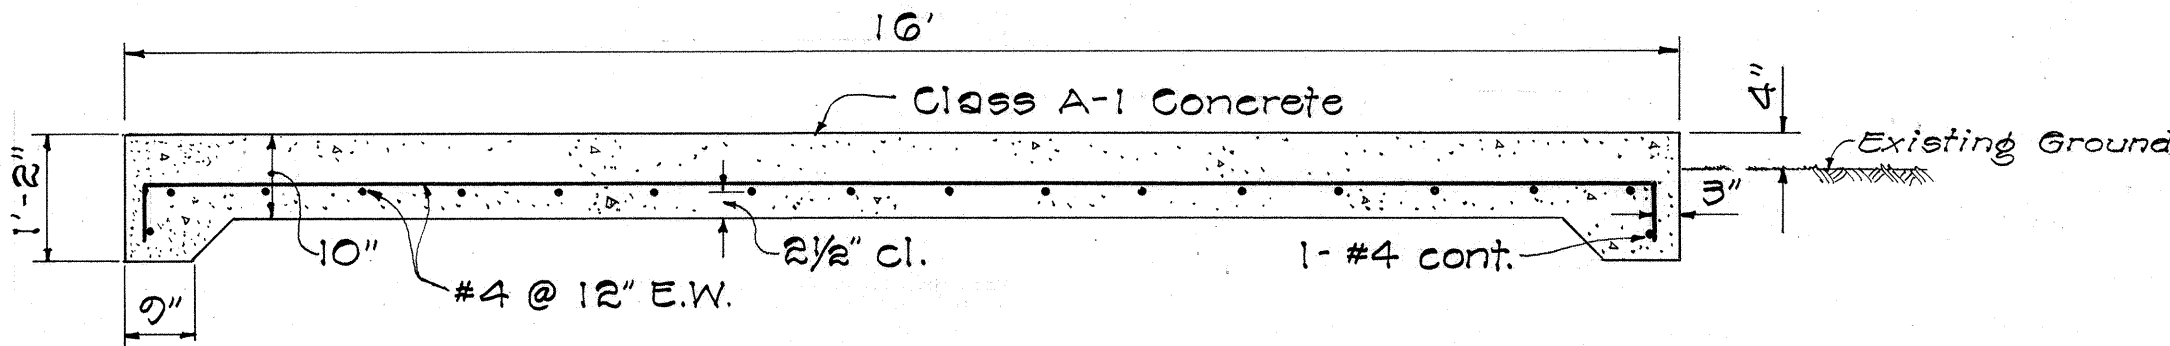

TYPICAL SECTION
INCINERATOR BASE
Scale: 1/2" = 1'-0"

STATE OF HAWAII
DEPARTMENT OF TRANSPORTATION
HIGHWAYS DIVISION

RELOCATION OF INCINERATOR
FOR HALE MOHALU HOSPITAL

INTERSTATE ROUTE H-1
F.A.I. PROJ. NO. I-HI-1(43)

Scale: As Noted

Oct. 1967

SHEET No. 1 OF 1 SHEETS

DESIGNED BY	DATE
NOTED BY	
CHECKED BY	
QUANTITIES BY	
DESIGNED BY	
NOTED BY	
CHECKED BY	
QUANTITIES BY	
DESIGNED BY	
NOTED BY	
CHECKED BY	
QUANTITIES BY	