


FED. ROAD DIST. NO.	STATE	FED. AID PROJ. NO.	FISCAL YEAR	SHEET NO.	TOTAL SHEETS
HAWAII	HAW.	I-41(32):5 Unit 4	1967	18	101

REVISED: Feb. 1968

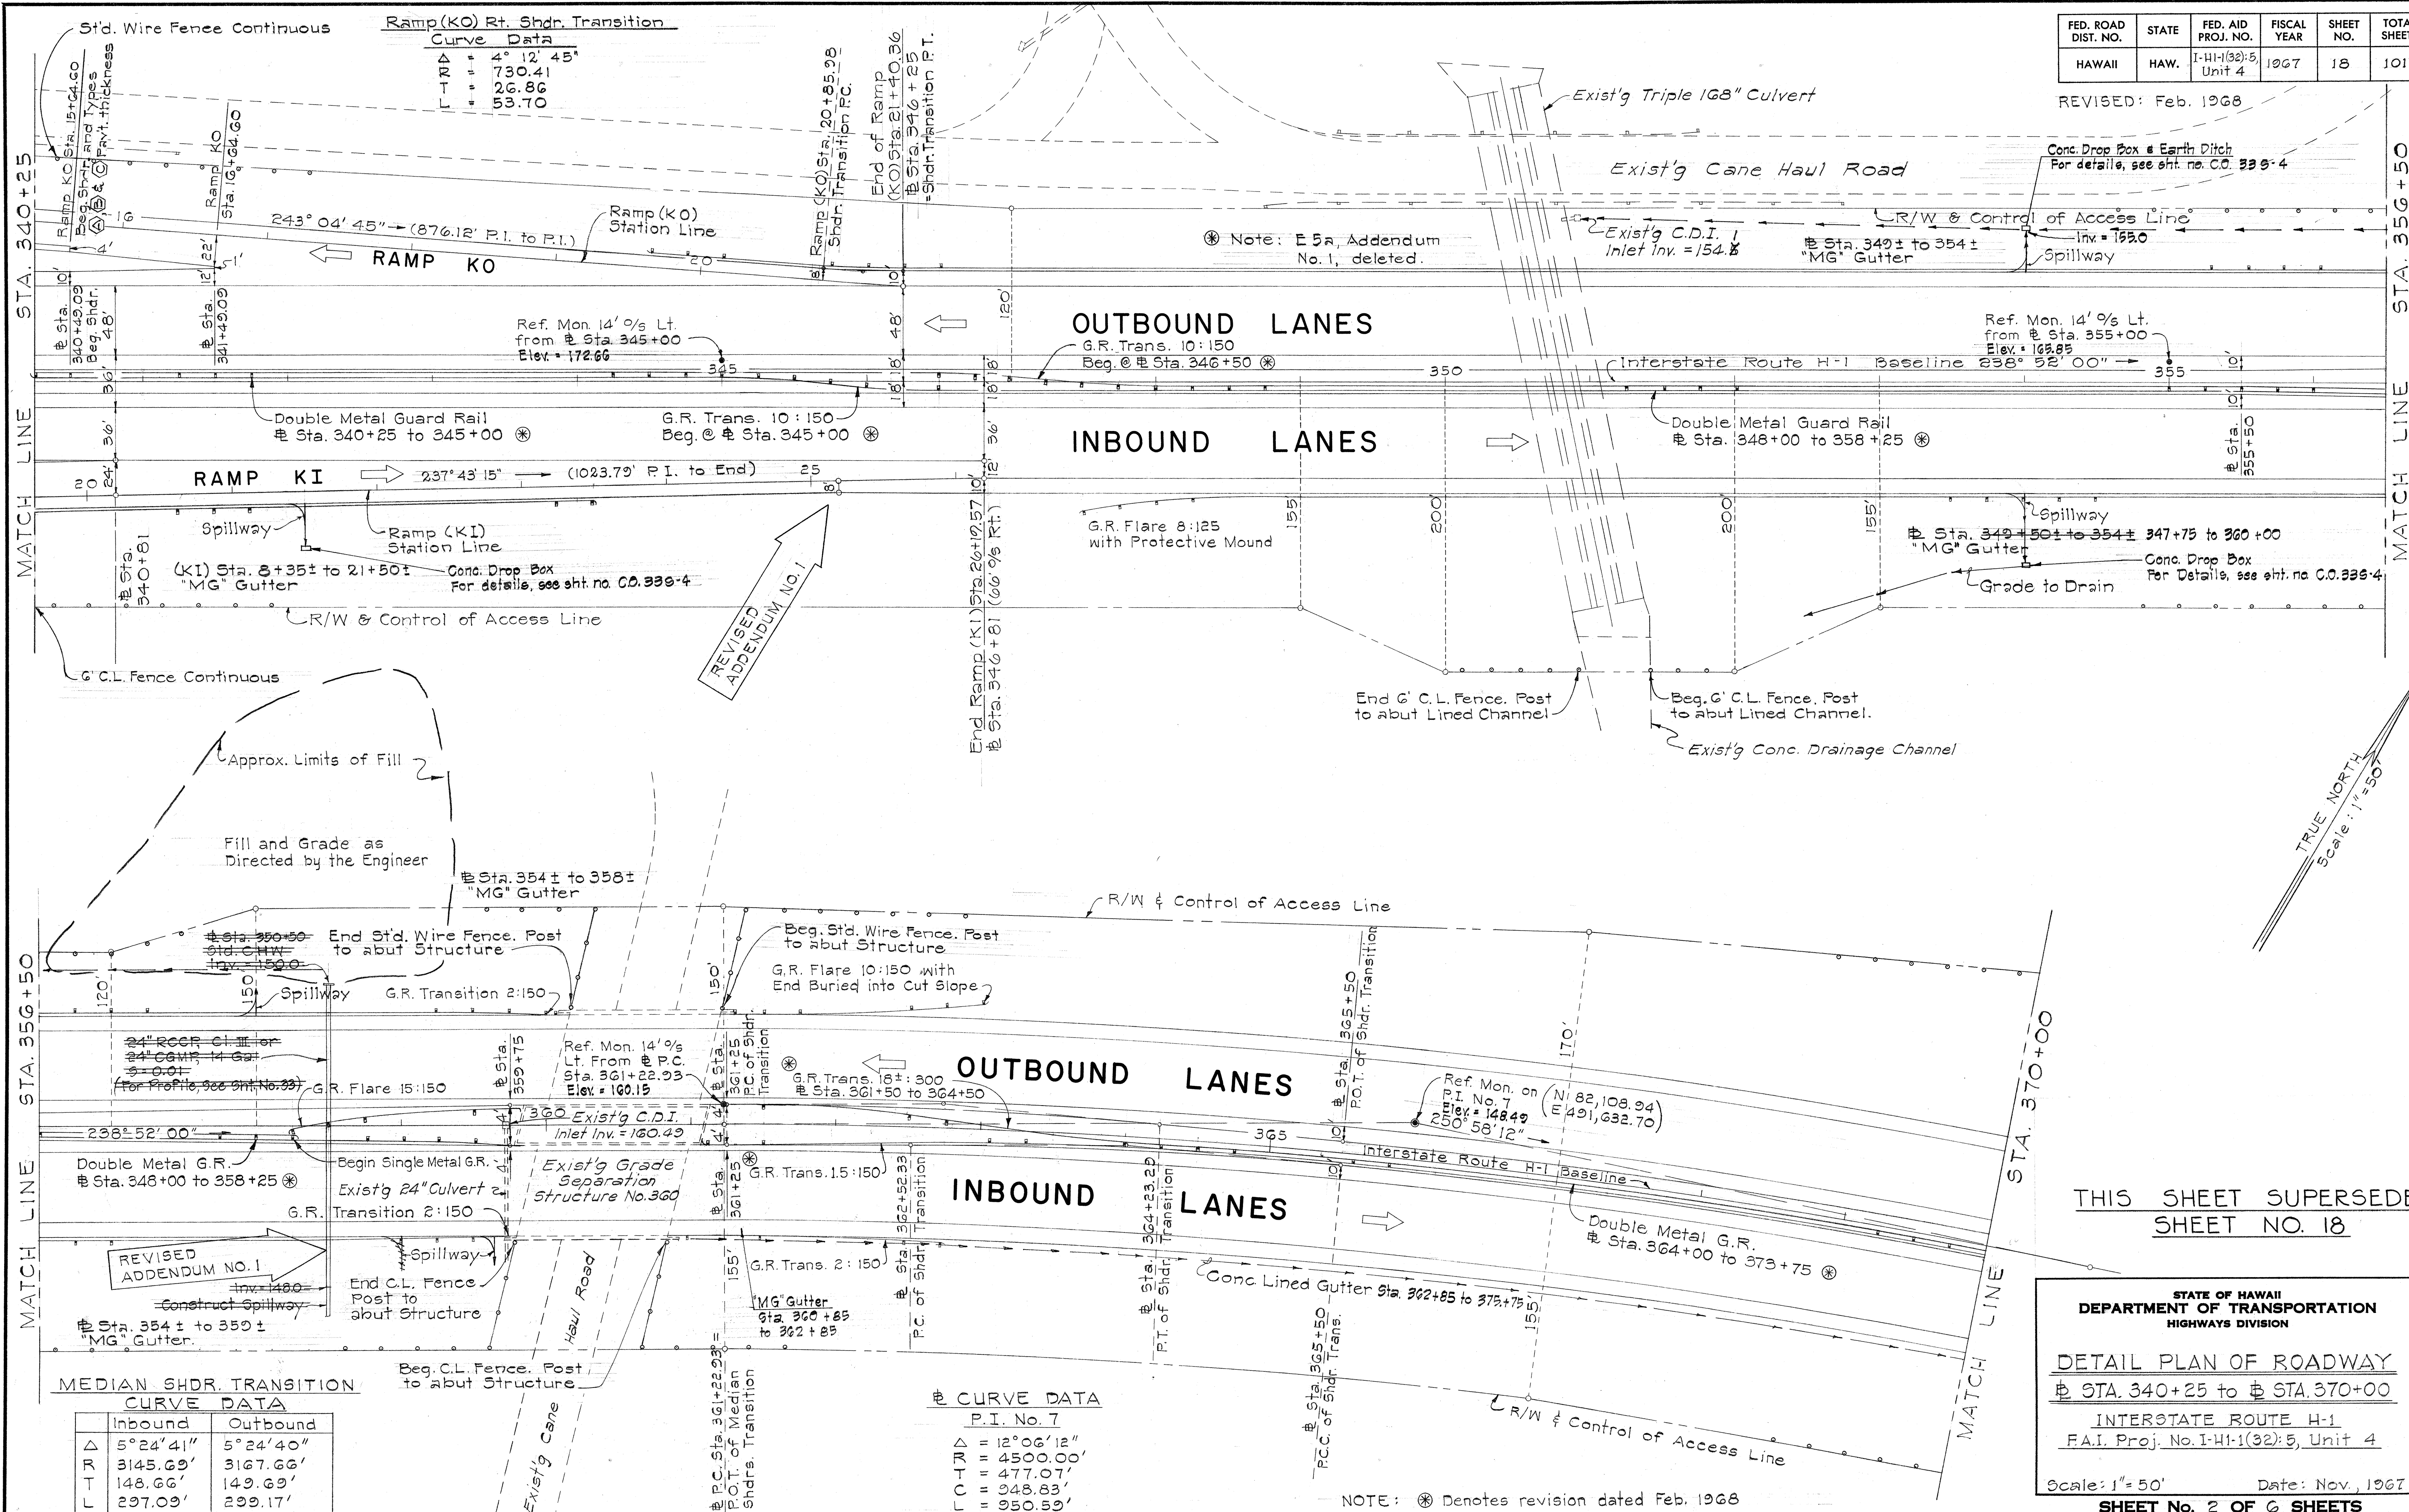

TRUE NORTH
Scale: 1"=50'

THIS SHEET SUPERSEDES
SHEET NO. 18

STATE OF HAWAII
DEPARTMENT OF TRANSPORTATION
HIGHWAYS DIVISION

DETAIL PLAN OF ROADWAY
STA. 340+25 to # STA. 370+00
INTERSTATE ROUTE H-1
F.A.I. Proj. No. I-41(32):5, Unit 4

Scale: 1"=50' Date: Nov., 1967

SHEET No. 2 OF 6 SHEETS

NOTE: * Denotes revision dated Feb. 1968

SURVEY PLOTTED BY	DATE
DESIGNED BY	
TRACED BY	
QUANTITIES BY	
CHECKED BY	

PRINTED ON NO. 10000 CLEARPRINT

C O I S


REVISÉD: Feb. 1968

SHEET No. 3 OF 6 SHEETS

	Inbound	Outbound
Δ	6° 36' 09"	6° 36' 09"
R	3,337.26'	1662.71'
T	192.50'	95.21'
L	384.57'	191.61'

FED. ROAD DIST. NO.	STATE	FED. AID PROJ. NO.	FISCAL YEAR	SHEET NO.	TOTAL SHEETS
HAWAII	HAW.	I-H-1(32):5 Unit 4	1967	20	101

REVISED: Feb. 1968

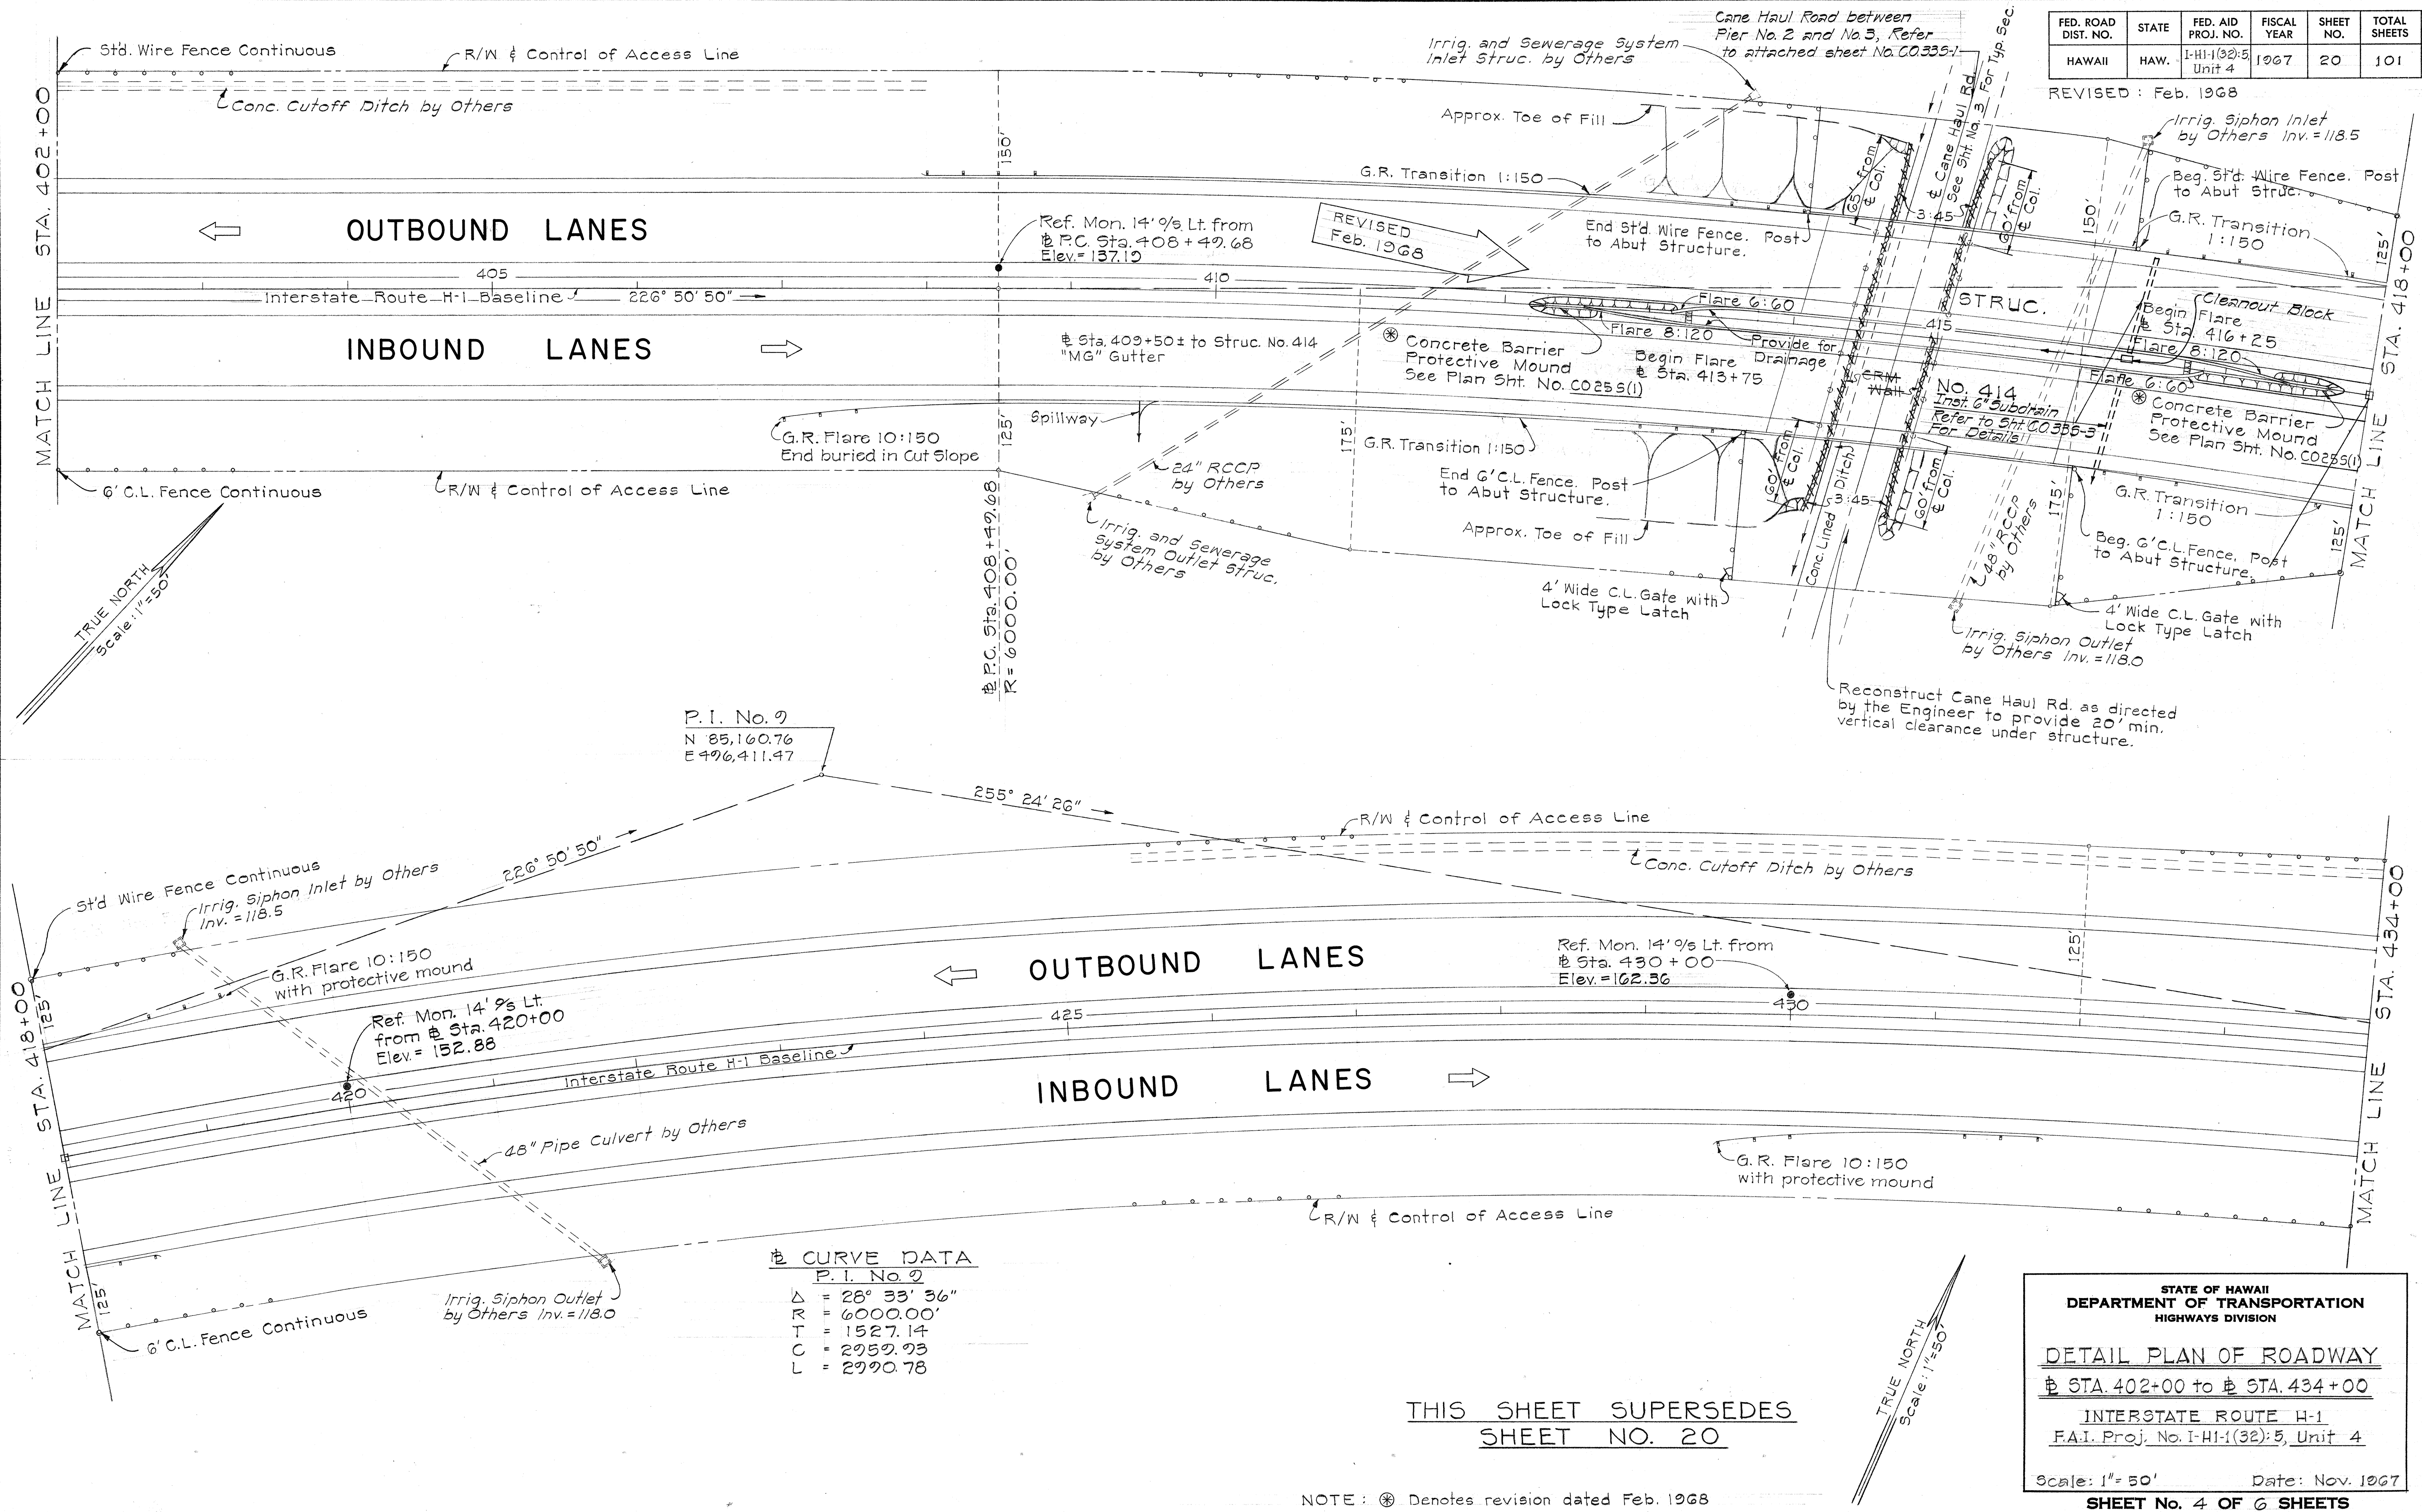

THIS SHEET SUPERSEDES
SHEET NO. 20

NOTE: ⊗ Denotes revision dated Feb. 1968

STATE OF HAWAII
DEPARTMENT OF TRANSPORTATION
HIGHWAYS DIVISION

DETAIL PLAN OF ROADWAY
STA. 402+00 to # STA. 434+00
INTERSTATE ROUTE H-1
F.A.I. Proj. No. I-H-1(32):5, Unit 4

Scale: 1" = 50' Date: Nov. 1967
SHEET NO. 4 OF 6 SHEETS

C020

FED. ROAD DIST. NO.	STATE	FED. AID PROJ. NO.	FISCAL YEAR	SHEET NO.	TOTAL SHEETS
HAWAII	HAW.	I-HI-1(32):5 UNIT	1967	22	101



Eq. = -554.47

Sta. 466+45.53 (Back)
= Outb. Sta. 472+00 (Forward)

OUTBOUND LANES


INBOUND LANES

END OF F.A.I. PROJECT
No. I-HI-1(32):5 UNIT 3
Sta. 466+45.53

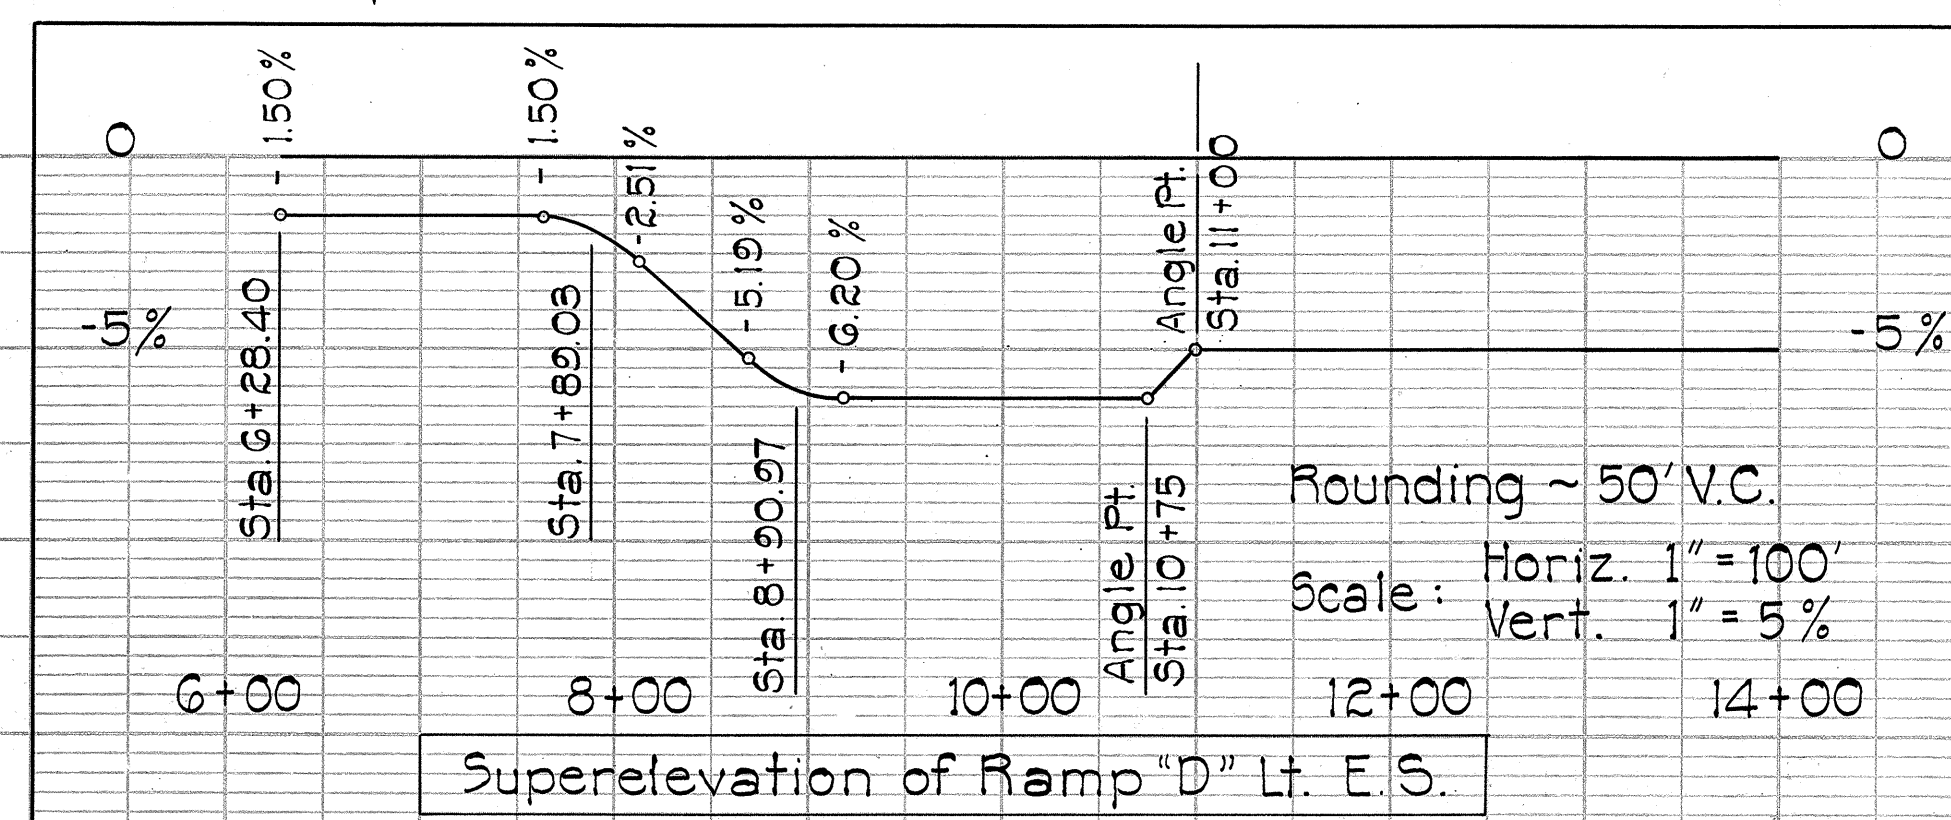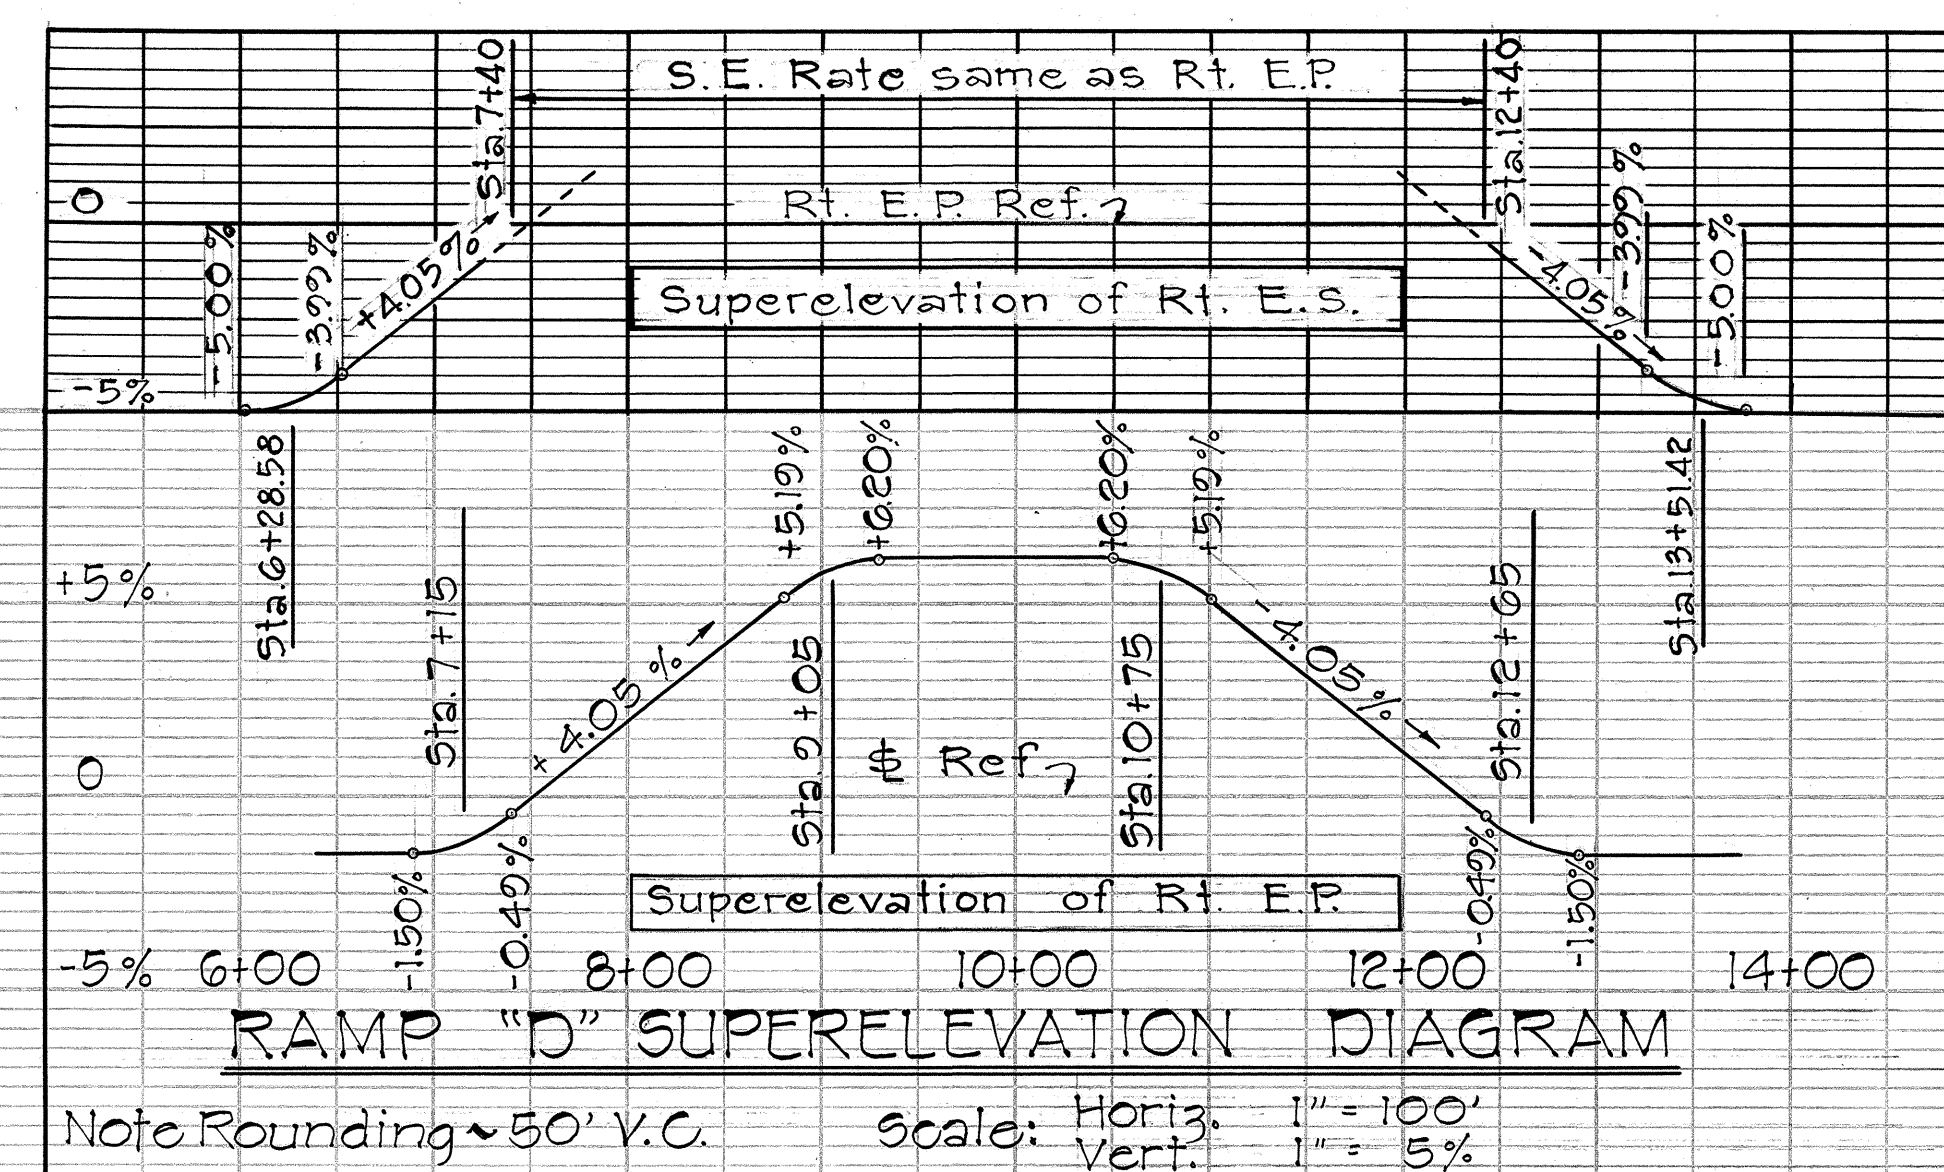

RAMP "D" PROFILE

SCALES: HORIZ. 1" = 50'
VERT. 1" = 10'

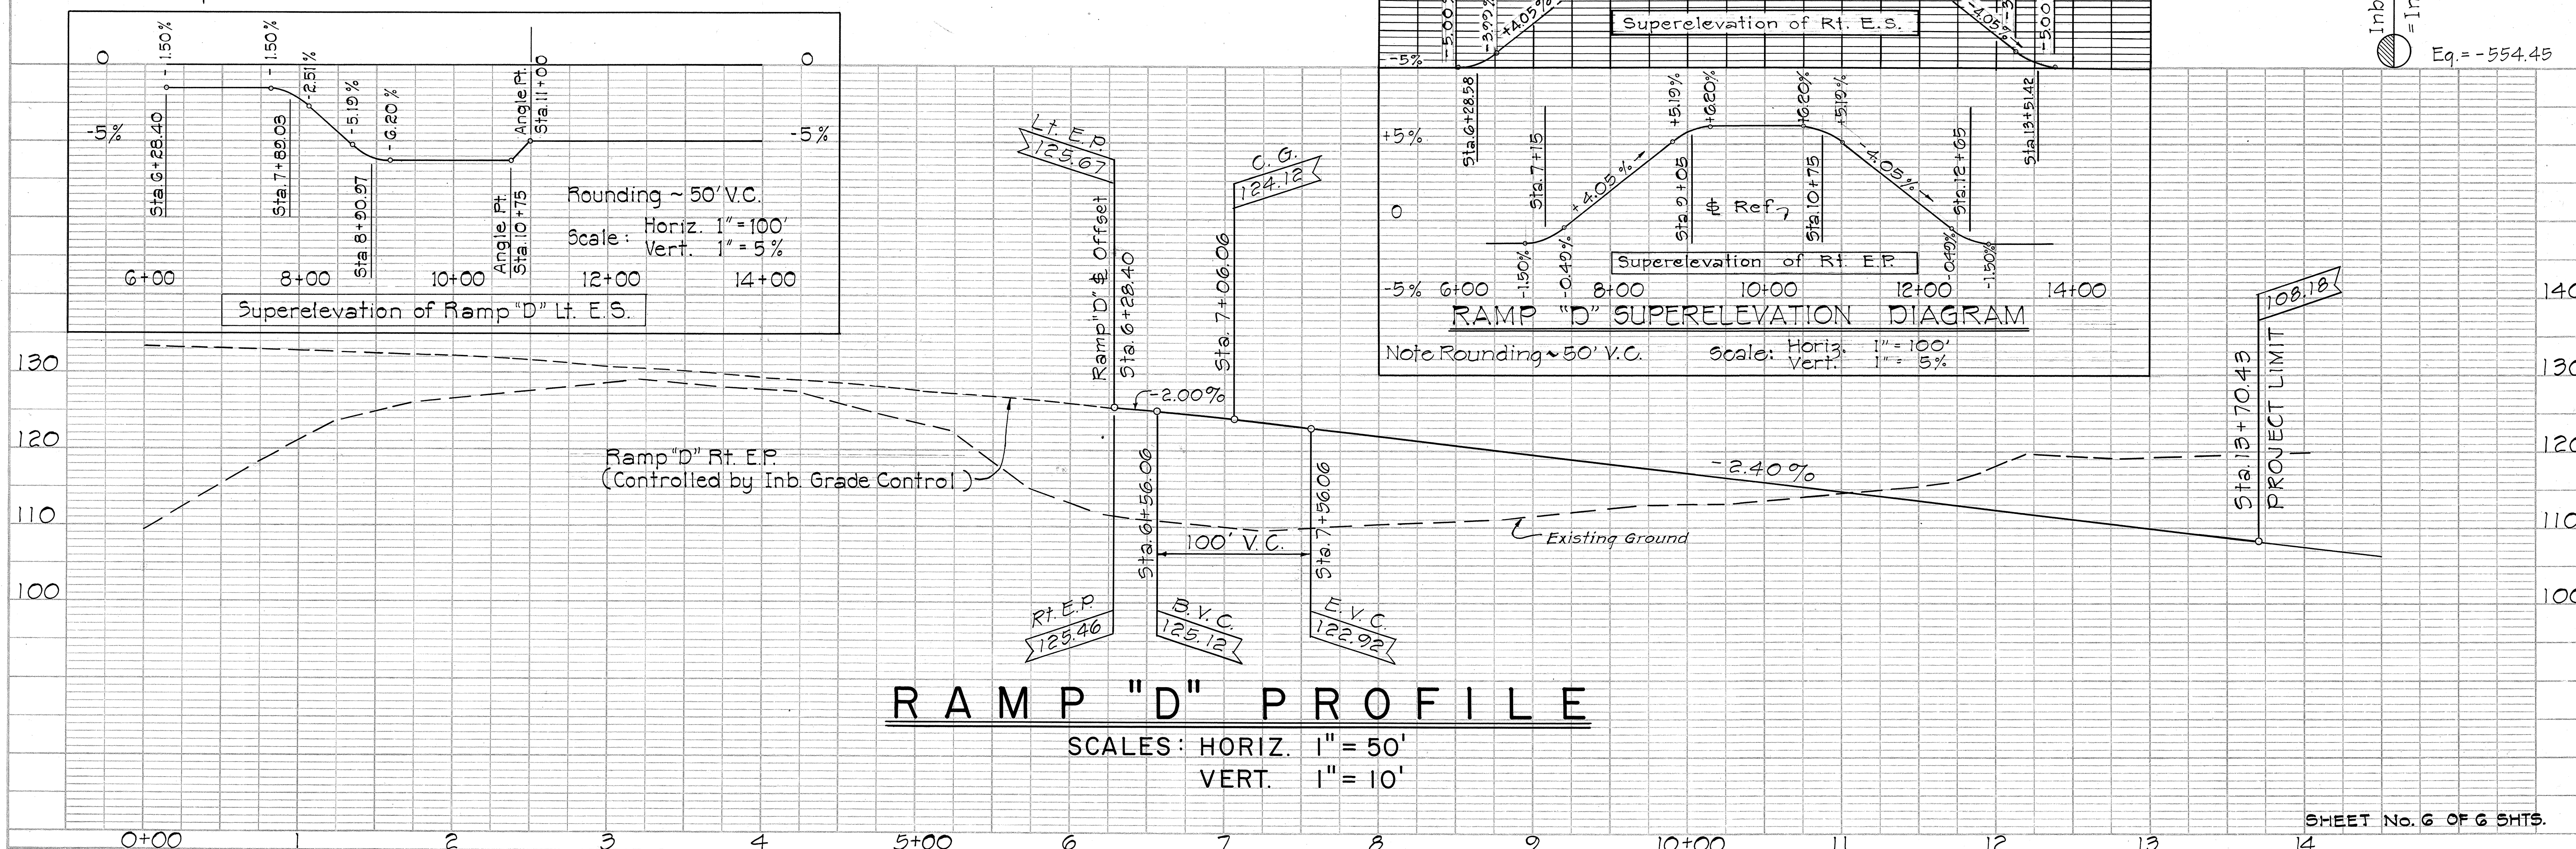

SHEET No. 6 OF 6 SHTS.