
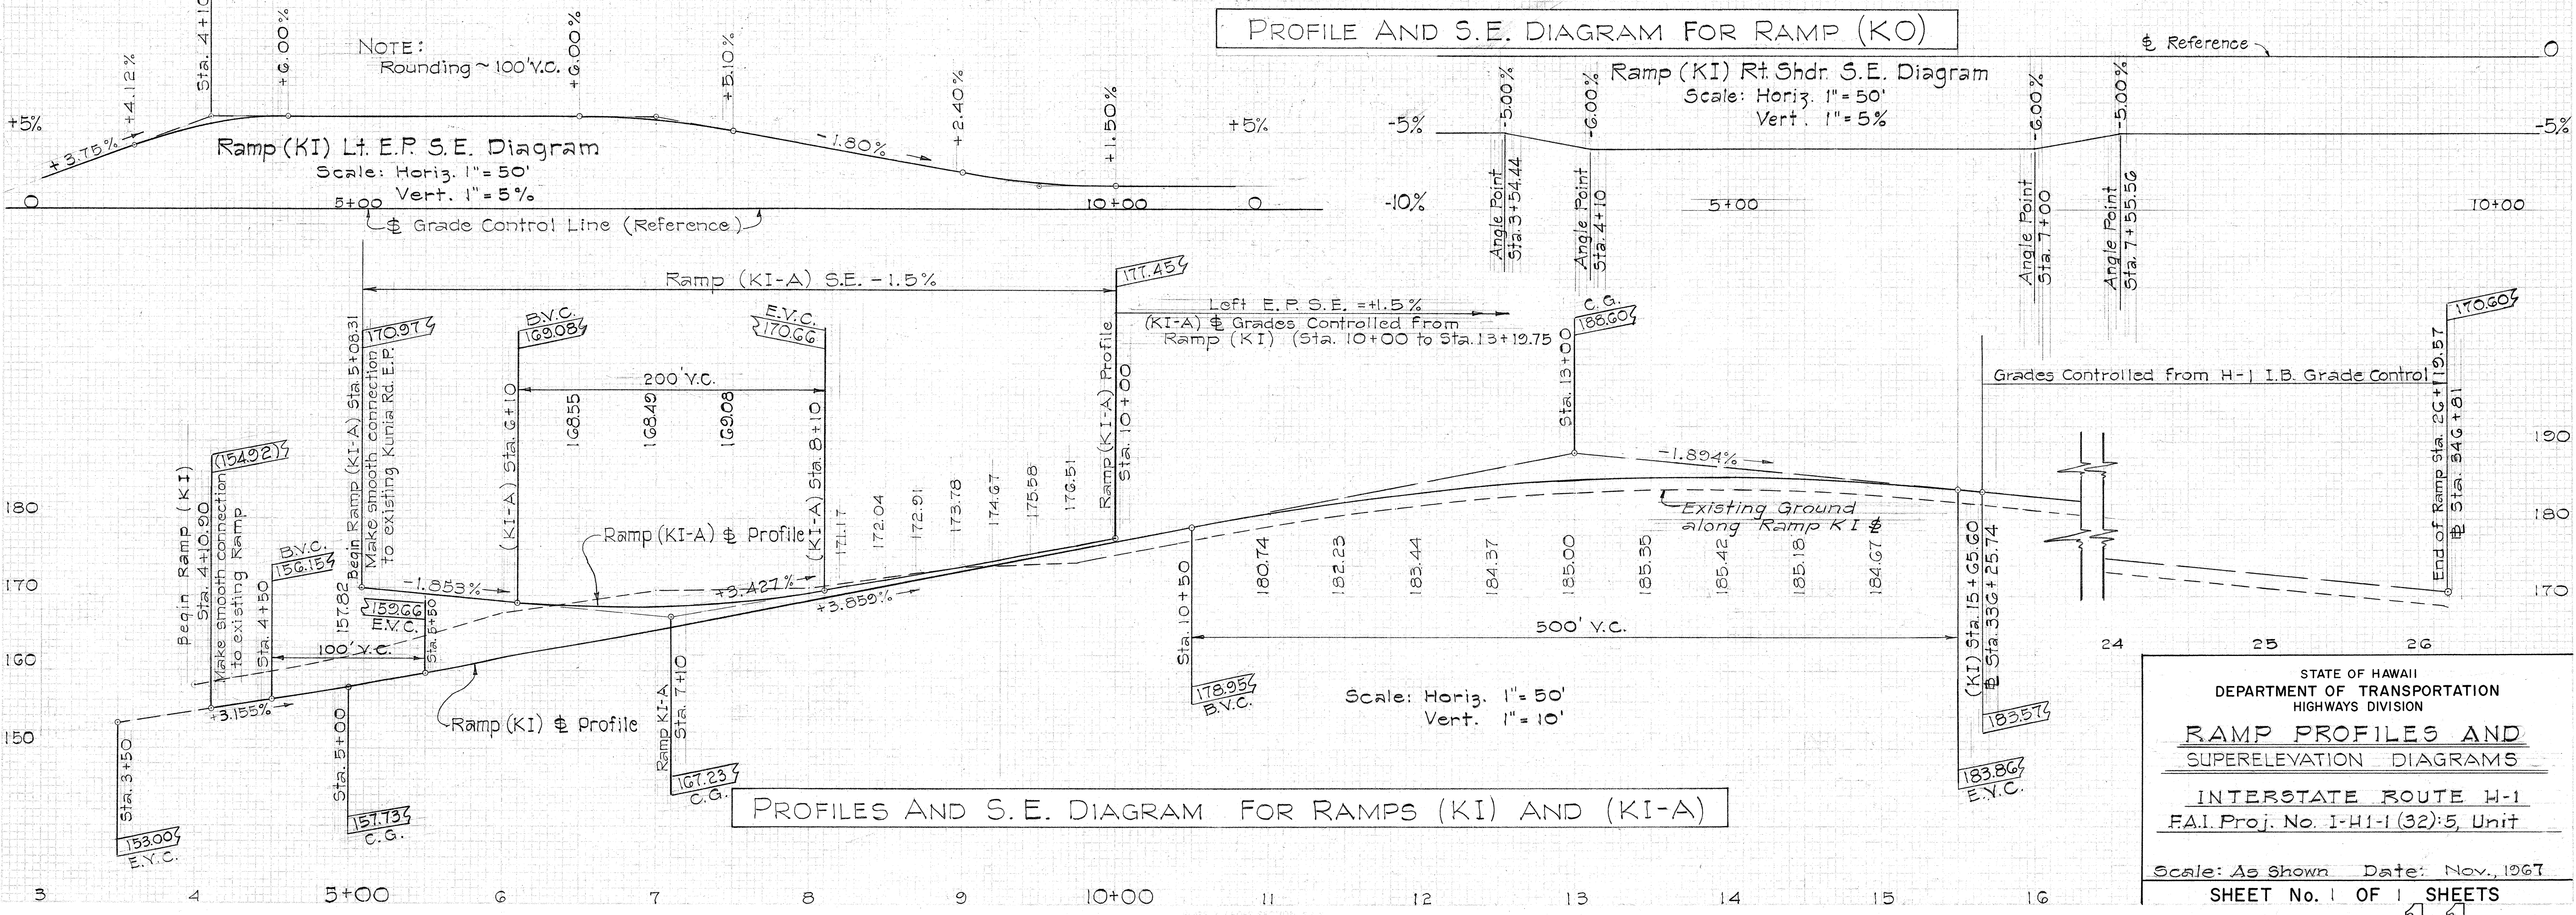


FED. ROAD DIST. NO.	STATE	FED. AID PROJ. NO.	FISCAL YEAR	SHEET NO.	TOTAL SHEETS
HAWAII	HAW.	1-H1-1(32)-5 Unit 4	1967	11	101

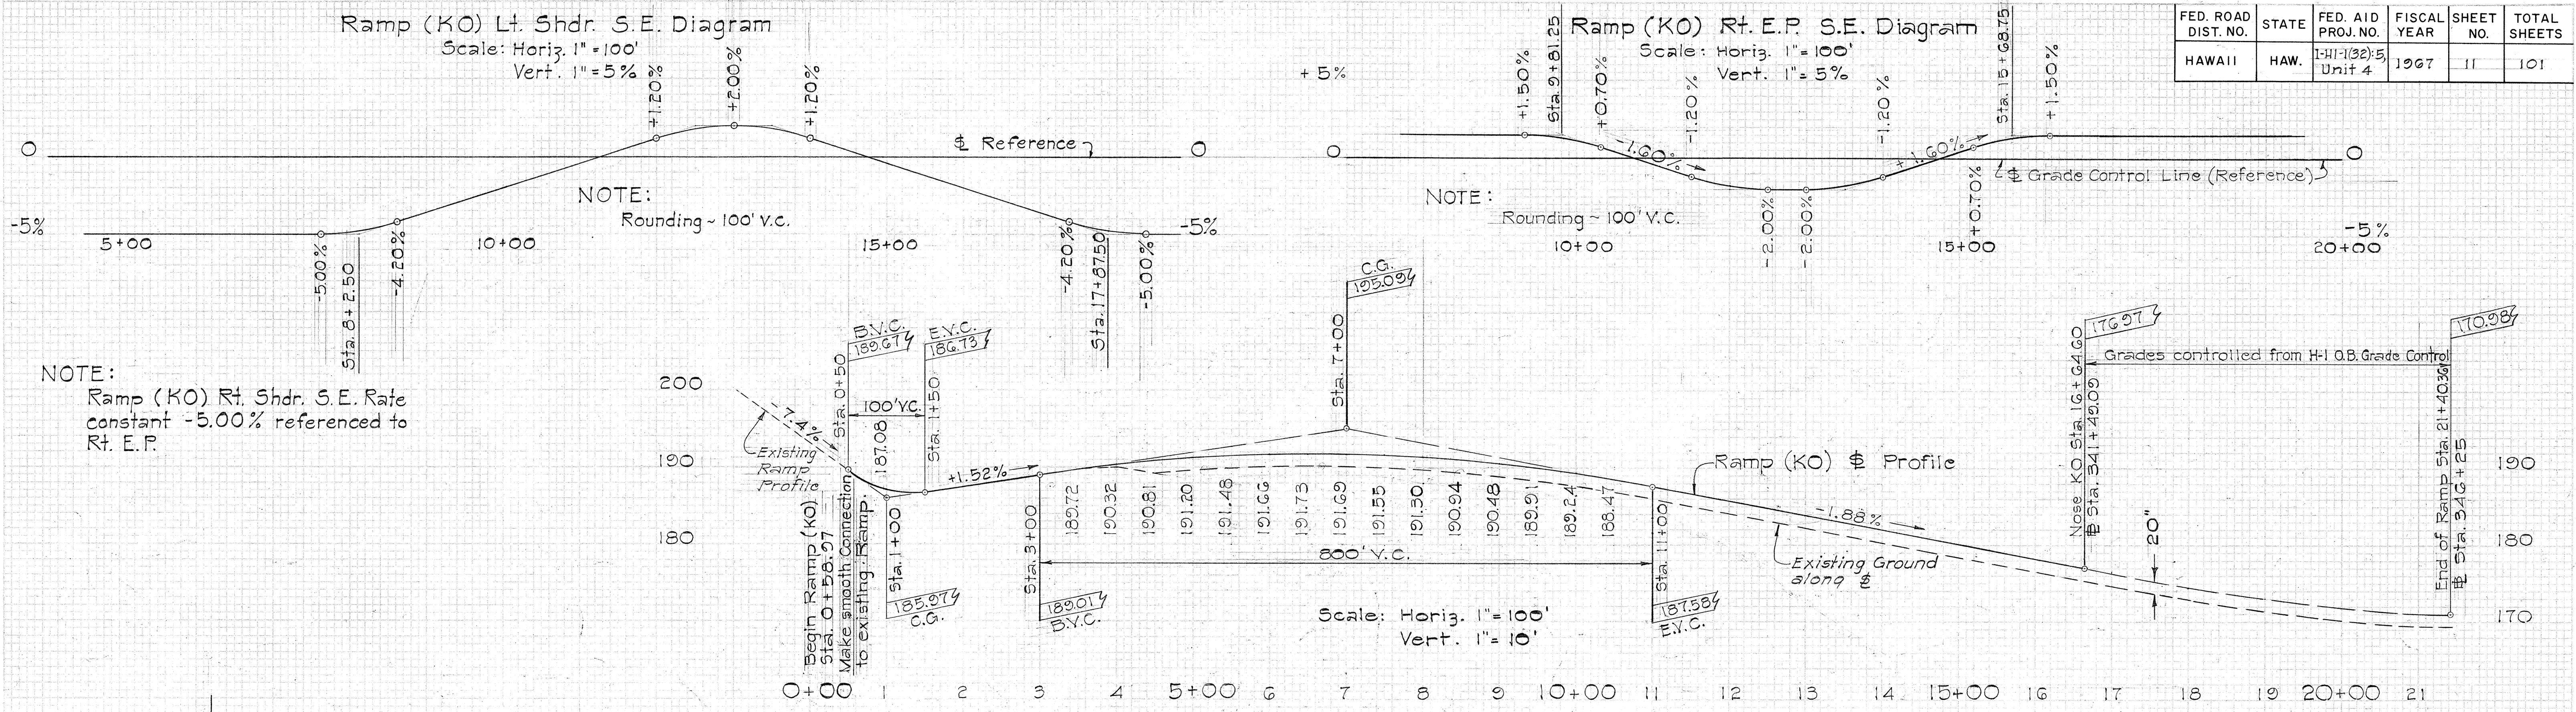

STATE OF HAWAII
DEPARTMENT OF TRANSPORTATION
HIGHWAYS DIVISION

**RAMP PROFILES AND
SUPERELEVATION DIAGRAMS**

INTERSTATE ROUTE H-1
FAI Proj. No. 1-H1-1 (32)-5, Unit

Scale: As Shown Date: Nov., 1967
SHEET No. 1 OF 1 SHEETS