

INDEX TO DRAWINGS	
SHEET NO.	DESCRIPTION
1	TITLE SHEET
2 - 5	TYPICAL SECTIONS
6 - 10	PLAN AND PROFILE
11	RAMP PROFILE
12 - 16	SUPERELEVATION DIAGRAMS
17 - 22	DETAIL ROADWAY PLANS
* 23 - 29	MISC. AND STANDARD ROADWAY DETAILS
* 30 - 37	DRAINAGE PLANS AND DETAILS
38 - 41	HIGHWAY LIGHTING SYSTEM
42 - 70	TRAFFIC SIGNS, LANDSCAPING AND PAVEMENT MARKER PLANS AND DETAILS
71	UTILITY PLAN
72 - 80	STRUCTURE NO. 414
81 - 94	STRUCTURE NO. 451
95 - 97	STRUCTURE STANDARD DETAILS
98 - 101	CROSS SECTIONS

* CO 25S(1), CO 25S(2) & CO 25S(3)
* * CO 33S-1, CO 33S-2, CO 33S-3, CO 33S-4 & CO 33S-5
* * * 102AS, 103AS & 104AS

STATE OF HAWAII
DEPARTMENT OF TRANSPORTATION
HIGHWAYS DIVISION
HONOLULU, HAWAII
"AS BUILT"
PLANS FOR
CONSTRUCTION OF A PORTION OF
INTERSTATE ROUTE H-1
EAST OF KUNIA INTERCHANGE TO WEST OF WAIAWA INTERCHANGE
(PAVING AND STRUCTURES)

FEDERAL AID INTERSTATE PROJECT No. I-HI-1(32):5, UNIT 4
AND
FEDERAL AID INTERSTATE PROJECT No. I-HI-1(22):5, UNIT 3

DISTRICT OF EWA
ISLAND OF OAHU

SCALES:


PLAN & PROFILE HOR. 1"= 100'
VER. 1"= 10'

CROSS SECTION HOR. 1"= 20'
VER. 1"= 20'

NOTE:
ALL CHANGES MADE DURING CONSTRUCTION HAVE BEEN
NOTED ON THESE TRACINGS IN RED AND CHECKED BY:

Thomas N. Miyamoto 3/12/71
PROJECT ENGINEER DATE


FED. ROAD DIST. NO.	STATE	FED. AID PROJ. NO.	FISCAL YEAR	SHEET NO.	TOTAL SHEETS
HAWAII	HAW.	I-HI-1(32):5 UNIT 4	1967	1	101

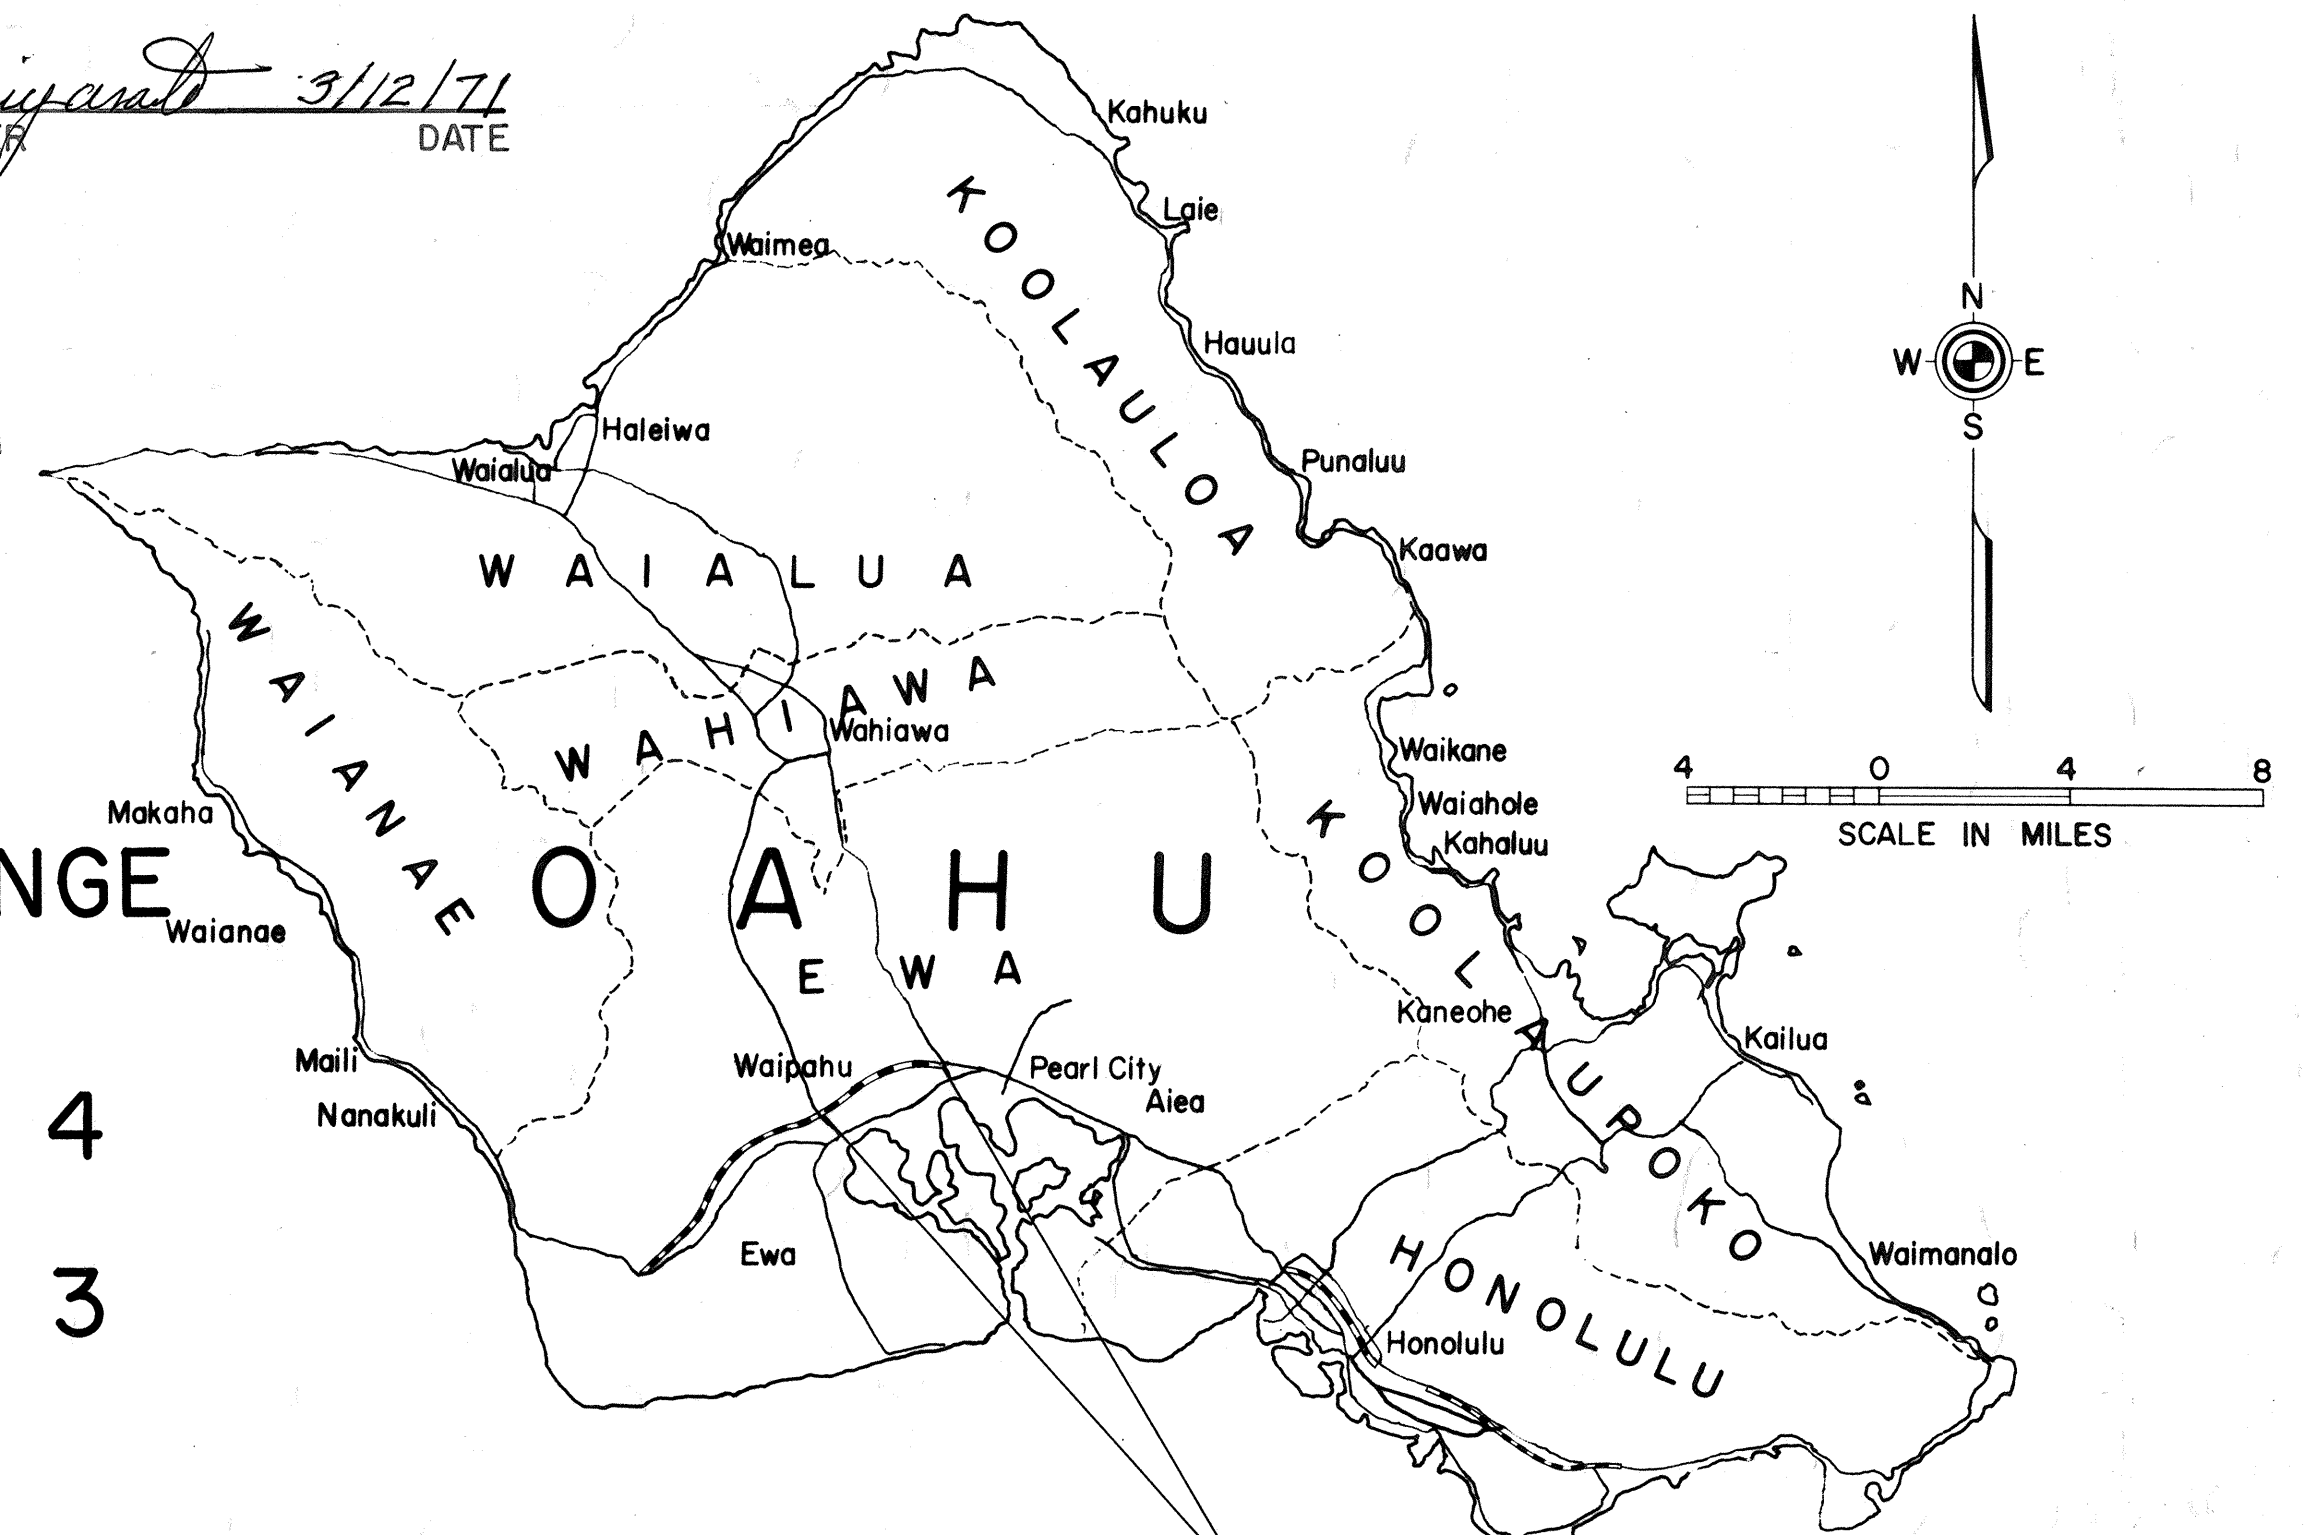

LOCATION OF PROJECT
F.A.I. Proj. No. I-HI-1(32):5, Unit 4
F.A.I. Proj. No. I-HI-1(22):5, Unit 3

— Federal Aid Interstate Projects Previously Constructed or Under Construction

INTERSTATE ROUTE H-1 FED. AID INTERSTATE PROJECT NOS. I-HI-1(32):5, UNIT 4 AND I-HI-1(22):5, UNIT 3

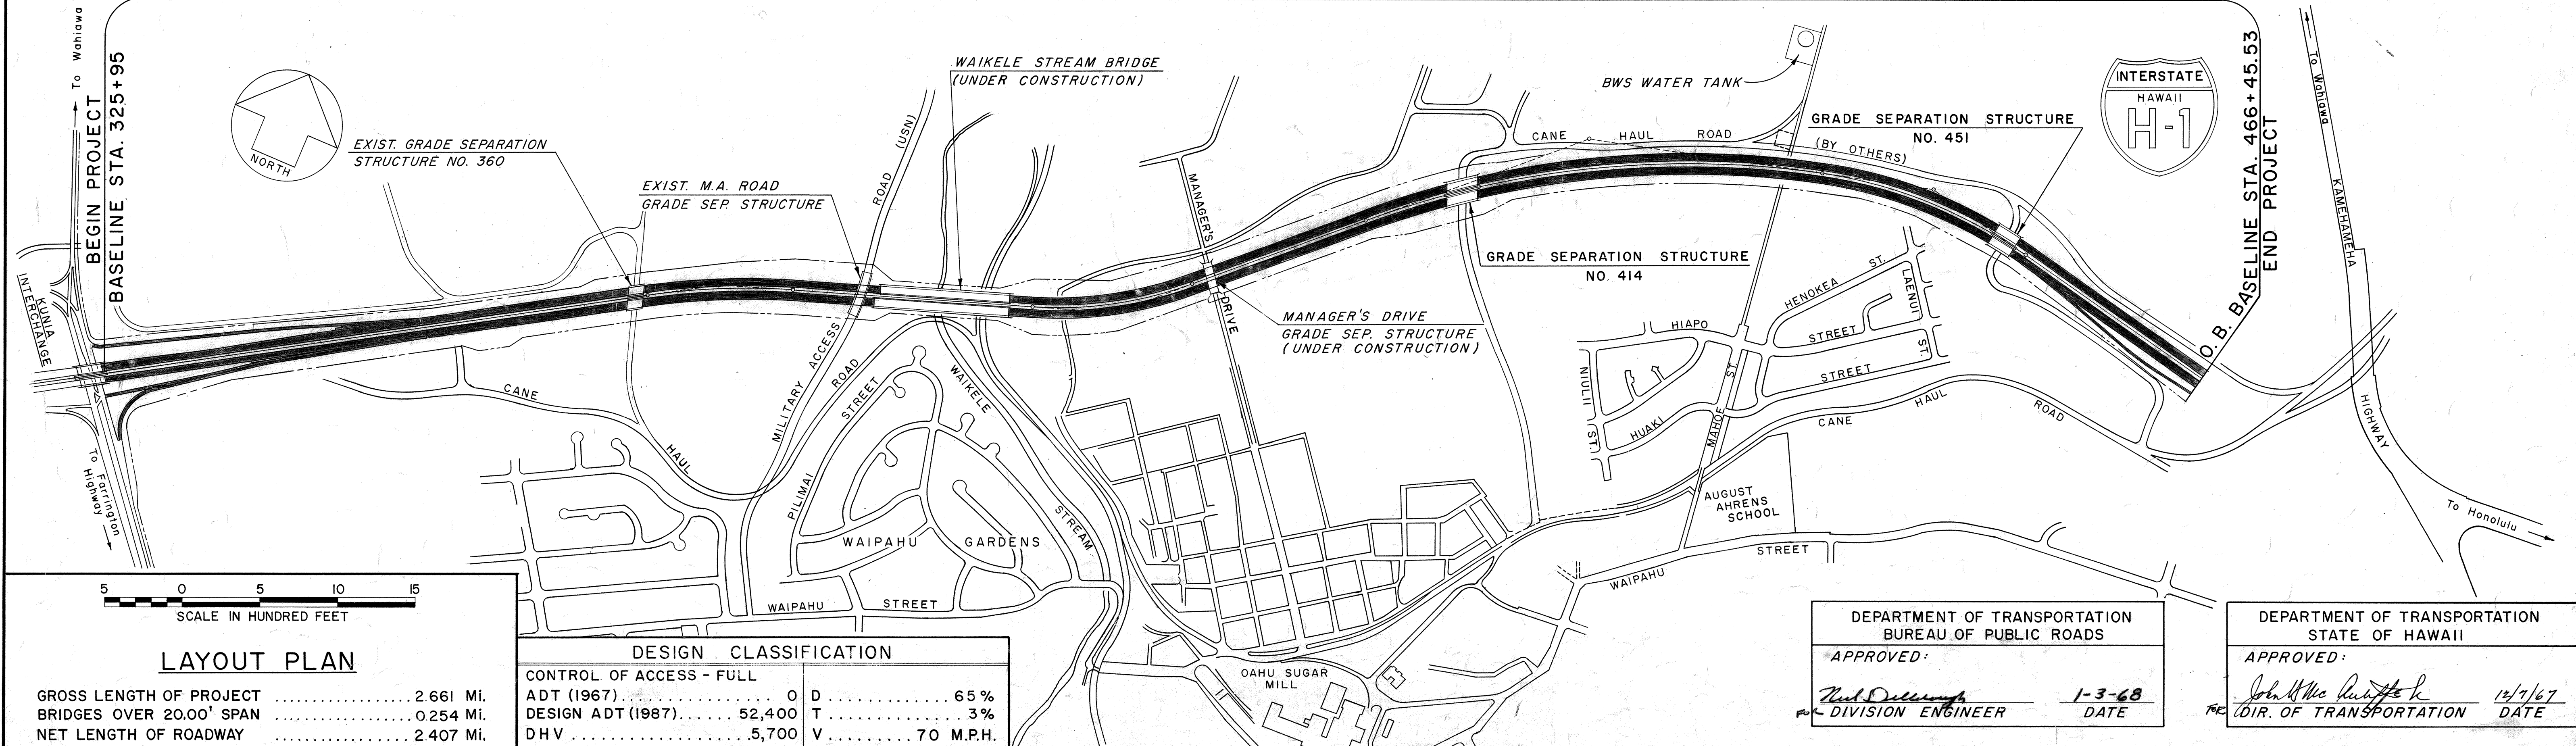

LAYOUT PLAN

GROSS LENGTH OF PROJECT 2.661 MI.
BRIDGES OVER 20.00' SPAN 0.254 MI.
NET LENGTH OF ROADWAY 2.407 MI.

DESIGN CLASSIFICATION

CONTROL OF ACCESS - FULL		
ADT (1967)	0	D 65%
DESIGN ADT (1987)	52,400	T 3%
DHV	5,700	V 70 M.P.H.

DEPARTMENT OF TRANSPORTATION
BUREAU OF PUBLIC ROADS

APPROVED:

John D. Williams
DIVISION ENGINEER

1-3-68
DATE

DEPARTMENT OF TRANSPORTATION
STATE OF HAWAII

APPROVED:

John H. Williams
DIR. OF TRANSPORTATION 12/7/67
DATE

Mike Miura
DESIGN ENGR.
HWY. DESIGN UNIT
50511-Local 301
Nov. 1967
DATE