
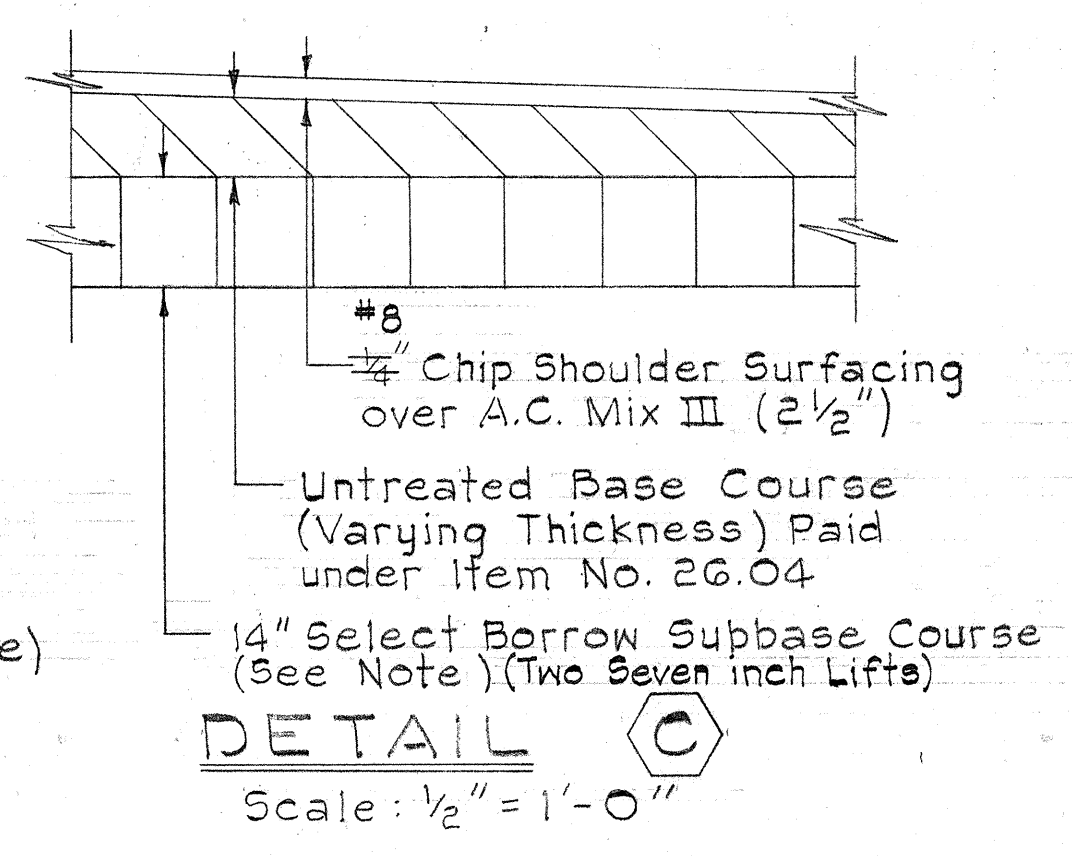
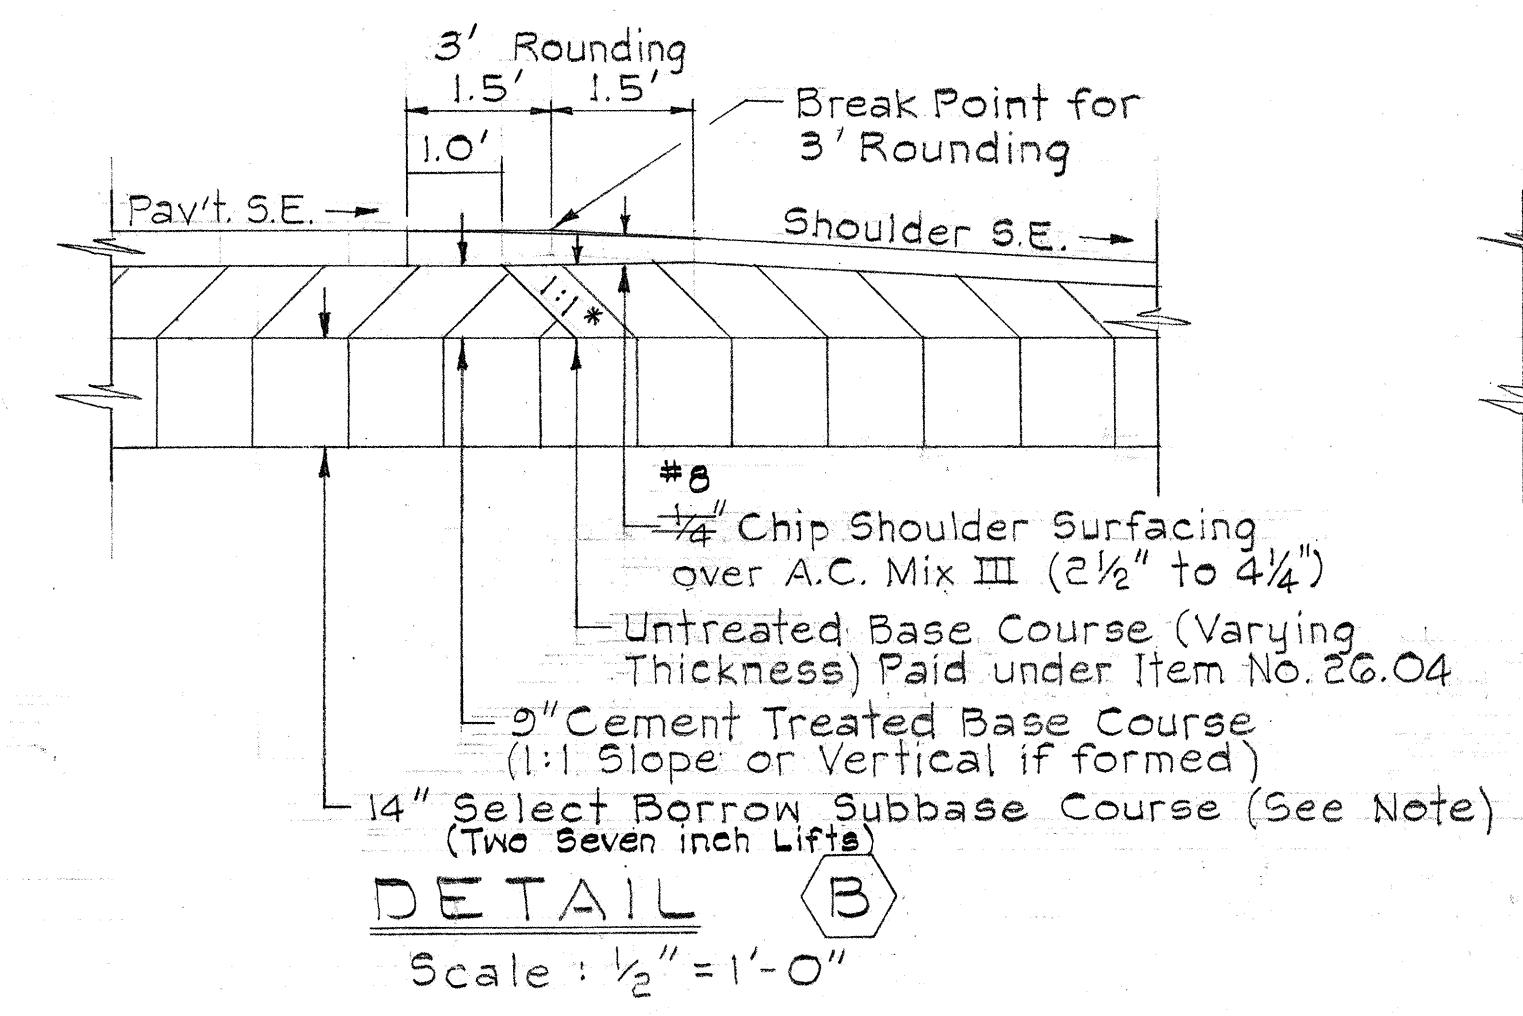
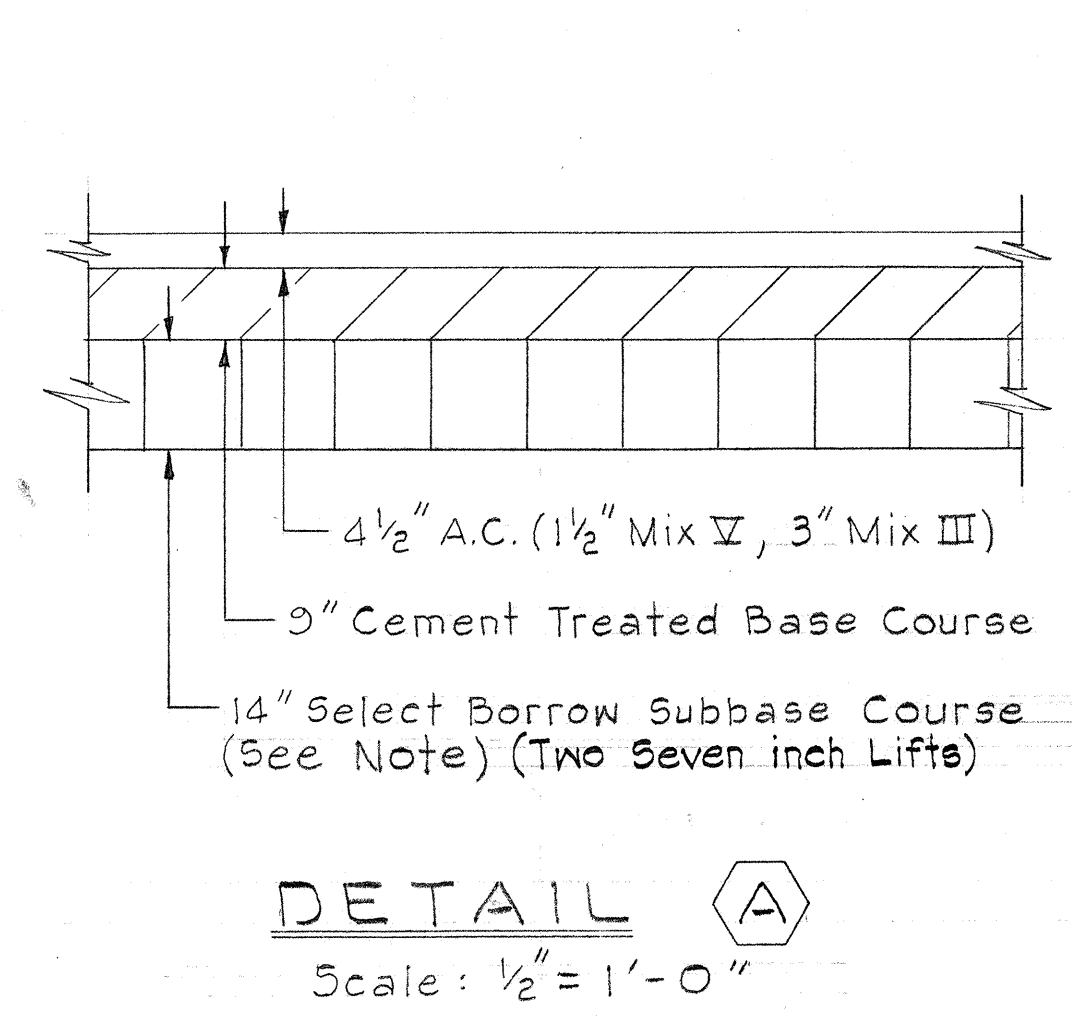
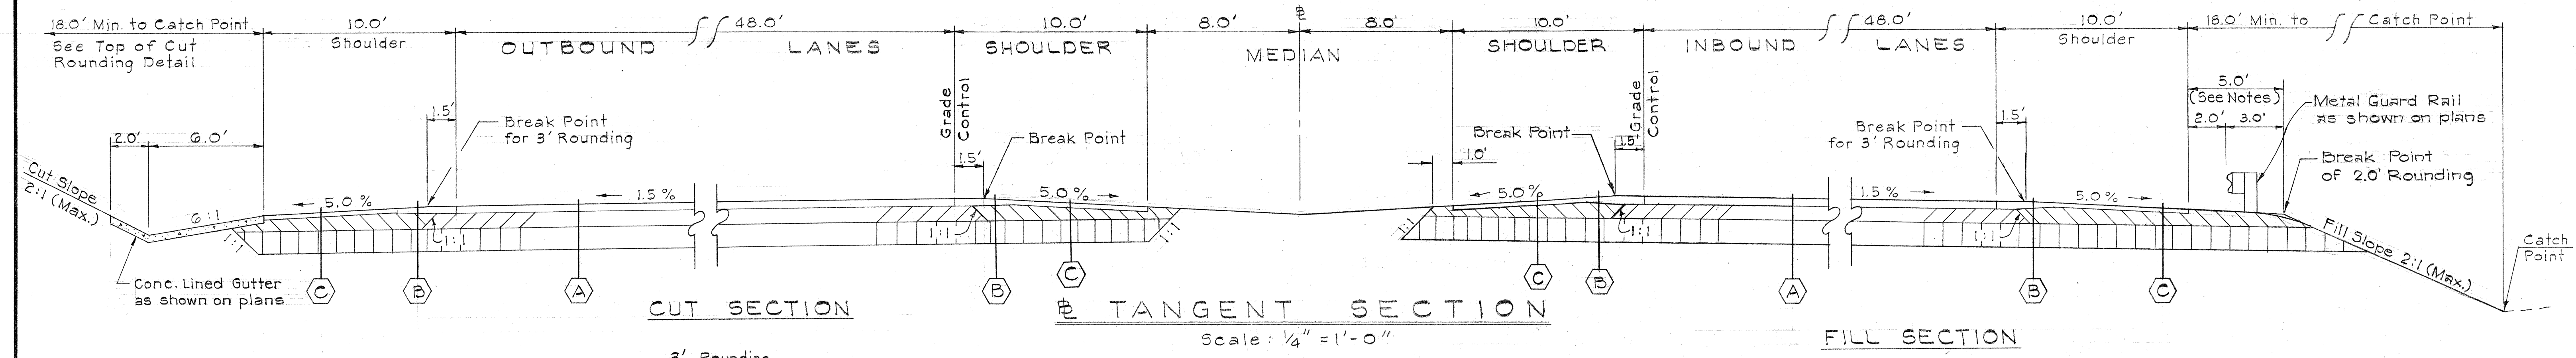
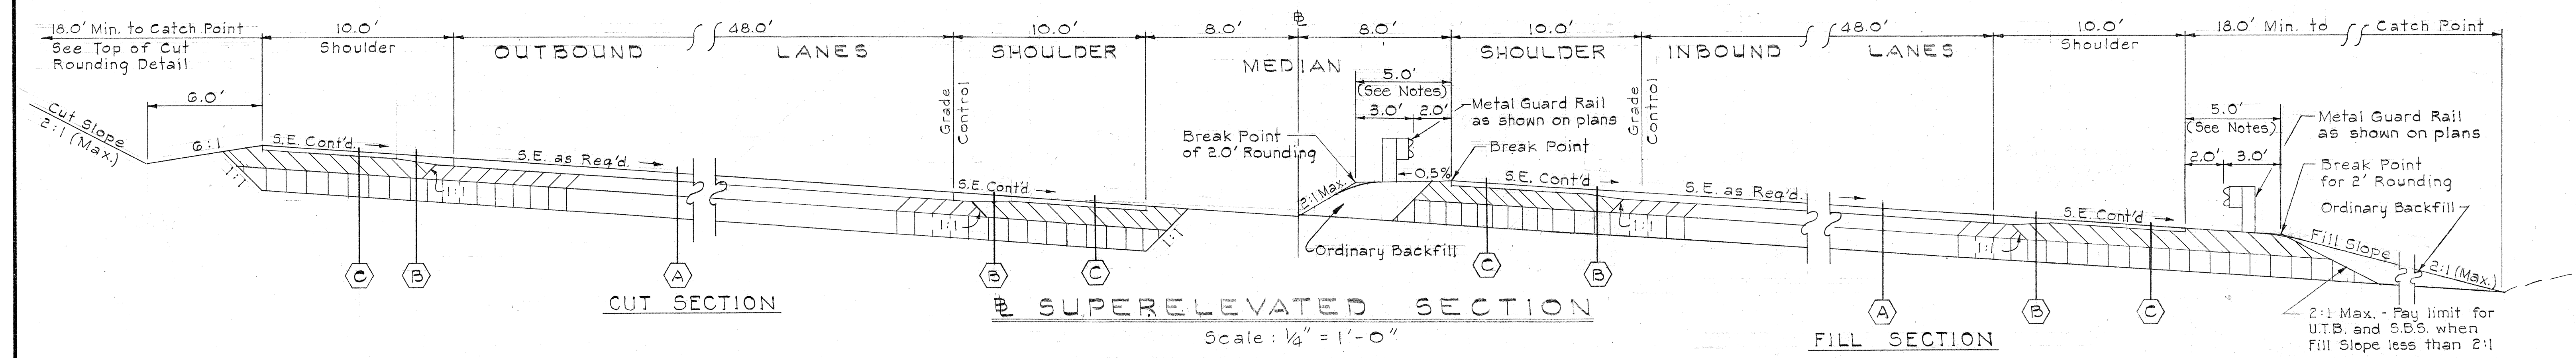


FED. ROAD DIST. NO.	STATE	FED. AID PROJ. NO.	FISCAL YEAR	SHEET NO.	TOTAL SHEETS
HAWAII	HAW.	I-HI-1(32):5 Unit 4	1967	2	101

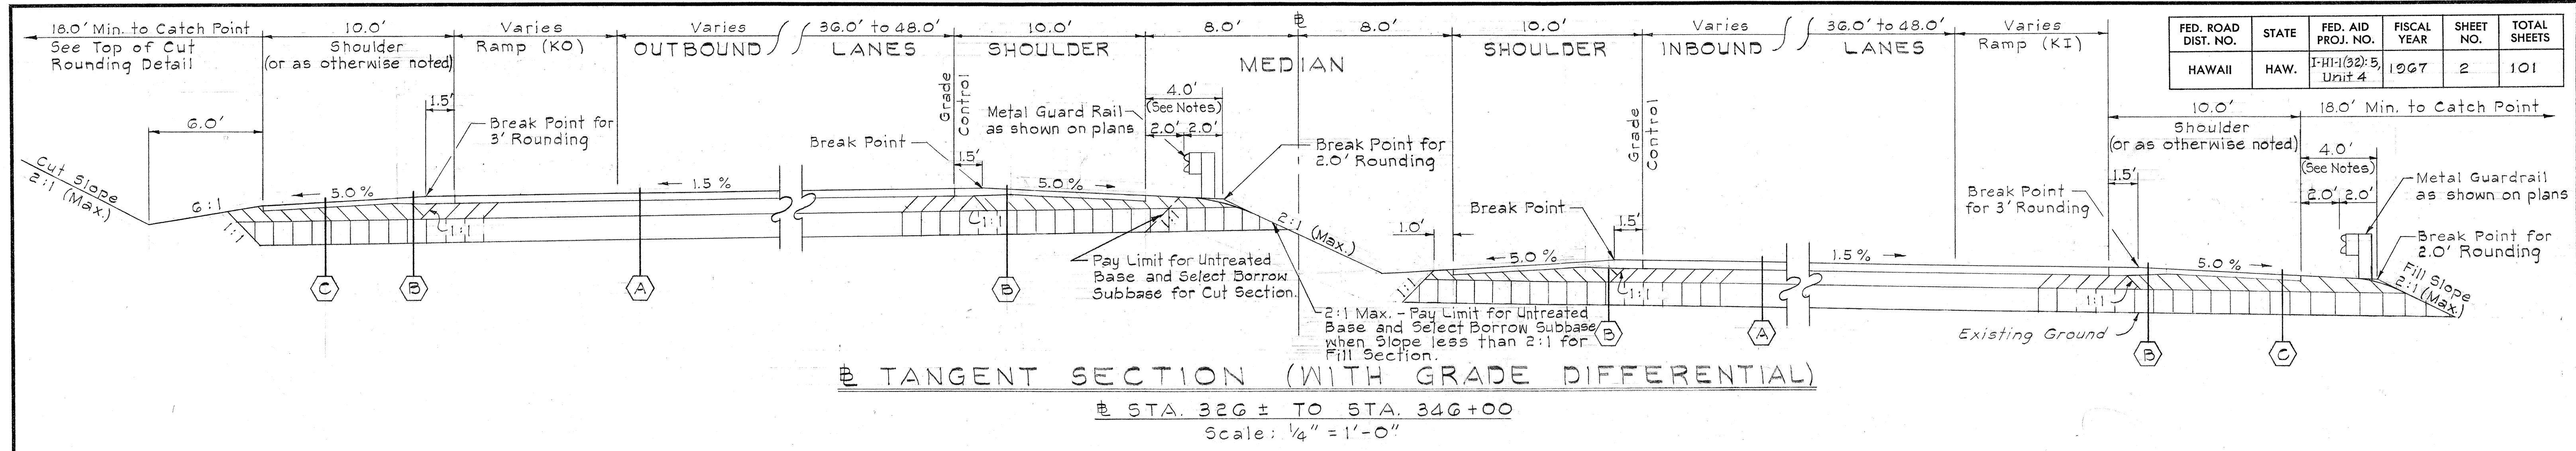

- NOTES:**
1. Select Borrow Subbase Course shall be 4" thick from approximately Sta. 324 to Waikale Stream Bridge. The exact limits shall be determined by the Engineer.
 2. For General Typical Section Notes see Sheet No. 5

STATE OF HAWAII
 DEPARTMENT OF TRANSPORTATION
 HIGHWAYS DIVISION

TYPICAL SECTIONS
BASELINE




INTERSTATE ROUTE H-1
 F.A.I. Proj. No. I-HI-1(32):5, Unit 4

Scale: As Noted Date: Nov., 1967




SHEET No. 1 OF 4 SHEETS

SURVEY PLOTTED BY	DATE
DRAWN BY	
DESIGNED BY	
QUANTITIES BY	
CHECKED BY	
ORIGINAL PLAN	
NOTE BOOK	
No.	

FED. ROAD DIST. NO.	STATE	FED. AID PROJ. NO.	FISCAL YEAR	SHEET NO.	TOTAL SHEETS
HAWAII	HAW.	I-HI-1(32)5, Unit 4	1967	3	101

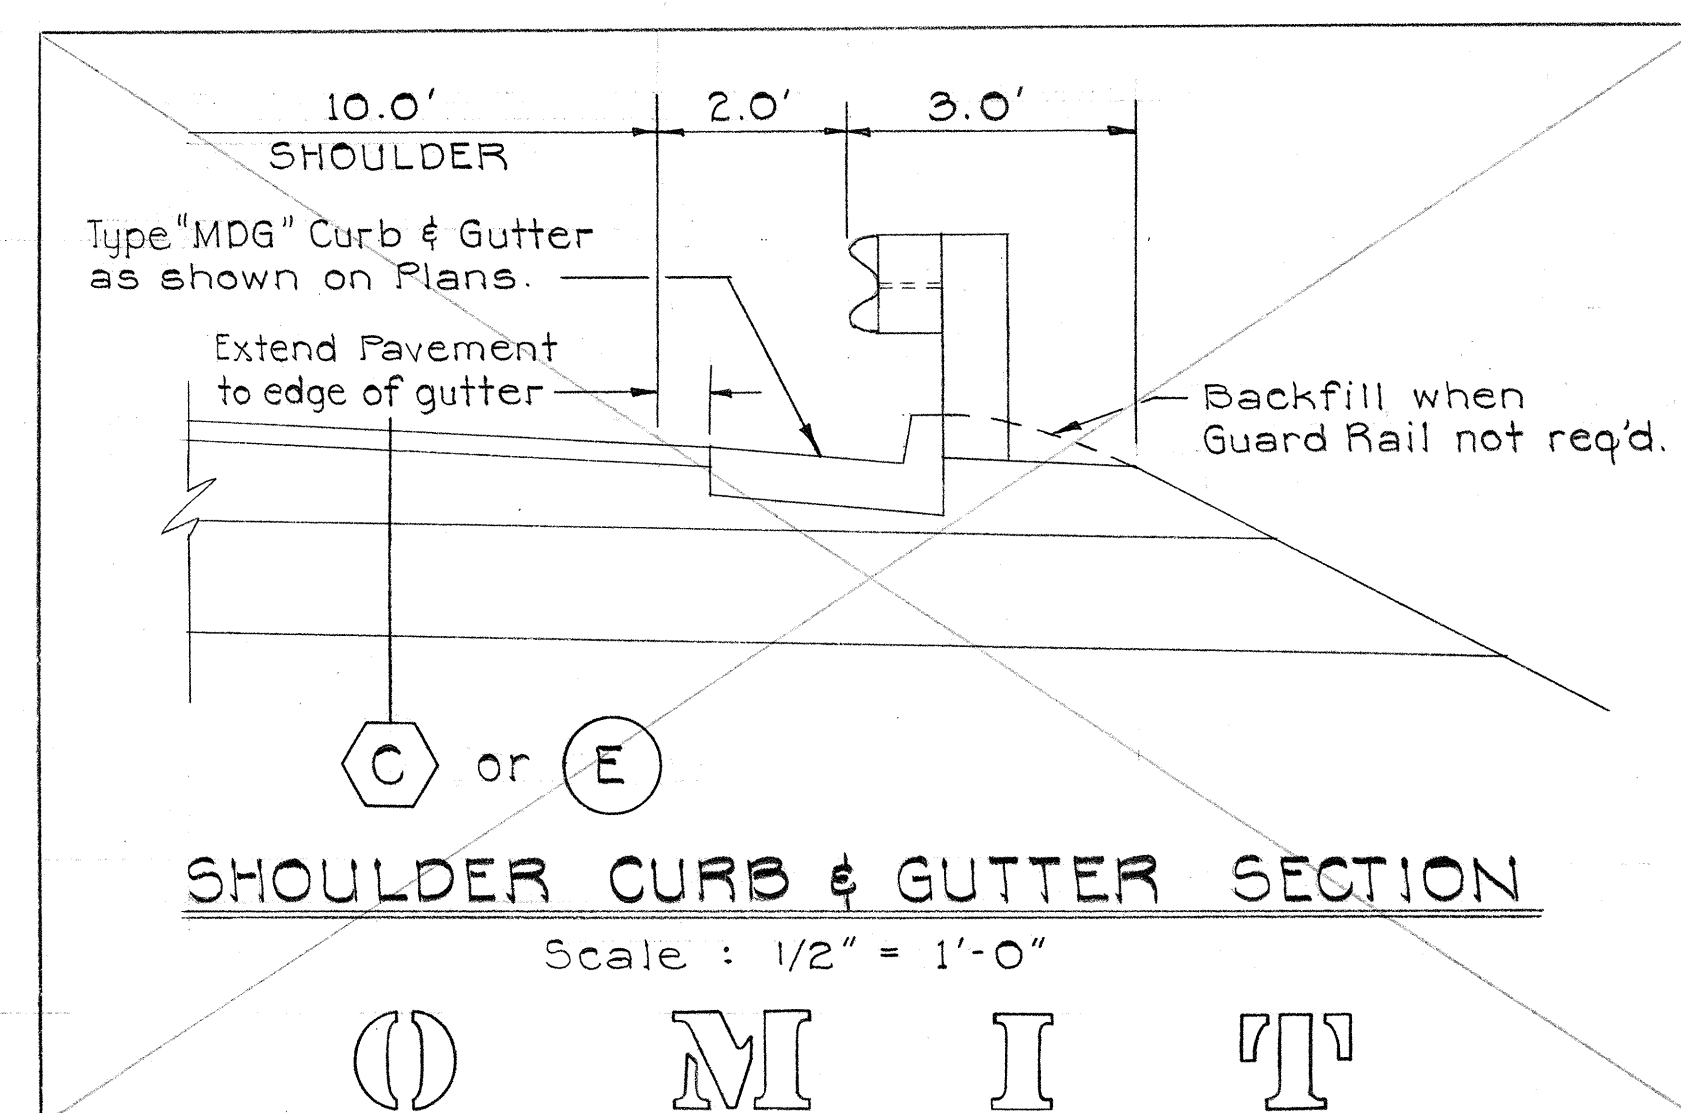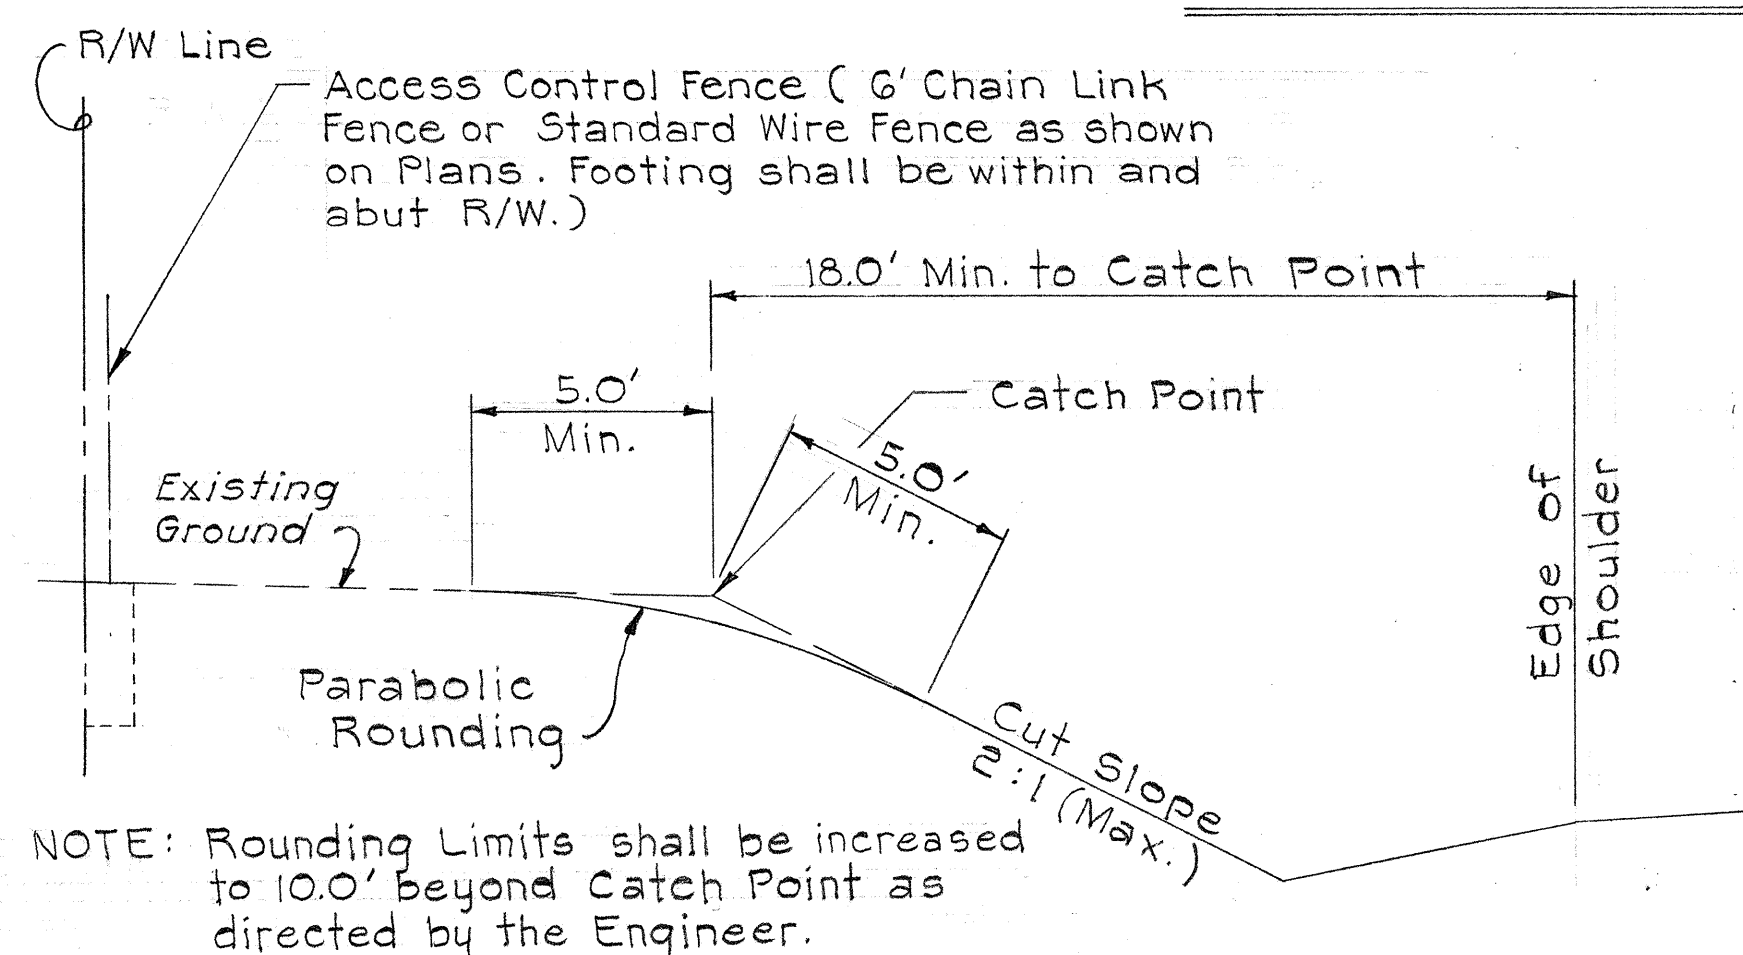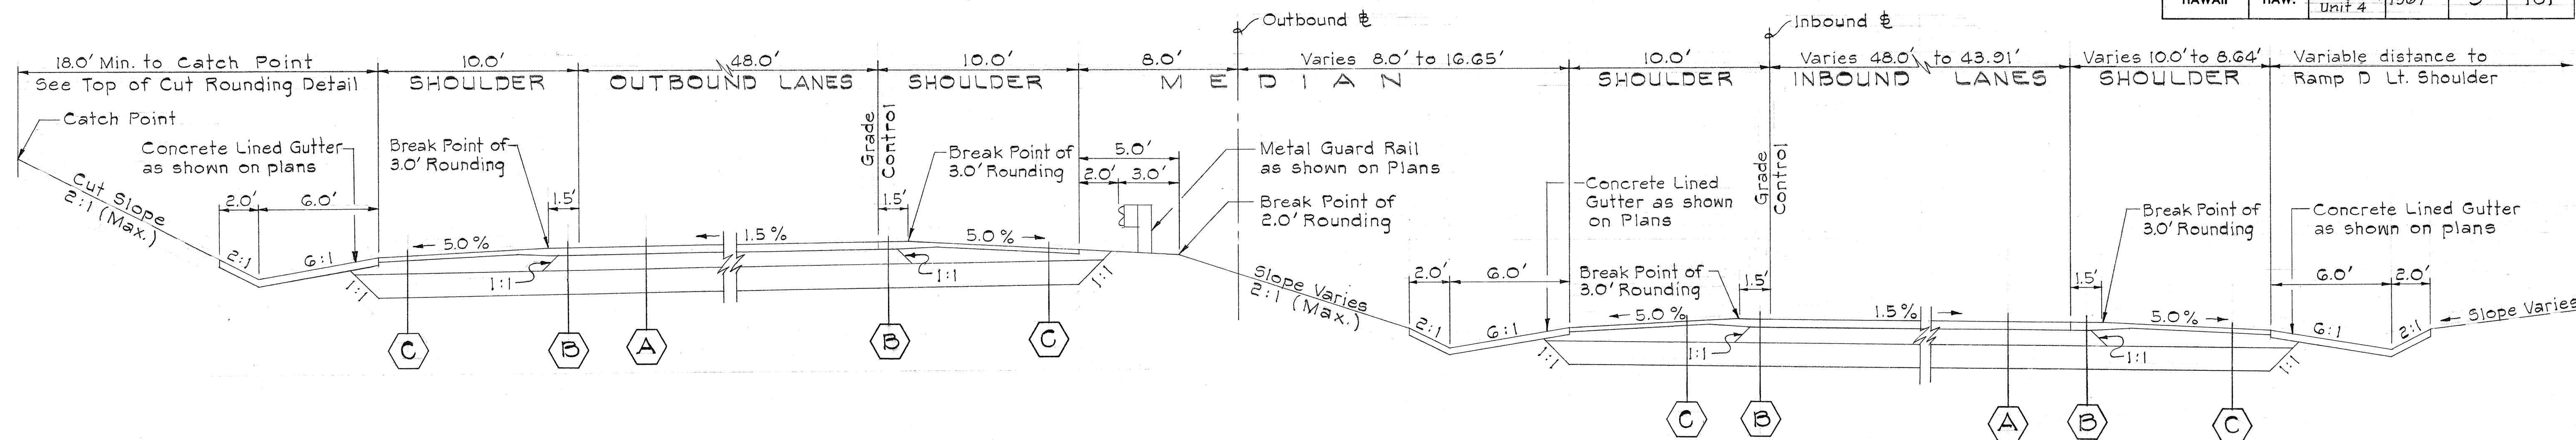

NOTE :
For General Typical Section
Notes and Details (A), (B), (C)
and (E) see Sheet Nos. 2 & 5

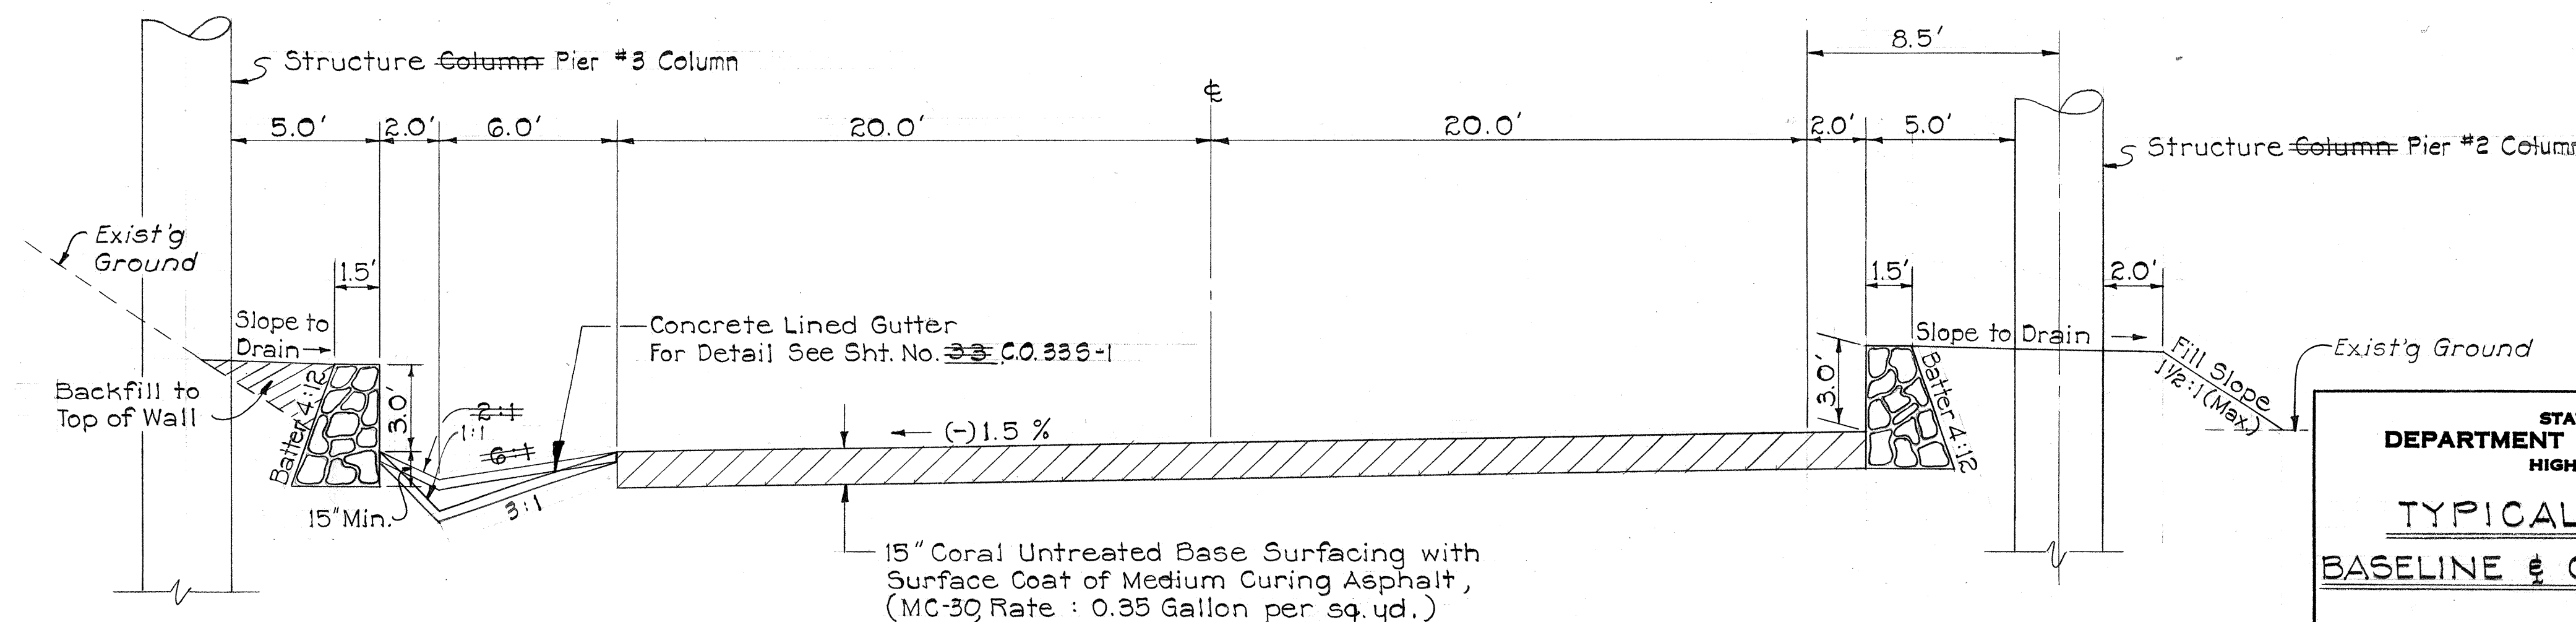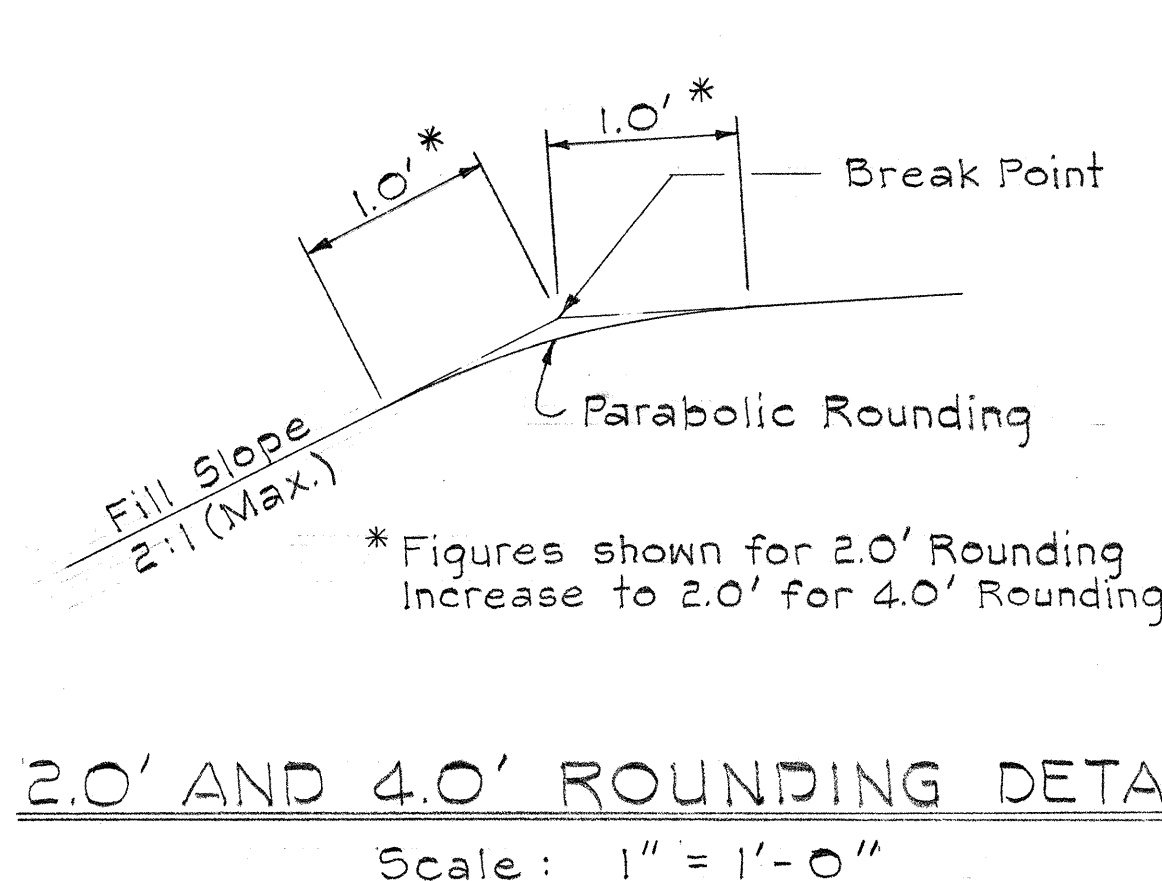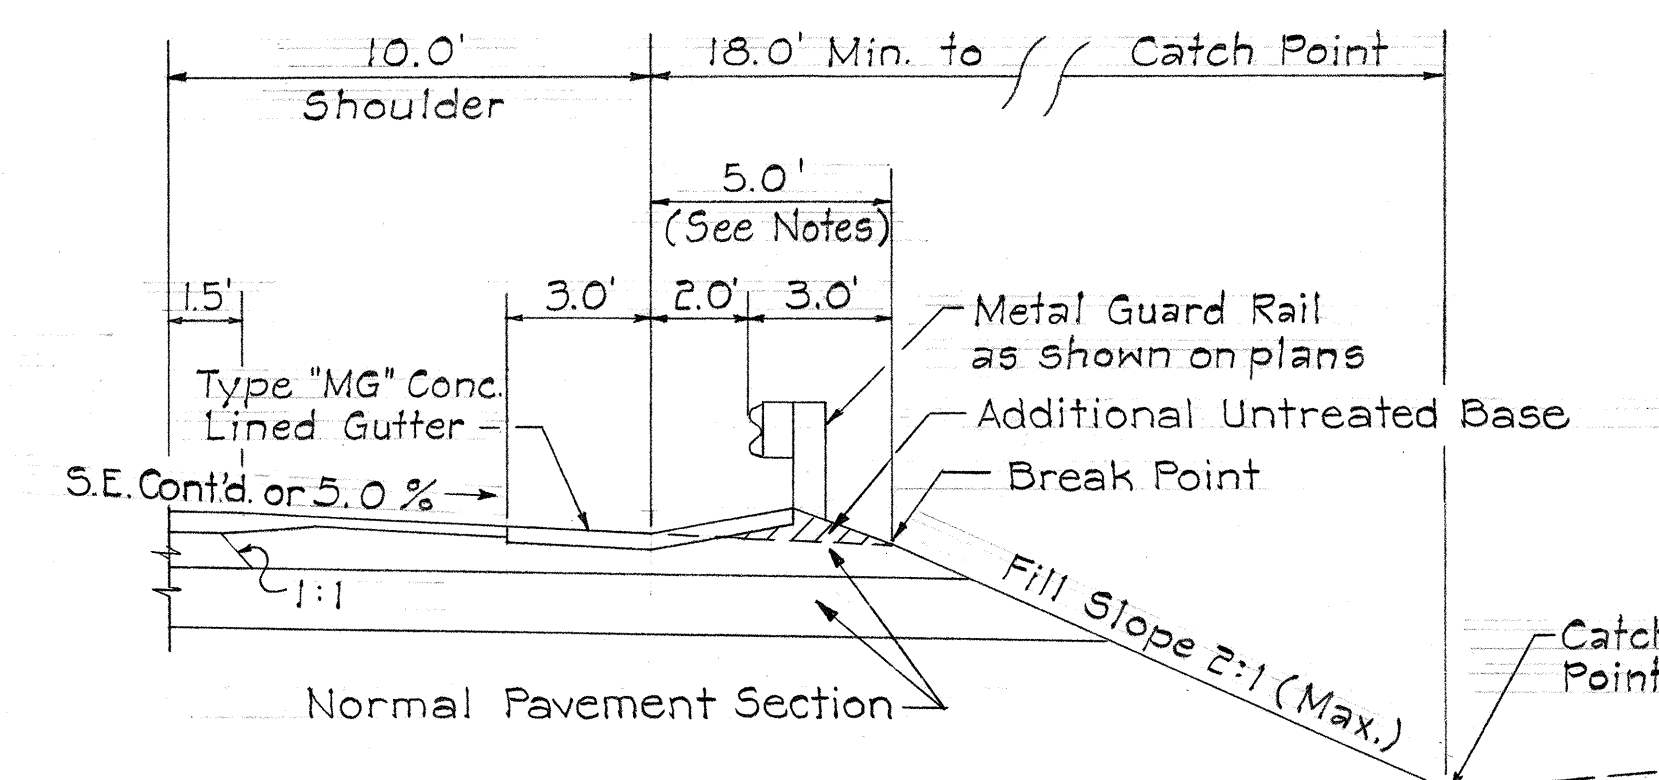

STATE OF HAWAII
DEPARTMENT OF TRANSPORTATION
HIGHWAYS DIVISION

TYPICAL SECTIONS

BASELINE & CANE HAUL ROAD


INTERSTATE ROUTE H-1
F.A.I. Proj. No. I-HI-1(32):5, Unit 4

Scale : As Noted Date : Dec., 1967

SHEET No. 2 OF 4 SHEETS


ORIGINAL PLAN	SURVEY PLOTTED BY _____ DATE _____
NOTE BOOK	DRAWN BY _____
	TRACED BY _____
	DESIGNED BY _____
	QUANTITIES BY _____
No. _____	CHECKED BY _____

FED. ROAD DIST. NO.	STATE	FED. AID PROJ. NO.	FISCAL YEAR	SHEET NO.	TOTAL SHEETS
HAWAII	HAW.	I-HI-1(32):5, Unit 4	1967	4	101

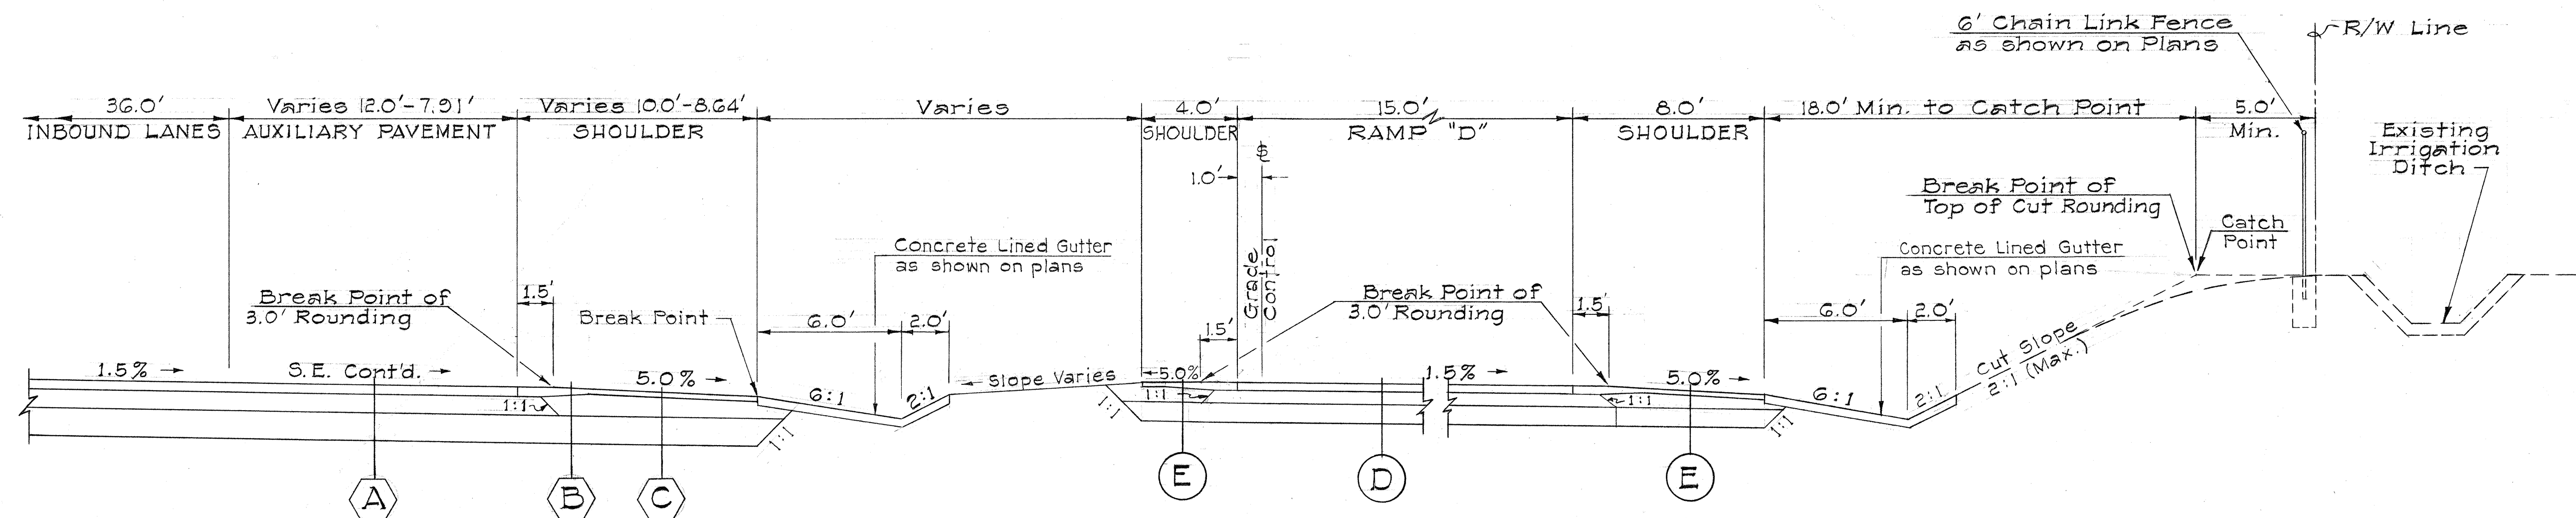


TYPICAL TANGENT SECTION IN CUT

Scale: 1/4" = 1'-0"

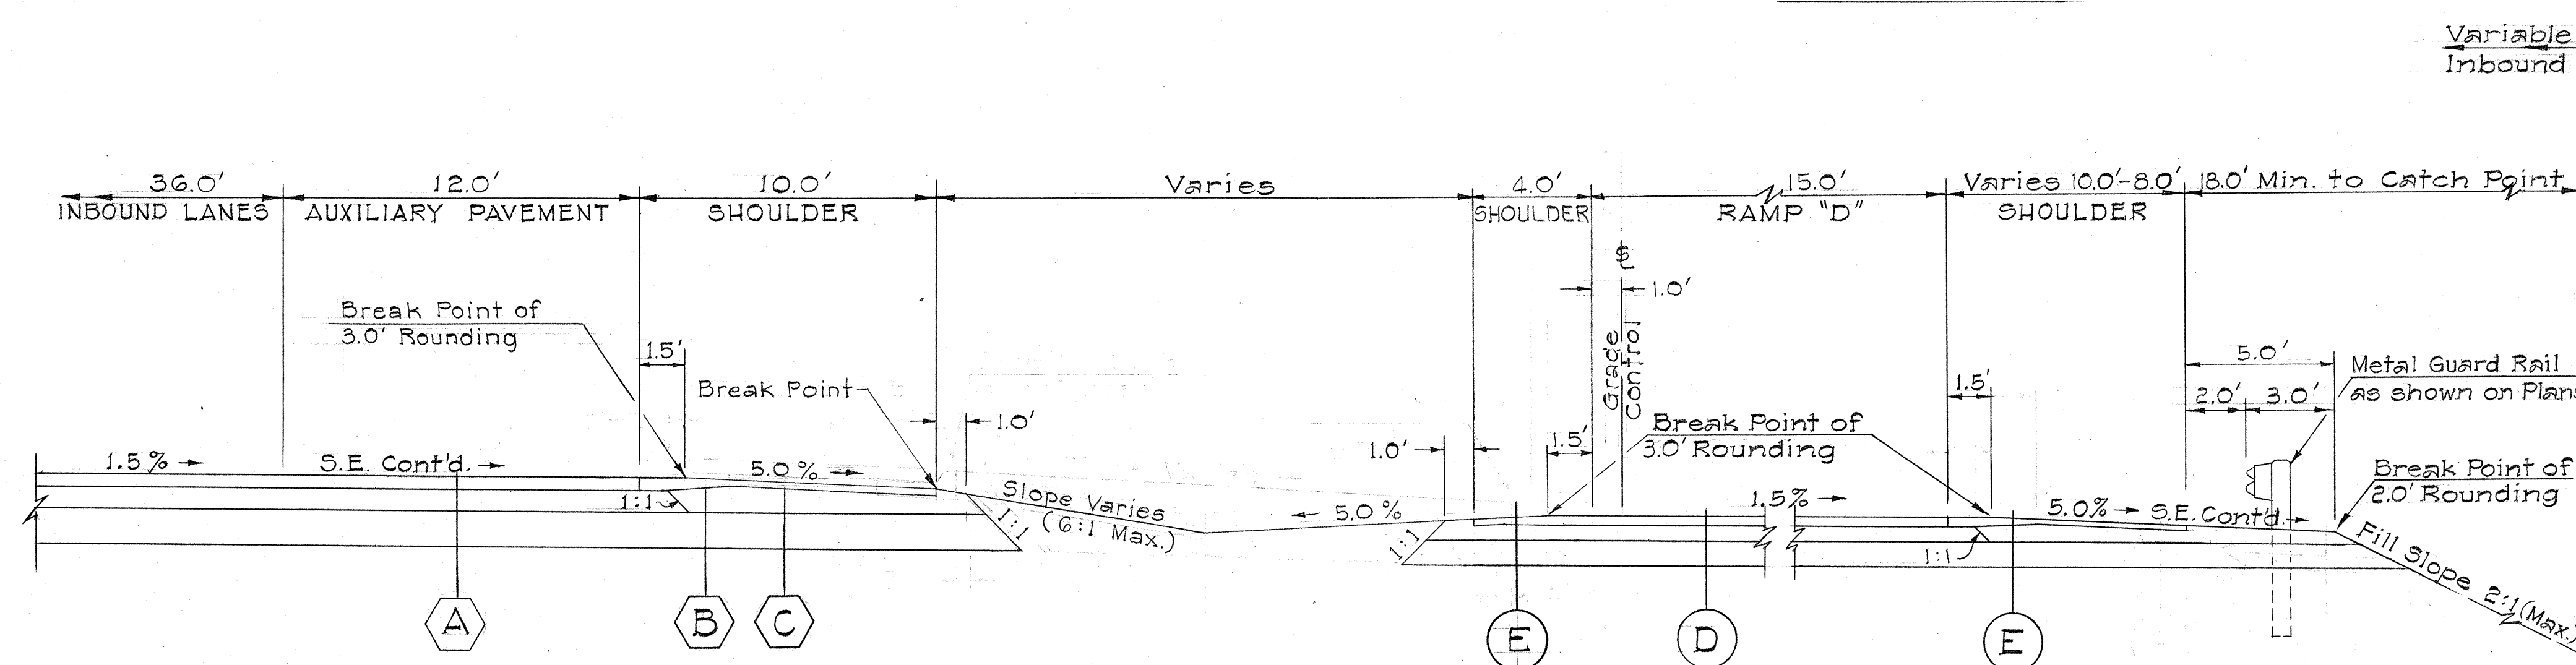


TYPICAL TANGENT SECTION IN FILL

Scale: 1/4" = 1'-0"

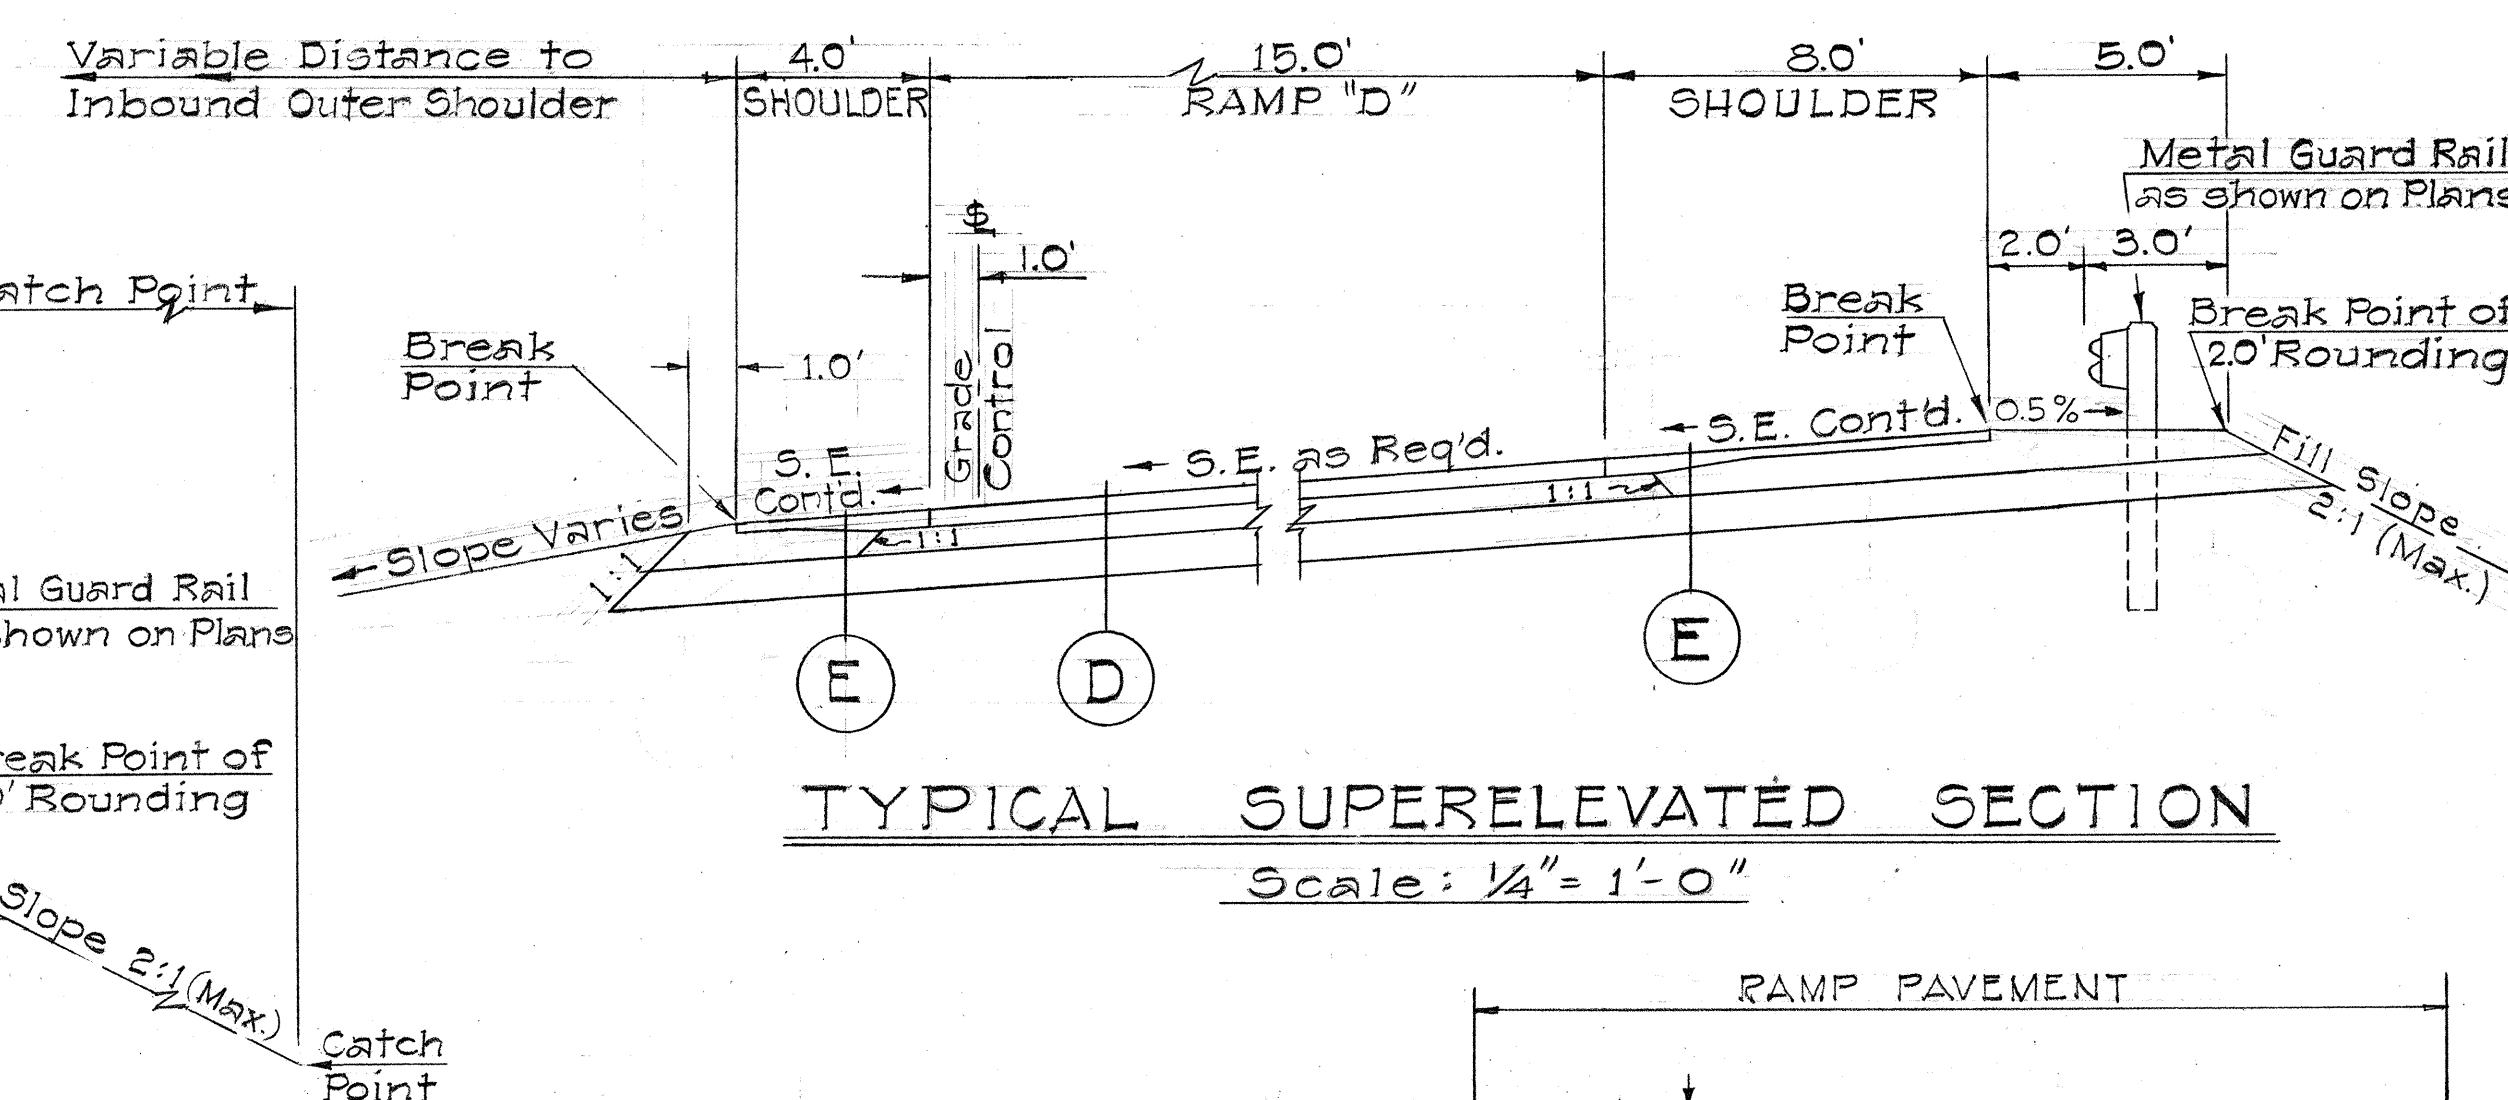

TYPICAL SUPERELEVATED SECTION


Scale: 1/4" = 1'-0"

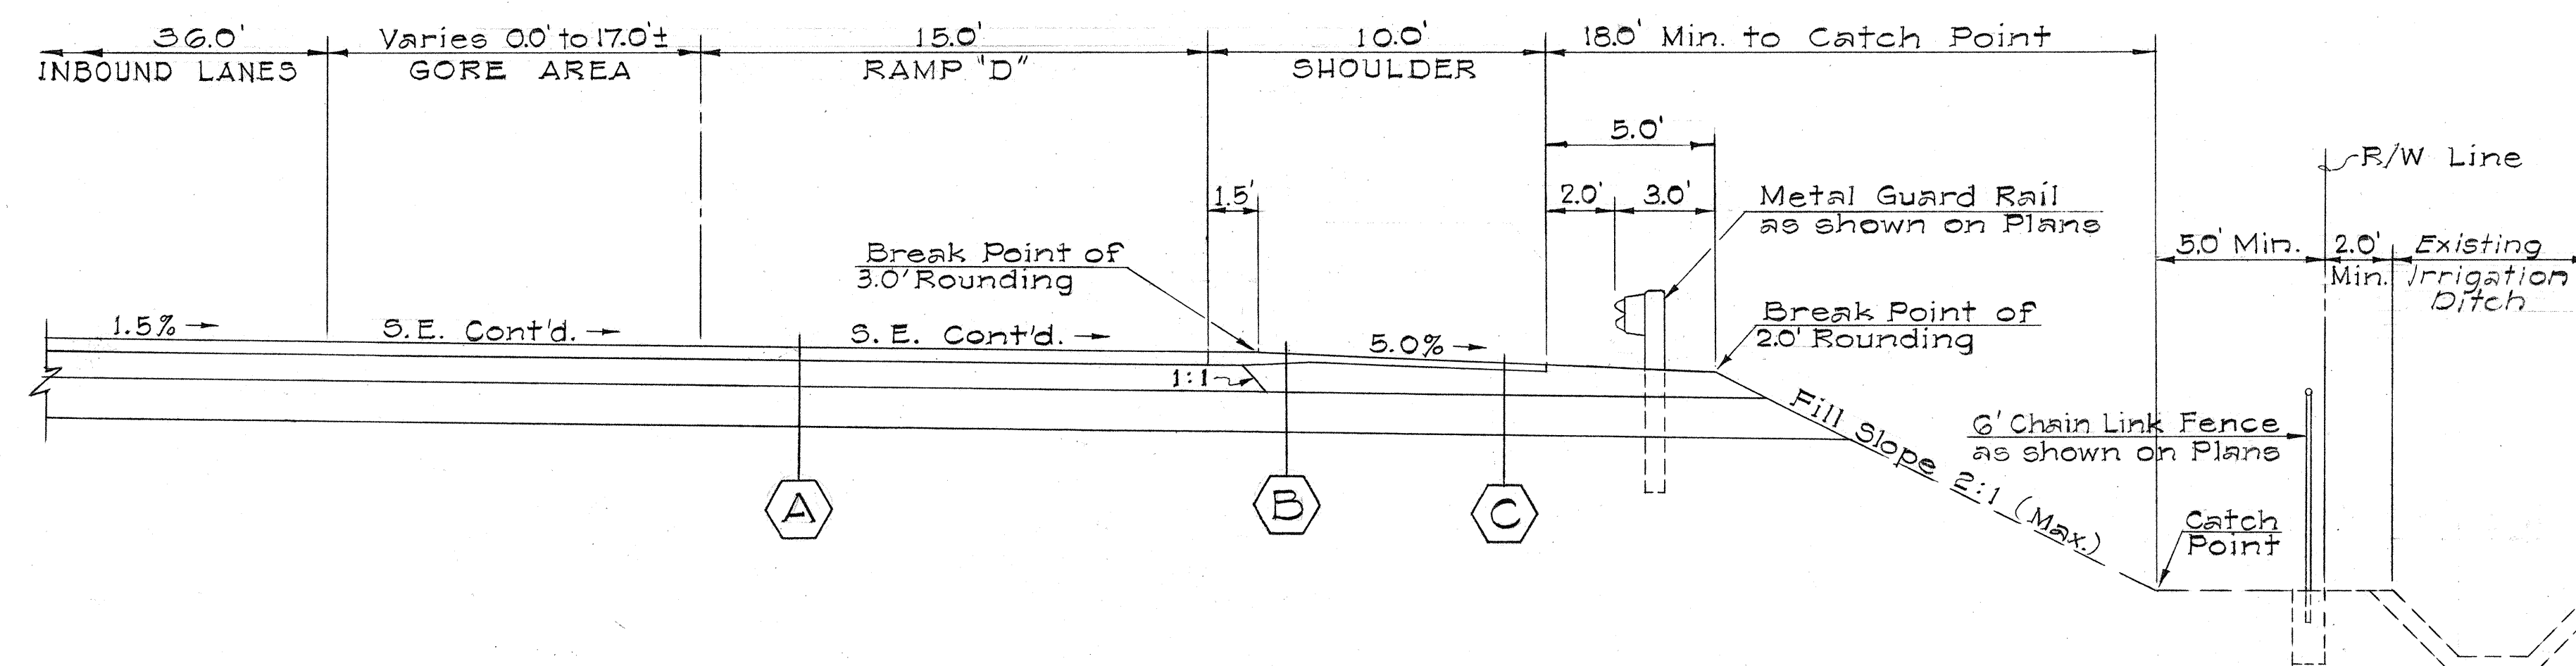

SECTION VICINITY OF STA. 458 ± (INBOUND)


Scale: 1/4" = 1'-0"

NOTE:
For General Typical Section
Notes and Details (A), (B) and (C)
see Sheet Nos. 2 & 5.

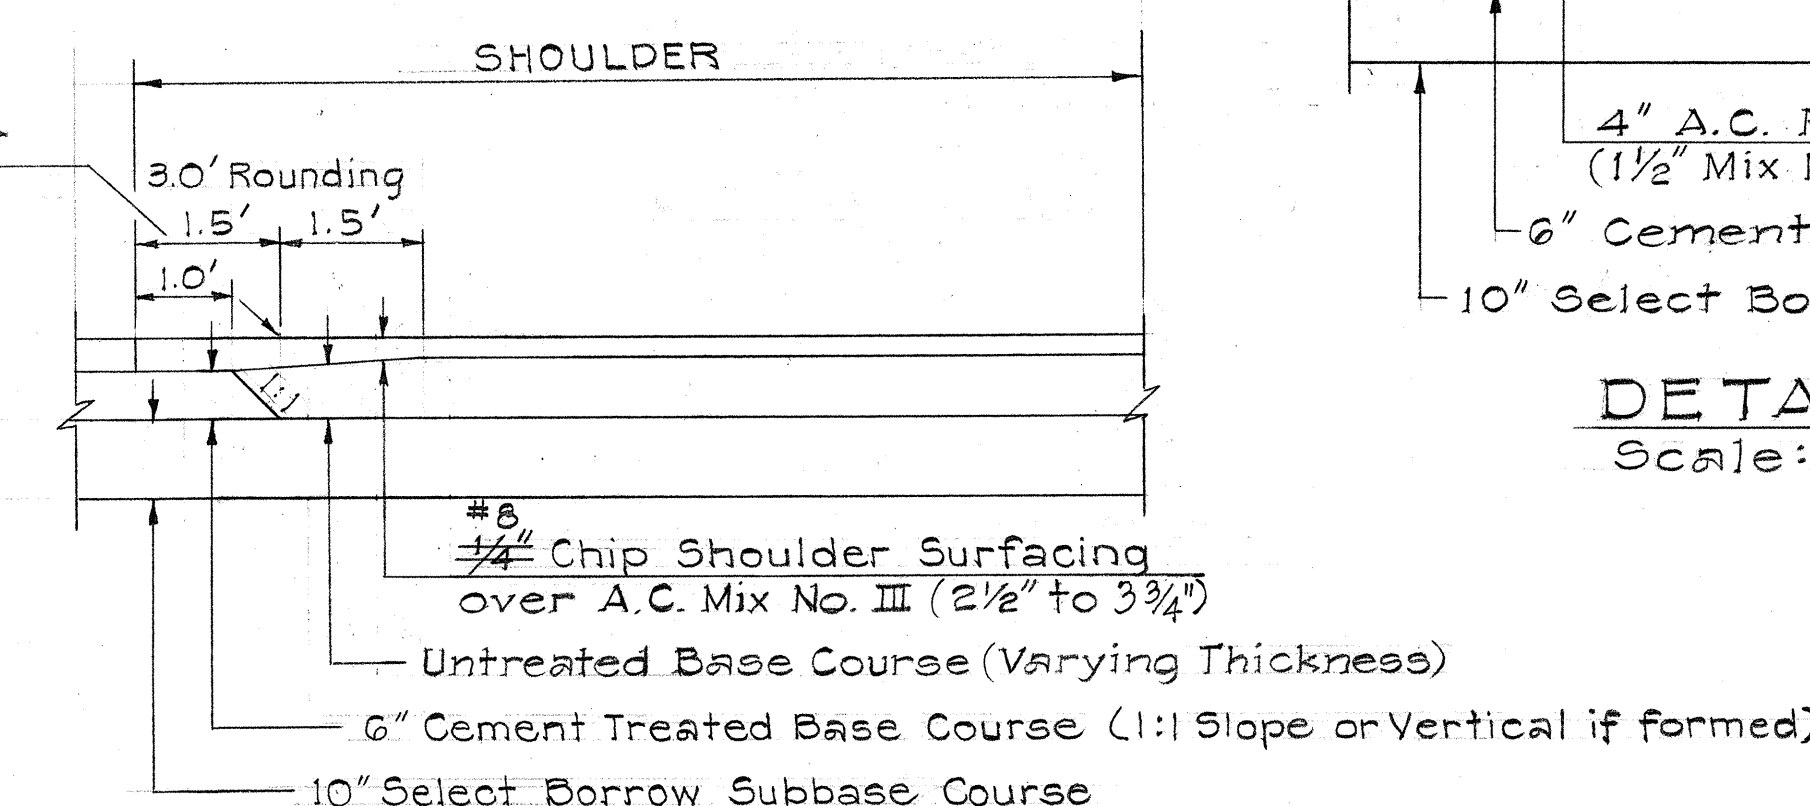

DETAIL (D)

Scale: 1/2" = 1'-0"

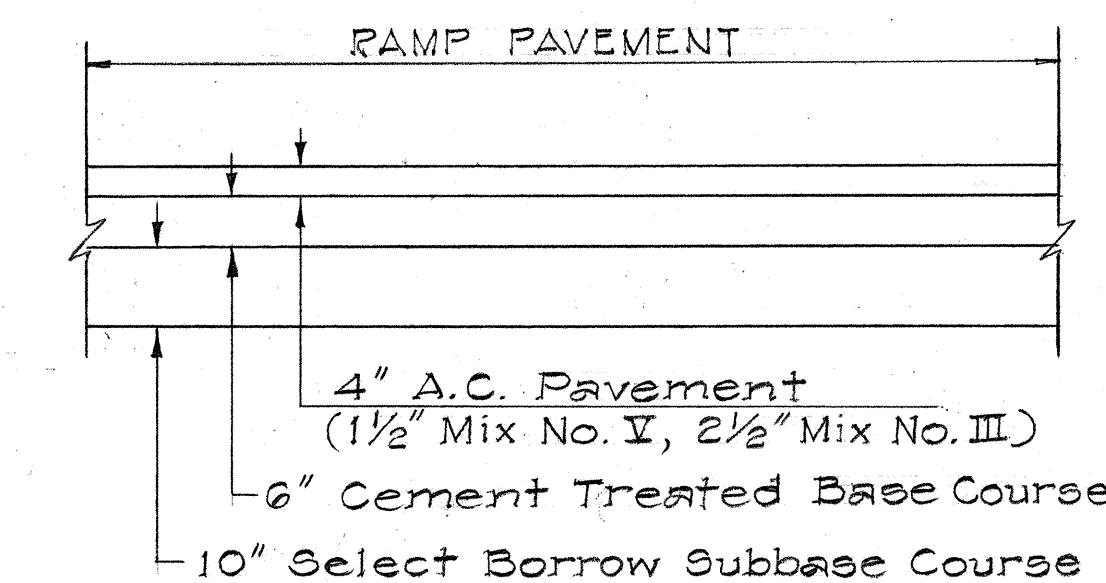


DETAIL (E)

Scale: 1/2" = 1'-0"


STATE OF HAWAII
DEPARTMENT OF TRANSPORTATION
HIGHWAYS DIVISION
**TYPICAL SECTIONS
RAMP "D"
AND ADJACENT LANES**
INTERSTATE ROUTE H-1
F.A.I. Proj. No. I-HI-1(32):5, Unit 4
Scale: As Noted Date: Nov., 1967
SHEET No. 3 OF 4 SHEETS

DATE	DESIGNED BY	CHECKED BY
PLANNED BY	NOTED BY	QUANTITIES BY
ORIGINAL	PLAN	NOTE BOOK
NO.		


FED. ROAD DIST. NO.	STATE	FED. AID PROJ. NO.	FISCAL YEAR	SHEET NO.	TOTAL SHEETS
HAWAII	HAW.	I-HI-1(32):5, Unit 4	1967	5	101

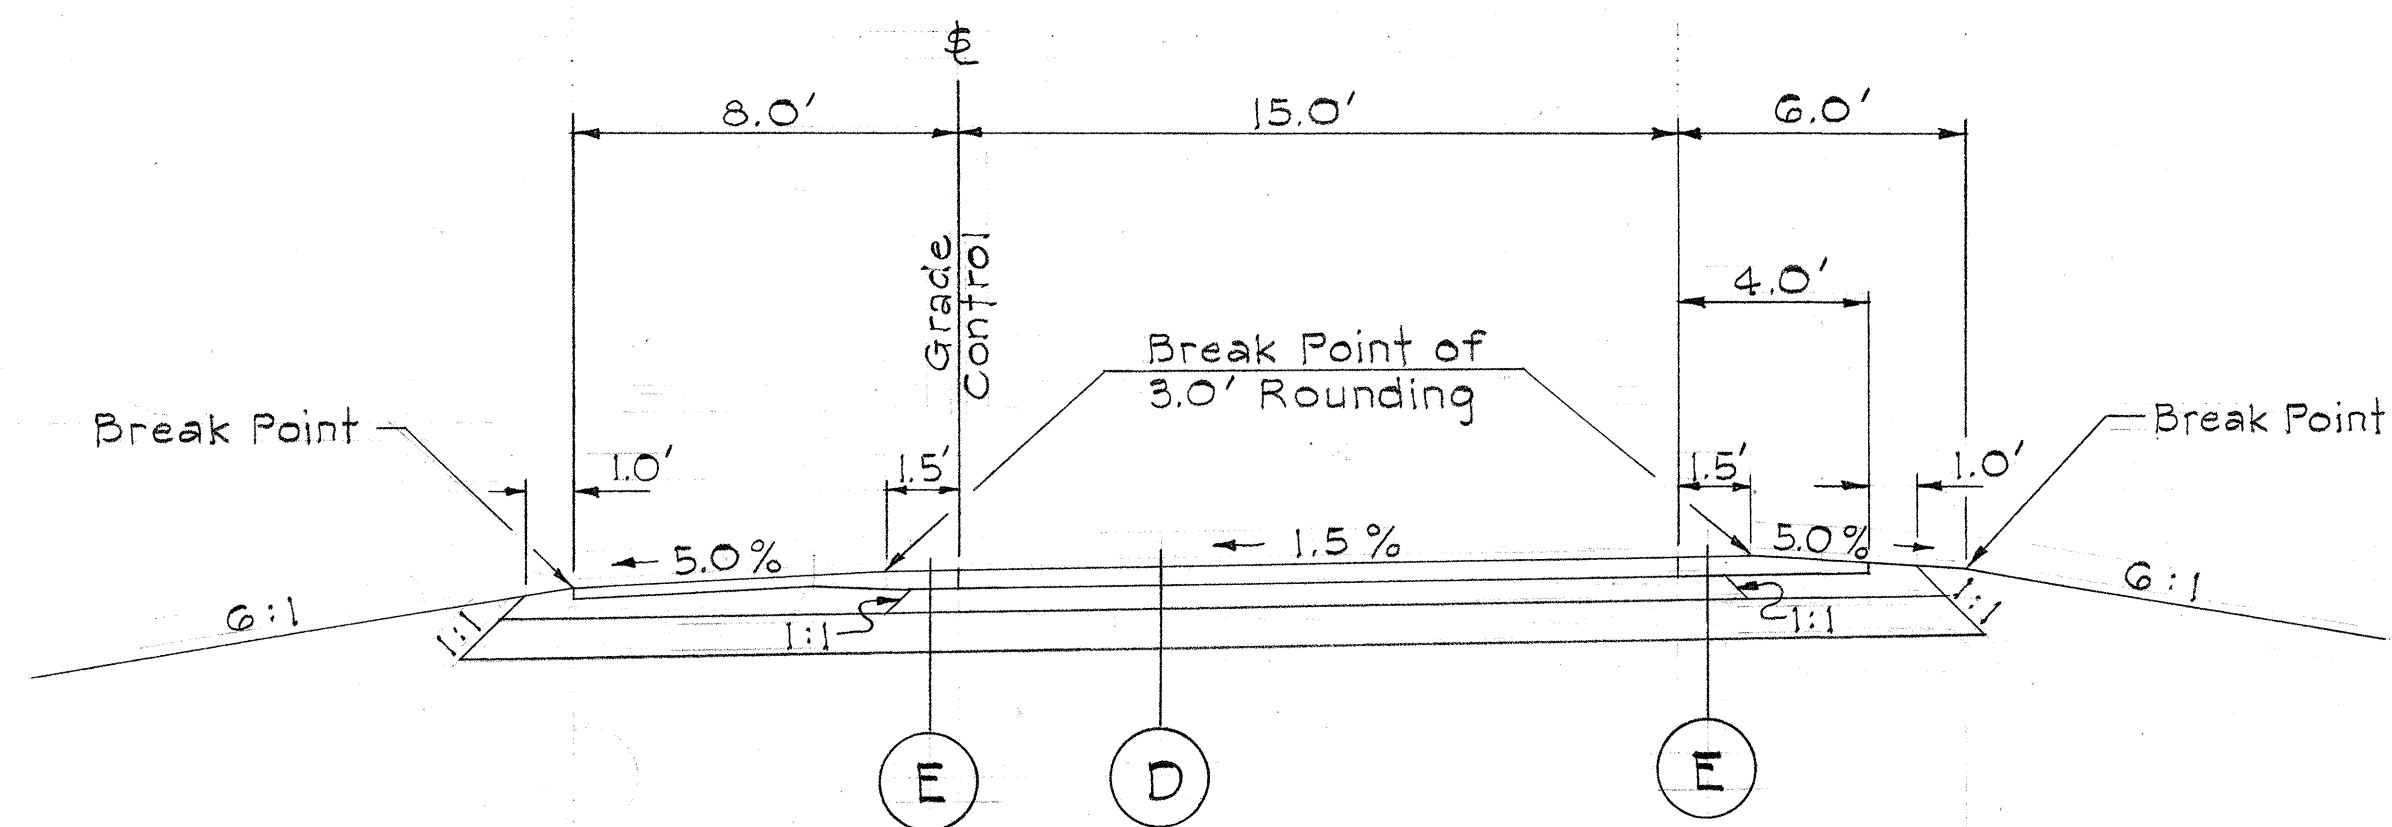


RAMP (KO)
Scale: 1/4" = 1'-0"

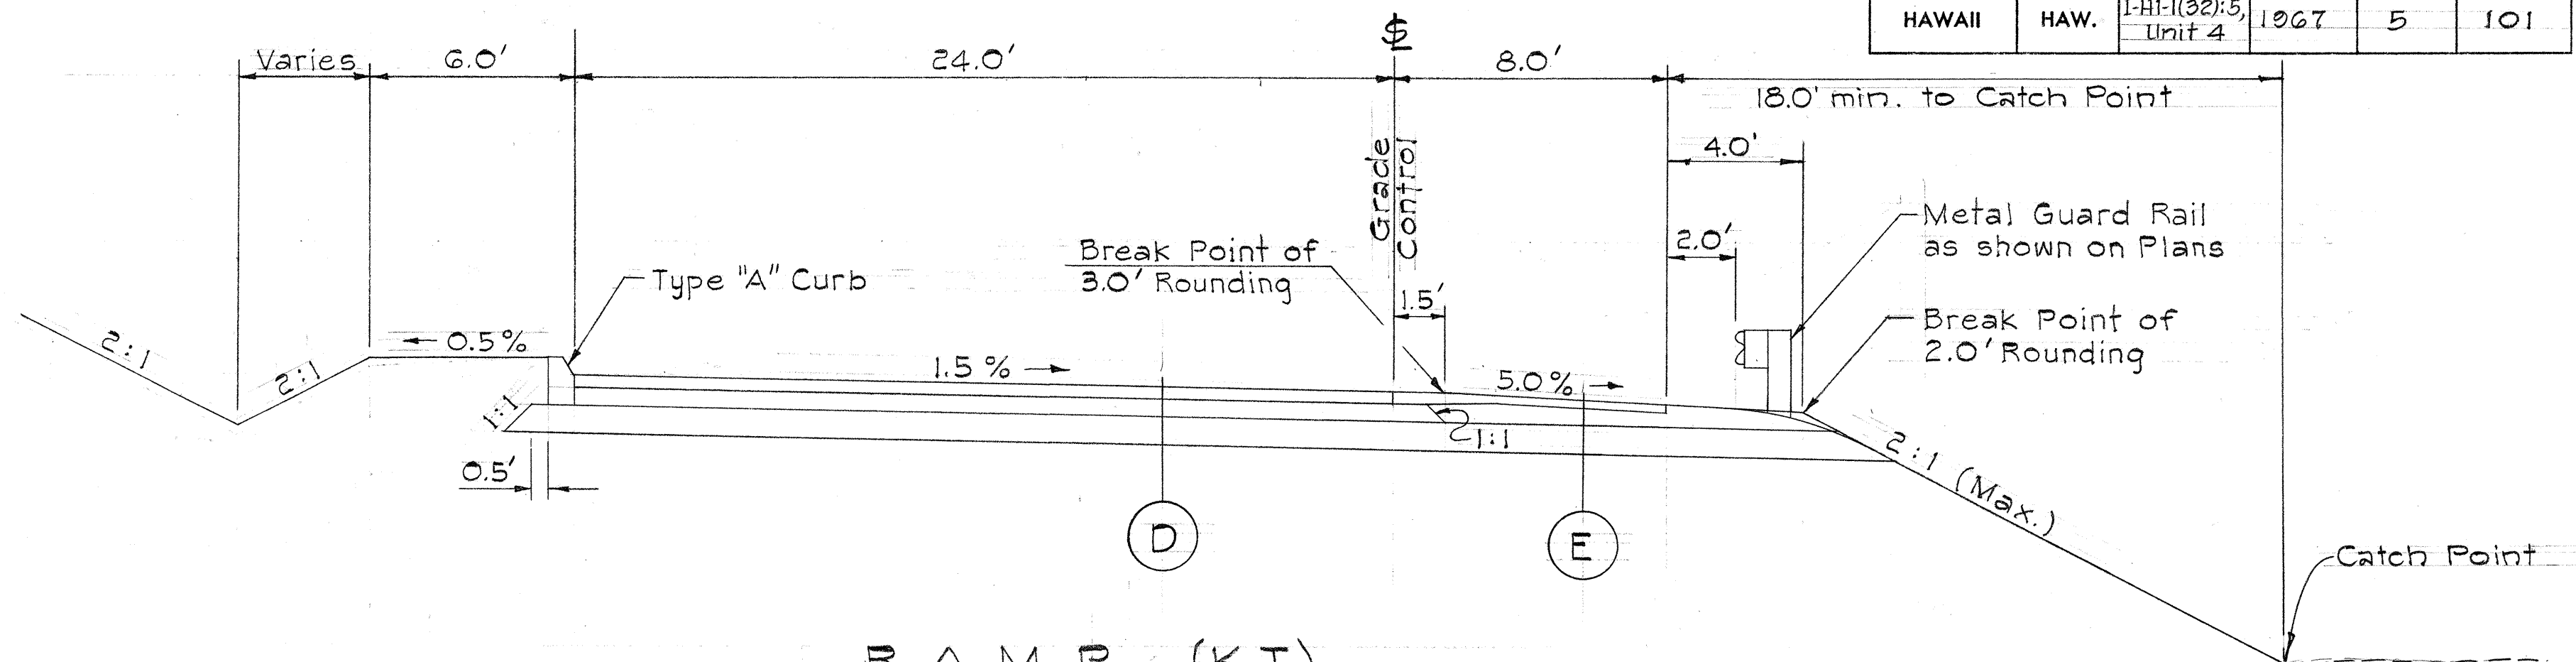

RAMP (KI)
VICINITY OF STA. 13+00± TO STA. 15+00±
Scale: 1/4" = 1'-0"

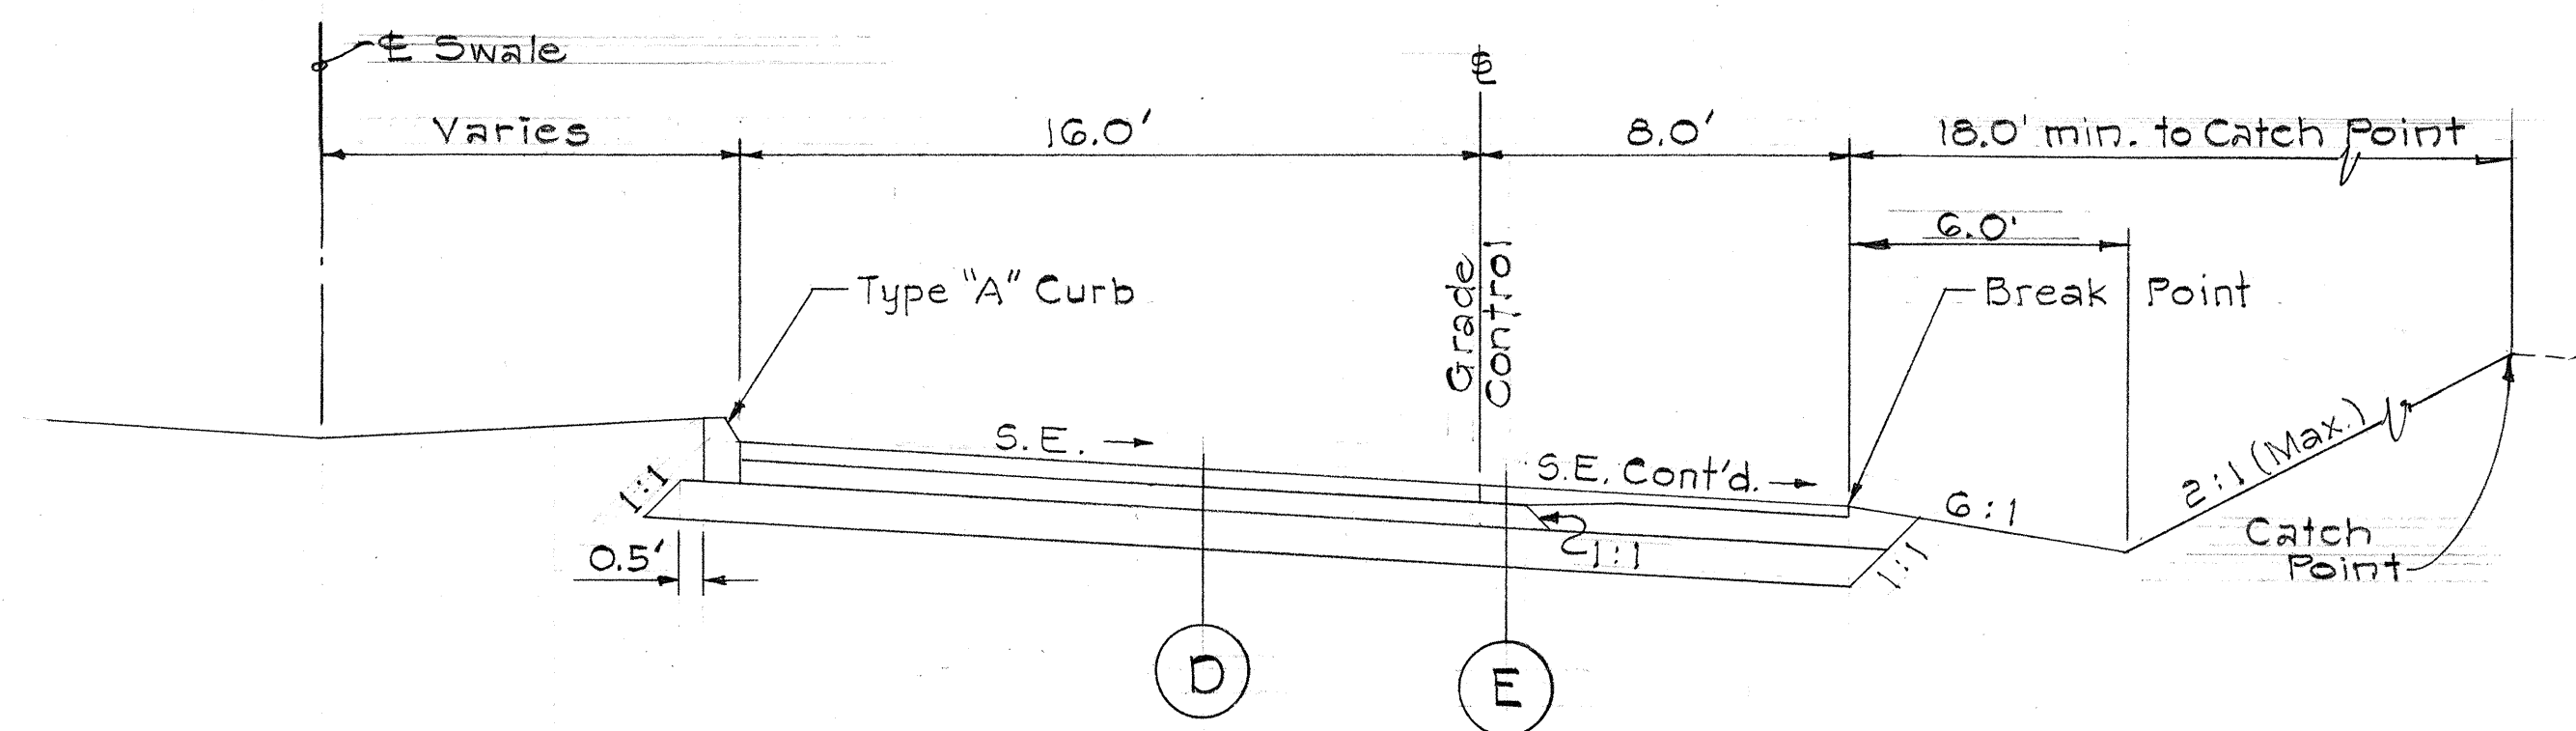

RAMP (KI)
VICINITY OF STA. 4+00± TO STA. 8+00±
Scale: 1/4" = 1'-0"

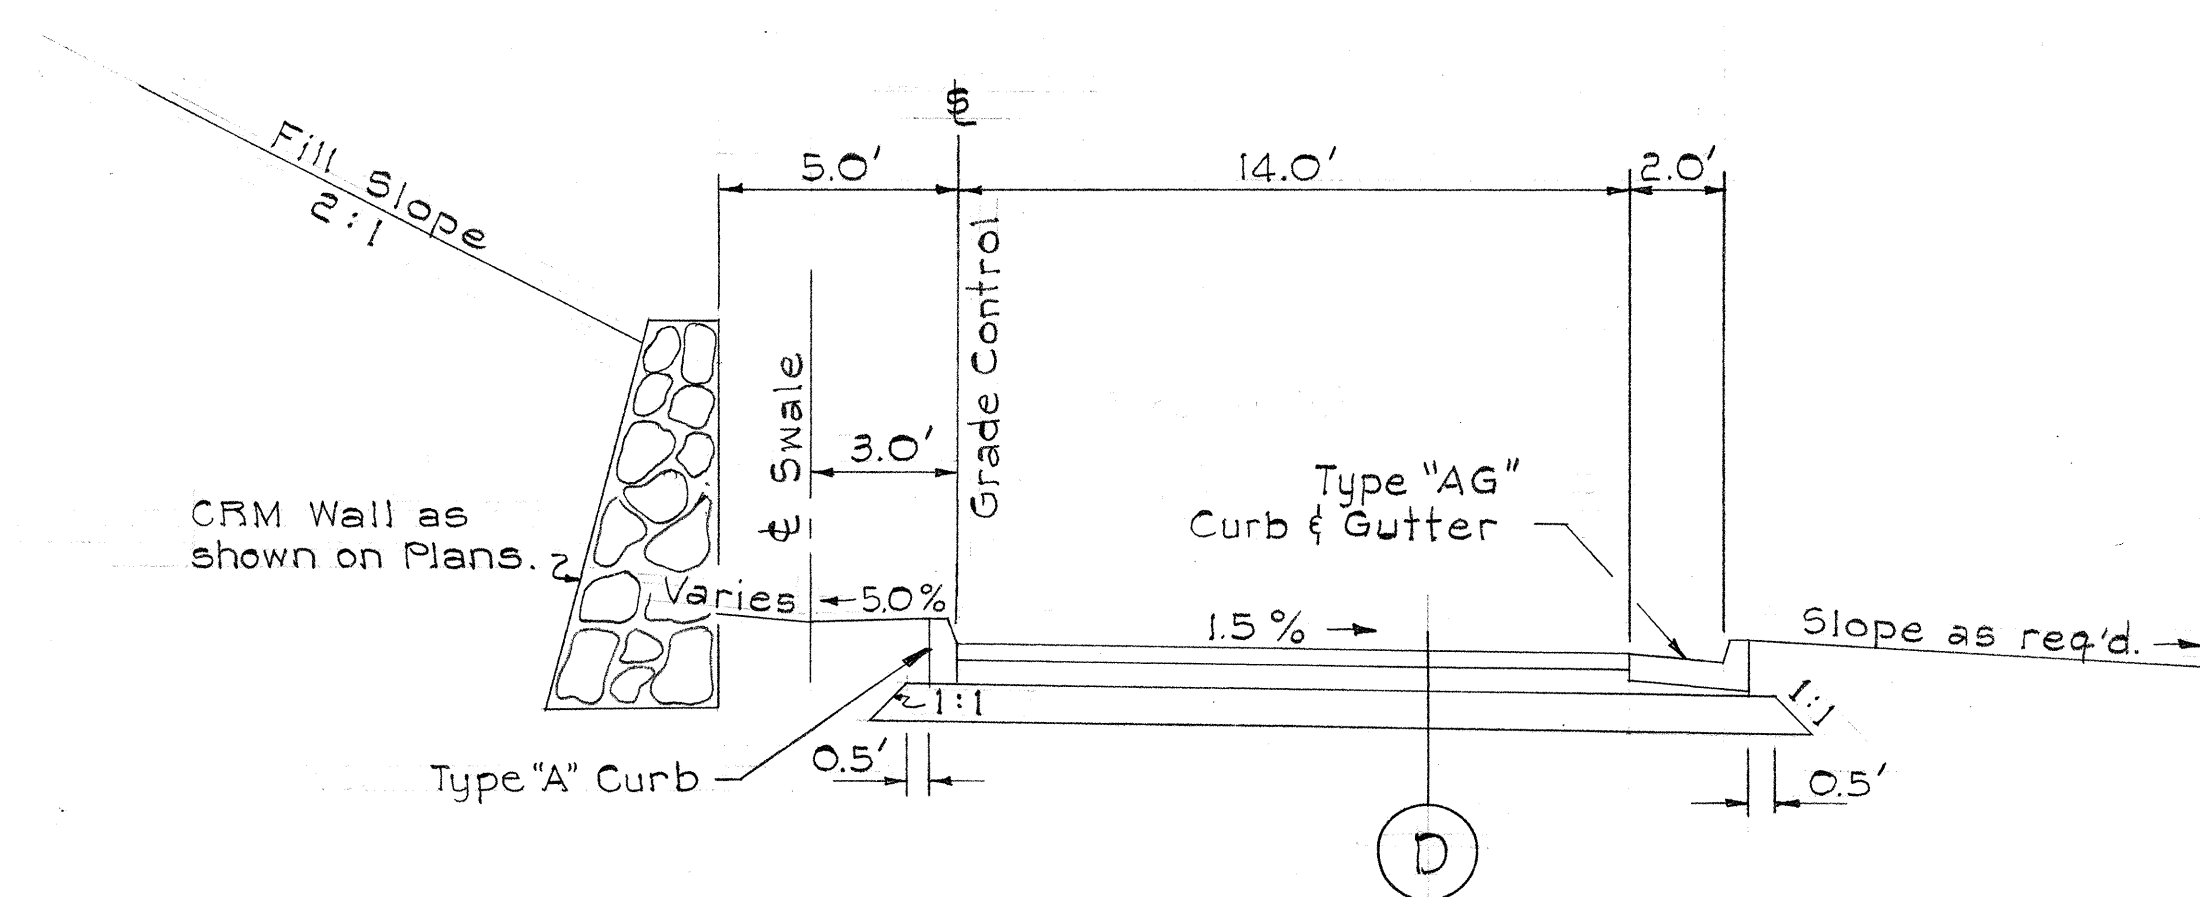

RAMP (KI-A)
Scale: 1/4" = 1'-0"

GENERAL TYPICAL SECTION NOTES

- Portion of the roadway prism has been constructed or is presently being constructed under a separate contract. Cross Sections are not shown where the roadway prism is approximately at the subbase course level for fill sections and at the finish pavement level for cut sections. However, fill sections may require some corrective grading and cut sections will require excavation to subbase course level.
- Sections shown as Fill Section or Cut Sections apply on both sides of the Baseline, as the actual case may be. Refer to the Cross Sections for actual cut or fill slopes and limits.
- Top Limit of Roadway Prism at Fill Section :
 - 4.0' beyond 10.0' Shoulder from Beg. of Proj. to Waikale Stream Bridge.
 - 5.0' beyond 10.0' Shoulder from Waikale Stream Bridge to End of Proj.
 - Provide Additional widening for guard rail flares.
- See Plan Sheet No. 33 for "Type "MG" Concrete Lined Gutter" details.
- Cement Treated Base Course edges may be vertical instead of 1:1 slope if sides are formed.
- Two types of Access Control Fencing are used on this project :
 - 6' Chain Link Fence.
 - 4.5' Standard Wire Fence. See Plans for type and layout.
- Unless noted otherwise, Guard Rail face shall be offset 2.0' from shoulder outer edge.
- See Plan Sheet No. 25 for "Guard Rail End Protective Mound Detail."

NOTE :
For Details ① and ②
see Sheet No. 4.

STATE OF HAWAII
DEPARTMENT OF TRANSPORTATION
HIGHWAYS DIVISION

TYPICAL SECTIONS
RAMPS

INTERSTATE ROUTE H-1
F.A.I. Proj. No. I-HI-1(32):5, Unit 4
Scale: As Noted Date: Dec., 1967

SHEET No. 4 OF 4 SHEETS

SURVEY PLATTED BY	DATE
DRAWN BY	
CHECKED BY	
NOTE BOOK	
NO.	