

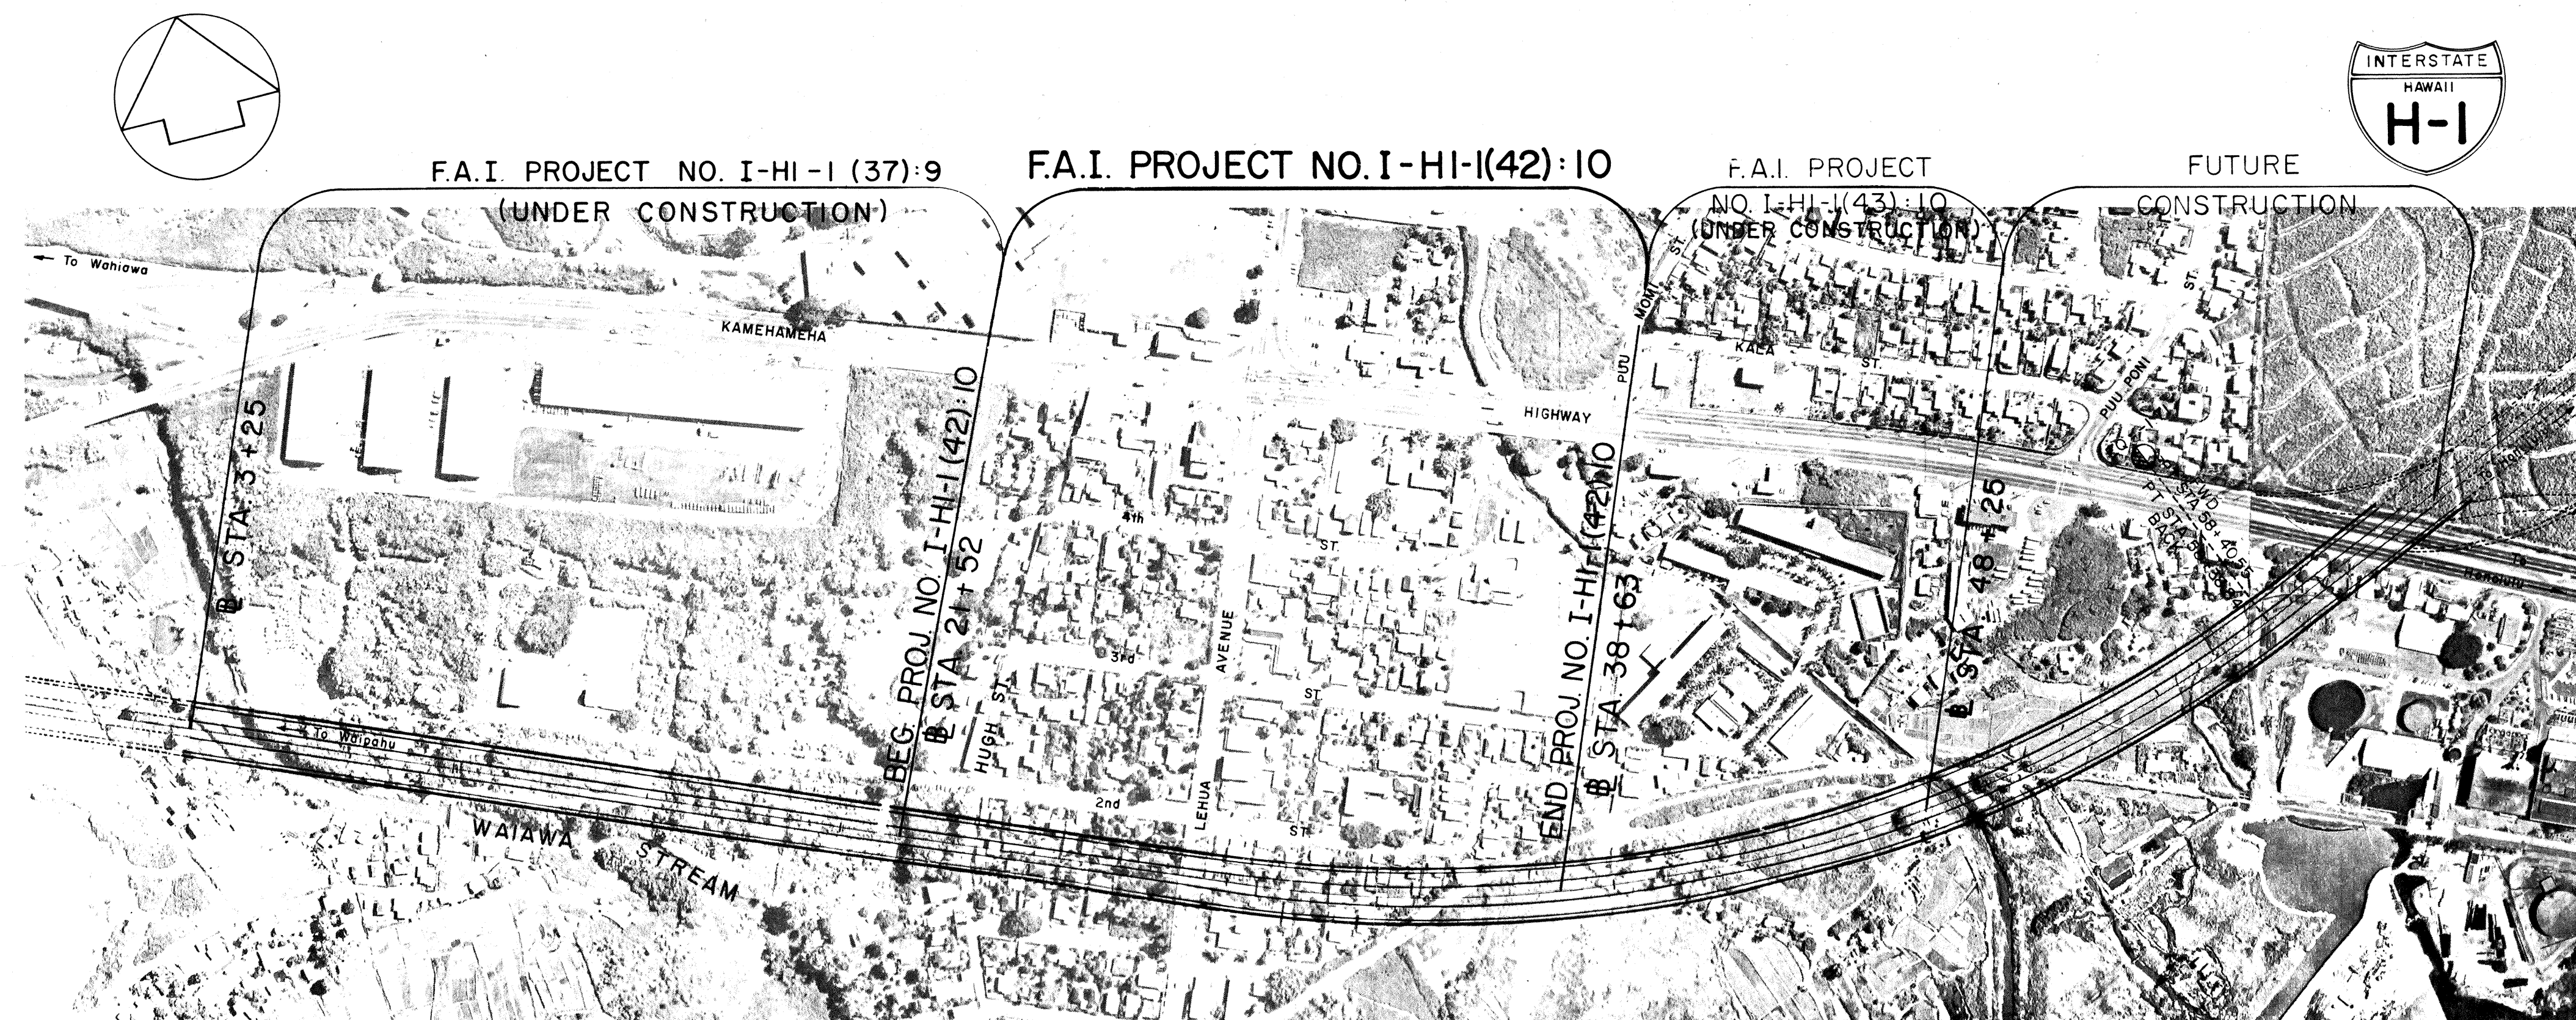
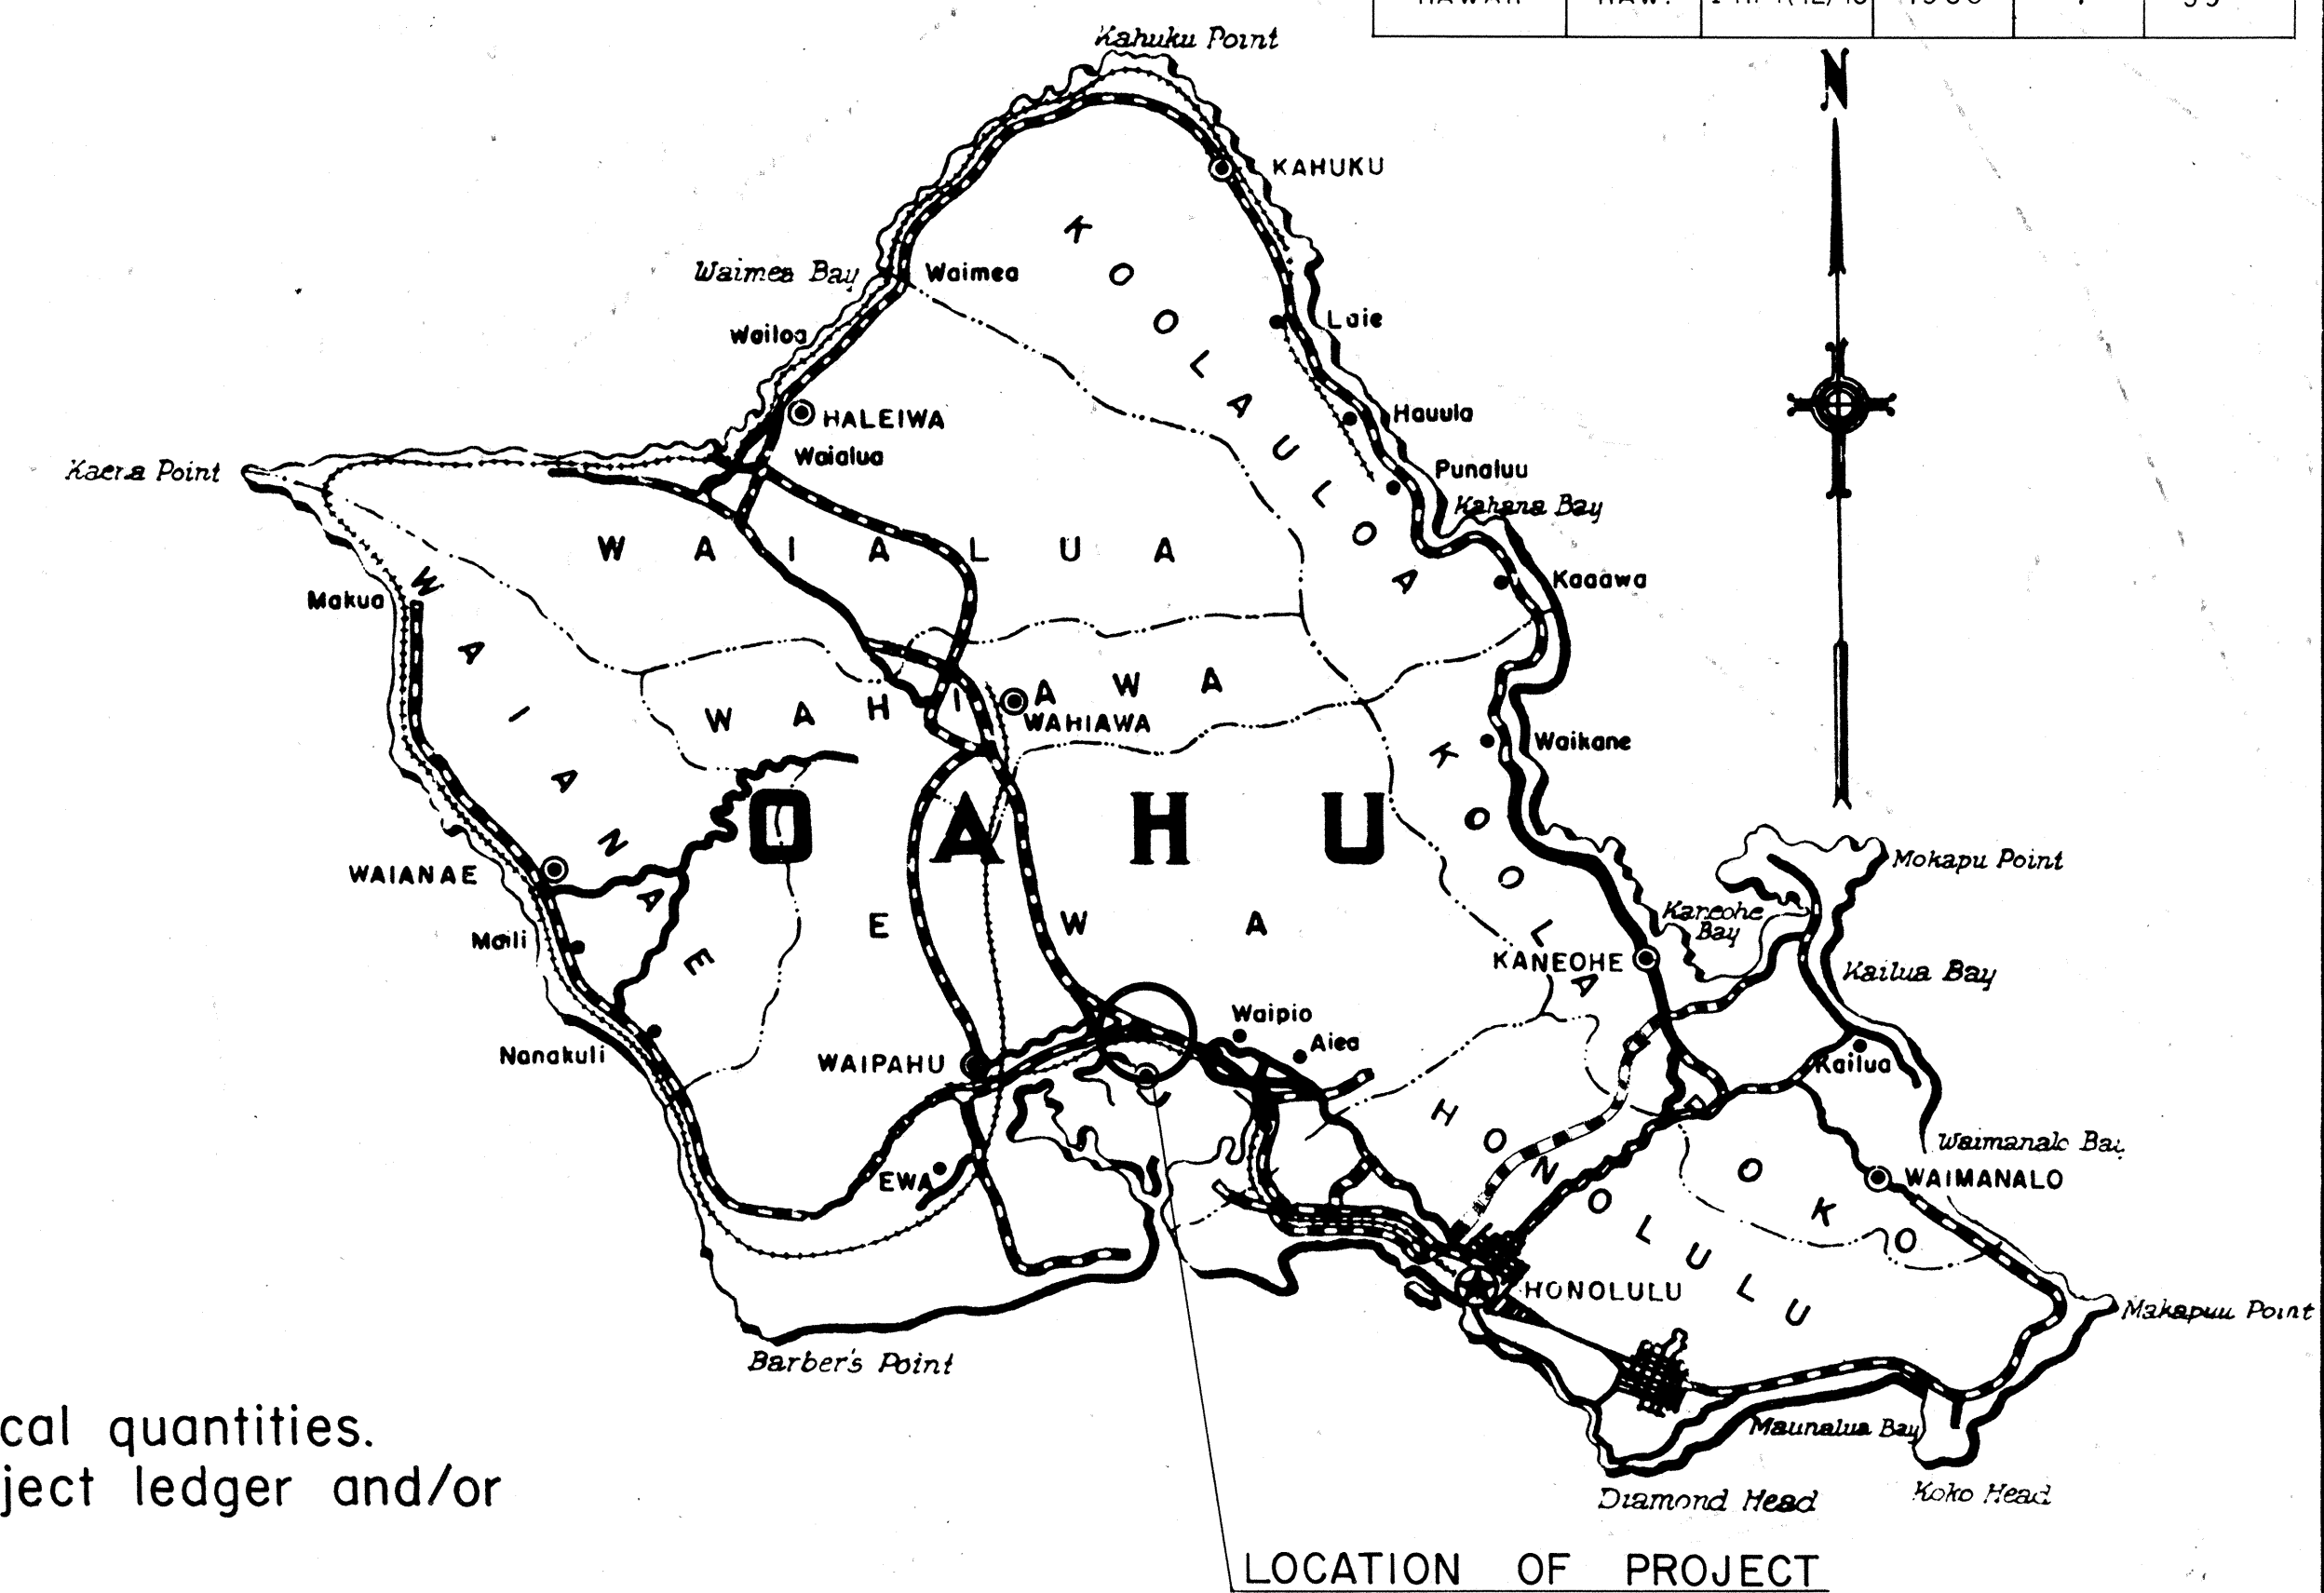
INDEX TO DRAWINGS	
SHT. NO.	DESCRIPTION
1	TITLE SHEET
2-3	PLAN AND PROFILE
4-5	DETAIL PLAN OF ROADWAY
6	HUGH STREET REALIGNMENT
7-11	MISC. AND STANDARD DETAILS
12-42	PEARL CITY VIADUCT
43	PROPOSED GENERATOR ROOM FOR PEARL CITY FIRE STATION
44-54	ACCESS ROAD AND UTILITIES
55-56	UTILITIES : SEWER
57-58	LIGHTING PLAN AND DETAILS
59	SANITARY SEWER PROTECTIVE CONCRETE COVERING

STATE OF HAWAII
DEPARTMENT OF TRANSPORTATION
HIGHWAYS DIVISION
HONOLULU, HAWAII
"AS BUILT" PLANS OF
INTERSTATE ROUTE H-1
WAIAWA STREAM TO WEST OF WAI'AU INTERCHANGE
(HUGH STREET TO $\pm 38+63$)
FEDERAL AID INTERSTATE PROJECT NO. I-HI-1(42):10
DISTRICT OF EWA
ISLAND OF OAHU

SCALES

PLAN -----	1 INCH = 100 FT.
PROFILE -----	HOR. 1 INCH = 100 FT.
	VER. 1 INCH = 10 FT.

All quantities shown are theoretical quantities.
For actual quantities, refer to project ledger and/or
computation book..

Federal Aid Projects Previously Constructed Or Under Construction 

DESIGN CLASSIFICATION

ADT (1965)	0
ADT (1988)	80,900
D	65 35
DHV	10.5 %
T	4.0 %
T ₂₄	6.0 %
V	60 M.P.H.

NOTE:

ALL CHANGES MADE DURING CONSTRUCTION
HAVE BEEN NOTED IN RED ON THESE TRACINGS
AND CHECKED BY:

George J. Kato
PROJECT ENGINEER
Oct. 15, 1971
DATE

APPROVED: *John H Mc Carthy Jr* DATE *5/13/68*
 THE DIRECTOR OF TRANSPORTATION

DEPARTMENT OF TRANSPORTATION BUREAU OF PUBLIC ROADS	
APPROVED:	
<i>Paul P. Delaney</i> FOR DIVISION ENGINEER	<i>1-3-61</i> DATE

LENGTH OF PROJECT..... = 0.324 MILE
STRUCTURE..... = 0.324 MILE