
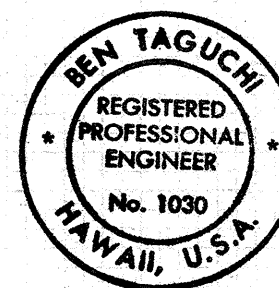
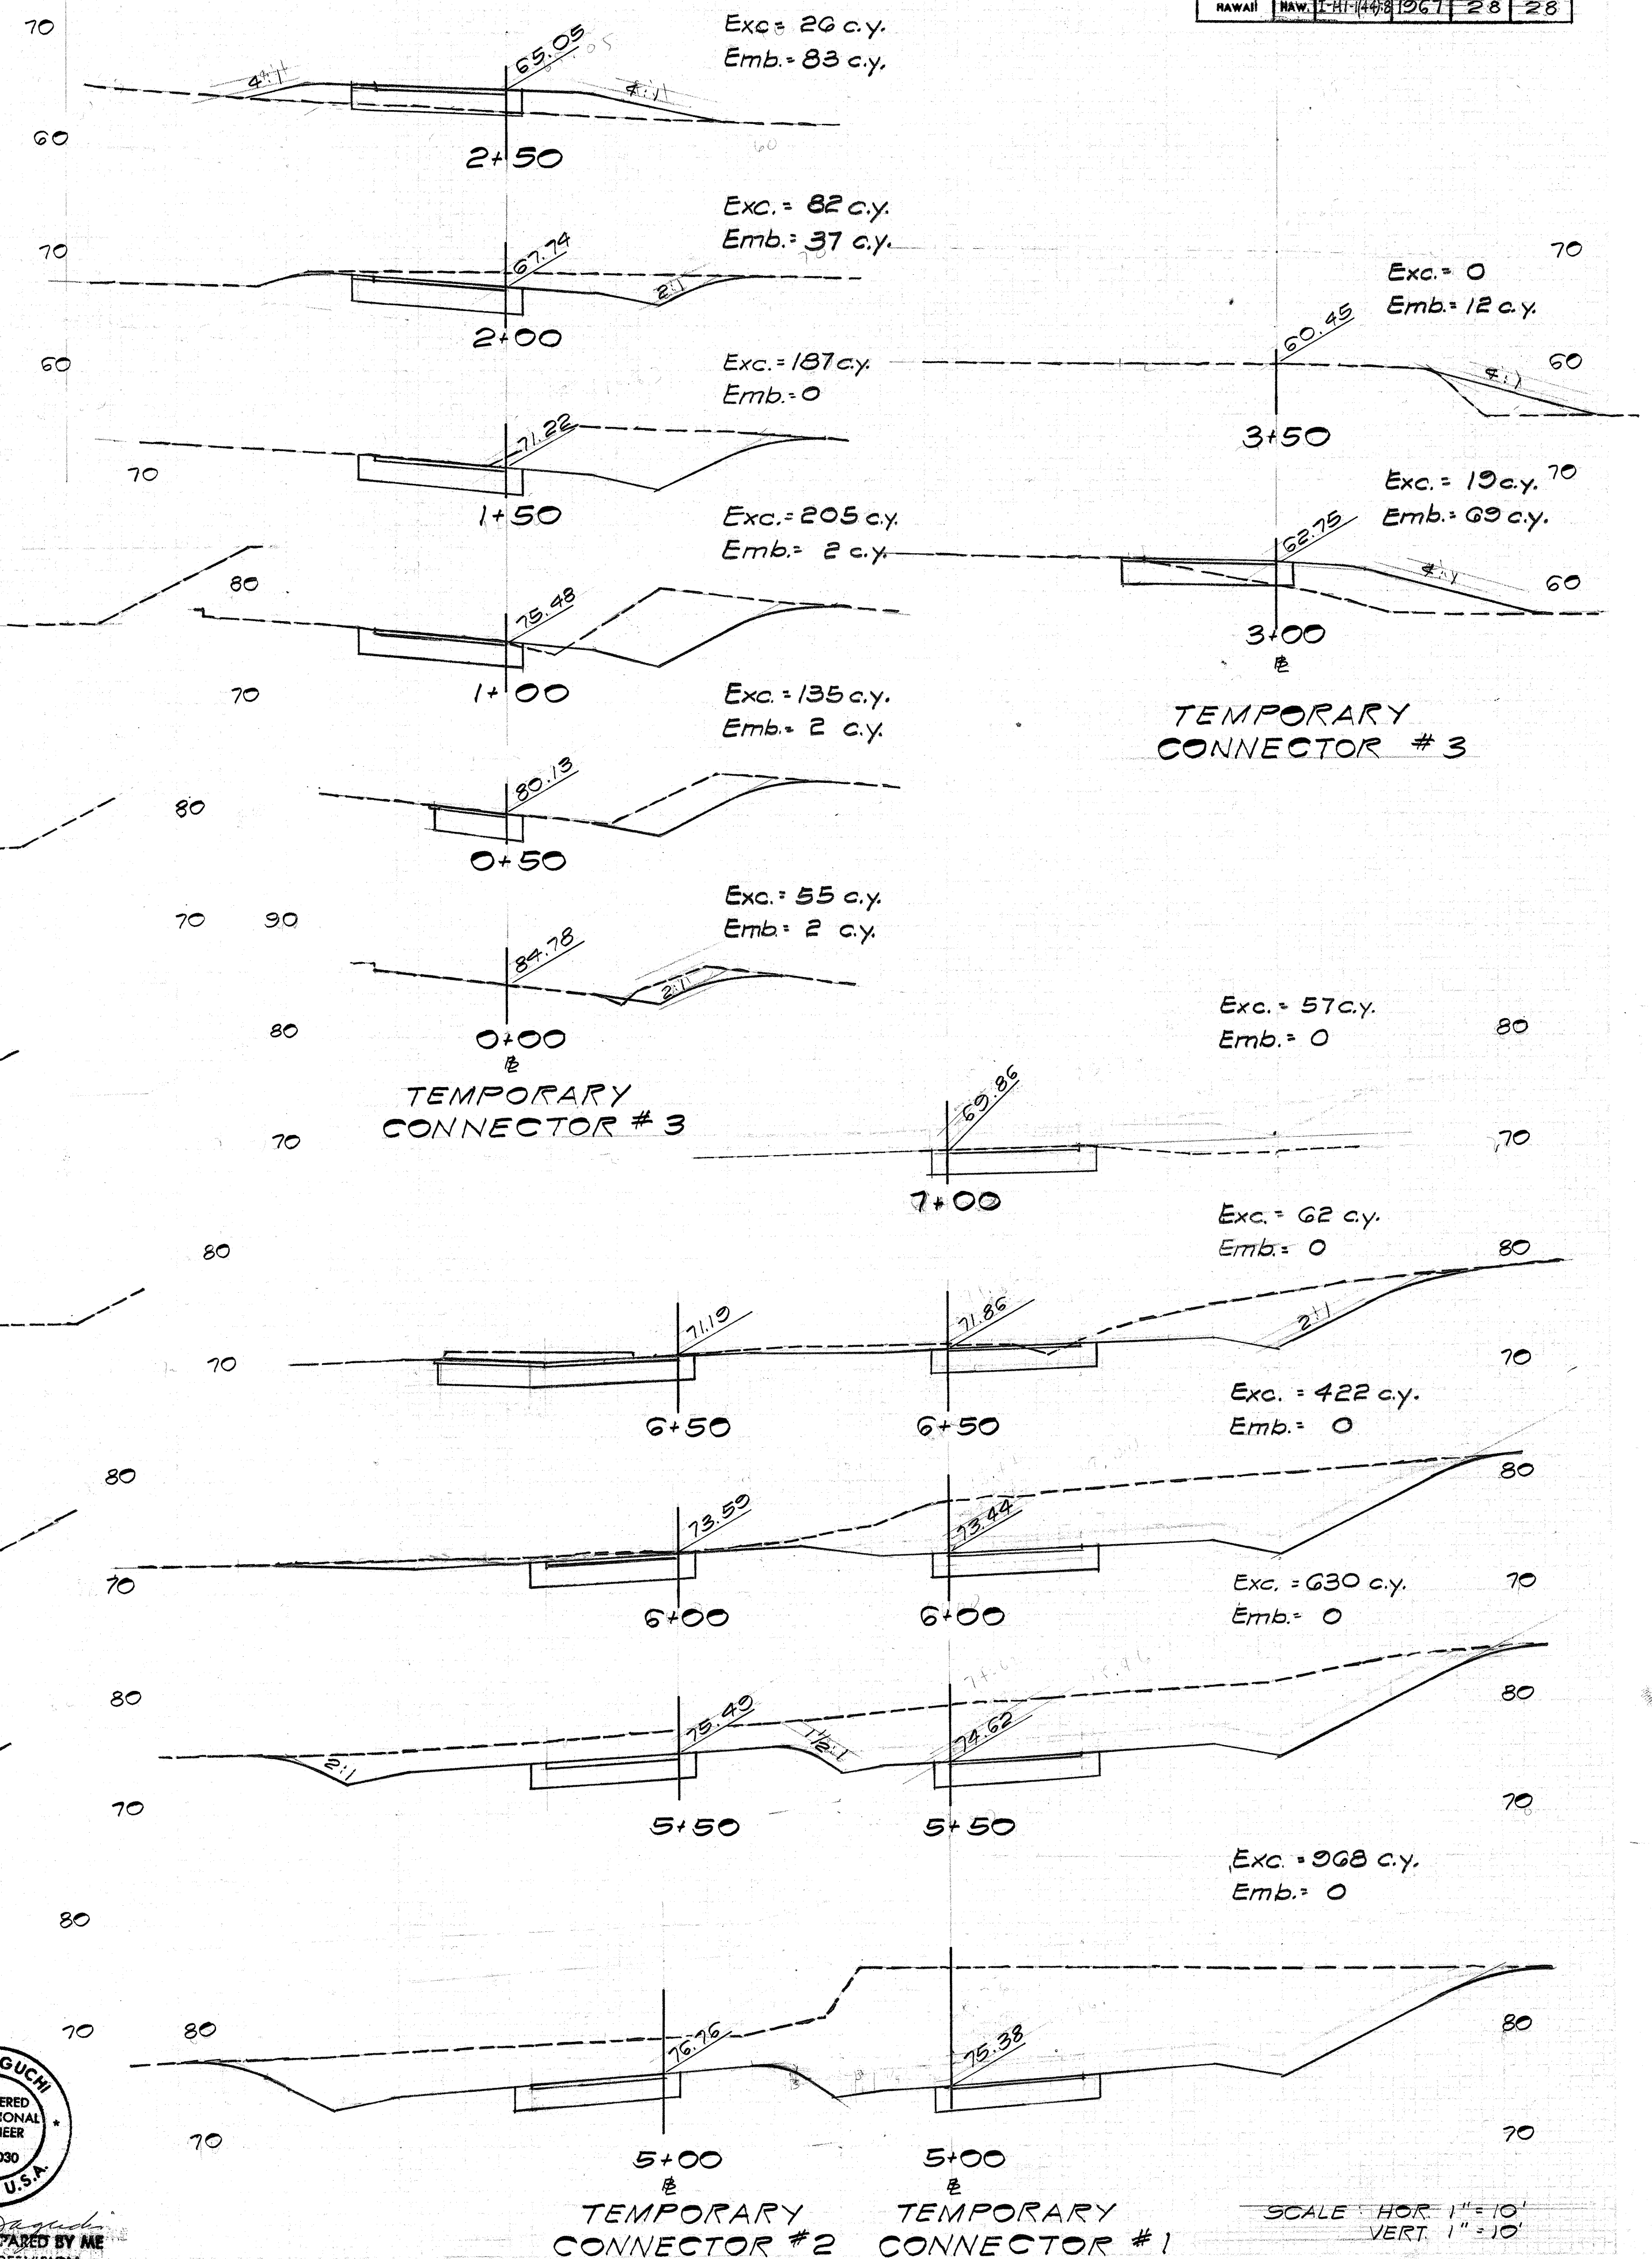


FED. ROAD DIST. NO.	STATE	FED. AID PROJ. NO.	FISCAL YEAR	SHEET NO.	TOTAL SHEETS
1-1	HA	1-1	1967	28	28

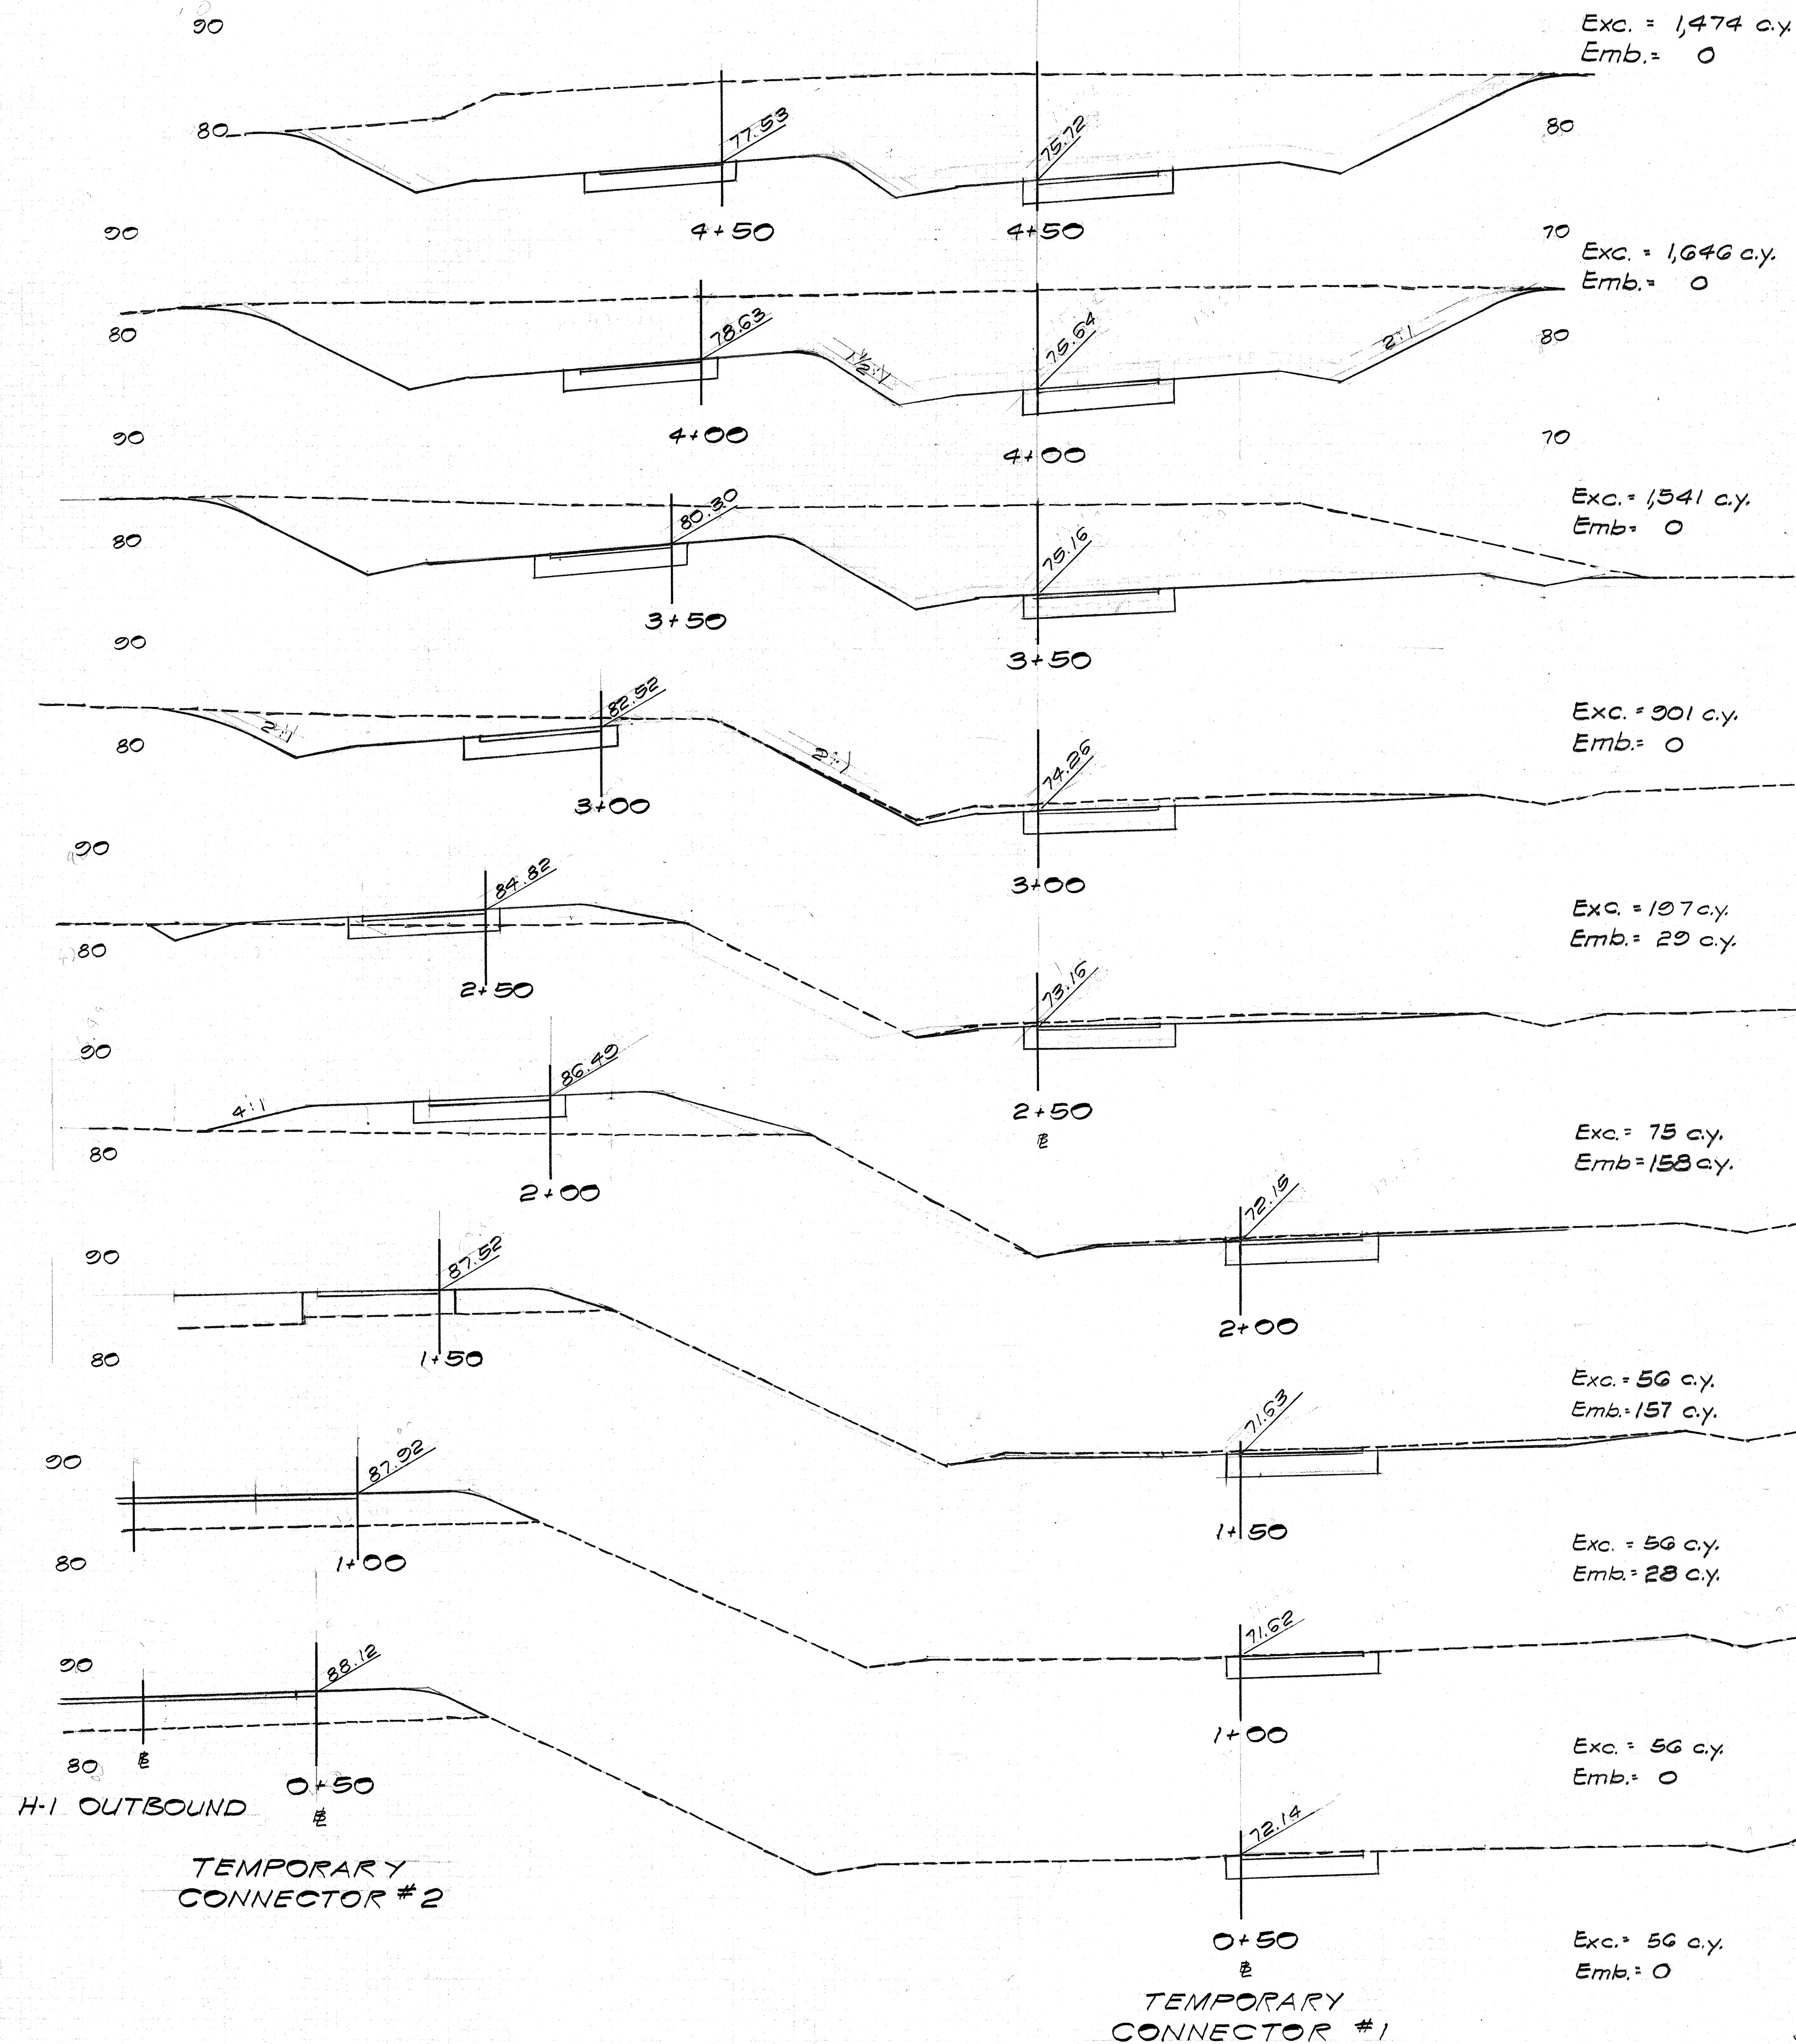

THIS WORK WAS PREPARED BY ME
OR UNDER MY SUPERVISION.