


True North
Scale 1"=50'

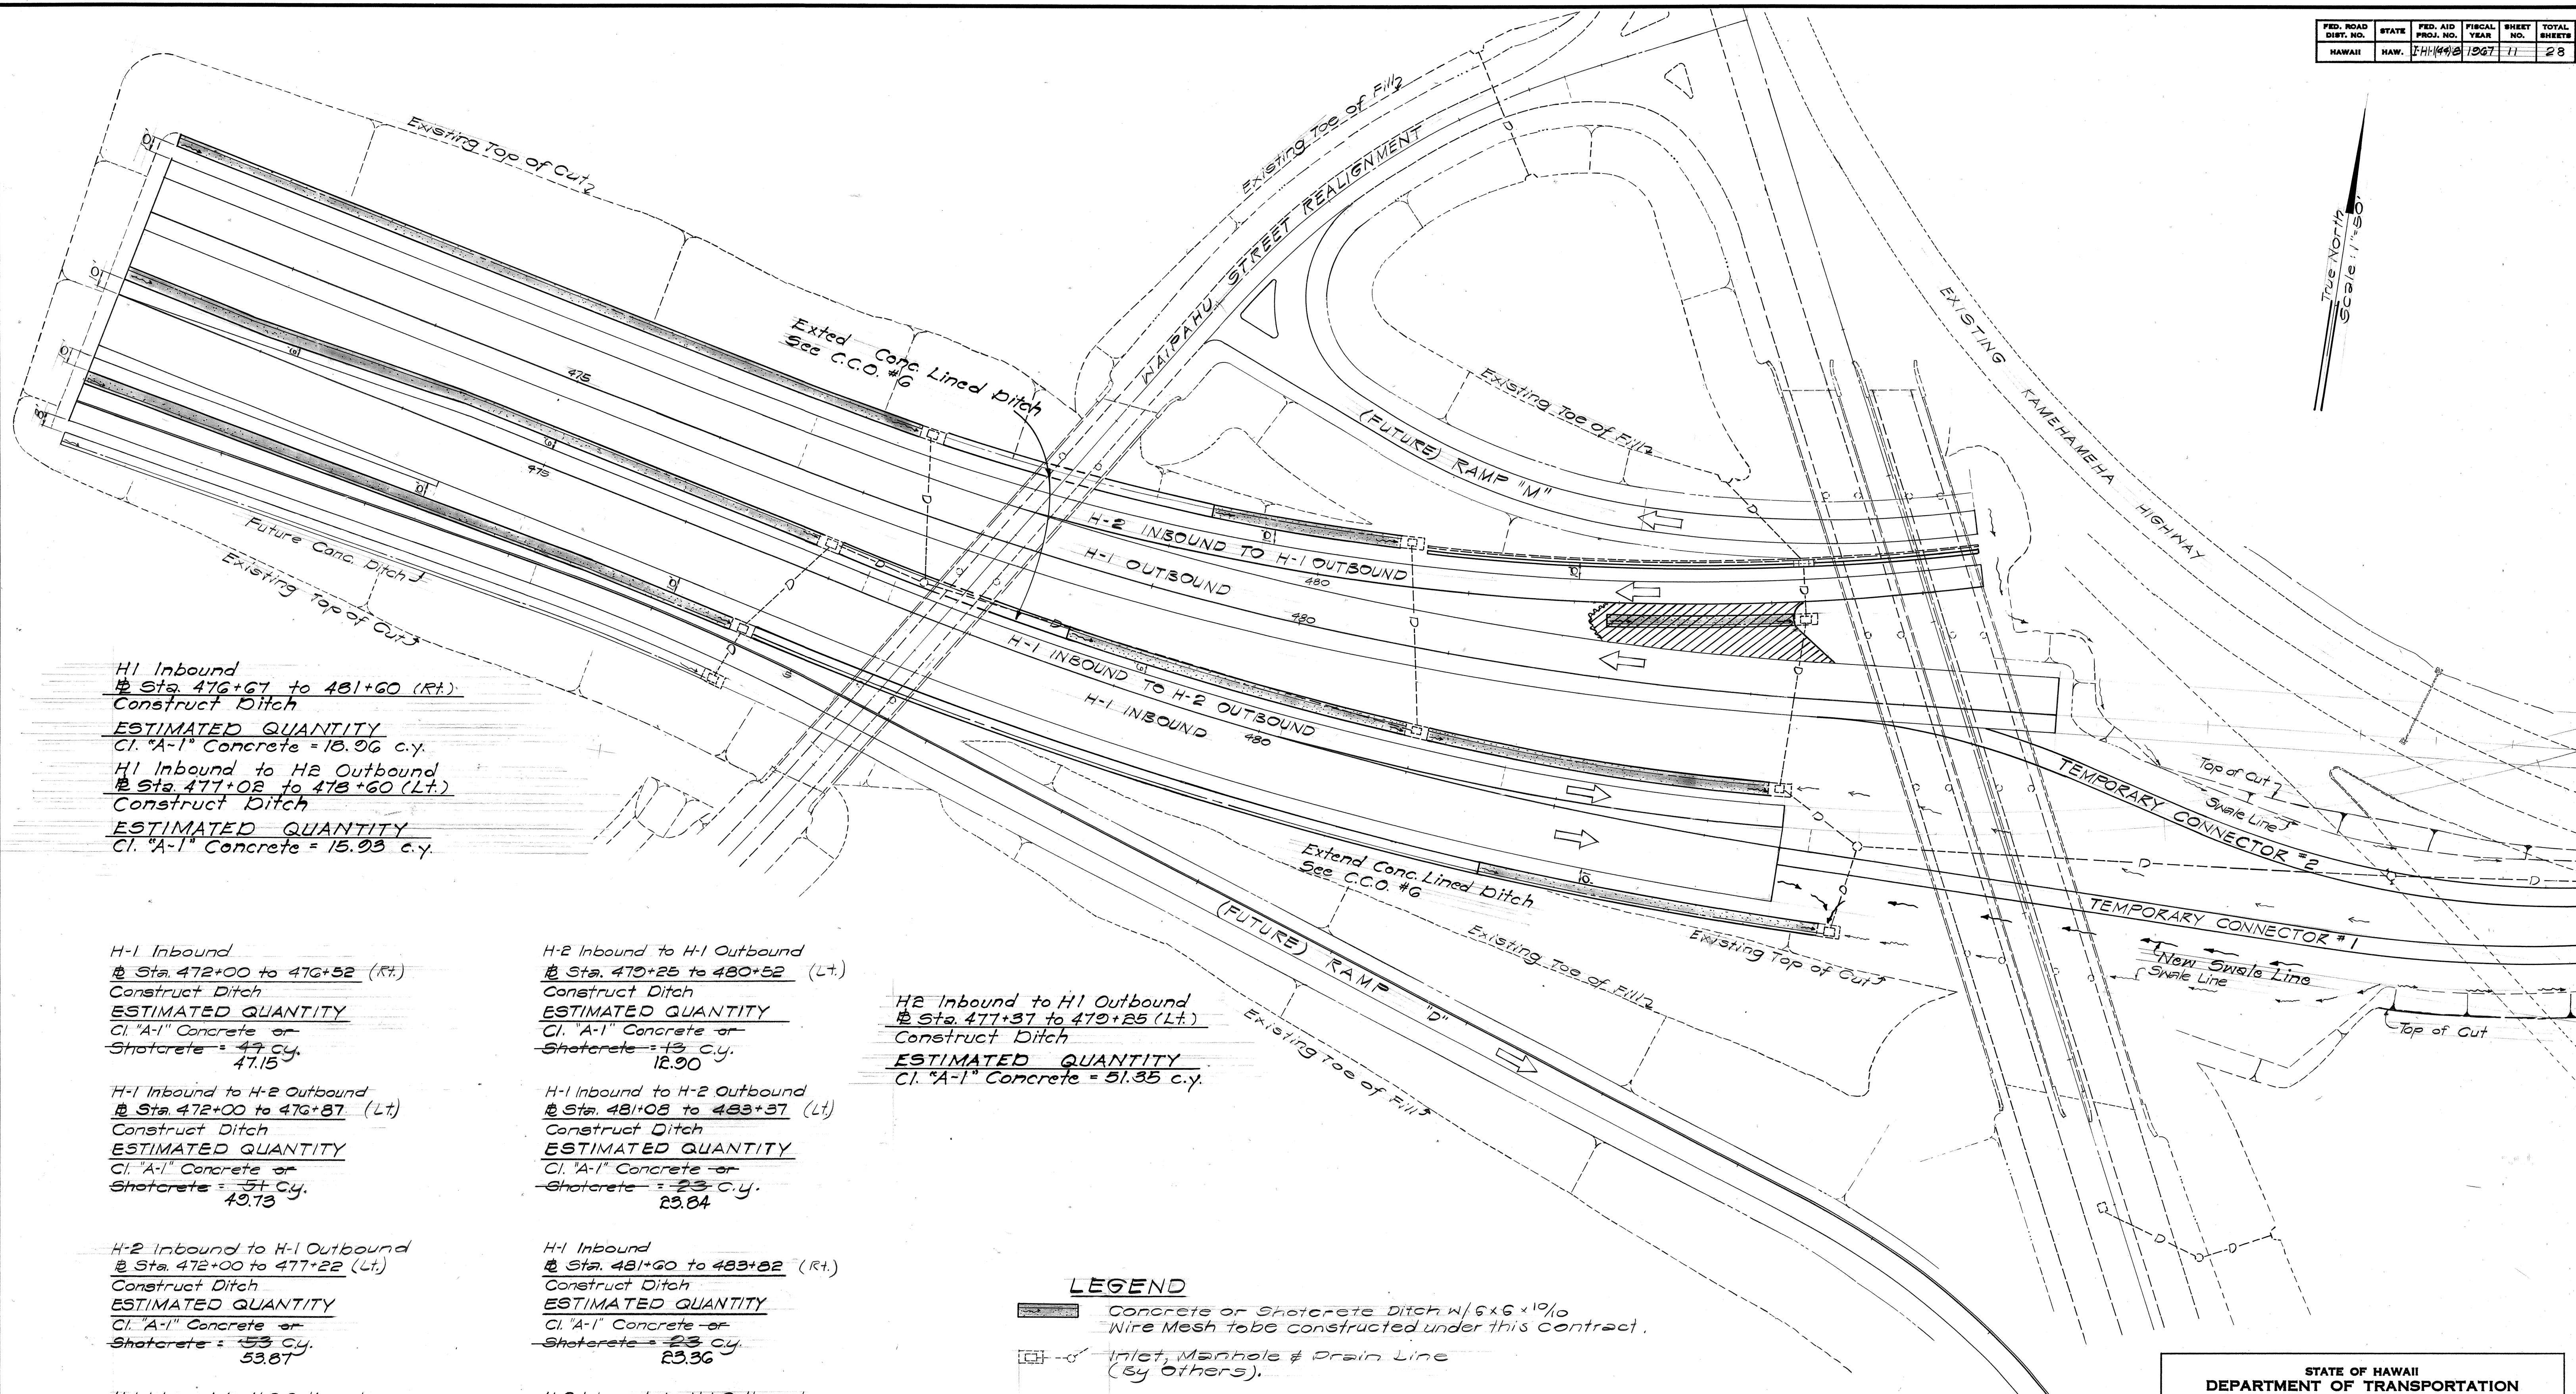

H-1 Inbound
Sta. 476+67 to 481+60 (Rt.)
Construct Ditch
ESTIMATED QUANTITY
Cl. "A-1" Concrete = 18.96 c.y.
H-1 Inbound to H-2 Outbound
Sta. 477+08 to 478+60 (Lt.)
Construct Ditch
ESTIMATED QUANTITY
Cl. "A-1" Concrete = 15.93 c.y.

H-1 Inbound
Sta. 472+00 to 476+32 (Rt.)
Construct Ditch
ESTIMATED QUANTITY
Cl. "A-1" Concrete or
Shotcrete = 47 c.y.
47.15

H-1 Inbound to H-2 Outbound
Sta. 472+00 to 476+37 (Lt.)
Construct Ditch
ESTIMATED QUANTITY
Cl. "A-1" Concrete or
Shotcrete = 51 c.y.
49.73

H-2 Inbound to H-1 Outbound
Sta. 472+00 to 477+22 (Lt.)
Construct Ditch
ESTIMATED QUANTITY
Cl. "A-1" Concrete or
Shotcrete = 53 c.y.
53.87

H-1 Inbound to H-2 Outbound
Sta. 478+60 to 480+02 (Lt.)
Construct Ditch
ESTIMATED QUANTITY
Cl. "A-1" Concrete or
Shotcrete = 24 c.y.
23.93

H-2 Inbound to H-1 Outbound
Sta. 479+25 to 480+32 (Lt.)
Construct Ditch
ESTIMATED QUANTITY
Cl. "A-1" Concrete or
Shotcrete = 13 c.y.
12.90

H-1 Inbound to H-2 Outbound
Sta. 481+08 to 483+37 (Lt.)
Construct Ditch
ESTIMATED QUANTITY
Cl. "A-1" Concrete or
Shotcrete = 23 c.y.
23.84

H-1 Inbound
Sta. 481+60 to 483+32 (Rt.)
Construct Ditch
ESTIMATED QUANTITY
Cl. "A-1" Concrete or
Shotcrete = 23 c.y.
23.36

H-2 Inbound to H-1 Outbound
Sta. 481+00 to 483+12 (Rt.)
Construct Ditch
ESTIMATED QUANTITY
Cl. "A-1" Concrete or
Shotcrete = 13 c.y.
12.60

H-2 Inbound to H-1 Outbound
Sta. 477+37 to 479+25 (Lt.)
Construct Ditch
ESTIMATED QUANTITY
Cl. "A-1" Concrete = 51.35 c.y.


LEGEND

- Concrete or Shotcrete Ditch w/ 6x6x10% Wire Mesh to be constructed under this contract.
- Inlet, Manhole & Drain Line (by others).

NOTE

6x6x10% Wire Mesh shall be considered incidental to the various contract items

Hatched Area Denotes Filling Over Concrete Ditch For Safety Precaution

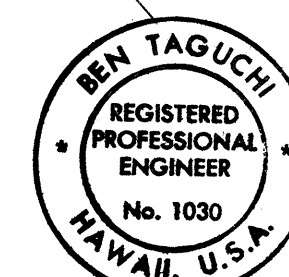

THIS WORK WAS PREPARED BY ME
OR UNDER MY SUPERVISION.

STATE OF HAWAII
DEPARTMENT OF TRANSPORTATION
HIGHWAYS DIVISION

DRAINAGE PLAN

WAI'AWA INTERCHANGE
F.A.I. Proj. No. I-HI-1(44): 8

Scale: As shown Date: JAN. 1968

SHEET No. OF SHEETS