



FED. ROAD DIST. NO.	STATE	FED. AID PROJ. NO.	FISCAL YEAR	SHEET NO.	TOTAL SHEETS
HAWAII	HAW.	1-41-144-8	1967	10	28

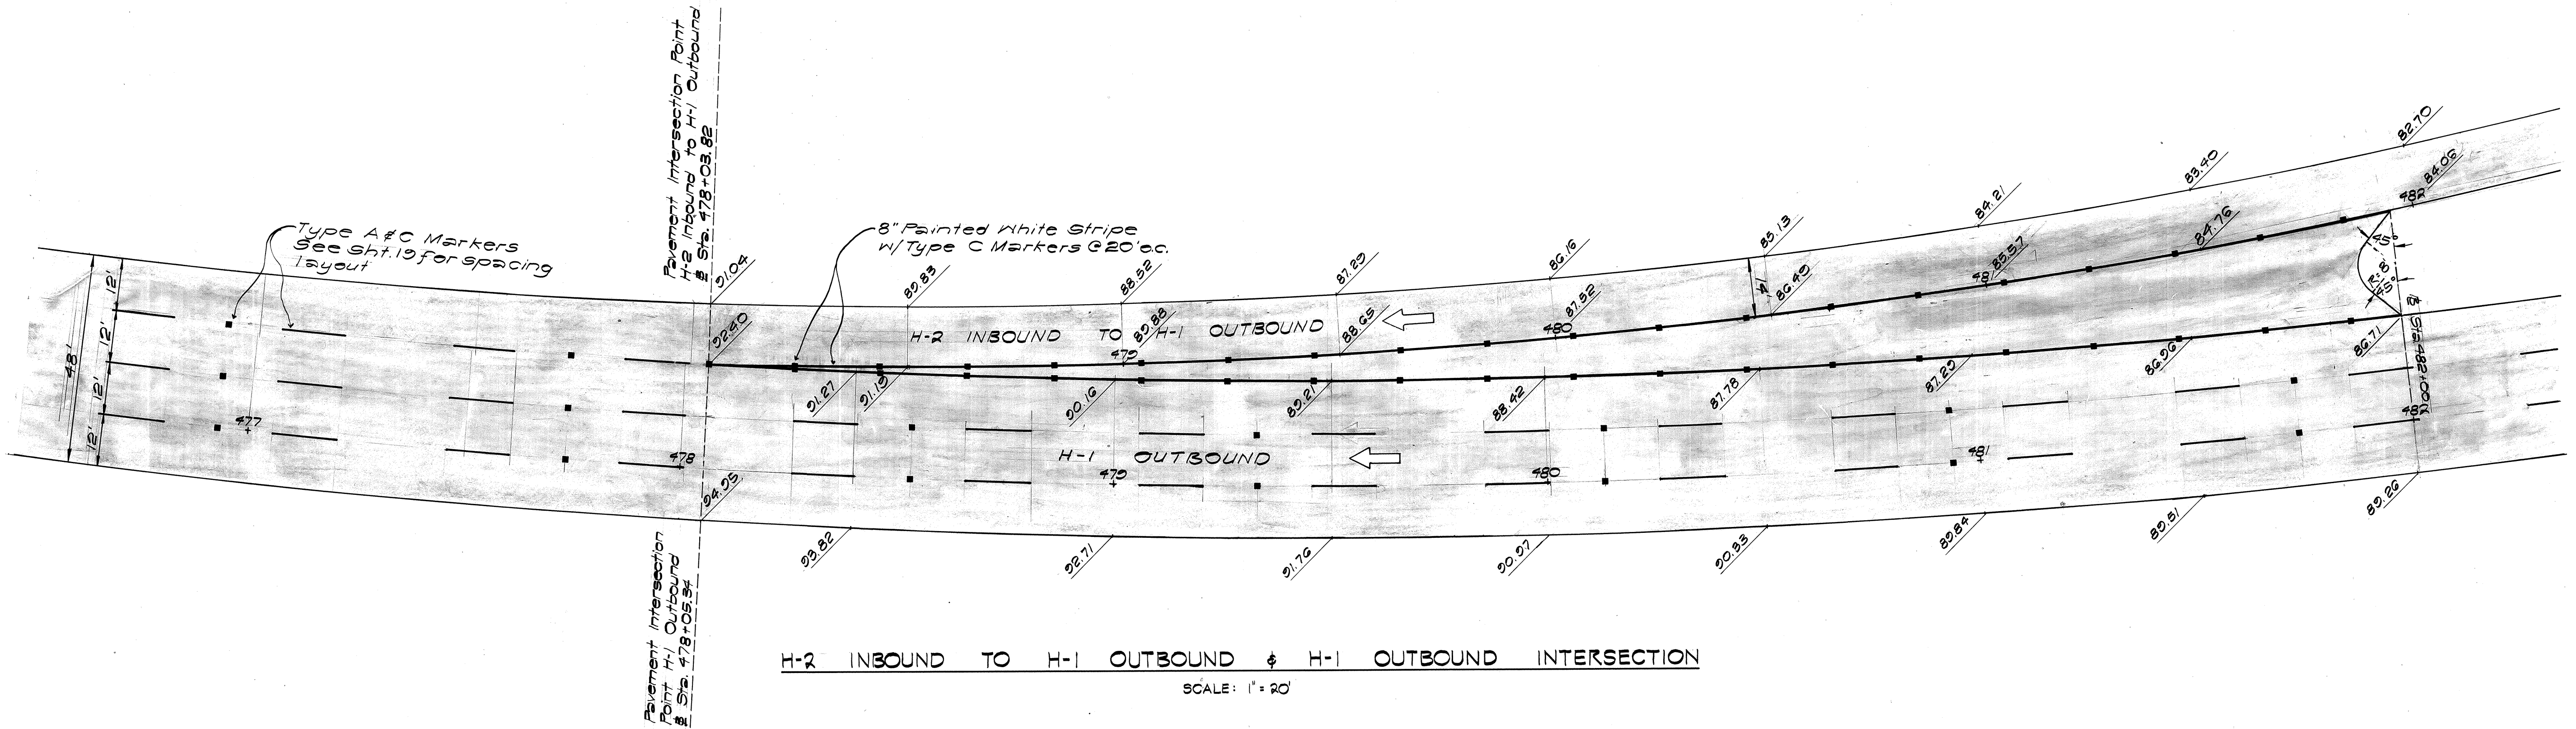


True North
Scale: 1" = 20'

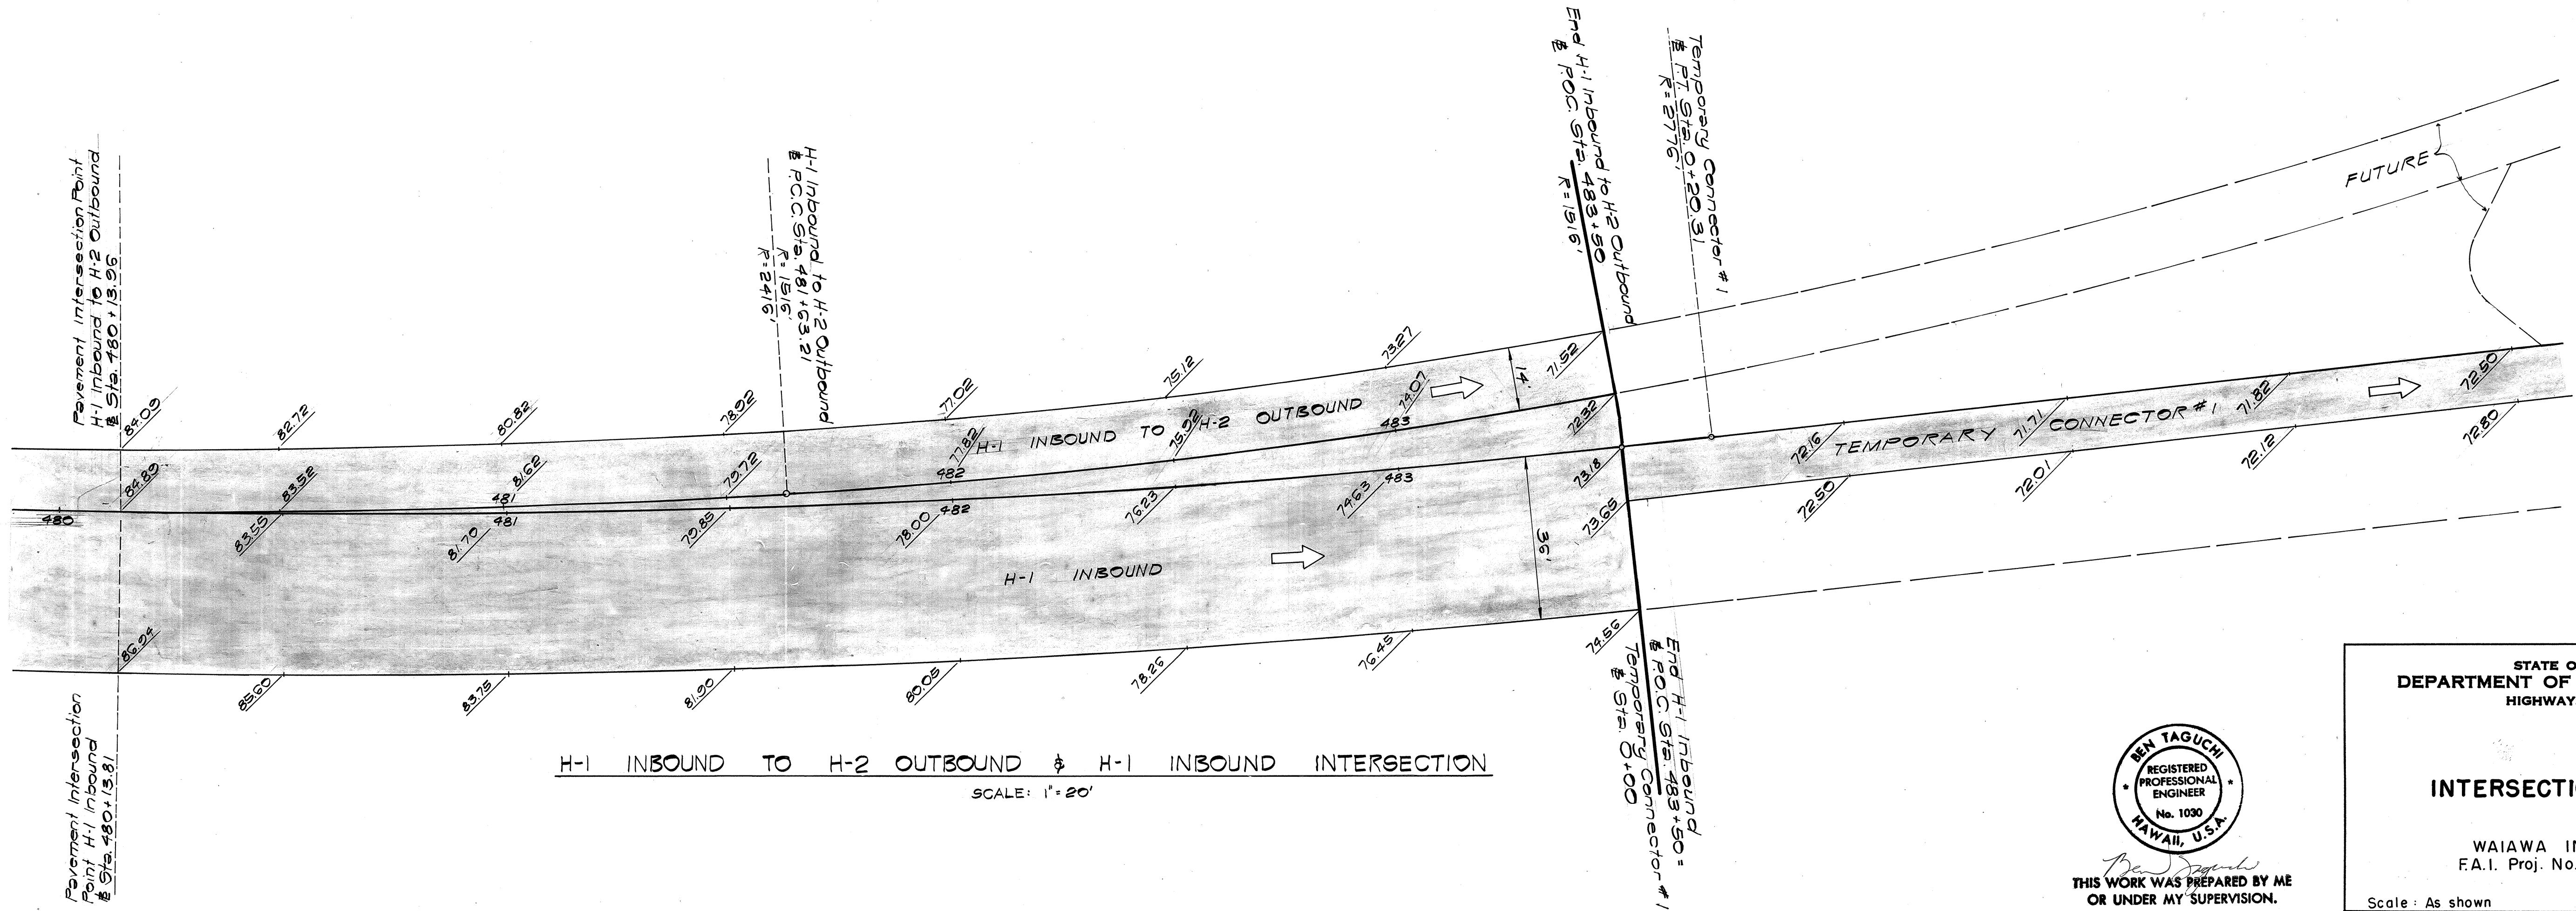

True North
Scale: 1" = 20'

DATE	SURVEY PLOTTED BY
PLAN	DRAWN BY
NOTE BOOK	DESIGNED BY
QUANTITIES BY	CHECKED BY

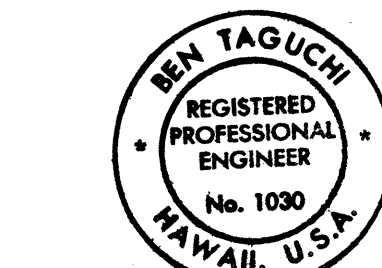

THIS WORK WAS PREPARED BY ME
OR UNDER MY SUPERVISION.

STATE OF HAWAII
DEPARTMENT OF TRANSPORTATION
HIGHWAYS DIVISION

INTERSECTION DETAILS

WAIAWA INTERCHANGE
F.A.I. Proj. No. I - HI - 1(44)-8
Scale: As shown Date: JAN. 1968

SHEET No. 10 OF 28 SHEETS