


[illegible]

STATE OF HAWAII  
DEPARTMENT OF TRANSPORTATION  
HIGHWAYS DIVISION  
HONOLULU, HAWAII


PLANS FOR  
RESURFACING A PORTION OF  
INTERSTATE ROUTE H-1  
MAKIKI STREET TO ALEXANDER STREET  
PROJECT NO. HI-I-02-69

FED. ROAD DIST. NO.	STATE	PROJ. NO.	FISCAL YEAR	SHEET NO.	TOTAL SHEETS
HAWAII	HAW.	HI-I-02-69	1968	1	1

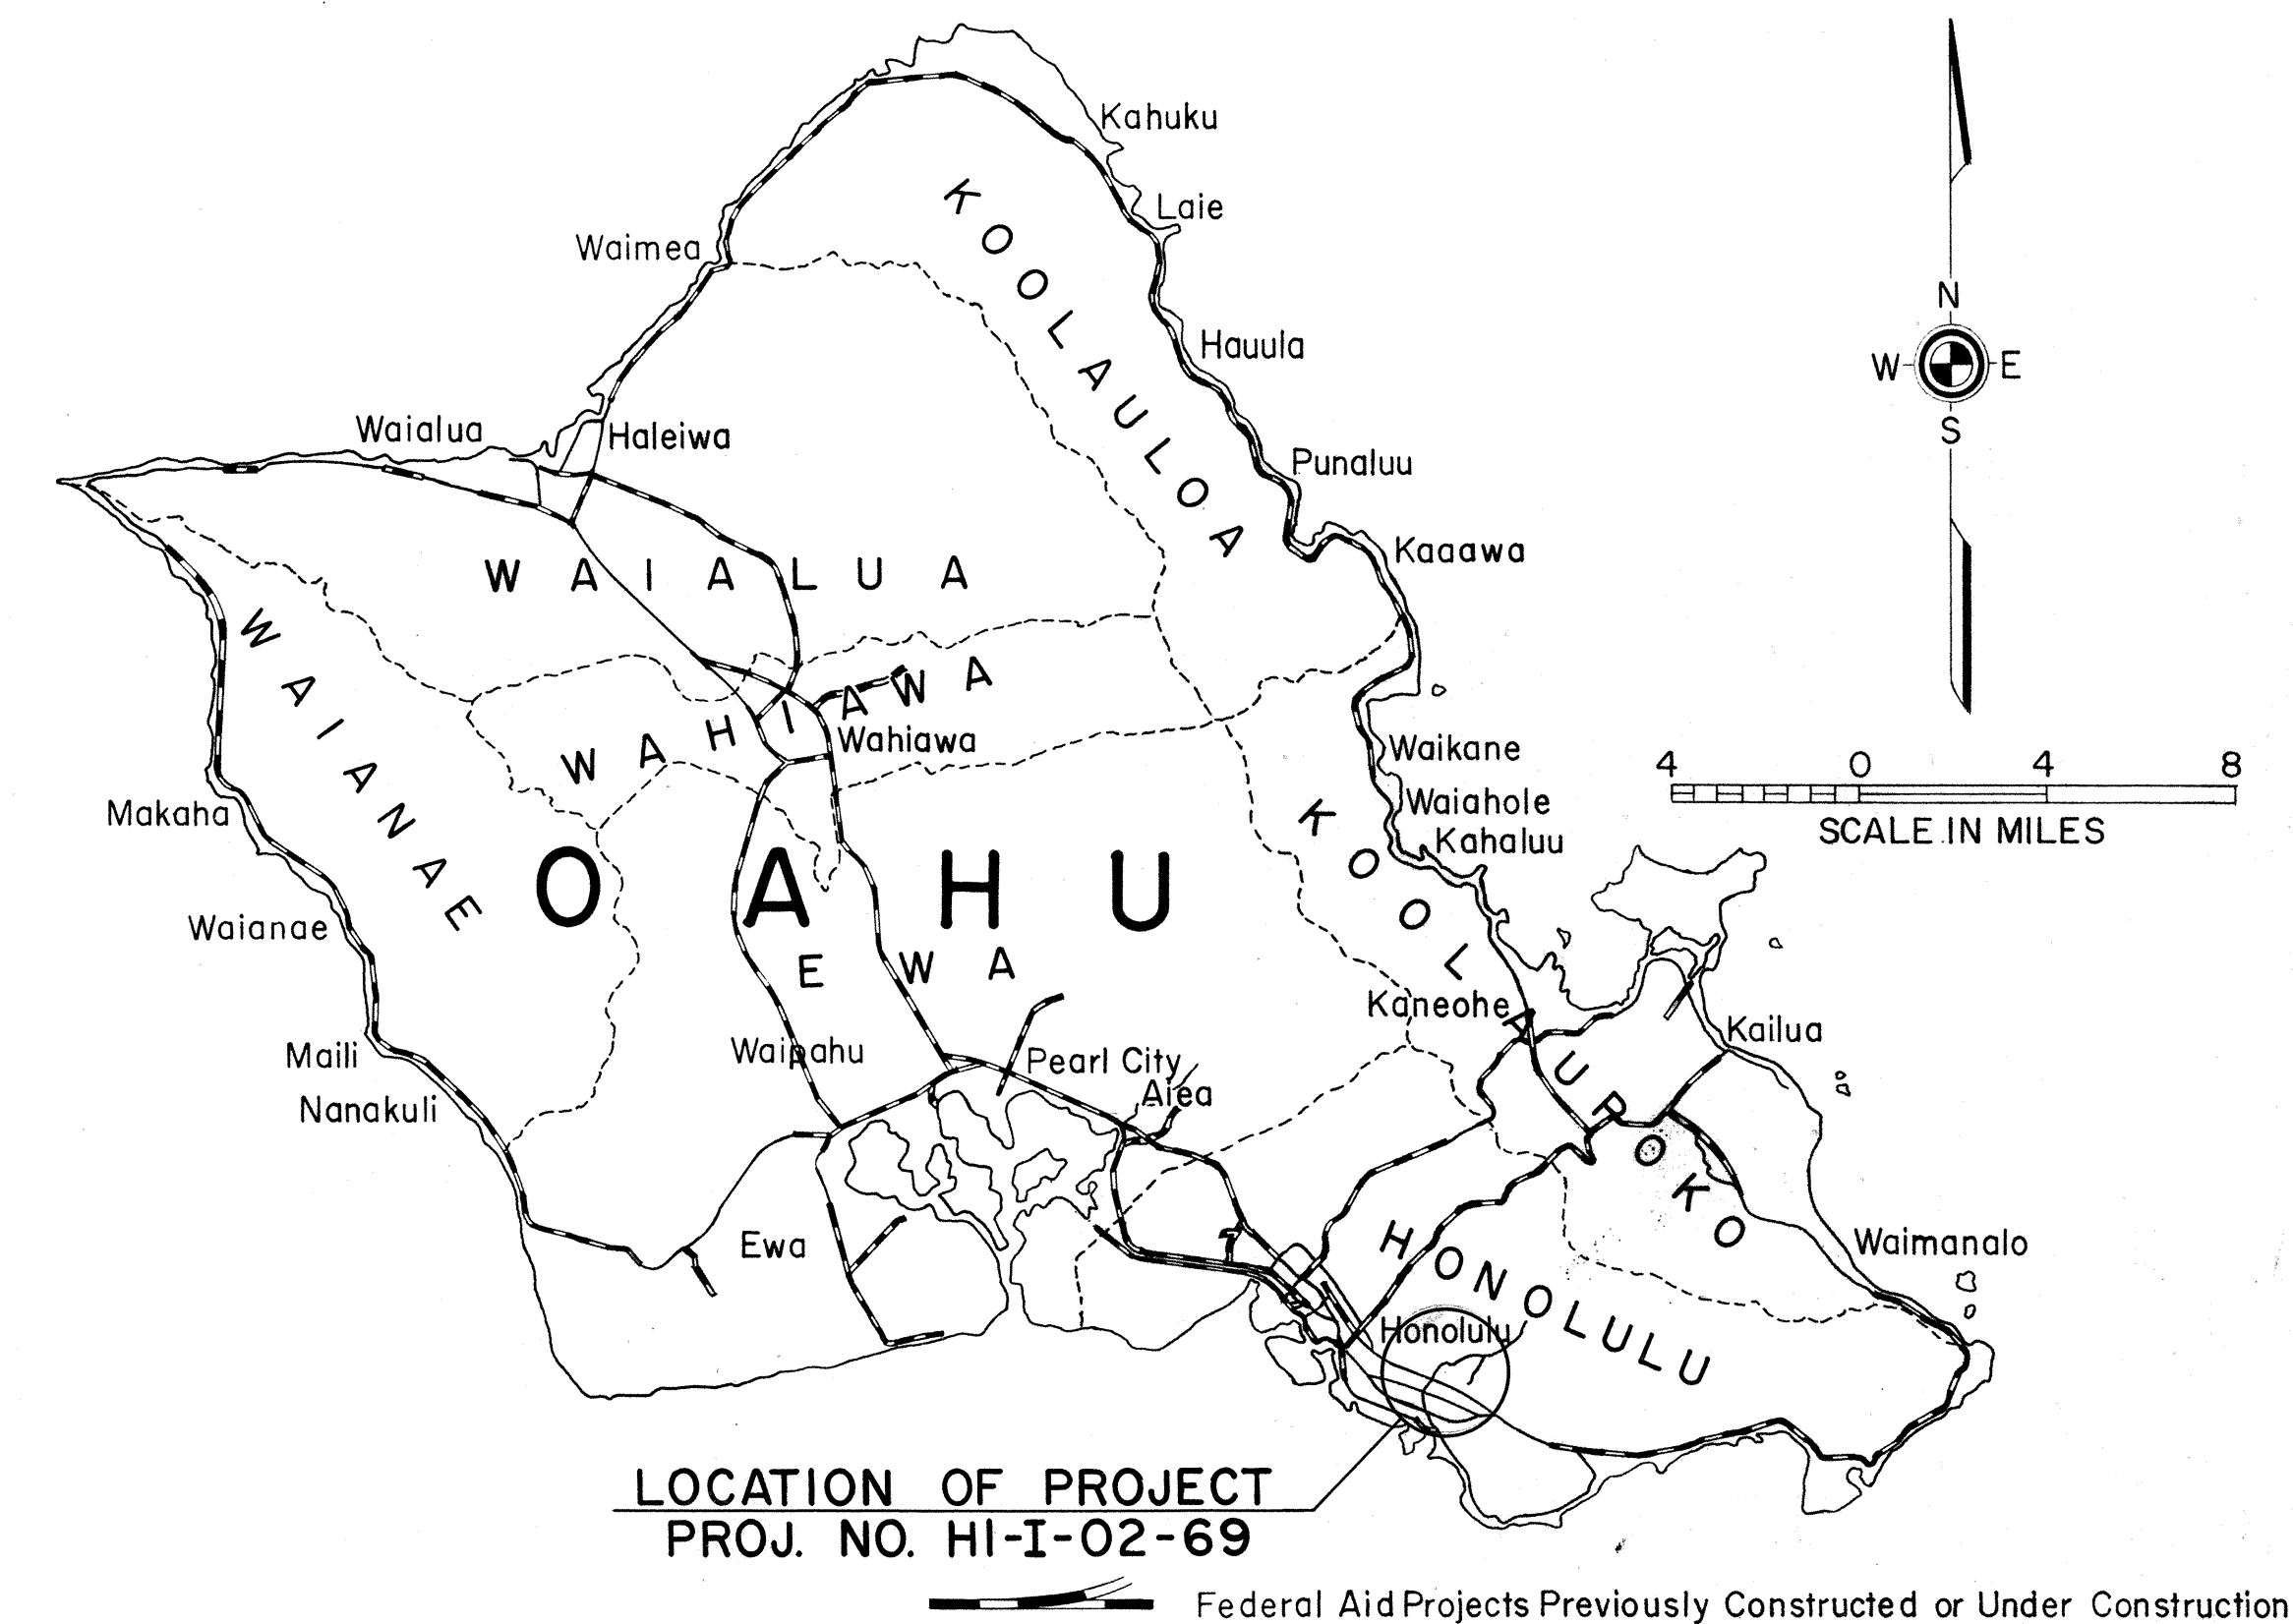

GENERAL NOTES:

NO AS-BUILT CHANGES

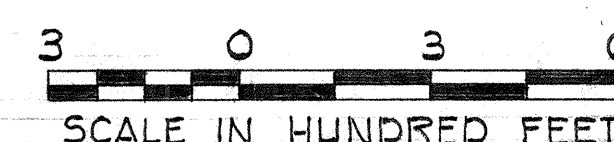

DEPARTMENT OF TRANSPORTATION STATE OF HAWAII	
APPROVED:	
<i>E. Alvey Haight</i> <u>DIRECTOR OF TRANSPORTATION</u>	<u>8/26/68</u>
SHEET NO. 1 OF 1 SHEET	