

PLAN	SURVEYED	DATE
NO.	BY	
NOTE BOOK	PLOTTED	
NO.	ALIGNED	
	CHECKED	
	BY	
	OF WAY	
	CHECKED	

PROFILE	SURVEYED	BY	DATE
	PLOTTED		
NOTE BOOK	CHAINS CHECKED		
NO.	B. IS NOTED		
	STRUCTURE NOTATIONS CHKD.		








FED. ROAD DIST. NO.	STATE	FED. AID PROJ. NO.	FISCAL YEAR	SHEET NO.	TOTAL SHEETS
HAWAII	HAW.	1-H-1(40)0	1968	15	133

$$\Delta = 90^{\circ}00'00''$$

$$4/2 = 45^{\circ}00'00''$$

$$R = 100.00$$

$$L = 157.08$$

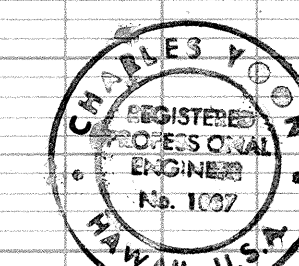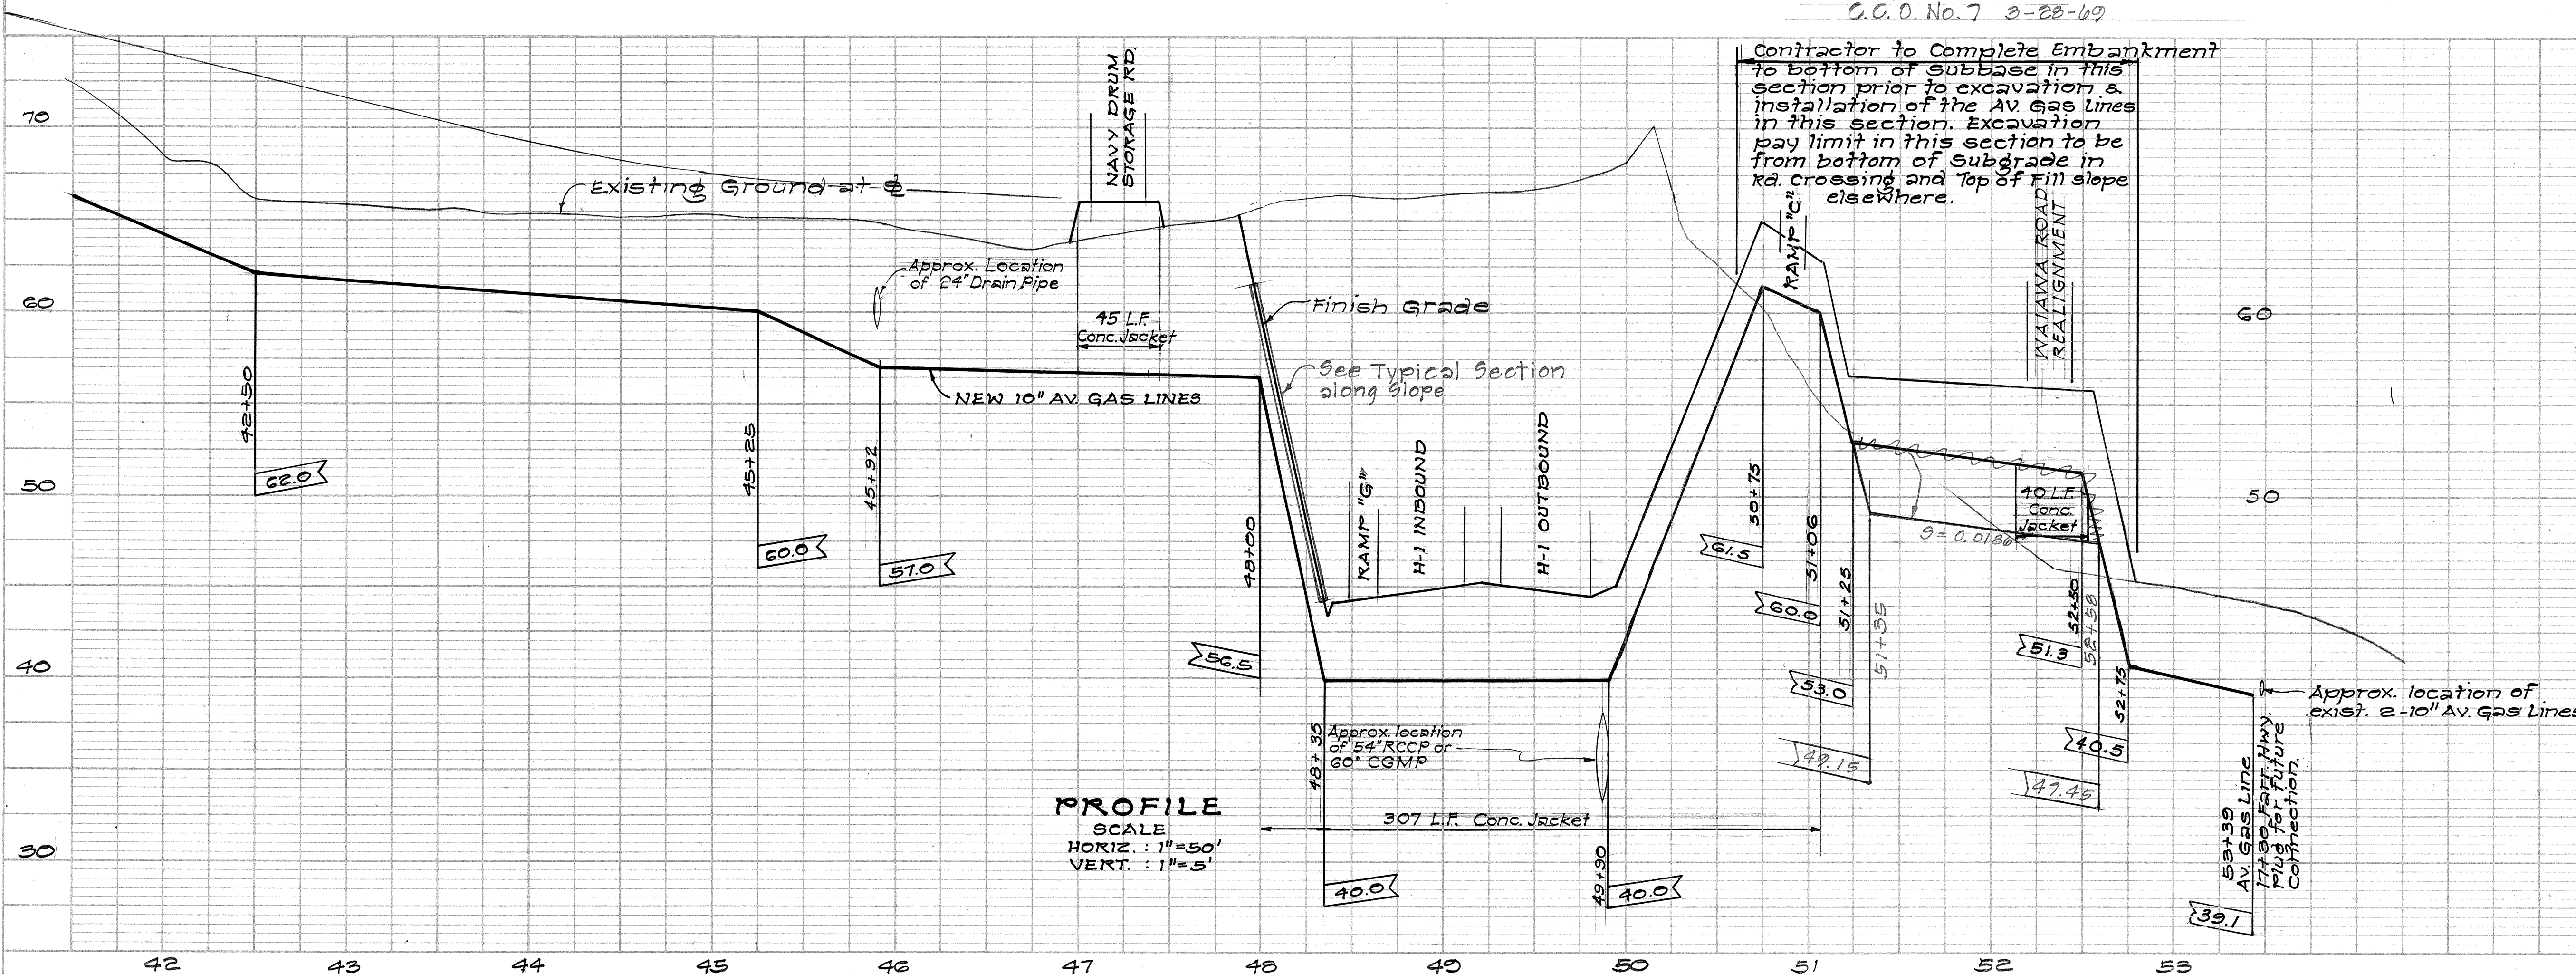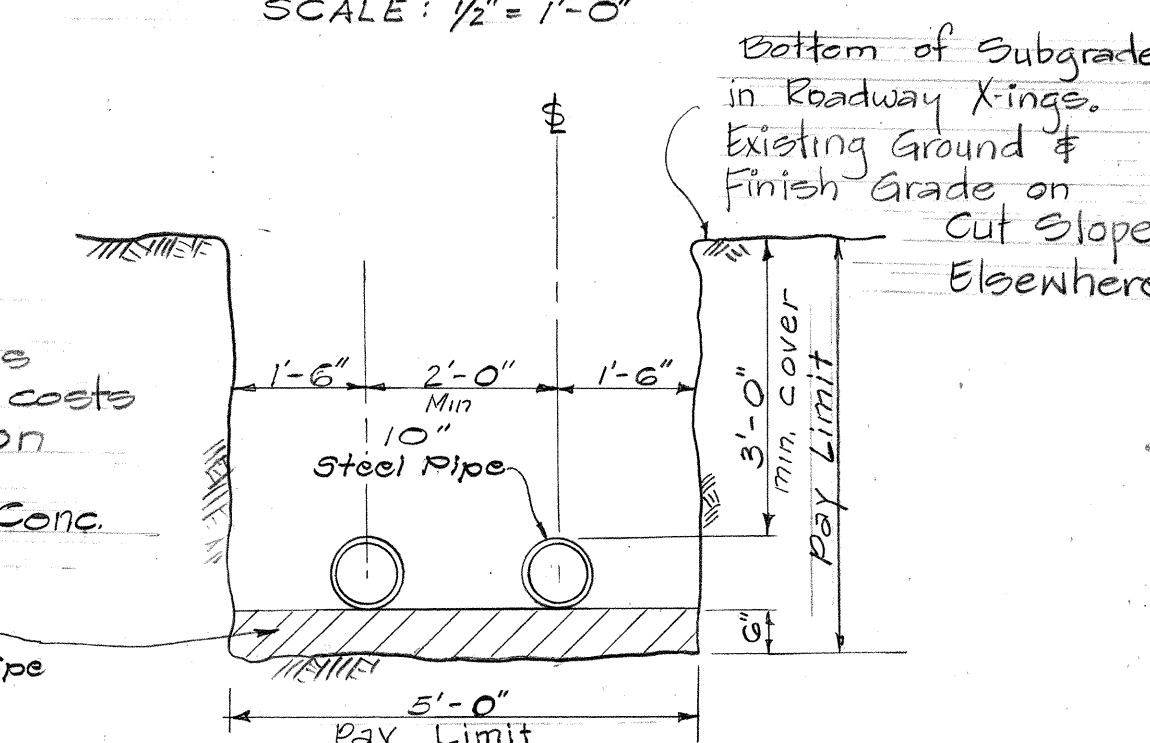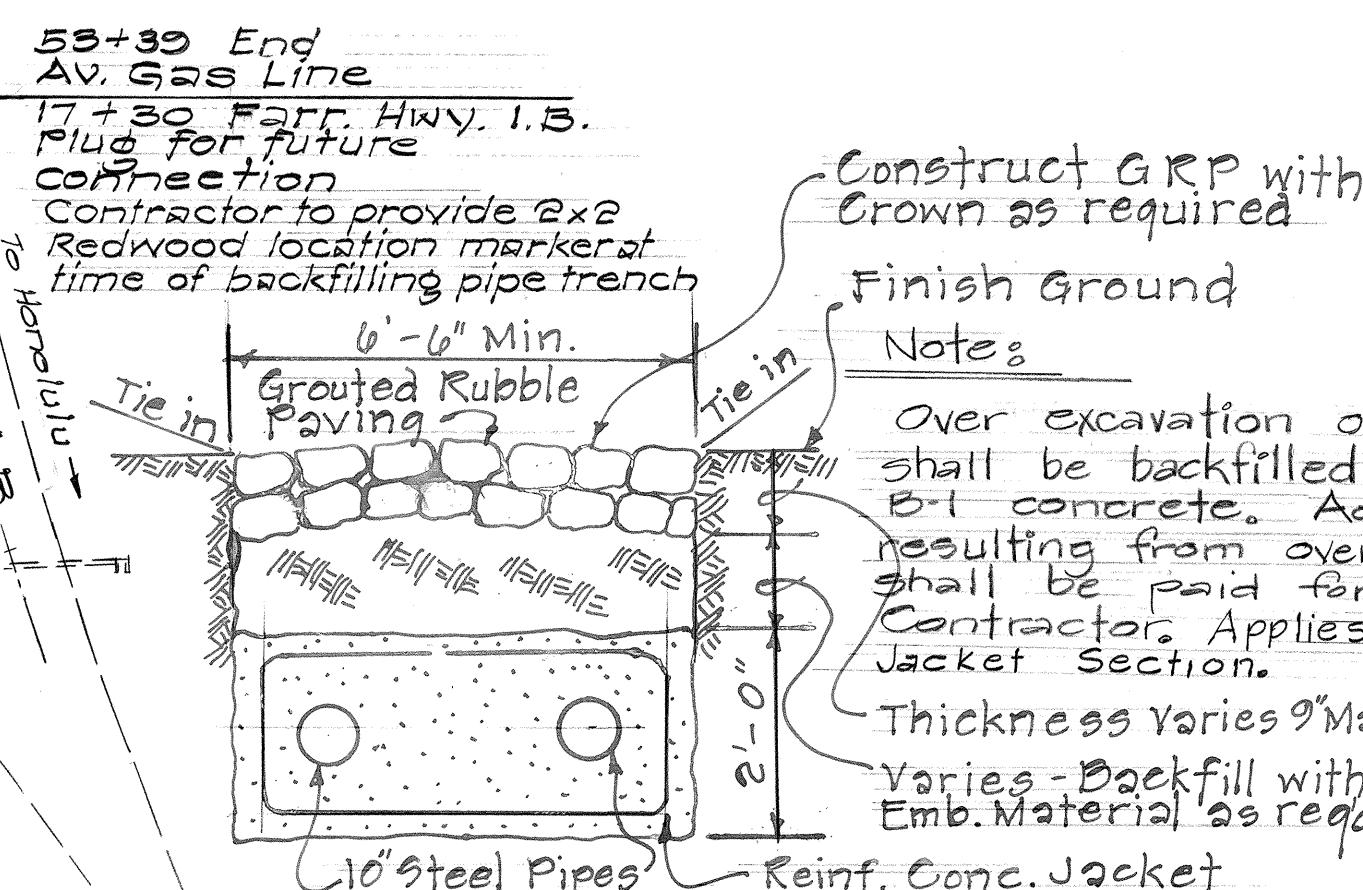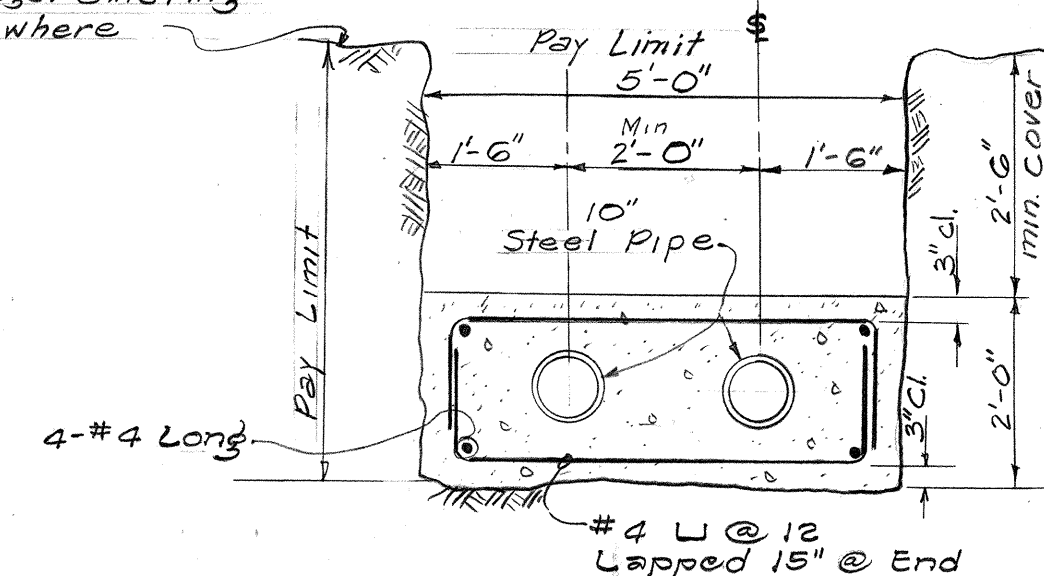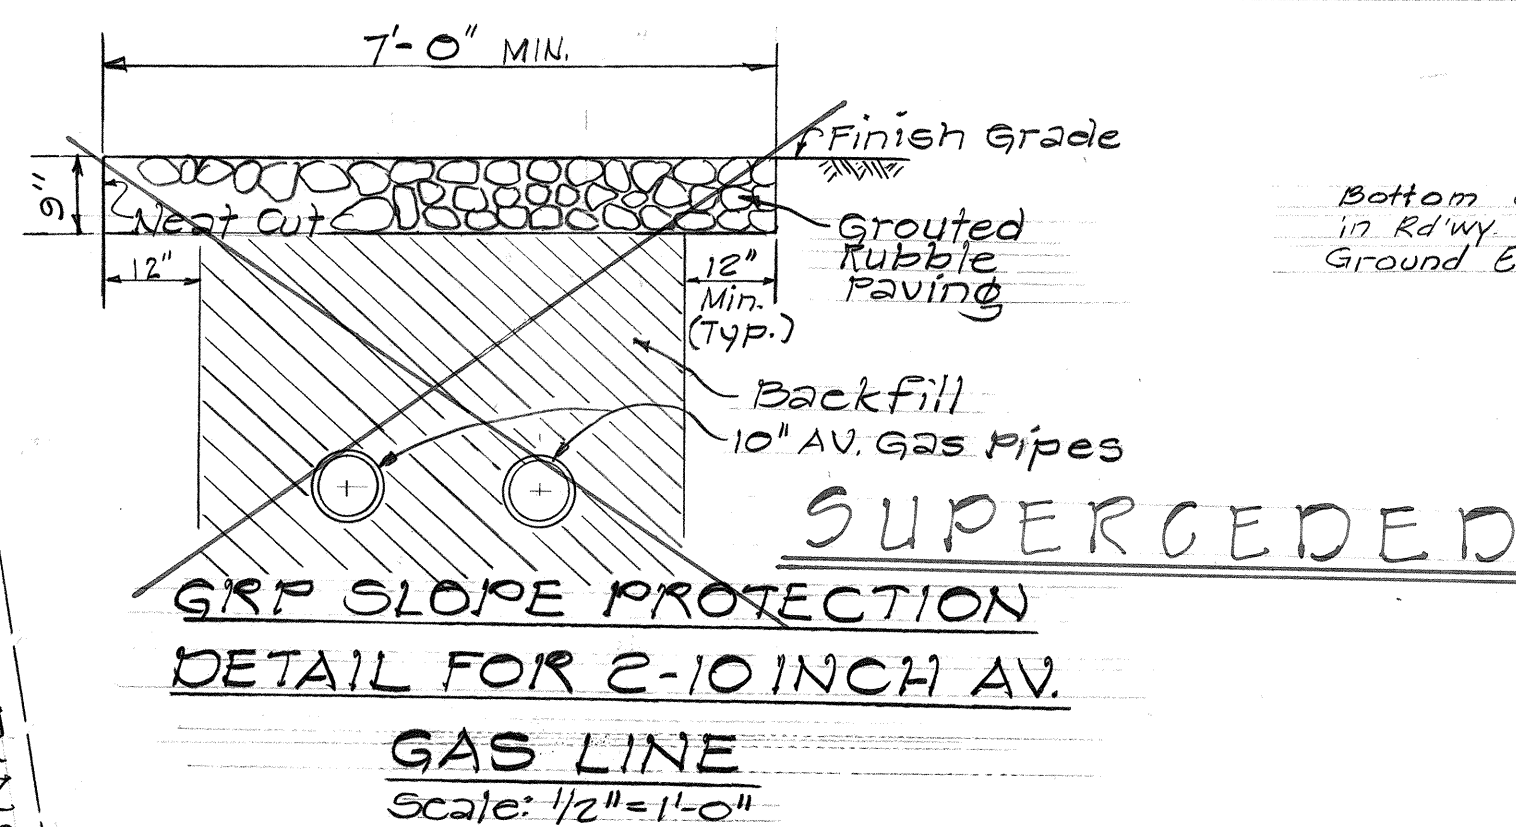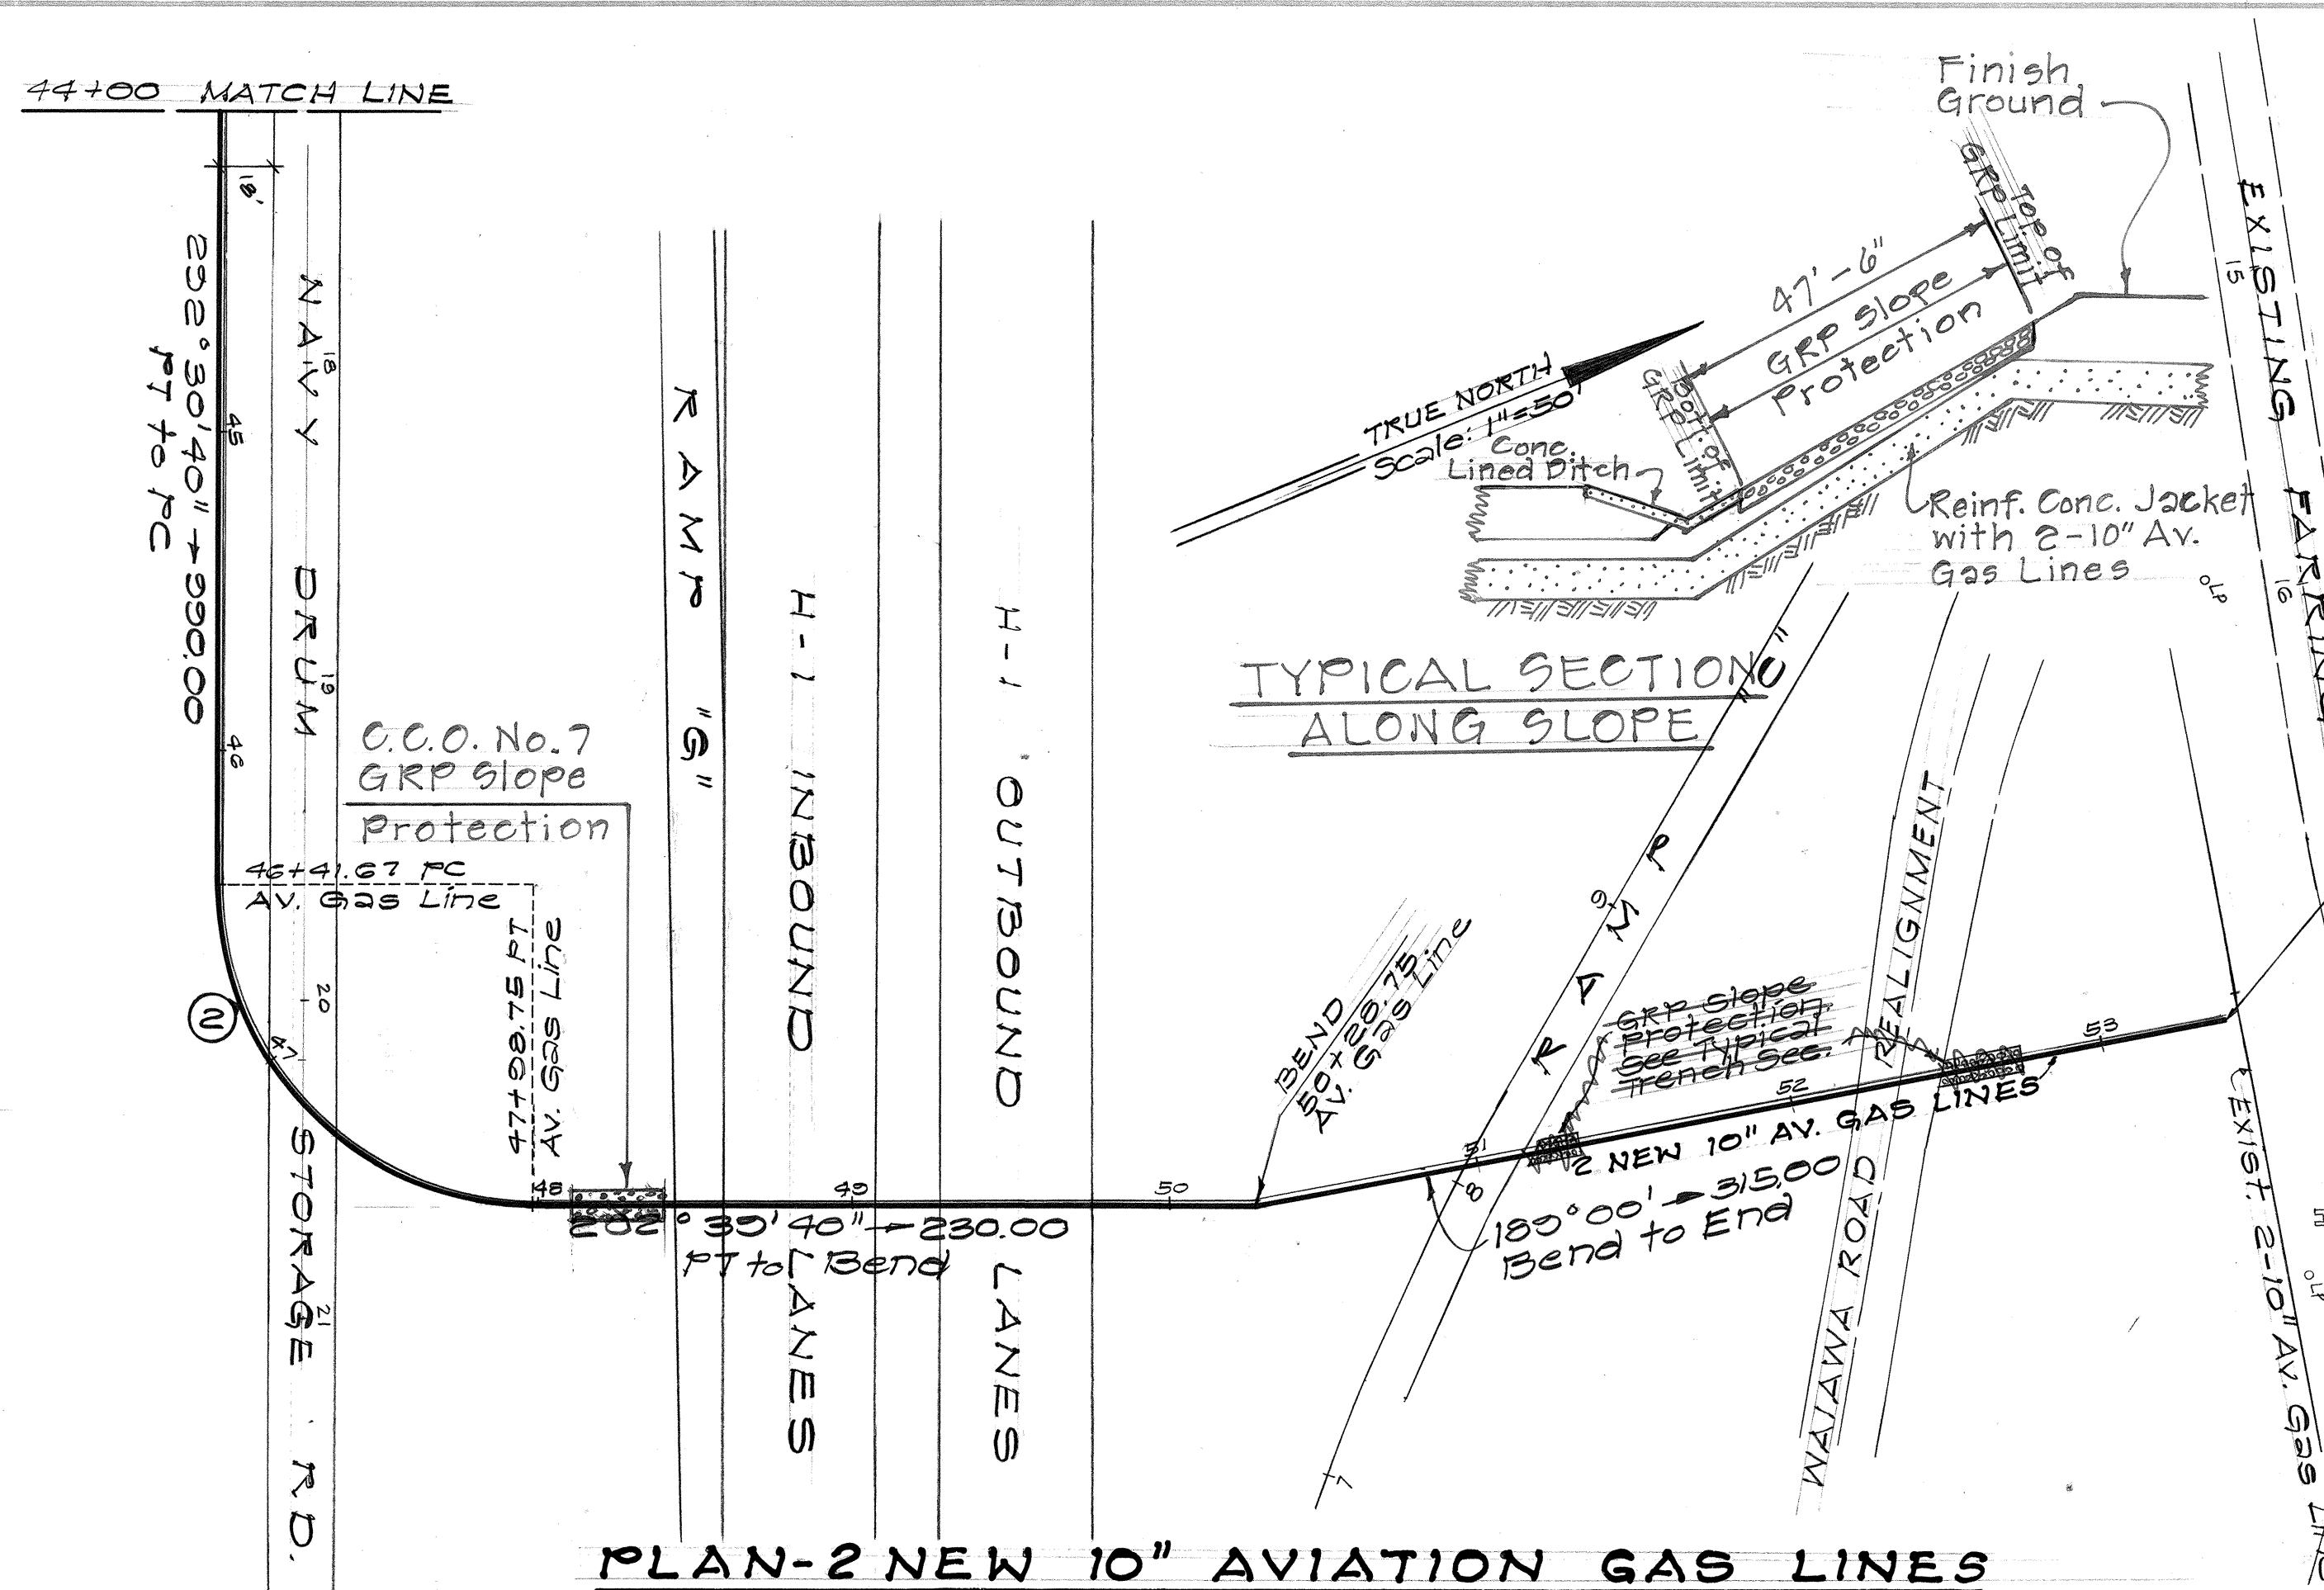

THIS WORK WAS PREPARED BY ME OR UNDER MY SUPERVISION.
Charles Yoon