
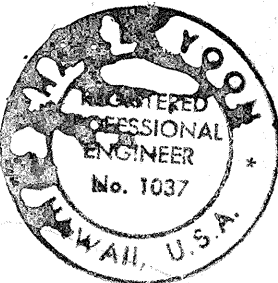


FED. ROAD DIST. NO.	STATE	FED. AID PROJ. NO.	FISCAL YEAR	SHEET NO.	TOTAL SHEETS
HAWAII	HAW.	I-HI-1(48):9	1968	110	123

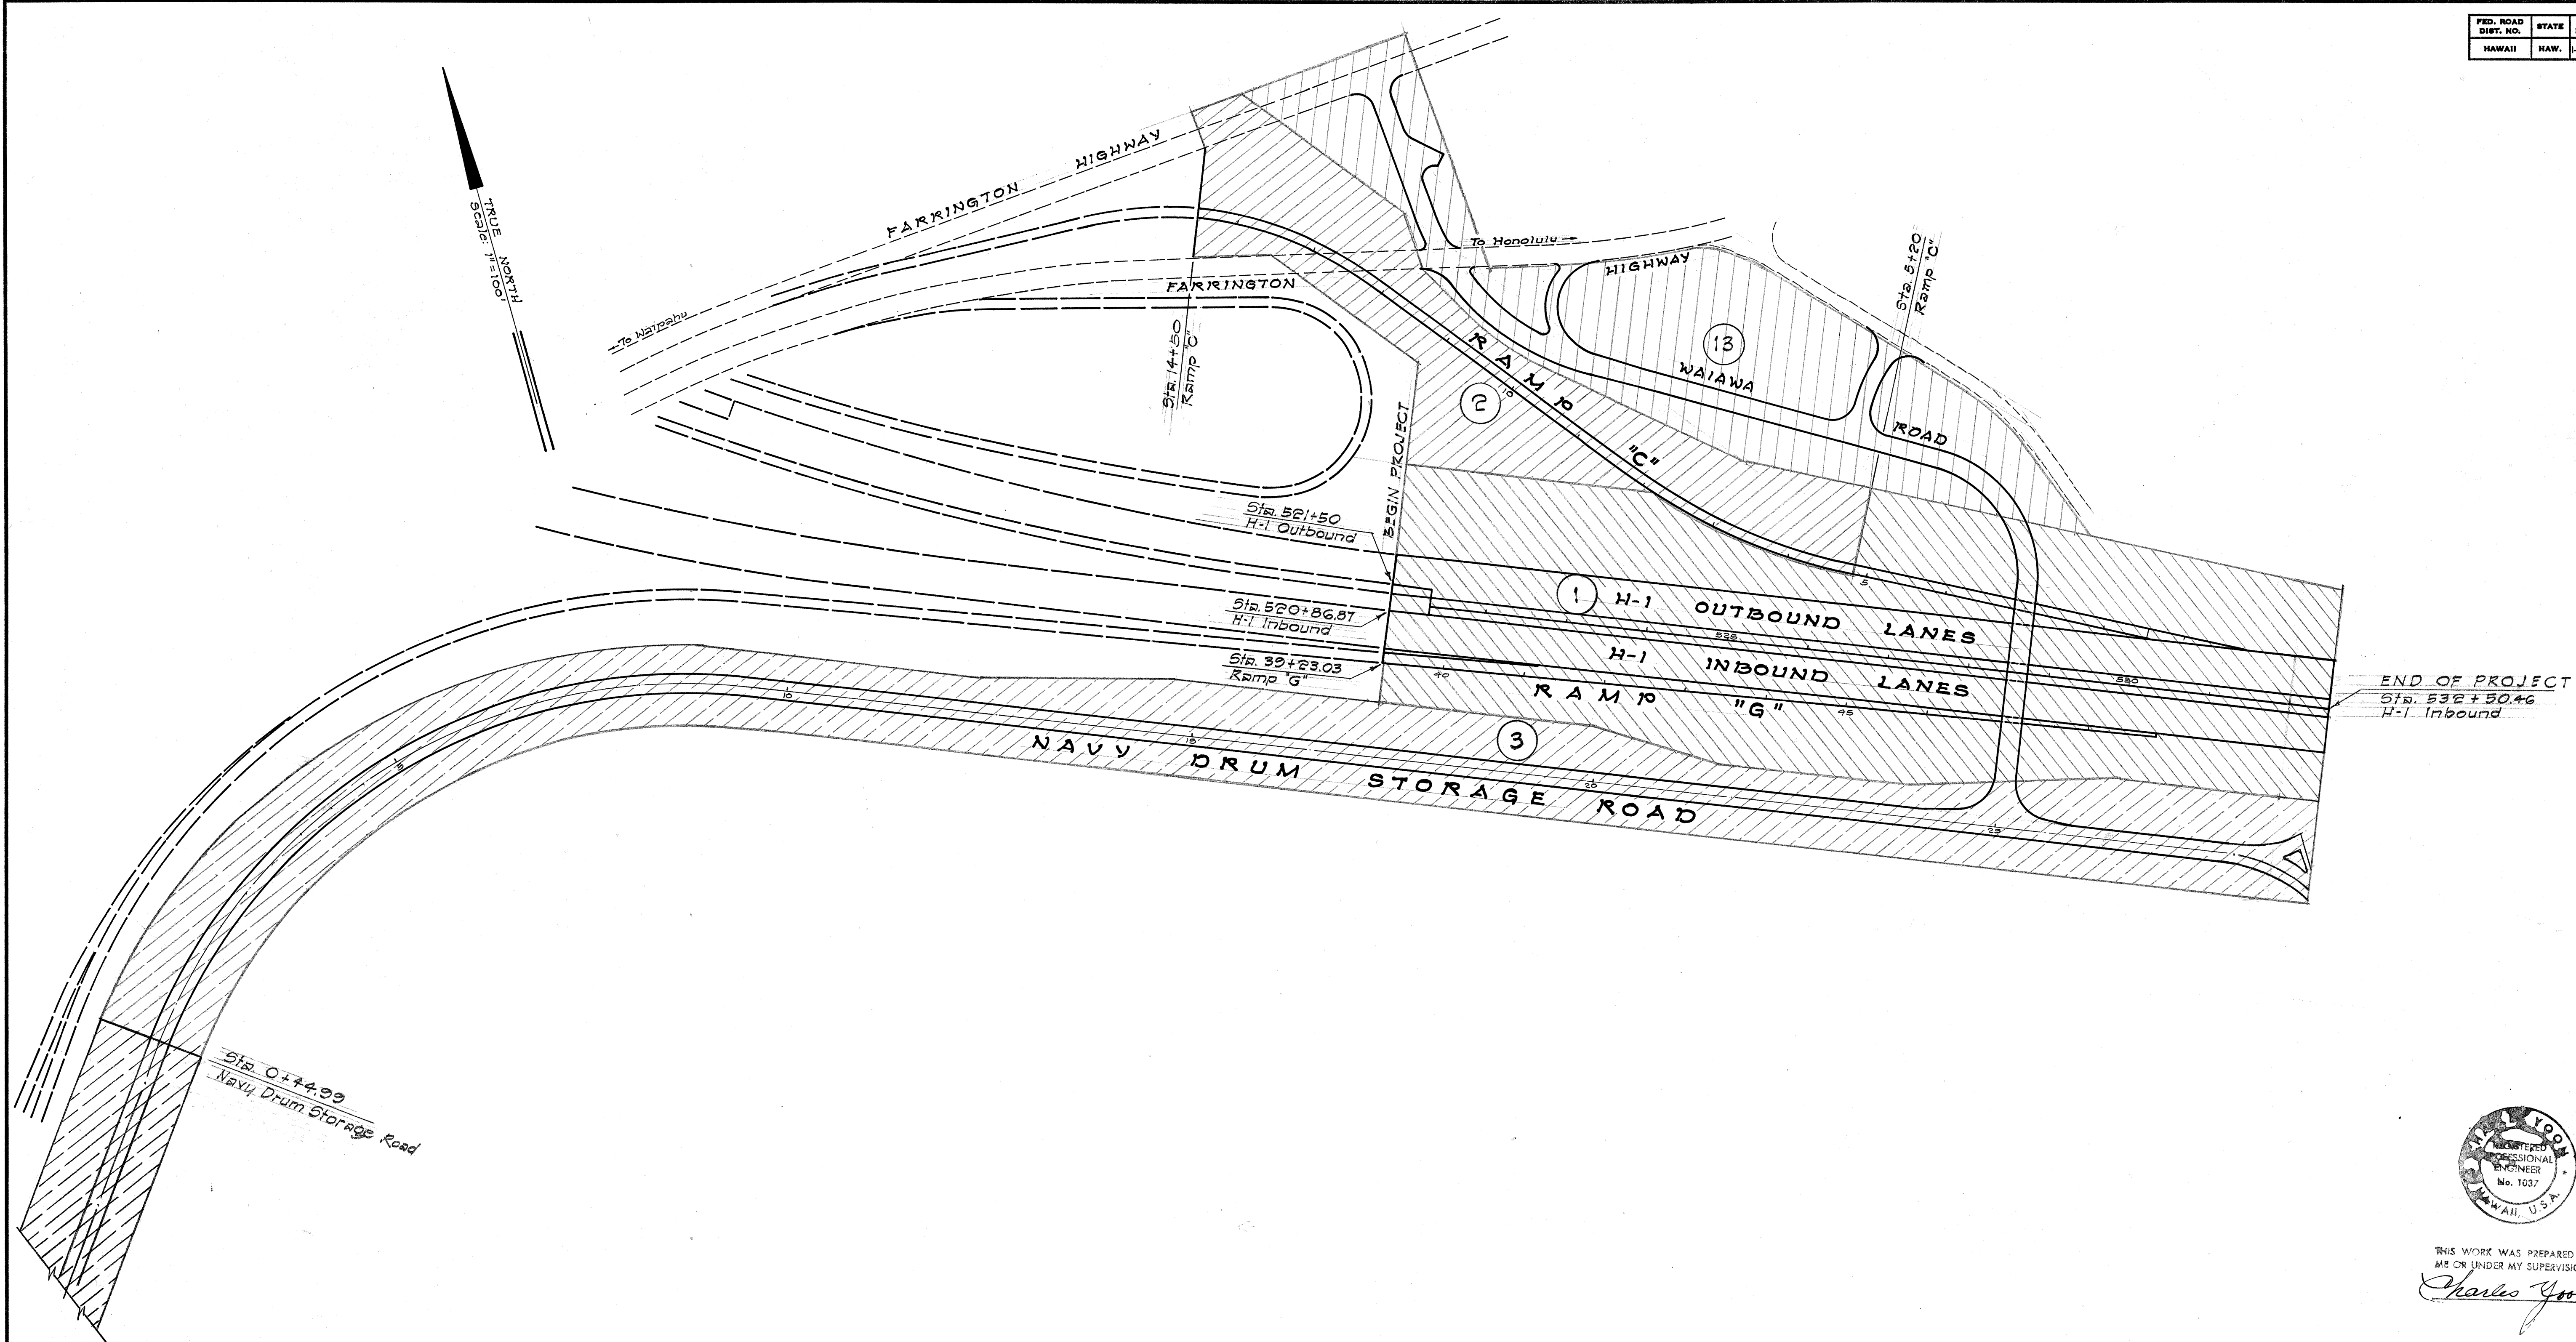

THIS WORK WAS PREPARED BY
ME OR UNDER MY SUPERVISION.

Charles Yoon

STATE OF HAWAII
DEPARTMENT OF TRANSPORTATION
HIGHWAYS DIVISION

CROSS-SECTION INDEX

F.A.I. PROJ. NO. I-HI-1(48):9

Scale: 1" = 100'

SHEET No. OF SHEETS

DESIGNED BY	DATE
DRAWN BY	
CHECKED BY	
NOTED BY	
NO.	