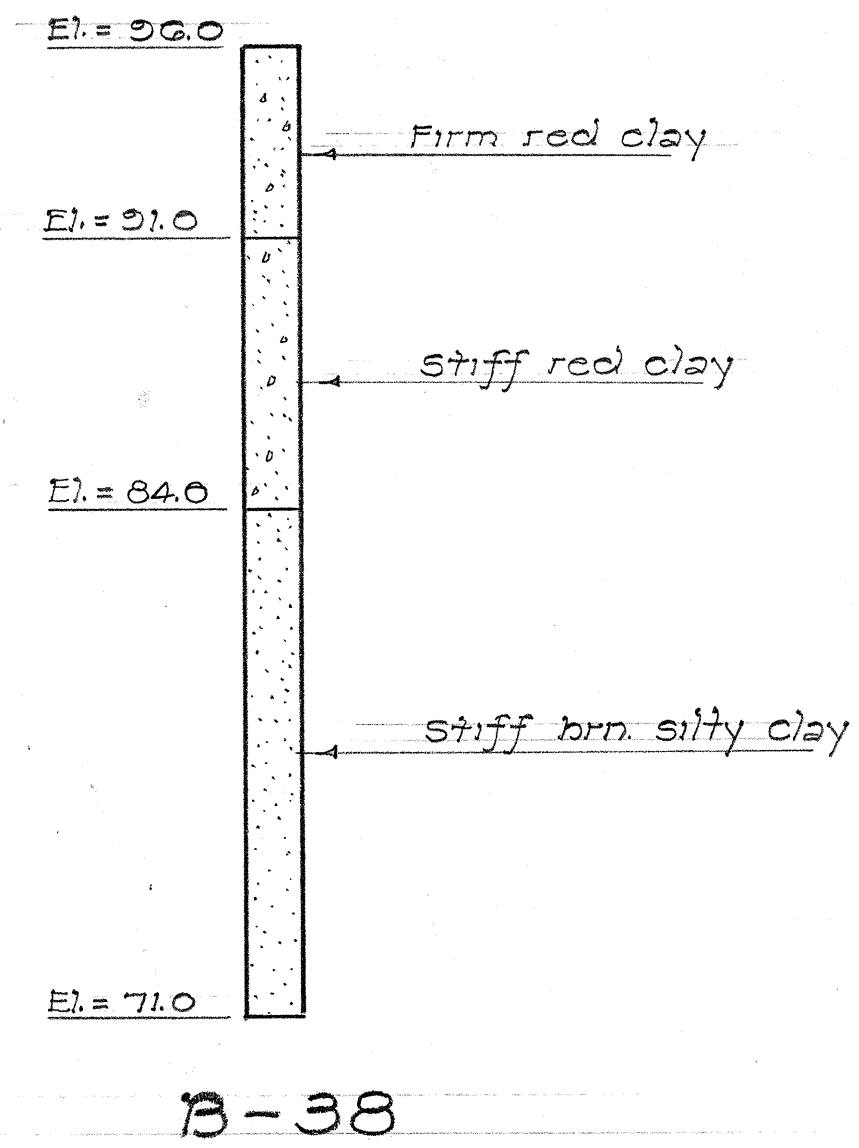
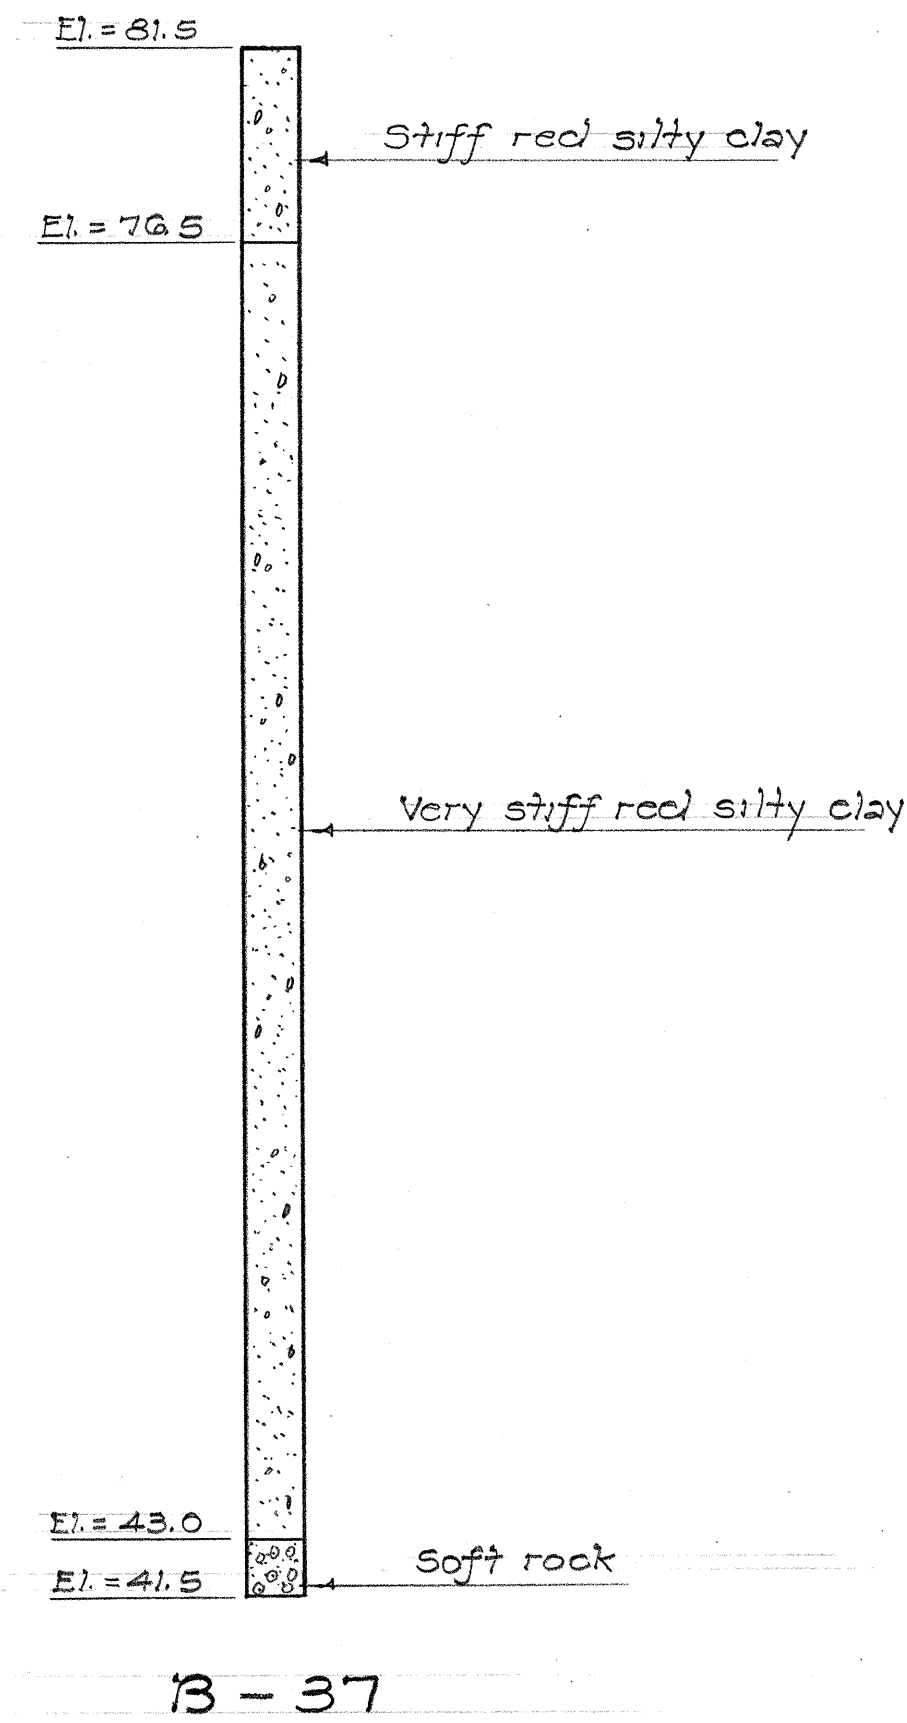
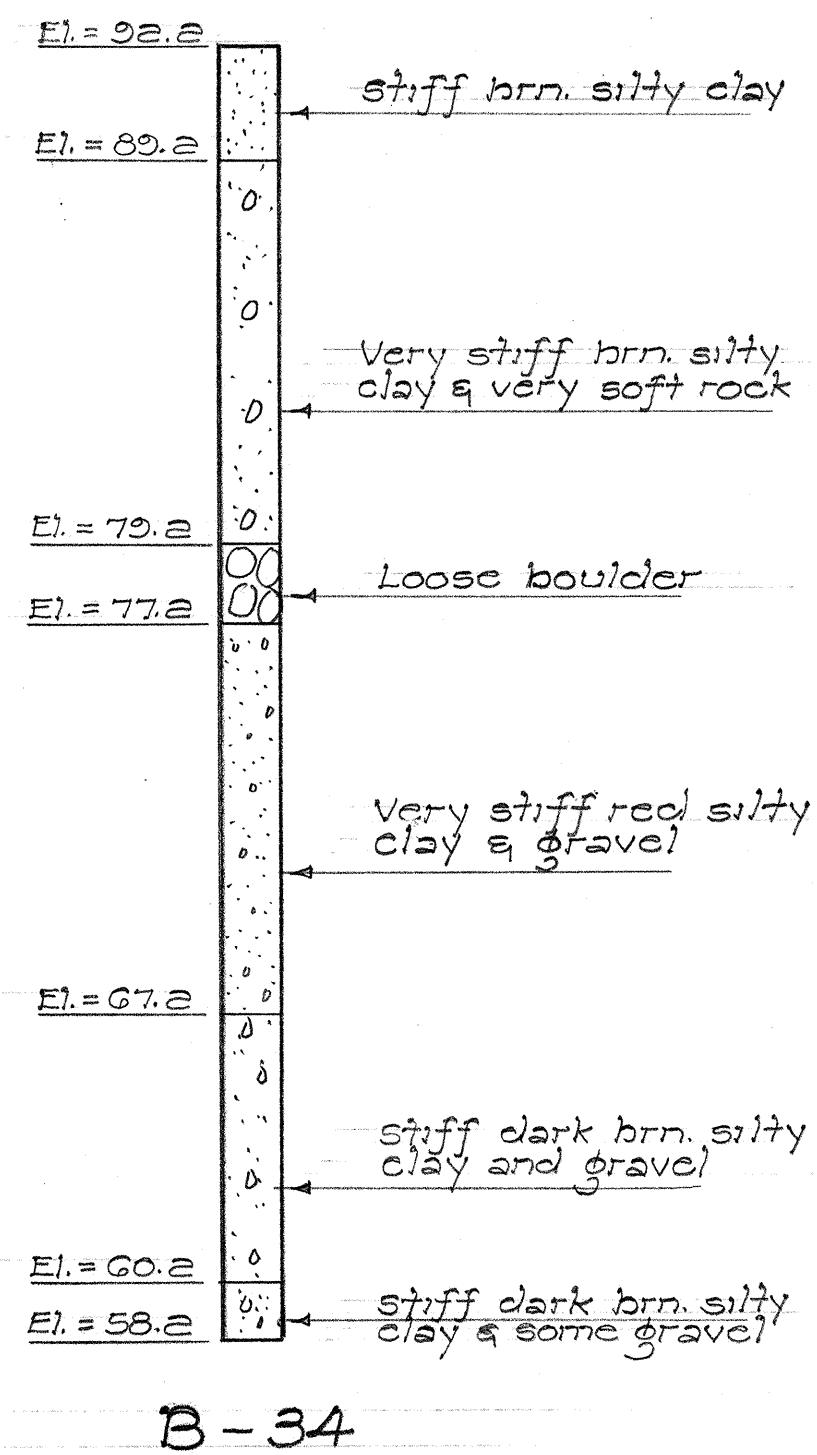
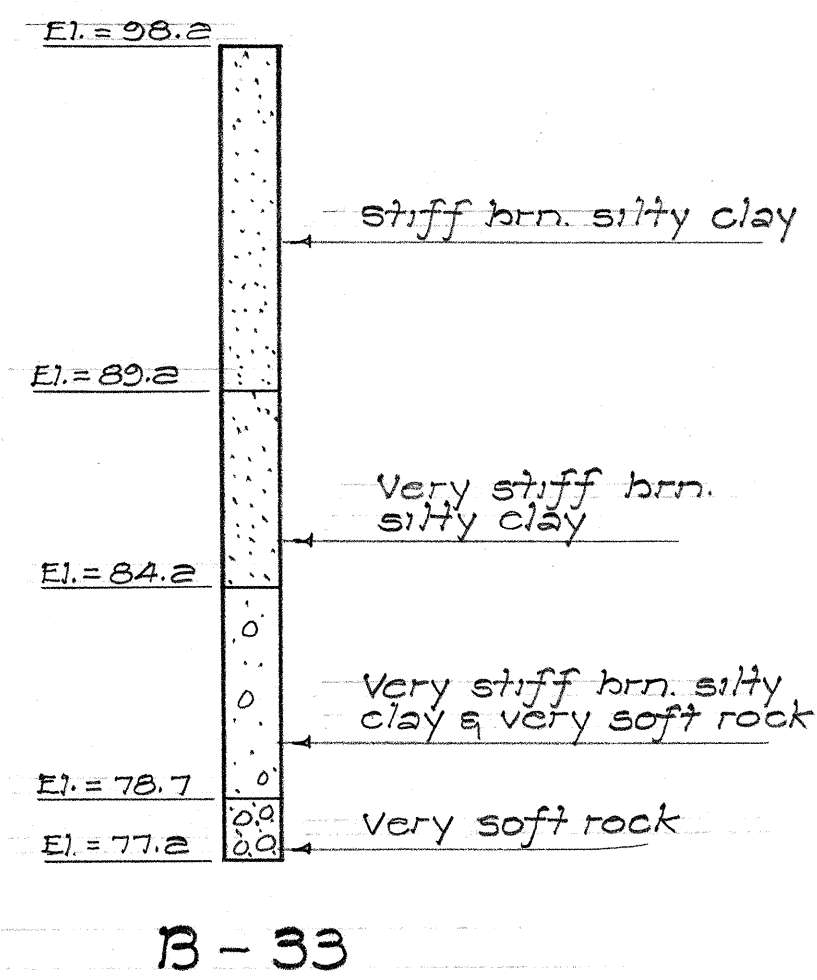
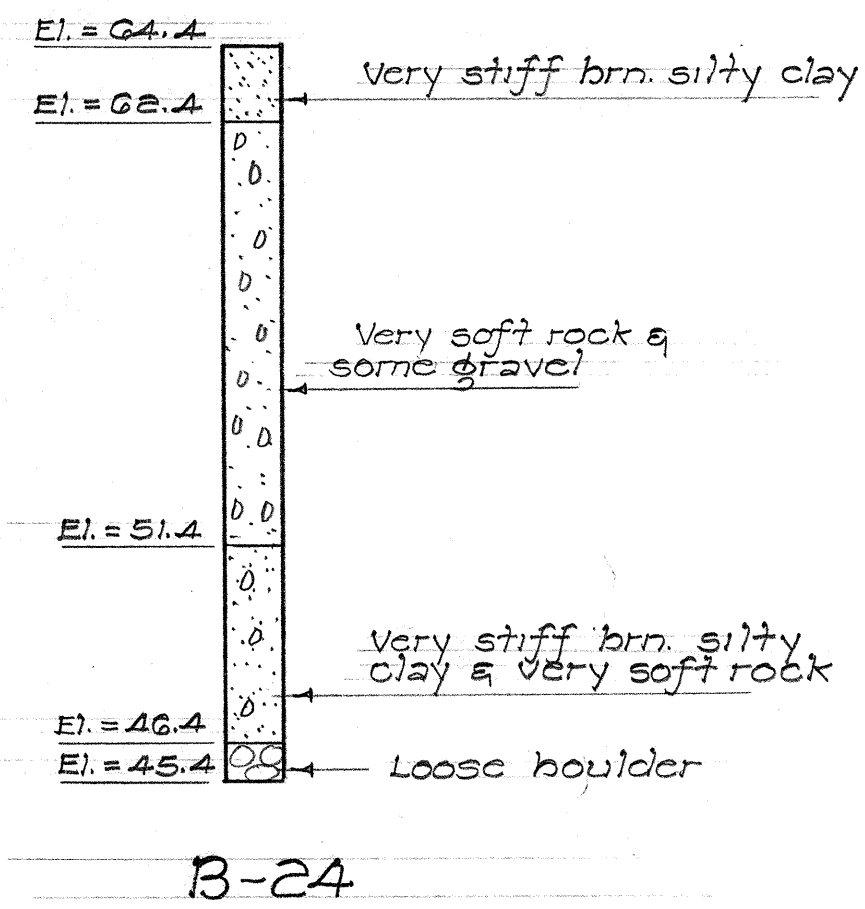
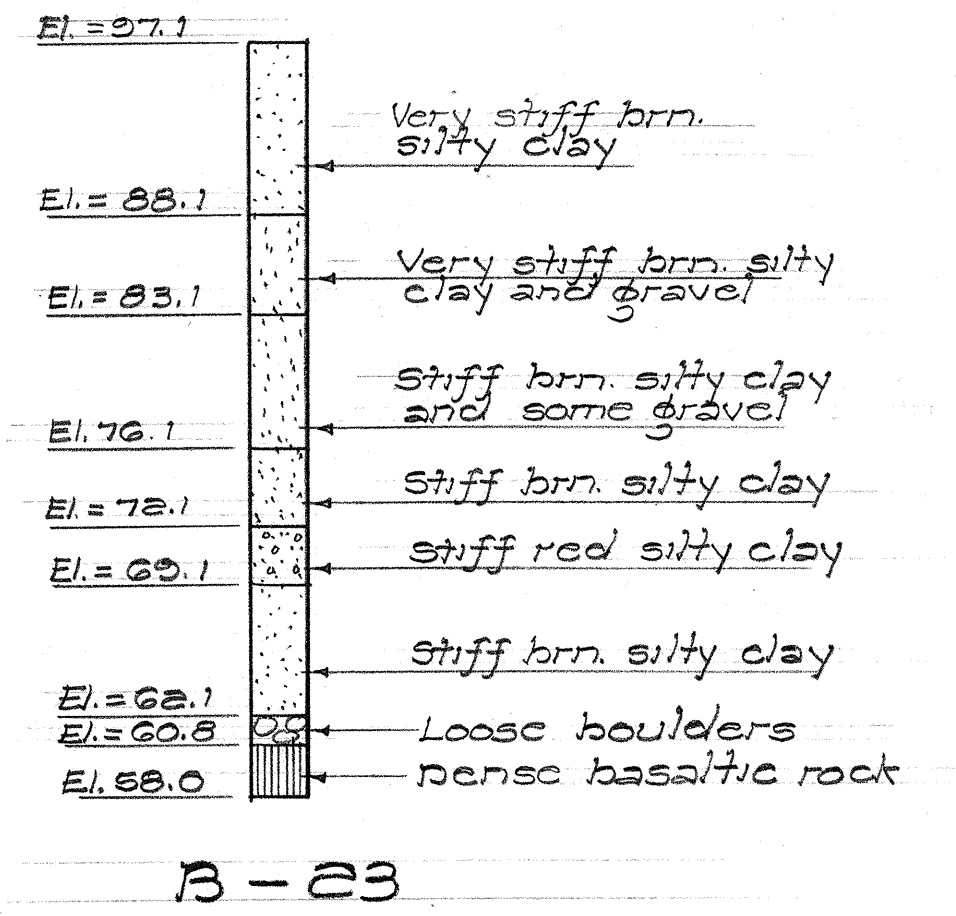
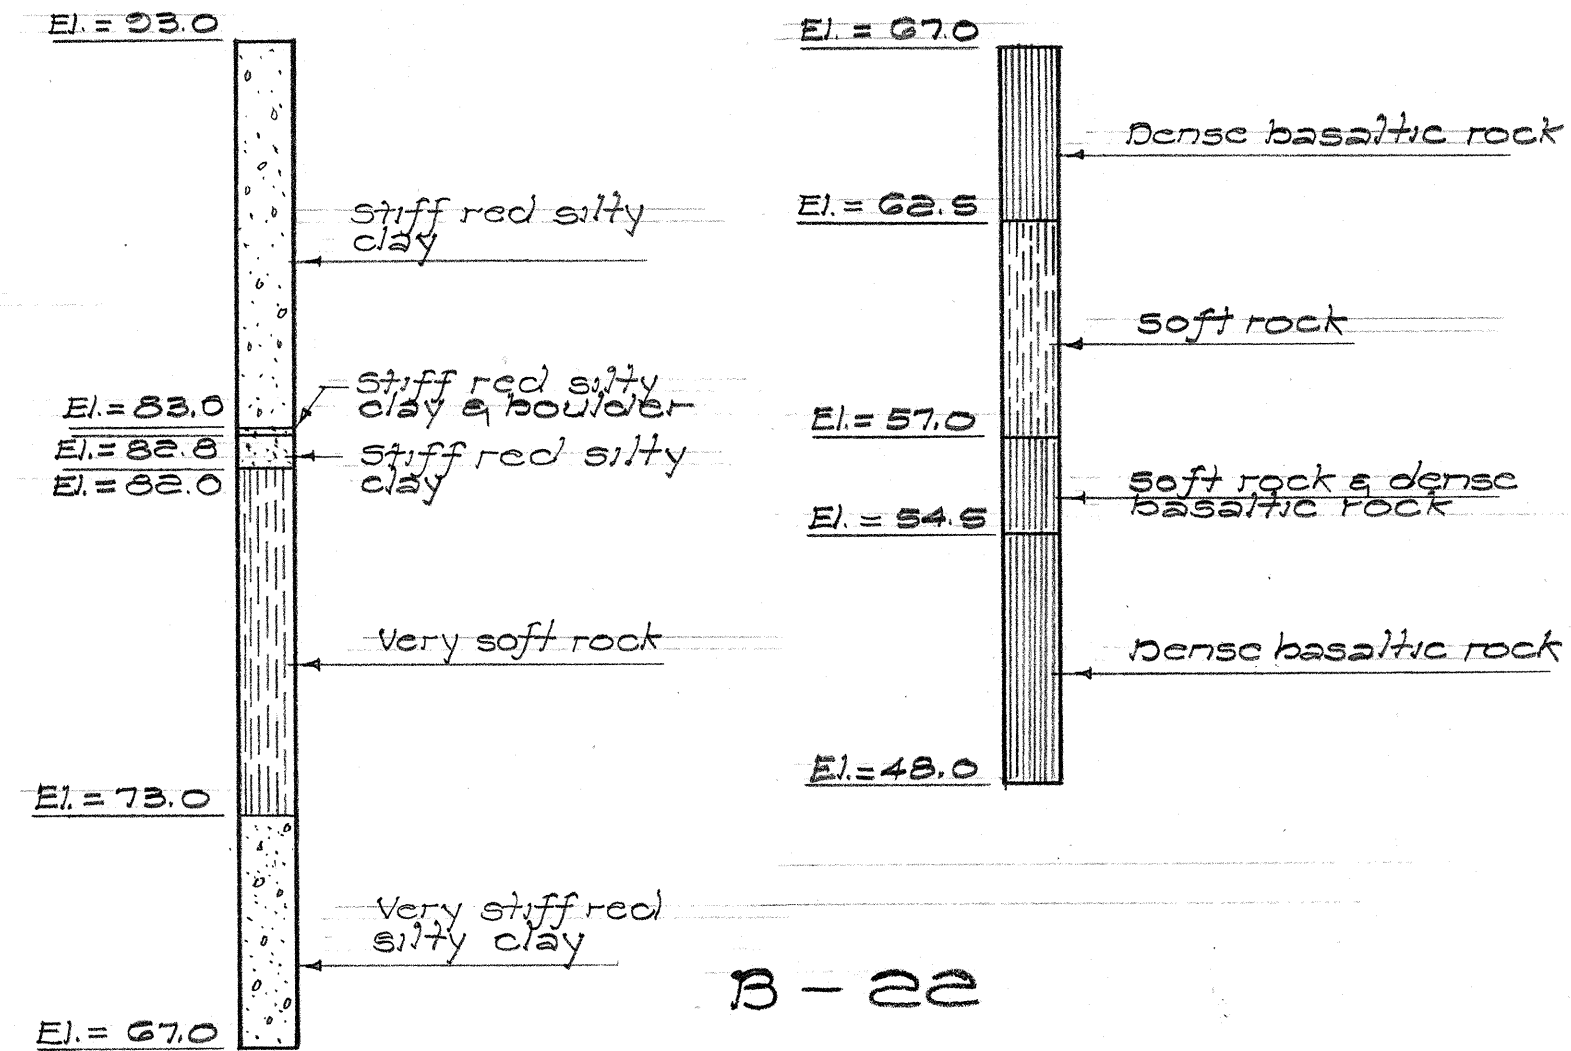
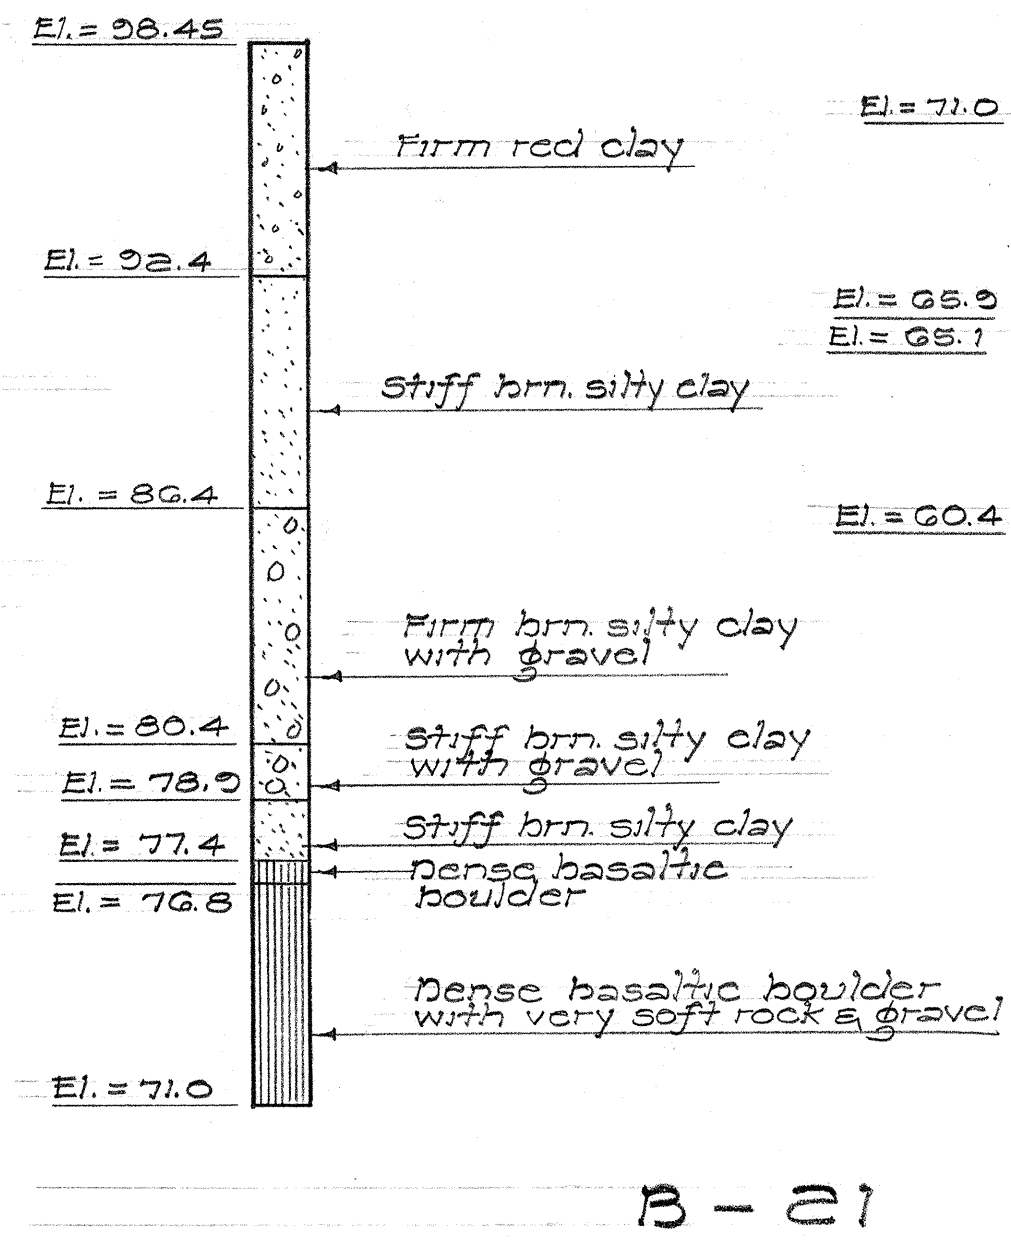
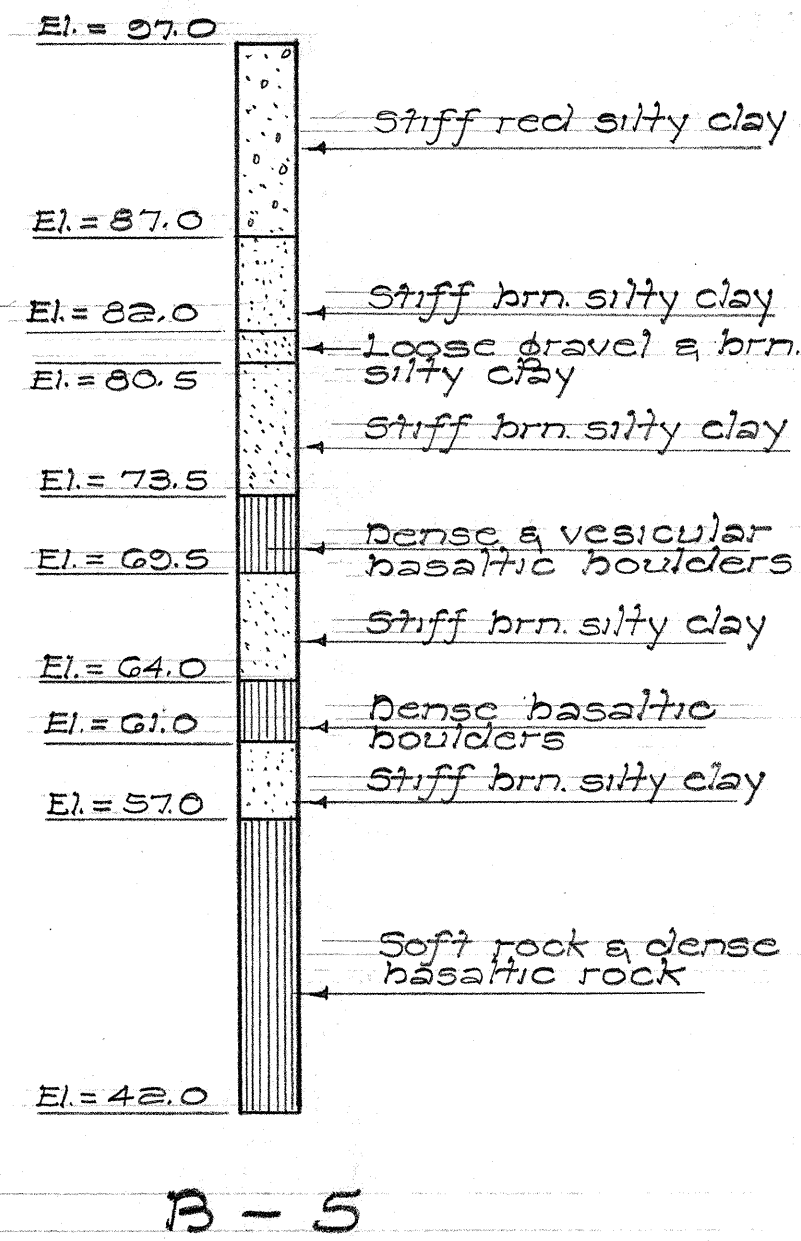
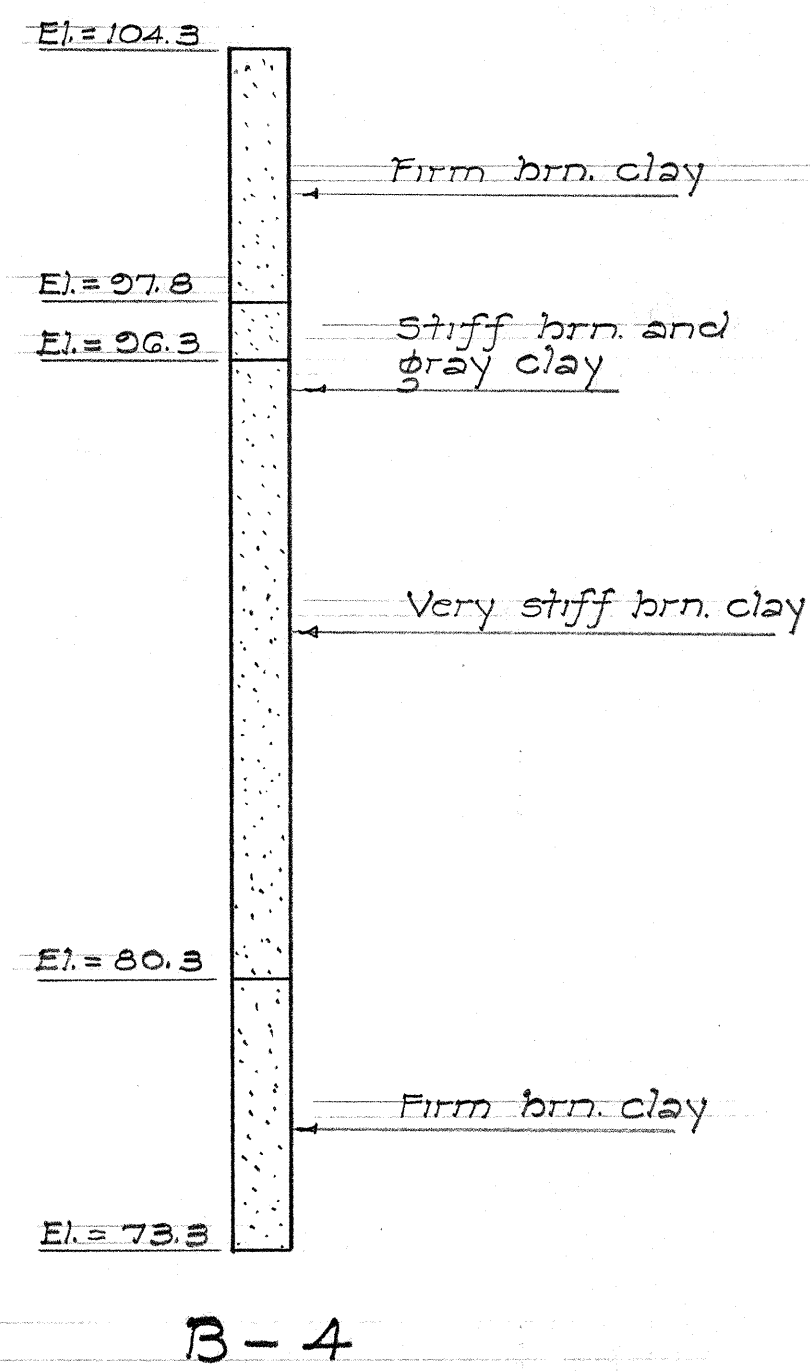


THIS WORK WAS PREPARED BY
ME OR UNDER MY SUPERVISION.
Charles Yoon

STATE OF HAWAII
DEPARTMENT OF TRANSPORTATION
HIGHWAYS DIVISION

BORING DATA

F.A.I. PROJ. NO. I-H1-1 (47)9
Scale: 1" = 5'

SHEET No. 1 OF 1 SHEETS

33