


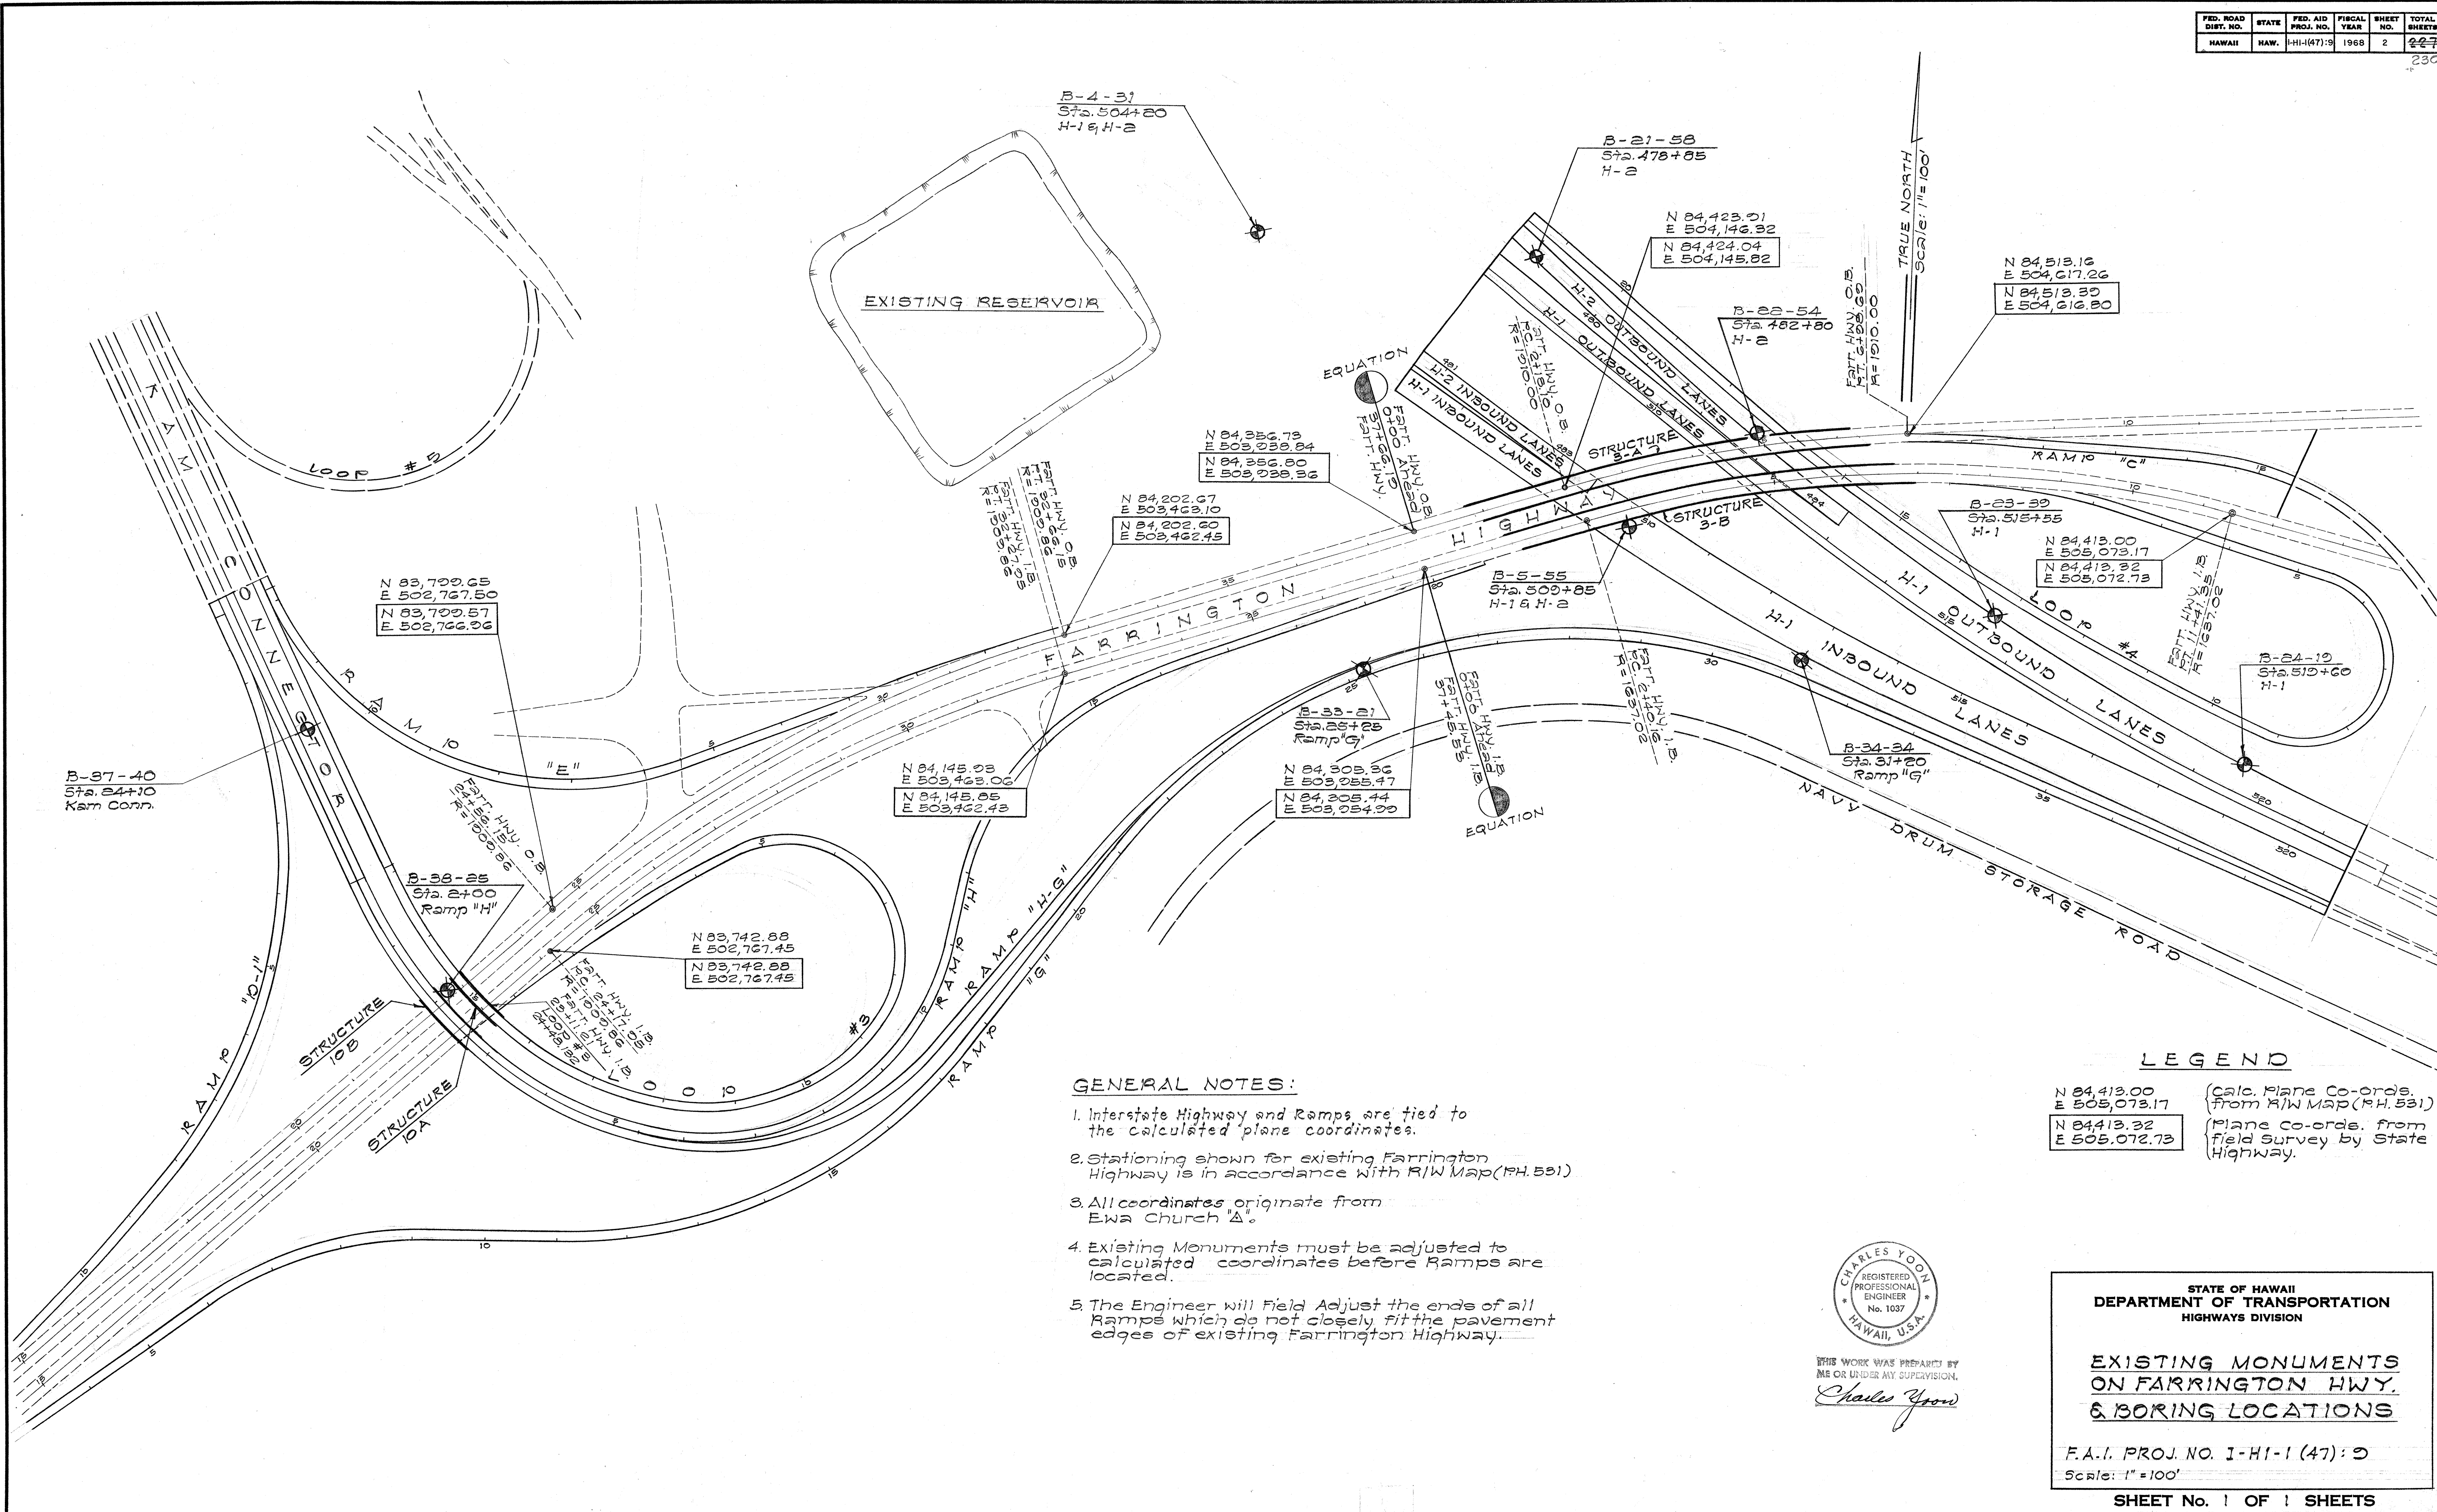


GENERAL NOTES:

- Interstate Highway and Ramps are tied to the calculated plane coordinates.
- Stationing shown for existing Farrington Highway is in accordance with R/W Map (PH. 531)
- All coordinates originate from Ewa Church "A".
- Existing Monuments must be adjusted to calculated coordinates before Ramps are located.
- The Engineer will Field Adjust the ends of all Ramps which do not closely fit the pavement edges of existing Farrington Highway.

LEGEND

N 84,413.00 E 505,073.17	(Calc. Plane Co-ords. from R/W Map (PH. 531))
N 84,413.32 E 505,072.73	(Plane Co-ords. from field survey by State Highway)

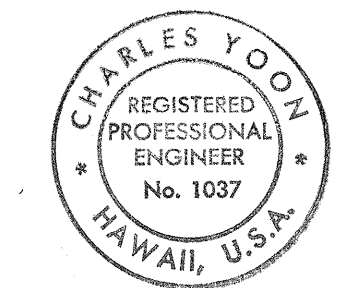

THIS WORK WAS PREPARED BY ME OR UNDER MY SUPERVISION.
Charles Yoon

STATE OF HAWAII
DEPARTMENT OF TRANSPORTATION
HIGHWAYS DIVISION

EXISTING MONUMENTS ON FARRINGTON HWY. & BORING LOCATIONS

F.A.I. PROJ. NO. I-HI-1 (47): 2
Scale: 1" = 100'

SHEET No. 1 OF 1 SHEETS

DATE	_____
DESIGNED BY	_____
DRAWN BY	_____
CHECKED BY	_____
NOTED BY	_____
NO.	_____