

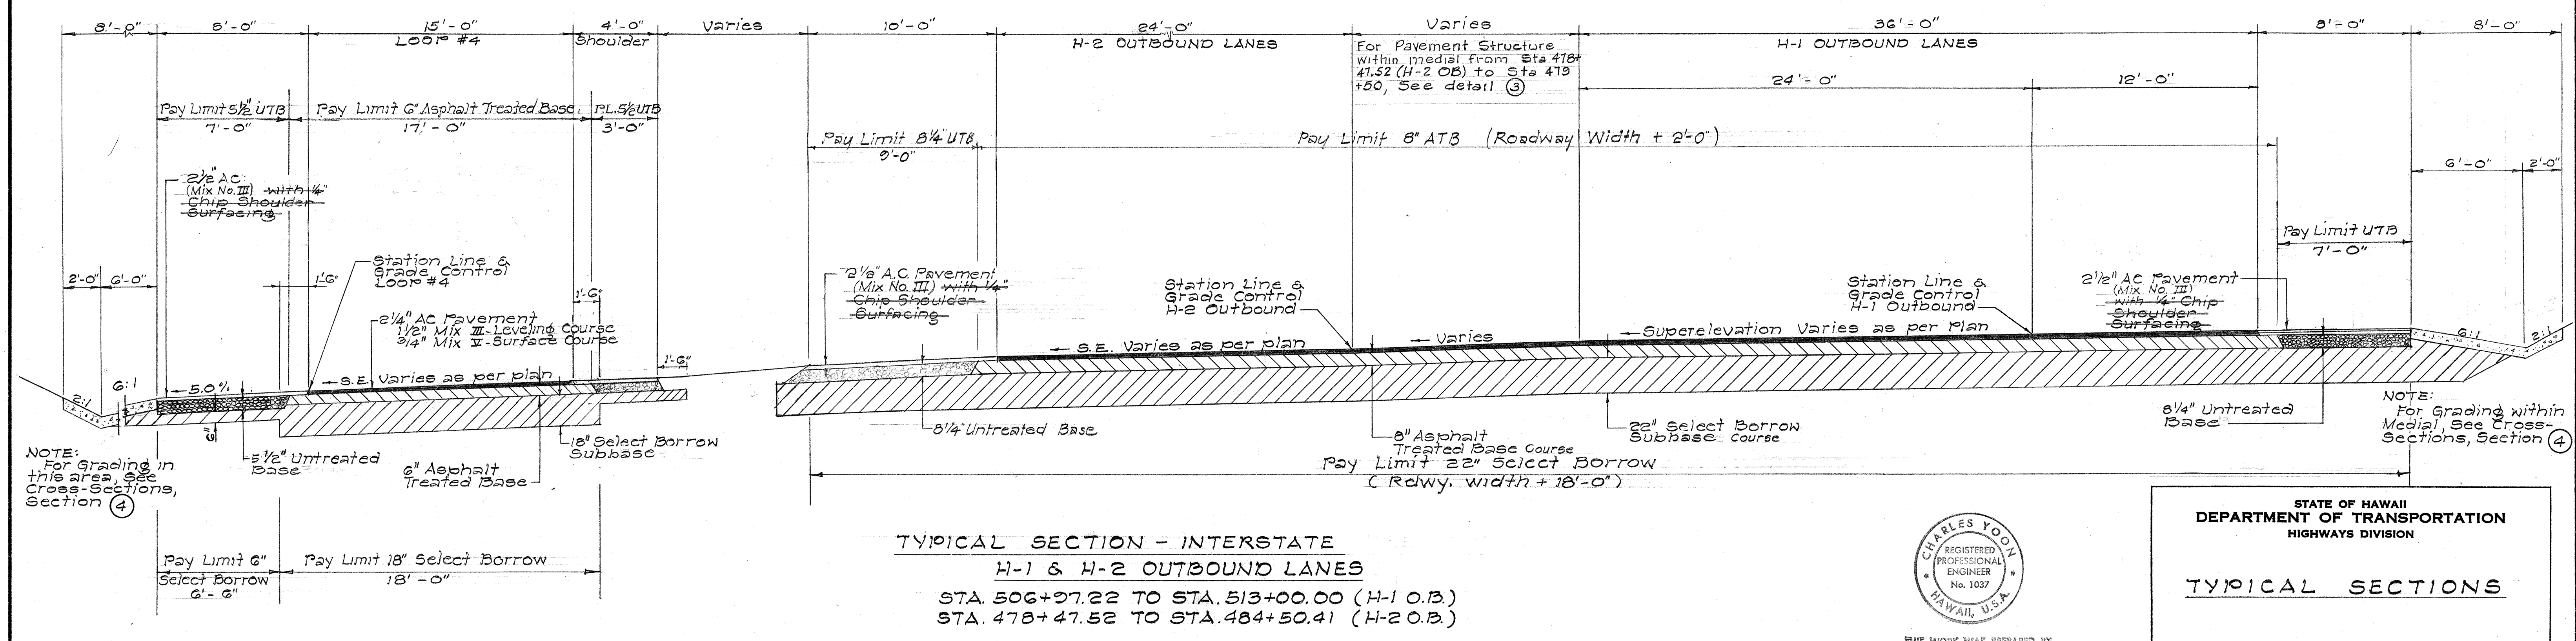


FED. ROAD DIST. NO.	STATE	FED. AID PROJ. NO.	FISCAL YEAR	SHEET NO.	TOTAL SHEETS
HAWAII	HAW.	HEH(47)9	1968	5	227

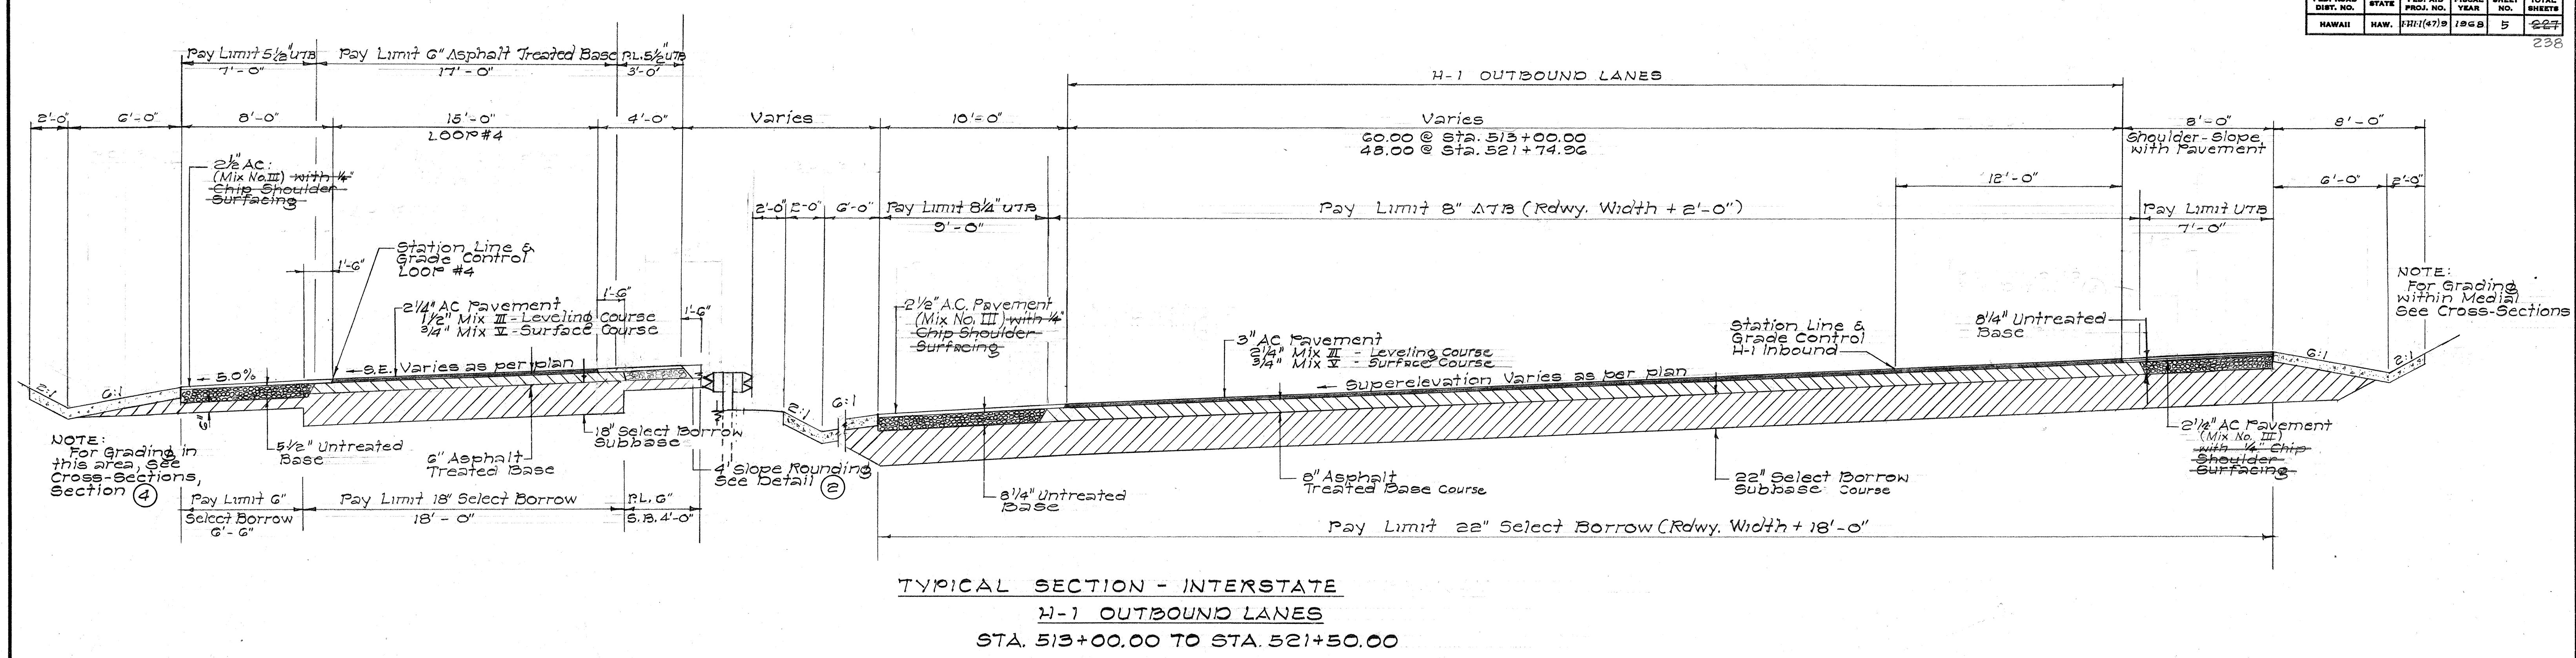

SURVEY PLOTTED BY	DATE
DESIGNED BY	
NOTED BY	
CHECKED BY	
ORIGINAL PLAN	
NOTE BOOK	
NO.	

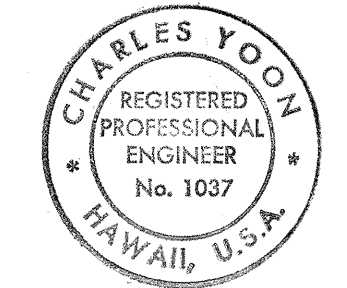

THIS WORK WAS PREPARED BY
ME OR UNDER MY SUPERVISION,
Charles Yoon


STATE OF HAWAII
DEPARTMENT OF TRANSPORTATION
HIGHWAYS DIVISION

TYPICAL SECTIONS


F.A.I. PROJ. NO. I-HI-1 (47):5
Scale: 1/4" = 1'-0"

SHEET No. 1 OF 6 SHEETS


FED. ROAD DIST. NO.	STATE	FED. AID PROJ. NO.	FISCAL YEAR	SHEET NO.	TOTAL SHEETS
HAWAII	HAW.	141-1(47) 3	1968	6	227

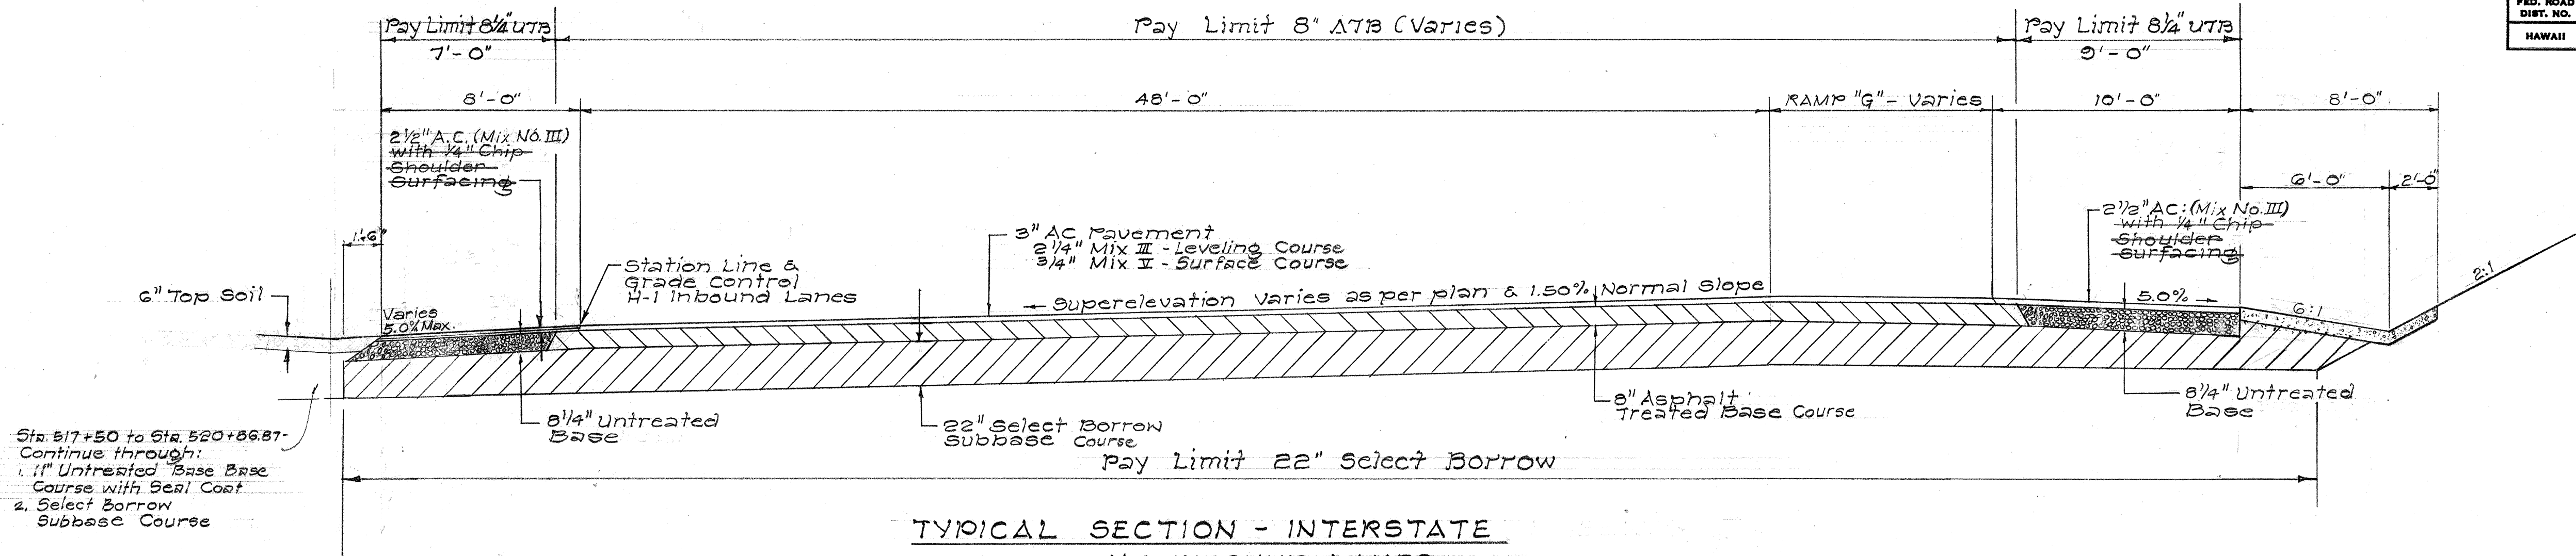


TYPICAL SECTION - INTERSTATE
H-1 INBOUND LANES
STA. 515+59.23 TO STA. 520+86.87

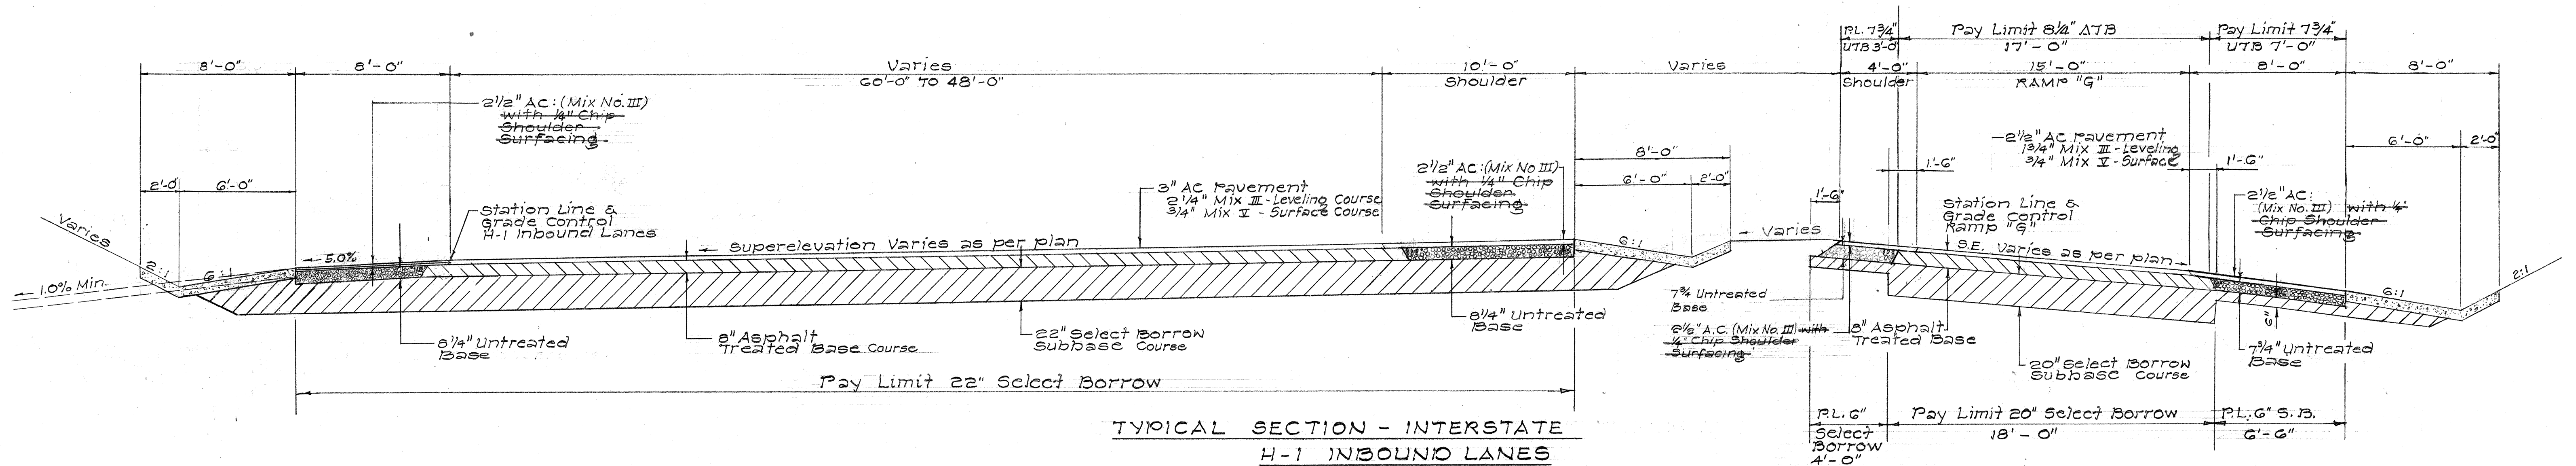

TYPICAL SECTION - INTERSTATE
H-1 INBOUND LANES
STA. 503+10.31 TO STA. 515+59.23

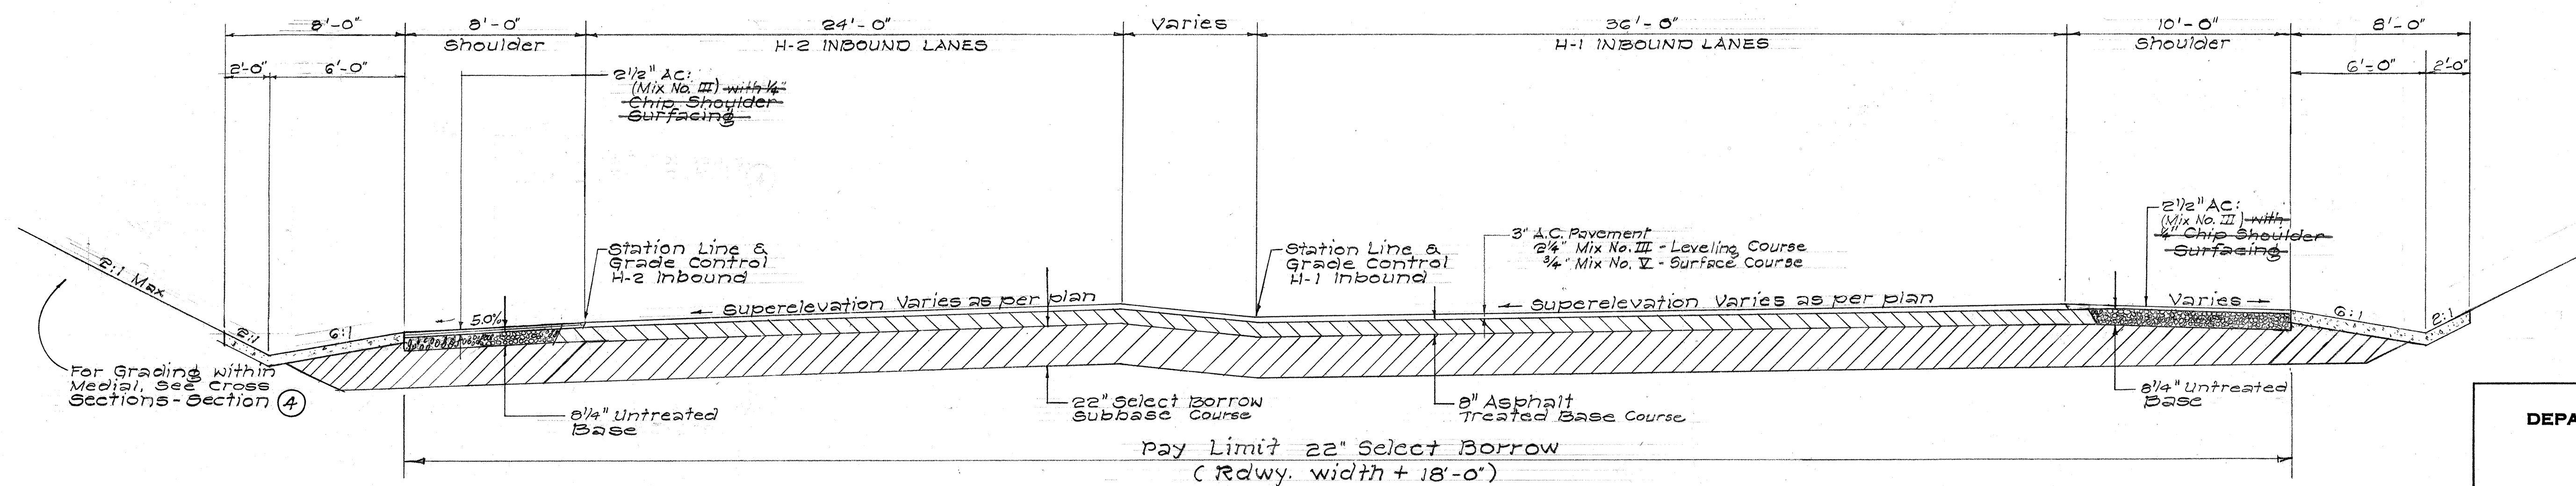

TYPICAL SECTION - INTERSTATE
H-1 & H-2 INBOUND LANES
STA. 506+12.08 TO STA. 509+10.31 (H-1 I.B.)
STA. 480+60.31 TO STA. 483+57.54 (H-2 I.B.)

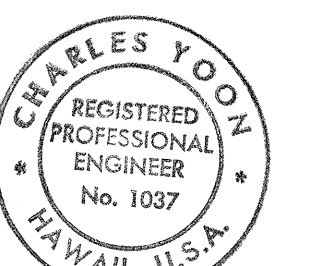

THIS WORK WAS PREPARED BY
ME OR UNDER MY SUPERVISION,
Charles Yoon


STATE OF HAWAII
DEPARTMENT OF TRANSPORTATION
HIGHWAYS DIVISION

TYPICAL SECTIONS

F.A.I. PROJ. NO. I-HI-1(47)-3
Scale: 1/4" = 1'-0"


SHEET No. 2 OF 6 SHEETS

5

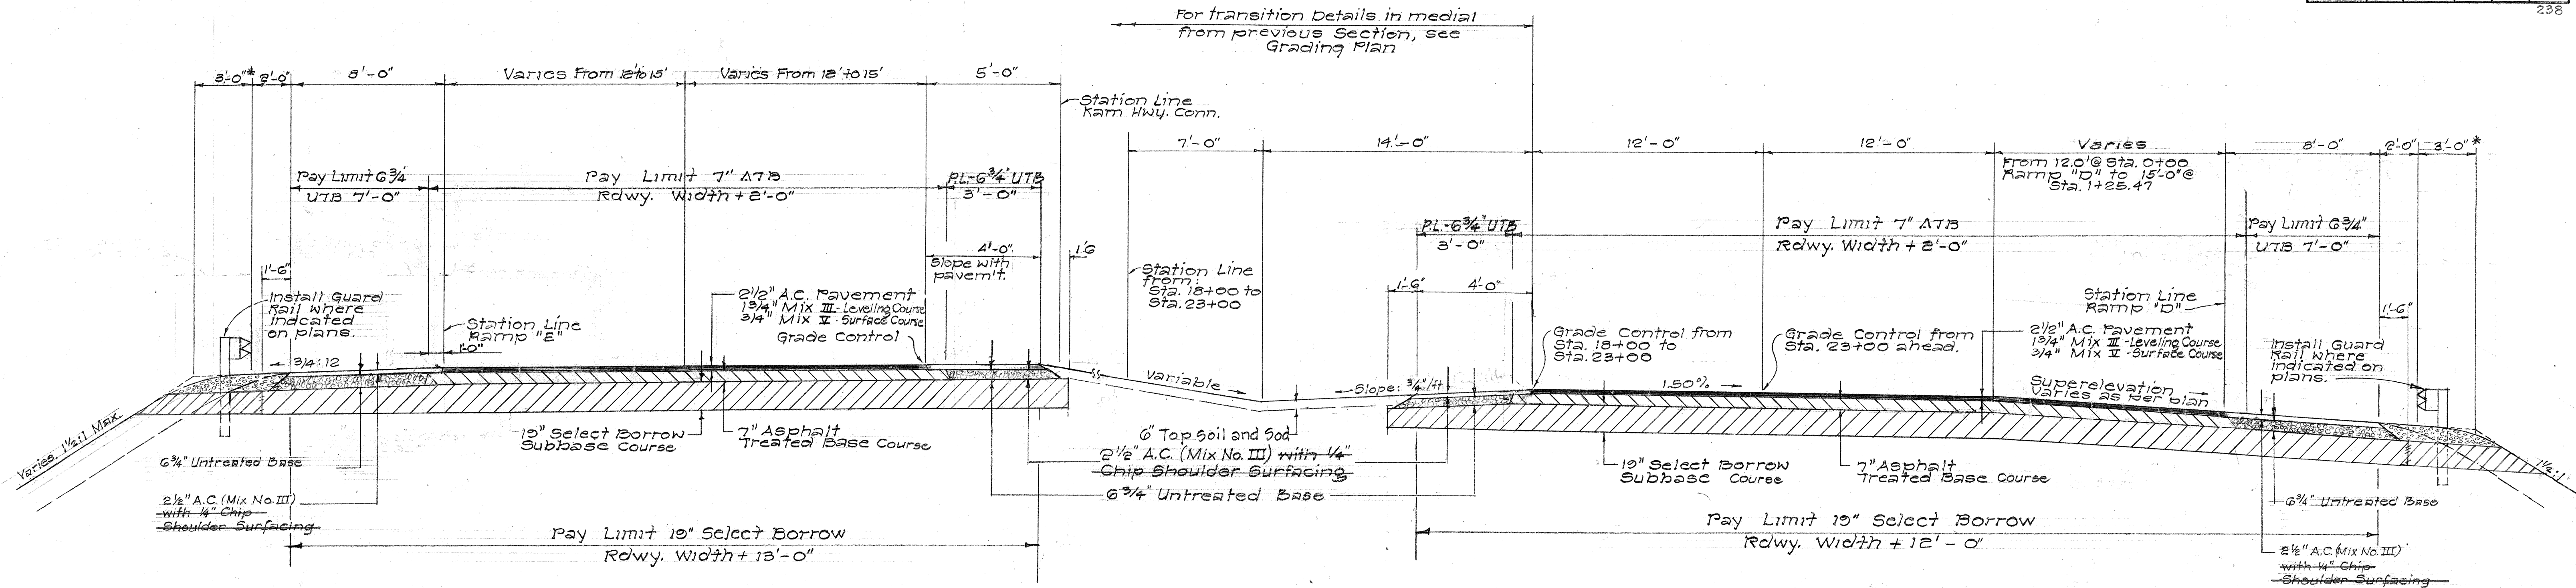


TYPICAL SECTION - KAM HWY. CONNECTOR
OUTBOUND LANES
STA. 22+13.55 TO STA. 22+82.60

TYPICAL SECTION - KAM HWY. CONNECTOR
INBOUND LANES
STA. 22+13.55 TO STA. 23+51.65

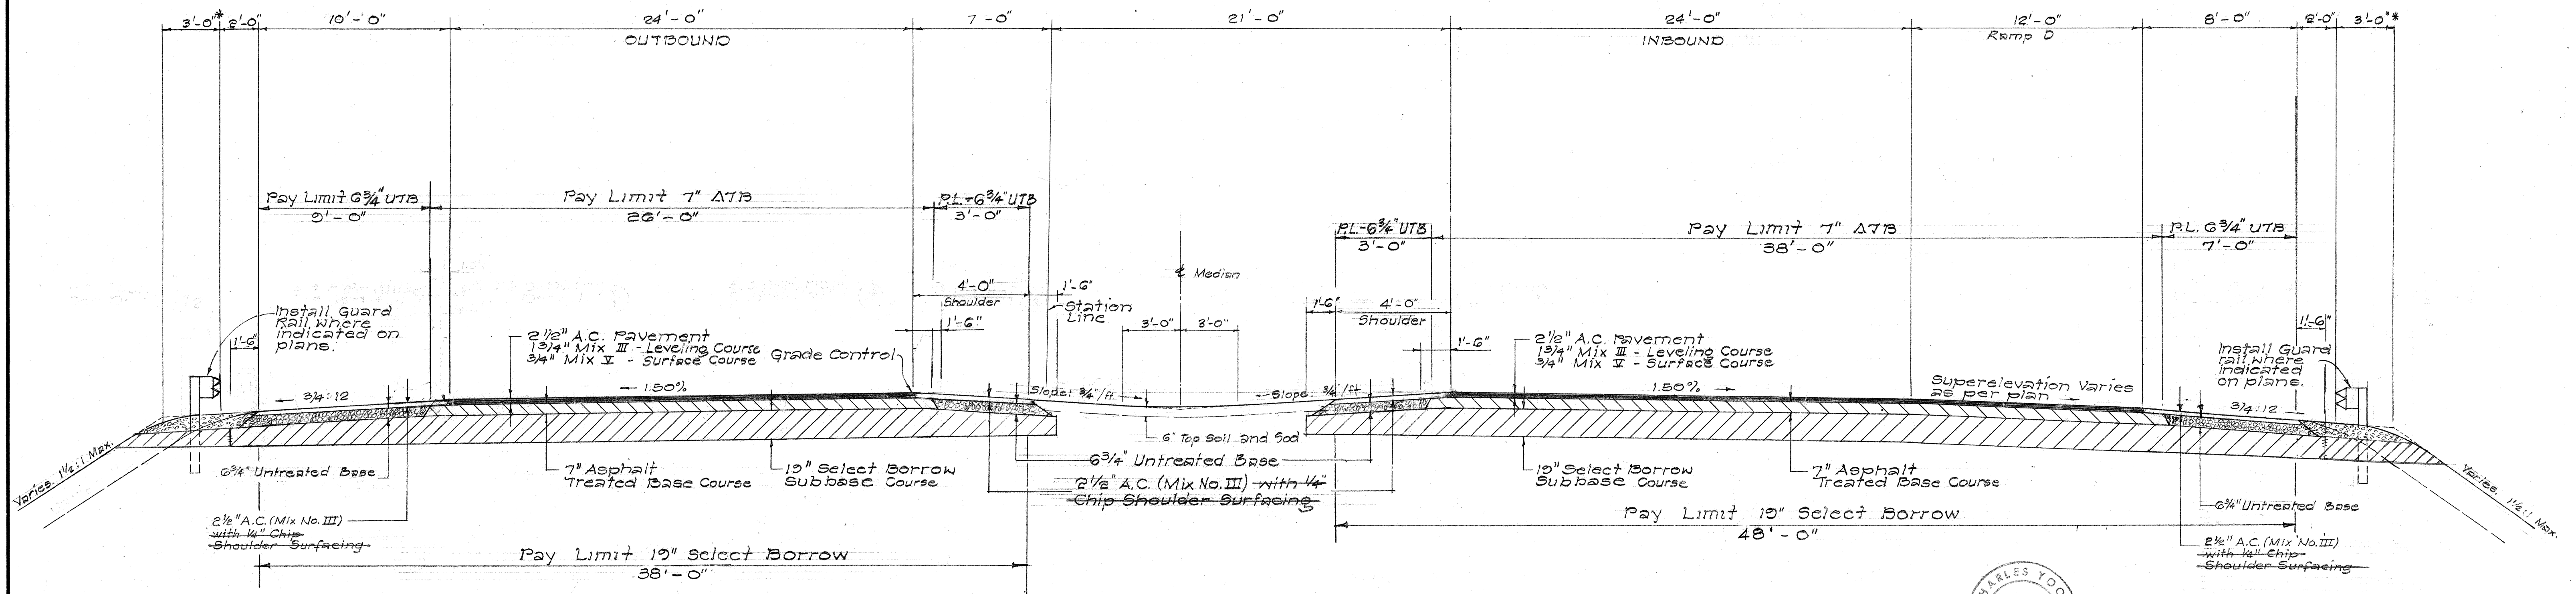

TYPICAL SECTION - KAM HWY. CONNECTOR
STA. 22+00.00 TO STA. 22+13.55 (O.B. & I.B. LANES)
STA. 4+37.00 TO STA. 9+42.00 (O.B. LANES ONLY)

NOTE: The plant material for areas to be sodded shall be Bermuda Grass (Cynodon Dactylon).

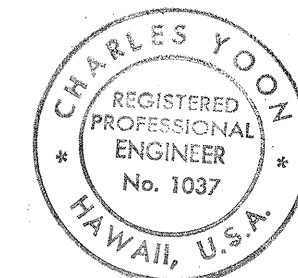

THIS WORK WAS PREPARED BY
ME OR UNDER MY SUPERVISION.

Charles Yoon

STATE OF HAWAII
DEPARTMENT OF TRANSPORTATION
HIGHWAYS DIVISION


TYPICAL SECTIONS

F.A.I. PROJ. NO. I-HI-1 (47): 3


Scale: 1/4" = 1'-0"

SHEET No. 3 OF 6 SHEETS


*NOTE: Extra 3' widening required
only where Guard Rail is indicated.

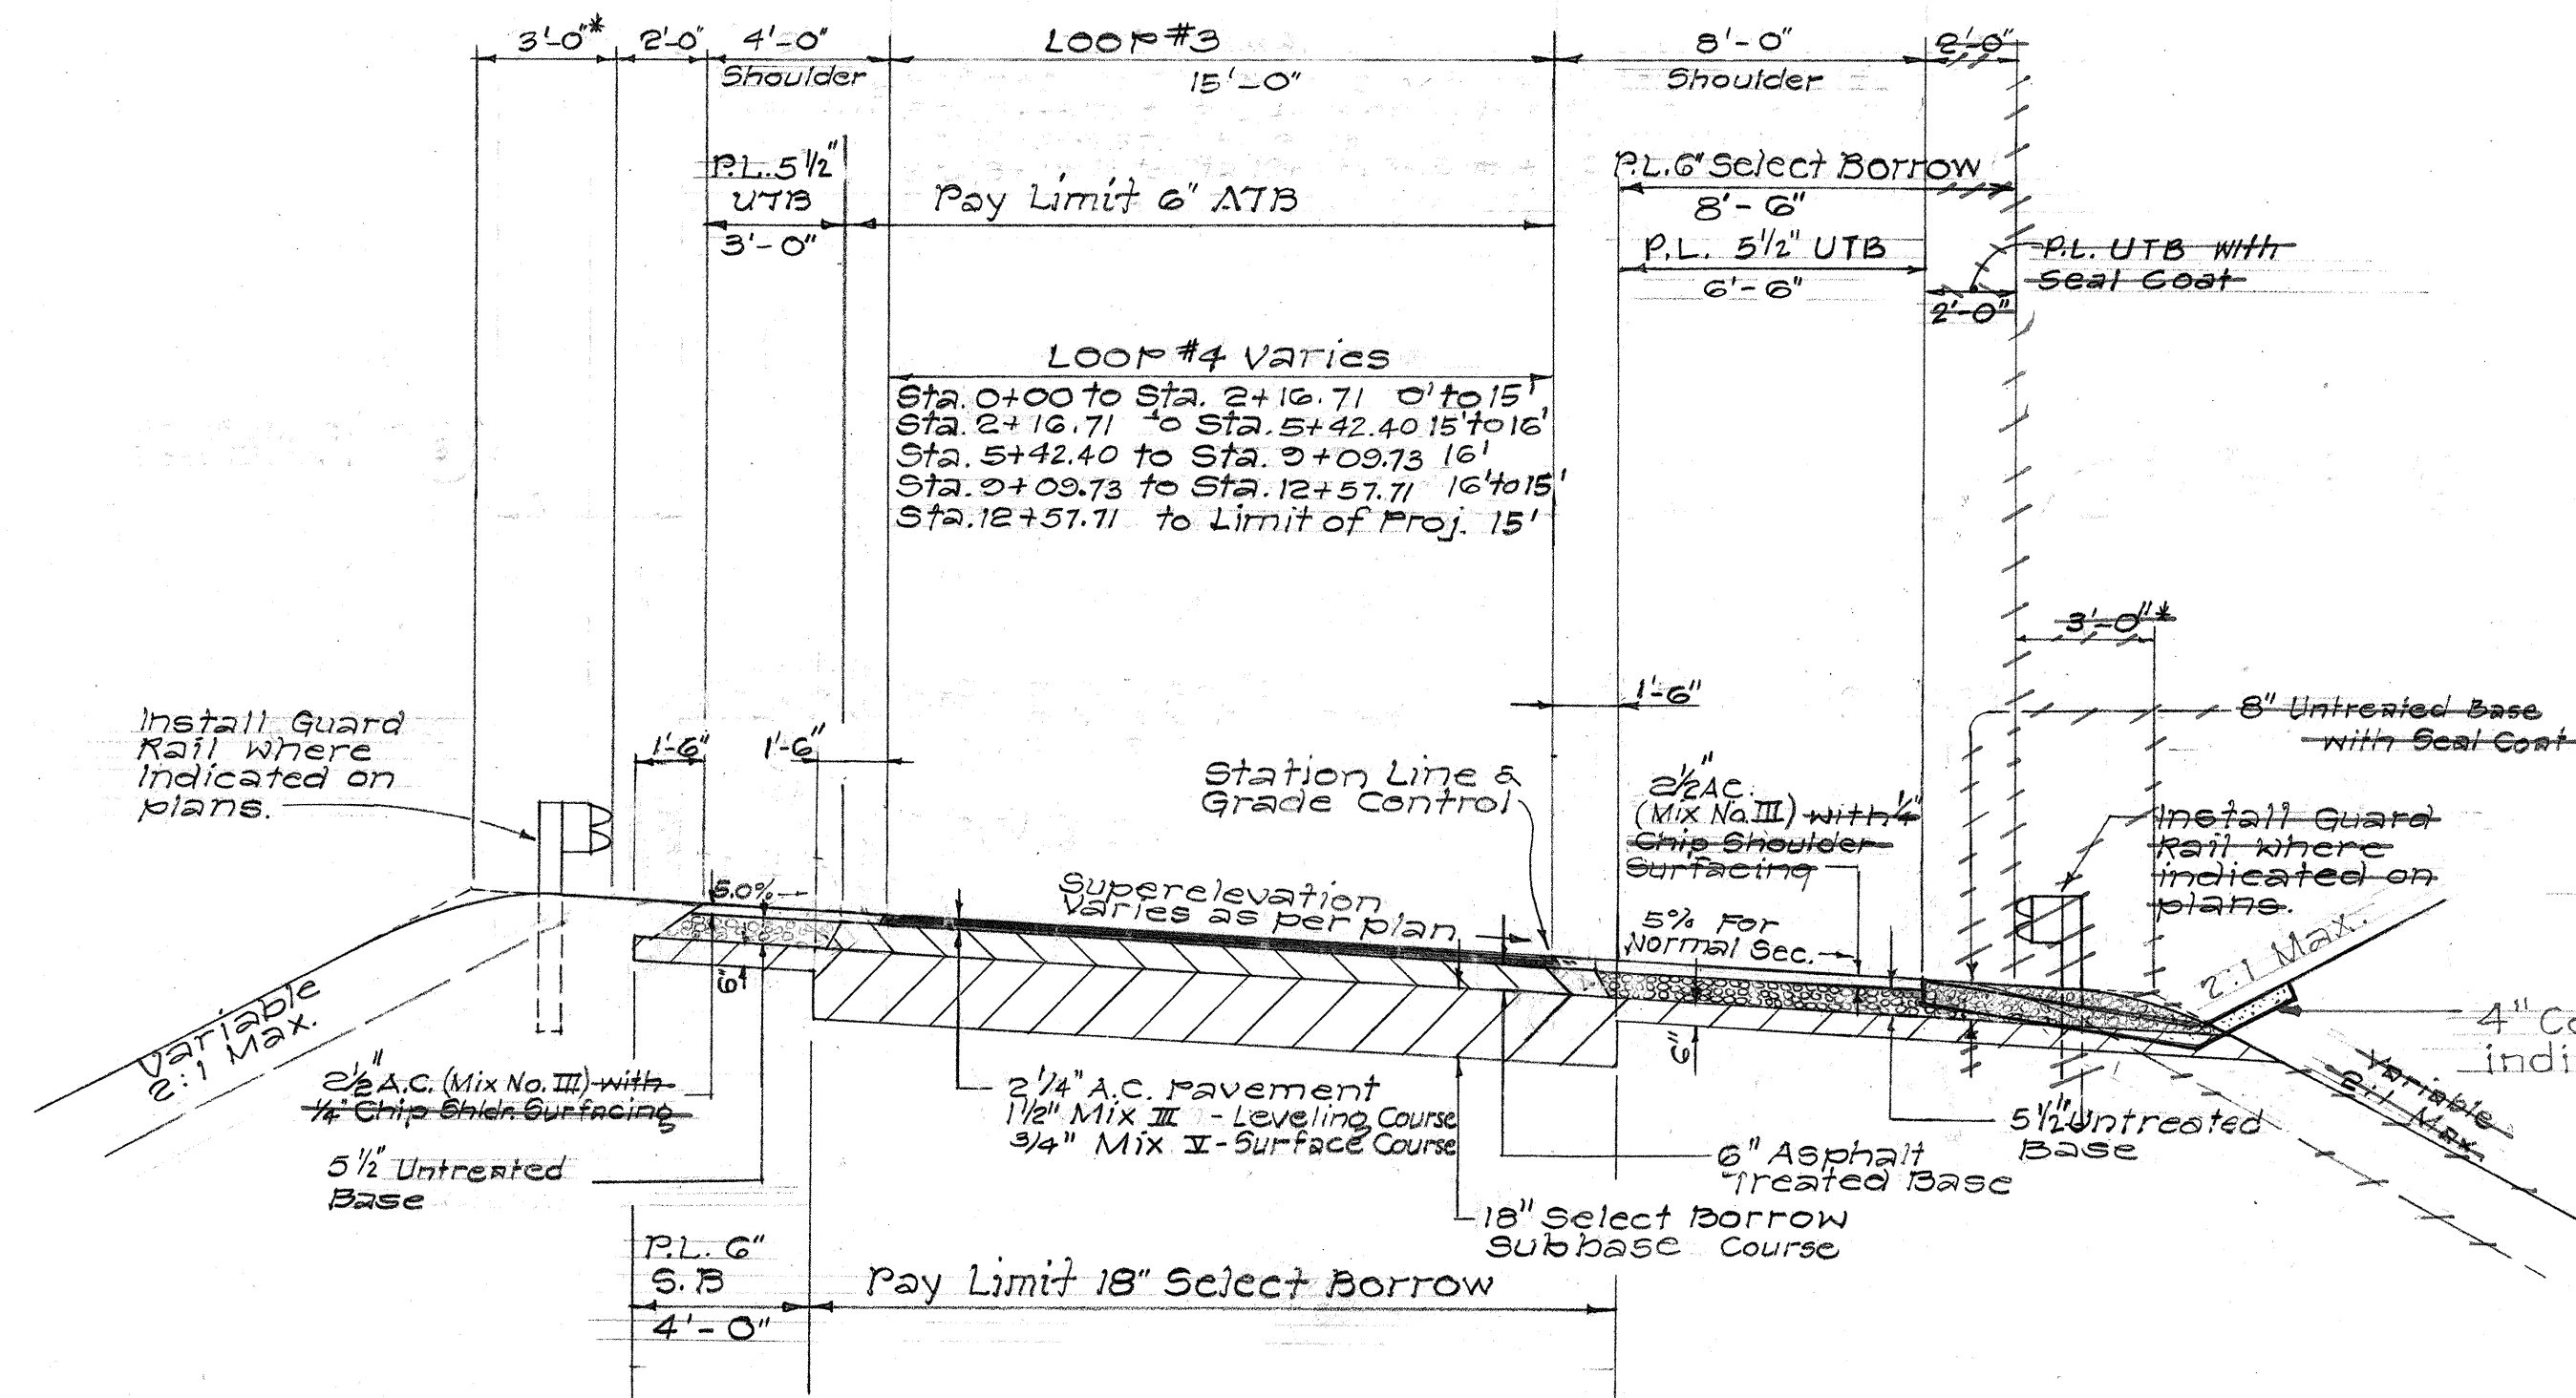


TYPICAL SECTION - LOOP #3
& LOOP #4

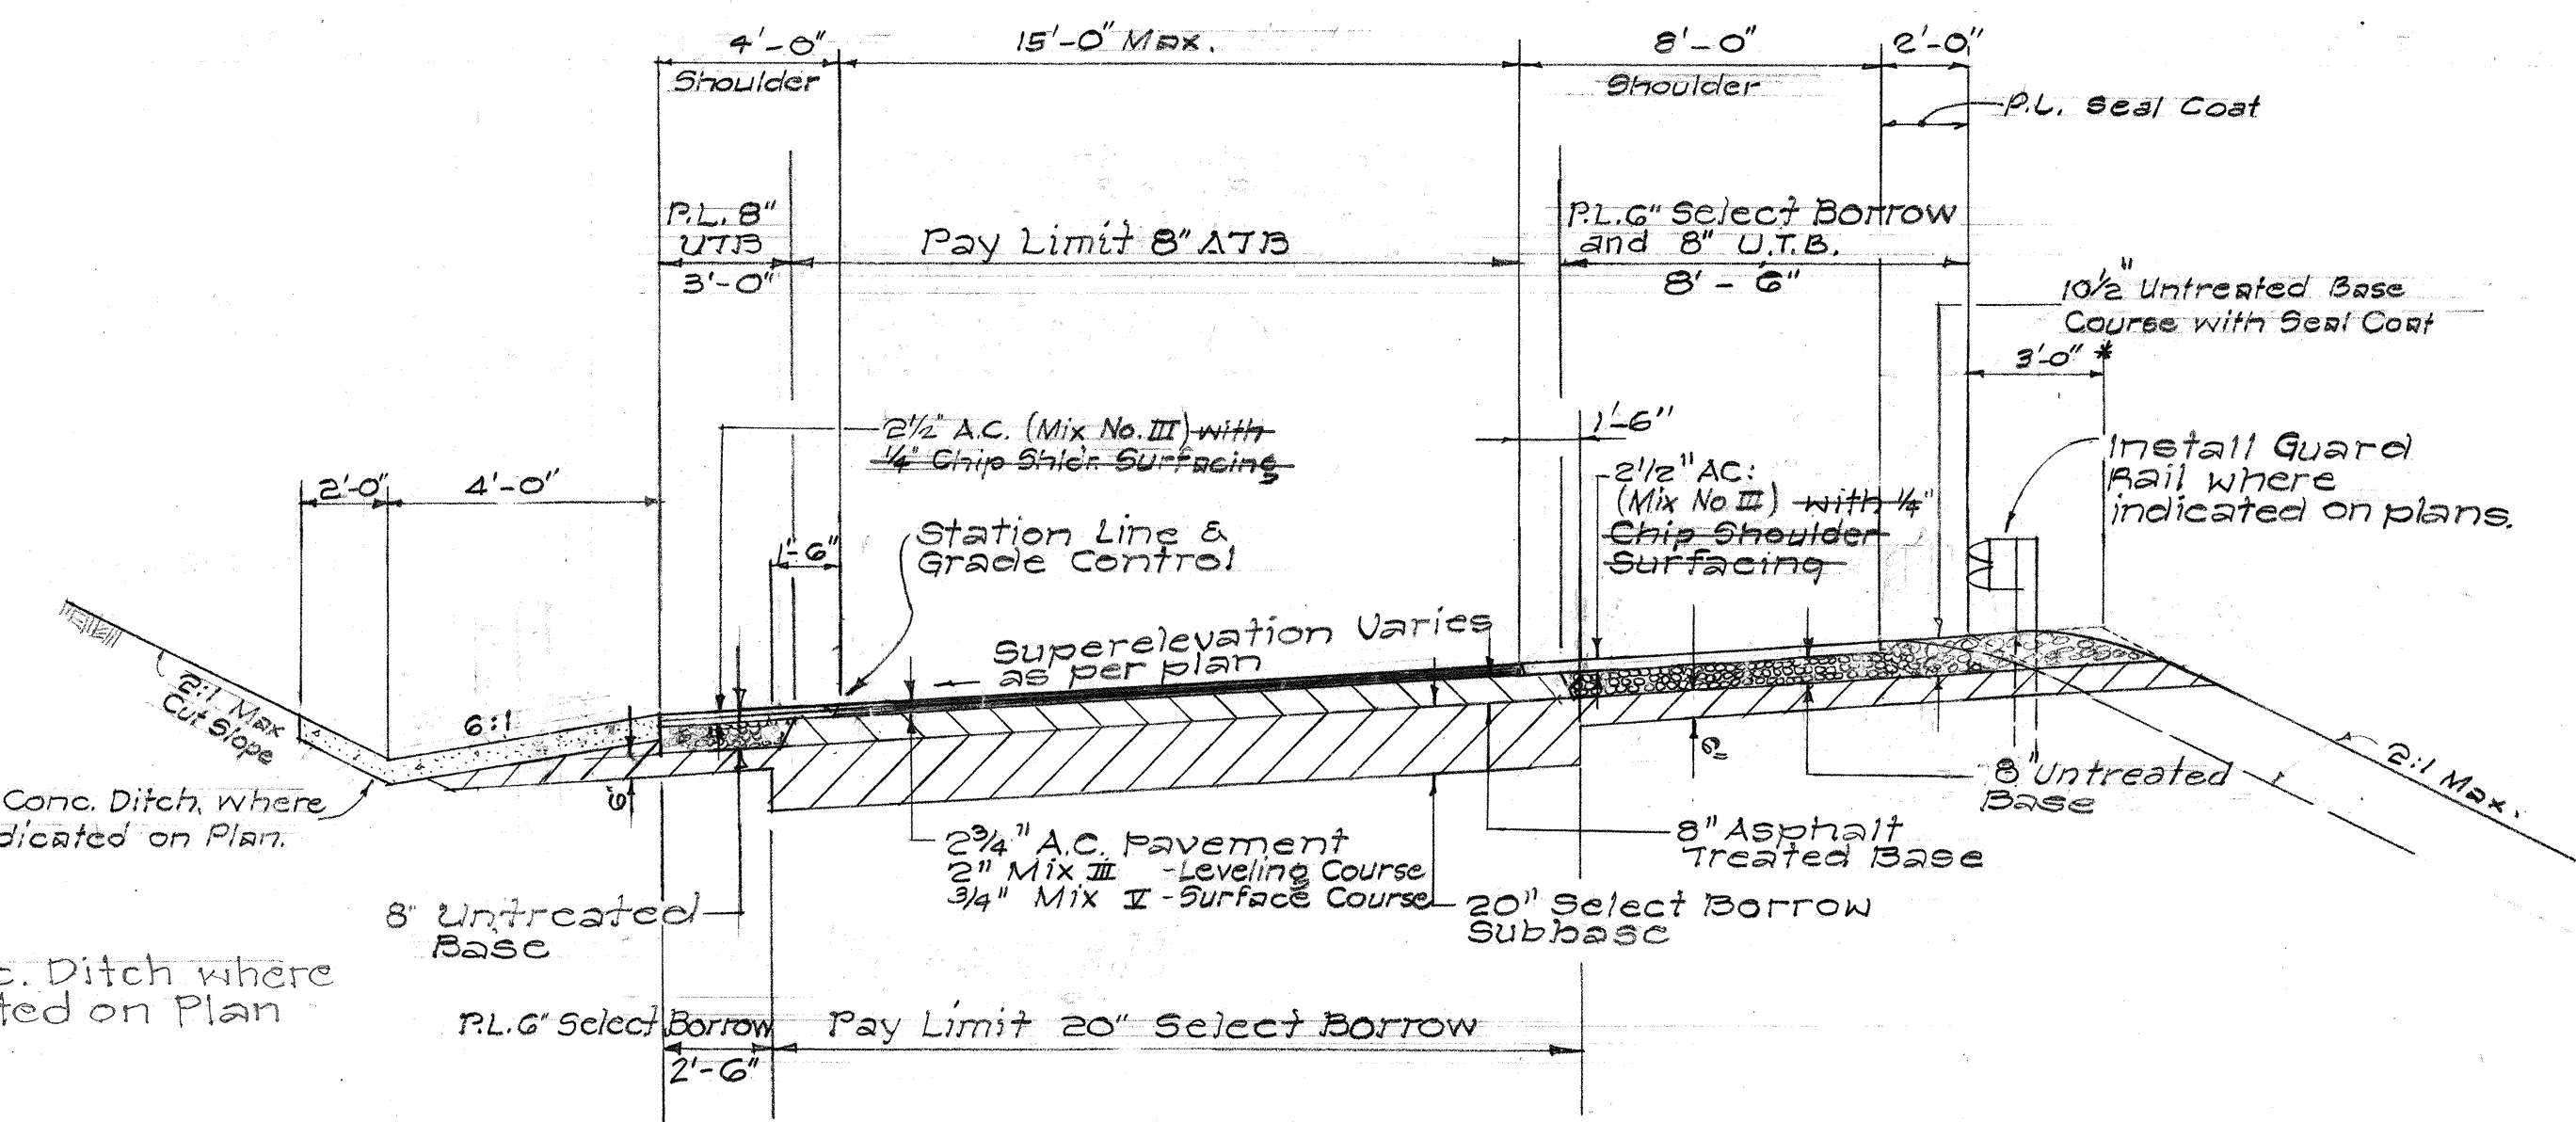

TYPICAL SECTION - RAMP "C"

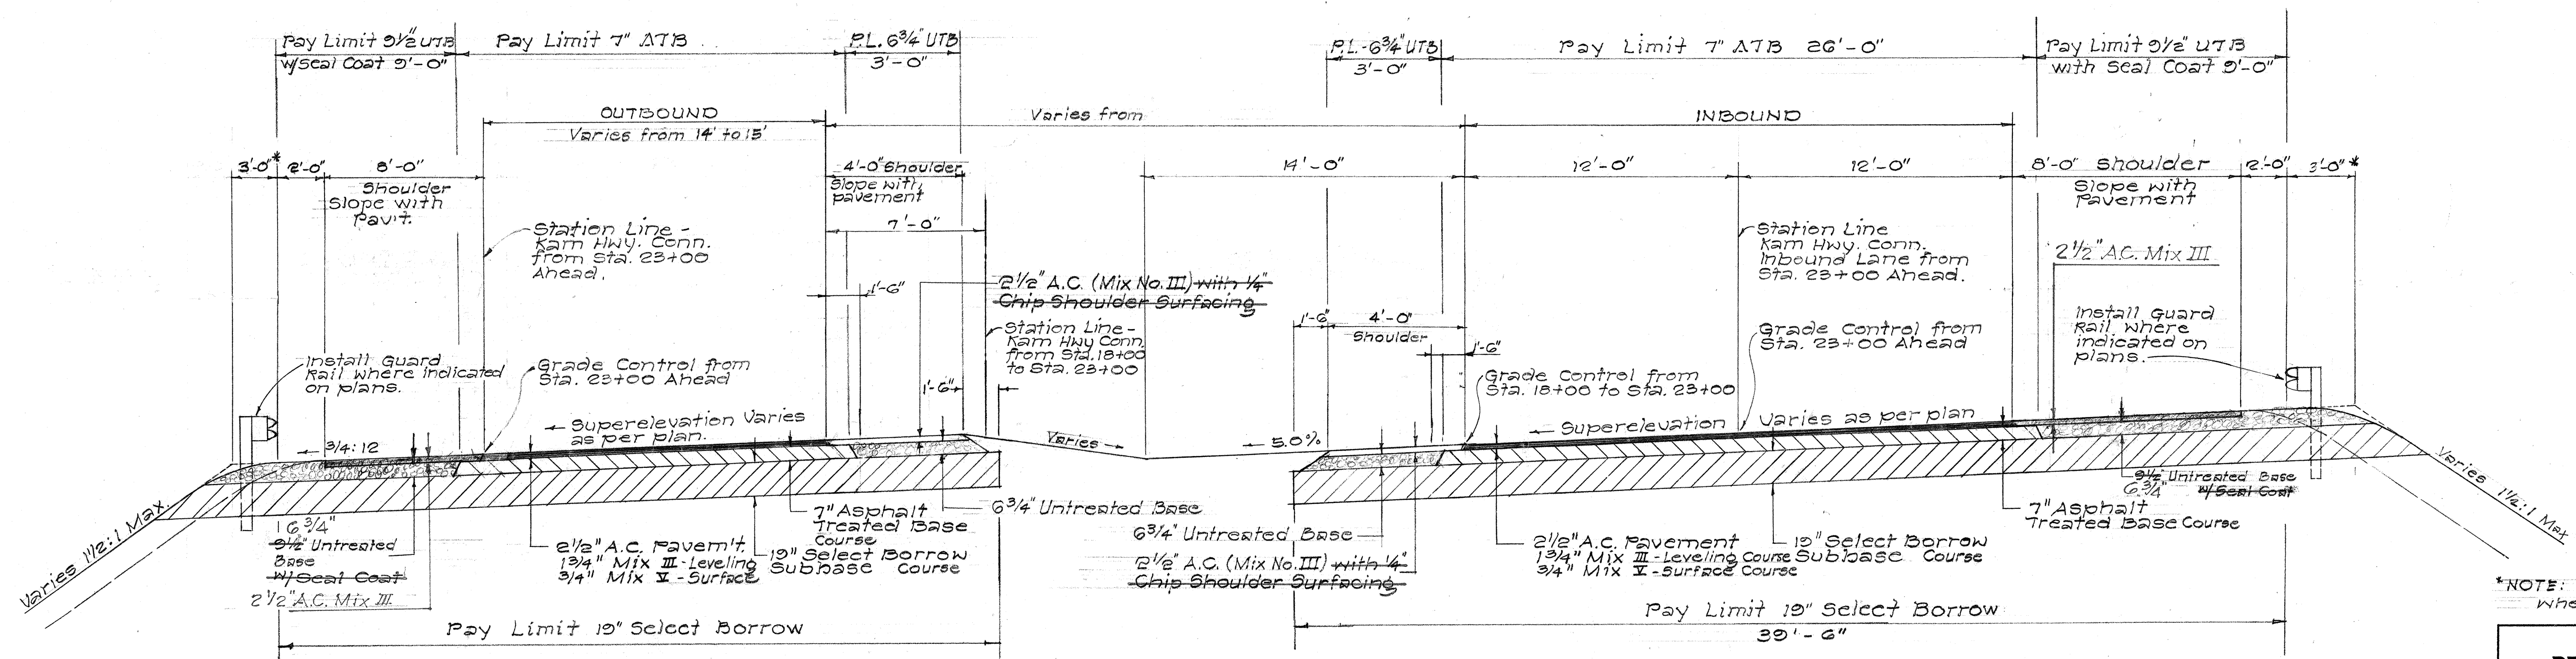

TYPICAL SECTION - KAM HWY. CONNECTOR
INBOUND - STA. 23+51.65 TO STA. 26+30.00
OUTBOUND - STA. 22+82.69 TO STA. 26+30.00
RAMP "H" STA. 0+00 TO 1+35
LOOP #3 STA. 16+00 TO 17+06.34
NOT TO SCALE

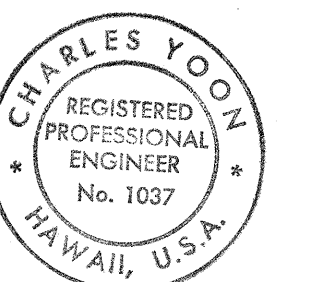

THIS WORK WAS PREPARED BY
ME OR UNDER MY SUPERVISION,
Charles Yoon









*NOTE: Extra 3' widening required only
where Guard Rail is indicated.

STATE OF HAWAII
DEPARTMENT OF TRANSPORTATION
HIGHWAYS DIVISION

TYPICAL SECTIONS

F.A.I. PROJ. NO. I-HI-1 (47):2
Scale: 1/4" = 1'-0"

SHEET No. 4 OF 6 SHEETS

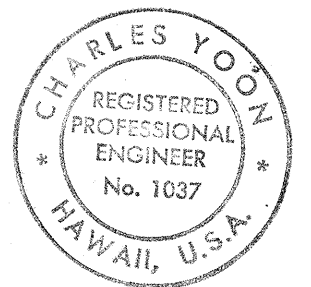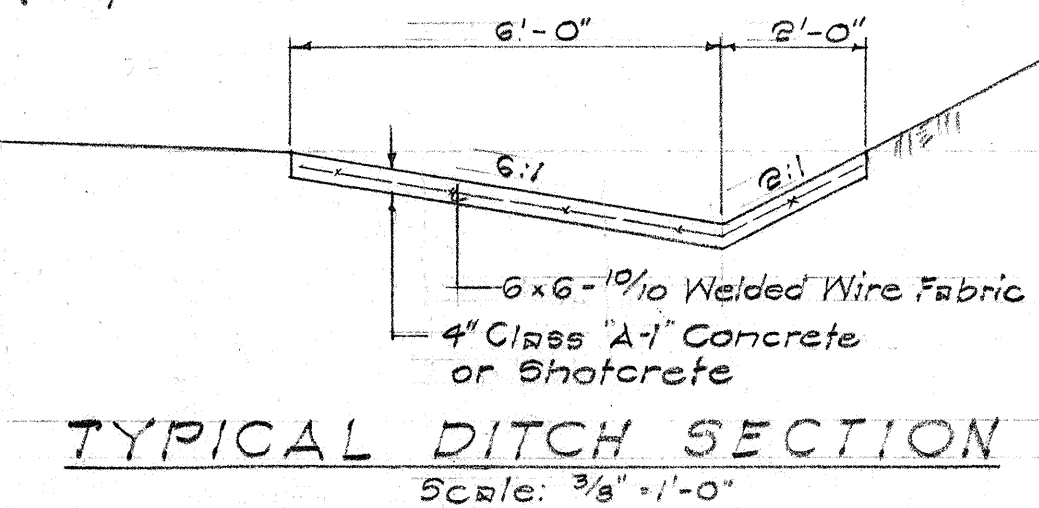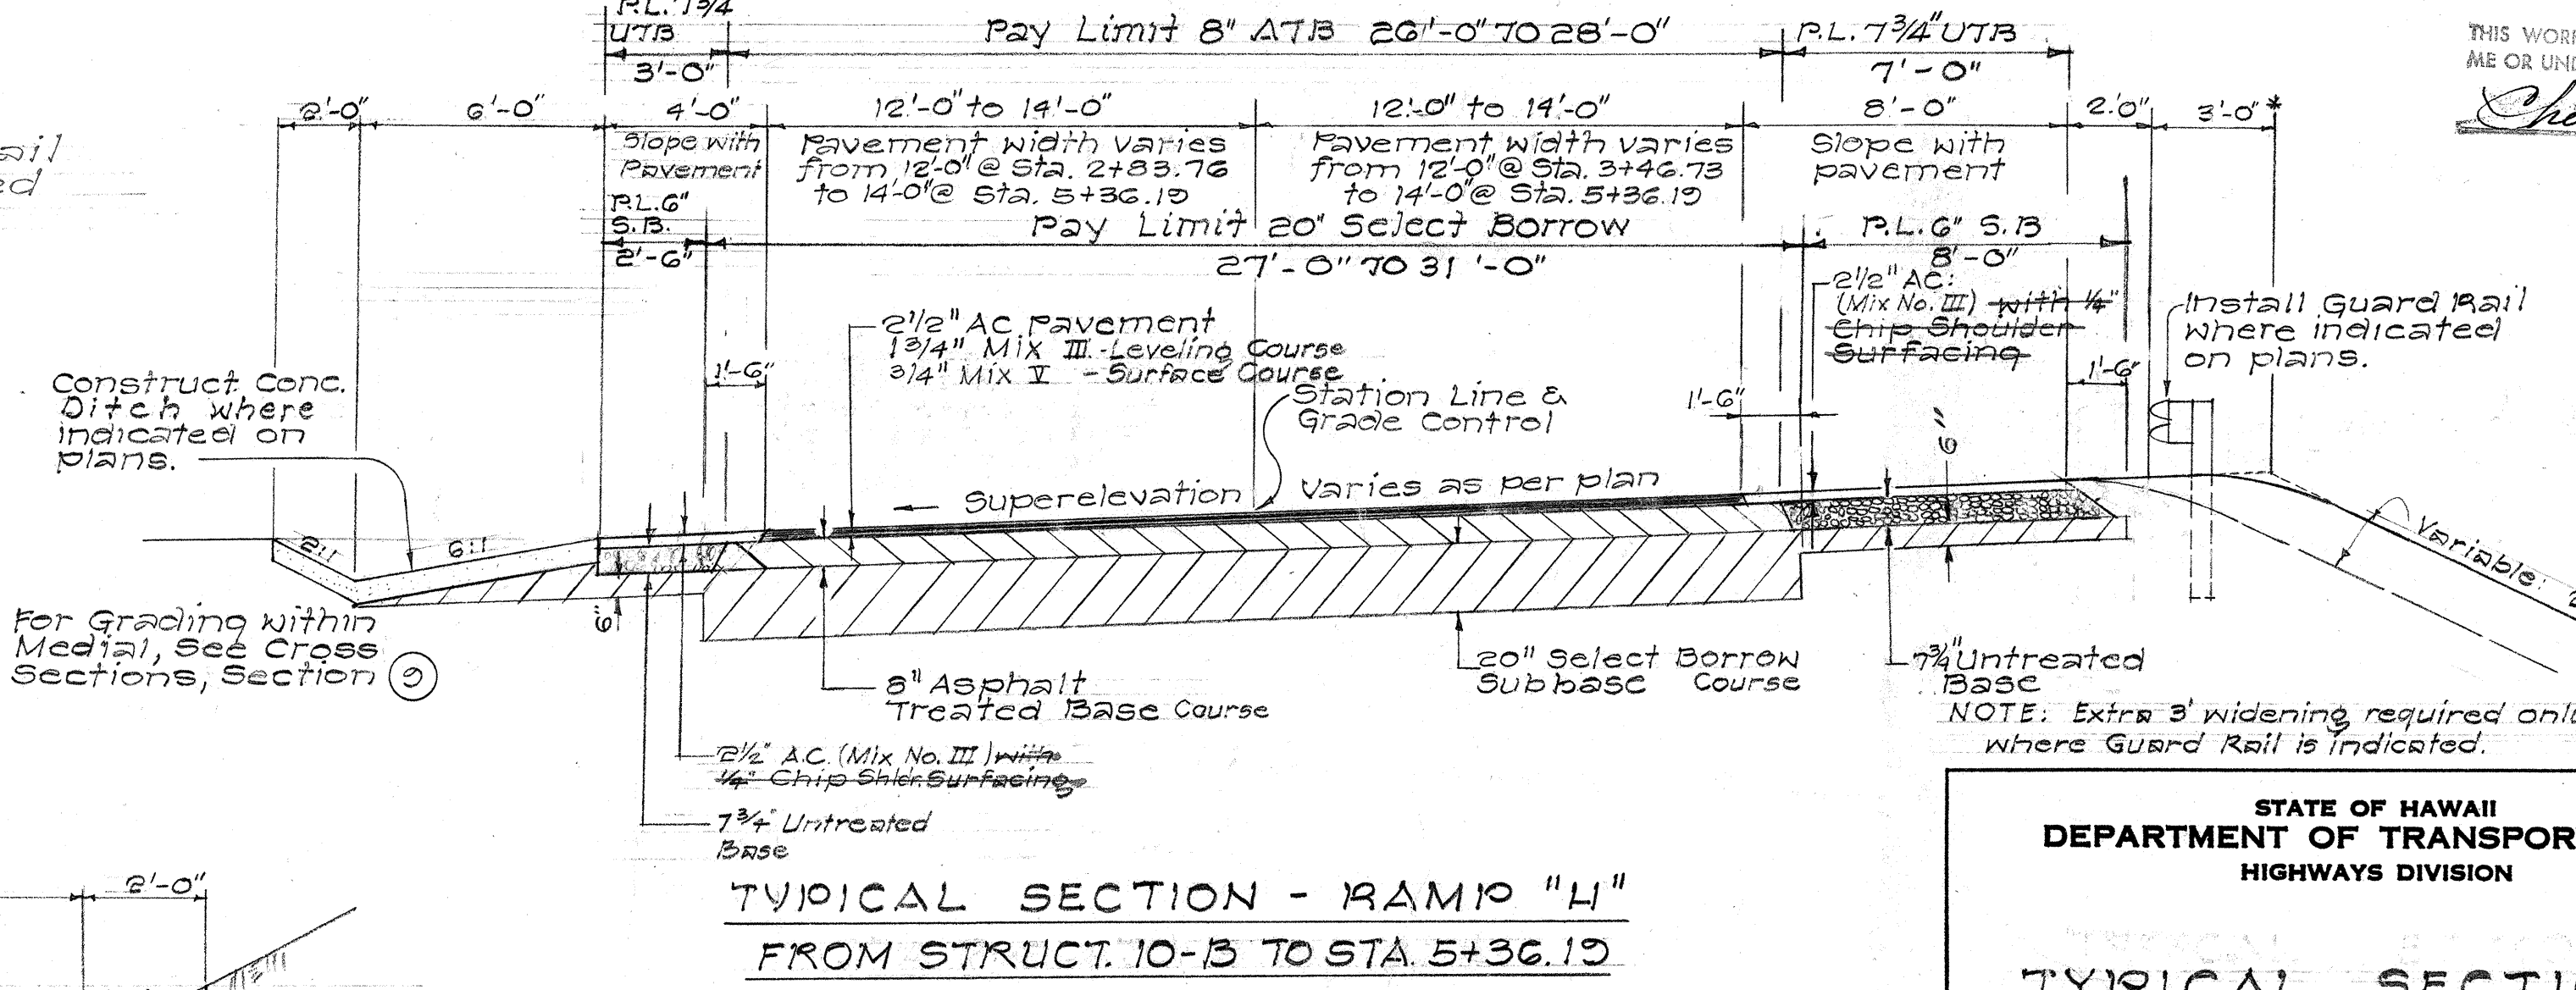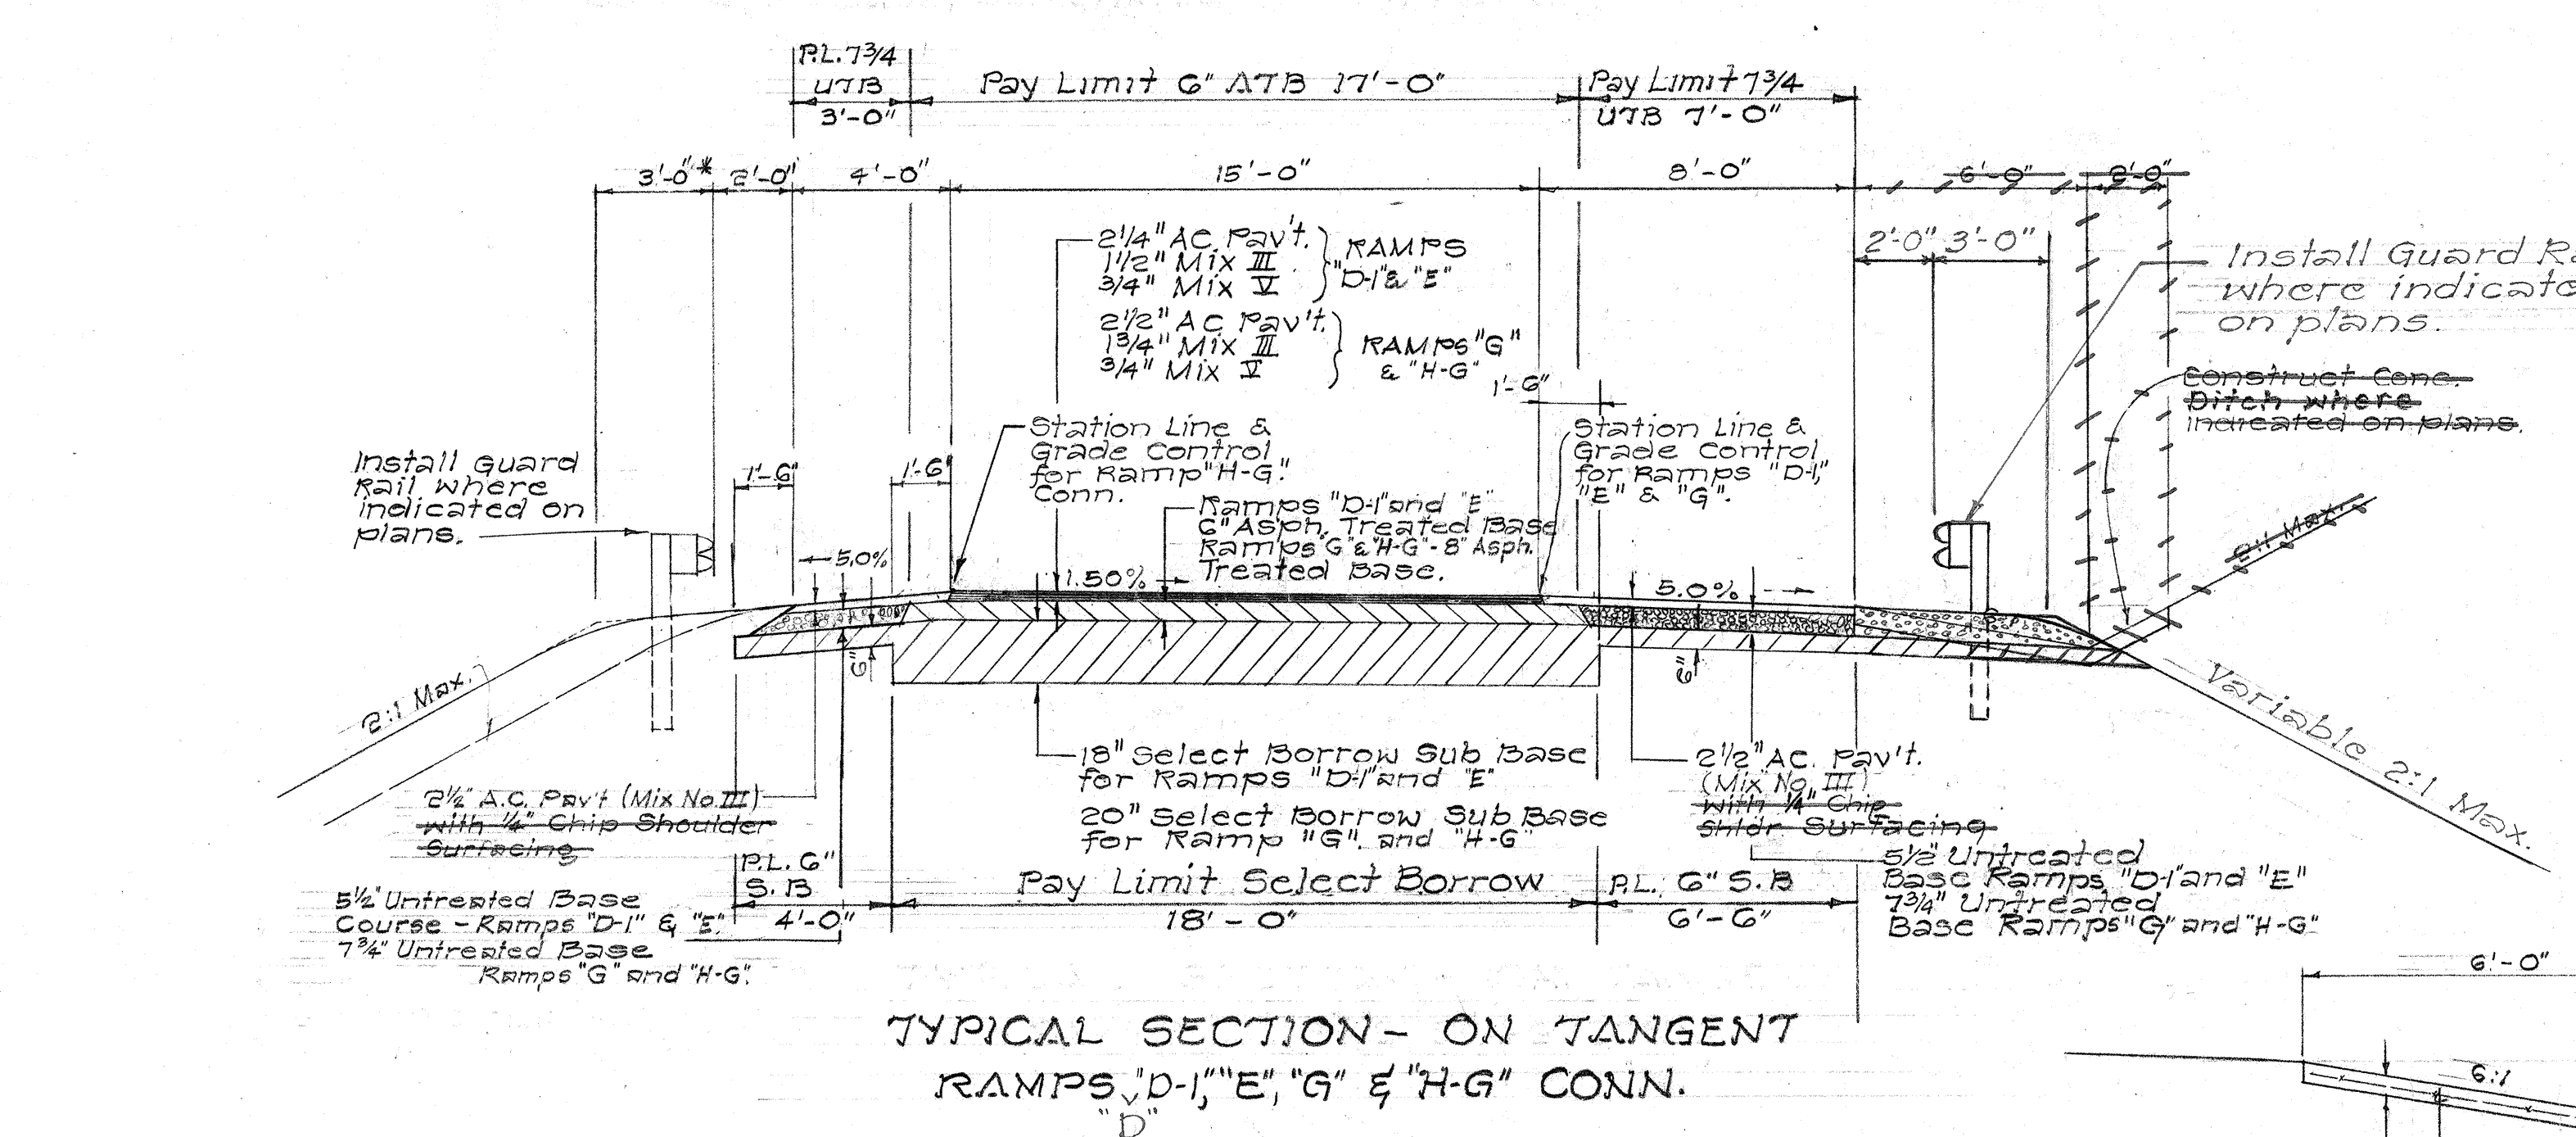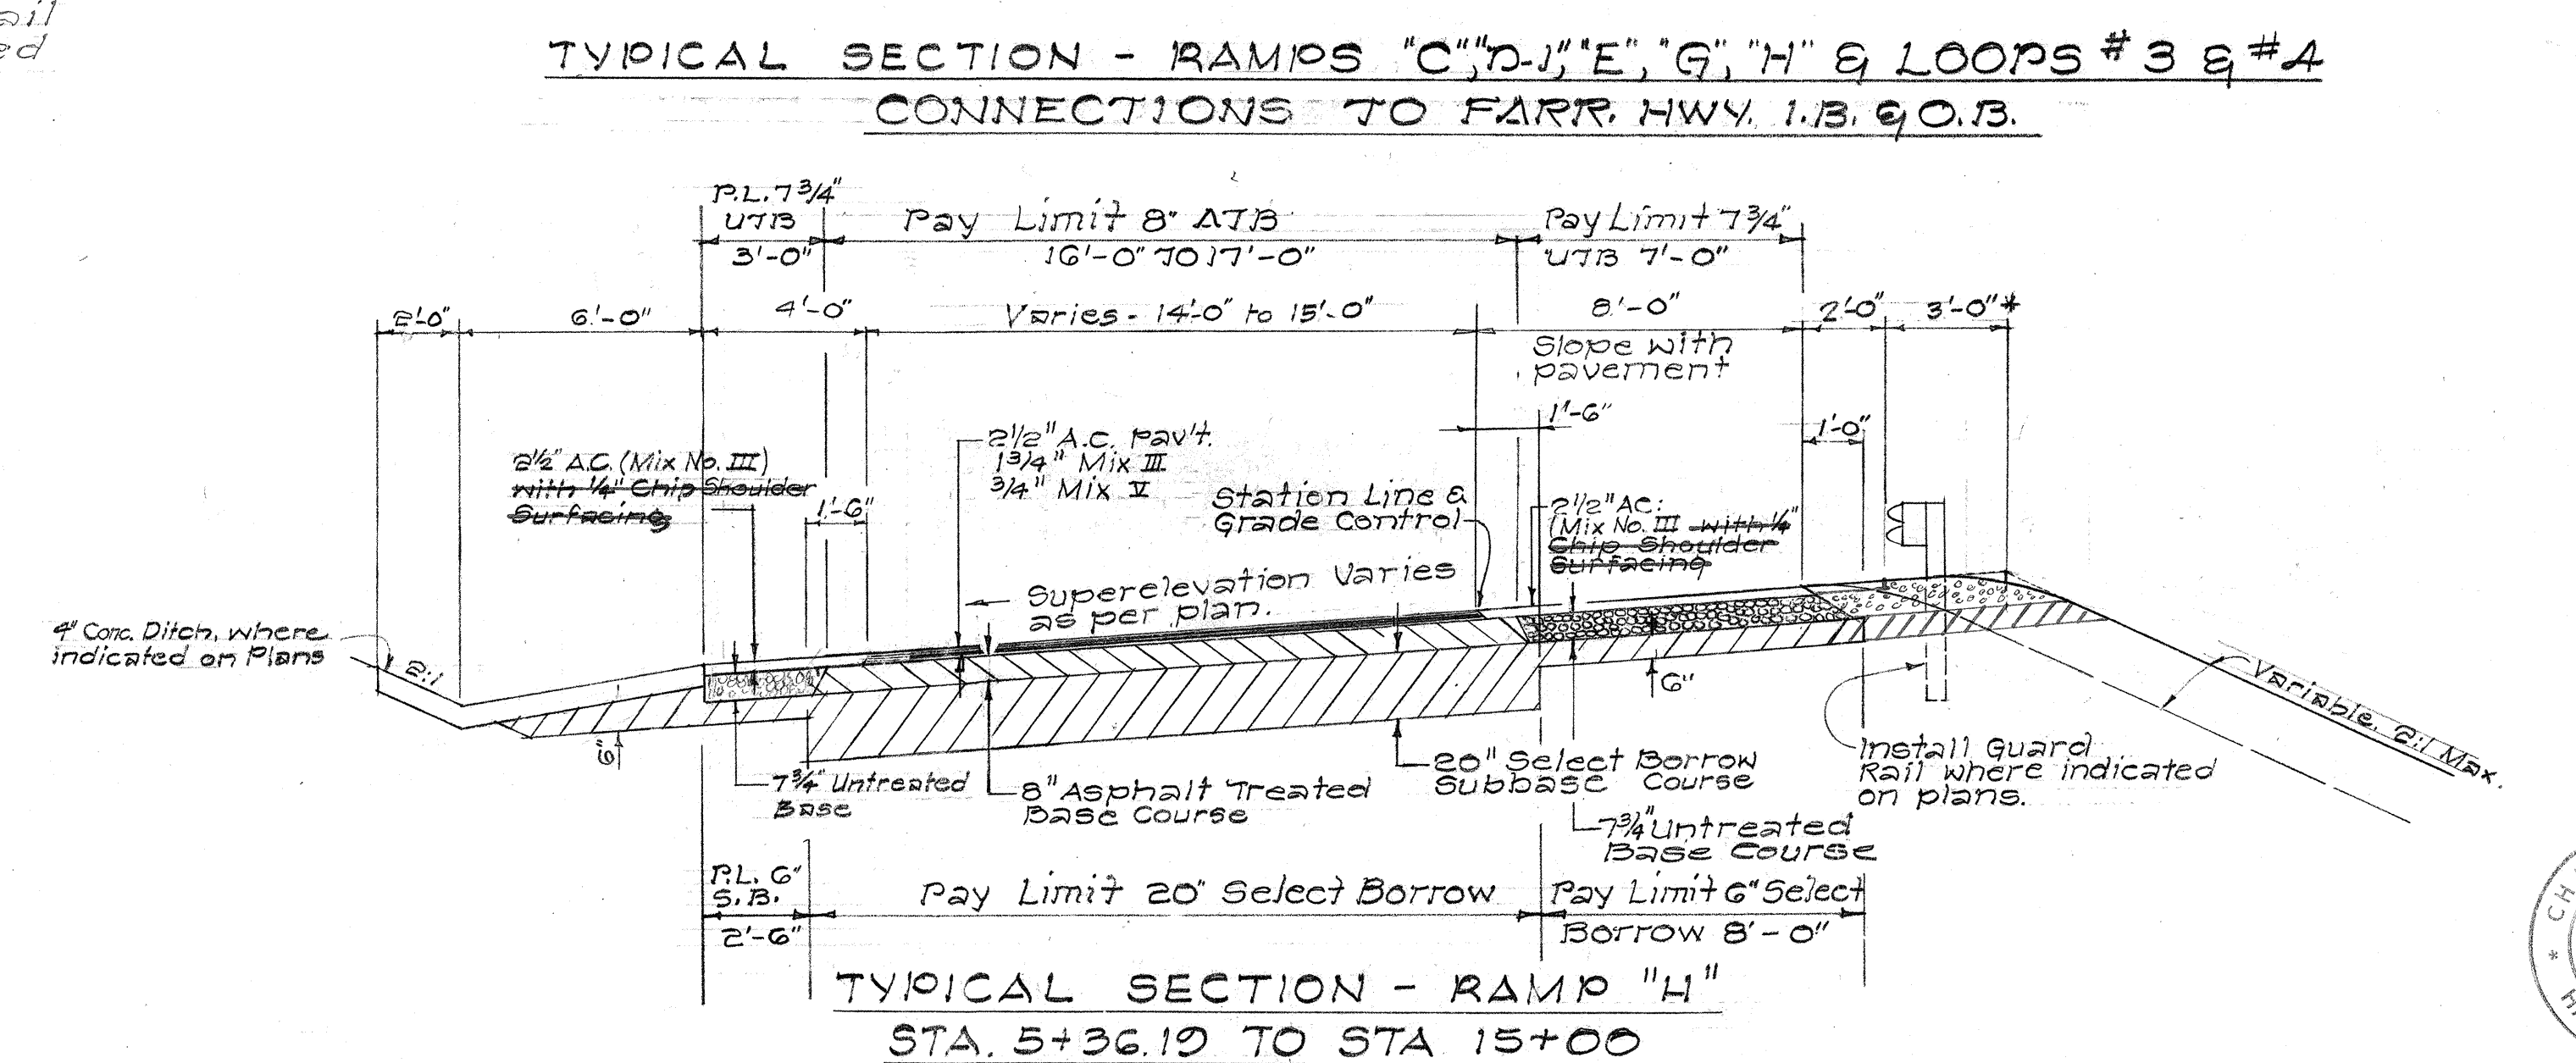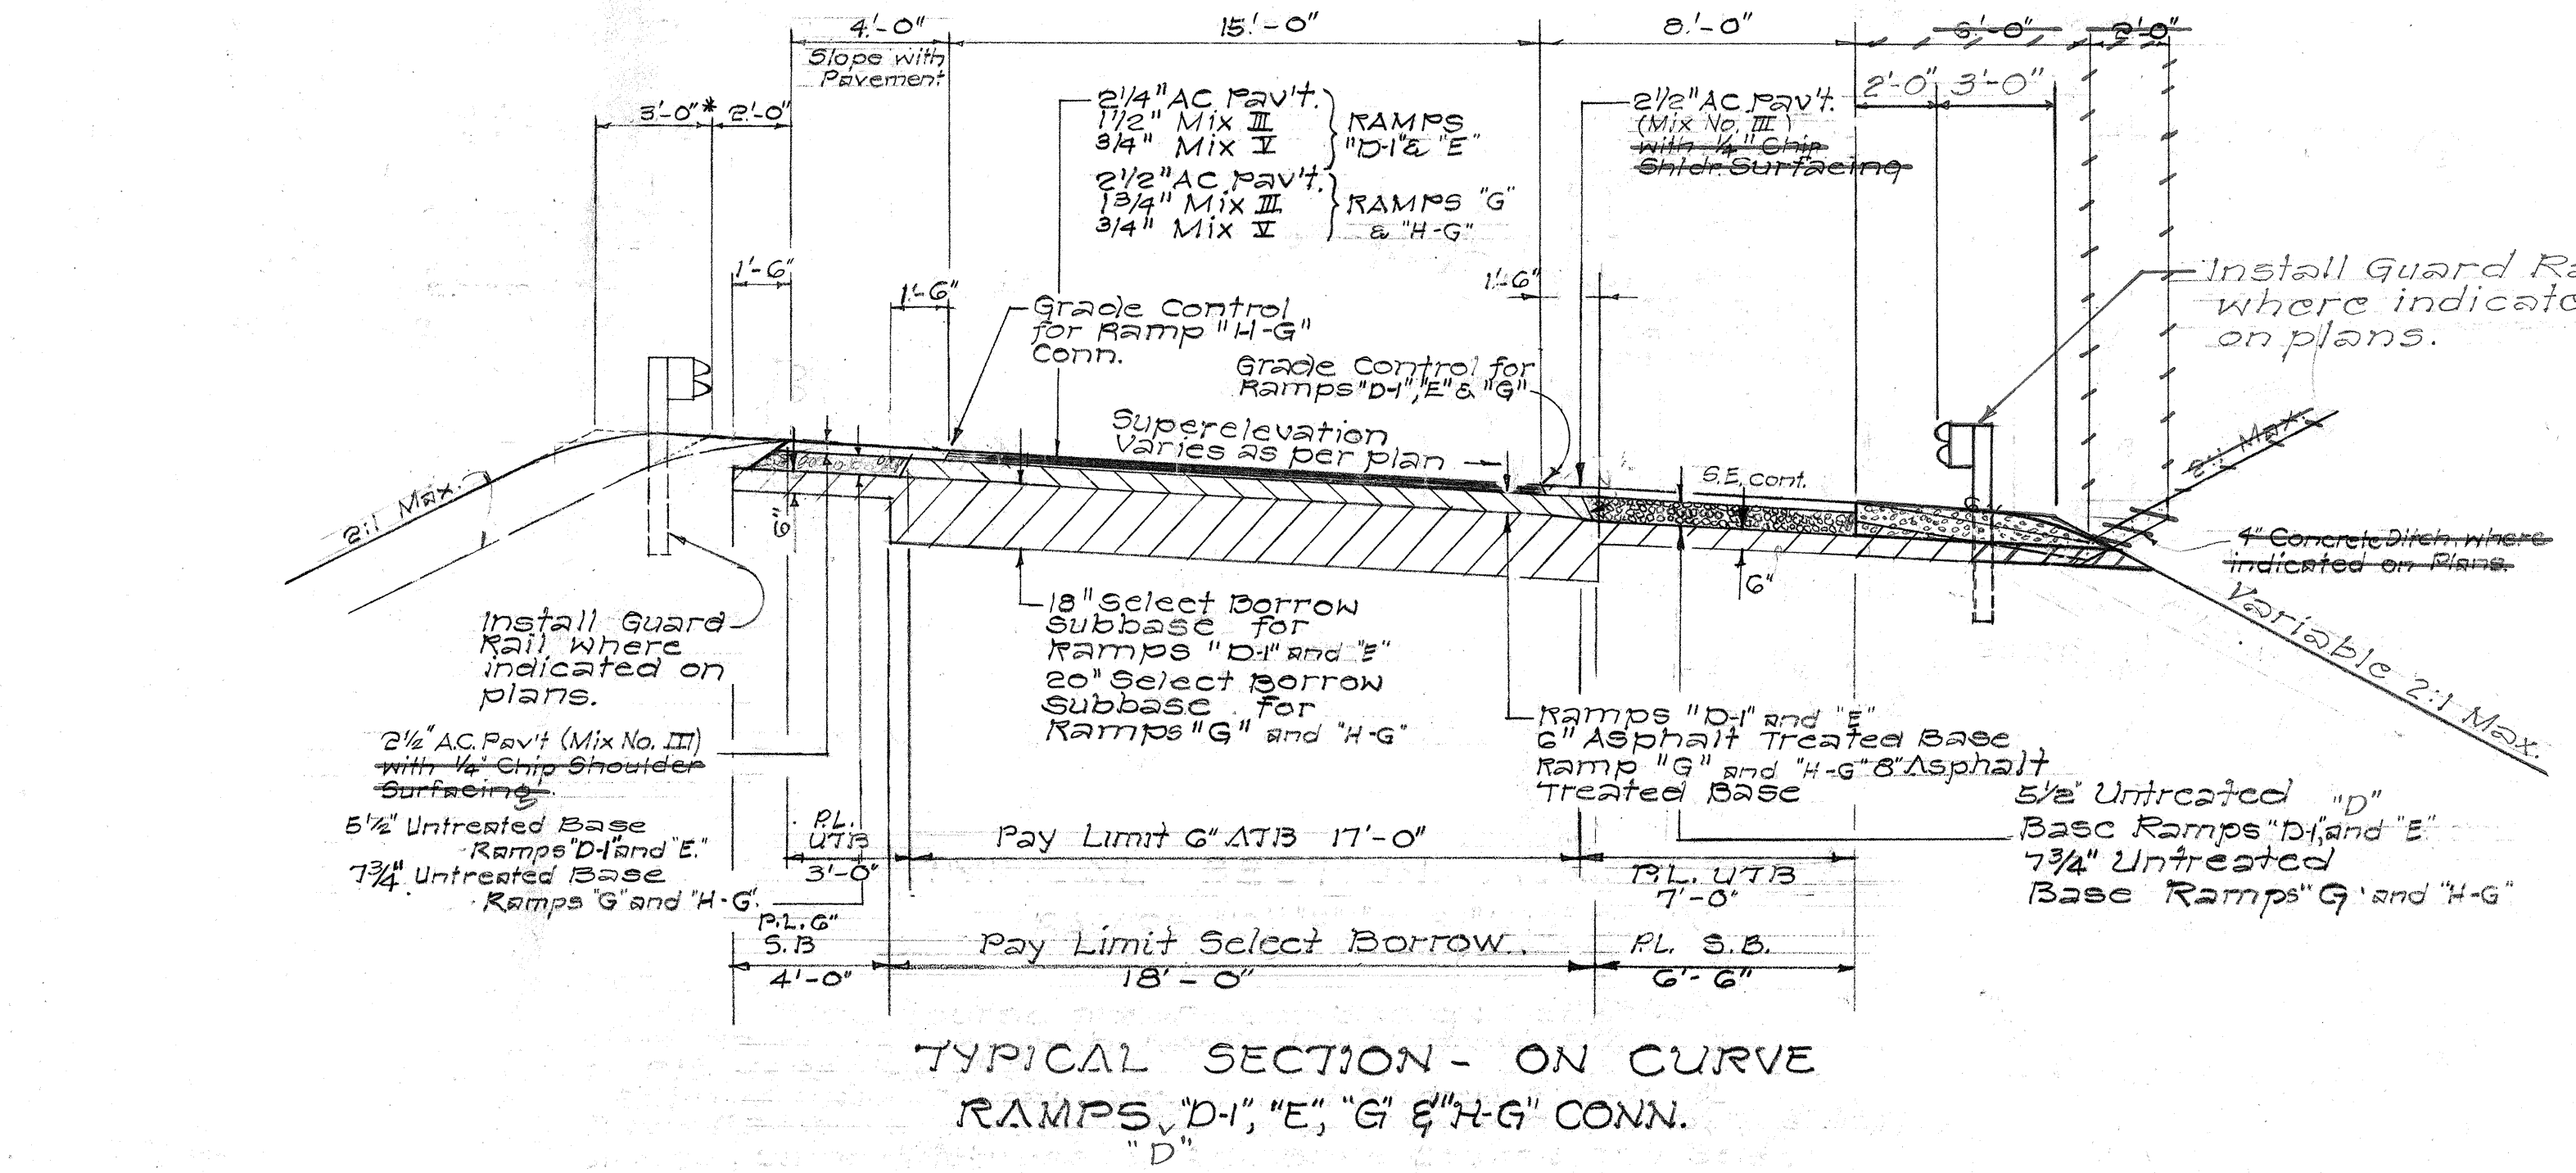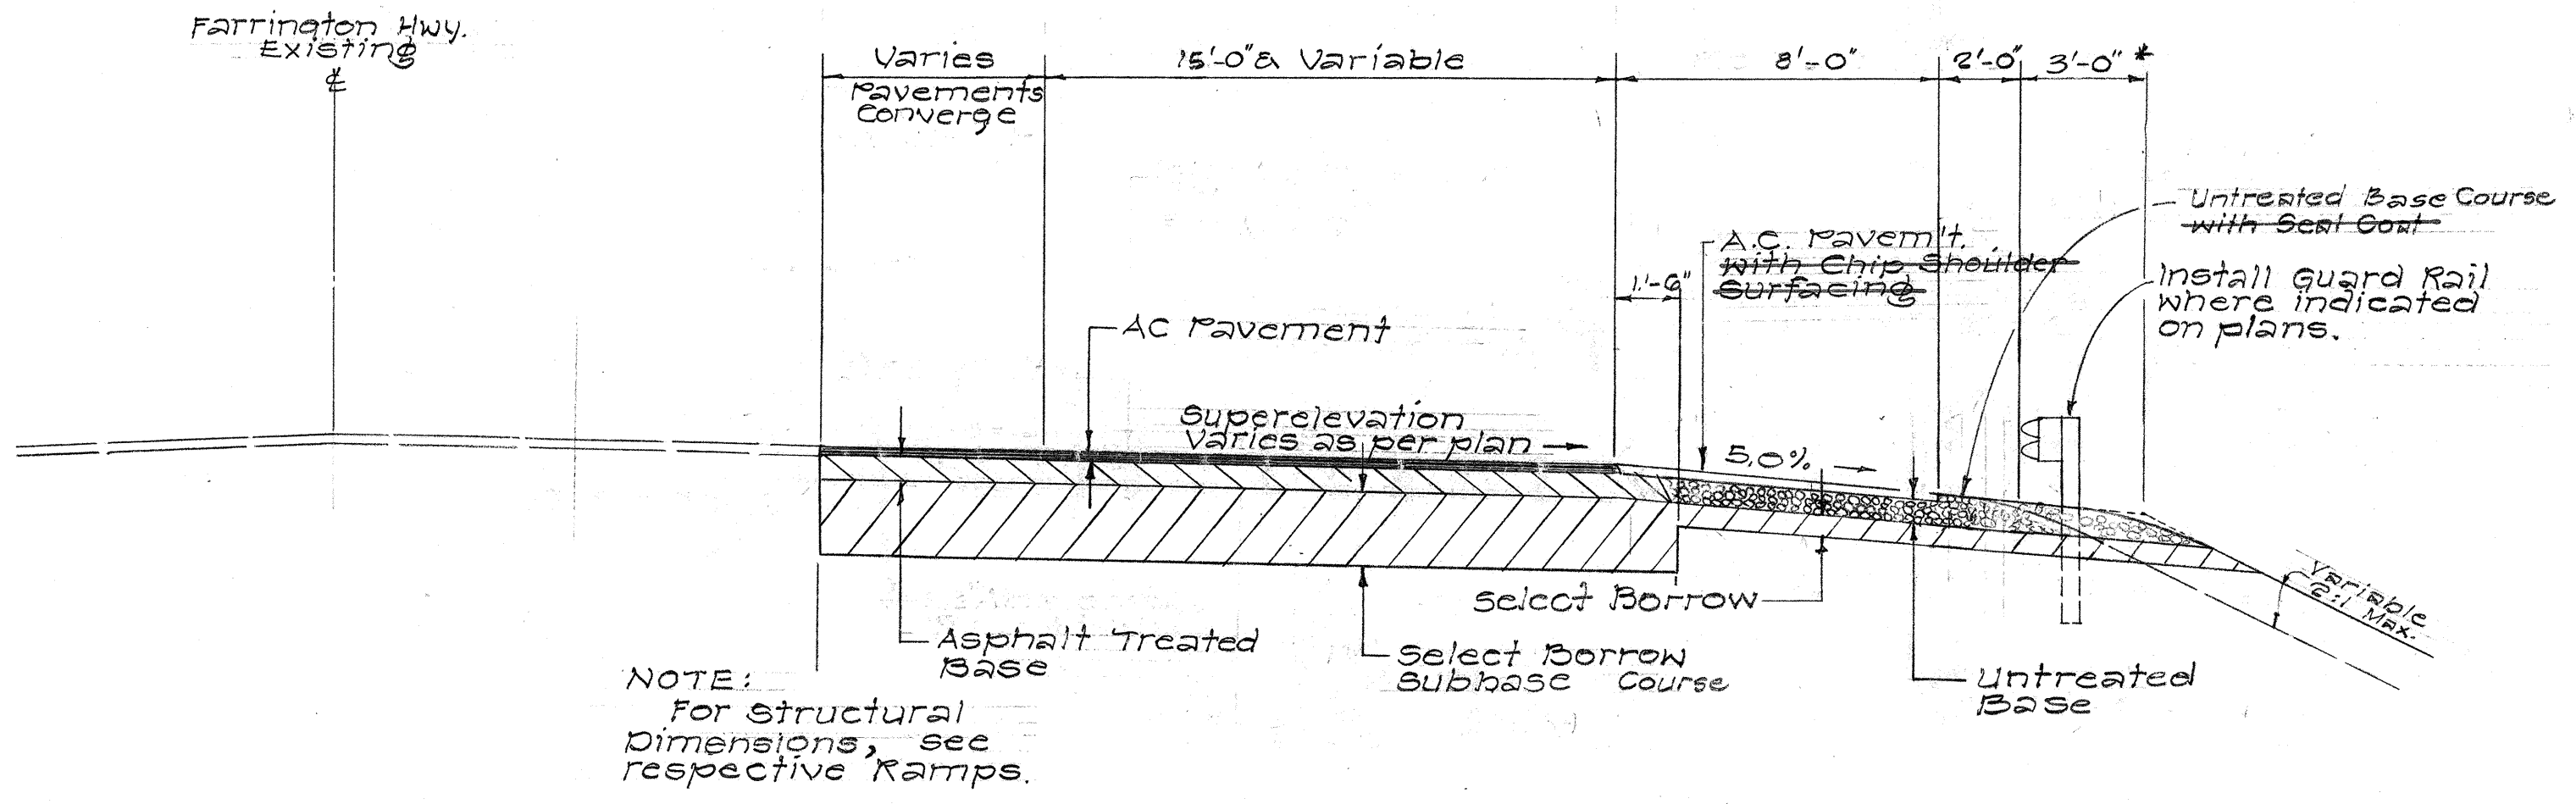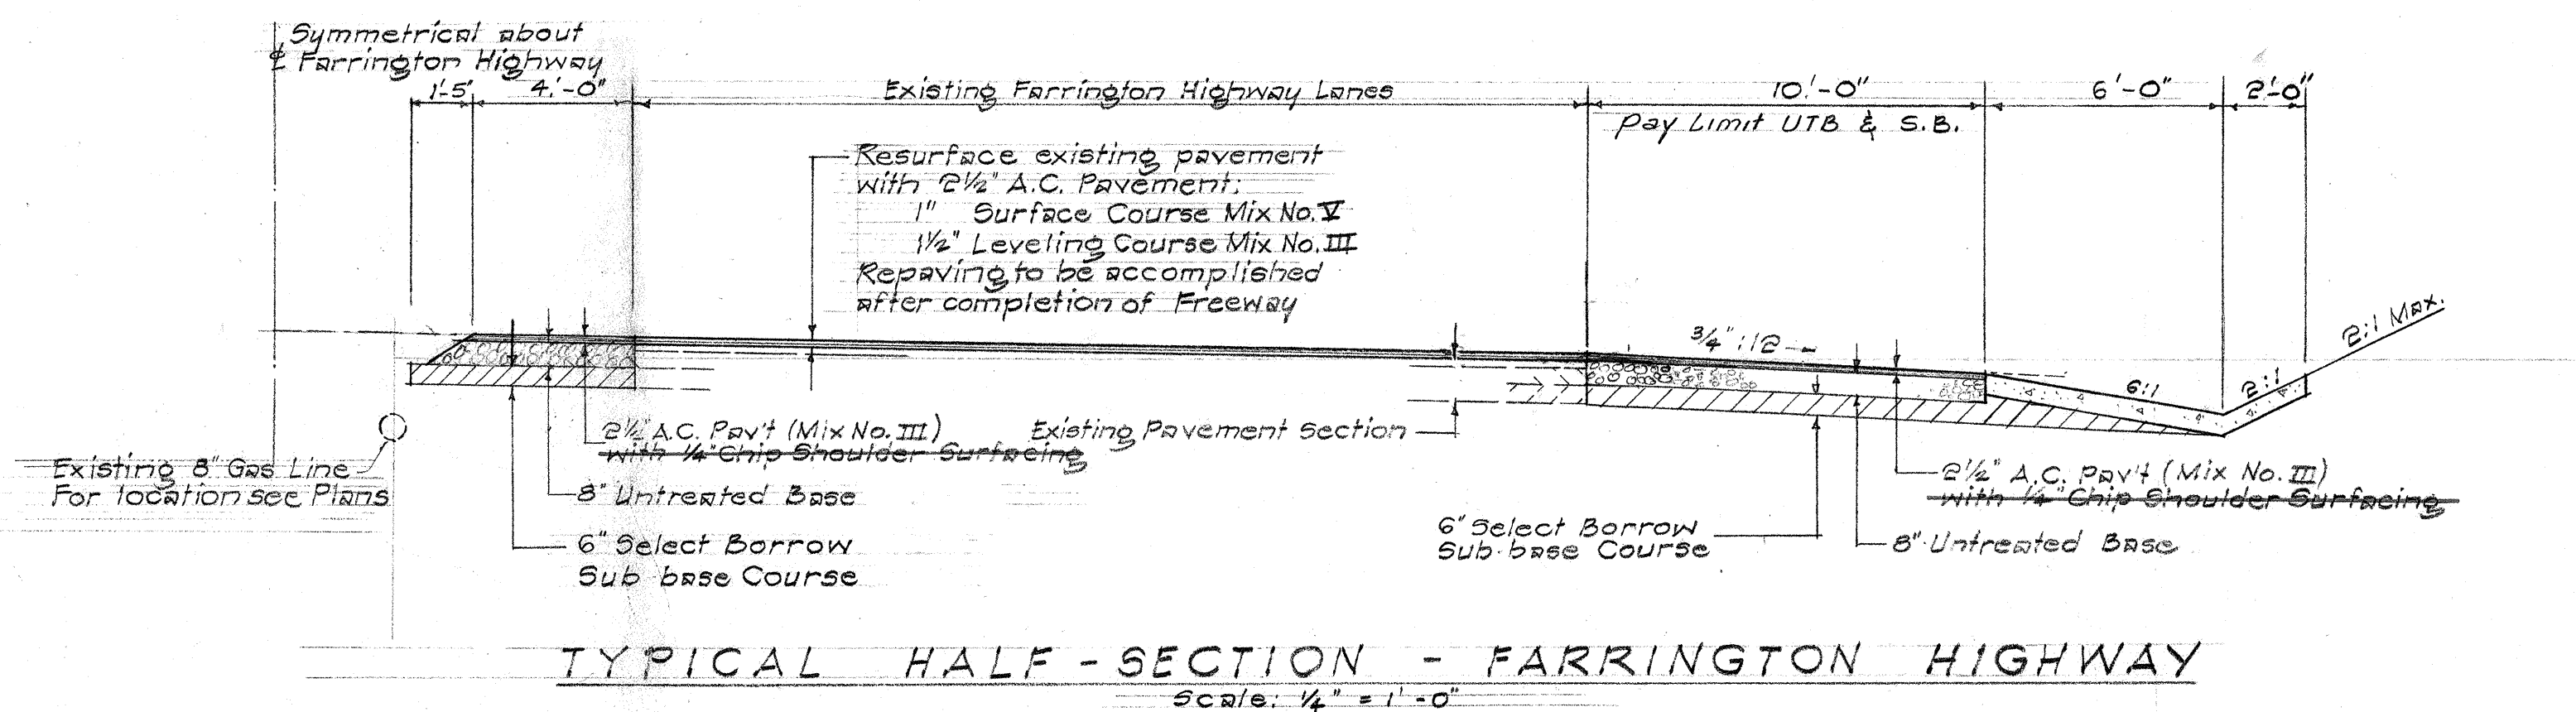

THIS WORK WAS PREPARED BY ME OR UNDER MY SUPERVISION,
Charles Yoon

STATE OF HAWAII
DEPARTMENT OF TRANSPORTATION
HIGHWAYS DIVISION

TYPICAL SECTIONS

F.A.I. PROJ. NO. I-HI-1 (47): 5
Scale: 1/4" = 1'-0"

SHEET No. 5 OF 6 SHEETS

DATE	PLANNED BY
DESIGNED BY	TRACED BY
QUANTITIES BY	CHECKED BY
ORIGINAL PLAN	NOTE BOOK