


FED. ROAD DIST. NO.	STATE	FED. AID PROJ. NO.	FISCAL YEAR	SHEET NO.	TOTAL SHEETS
HAWAII	HAW.	I-HI-1(31):21, Unit 3	1968	46	47


Revised: 12-6-68

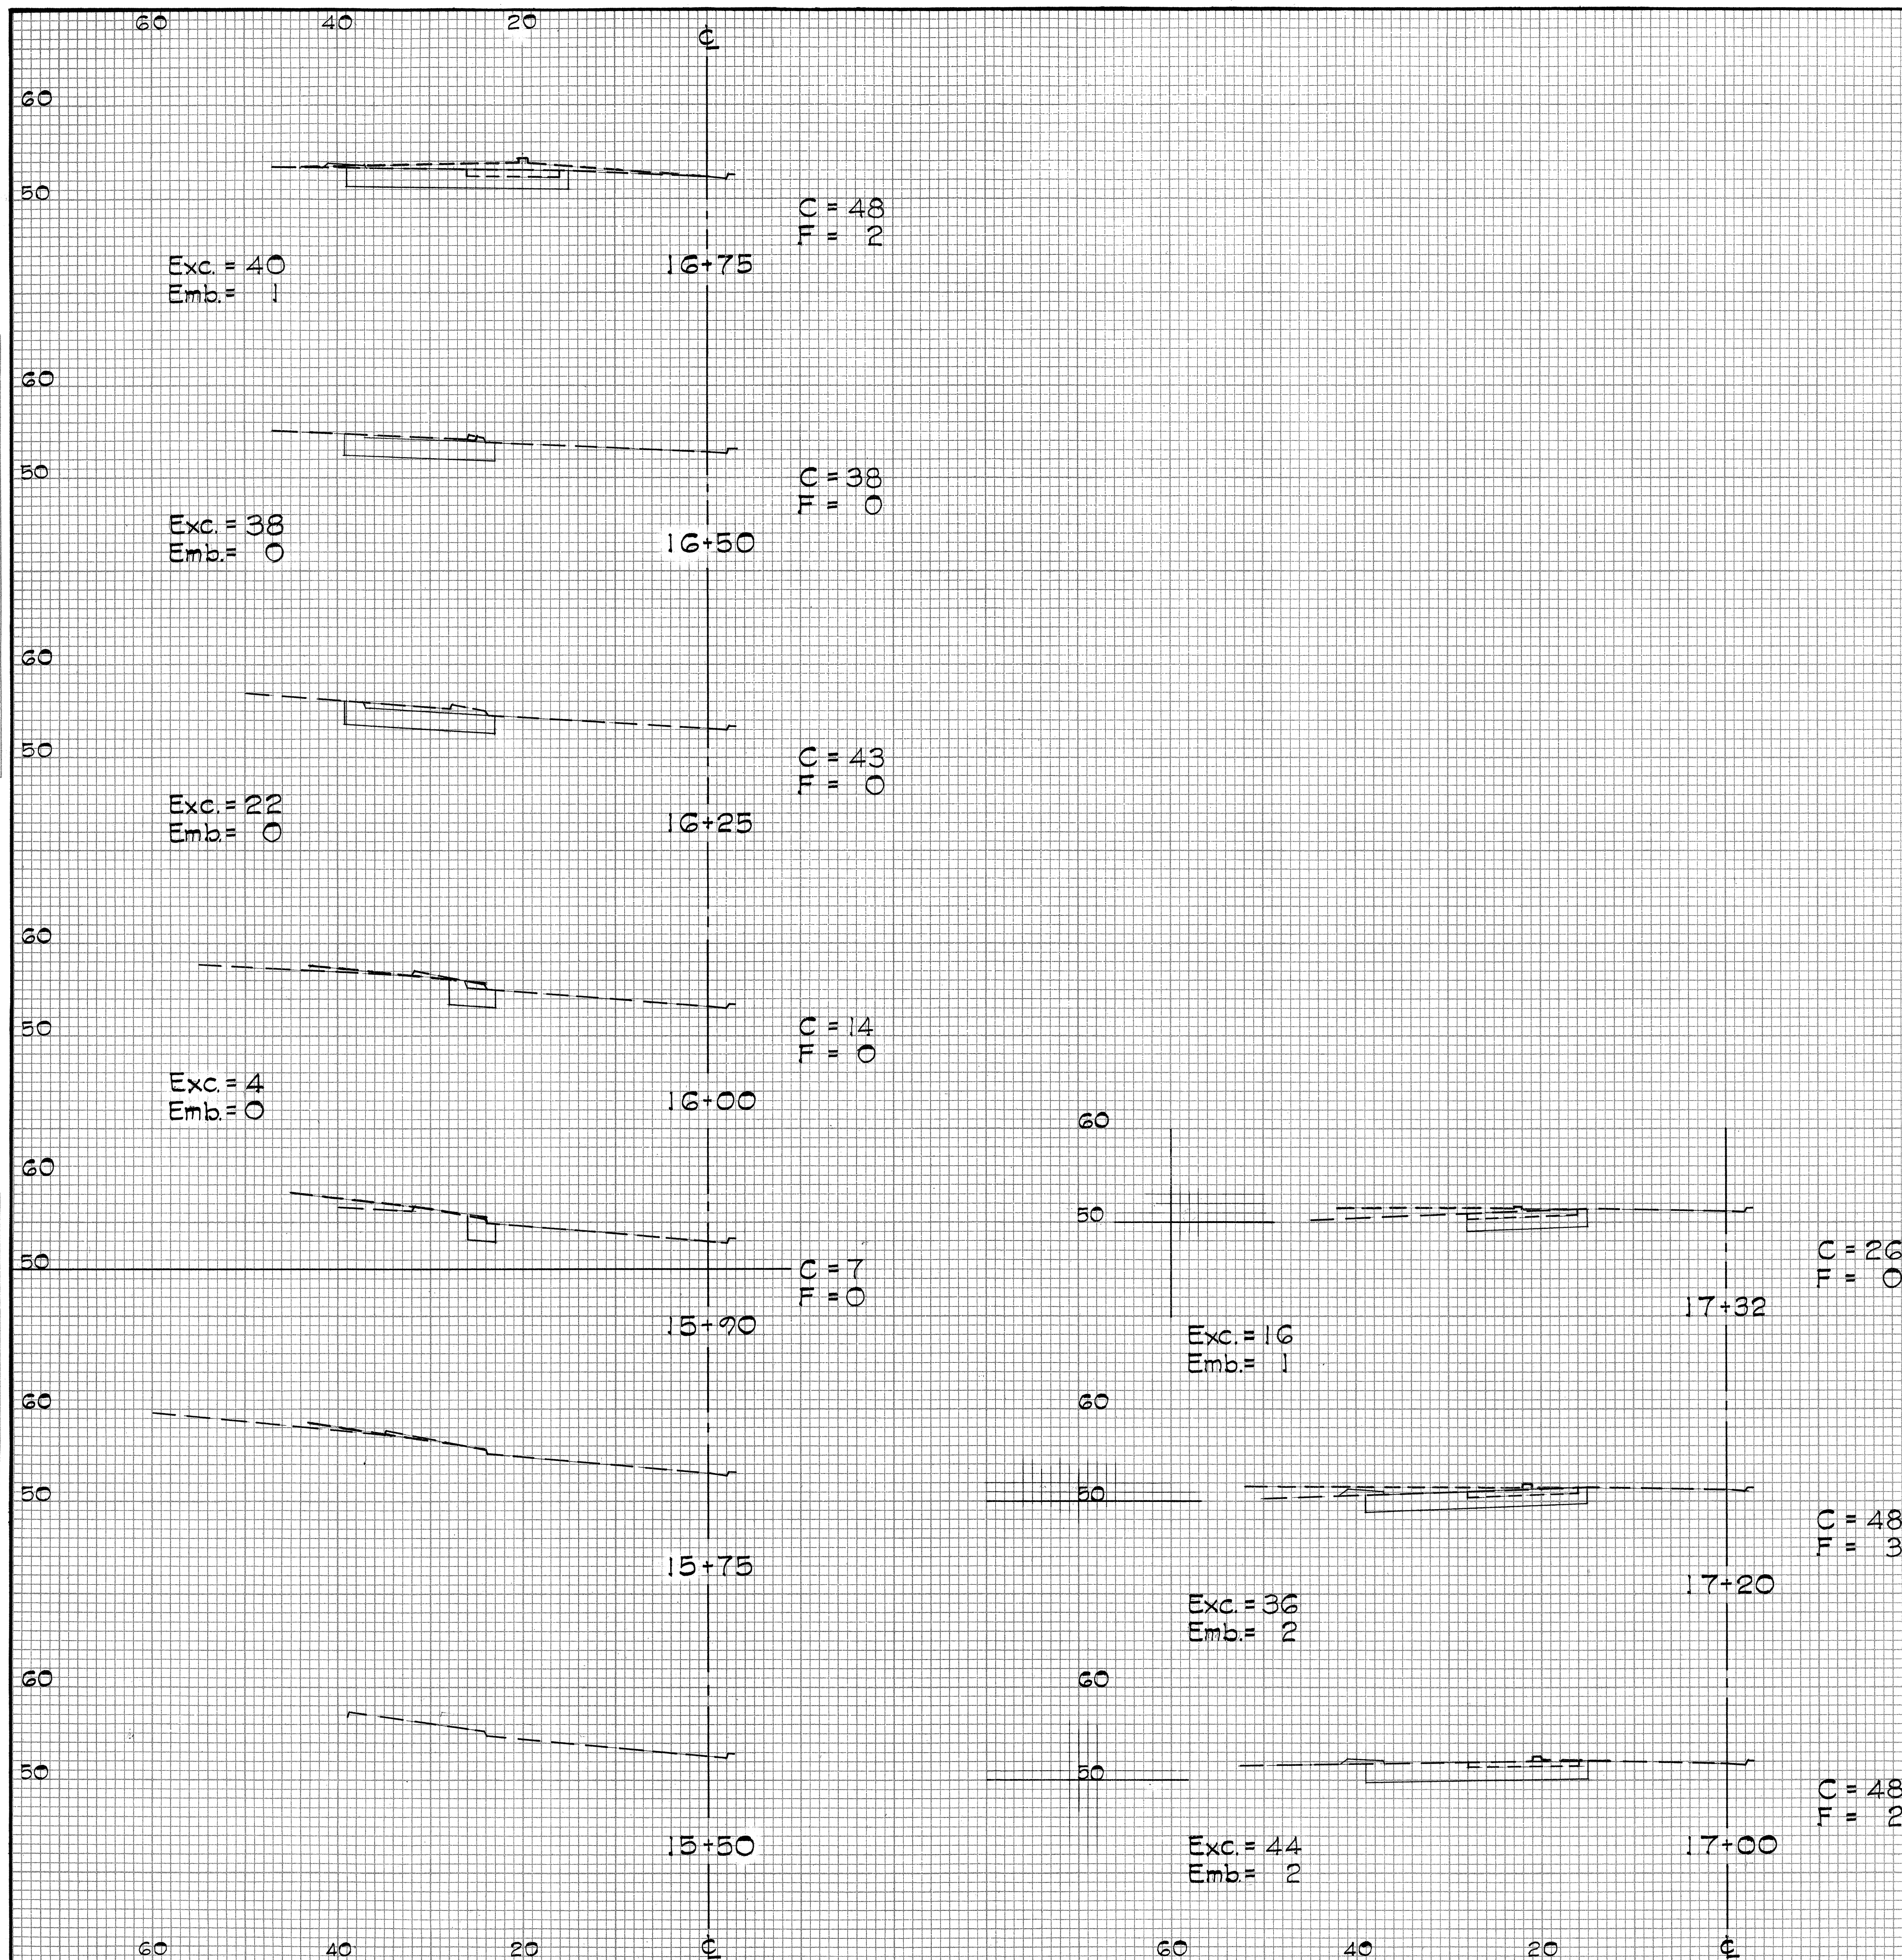

CROSS SECTIONS
RAMP B

FED. RD. DIST. No.	STATE	FED. AID PROJ. No.	FISCAL YEAR	SHT. No.	TOTAL SHTS.
HAWAII	HAW	1H-1(3)12	Unit 3	1968	47

Revised: 12-6-68

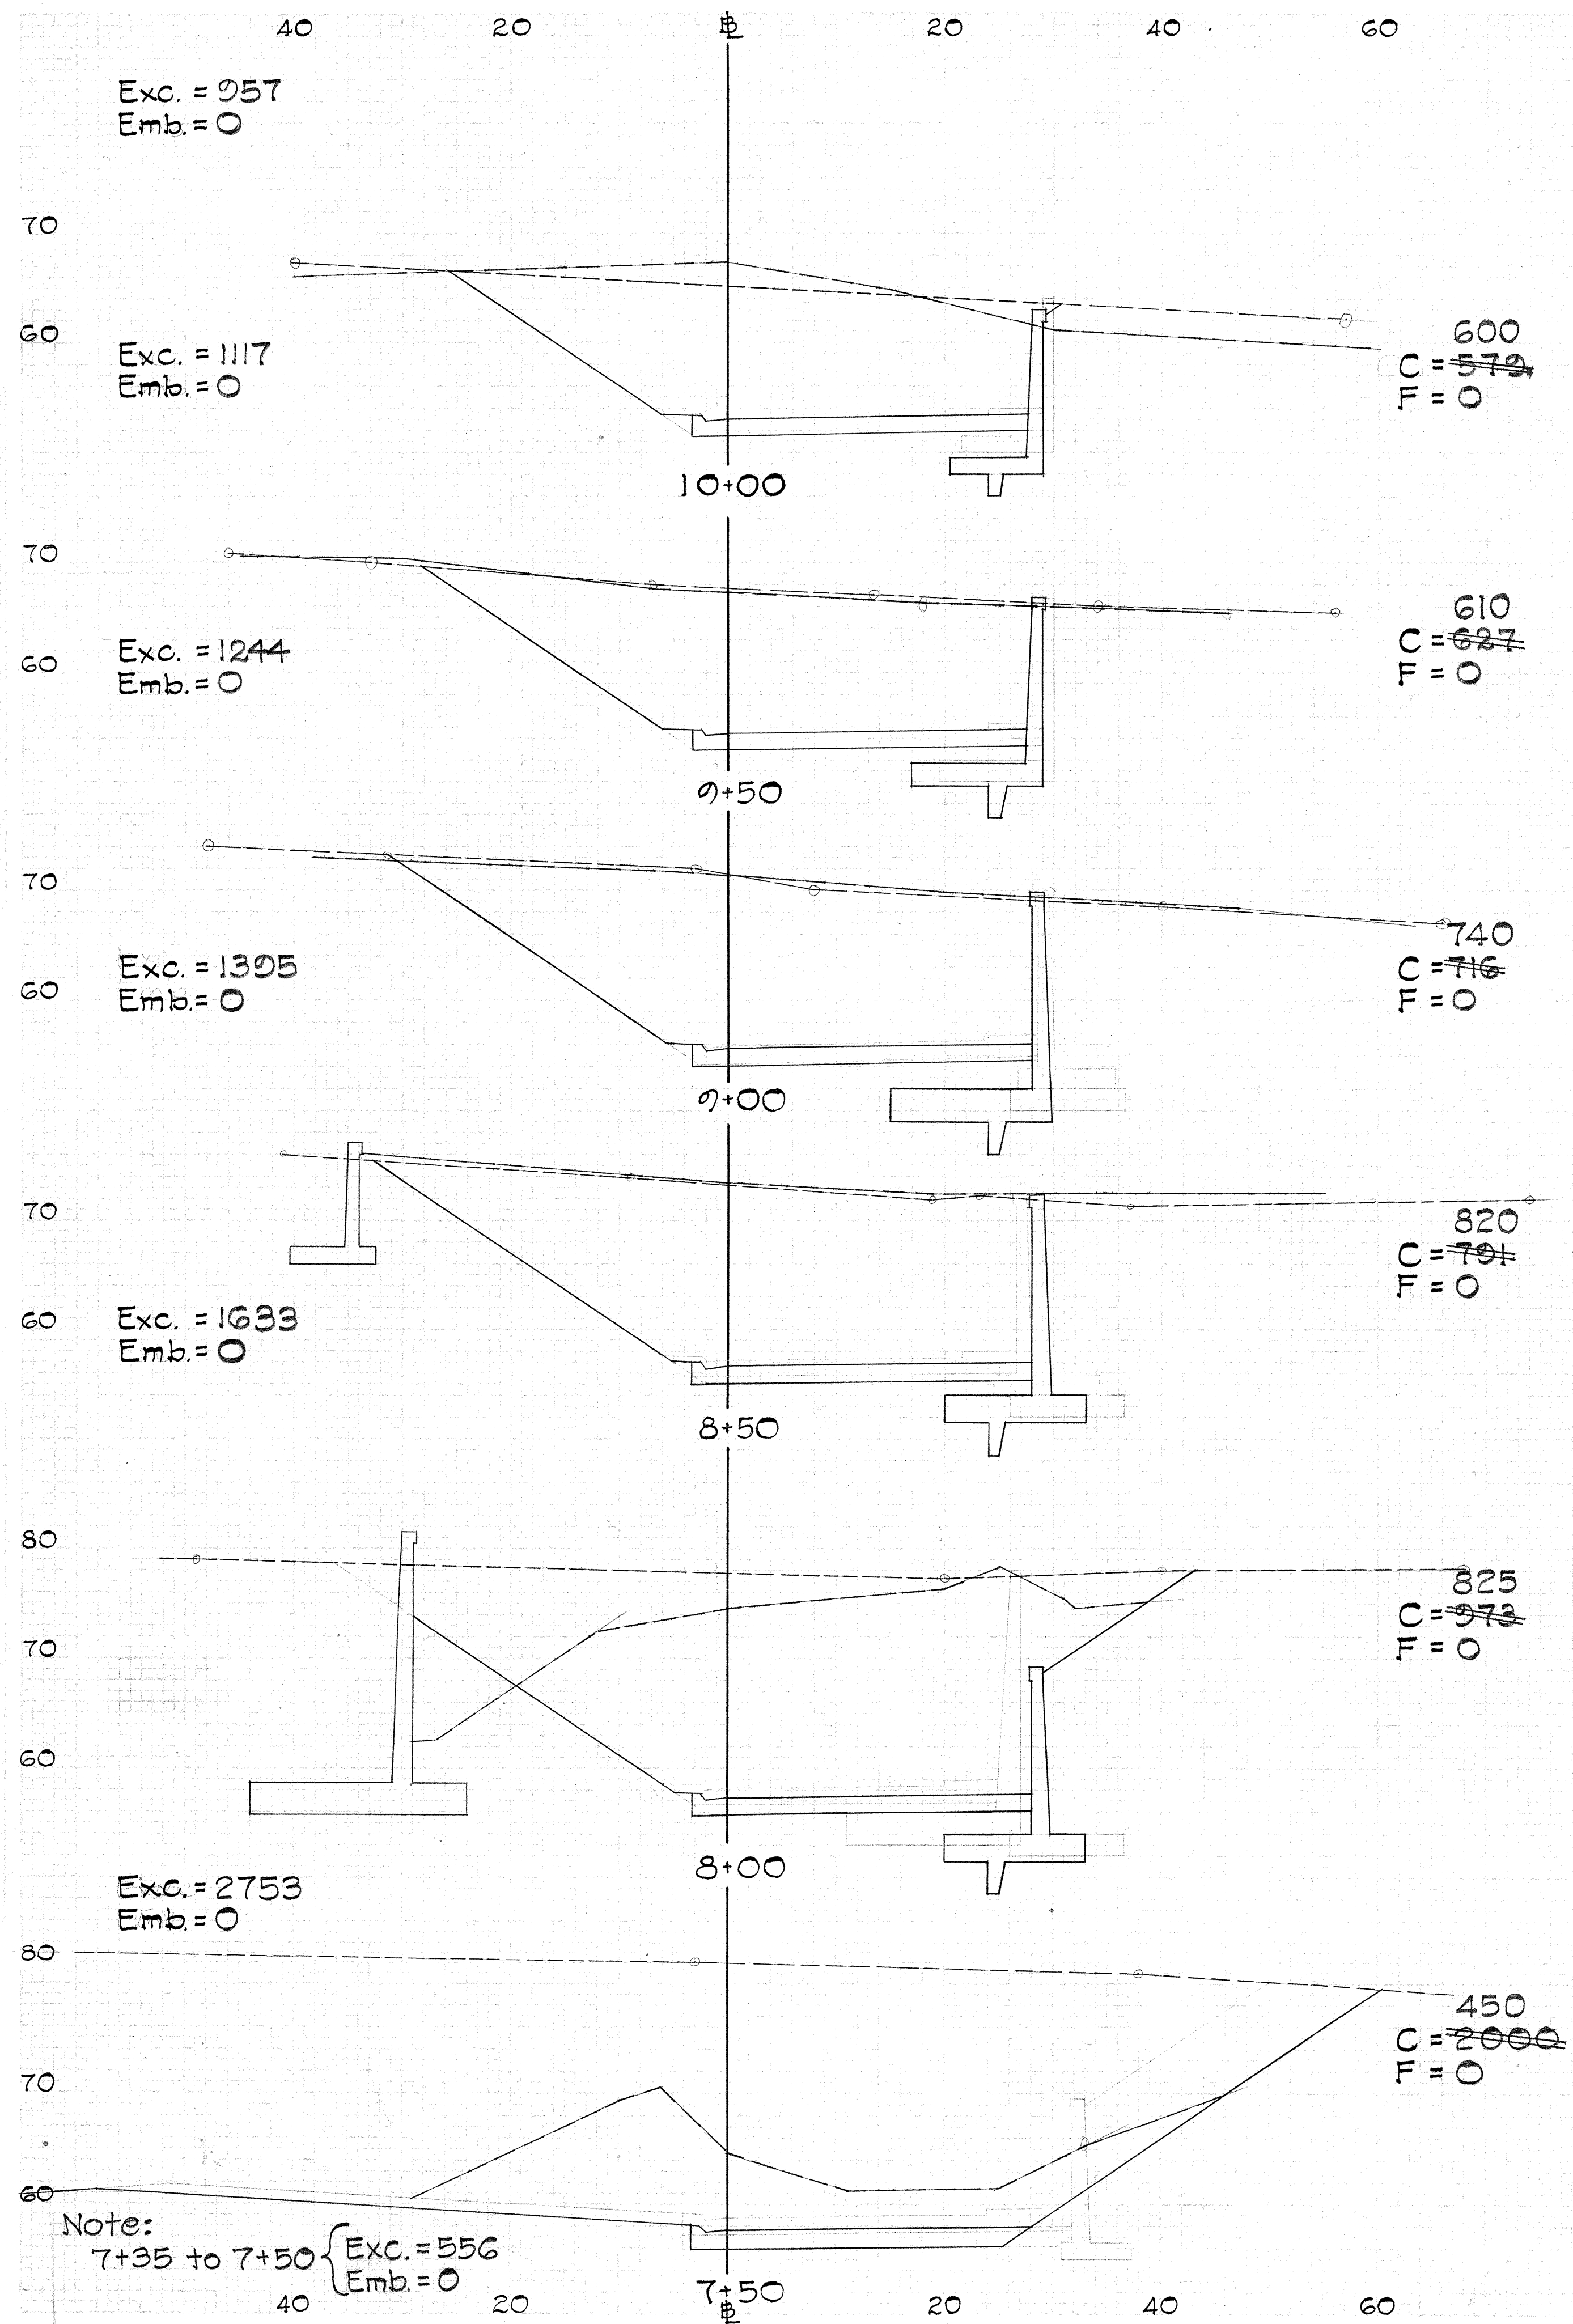

CROSS SECTIONS
RAMP B-1

