


FED. ROAD DIST. NO.	STATE	FED. AID PROJ. NO.	FISCAL YEAR	SHEET NO.	TOTAL SHEETS
HAWAII	HAW.	FH-1(16)H1 FH-1(16)H1	1966	39	28

DATE	
BY	
CHECKED	
DESIGNED	
NOTED	
NO.	

DATE	
BY	
CHECKED	
DESIGNED	
NOTED	
NO.	

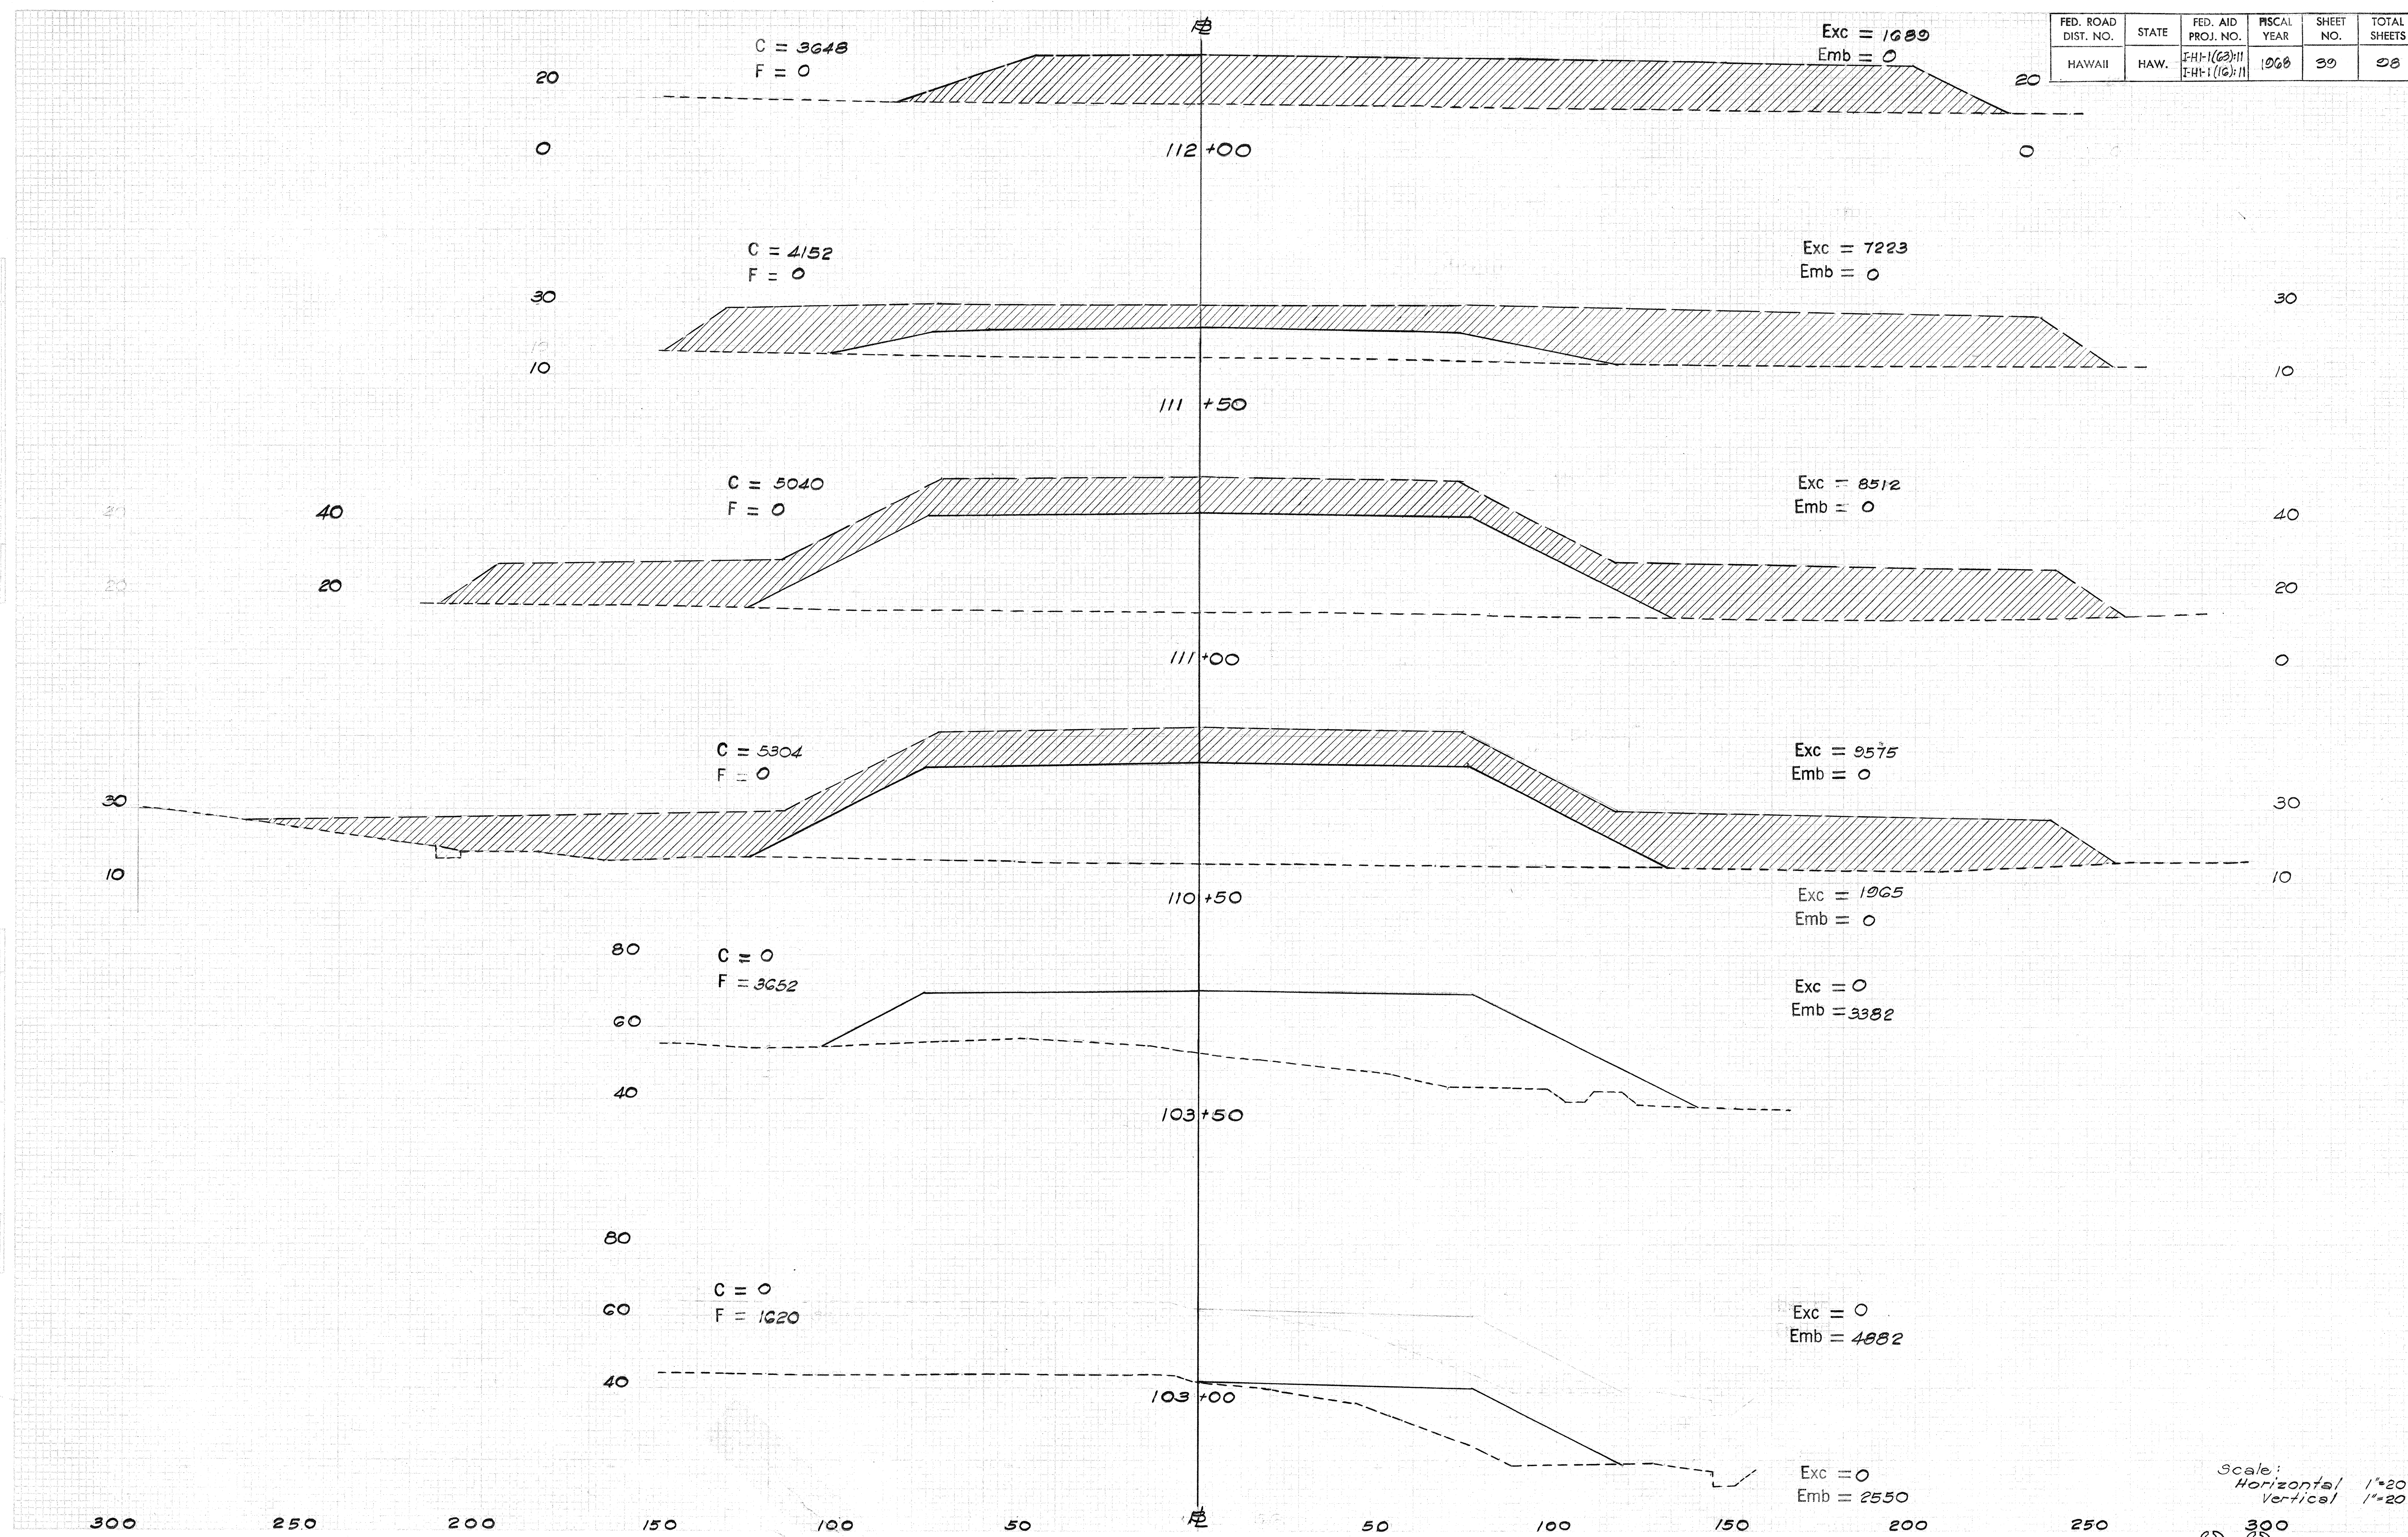

Scale:
Horizontal 1"=20'
Vertical 1"=20'

FED. ROAD DIST. NO.	STATE	FED. AID PROJ. NO.	FISCAL YEAR	SHEET NO.	TOTAL SHEETS
HAWAII	HAW.	I-H-1(63)11 I-H-1(16)11	1968	40	98

C = 60
F = 0

2+51.75

Exc = 105
Emb = 10

C = 50
F = 10

2+00

Exc = 97
Emb = 16

C = 55
F = 7

1+50

Exc = 103
Emb = 16

C = 56
F = 10

1+00

Exc = 107
Emb = 26

C = 62
F = 18

0+50

Exc = 76
Emb = 16

C = 75
F = 0

0+20

Exc = 14
Emb = 0

REALIGNED & PONO STREET

C = 33
F = 0

2+40.24

Exc = 52
Emb = 1

C = 37
F = 1

2+00

Exc = 74
Emb = 2

C = 43
F = 7

1+50

Exc = 68
Emb = 2

C = 30
F = 1

1+00

Exc = 46
Emb = 1

C = 29
F = 0

0+57.65

REALIGNED & PONO HANA PLACE

Scale:
Horizontal 1"=5'
Vertical 1"=5'