



FED. AID DIST. NO.	STATE	FED. AID PROJ. NO.	FISCAL YEAR	SHEET NO.	TOTAL SHEETS
HAWAII	HAWAII	I-HI-1(63)-11	1968	3	28

PLAN	DATE	BY
SURVEYED		
NOTE BOOK		
ALIGNED CHECKED		
RT. OF WAY CHECKED		
NO.		

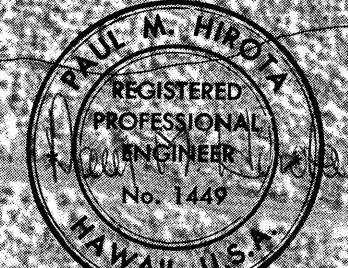

PROFILE	DATE	BY
SURVEYED		
NOTE BOOK		
GRADES CHECKED		
B. M. S. NOTED		
STRUCTURE NOTING CHVD.		
NO.		

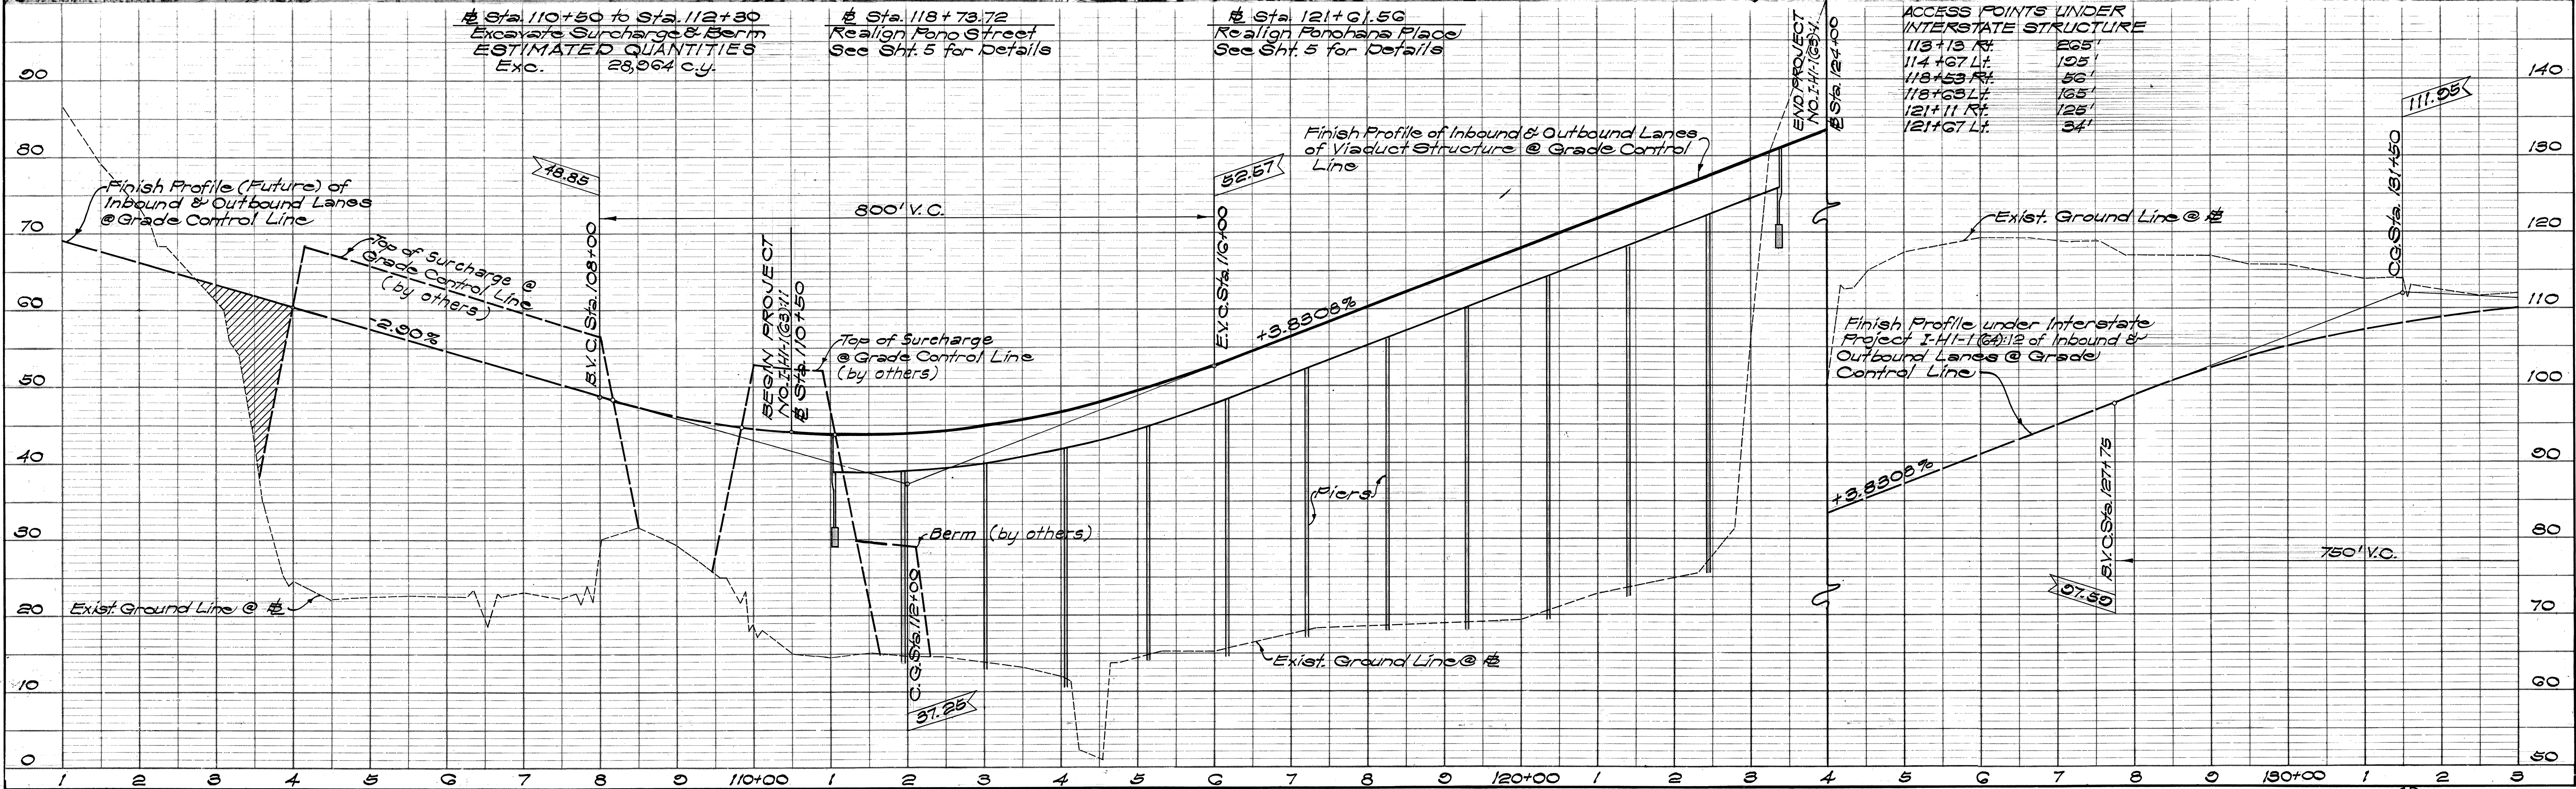

THIS WORK WAS PREPARED BY ME OR UNDER MY SUPERVISION.