

FED. ROAD DIST. NO.	STATE	FED. AID PROJ. NO.	FISCAL YEAR	SHEET NO.	TOTAL SHEETS
HAWAII	HAW.	I-H-1(63):11 I-H-1(16):11	1968	18	28

GENERAL WATER NOTES

- The Contractor shall notify the Board of Water Supply in writing one week prior to commencing work on the water system.
- The Contractor shall arrange with the Board of Water Supply to cut-off existing unused service laterals, remove meter boxes and appurtenances, prior to commencement of clearing and grading operations. Contractor shall provide all necessary excavation.
- Asterisk (*) indicates work to be performed by B.W.S. Materials to be furnished by the Contractor unless specified as "relocate".
- All excavation and backfill shall be done by the Contractor, including excavation for the relocation and lowering of existing mains and excavation for meter to house service connections.
- The locations of existing mains and appurtenances shown on the plans are approximate only and the Contractor shall verify the exact locations. Any adjustment to the water mains and appurtenances whether shown on the construction plans or not shall be made a part of the project.
- The Contractor shall plug the ends of abandoned water mains with class "C-1" concrete. Payment for the class "C-1" concrete used as plugs shall be considered incidental to the various contract items for the water system.
- Concrete in reaction and test blocks shall be class "B-1".
- H.E.Co. and H.T.Co. utility poles, handholes, manholes, ductlines and sewer mains and appurtenances to have minimum of three (3) feet clearance from water mains and other water system appurtenances. Ductlines and sewer lines crossing water mains to have minimum 6" vertical clearances.
- Any excavation work around existing water main shall be by hand only.
- Temporary cleanouts shall be installed by the Contractor wherever necessary and the cost thereof shall be incidental to pipeline work.
- Items indicated as "relocate" on the plans shall be removed, cleaned, painted and reinstalled at the new location by the Contractor unless otherwise specified.
- Prior to final inspection, all fire hydrants shall be cleaned of all oil, grease, dirt or other loose materials and given one coat of an approved red lead and one coat of an approved aluminum hydrant paint.
- ~~Prior to final inspection, all fire hydrants shall be cleaned of all oil, grease, dirt or other loose materials and given one coat of an approved red lead and one coat of an approved aluminum hydrant paint.~~
- All gate valves, fire hydrants and other appurtenances specified as "salvage" on the plans shall be removed, cleaned, and returned to B.W.S. Manana Store Yard, by the Contractor.
- In fill areas where the cover (from the existing ground) over the new main is less than three (3) feet, the Contractor shall first fill and compact the area (to provide a minimum of three (3) feet cover) prior to trenching for the new main.

GENERAL SEWER NOTES

- The Engineer reserves the right to request the use of reinforced concrete cradle and jacket and or piling in the event that field conditions make such structural requirements necessary.
- The Contractor shall notify the Division of Sewers two days prior to commencement of sewer work.
- Top of sewer manholes in easements shall be four (4) inches above ground unless otherwise directed by the Engineer.
- Existing laterals shown are from best sources available. The Contractor shall verify the exact locations as required. Any other existing laterals exposed during construction shall be extended and reconnected to new mains if services are required or cut and plugged.
- All frames and covers on existing sewer manholes to be demolished shall be cleaned and reused on new sewer manholes.

GENERAL ELECTRIC & TELEPHONE NOTES

- Existing electric and telephone systems shown on these plans are located from the best sources available. The Contractor shall check and verify the exact location and depth of same.
- Contractor to stake out proposed ductlines, pole and anchor locations; H.E.Co. to check locations before Contractor undertakes excavations.
- Minimum depth of ductlines from finish grade to top of concrete jacket where ducts are concrete encased - 2'-0" unless otherwise shown.
- Ducts encased in concrete jackets:
 - Normal distance from face of jacket to all ducts to be 3" minimum.
 - Clear distance of 1 1/2" minimum between ducts of same utility company.
 - Clear distances of 3" minimum between H.E.Co. ducts and H.T.Co. ducts.
- All ducts and conduits called for installation in concrete jacket shall be inspected and approved by the respective Engineer of H.E.Co. or H.T.Co. or their representative before concrete placing. 24 hr. (min.) notice shall be given before placing concrete.
- Depth of all pullboxes, service boxes and H.E.Co. handholes and manholes to be determined in the field.
- Poles and anchors for H.E.Co. unless otherwise noted.
- Depth of poles and anchor holes are taken from finish grade.
- For pole setting depth data, see sht. No. 20.
- Installation of, and backfill for poles by H.E.Co. unless otherwise noted.
- Backfill of anchor holes by the Contractor under H.E.Co. supervision unless otherwise noted.
- The Contractor shall notify the affected property owners, if any, at least one week in advance as to the time and duration the trenching and installation of underground electric and telephone service facilities are to be performed with their lots.

LEGEND

EXISTING	NEW		EXISTING	NEW	
—Sg—	—Sg—	Sewer Line	•P	•P	Electric or Telephone Pole
—Wg—	—Wg—	Water Line	•A	•A	Electric or Telephone Pole with Anchor
—E—	—E—	Electric Duct Line	•L.S.	•L.S.	Light Standard
—T—	—T—	Telephone Duct Line	■H.E.	□H.E.	Electric Handhole or Manhole
—SMH	—SMH	Sewer Manhole	■H.T.	□H.T.	Telephone Handhole or Manhole
—WMH	—WMH	Water Manhole	✕P.Pole		Electric or Telephone Pole to be removed
—WV	—WV	Water Valve	—	—	Direct Buried Conduits (Elec. and/or Tel.)
—W.M.	—W.M.	Water Meter	—	—	Cut and Plug Sewer or Water Line
—F.H.	—F.H.		—	—	Cut, Plug & Abandon in Place Sewer or Water Line

APPROVED:

P. Henderson
Hawaiian Electric Co., Inc.
P. Hull
Hawaiian Telephone Co.
J. Kawakami
Chief, Engineering Division B.W.S.
W. Lee
Sewer System Director, Division of Sewers


8-20-68
Date
8-20-68
Date
8-20-68
Date
8-12-68
Date



THIS WORK WAS PREPARED BY ME OR UNDER MY SUPERVISION.

STATE OF HAWAII
DEPARTMENT OF TRANSPORTATION
HIGHWAYS DIVISION
UTILITY GENERAL NOTES
SEWER, WATER,
ELECTRICAL AND TELEPHONE
INTERSTATE ROUTE H-1
PROJ. NOS. I-H-1(63):11
I-H-1(16):11
Date: 8/14/68
SHEET No. 1 OF 17 SHEETS


FED. ROAD DIST. NO.	STATE	FED. AID PROJ. NO.	FISCAL YEAR	SHEET NO.	TOTAL SHEETS
HAWAII	HAW.	I-H-1(03):11 I-H-1(10):11	1968	19	28

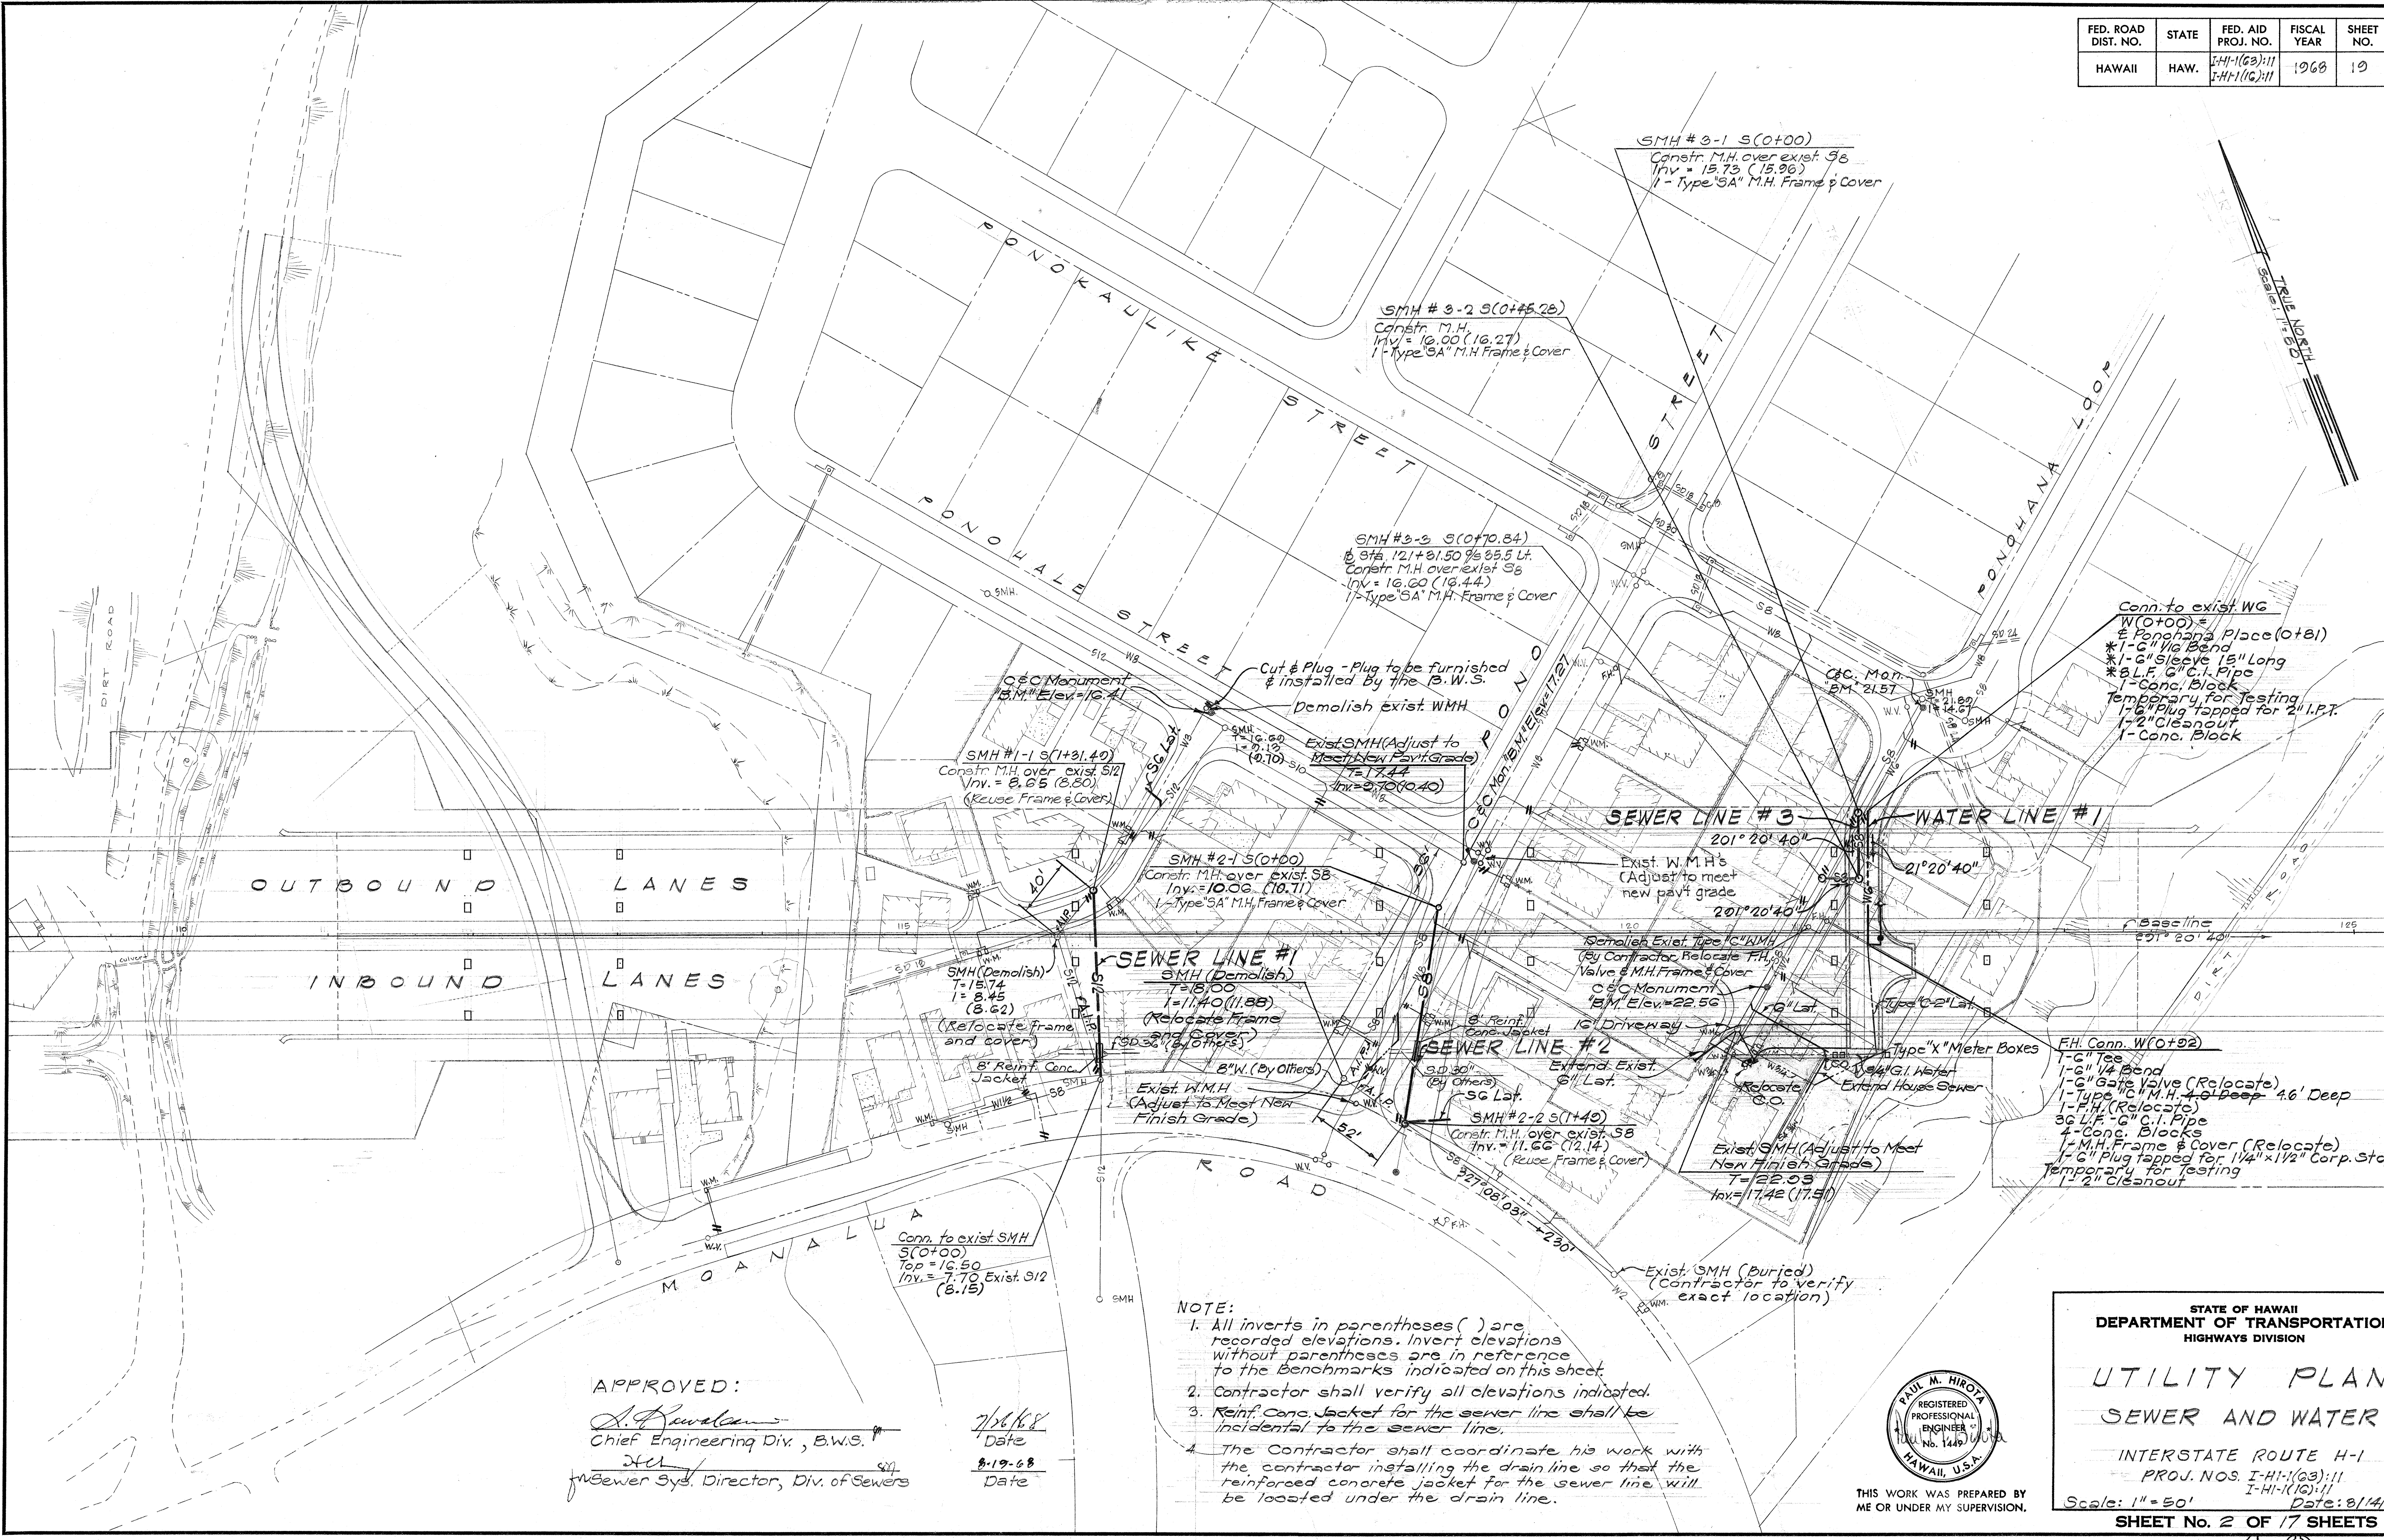

STATE OF HAWAII
DEPARTMENT OF TRANSPORTATION
HIGHWAYS DIVISION

UTILITY PLAN SEWER AND WATER

INTERSTATE ROUTE H-1
PROJ. NOS. I-H-1(03):11
I-H-1(10):11
Scale: 1" = 50'
Date: 8/14/68
SHEET NO. 2 OF 17 SHEETS

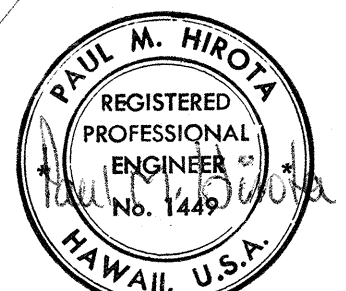

THIS WORK WAS PREPARED BY
ME OR UNDER MY SUPERVISION.

NOTE:

- All inverts in parentheses () are recorded elevations. Invert elevations without parentheses are in reference to the benchmarks indicated on this sheet.
- Contractor shall verify all elevations indicated.
- Reinf. Conc. Jacket for the sewer line shall be incidental to the sewer line.
- The Contractor shall coordinate his work with the contractor installing the drain line so that the reinforced concrete jacket for the sewer line will be located under the drain line.

APPROVED:

S. Kawakami
Chief Engineering Div., B.W.S.

J. A. [Signature]
Sewer Sys. Director, Div. of Sewers


7/16/68
Date

8-19-68
Date

REFERENCE NOTES:

1. For details of H.T. Pull Box #435 T-B, see Sht. 23
2. For profiles of duct lines, see Sht. 21
3. For details of Double 3'x5' Precast Handhole see Sht. 24
4. Contractor shall excavate & backfill trench for H.E.Co. direct buried cable in Lot Tax Map Key 9-8-26:70. Furnishing & installing cable shall be by H.E.Co. (To be measured & paid for under Item 120.3651.)


FED. ROAD DIST. NO.	STATE	FED. AID PROJ. NO.	FISCAL YEAR	SHEET NO.	TOTAL SHEETS
HAWAII	HAW.	HI-1(63):11 HI-1(16):11	1968	20	28

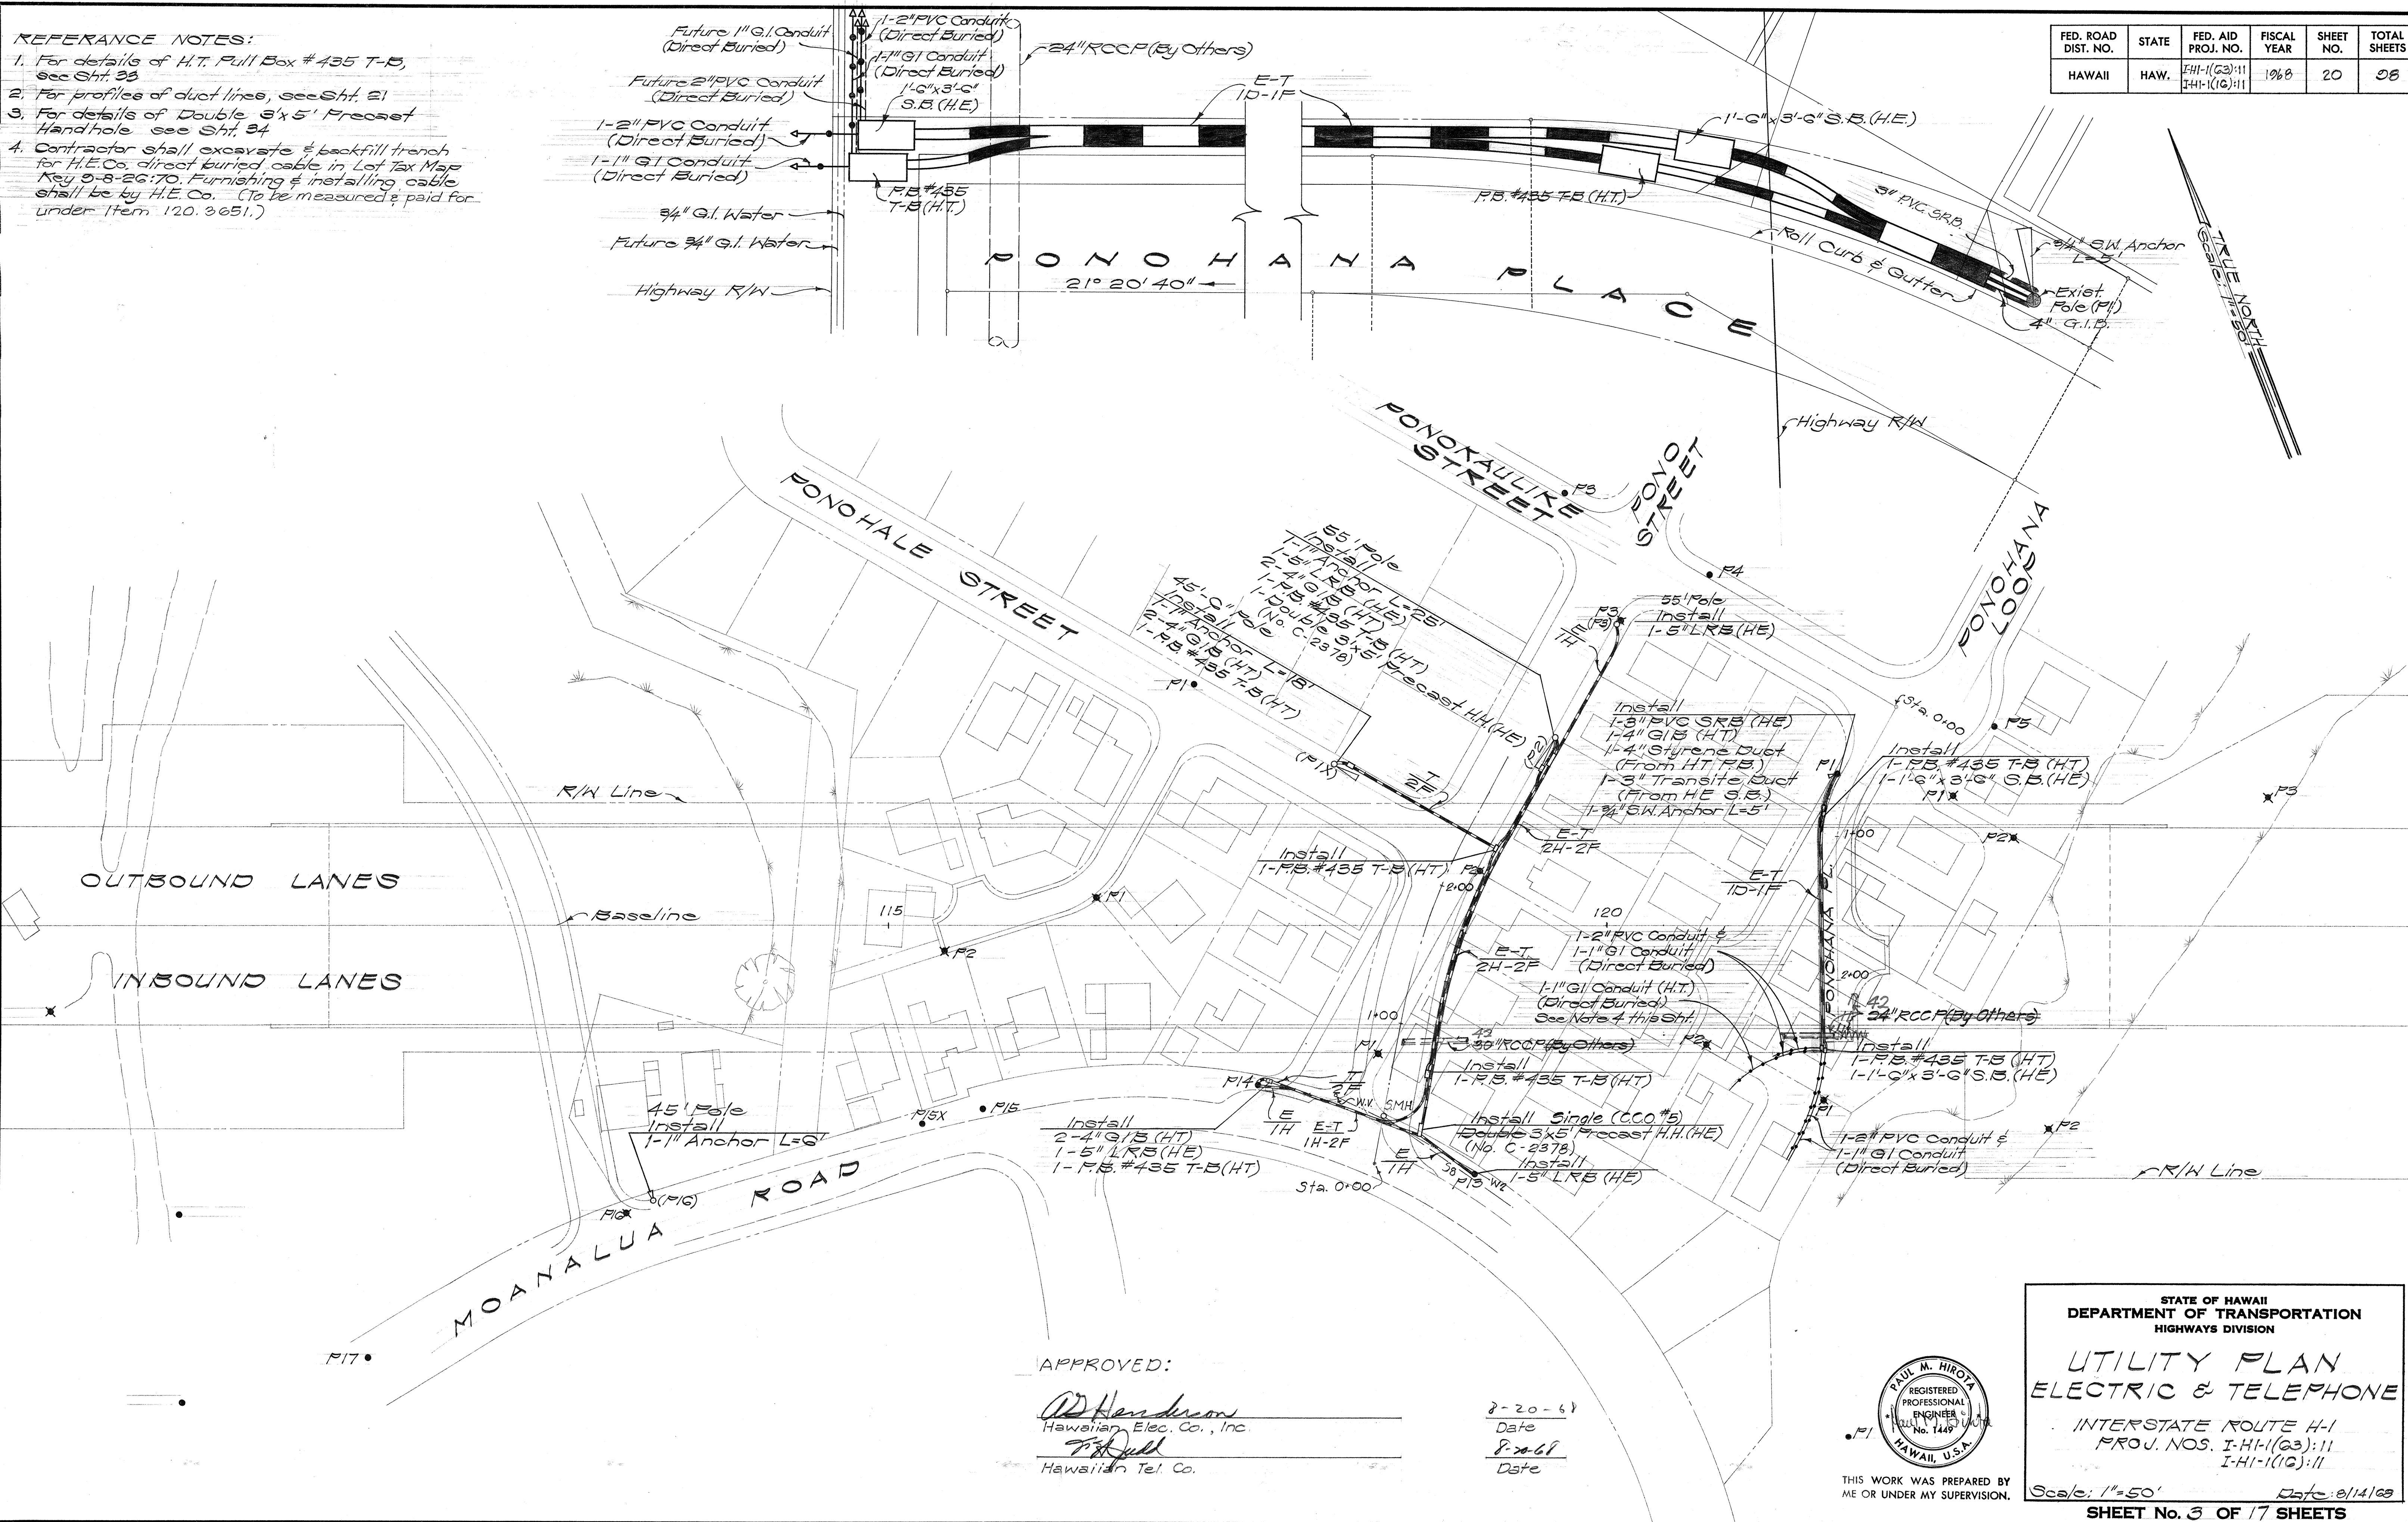

APPROVED:

Ad Henderson
Hawaiian Elec. Co., Inc.
W. J. Hall
Hawaiian Tel. Co.

8-20-67
Date
8-20-68
Date

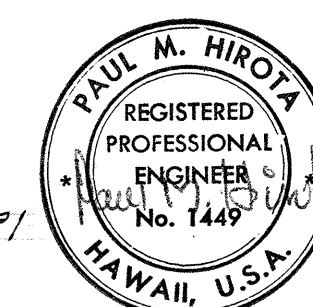

THIS WORK WAS PREPARED BY
ME OR UNDER MY SUPERVISION.

STATE OF HAWAII
DEPARTMENT OF TRANSPORTATION
HIGHWAYS DIVISION


**UTILITY PLAN
ELECTRIC & TELEPHONE**

INTERSTATE ROUTE H-1
PROJ. NOS. I-H-1(63):11
I-H-1(16):11


Scale: 1"=50' Date: 8/14/68
SHEET No. 3 OF 17 SHEETS

FED. ROAD DIST. NO.	STATE	FED. AID PROJ. NO.	FISCAL YEAR	SHEET NO.	TOTAL SHEETS
HAWAII	HAW.	I-HI-(63)-11 I-HI-(16)-11	1968	21	28


LEGEND FOR CONDUIT	
CONDUIT SIZE	SYMBOL
3"	D
4"	F
5"	H

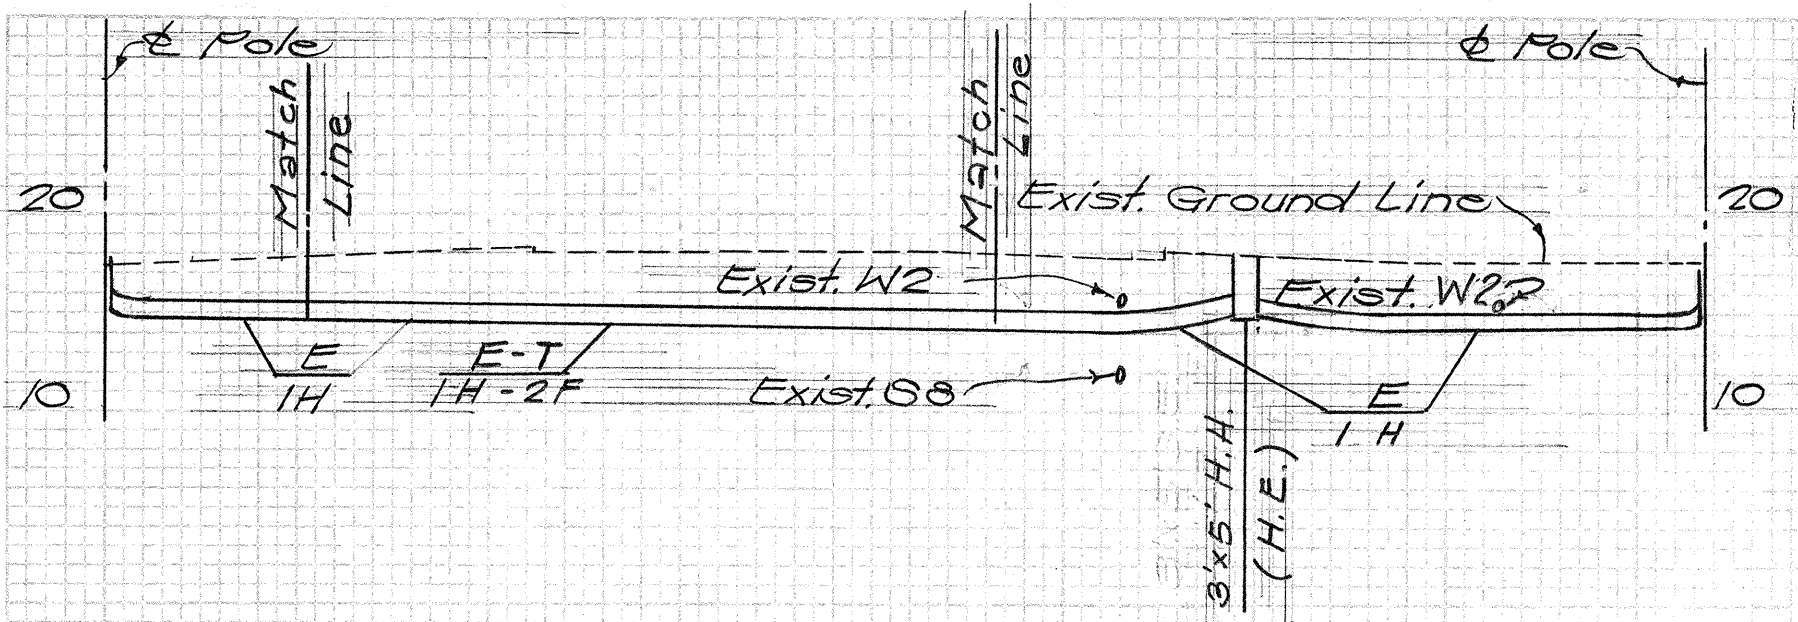


PROFILE-MOANALUA RD. ELECTRICAL DUCT LINE
Scales: Horiz. 1"=20'
Vert. 1"=10'

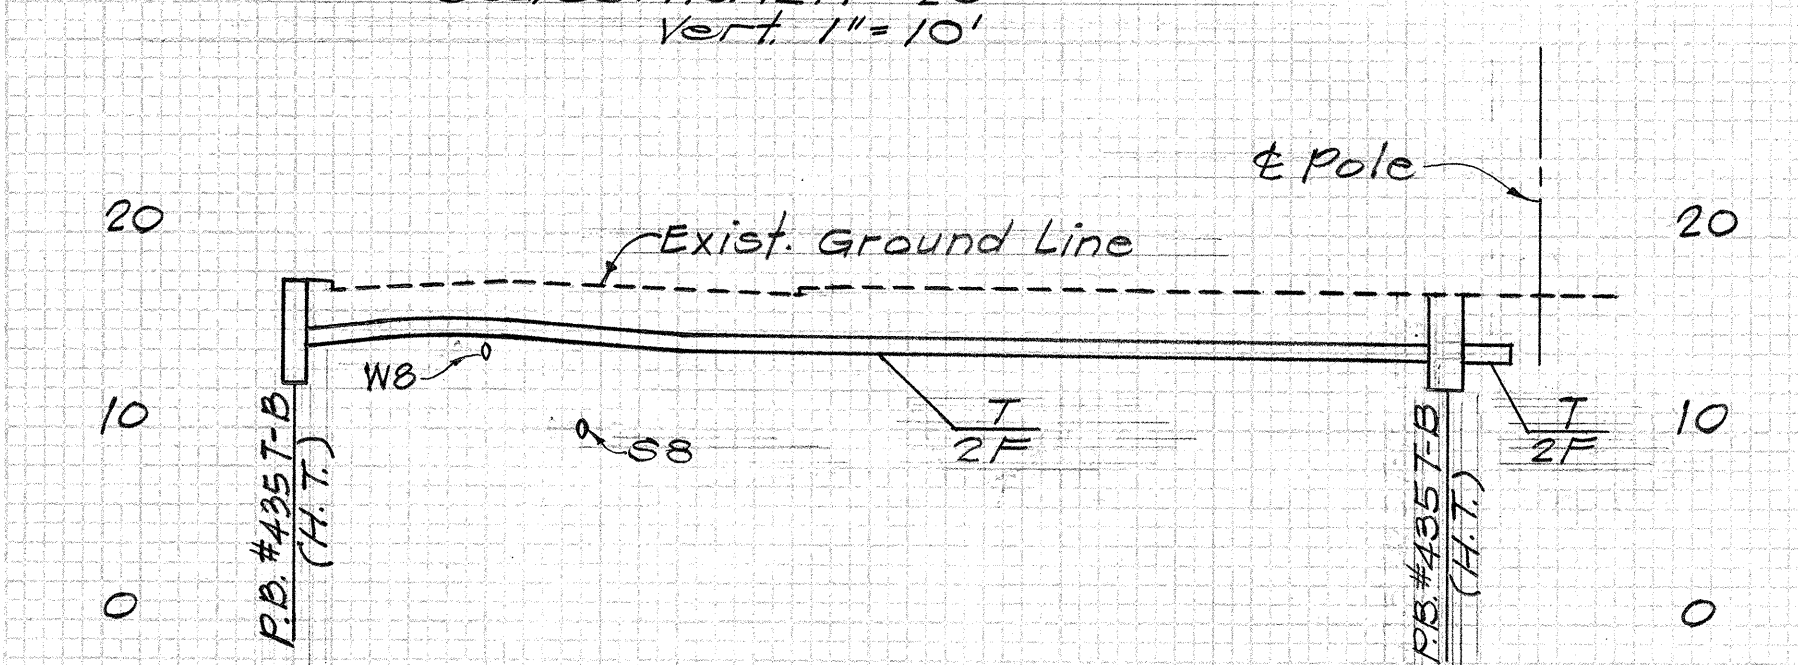


PROFILE-PONOHALE ST. TELEPHONE DUCT LINE
Scales: Horiz. 1"=20'
Vert. 1"=10'

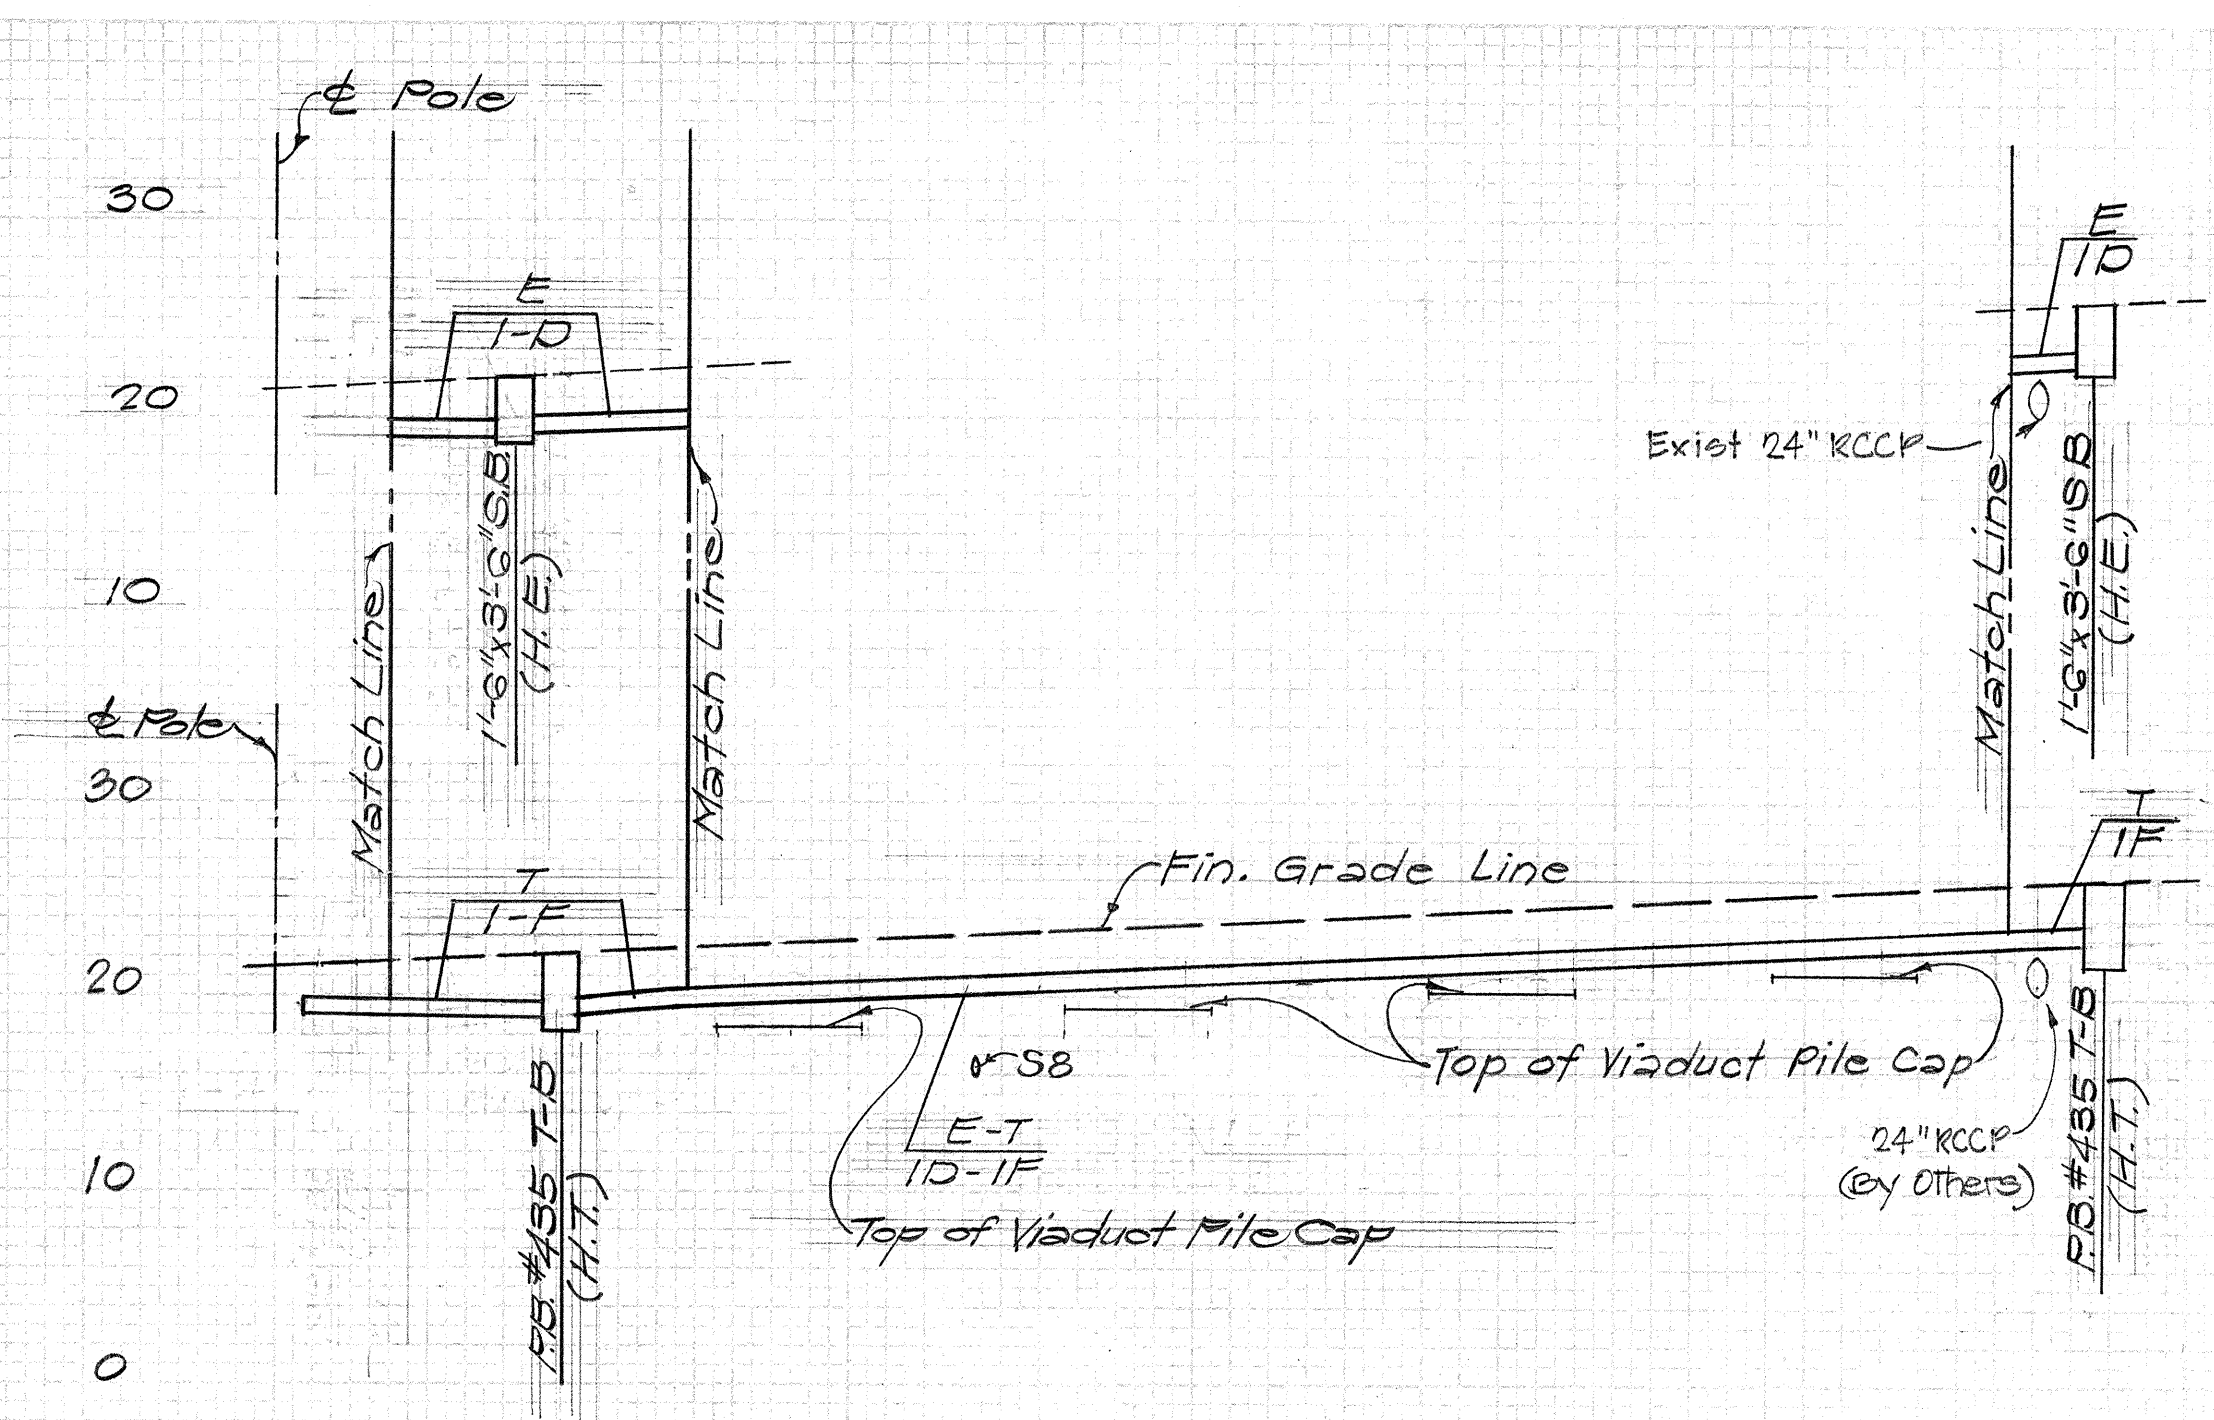


PROFILE-PONOHANA PL. ELEC. & TELE. DUCT LINE
Scales: Horiz. 1"=20'
Vert. 1"=10'

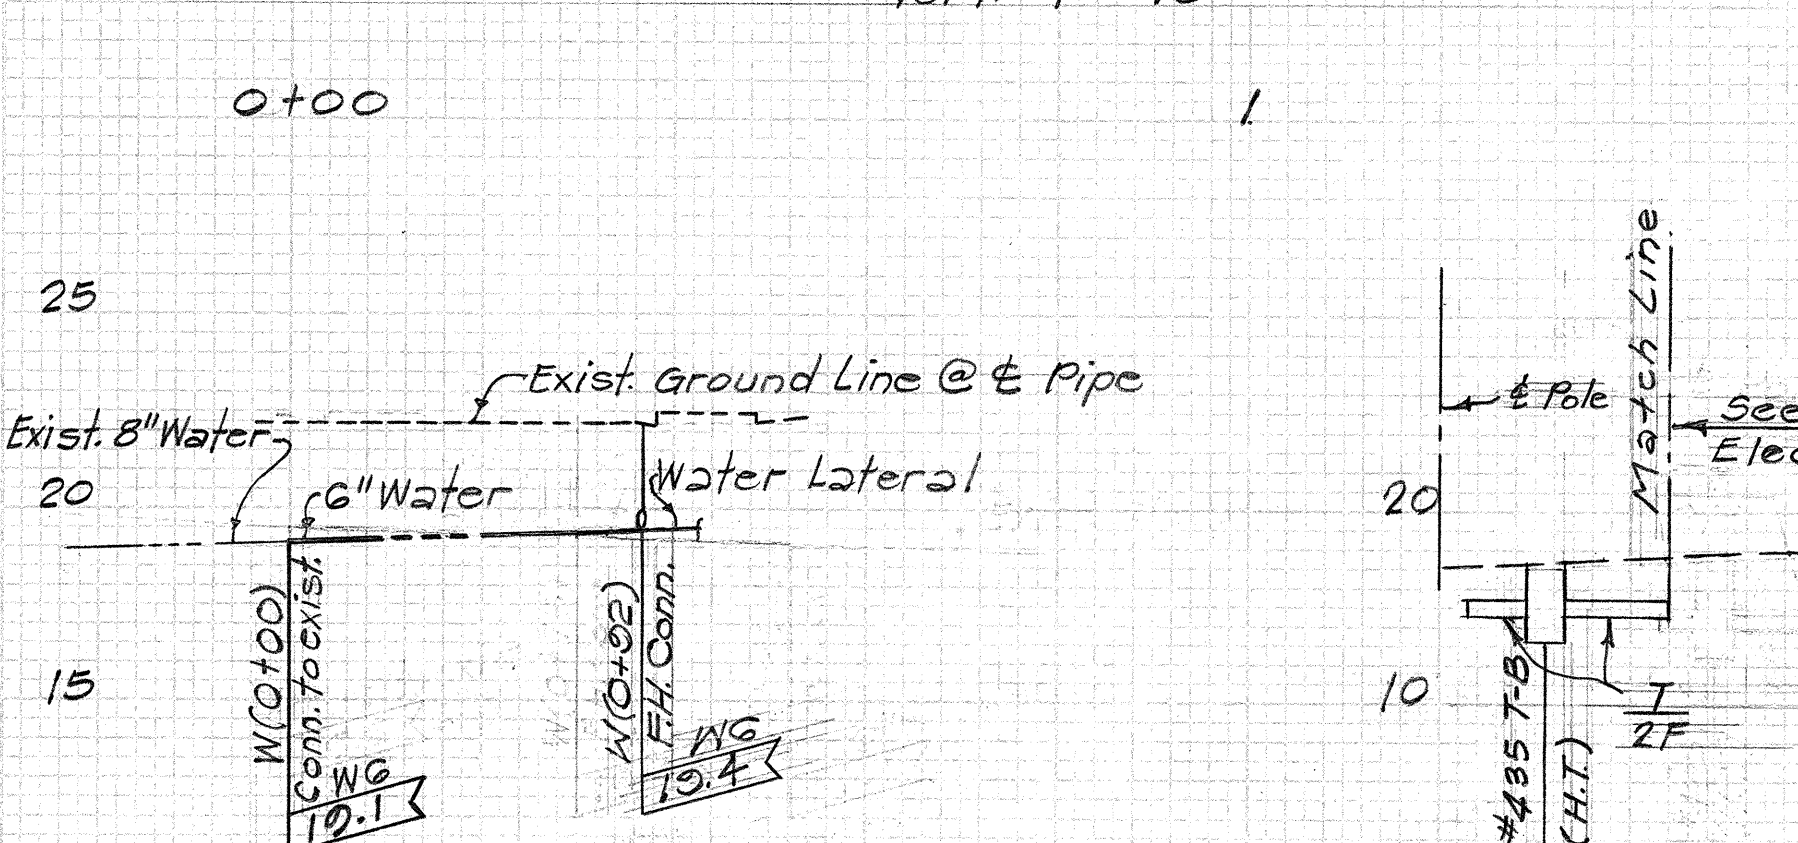


PROFILE-WATER LINE #1
Scales: Horiz. 1"=50'
Vert. 1"=5'

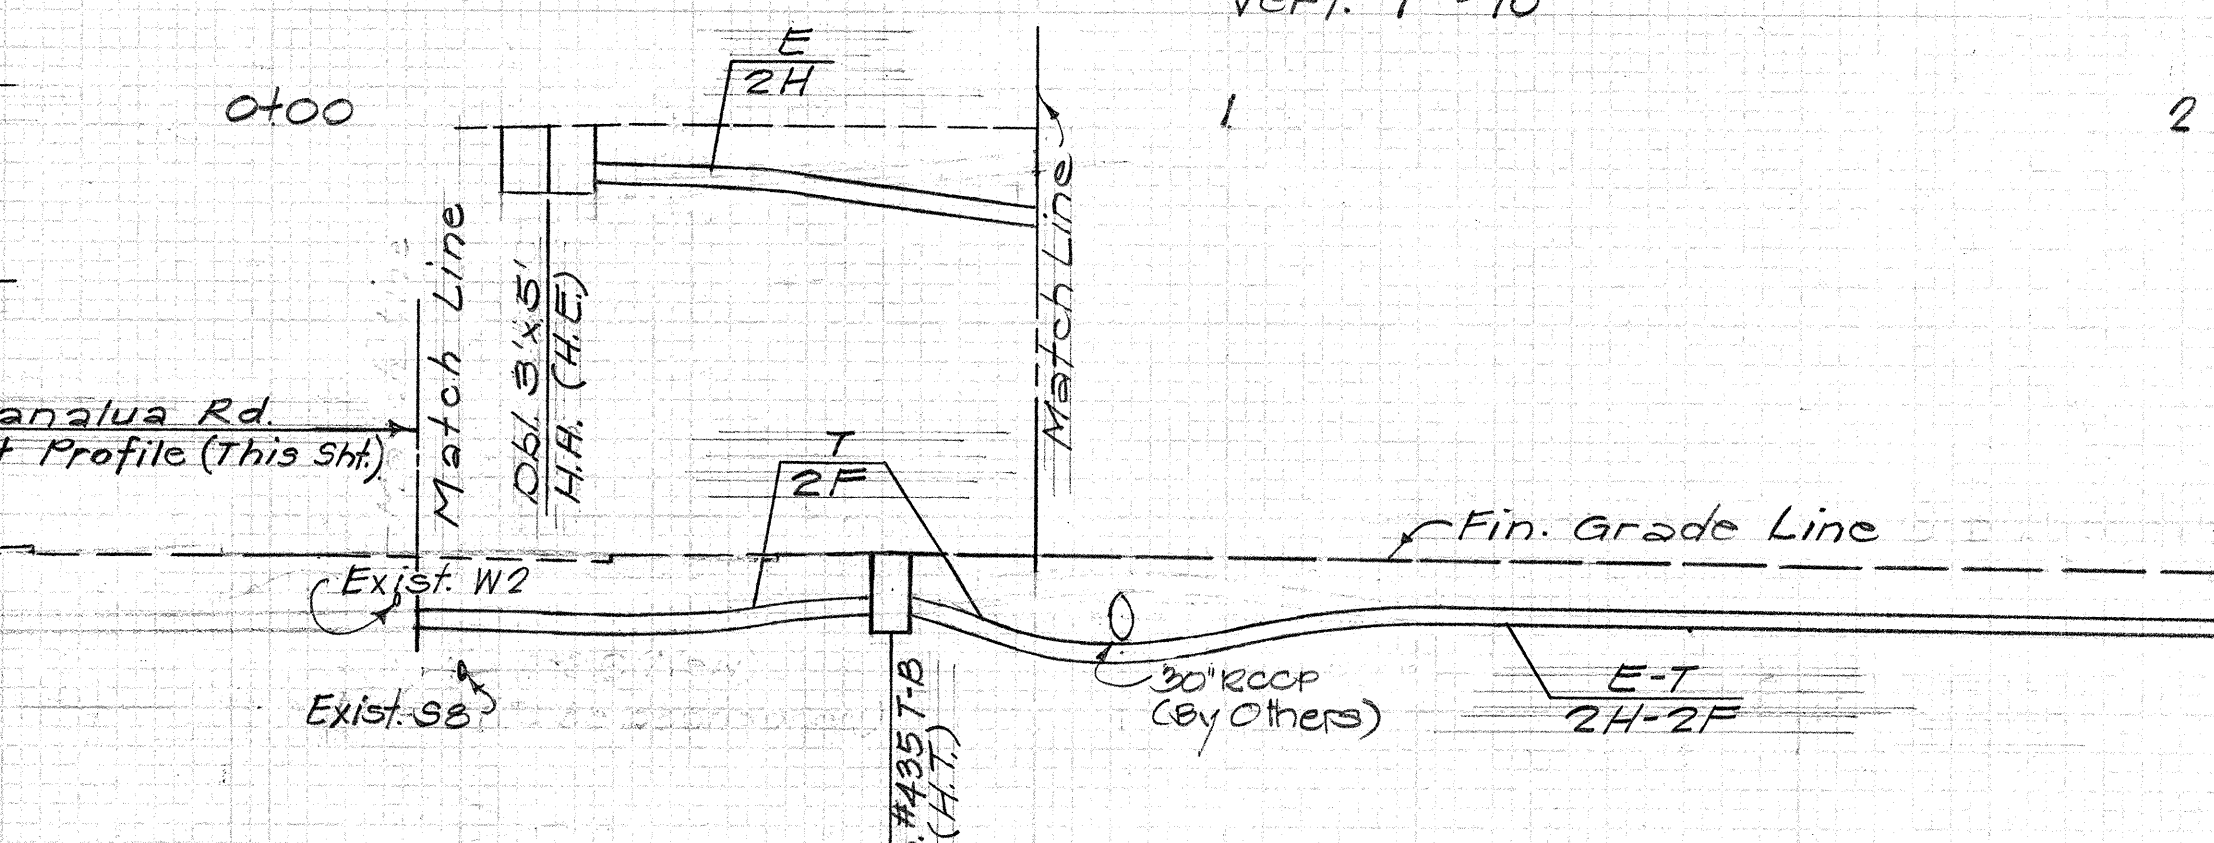


PROFILE-PONO ST. ELEC. & TELE. DUCT LINE
Scales: Horiz. 1"=20'
Vert. 1"=10'

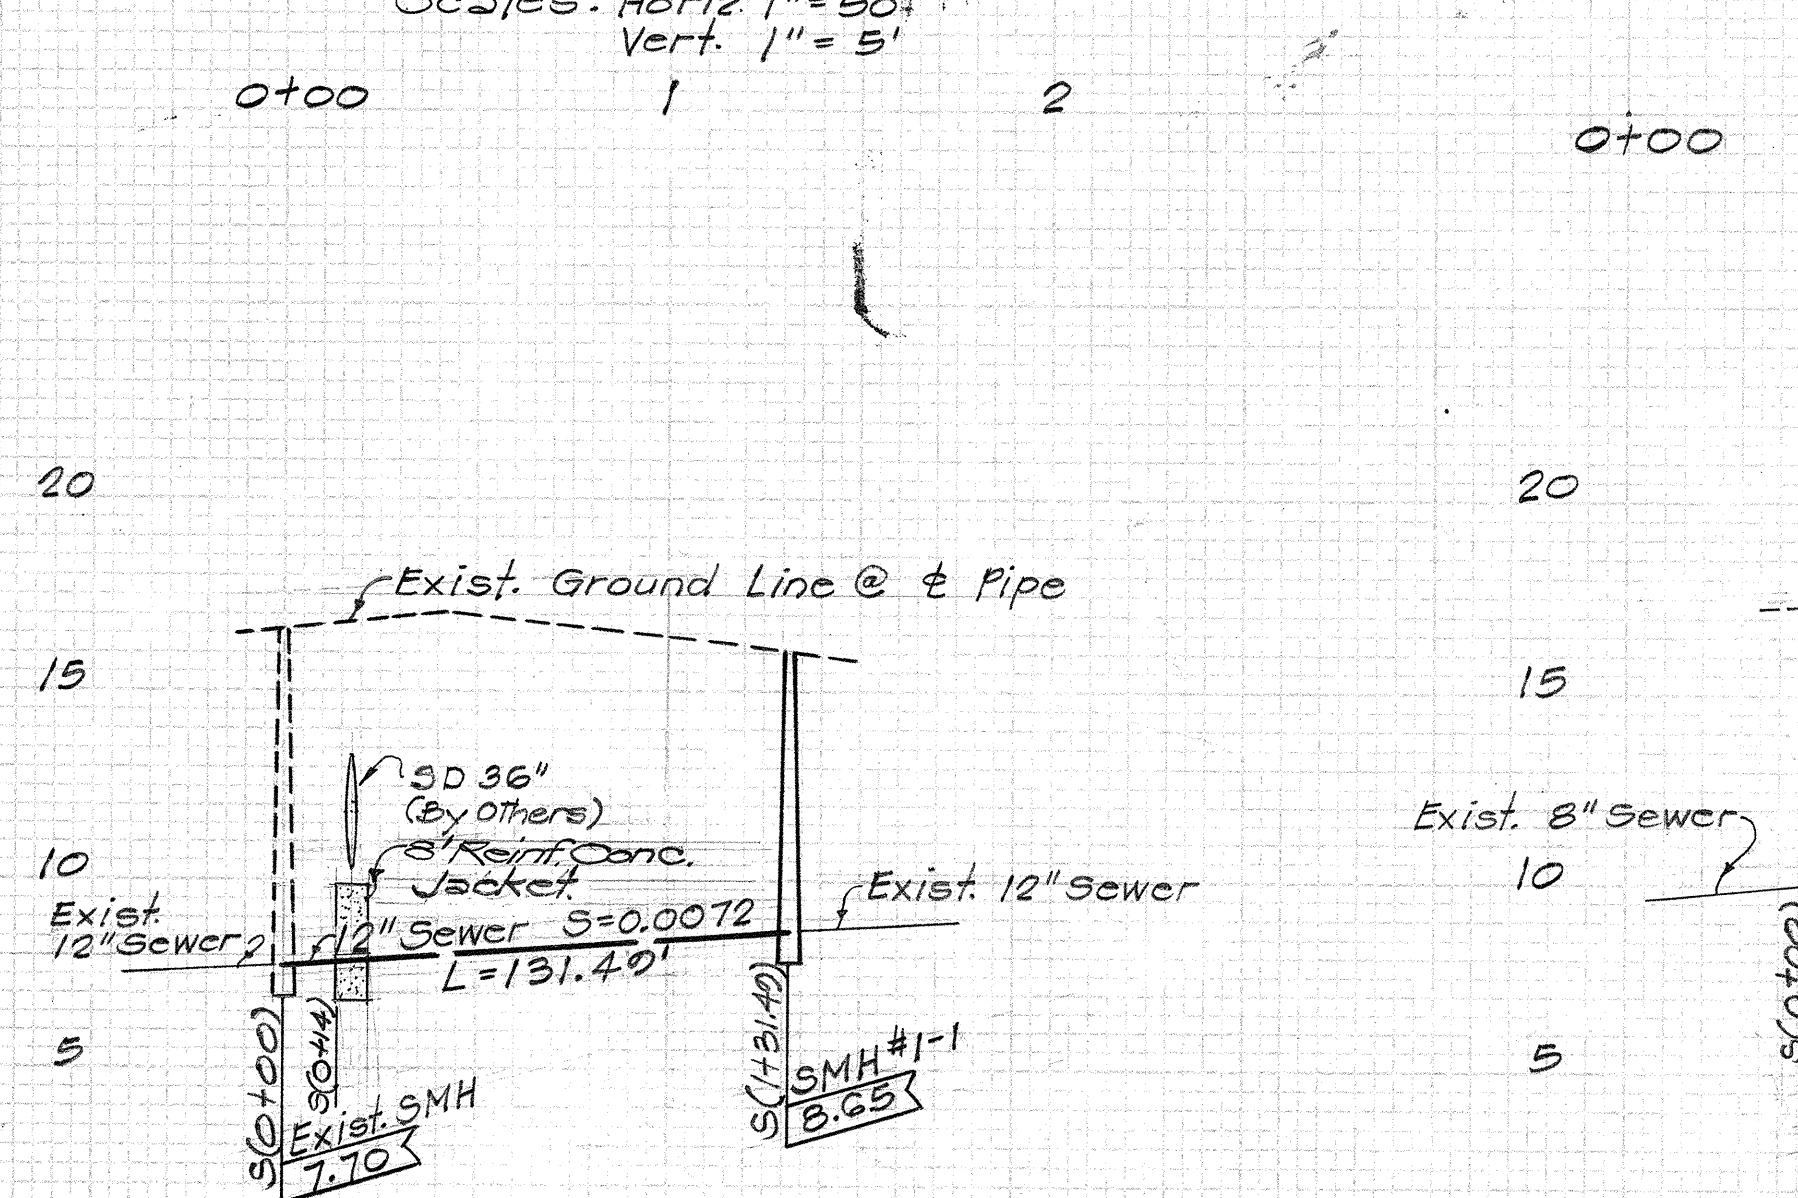

PROFILE-SEWER LINE #1
Scales: Horiz. 1"=50'
Vert. 1"=5'

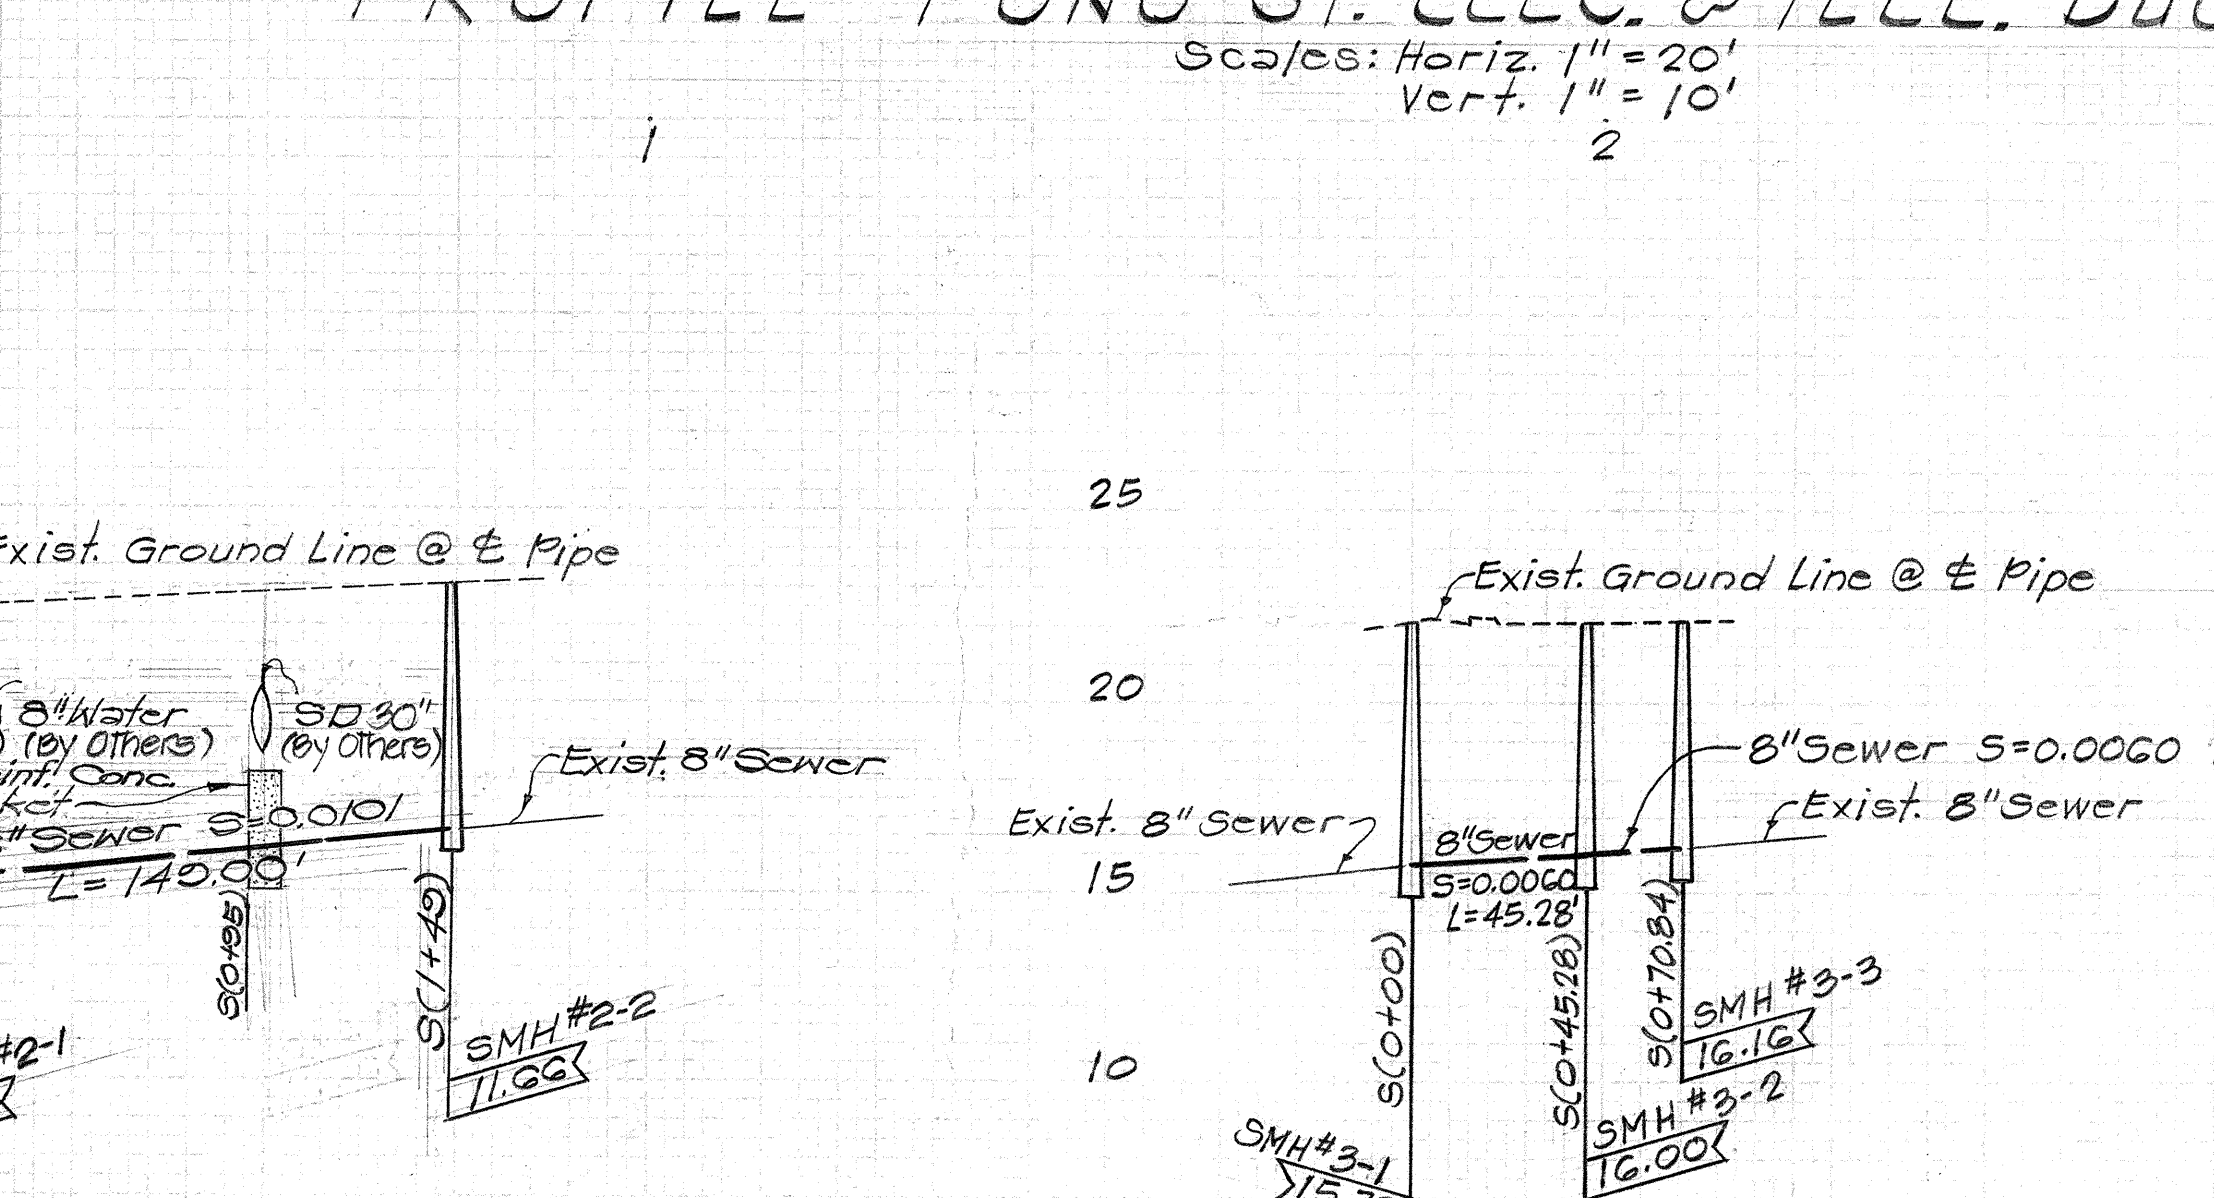

PROFILE-SEWER LINE #2
Scales: Horiz. 1"=50'
Vert. 1"=5'

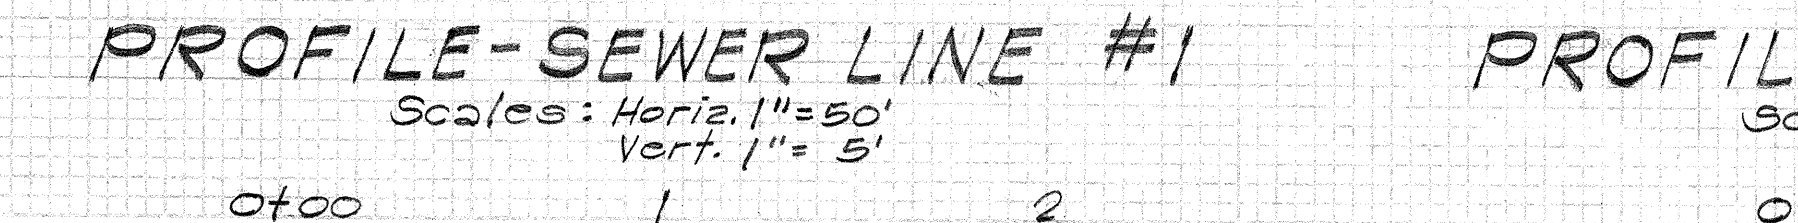

PROFILE-SEWER LINE #3
Scales: Horiz. 1"=50'
Vert. 1"=5'

2-5" TRANSITE KORDUCTS
2-4" STYRENE DUCTS
(Not to Scale)

1-5" TRANSITE KORDUCT DUCTS
(Not to Scale)

2-4" STYRENE DUCTS (H.T.)
(Not to Scale)

1-3" TRANSITE KORDUCT
(Not to Scale)

2-5" TRANSITE KORDUCT (H.E.)
(Not to Scale)

1-4" STYRENE DUCT
(Not to Scale)

1-3" TRANSITE KORDUCT (H.E.)
(Not to Scale)

1-4" STYRENE DUCT (H.T.)
(Not to Scale)

1-5" TRANSITE KORDUCT (H.E.)
(Not to Scale)

1-2" PVC Conduit & 1-1" G.I. Conduit
(Direct Burial)


APPROVED:

Paul M. Hirota
Hawaiian Elec. Co., Inc.
Date: 8-20-68

Paul M. Hirota
Hawaiian Tel. Co.
Date: 8-20-68

Paul M. Hirota
Chief, Engineering Div., B.W.S.
Date: 8-20-68

Paul M. Hirota
Sewer Sys. Director, Div. of Sewers
Date: 8-20-68

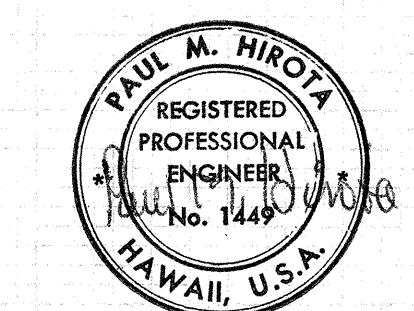

STATE OF HAWAII
DEPARTMENT OF TRANSPORTATION
HIGHWAYS DIVISION

UTILITY PROFILE
SEWER, WATER, ELECTRIC
AND TELEPHONE
INTERSTATE ROUTE H-1
PROJ. NOS. I-HI-(63)-11
I-HI-(16)-11
Scale: As Shown Date: 8/14/68

SHEET No. 4 OF 17 SHEETS


THIS WORK WAS PREPARED BY ME OR UNDER MY SUPERVISION.

FED. ROAD DIST. NO.	STATE	FED. AID PROJ. NO.	FISCAL YEAR	SHEET NO.	TOTAL SHEETS
HAWAII	HAWAII	HA-1(63)-11 HA-1(16)-11	1968	22	26

SCHEDULE OF COPPER FITTINGS (SOLDERED JOINT)


ITEM NO.	DESCRIPTION	SINGLE SERVICE CONN.	MULTIPLE TWO SERVICES	SERV.CONN. THREE SERVICES
1	Corporation Stop Brass (H-10003)	1	1	1
2	Ground Joint Union (Style Copper To N.P.T.E. No. C-109)	1	1	1
3	Adapter, Copper To N.P.T.E. (Style No. C-101)	2	1	1
4	Stopcock Brass (BWS Standard)	1	1	1
5	Fitting Adapter, (Style Fitting To N.P.T.E. No. C-104)	—	1	1
6	Tee, Copper To Copper To Copper (Style No. T-300)	—	1	1
7	Bushings, Fitting To Copper (Style No. C-103)	—	2	2
8	90° Elbow, Copper To Copper (Style No. C-200)	—	2	2
9	Adapter, Copper To N.P.T.E. (Style No. C-101)	1	2	3
10	Stopcock Brass (BWS Standard)	1	2	3
11	Reducing Tee, Copper To Copper To Copper (Substitute For Items Number 6 and 7). (Style No. T-300)	—	1	1
12	Tee, Copper To Copper To Copper (Style No. T-300)	—	—	1
13	Bushing, Fitting To Copper (Style No. C-103)	—	—	1
14	Reducing Tee, Copper To Copper To Copper (Substitute For Items Number 12 and 13) (Style No. T-300)	—	—	1

NOTE:
Reference Numbers shown thus (H-10003) are from Mueller Co. Catalog "H" and (Style No. T-300) are from Mueller Brass Co. "Streamline" Catalog S-354. Approved Equal may be used.

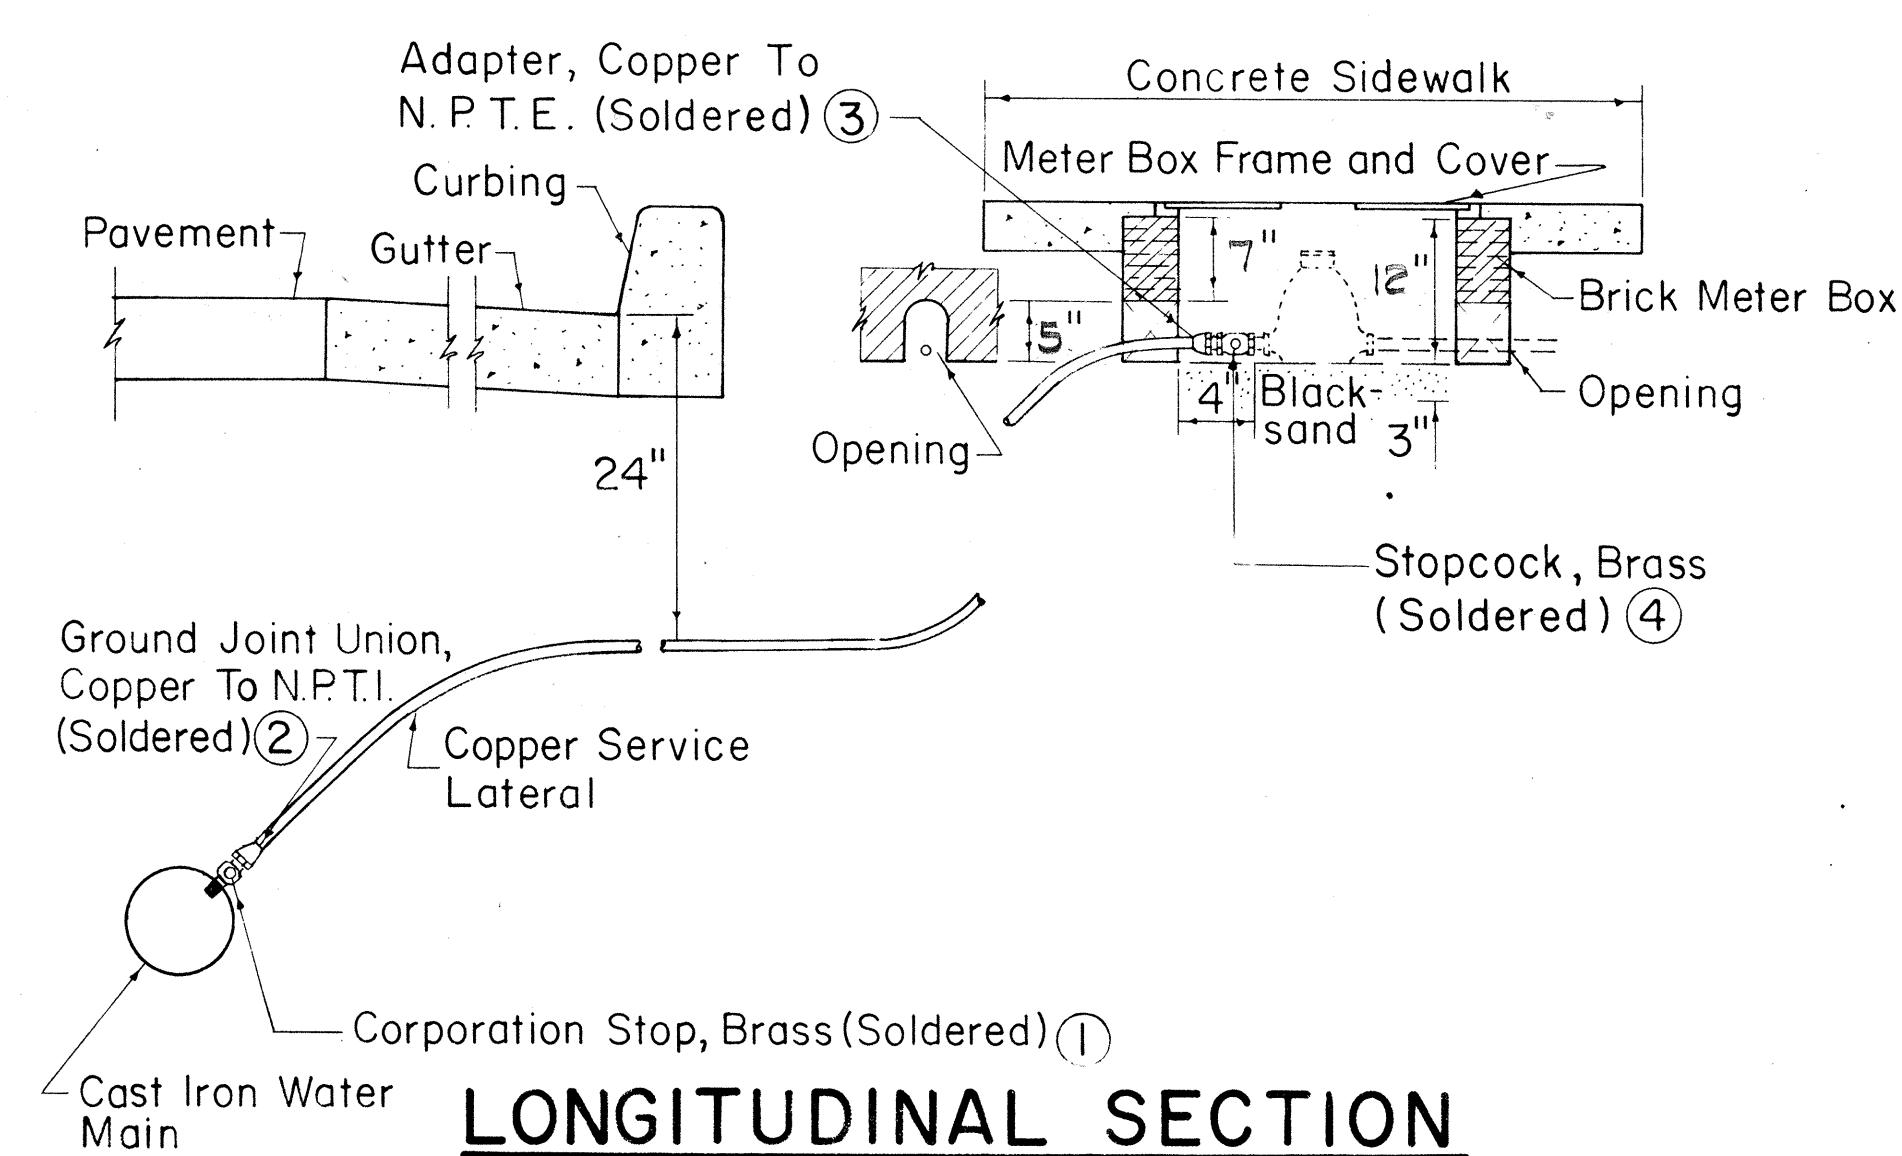

LONGITUDINAL SECTION


NOTE:
All castings shall be made accurately to the dimensions shown. Seat and cover shall be machined or ground where necessary to secure flat and true surfaces. The cover shall not rattle in any position.

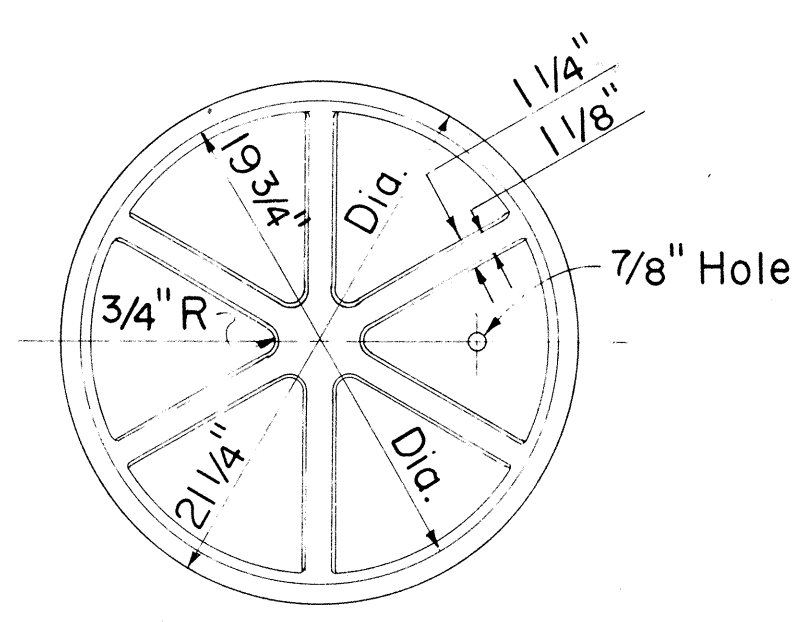


BOTTOM VIEW OF COVER

MANHOLE FRAME & COVER CAST IRON, 20" SIZE


SCALE: 1-1/2" = 1'-0"

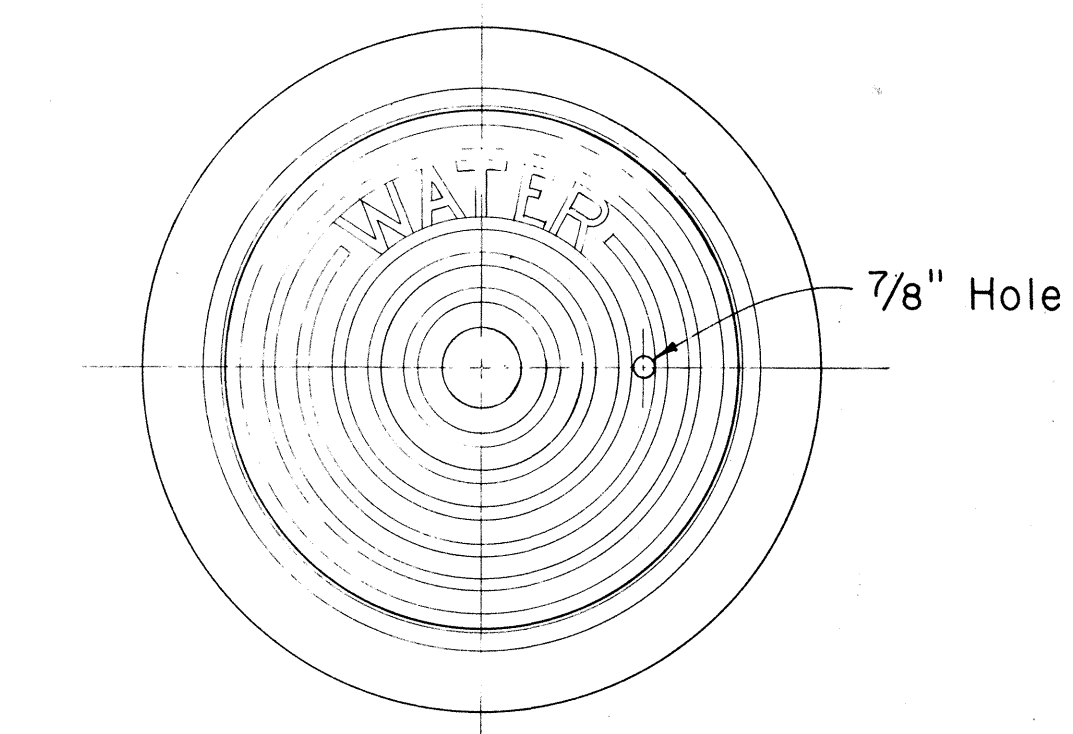

PLAN OF FRAME AND COVER

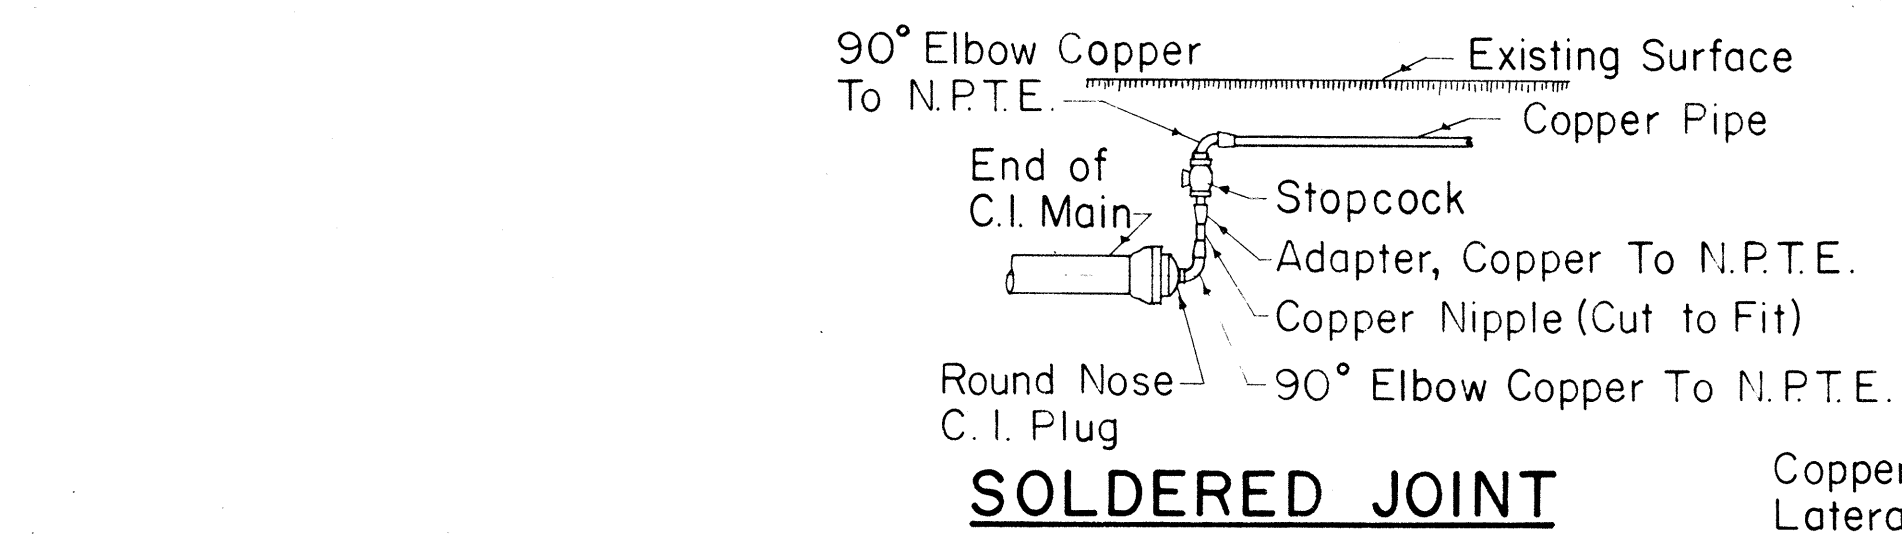


SOLDERED JOINT

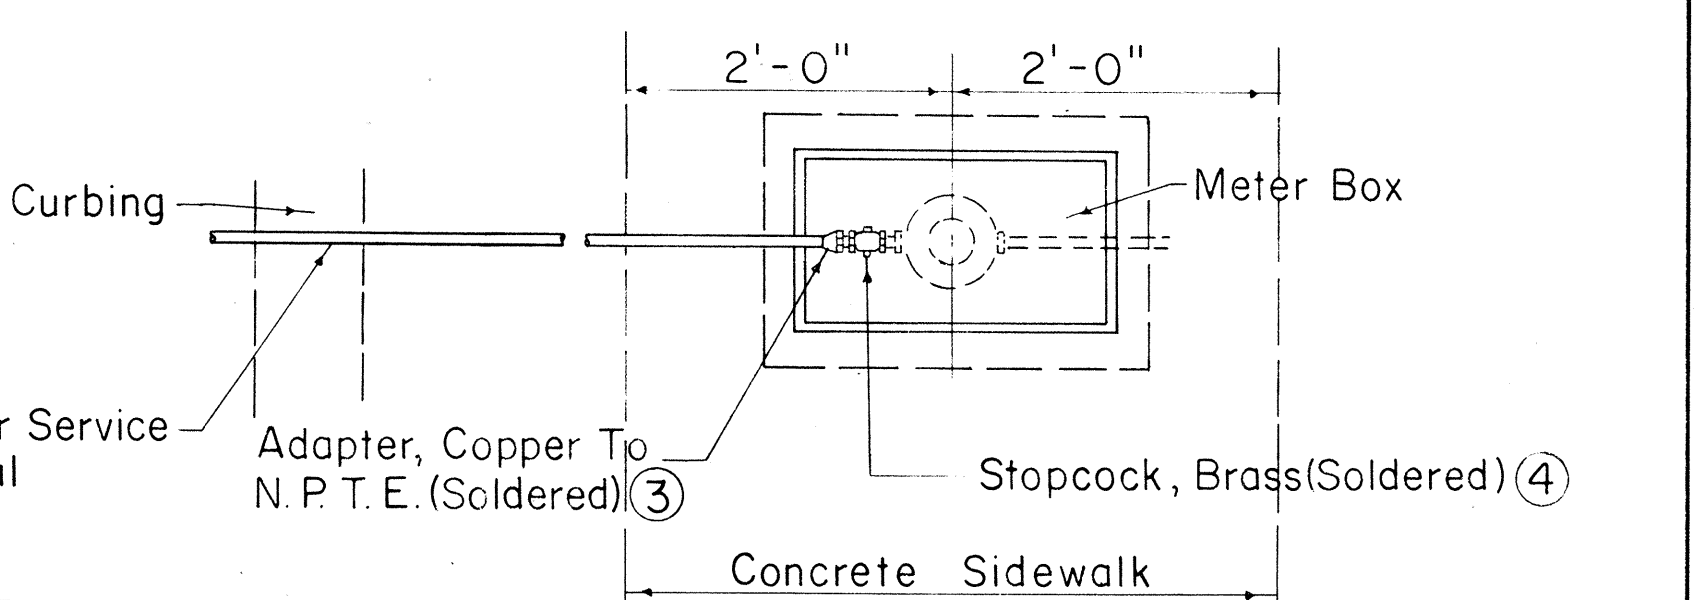


SINGLE SERVICE CONNECTION

SERVICE LATERAL CONNECTION AT END OF LINE

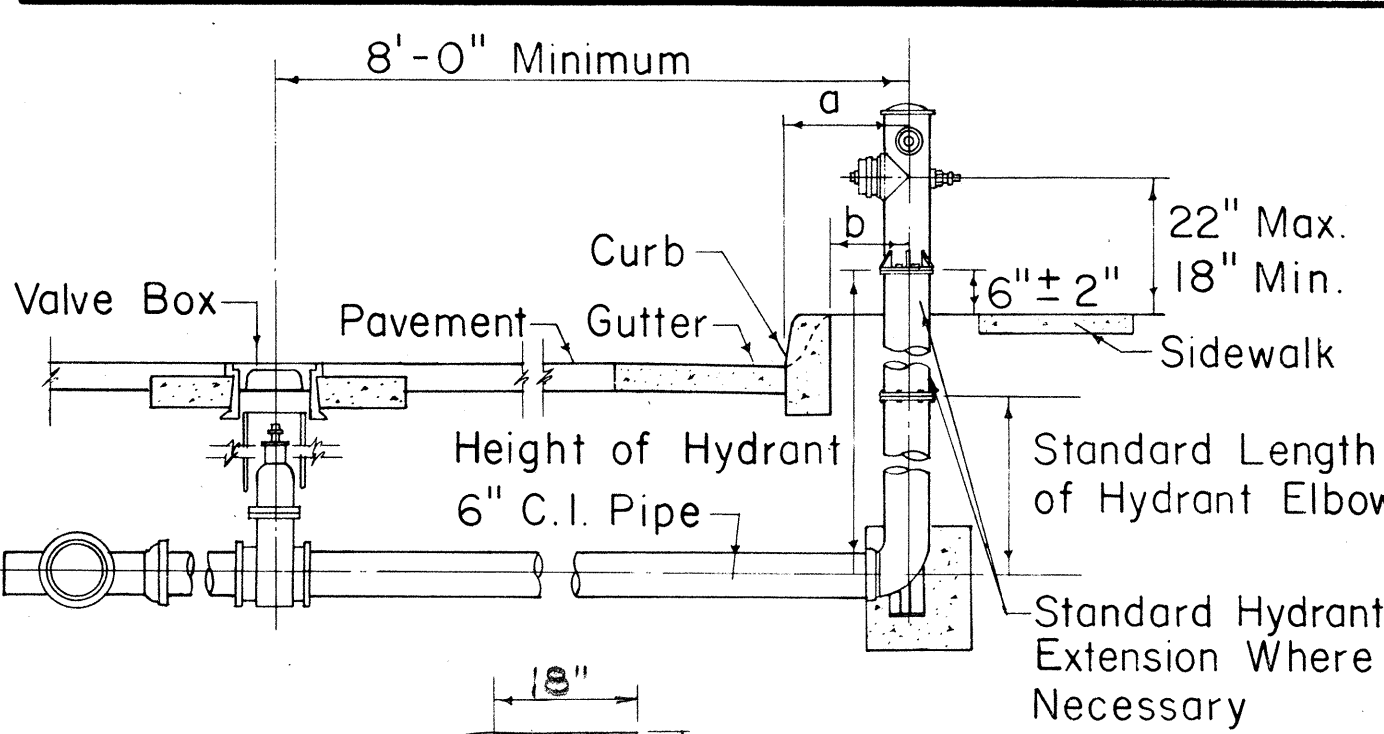


a	20" Min. (Standard Curb)
b	20" Min. (Roll Curb)

NOTE:
Gaskets for flanged joints shall be 1/16 inch duck-inserted rubber packing Garlock No. 19. Bolts shall be 5/8 inch diameter x 2 3/4 inch long steel machine bolts with cut threads, American Standard heavy hexagon heads, galvanized. Nuts shall be American Standard heavy cold punched hexagon nuts, galvanized.

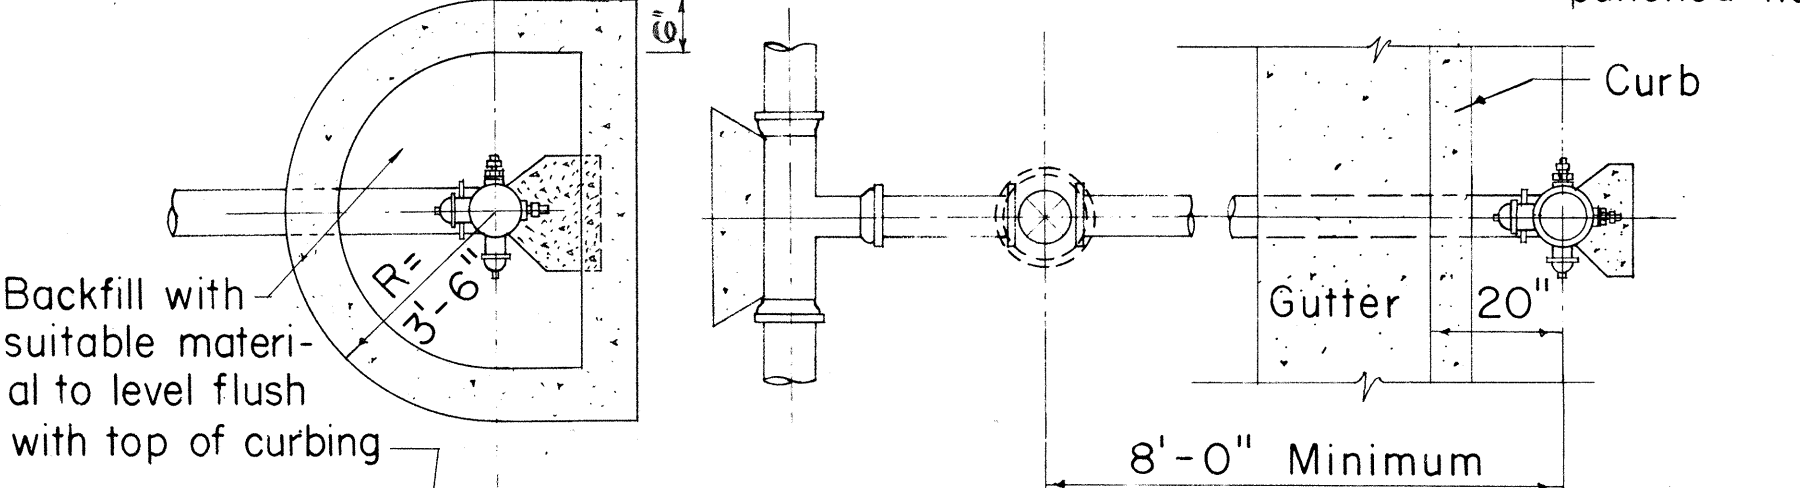

DETAIL OF CURBING
AT HYDRANT
WHERE REQUIRED

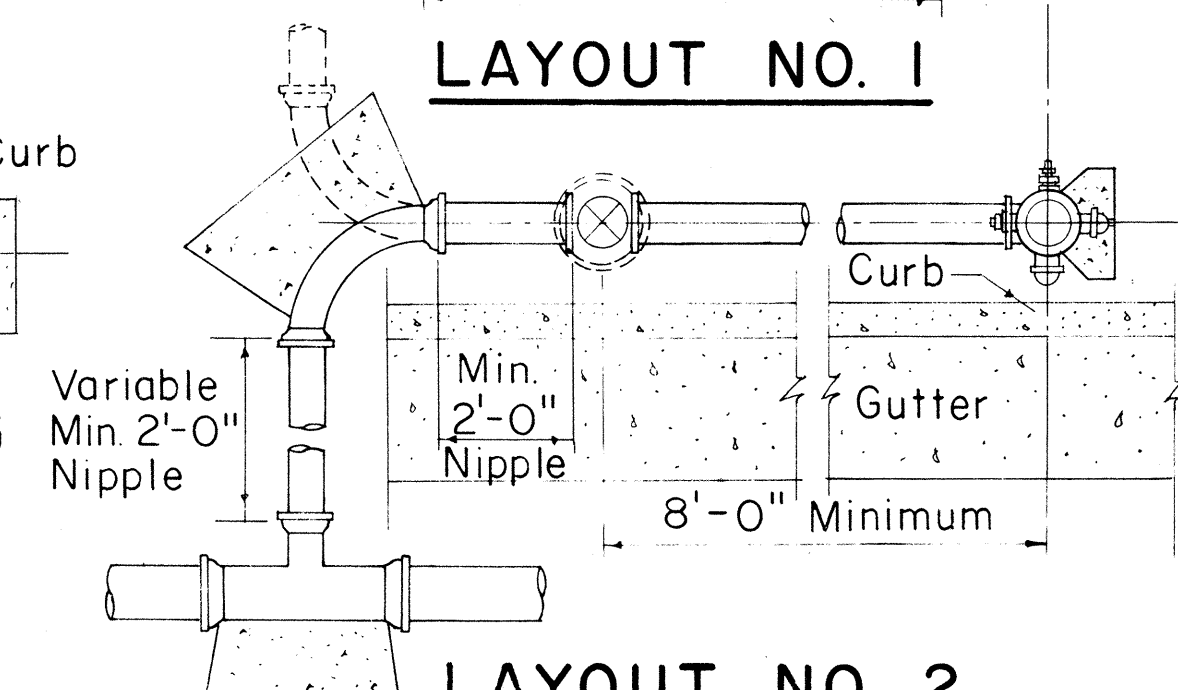

LAYOUT NO. 2

STANDARD FIRE HYDRANT LAYOUT


TYPE "A" METER BOX

TYPE "B" METER BOX

TYPE "X" METER BOX

STANDARD LENGTHS FOR HYDRANT ELBOWS
30"
36"
42"
48"

Standard Hydrant Extensions are available in the following Lengths:
6 to 30 inches long in increments of 6 inches

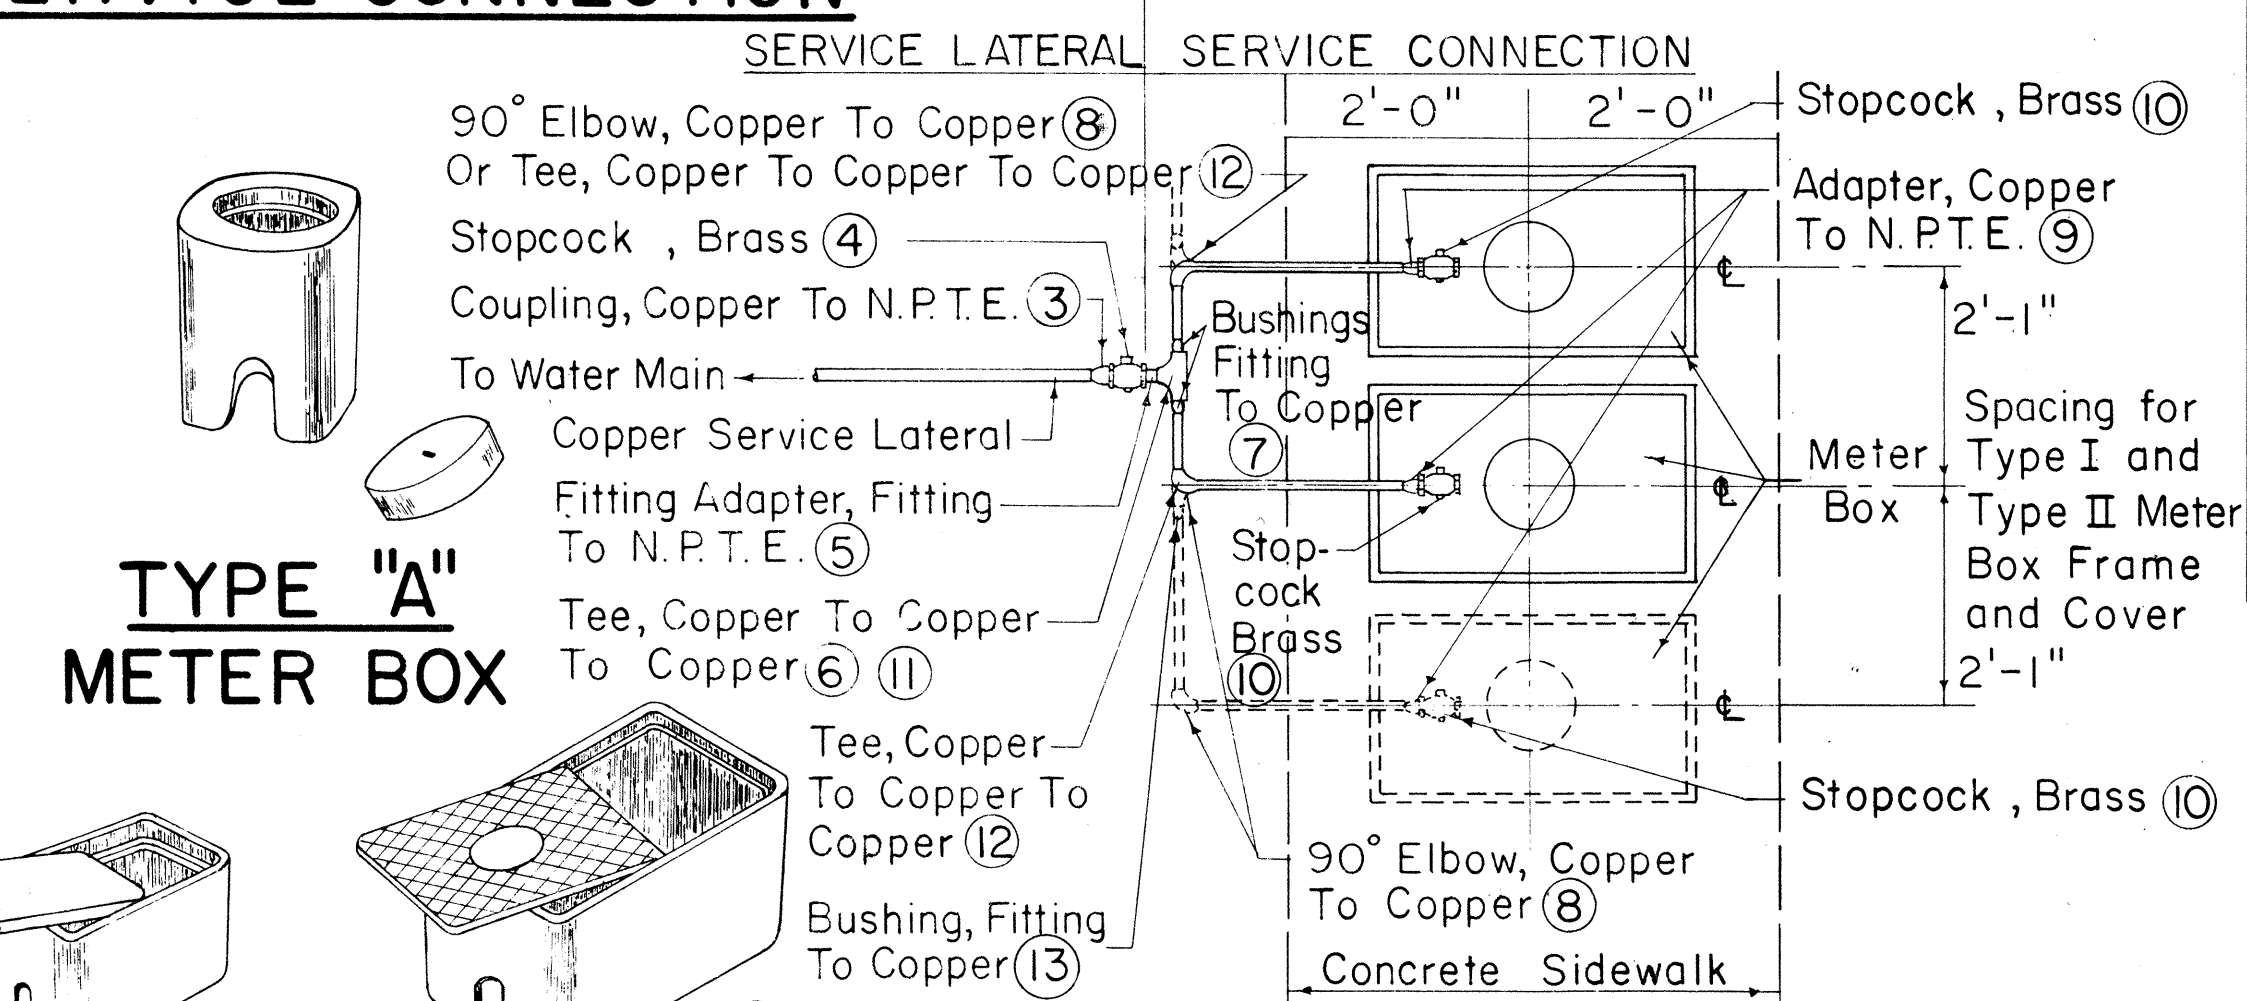

MULTIPLE SERVICE CONNECTION SOLDERED JOINTS

METER BOX DATA					
TYPE METER BOX	METER SIZES	OVERALL DIMENSIONS AT BOTTOM	OVERALL DIMENSIONS AT TOP	COMPLETE WEIGHT	OVERALL DIMENSIONS OF LID
A	5/8" or 3/4" Without Valve	7 1/4" x 7 1/4"	10" x 10"	45 lbs.	7 3/8" Dia.
B	5/8" or 3/4"	9 1/2" x 16"	12 1/4" x 18 3/8"	82 lbs.	8 3/4" x 14 1/2"
X		14 1/2" x 23 1/2"	16" x 25"	143 lbs.	13 1/8" x 22 1/8"

APPROVED:

A. H. Hama
CHIEF, ENGINEERING DIVISION
BOARD OF WATER SUPPLY
DATE 7/26/68

STATE OF HAWAII
DEPARTMENT OF TRANSPORTATION
HIGHWAYS DIVISION

BOARD OF WATER SUPPLY
CITY & COUNTY OF HONOLULU


STANDARD WATER DETAILS

Scale: As Noted


Date 8/14/68

FED. AID DIST. NO.	STATE	FED. AID PROJ. NO.	FISCAL YEAR	SHEET NO.	TOTAL SHEETS
HAWAII	HAWAII	I-H-1(103)11 I-H-1(110)11	1968	20	28


NOTE:
Contractor to furnish 1/2" brass plug (Tapered thread) to replace corporation stop upon completion of chlorination.

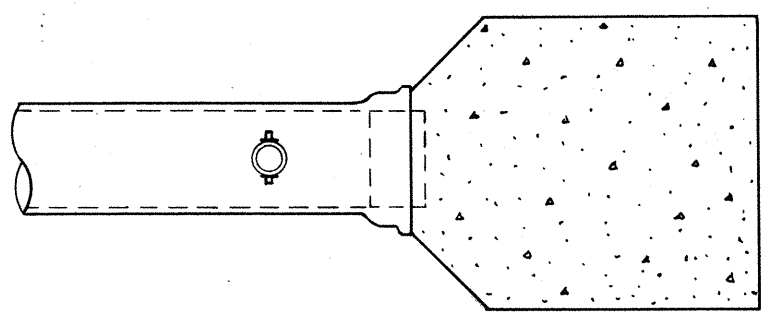

TOP VIEW

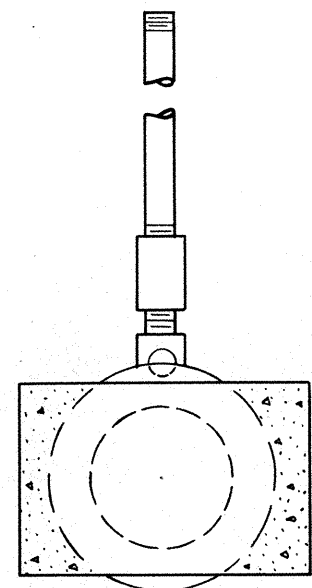


END VIEW

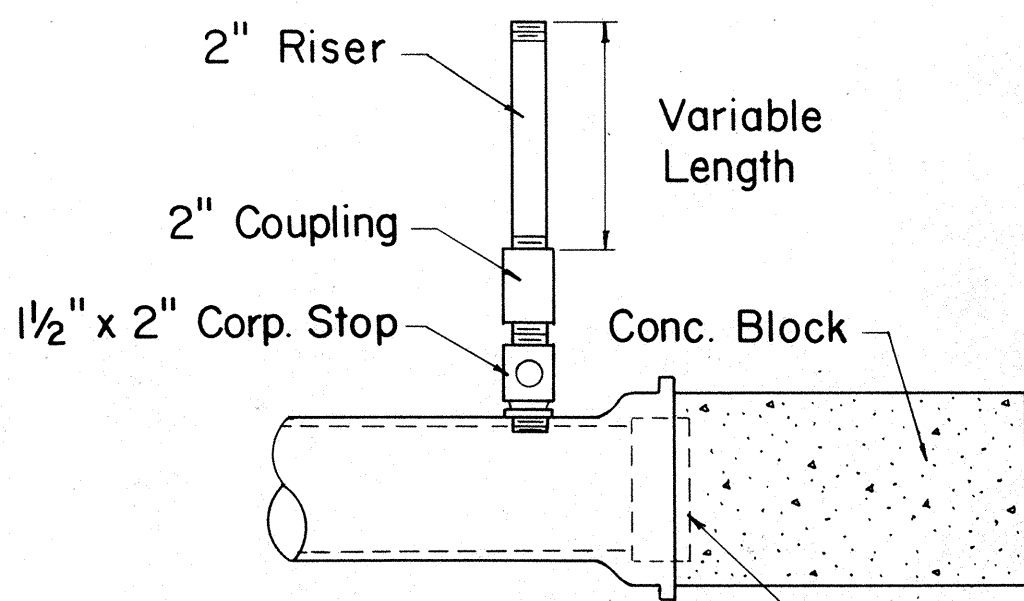


SIDE VIEW

DETAIL OF
TEMPORARY 2" CLEANOUT
Not to Scale

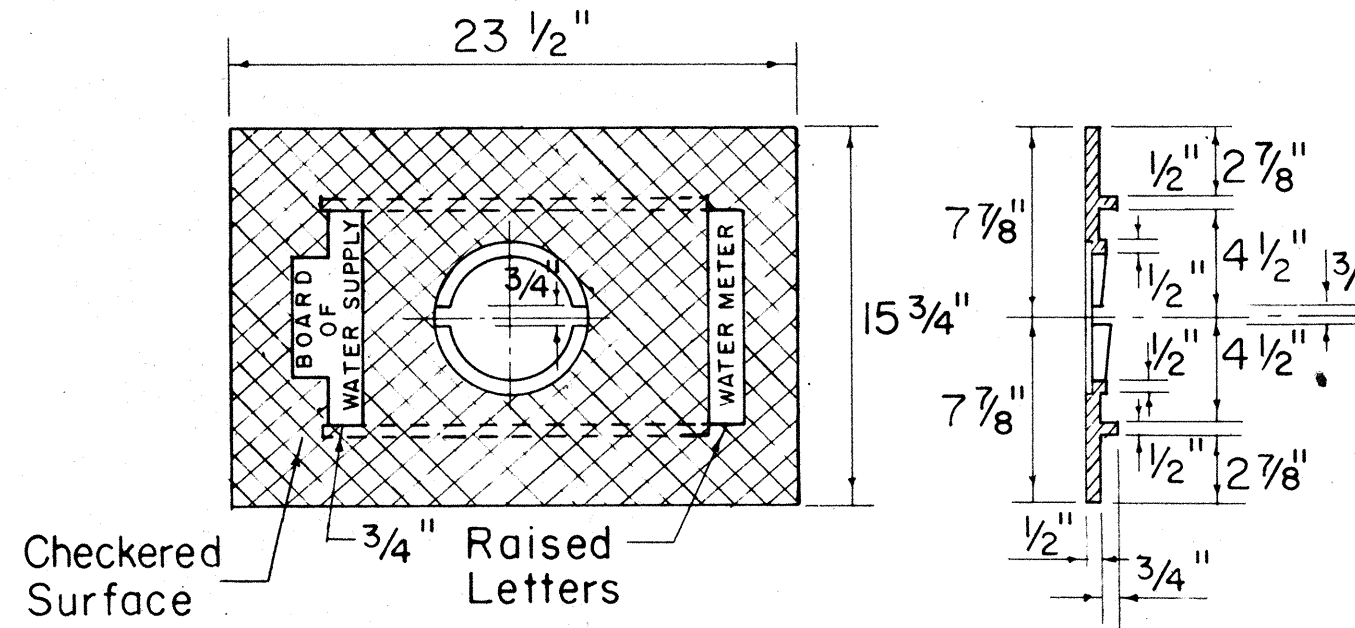


COVER PLATE

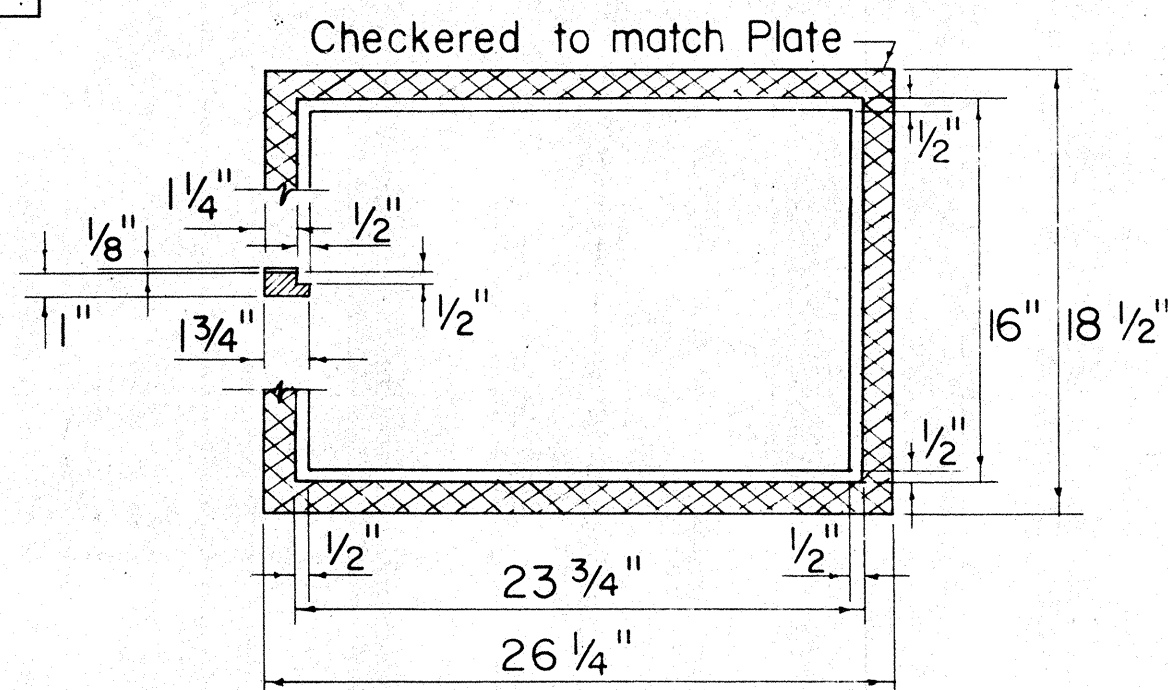

FRAME
CAST IRON FRAME AND PLATE
TYPE II



Scale: 1 1/2" = 1'-0"

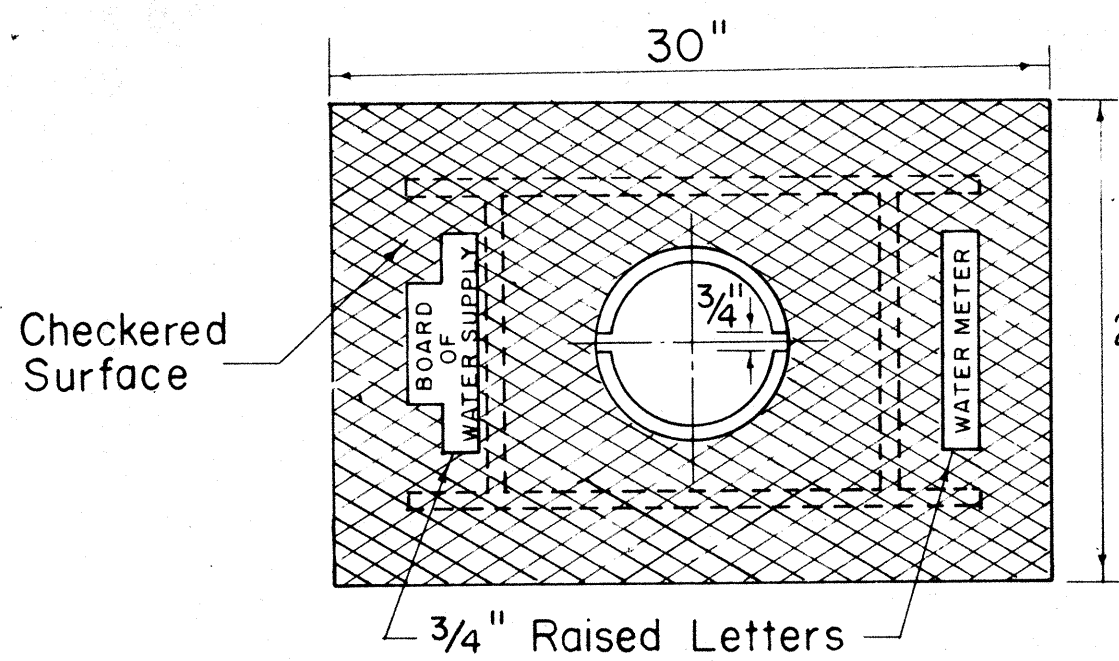


COVER PLATE

CAST IRON FRAME, PLATE AND COVER
TYPE III



Scale: 1 1/2" = 1'-0"

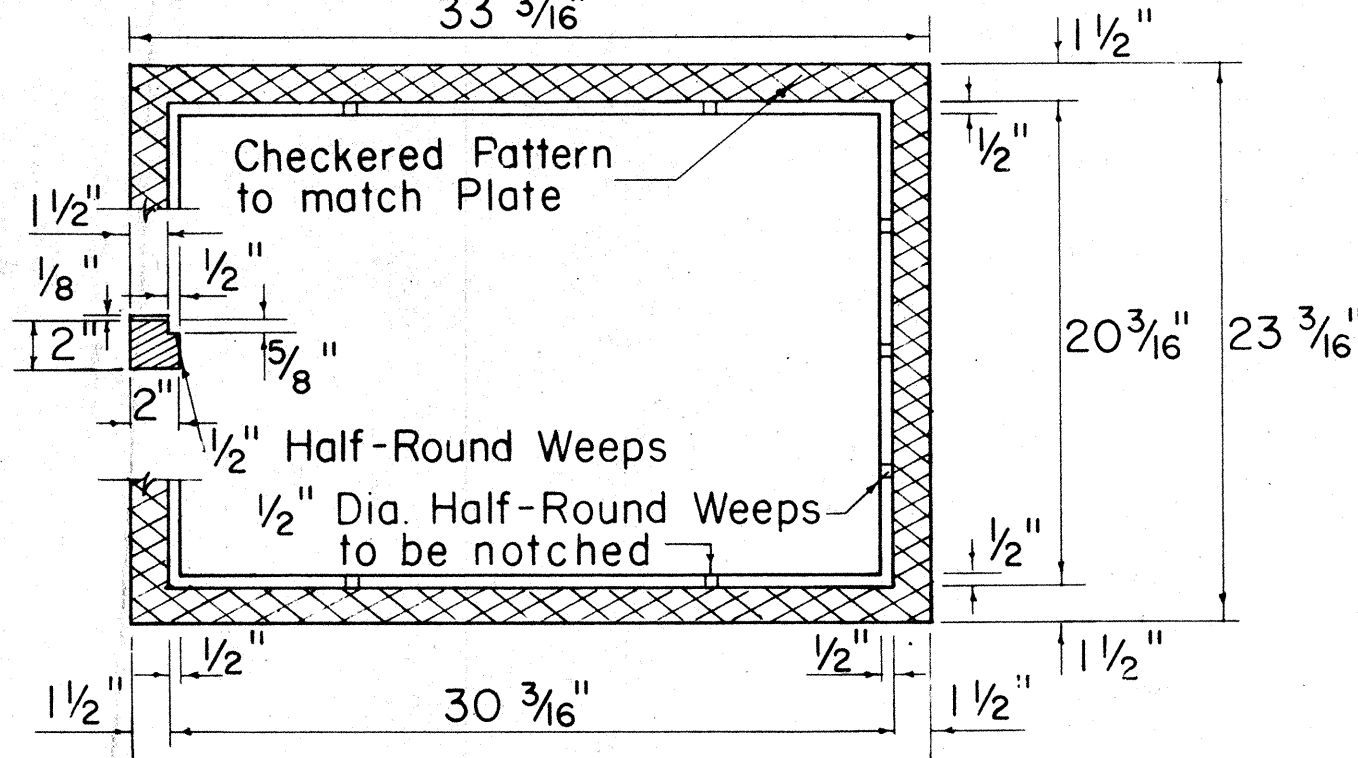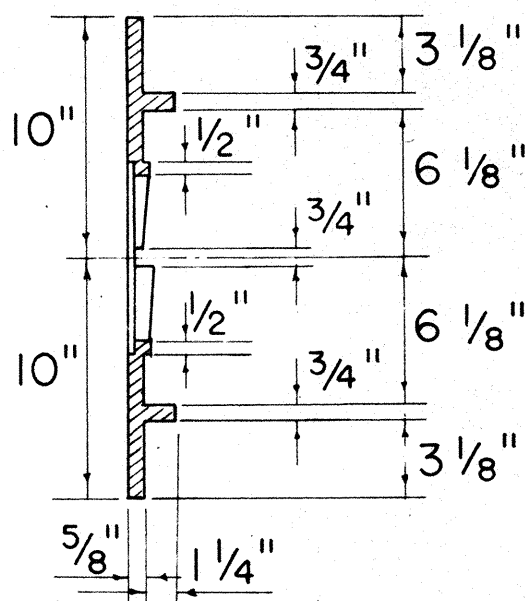

FRAME

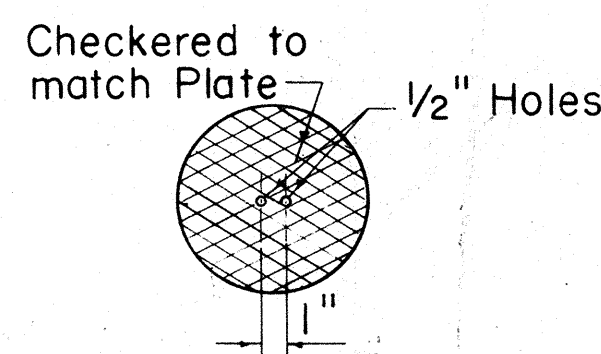


READING COVER

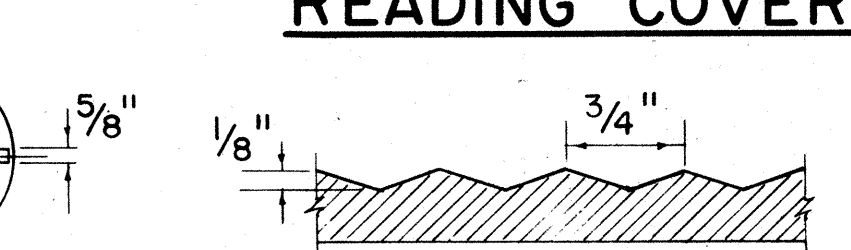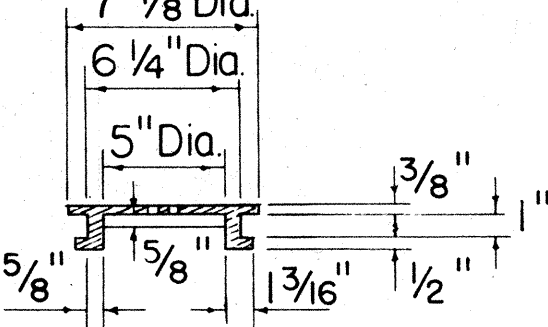


READING COVER

CHECKERED PATTERN
CAST IRON COVER FOR
TYPE II FRAME
Not to Scale

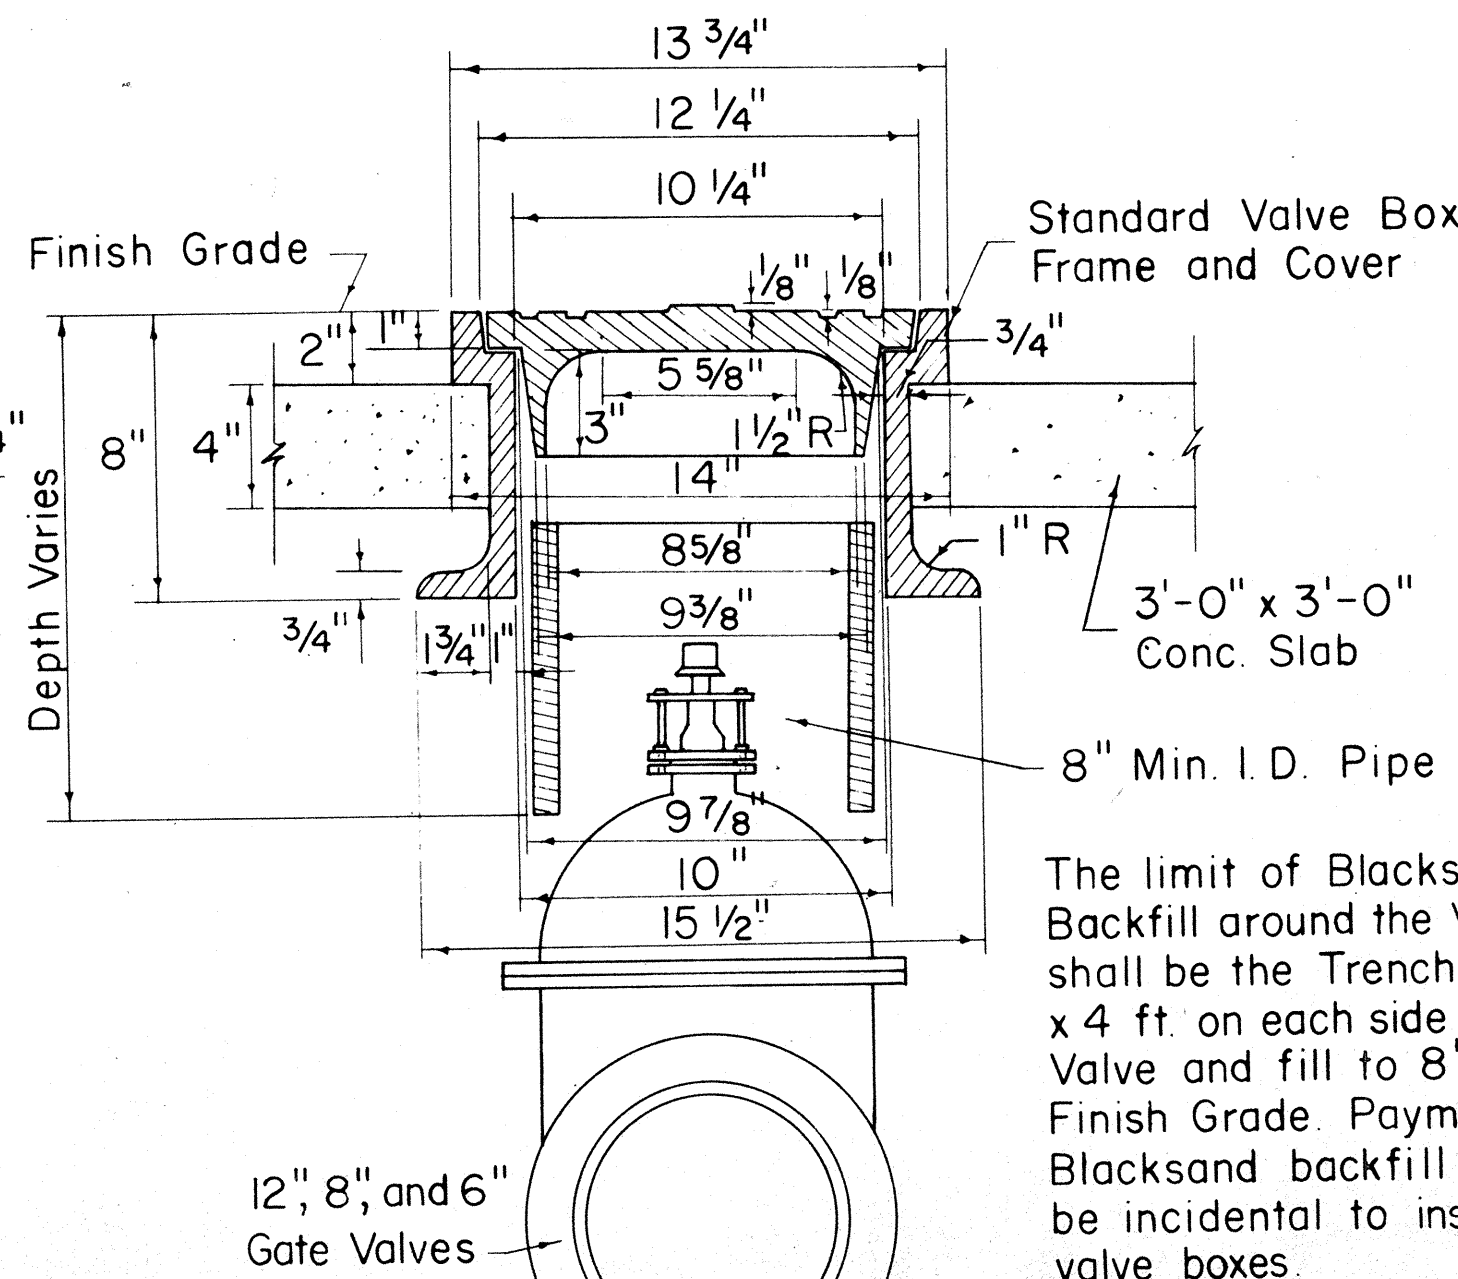



NOTE:
For Bevel Geared Gate Valves, See B.W.S. Standard (Detail Sheet filed in B.W.S. Engr. Division)

INSTALLATION OF VALVE
BOX FOR GATE VALVES
Not to Scale

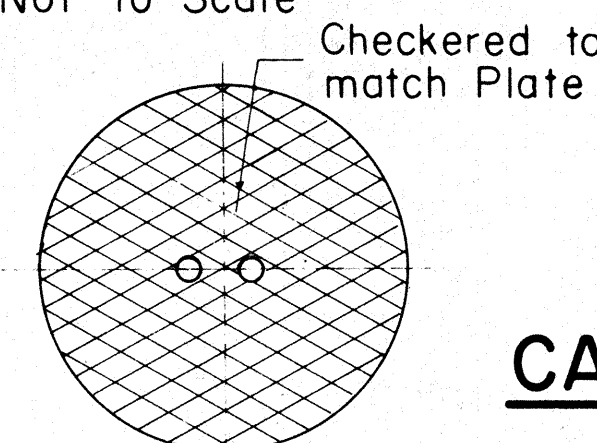


CAST IRON FRAME AND COVER

Scale: 3" = 1'-0"

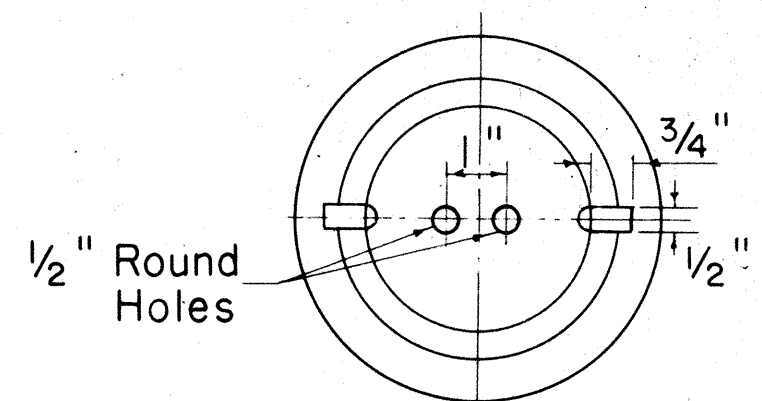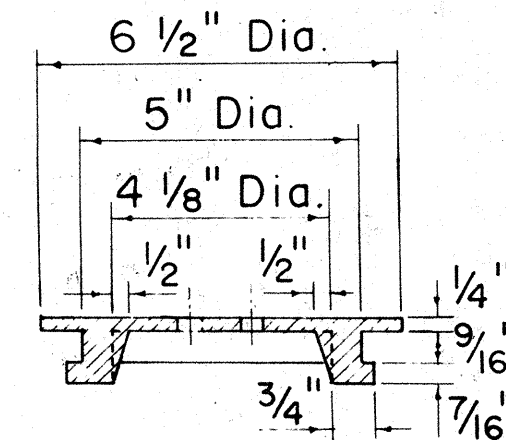


READING COVER

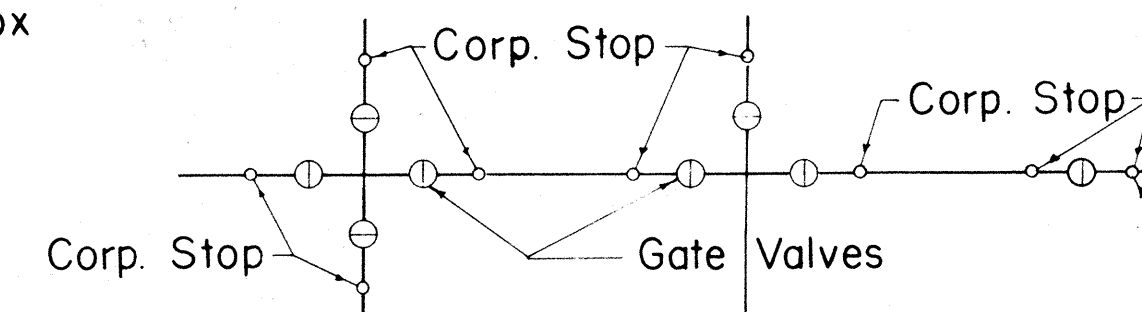

CORP. STOP LAYOUT


Not to Scale

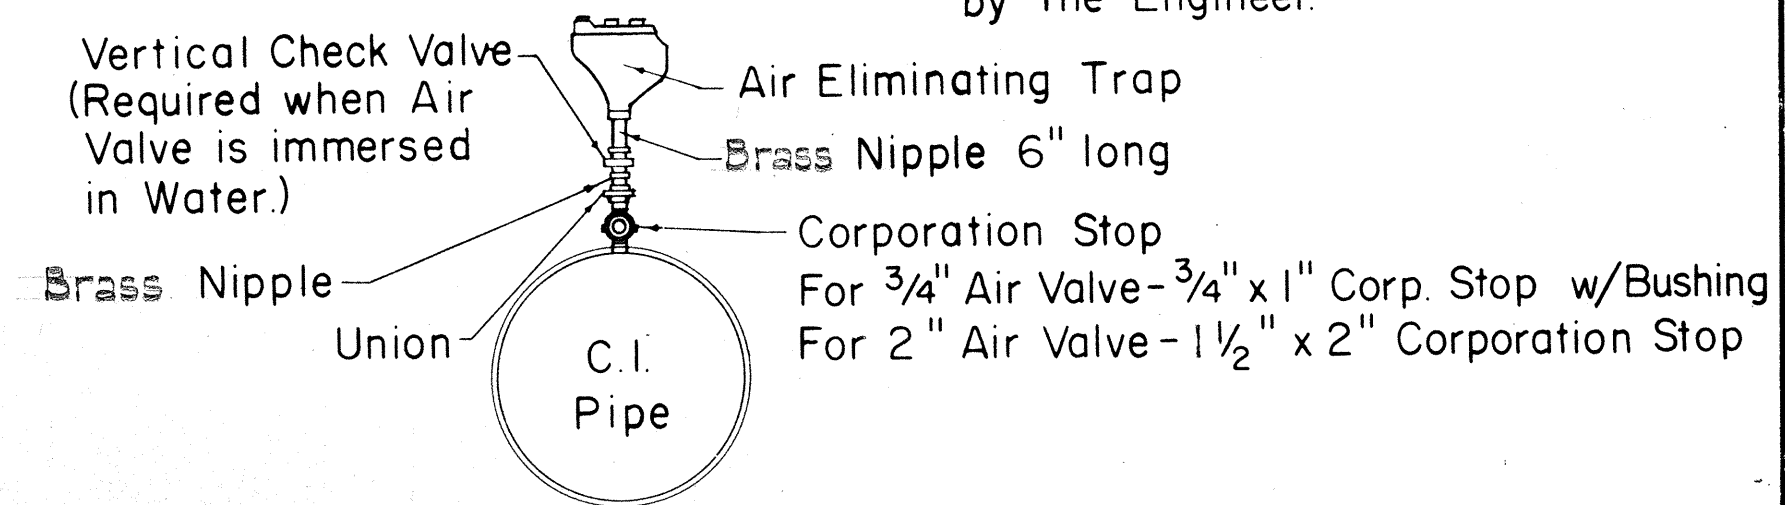


DETAIL OF CONNECTION FOR
AIR ELIMINATING TRAP
Not to Scale

Offset word "WATER" 1 3/4" high, 1/8" deep

NOTE:
All castings shall be made accurately to the dimensions shown. Seat and Cover shall be ground where necessary to secure flat and true surfaces. The Cover shall not rattle in any position.
Minor changes in dimensions may be made to suit foundry conditions provided such changes are approved by the Board of Water Supply.

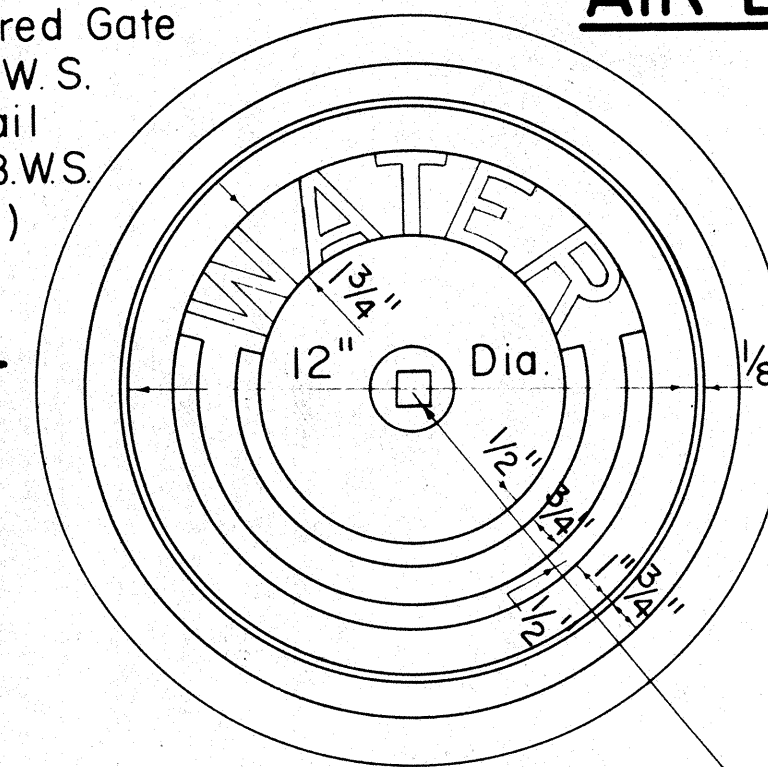

3/4" Sq. Hole with 1/2" wide ridge

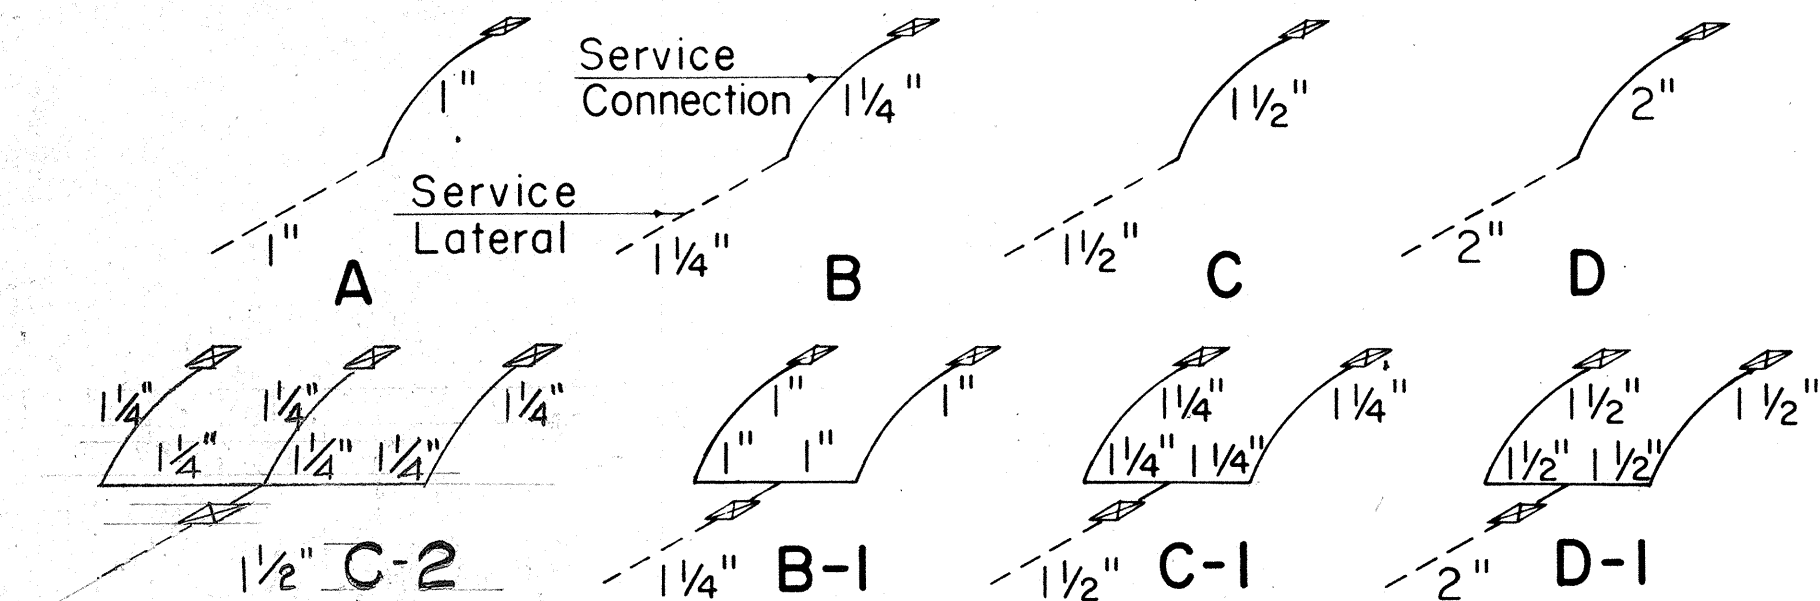

TYPICAL LAYOUT OF SERVICE
LATERALS AND CONNECTIONS
Not to Scale

APPROVED:

S. Kawakami 4/26/68
CHIEF, ENGINEERING DIVISION B.W.S. DATE

STATE OF HAWAII DEPARTMENT OF TRANSPORTATION HIGHWAYS DIVISION BOARD OF WATER SUPPLY CITY & COUNTY OF HONOLULU STANDARD WATER DETAILS Scale: As Noted Date 8/14/68 SHEET NO. 6 OF 17 SHEETS











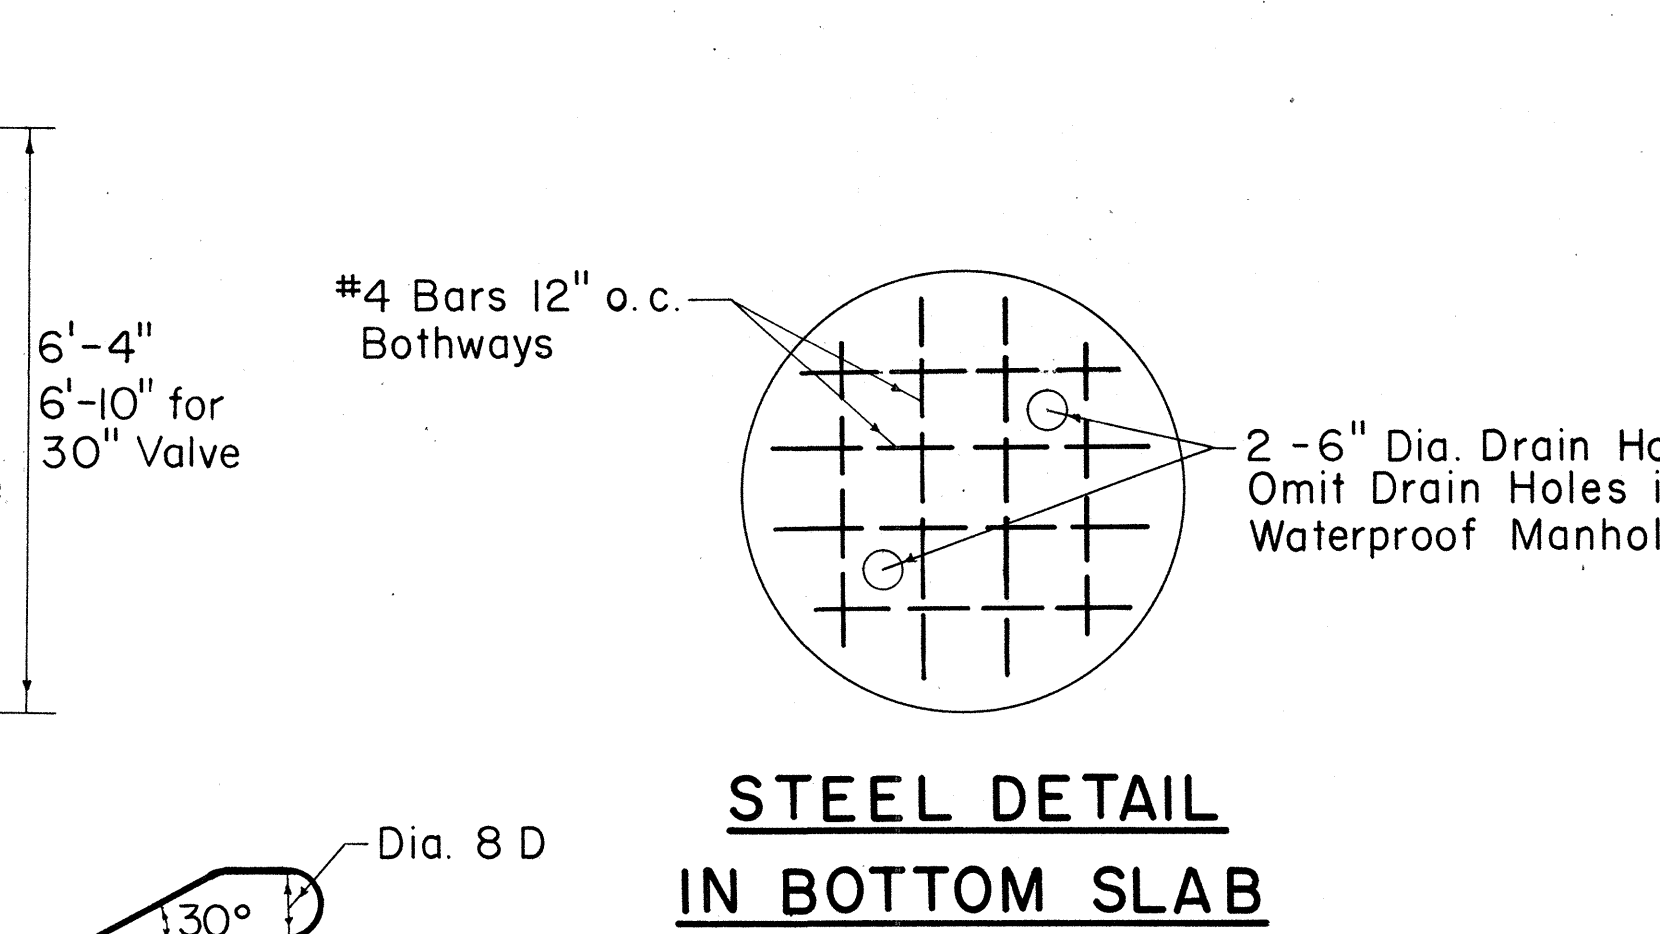



TABLE "A"
REQUIRED CORPORATION STOP SIZES
AT GATE VALVE

DIA. OF MAIN INCHES	SIZE OF CORP STOP
4	1" x 1/4"
6	1" x 1/4"
8	1" x 1/4"
12	1" x 1/4"
16	1" x 1/4"
20	1" x 1/4"
24	1 1/2" x 2"
36	1 1/2" x 2"
42	1 1/2" x 2"

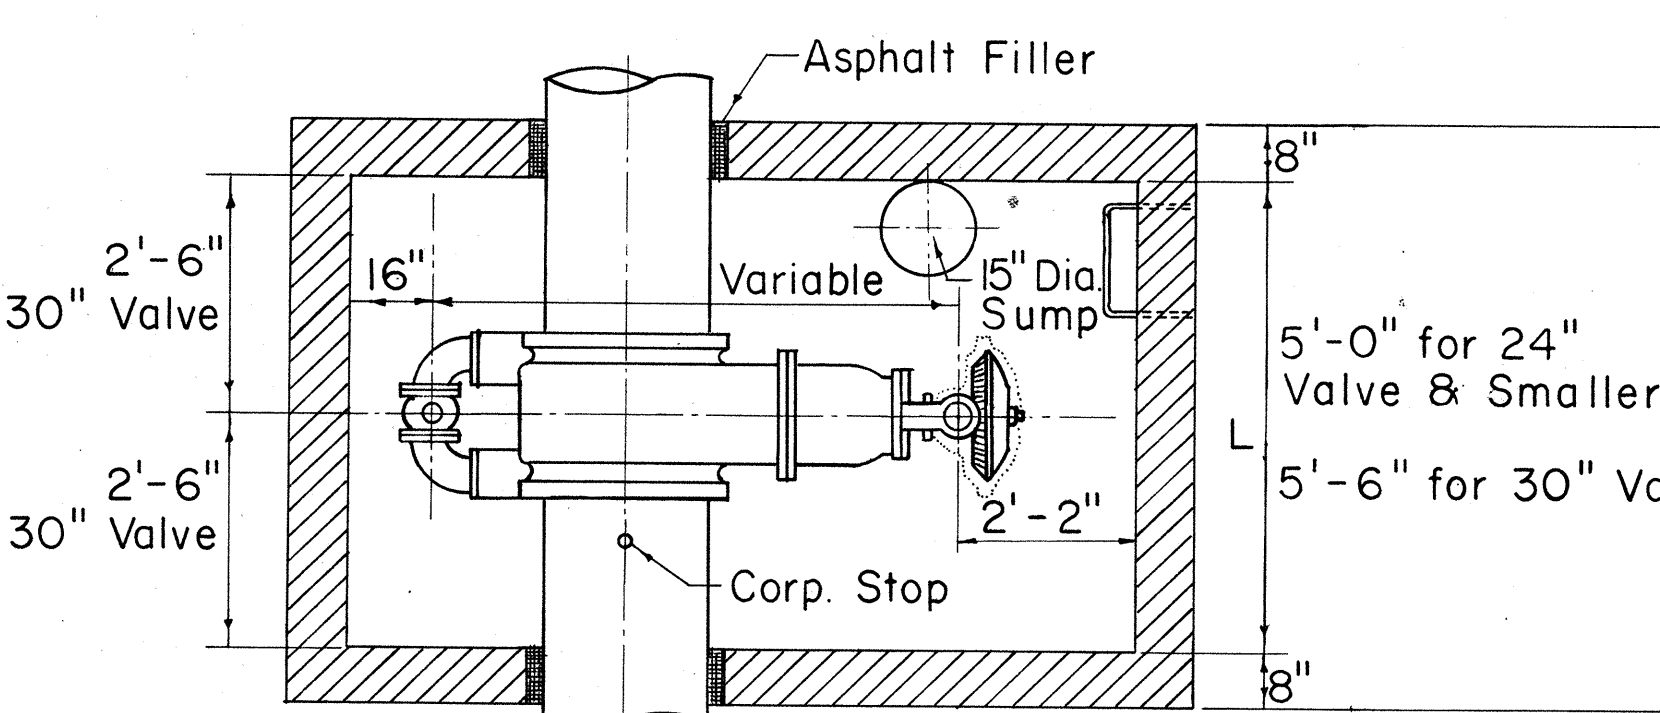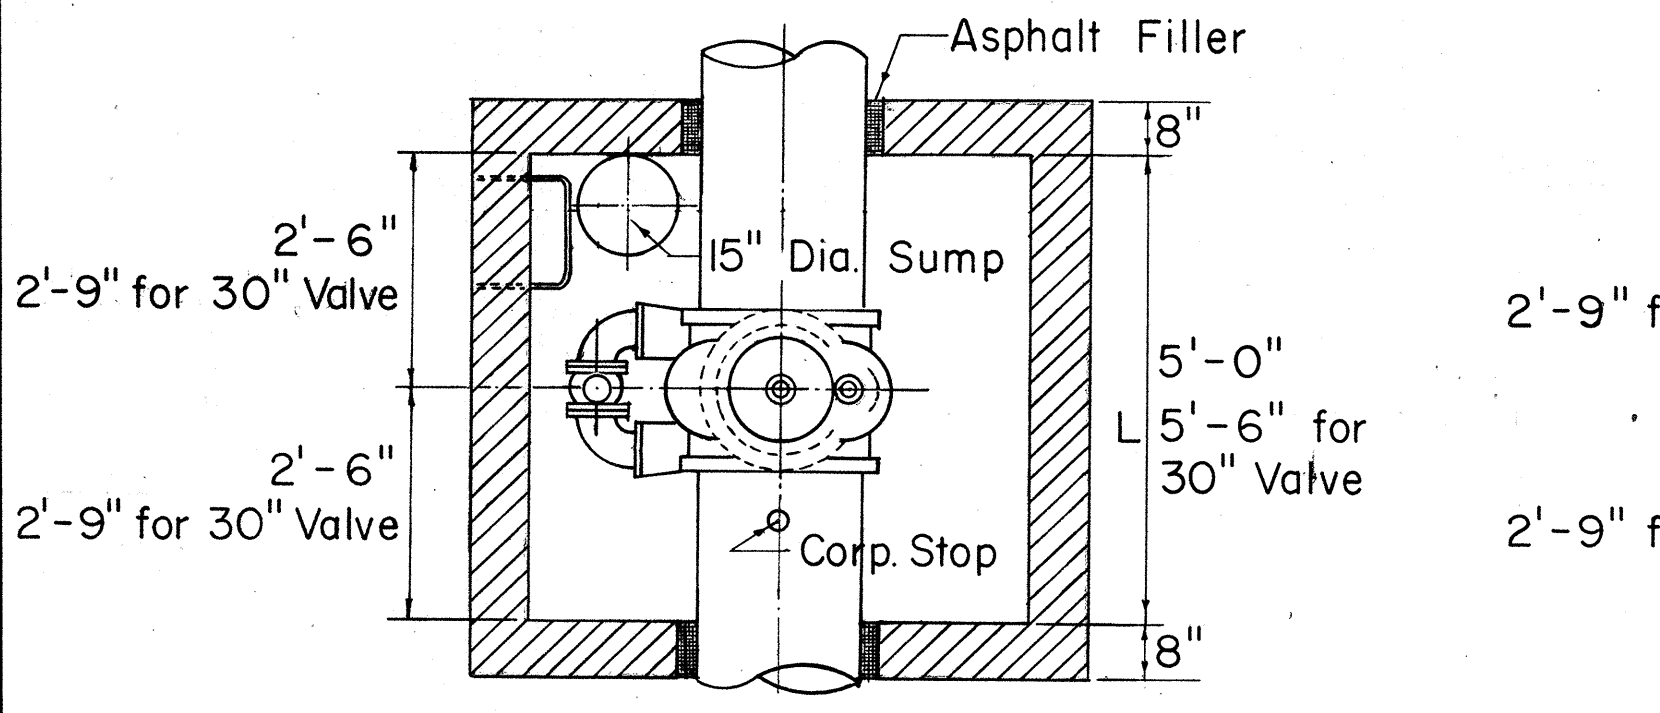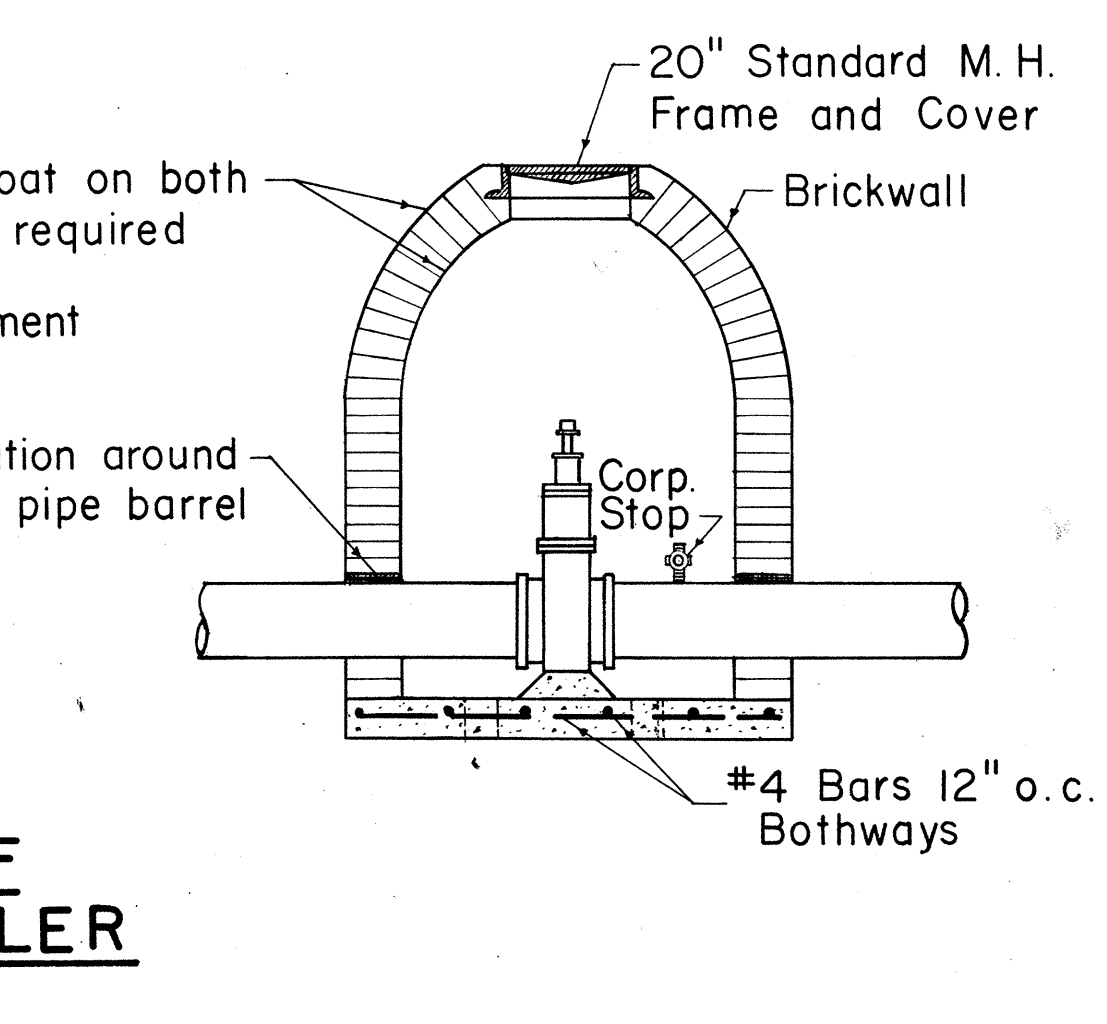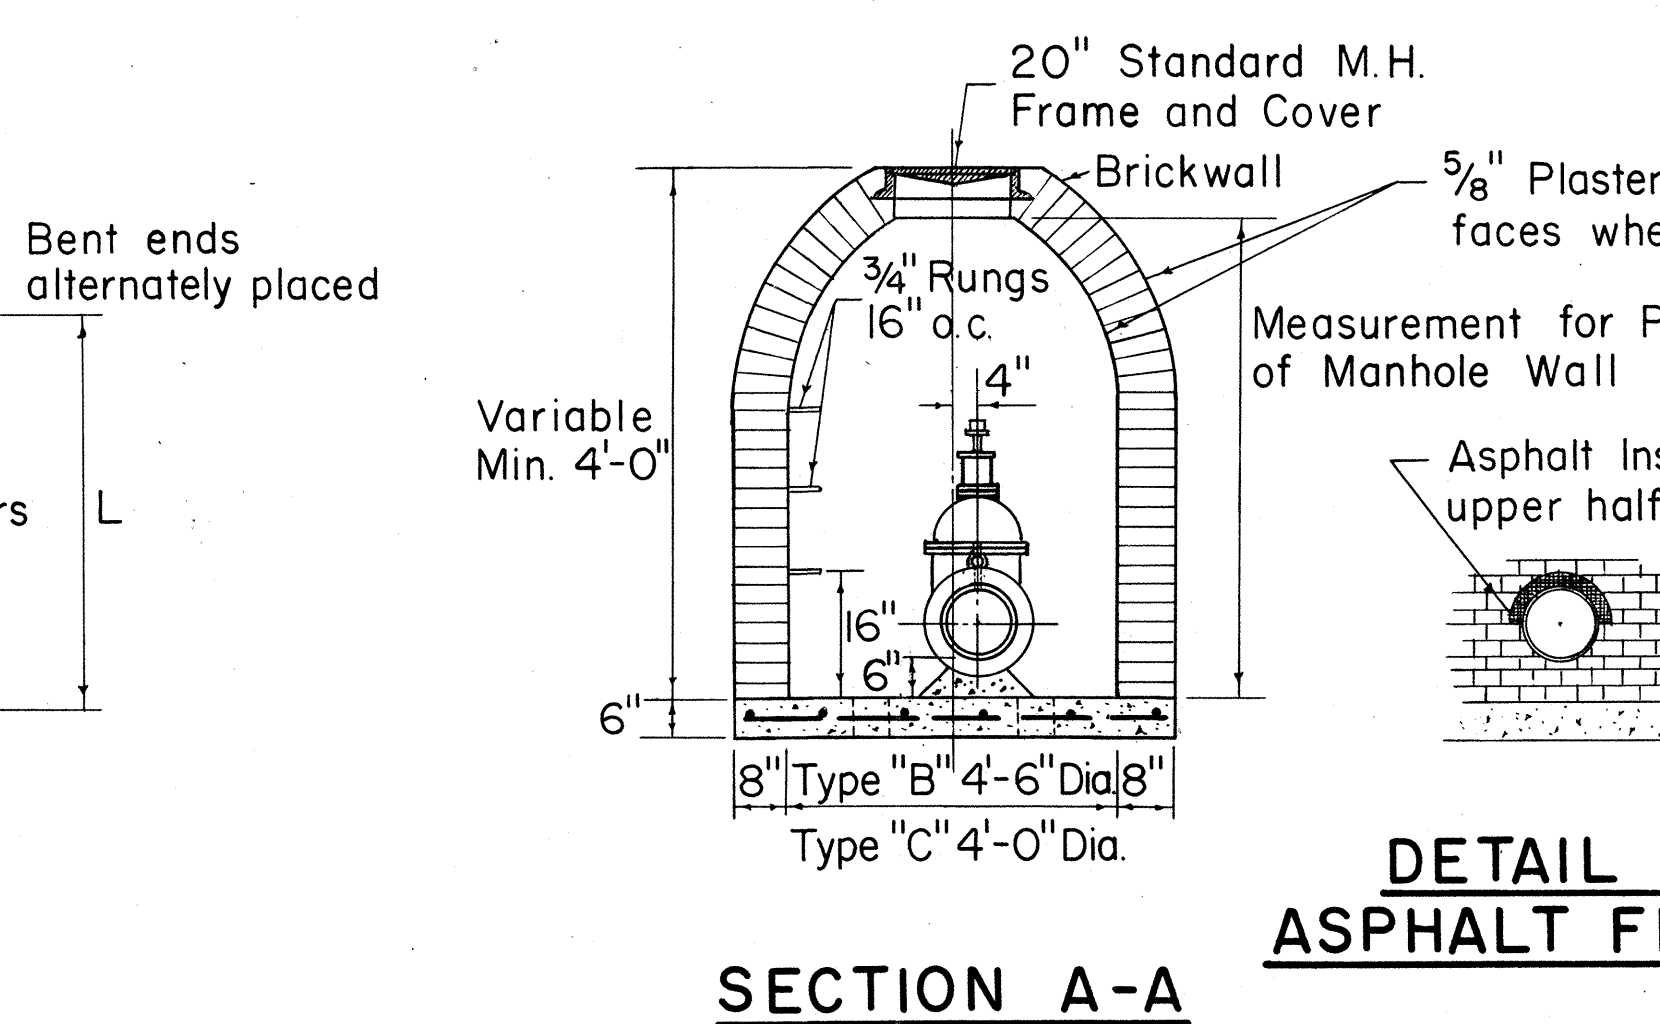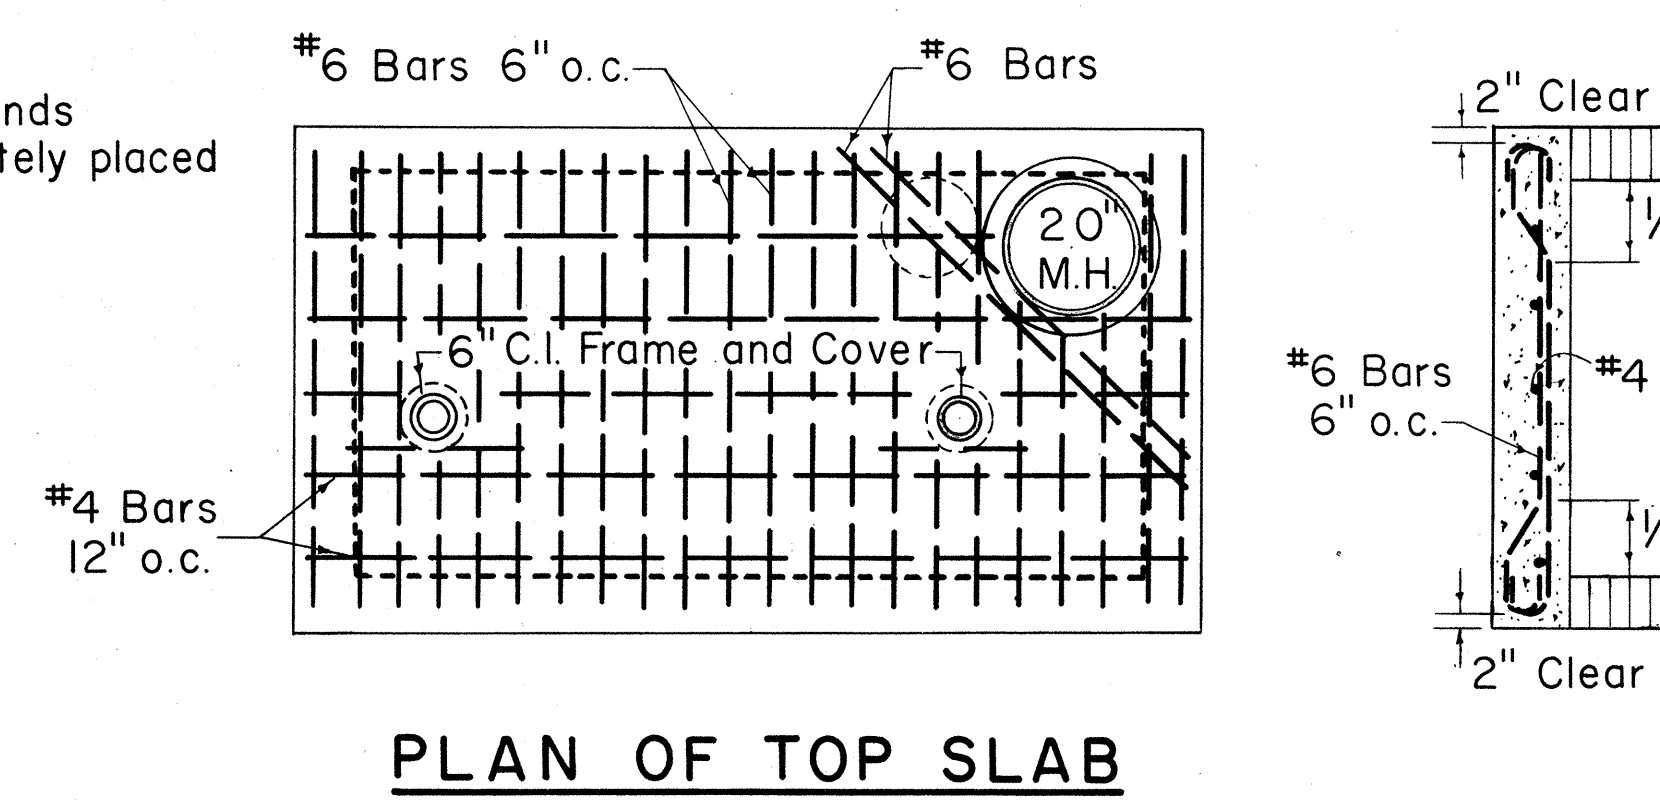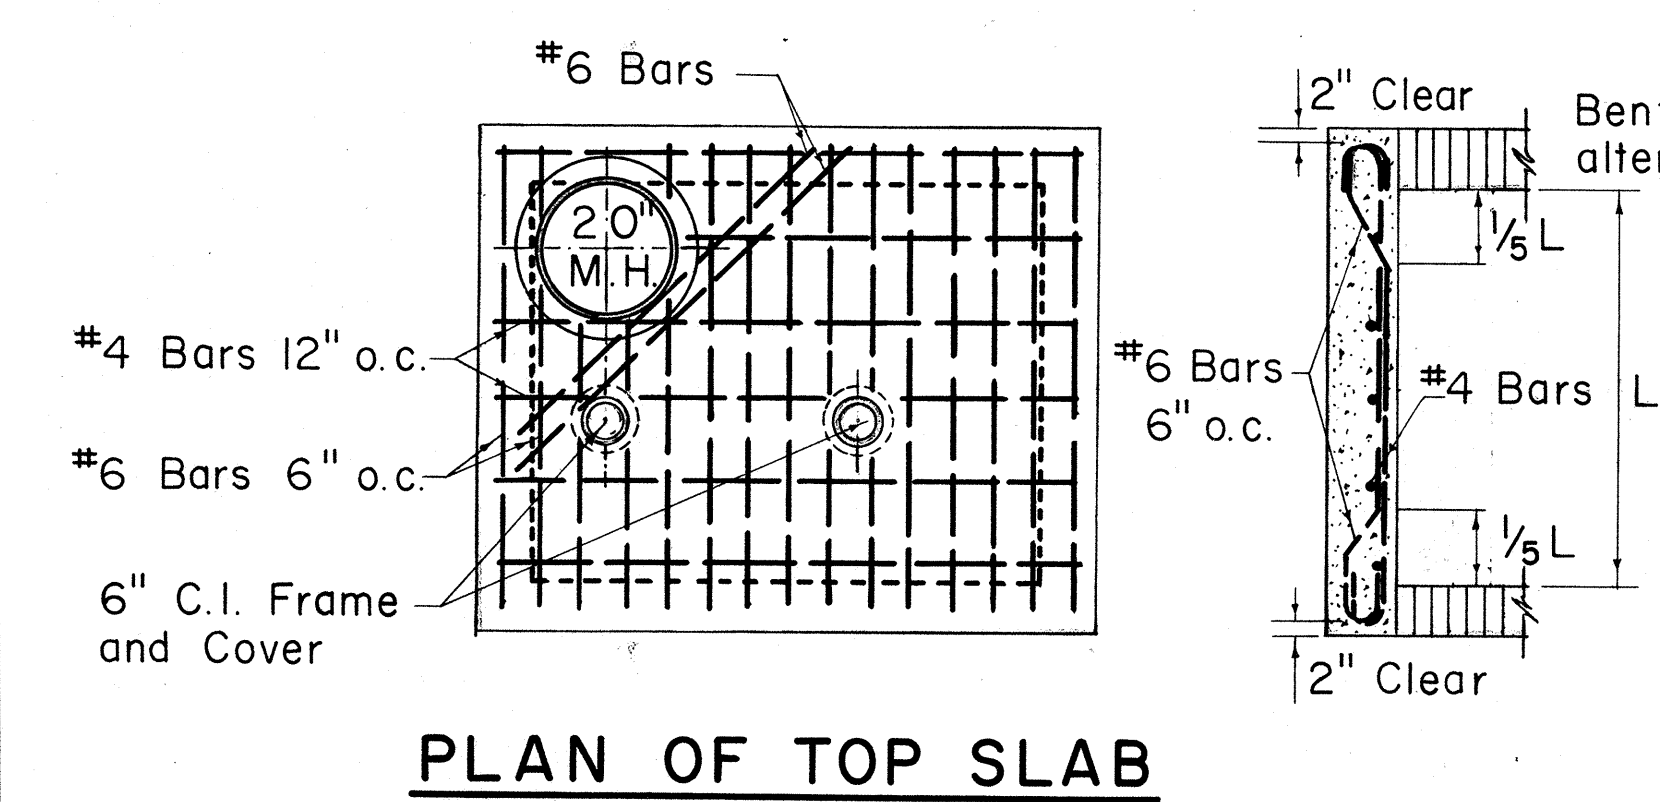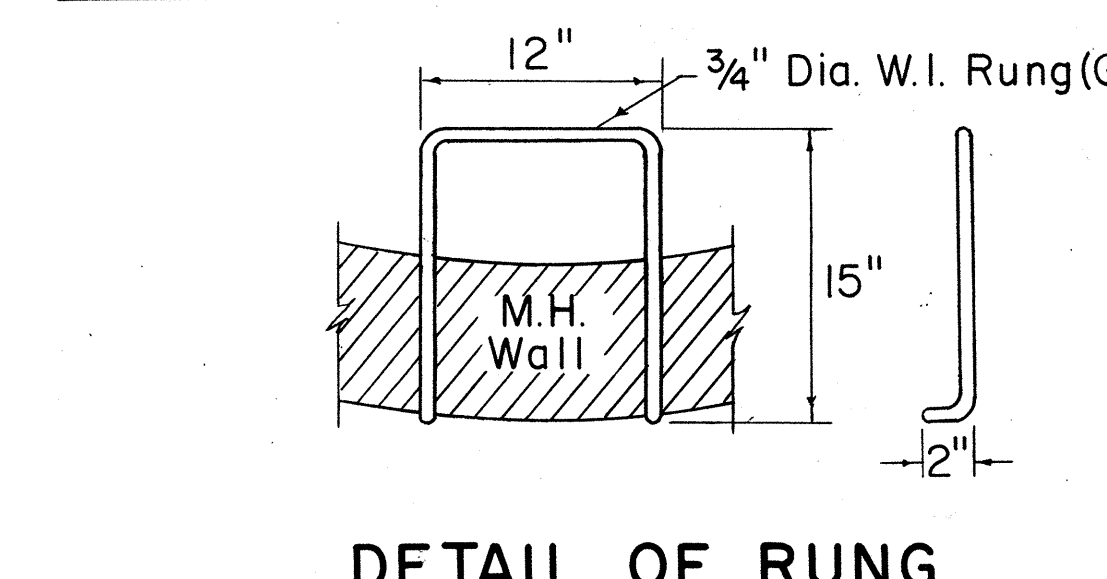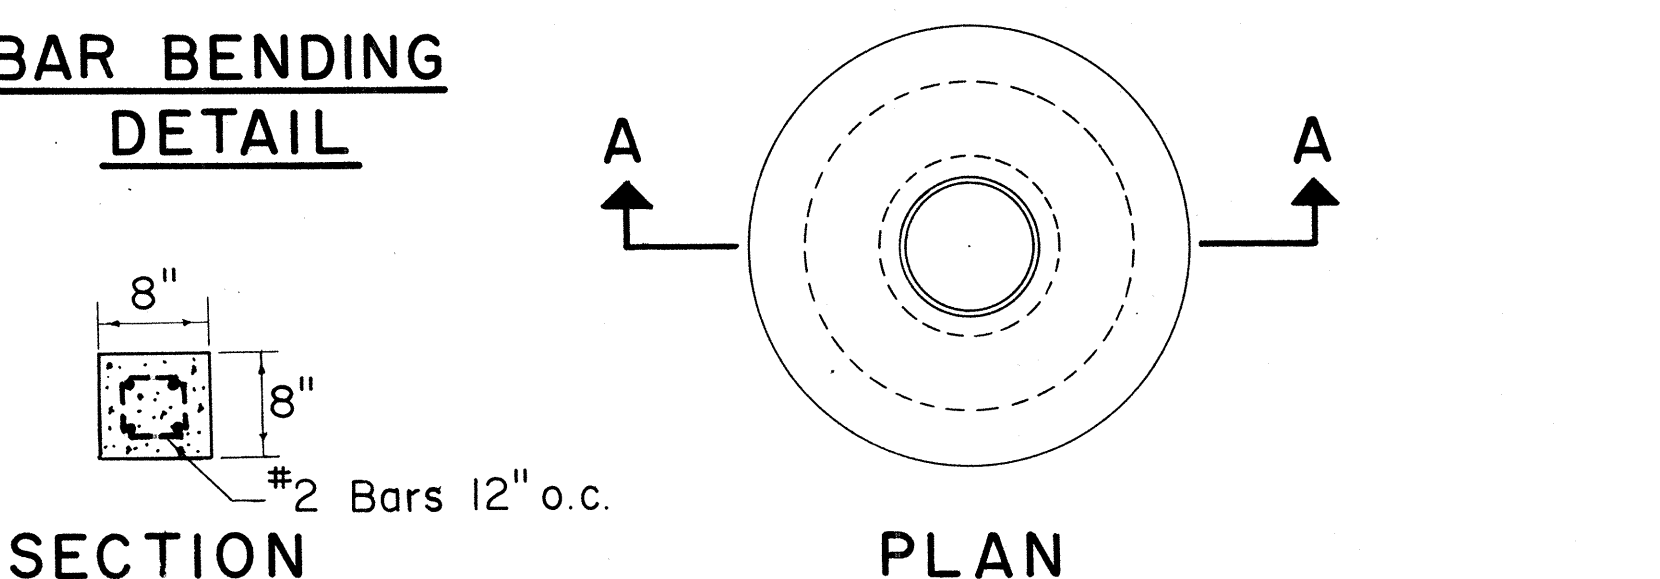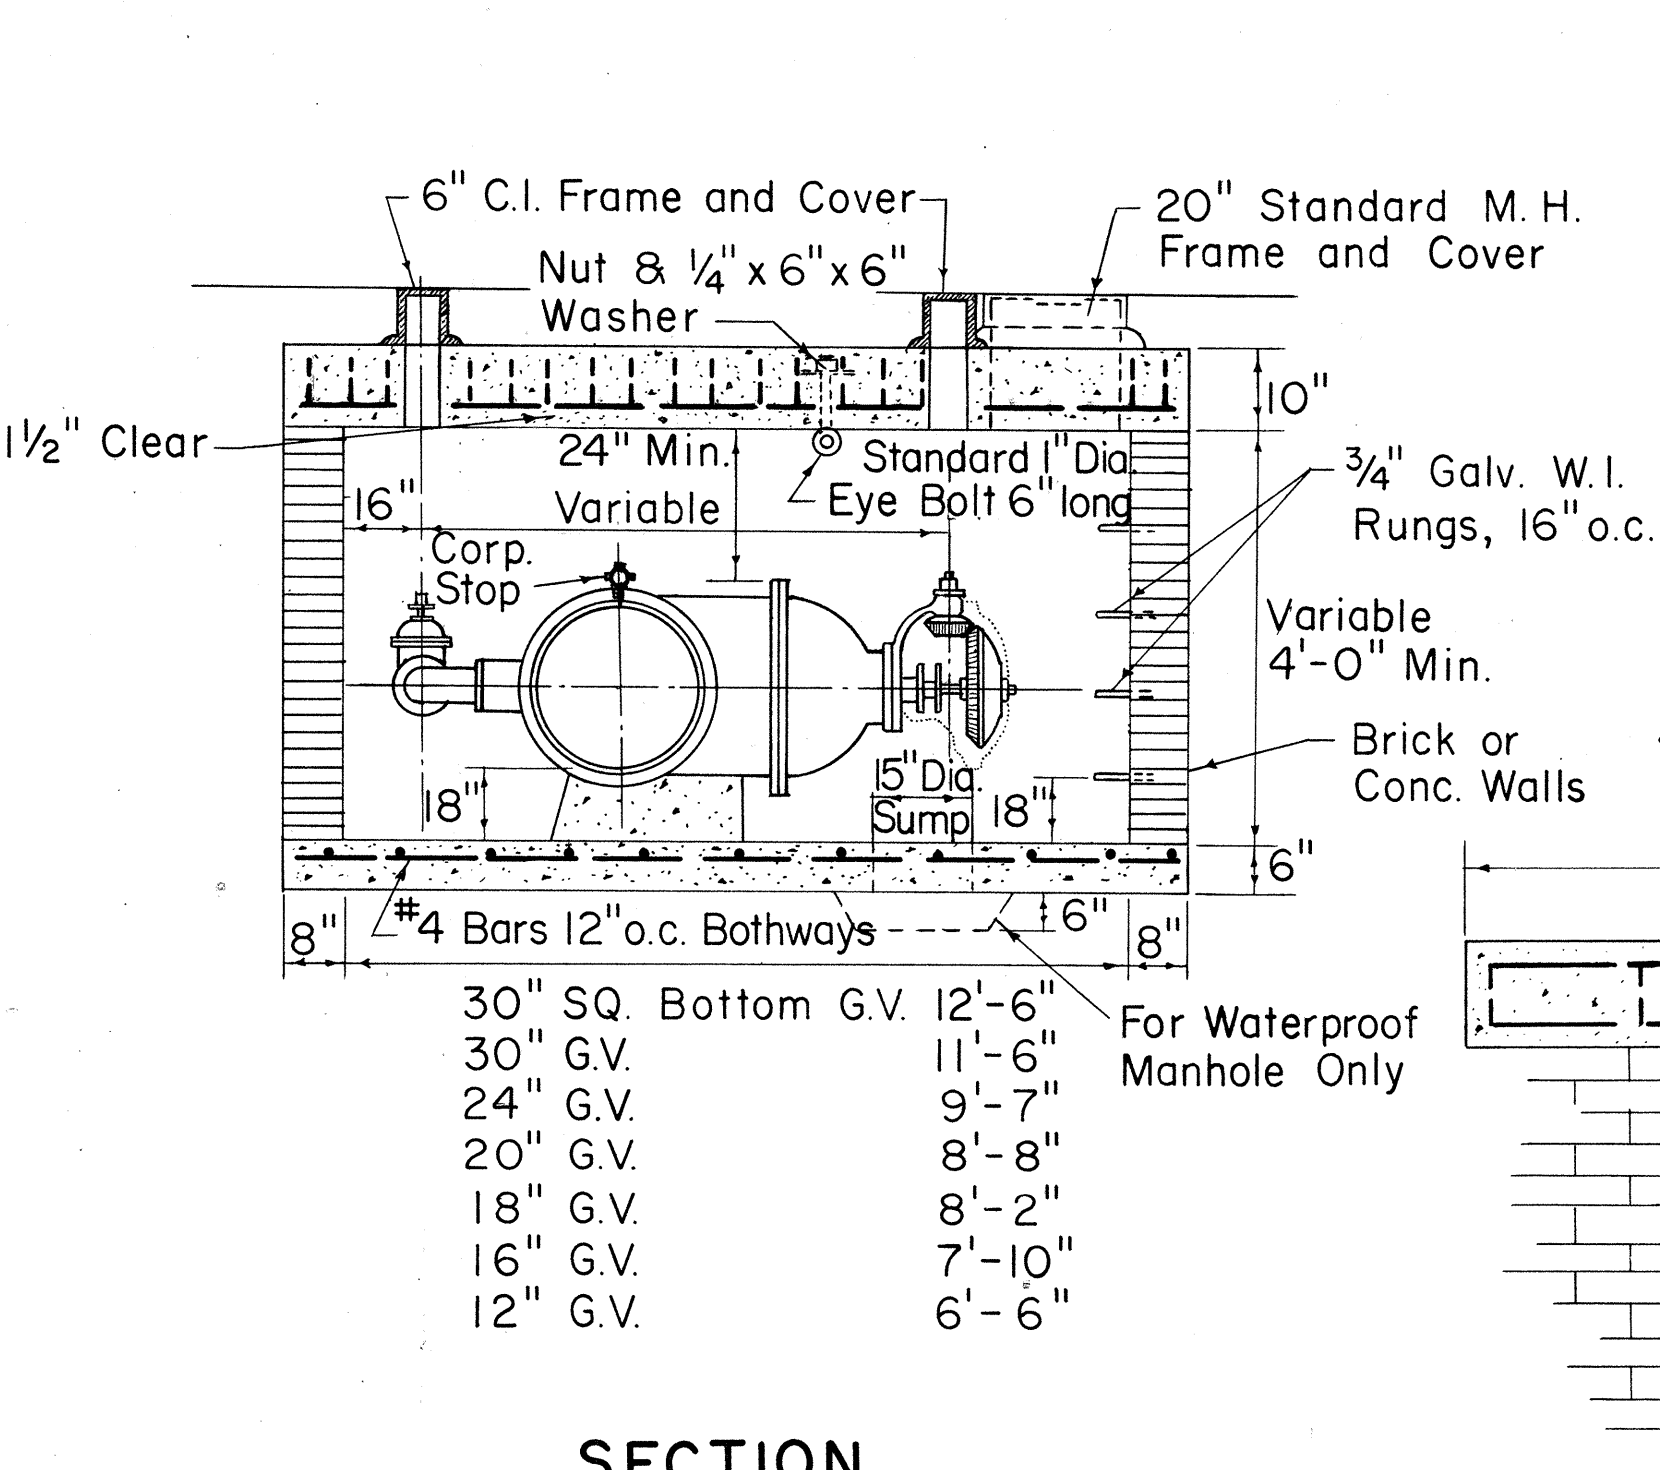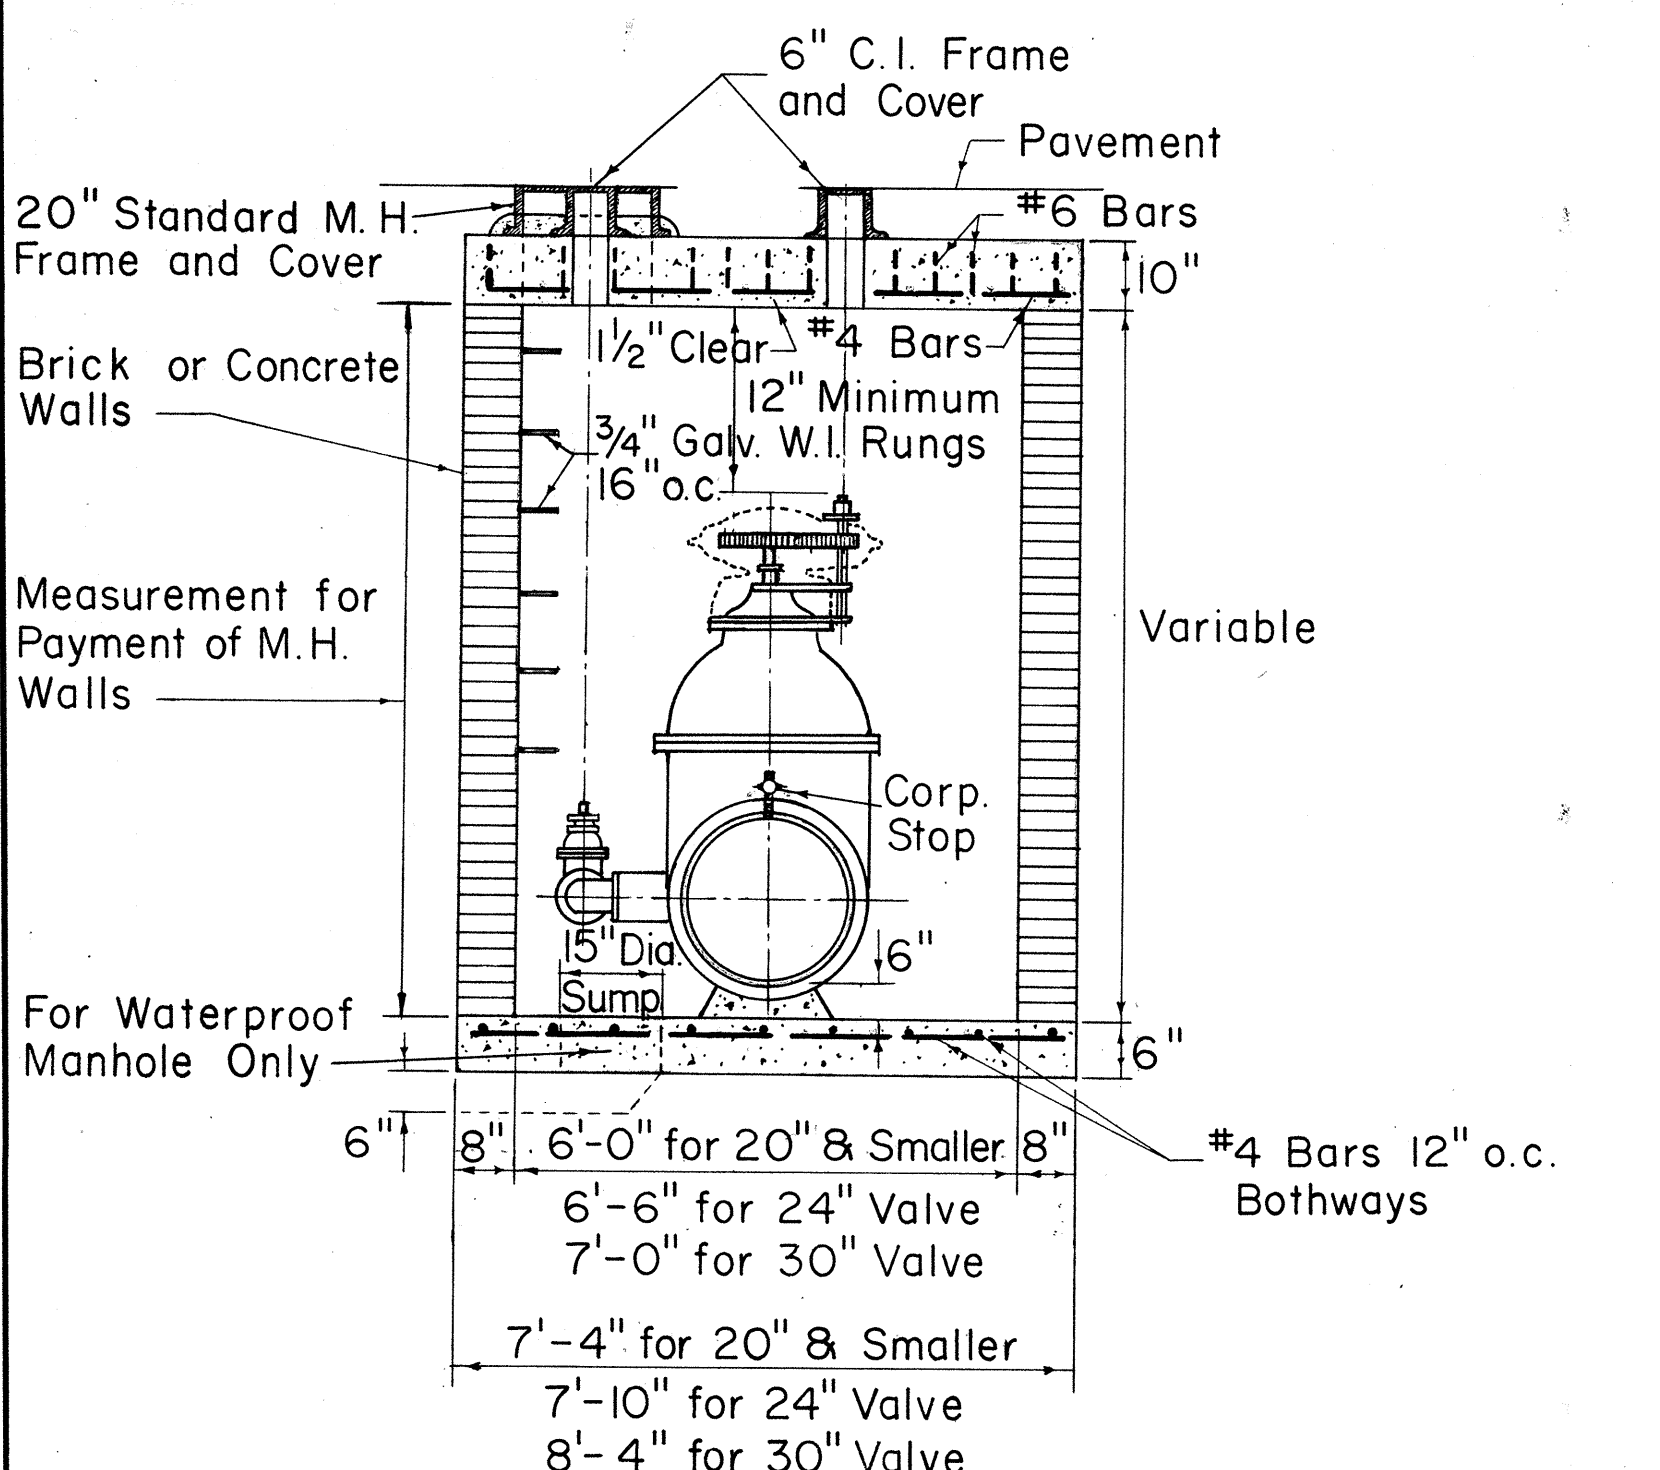

SECTION
TYPE "A" MANHOLE
FOR SPUR GEARED GATE VALVES

SECTION
TYPE "A" MANHOLE
FOR BEVEL GEARED GATE VALVES

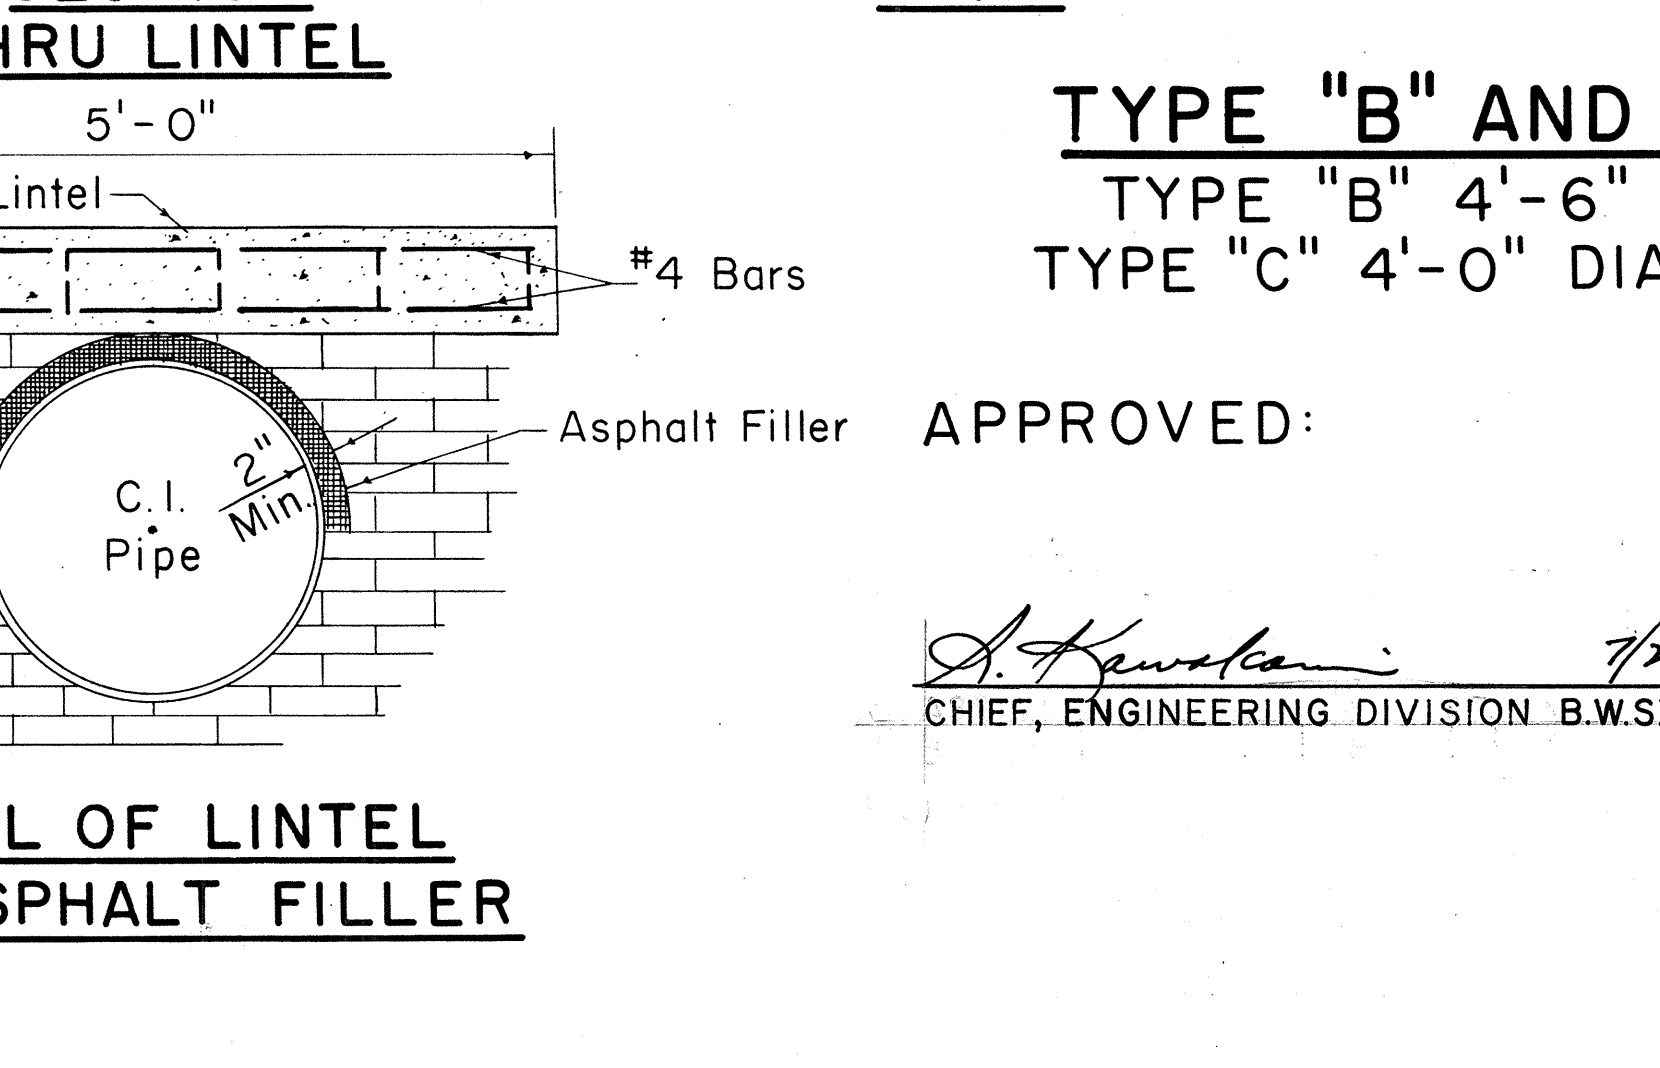

DETAIL OF LINTEL AND ASPHALT FILLER


TYPE "B" AND "C" MANHOLES
TYPE "B" 4'-6" DIA. (FOR 12" G.V.)
TYPE "C" 4'-0" DIA. (FOR 6" & 8" G.V.)

APPROVED:
A. Kawakami 7/24/68
CHIEF, ENGINEERING DIVISION B.W.S. DATE


STATE OF HAWAII
DEPARTMENT OF TRANSPORTATION
HIGHWAYS DIVISION
BOARD OF WATER SUPPLY
CITY & COUNTY OF HONOLULU
STANDARD WATER DETAILS
Not to Scale Date 8/14/68
SHEET NO. 7 OF 17 SHEETS

FED. AID DIST. NO.	STATE	FED. AID PROJ. NO.	FISCAL YEAR	SHEET NO.	TOTAL SHEETS
HAWAII	HAWAII	HH-1(2)-11 1-H-1(10)-11	1968	25	38


NOTE:
Reinforced concrete manhole walls (See detail of plain manhole) shall be used for portions below the water table.

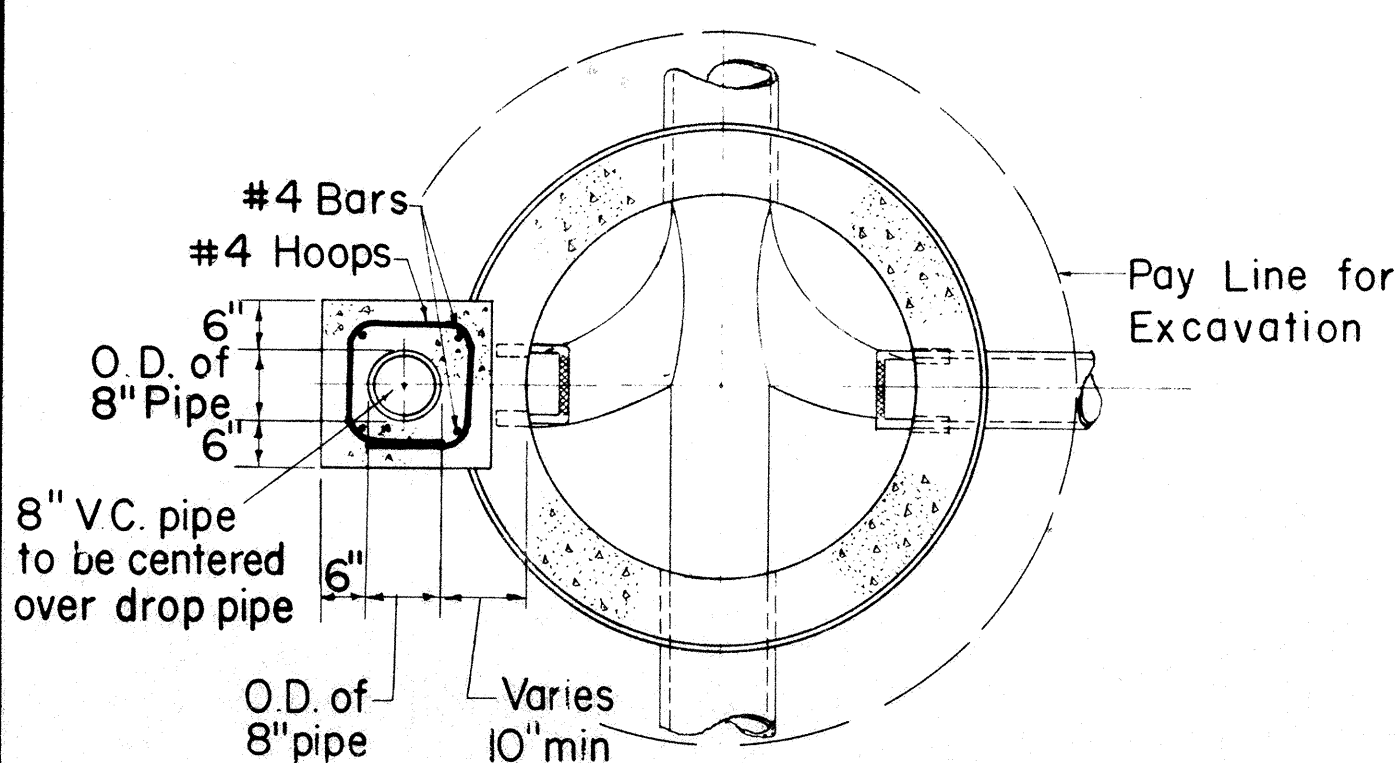


SECTION A-A
Scale: 1/2" = 1'-0"

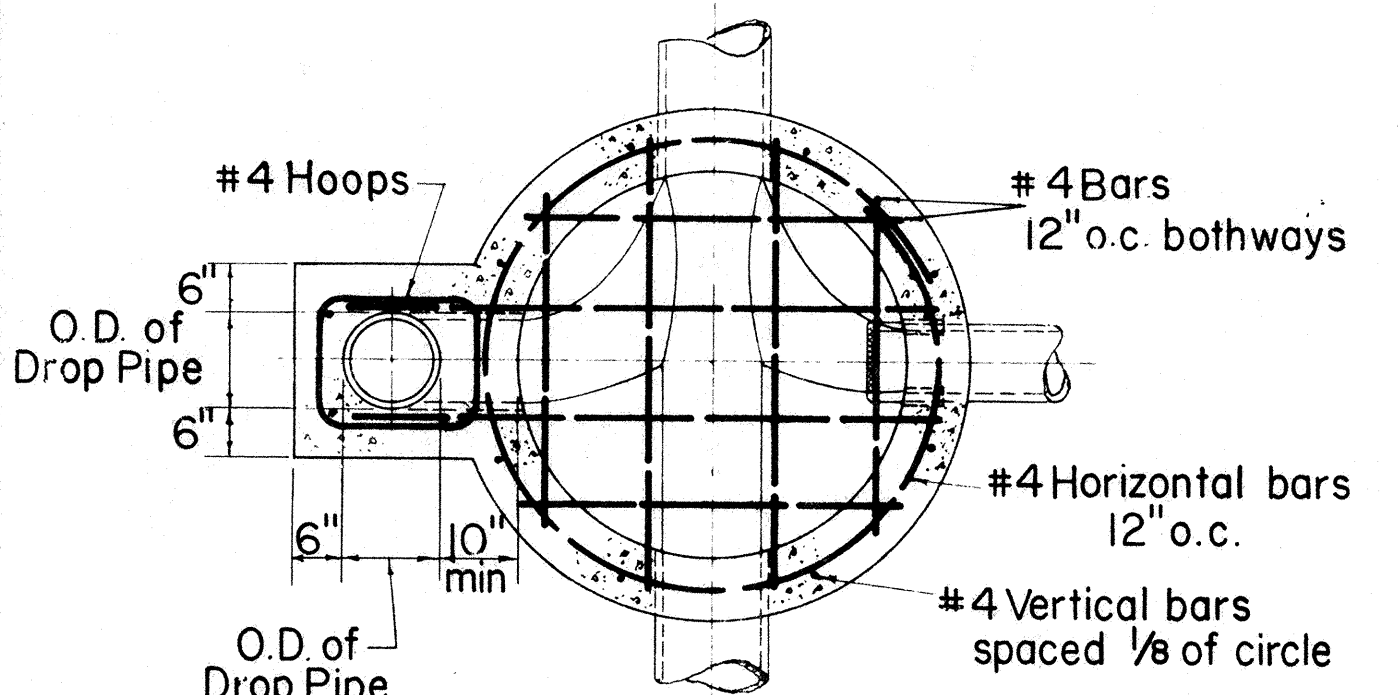


SECTION B-B
Scale: 1/2" = 1'-0"

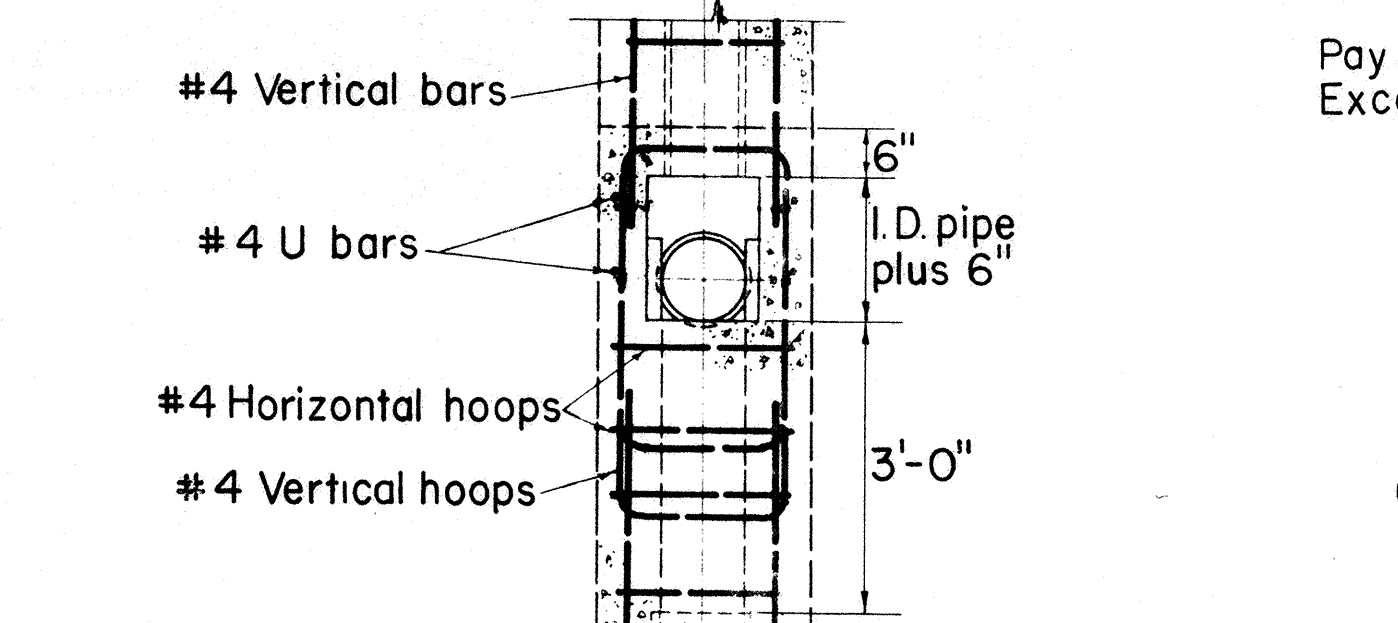


SECTION C-C
Scale: 1/2" = 1'-0"

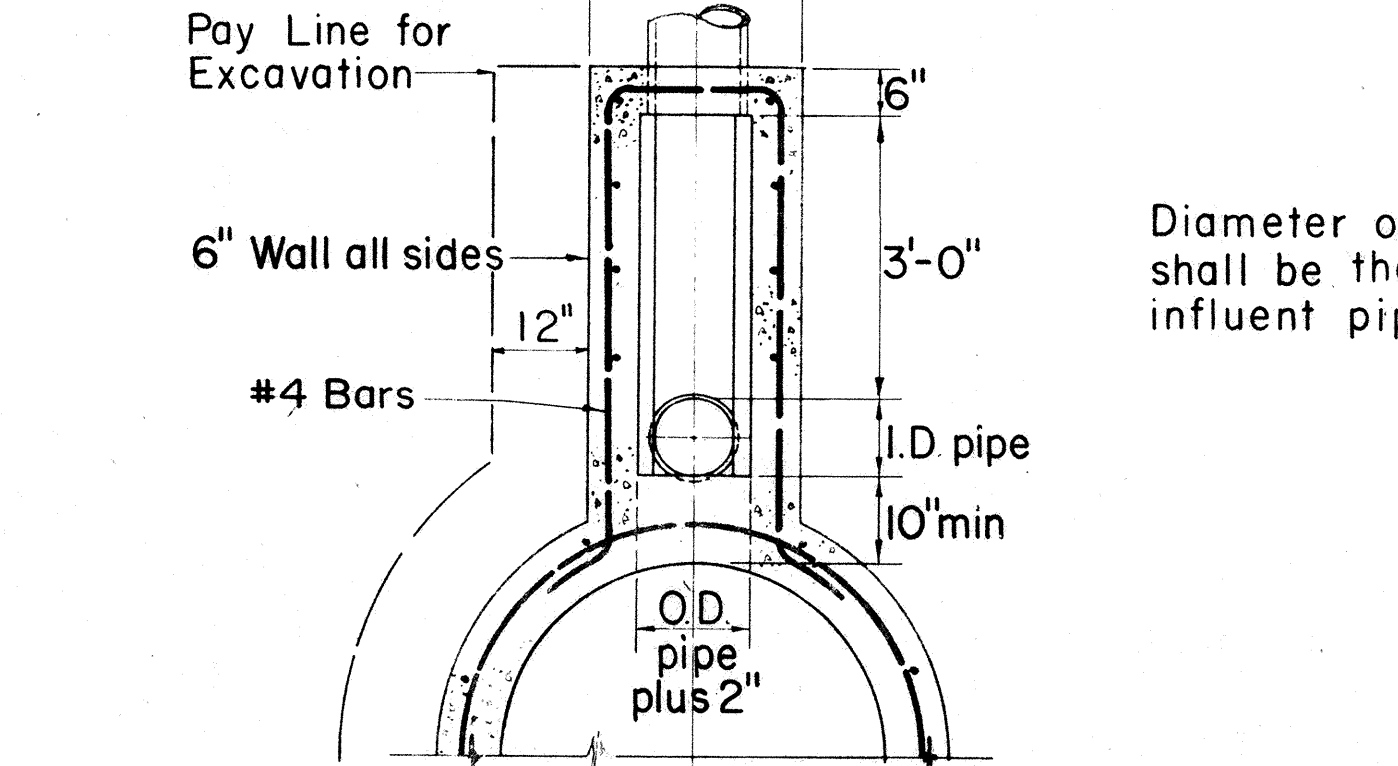


SECTION D-D
Scale: 1/2" = 1'-0"

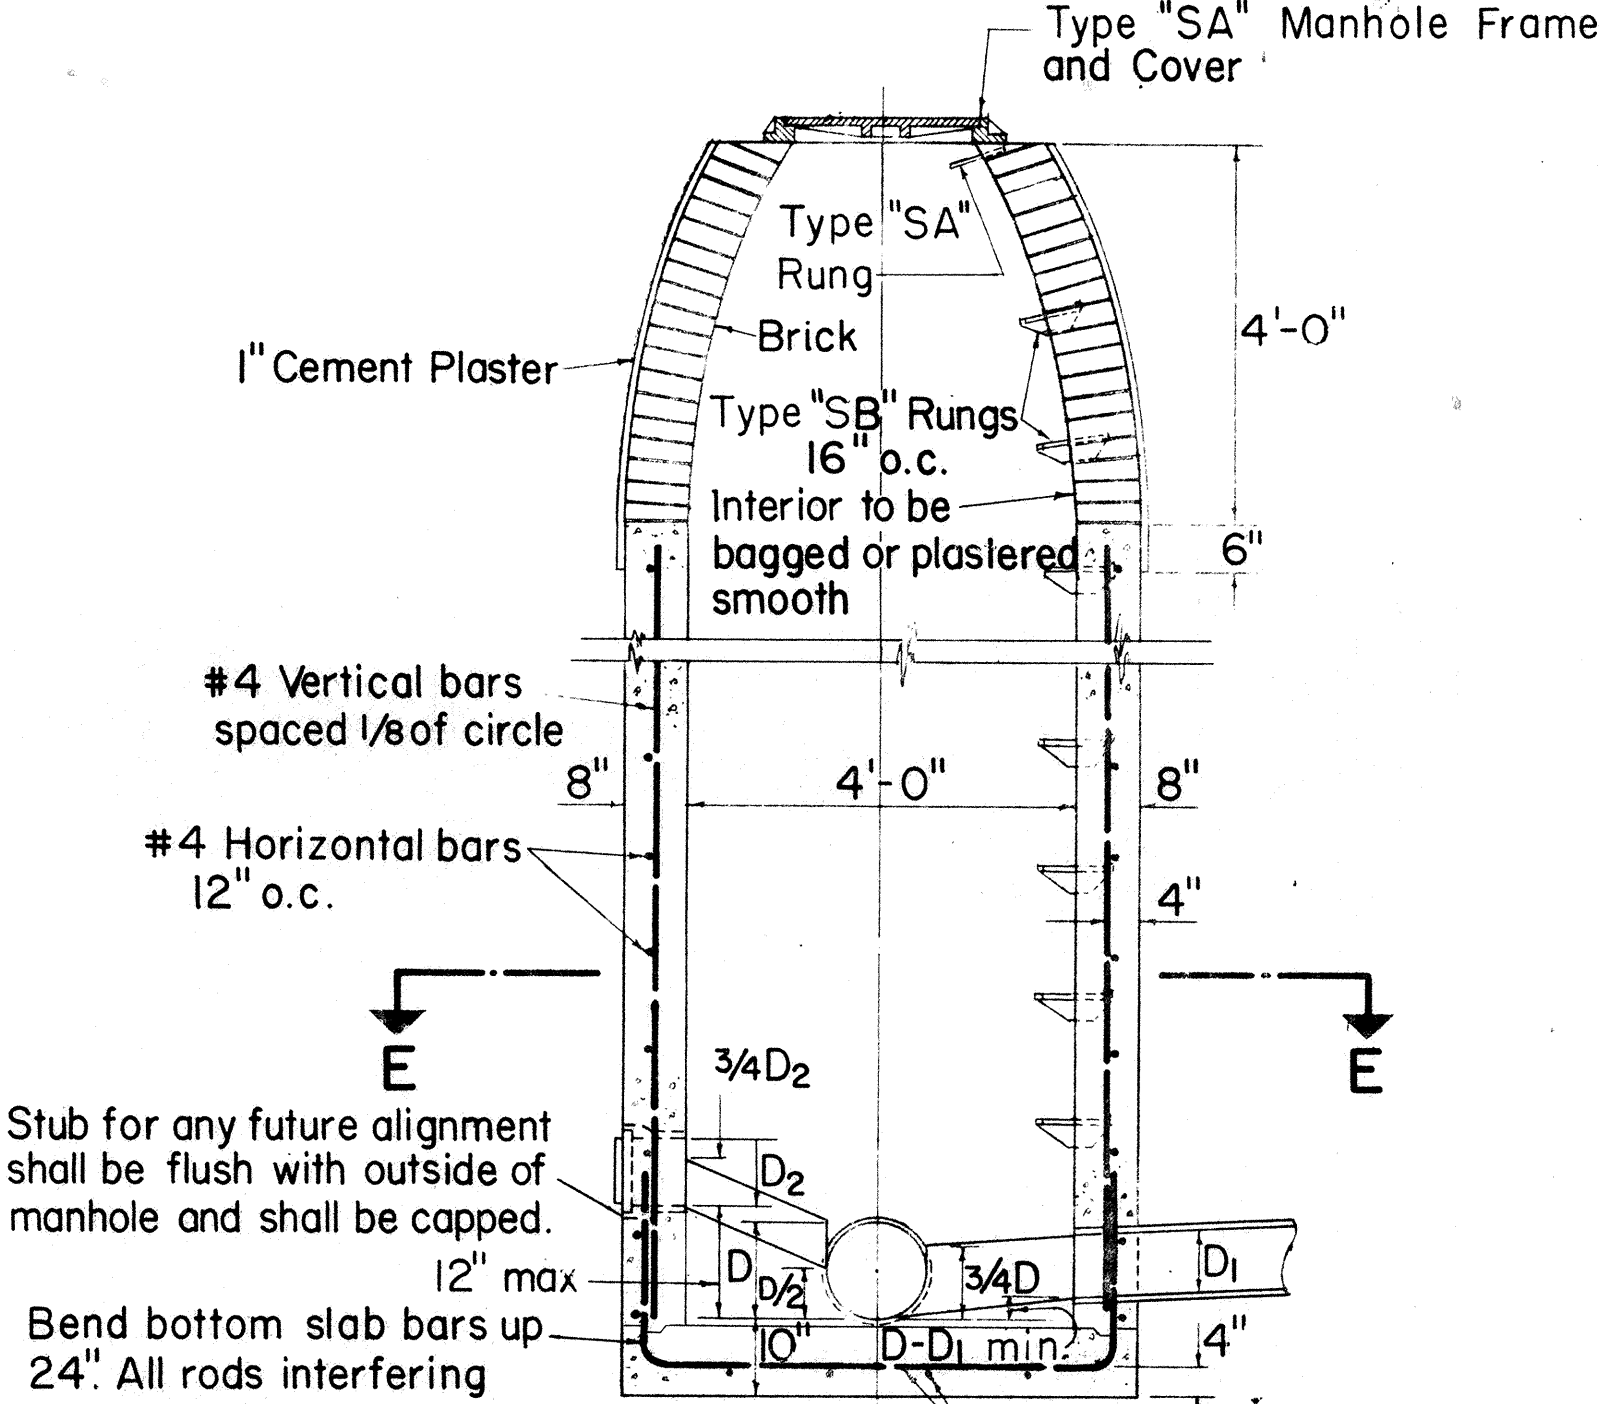


PLAIN MANHOLE
Scale: 1/2" = 1'-0"

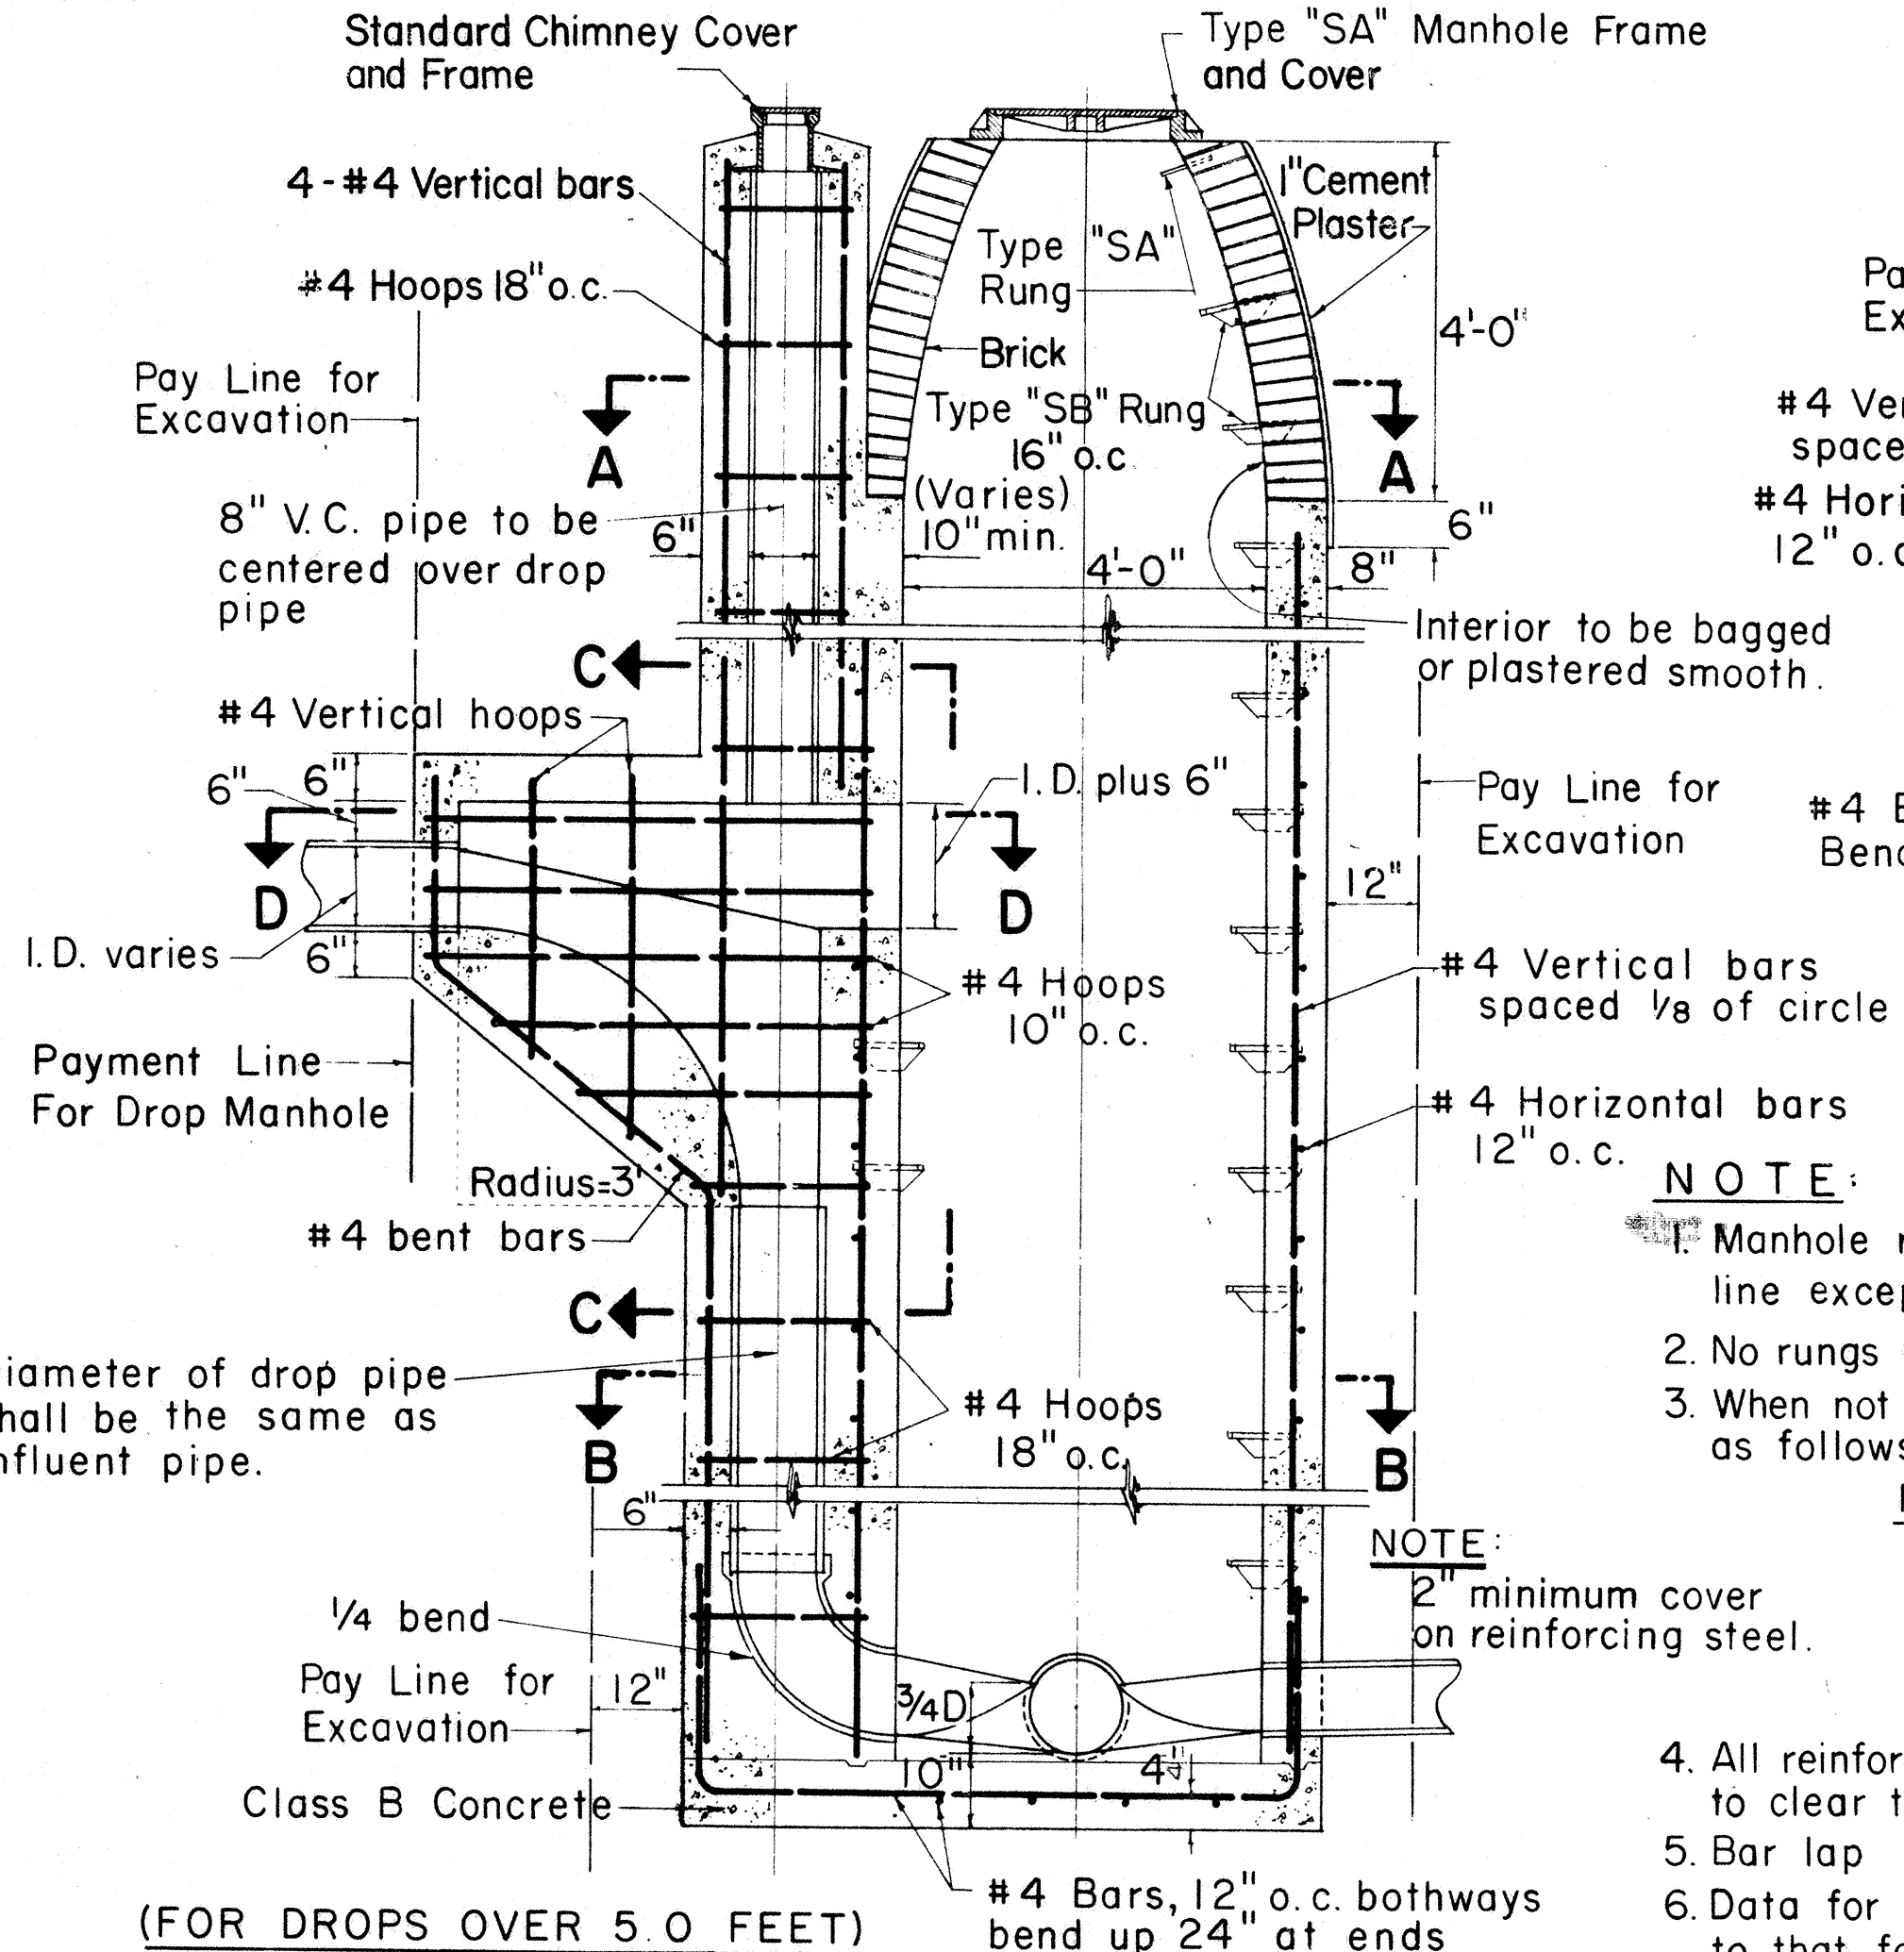

DROP MANHOLE
Scale: 1/2" = 1'-0"

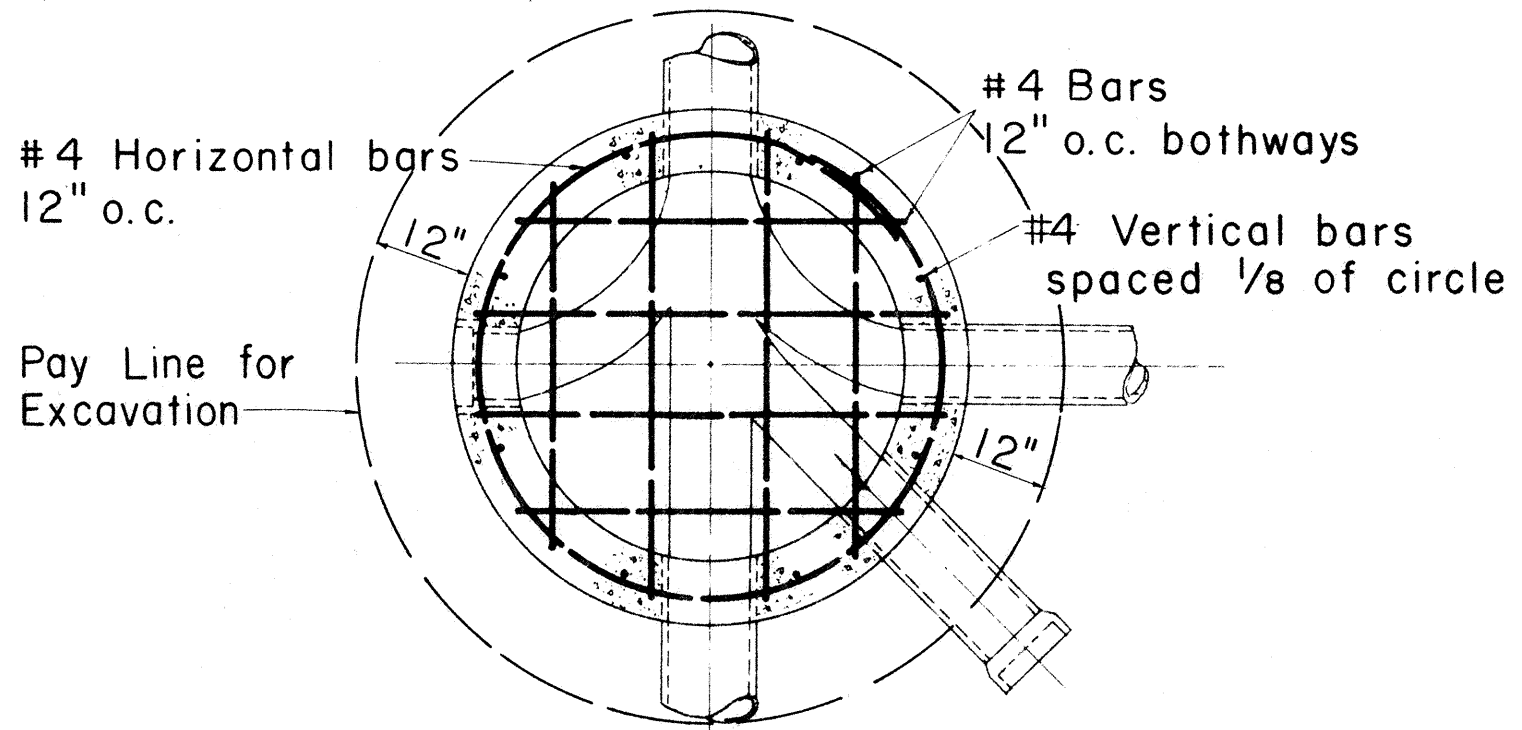


SECTION E-E
Scale: 1/2" = 1'-0"

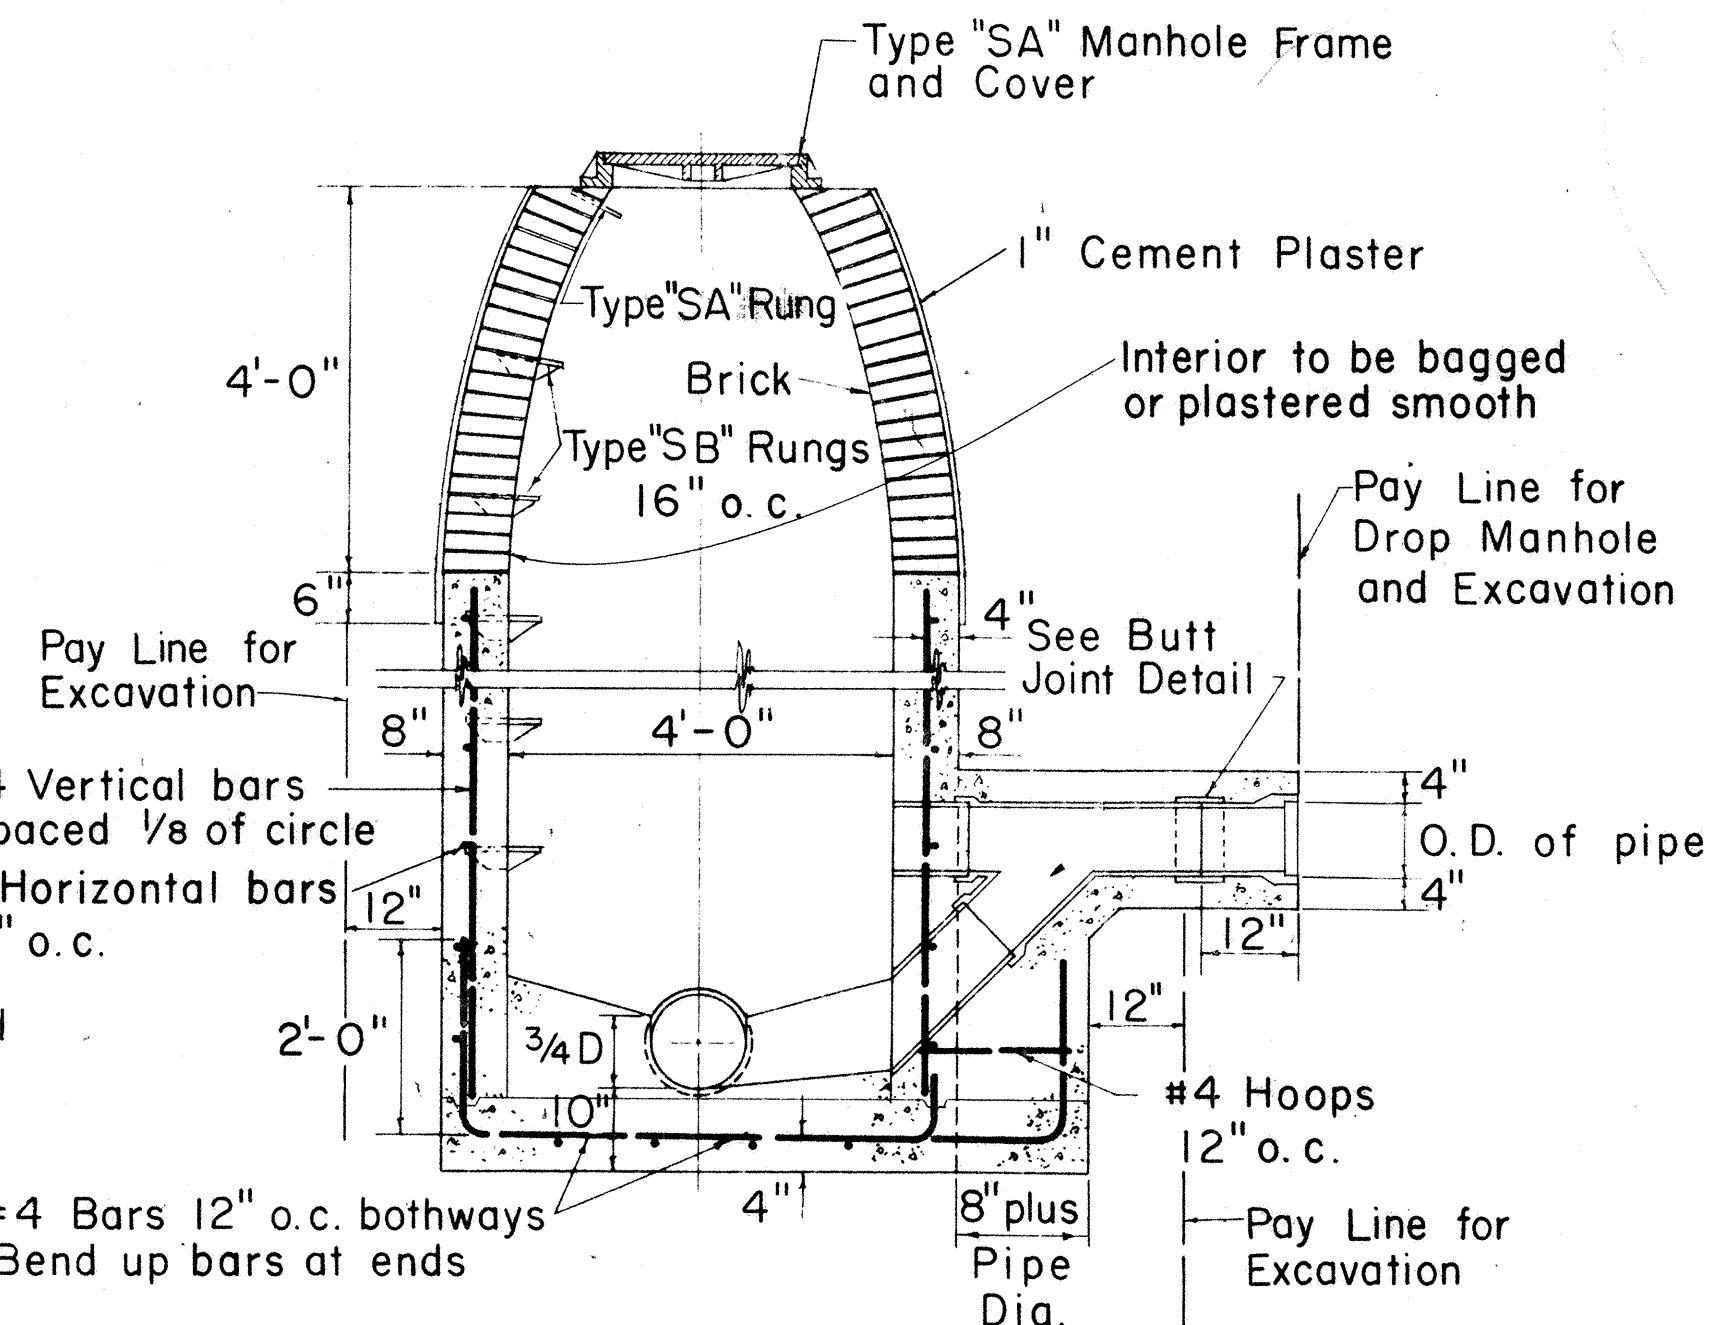

SHALLOW DROP MANHOLE
Scale: 1/2" = 1'-0"

- NOTE:
- Manhole rungs shall not be aligned above any flow line except in drop manhole.
 - No rungs shall be installed in manholes less than 3' high.
 - When not otherwise noted, manhole stubs shall be sloped as follows:
- | Pipe Size | Rise Per Foot |
|-----------|---------------|
| 6" | 1/8" |
| 8" | 3/32" |
| 10" | 1/16" |
| 12" | 1/16" |
- All reinforcing rods interfering with pipes shall be bent to clear them.
 - Bar lap to be 40 diameters in length.
 - Data for special manholes not shown shall be similar to that for plain manholes.
 - Size of drop pipe in all Drop Manholes shall be same as influent line.

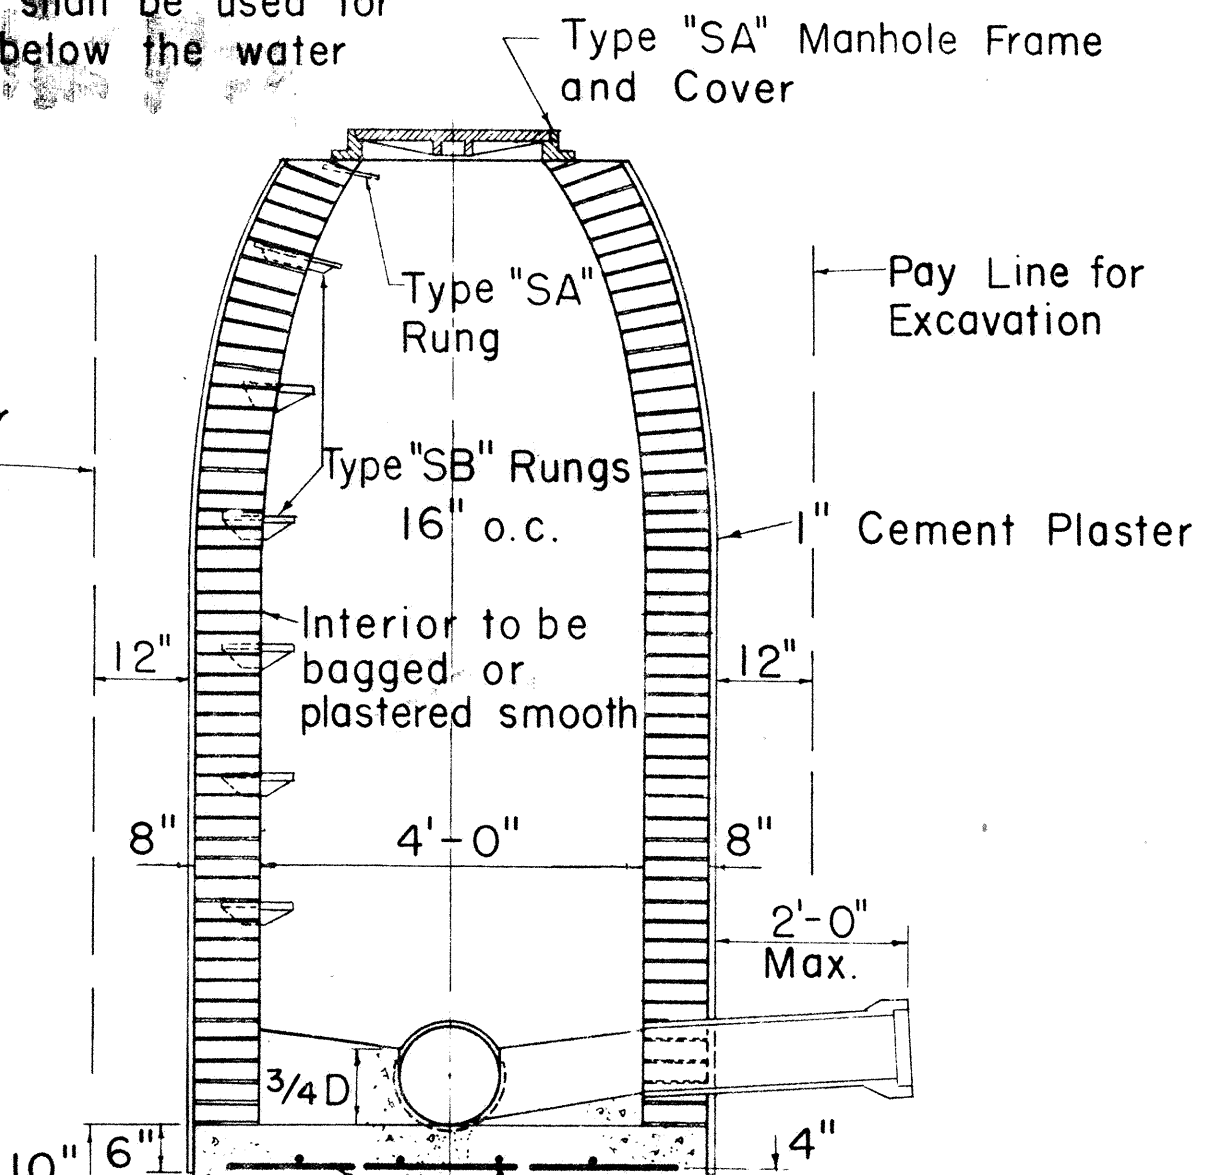

BRICK MANHOLE
Scale: 1/2" = 1'-0"

Payment for excavation for manholes shall be made under unit price for trench excavation and shall be measured to one foot outside of walls from original ground elevation to authorized bottom elevation.
Payment for manhole walls (brick, or cast-in-place concrete) shall include brick, mortar, concrete, reinforcing steel, cast-iron steps, galvanized wrought iron rungs, and plastering.

8. Manhole wall to be of reinforced concrete to height 1' above normal ground water table.

APPROVED:

SEWER SYSTEM DIRECTOR, DIVISION OF SEWERS
DATE: 8-13-68

STATE OF HAWAII
DEPARTMENT OF TRANSPORTATION
HIGHWAYS DIVISION
DIVISION OF SEWERS
CITY & COUNTY OF HONOLULU

STANDARD DETAILS
SEWERS - DROP MANHOLE AND
BRICK MANHOLE DETAILS

Scales: As Noted Date: 8/14/68

SHEET NO. 25 OF 17 SHEETS

9" Dia.

3/4"

7 1/2"

7"

3/4"

1/8"

1/4"

5 1/2"

5"

1/4"

1/8"

6"

8 1/2"

1/4" Long Notch





14"

SECTION

DROP MANHOLE


CHIMNEY CASTING

Scale: 1 1/2" = 1' - 0"

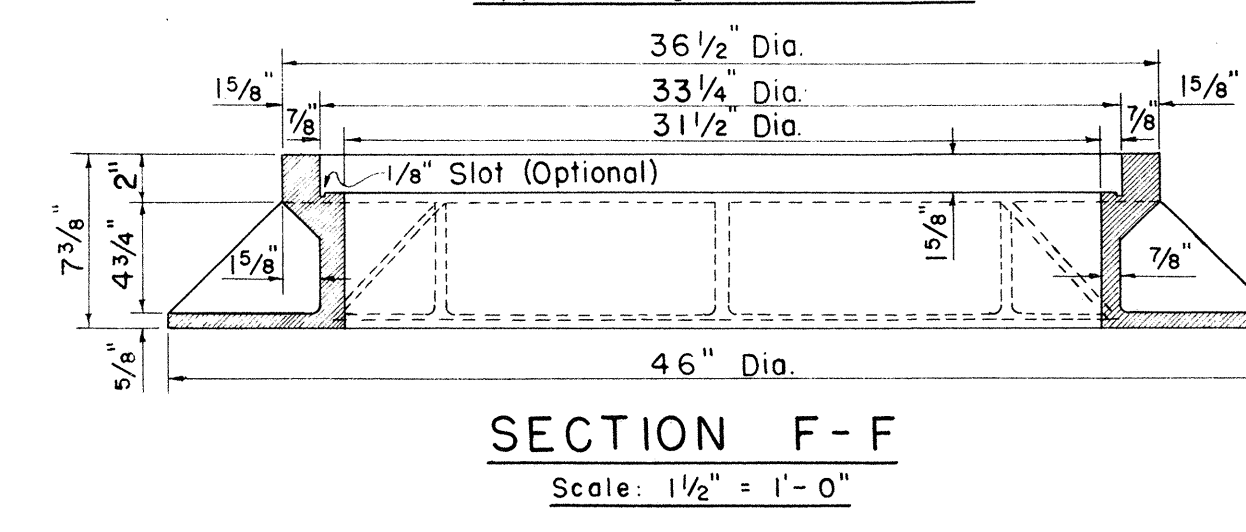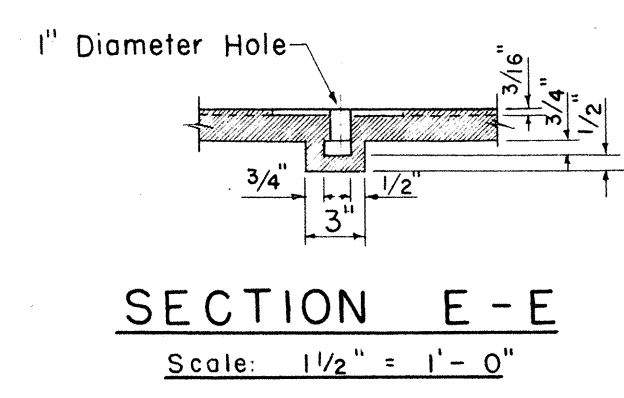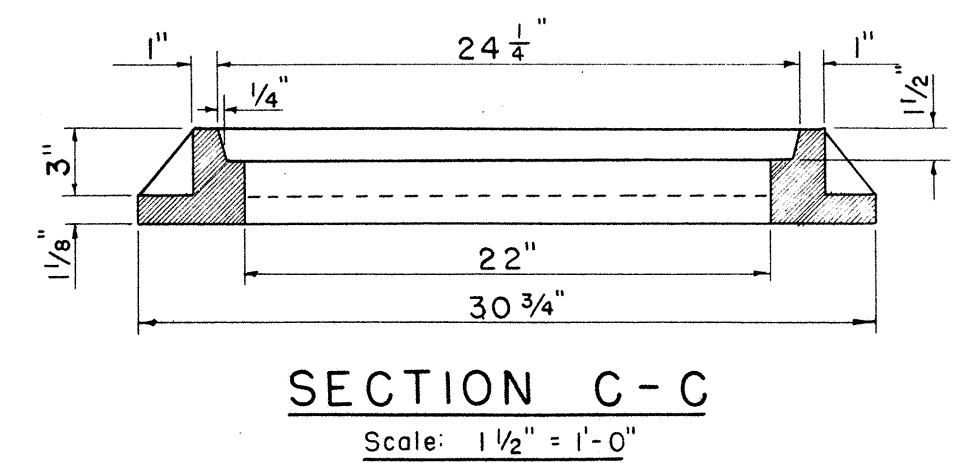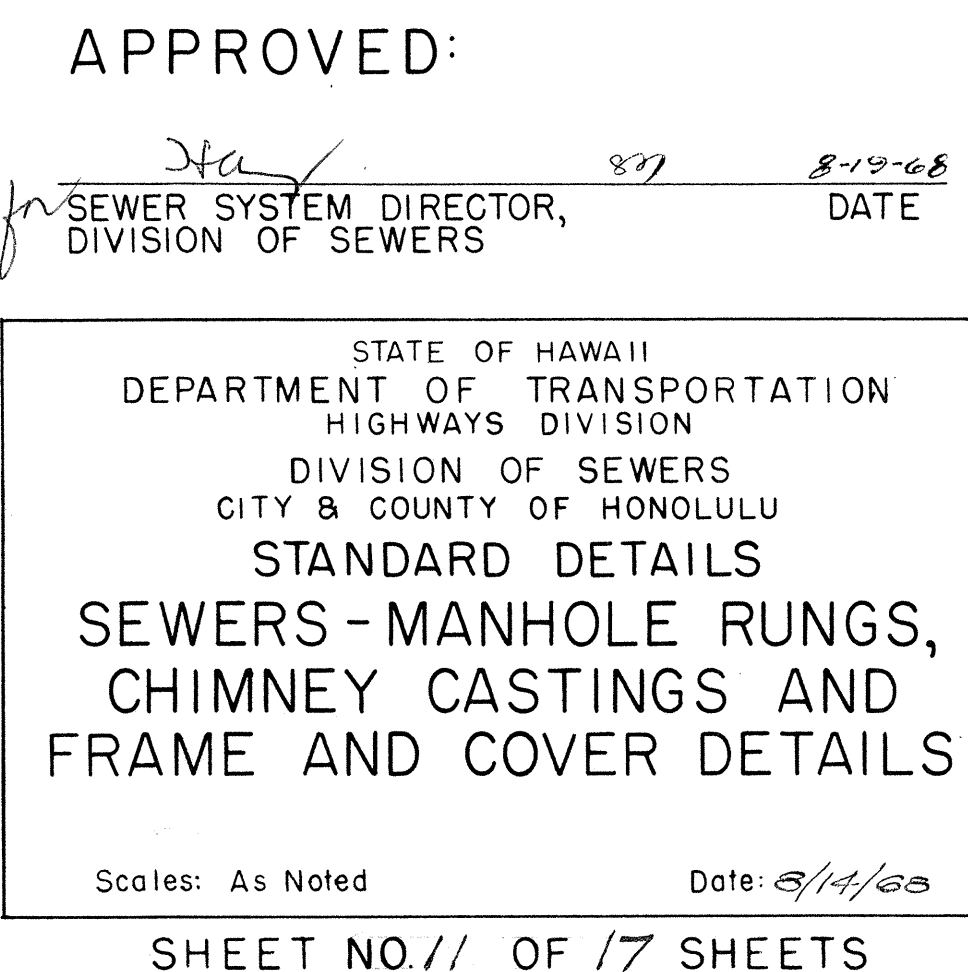


Scale: $1\frac{1}{2}'' = 1' - 0''$


FED. AID DIST. NO.	STATE	FED. AID PROJ. NO.	FISCAL YEAR	SHEET NO.	TOTAL SHEETS
HAWAII	HAWAII	HI-1(63)11 HI-1(16)11	1960	29	28

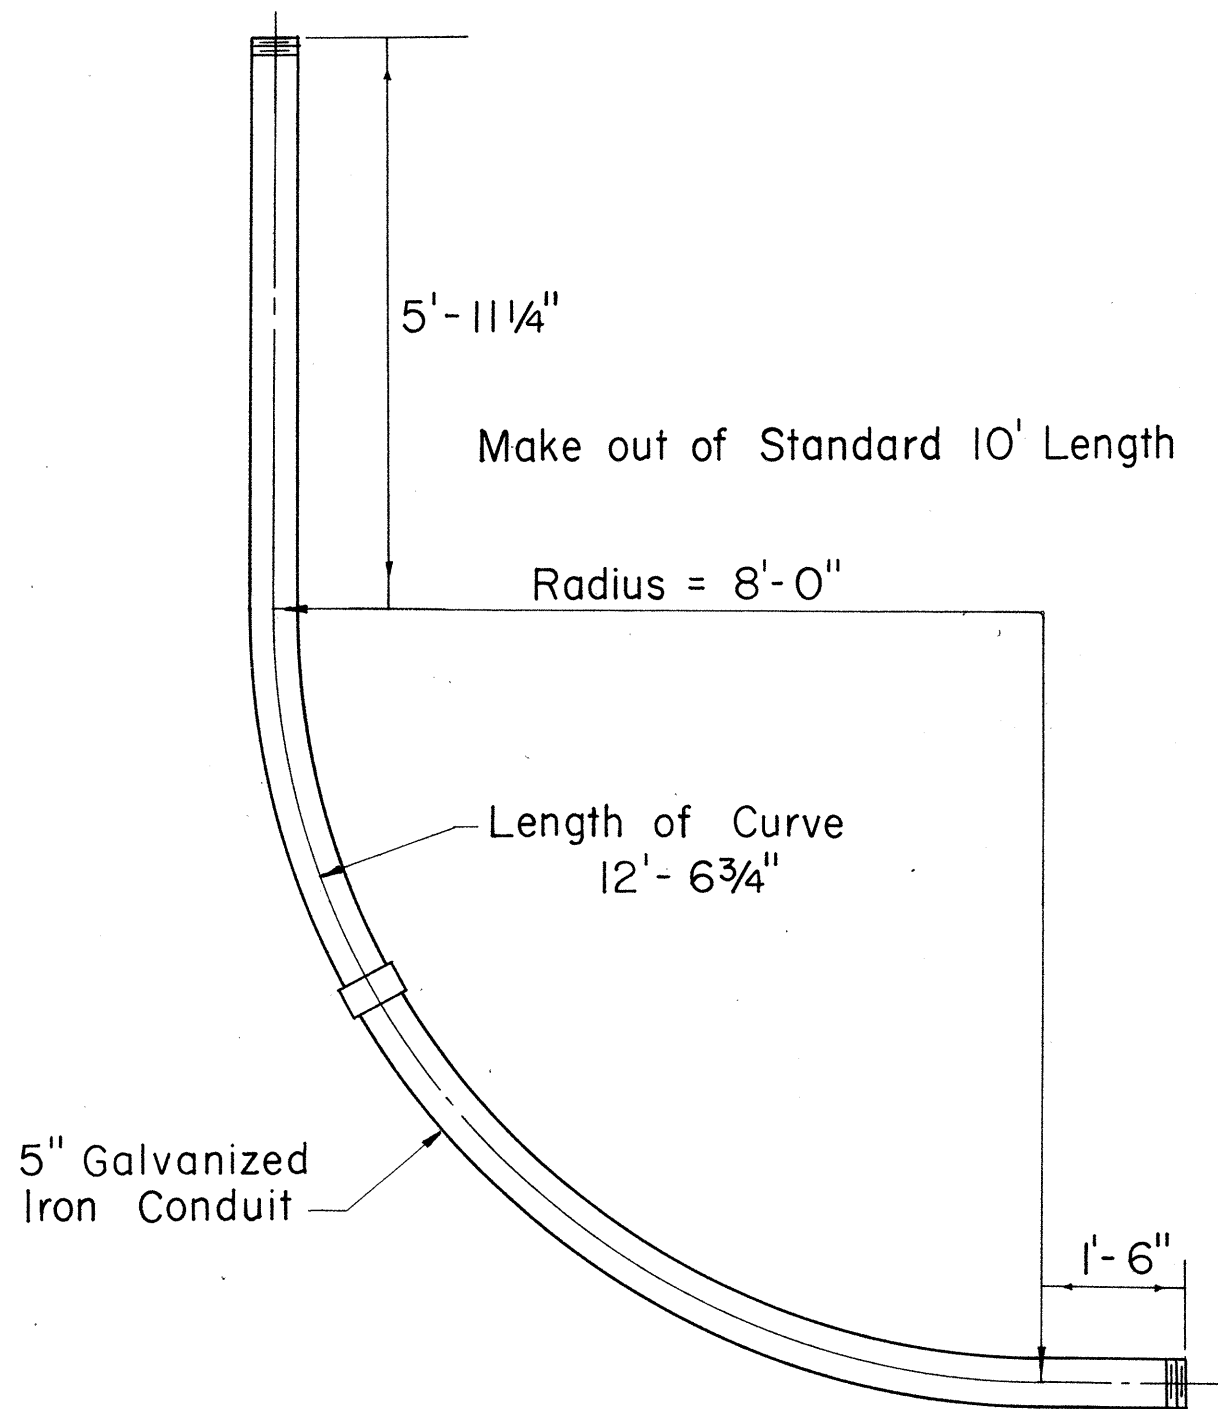

46 KV COMBINATION RISER AND BEND
(8'-0" RADIUS)
Not to Scale

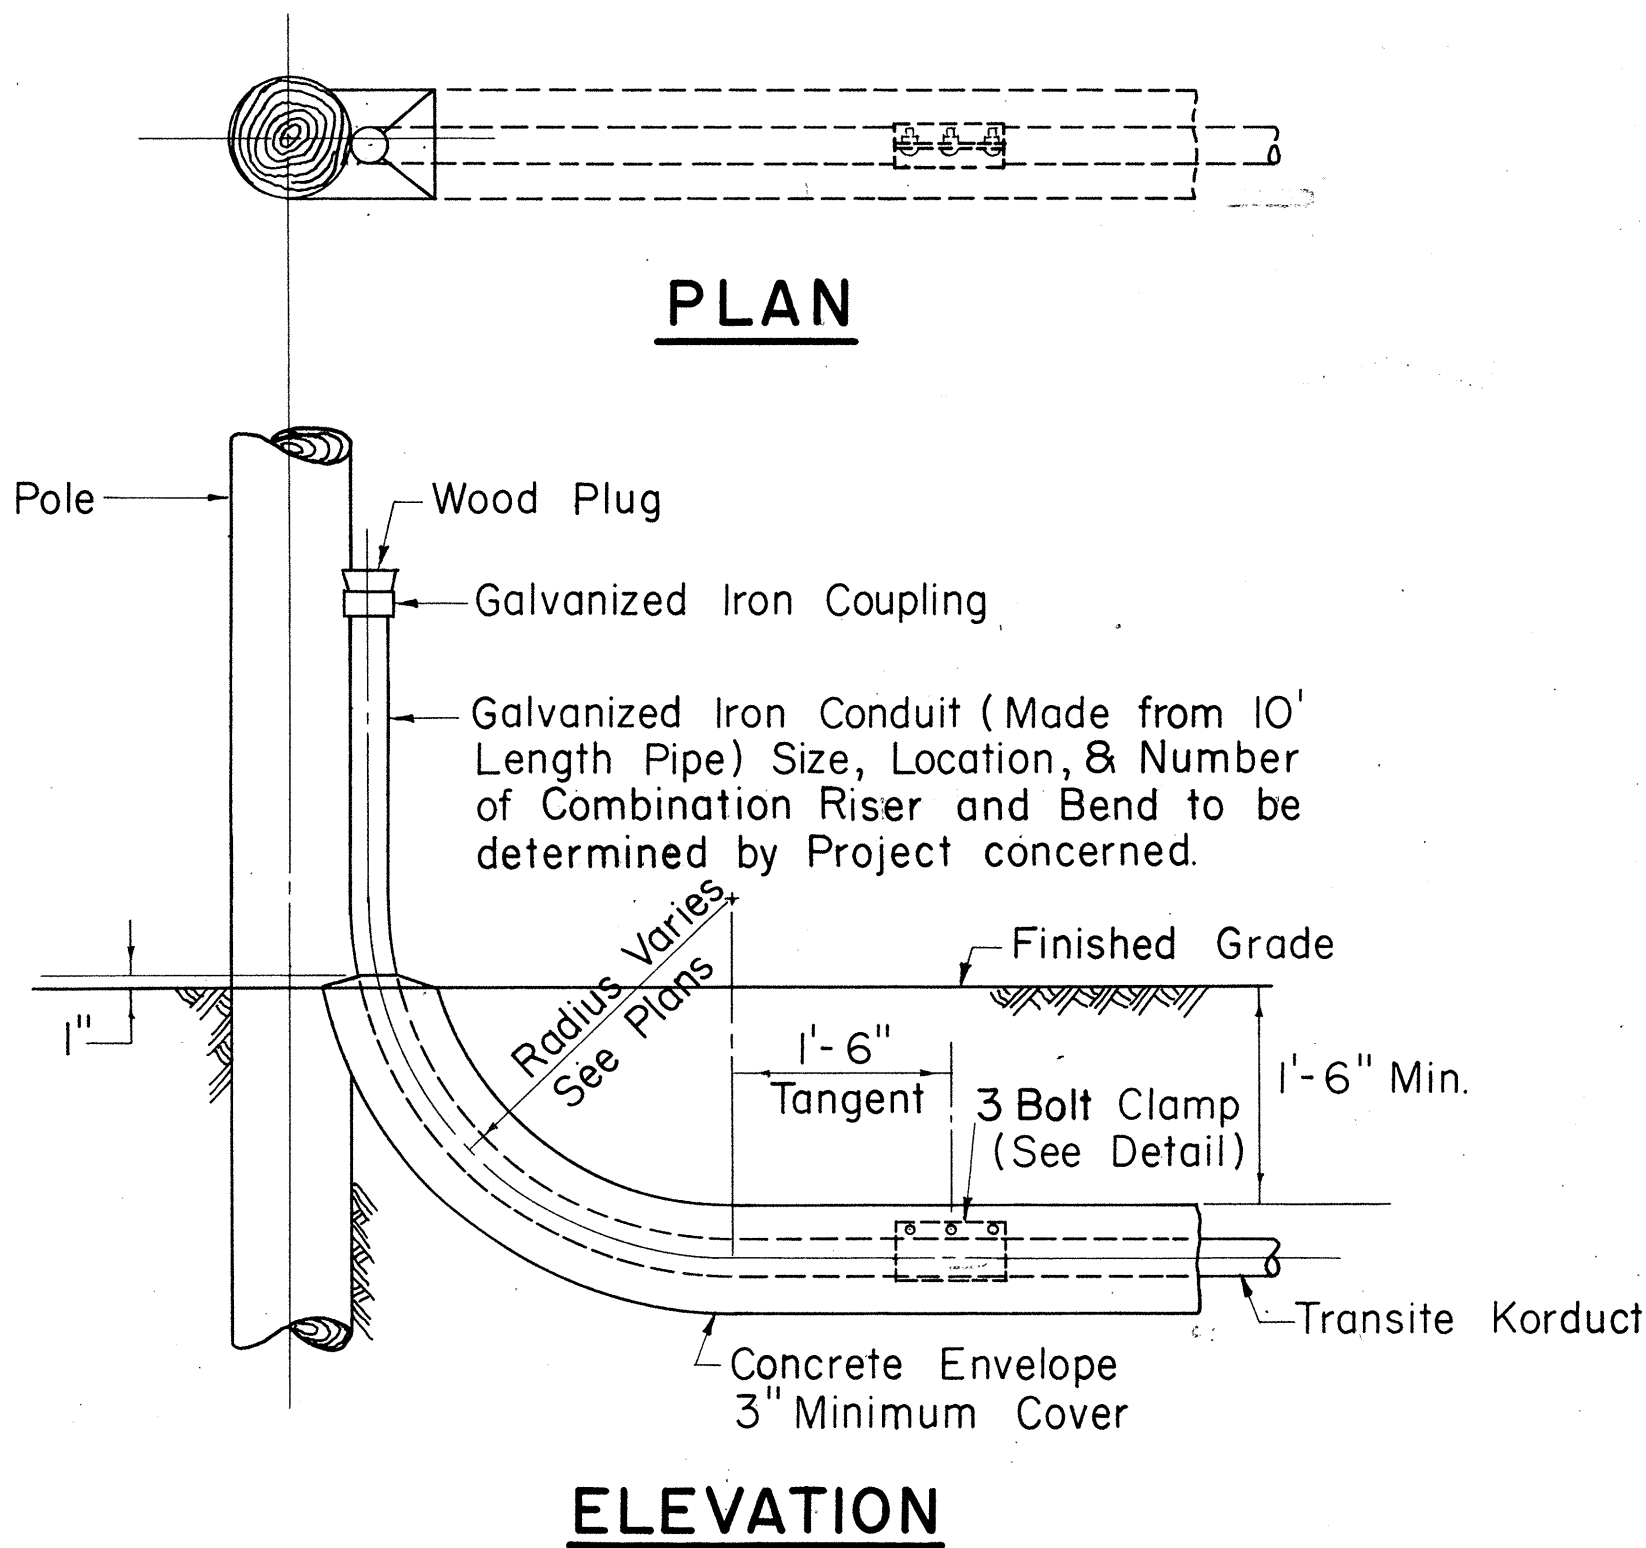


TYPICAL DETAIL COMBINATION RISER AND BEND
Scale: 3/4" = 1'-0"

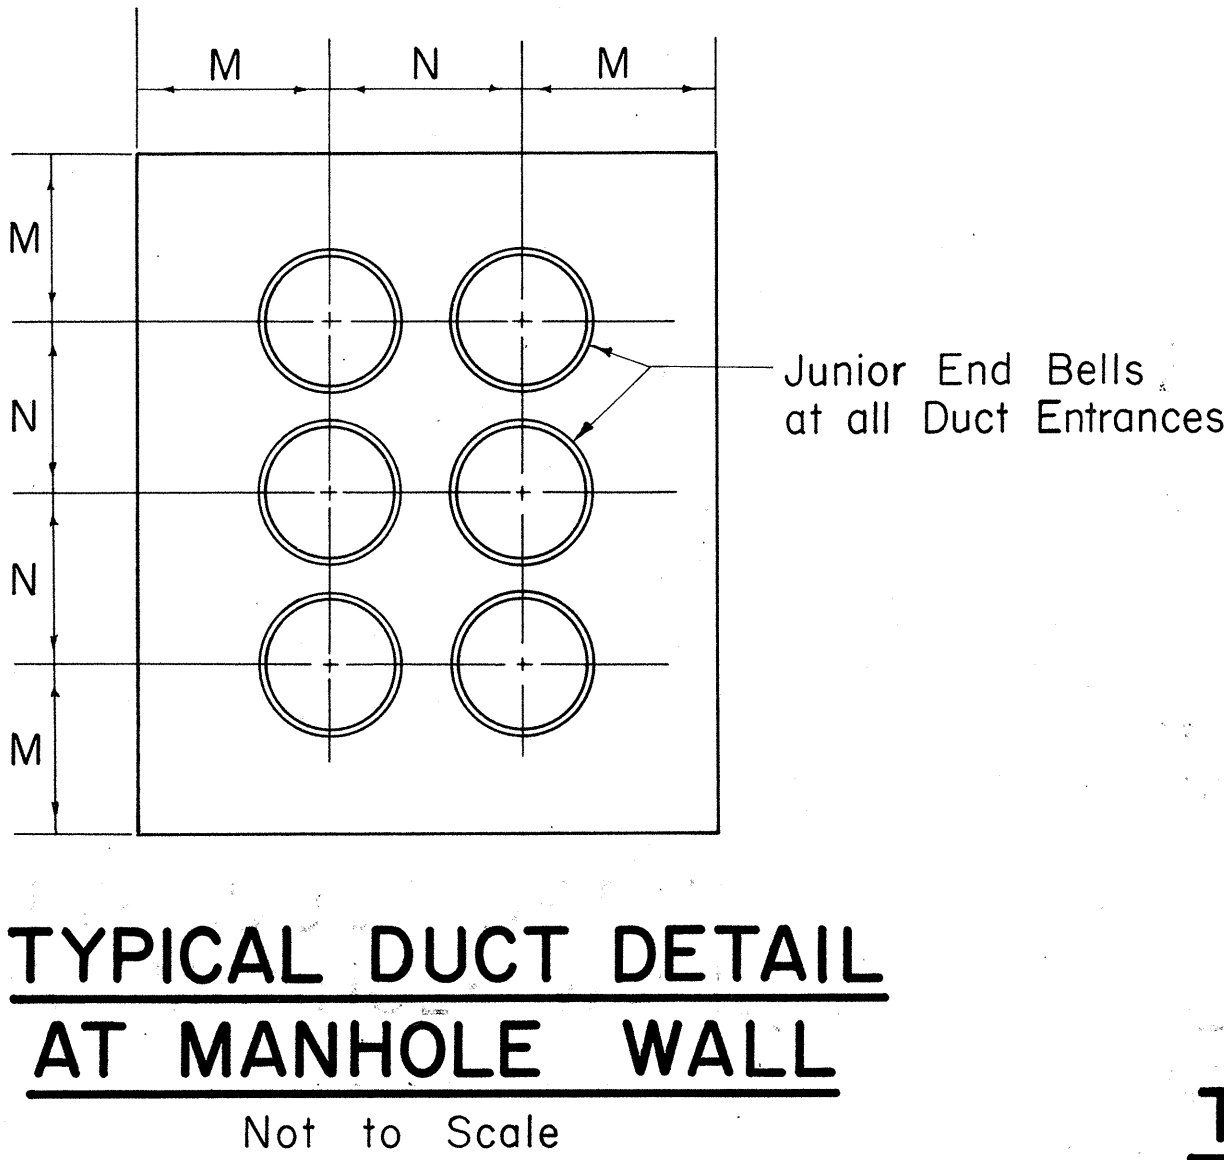


TYPICAL DUCT DETAIL AT MANHOLE WALL
Not to Scale


SIZE	M	N
3"	5"	6"
4"	5 1/2"	7"
4 1/2"	5 1/2"	7 1/2"
5"	6"	8"

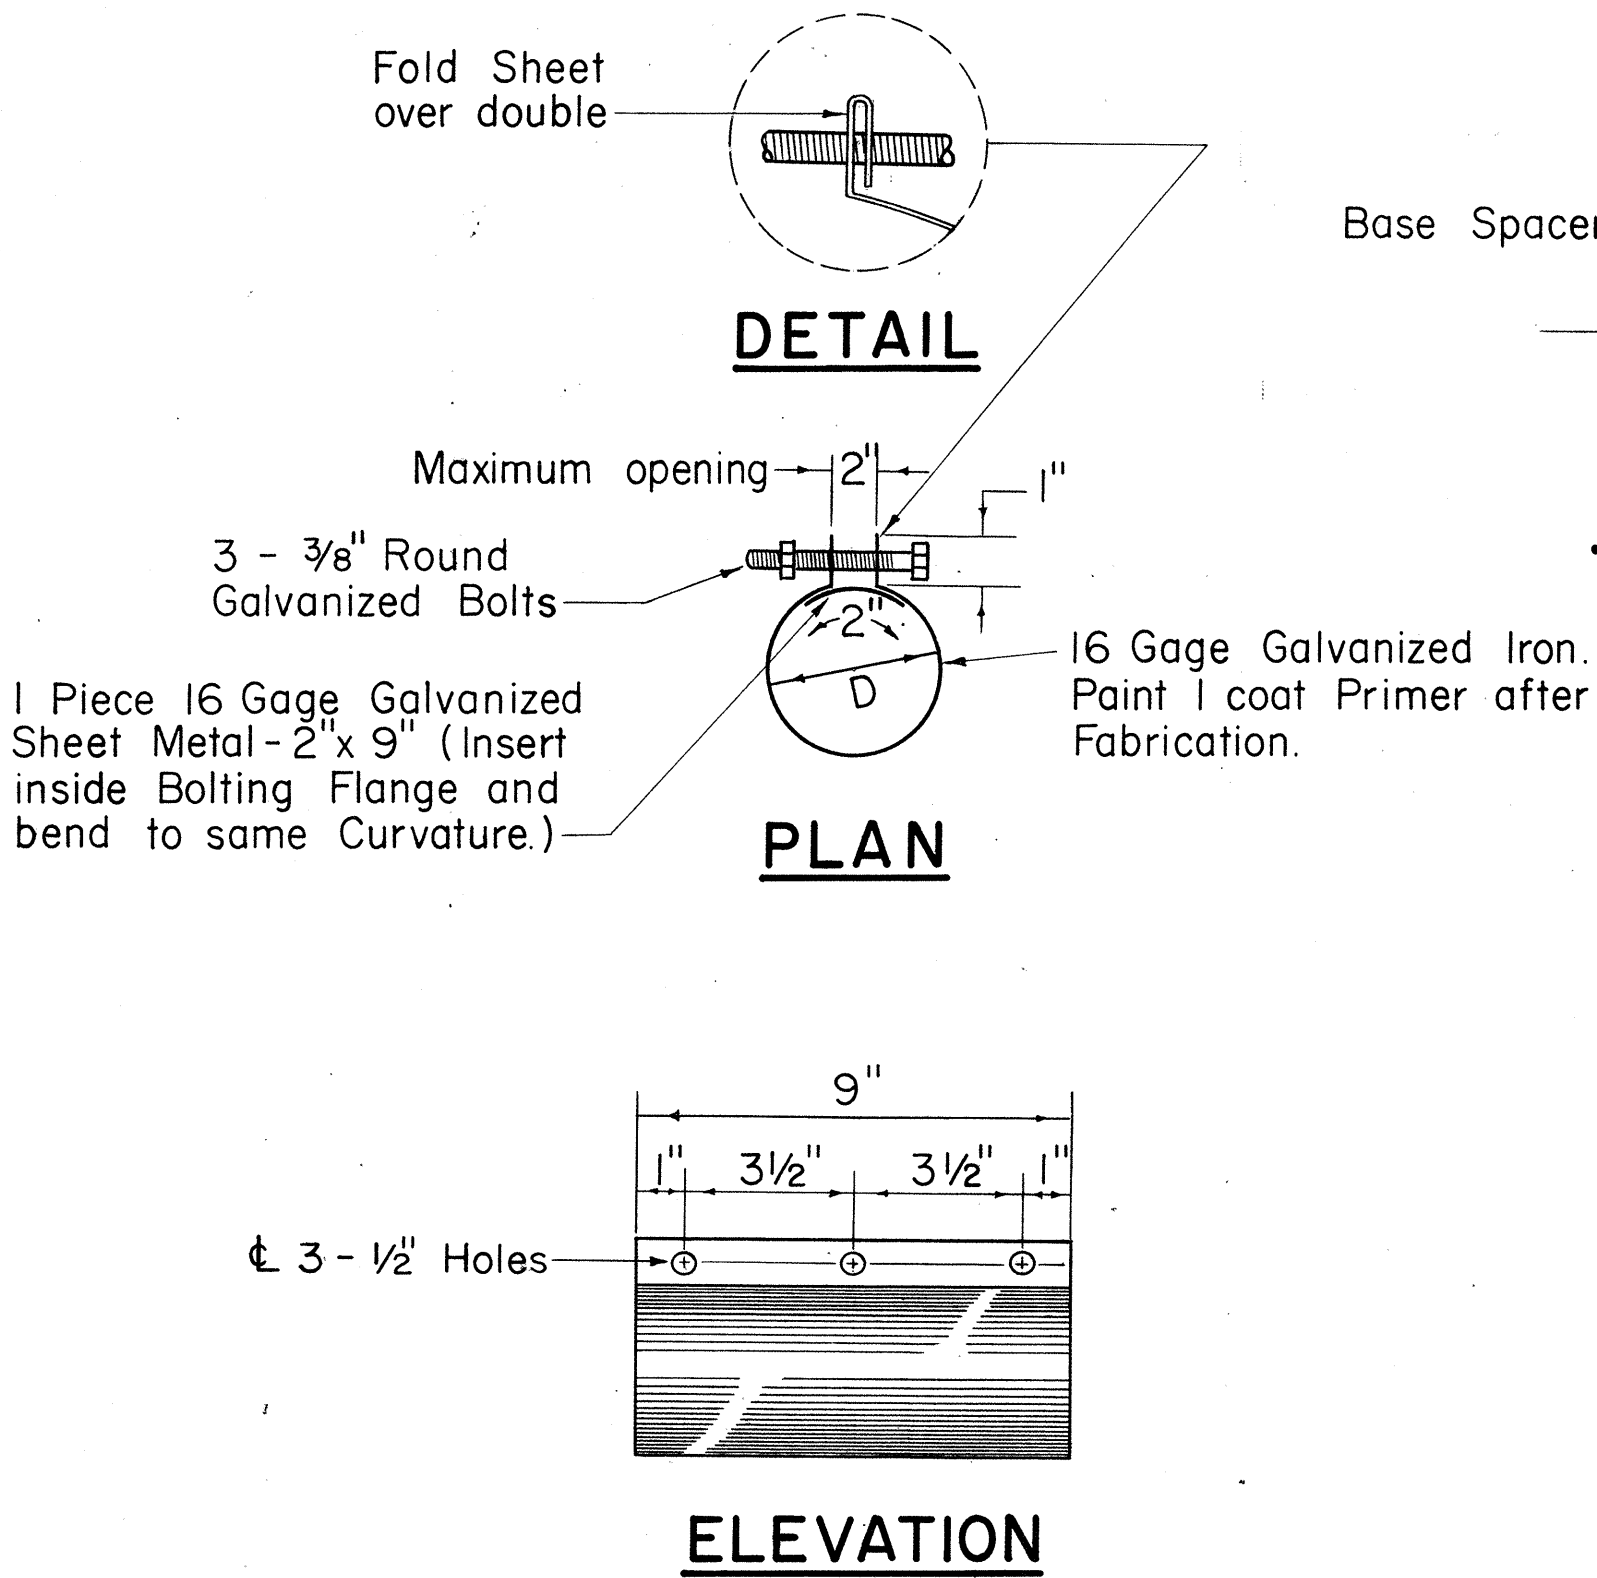

3 BOLT CLAMP DETAIL
Scale: 3" = 1'-0"

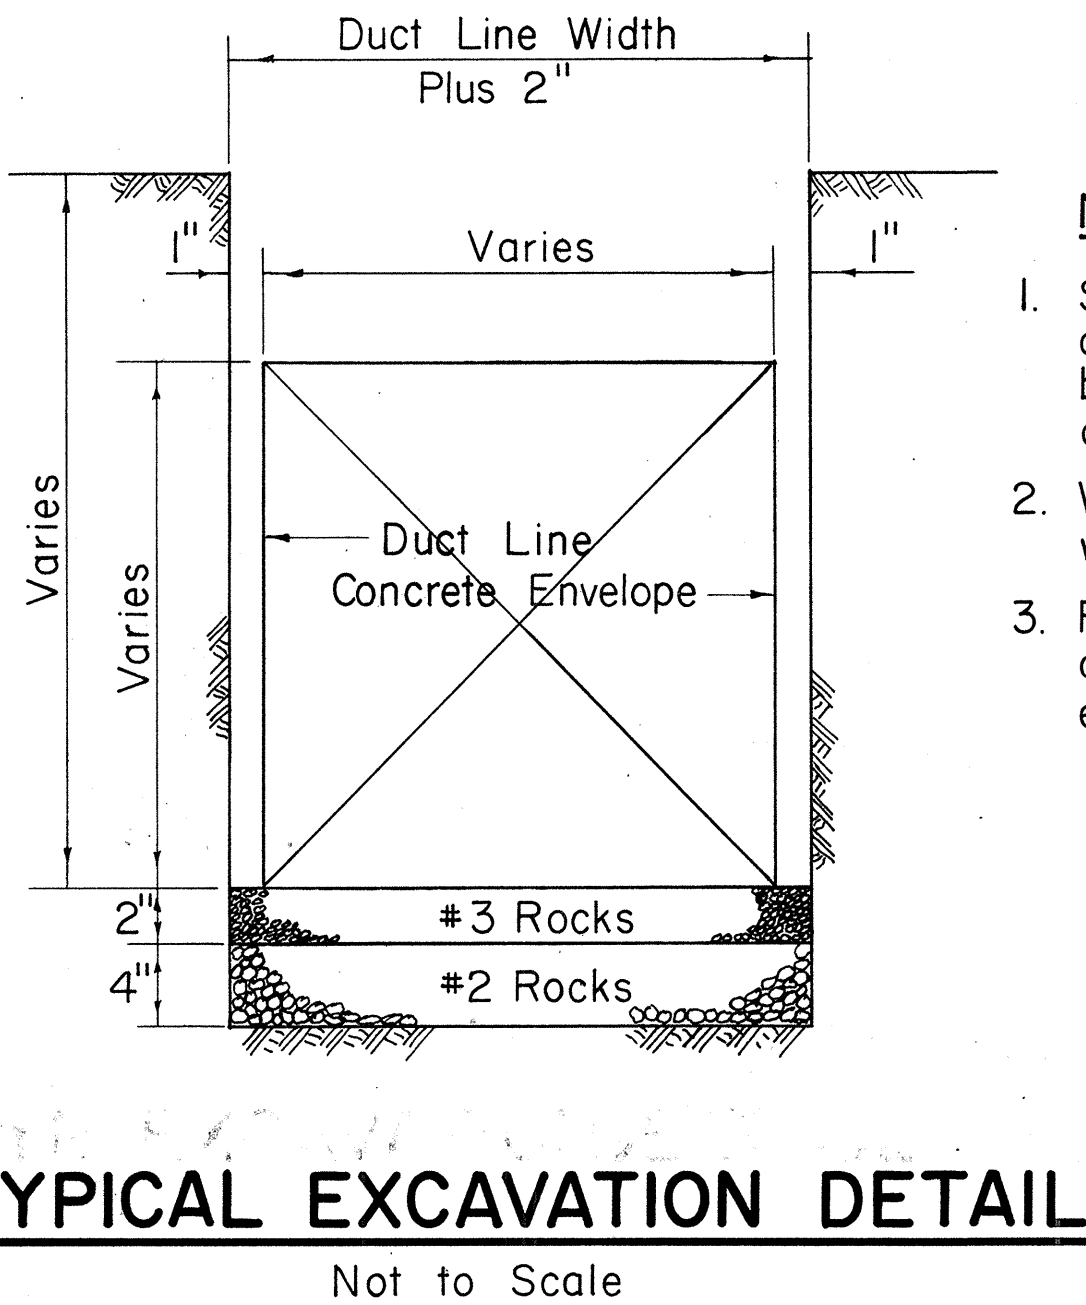

TYPICAL EXCAVATION DETAIL
Not to Scale

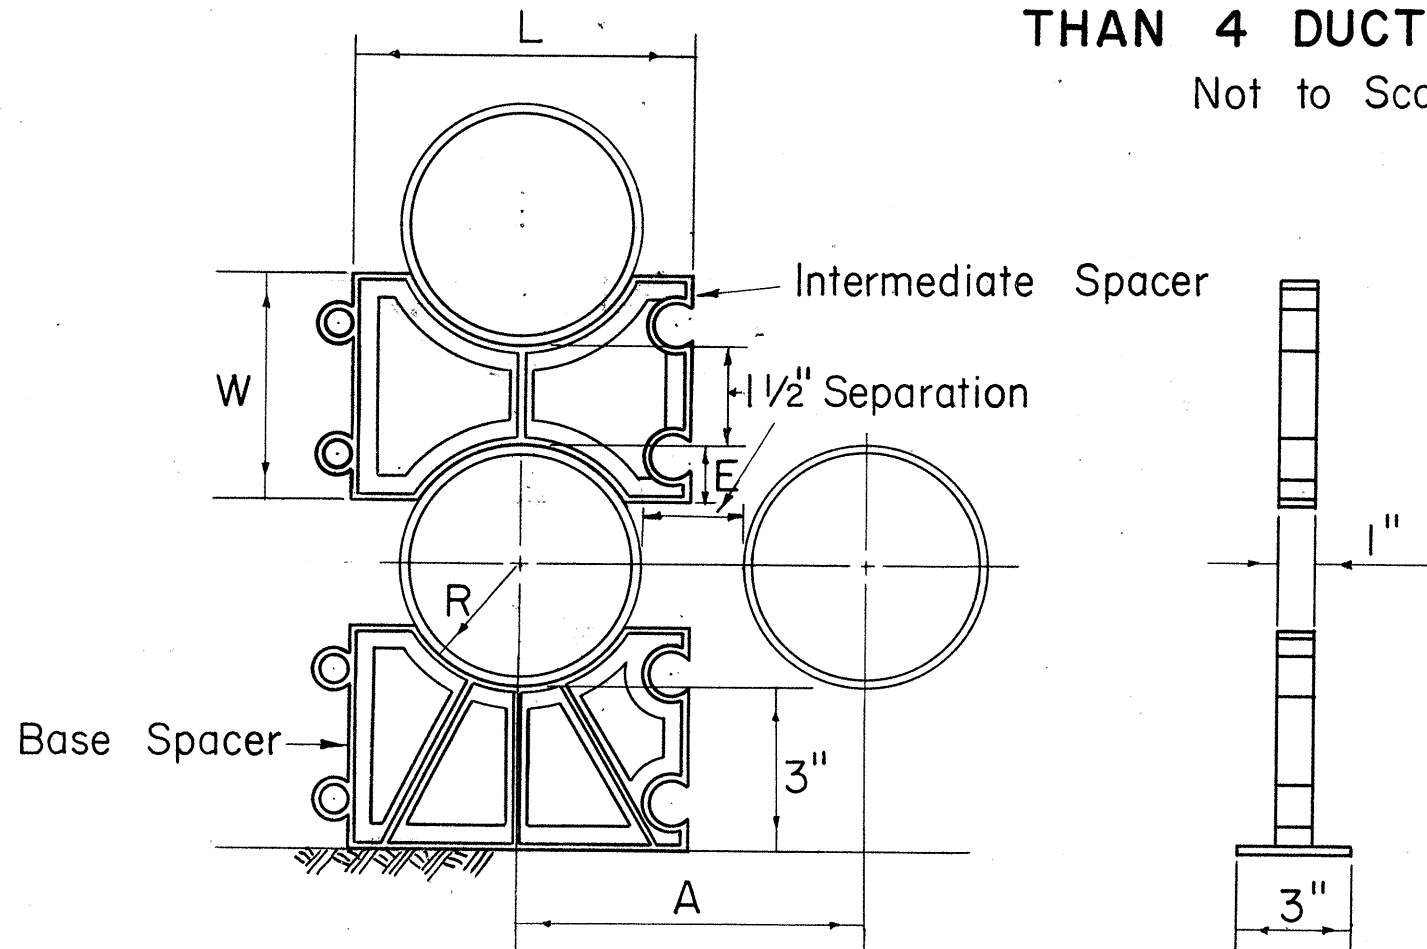


TYPICAL PLASTIC SPACERS
Not to Scale


SIZE	R	E	W	A	L
3"	1 27/32"	7/8"	3 1/4"	5 1/8"	5"
4"	2 13/32"	1 1/8"	3 3/4"	6 1/4"	6 1/8"
4 1/2"	2 23/32"	1 1/4"	4"	6 7/8"	6 3/4"
5"	3 1/16"	1 3/8"	4 1/4"	7 5/8"	7 1/2"

For 1 1/2" Separation


- NOTES**
1. Size of Concrete Envelope and Depth of Excavation to be determined by Project concerned.
 2. Widen Trench Excavation when Forms are used.
 3. Rock Foundation required only when Water is encountered.

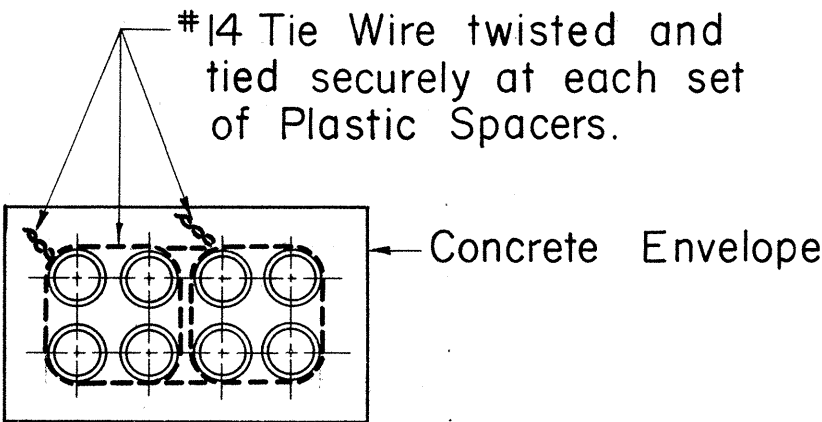

TIE WIRE DETAIL
FOR DUCT LINE MORE THAN 4 DUCTS WIDE
Not to Scale

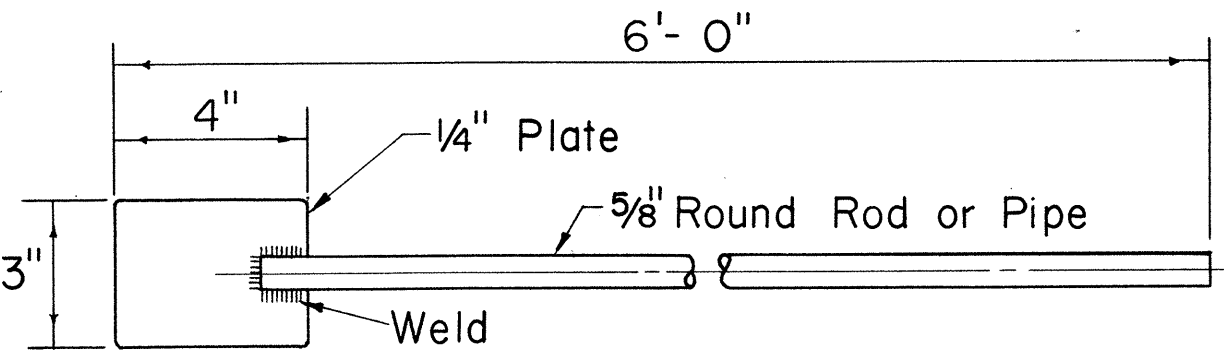

CONCRETE DUCT ENVELOPE TAMPING ROD
Scale: 3" = 1'-0"

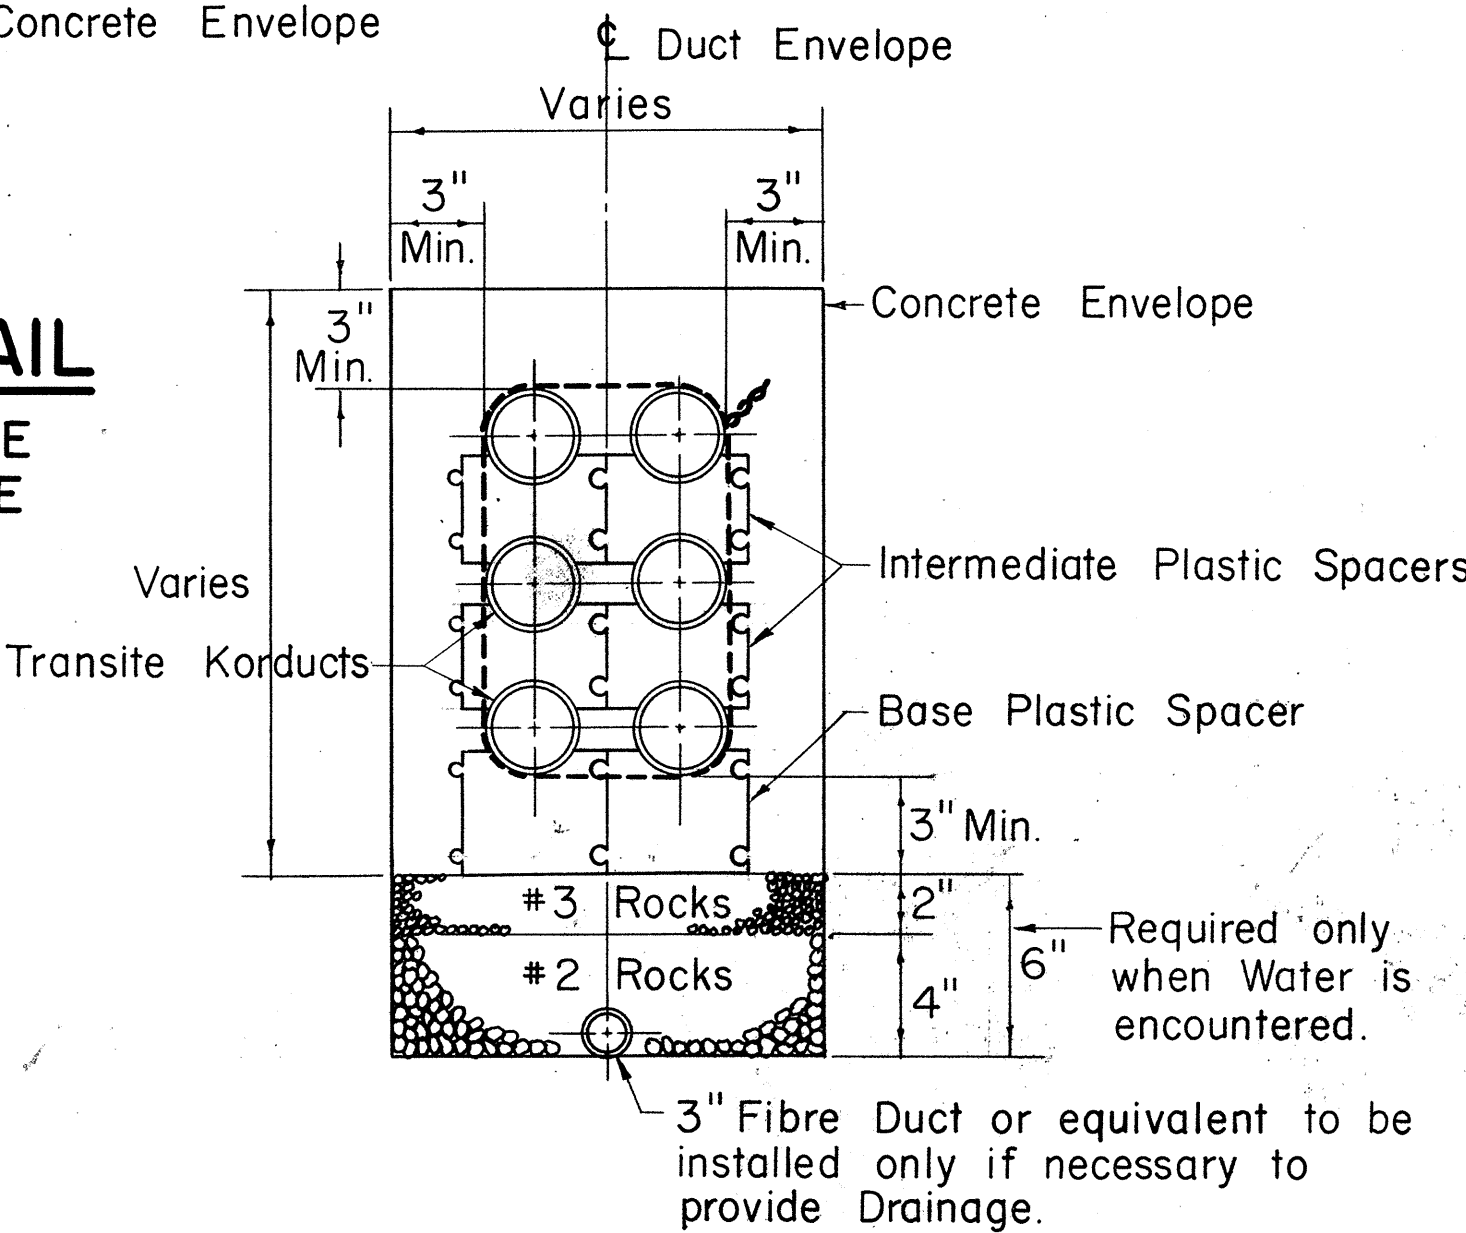


TYPICAL DUCT PLASTIC SPACERS & DRAINAGE SECTION
(6 WAY DUCT SHOWN - 3 HIGH - 2 WIDE)
Not to Scale

APPROVED:
A. Henderson
HAWAIIAN ELECTRIC CO., INC. DATE 8-20-68

HECo., Inc. Drawing Number	
18585	SHEET No. 1 OF 2 SHEETS
STATE OF HAWAII DEPARTMENT OF TRANSPORTATION HIGHWAYS DIVISION	
STANDARD DETAILS	
CONSTRUCTION STANDARDS TRANSITE KORDUCTS UNDERGROUND DUCT LINES	
Scales: As Noted	Date: 9/14/68
SHEET NO. 12 OF 17 SHEETS	


FED. AID DIST. NO.	STATE	FED. AID PROJ. NO.	FISCAL YEAR	SHEET NO.	TOTAL SHEETS
HAWAII	HAWAII	HA-11(16)11	1968	30	68

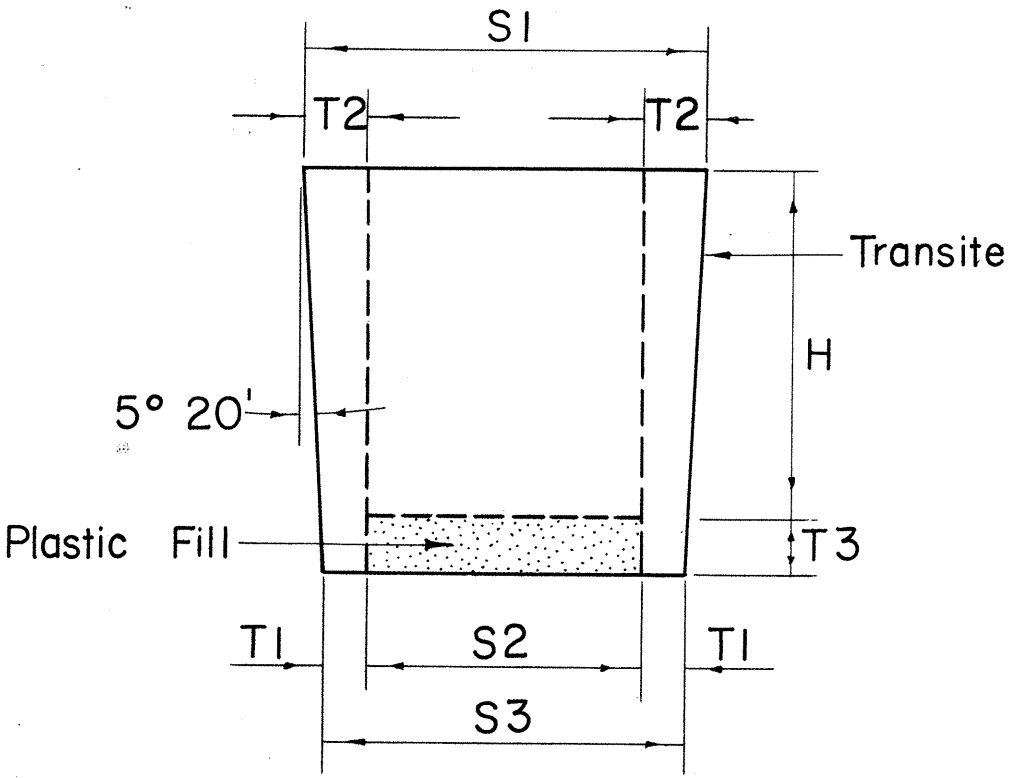

PLUGS FOR TRANSITE KORDUCTS

Not to Scale

SIZE	H	S1	S2	S3	T1	T2	T3
3"	4"	3 3/8"	2"	2 5/8"	5 1/16"	11 1/16"	3 3/4"
4"	4 1/2"	4 27/64"	2 3/4"	3 37/64"	13 3/32"	27 3/32"	3 3/4"
4 1/2"	4 1/2"	4 59/64"	3"	4 5/64"	35 3/64"	31 3/32"	3 3/4"
5"	4 1/2"	5 27/64"	3 1/2"	4 37/64"	35 3/64"	31 3/32"	3 3/4"

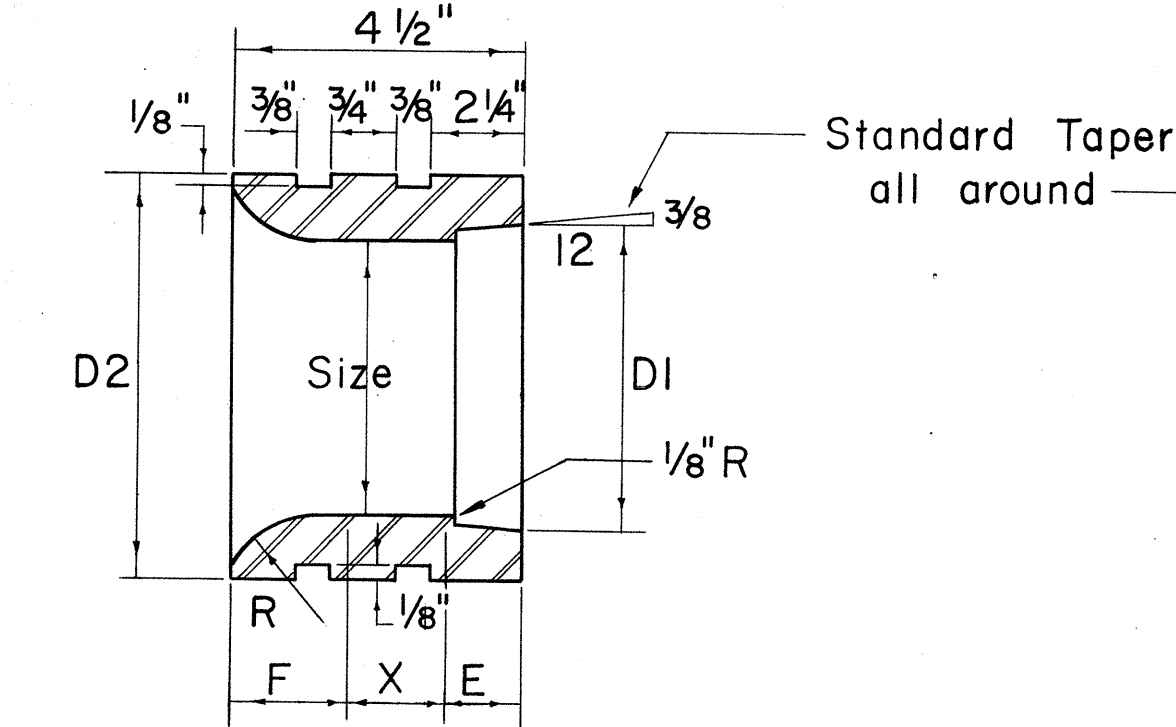


JUNIOR END BELLS

Not to Scale

SIZE	D1	D2	F	X	E	R
3"	3 25/64"	4 1/2"	1 11/32"	29 3/32"	1 1/4"	3 3/4"
4"	4 25/64"	5 3/4"	1 9/16"	19 1/16"	1 3/8"	2"
4 1/2"	4 57/64"	6 1/4"	1 9/16"	19 1/16"	1 3/8"	2"
5"	5 29/64"	7"	1 9/16"	17 1/16"	1 1/2"	2"


Note "X"
Provide one set of Spacers
(a) 10 Ft. straight run for 4 Ducts high or less.
(b) 5 Ft. straight run for 5 Ducts high or more.

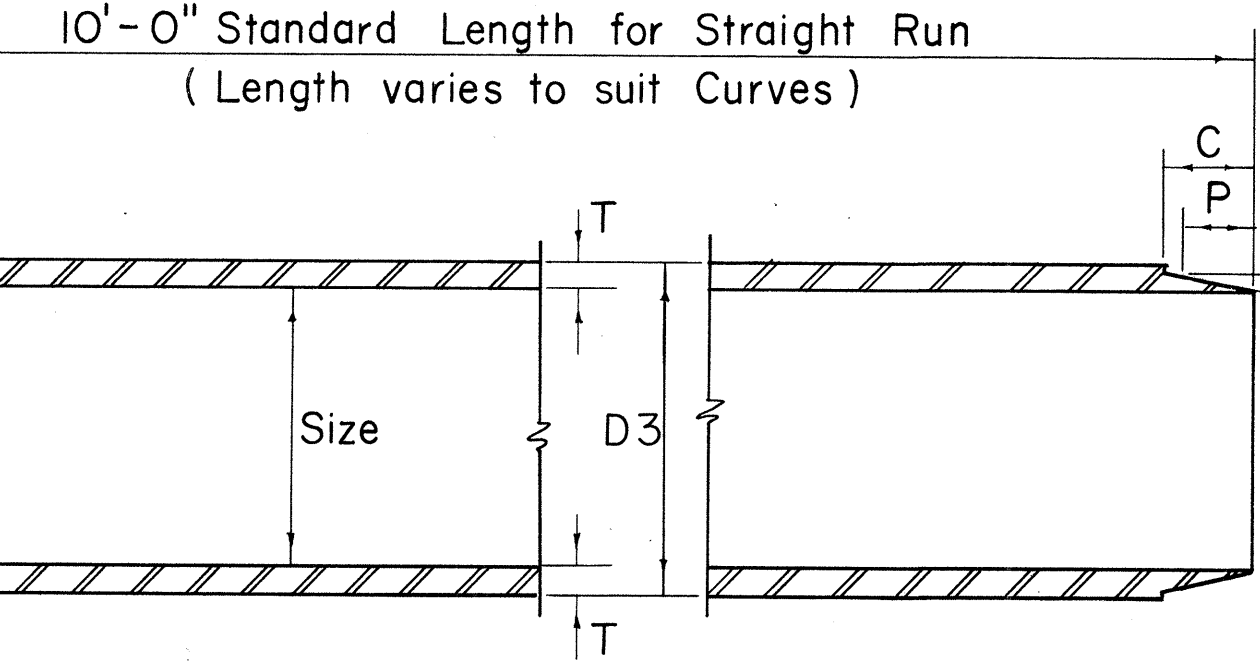

TRANSITE KORDUCTS

Not to Scale


SIZE	D1	D3	C	P	T
3"	3 25/64"	3 35/64"	1 1/8"	7 7/8"	17 1/64"
4"	4 25/64"	4 35/64"	1 1/4"	1"	17 1/64"
4 1/2"	4 57/64"	5 3/64"	1 1/4"	1"	17 1/64"
5"	5 29/64"	5 39/64"	1 5/8"	1 1/8"	19 1/64"

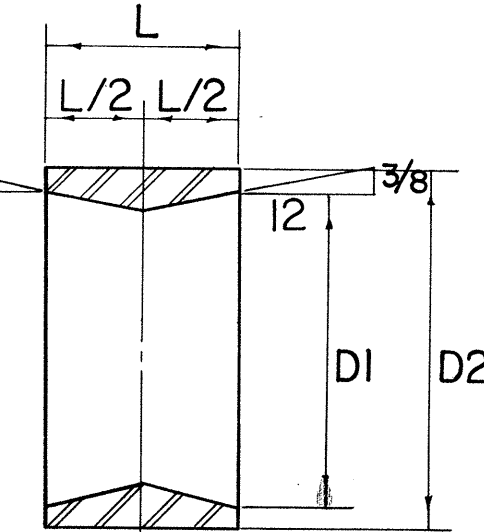

TAPERED COUPLINGS


Not to Scale

SIZE	D1	D2	L
3"	3 25/32"	4 11/64"	2 1/4"
4"	4 25/64"	5 3/16"	2 1/2"
4 1/2"	4 57/64"	5 49/64"	2 1/2"
5"	5 29/64"	6 21/64"	2 3/4"

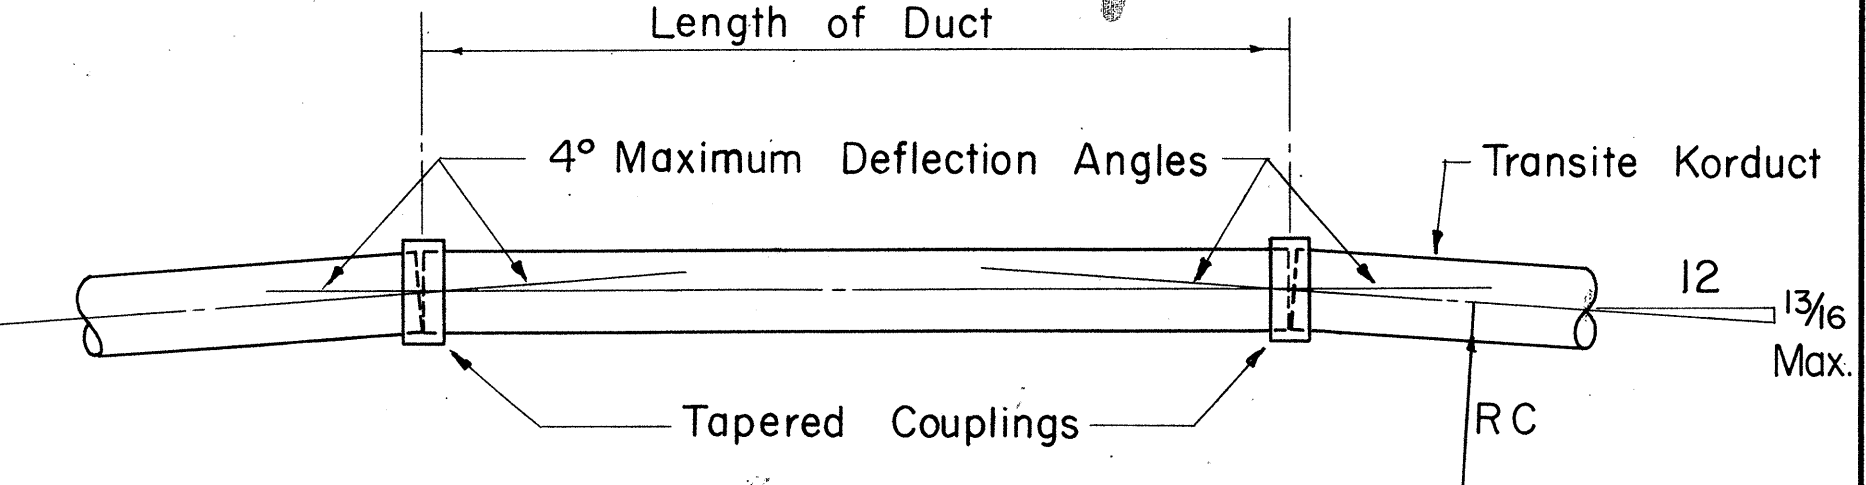

METHOD OF FORMING CURVES


Not to Scale

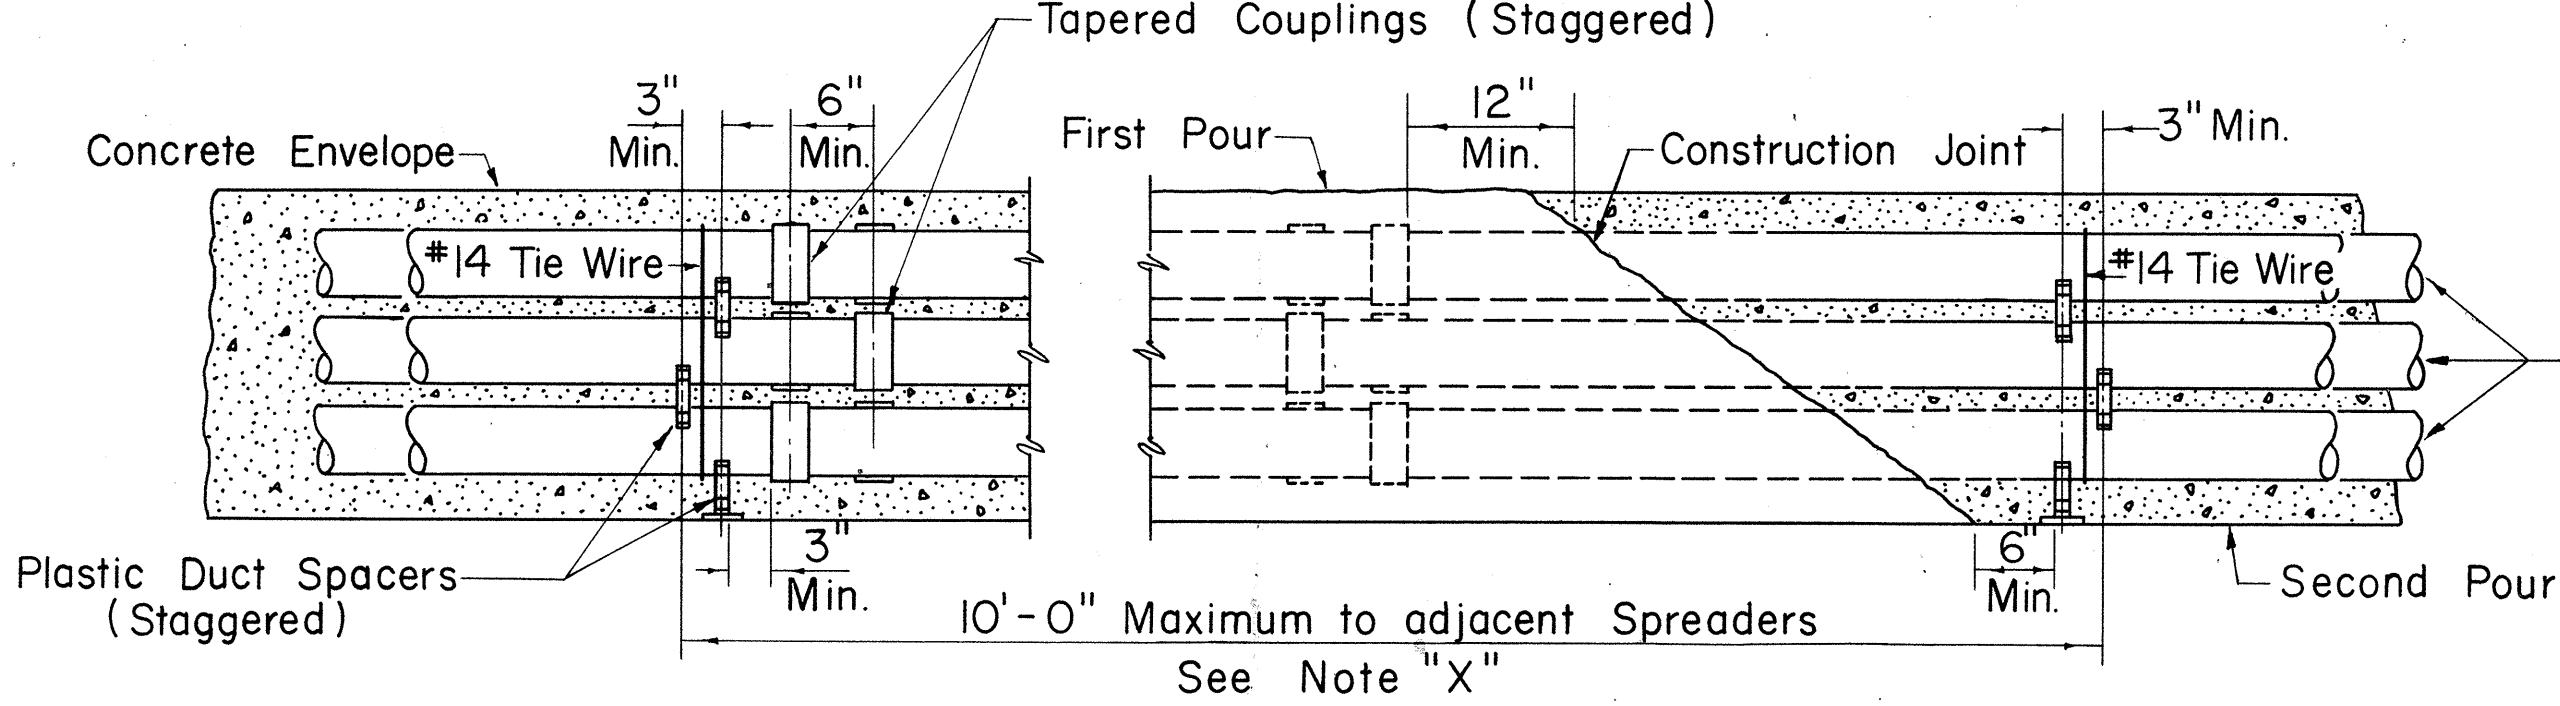

TYPICAL DUCT ENVELOPE ELEVATION

(6 WAY DUCT LINE SHOWN)


Not to Scale

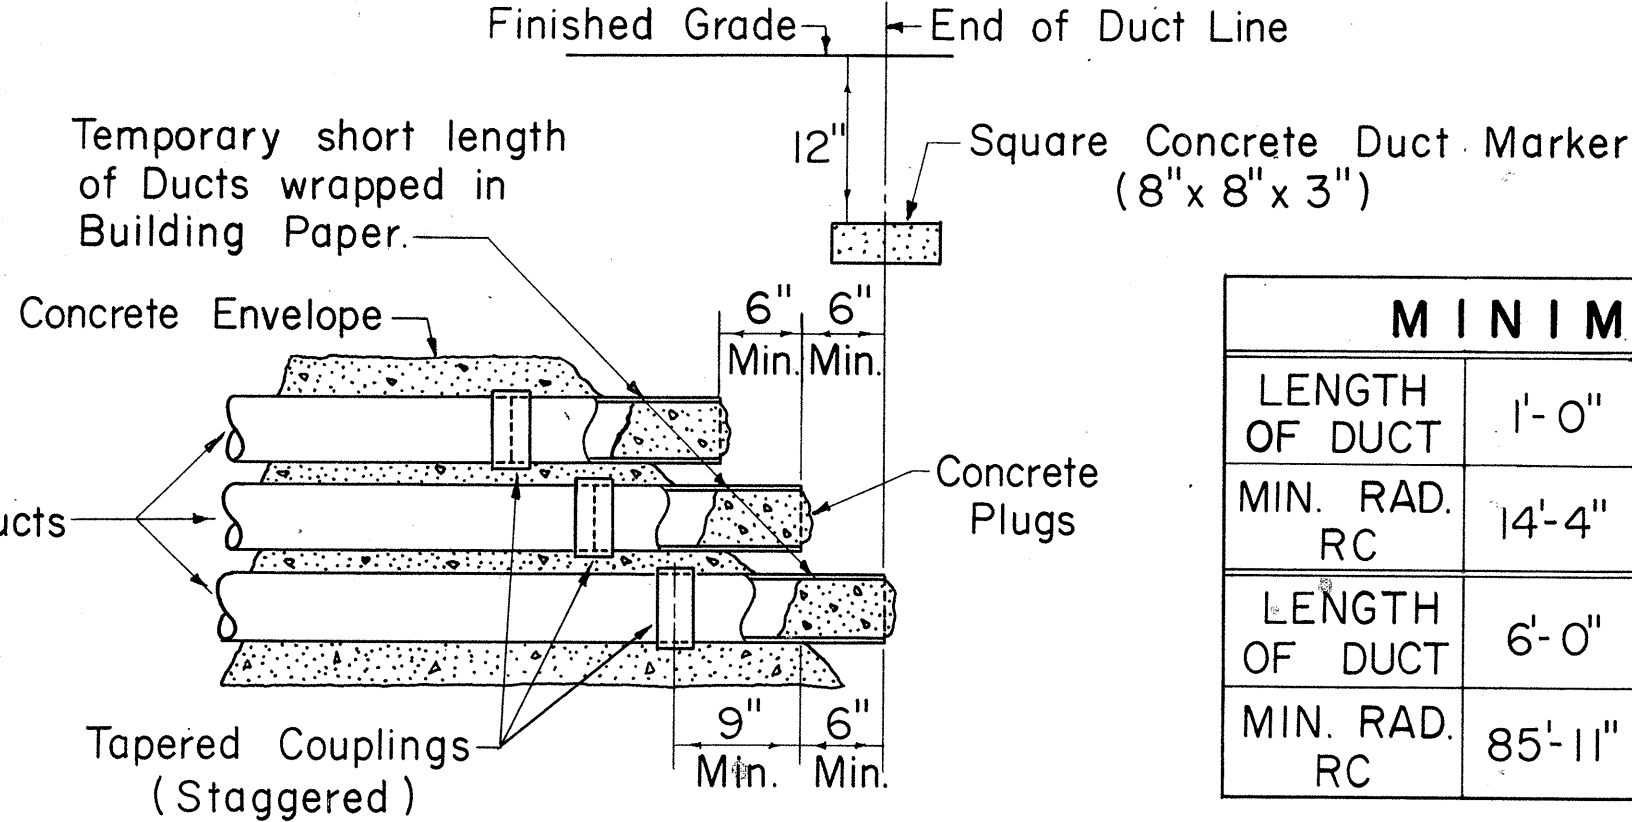

TYPICAL STUB OUT DETAIL


Not to Scale

	MINIMUM RADIUS TO FORM CURVES									
LENGTH OF DUCT	1'-0"	1'-6"	2'-0"	2'-6"	3'-0"	3'-6"	4'-0"	4'-6"	5'-0"	5'-6"
MIN. RAD. RC	14'-4"	21'-6"	28'-8"	35'-10"	42'-11"	50'-1"	57'-3"	64'-5"	71'-7"	78'-9"
LENGTH OF DUCT	6'-0"	6'-6"	7'-0"	7'-6"	8'-0"	8'-6"	9'-0"	9'-6"	10'-0"	
MIN. RAD. RC	85'-11"	93'-1"	100'-3"	107'-5"	114'-7"	121'-8"	128'-10"	136'-0"	143'-2"	

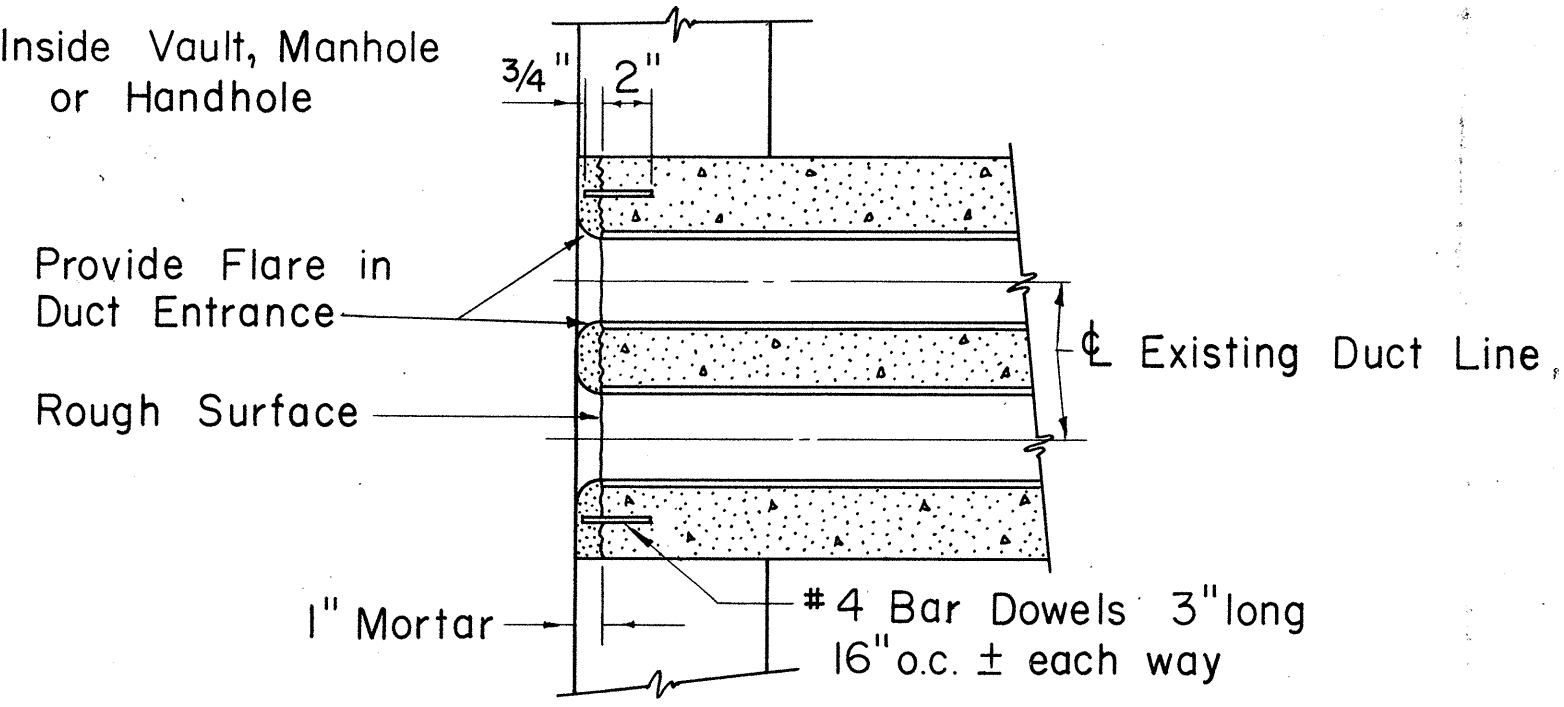

DUCT LINE ENTRANCE AT EXISTING DUCT LINE

Scale: 1 1/2" = 1'-0"

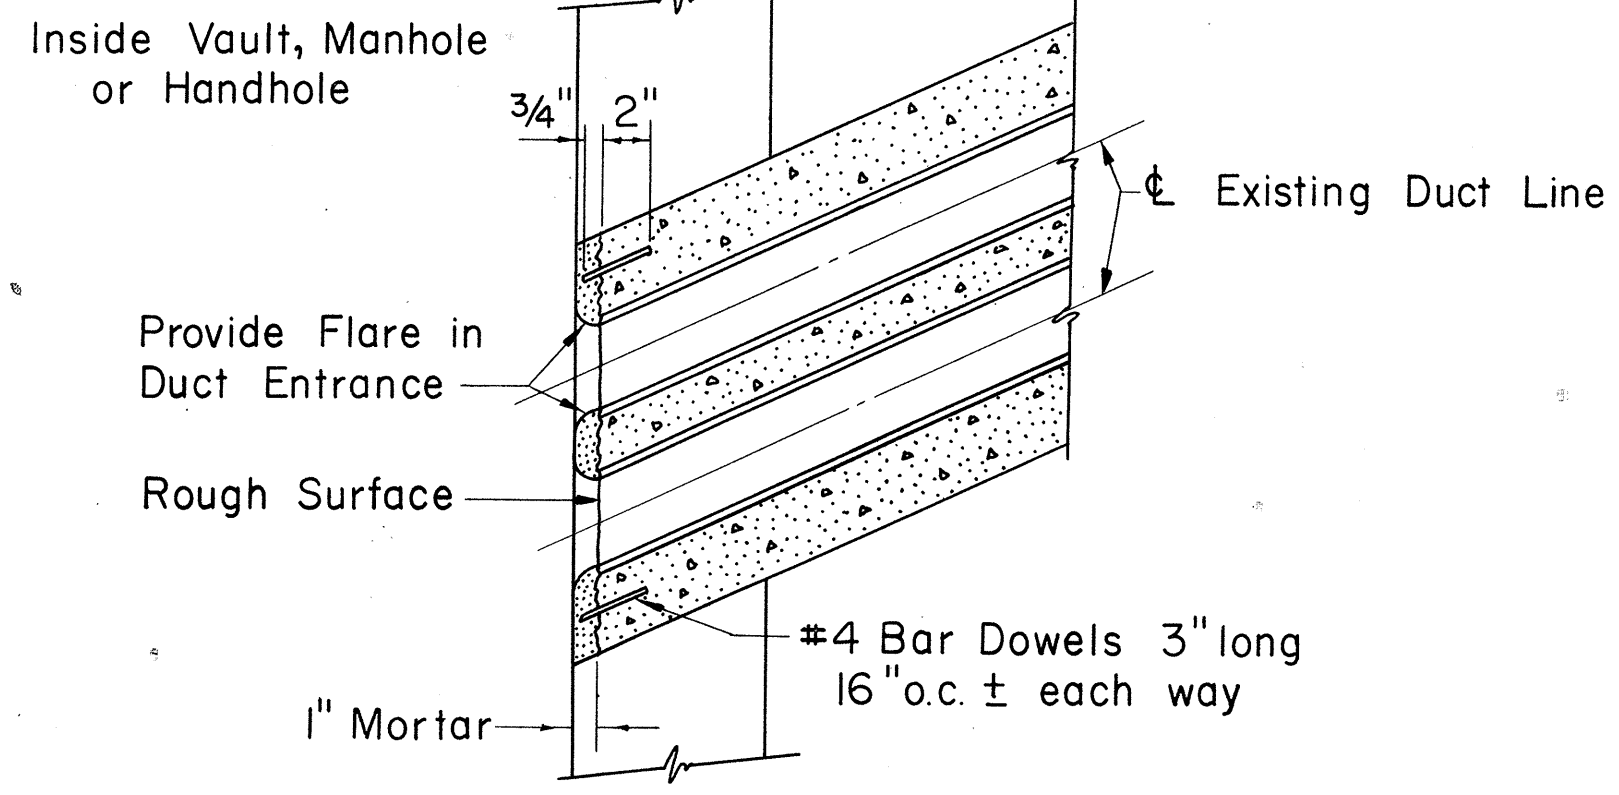

DUCT LINE DIAGONAL ENTRANCE

Scale: 1 1/2" = 1'-0"

APPROVED:
R. Henderson 8-20-68
HAWAIIAN ELECTRIC CO., INC. DATE

HECo., Inc. Drawing Number
18585

SHEET No. 2
OF 2 SHEETS

STATE OF HAWAII
DEPARTMENT OF TRANSPORTATION
HIGHWAYS DIVISION
STANDARD DETAILS
CONSTRUCTION STANDARDS
TRANSITE KORDUCTS
UNDERGROUND DUCT LINES

Scales: As Noted
Date 8/14/68

FED. AID DIST. NO.	STATE	FED. AID PROJ. NO.	FISCAL YEAR	SHEET NO.	TOTAL SHEETS
HAWAII	HAWAII	7-HI-1(63)-11 7-HI-1(16)-11	1968	31	28

CREOSOTED DOUGLAS FIR & YELLOW PINE POLE DATA									
LENGTH IN FEET	CLASS	APPROX. MINIMUM DIMENSIONS (INCHES)				AVERAGE WEIGHT (LBS.)	POLE SETTING DEPTH (FT.)		BREAKING LOAD 2'-0" BELOW TOP OF POLE (LBS.)
		AT TOP		6' FROM BUTT			DOUGLAS FIR	IN SOIL	
		DIA.	CIR.	DIA.	CIR.				
25	5	6.04	19	8.26	26	525	4.5	3	1900
30	3	7.32	23	10.32	32.5	810	5	3.5	3000
	5	6.04	19	8.90	28	600	5	3.5	1900
35	2	7.96	25	12.23	37.5	1260	5	3.5	3700
	5	6.04	19	9.55	30	770	5	3.5	1900
40	3	7.32	23	11.77	37	1320	5.5	3.5	3000
45	2	7.96	25	13.20	41.5	1845	6	4	3700
	3	7.32	23	12.25	38.5	1575	6	4	3000
50	2	7.96	25	13.70	43	2150	6.5	4	3700
	3	7.32	23	12.70	40	1850	6.5	4	3000
55	1	8.59	27	15.11	47.5	2860	7	4.5	4500
	2	7.96	25	14.15	44.5	2475	7	4.5	3700
	3	7.32	23	13.20	41.5	2145	7	4.5	3000
60	1	8.59	27	15.75	49.5	3360	7	4.5	4500
	2	7.96	25	14.62	46	2820	7	4.5	3700
65	1	8.59	27	16.20	51	3835	7.5	5	4500
	2	7.96	25	15.11	47.5	3250	7.5	5	3700
70	1	8.59	27	16.70	52.5	4340	7.5	5	4500
	2	7.96	25	15.60	49	3640	7.5	5	3700
75	1	8.59	27	17.20	54	4800	8	5.5	4500
	2	7.96	25	16.05	50.5	4050	8	5.5	3700
80	1	8.59	27	17.50	55	5240	8	6	4500
	2	7.96	25	16.40	51.5	4400	8	6	3700
85	1	8.59	27	18.00	56.5	5780	8.5	6.5	4500
	2	7.96	25	16.88	53	4930	8.5	6.5	3700
90	1	8.59	27	18.30	57.5	6300	8.5	6.5	4500
	2	7.96	25	17.20	54	5400	8.5	6.5	3700

NOTE:
The ultimate fiber stress for creosoted Southern Yellow Pine & Douglas Fir is 7,400 Lbs. per square inch.
Weights are for untreated poles. Add 5% as estimate of added weight of creosote treatment.

REFERENCES:
American Standards Association 05.4-1941, 05.6-1945.
Standard Handbook for Electrical Engineers, Eighth Edition
H. E. Co. Specification for Poles.


WOOD POLE DATA

APPROVED:
AD Henderson 8-20-68
HAWAIIAN ELECTRIC Co., Inc. DATE

STATE OF HAWAII
DEPARTMENT OF TRANSPORTATION
HIGHWAYS DIVISION
STANDARD DETAILS
H. E. Co. AND H. T. Co.
SERVICE BOX DETAILS
AND WOOD POLE DATA


Scales: As Noted Date 8/14/68

SHEET NO. 14 OF 17 SHEETS

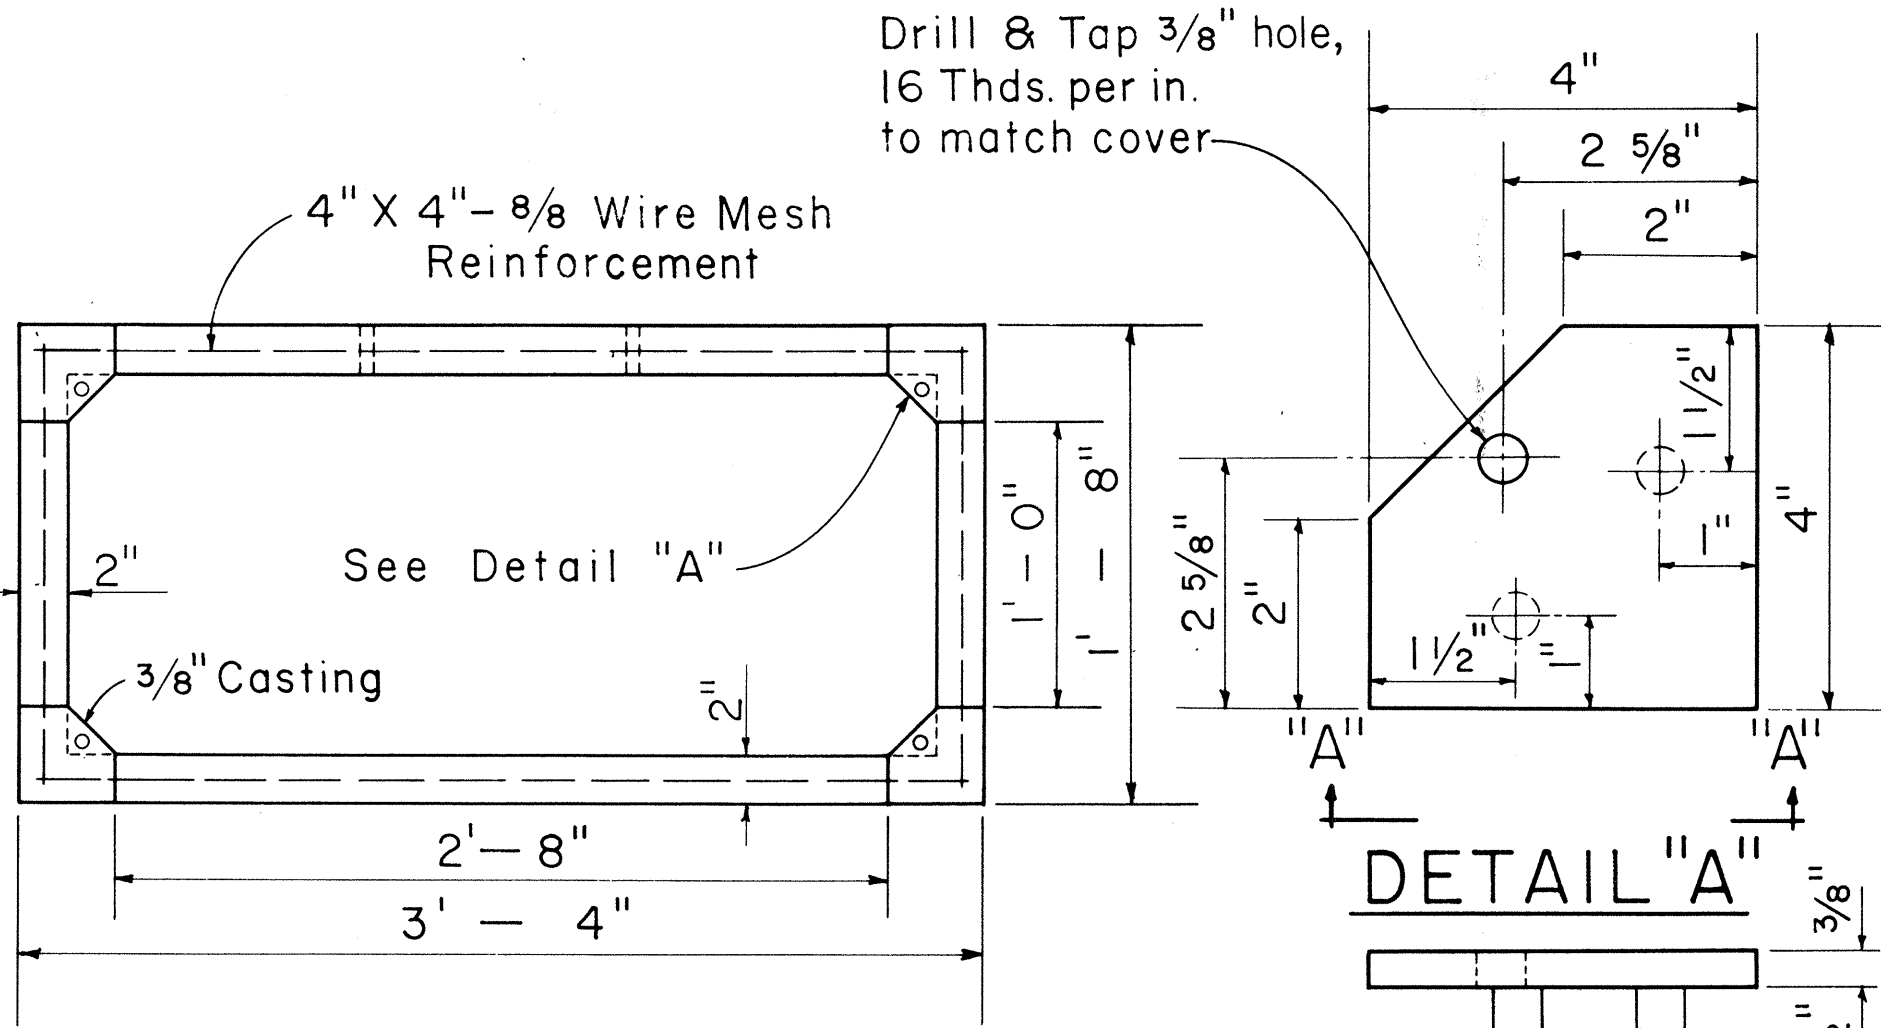


PLAN

SECTION "A-A"

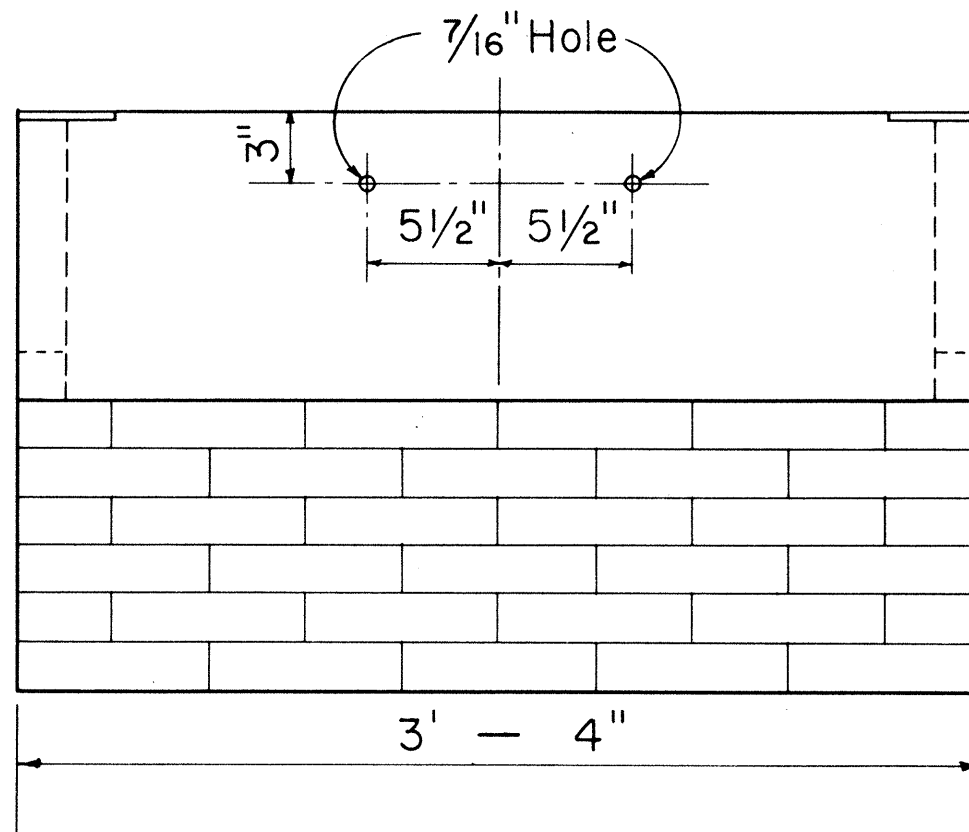


SIDE VIEW

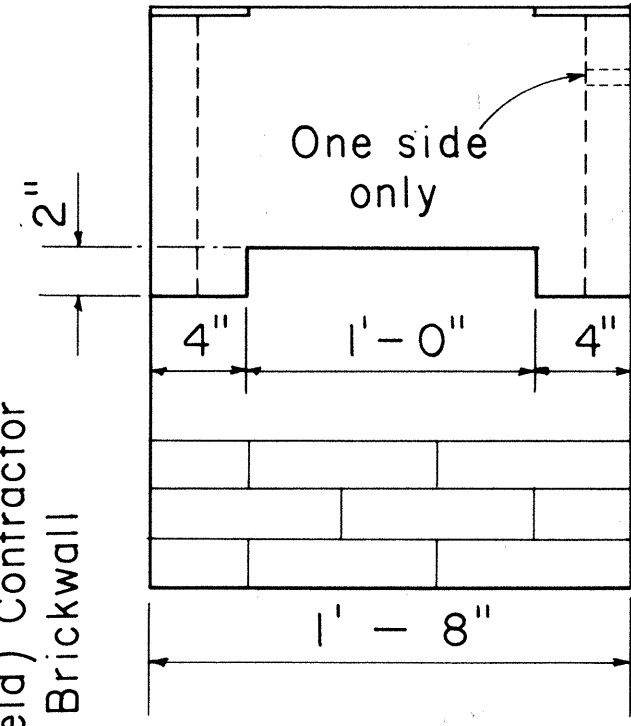

END VIEW

NOTES:
Use 3/8" Plate for driveways.
Concrete Box 225 Lbs.
1/4" Checker Plate 62 Lbs.
Secure cover with 3/8" x 1" flat head brass machine screws.

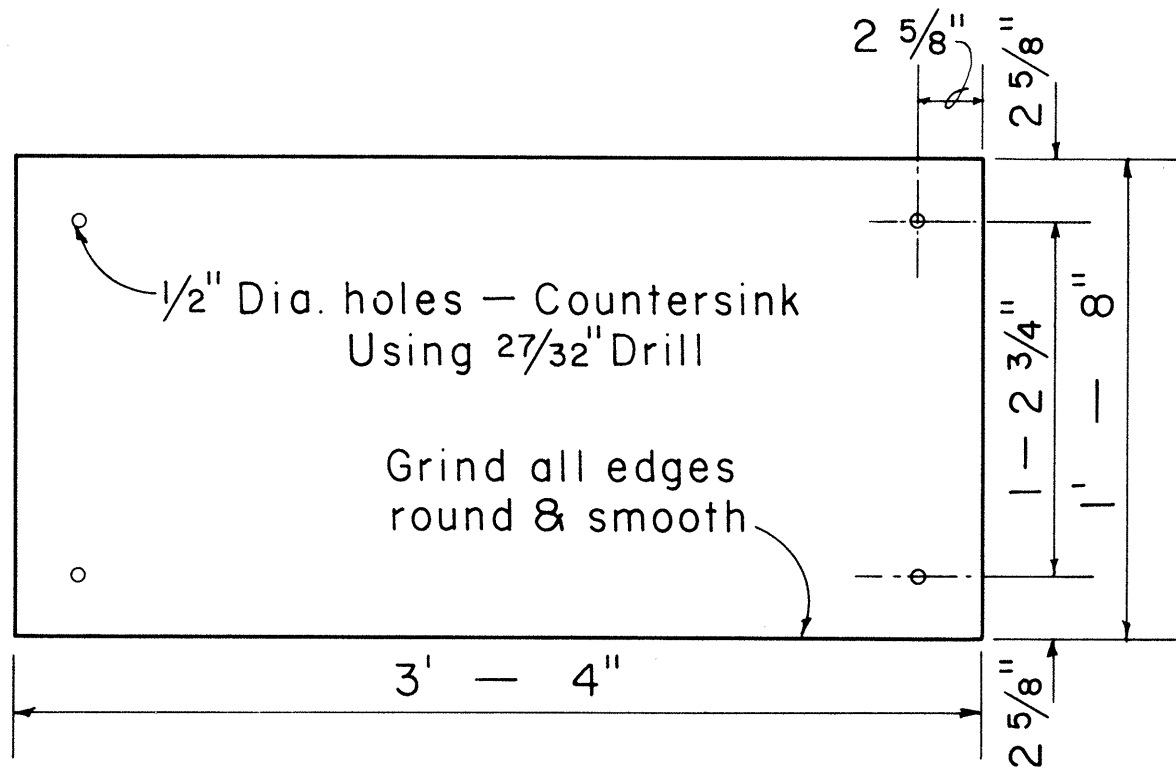


1/4" CHECKER PLATE COVER

(Hot dip galvanize checkered plate after drilling, countersinking, and grinding edge)

1'-4" X 3'-0" CONCRETE SERVICE BOX


Scale: 1 1/2" = 1' - 0"

OII250

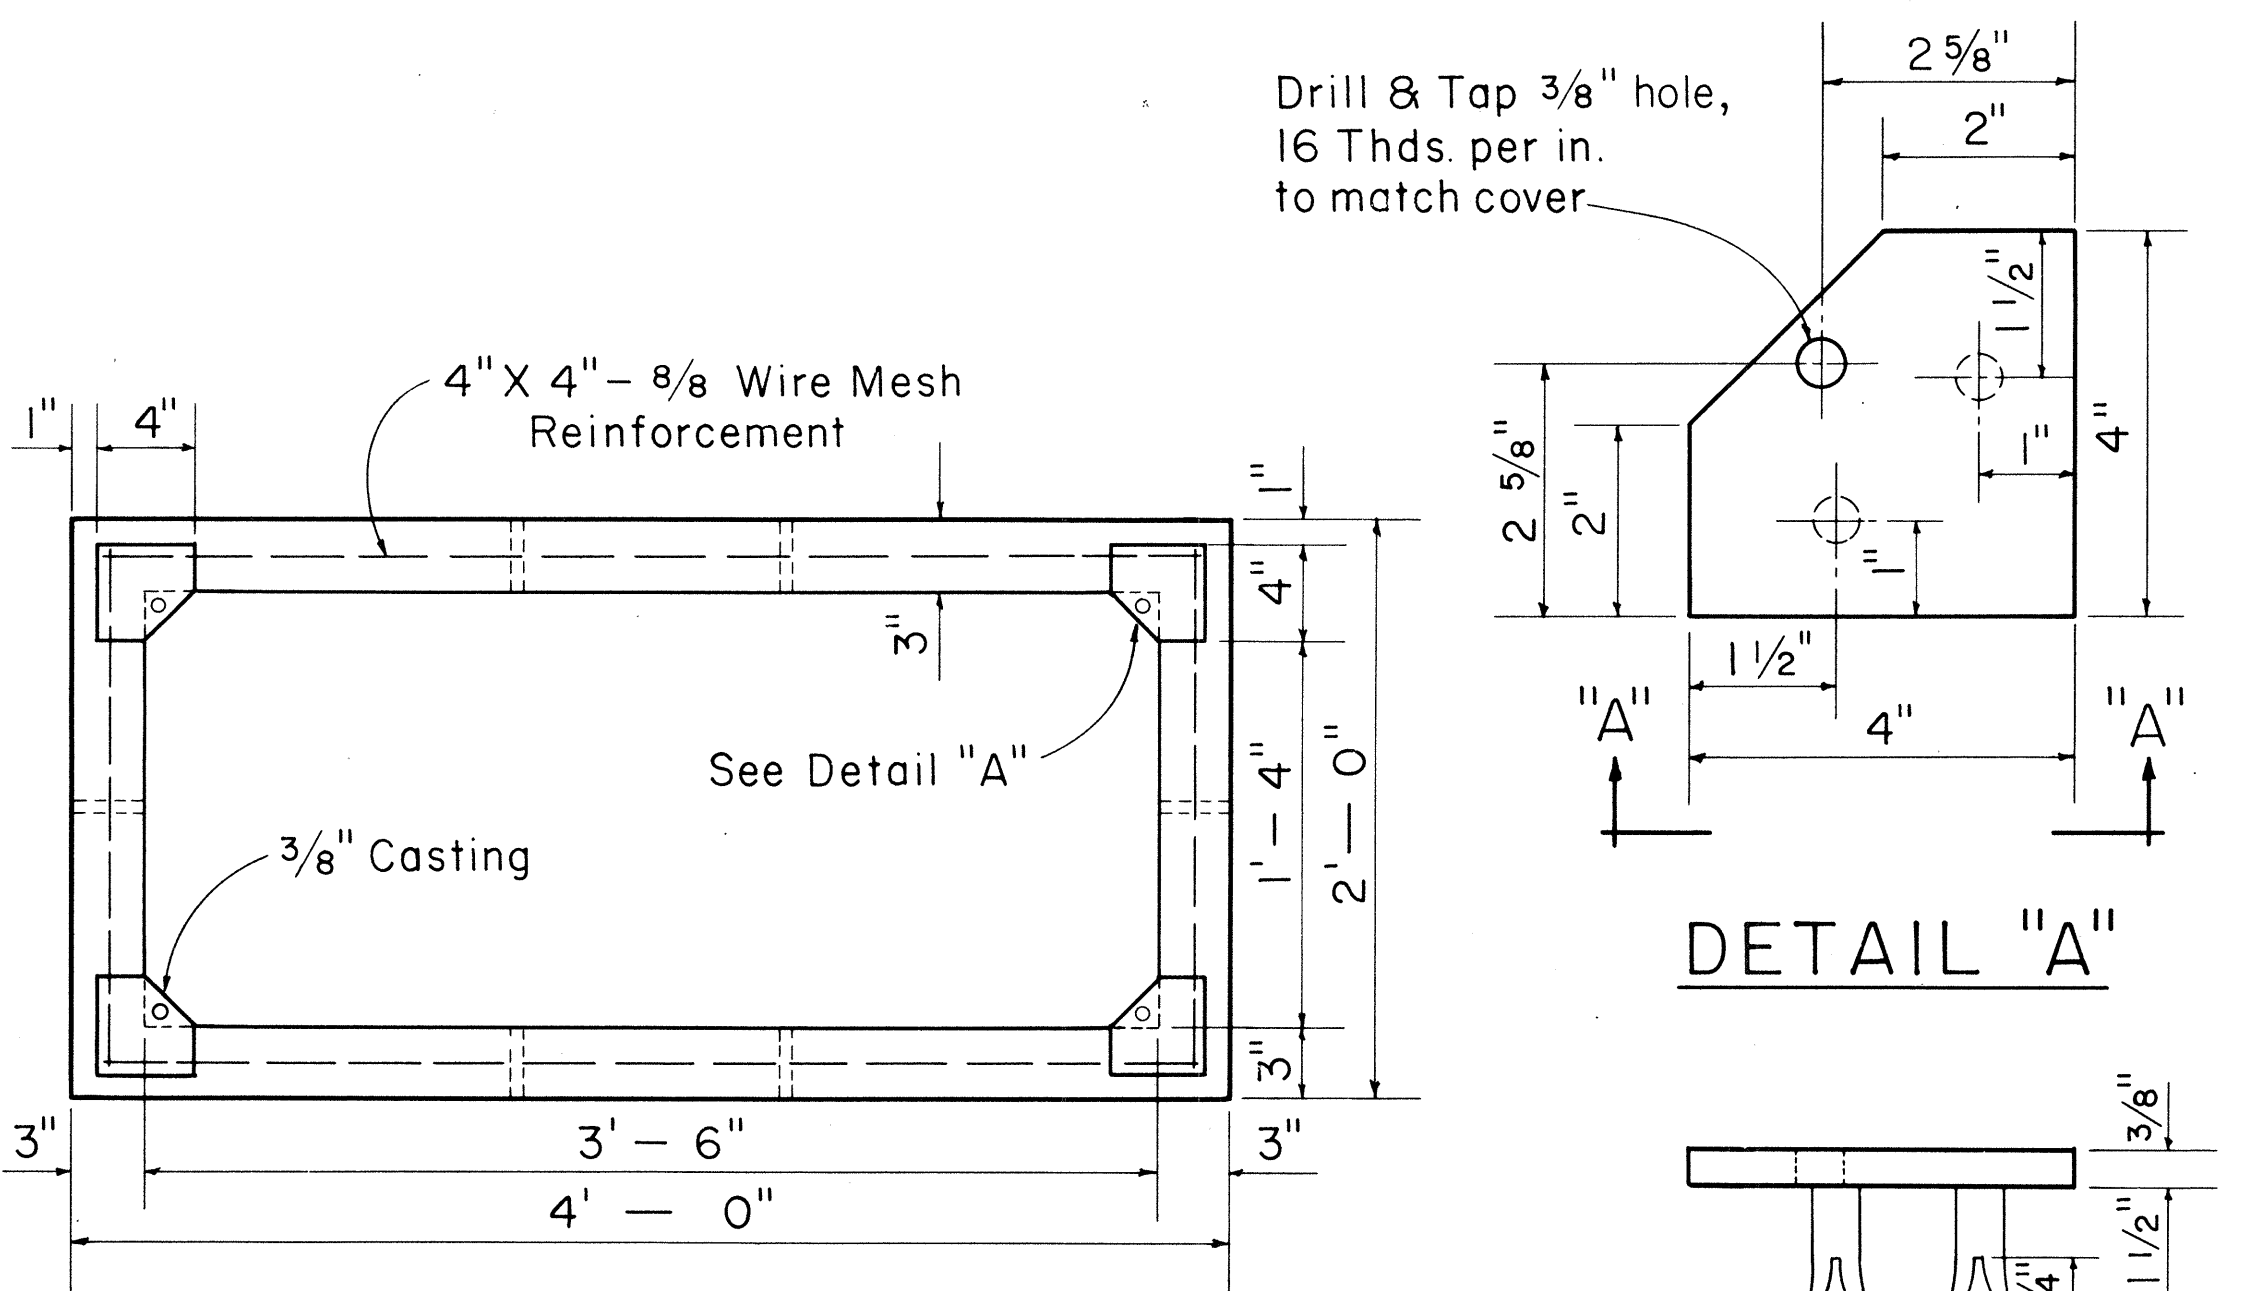


PLAN

SECTION "A-A"

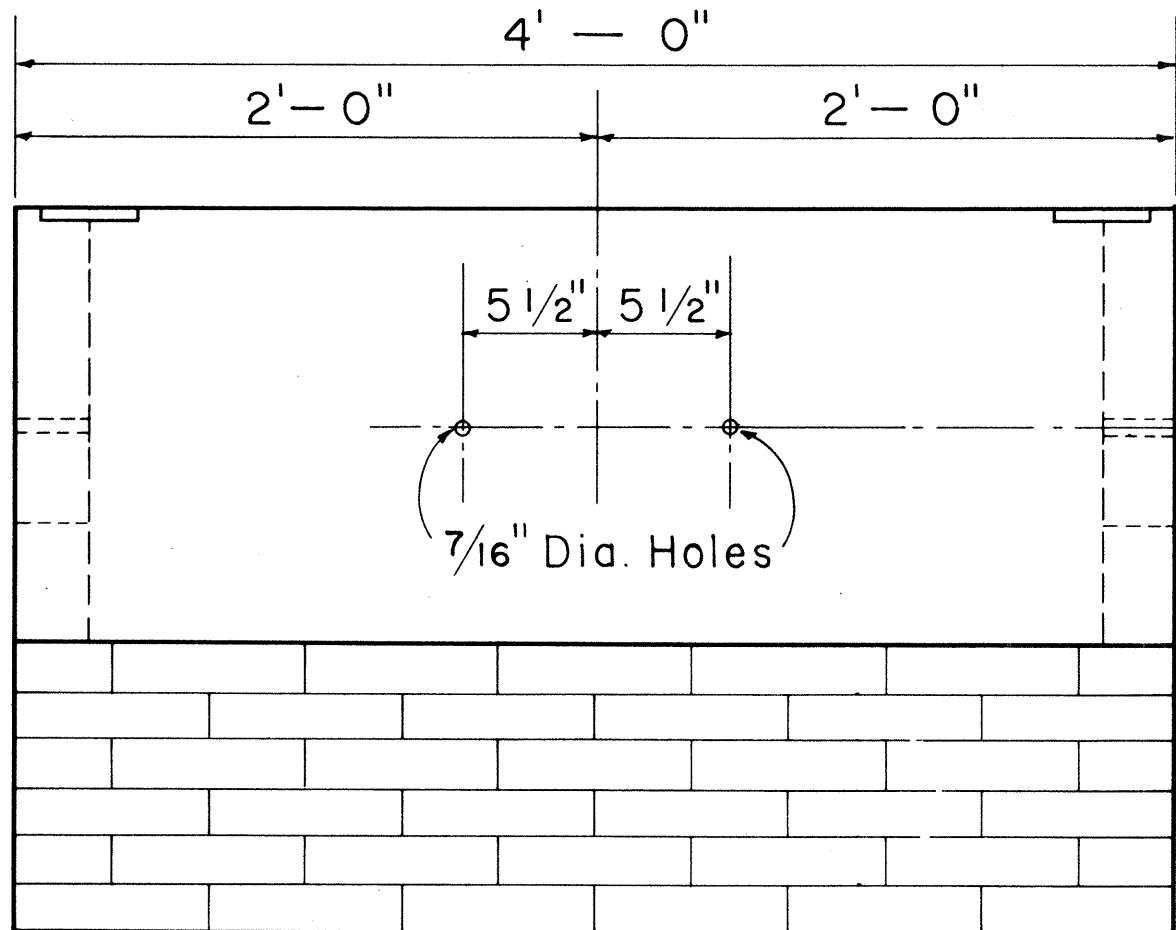


SIDE VIEW

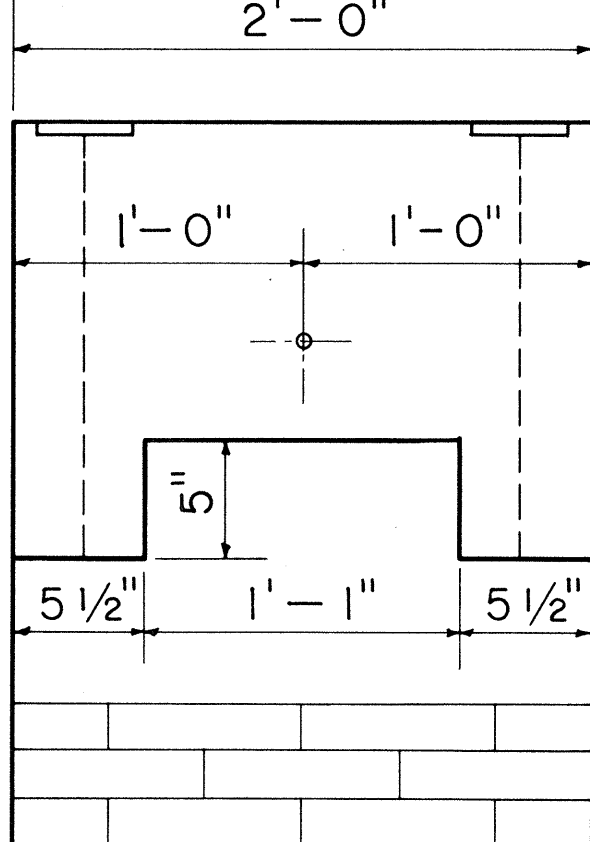

END VIEW

NOTES:
Use 3/8" Plate for driveway.
Concrete Box 575 Lbs.
1/4" Checker Plate 130 Lbs.
Secure cover with 3/8" x 1" flat head brass machine screws.

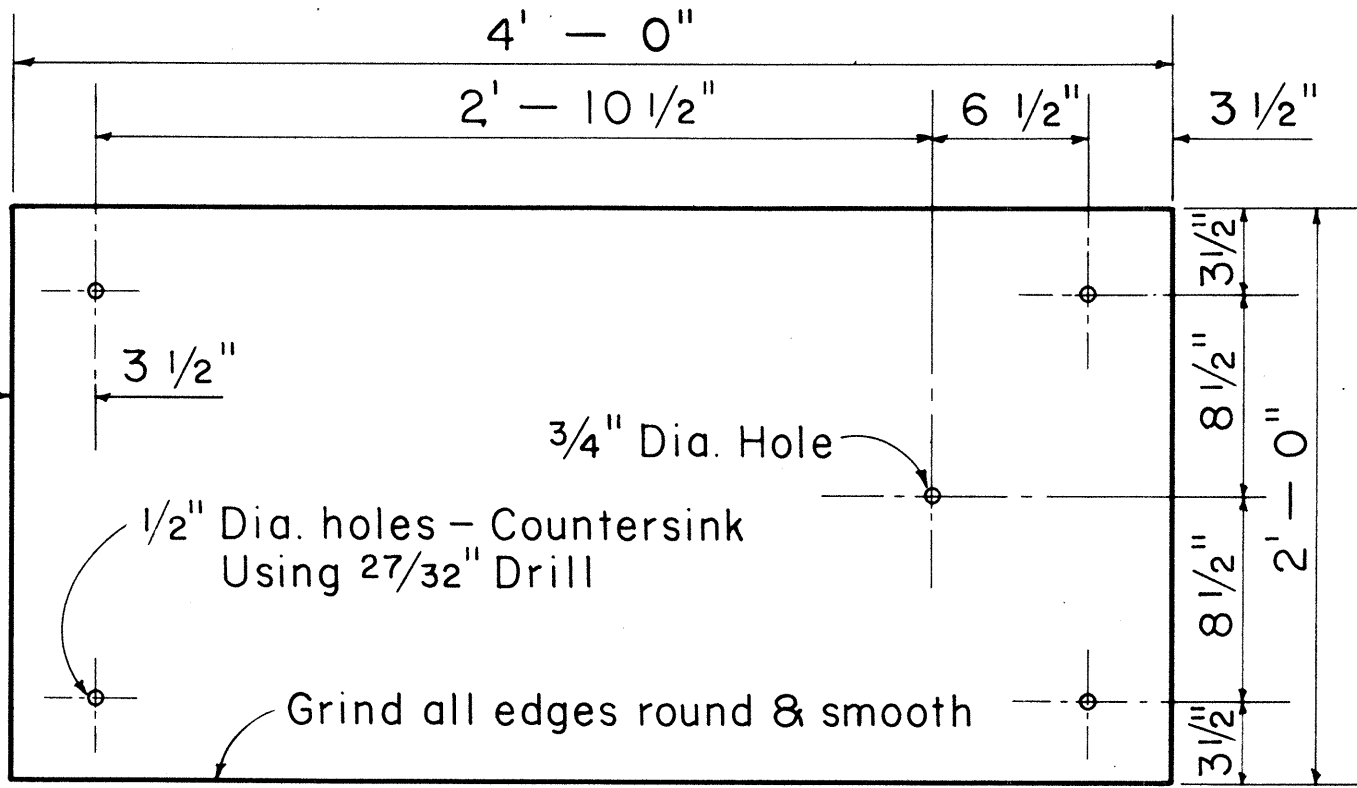

1/4" CHECKER PLATE COVER

(Hot dip galvanize checkered plate after drilling, countersinking, and grinding edge)

1'-6" X 3'-6" CONCRETE SERVICE BOX

Scale: 1 1/2" = 1' - 0"

OII255

ORIGINAL PLAN	DATE
SURVEY PLOTTED BY	
DRAWN BY	
DESIGNED BY	
CHECKED BY	
NOTE BOOK	
No.	

FED. AID DIST. NO.	STATE	FED. AID PROJ. NO.	FISCAL YEAR	SHEET NO.	TOTAL SHEETS
HAWAII	HAWAII	1-H-1(23)11	1960	32	08

FOR 25', & 30' POLES WITH 8'-0" ANCHOR RODS				
"A"	"B"	"C"		"D" = ("A" + "B")
LEAD-ANCHOR ROD TO C OF POLE	ANCHOR ROD TO C OF HOLE	VERTICAL DEPTH 18" D.M.	24" D.M.	TOTAL DISTANCE POLE TO HOLE
5'-0"	1'-8"	7'-1"	7'-4"	6'-8"
10'-0"	3'-0"	6'-7"	7'-0"	13'-0"
15'-0"	4'-0"	6'-1"	6'-6"	19'-0"
20'-0"	4'-8"	5'-6"	5'-10"	24'-8"
25'-0"	5'-2"	4'-11"	5'-4"	30'-2"
FOR 35' THRU 70' POLES WITH 8'-0" ANCHOR RODS				
5'-0"	1'-0"	7'-3"	7'-4"	6'-0"
10'-0"	1'-11"	7'-1"	7'-3"	11'-11"
15'-0"	2'-8"	6'-9"	7'-1"	17'-8"
20'-0"	3'-3"	6'-6"	6'-10"	23'-3"
25'-0"	3'-10"	6'-2"	6'-7"	28'-10"
FOR 40' THRU 70' POLES WITH 1 1/4" x 10'-0" ANCHOR RODS				
5'-0"	1'-7"		9'-4"	6'-7"
10'-0"	3'-0"		9'-0"	13'-0"
15'-0"	4'-2"		8'-6"	19'-2"
20'-0"	5'-3"		7'-11"	25'-3"
25'-0"	6'-2"		7'-3"	31'-2"

D. M. = Deadman

TABLE 2 ANCHOR ROD - ANCHOR SLUG - SQUARE WASHER COMBINATION							
H.E. CODE NO.	ANCHOR ROD	WORKING TENSION 1/2 ULT (LBS.)	H.E. CONC. CODE NO.	ANC. (IN.)	H.E. CODE NO.	WASHER SIZE	QTY.
617	5/8" x 8'-0" Steel	8,000	518	18	2320	4" x 4" x 3/16"	2
615	5/8" x 8'-0" Cu Cov Stl	9,250	518	18	**	3" x 3" x 1/8"	2
618	3/4" x 8'-0" Steel	11,500	518	18	2330	6" x 6" x 3/8"	1
619	1" x 8'-0" Steel	18,000	524	24	2331	6" x 6" x 1/2"	1
616	1" x 8'-0" Cu Cov Stl	22,500	524	24	**	4" x 4" x 3/16"	2
613	1 1/4" x 10'-0" Steel	29,000	524	24	2330	6" x 6" x 3/8"	2

** Use bronze square washers included in anchor rod assembly on copper covered steel (Cu Cov Stl) anchor rods.

ANCHORING DATA

APPROVED :

AD Henderson 8-20-69
HAWAIIAN ELECTRIC Co., Inc. DATE


STATE OF HAWAII
DEPARTMENT OF TRANSPORTATION
HIGHWAYS DIVISION

STANDARD DETAILS
H.E. Co. AND H.T. Co.
ANCHOR DETAILS AND
ANCHORING DATA

Scales: As Noted

Date 9/4/69


SHEET No. 15 OF 17 SHEETS

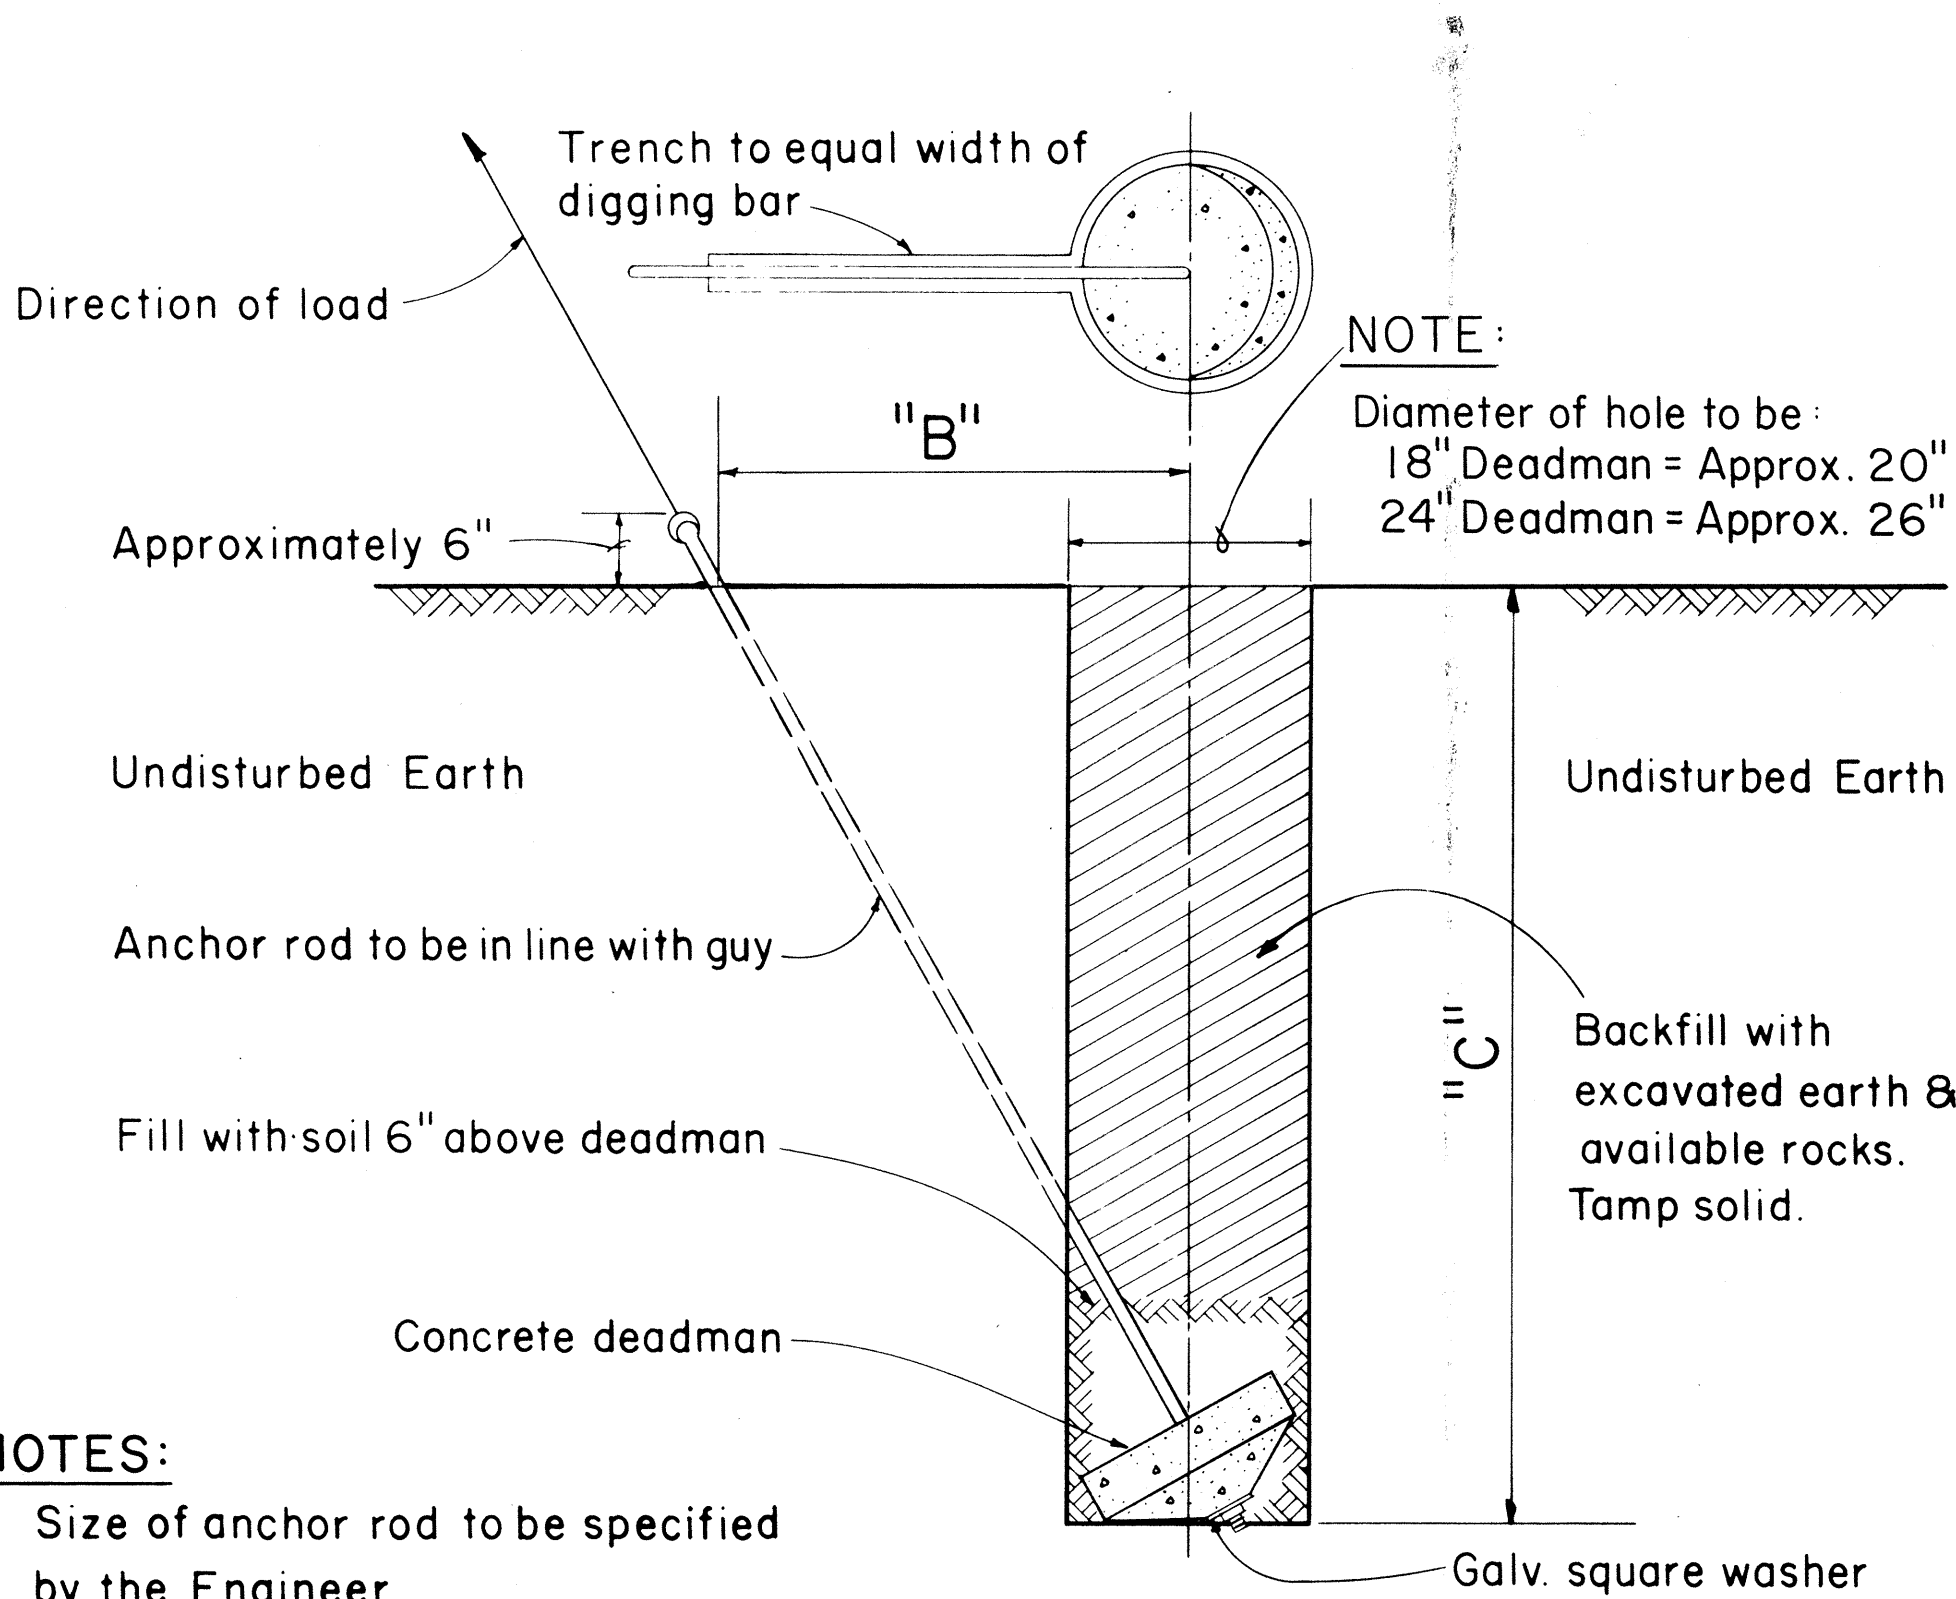


- NOTES:
- Size of anchor rod to be specified by the Engineer
 - Use Anchoring Data.

GUY ANCHOR DEADMAN

Scale: 3/4" = 1' - 0"

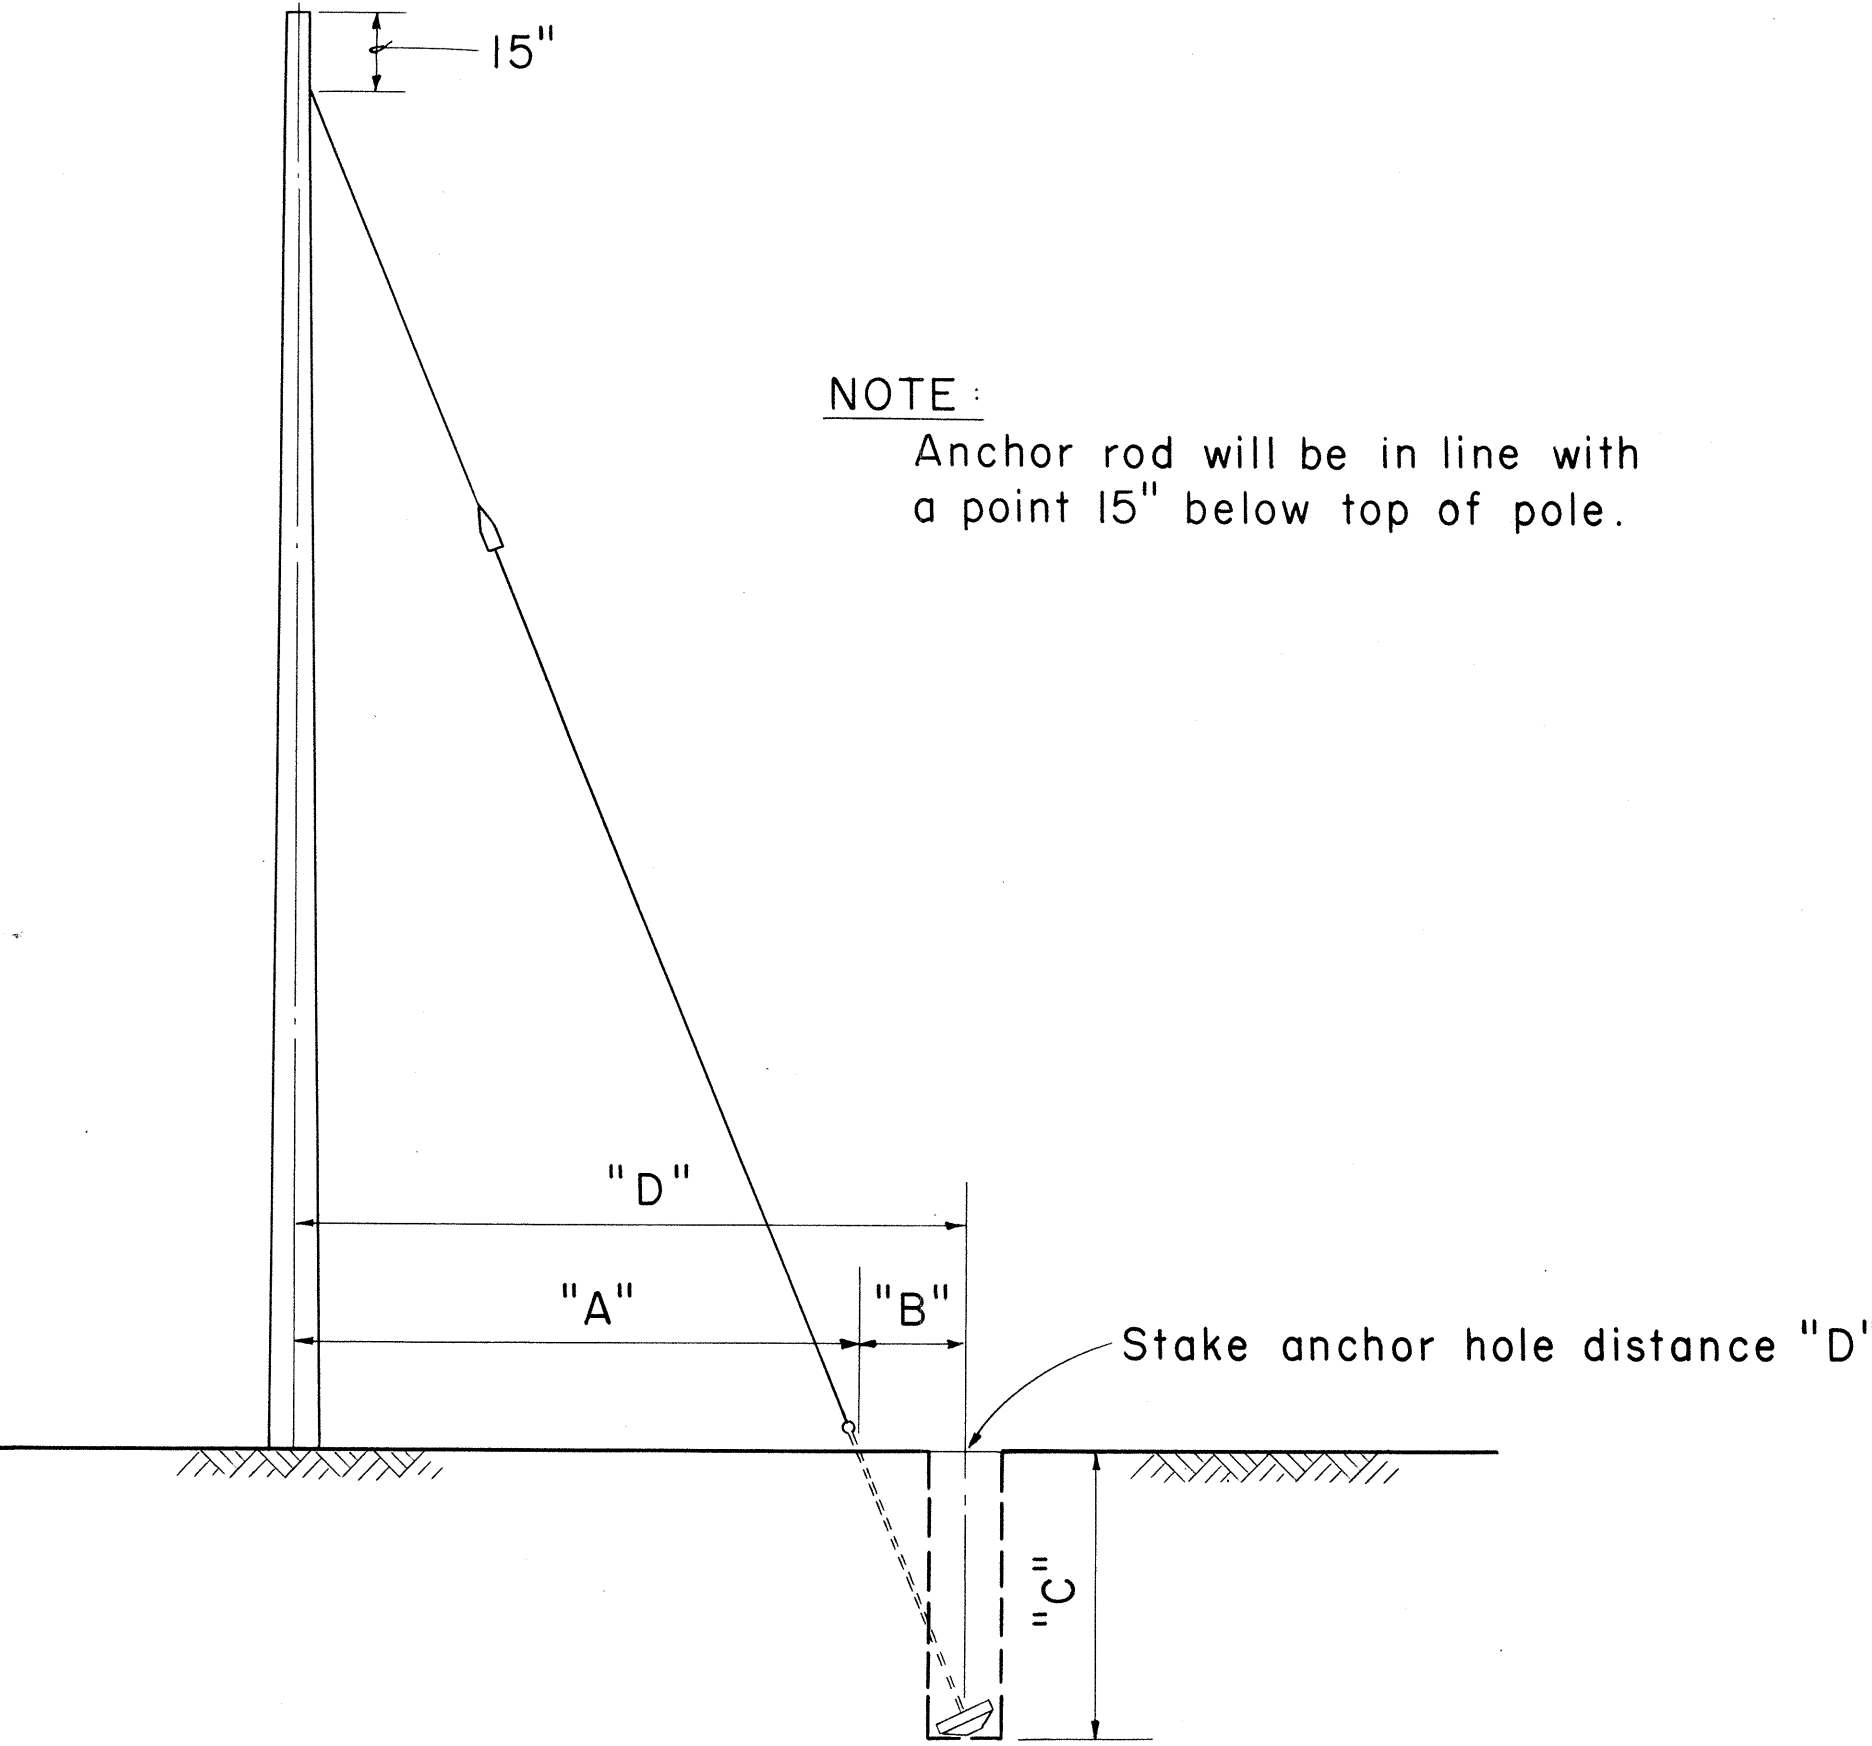


- NOTE:
- Anchor rod will be in line with a point 15" below top of pole.

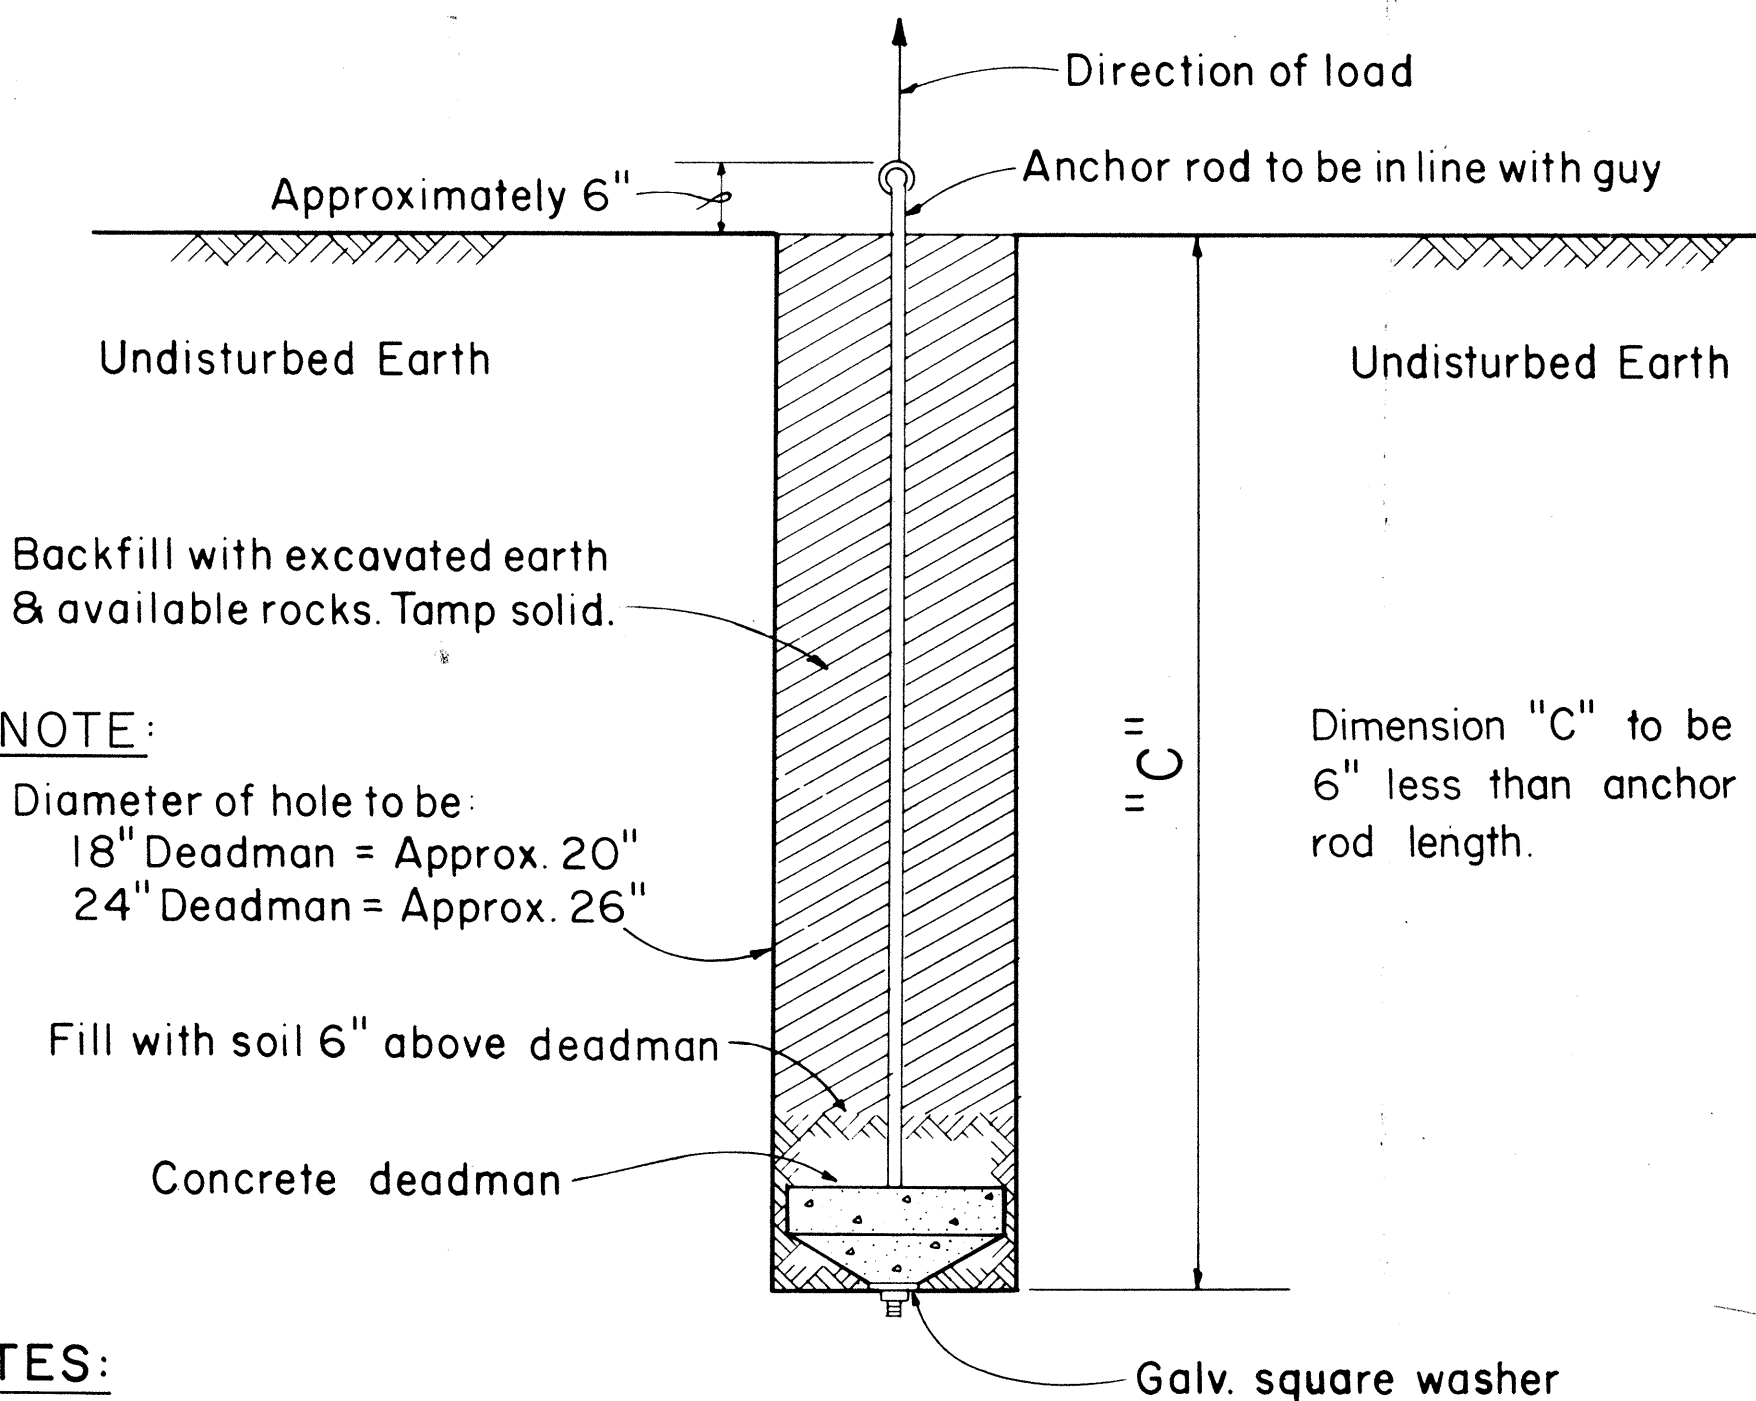

- NOTES:
- Size of anchor rod to be specified by the Engineer.
 - Use Anchoring Data.

SIDE - WALK ANCHOR

Scale: 3/4" = 1' - 0"

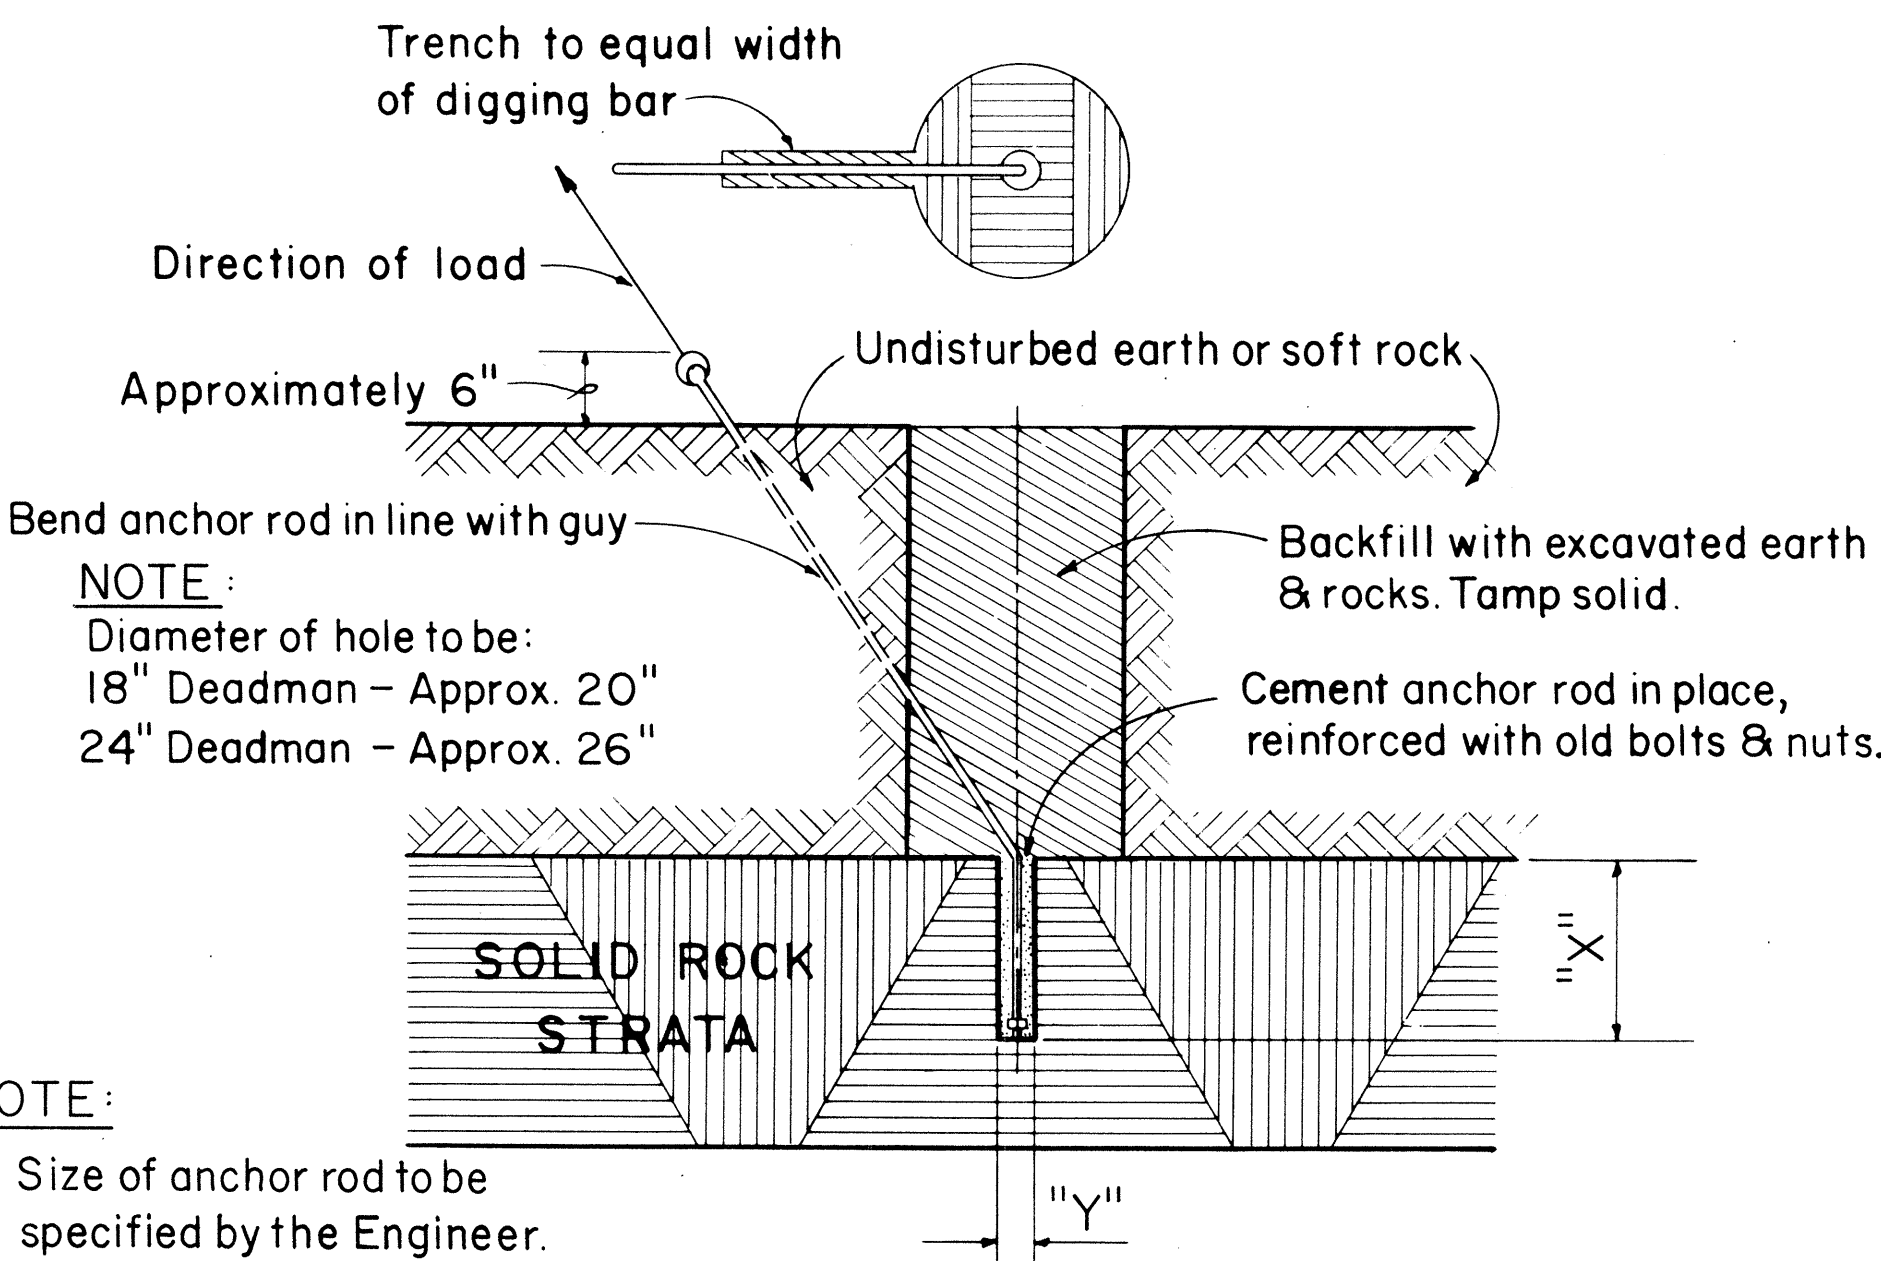

- NOTE:
- Size of anchor rod to be specified by the Engineer.
 - "X" Should not be less than 24". If "X" is less than 24" complete hole & install anchor.
 - "Y" 5/8" Anchor rod drill 2" hole
3/4" Anchor rod drill 2" hole
1" Anchor rod drill 2 1/2" hole
1 1/4" Anchor rod drill 3" hole
 - Use Anchoring Data.

ROCK ANCHOR

Not to Scale

