



FED. ROAD DIST. NO.	STATE	FED. AID PROJ. NO.	FISCAL YEAR	SHEET NO.	TOTAL SHEETS
HAWAII	HAW.	I-HI-(64):12 UNIT 1	1969	10	158
I-HI-1(64):11					

NOTE:
The contractor shall install the 84" pipe culvert beyond the End of Project up to the Type "I" C.D.I. at baseline Sta. 179+34.5. The Type "I" C.D.I. to be constructed by others.

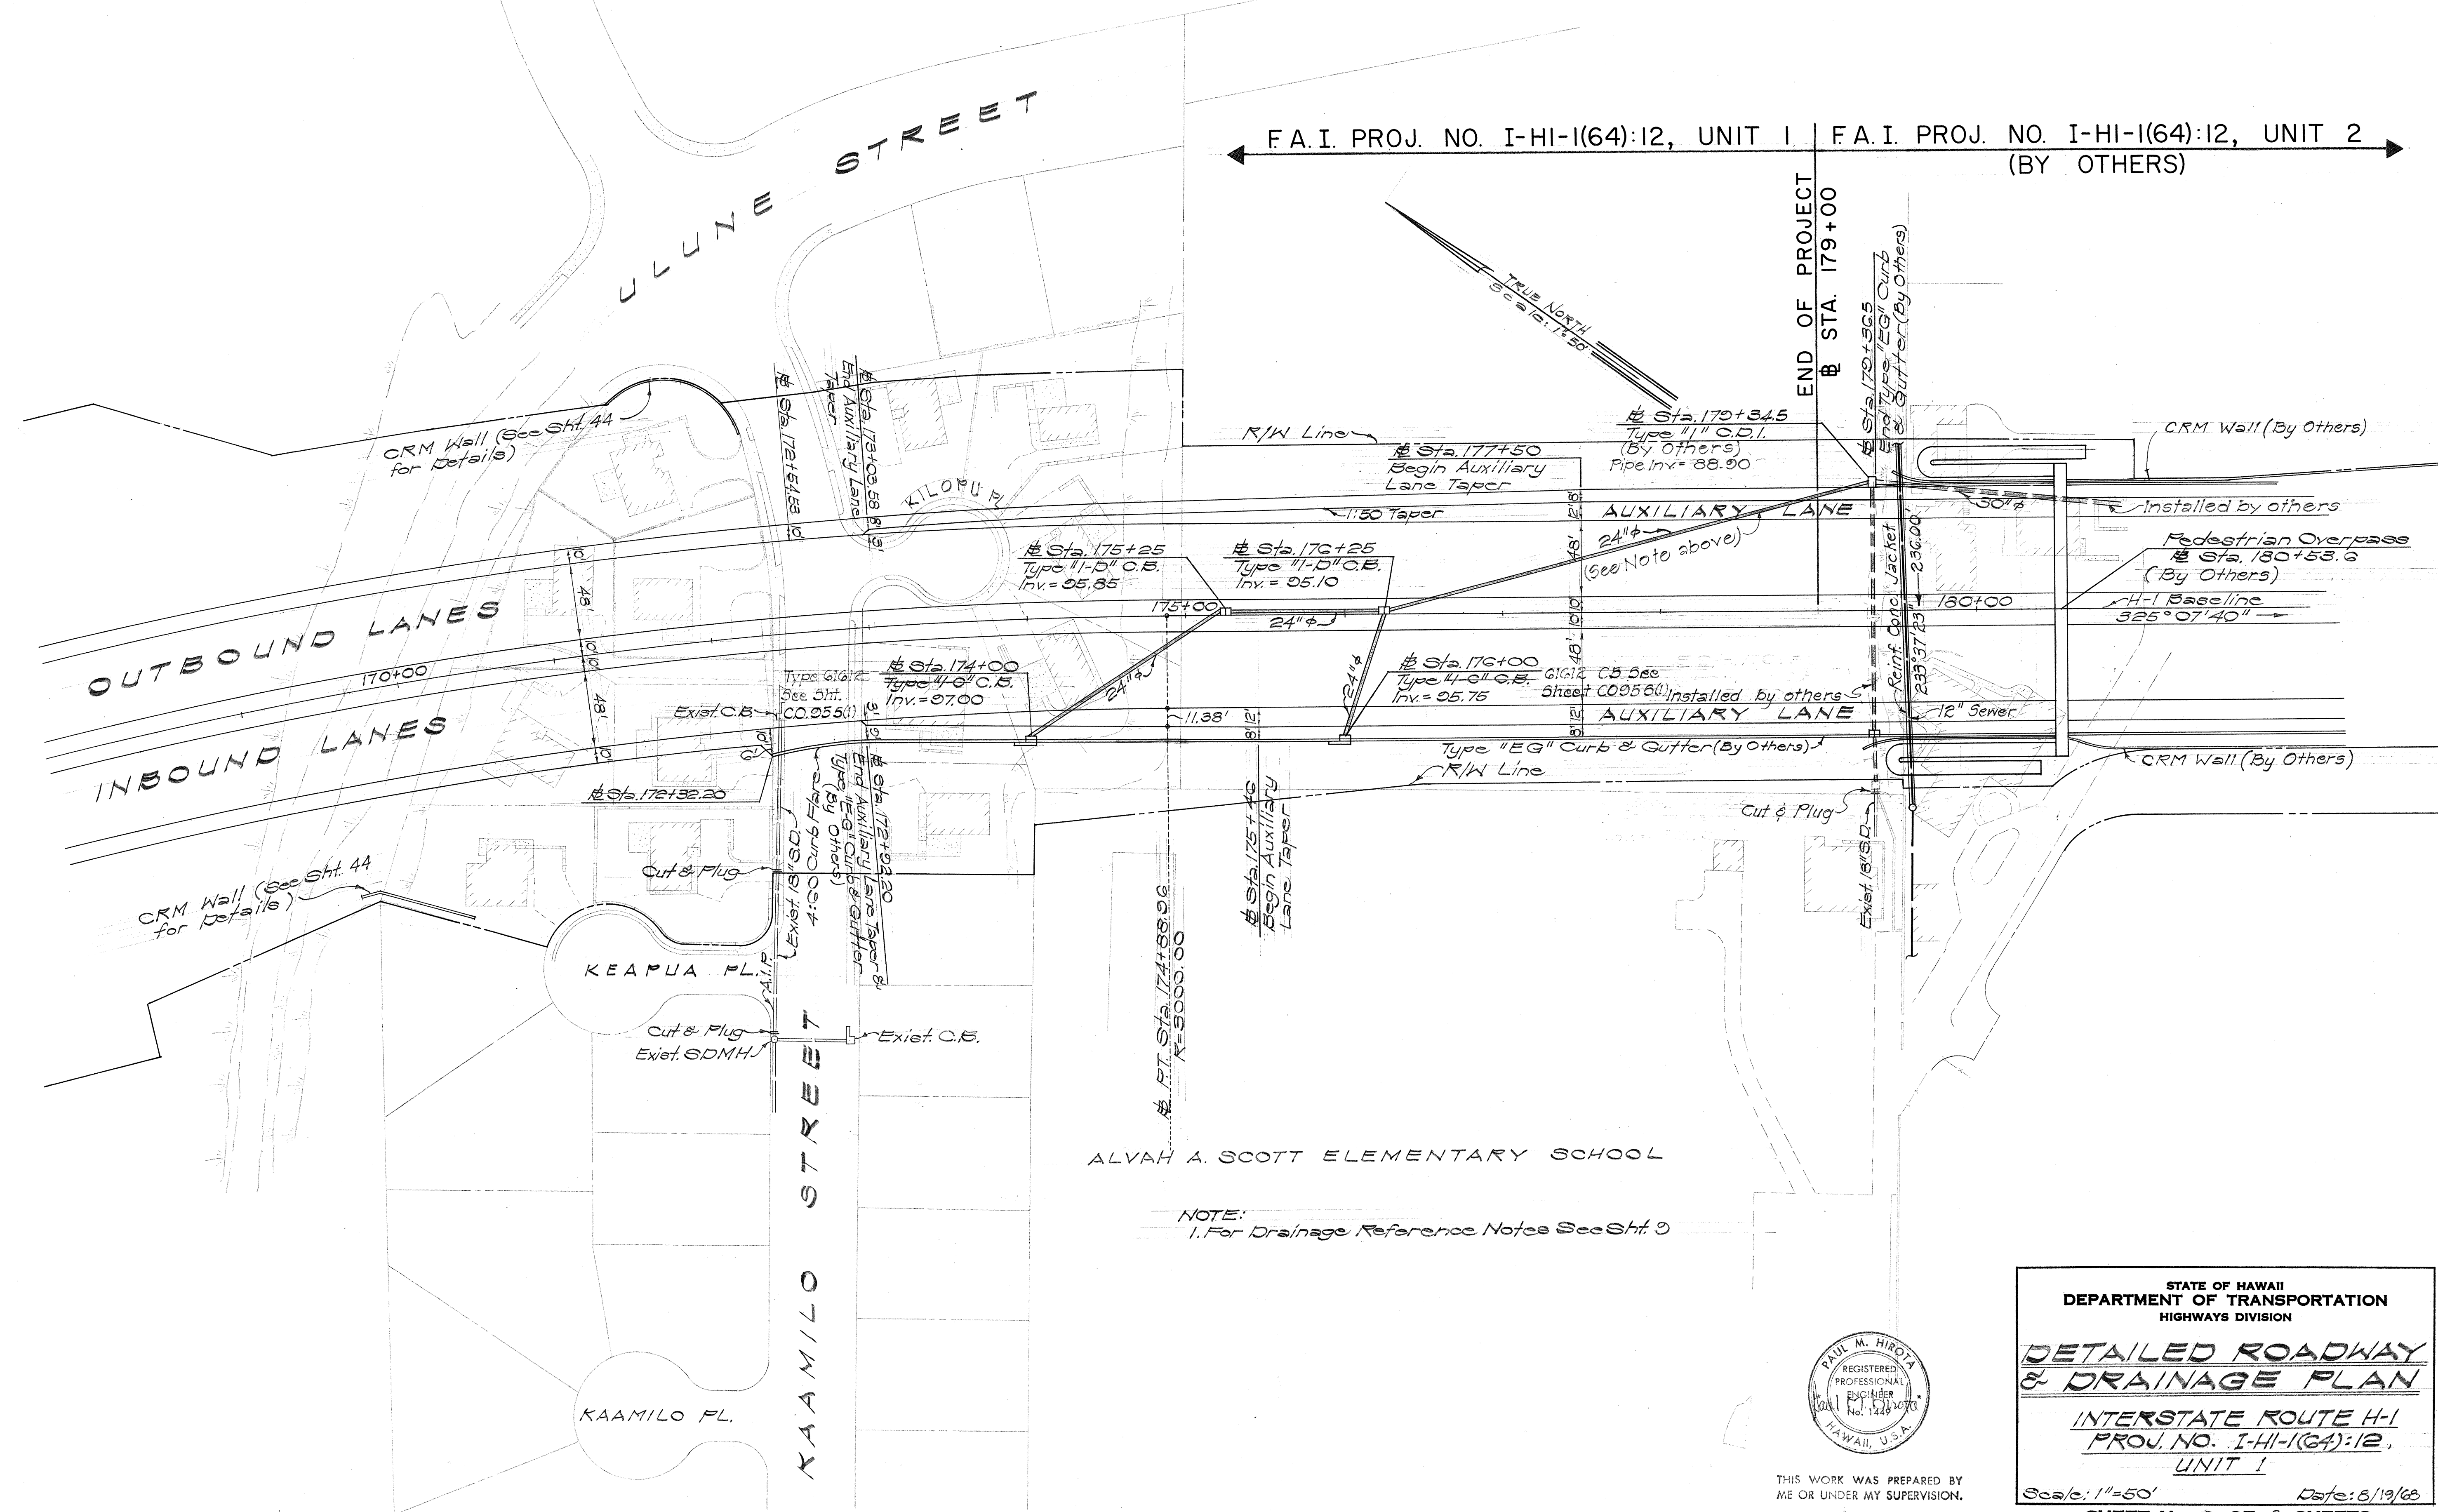

NOTE:
1. For Drainage Reference Notes See Sht. 9

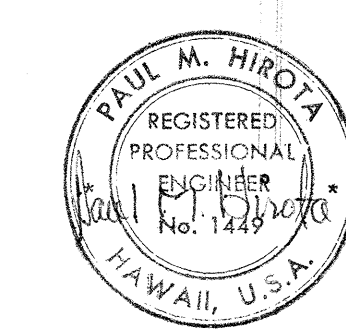

THIS WORK WAS PREPARED BY ME OR UNDER MY SUPERVISION.

STATE OF HAWAII
DEPARTMENT OF TRANSPORTATION
HIGHWAYS DIVISION

DETAILED ROADWAY & DRAINAGE PLAN

INTERSTATE ROUTE H-1
PROJ. NO. I-HI-1(64):12,
UNIT 1
Scale: 1"=50' Date: 8/19/68
SHEET No. 2 OF 3 SHEETS

ORIGINAL PLAN	DATE
DESIGNED BY	
CHECKED BY	
NOTED BY	
NO.	

