

S U M M A R Y

FED. ROAD DIST. NO.	STATE	FED. AID PROJ. NO.	FISCAL YEAR	SHEET NO.	TOTAL SHEETS
HAWAII	HAW.	HI-16412 Unit 1	1969	88	158

Revised: June 30, 1969

STRUCTURES			PIPE CULVERTS		ESTIMATED																			QUANTITIES																			REMARKS
NUMBER	TYPE	STATION	ITEM	NO.	14.01	15.01	20A.01	46.101	46.201	46.213A	48.01	58B.034	58.128	58.174	58.122	58.024	58.172	60.018	60.048	62.01	63.01	67.11	68.01	54A.07	112.01A2	54A.10	59B.193																
			FROM	TO	Structure Excavation other than at Bridges	Ditch and Channel Excavation	Untreated Base for Pipe Foundation	Class A-1 Concrete other than in Bridges	Class B-1 Concrete other than in Bridges	Class B-1 Concrete for Concrete Lined Ditch	Reinforcing Steel other than in Bridges	24" ACCP, Class III or 24" RCCP, Class III	54" RCCP, CI-III	42" RCCP, CI-IV	36" RCCP, CI-III	48"x27" CMP Arch (12 Gage)	36" RCCP, CI-IV	108" Sectional Plate Pipe Culvert (12 Gage)	108" Sectional Plate Pipe Culvert (10 Gage)	Cement Rubble Masonry	Grouted Rubble Paving	Brick Wall for Type "D" or "E" SDMH	Type "A" Cast Iron Frame and Cover	Type "A-12" Steel Frame and Grates	Shotcrete for Concrete Lined Ditch	Type GI-2 Steel Frame and Grate	24" GMP 8 Ga. or 24" RCCP with Concrete Collars, Class III, or 24" ACCP with Collars, Class III																
			UNIT	USED	C.Y.	C.Y.	C.Y.	C.Y.	C.Y.	C.Y.	Lb.	L.F.	L.F.	L.F.	L.F.	L.F.	L.F.	L.F.	L.F.	C.Y.	C.Y.	L.F.	Sq.	Sq.	C.Y.	Sq.	Sq.	L.F.															
	DIVERSION CHANNEL	107+34 Lt. TO 105+61.5 Rt.				42.28 8200																																					
	TYPE "E" SDMH	116+50 Rt.	116+50 Rt.	114+07.5 Rt.	492				2		87		240									4	1																				
	TYPE "E" SDMH	117+00 Rt.	117+00 Rt.	116+50 Rt.	284				2		72		136									4	1																				
	TYPE "E" SDMH	120+40 Rt.	120+40 Rt.	117+00 Rt.	305			5.5	3.0		2024			246								4	1																				
	TYPE "E" SDMH	122+05 Rt.	122+05 Rt.	120+40 Rt.	297				5		166						162					4	1																				
	TYPE "E" SDMH	122+70 Rt.	122+70 Rt.	122+05 Rt.	191				6.5		218				78				9.5	4	1																						
	TYPE GI-2 C.D.I.	124+00 Rt.	124+00 Rt.	122+70 Rt.	525			5.5			27				128																												
	TYPE GI-2 C.D.I.	124+00 Lt.	124+00 Lt.	124+00 Rt.	521			4.5			27				144																												
	TYPE "E" SDMH	126+00 Lt.	126+00 Lt.	124+00 Lt.	476				2		71				196						4	1																					
	TYPE "E" SDMH	126+84 Lt.	126+84 Lt.	126+00 Lt.	218				3		112				114						4	1																					
	SPILLWAY	145+20 Rt.				57.5 575					14.68	232.7													#0																		
	CONCRETE DROP BOX	146+35 Rt.			5.3				2.41																#0																		
	CUT-OFF DITCH	141+00 TO 146+20 Lt.				220 220					56.15	852.6													#0																		
	SPILLWAY	145+05 Lt.				85.3 853					21.83	345.8													#0																		
	SECT. PLATE PIPE CULVERT	148+08				278.5 2785		167.4	44.92			659.20					68.1	206.0																									
	CONCRETE DROP BOX	148+20 Lt.			5.3				2.41																																		
	CONCRETE DROP BOX	148+00 Lt.			5.3				2.41																																		
	CUT-OFF DITCH	148+00 TO 163+60 Lt.				676.2 6762						222.16	260.12												#0																		
	SPILLWAY	163+40 Rt.				592.6 5926		Culv. Conn. Slab	1.62	15.23	241.3	Spillway												#0																			
	CONCRETE DROP BOX	164+60 Rt.			5.3				2.41			178.5	Culv. Conn. Slab																														
	SPILLWAY	163+50 Lt.				77.1 771					18.77	303.1												#0																			
	CONCRETE DROP BOX	165+00 Lt.			5.3				2.41																																		
	TYPE "I-D" CATCH BASIN	162+50	162+50	163+40	30.5 305			2.62			45.7	85.8											2.10																				
	TYPE "I-D" CATCH BASIN	163+40	163+40	163+52 Rt.	64.3 643			2.74			45.7	101.0											2.10																				
	EARTH DITCHES	164+61				135	CCO 24																																				

ORIGINAL PLAN	SURVEY PLOTTED BY _____ DATE _____
NOTE BOOK	DRAWN BY _____ 6
	TRACED BY _____ 6
	DESIGNED BY _____ 44
	QUANTITIES BY _____ 44
No. _____	CHECKED BY _____ 44
	_____ 44


S U M M A R Y

ORIGINAL	SURVAY IDENTIFIED BY	DATE
PLAN	DRAWN BY	
	TRACED BY	
NOTE BOOK	DESIGNED BY	
	QUANTITIES BY	
No.	CHECKED BY	




SHEET No. 2 OF 20 SHEETS

§ 9

FED. ROAD DIST. NO.	STATE	FED. AID PROJ. NO.	FISCAL YEAR	SHEET NO.	TOTAL SHEETS
HAWAII	HAW.	I-HI-1(64):12 Unit 1	1969	90	158
		HI-1(16):11			

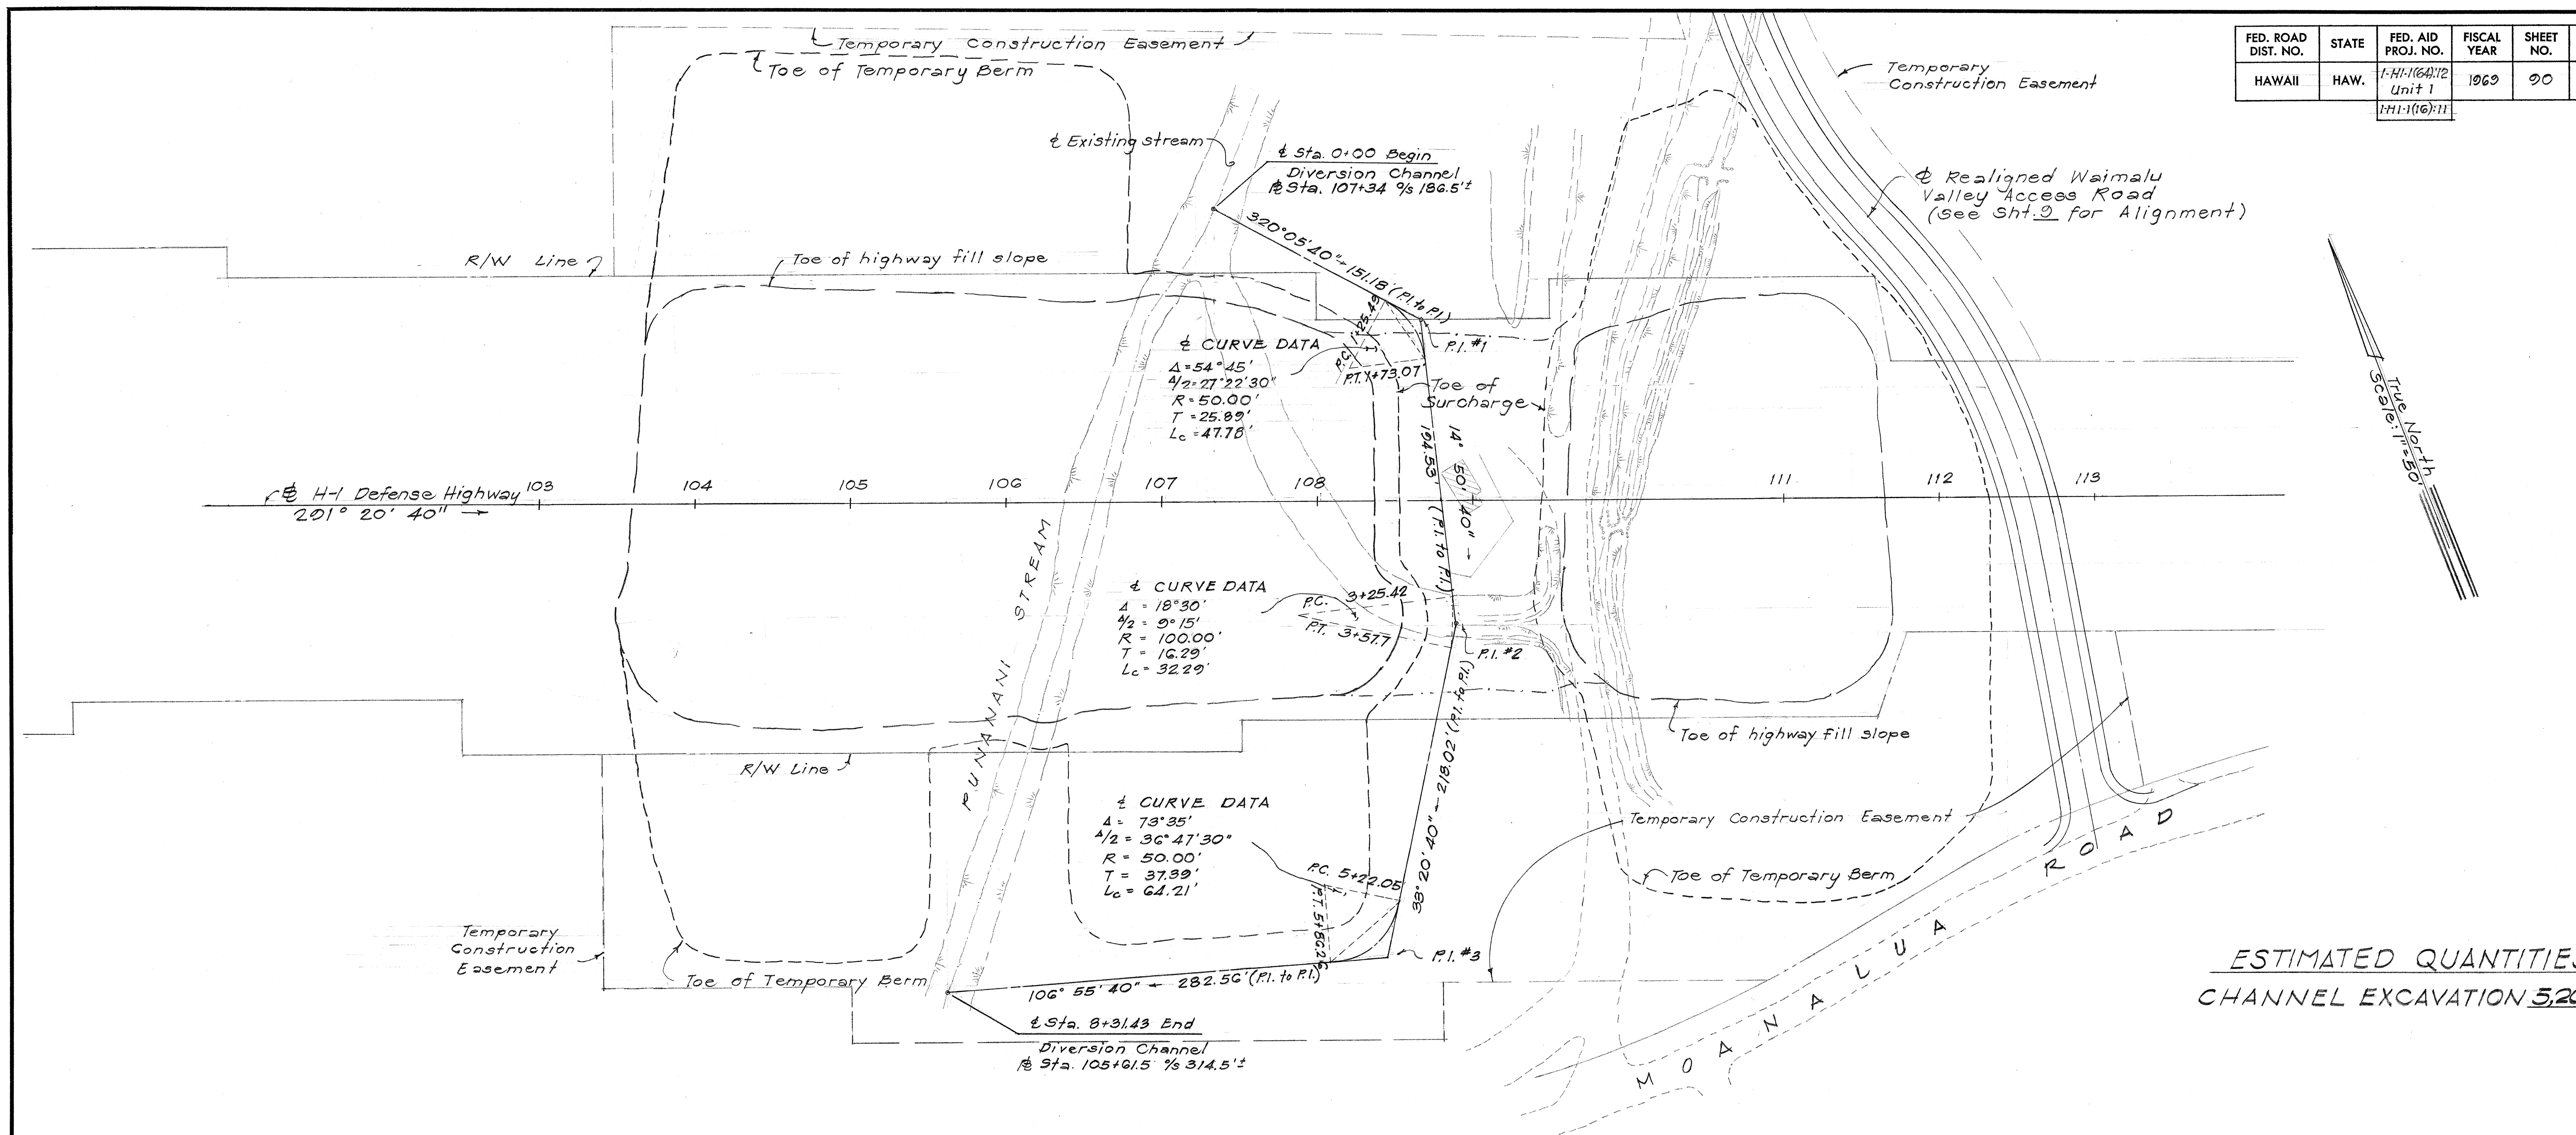

ESTIMATED QUANTITIES
CHANNEL EXCAVATION 5,200 CY.

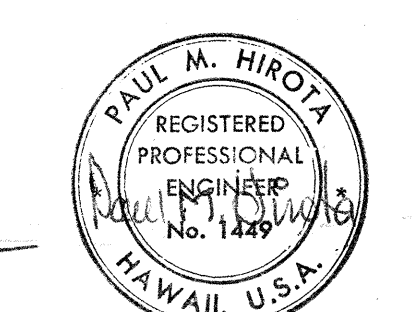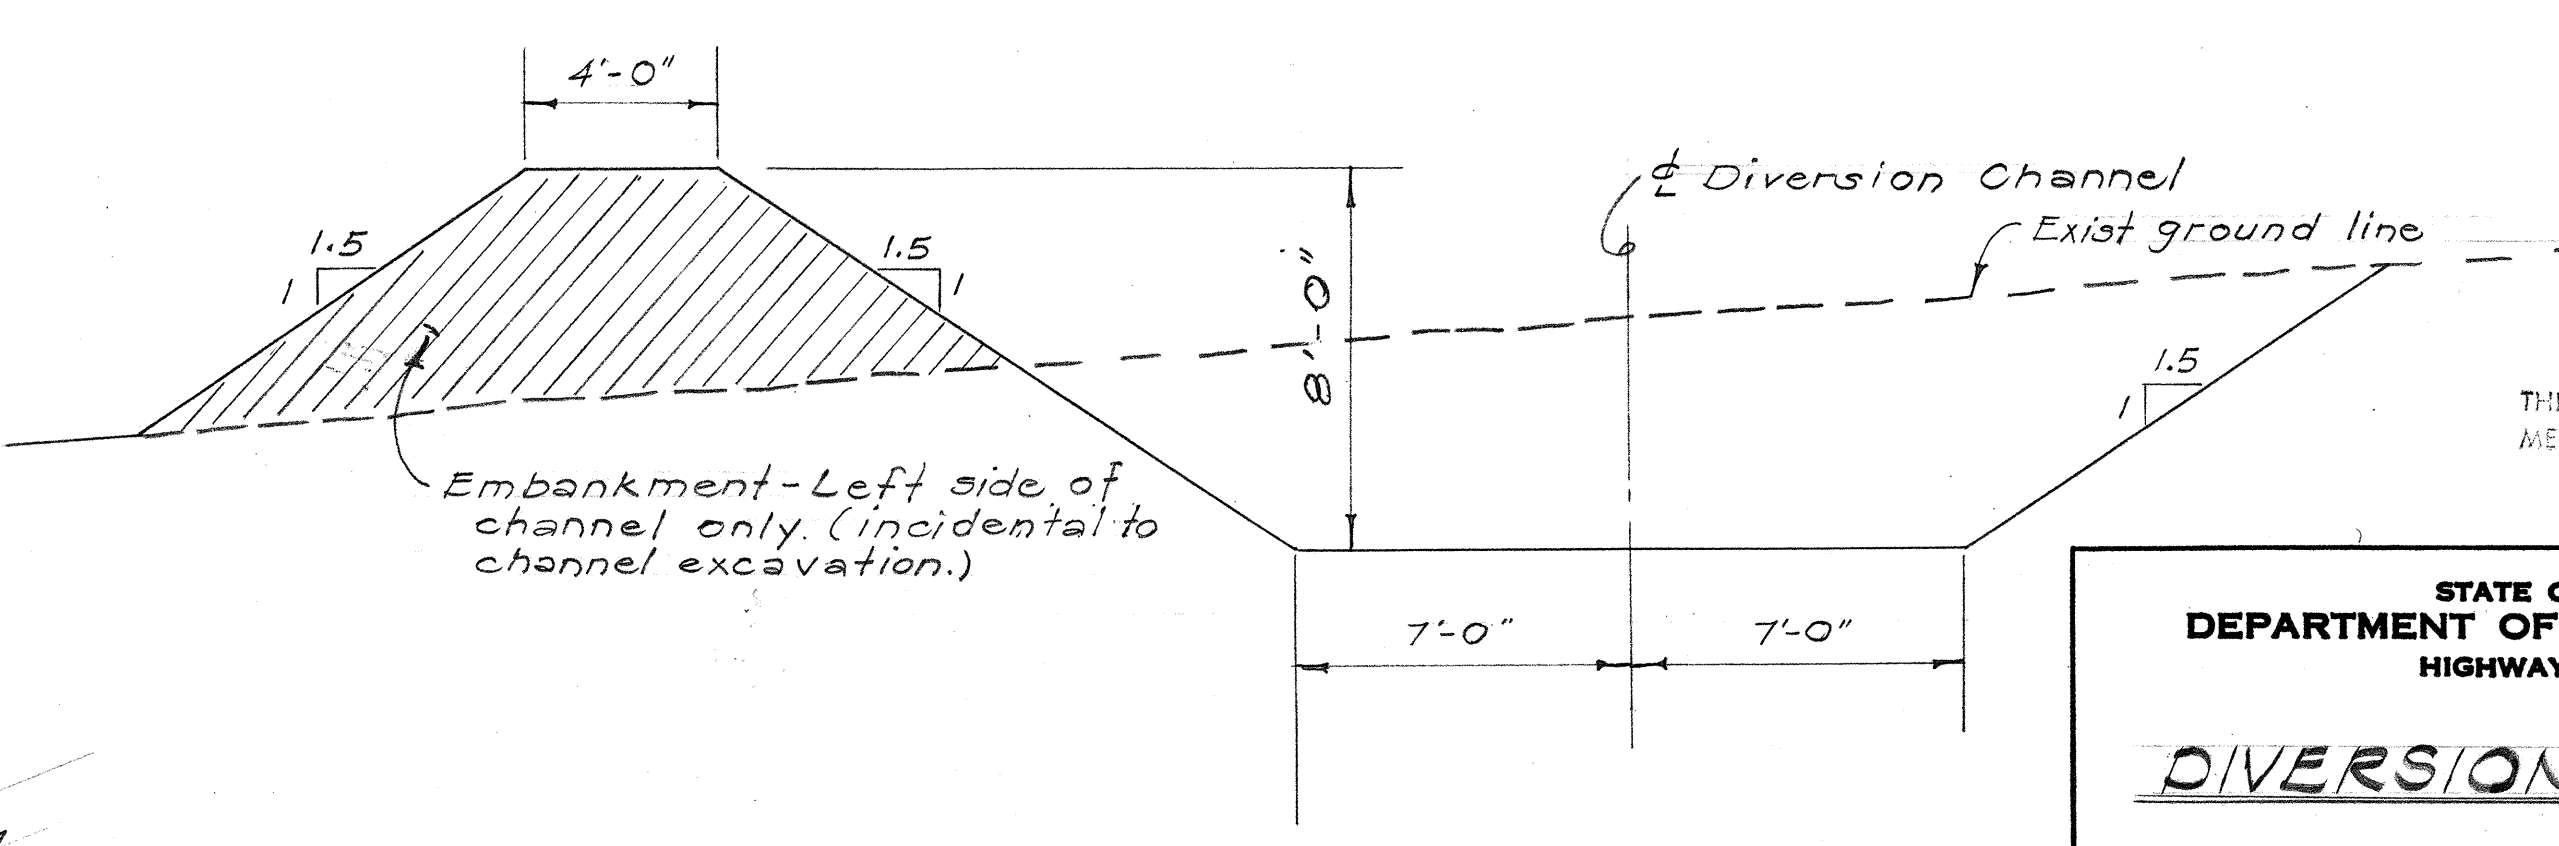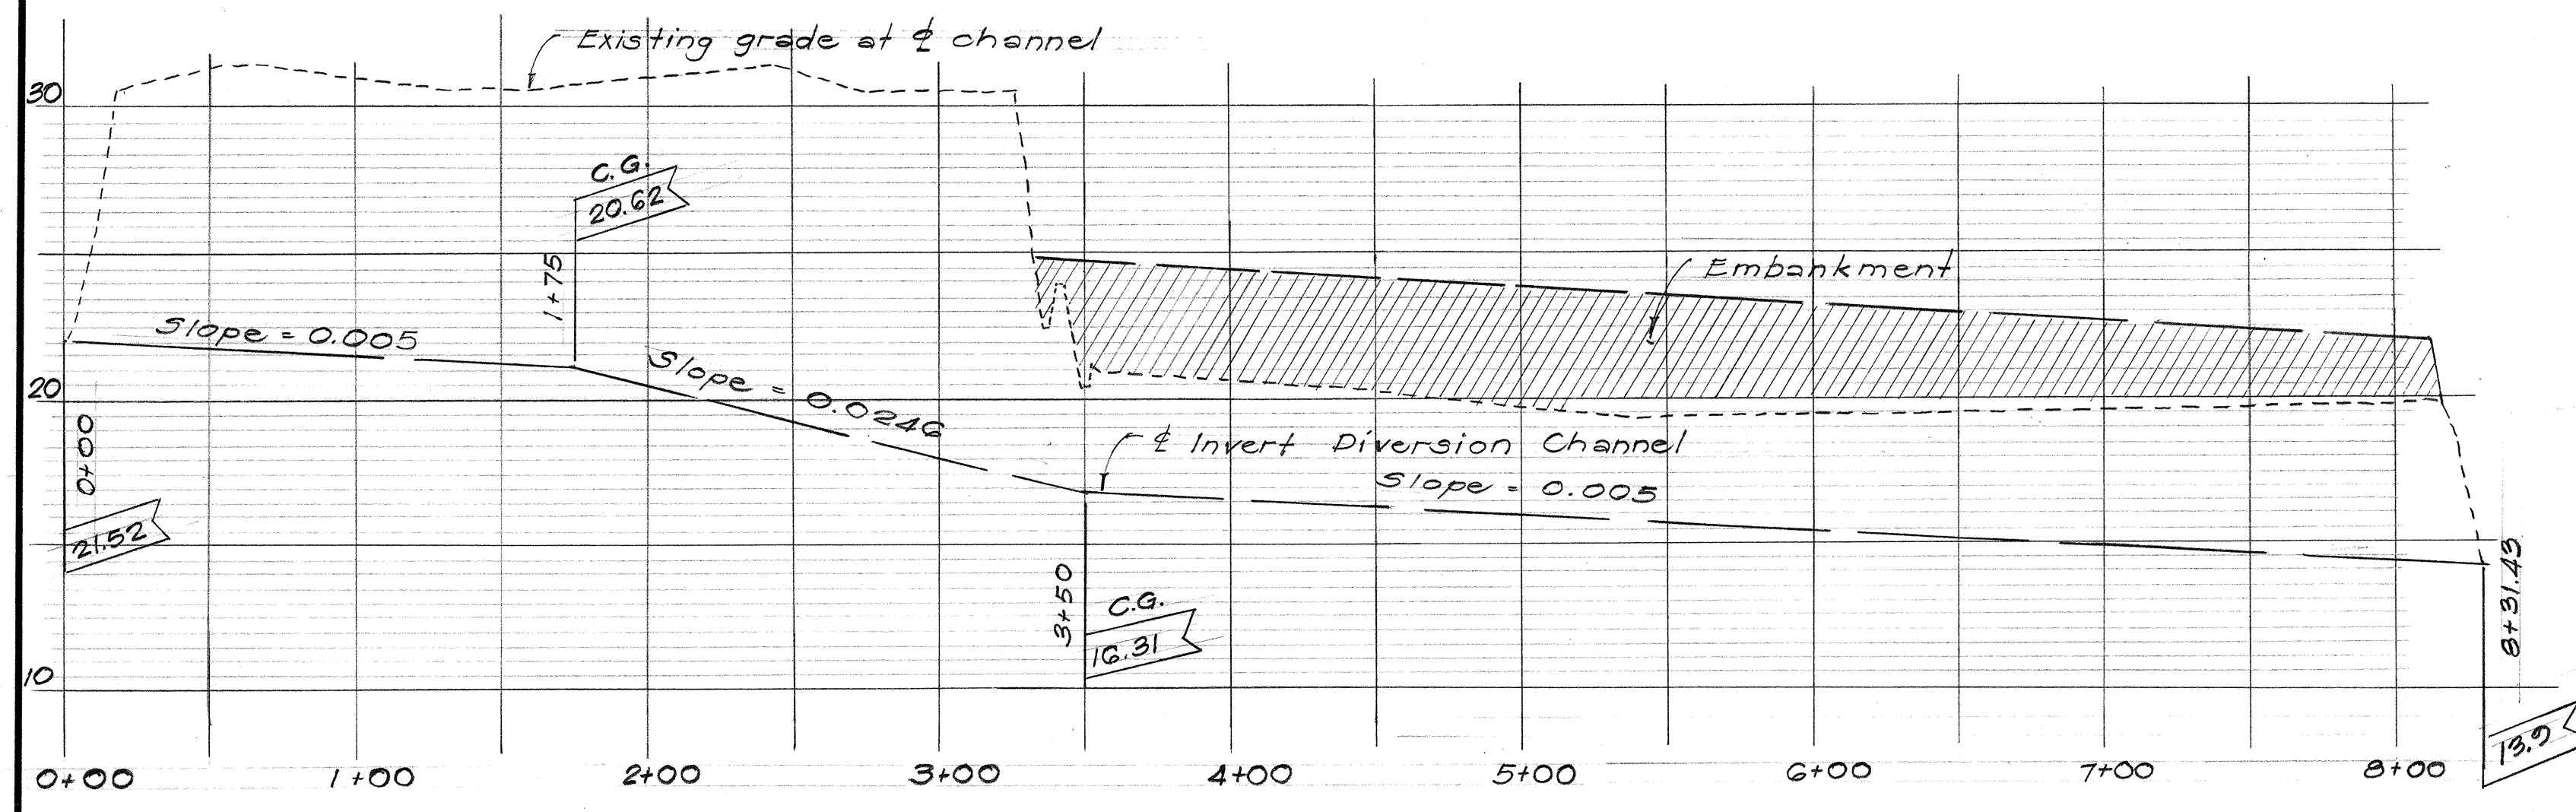

THIS WORK WAS PREPARED BY
ME OR UNDER MY SUPERVISION,

STATE OF HAWAII
DEPARTMENT OF TRANSPORTATION
HIGHWAYS DIVISION

DIVERSION CHANNEL

PLAN, PROFILE & DETAILS

INTERSTATE ROUTE H-1

PROJ. NO. I-HI-1(64):12, UNIT 1

Scale: As Shown

Date: 8/19/68

SHEET No. 3 OF 20 SHEETS


90

FED. ROAD DIST. NO.	STATE	FED. AID PROJ. NO.	FISCAL YEAR	SHEET NO.	TOTAL SHEETS
HAWAII	HAW.	I-HI-1(64)12 Unit 1	1969	91	158

Revised: June 30, 1969


NOTES:

1. G.R.P. required beyond the limit of payment shall be done at the Contractor's own expense.
2. Transverse slopes of G.R.P. to follow cut slope.
3. All voids between G.R.P. & walls of excavation shall be filled with concrete. Backfilling with earth material will not be allowed.

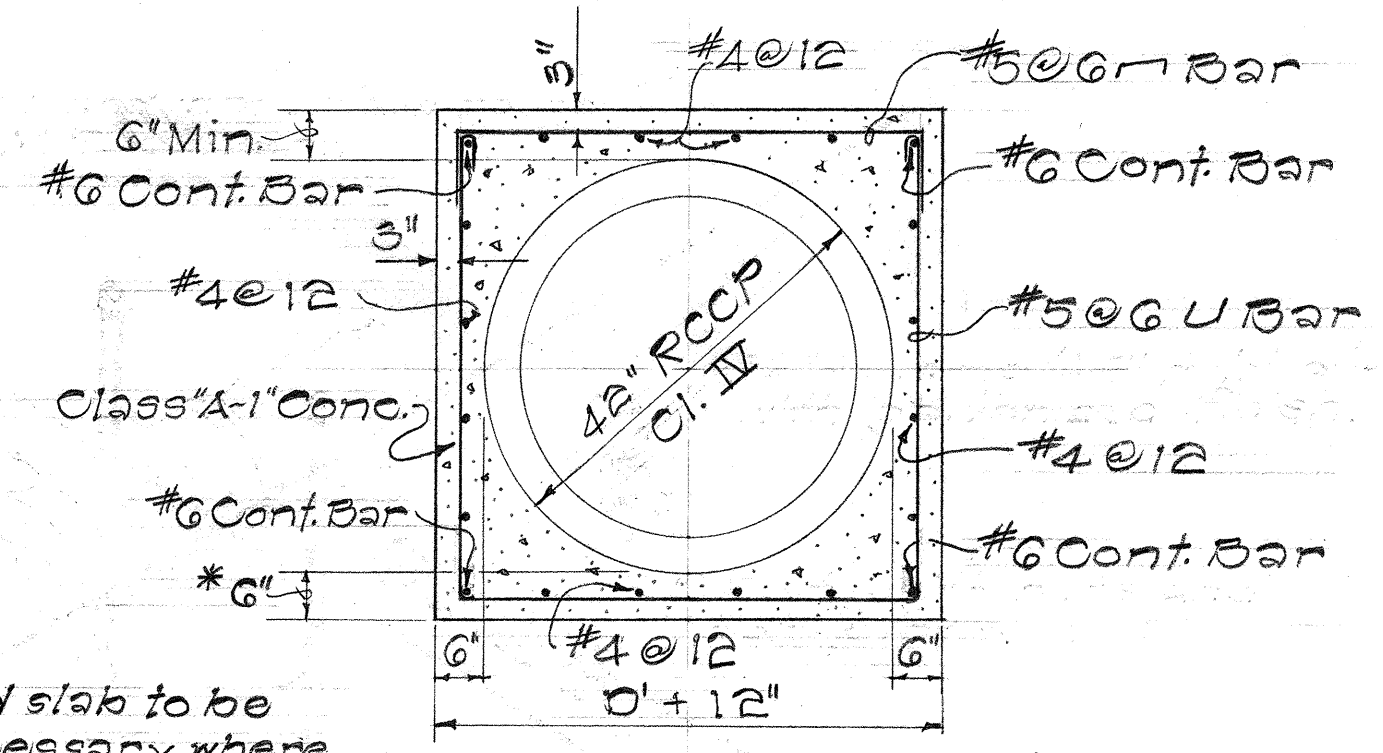


TYPICAL SECTION
DETAILS OF REINF. CONC. JACKET
(PONO STREET)
Scale: 1/2" = 1'-0"

*6" Reinforced slab to be omitted if necessary where crossing sewer pipe.

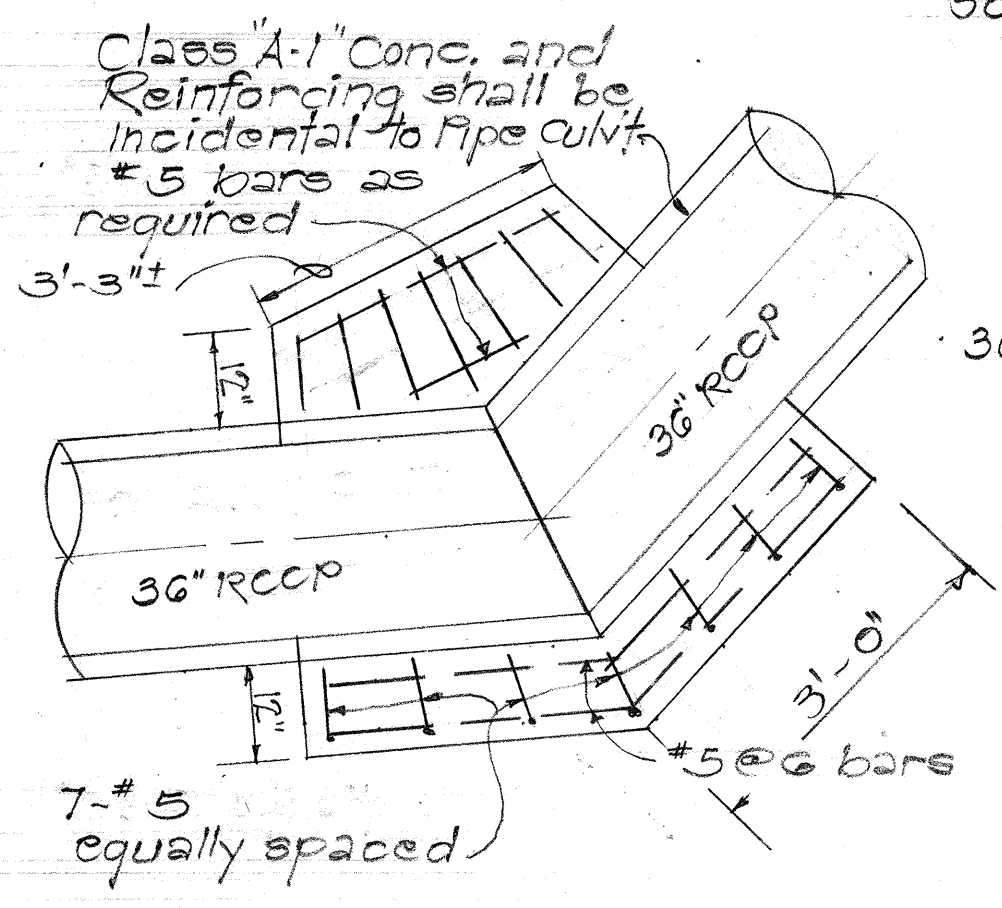


ELEVATION VIEW


Note: For Opposite bend use similar details

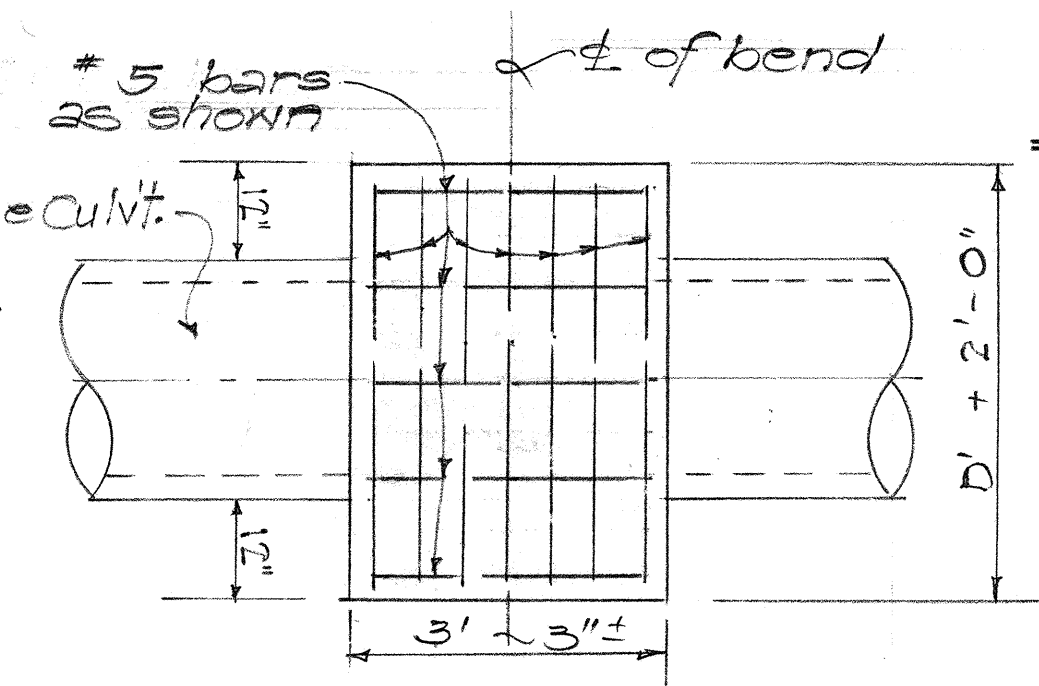


PLAN VIEW

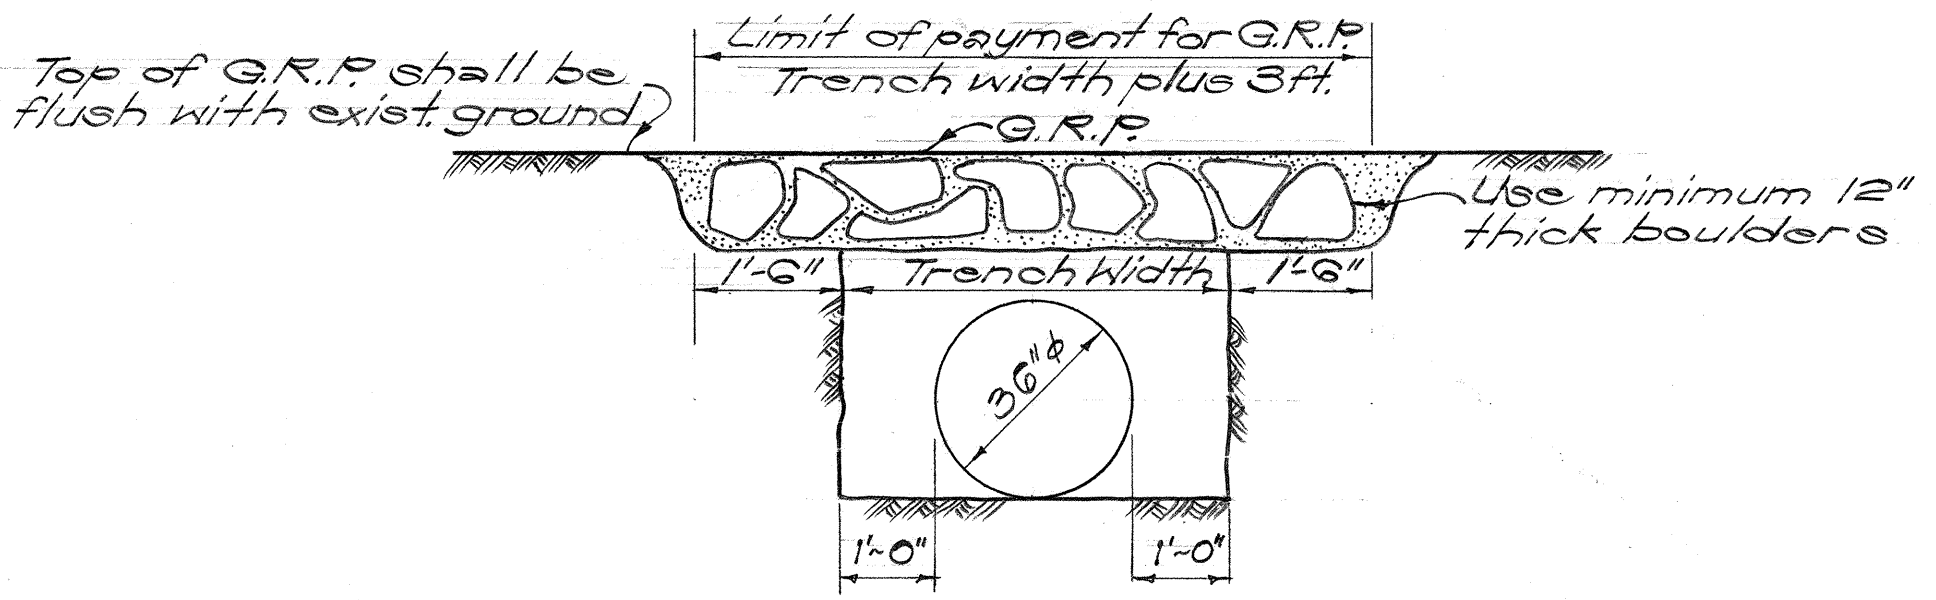


TYPICAL DETAIL OF G.R.P. SEAL
OVER STORM DRAIN LINE

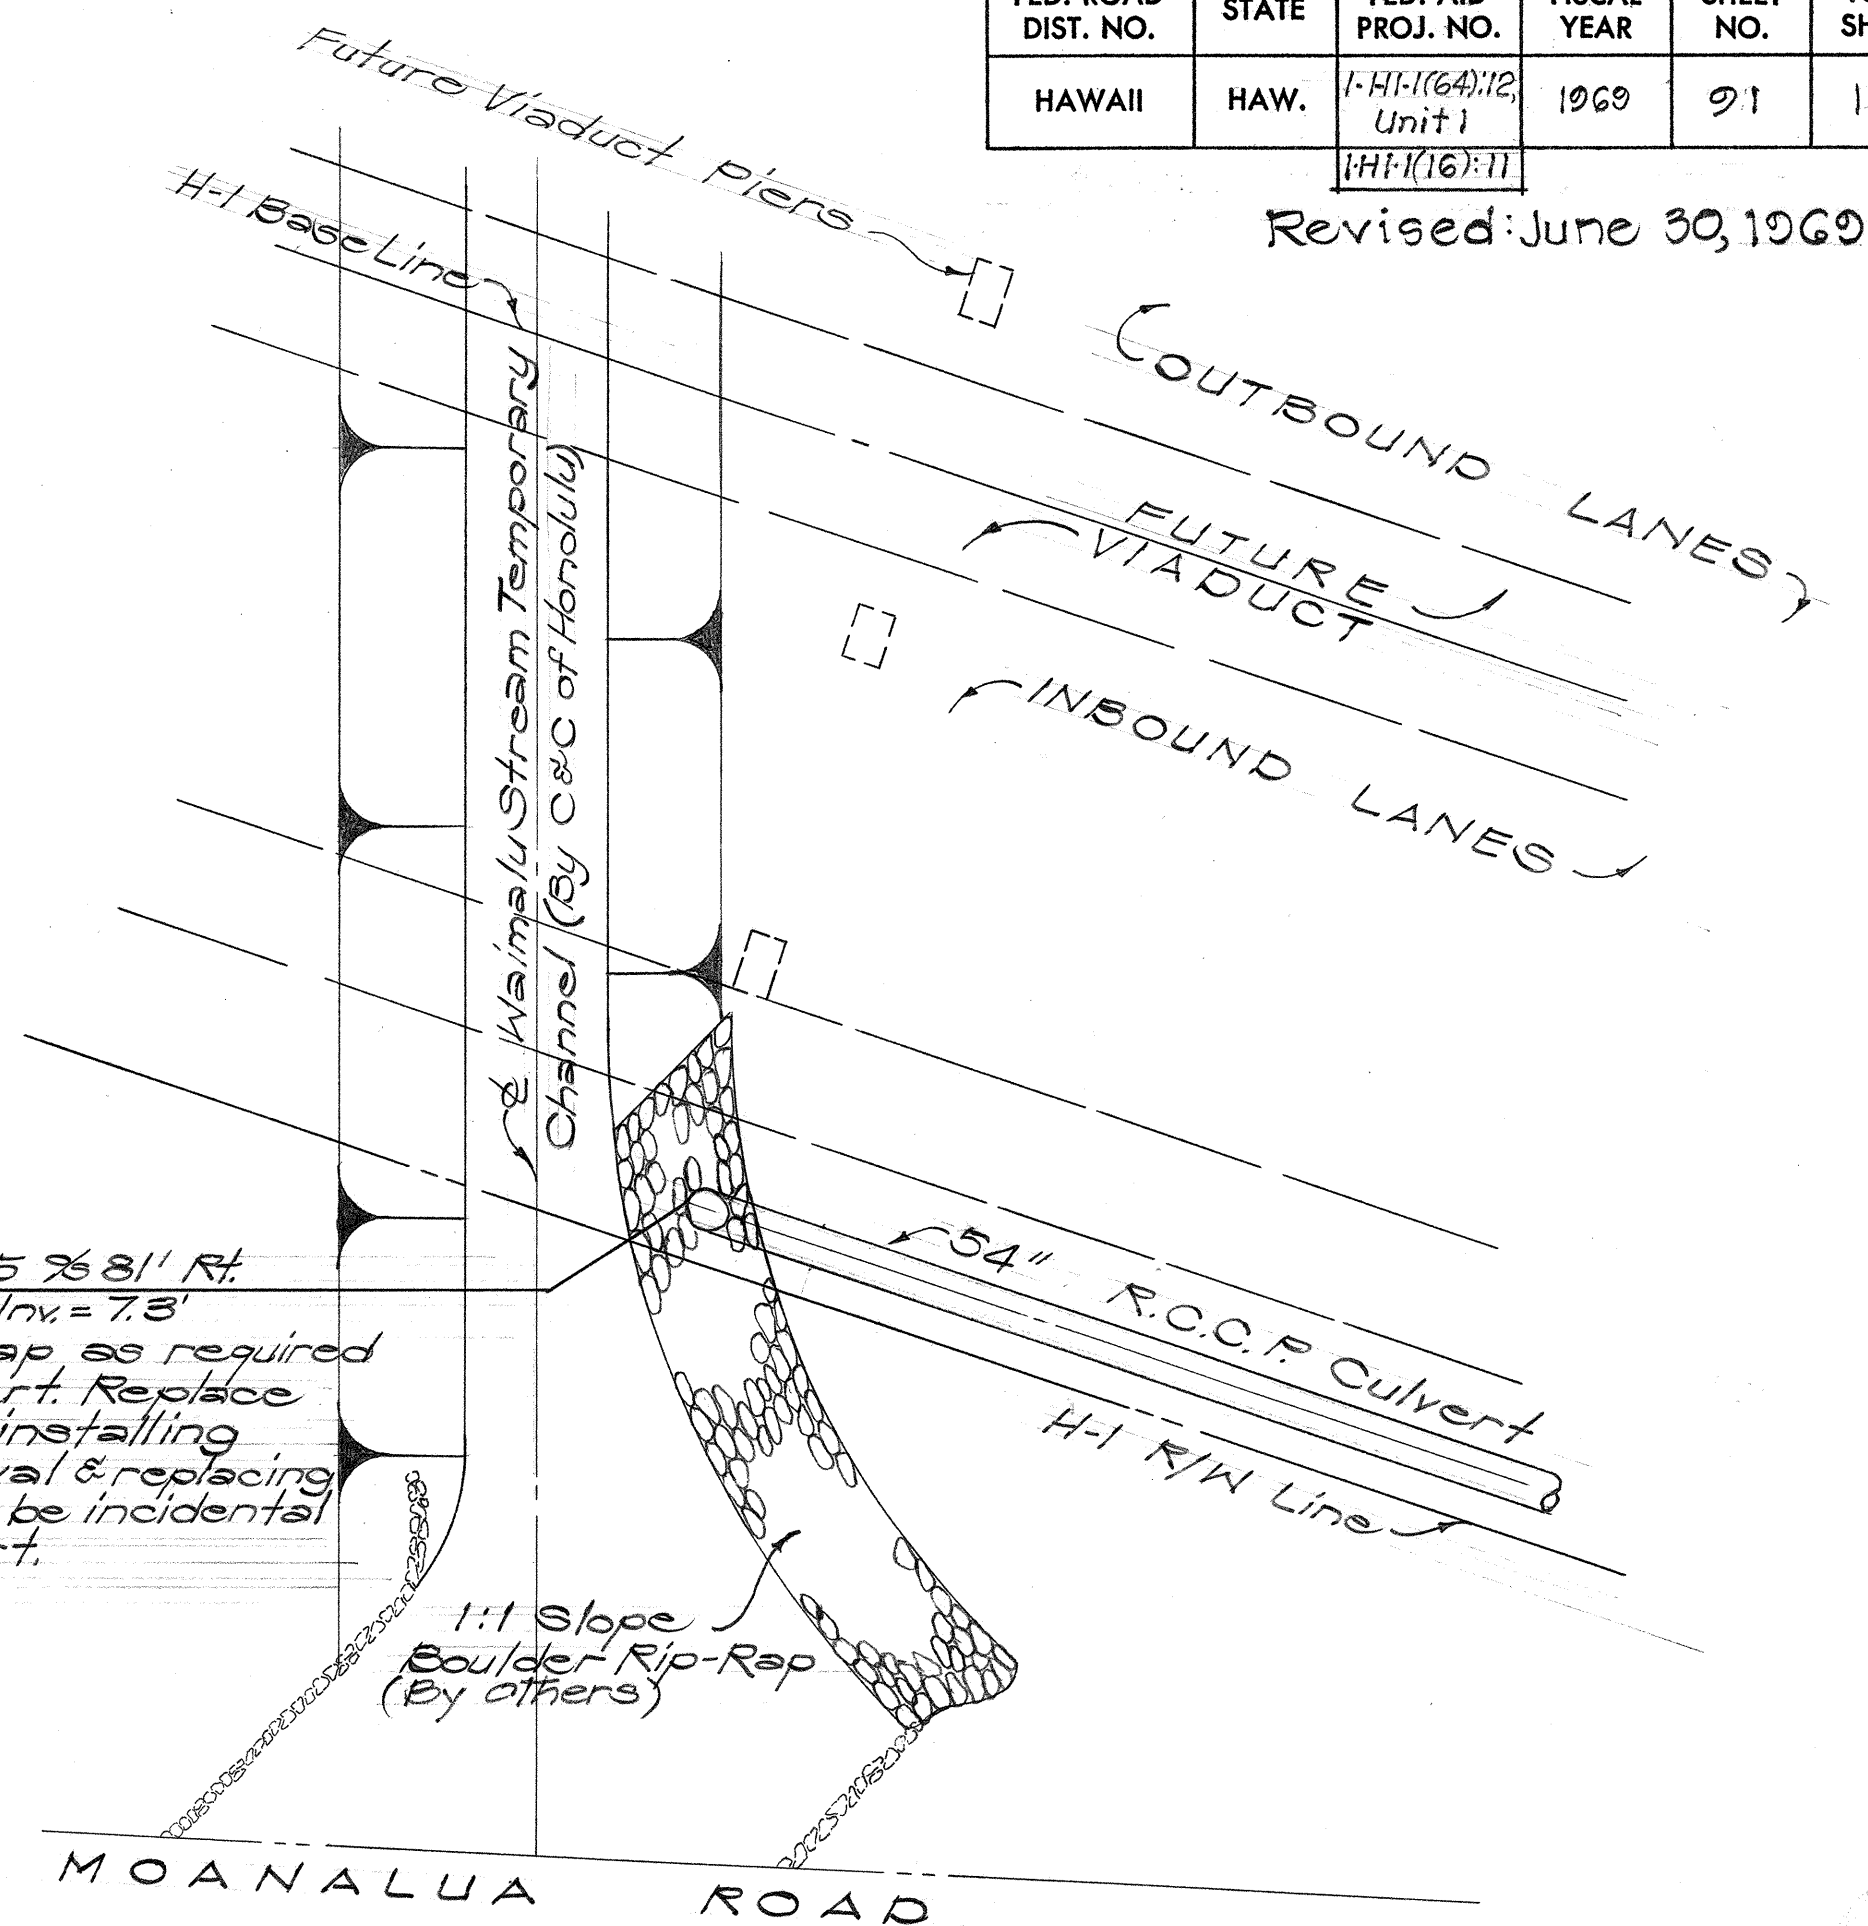

PLAN
Scale: 1" = 20'-0"

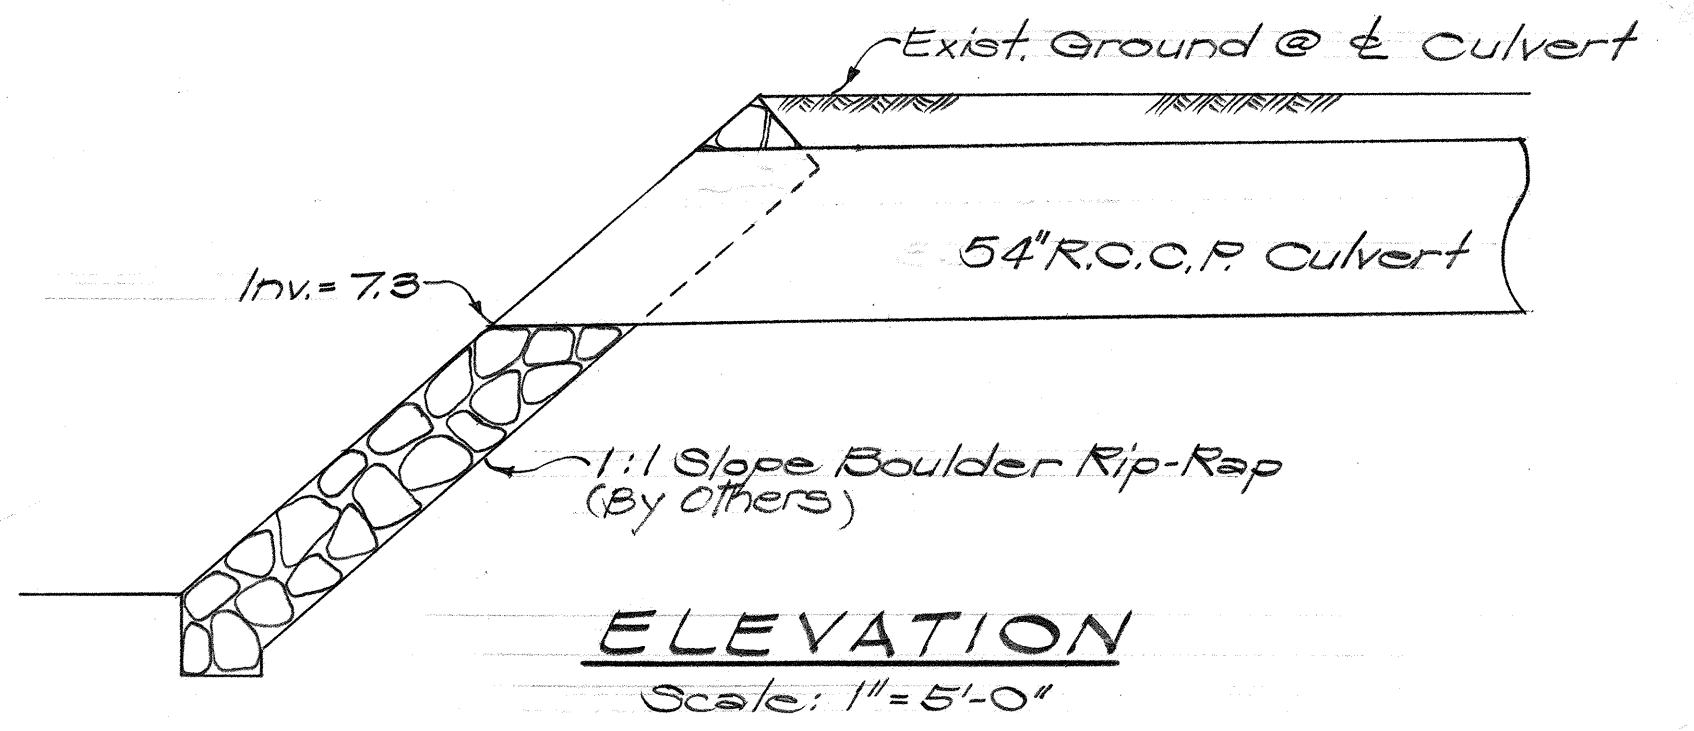

54" R.C.C.P. OUTLET DETAIL
@ STA. 114+07.5

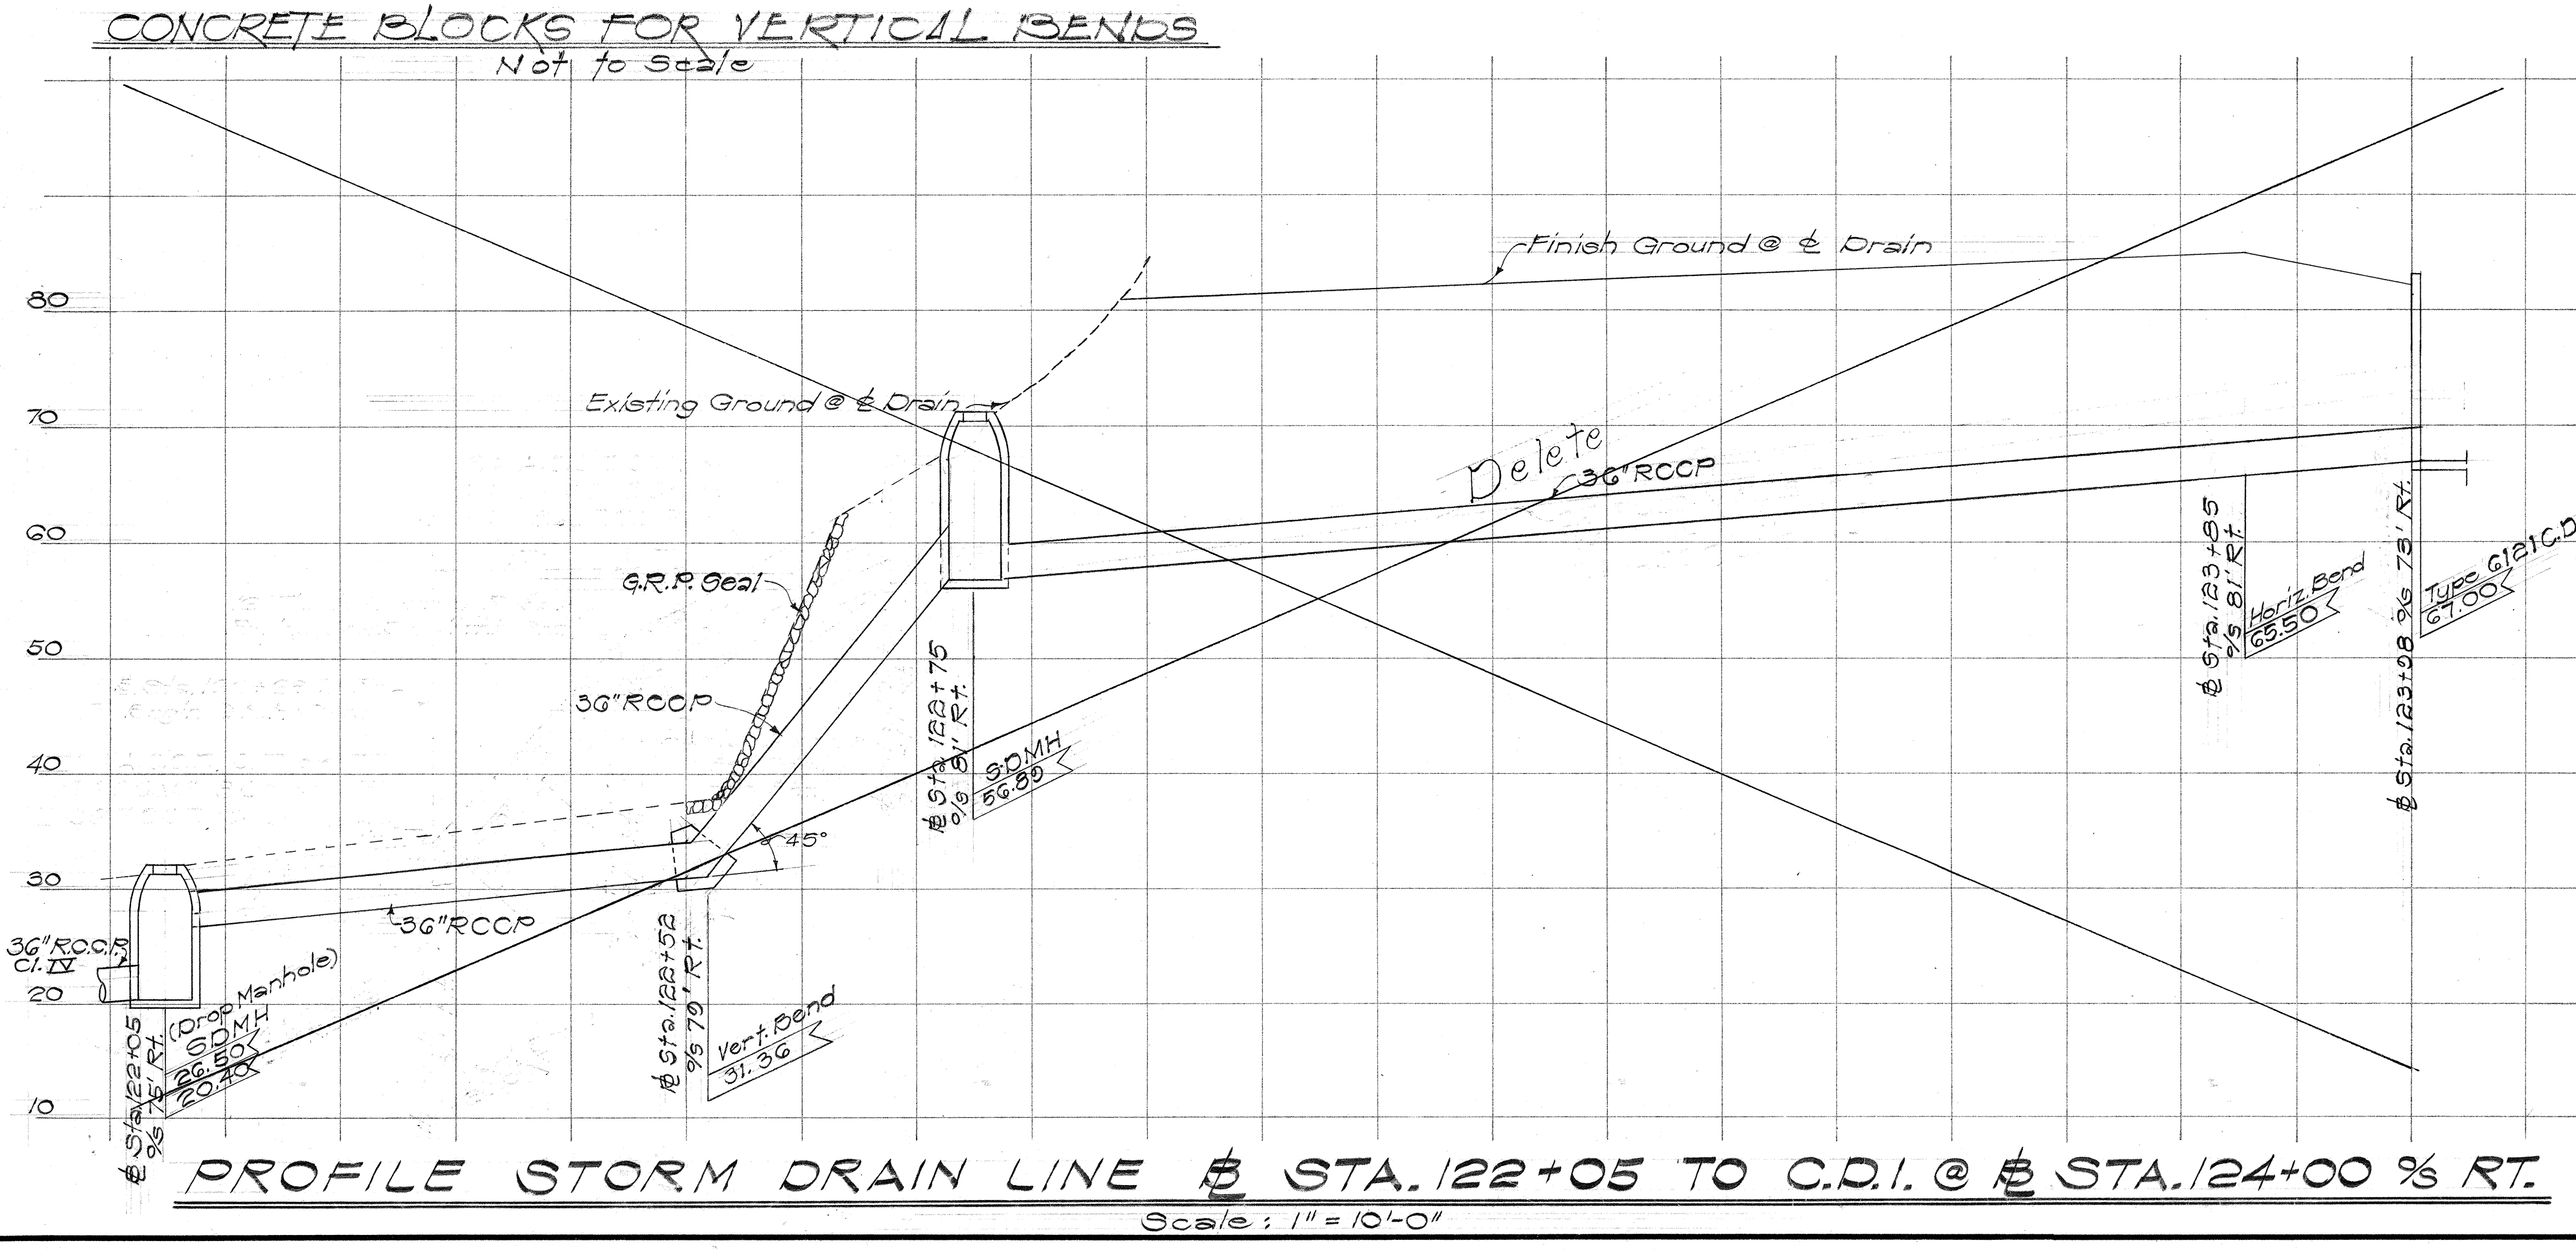

PROFILE STORM DRAIN LINE @ STA. 122+05 TO C.D.I. @ STA. 124+00 % RT.
Scale: 1" = 10'-0"



THIS WORK WAS PREPARED BY ME OR UNDER MY SUPERVISION.

STATE OF HAWAII
DEPARTMENT OF TRANSPORTATION
HIGHWAYS DIVISION

DRAINAGE DETAILS

INTERSTATE ROUTE H-1
PROJ. NO. I-HI-1(64)12,
UNIT 1

Scale: As Shown Date: 8/19/68


SHEET No. 4 OF 20 SHEETS

THIS SHEET SUPERSEDES SHEET NO. 91

C 0 9 1


FED. ROAD DIST. NO.	STATE	FED. AID PROJ. NO.	FISCAL YEAR	SHEET NO.	TOTAL SHEETS
HAWAII	HAW.	4-11-1(64):12 Unit 1	1969	92	158

Revised: June 30, 1969

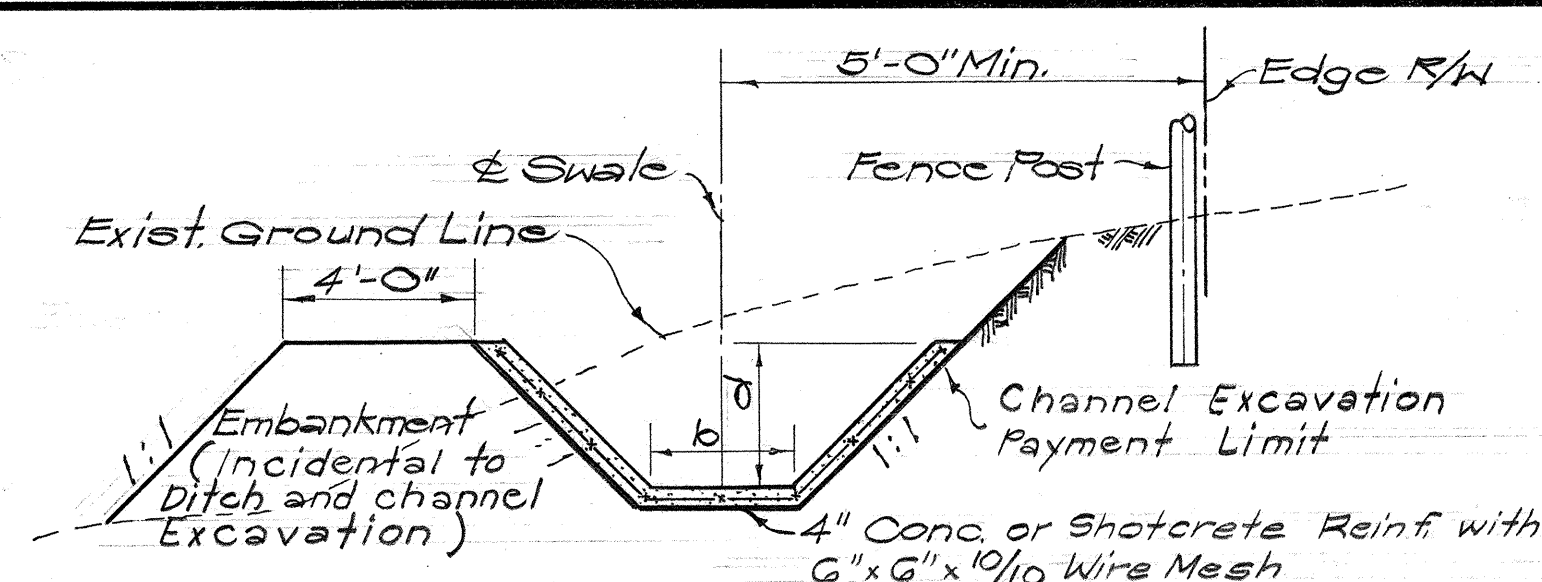


TYPE 1 TYPICAL SECTION
CUT-OFF DITCH (LINED)


Not to Scale

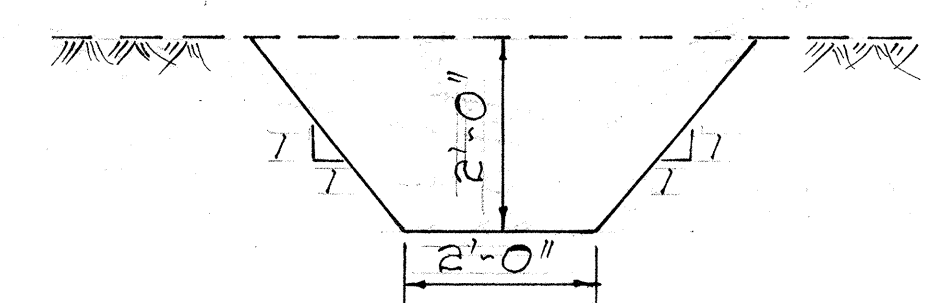


EARTH DITCH AT STA. 165+00 ± TO 167+00 ± LT & RT

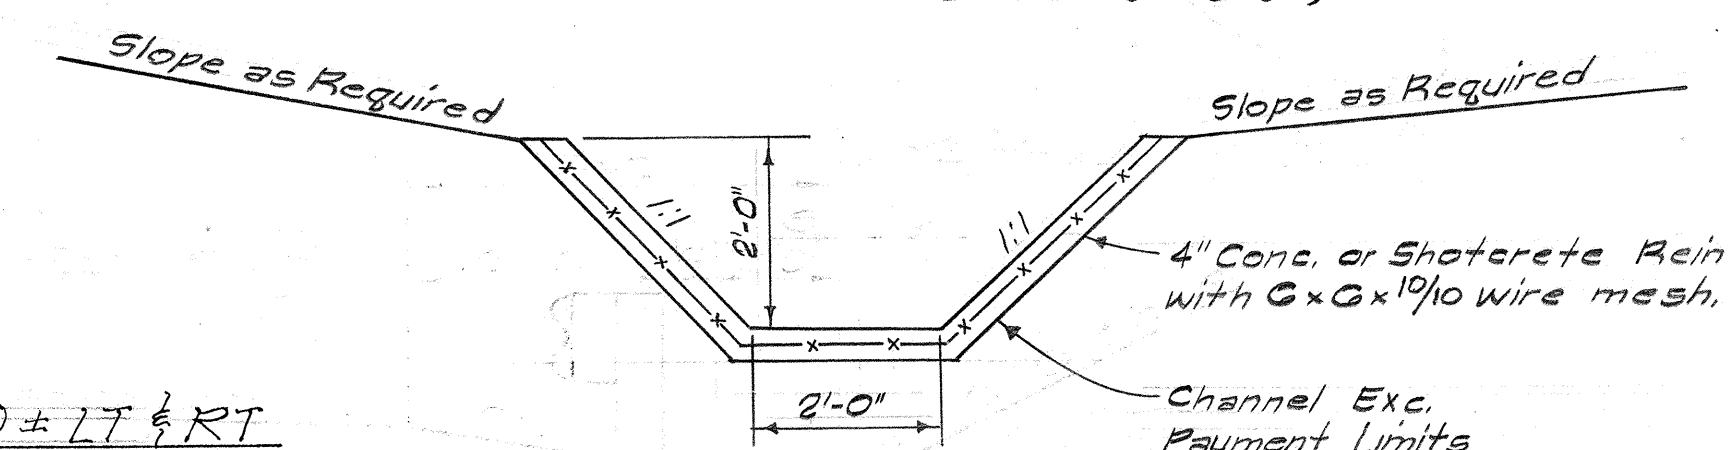


SECTION "C-C"
Scale: $\frac{1}{2}" = 1' - 0"$

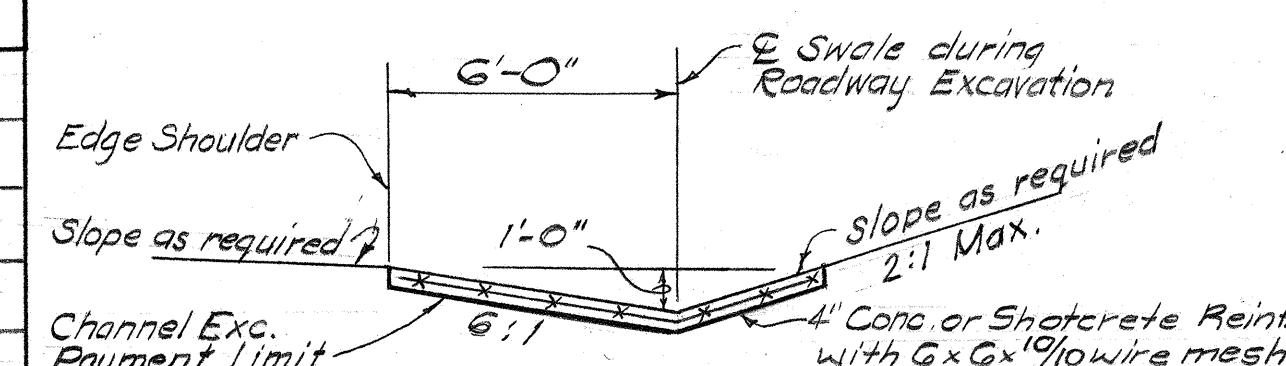[illegible]

SECTION "A-A"
Scale: $\frac{1}{4}'' = 1'-0''$

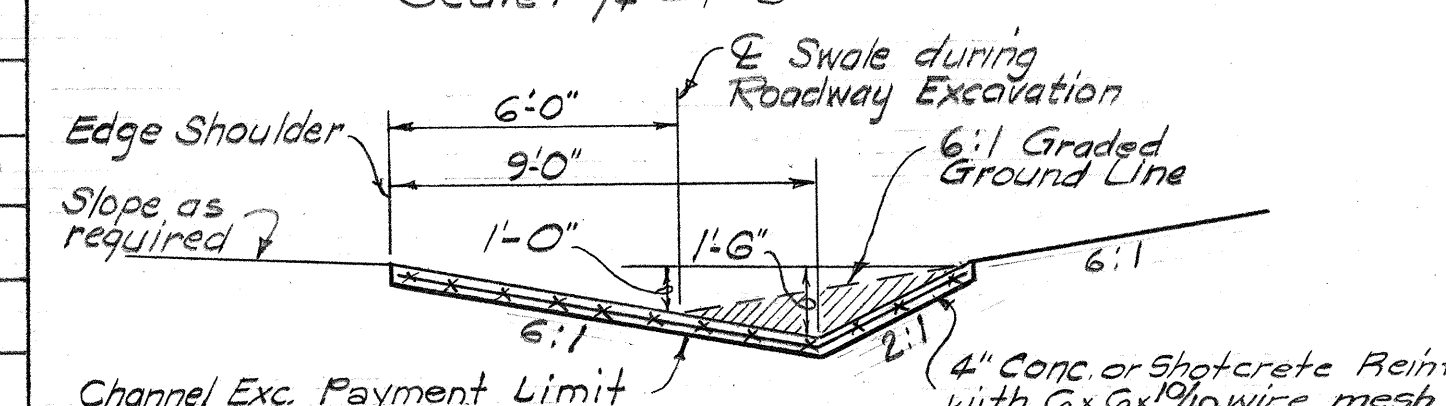


SECTION "B-B"
Scale: 1/4" = 1'-0"

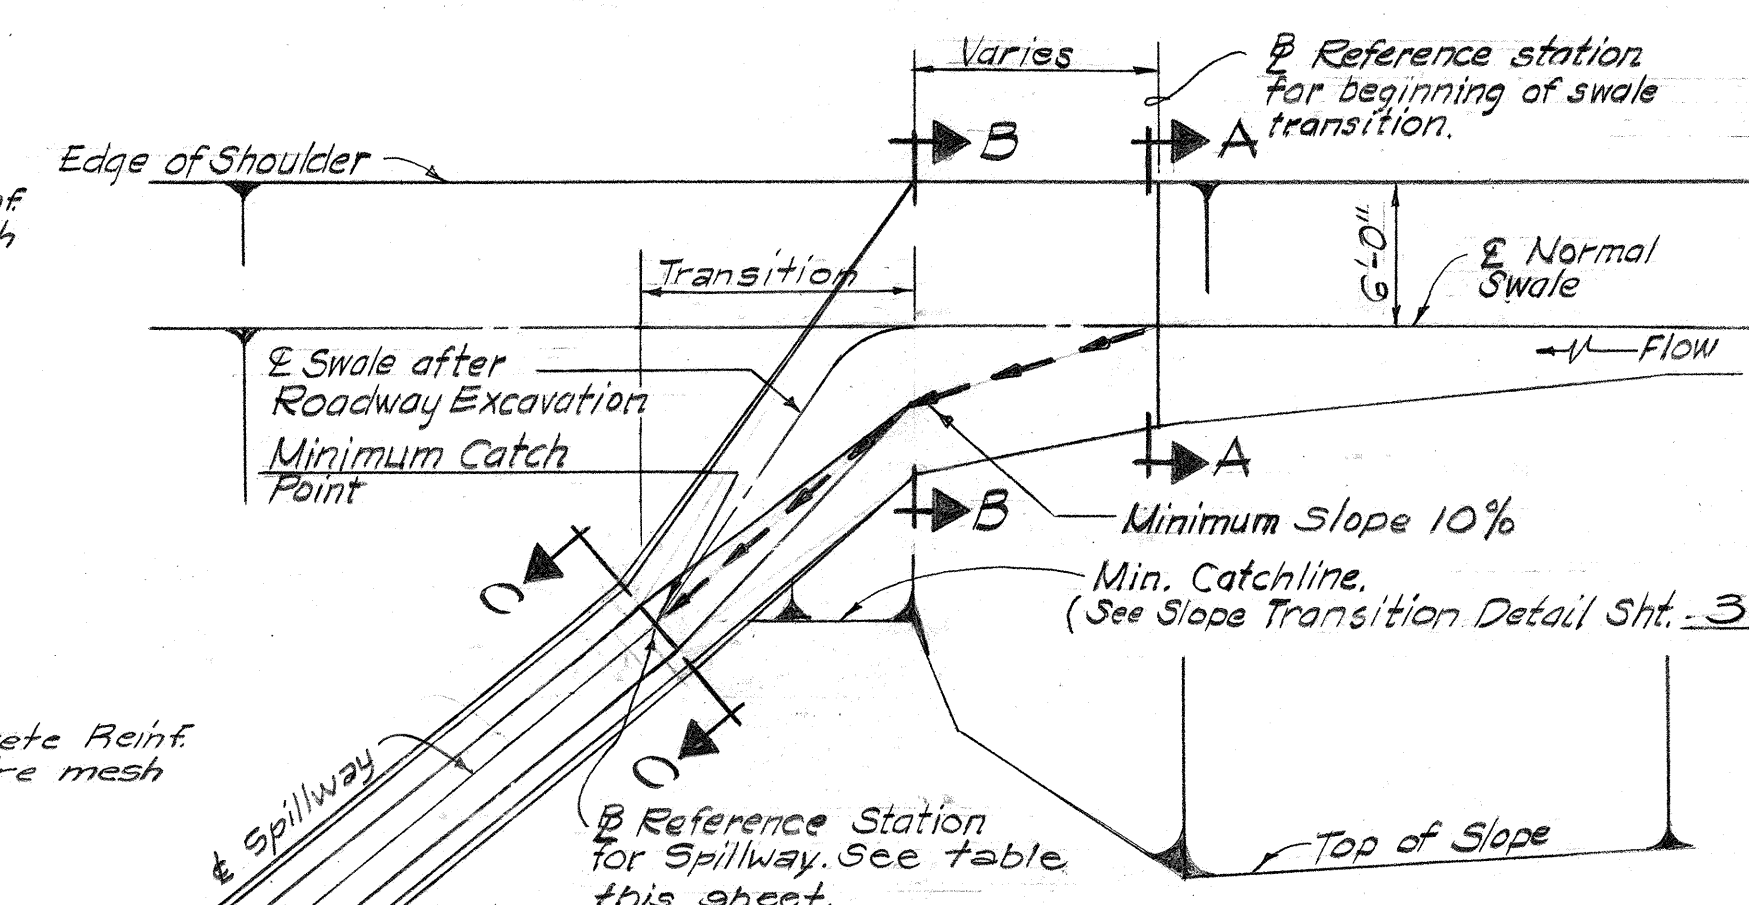

PLAN
SWALE TRANSITION (By Others)
Scale: $\frac{1}{8}'' = 1'-0''$

NOTE:


1. Reverse plan view when flow is in direction opposite to that shown.
2. The plan view and sections for the swale transition are included for information only. The swale transition is by others. The spillway shall be a part of this contract.

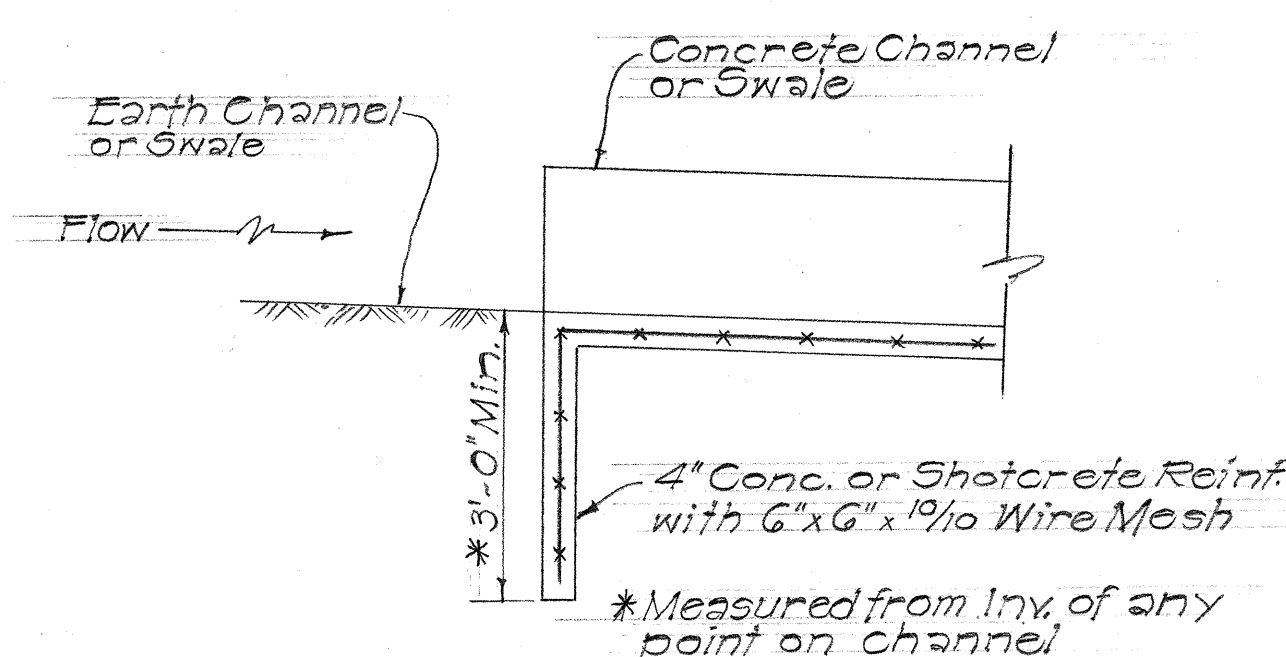

ELEVATION
Not to Scale

TYPICAL EARTH CHANNEL TO
CONCRETE CHANNEL CONNECTION

SPILLWAY REFERENCE STATION AND LOCATION	
145+20	RIGHT
145+25	LEFT
163+40	RIGHT
163+50	LEFT
168+80	RIGHT
169+28	LEFT

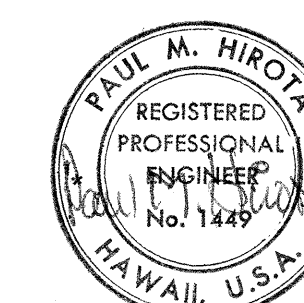

THIS WORK WAS PREPARED BY
ME OR UNDER MY SUPERVISION.

STATE OF HAWAII
DEPARTMENT OF TRANSPORTATION
HIGHWAYS DIVISION

DRAINAGE DETAILS

INTERSTATE ROUTE H-1
PROJ. NO. I-HI-1(G4):12.
UNIT 1

Scale: As Shown Date: 8/19/68


SHEET No. 5 OF 20 SHEETS

CO 92

THIS SHEET SUPERSEDES SHEET NO. 92


PRINTED ON NO. 1000H CLEARBRIN

FED. ROAD DIST. NO.	STATE	FED. AID PROJ. NO.	FISCAL YEAR	SHEET NO.	TOTAL SHEETS
HAWAII	HAW.	1-HI-1(64)12 Unit 1	1963	23	158
		1-HI-1(16)11			

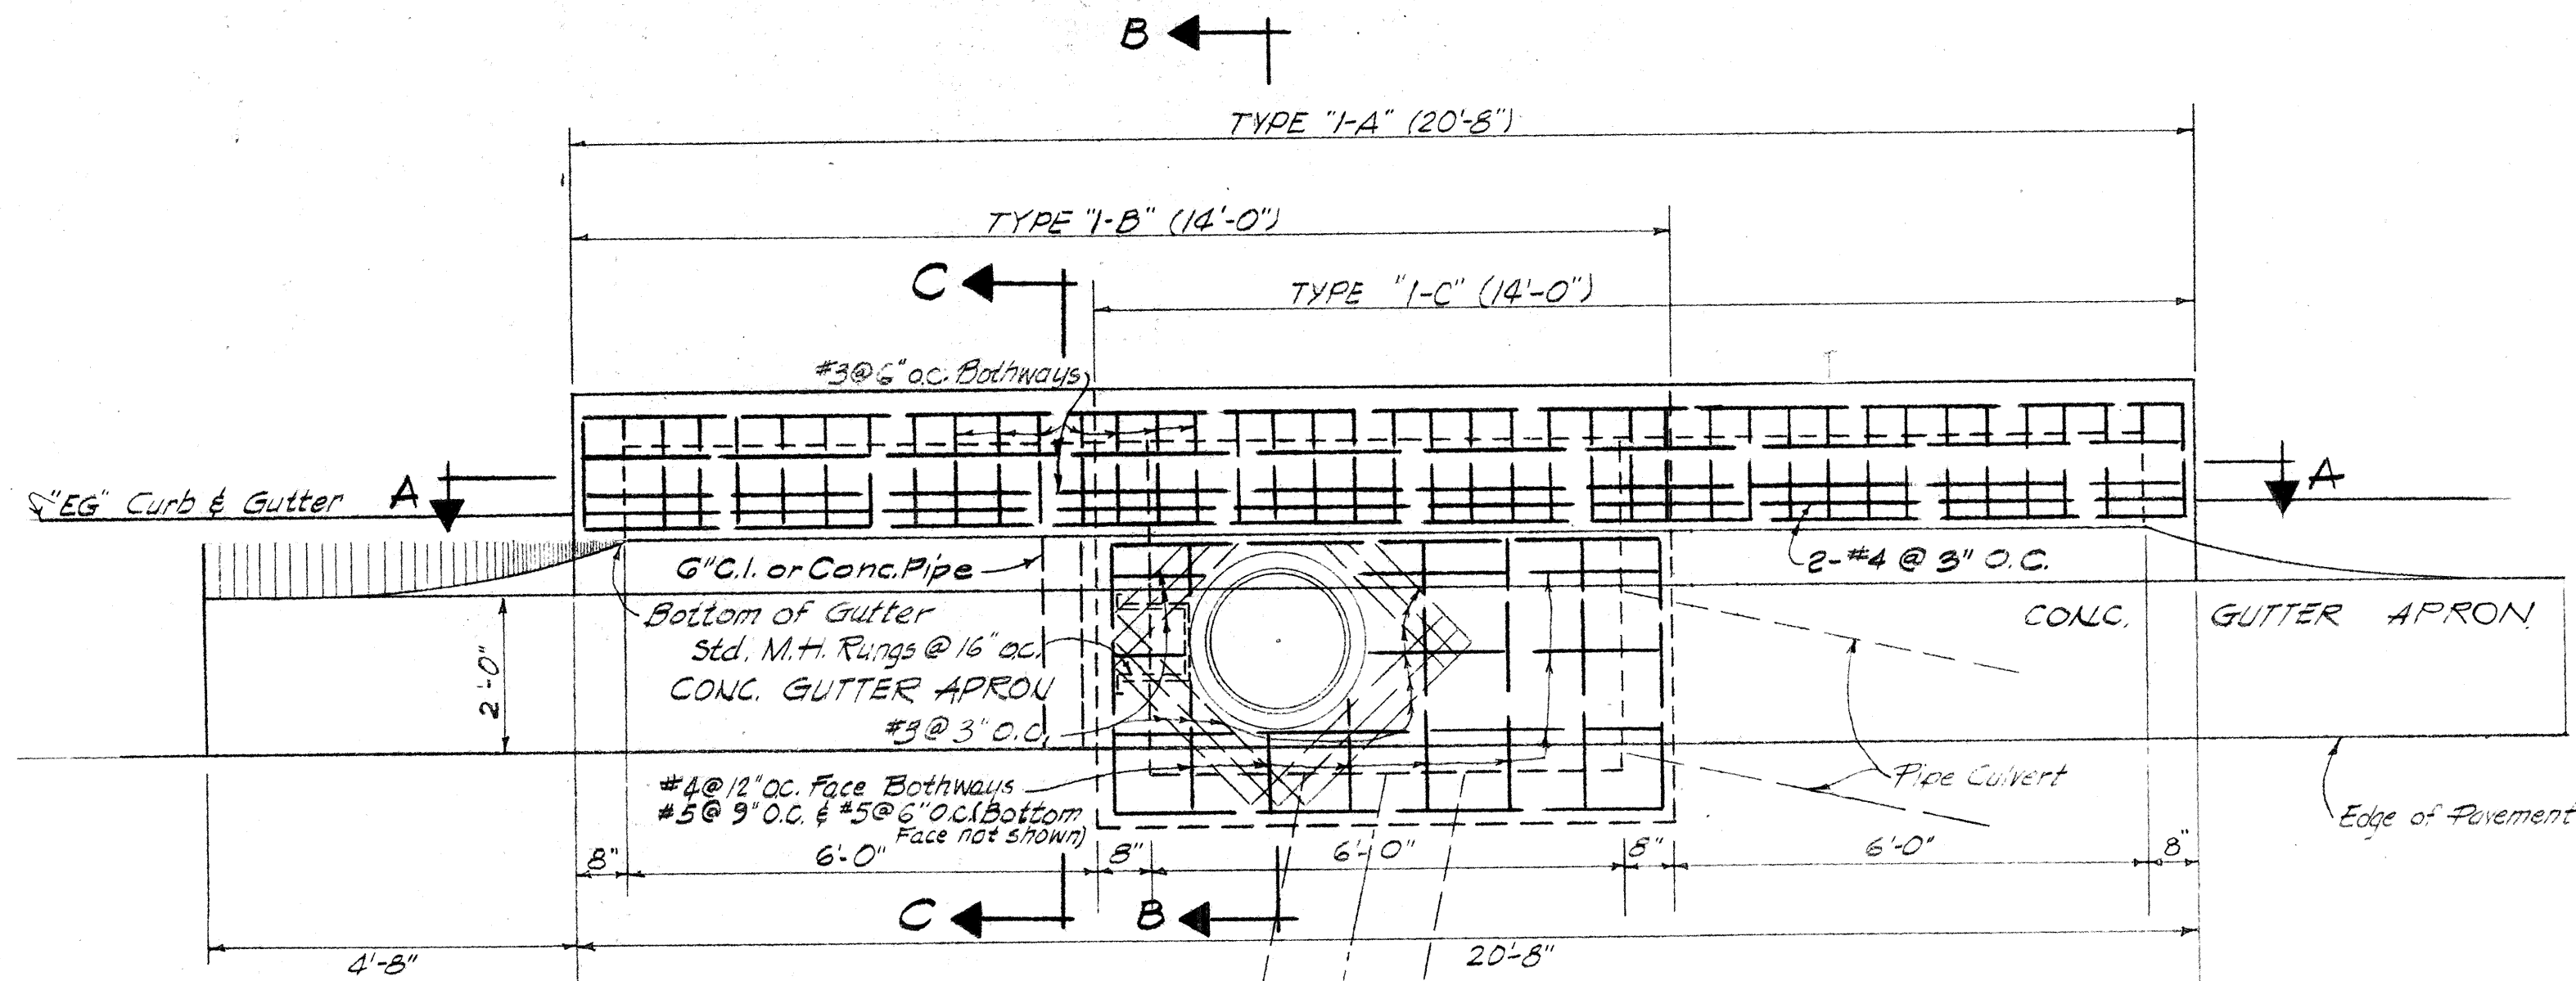


- NOTE:**
- The contractor shall install one 6" cast iron or concrete pipe (two for Type I-A), as incidental to Class A-1 concrete other than at bridges.
 - Culvert shall leave C.B. from any position and any direction indicated by plans or ordered by the Engineer. Culvert may both enter and leave C.B.
 - Location of frame and cover and/or standard manhole rungs shall be determined by Engineer.

PLAN
Scale: 1/2" = 1'-0"

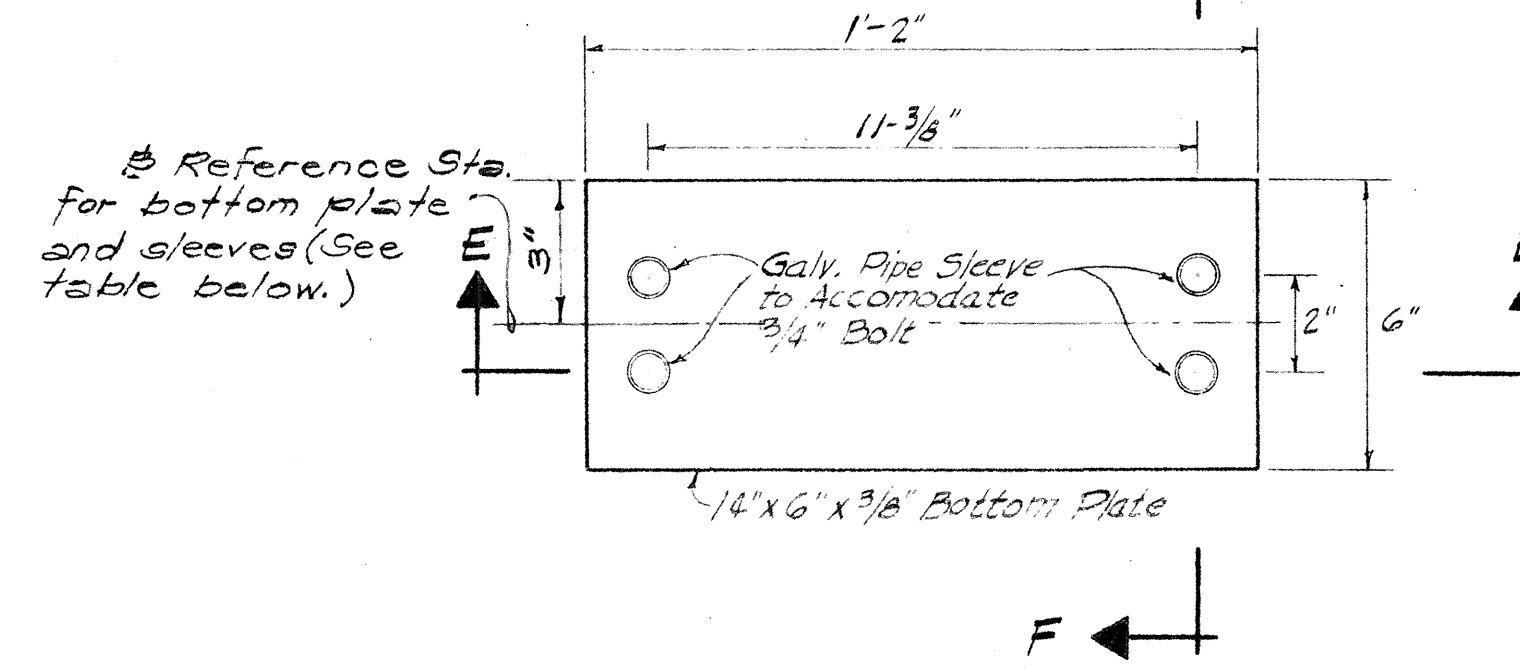


PLAN
Scale: 3" = 1'-0"

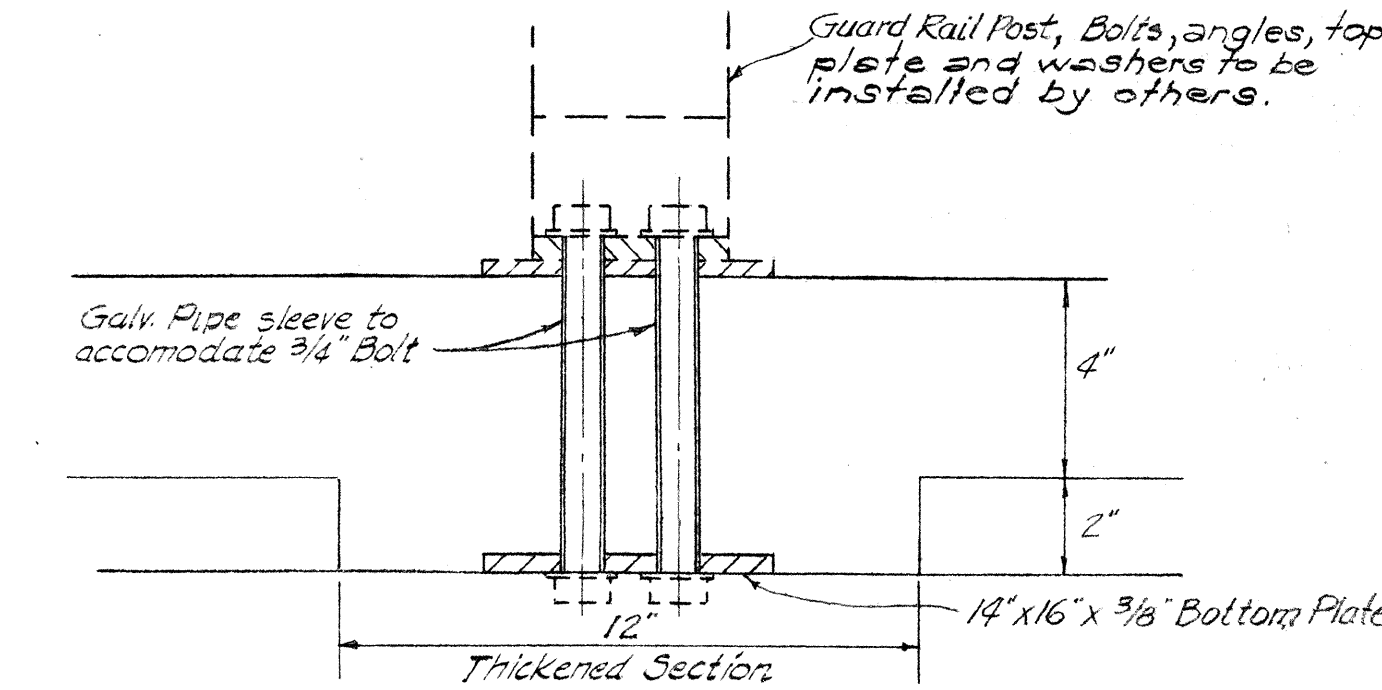

SECTION F-F
Scale: 3" = 1'-0"


- NOTE:**
- Bottom plate assembly (bottom plate and sleeves) shall be installed with roof slab, incidental to reinforcing steel.
 - Exposed surfaces of the bottom plate assembly shall be painted with one prime coat and two field coats, in accordance with Section 49 of the Specifications. The choice of field coat shall be at the Contractor's option.
 - Reinforcing for top slab similar to reinforcing for Type 'I-A', 'I-B' or 'I-C', except for thickened section.
 - The bottom plate shall be Hot-Dipped Galvanized after assembly and prior to painting.

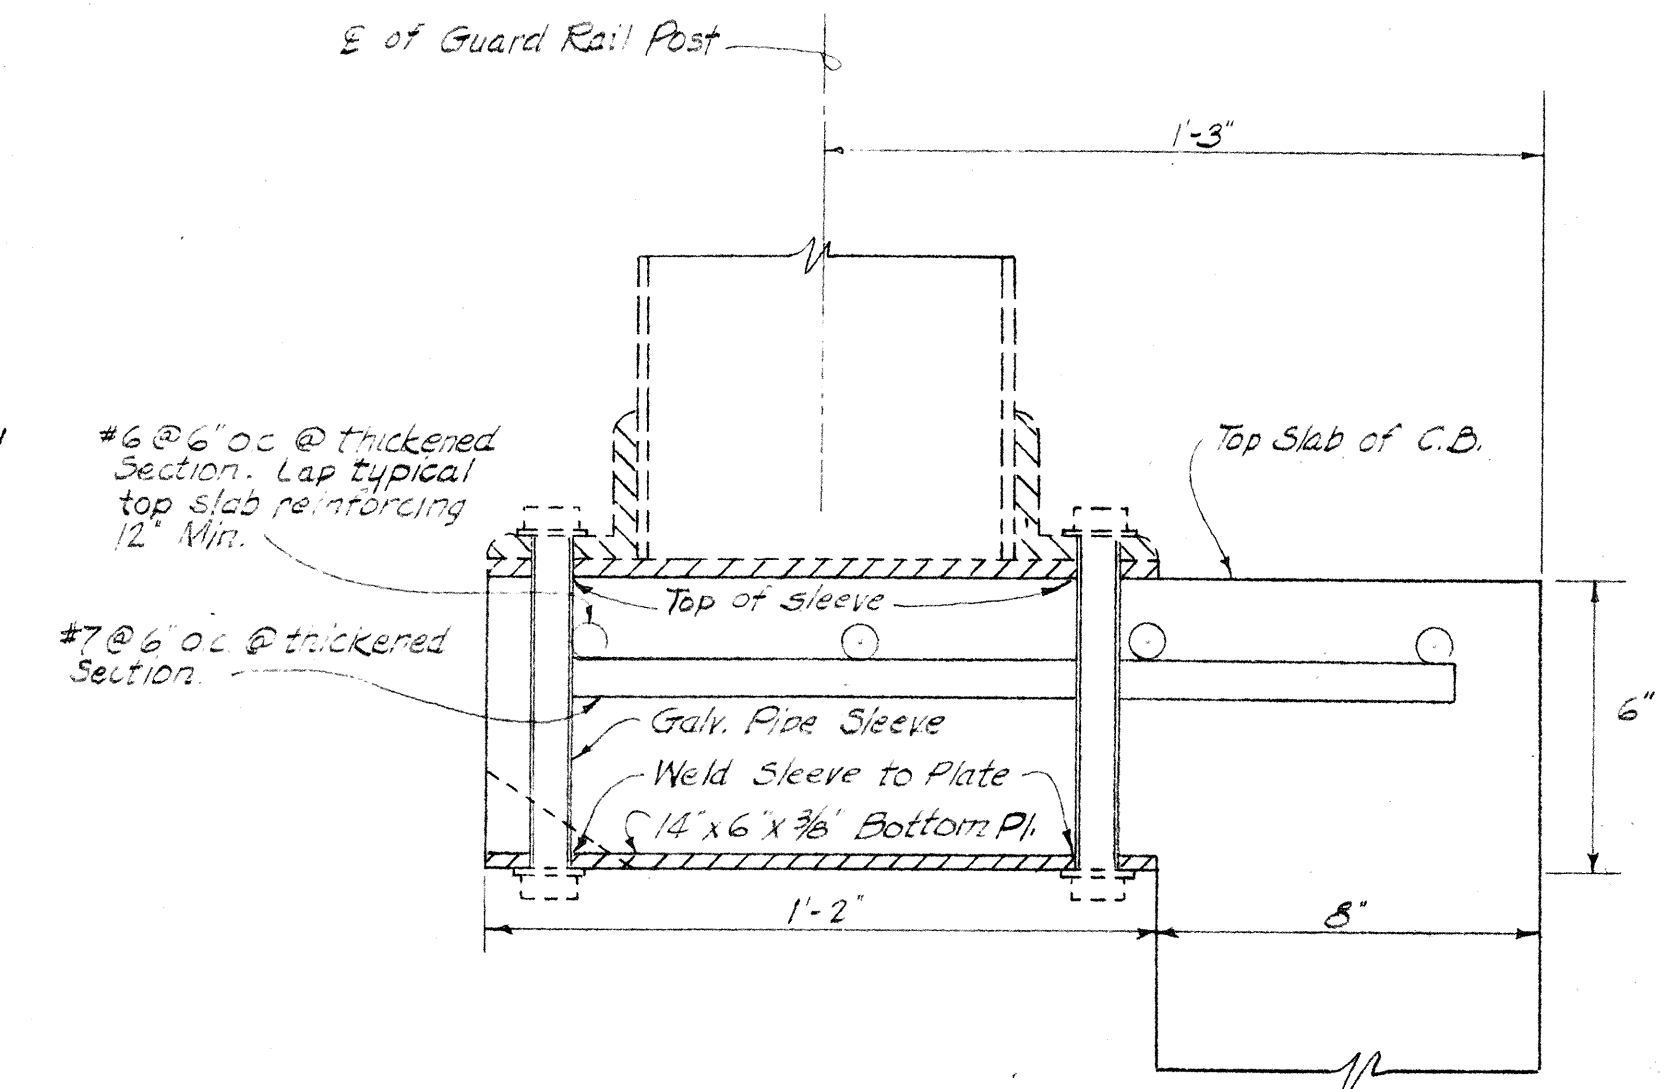

SECTION E-E
Scale: 3" = 1'-0"


DETAIL OF BOTTOM PLATE ASSEMBLY FOR GUARD RAIL POST CONNECTION

BOTTOM PLATE ASSEMBLY LOCATION		REFERENCE STATION FOR BOTTOM PLATE ASSEMBLY			
TYPE	LOCATION	183+08.41	183+09.00	183+09.25	183+12.50
"I-A"	183+08.41	183+09.00	183+09.25	183+12.50	
"I-A"	183+09.00	183+09.25	183+12.50		
"I-A"	186+12.00	186+64.50	186+70.75	186+77.00	

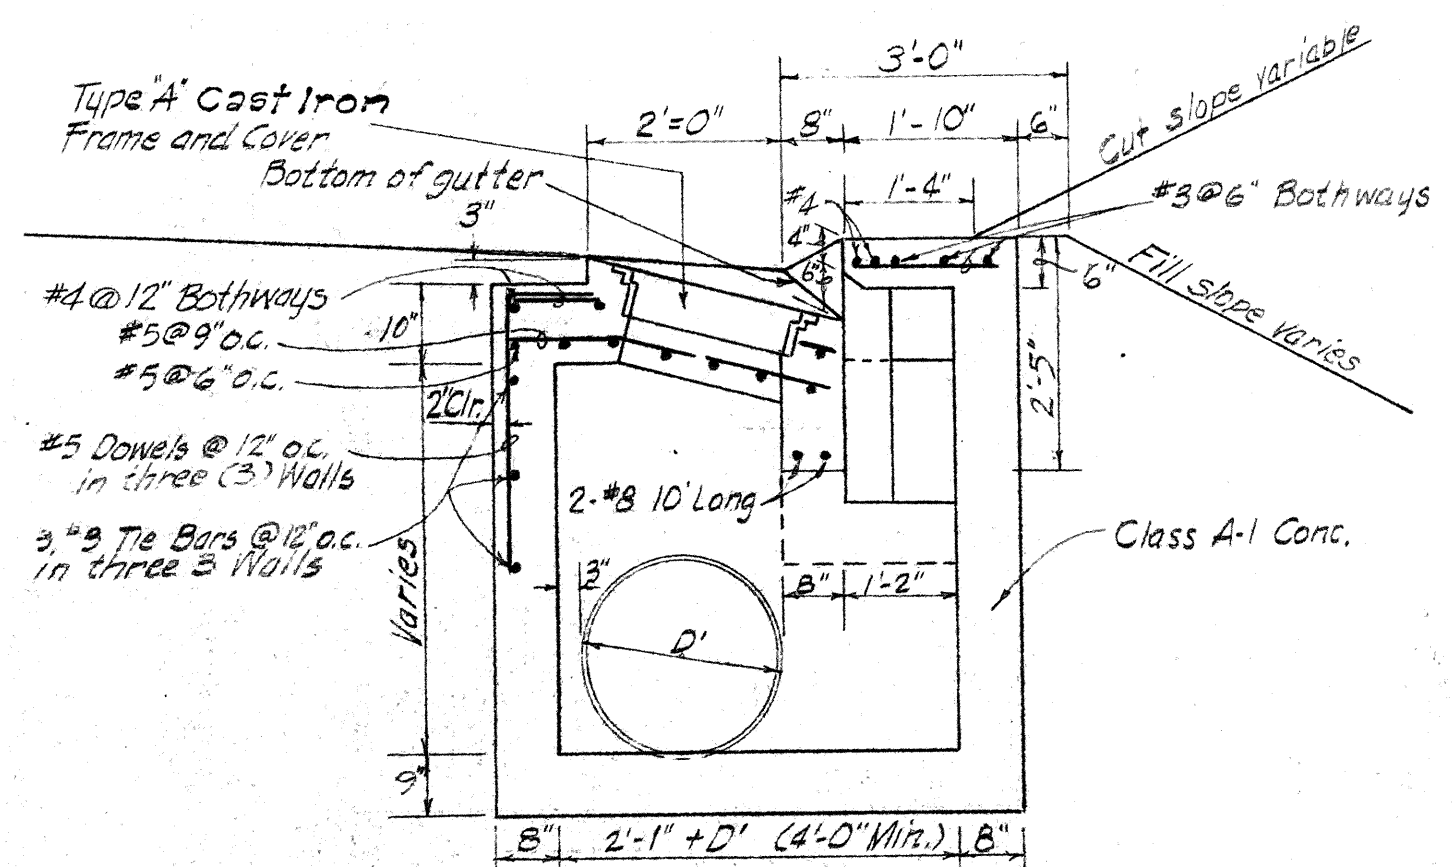


SECTION B-B
Scale: 1/2" = 1'-0"

DETAIL OF TYPE 'I-A', 'I-B' AND 'I-C' CATCH BASIN

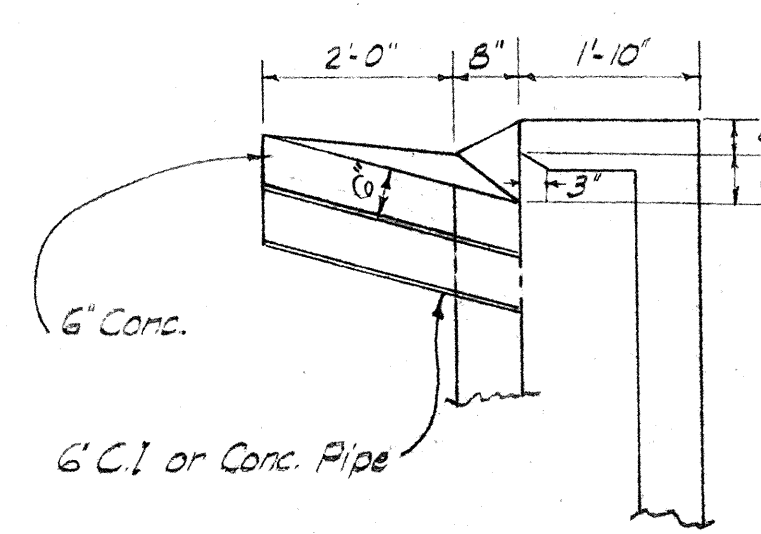

SECTION C-C
Scale: 1/2" = 1'-0"

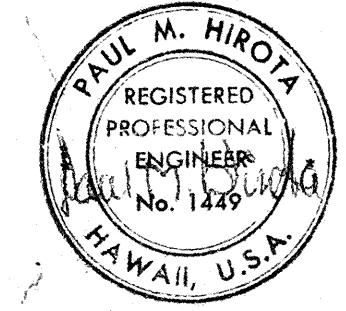

THIS WORK WAS PREPARED BY ME OR UNDER MY SUPERVISION.

STATE OF HAWAII
DEPARTMENT OF TRANSPORTATION
HIGHWAYS DIVISION

DRAINAGE DETAILS

INTERSTATE ROUTE H-1
PROJ. NO. 1-HI-1(64)12,
UNIT 1


Scale: As Shown Date: 8/19/68

SHEET NO. 6 OF 20 SHEETS


SURVEY PLOTTED BY	DATE
DRAWN BY	
CHECKED BY	
DESIGNED BY	
QUANTITIES BY	
NOTED BY	
CHECKED BY	

FED. ROAD DIST. NO.	STATE	FED. AID PROJ. NO.	FISCAL YEAR	SHEET NO.	TOTAL SHEETS
HAWAII	HAW.	1-HI-1(64)12 Unit 1	1960	94	158

*4'-0" x 1'-6" Opening - Type 1 C.D.I. Only

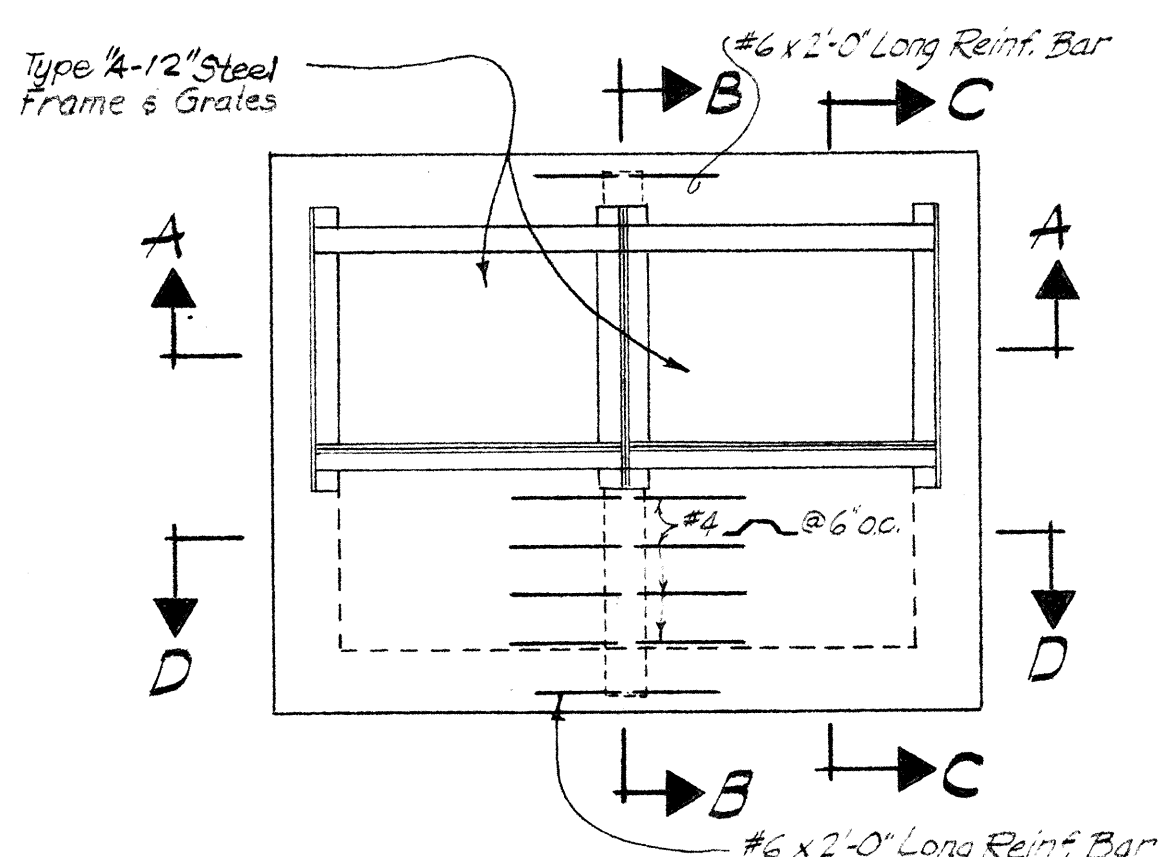


PLAN
Scale: 1/2" = 1'-0"

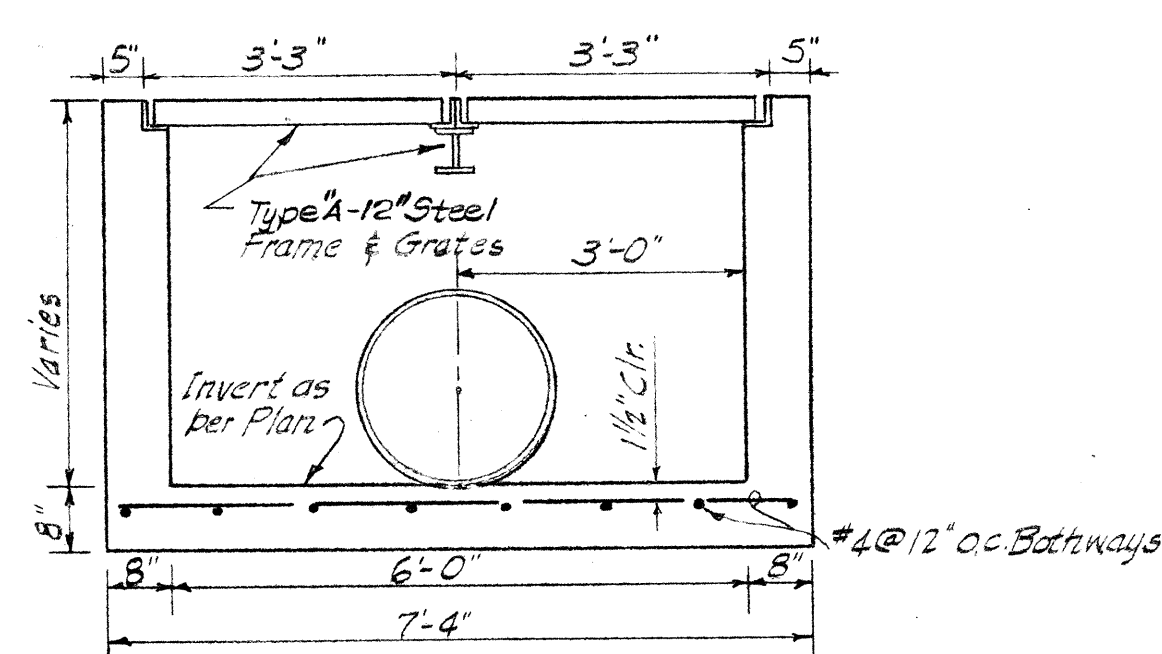


SECTION A-A
Scale: 1/2" = 1'-0"

CATCH BASIN - TYPE "I-D"

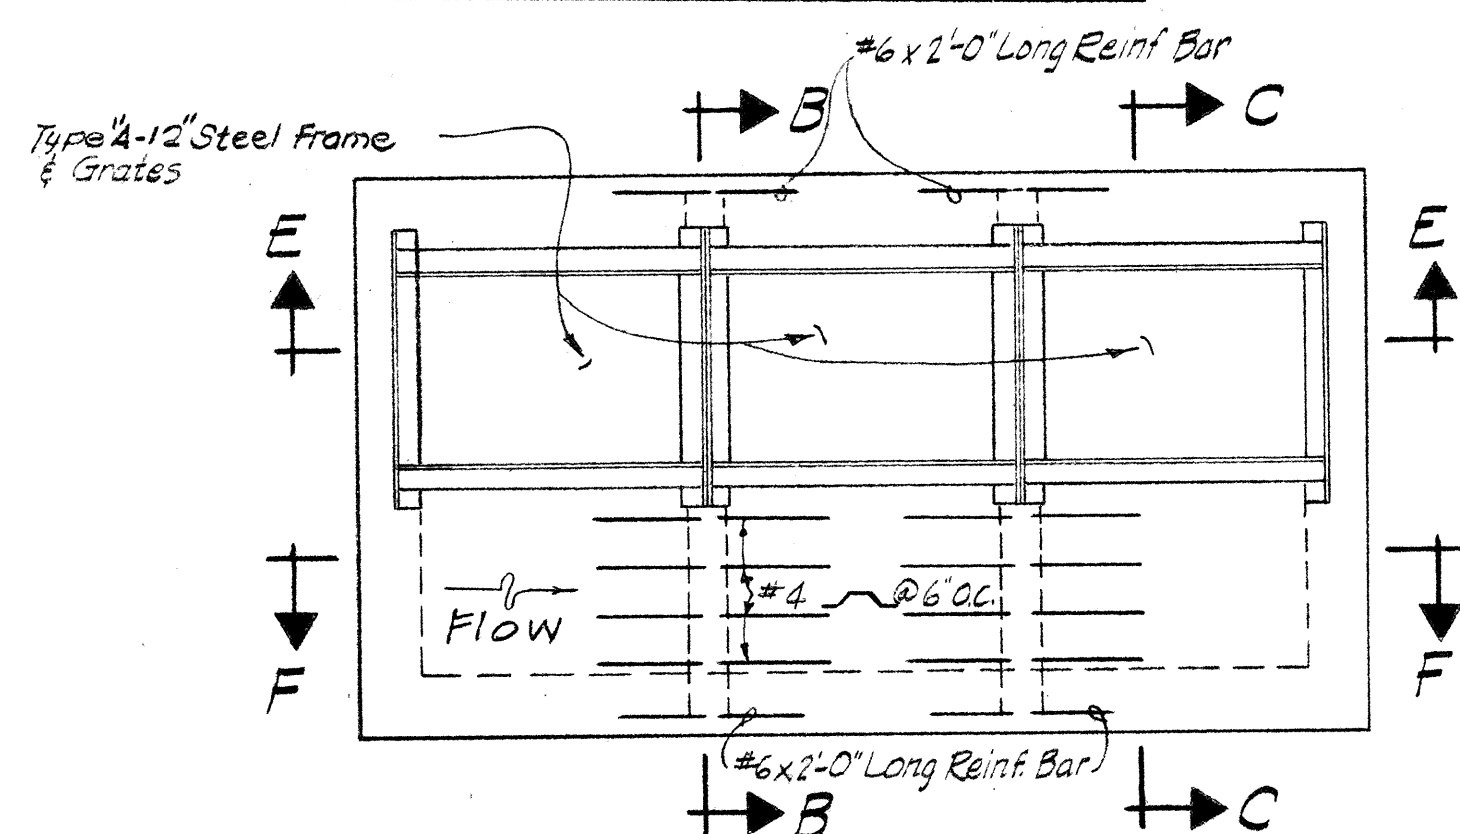


PLAN
Scale: 1/2" = 1'-0"

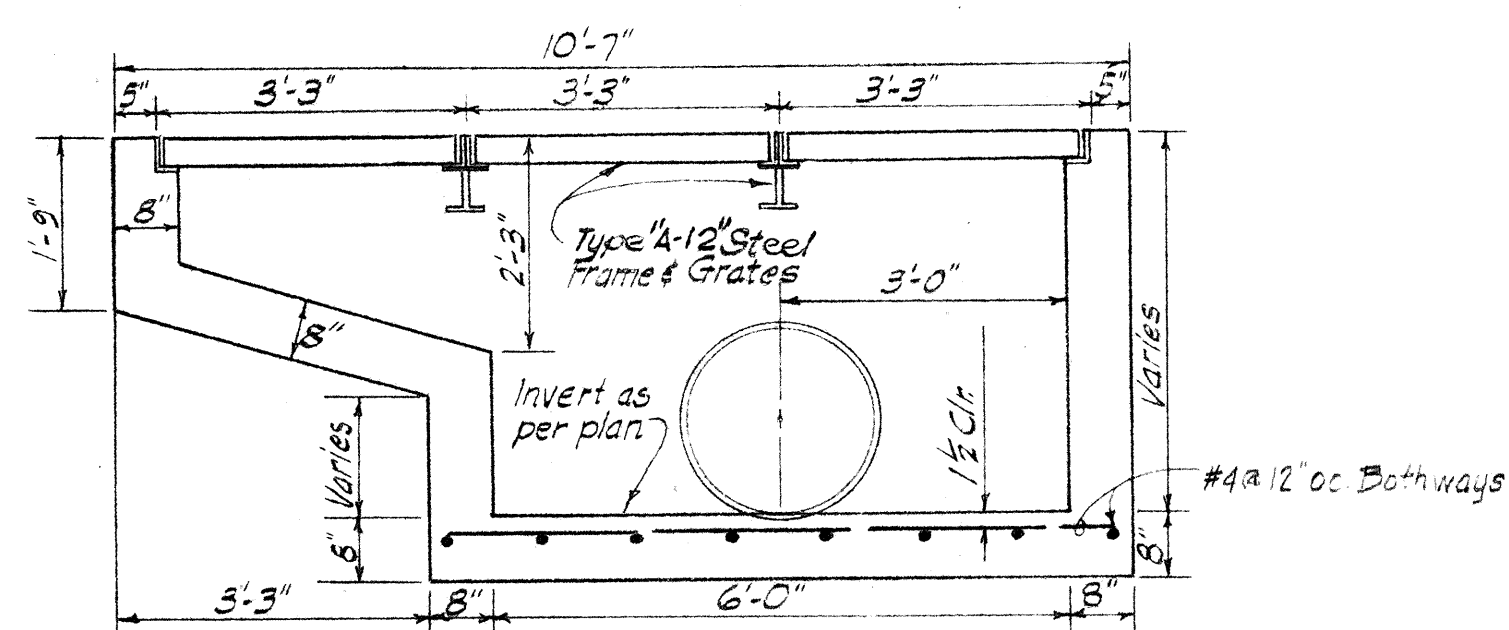


SECTION E-E
Scale: 1/2" = 1'-0"

CATCH BASIN - TYPE "I-E"

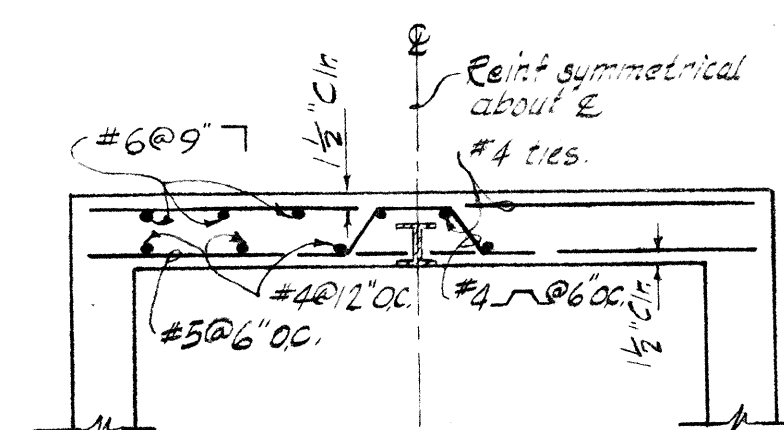

SECTION D-D
Scale: 1/2" = 1'-0"

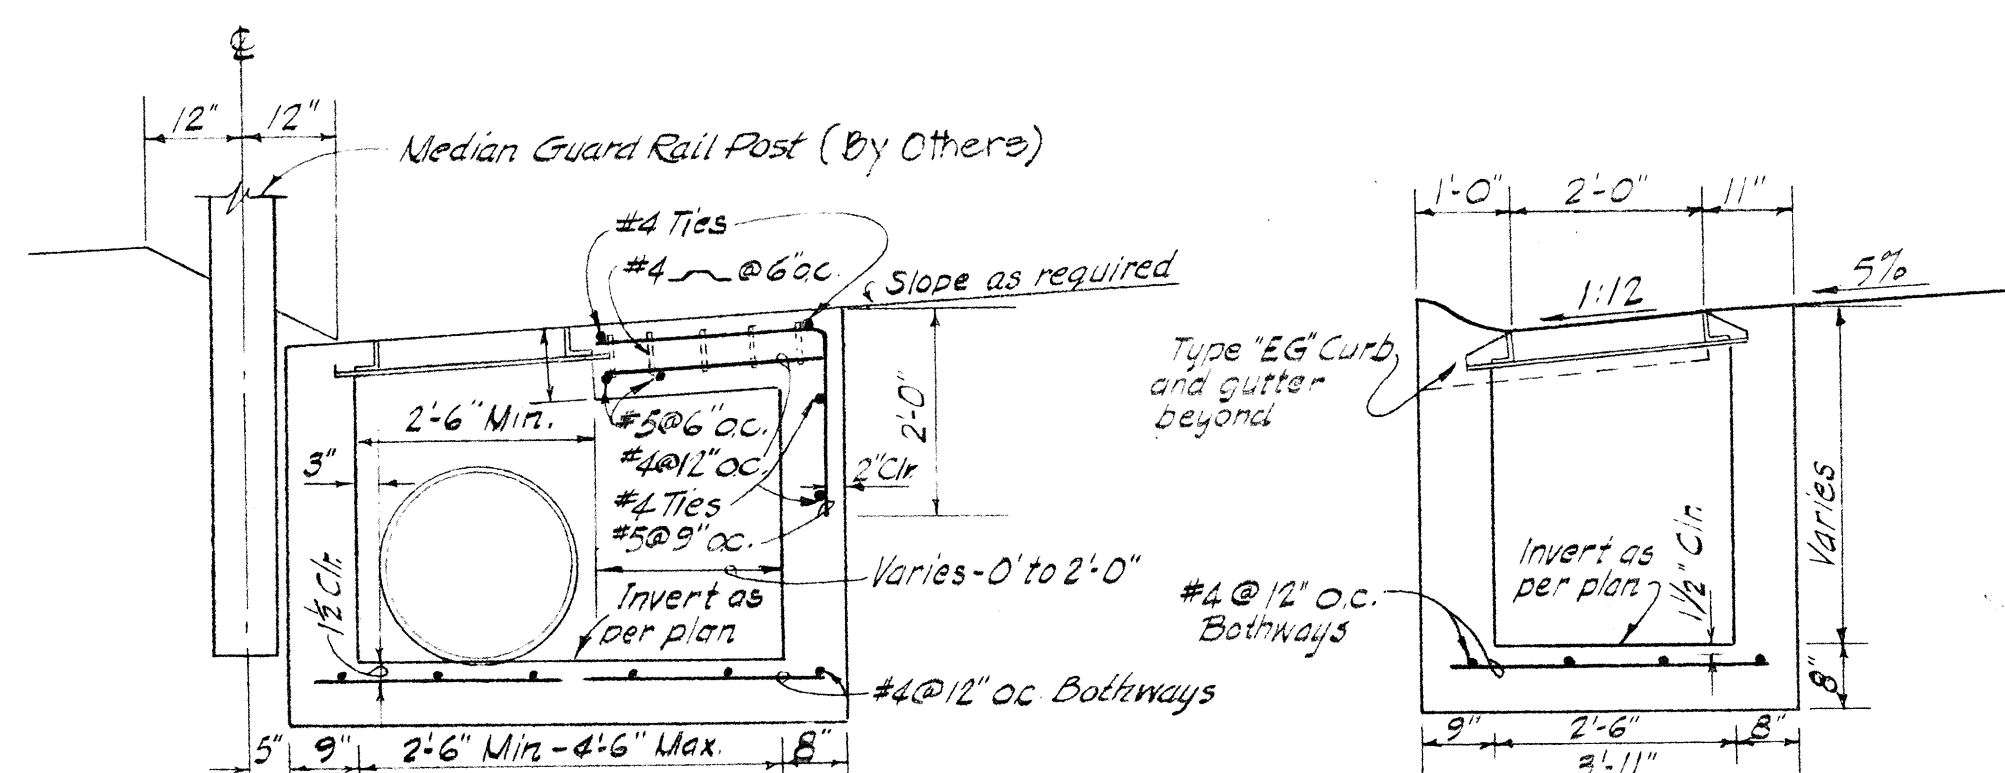


(IN MEDIAN AREAS)

(AT CURB & GUTTER SECTIONS)


TYPICAL SECTIONS "C-C"

Scale: 1/2" = 1'-0"

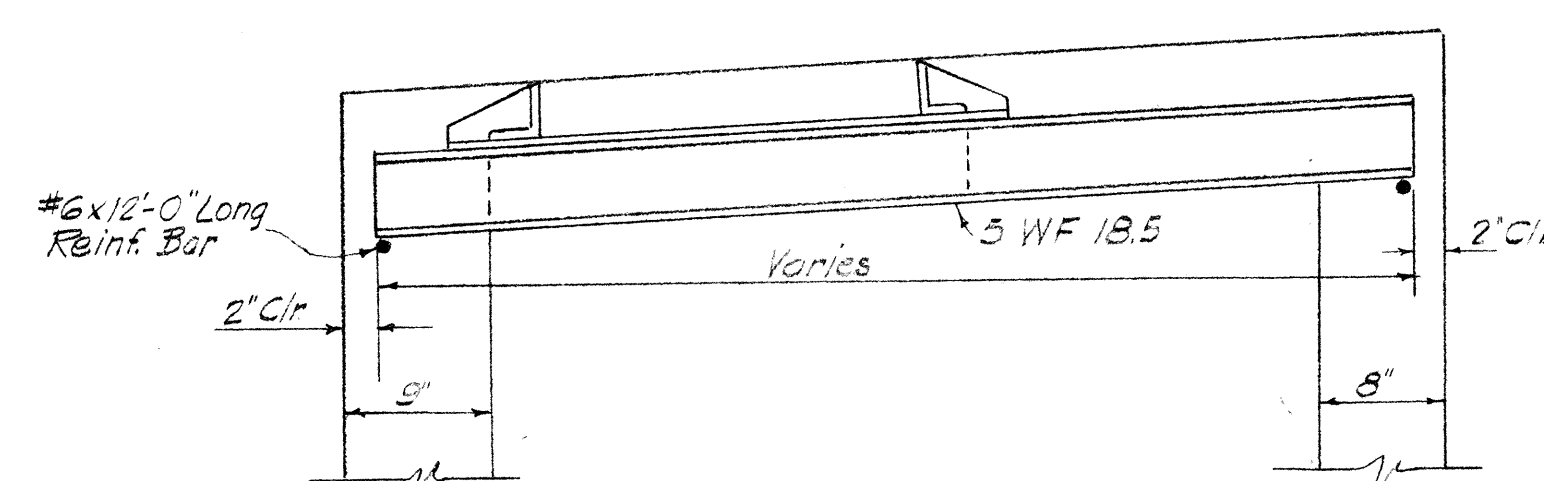

TYPICAL SECTIONS "B-B"


Scale: 1" = 1'-0"

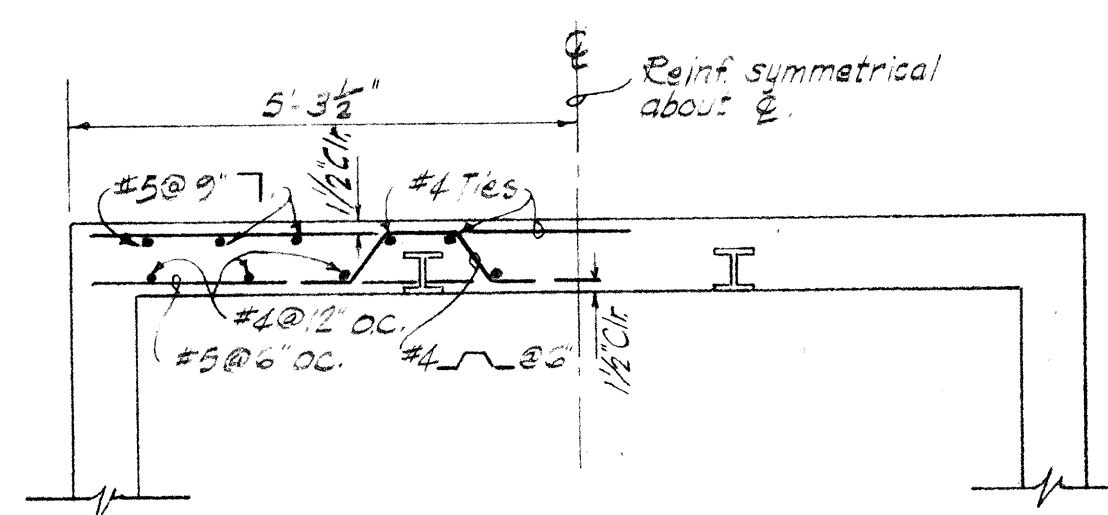


SECTION F-F
Scale: 1/2" = 1'-0"

NOTES (For CB's Only):

1. Reinforcing steel in top slab and walls to be incidental to Type "A-18" Steel Frame and Grates. Reinforcing steel in bottom slab to be paid for as Reinforcing steel other than in bridges.

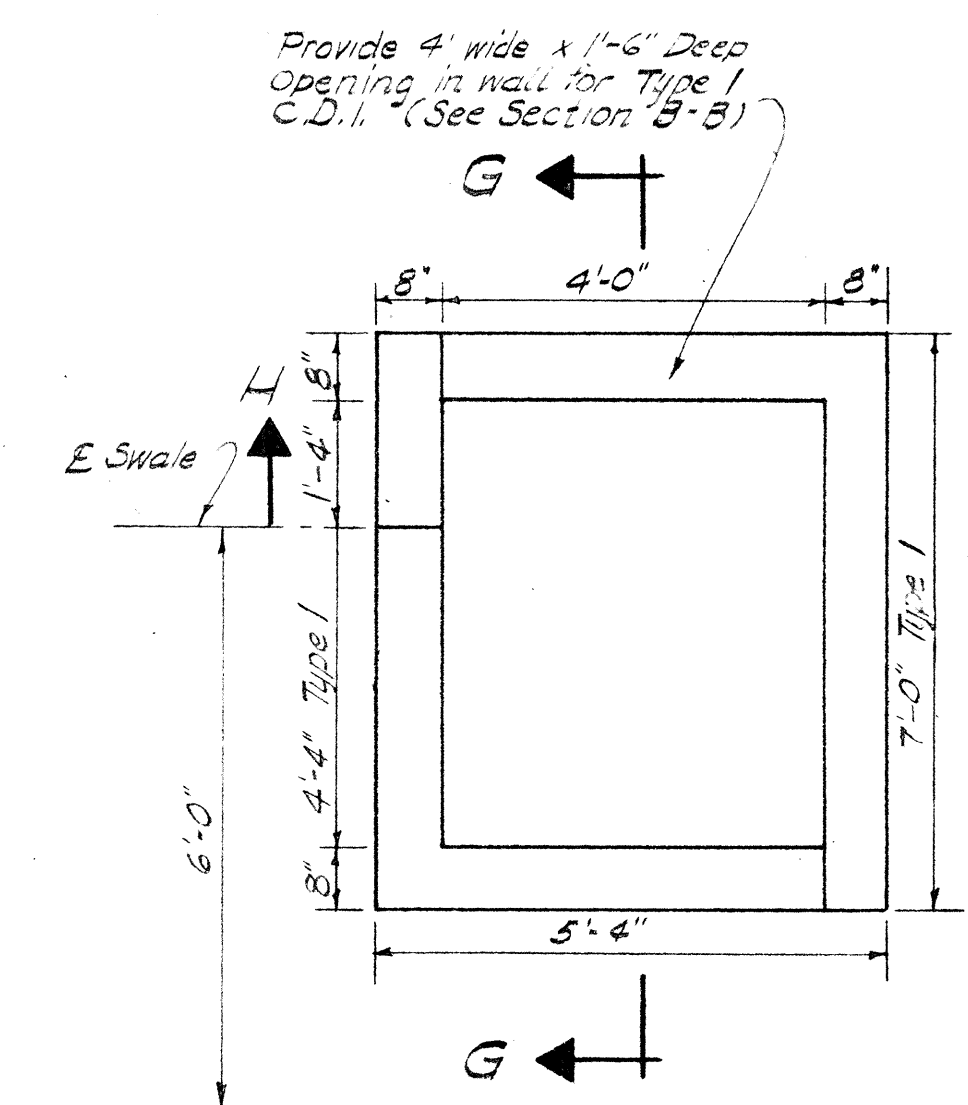


PLAN
Scale: 1/2" = 1'-0"

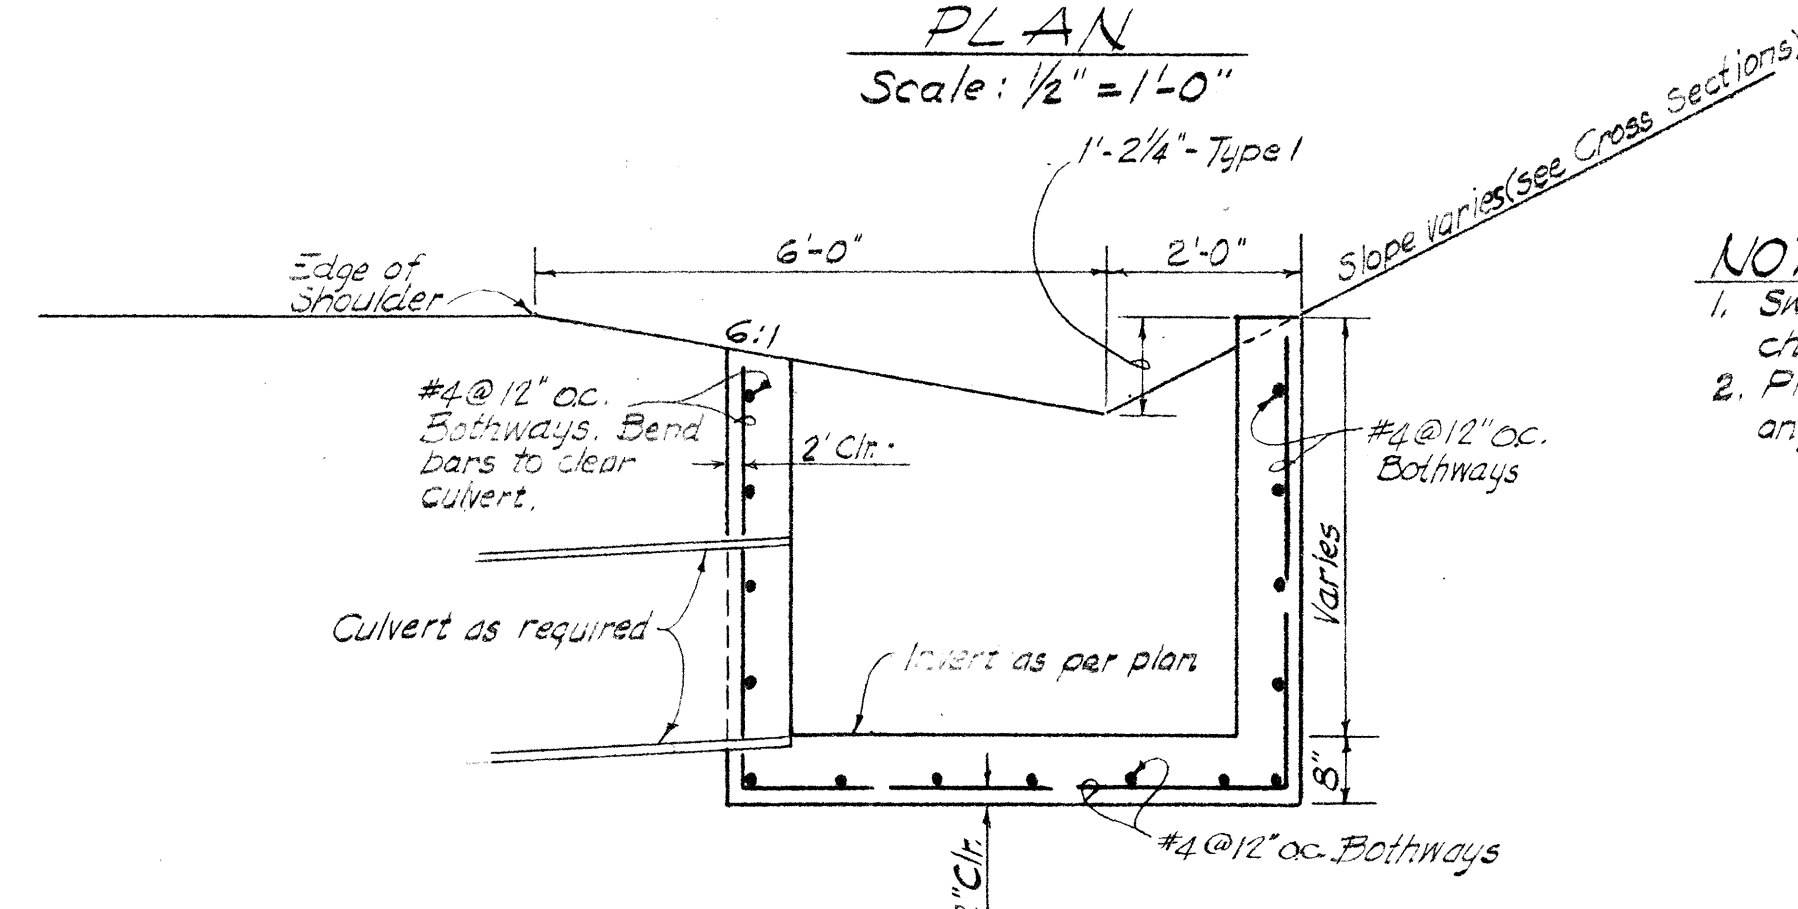

SECTION "G-G"
Scale: 1/2" = 1'-0"

TYPE 1 CONC. DROP INTAKE (C.D.I.) DETAILS

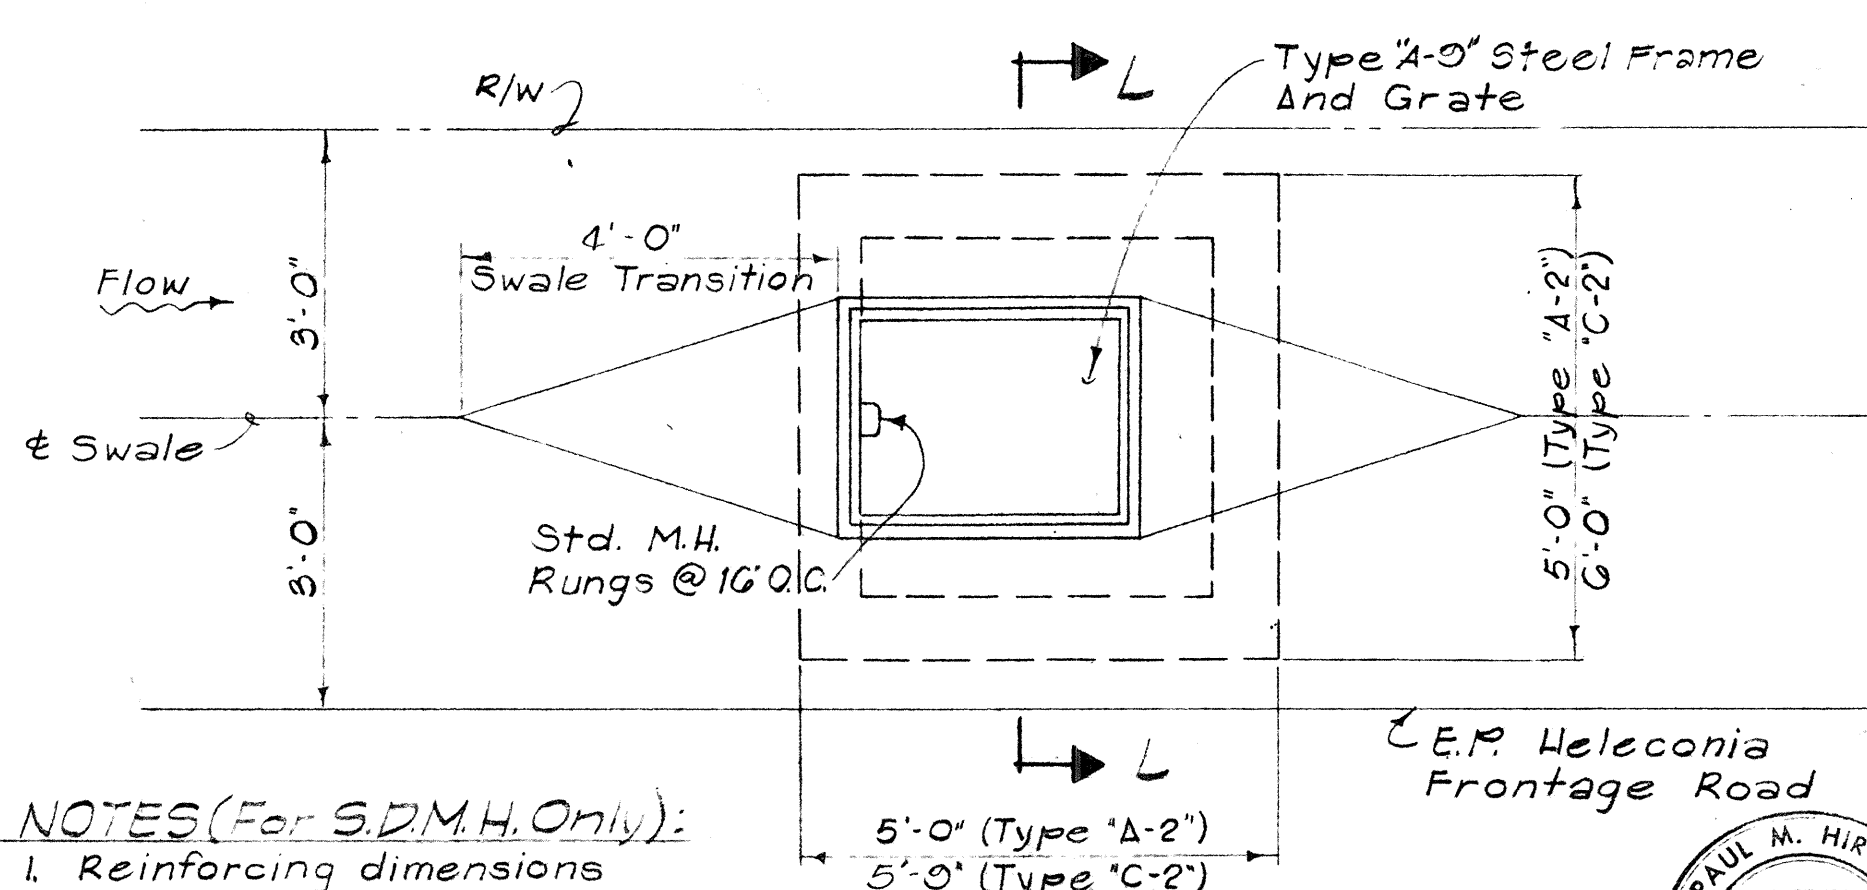

PLAN
Scale: 1/2" = 1'-0"


NOTES (For S.D.M.H. Only):

1. Reinforcing dimensions & details "A-2" & "C-2" S.D.M.H. same as for Type "A-1" & "C-1" S.D.M.H. except top slab and dimensions as shown.
2. Standard M.H. rungs to be incidental to class "A-1" concrete. See Sht. 99 for Details.


STORM DRAIN MAN-HOLE - TYPE "A-2" & "C-2"

NOTES (For C.D.I. Only):

1. Swale can enter C.D.I. from either side. Plan view changes accordingly.
2. Pipe culvert can leave and/or enter C.D.I. from any direction.

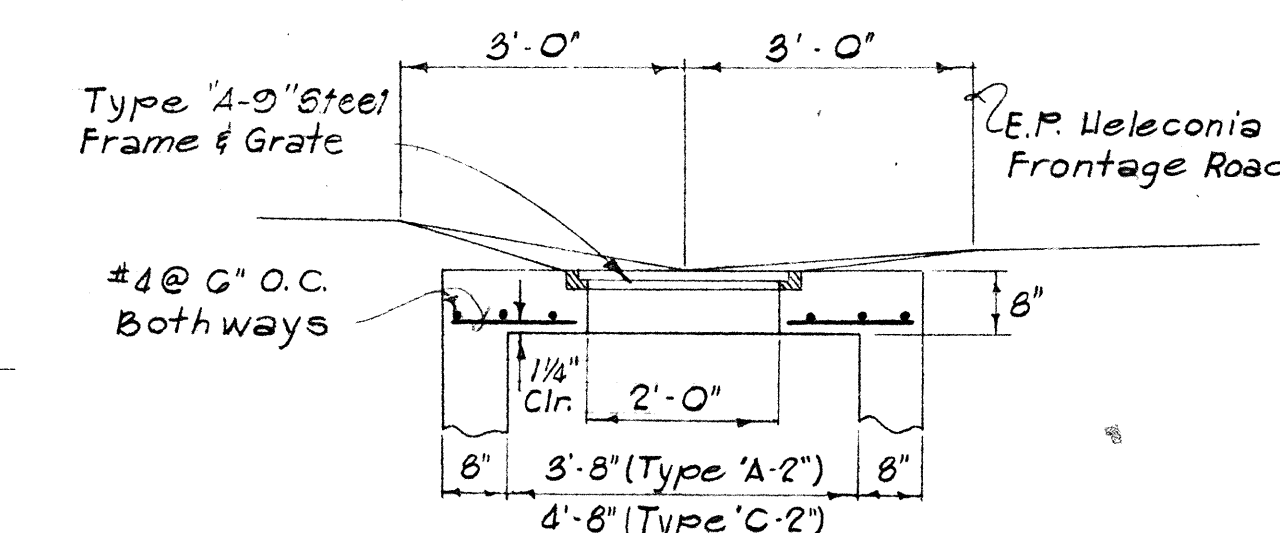

SECTION "L-L"
Scale: 1/2" = 1'-0"

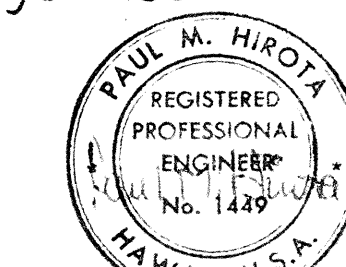


THIS WORK WAS PREPARED BY ME OR UNDER MY SUPERVISION.

STATE OF HAWAII
DEPARTMENT OF TRANSPORTATION
HIGHWAYS DIVISION


DRAINAGE DETAILS

INTERSTATE ROUTE H-1
PROJ. NO. I-HI-1(64)12
UNIT 1
Scale: As Shown Date: 8/19/68
SHEET No. 7 OF 20 SHEETS


FED. ROAD DIST. NO.	STATE	FED. AID PROJ. NO.	FISCAL YEAR	SHEET NO.	TOTAL SHEETS
HAWAII	HAW.	I-41-1(64)-12 Unit 1	1969	95	158
I-41-1(64)-12					

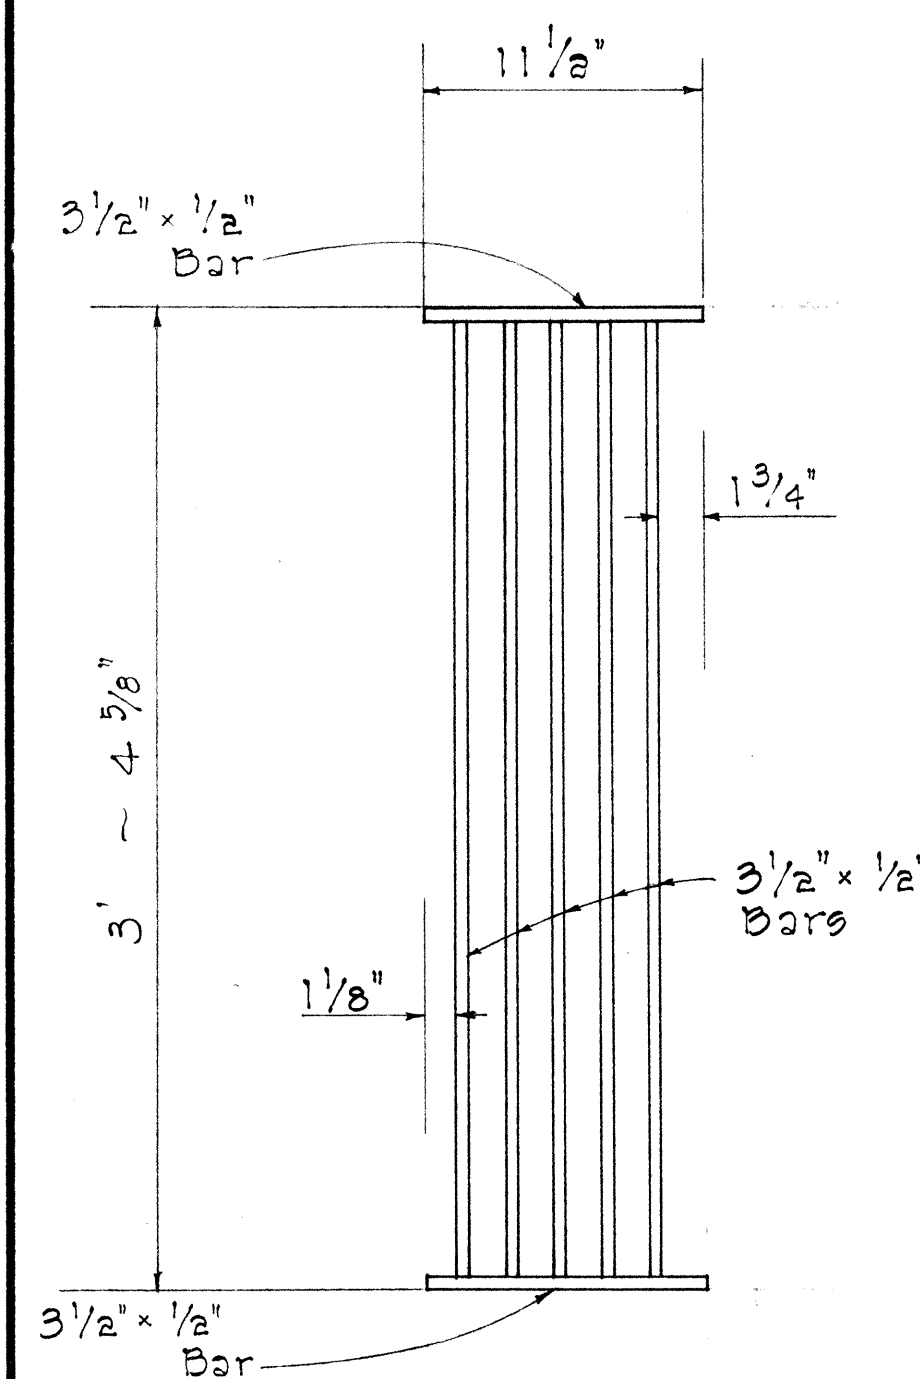


PLAN
Scale: 1 1/2" = 1'-0"

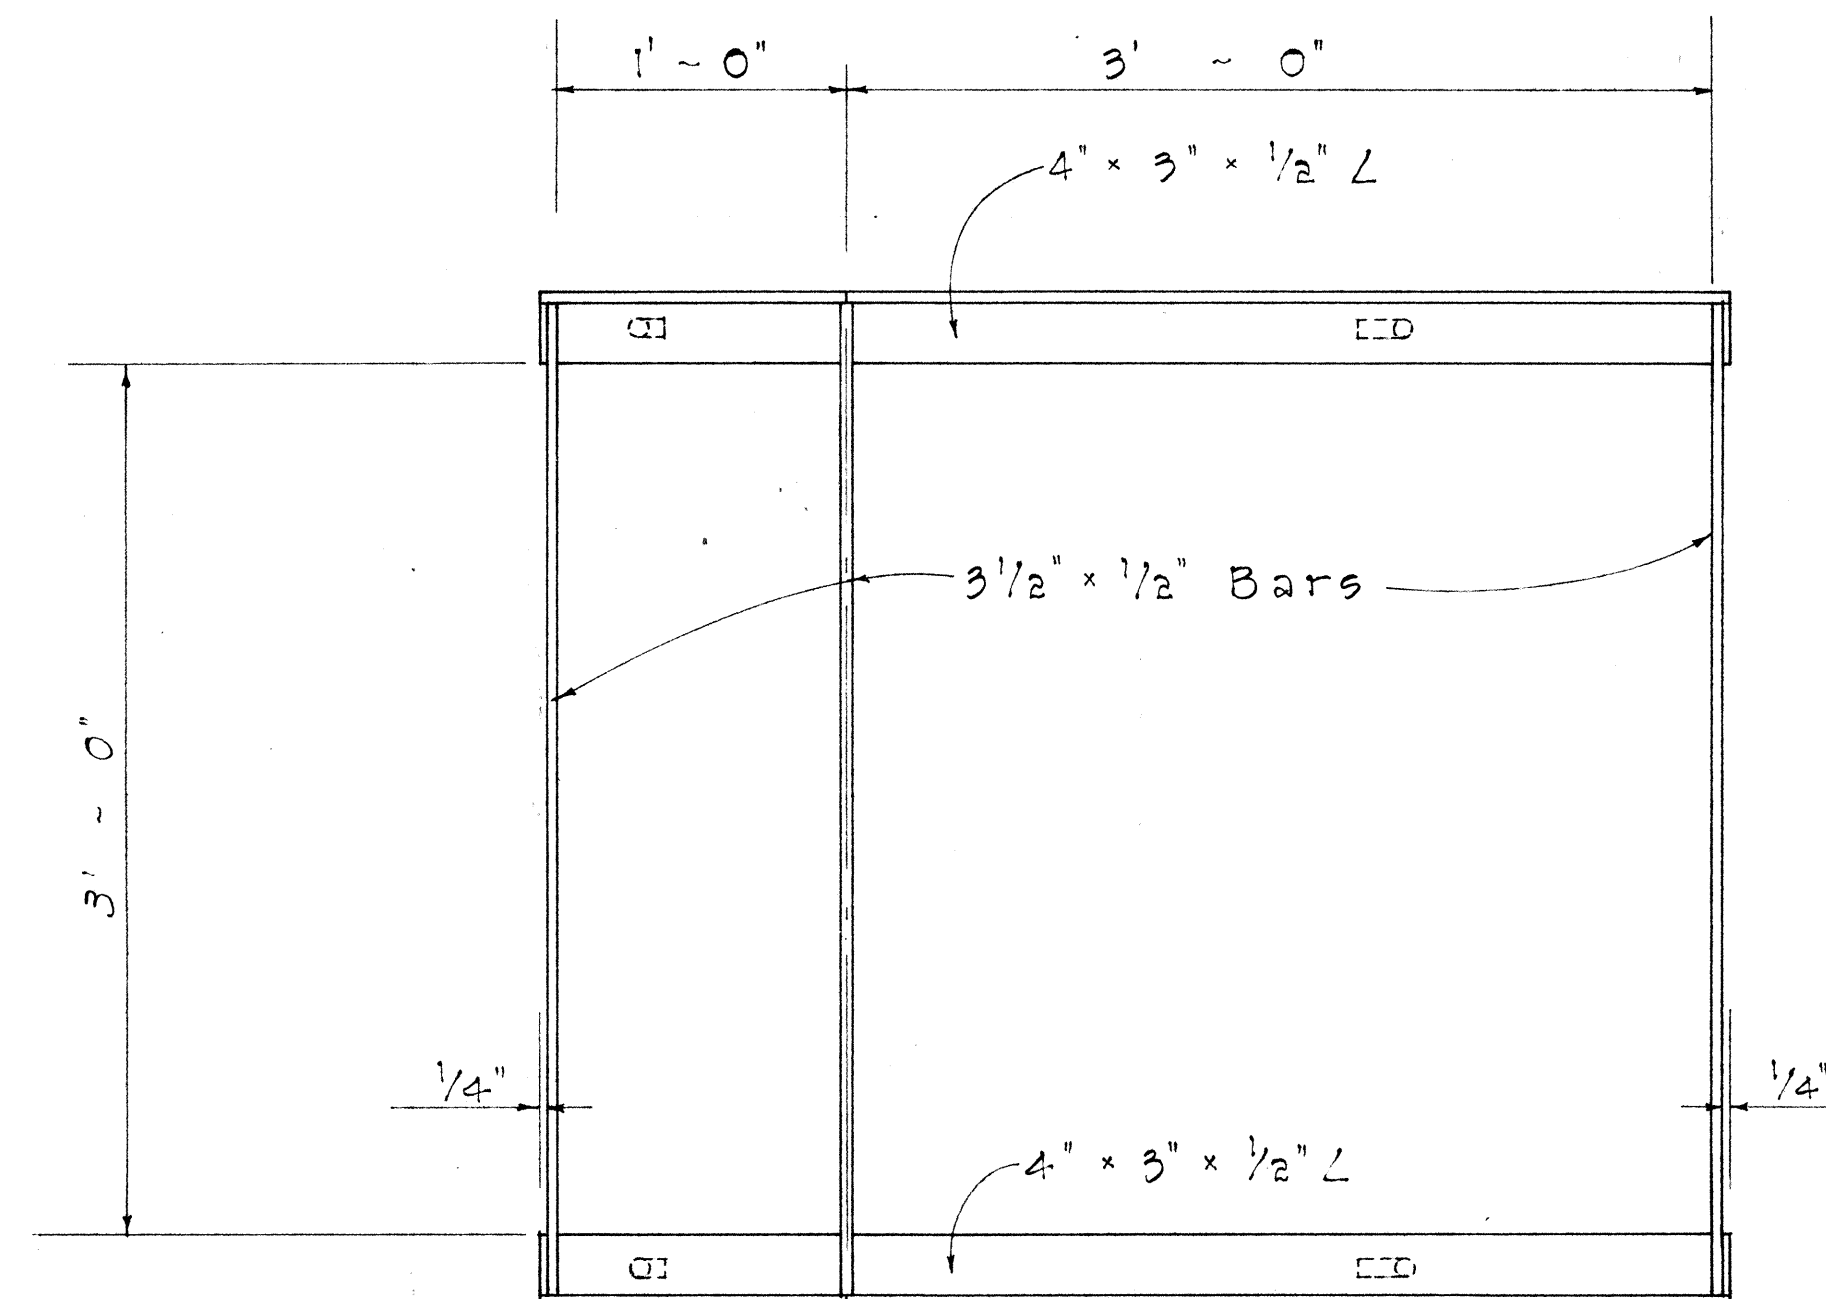


PLAN
Scale: 1 1/2" = 1'-0"

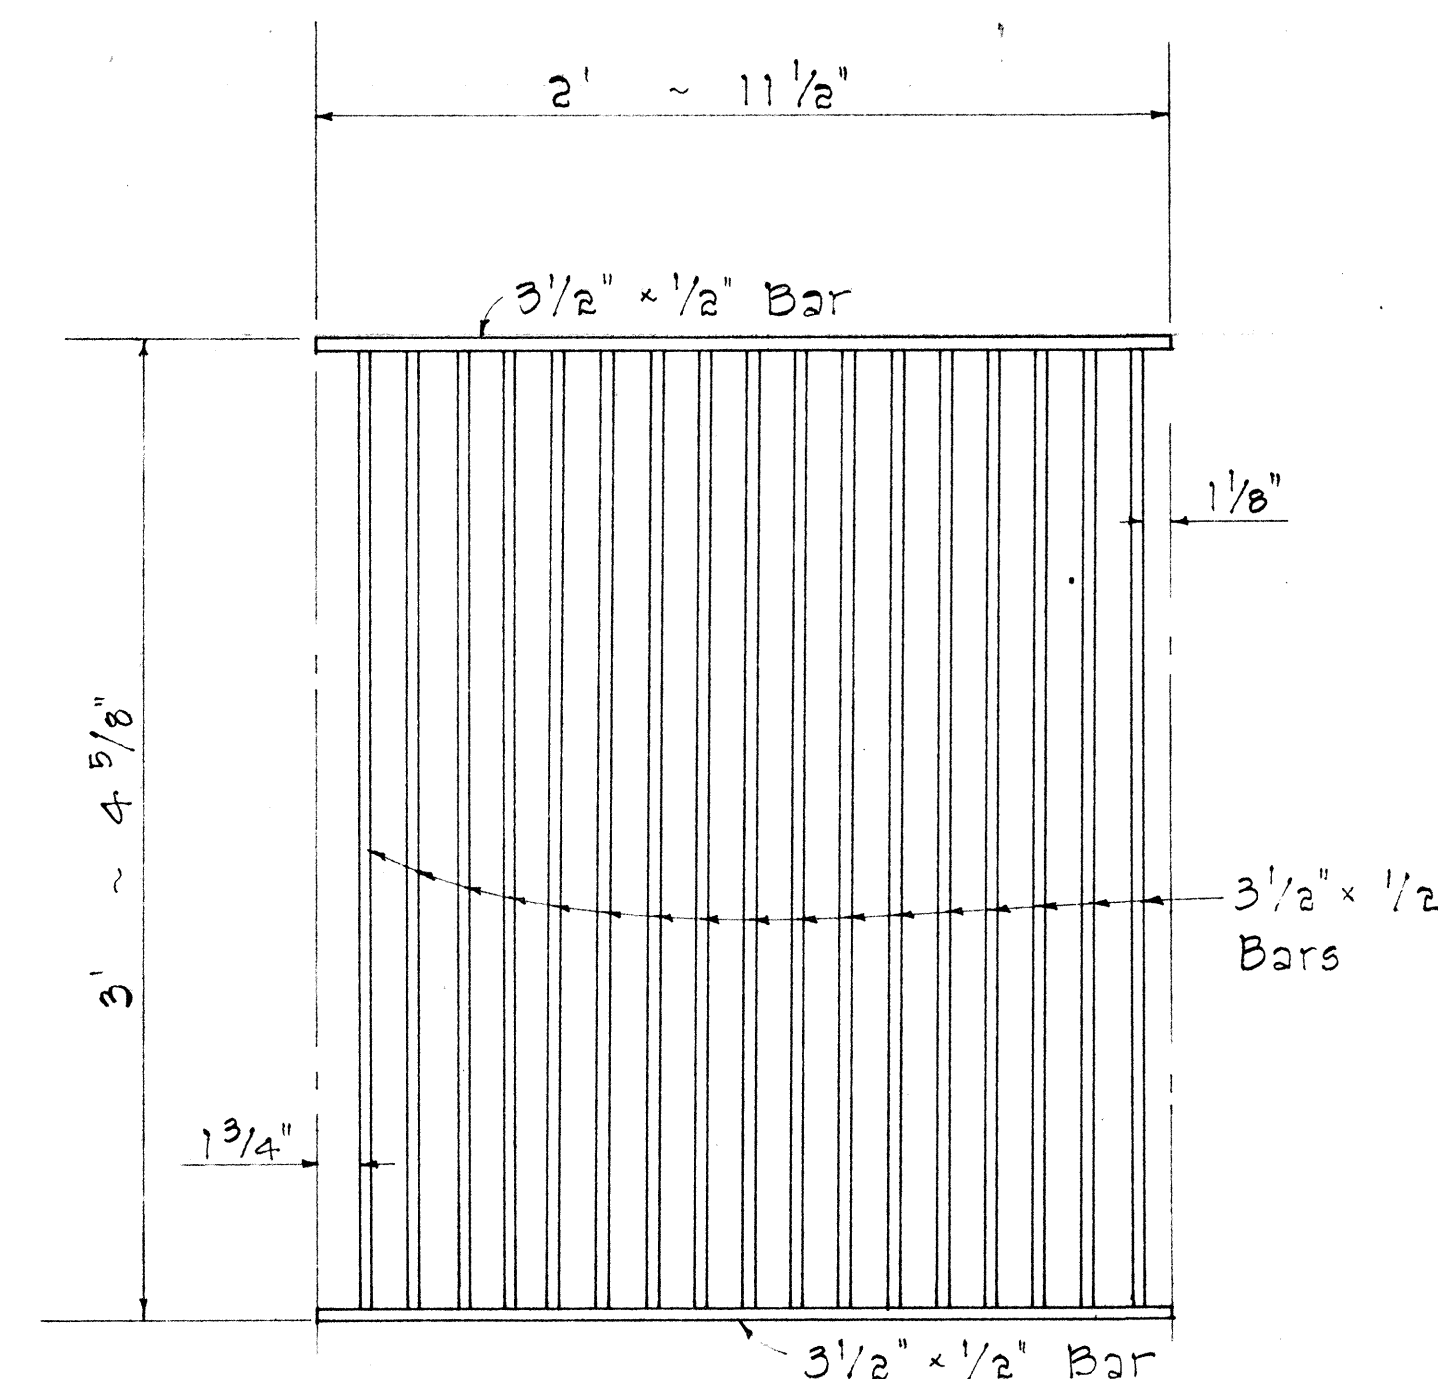


PLAN
Scale: 1 1/2" = 1'-0"

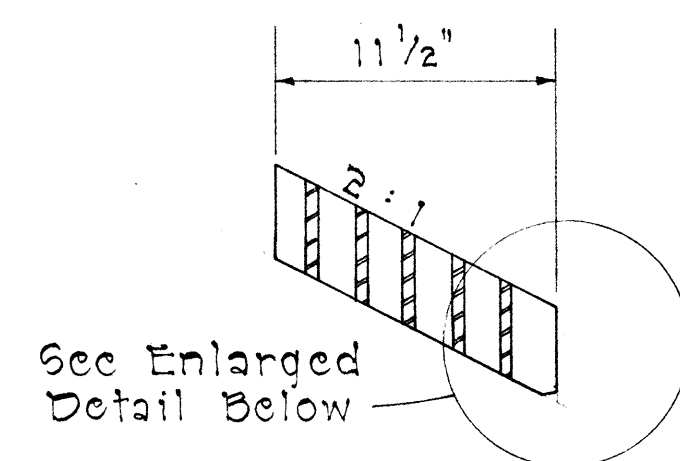


SECTION
Scale: 1 1/2" = 1'-0"

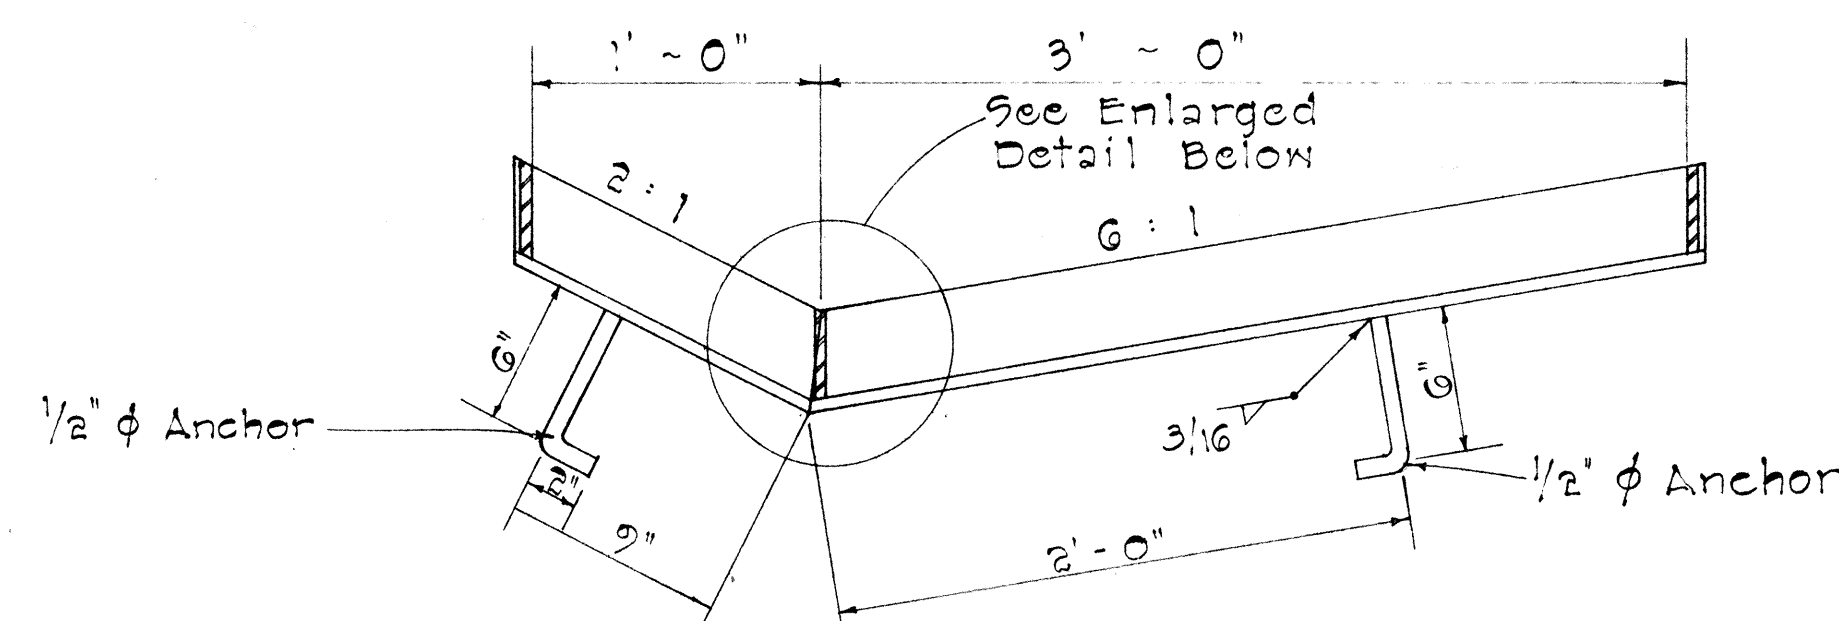

SECTION
Scale: 1 1/2" = 1'-0"

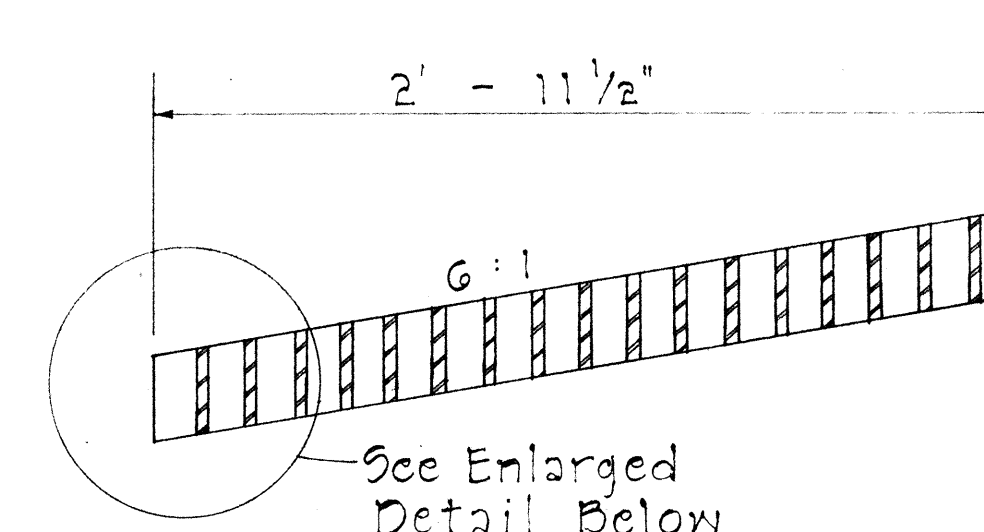


SECTION
Scale: 1 1/2" = 1'-0"

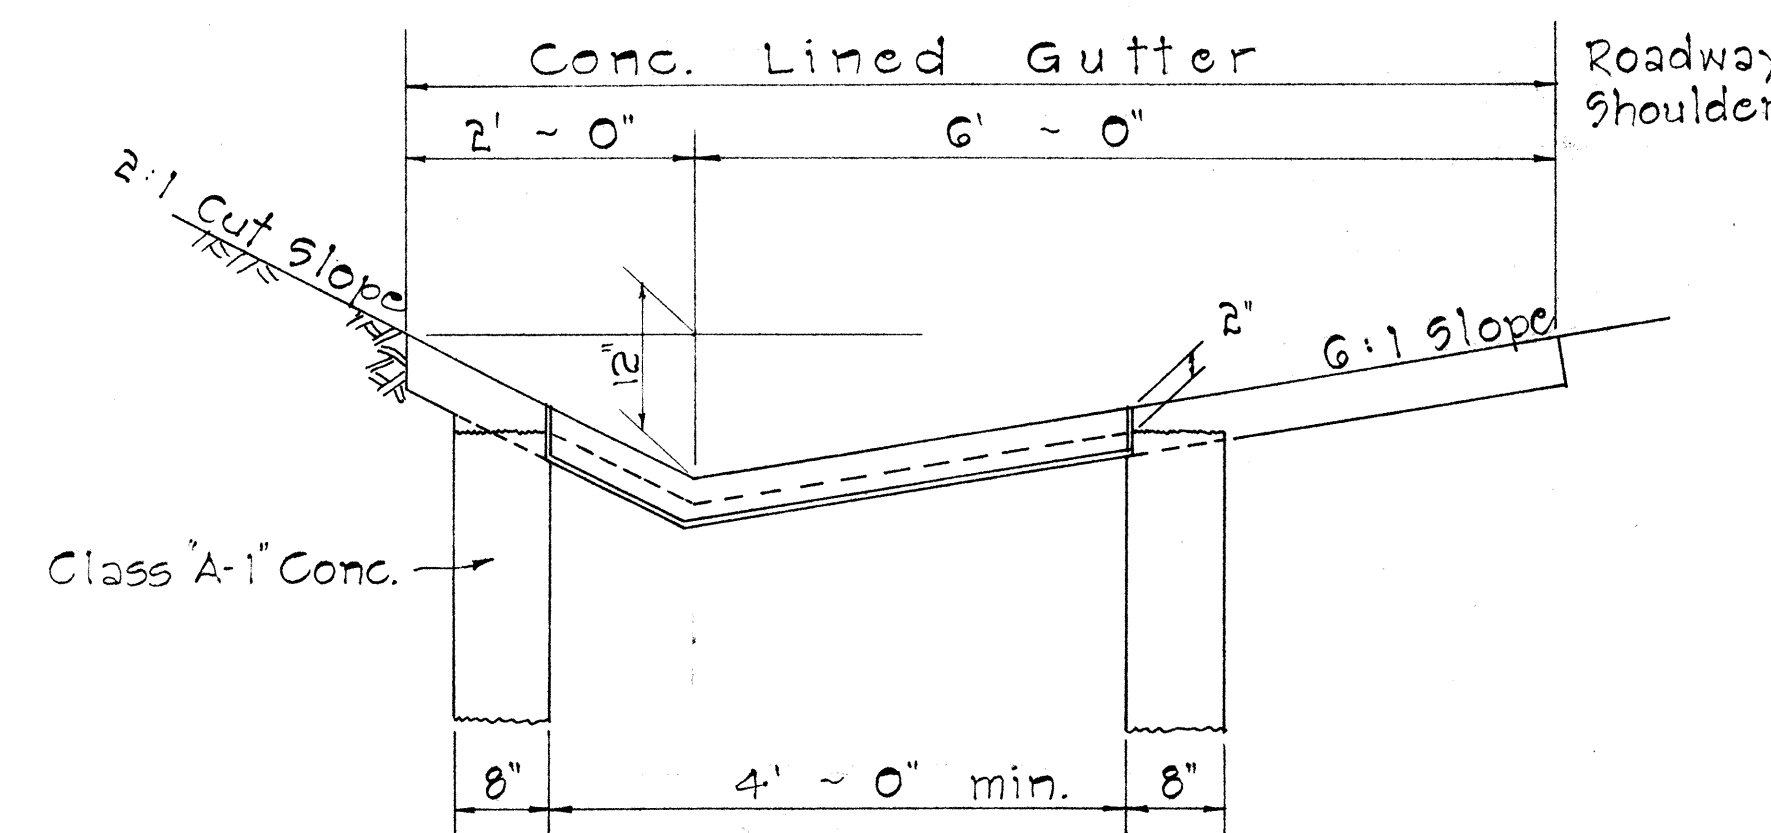


SECTION VIEW

Scale: 3/4" = 1'-0"

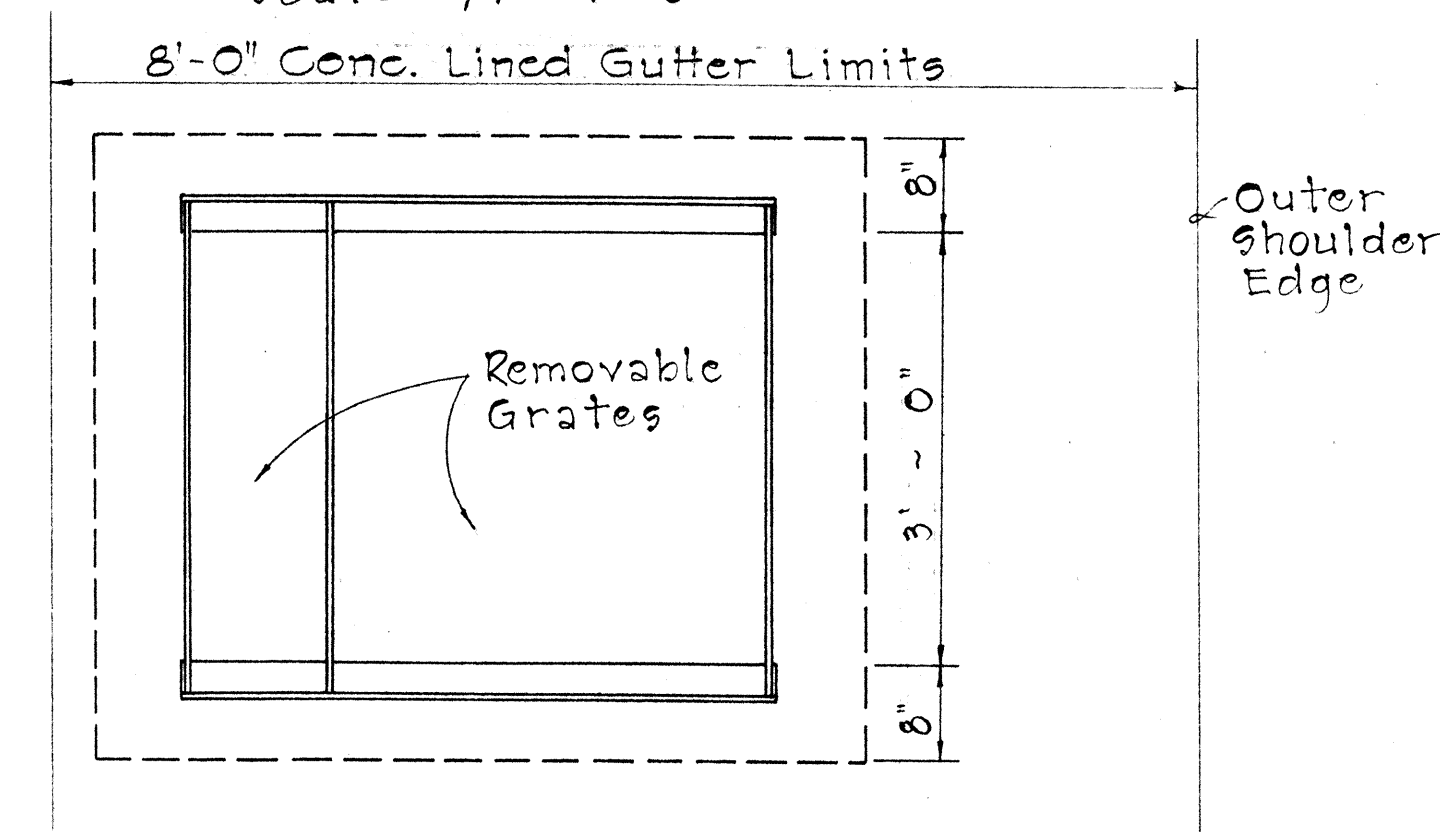


PLAN VIEW


Scale: 3/4" = 1'-0"

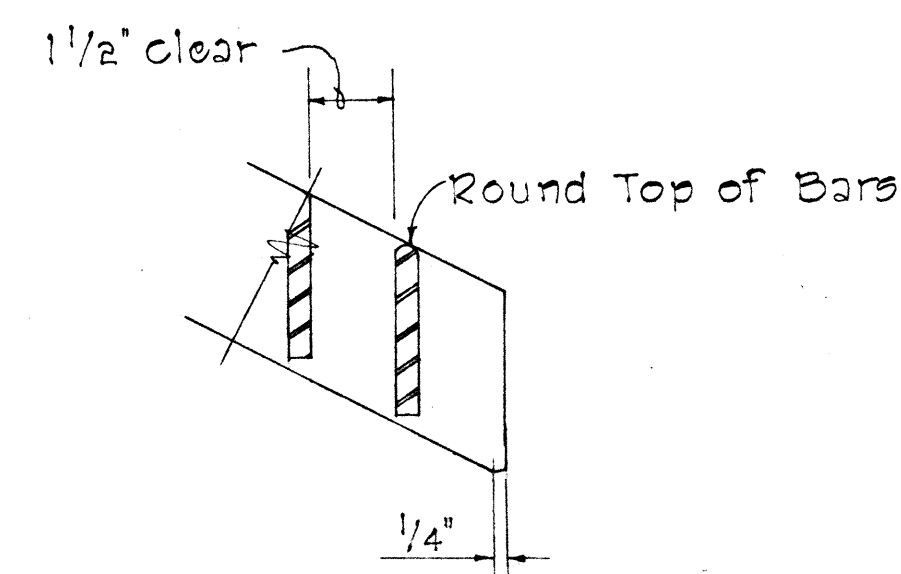

GRATE ON 2:1 SLOPE
Scale: 3" = 1'-0"

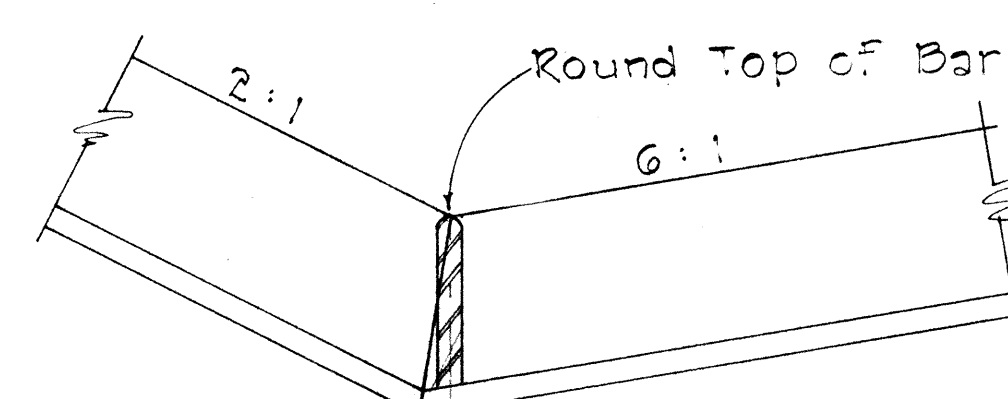

FRAME
Scale: 3" = 1'-0"

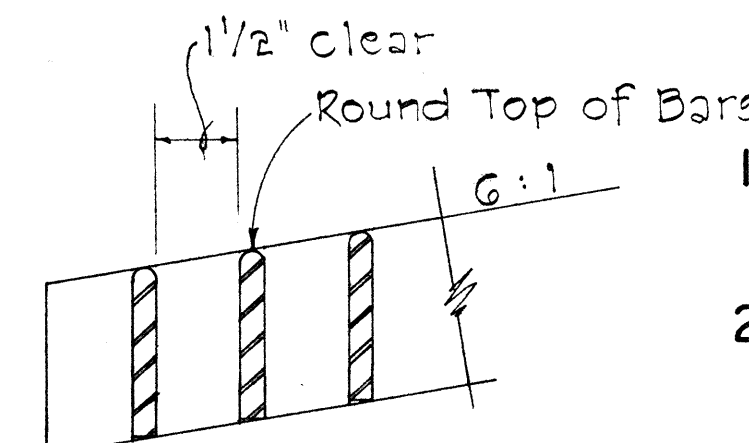

GRATE ON 6:1 SLOPE
Scale: 3" = 1'-0"

GENERAL NOTES

1. Contractor has the option of using welded steel grate.
2. Grates and Frames shall be hot dip galvanized after fabrication, see specifications.
3. All welds 3/8" unless otherwise noted.
4. The various materials shall conform to the specifications of ASTM as listed in the following tabulation and the Standard Specifications.

Material	ASTM Designation
Structural Steel	A283, Grade D
Cast Steel	A27, Grade 65-35
Malleable Iron Casting	A47, Gr. No. 35018

STATE OF HAWAII
DEPARTMENT OF TRANSPORTATION
HIGHWAYS DIVISION

DRAINAGE DETAIL
TYPE G121
STEEL FRAME & GRATE

INTERSTATE ROUTE H-1
PROJ. No. I-41-1(64)-12,
UNIT 1

Scale: As Shown Date: Jan. 1969

SURVEY PLOTTED BY	DATE
DESIGNED BY	
TRACED BY	
NOTED BY	
QUANTITIES BY	
CHECKED BY	
ORIGINAL PLAN	
NOTE BOOK	
No.	

DETAIL OF TYPE 6121 STEEL FRAME AND GRATE

FED. ROAD DIST. NO.	STATE	FED. AID PROJ. NO.	FISCAL YEAR	SHEET NO.	TOTAL SHEETS
HAWAII	HAW.	T-H-11(4) 12, Unit 1	1960	0095-1	150


GENERAL NOTES

- Grates and Frames shall be hot dip galvanized after fabrication, see specifications.
- All welds $\frac{3}{8}$ " unless otherwise noted.
- Refer to "Spacing Table" for Types 61612 & 61613 Drop Intake and Frame & Grates dimensions.
- The Frame & Grate materials shall conform to the specifications of ASTM Designation Structural Steel A283, Grade D and the Standard Specifications.
- Culvert shall leave Drop Intake from any position and any direction indicated by plans or ordered by the Engineer. Culverts may both enter and leave Drop Intake so that Drop Intake will act as manhole.

SPACING TABLE					
TYPE	NO. BARS	A	B	C	D
61612	11	2'-0"	1'-11½"	1¼"	1'-6"
61613	17	3'-0"	2'-11½"	1⅛"	2'-0"


STATE OF HAWAII
DEPARTMENT OF TRANSPORTATION
HIGHWAYS DIVISION
STANDARD DETAILS
TYPE 61612 & 61613
GRADED DROP INTAKES

Scales: As Noted Date: Feb. 1969
SHEET No. OF SHEETS

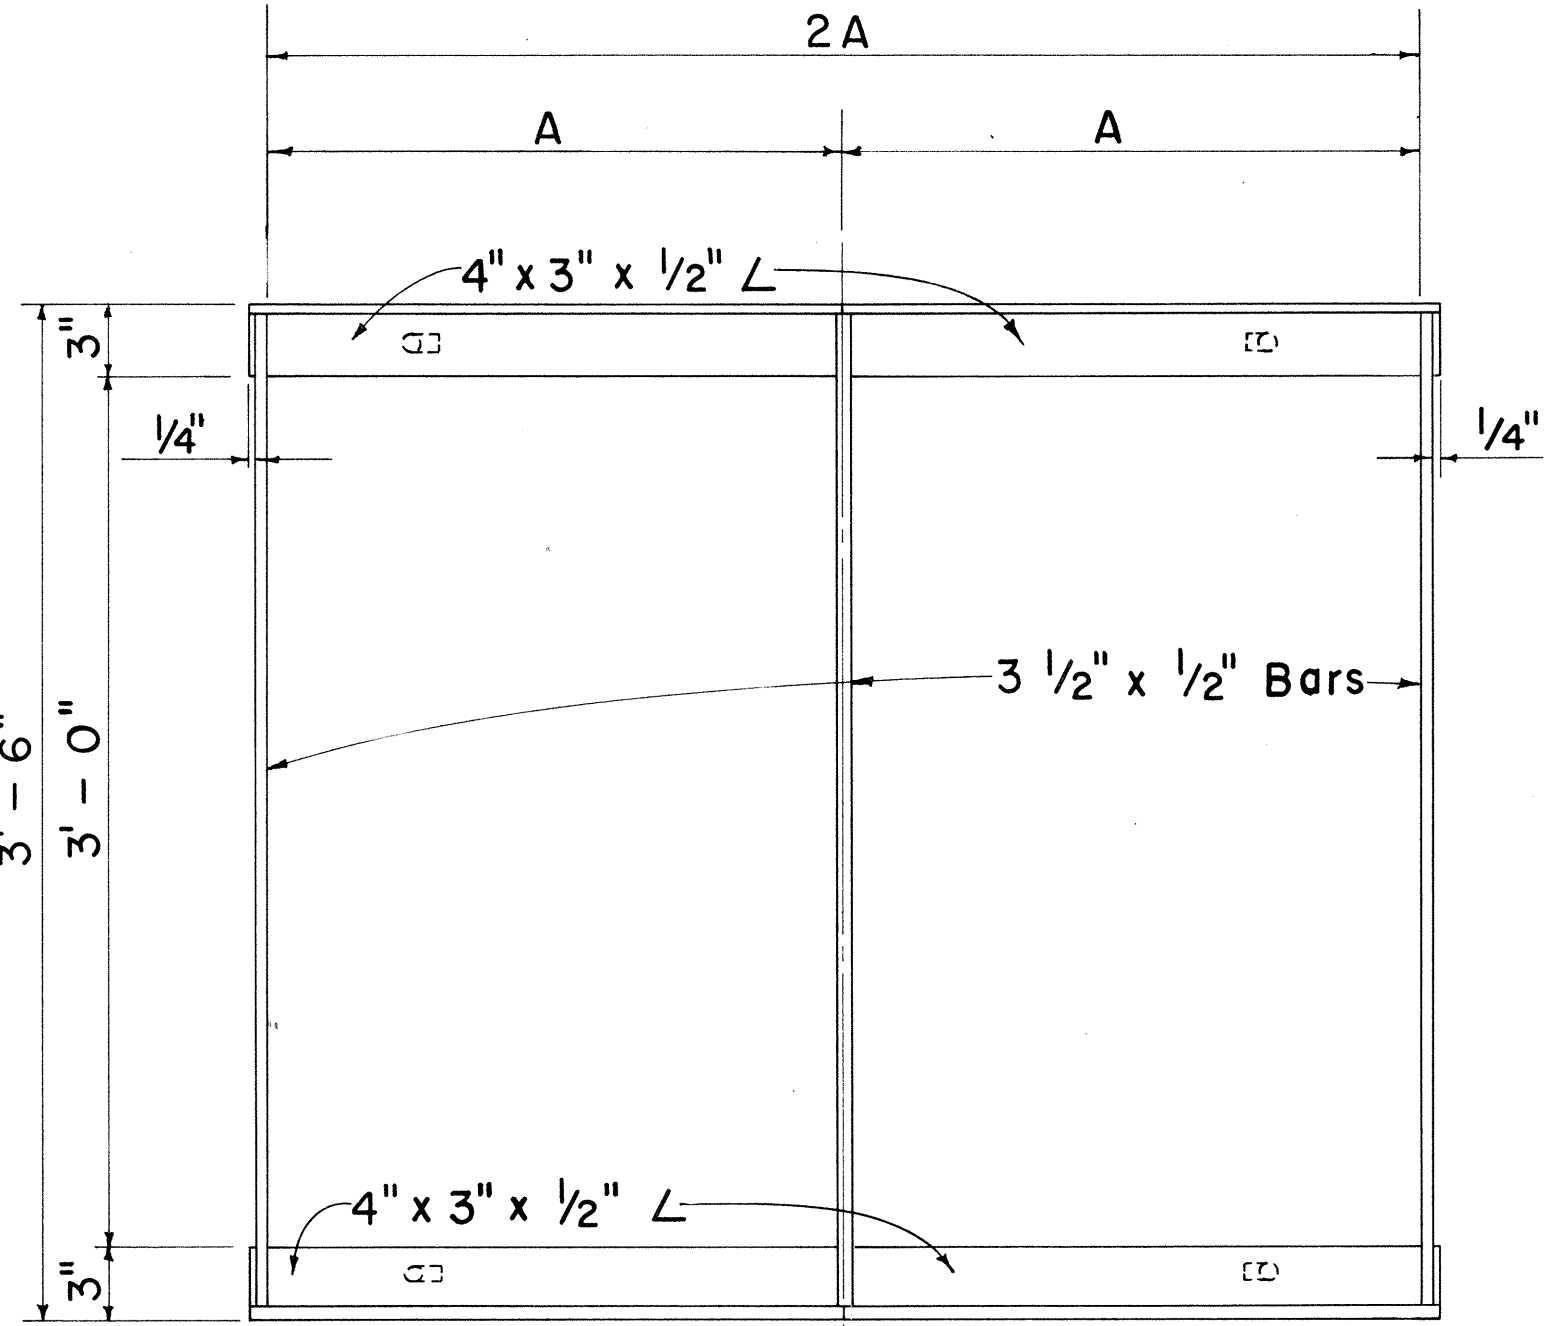


PLAN

Scale: 1 1/2" = 1'-0"

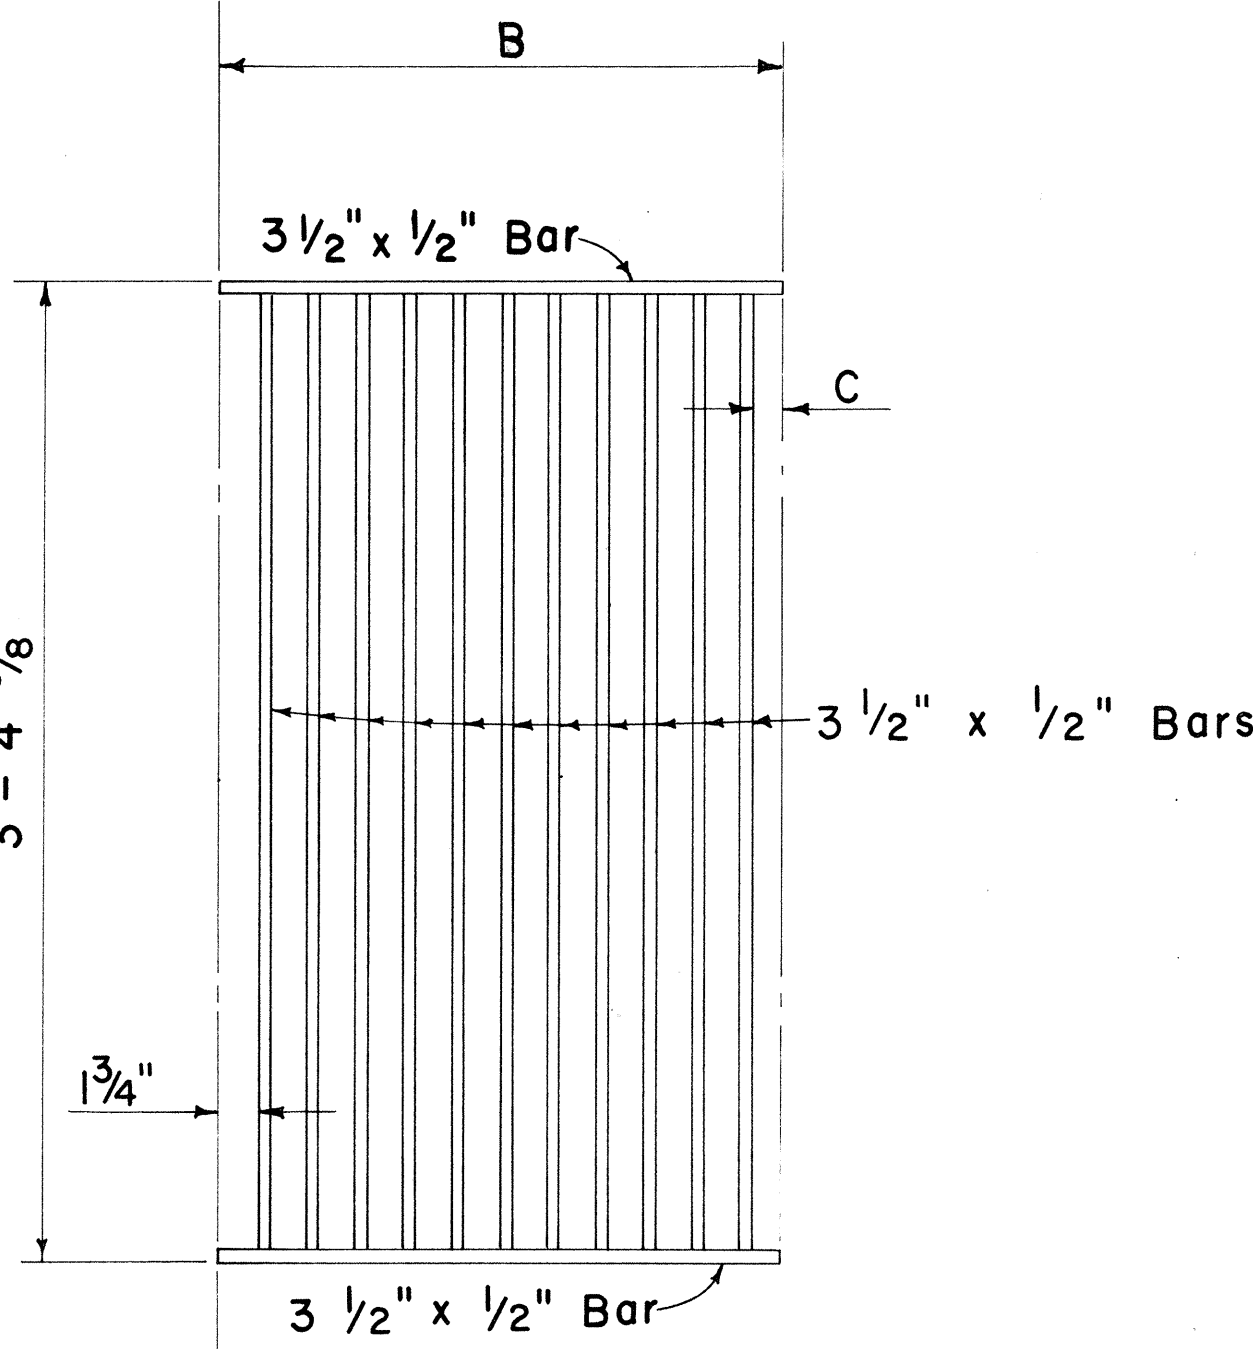


PLAN

Scale: 1 1/2" = 1'-0"

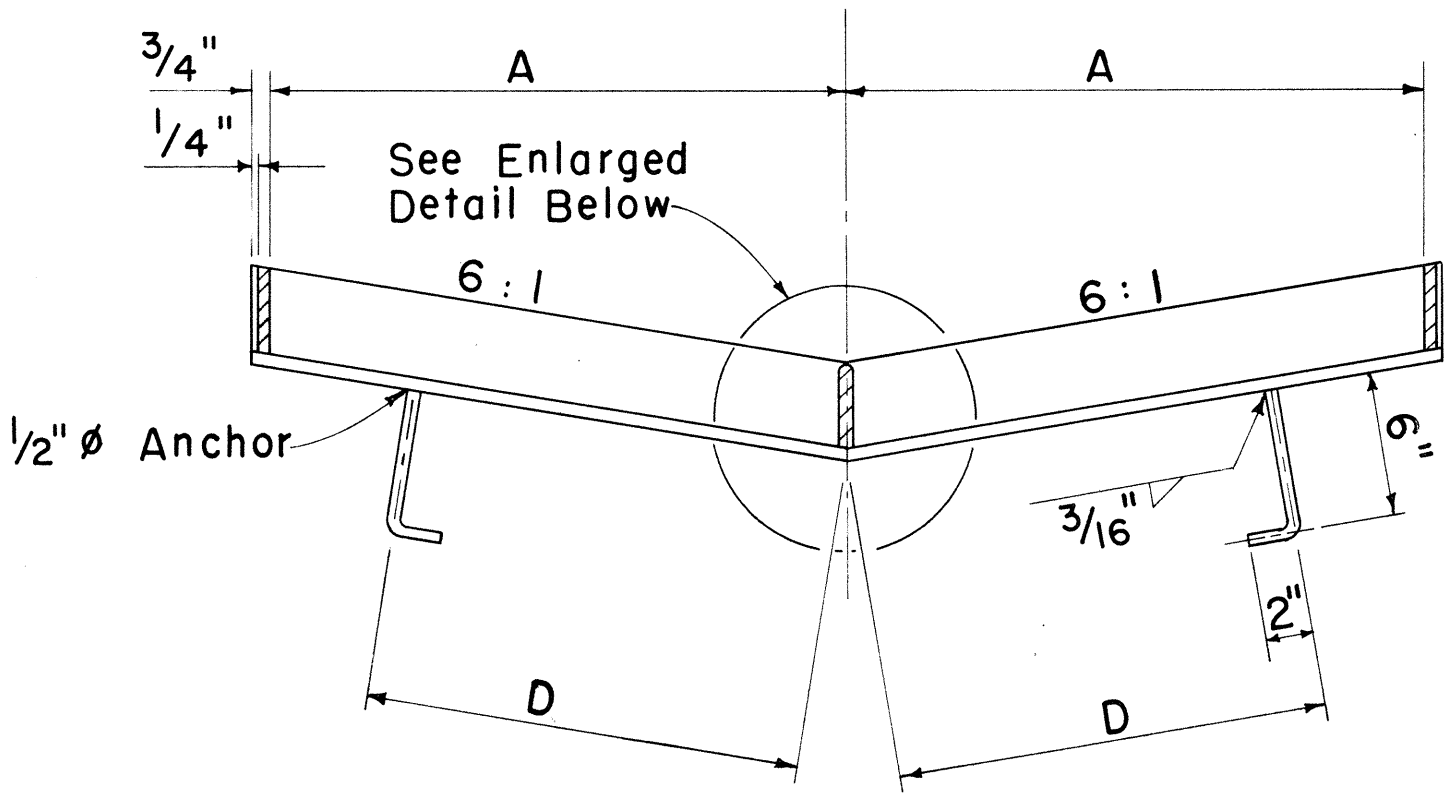


SECTION

Scale: 1 1/2" = 1'-0"

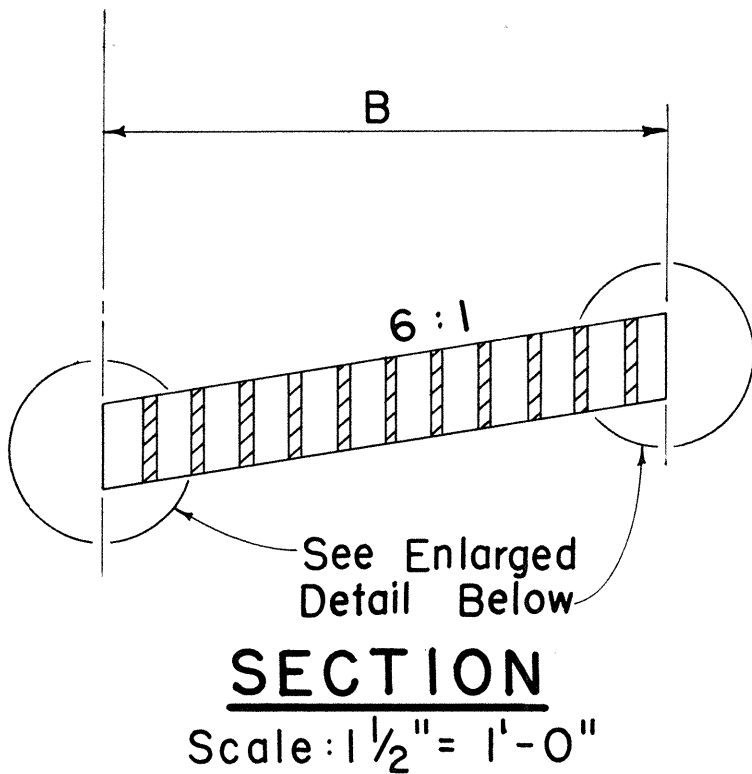


SECTION

Scale: 1 1/2" = 1'-0"

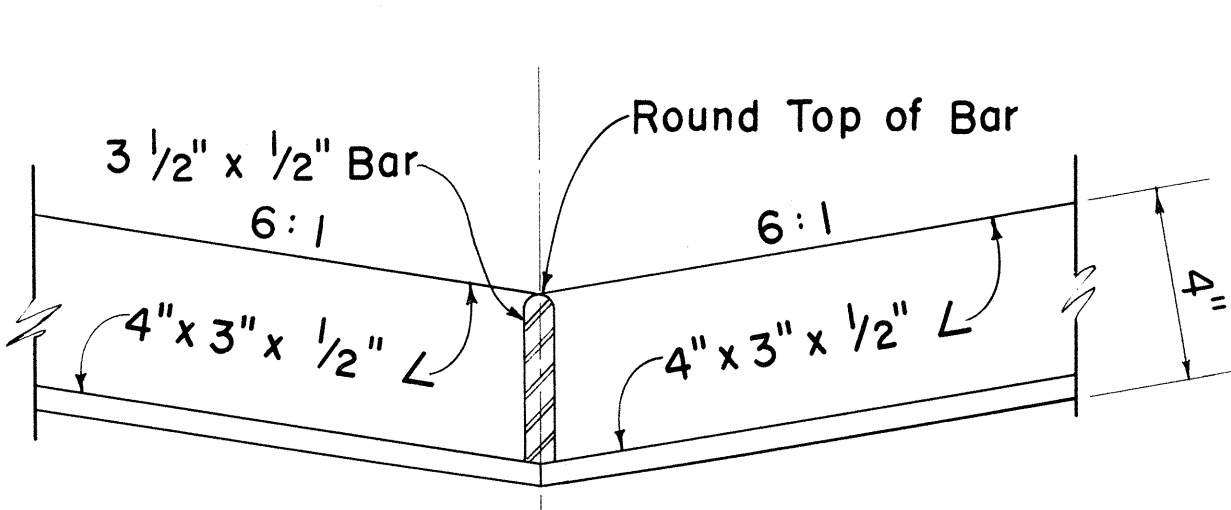


FRAME

Scale: 3" = 1'-0"

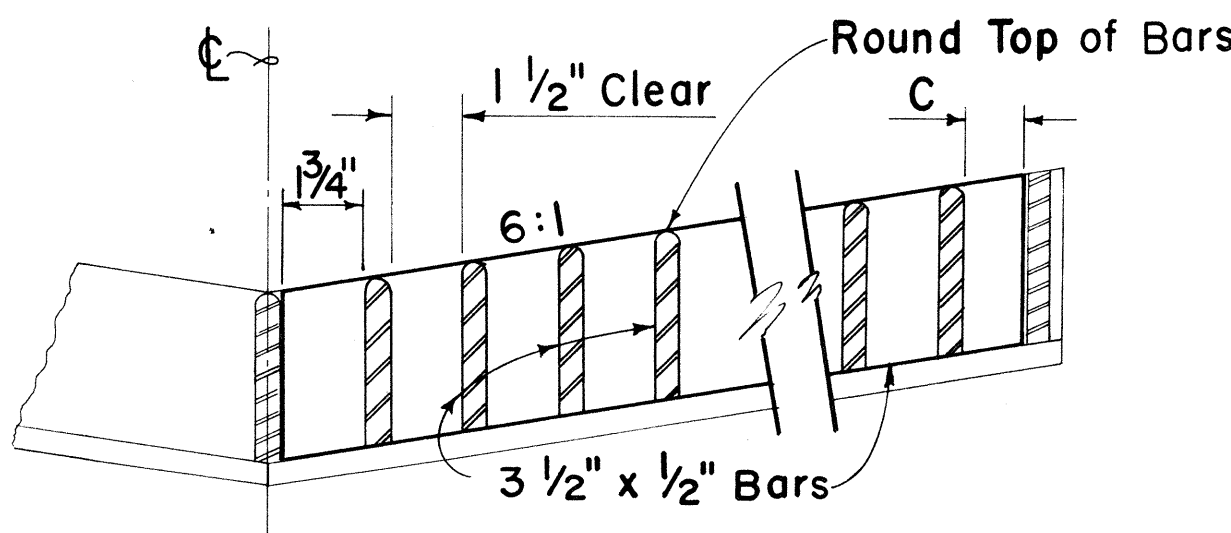


GRATE


Scale: 3" = 1'-0"

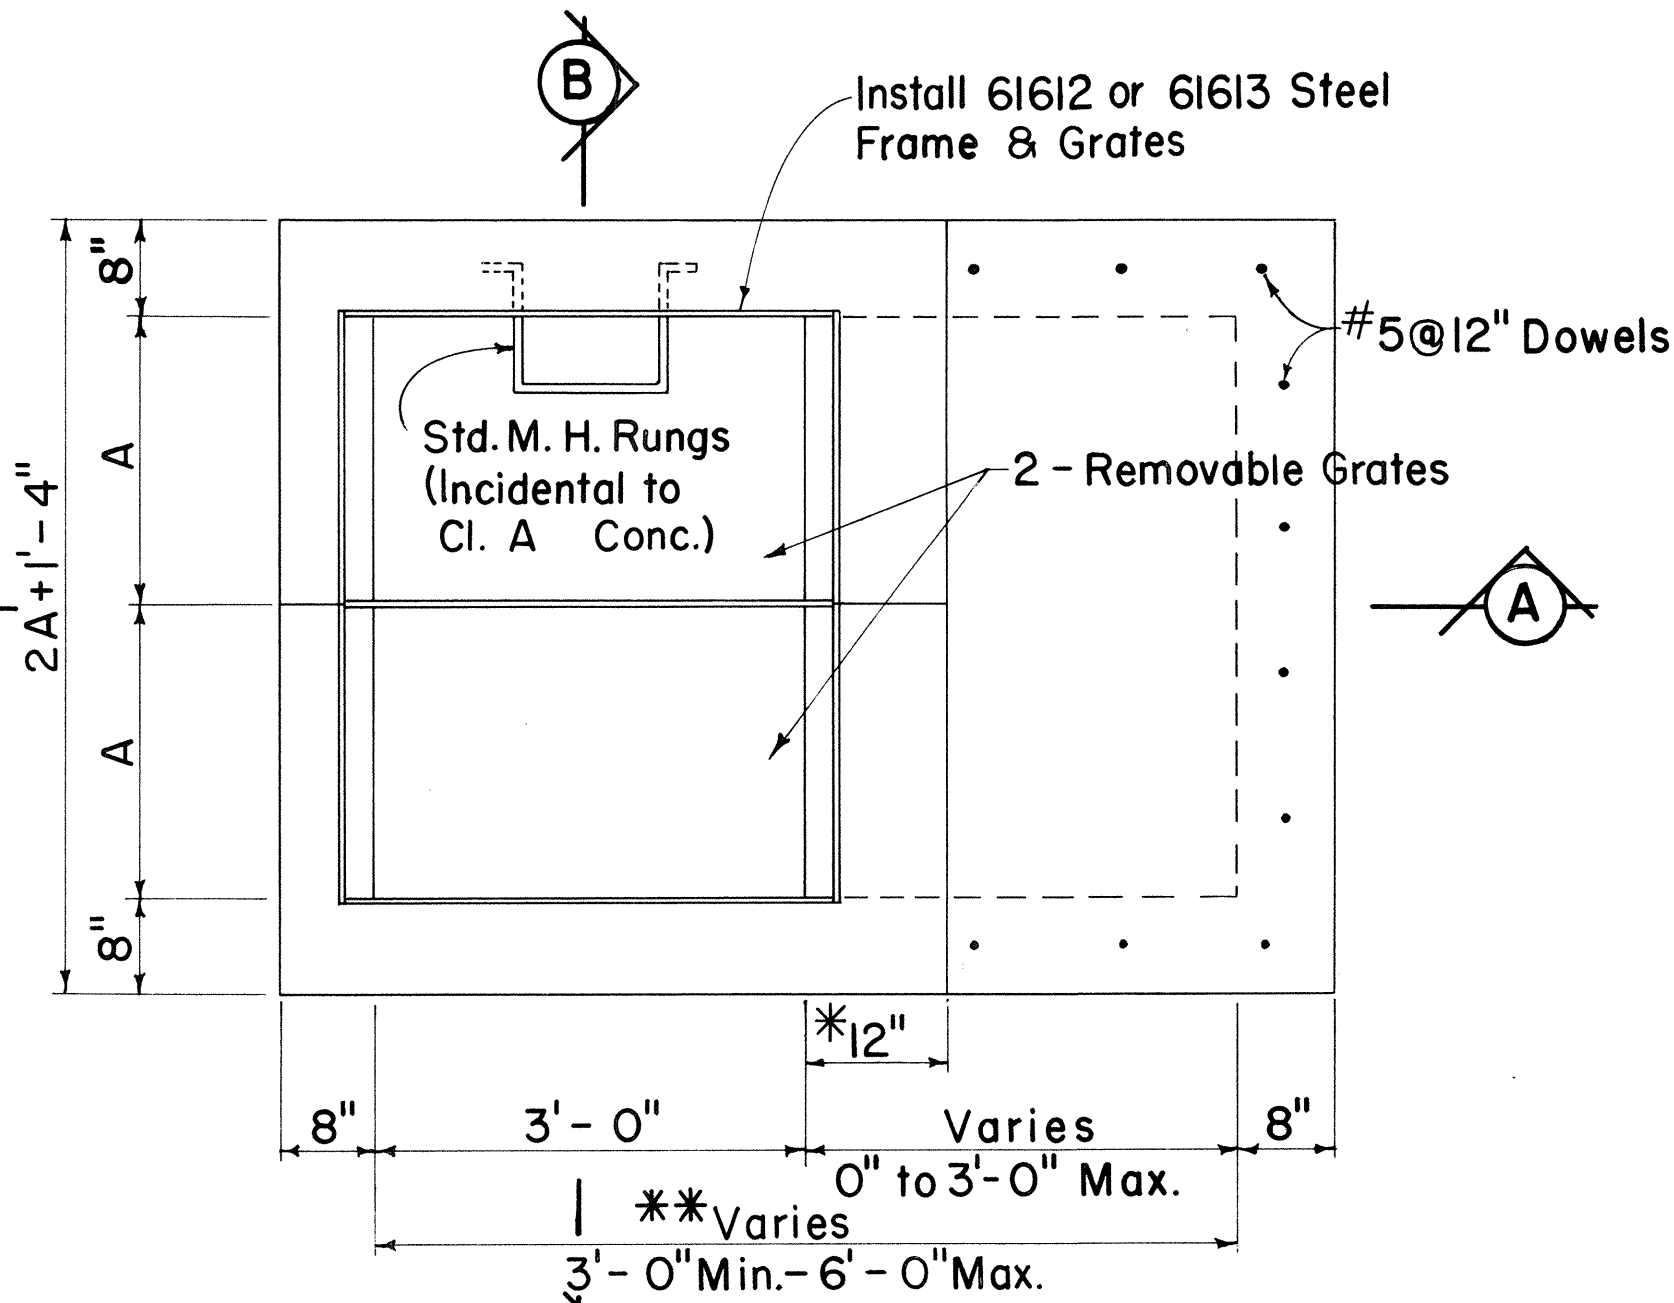

PLAN

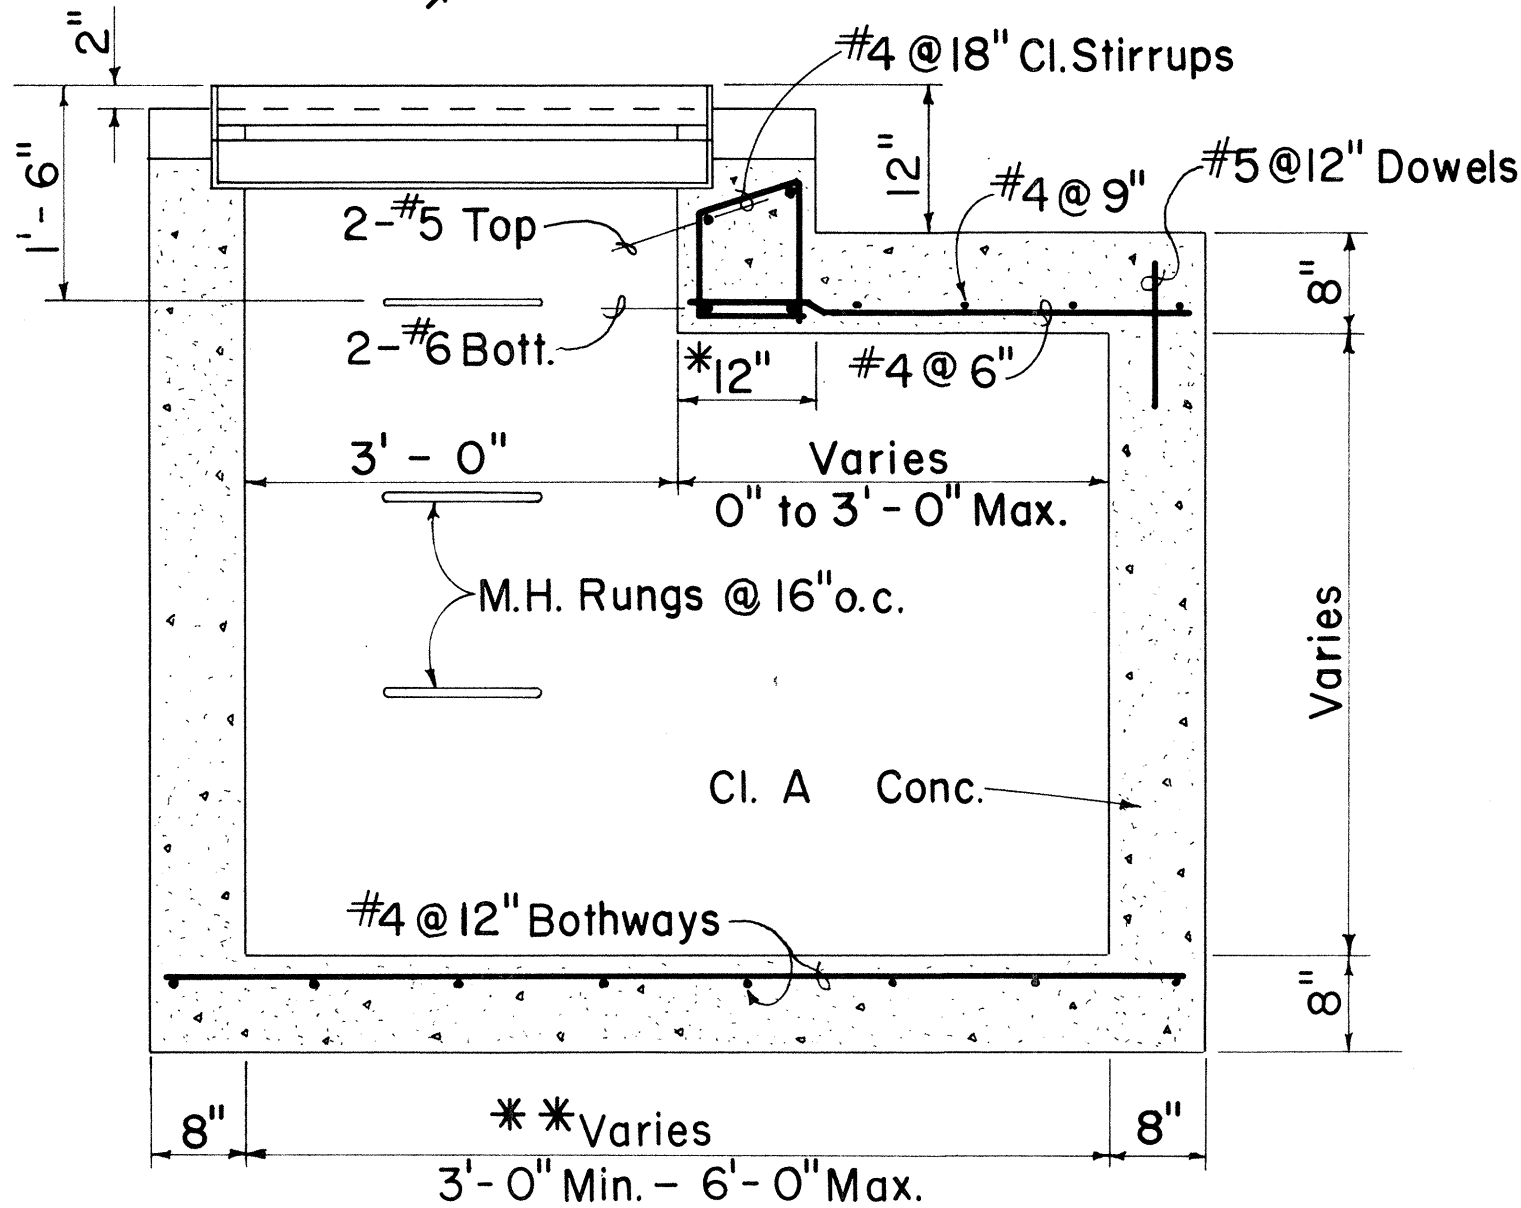

SECTION A - A

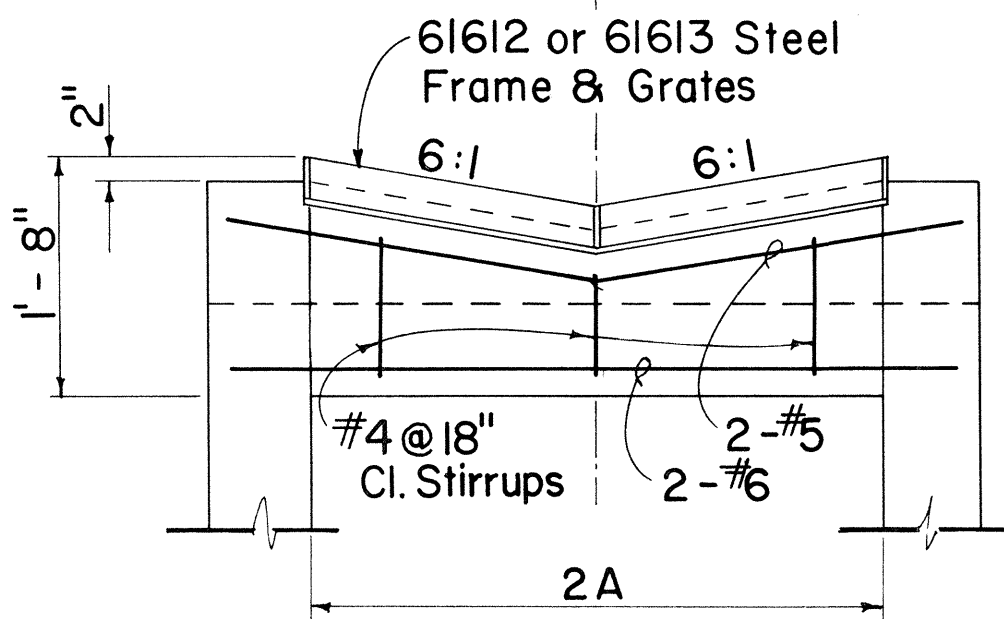







SECTION B - B

DETAILS OF 61612 OR 61613 DROP INTAKE

Scale: 3/4" = 1'-0"

- *For Minimum size box of 3'-0", use 8" and eliminate reinforcing steel shown in the top portion.
- **For Culverts larger than 30", the minimum dimension shall be D'.

FED. ROAD DIST. NO.	STATE	FED. AID PROJ. NO.	FISCAL YEAR	SHEET NO.	TOTAL SHEETS
HAWAII	HAW.	F-11-1(64):12 Unit 1	1969	96	158
		F-11-1(16):11			

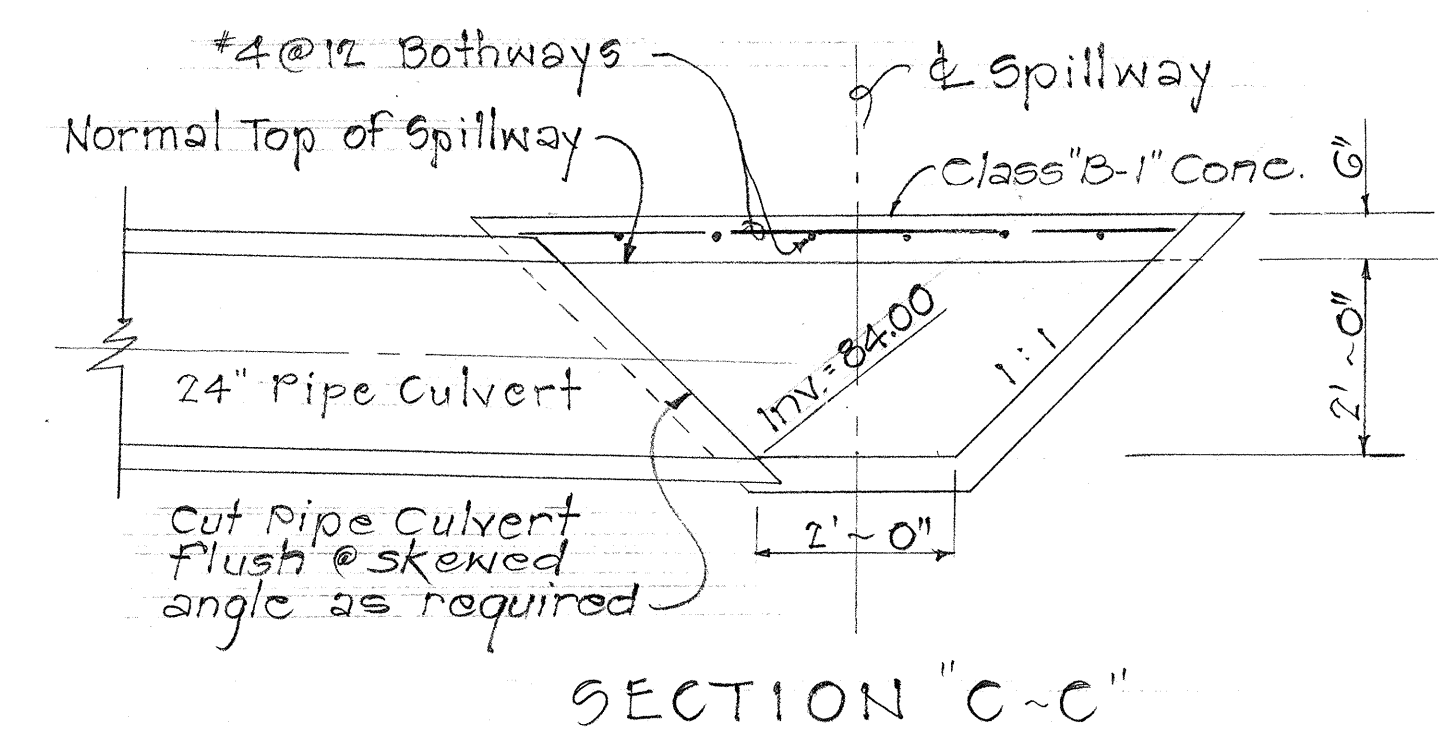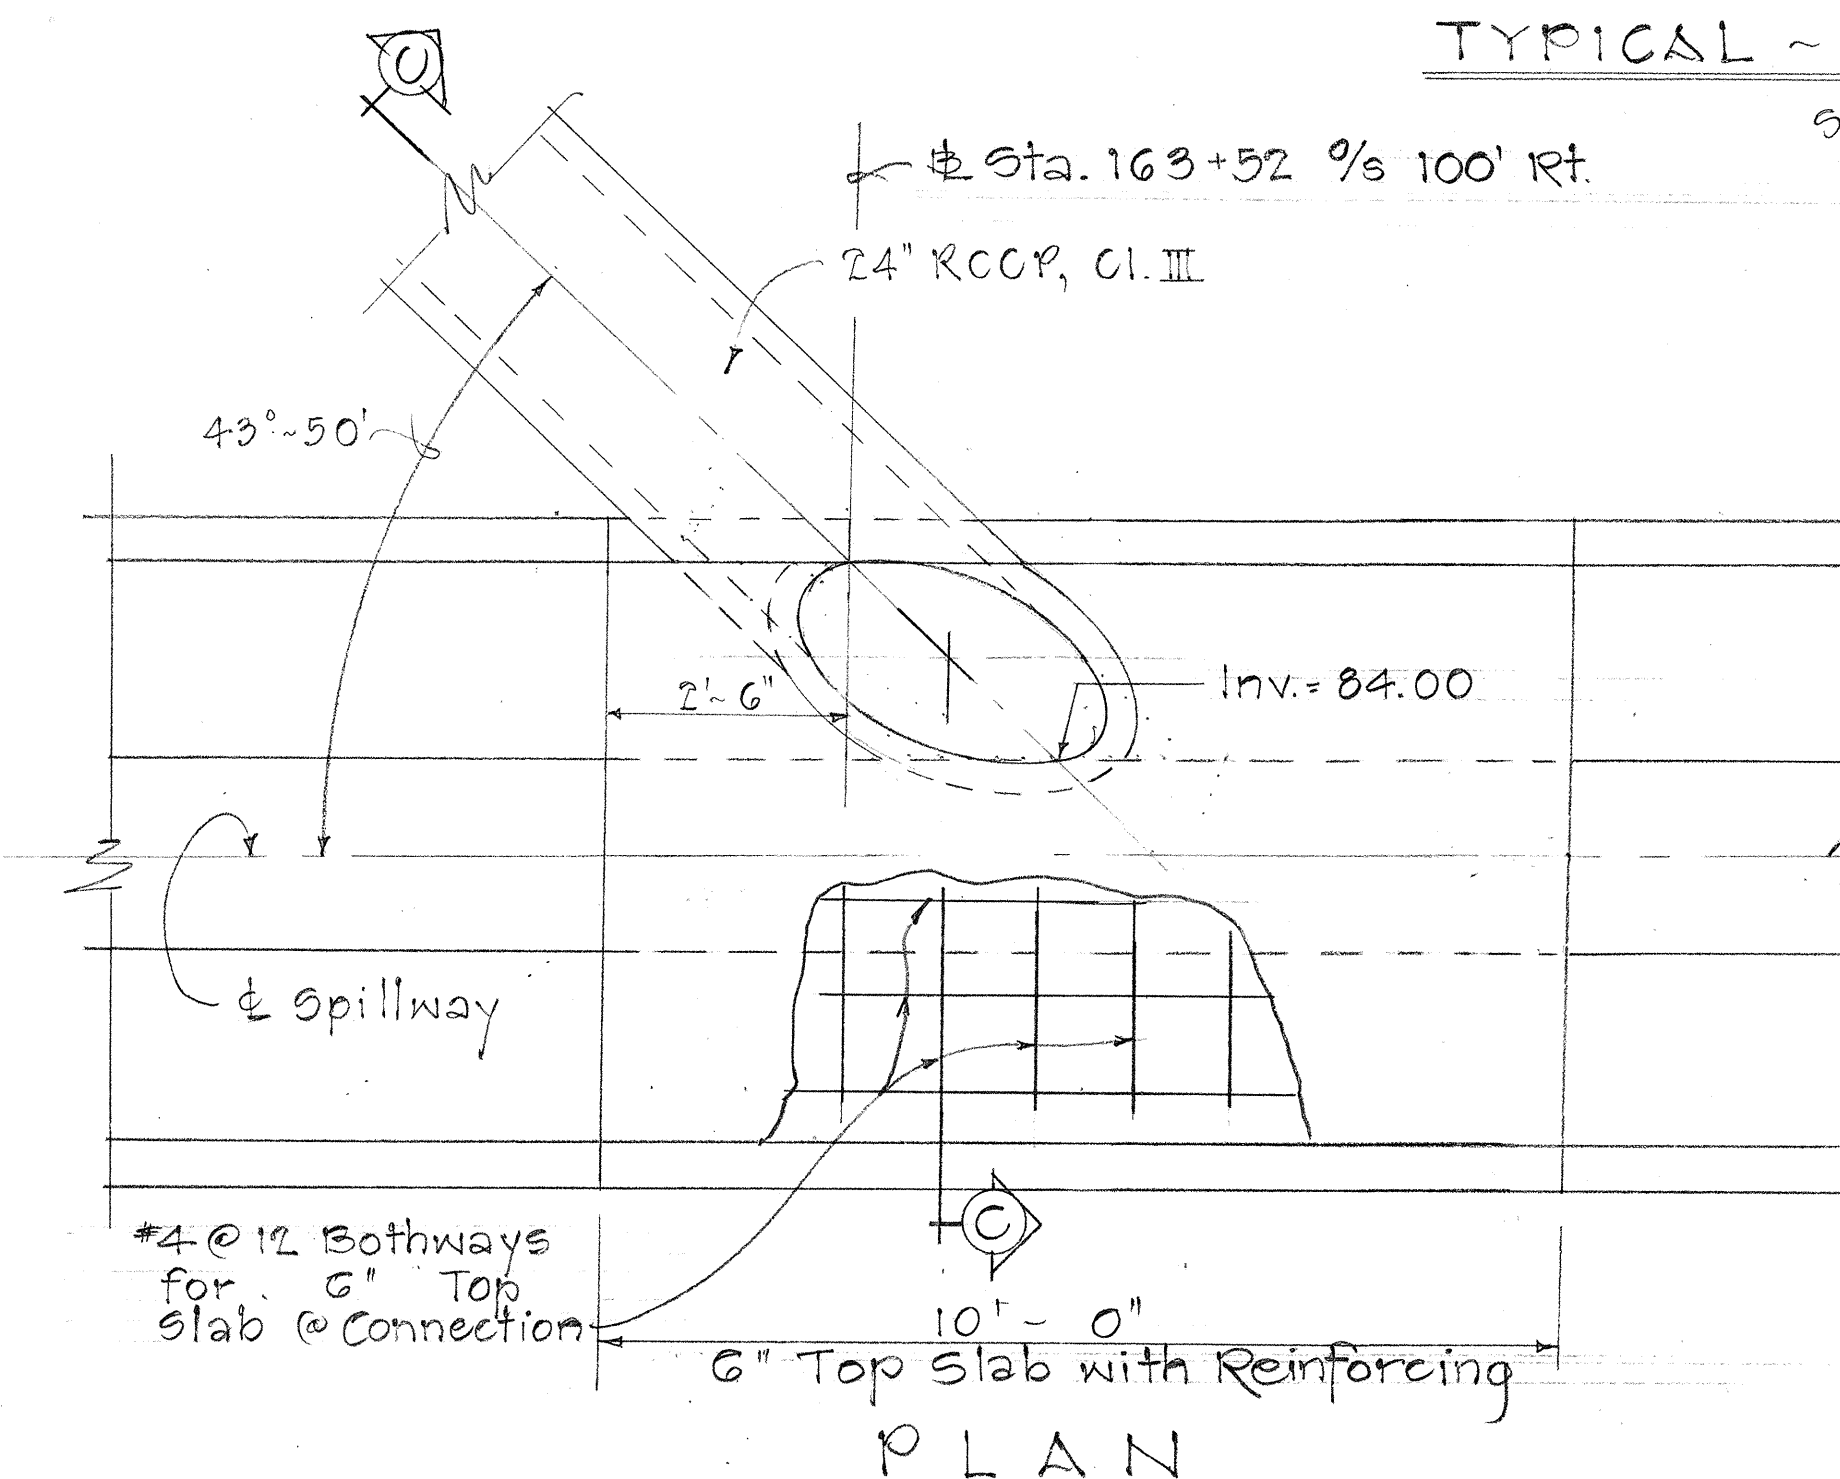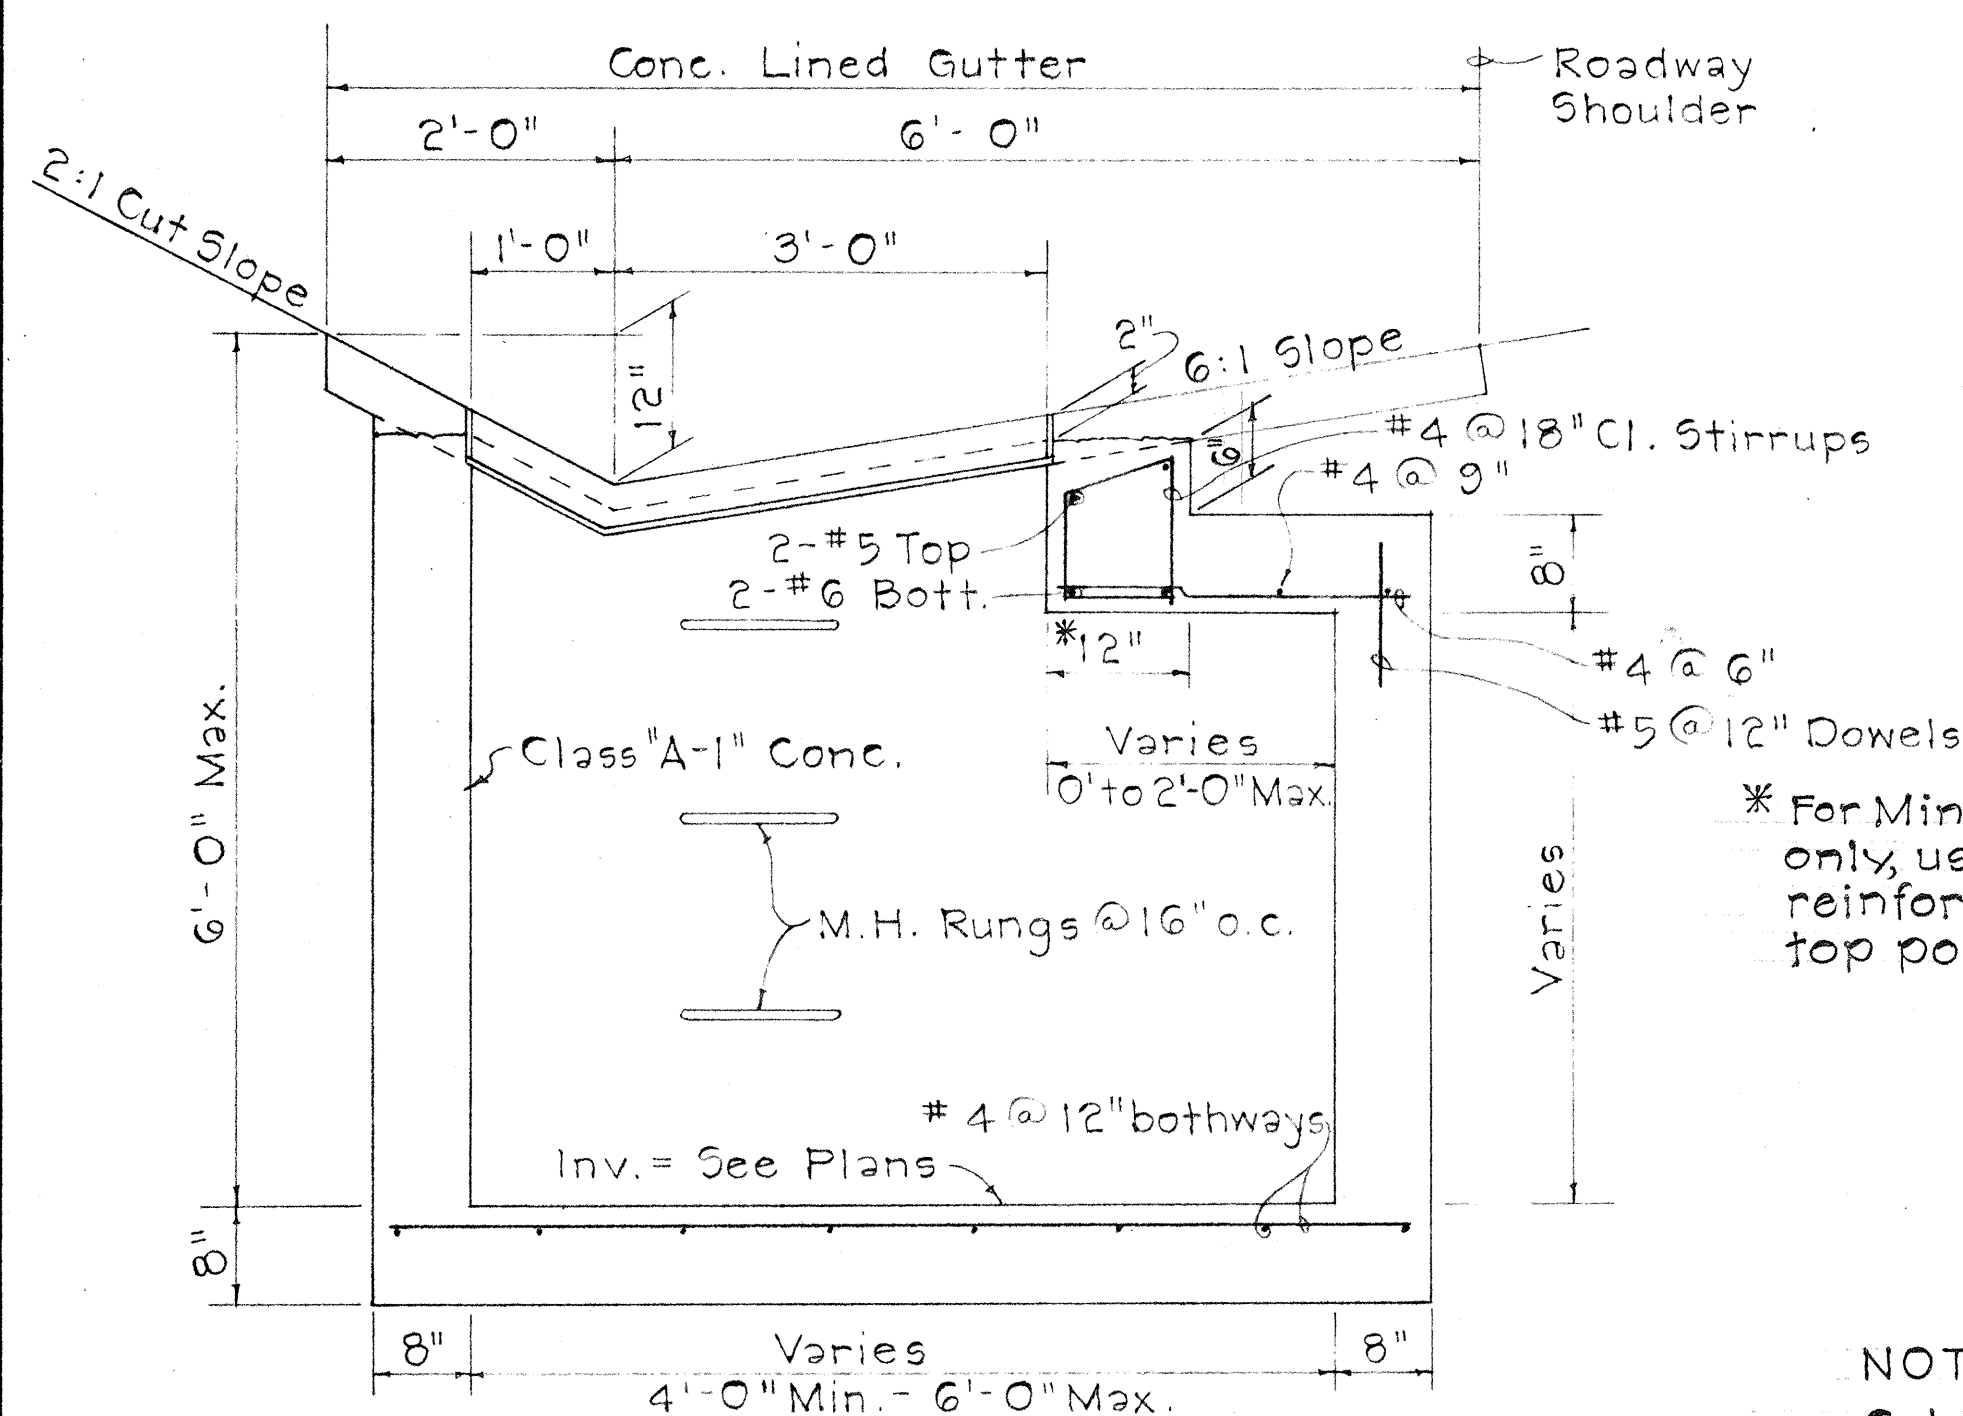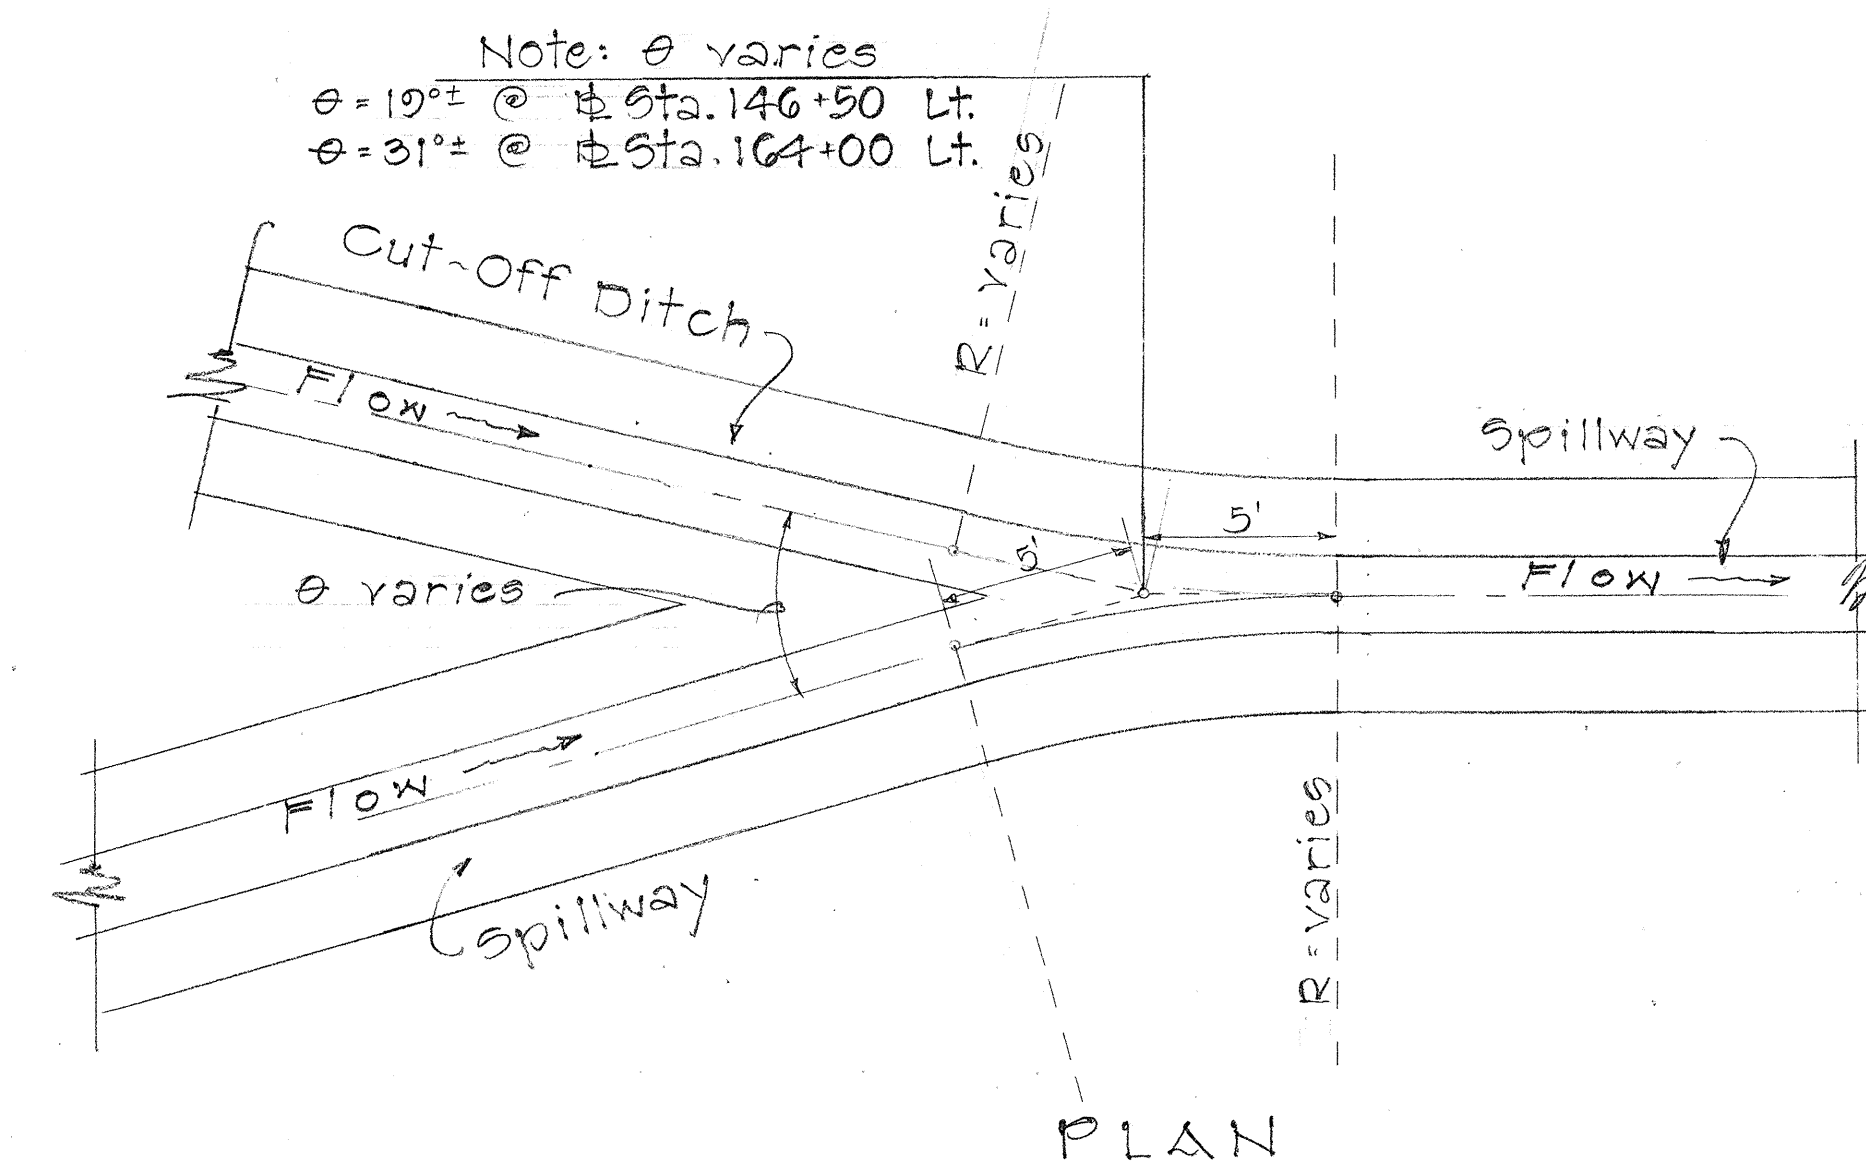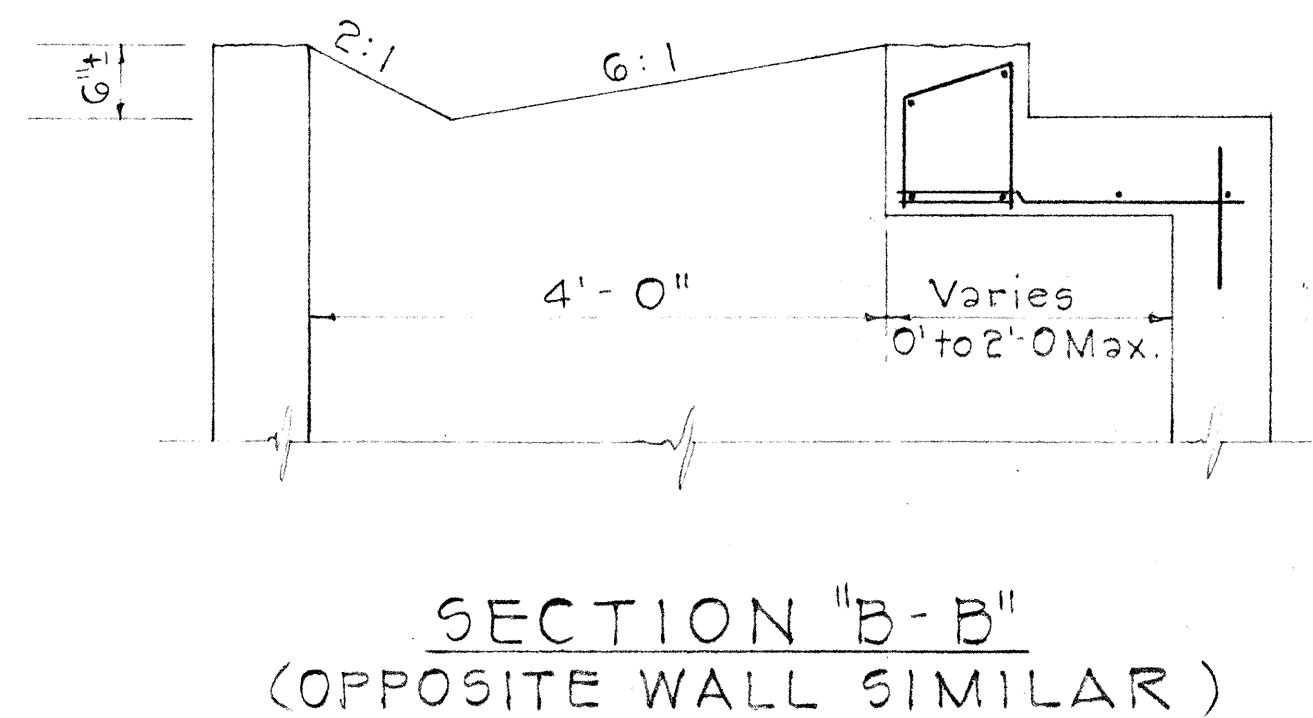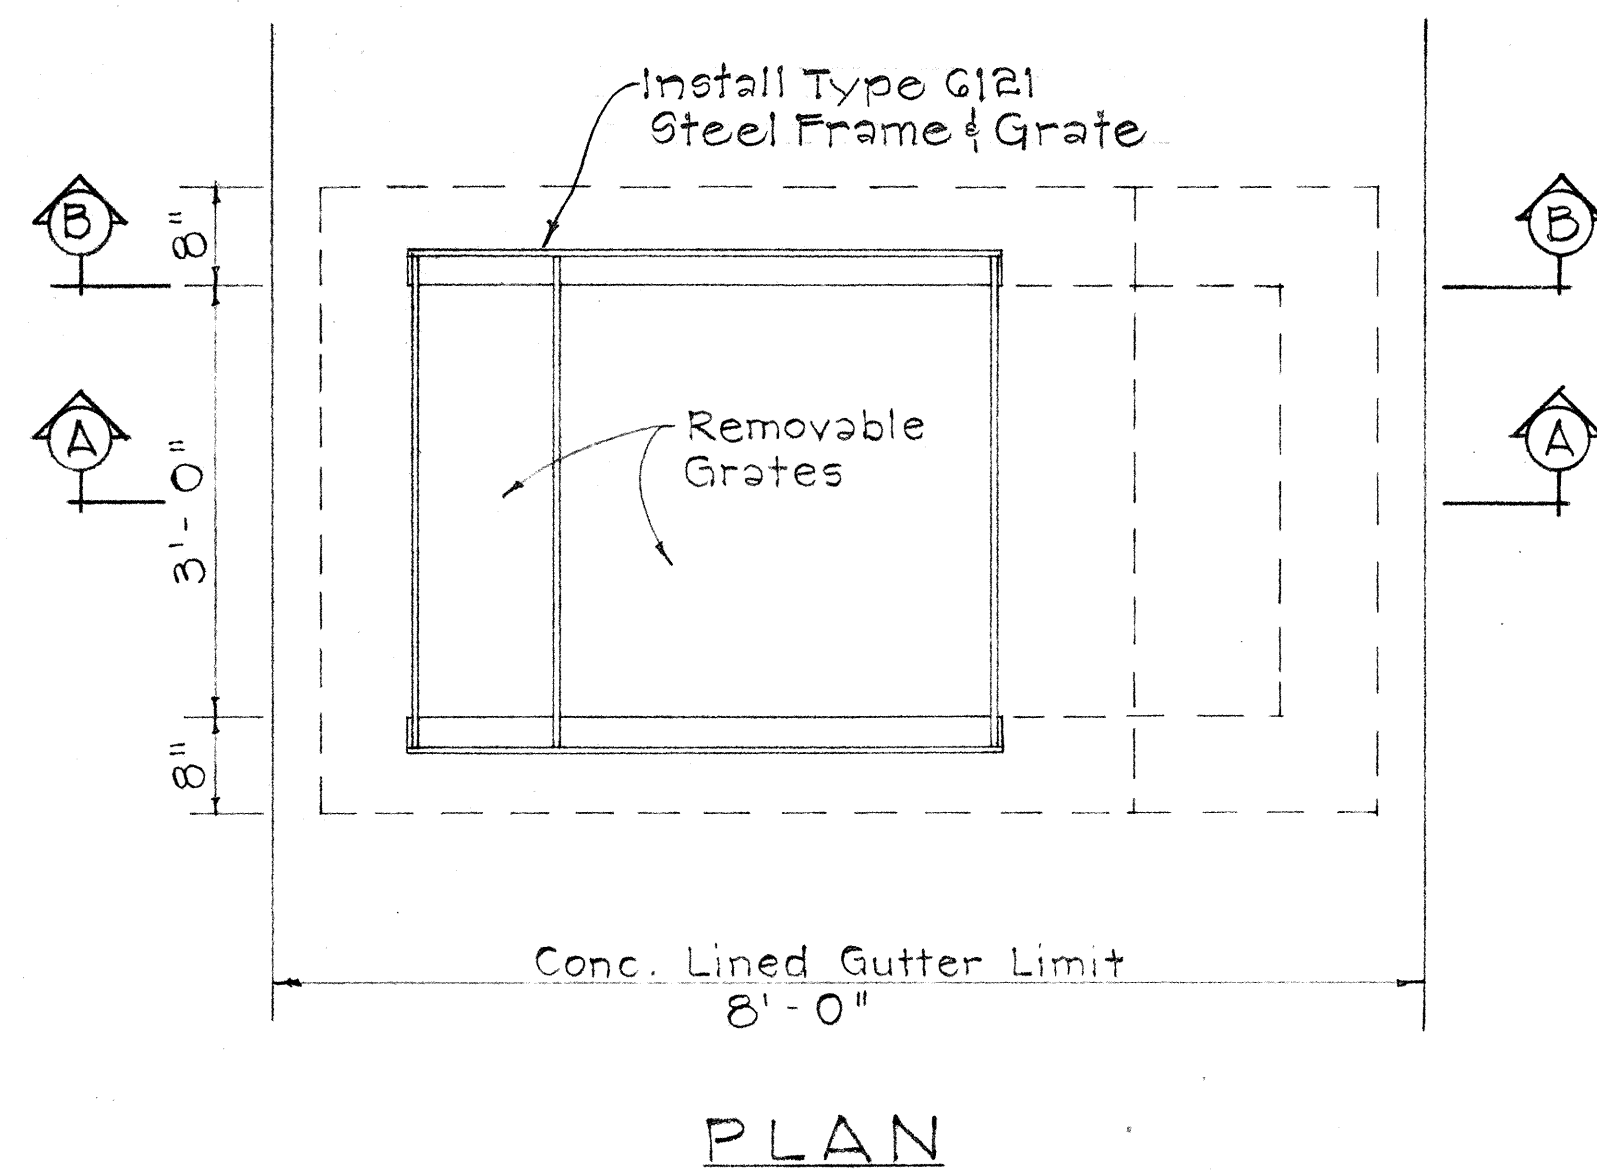

NOTE: Culvert shall leave C.D.I. from any position and any direction indicated by plans or ordered by the Engineer. Culvert may both enter and leave C.D.I. so that C.D.I. will act as manhole.

PIPE CULVERT CONNECTION TO SPILLWAY
AT STA. 163+52 9/s 100' RT.
scale: 1/2" = 1' 0"

DETAILS OF CONCRETE DROP INTAKE FOR TYPE G121 STEEL FRAME & GRATE
Scale: $\frac{3}{4}'' = 1'-0''$

STATE OF HAWAII
DEPARTMENT OF TRANSPORTATION
HIGHWAYS DIVISION

DRAINAGE DETAILS

INTERSTATE ROUTE H-1
PROJ. NO. 1-HI-1(64)-12, UNIT 1


Scale: As Shown Date: Jan. 1969

SHEET No. 9 OF 20 SHEETS

FED. ROAD DIST. NO.	STATE	FED. AID PROJECT	FISCAL YEAR	SHEET NO.	TOTAL SHEETS
HAWAII	HAWAII	1-HI-1164-12 Unit 1	1969	27	158
		1-HI-1164-11			


NOTE:

1. All welds $\frac{3}{8}$ " unless otherwise noted.
2. All steel shall be structural grade.
3. Grates and Frame shall be hot dip galvanized after fabrication in accordance with Section 44(H) of the Standard Specifications.
4. Detail of Types "A-1" and "A-2" Steel Frame and Grates are identical except for the thickness of end spacers and number of grate bars. See Table of End Spacer Thickness.

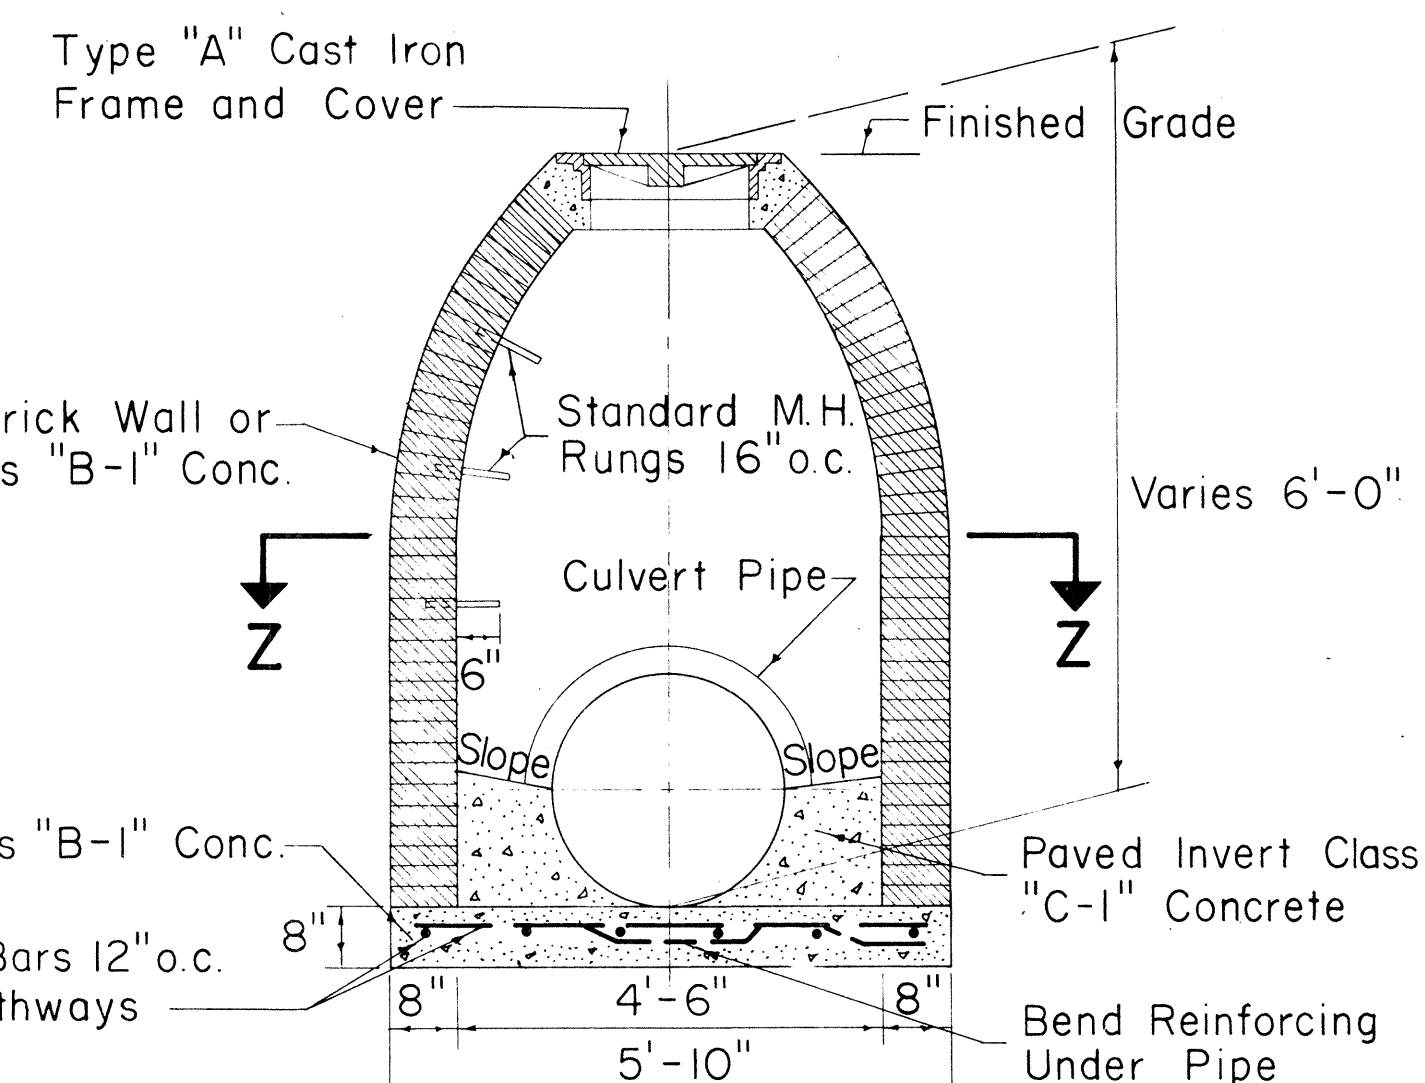


NOTE:

1. Exterior surface of brick wall shall be plastered with 1" thickness of 1:2 Cement Mortar.
2. Number size and direction of culvert pipes at manhole to be as shown on plans.
3. Paved invert not required at drop manholes.
4. All Class "C-1" Concrete to be incidental to Class "B-1" Concrete.

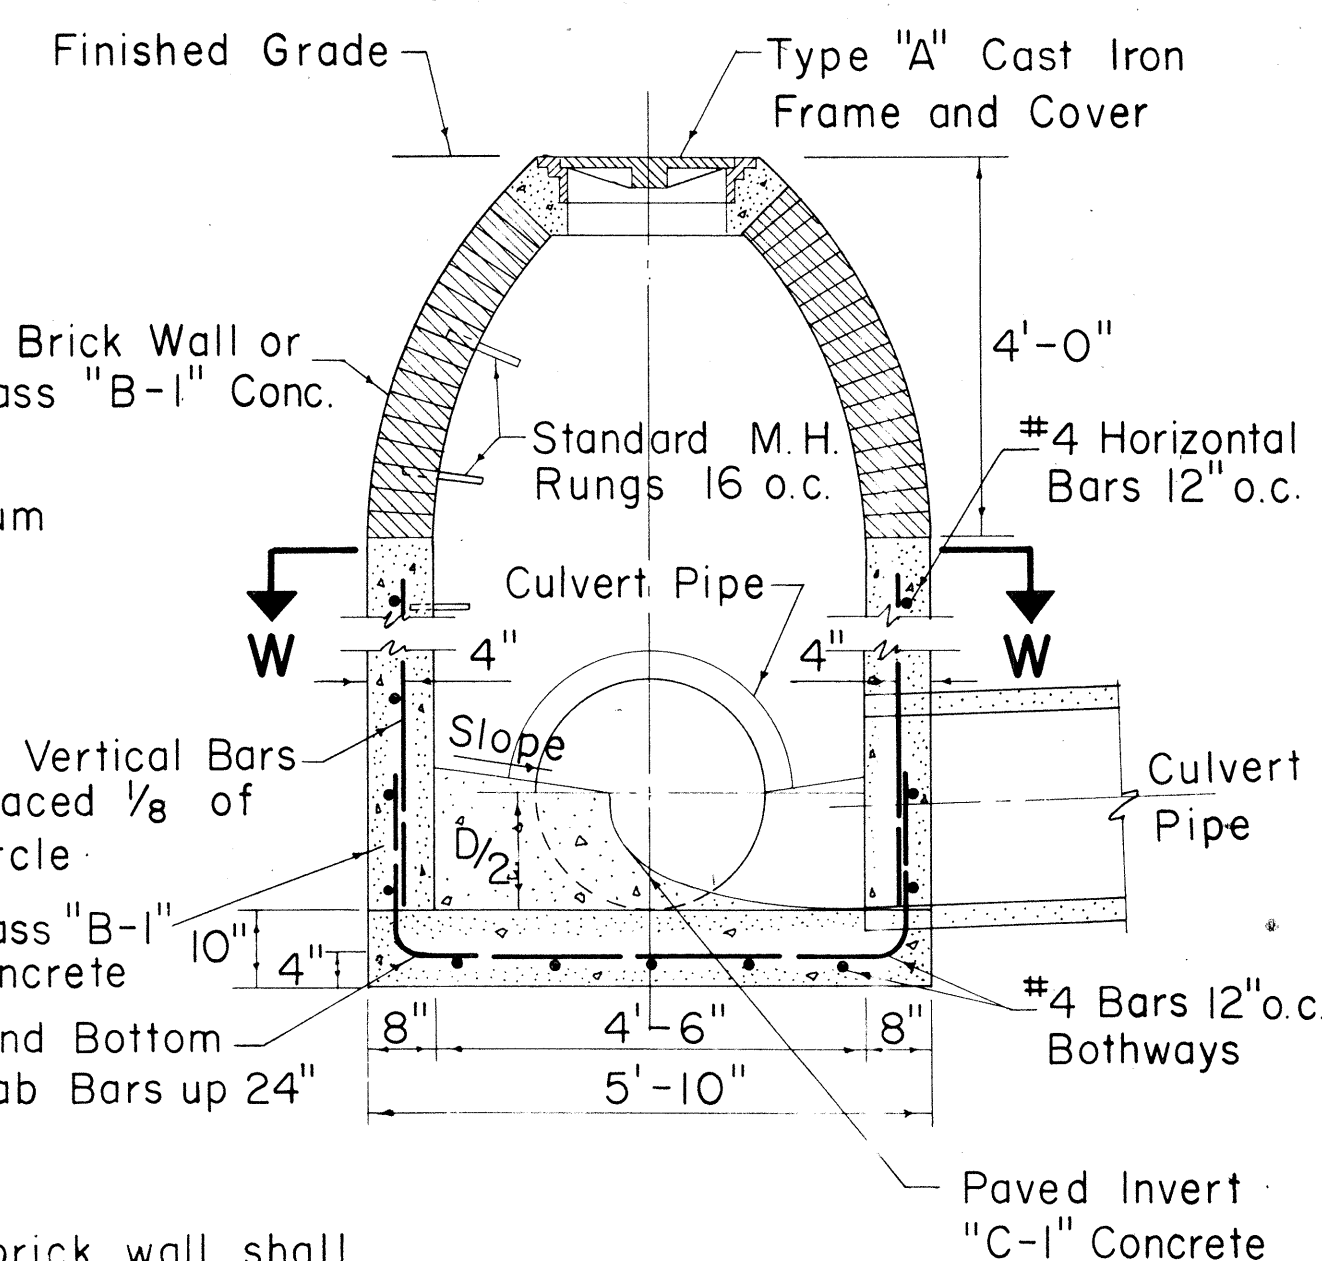

SECTION X-X

SECTION Y-Y

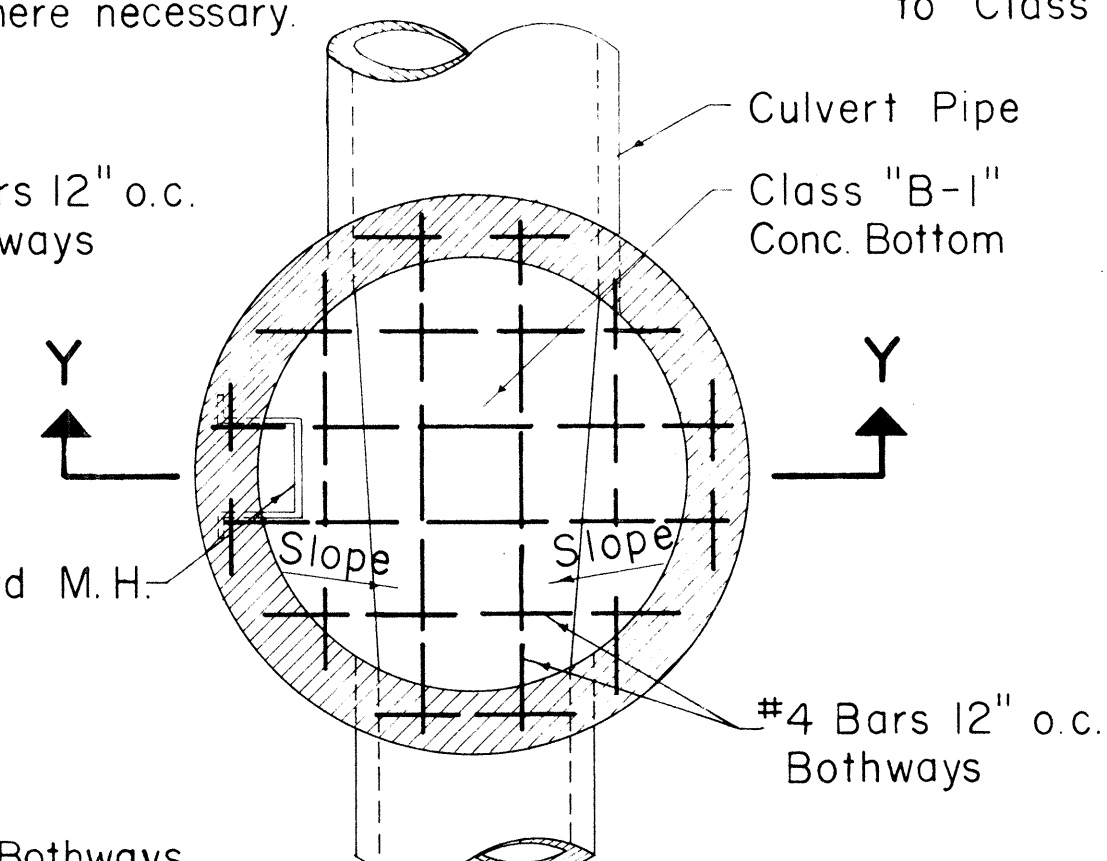


SECTION Z-Z

TYPE "D" STORM DRAIN MANHOLE


Scale: $\frac{1}{2}$ " = 1'-0"

TYPE "E" STORM DRAIN MANHOLE


Scale: $\frac{1}{2}$ " = 1'-0"

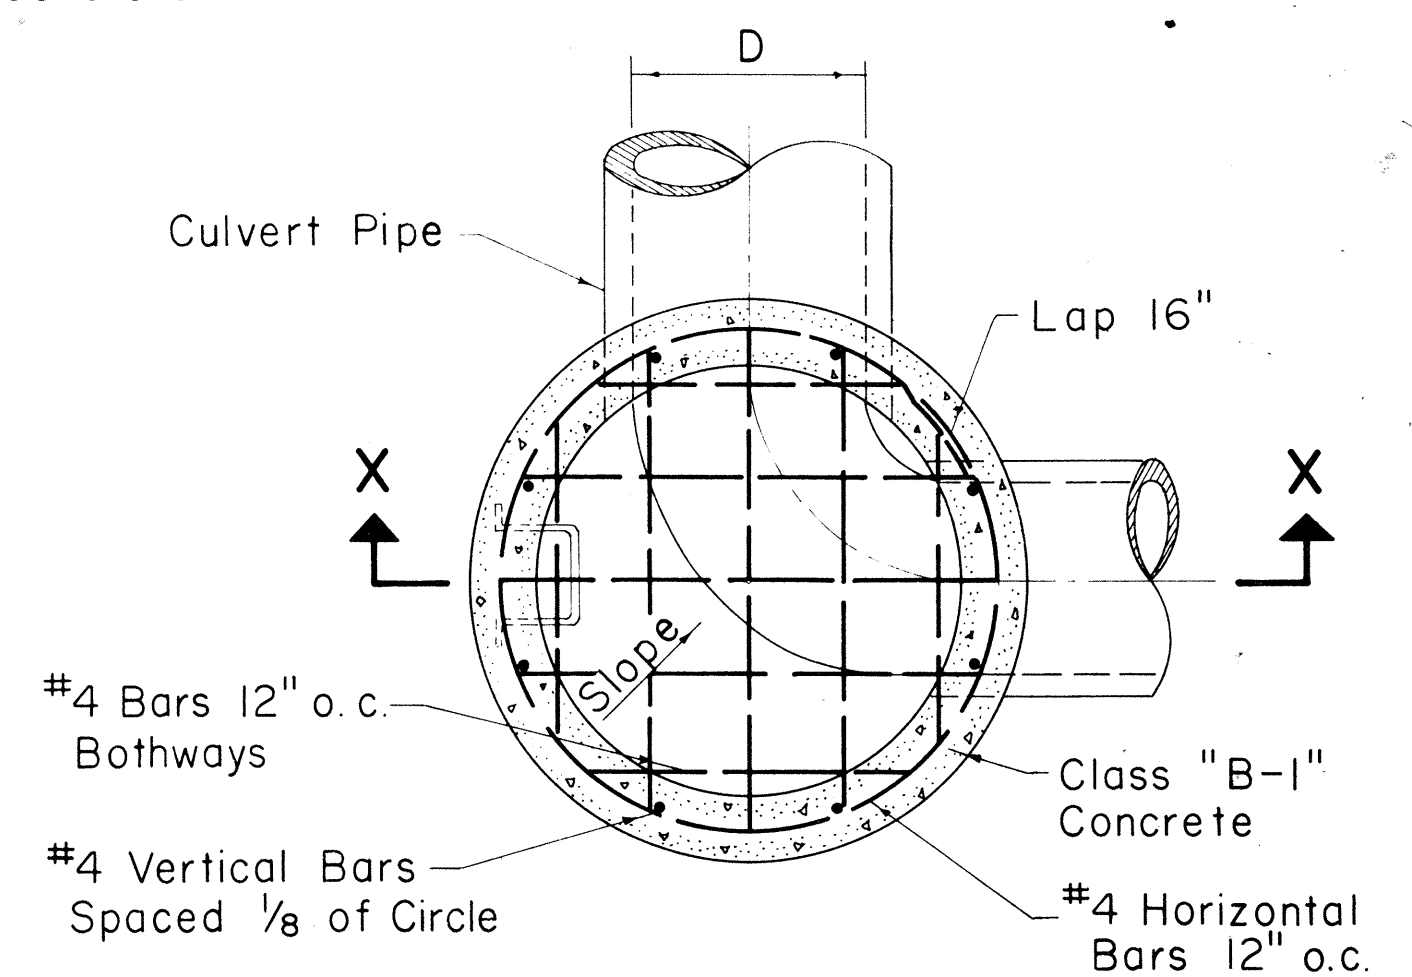

SECTION W-W

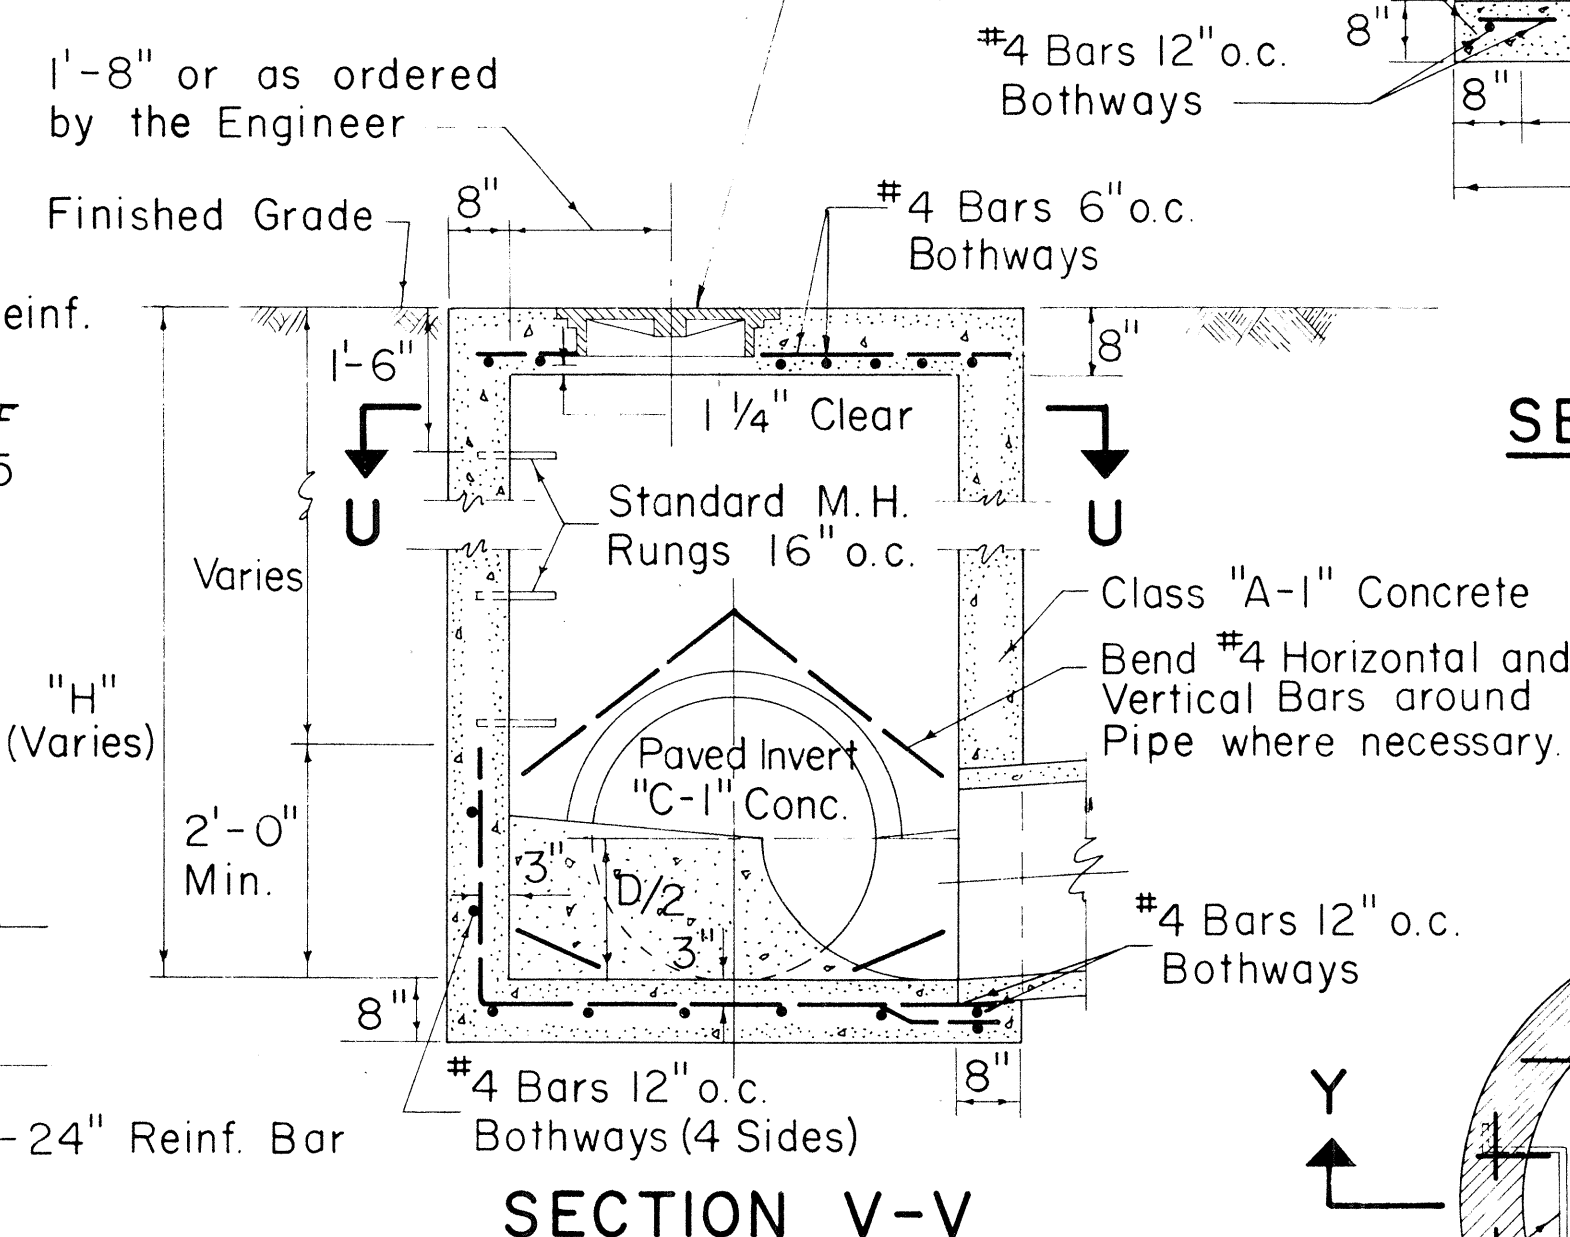

SECTION V-V

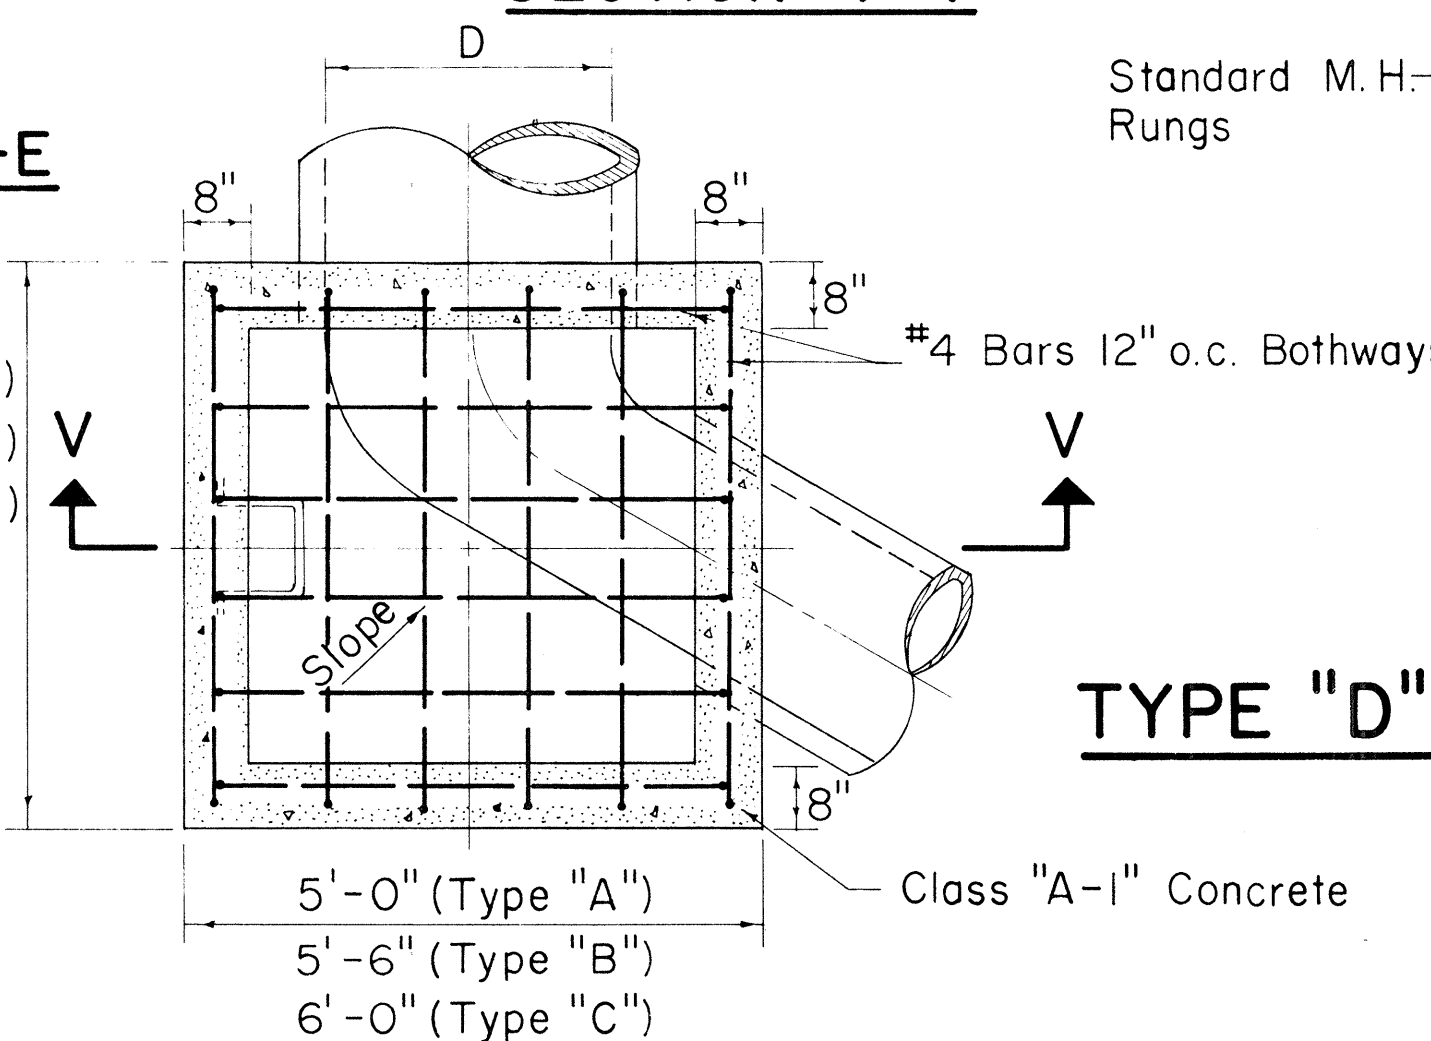


SECTION U-U


TYPE "A", "B", & "C"

S.D.M.H.

Scale: $\frac{1}{2}$ " = 1'-0"

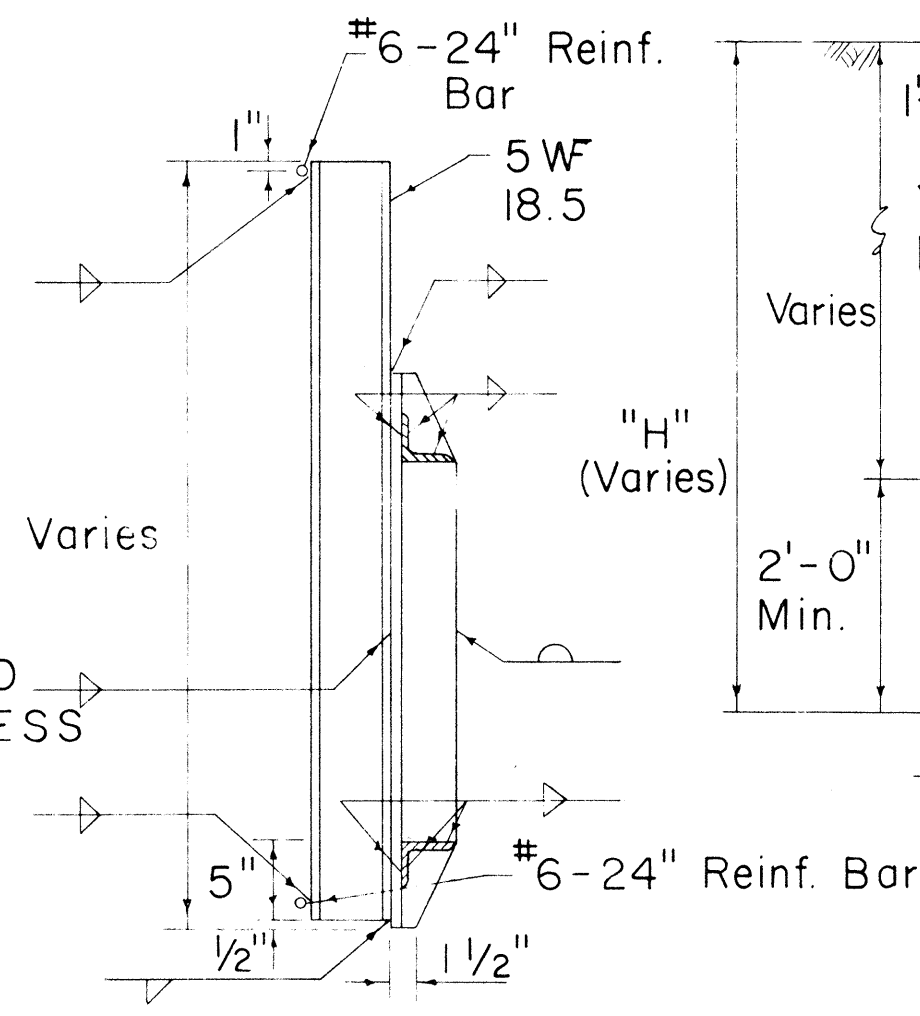


SECTION E-E

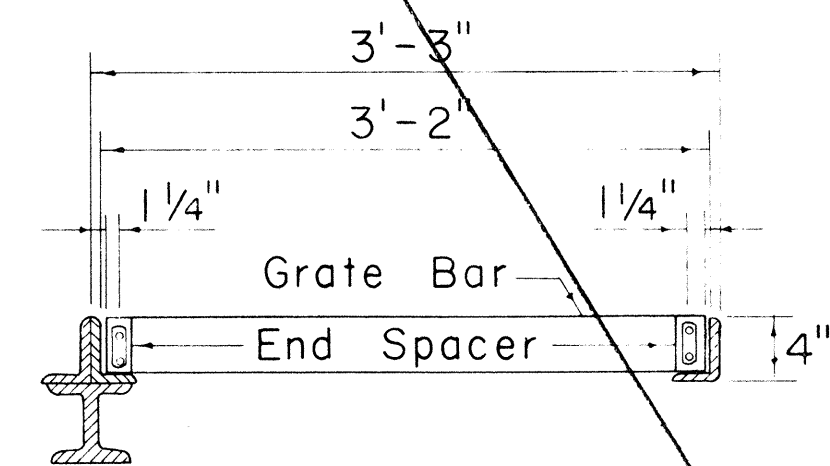


SECTION D-D

TYPE FRAME & GRATES	"T" (in.)
A-1	1
A-2	1 3/8

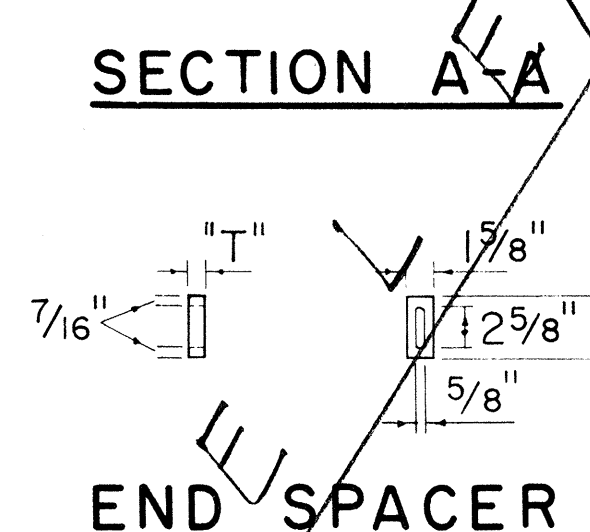


SECTION A-A


END SPACER

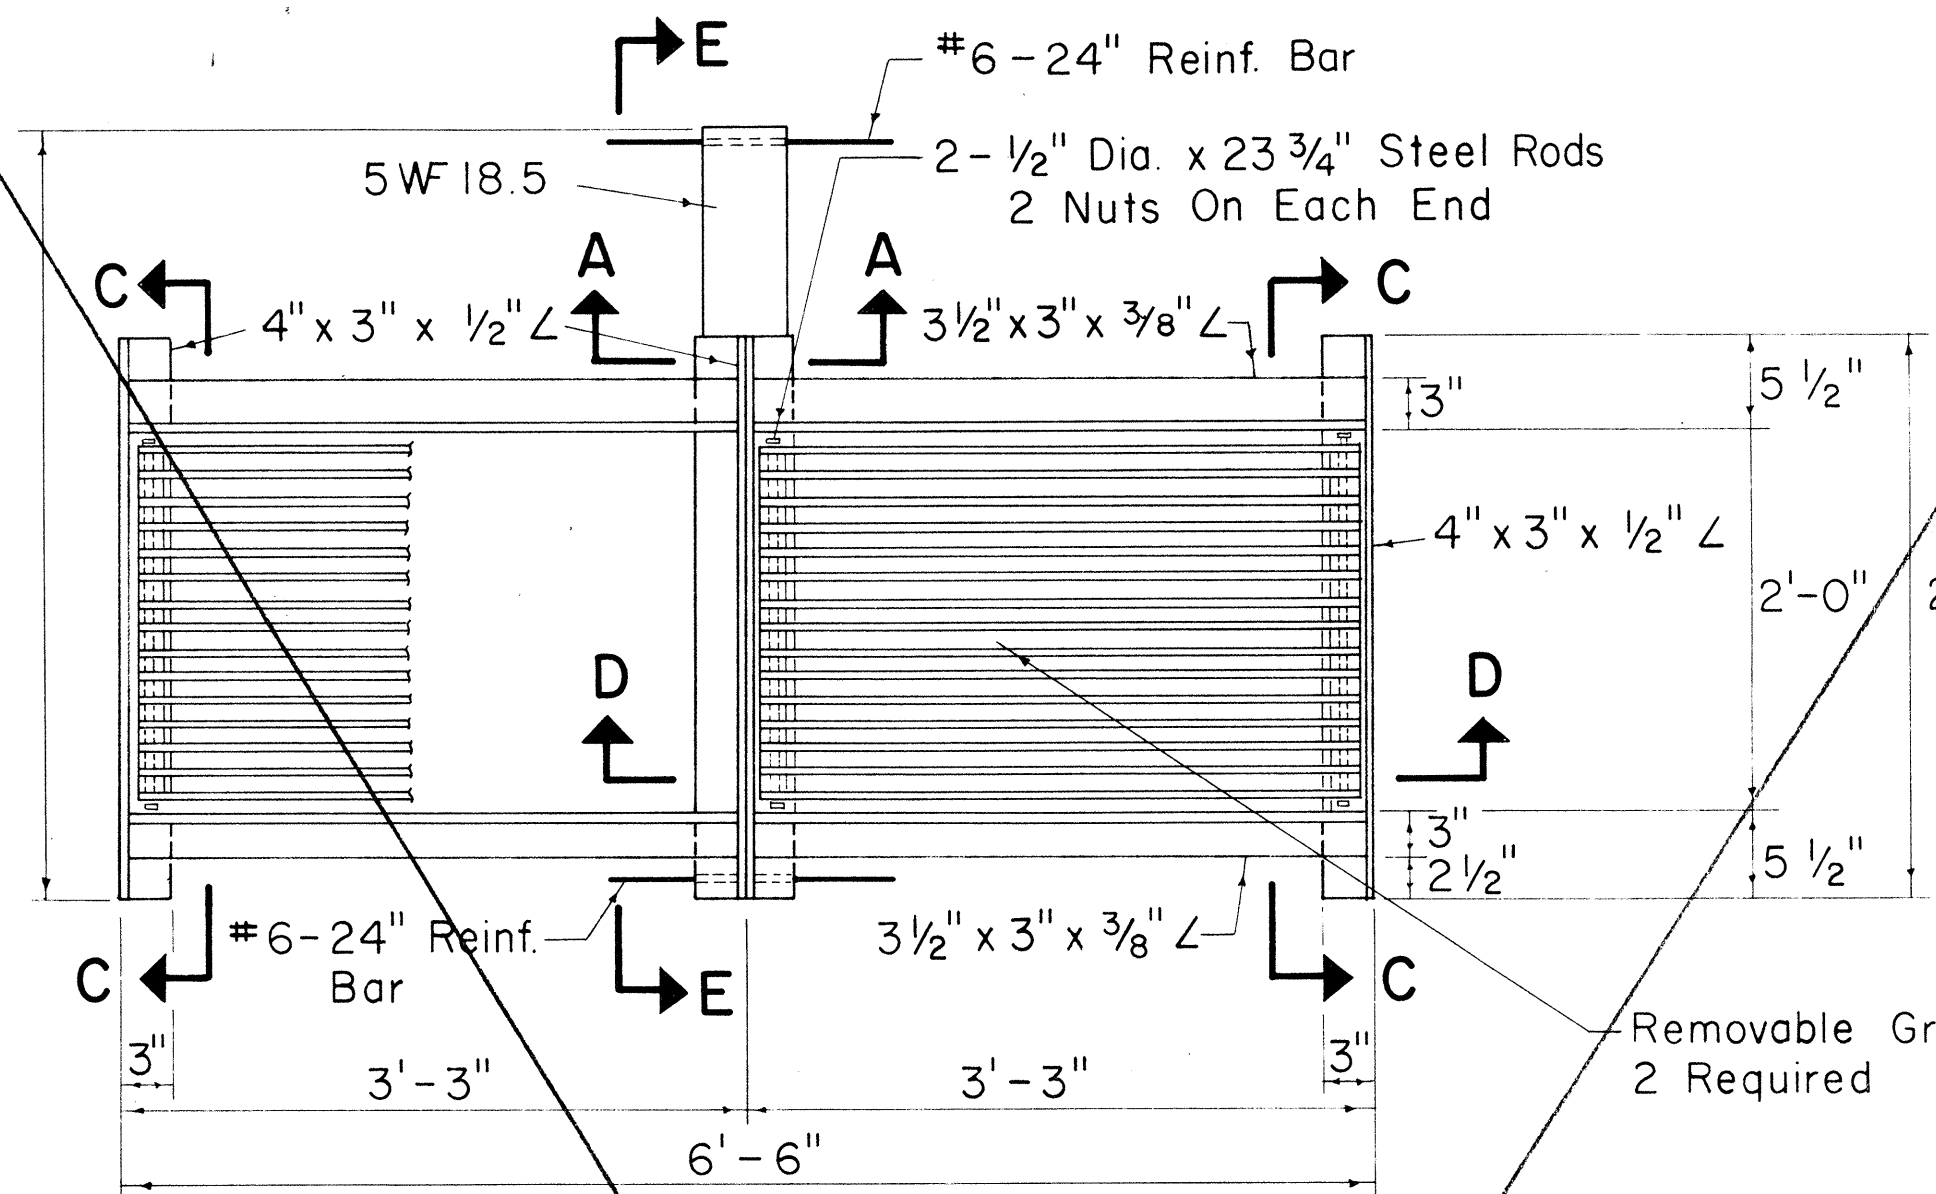

PLAN

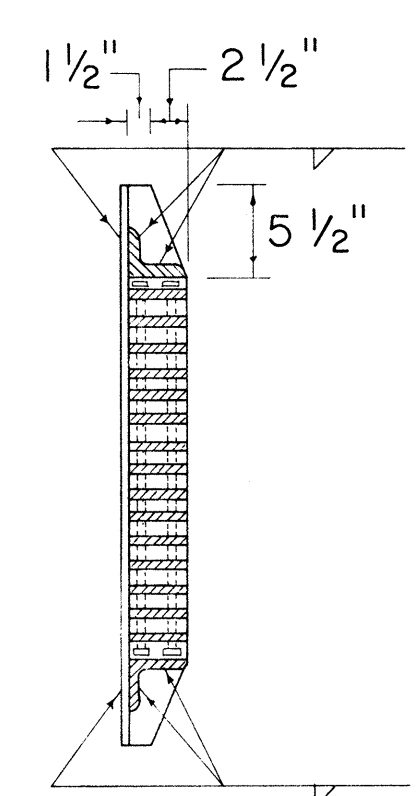

SECTION C-C

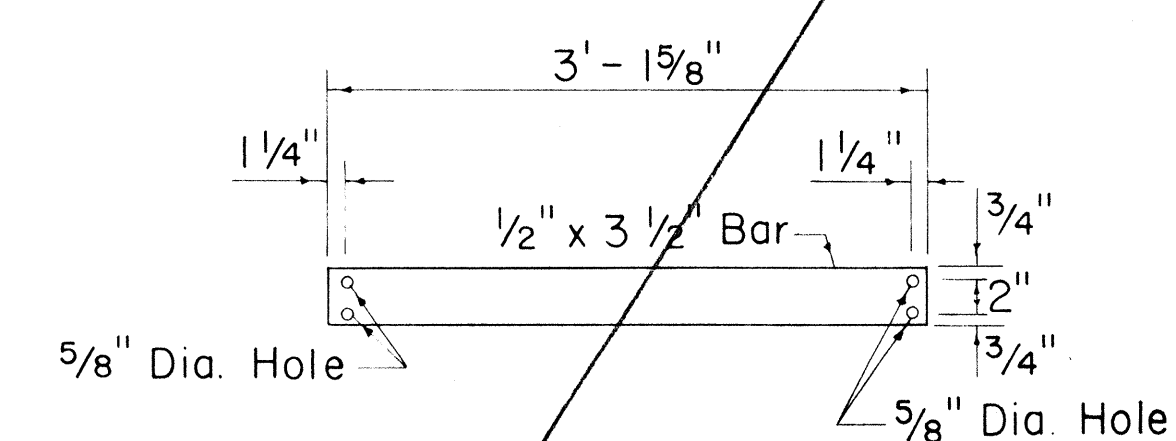

GRATE BARS

DETAIL OF TYPE "A-1" & "A-2" STEEL FRAME AND GRATES

Scale: 1" = 1'-0"

APPROVED:

DIRECTOR OF TRANSPORTATION DATE

STATE OF HAWAII
DEPARTMENT OF TRANSPORTATION
HIGHWAYS DIVISION

STANDARD DETAILS
STEEL FRAME AND GRATES
AND STORM DRAIN MANHOLES

Scales: As Noted Date 8/12/68

SHEET NO. 10 OF 20 SHEETS

FED. ROAD DIST. NO.	STATE	FED. AID PROJ. NO.	FISCAL YEAR	SHEET NO.	TOTAL SHEETS
HAWAII	HAW.	1-H-1(64)12 Unit 1	1969	98	158
1-H-1(16)-11					

GENERAL NOTES

- Contractor has the option of using cast malleable iron, cast steel, welded, bolted or cast steel end block grate.
- Grates and Frames shall be hot dip galvanized after fabrication, see specifications.
- All welds 3/8" unless otherwise noted.
- Center support assembly shall be used when two or more grates are specified. Incidental to Types A-9 or A-12 Frame and Grates.
- Refer to "Grate Bar Spacing Table" for Types A-9 and A-12 Grate dimensions.
- The various materials shall conform to the specifications of ASTM as listed in the following tabulation and the Std. Specifications.

Material	ASTM Designation
Structural Steel.....	A283, Grade D
Cast Steel.....	A27, Grade 65-35
Malleable Iron Casting....	A47, Gr. No. 35018

GRATE BAR SPACING TABLE

TYPE	NO. BARS	CLEAR BAR SPACING-W	X
A-9	9	2"	1 9/16"
A-12	12	1 3/8"	1 1/4"

NOTE:


- Type A-9 - Use in locations off the roadbed on all types of highways.
- Type A-12 - Use within the roadbed on all types of highways.

STATE OF HAWAII
DEPARTMENT OF TRANSPORTATION
HIGHWAYS DIVISION


STANDARD DETAILS
TYPES A-9 AND A-12
FRAMES AND GRATES

Scales: As Noted Date: Aug. 1968

SHEET No. 11 OF 20 SHEETS

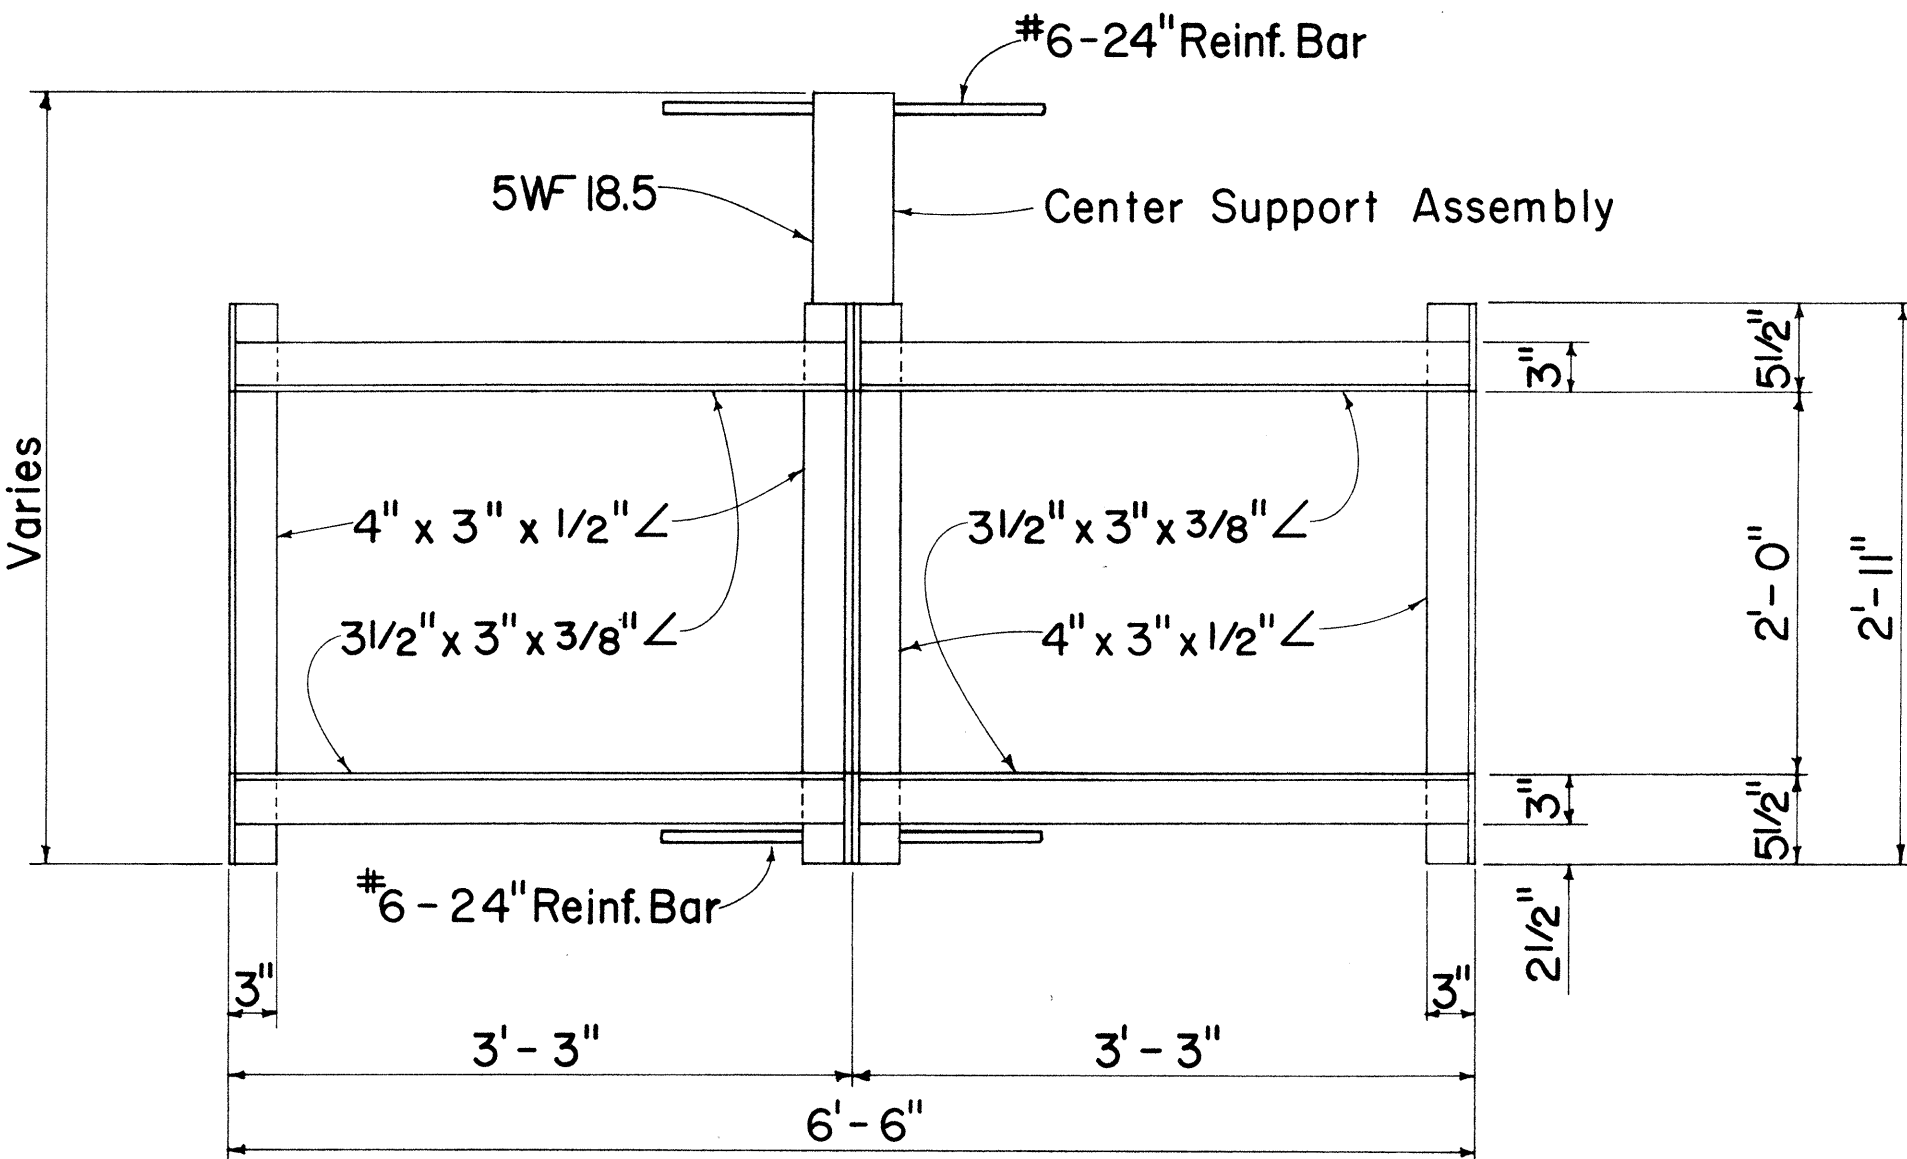


PLAN
(Two or More Grates)

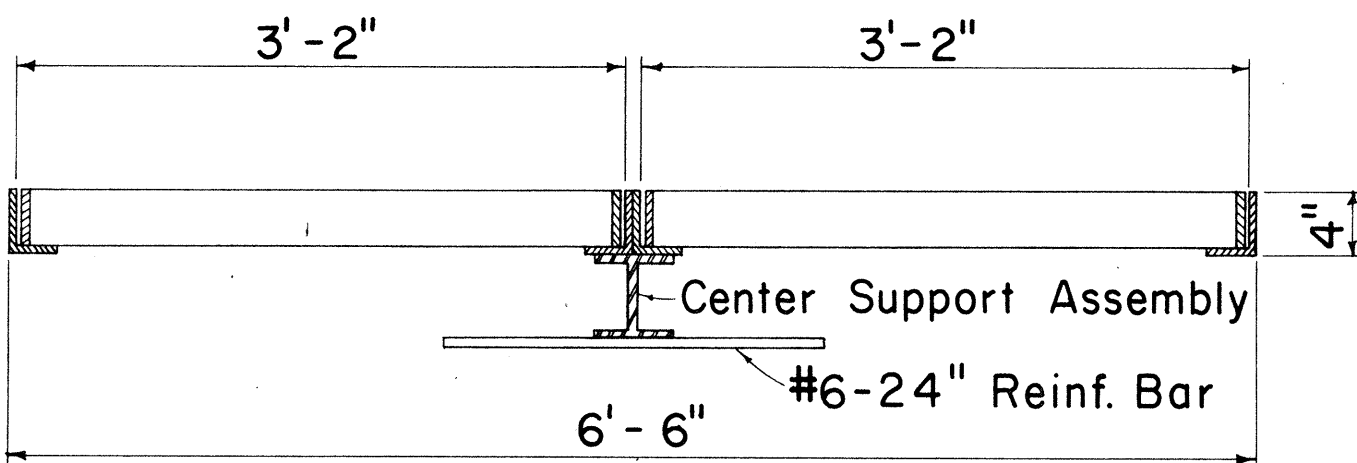

LONGITUDINAL SECTION
(Thru Frame & Grate)

FRAME DETAILS


Scale: 1"= 1'- 0"

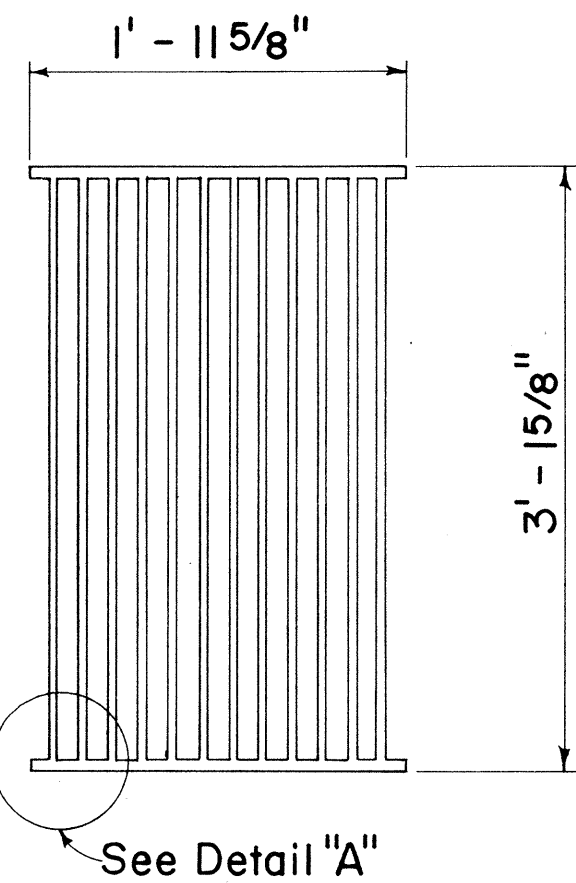


PLAN

Scale: 1"= 1'- 0"


ALTERNATIVE CAST MALLEABLE IRON
OR CAST STEEL GRATE

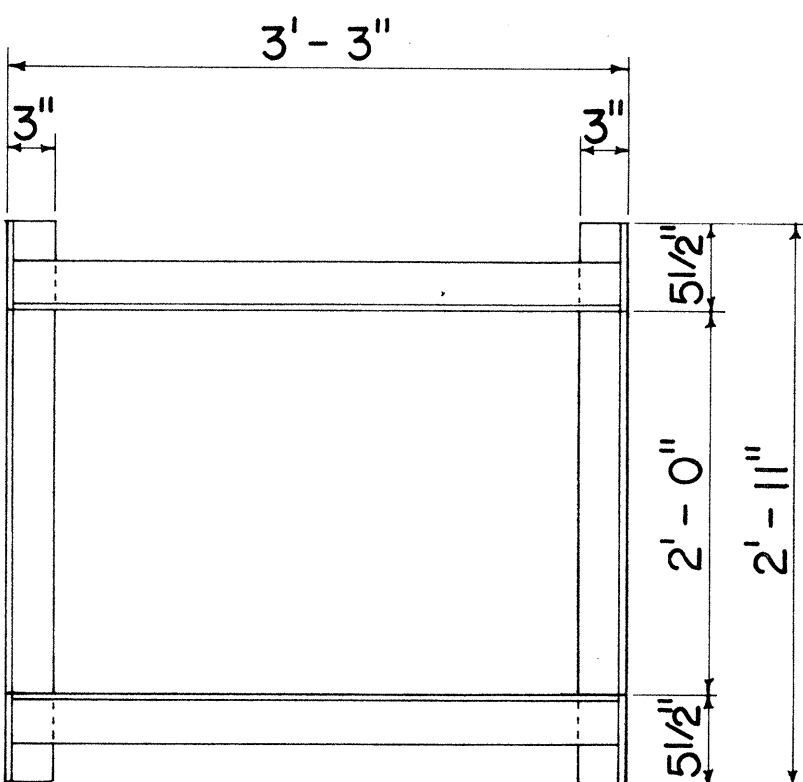

PLAN
(Single Grate)

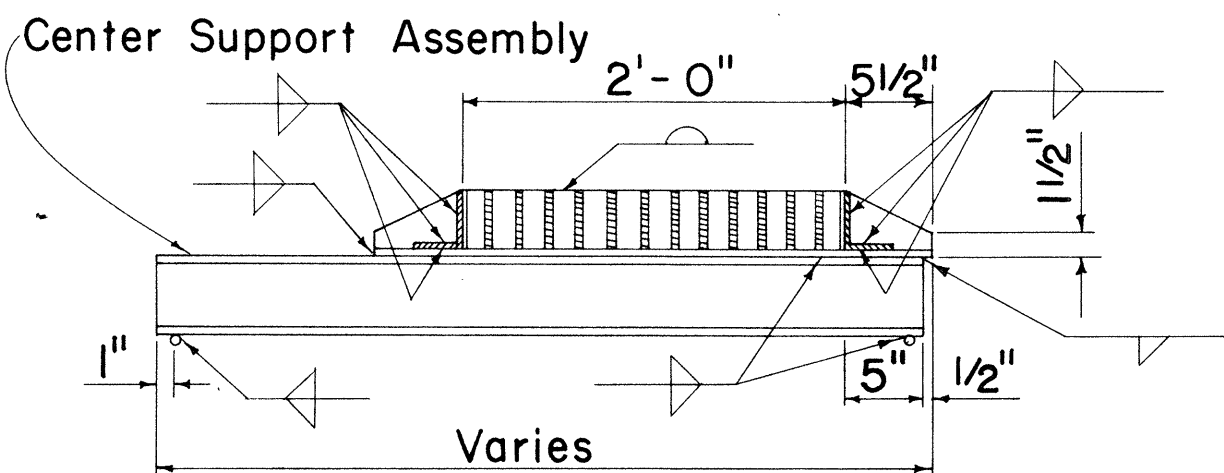


CROSS SECTION
(Thru Frame & Grate)

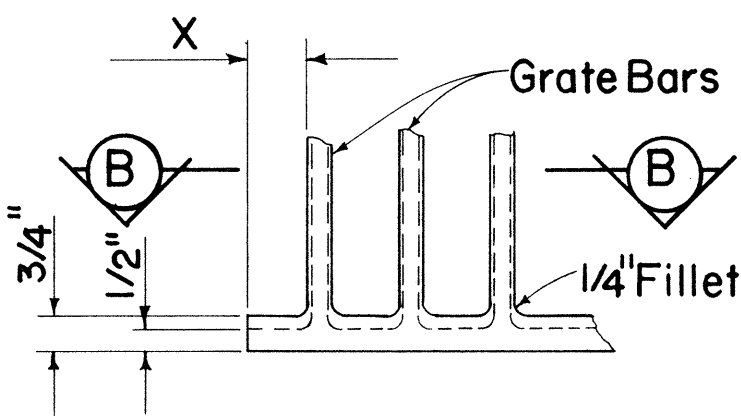


DETAIL "A"

Scale: 3"= 1'- 0"

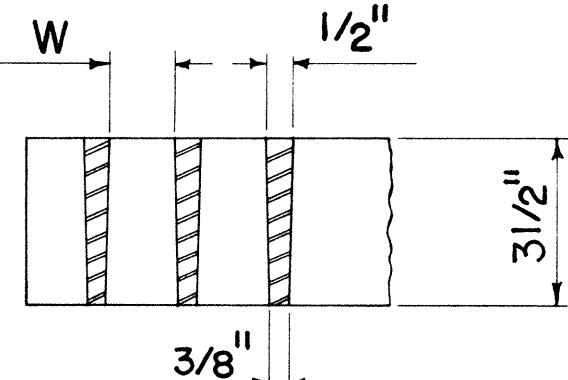


SECTION "B-B"

Scale: 3"= 1'- 0"

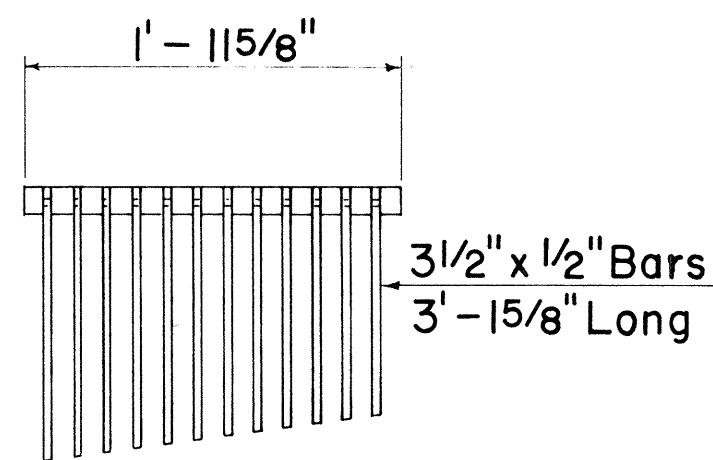

CAST END BLOCK


Scale: 1"= 1'- 0"

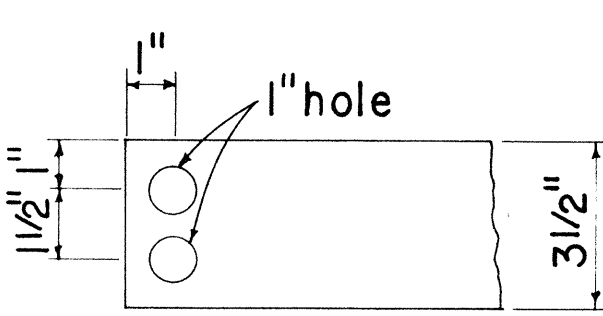

END OF BAR


Scale: 3"= 1'- 0"

ALTERNATIVE CAST MALLEABLE IRON
OR CAST STEEL END BLOCK GRATE

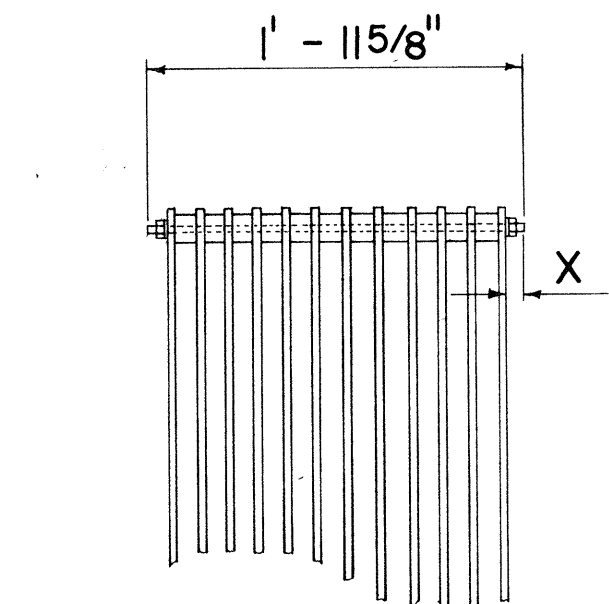

BOLTED END BLOCK


Scale: 1"= 1'- 0"

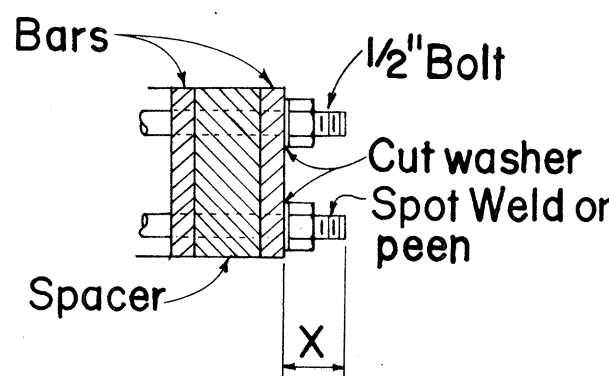

BOLTING DETAIL


Scale: 3"= 1'- 0"

ALTERNATIVE BOLTED GRATE

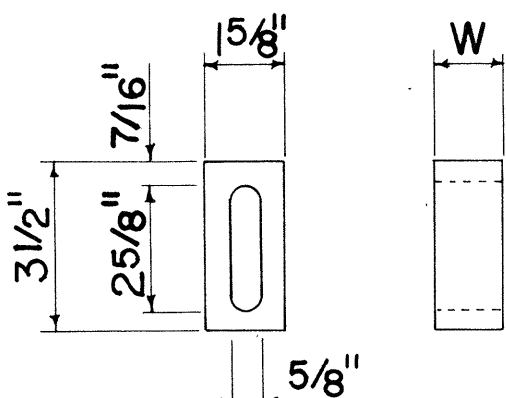


BAR SPACER

Scale: 3"= 1'- 0"

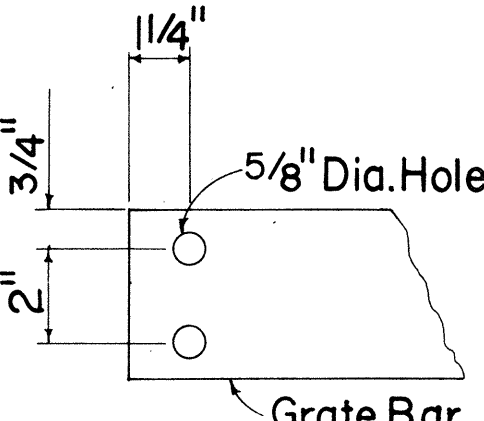


END OF BAR

Scale: 3"= 1'- 0"

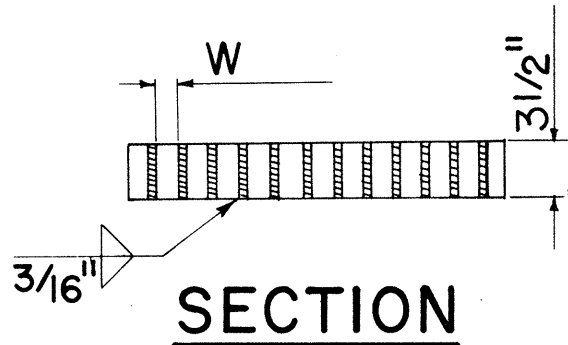

SECTION

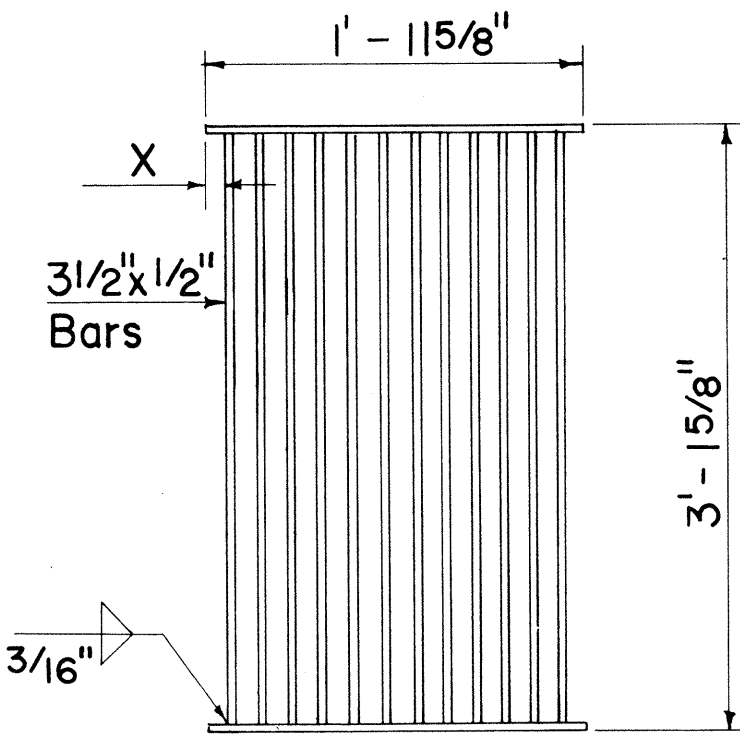

PLAN

ALTERNATIVE
WELDED GRATE


Scale: 1"= 1'- 0"

SURVEY PLOTTED BY: M.	DATE: 7/68
DESIGNED BY: H.K.M.	7/68
QUANTITIES BY: H.K.M.	8/68
CHECKED BY: H.K.M.	8/68
ORIGINAL PLAN	
NOTE BOOK	
No.	

ORIGINAL PLAN	SURVEY PLOTTED BY.....	DATE.....
NOTE BOOK	DESIGNED BY.....	" " " "
	DRAWN BY.....	" " " "
	TRACED BY <i>Calistro</i>	" " " "
	QUANTITIES BY.....	" " " "
	CHECKED BY.....	" " " "
No.		



DETAILS OF TYPE "S" CAST IRON FRAME AND COVER

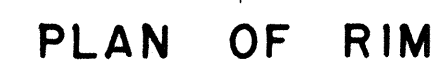

DETAILS OF TYPE "B"
CAST IRON FRAME AND COVER

SCALE : 1-1/2" = 1'-0"



DETAILS OF TYPE "A"

CAST IRON FRAME AND COVER

SCALE: 1-1/2" = 1'-0"

SECTION

TOP VIEW


TOP VIEW

TYPE C C.I. FRAME AND GRATING

SCALE: 3/4" = 1'-0"



SCALE: 1-1/2" = 1'-0"

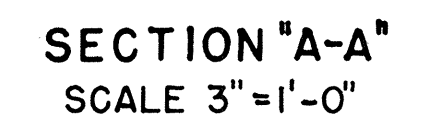

DETAILS OF TYPE "W" CAST IRON FRAME AND COVER

SCALE: 1-1/2" = 1'-0"








STATE OF HAWAII
DEPARTMENT OF TRANSPORTATION
HIGHWAYS DIVISION

STANDARD DETAILS CATCH BASIN AND MANHOLE CASTINGS

SCALES AS NOTED


SHEET NO 12 OF 20 SHEETS

FED. ROAD DIST. NO.	STATE	FED. AID PROJ. NO.	FISCAL YEAR	SHEET NO.	TOTAL SHEETS
HAWAII	HAWAII	1-HI-1(64)-12 Unit 1	1969	100	158
1-HI-1(64)-12 Unit 1					

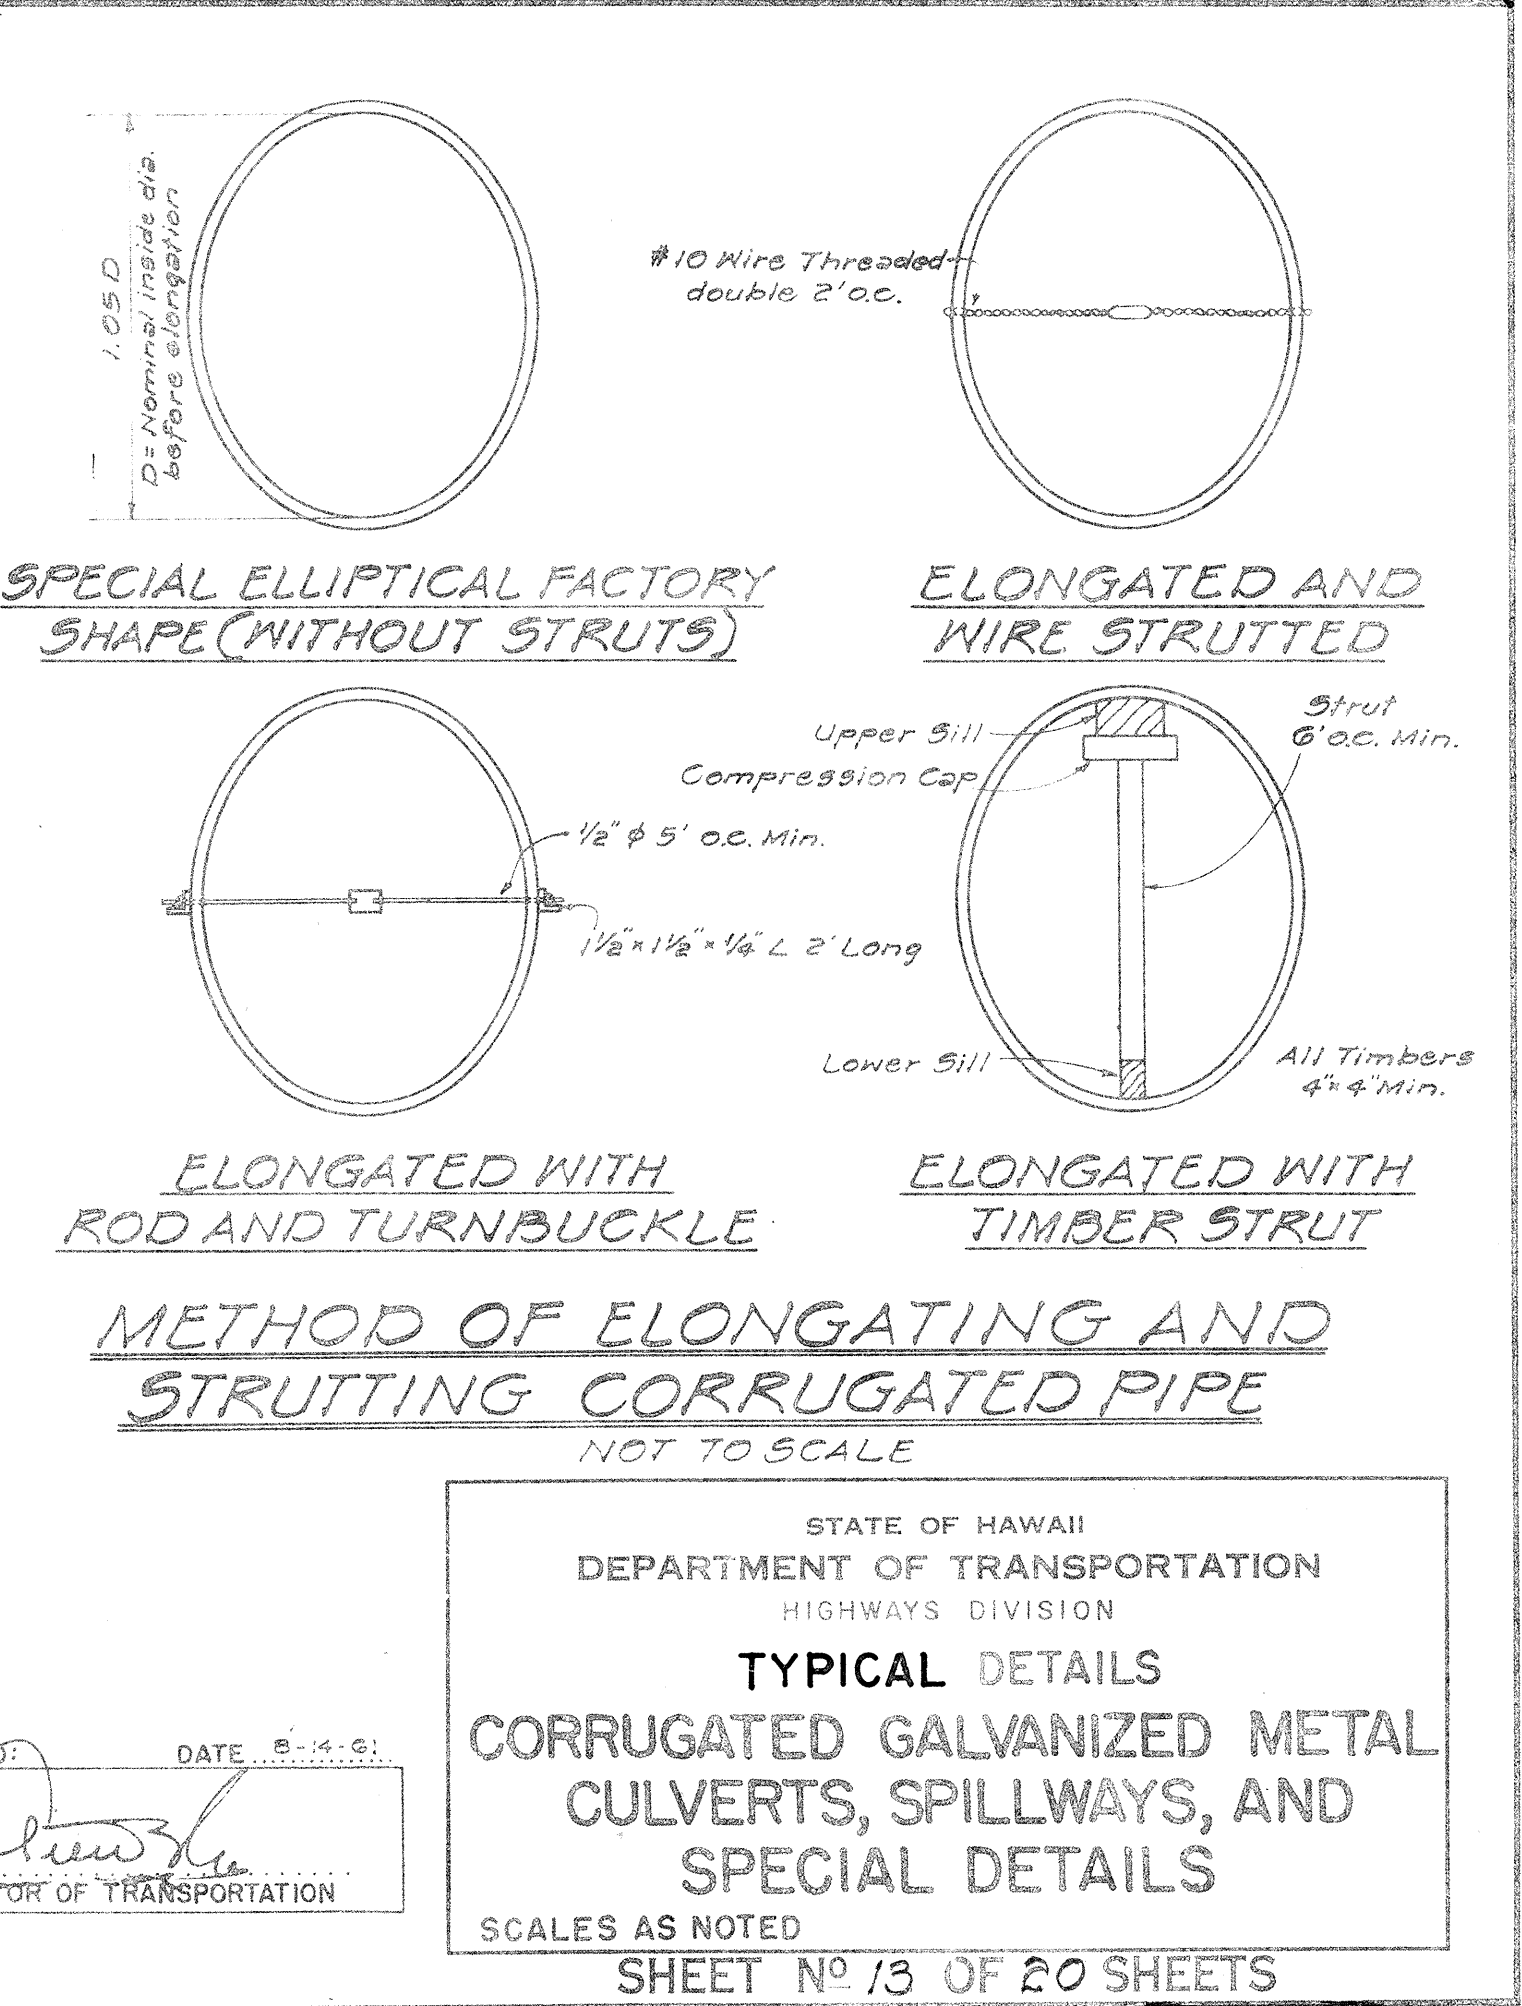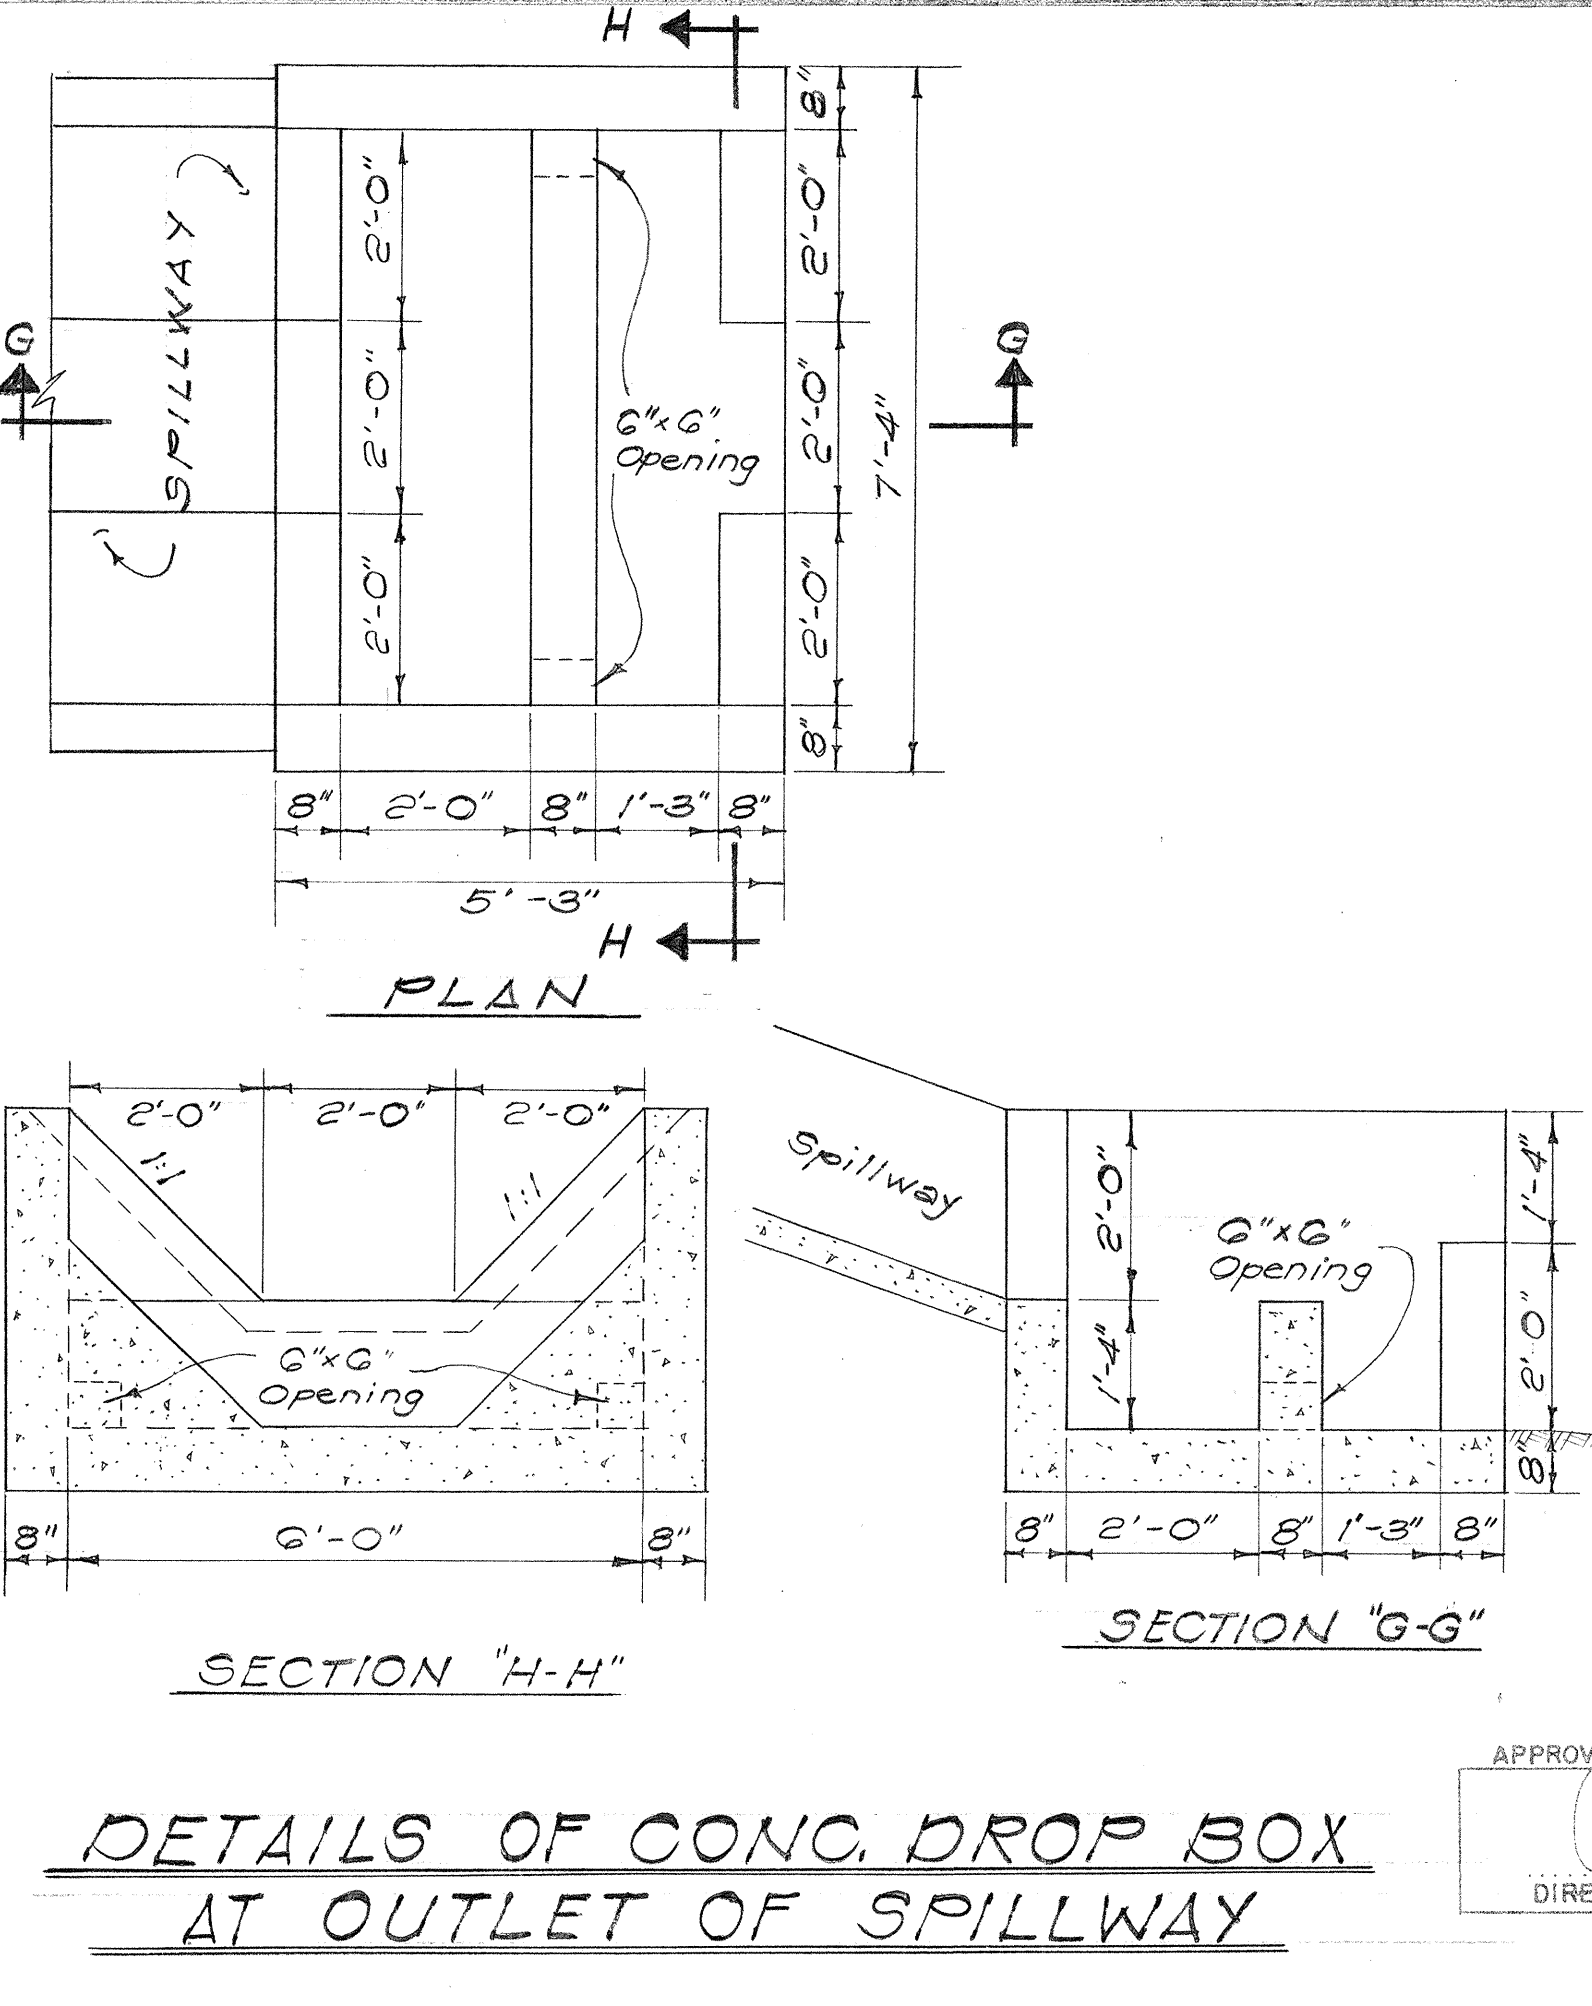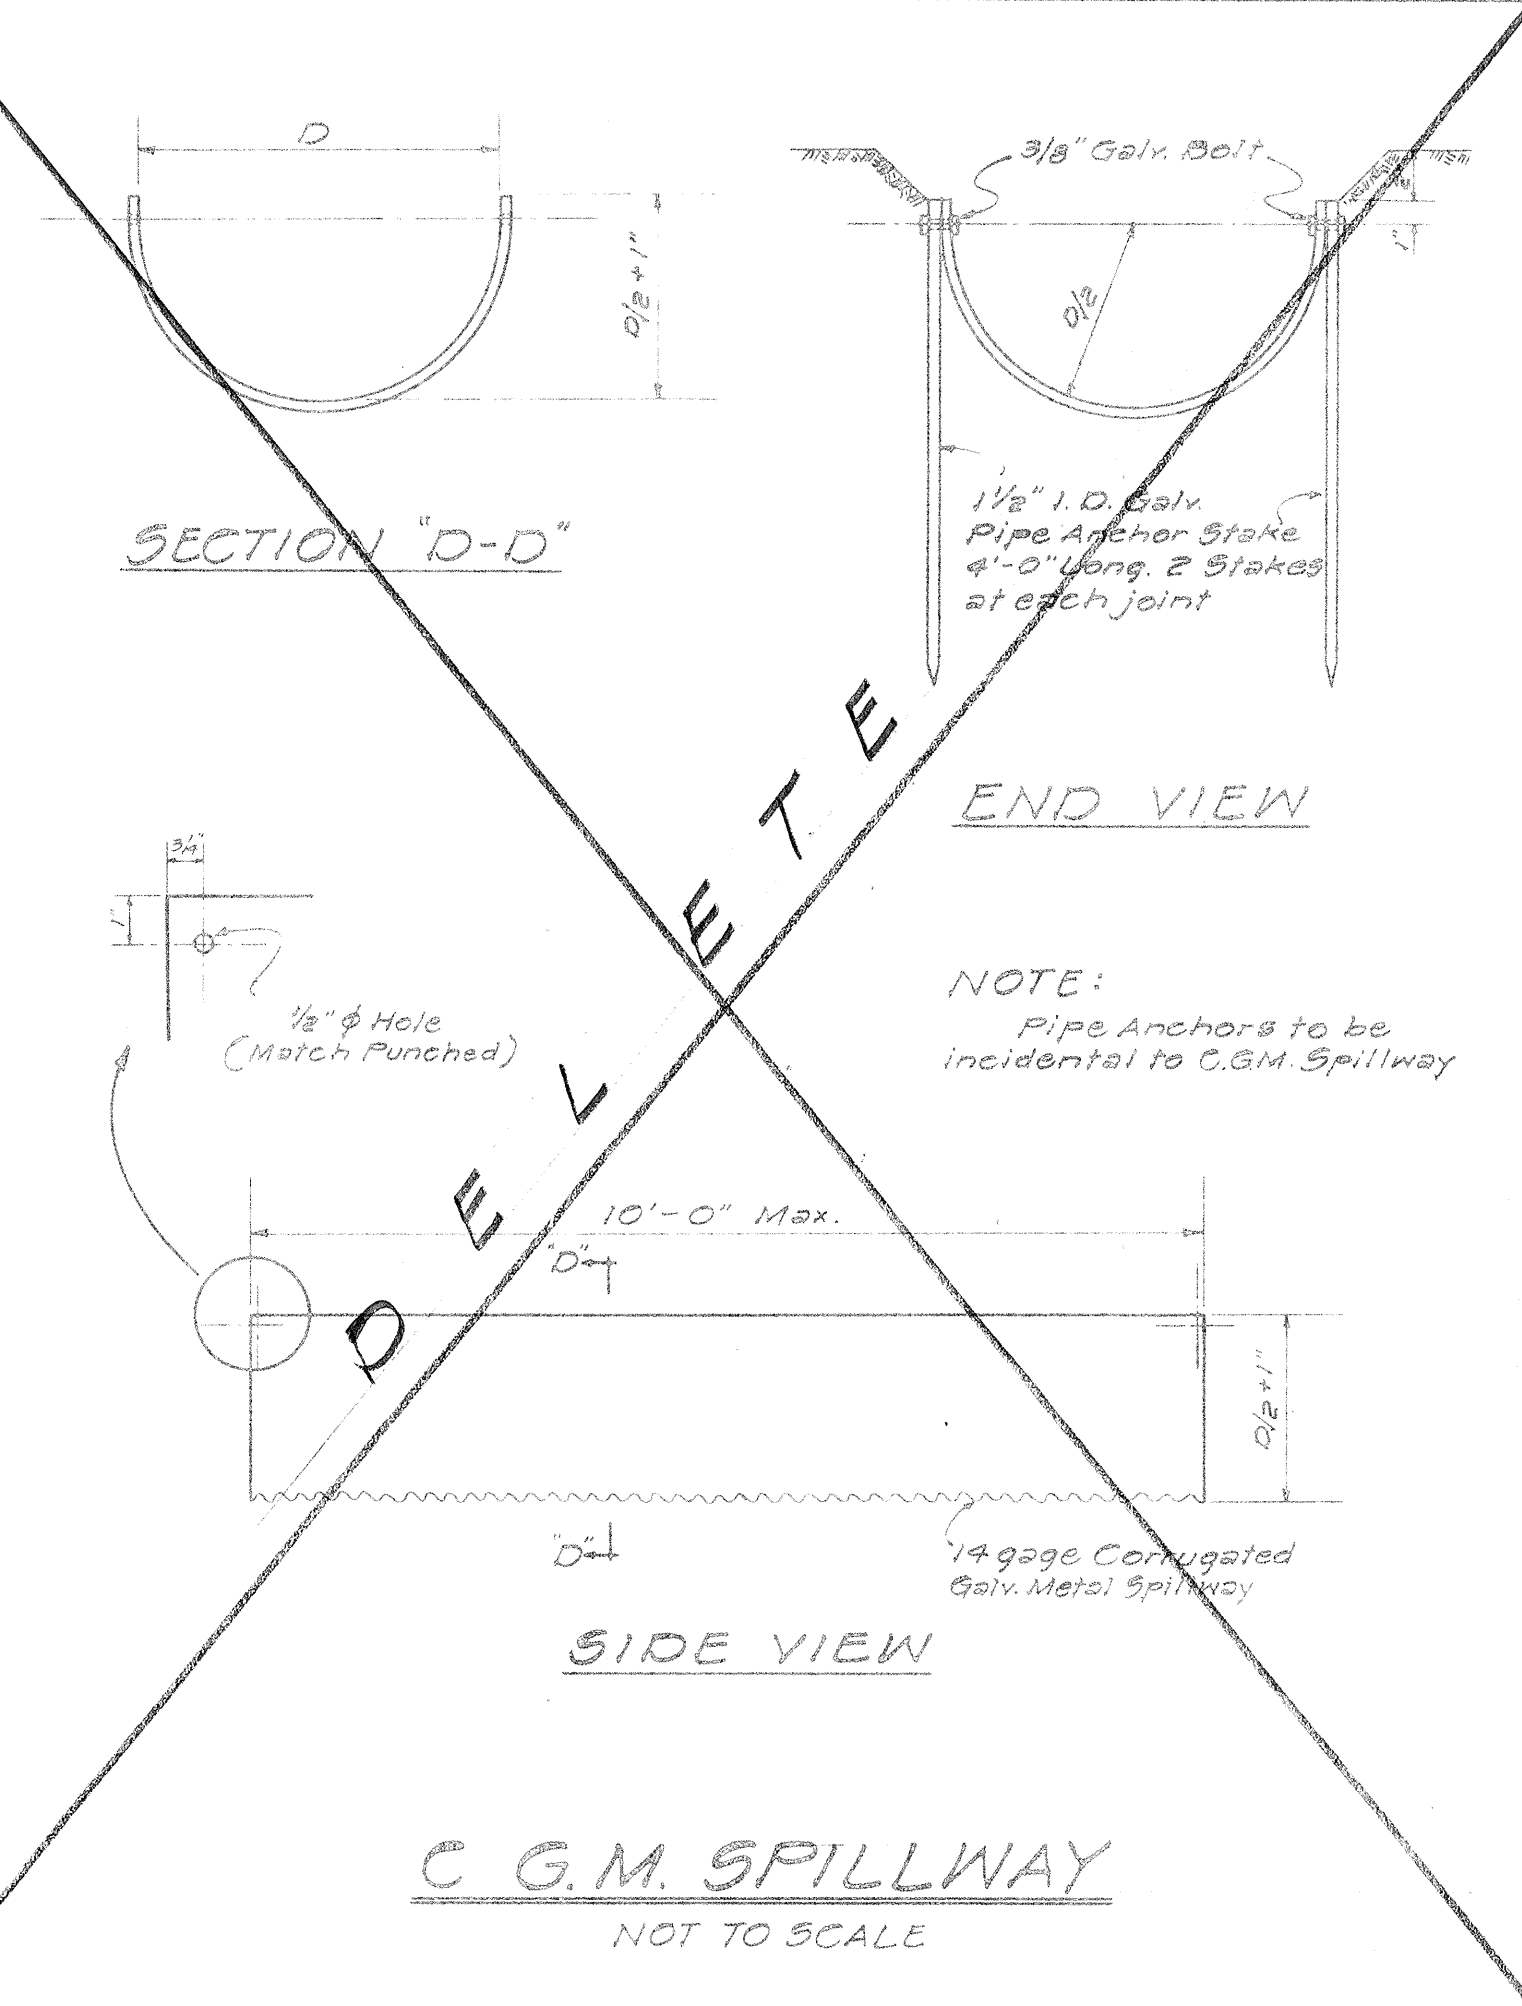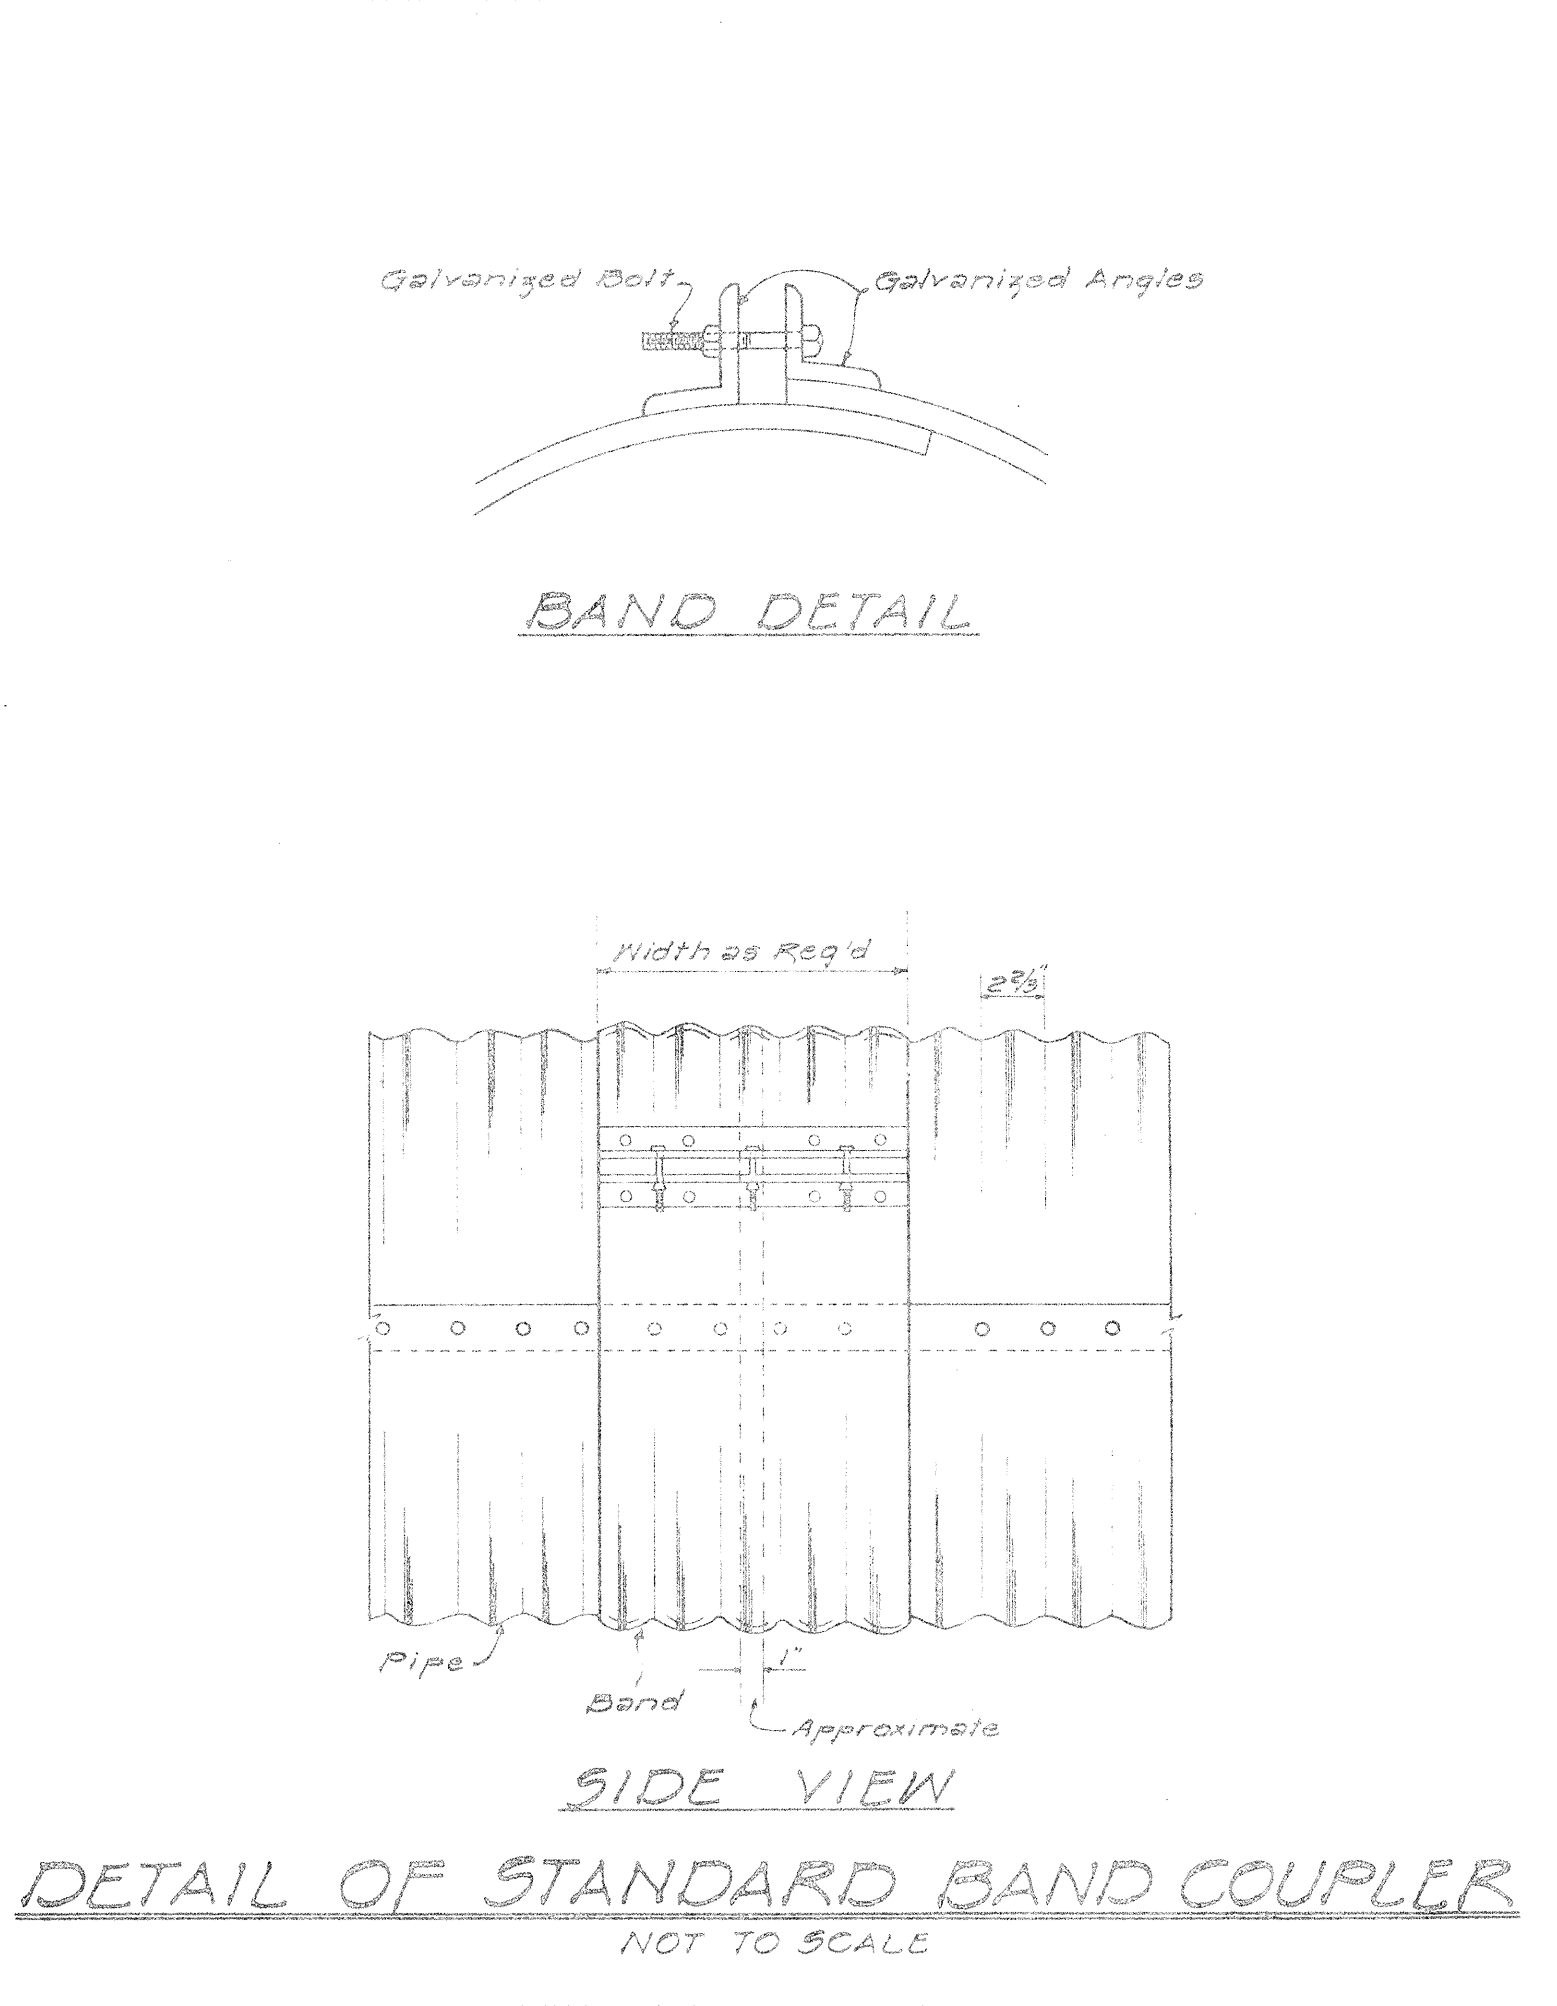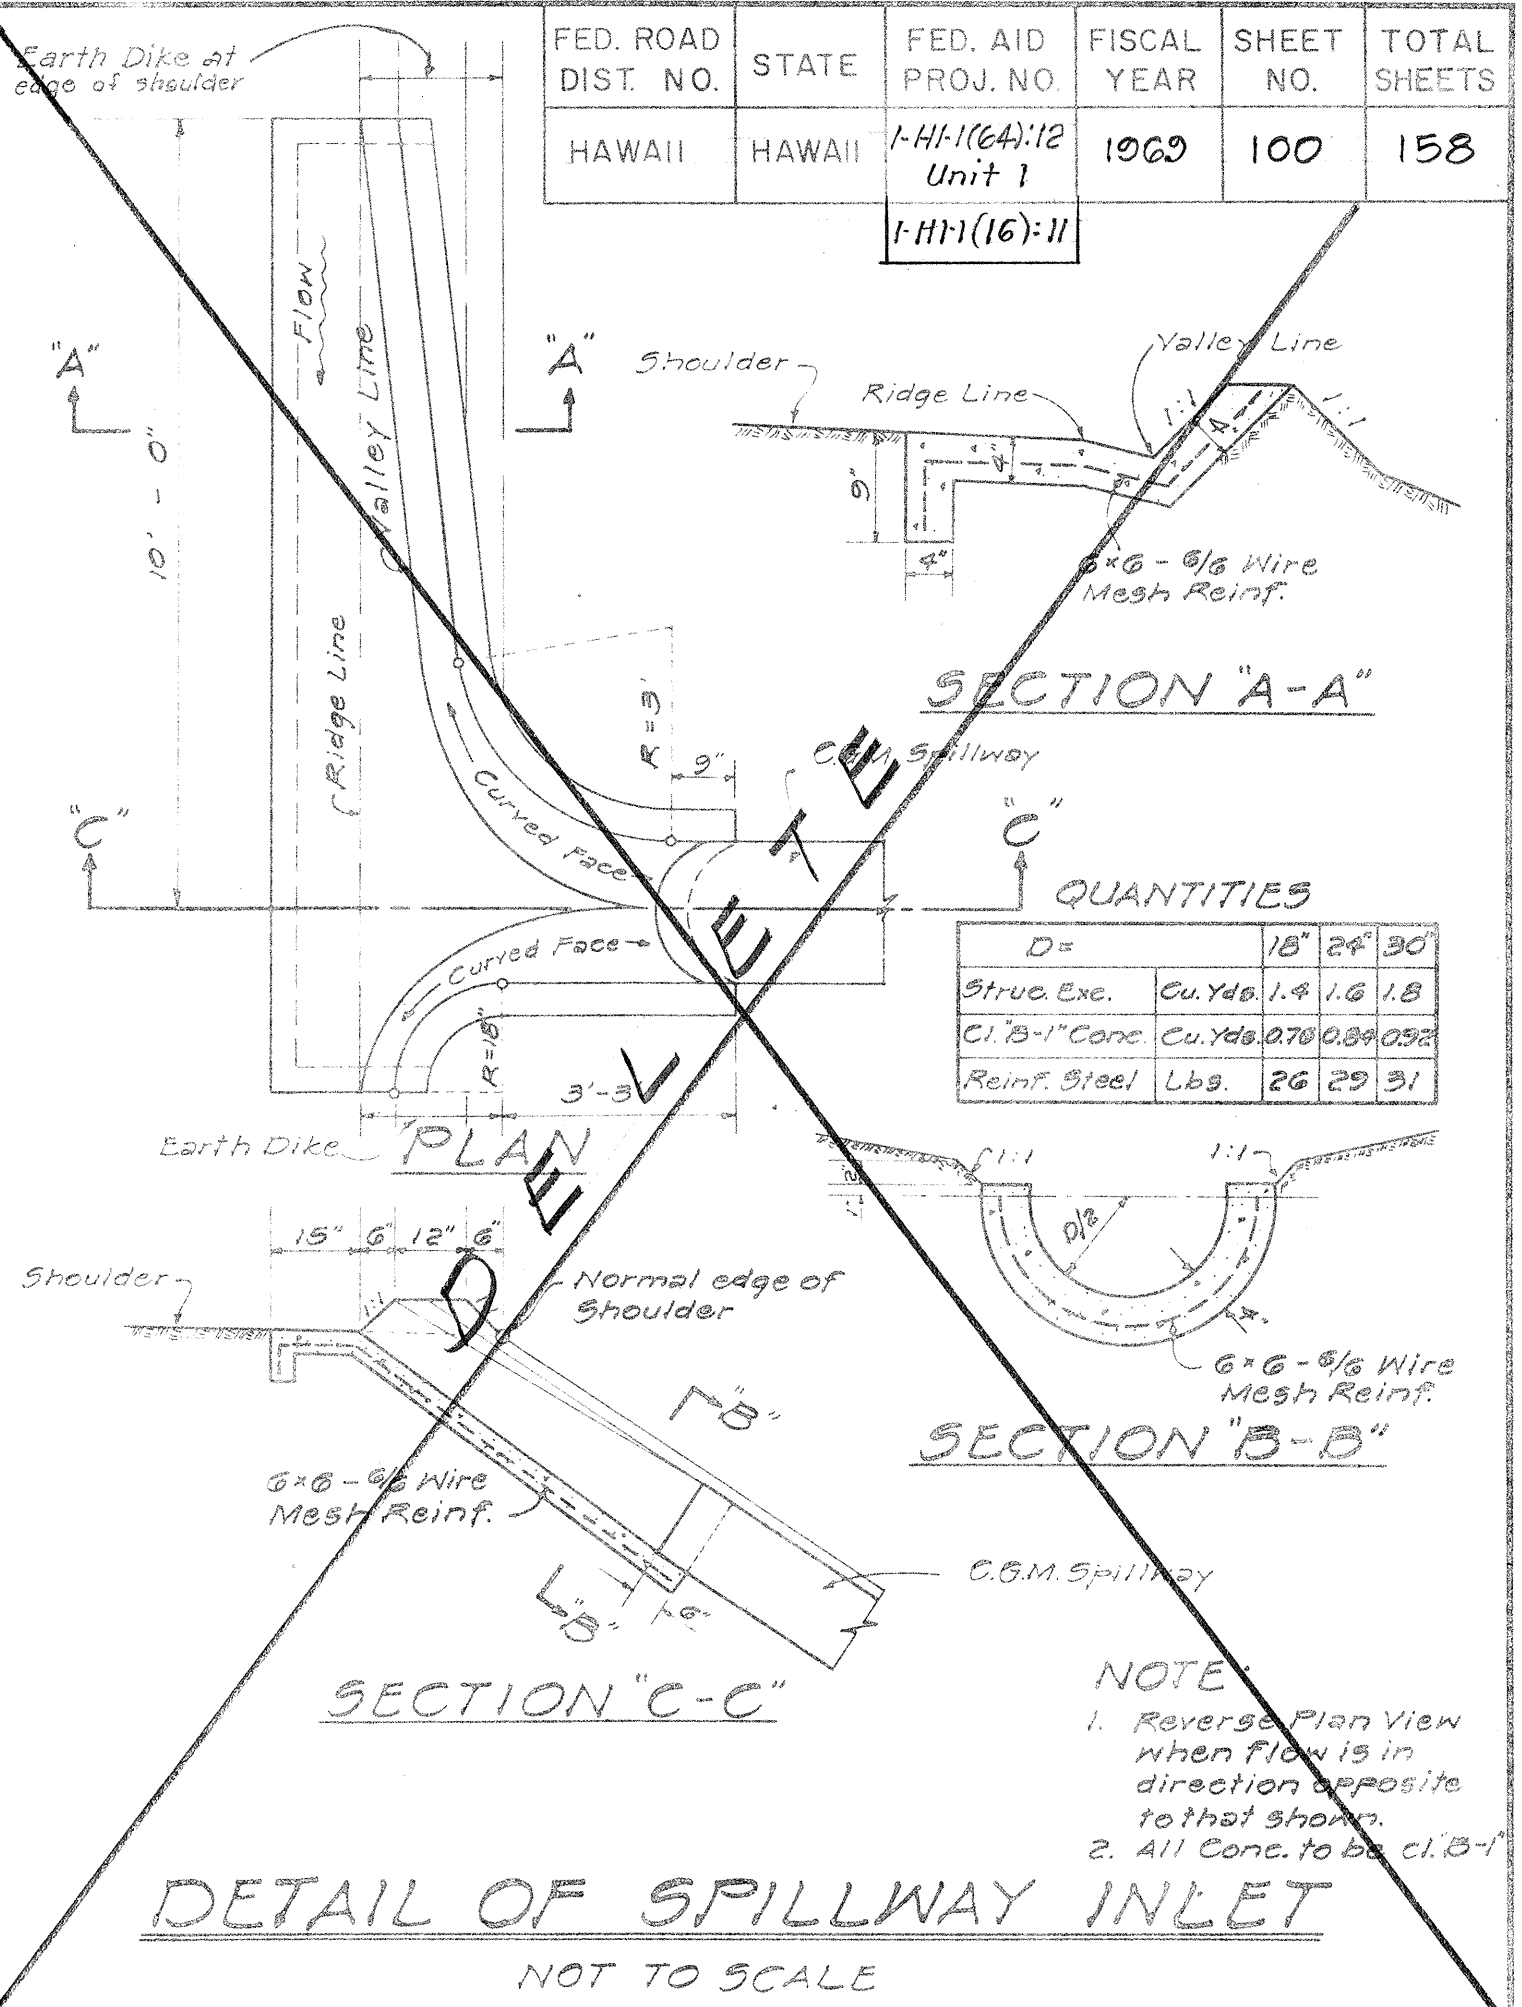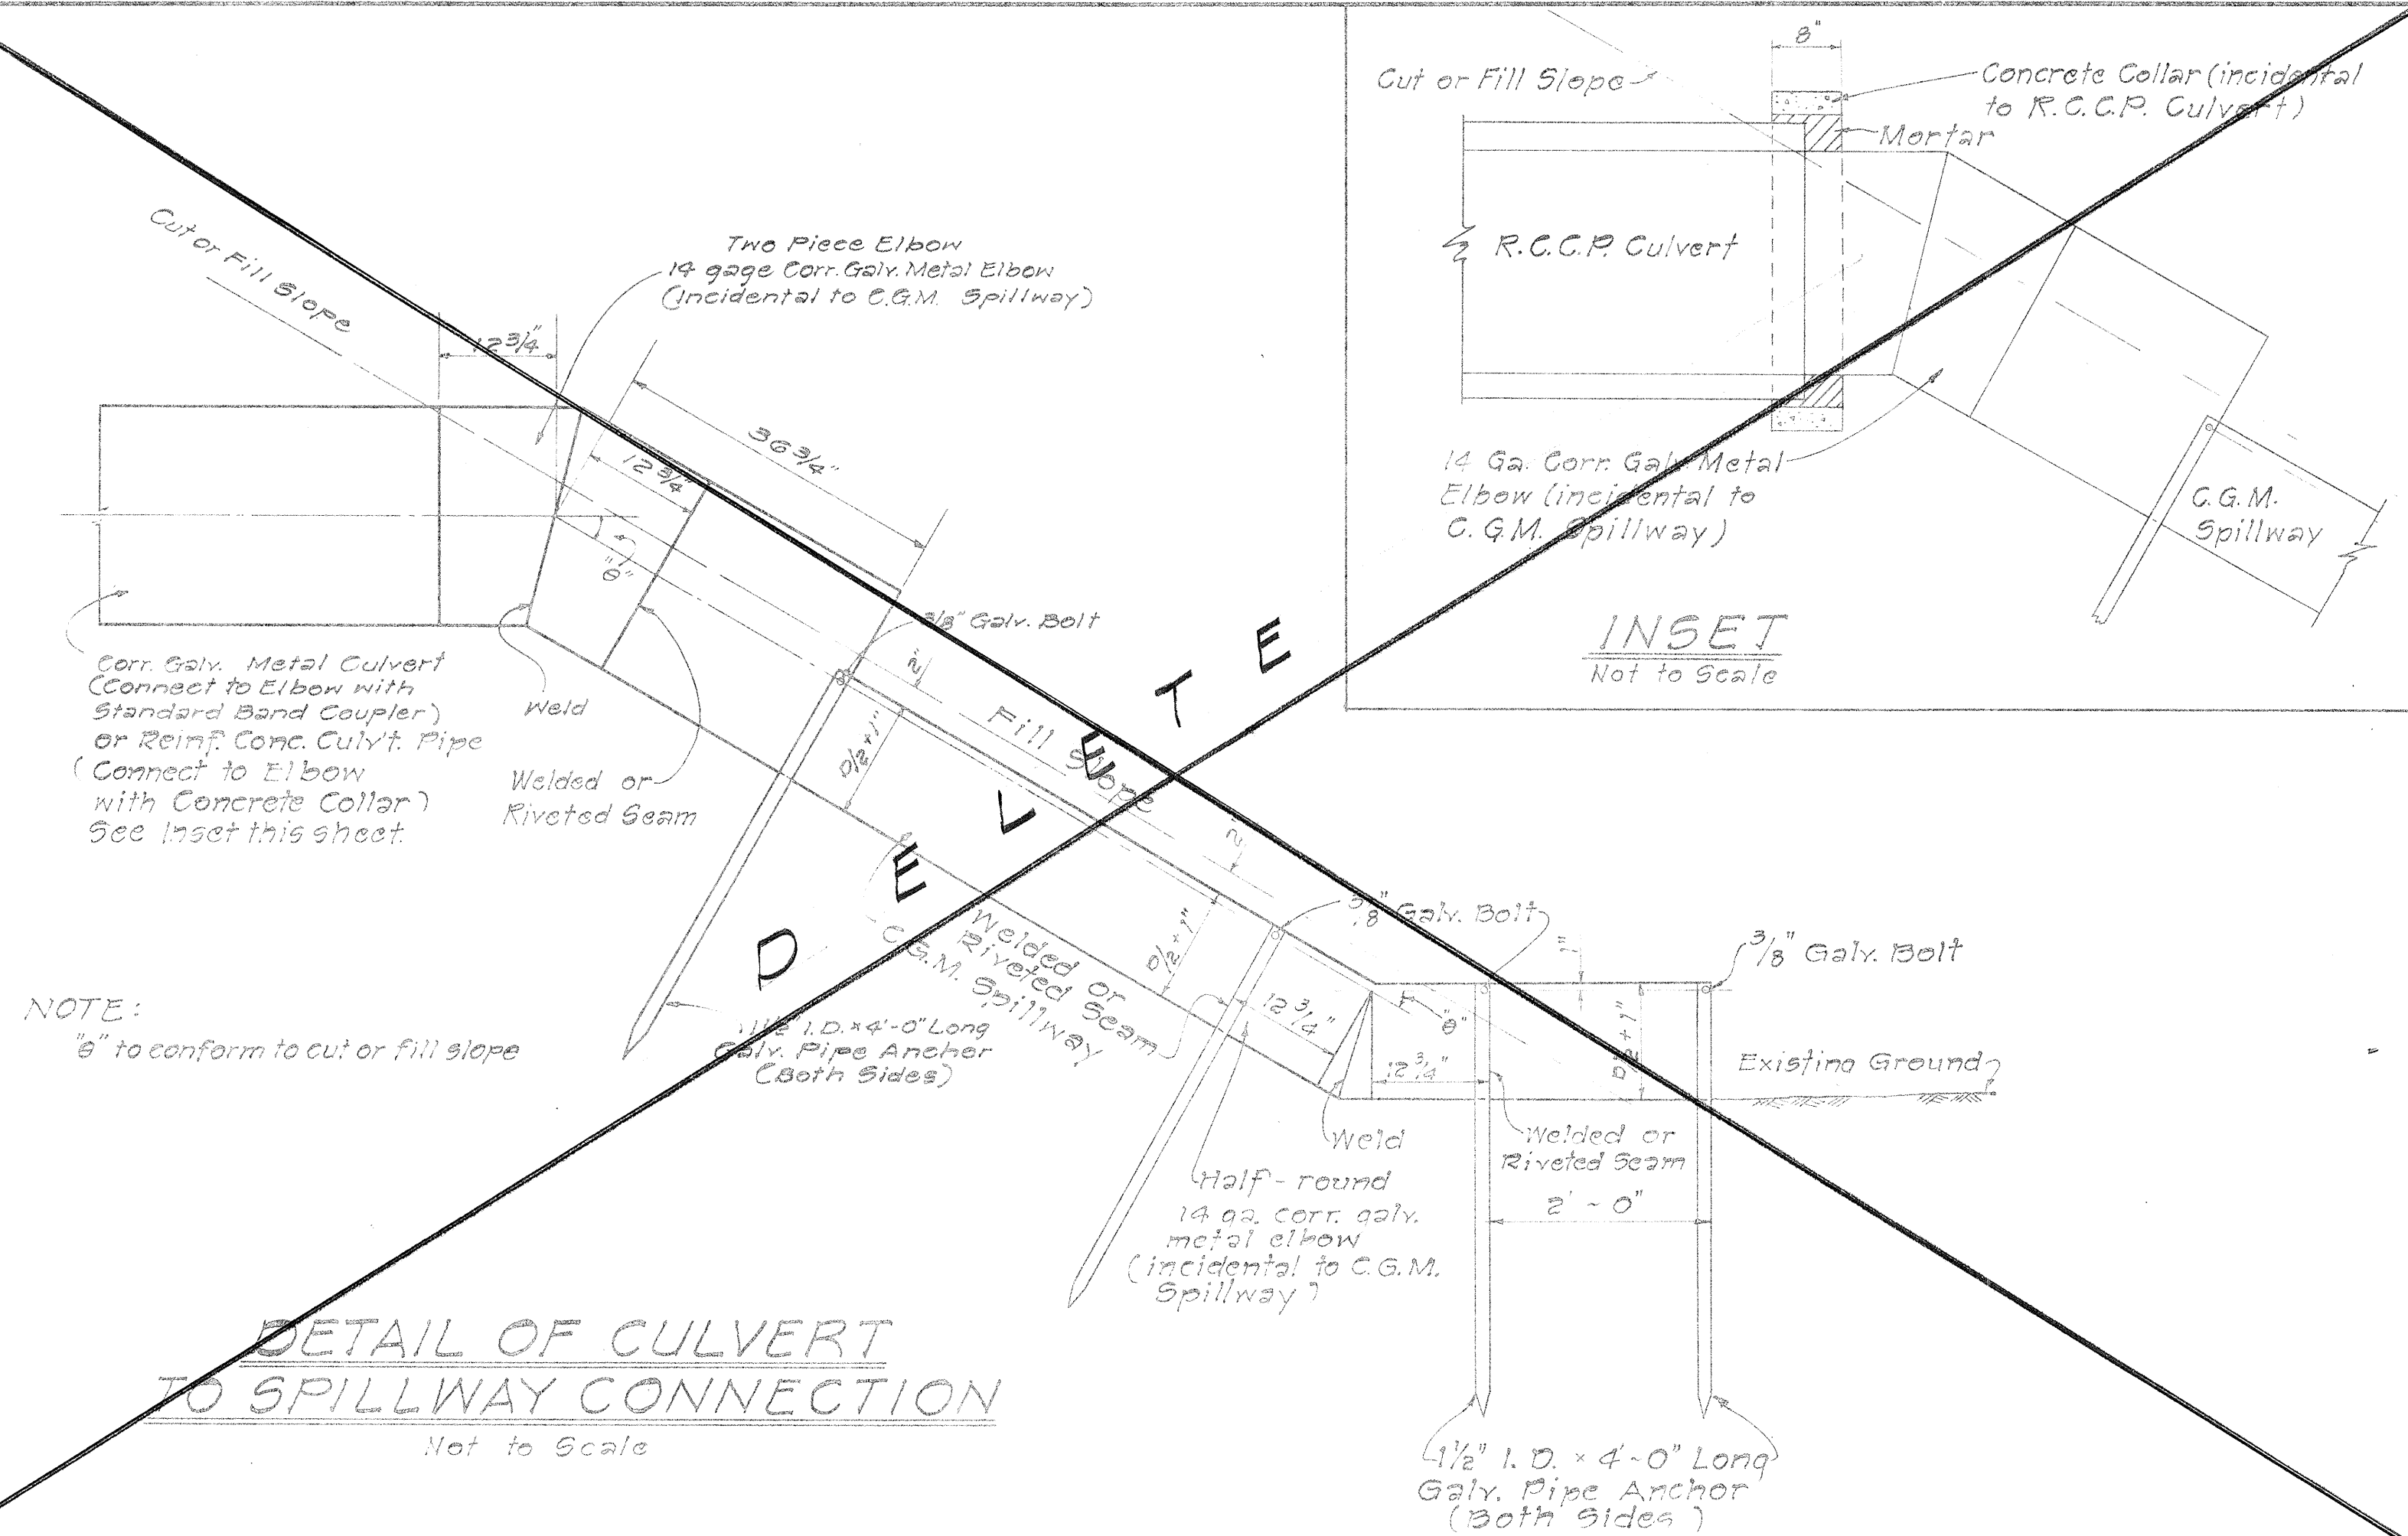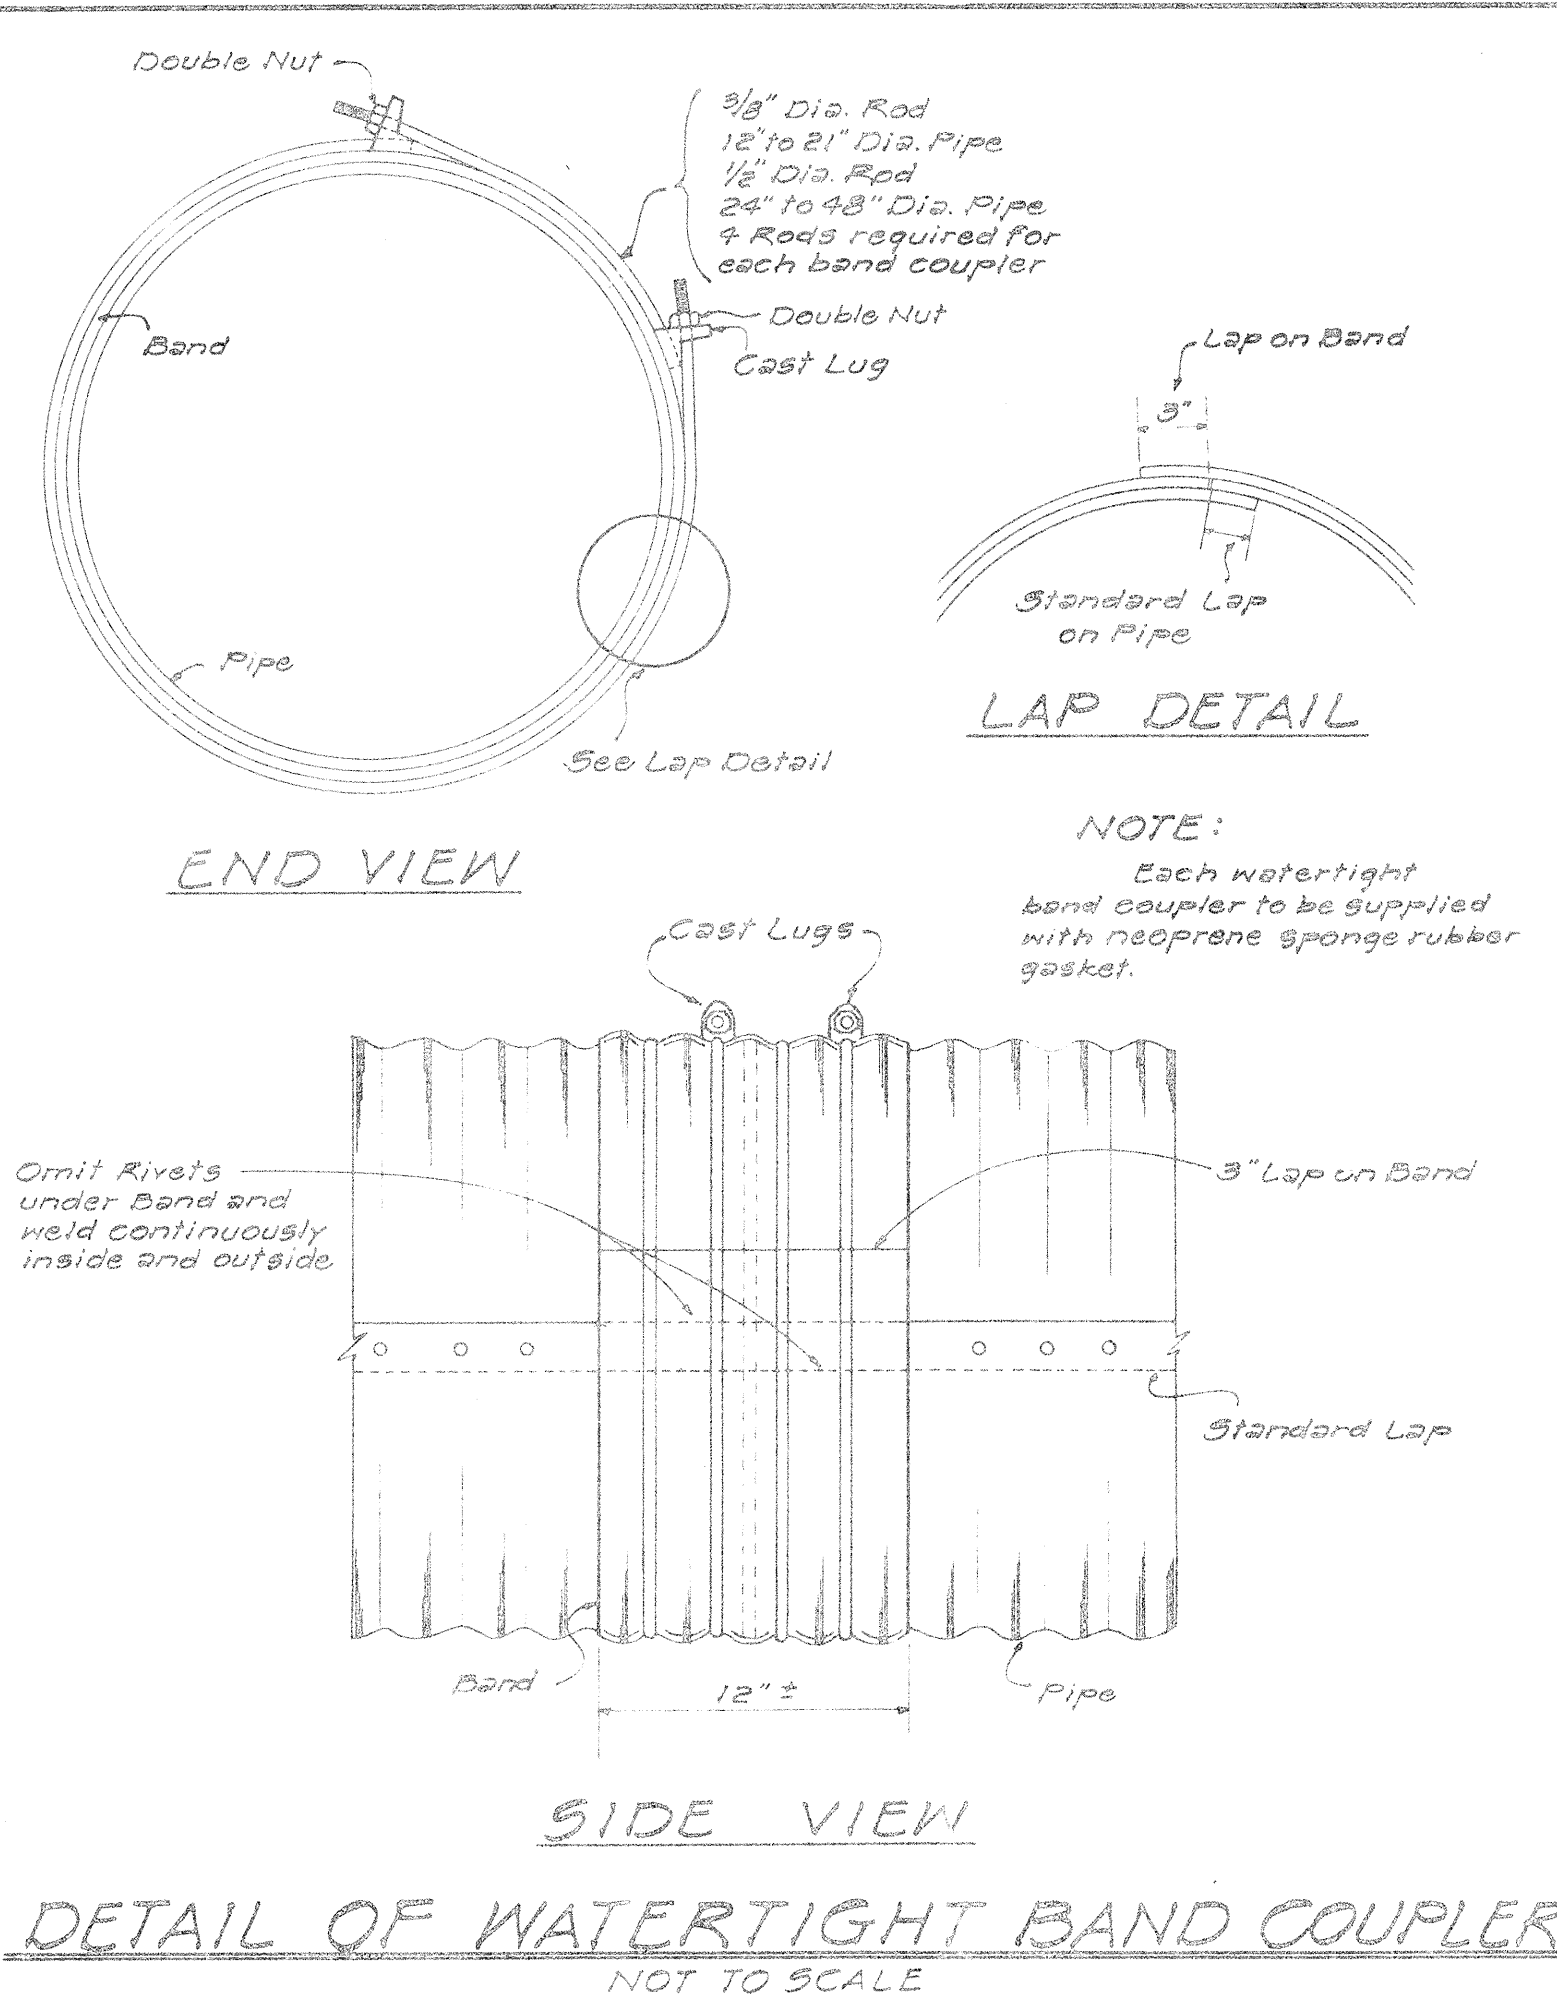


DESIGNED BY	DATE
DRAWN BY	5-23-66
CHECKED BY	5-24-66
APPROVED BY	
NO.	


FED. ROAD DIST. NO.	STATE	FED. AID PROJ. NO.	FISCAL YEAR	SHEET NO.	TOTAL SHEETS
HAWAII	HAW.	1-HI-1(64)112 Unit 1	1969	101	158
HI-1(16)111					

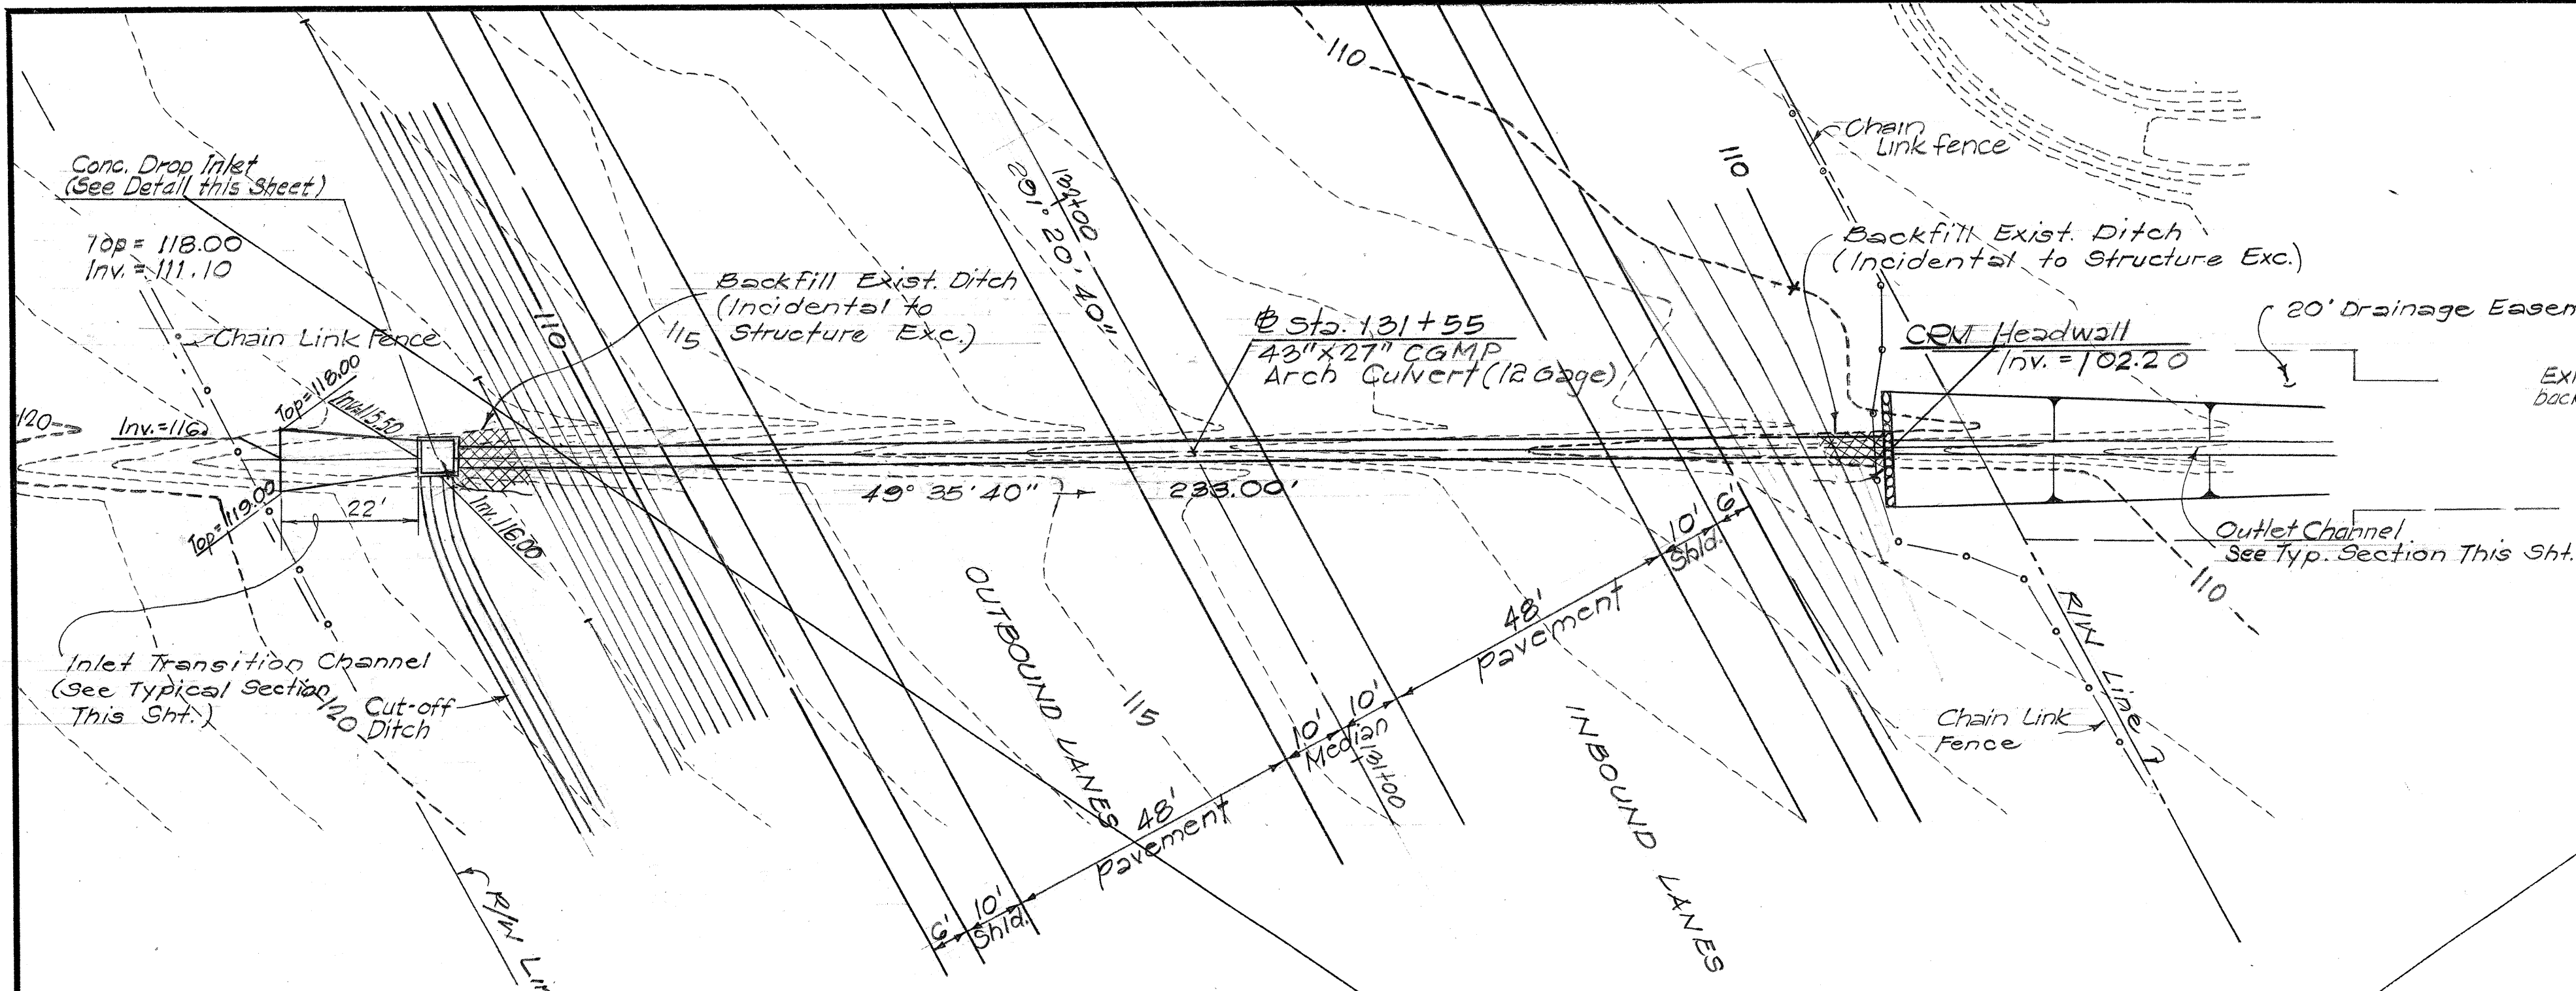


PLAN - 43"x27"CGMP ARCH CULVERT (12 GAGE) @ STA. 131+55
Scale: 1" = 20'

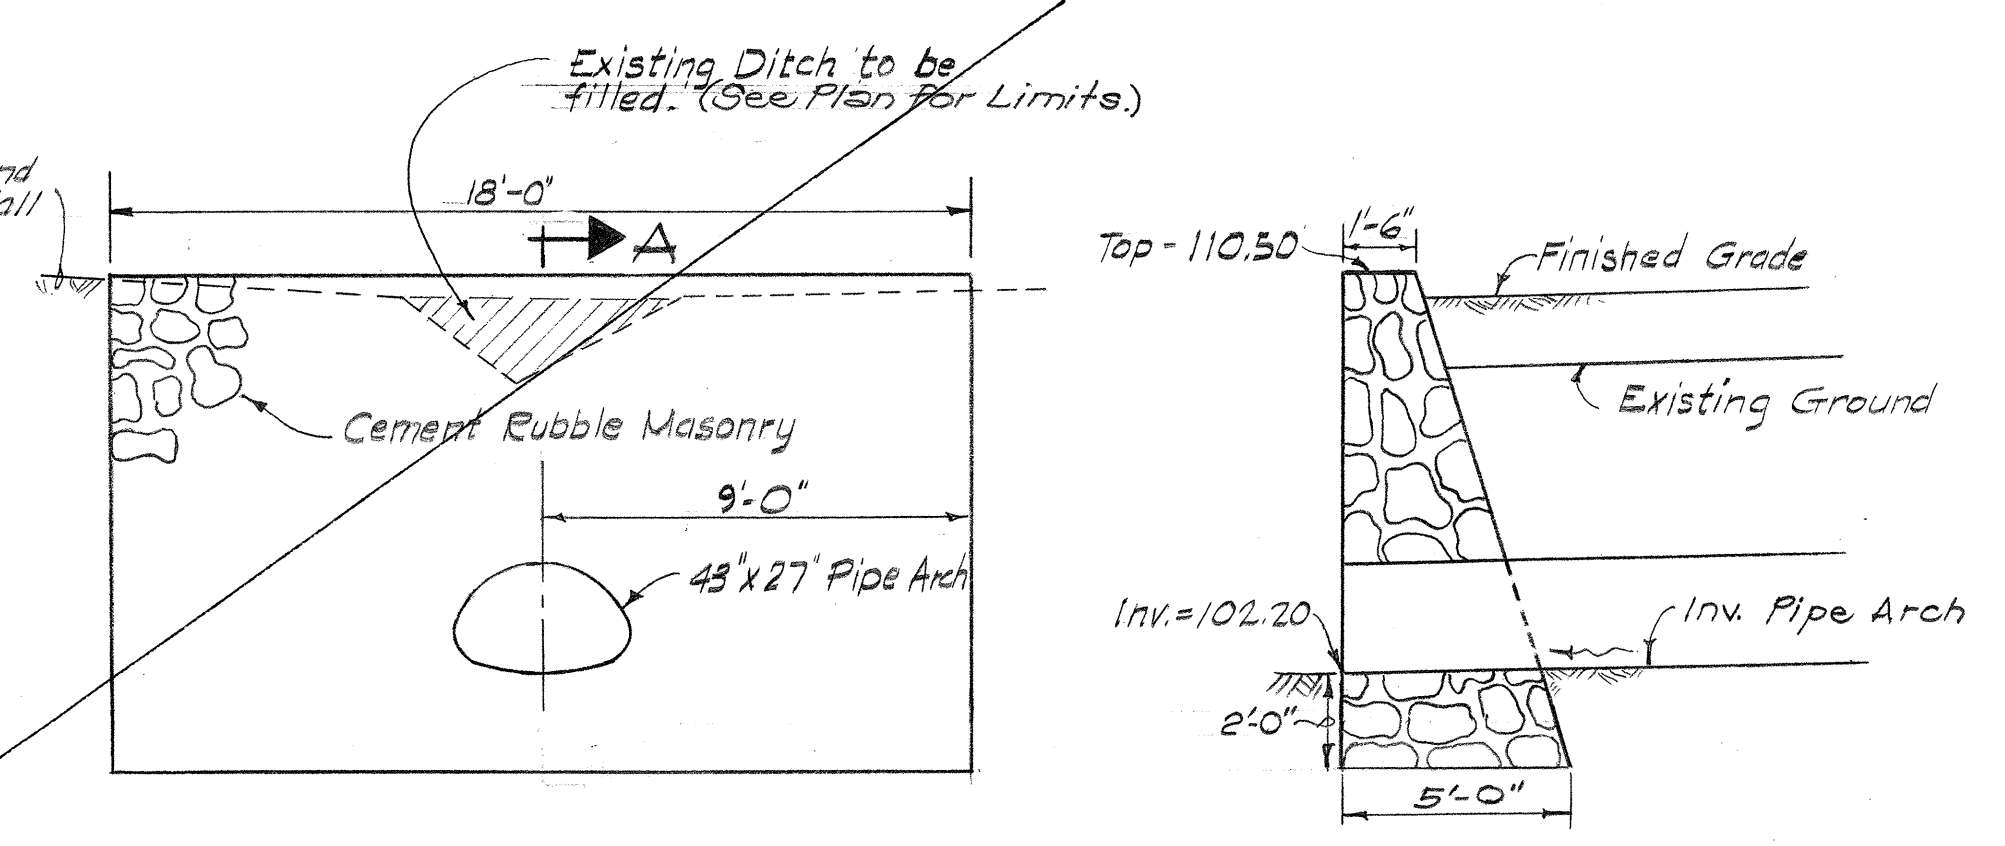


ELEVATION
Scale: 1/4" = 1'-0"
SECTION A-A
Scale: 1/4" = 1'-0"

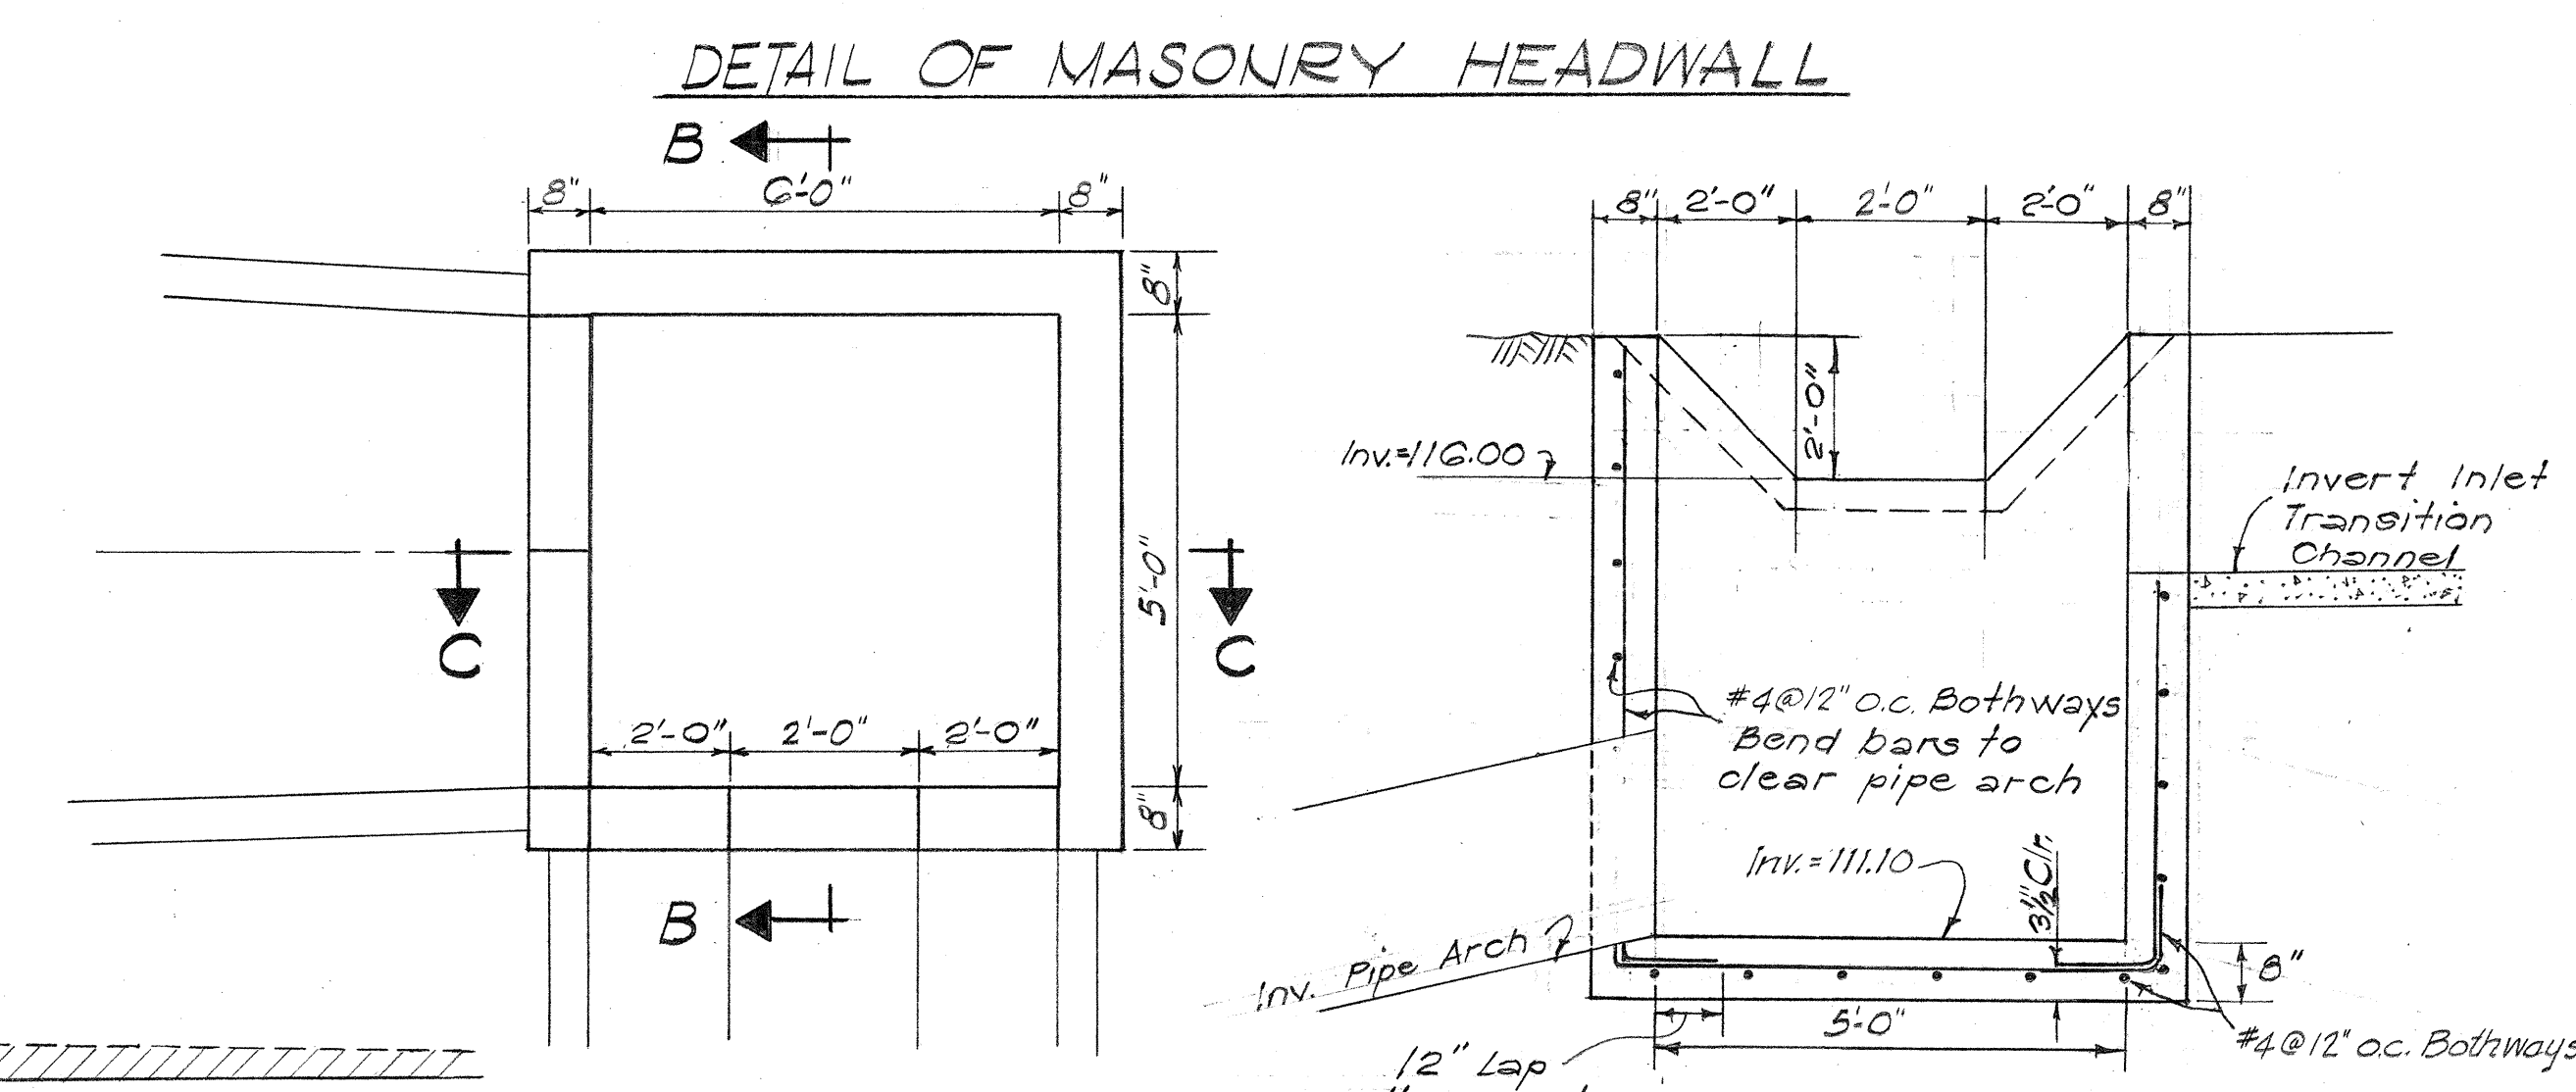


DETAIL OF MASONRY HEADWALL
PLAN CONC. DROP INLET
Not to Scale

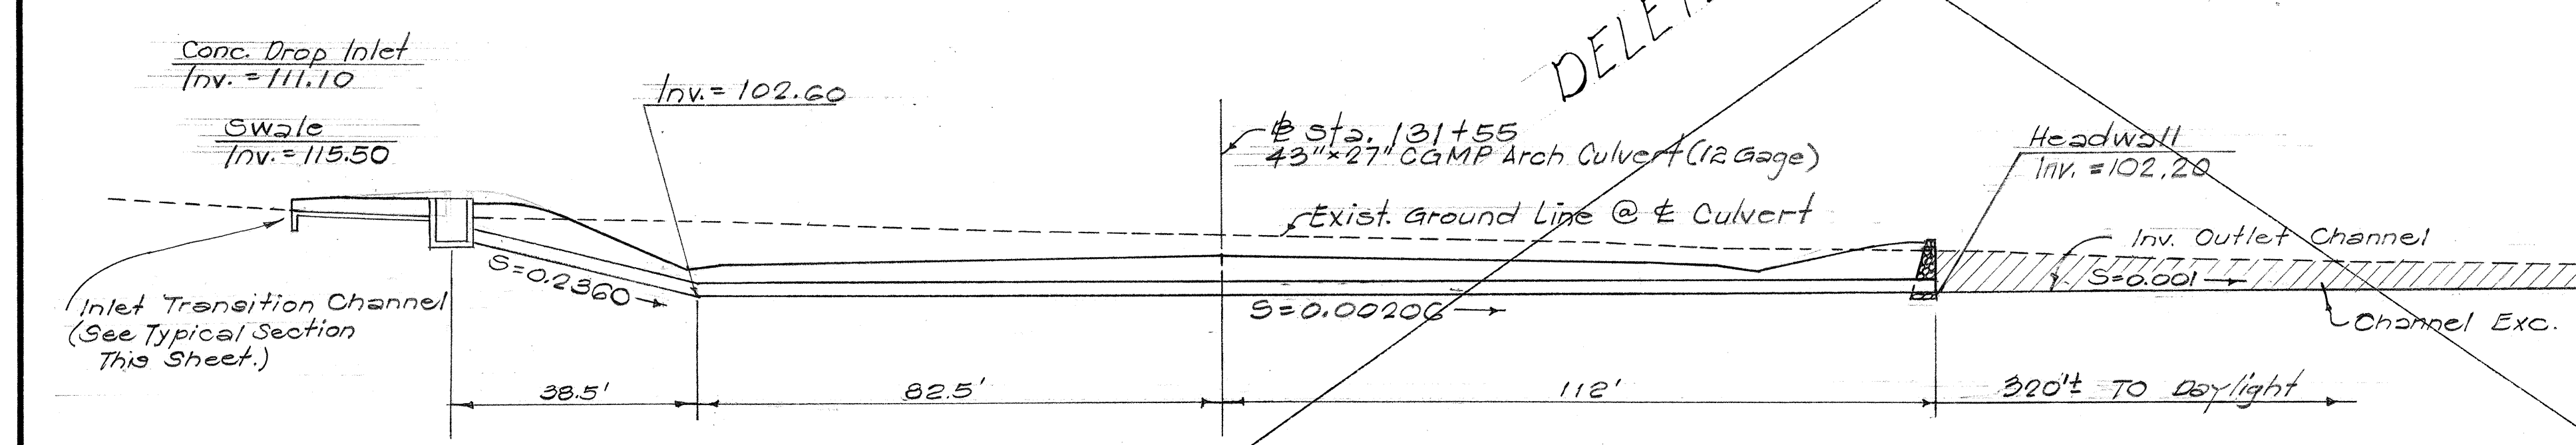

PROFILE - 43"x27"CGMP ARCH CULVERT (12 GAGE) @ STA. 131+55
Scale: 1" = 20'

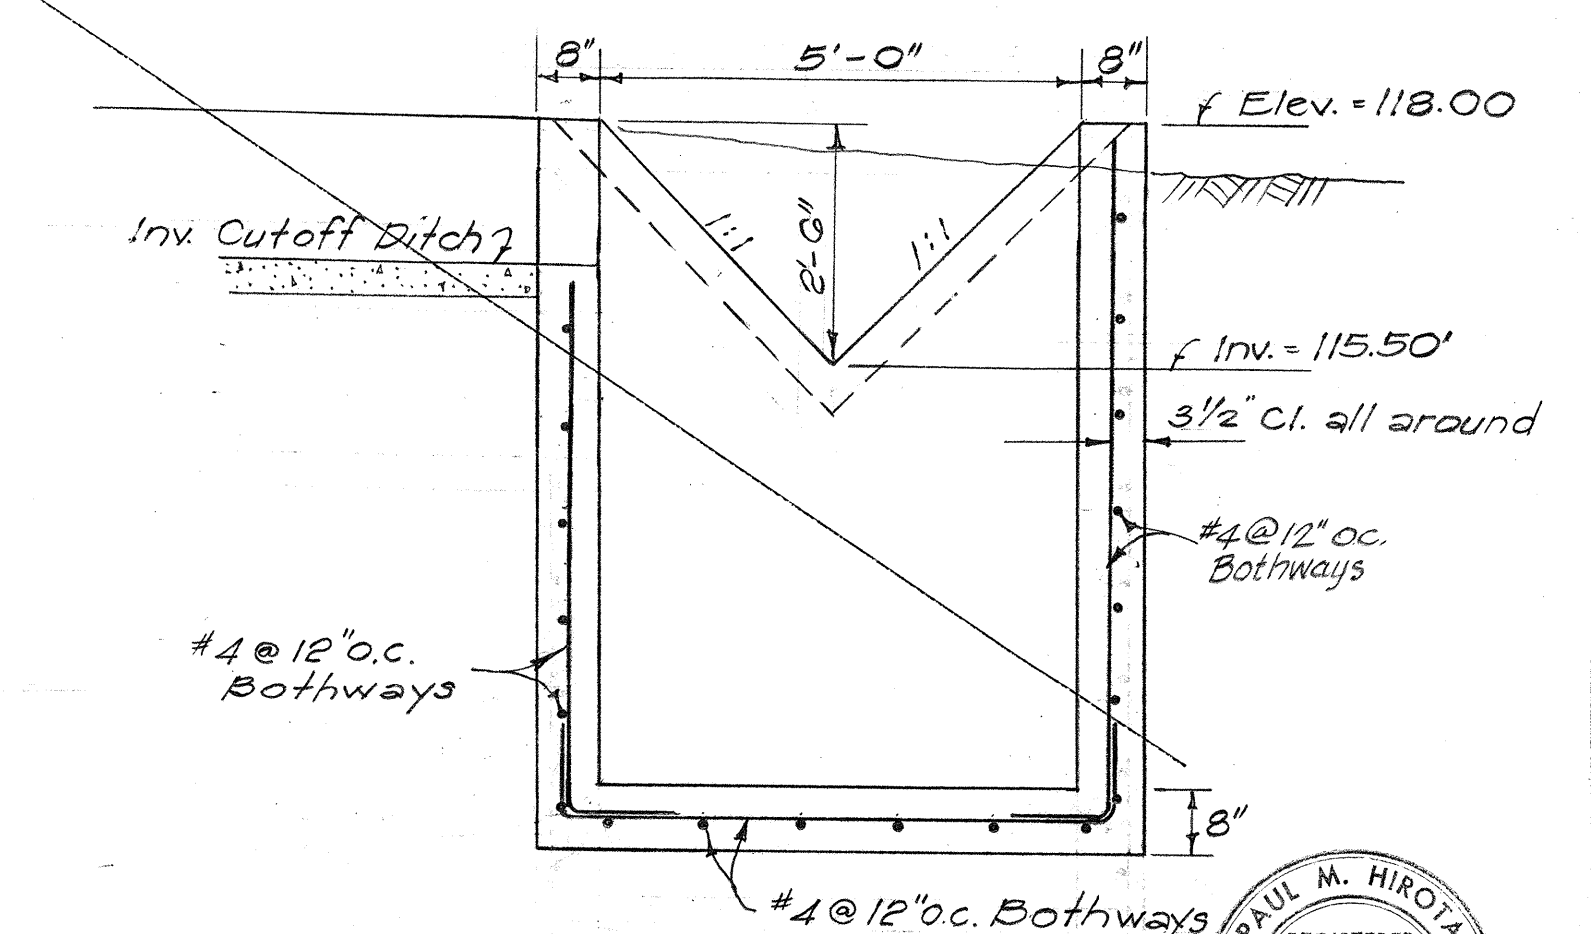

SECTION B-B
Scale: 1/2" = 1'-0"

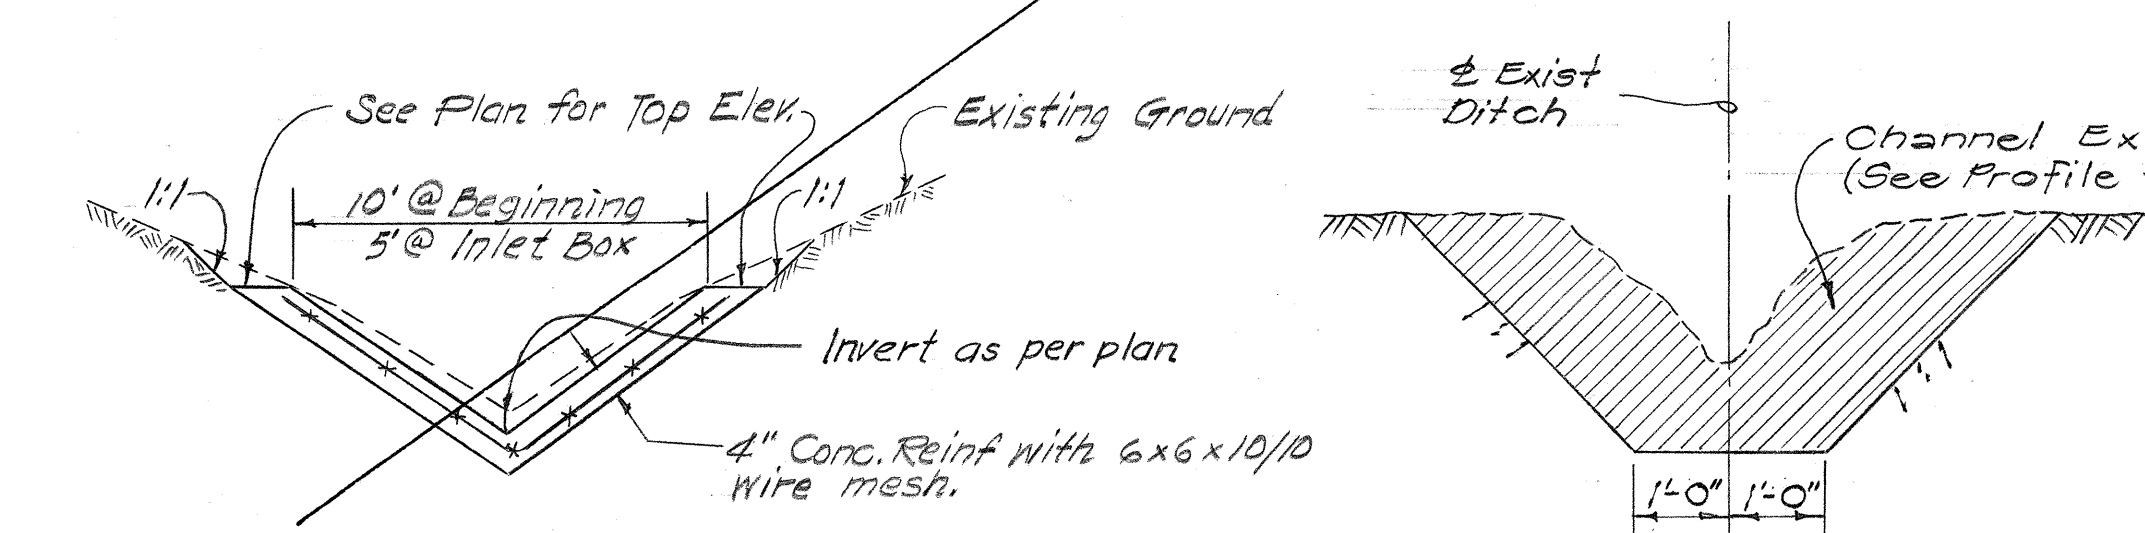


TYPICAL SECTION INLET TRANSITION CHANNEL
Scale: 1/2" = 1'-0"
TYPICAL SECTION OUTLET CHANNEL
Scale: 1/2" = 1'-0"

ESTIMATED QUANTITIES

ITEM	QUANTITY
1. Class A-1 Conc.	4 cy.
2. Reinf. Steel	300 lbs.
3. Class B-1 Conc. for Channel	3 cy.
4. Cement Rubble Masonry for Headwall	22 cy.
5. Structural Excavation	310 cy.
6. Channel Excavation	182 cy.
7. 43" x 27" Pipe Arch (No Alternate)	230 lf.

STATE OF HAWAII
DEPARTMENT OF TRANSPORTATION
HIGHWAYS DIVISION

43"x27" CORRUGATED GALVANIZED
METAL PIPE ARCH CULVERT
@ STA. 131+55
INTERSTATE ROUTE H-1
PROJ. NO. I-HI-1(64)112
UNIT 1
Scale: As Shown Date: 8/19/68
SHEET NO. 14 OF 20 SHEETS

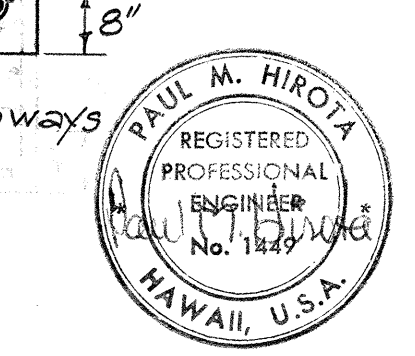


THIS WORK WAS PREPARED BY
ME OR UNDER MY SUPERVISION.

DATE	_____
DESIGNED BY	_____
CHECKED BY	_____
NOTED BY	_____
ORIGINAL PLAN	_____
NOTE BOOK	_____
NO.	_____

FED. ROAD DIST. NO.	STATE	FED. AID PROJ. NO.	FISCAL YEAR	SHEET NO.	TOTAL SHEETS
HAWAII	HAW.	I-HI-1(64)12 Unit 1	1969	102	158
I-HI-1(16)-11					

Culvert Curve Data

$\Delta = 20^{\circ}00'00''$
 $\frac{1}{4} \Delta = 2^{\circ}30'00''$
 $R = 114.63'$
 $T = 5.00'$
 $C = 10.00'$

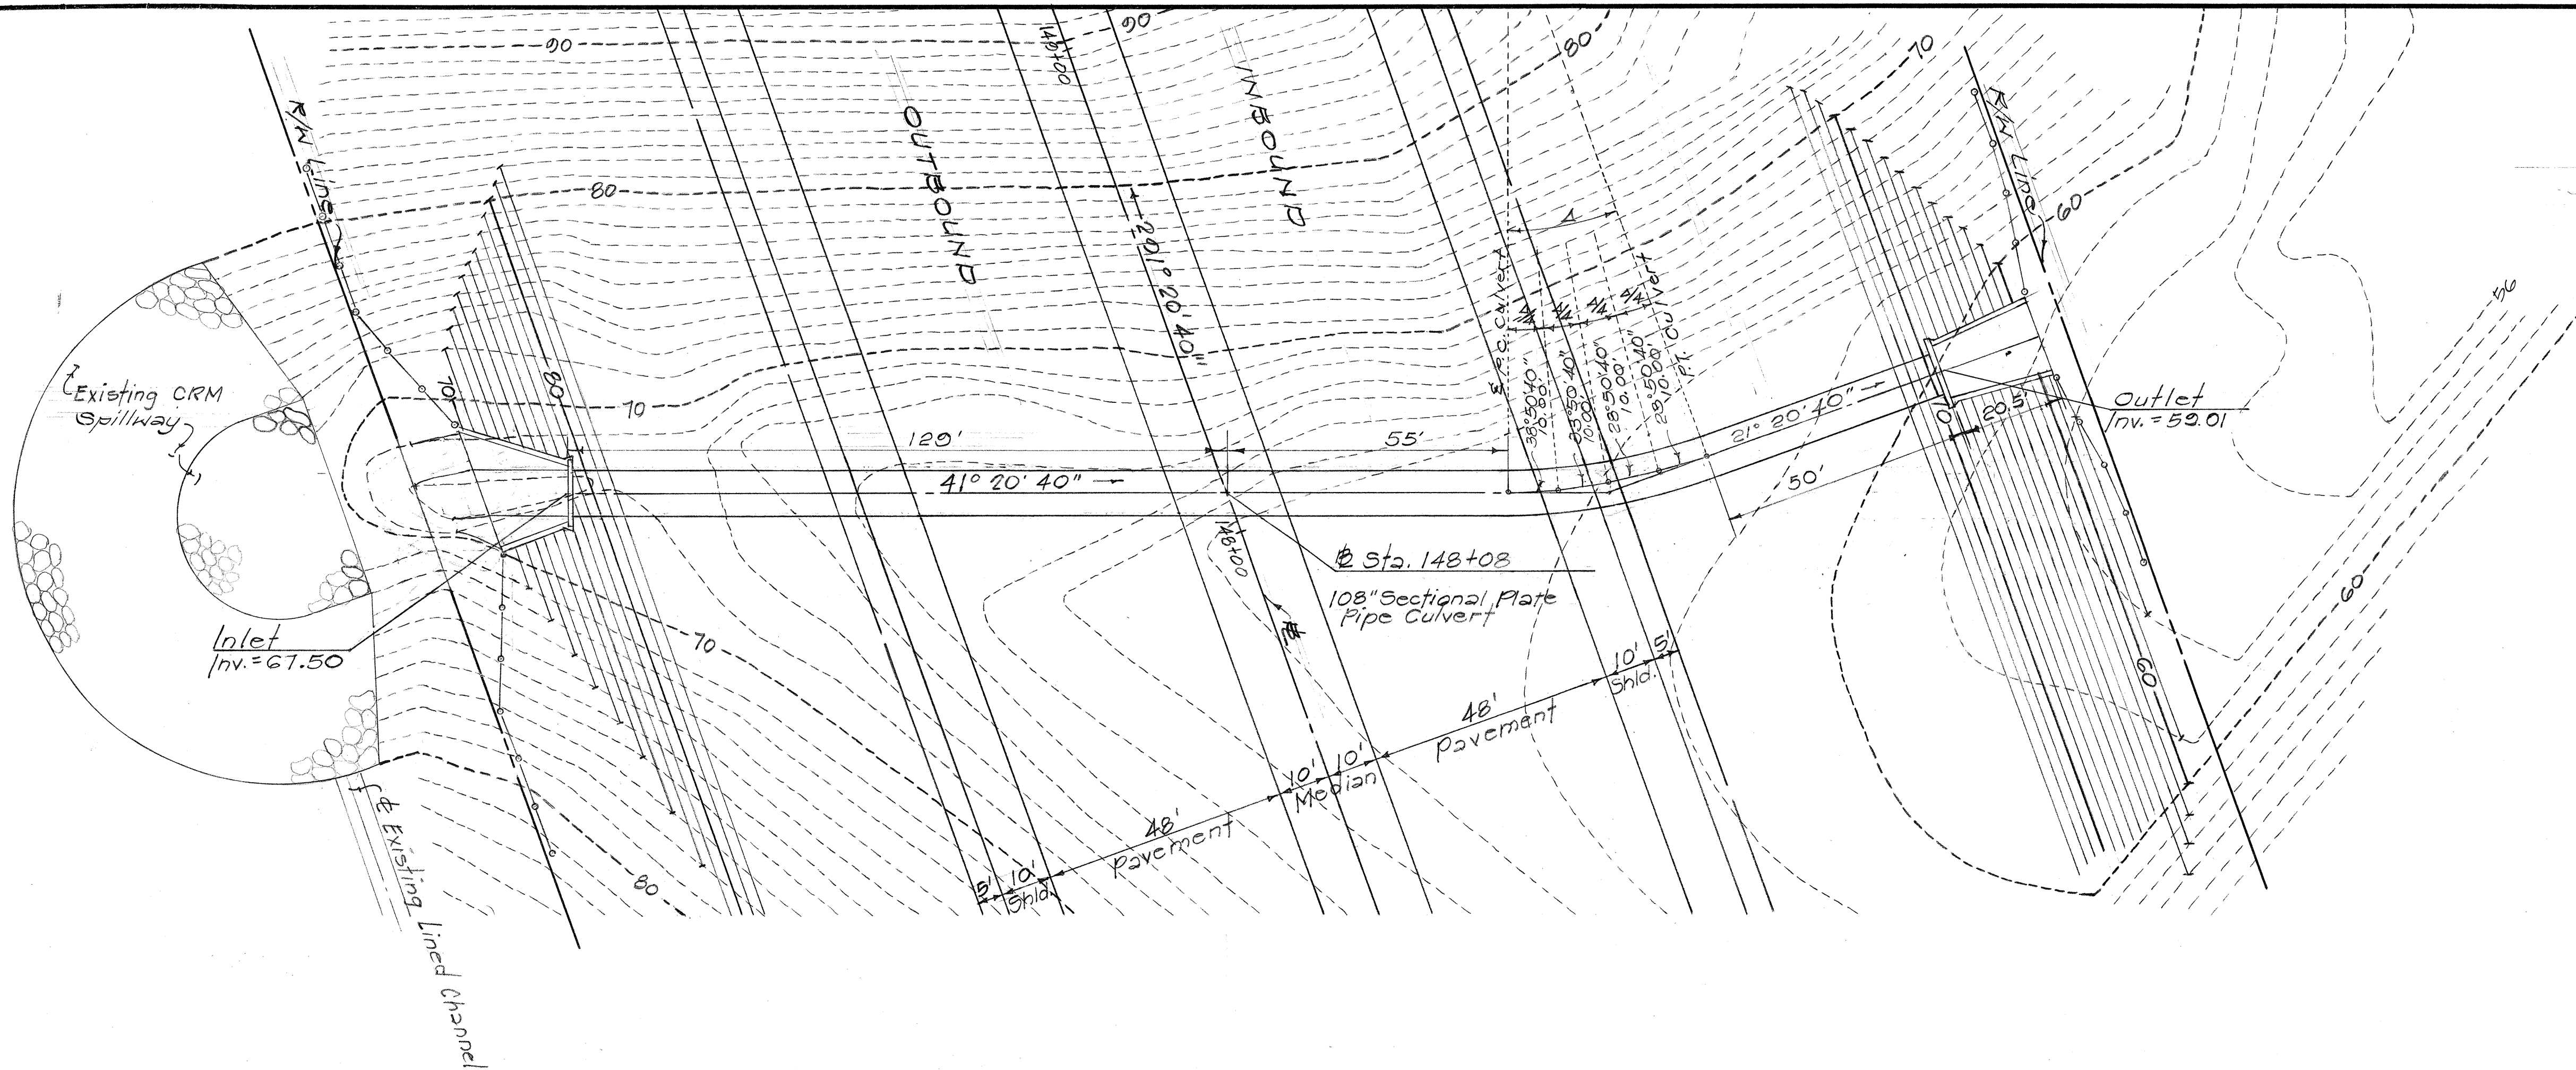


PLAN - 1-108" SECTIONAL PLATE PIPE CULVERT @ STA. 148+08

Scale: 1" = 20'


ESTIMATED QUANTITIES

ITEM	108' SECT. PLATE
1. Class A-1 Concrete	47 C.Y.
2. Reinforced Steel	6500 lbs.
3. Structural Excavation	315 C.Y.
4. Untreated Base for Pipe Foundation	171 C.Y.
5. 108' Sectional Plate Culvert (5% Elongated)	274 L.F.

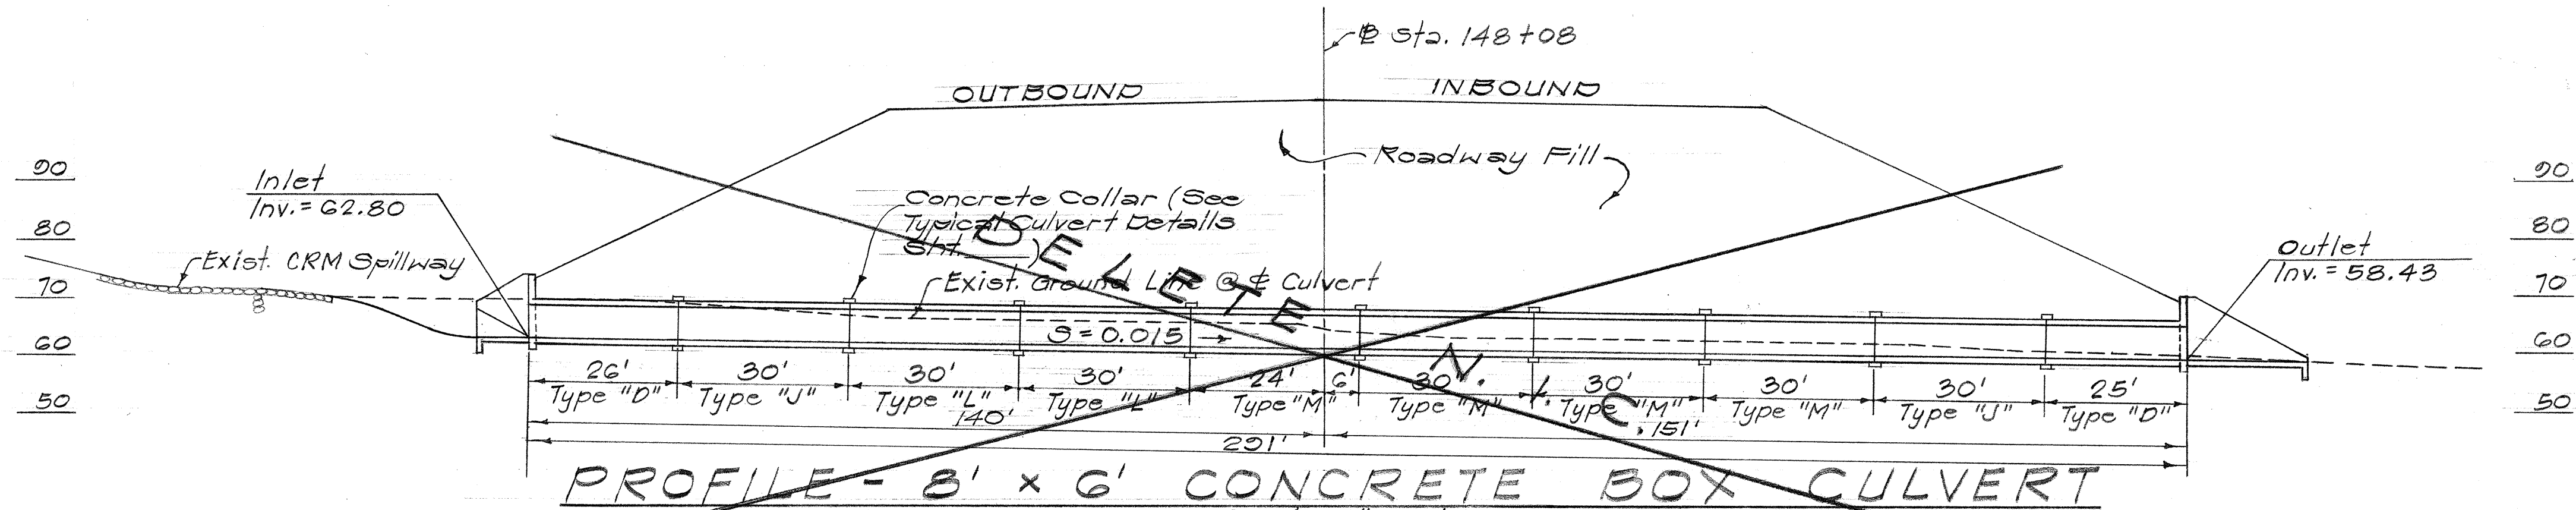


PROFILE - 8' x 6' CONCRETE BOX CULVERT

Scale: 1" = 20'

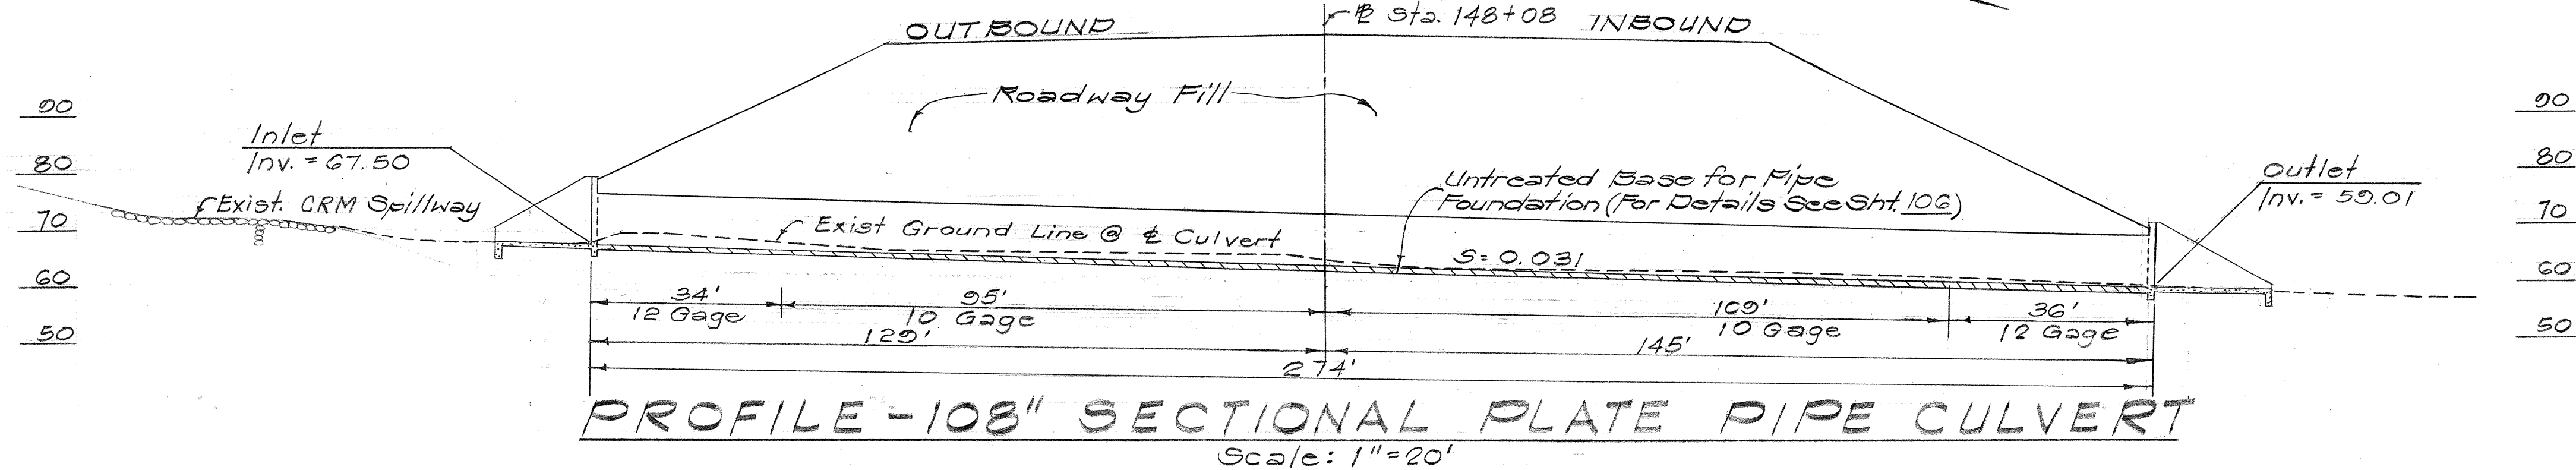

PROFILE - 108" SECTIONAL PLATE PIPE CULVERT

Scale: 1" = 20'

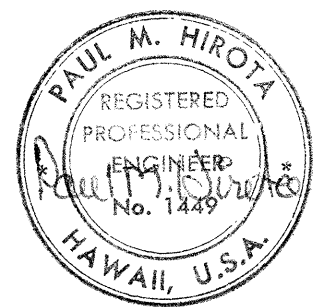

THIS WORK WAS PREPARED BY
ME OR UNDER MY SUPERVISION.

STATE OF HAWAII
DEPARTMENT OF TRANSPORTATION
HIGHWAYS DIVISION

108" SECTIONAL PLATE
PIPE CULVERT @ STA. 148+08


INTERSTATE ROUTE H-1
PROJ. NO. I-HI-1(64)12
UNIT 1

Scale: As Shown Date: 8/19/68


SHEET No. 15 OF 20 SHEETS

SURVEY PLATTED BY	DATE
DRAWN BY	
DESIGNED BY	
NOTED BY	
CHECKED BY	
ORIGINAL PLAN	
NOTE BOOK	
NO.	


FED. ROAD DIST. NO.	STATE	FED. AID PROJ. NO.	FISCAL YEAR	SHEET NO.	TOTAL SHEETS
HAWAII	HAW.	1-HI-1(64):12 Unit 1	1963	103	158
1-HI-1(16):11					

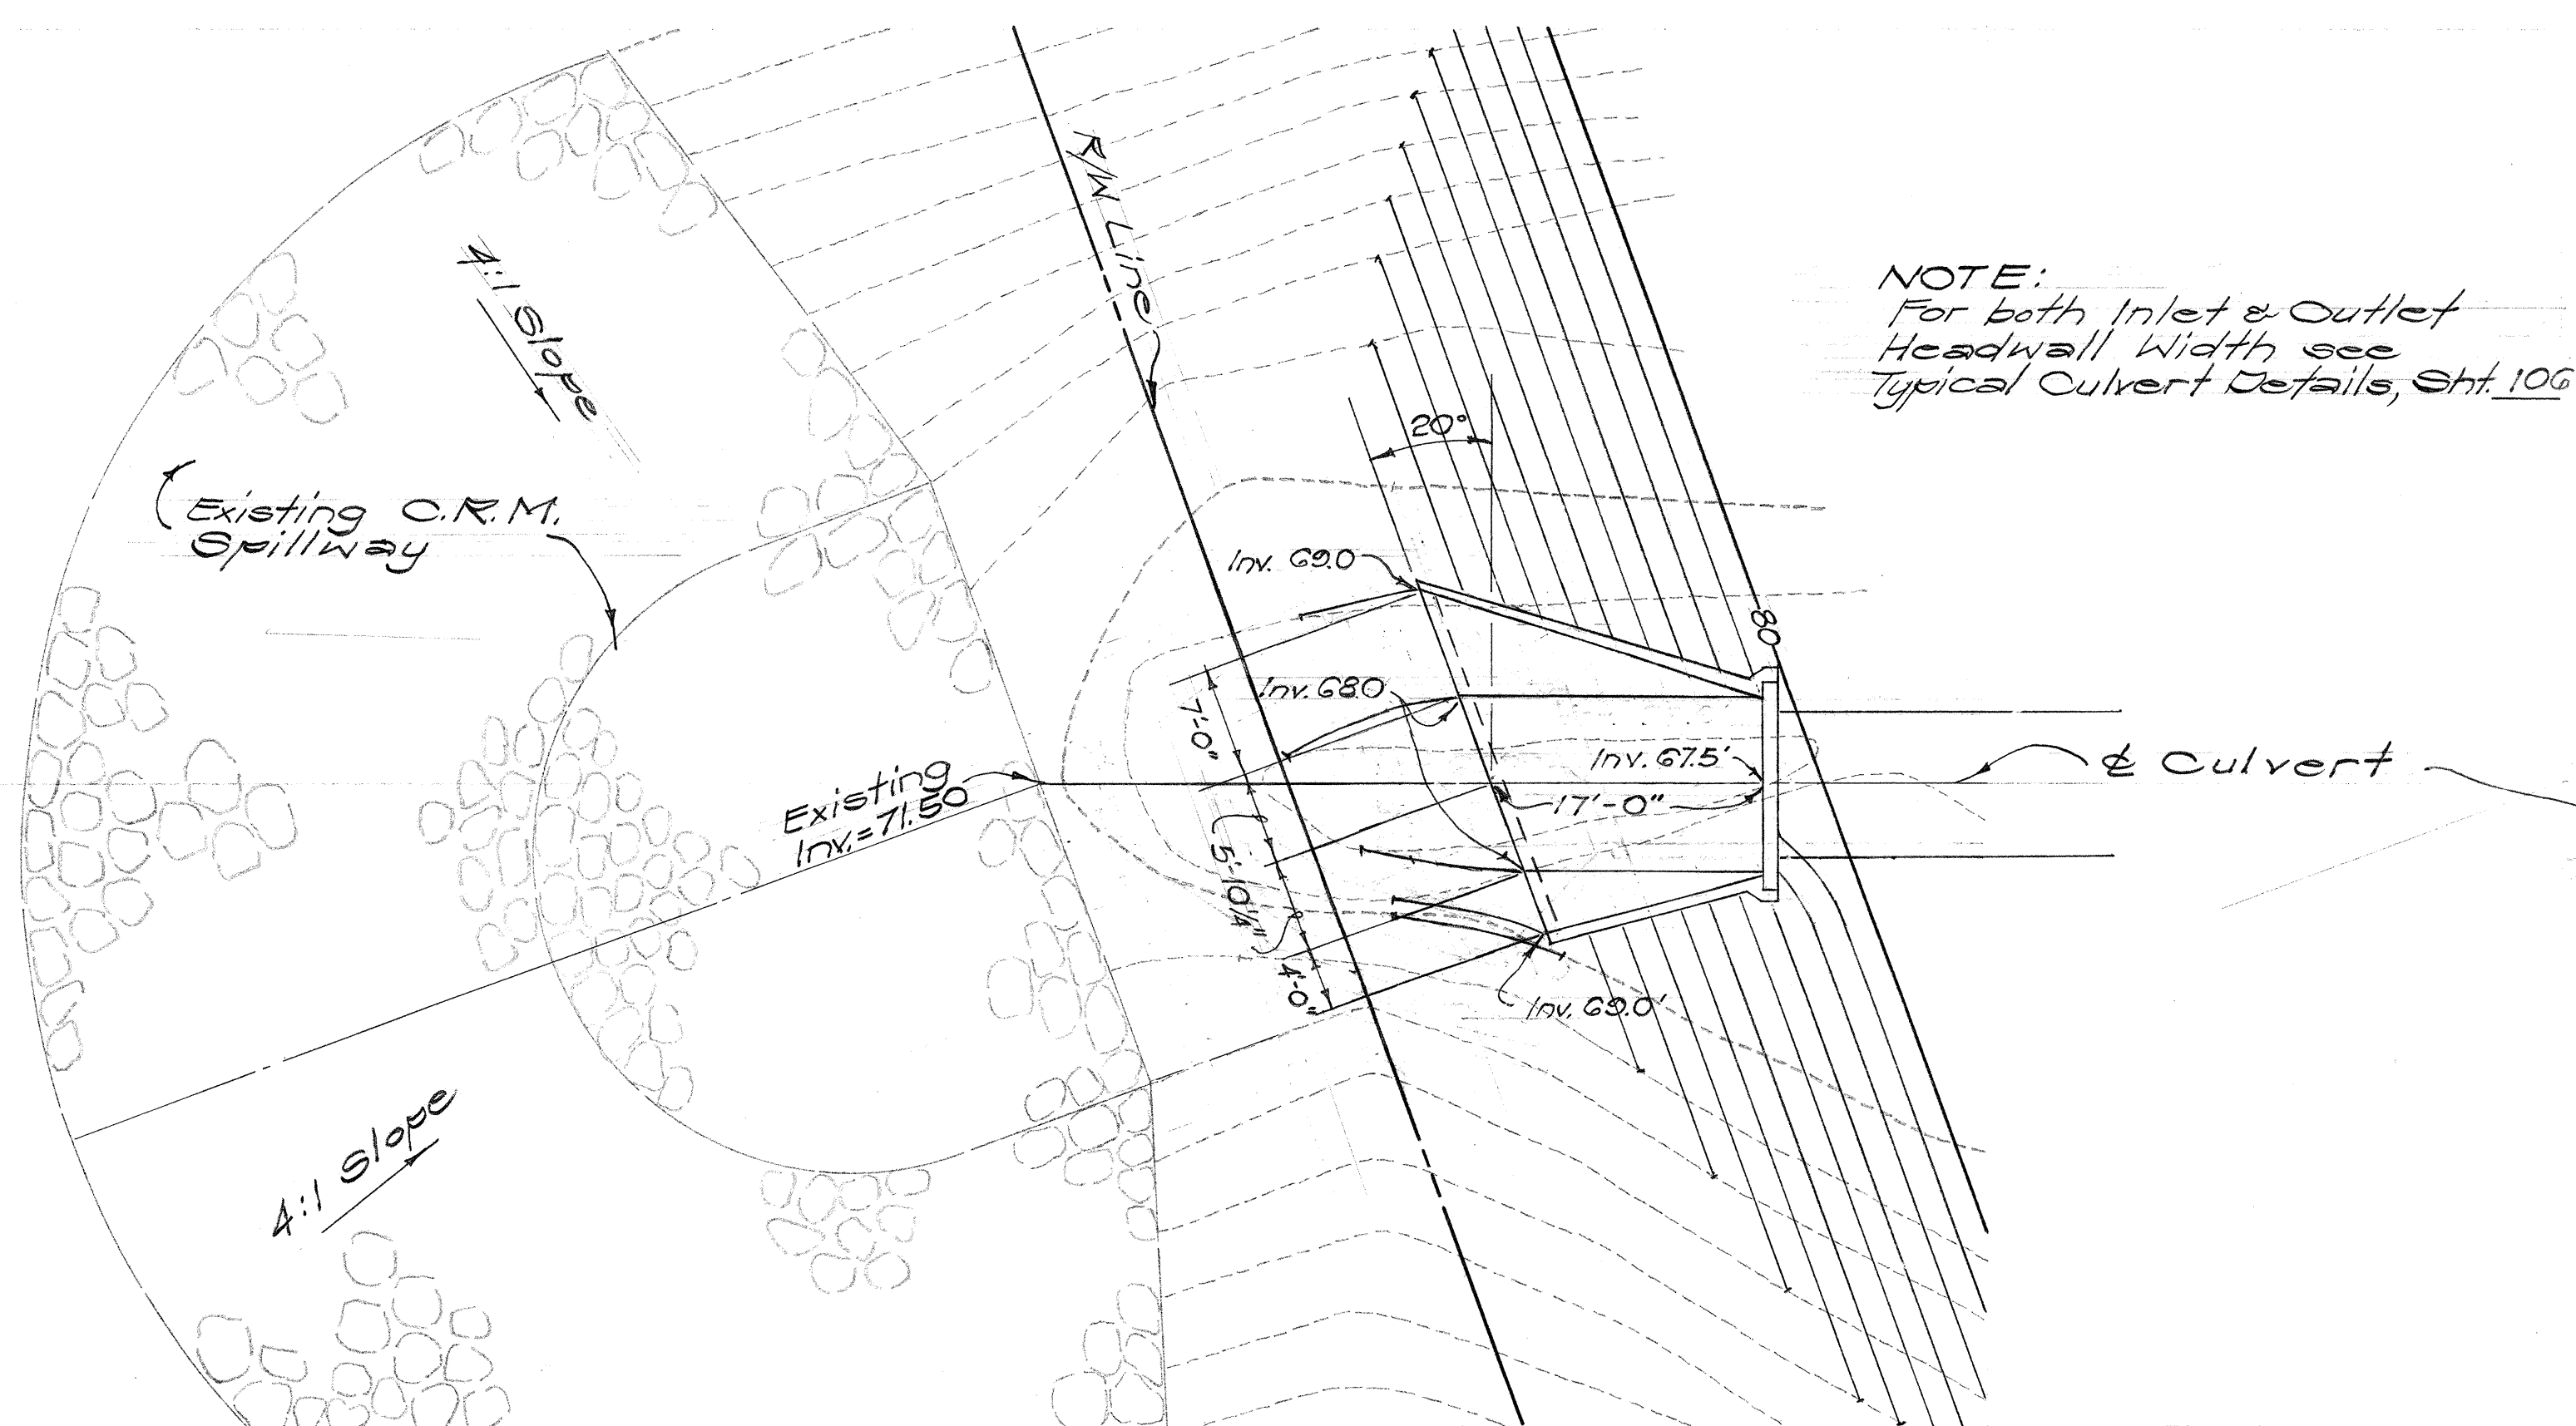


PLAN - INLET
Scale: 1" = 10'-0"

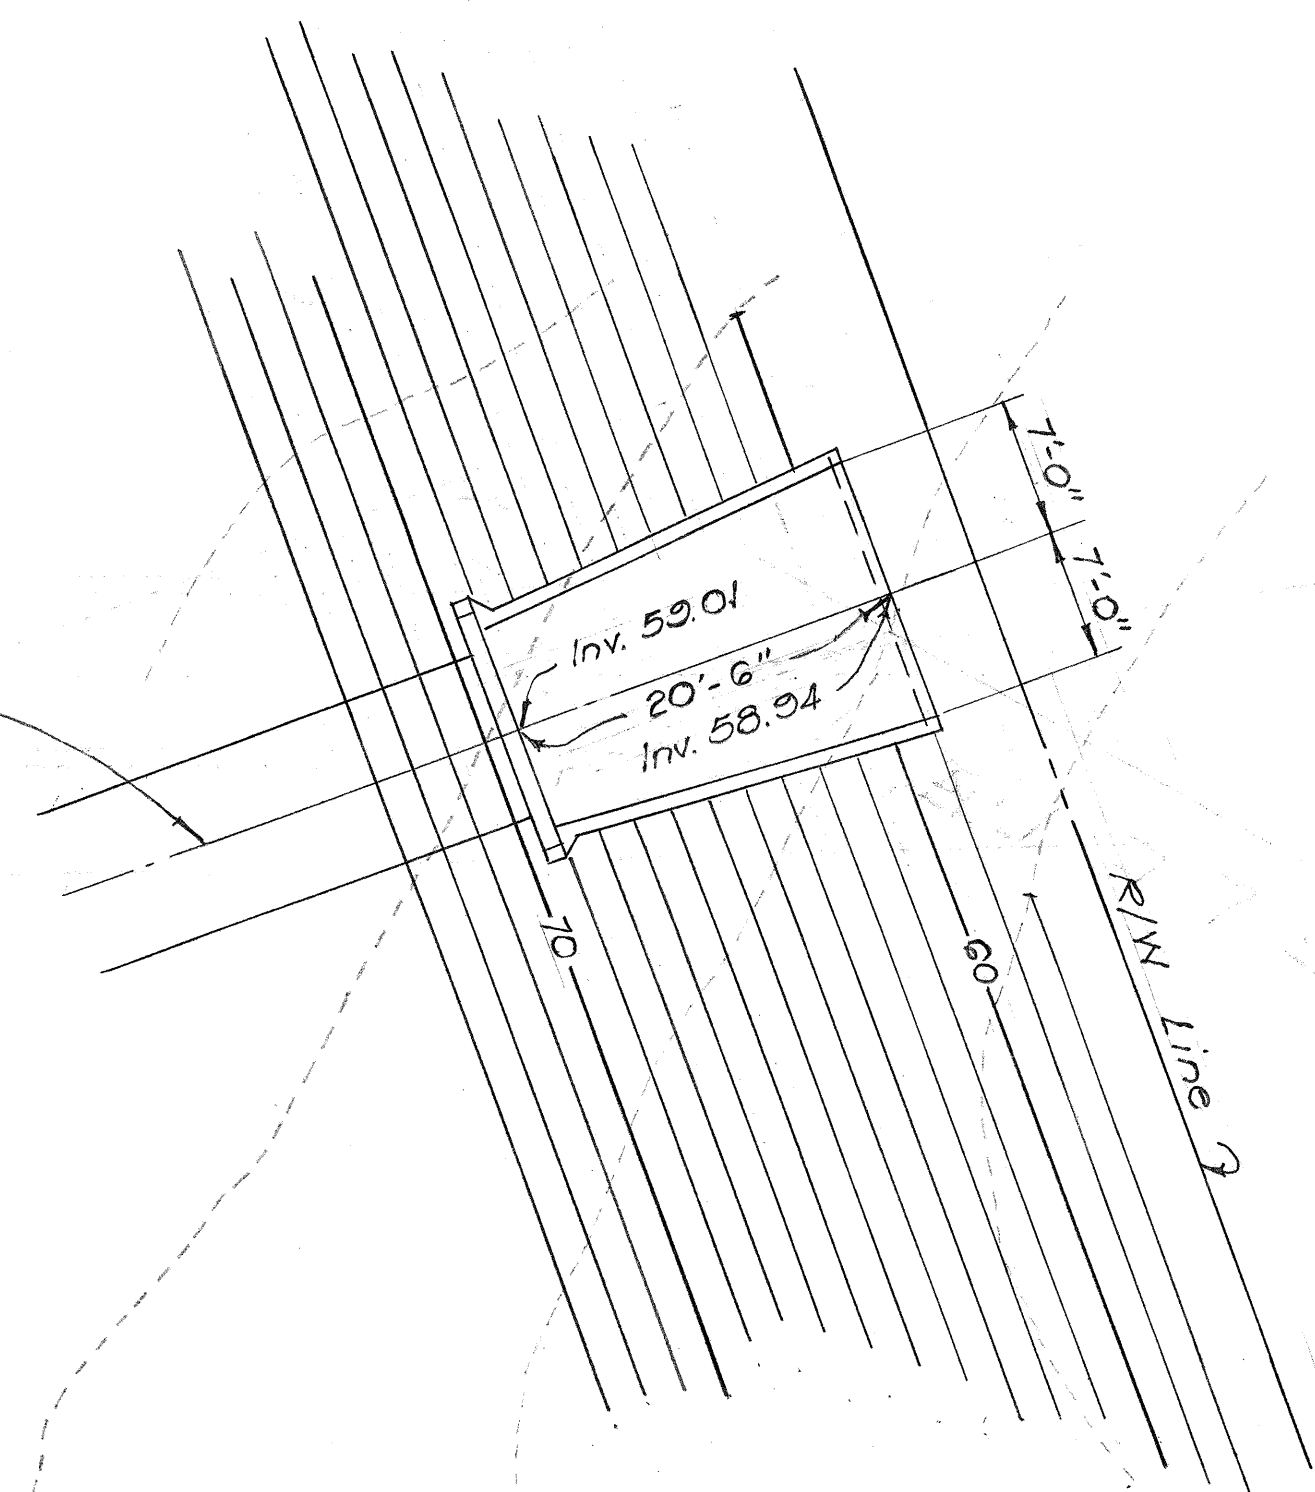


PLAN - OUTLET
Scale: 1" = 10'-0"

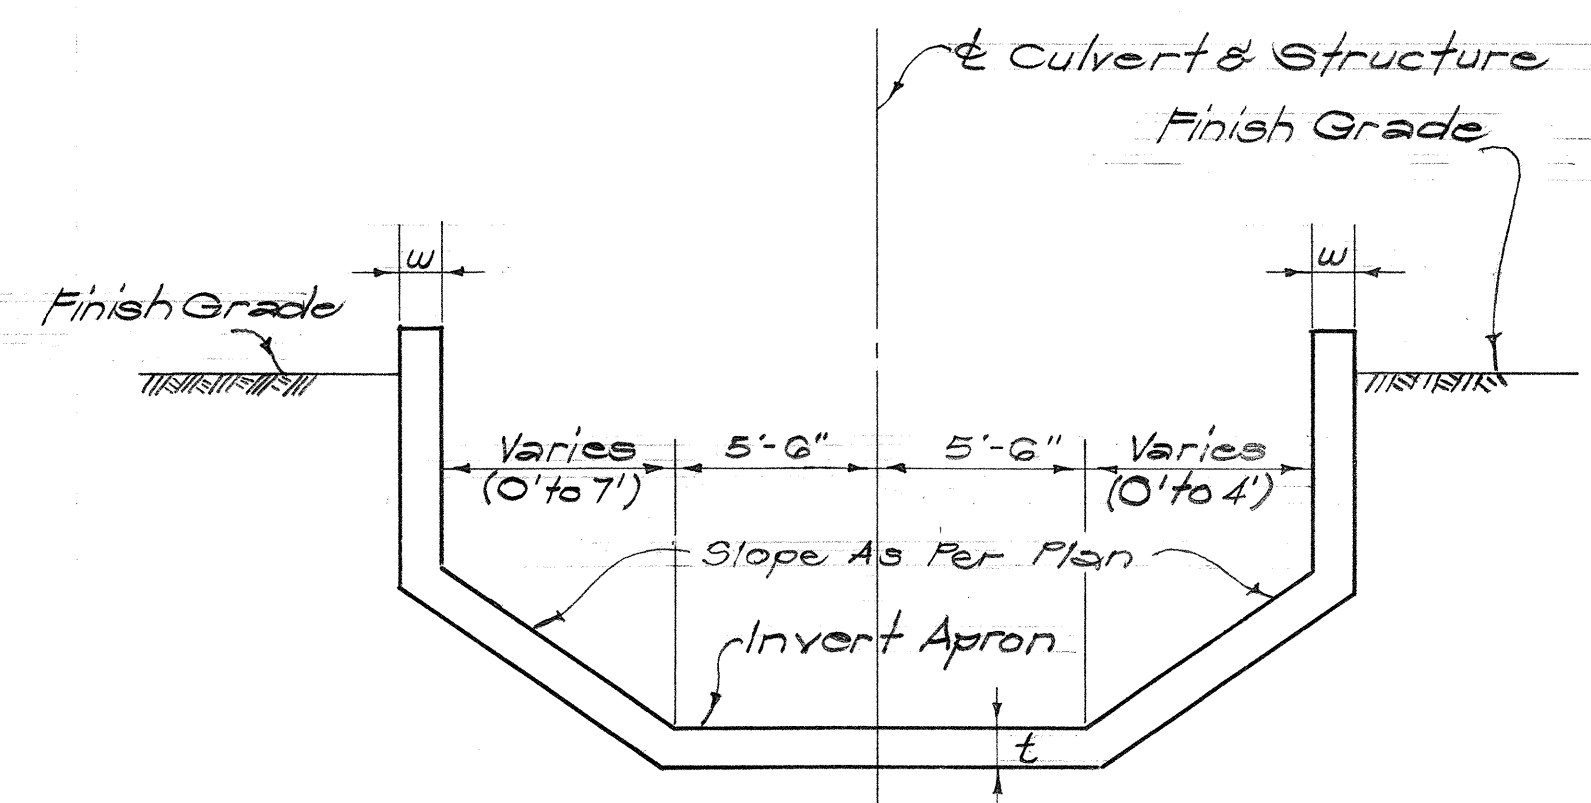

SECTION "A-A"
Not to Scale

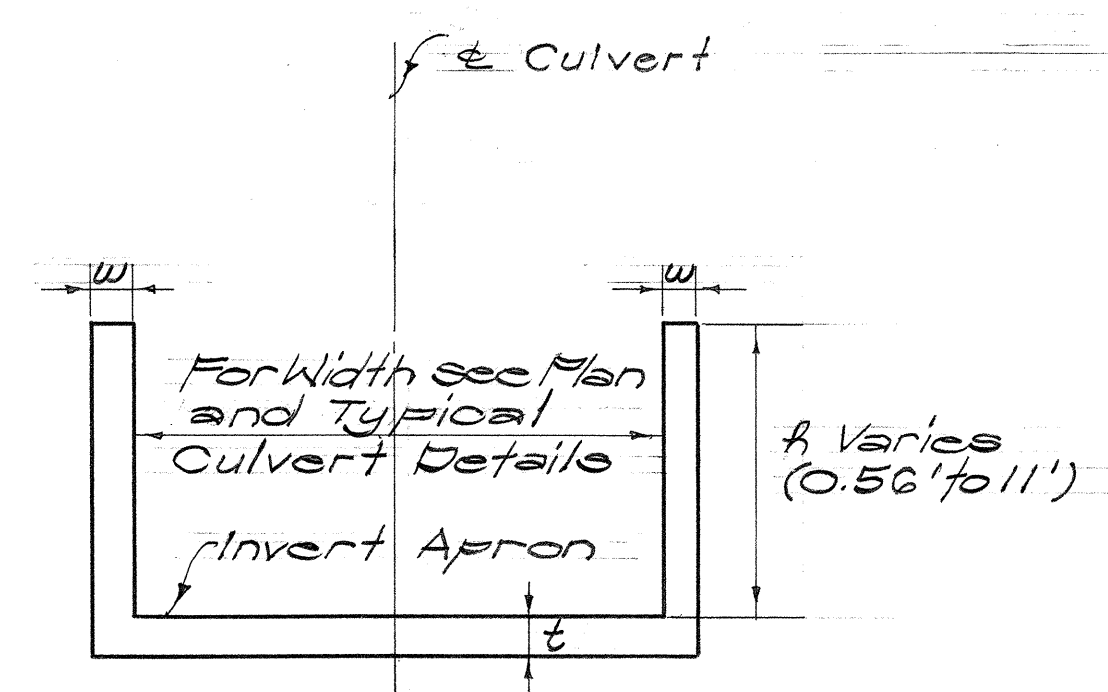

SECTION "B-B"
Scale: 1/4" = 1'-0"

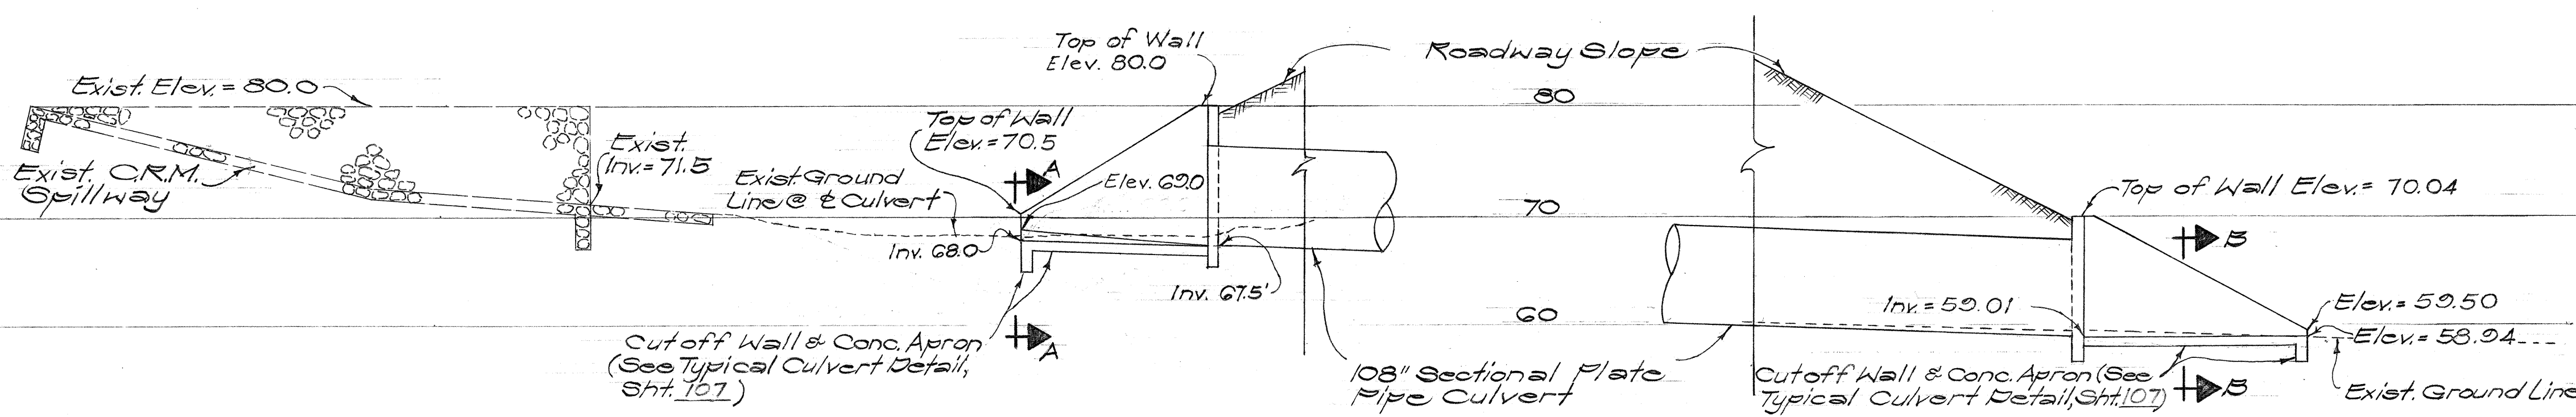


ELEVATION - INLET
Scale: 1" = 10'-0"

ELEVATION - OUTLET
Scale: 1" = 10'-0"

**108" SECTIONAL PLATE PIPE CULVERT
AT & STA. 148+08**

REFERENCE NOTES:
1. Refer to Typical Culvert Detail Drawings sheets 106 & 107
for additional details.

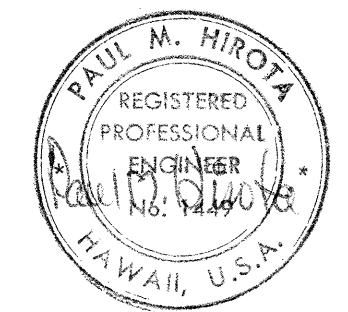

STATE OF HAWAII
DEPARTMENT OF TRANSPORTATION
HIGHWAYS DIVISION


**108" SECTIONAL PLATE
PIPE CULVERT @ & STA. 148+08**

**INTERSTATE ROUTE H-1
PROJ. NO. I-HI-1(64):12,
UNIT 1**

Scale: As Shown Date: 8/19/68
SHEET No. 16 OF 20 SHEETS


THIS WORK WAS PREPARED BY
ME OR UNDER MY SUPERVISION.

FED. ROAD DIST. NO.	STATE	FED. AID PROJ. NO.	FISCAL YEAR	SHEET NO.	TOTAL SHEETS
HAWAII	HAW.	I-HI-1(64):12, Unit 1	1969	104	158
HH-1(16)-11					

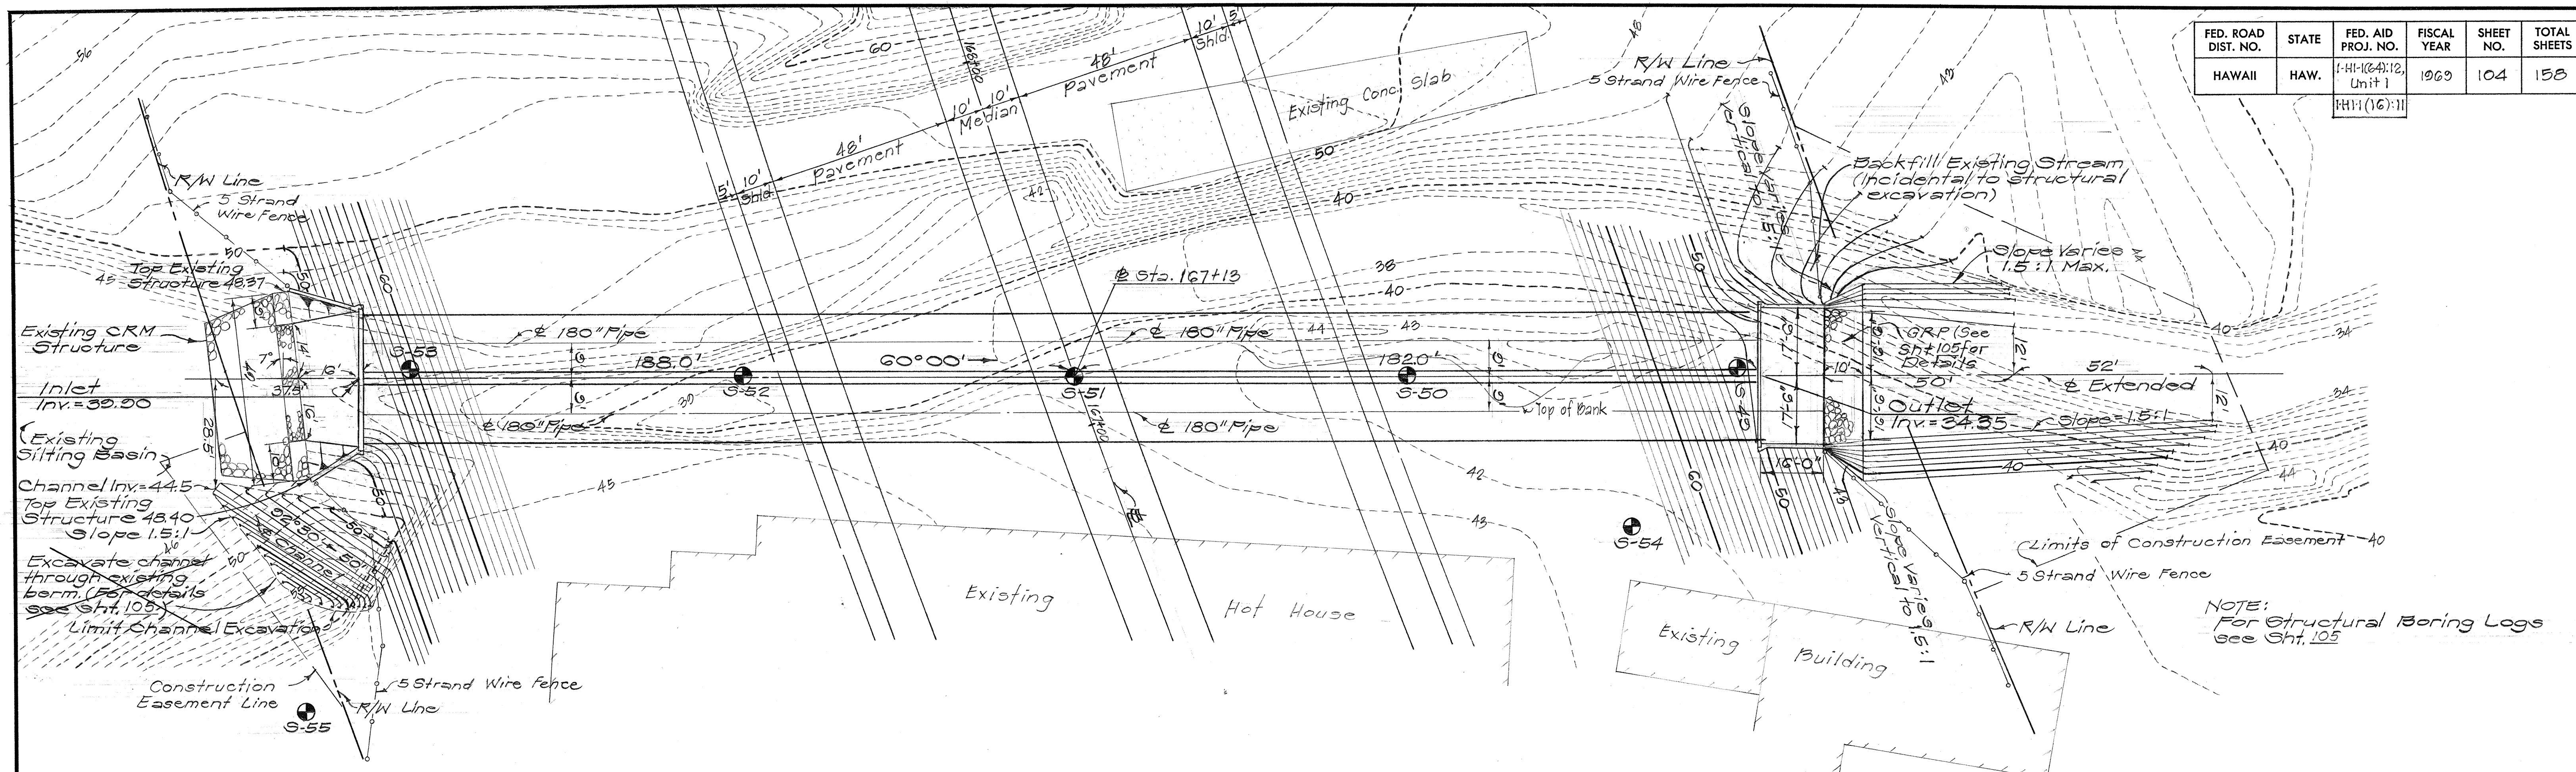

ESTIMATED QUANTITIES


1. 180" Sectional Plate Pipe (5% Elongated)	740 L.F.
2. Class 'A-1' Conc.	180 c.y.
3. Reinforcing Steel	17,950 lbs.
4. Structural Excavation	3,400 c.y.
5. Channel Excavation	840 c.y.
6. Untreated Base for Pipe Foundation	727 c.y.
7. Grouted Rubble Paving	21 c.y.
8. Course Rock	487 c.y.

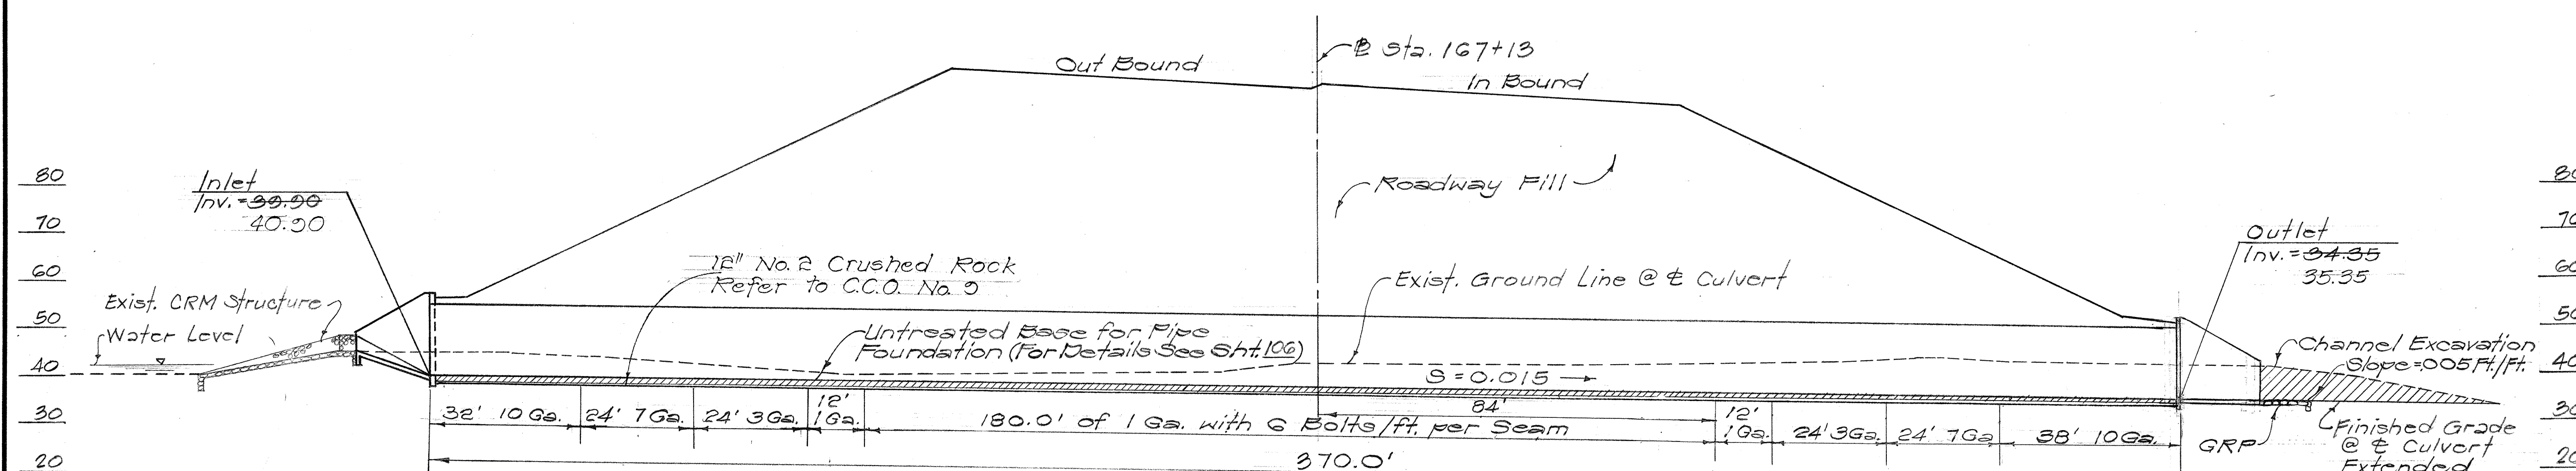

THIS WORK WAS PREPARED BY
ME OR UNDER MY SUPERVISION.


STATE OF HAWAII DEPARTMENT OF TRANSPORTATION HIGHWAYS DIVISION
TWO-180" SECTIONAL PLATE PIPE CULVERT - STA. 167+13
INTERSTATE ROUTE H-1 PROJ. NO. I-HI-1(64):12, UNIT 1
Scale: As Shown Date: 8/19/68
SHEET No. 17 OF 20 SHEETS

FED. ROAD DIST. NO.	STATE	FED. AID PROJ. NO.	FISCAL YEAR	SHEET NO.	TOTAL SHEETS
HAWAII	HAW.	1-HI-1(64)-12 Unit 1	1969	105	158

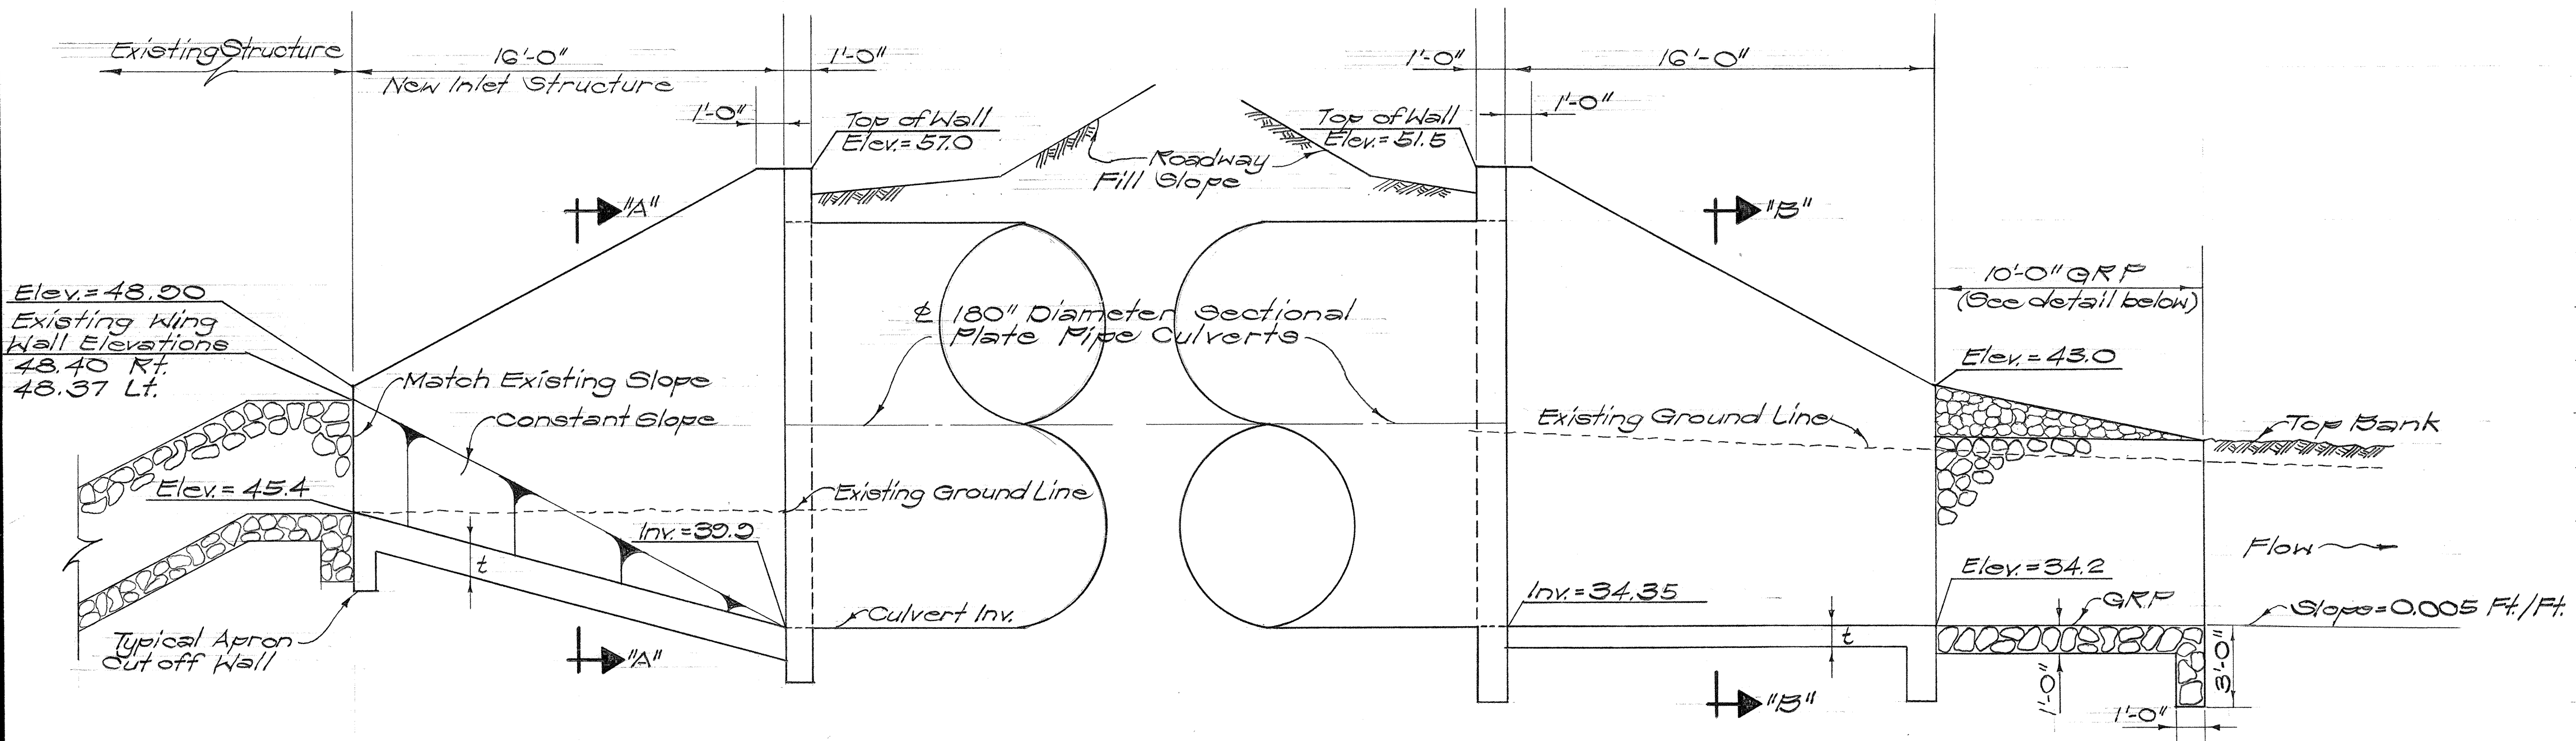


INLET ELEVATION @ STA. 167+13
Scale: 1/4" = 1'-0"

OUTLET ELEVATION @ STA. 167+13
Scale: 1/4" = 1'-0"

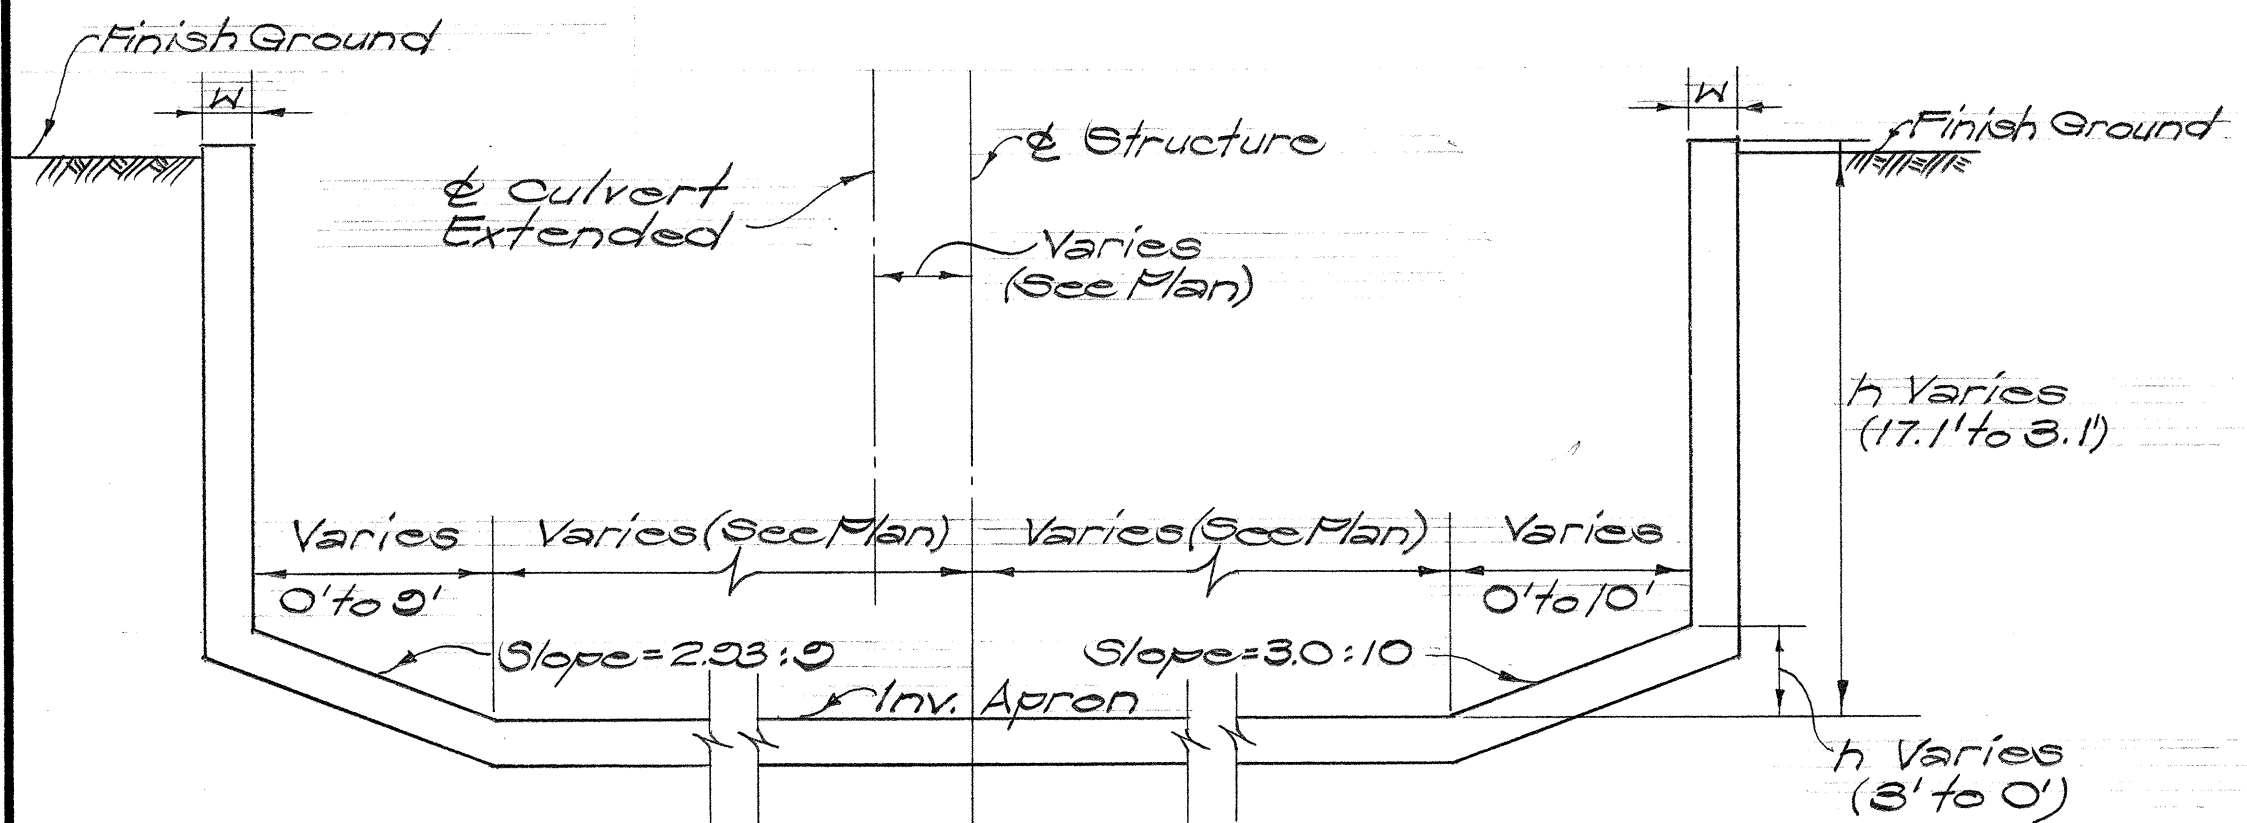


SECTION "A-A"
Scale: 1/4" = 1'-0"


REFERENCE NOTE:
Refer to Typical Culvert Details sheets 106 & 107 for reinforcing & additional details for headwalls, aprons & wing walls.

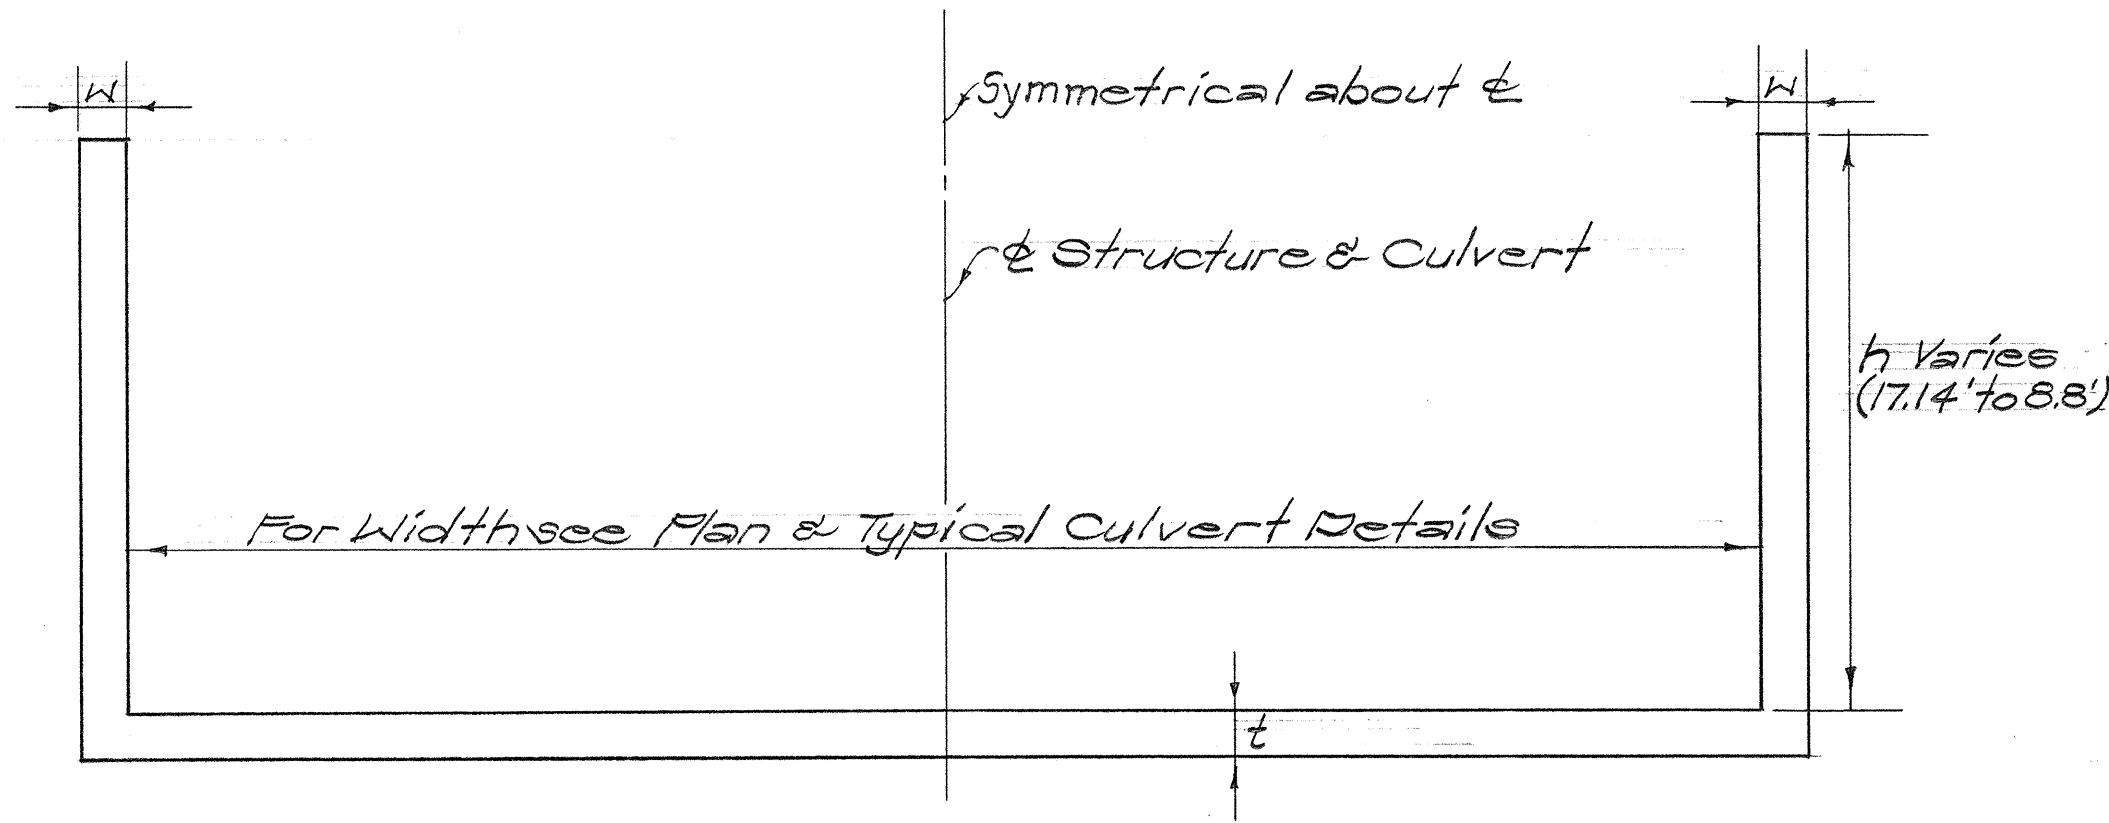

SECTION "B-B"
Scale: 1/4" = 1'-0"

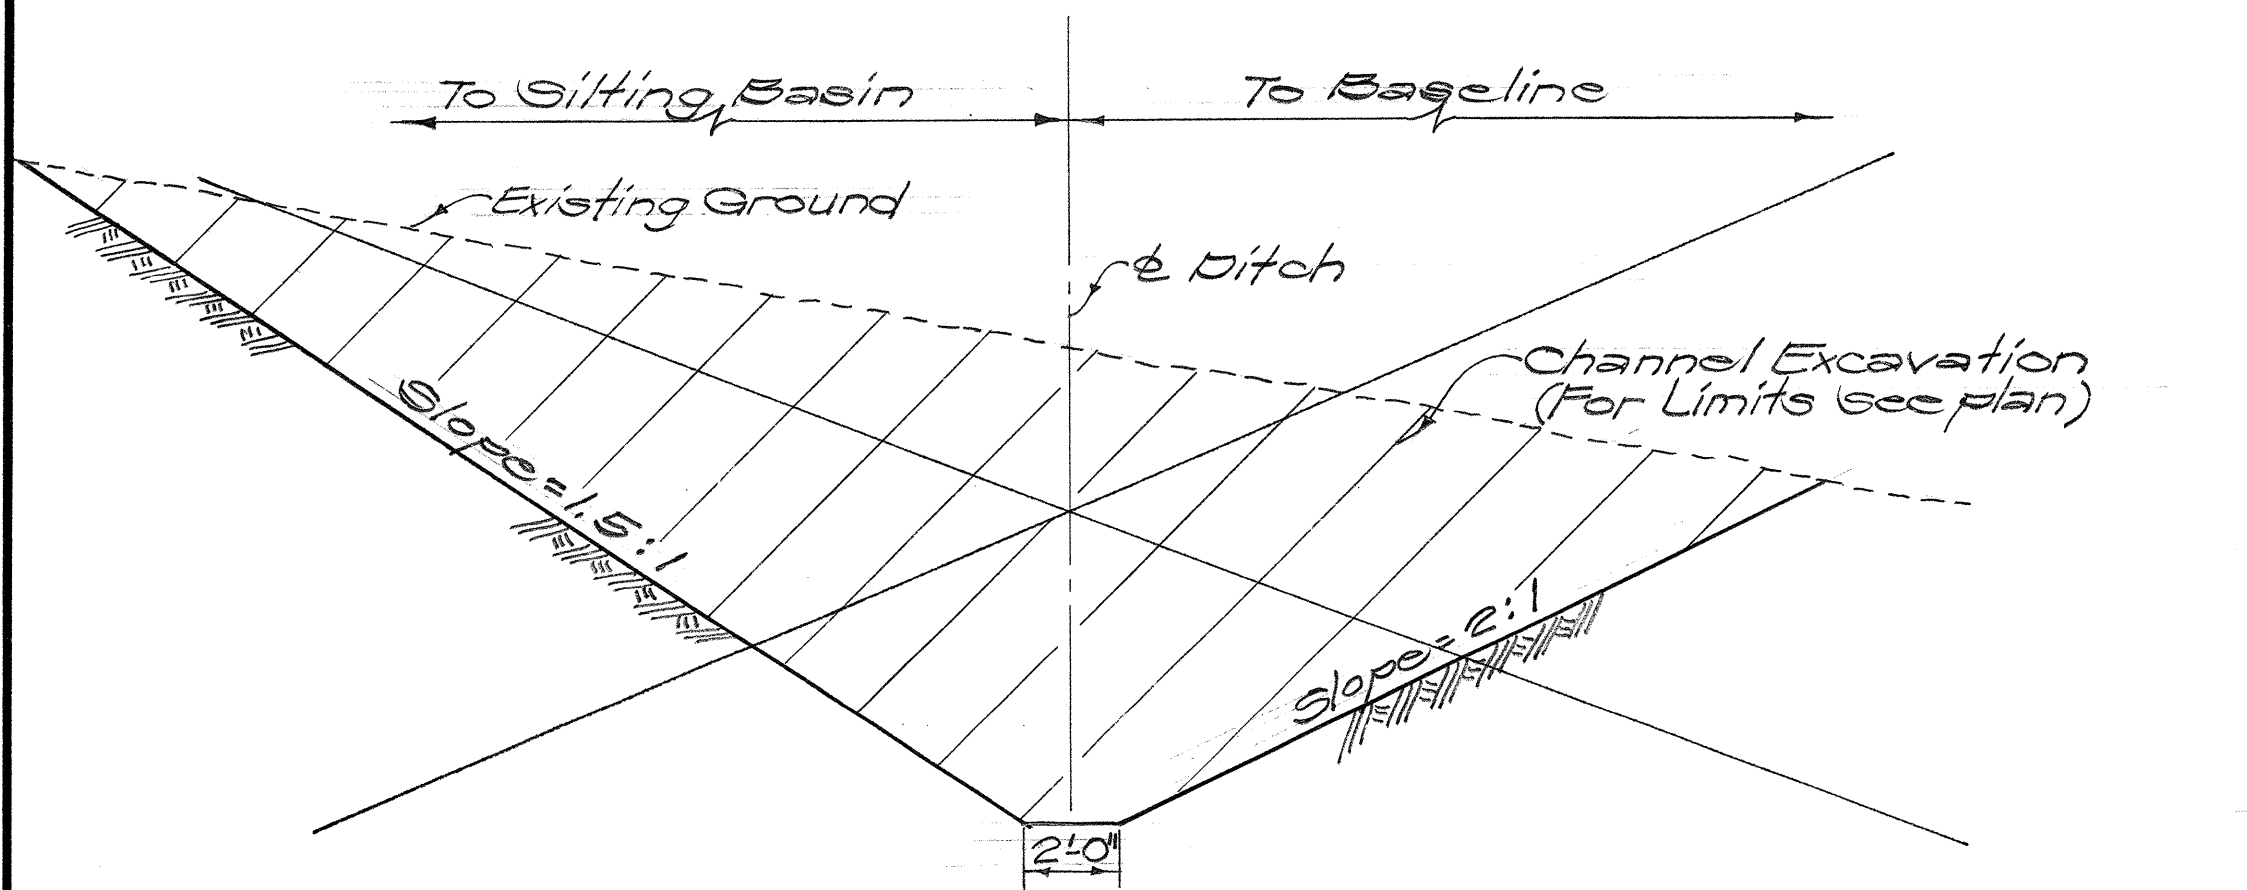


TYPICAL SECTION-CHANNEL THROUGH EXIST. BERM
Scale: 1/4" = 1'-0"

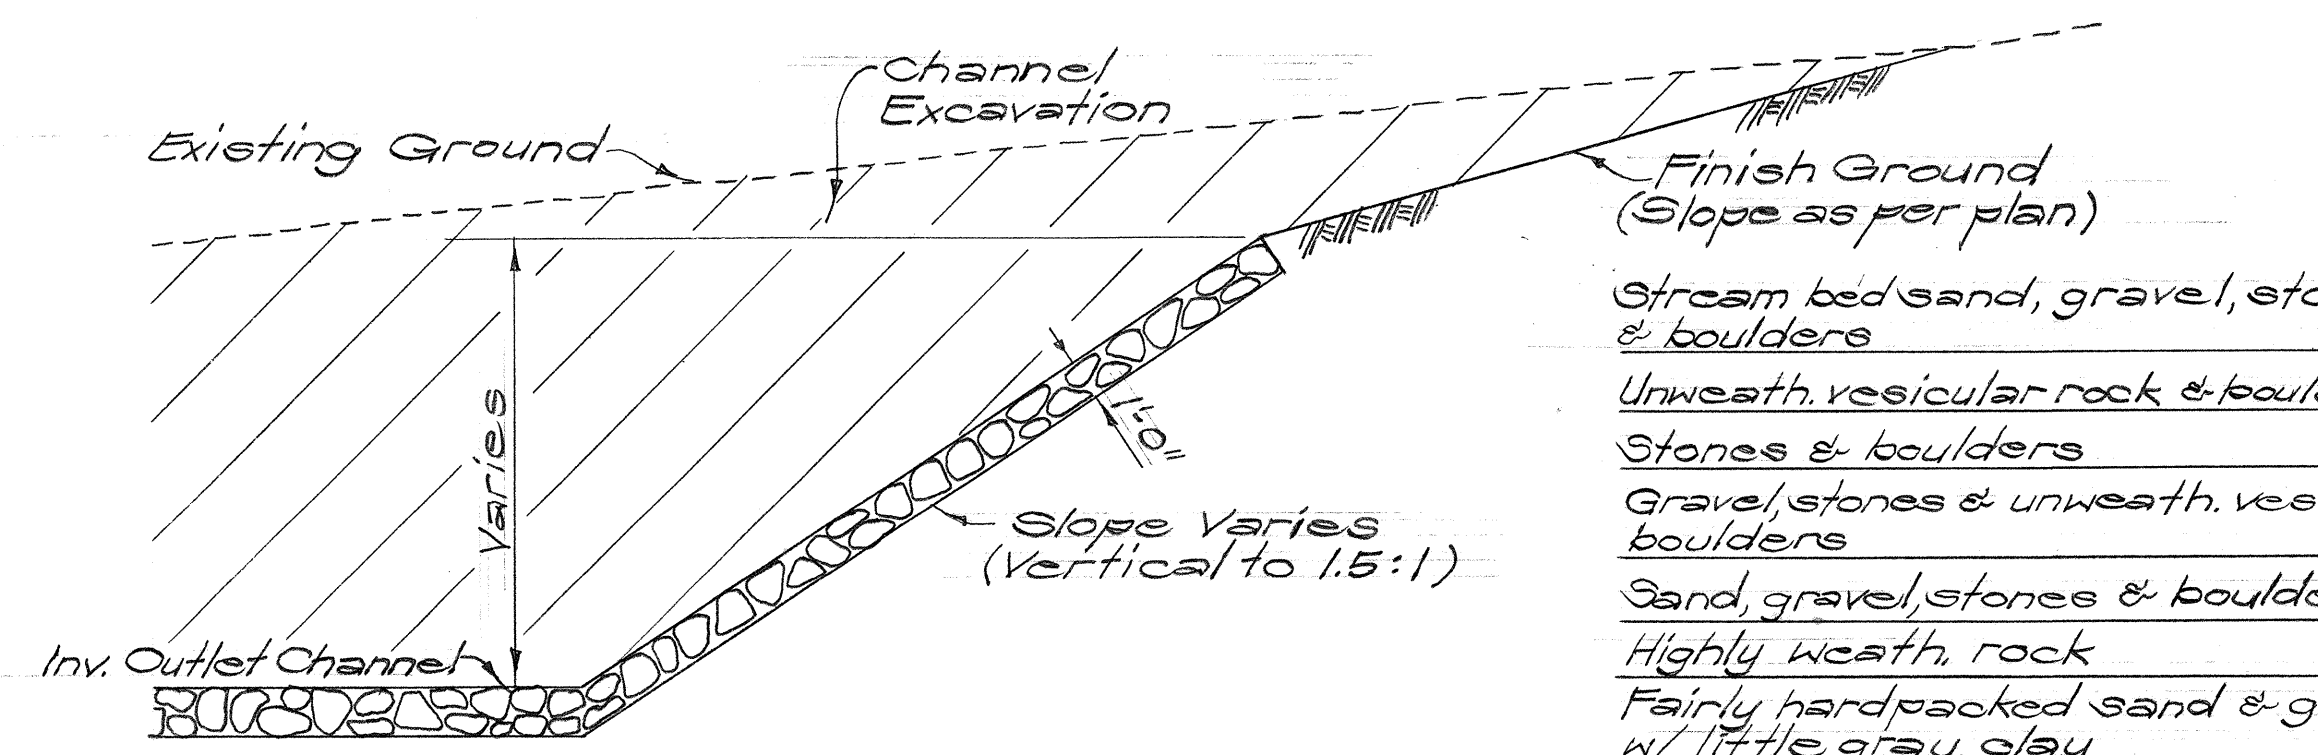


DETAIL G.R.P. LINING
Scale: 1/4" = 1'-0"


BORING S-49

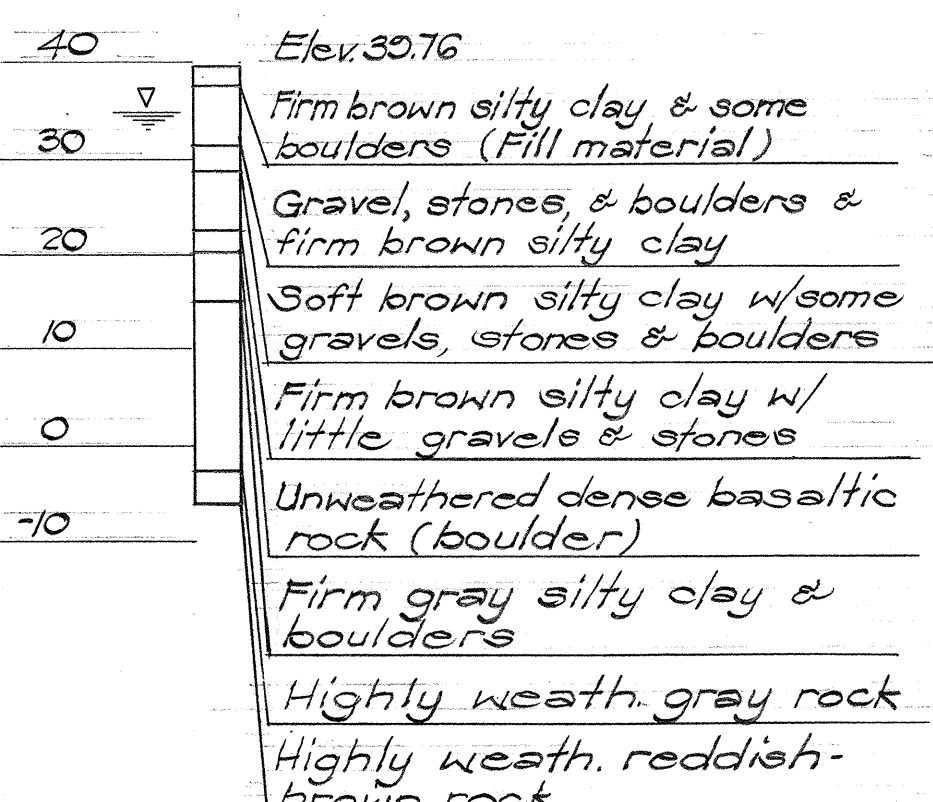


BORING S-50

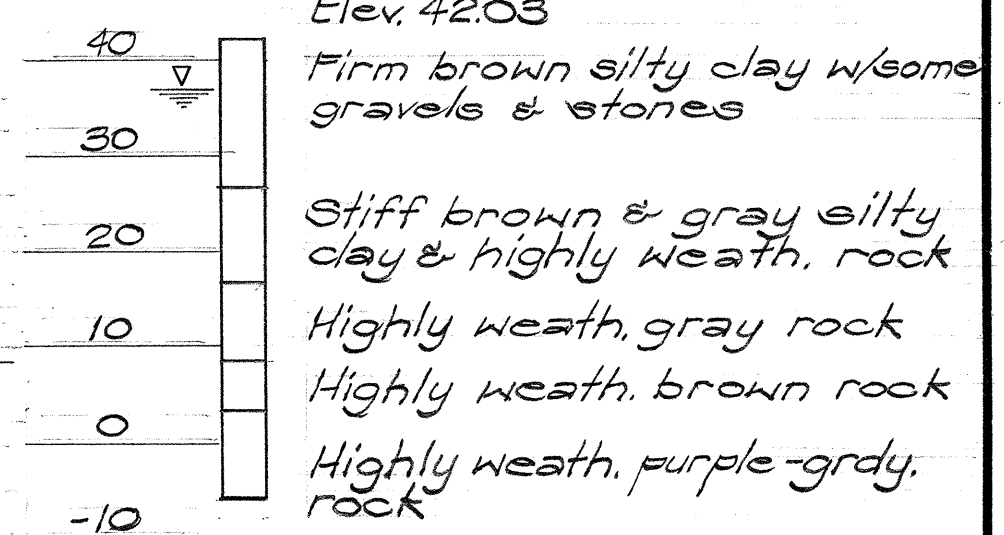


BORING S-54

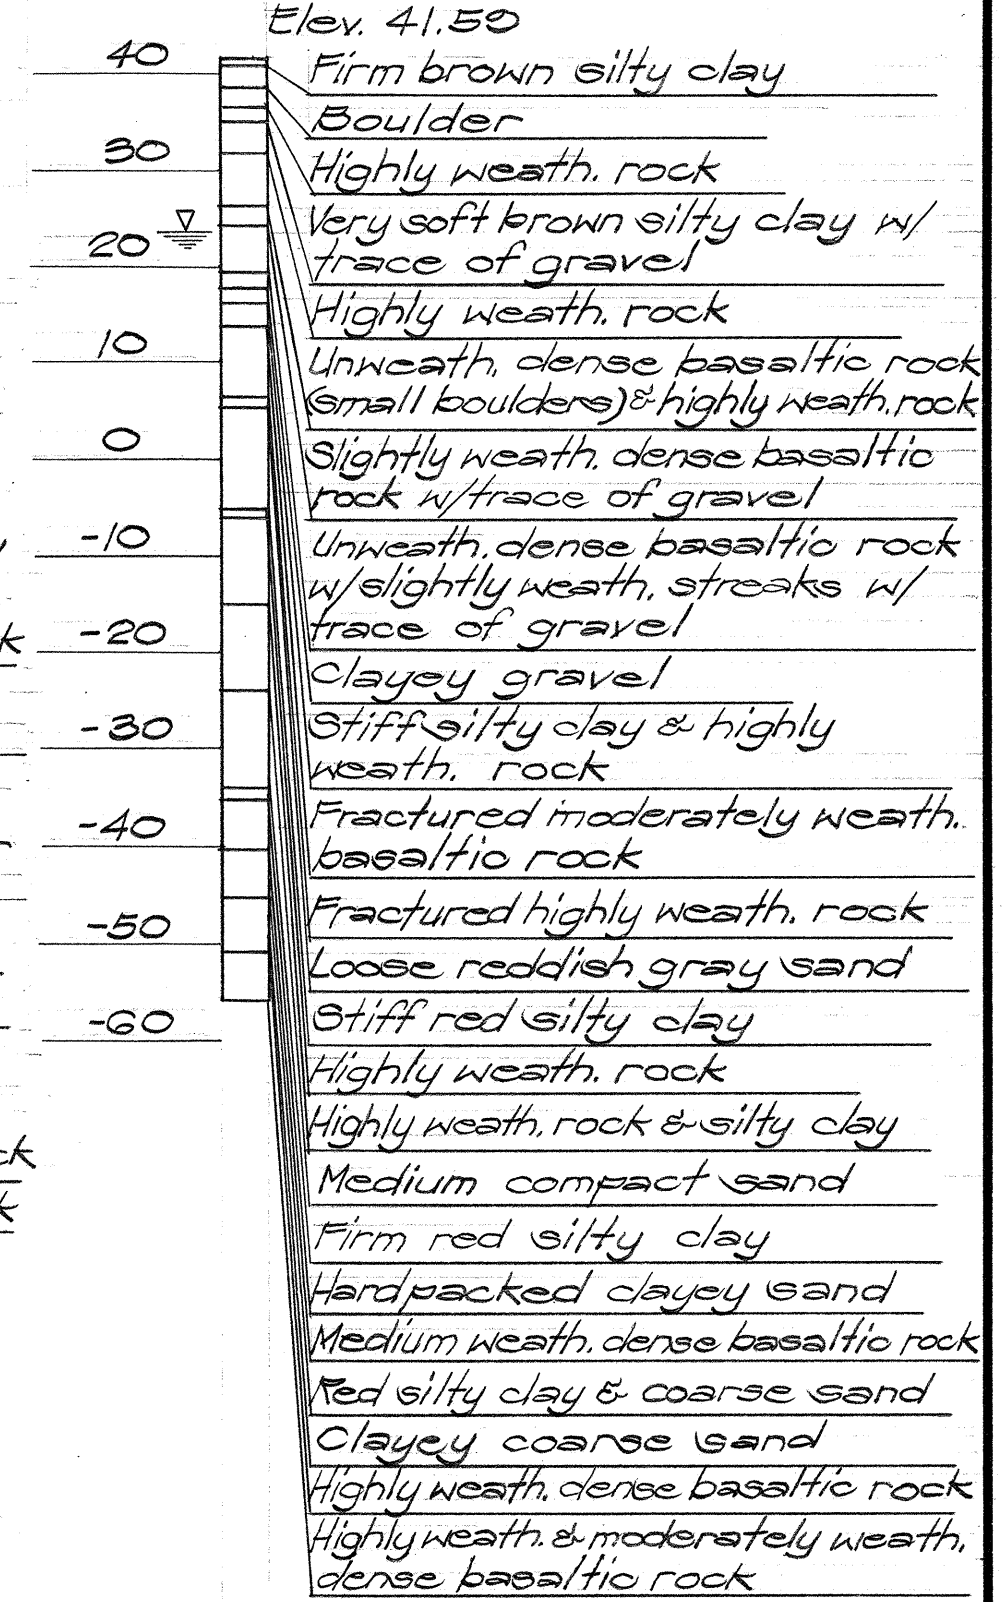


BORING S-51

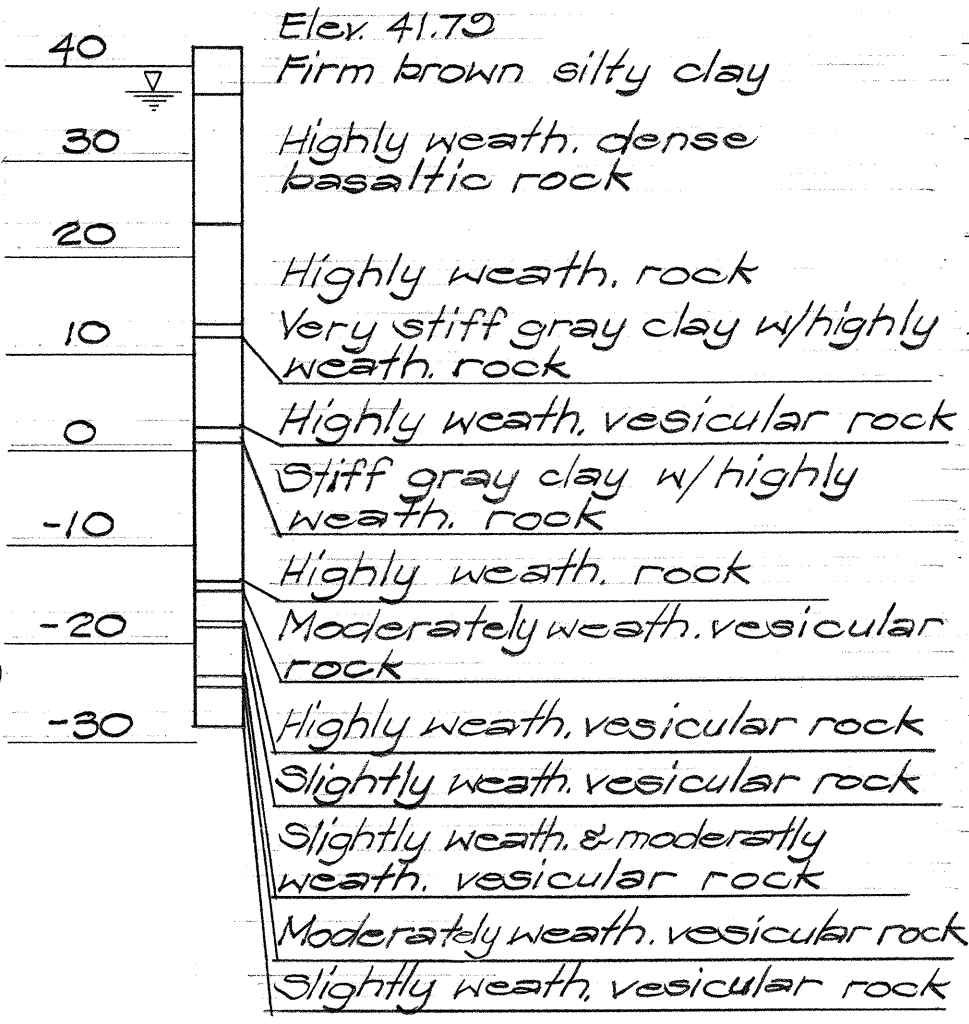



BORING S-52

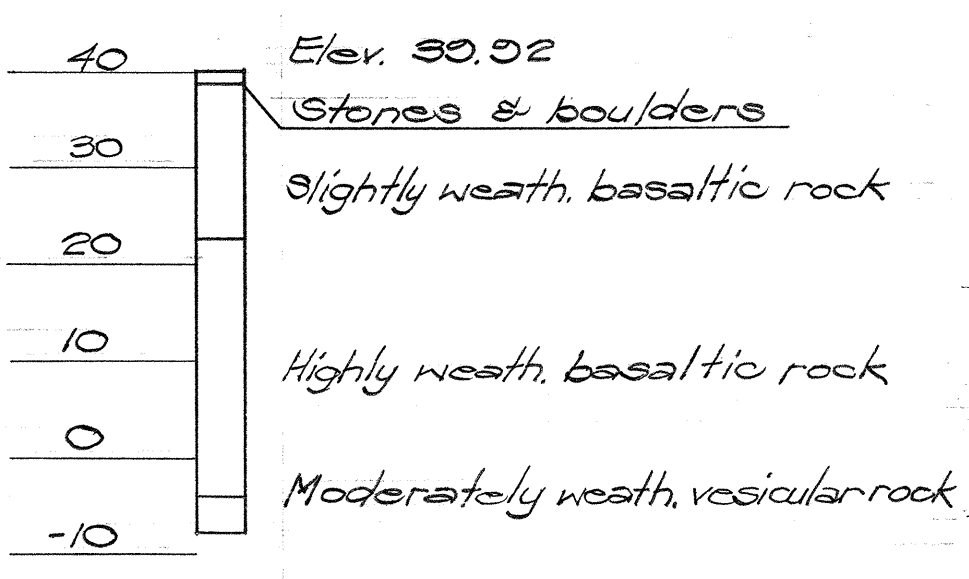

BORING S-53

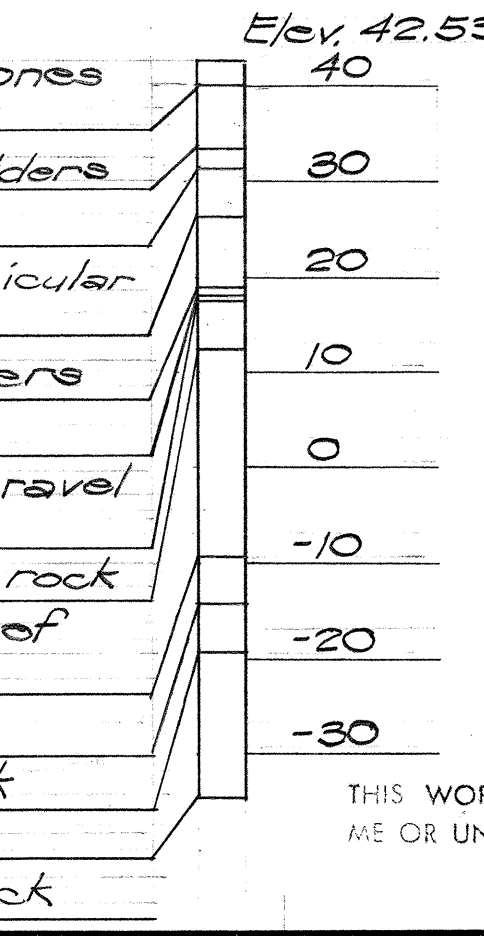


BORING S-55

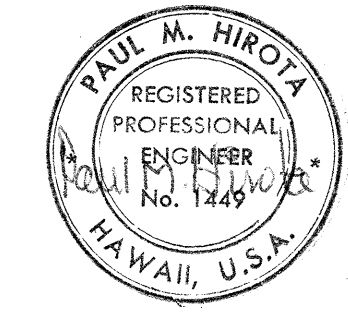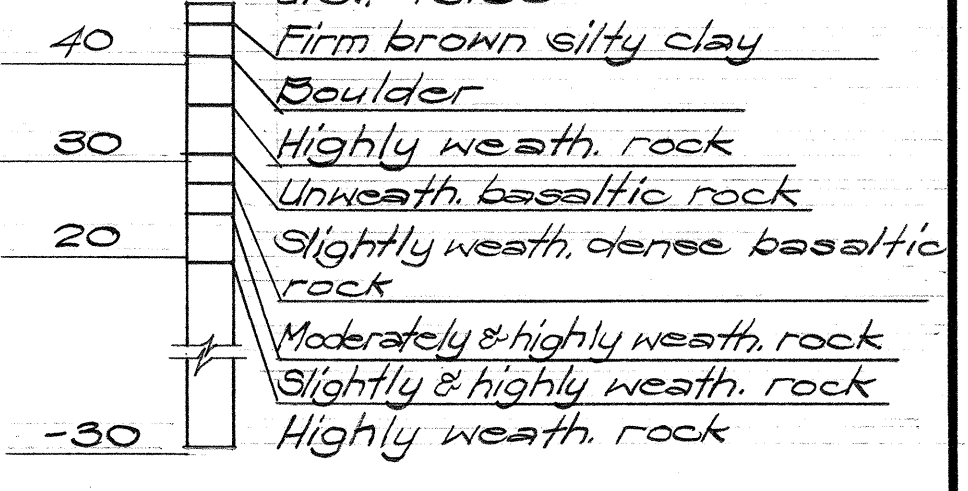

THIS WORK WAS PREPARED BY ME OR UNDER MY SUPERVISION.


STATE OF HAWAII
DEPARTMENT OF TRANSPORTATION
HIGHWAYS DIVISION
TWO-180" SECTIONAL PLATE
PIPE CULVERT - STA. 167+13
BORING LOGS
INTERSTATE ROUTE H-1
PROJ. NO. I-HI-1(64)-12,
UNIT 1
Scale: As Shown Date: 8/19/68
SHEET No. 18 OF 20 SHEETS

FED. ROAD DIST. NO.	STATE	FED. AID PROJ. NO.	FISCAL YEAR	SHEET NO.	TOTAL SHEETS
HAWAII	HAW.	1-HI-1(64):12 Unit 1	1963	106	158
HH-1(10):11					

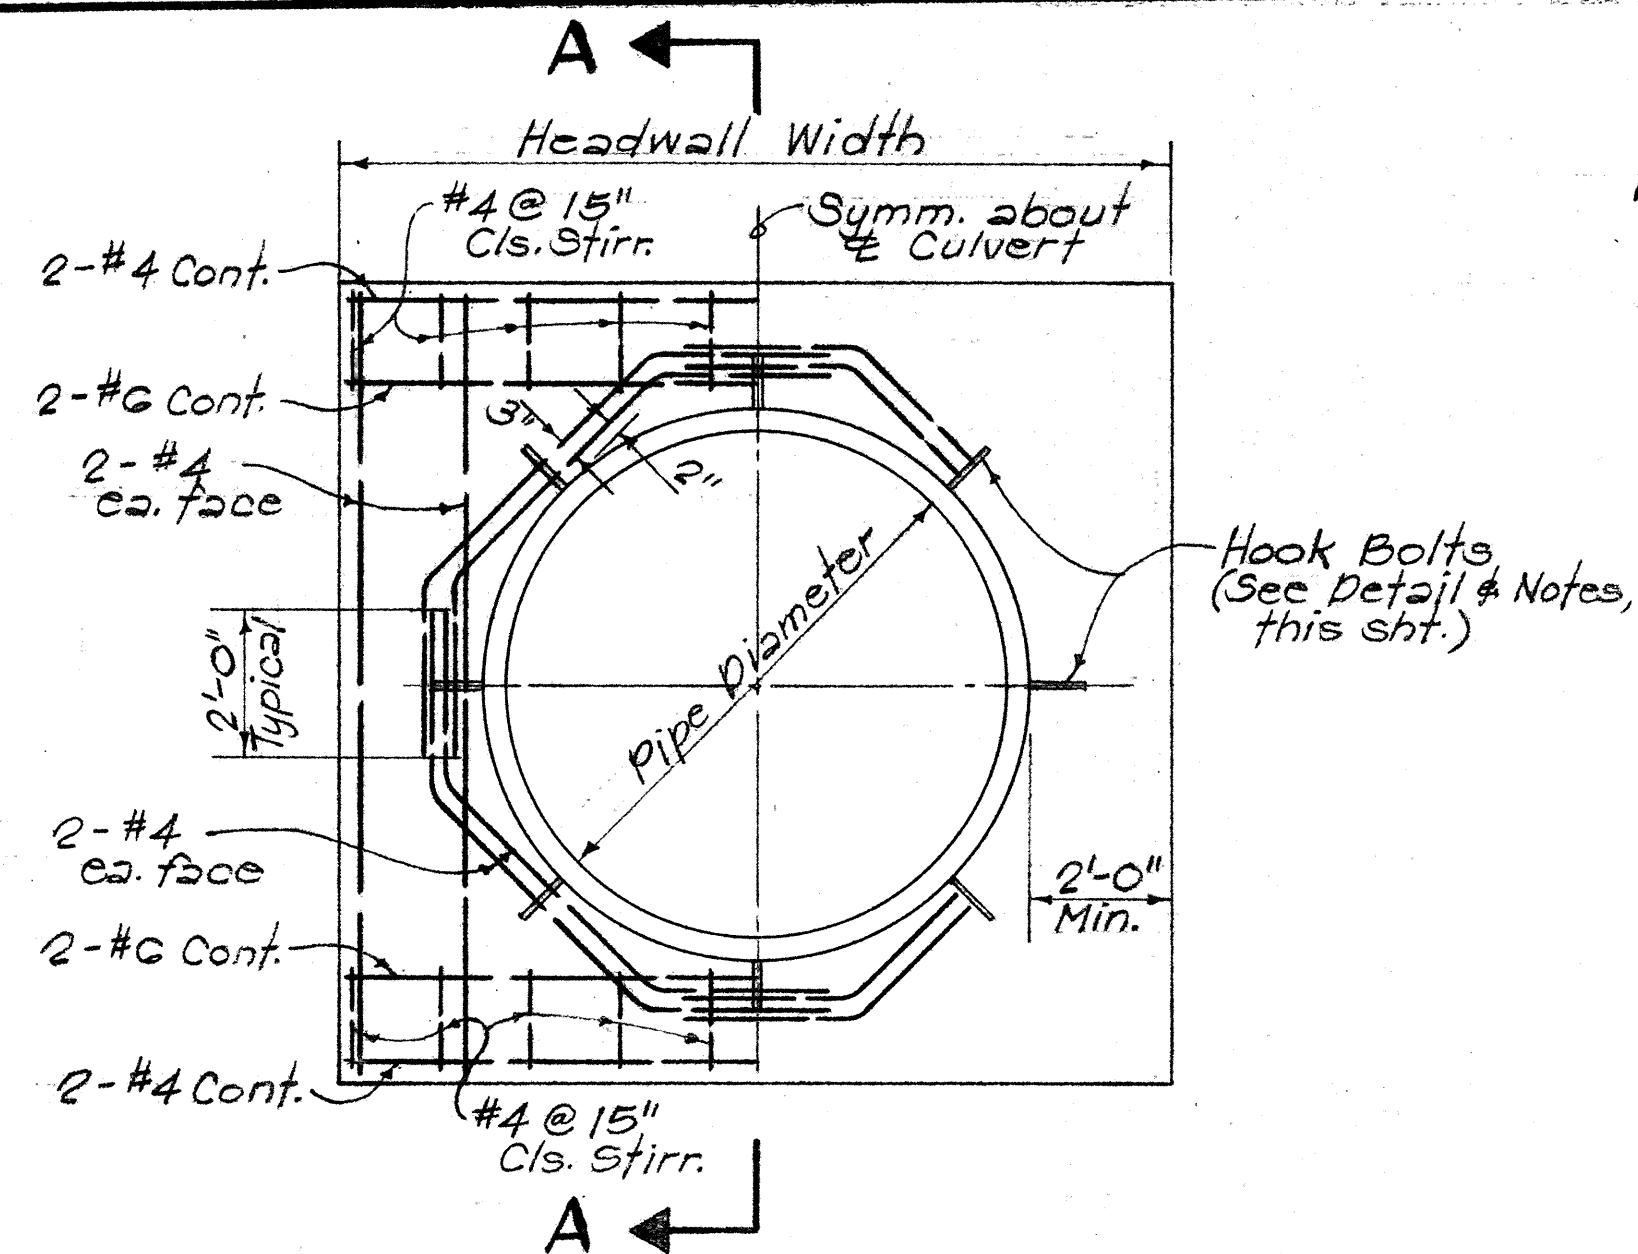


FRONT ELEVATION - SINGLE BARREL

Note: All reinforcing not shown shall be similar to details for single barrel headwall.

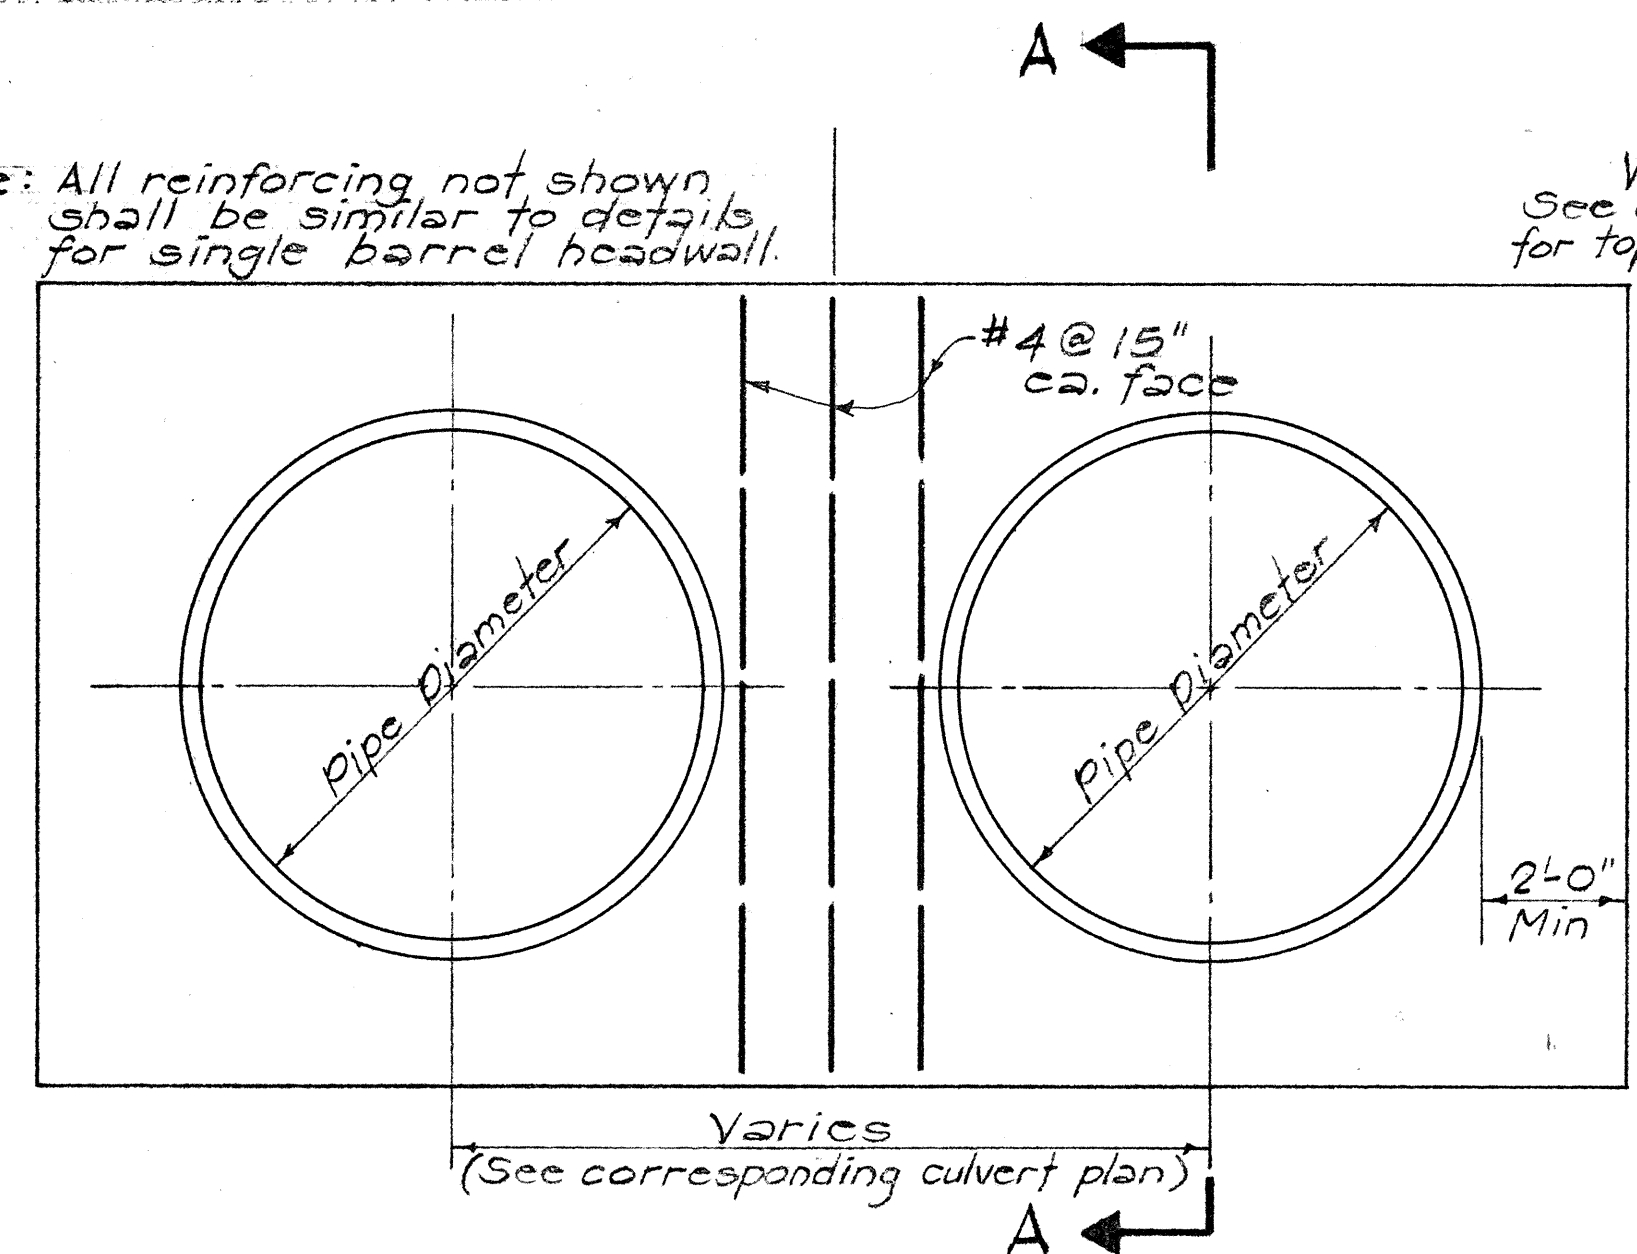


FRONT ELEVATION - MULTIPLE BARREL

Varies (2'-0" Min.) See corresponding plan for top of wall elev.

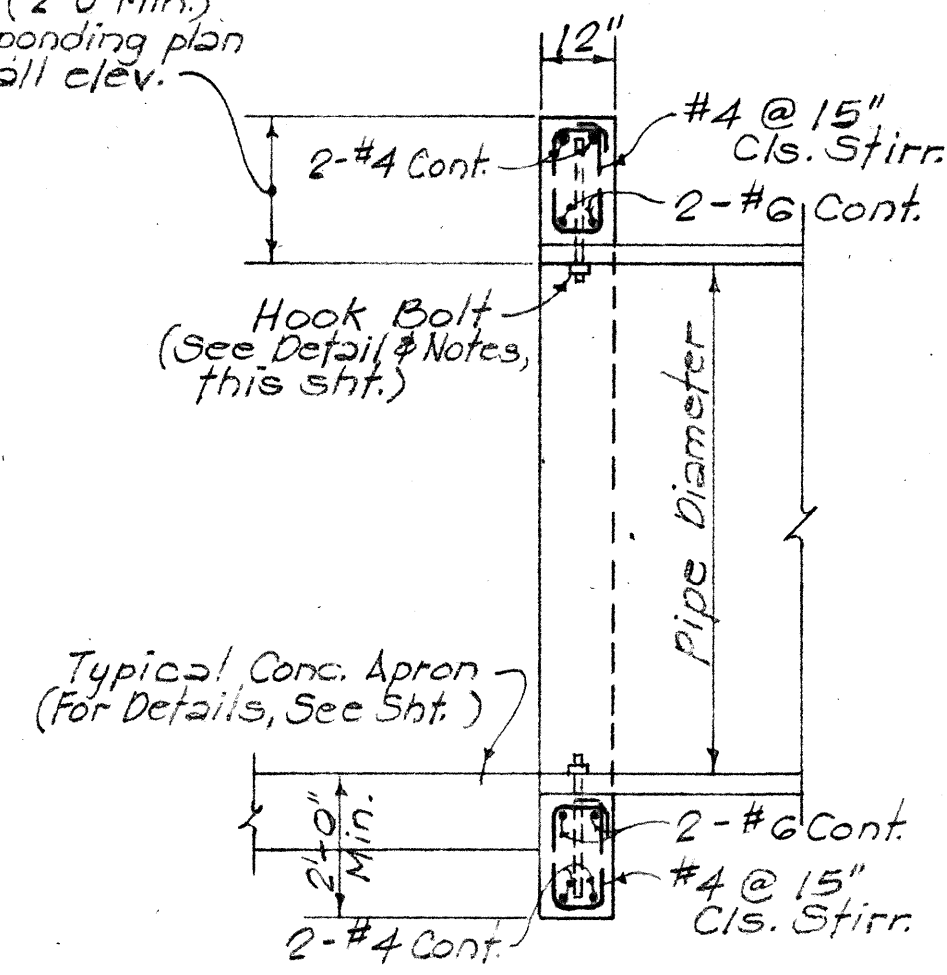


SECTION "A-A"

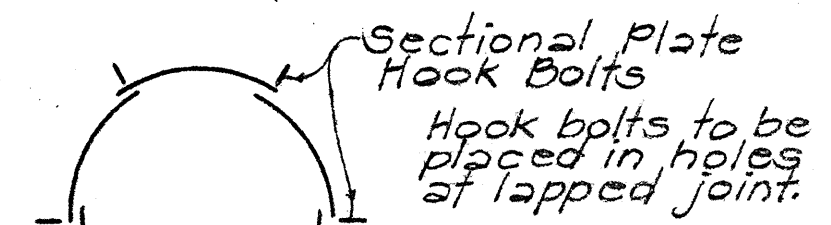


Note: Hook bolts shall be used only with Sectional Plate Pipe Culverts.

LOCATION OF HOOK BOLTS AT HEADWALL

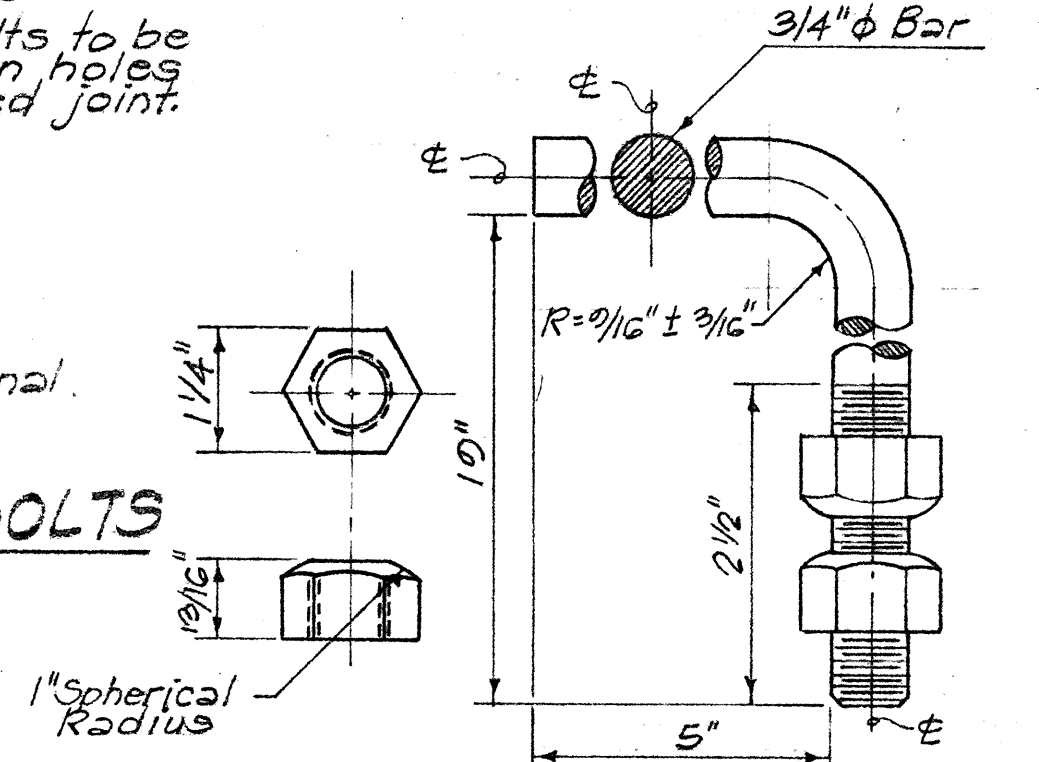


HOOK BOLT DETAIL Not to Scale


NOTE: Hook Bolt material shall meet the current ASTM A-307. Thread shall be American Standard Coarse Thread Series, Class 2, Free Fit. Bolts shall be galvanized to meet current ASTM Specification A-153. The galvanizing on thread portion shall not prevent turning the nut by hand. Nuts shall be carbon steel hot dip galvanized to meet ASTM Specification A-153. Nut threads shall be American Standard Coarse Thread Series (1/64 maximum oversize), cleaned after galvanizing to provide a free running fit on the Class 2 bolt. Nuts shall be 1/4" across flats, 13/16" thick, curve crowned to approximately 1" radius.

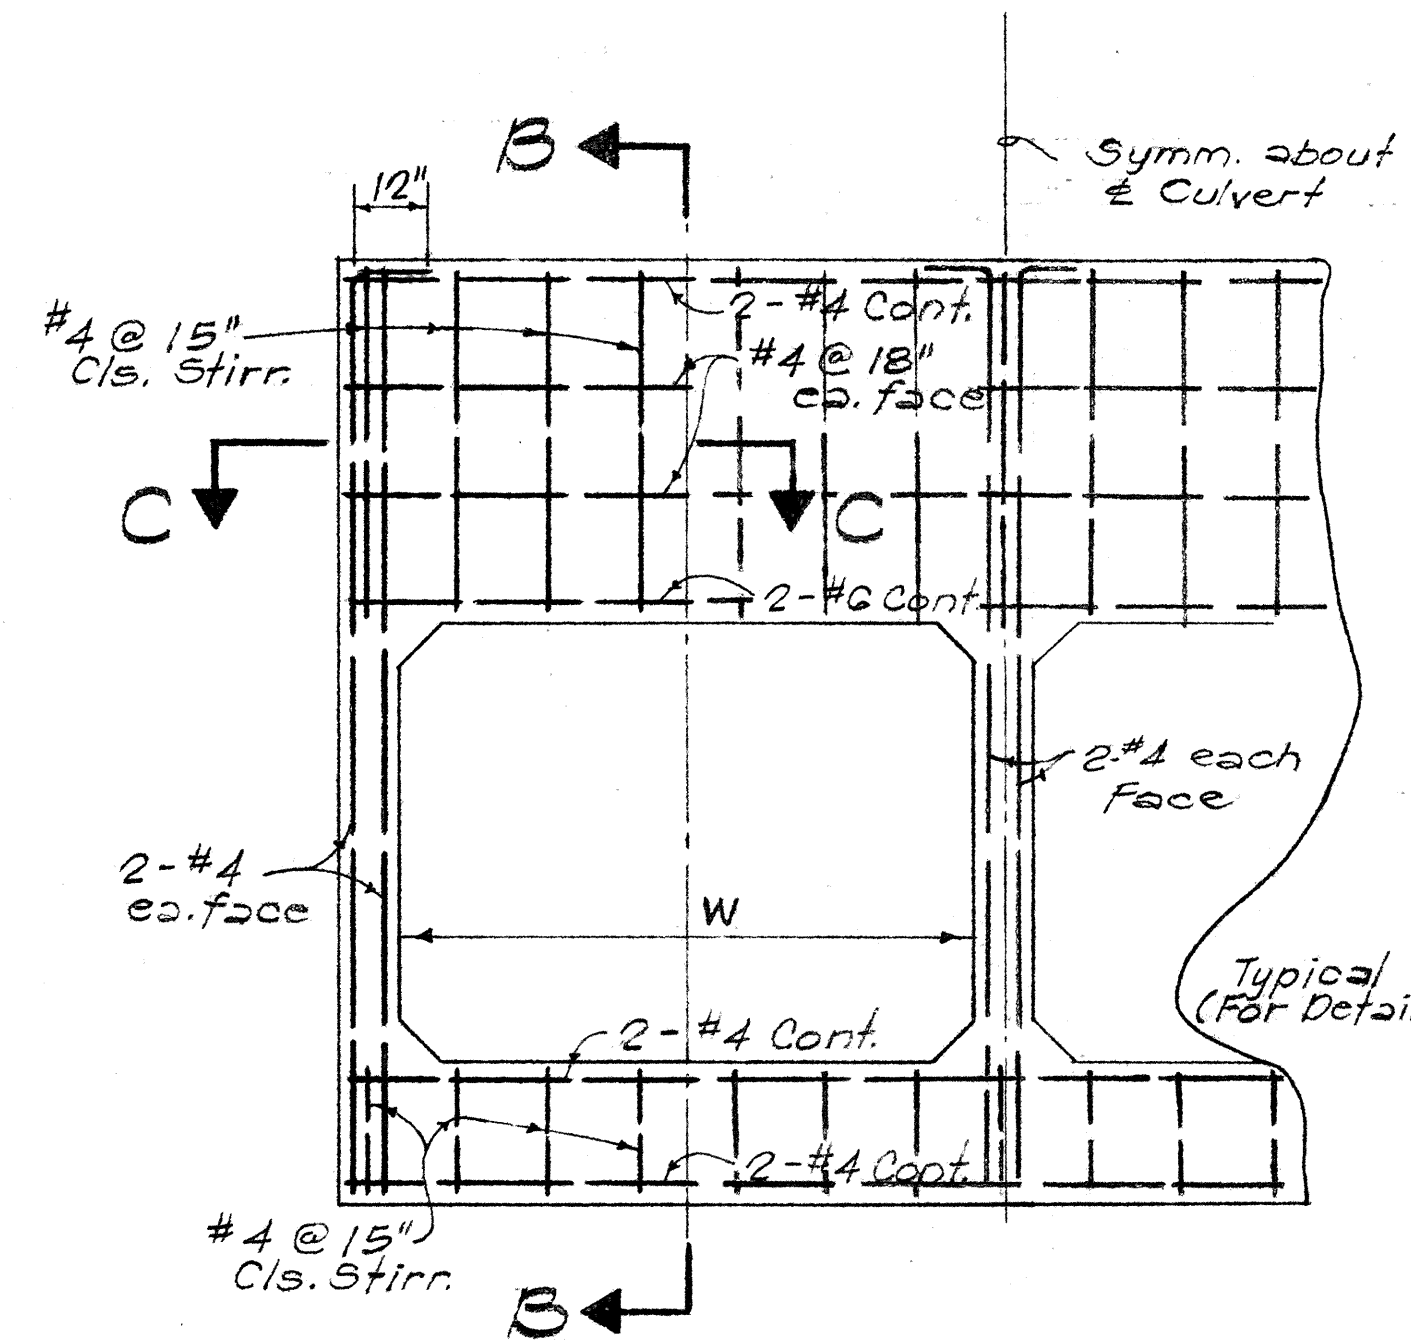

FRONT ELEVATION

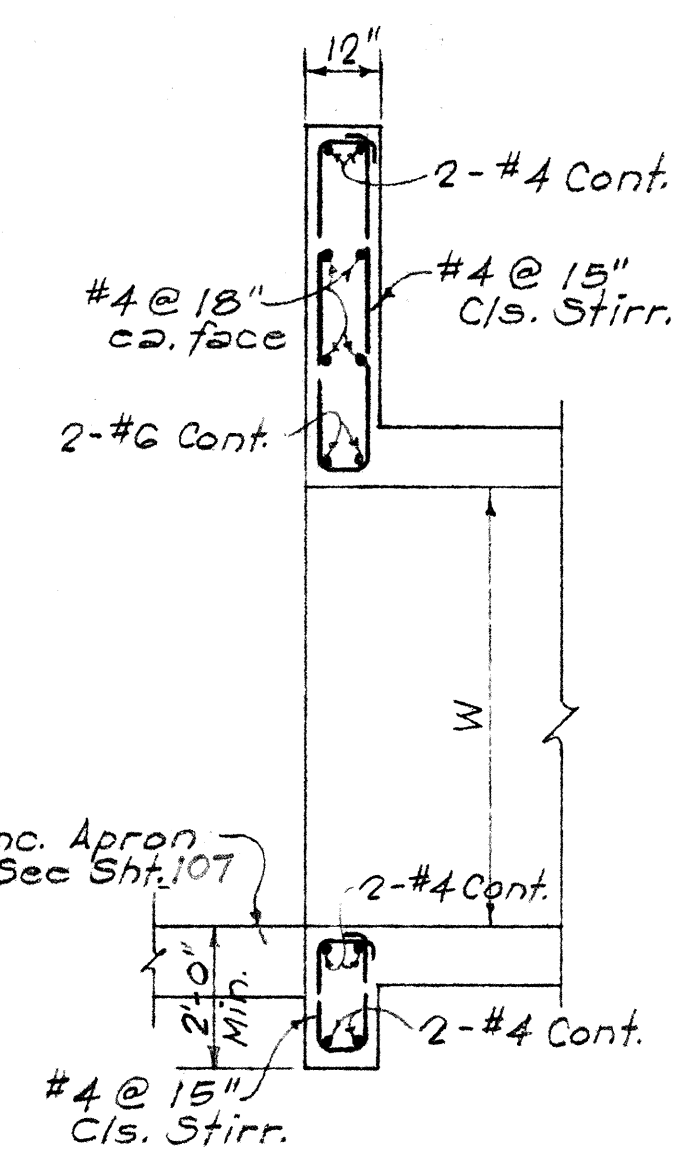


SECTION "B-B"

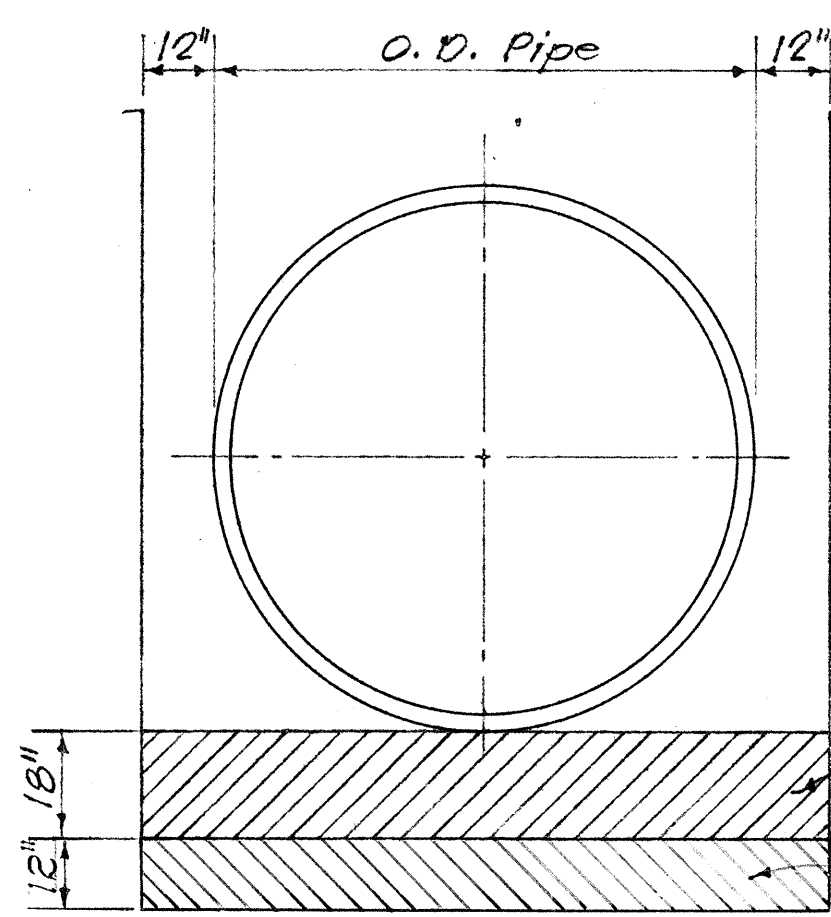


TYPICAL SECTION UNTREATED BASE FOR PIPE FOUNDATION

Scale: 3/8" = 1'-0"

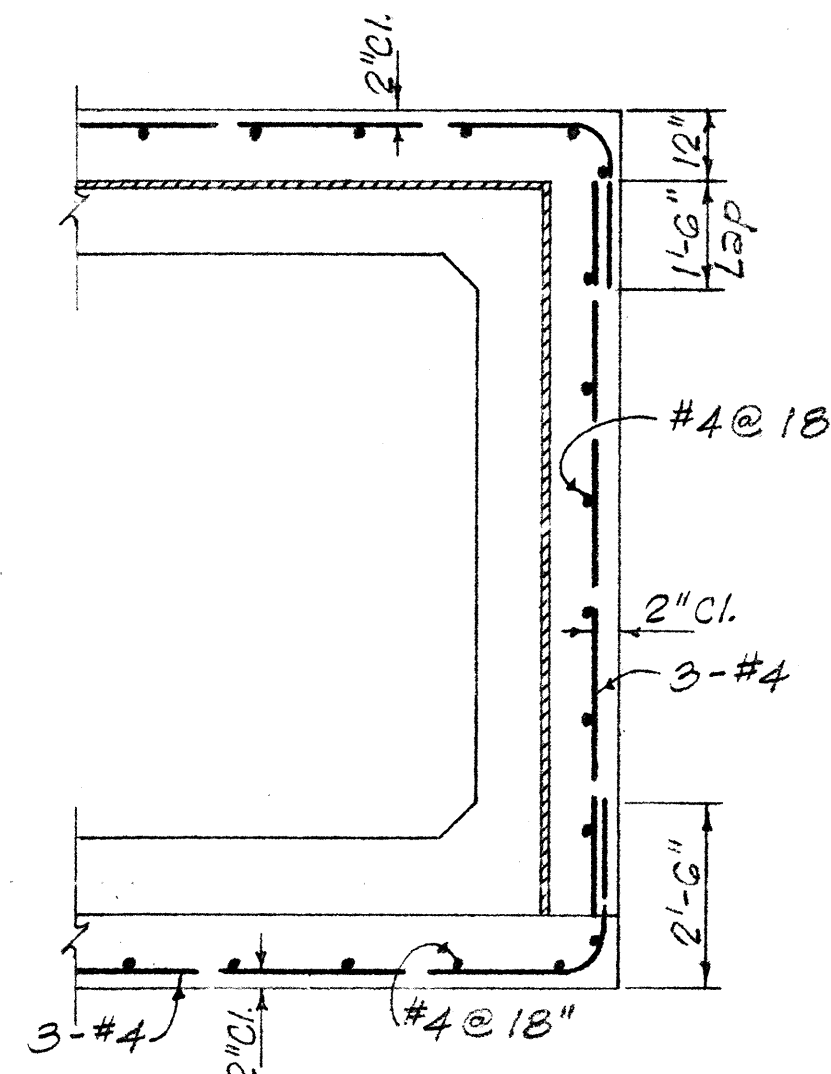


TYPICAL COLLAR DETAIL

Scale: 3/8" = 1'-0"

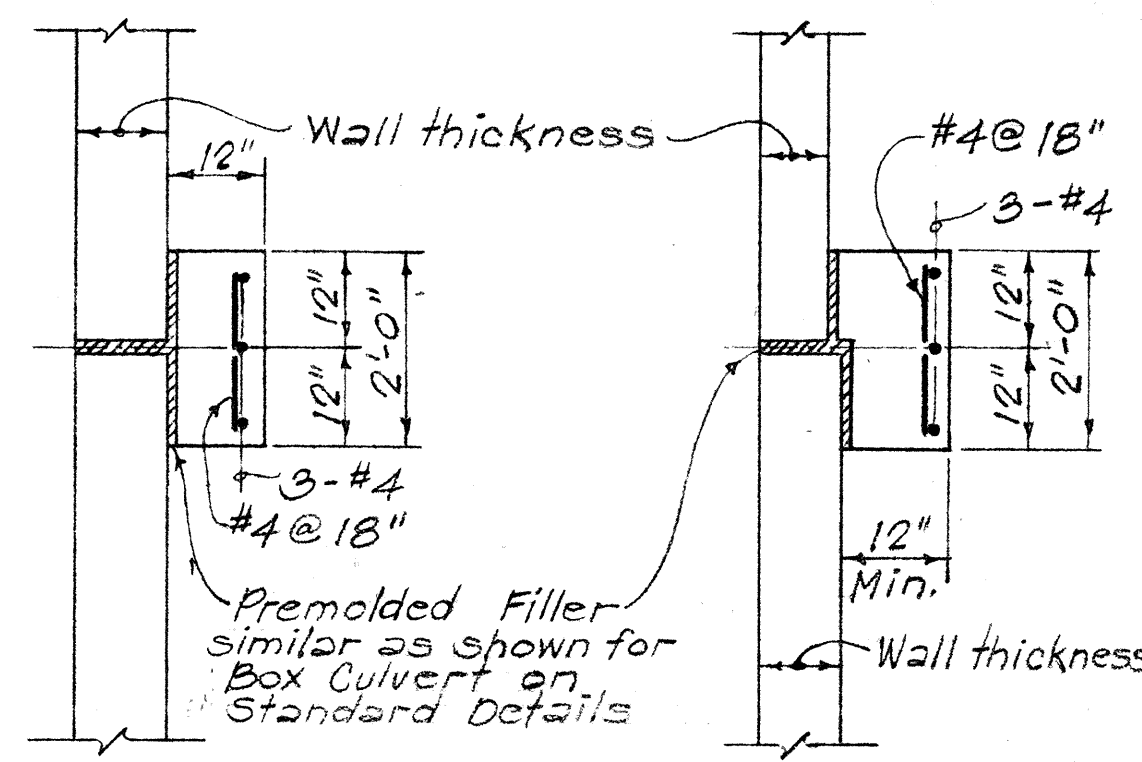

TYPICAL SECTION AT VARYING WALL THICKNESS


Scale: 1/2" = 1'-0"

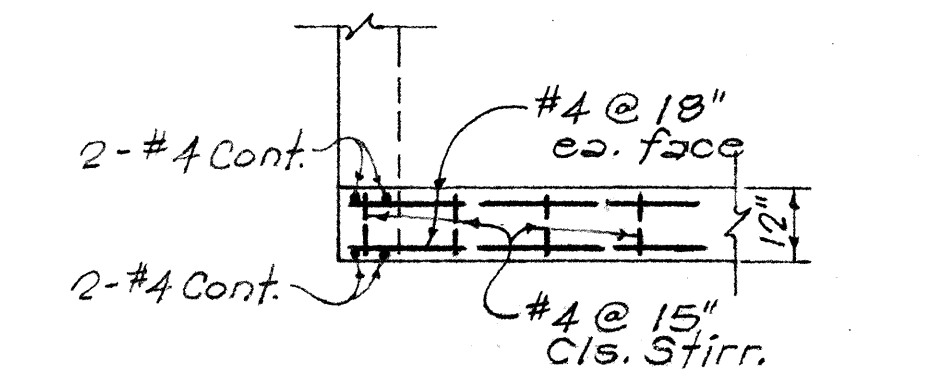

SECTION "C-C"

TYPICAL BOX CULVERT HEADWALL DETAILS

Scale: 3/8" = 1'-0"

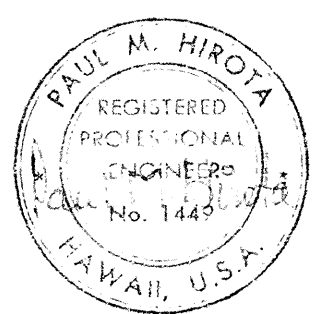


THIS WORK WAS PREPARED BY ME OR UNDER MY SUPERVISION.


STATE OF HAWAII
DEPARTMENT OF TRANSPORTATION
HIGHWAYS DIVISION

TYPICAL CULVERT DETAILS
INTERSTATE ROUTE H-1
PROJ. NO. 1-HI-1(64):12, UNIT 1
Scale: 1" = 50' Date: 8/19/68
SHEET No. 10 OF 20 SHEETS


FED. ROAD DIST. NO.	STATE	FED. AID PROJ. NO.	FISCAL YEAR	SHEET NO.	TOTAL SHEETS
HAWAII	HAW.	1-HH-164-12 Unit 1	1969	107	158

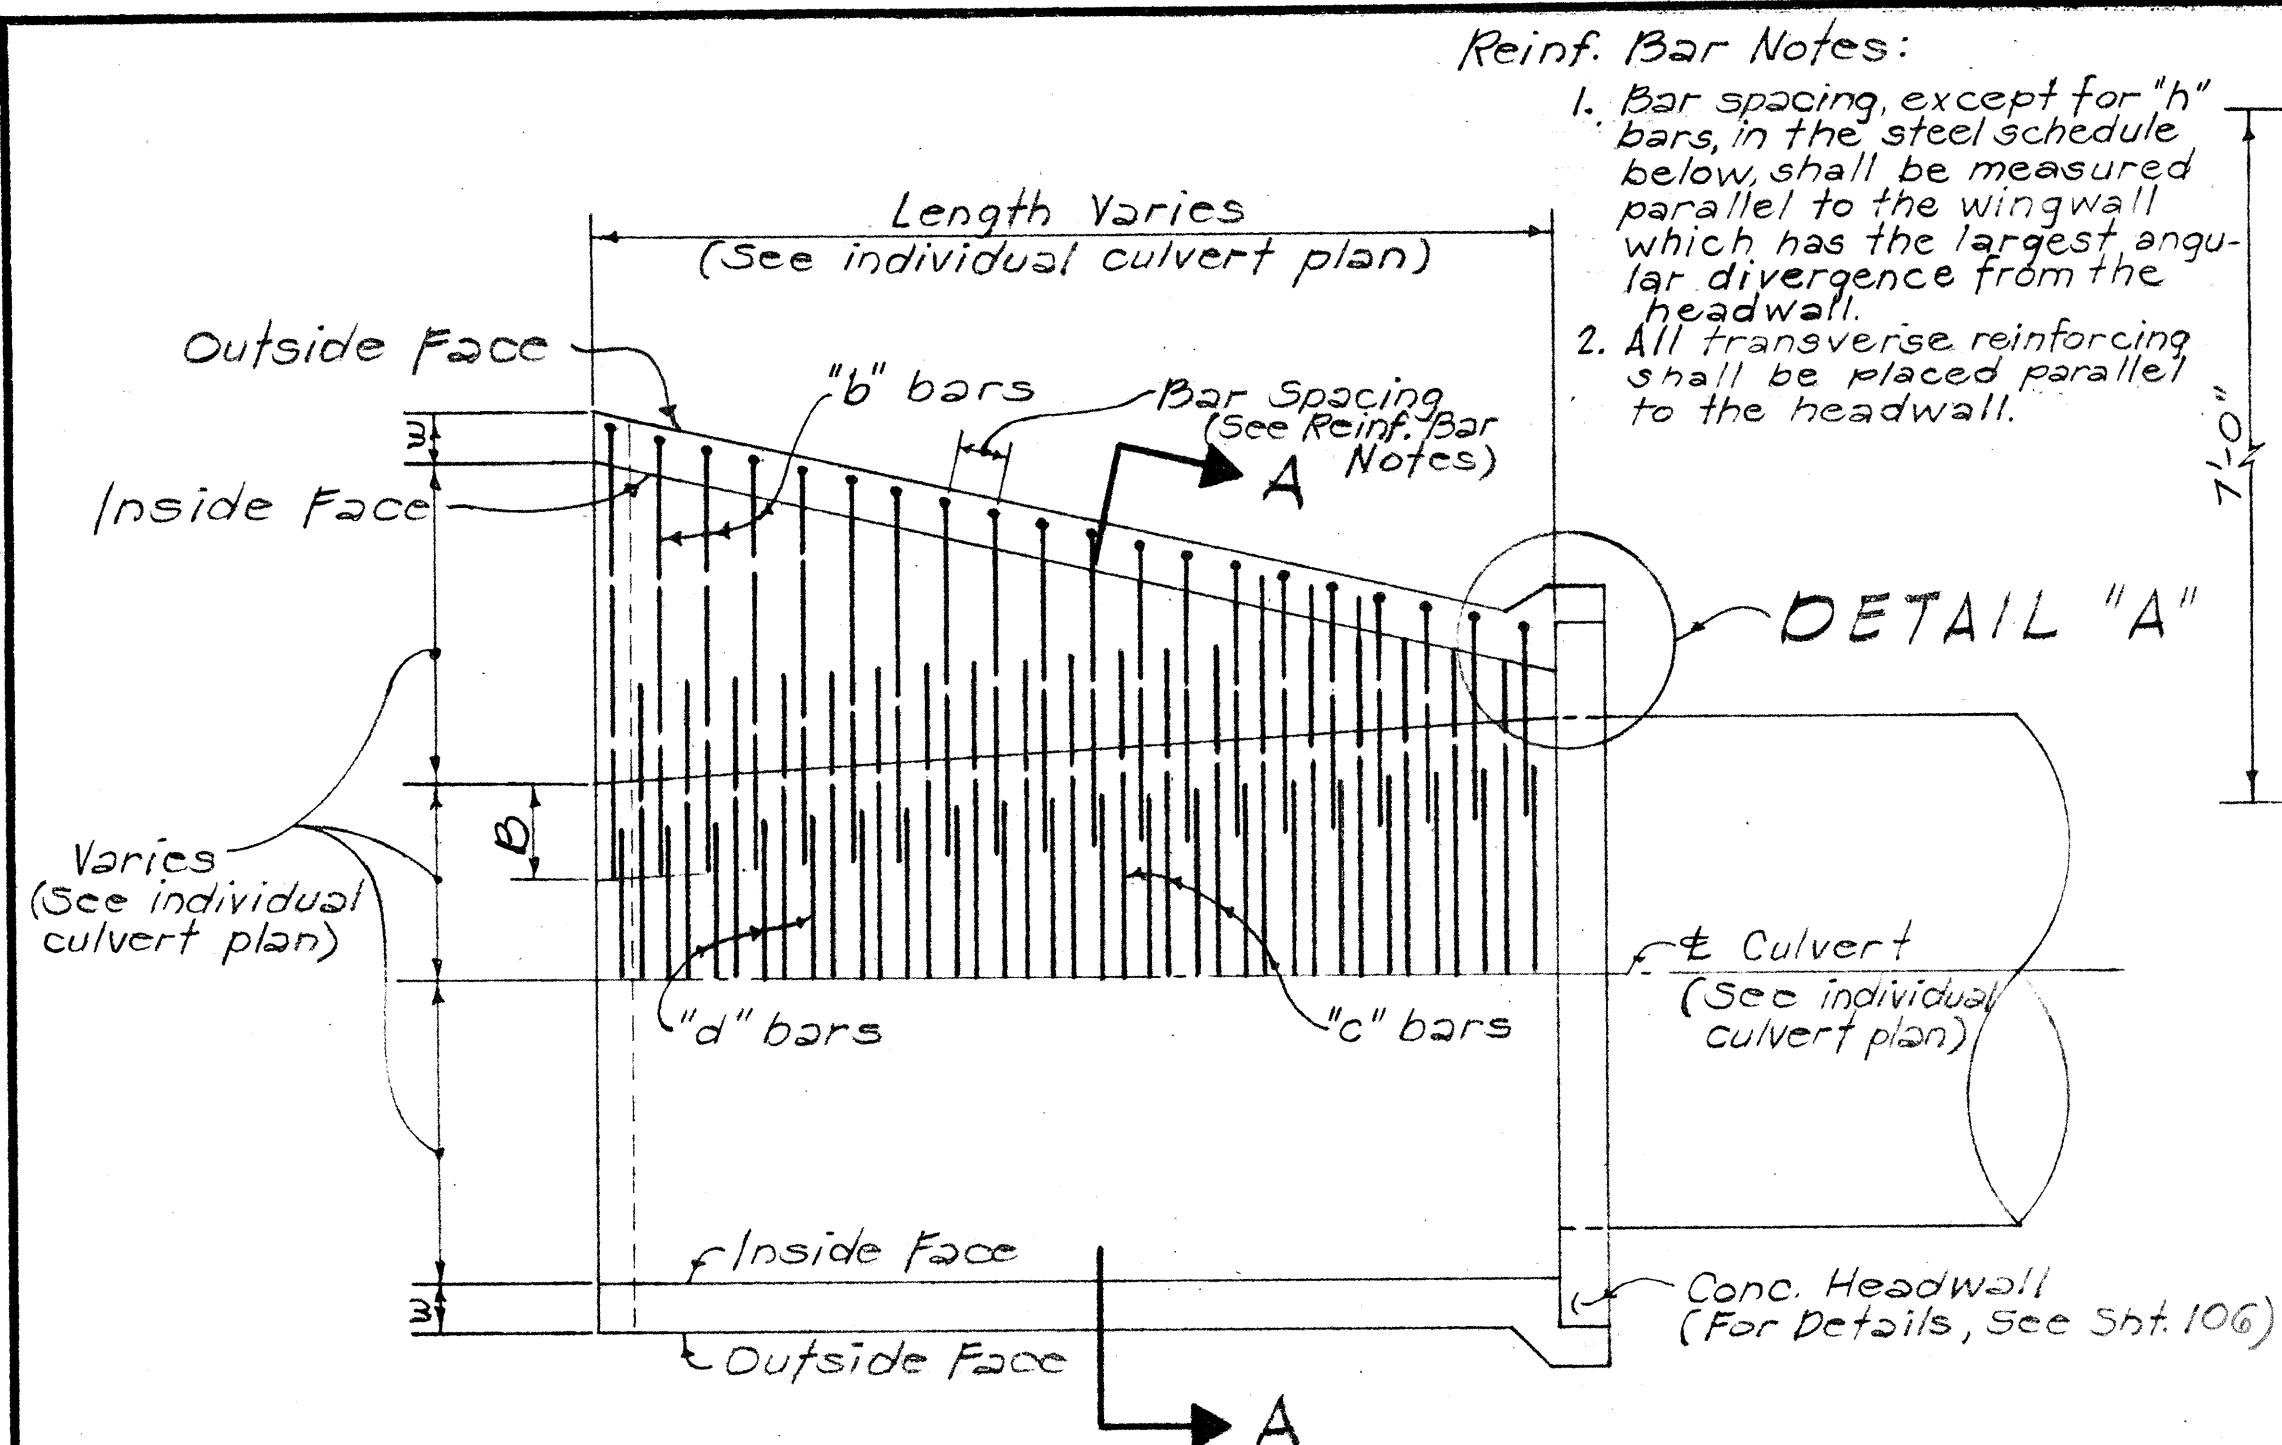

PLAN-TYPICAL CONCRETE APRON
Scale: 1/4" = 1'-0"

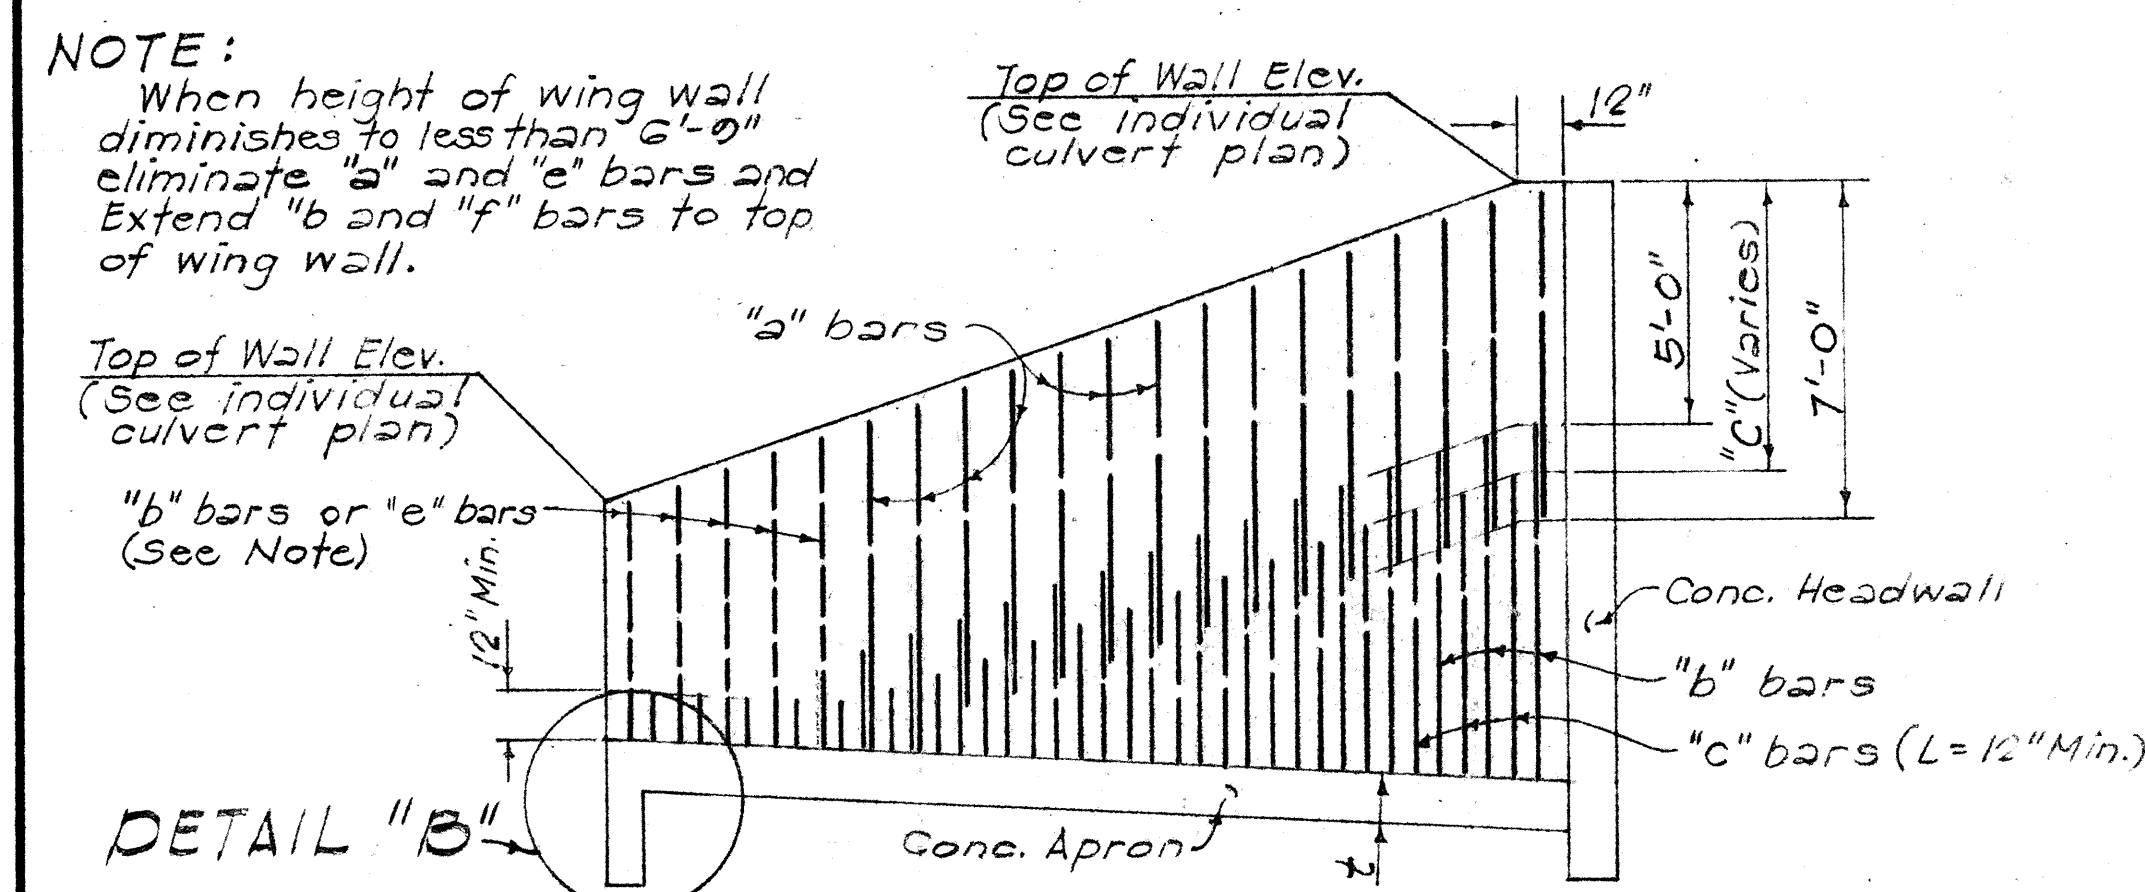

TYPICAL SECTION WING WALL WITH OUTSIDE FACE REINFORCING
Scale: 1/4" = 1'-0"

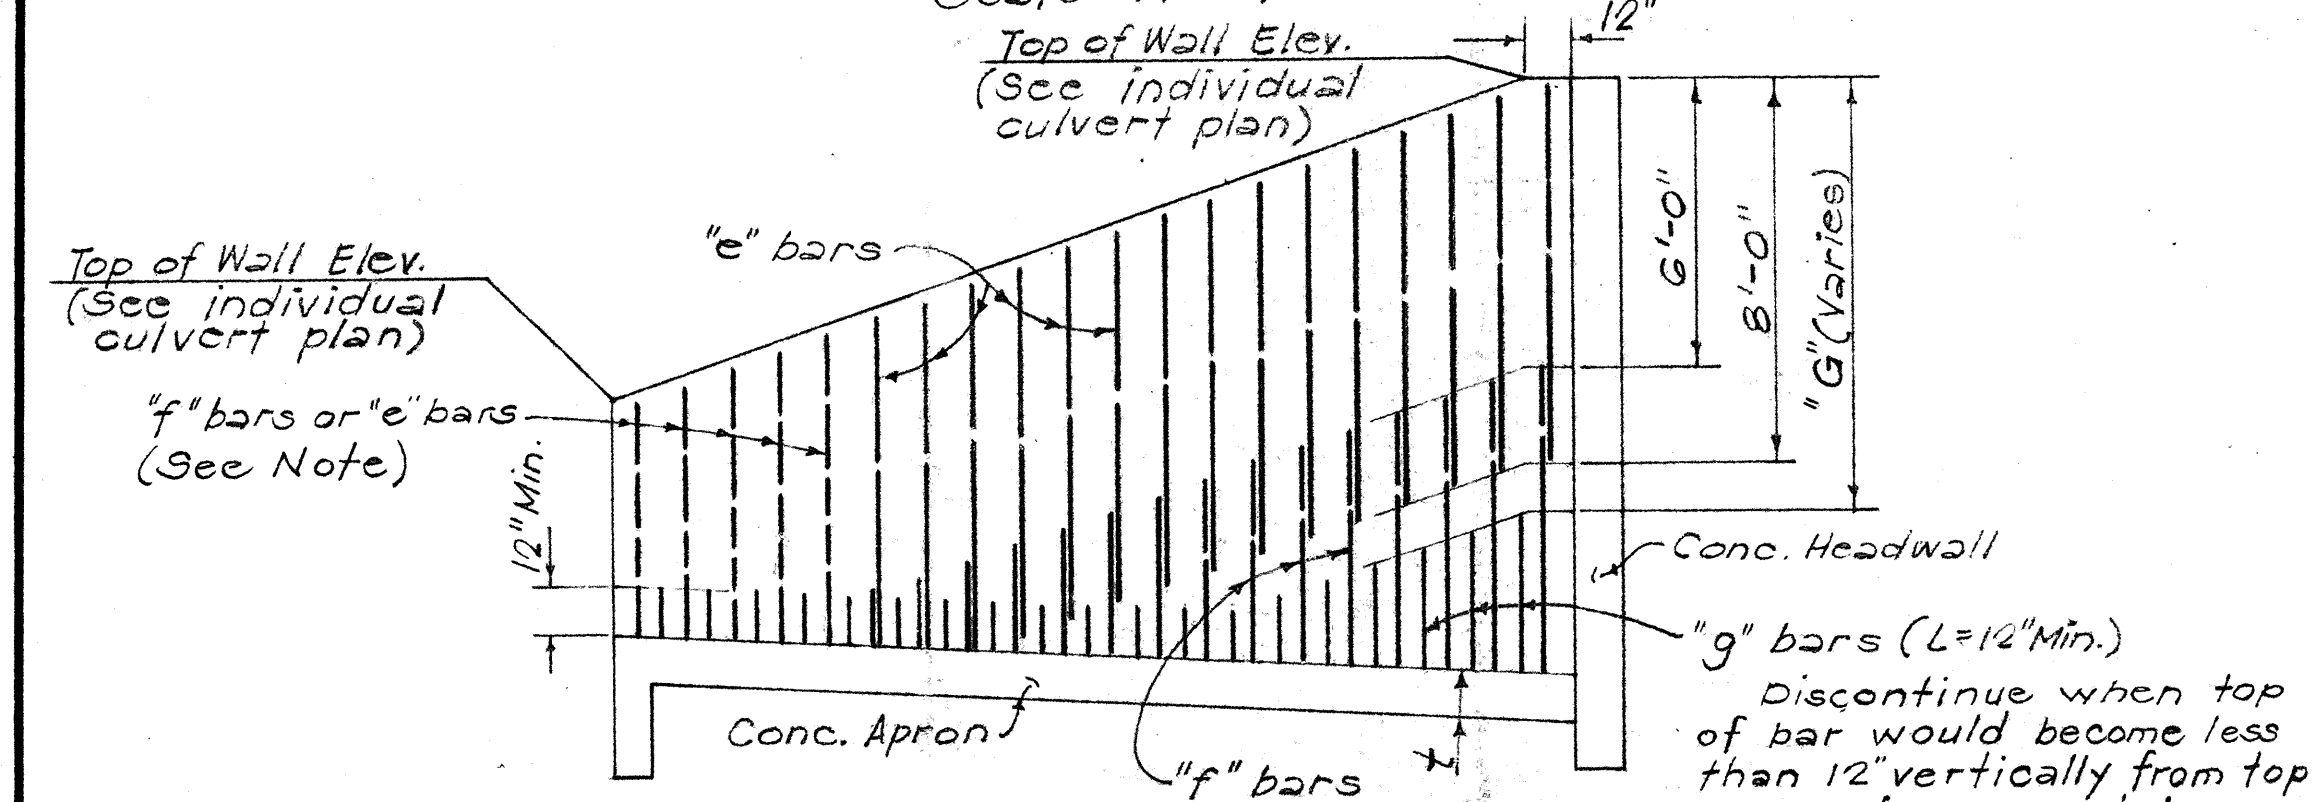


TYPICAL SECTION WING WALL WITH INSIDE FACE REINFORCING
Scale: 1/4" = 1'-0"


TYPICAL END STRUCTURE DETAILS

Reinf. Bar Notes:


1. Bar spacing, except for "h" bars, in the steel schedule below, shall be measured parallel to the wing wall which has the largest angular divergence from the headwall.
2. All transverse reinforcing shall be placed parallel to the headwall.

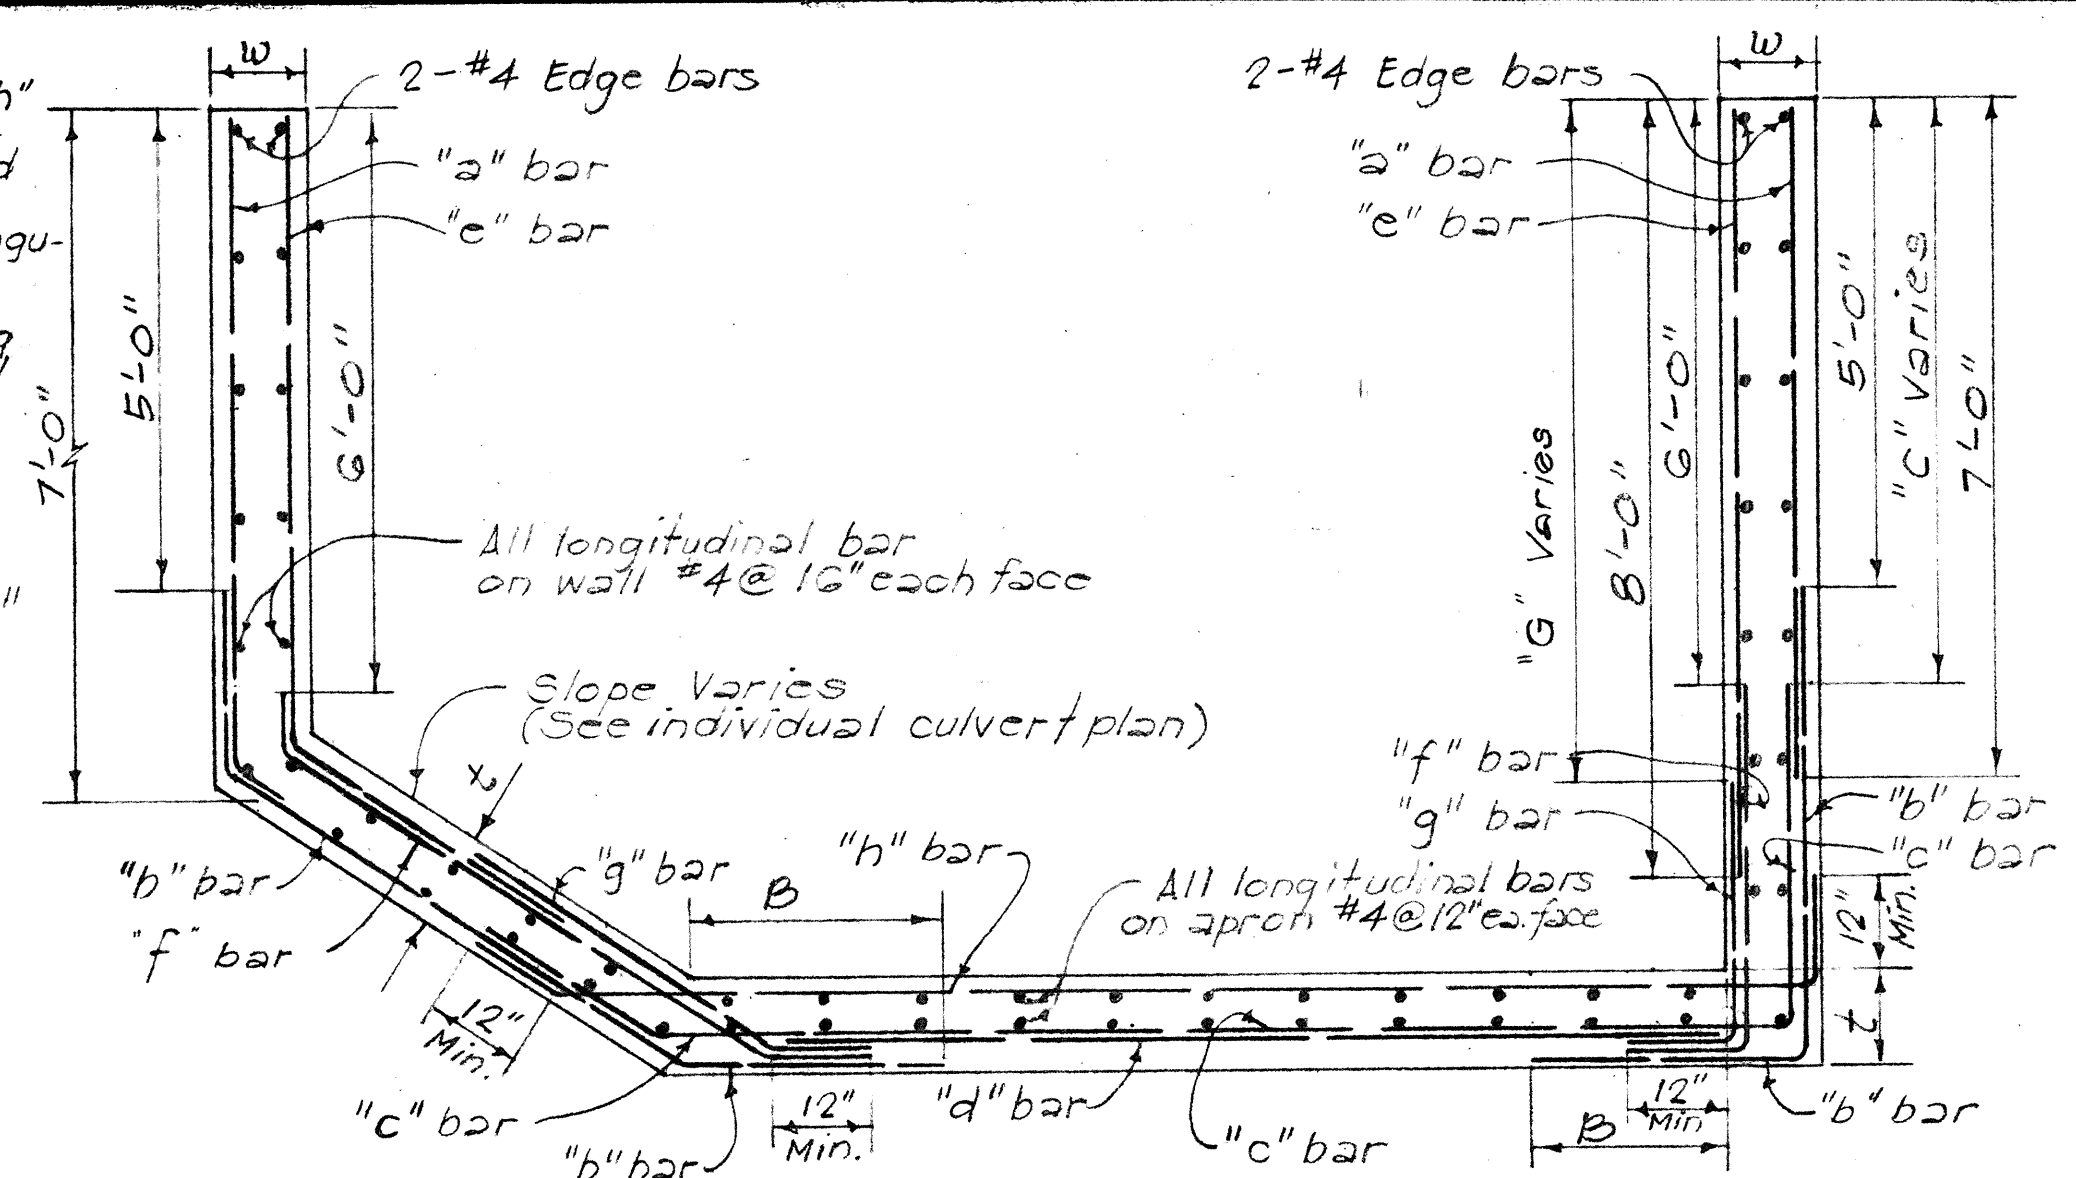

SECTION A-A TYPICAL REINFORCING
Scale: 1/2" = 1'-0"

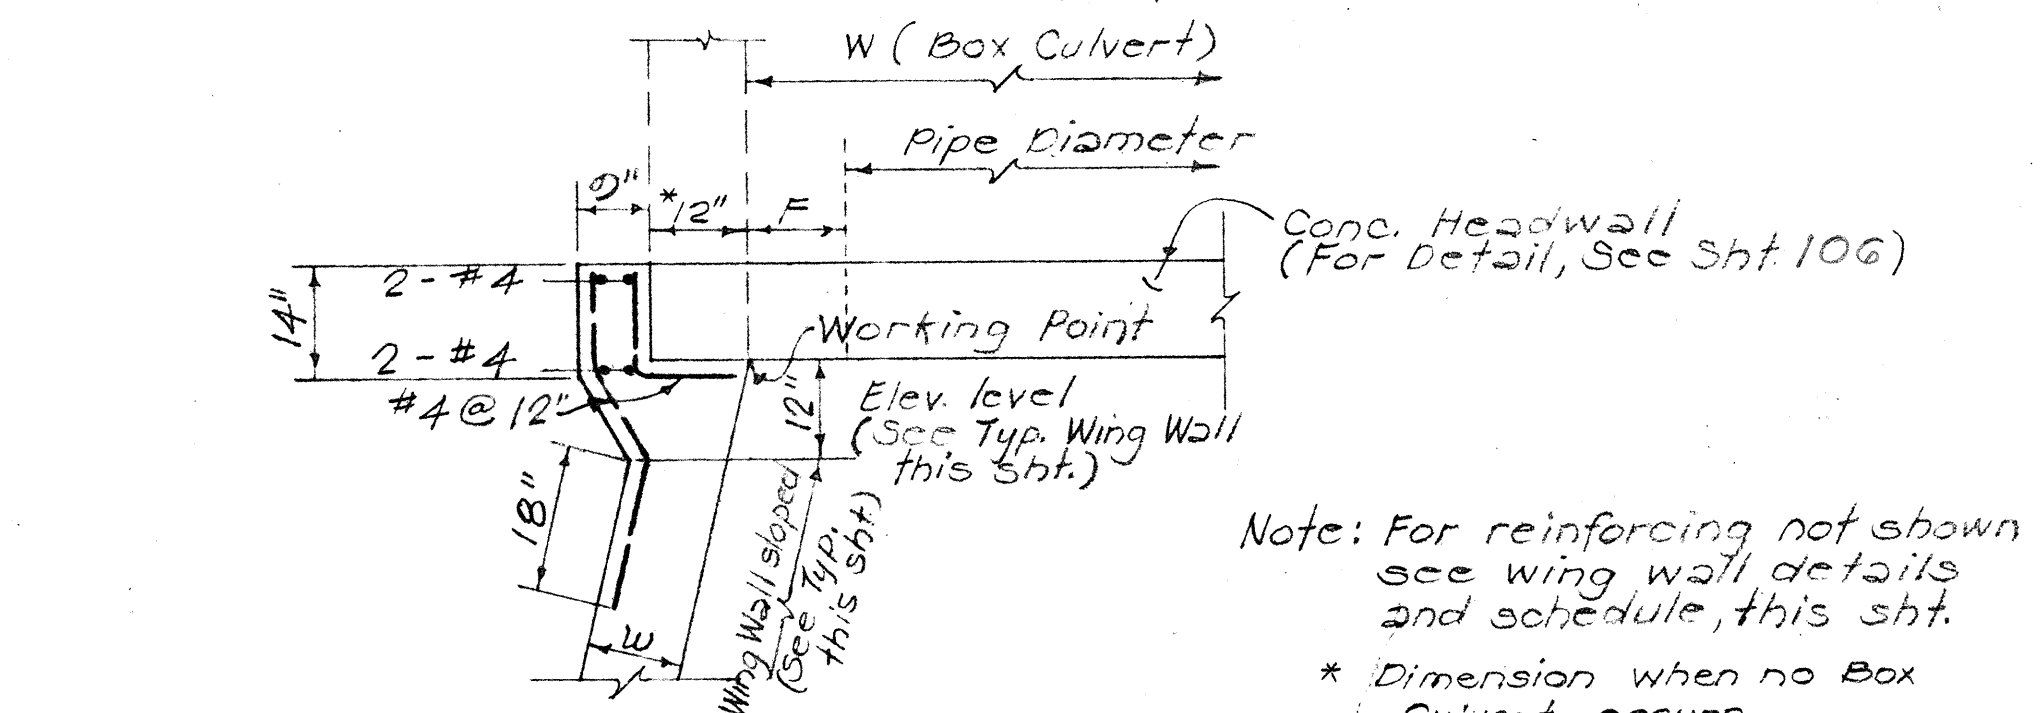


DETAIL A TYPICAL HEADWALL-WING WALL CONNECTION
Scale: 1/2" = 1'-0"

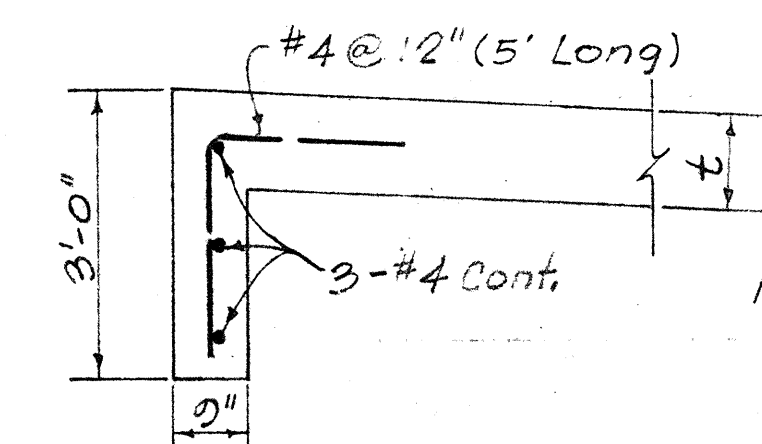


DETAIL B TYPICAL APRON CUT OFF WALL
Scale: 1/2" = 1'-0"


STEEL SCHEDULE					
Item	Pipe Culvert @ Sta. 183+00	Pipe Culvert @ Sta. 167+13	Pipe Culvert @ Sta. 148+08		
	Outlet	Inlet	Outlet	Inlet	Outlet
w	12"	12"	14"	0"	0"
t	14"	15"	16"	10"	10"
"a" bar	#4 @ 12"	#4 @ 12"	#4 @ 12"	#4 @ 12"	#4 @ 12"
"b" bar	#7 @ 12"	#7 @ 12"	#7 @ 12"	#5 @ 12"	#5 @ 12"
"c" bar	#7 @ 12"	#7 @ 12"	#7 @ 12"	#6 @ 12"	#6 @ 12"
"d" bar	#5 @ 12"				
"e" bar	#4 @ 12"	#4 @ 12"	#4 @ 12"	#4 @ 12"	#4 @ 12"
"f" bar	#6 @ 12"	#5 @ 12"	#6 @ 12"	#5 @ 12"	#5 @ 12"
"g" bar	#7 @ 12"	#6 @ 12"	#7 @ 12"		
"h" bar	#7 @ 6"	#7 @ 6"	#8 @ 6"	#5 @ 6"	#6 @ 12"
"B"	2'-0"	3'-6"	5'-0"	3'-6"	3'-6"
"C"	2'-0"	0'-0"	10'-0"	6'-0"	6'-0"
"G"	2'-0"	0'-0"	0'-0"		
"F"	1'-0"	1'-0"	1'-0"	1'-0"	1'-0"

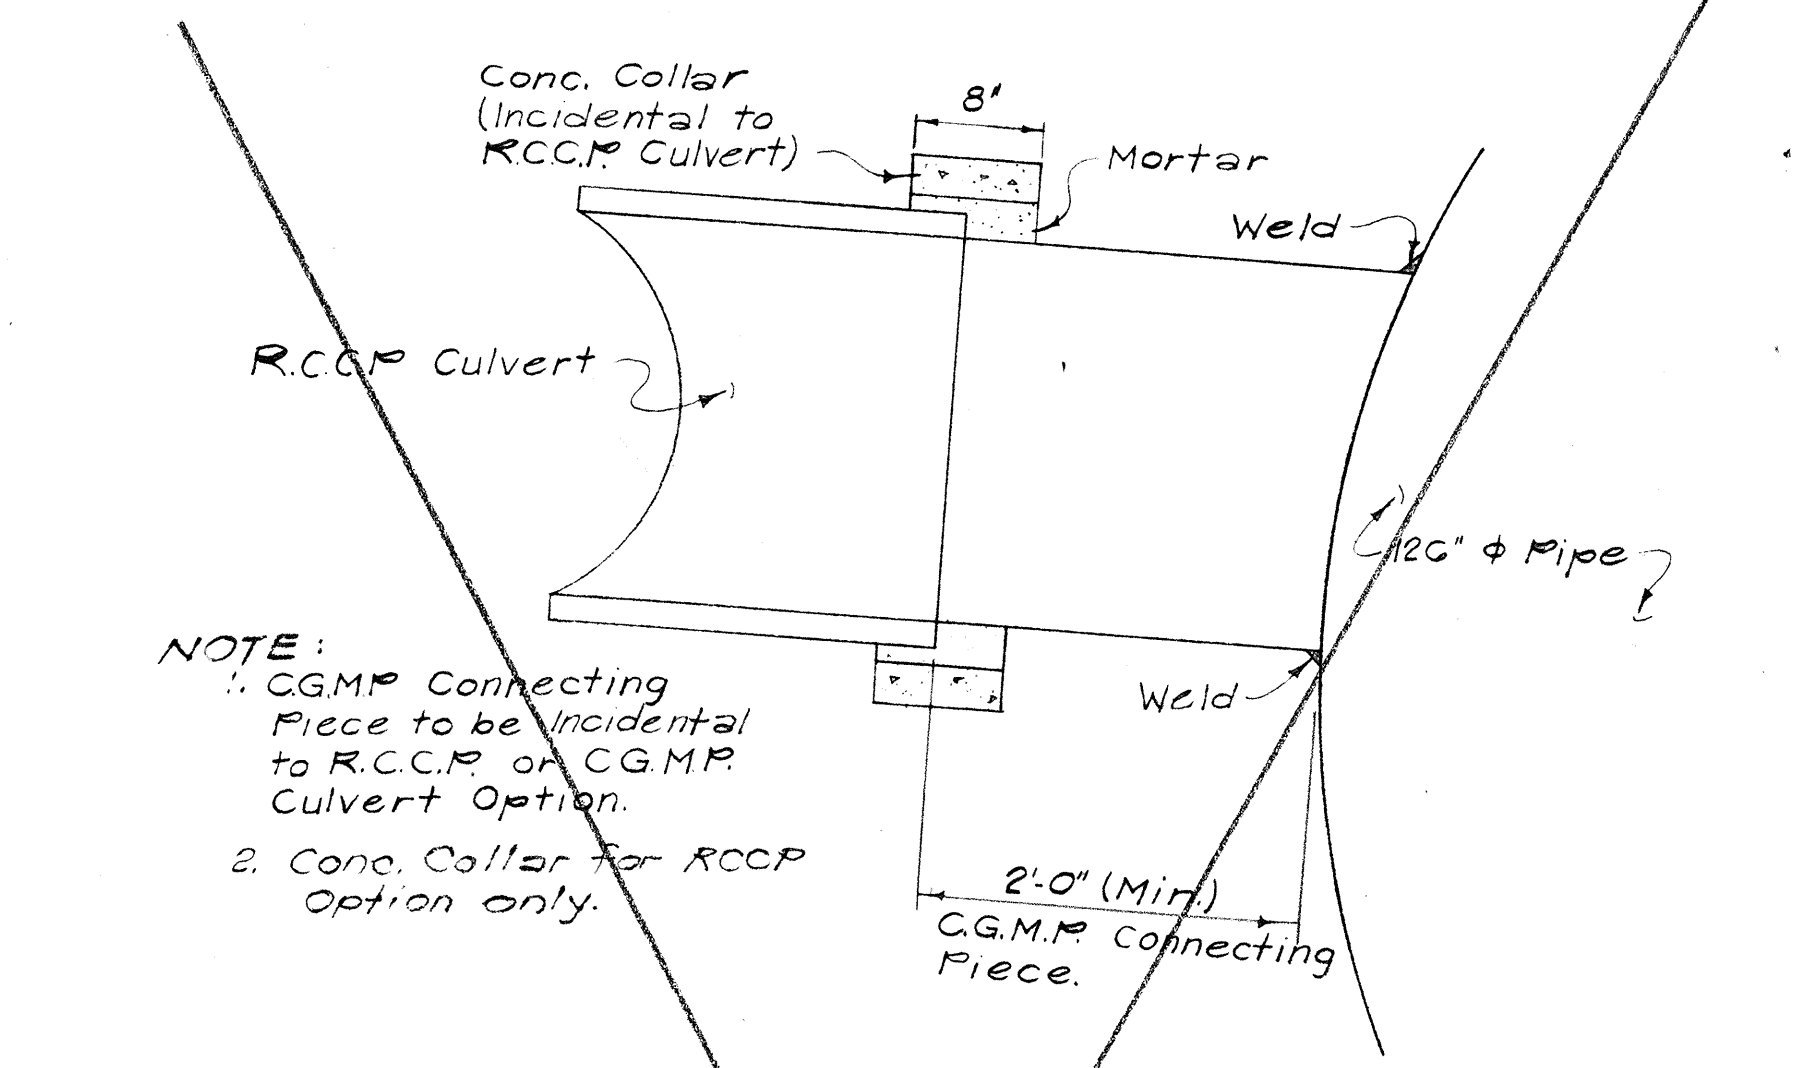

TYPICAL DETAIL OF RCCP OR CGMP CULVERT CONNECTION TO 126\"/>

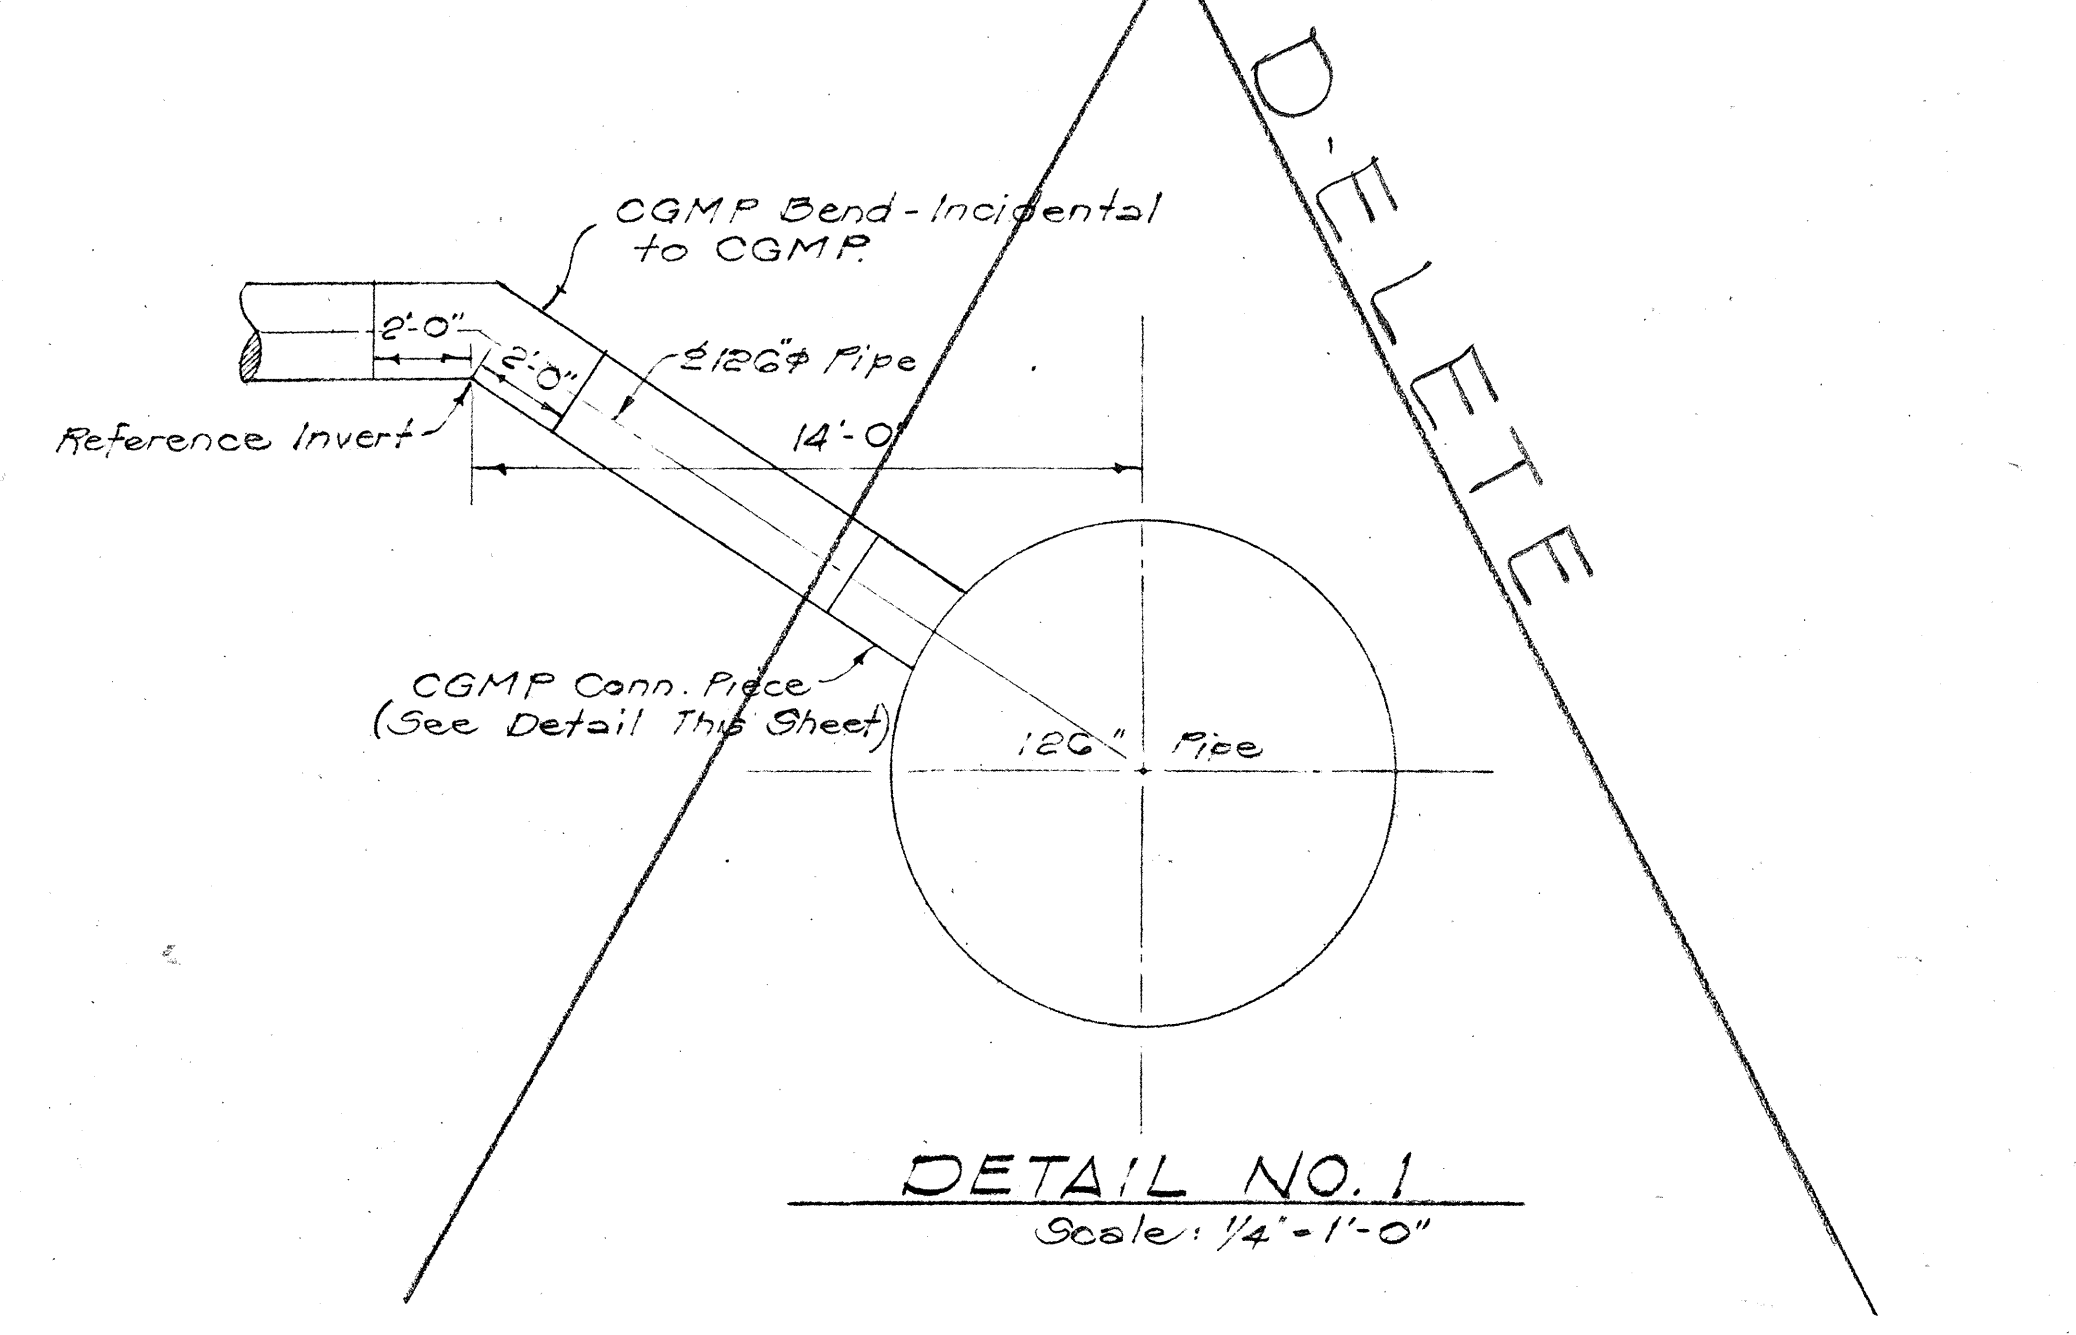

DETAIL NO. 1
Scale: 1/4" = 1'-0"

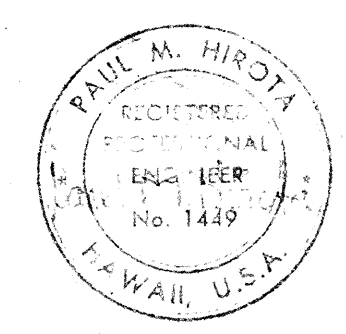

THIS WORK WAS PREPARED BY ME OR UNDER MY SUPERVISION.

STATE OF HAWAII
DEPARTMENT OF TRANSPORTATION
HIGHWAYS DIVISION

TYPICAL CULVERT DETAILS

INTERSTATE ROUTE H-1
PROJ. NO. I-HH-164-12, UNIT 1
Scale: 1" = 50' Date: 8/19/68
SHEET No. 20 OF 20 SHEETS