
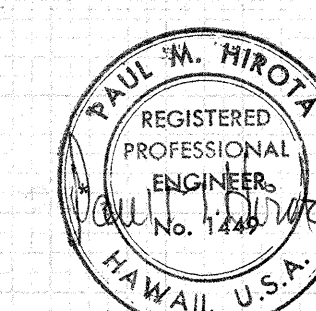


I-HI-1(16):

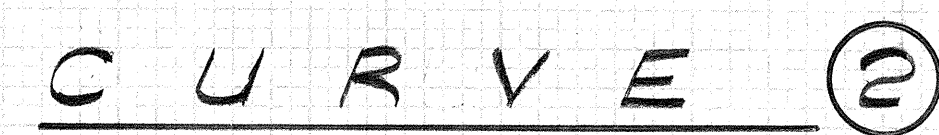

STATE OF HAWAII
DEPARTMENT OF TRANSPORTATION
HIGHWAYS DIVISION

INTERSTATE ROUTE 4-1
PROJ. NO. I-HI-1(64)12
UNIT 1

Scale: As Shown Date: 8/12/08
SHEET No. 1 OF 1 SHEETS