


FED. ROAD DIST. NO.	STATE	FED. AID PROJ. NO.	FISCAL YEAR	SHEET NO.	TOTAL SHEETS
HAWAII	HAW	I-HH(64)12 Unit 2	1969	124	128


FED. ROAD DIST. NO.	STATE	FED. AID PROJ. NO.	FISCAL YEAR	SHEET NO.	TOTAL SHEETS
HAWAII	HAW	I-HH(64)12 Unit 2	1969	124	128

FED. ROAD DIST. NO.	STATE	FED. AID PROJ. NO.	FISCAL YEAR	SHEET NO.	TOTAL SHEETS
HAWAII	HAW	I-HH(64)12 Unit 2	1969	124	128

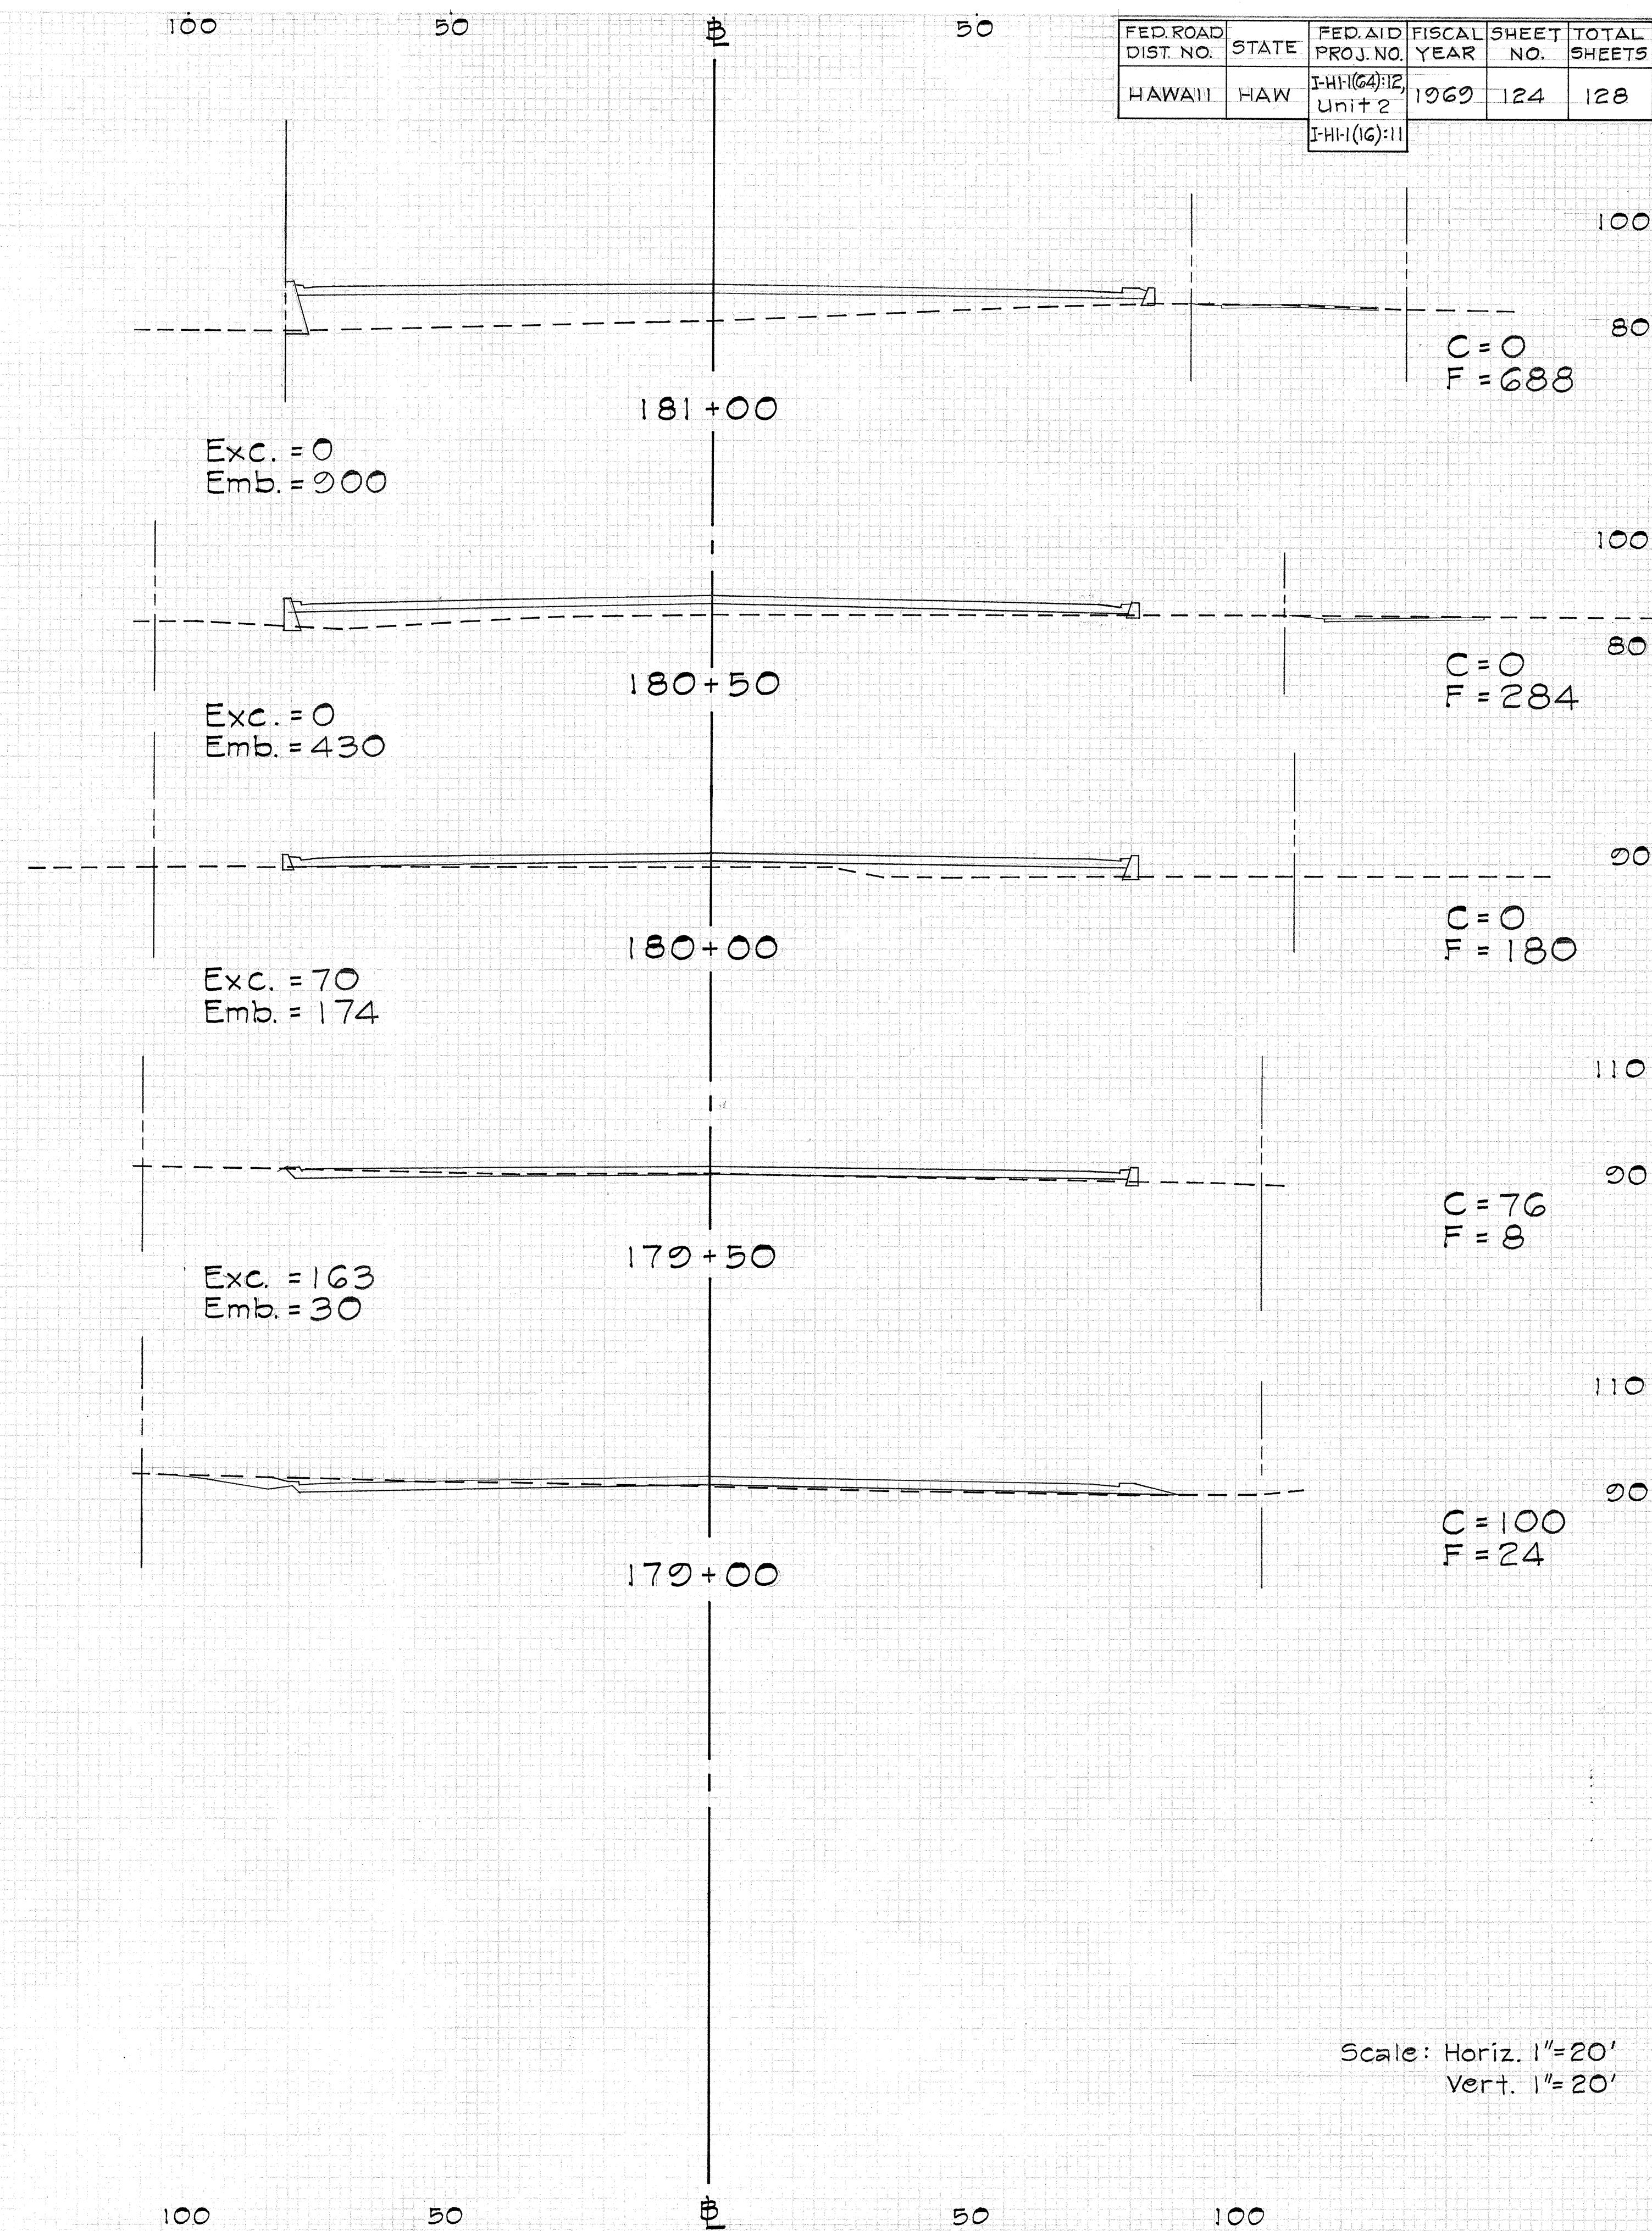



Scale: Horiz. 1"=20'
Vert. 1"=20'

FED. ROAD DIST. NO.	STATE	FED. AID PROJ. NO.	FISCAL YEAR	SHEET NO.	TOTAL SHEETS
HAWAII	HAW.	I-HI-1(64)18 Unit 2	1969	125	128
I-HI-1(16)11					

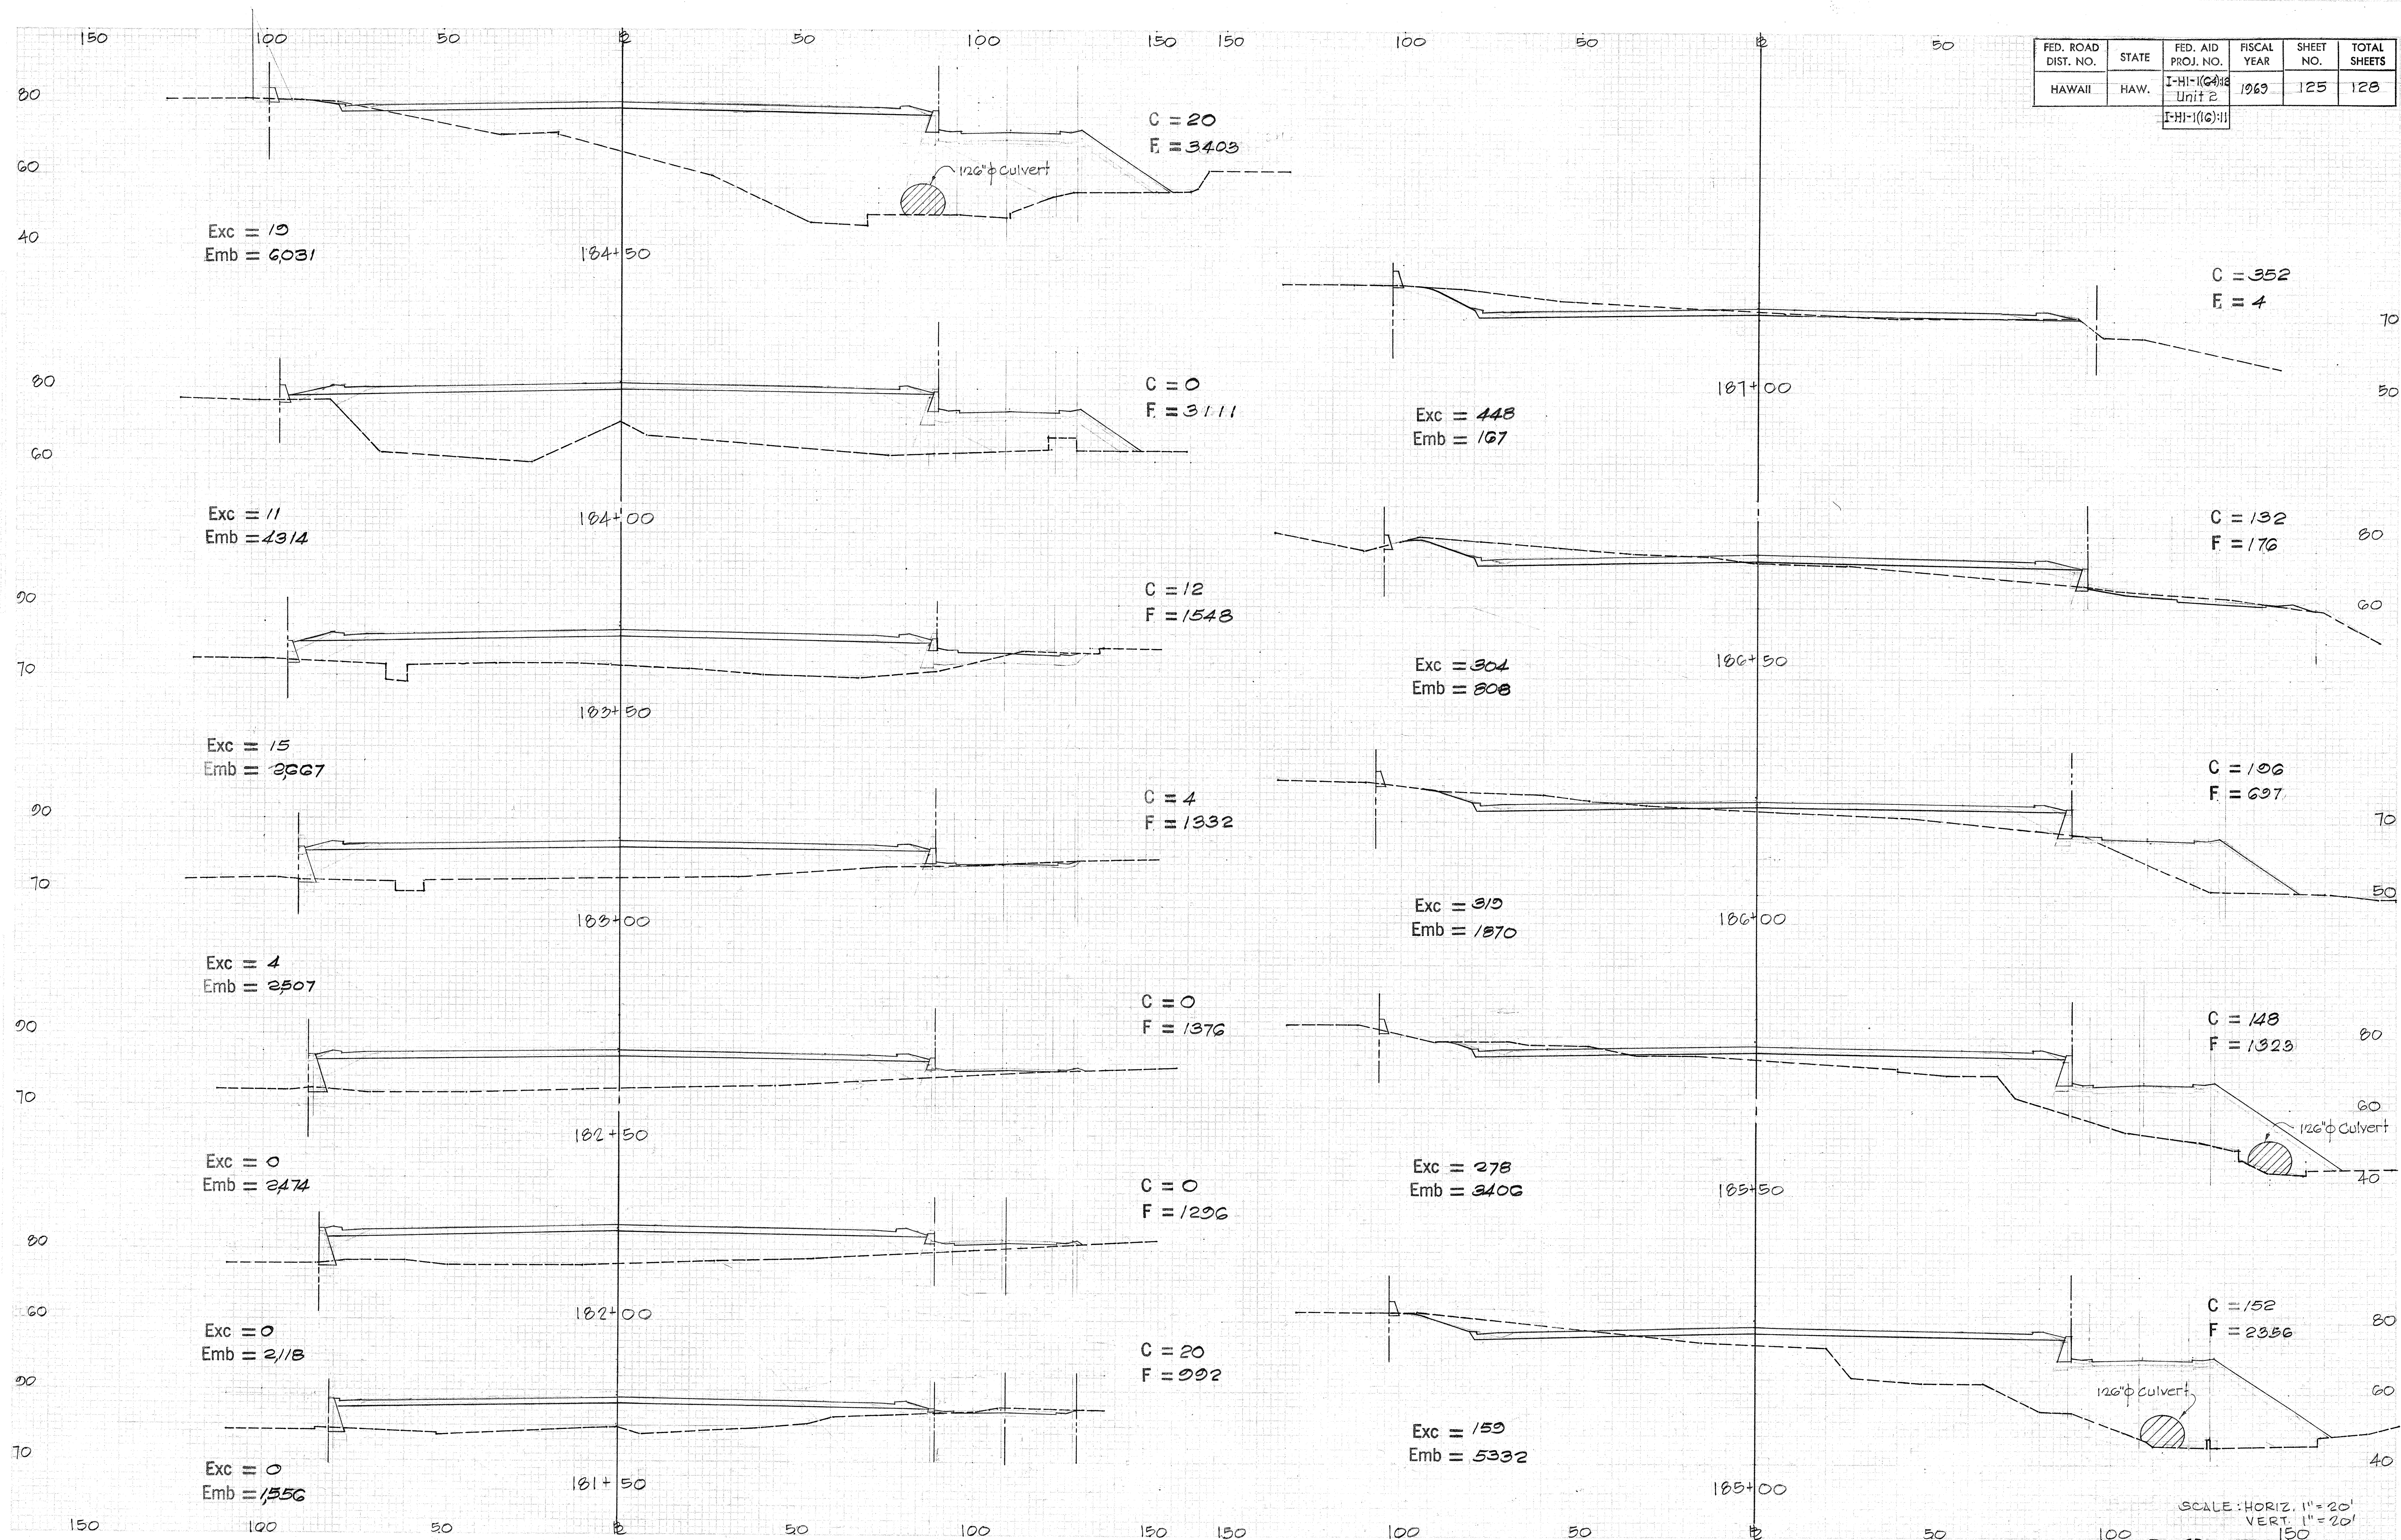


SCALE: HORIZ. 1" = 20'
VERT. 1" = 20'

FED. ROAD DIST. NO.	STATE	FED. AID PROJ. NO.	FISCAL YEAR	SHEET NO.	TOTAL SHEETS
HAWAII	HAW.	HA-1(64)12, Unit 2	1969	126	128

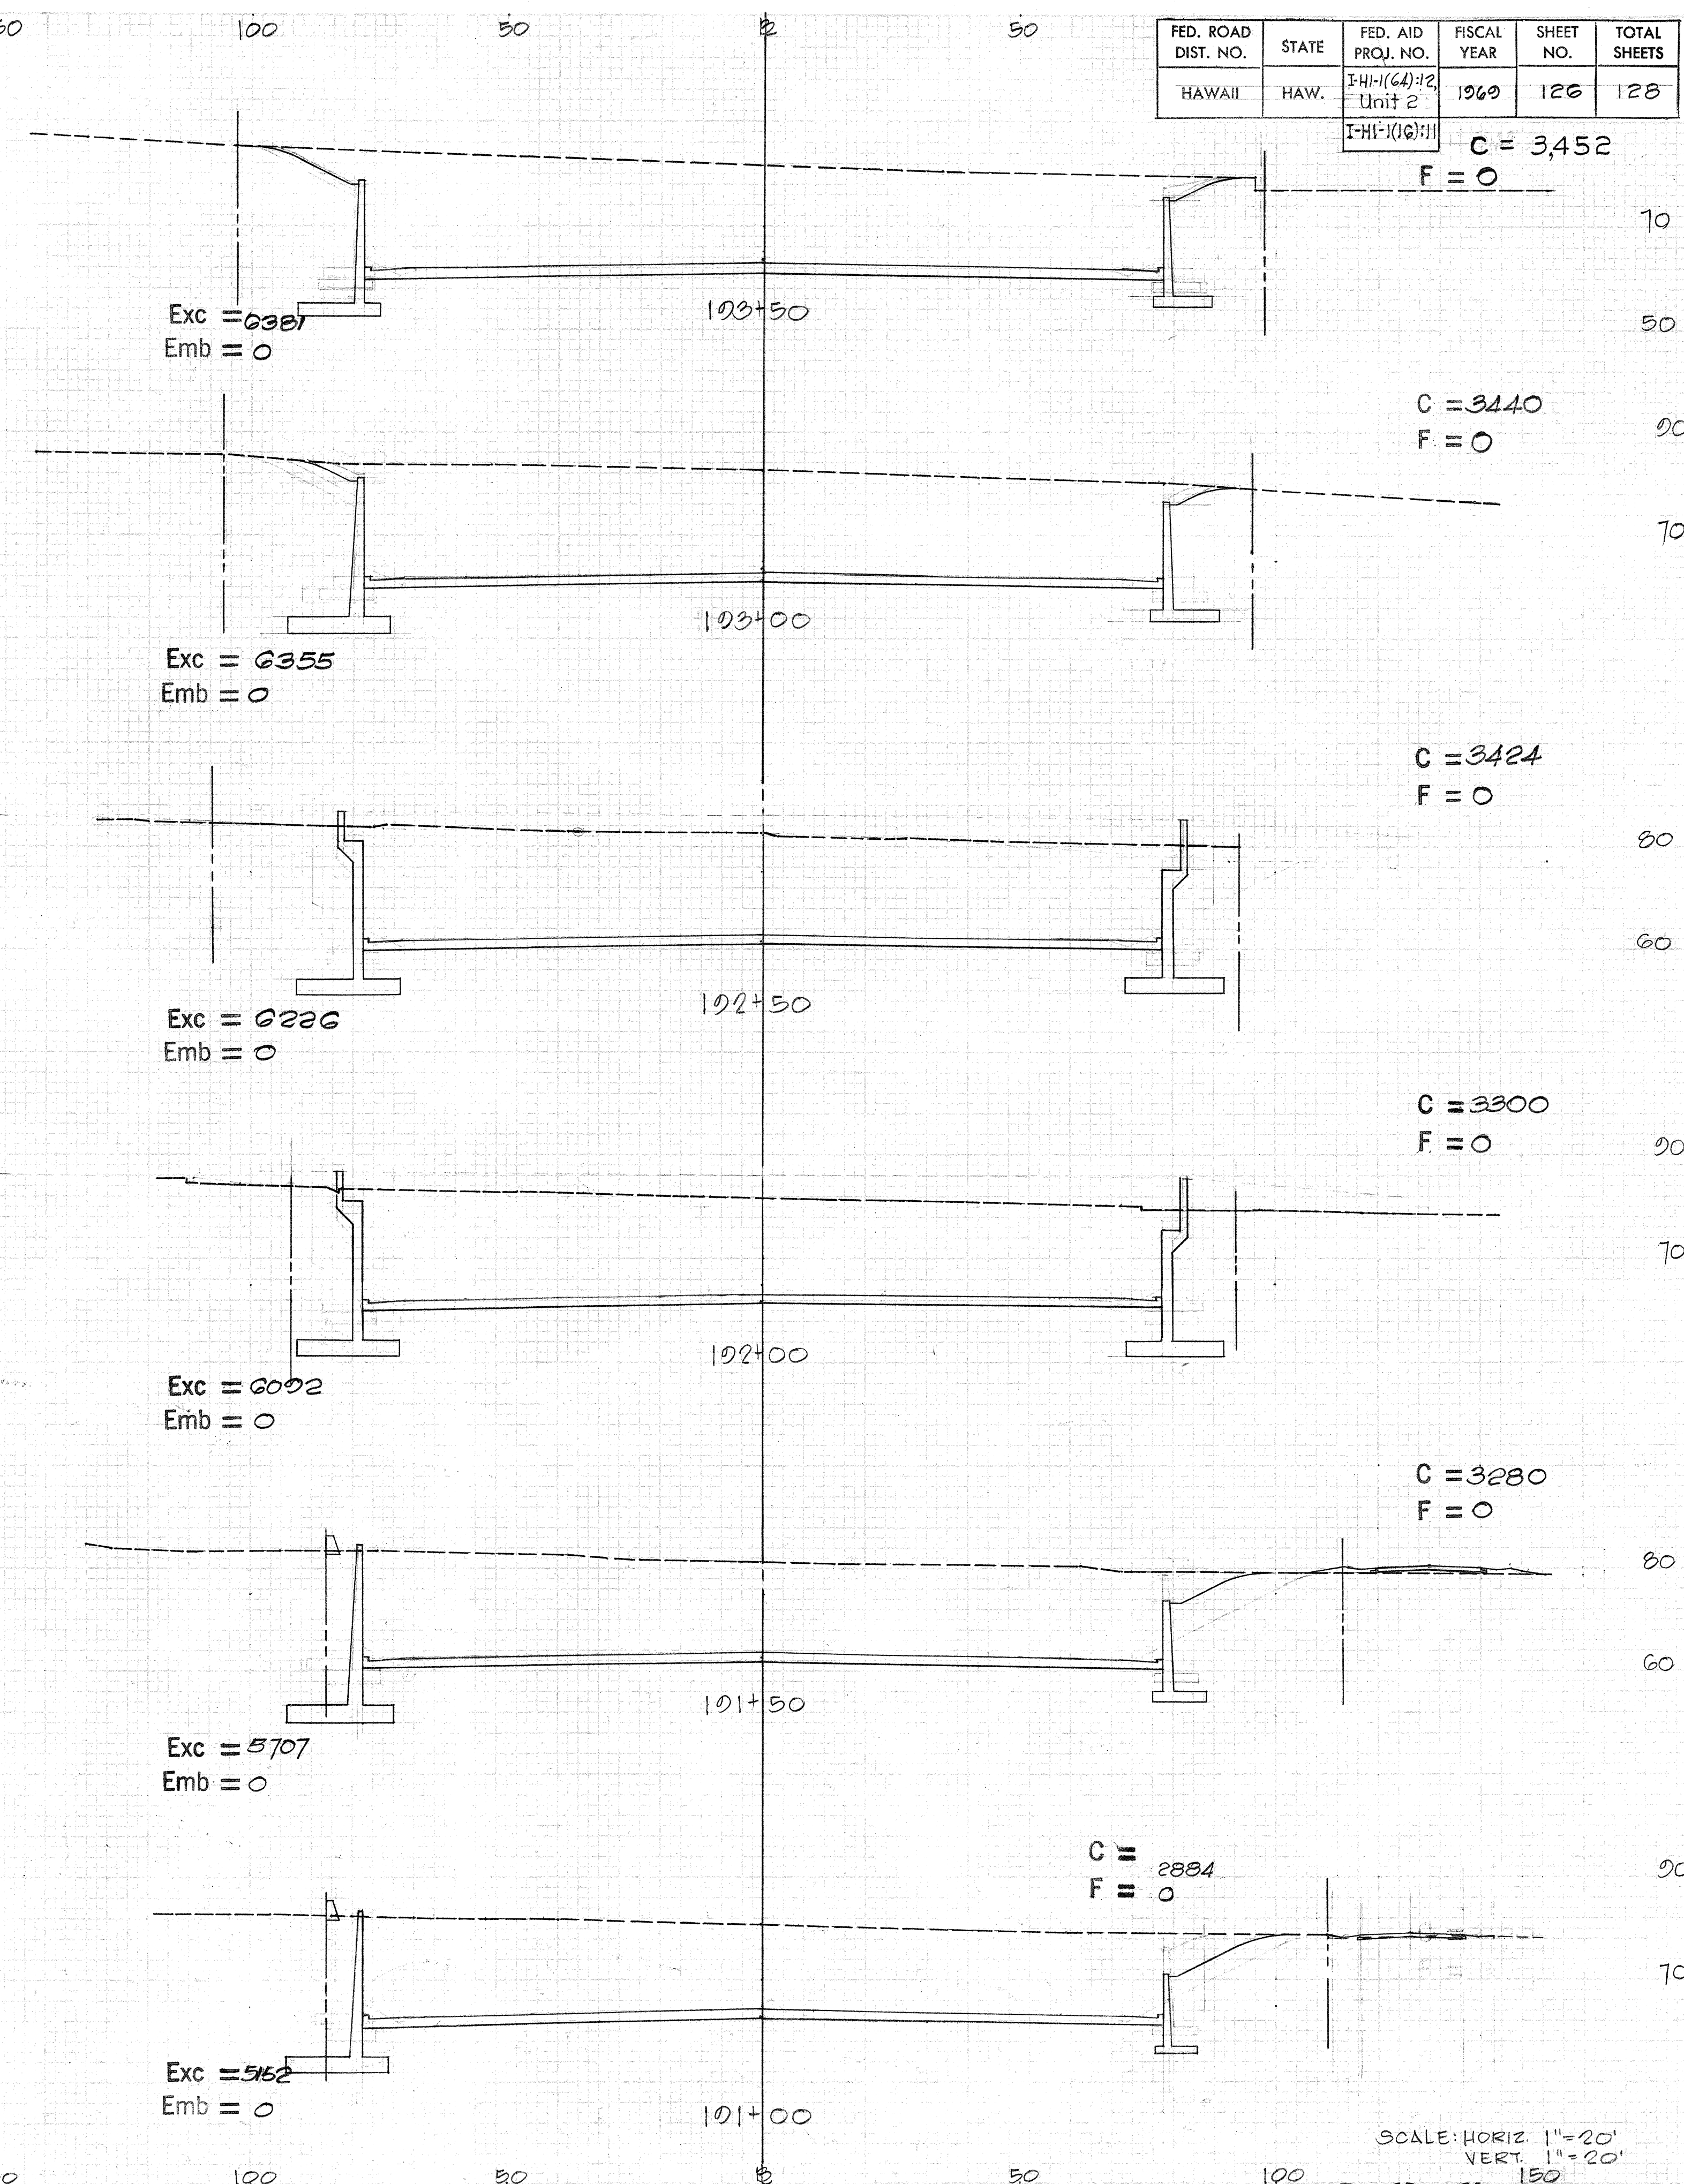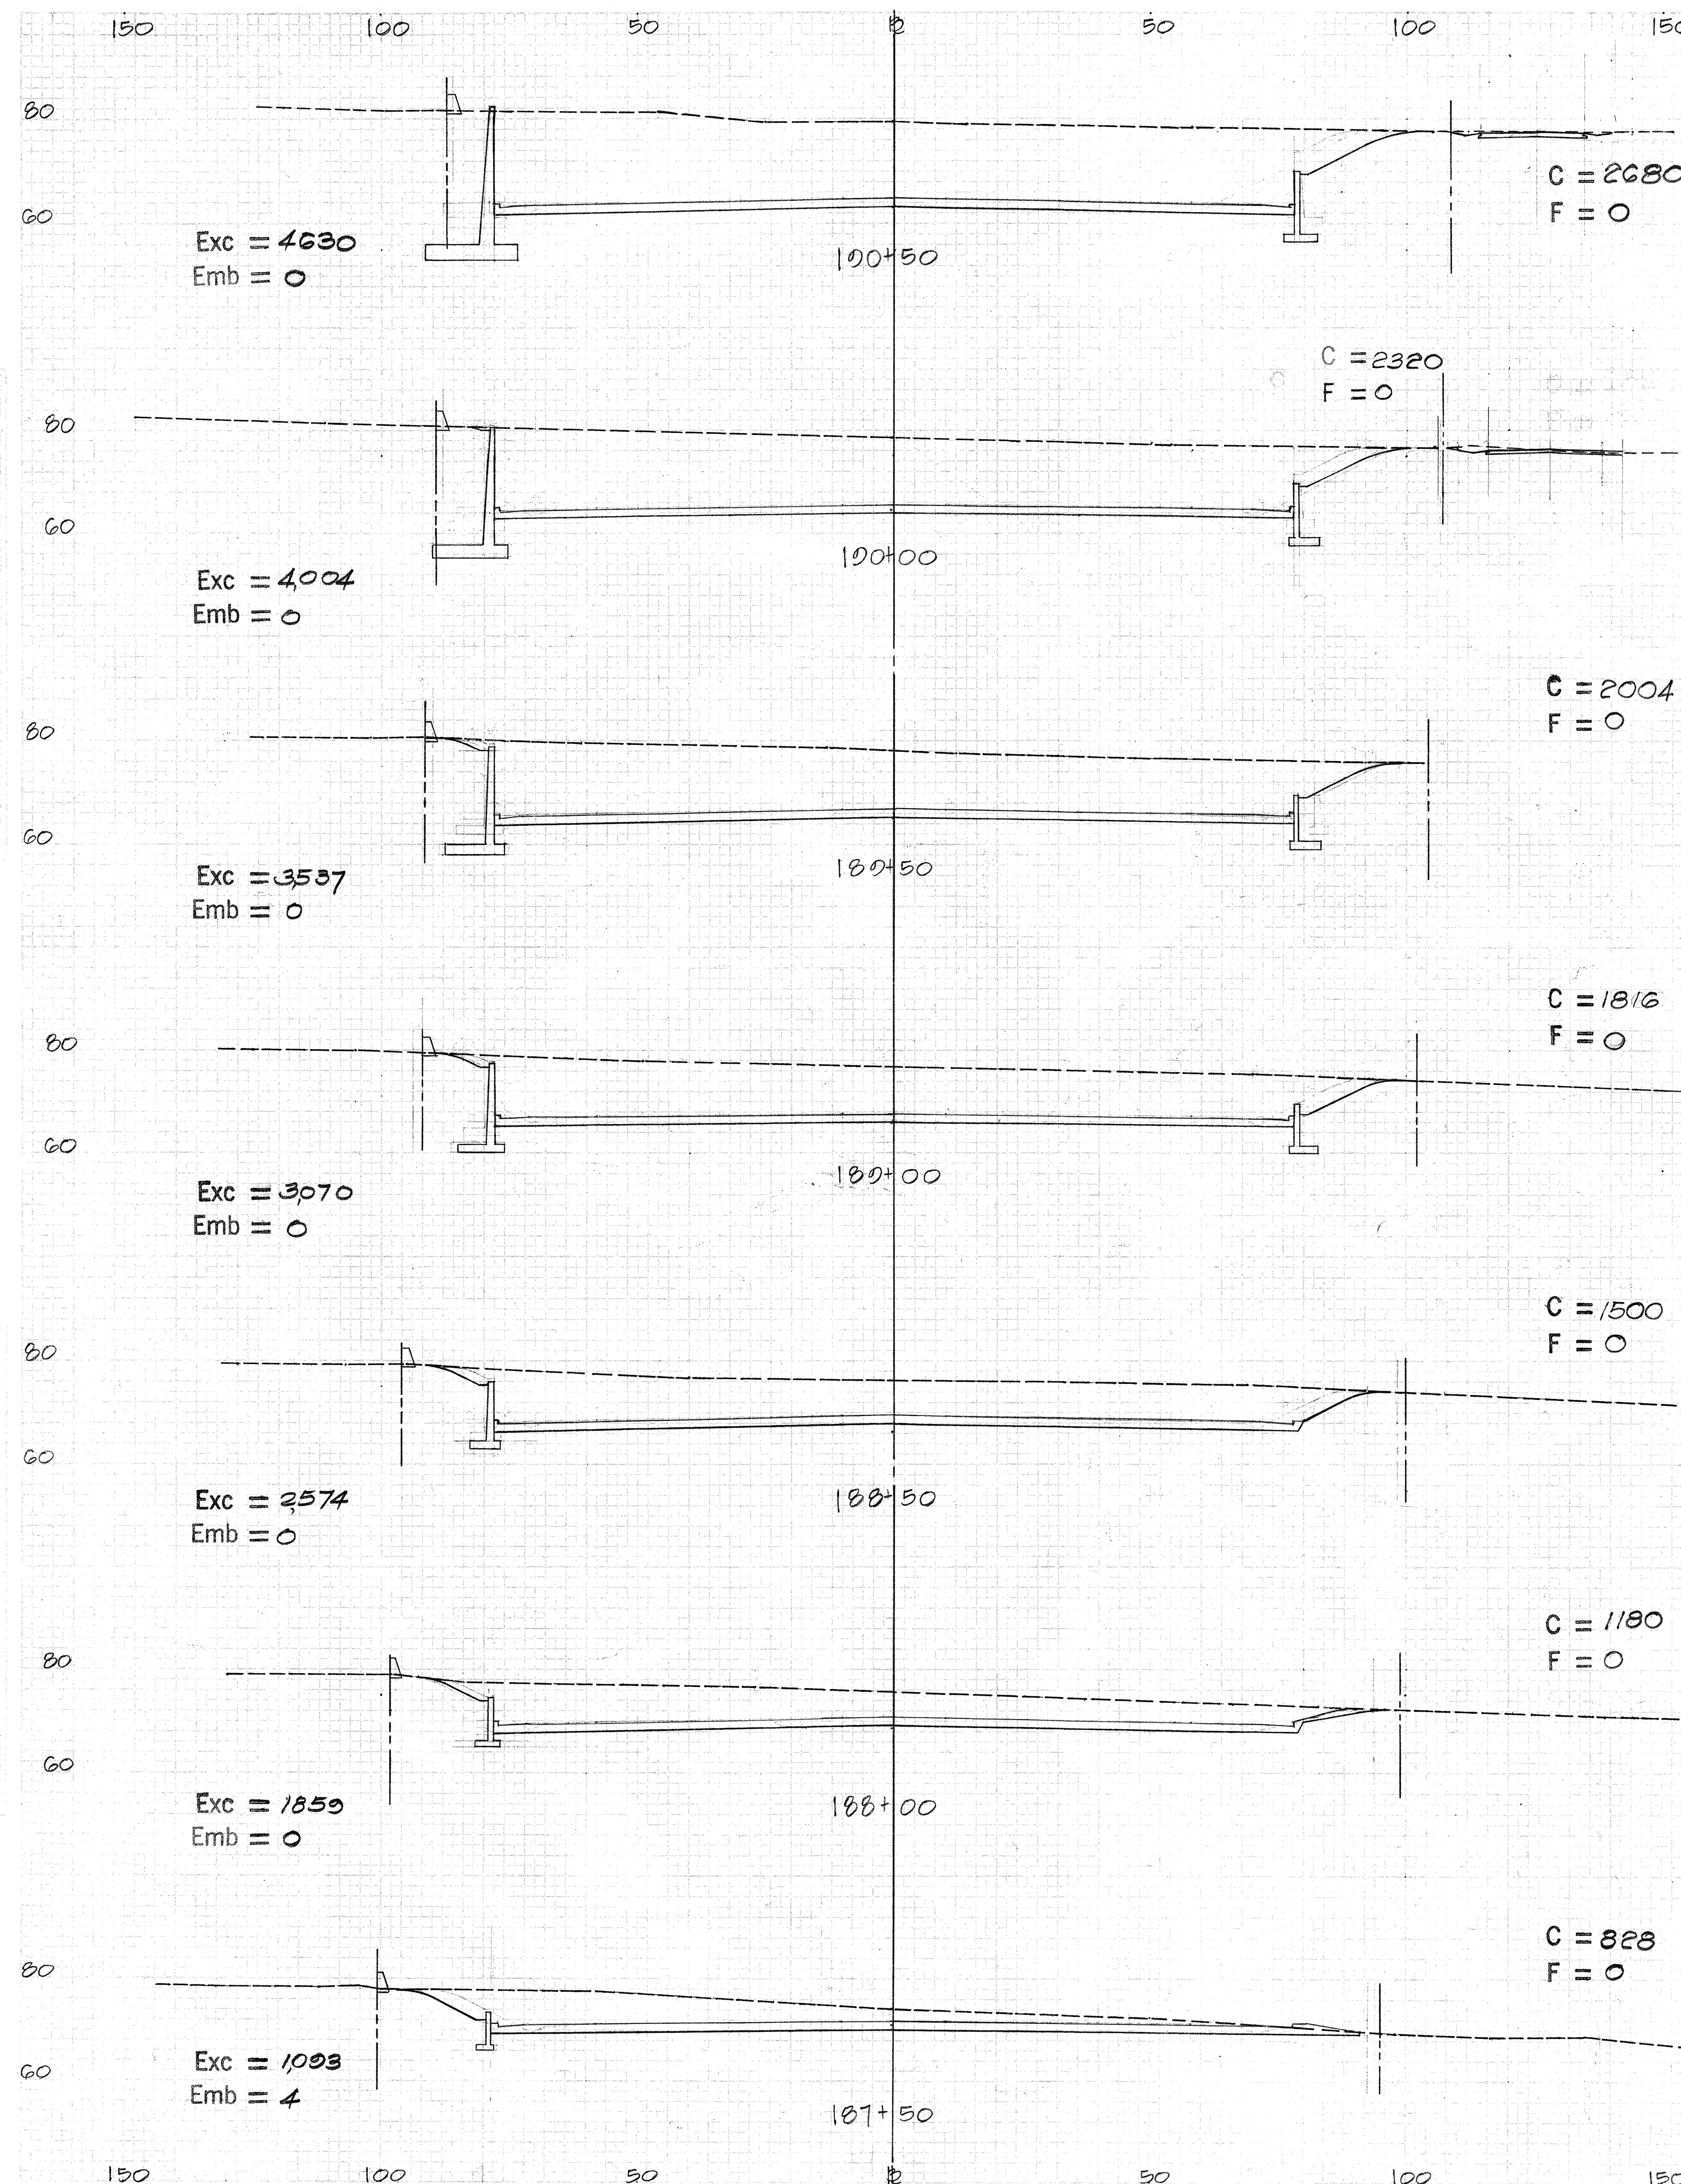


SCALE: HORIZ. 1"=20'
VERT. 1"=20'

FED. ROAD DIST. NO.	STATE	FED. AID PROJ. NO.	FISCAL YEAR	SHEET NO.	TOTAL SHEETS
HAWAII	HAW.	I-H-1(64)-12 Unit 2	1962	127	128
		I-H-1(16)-11			

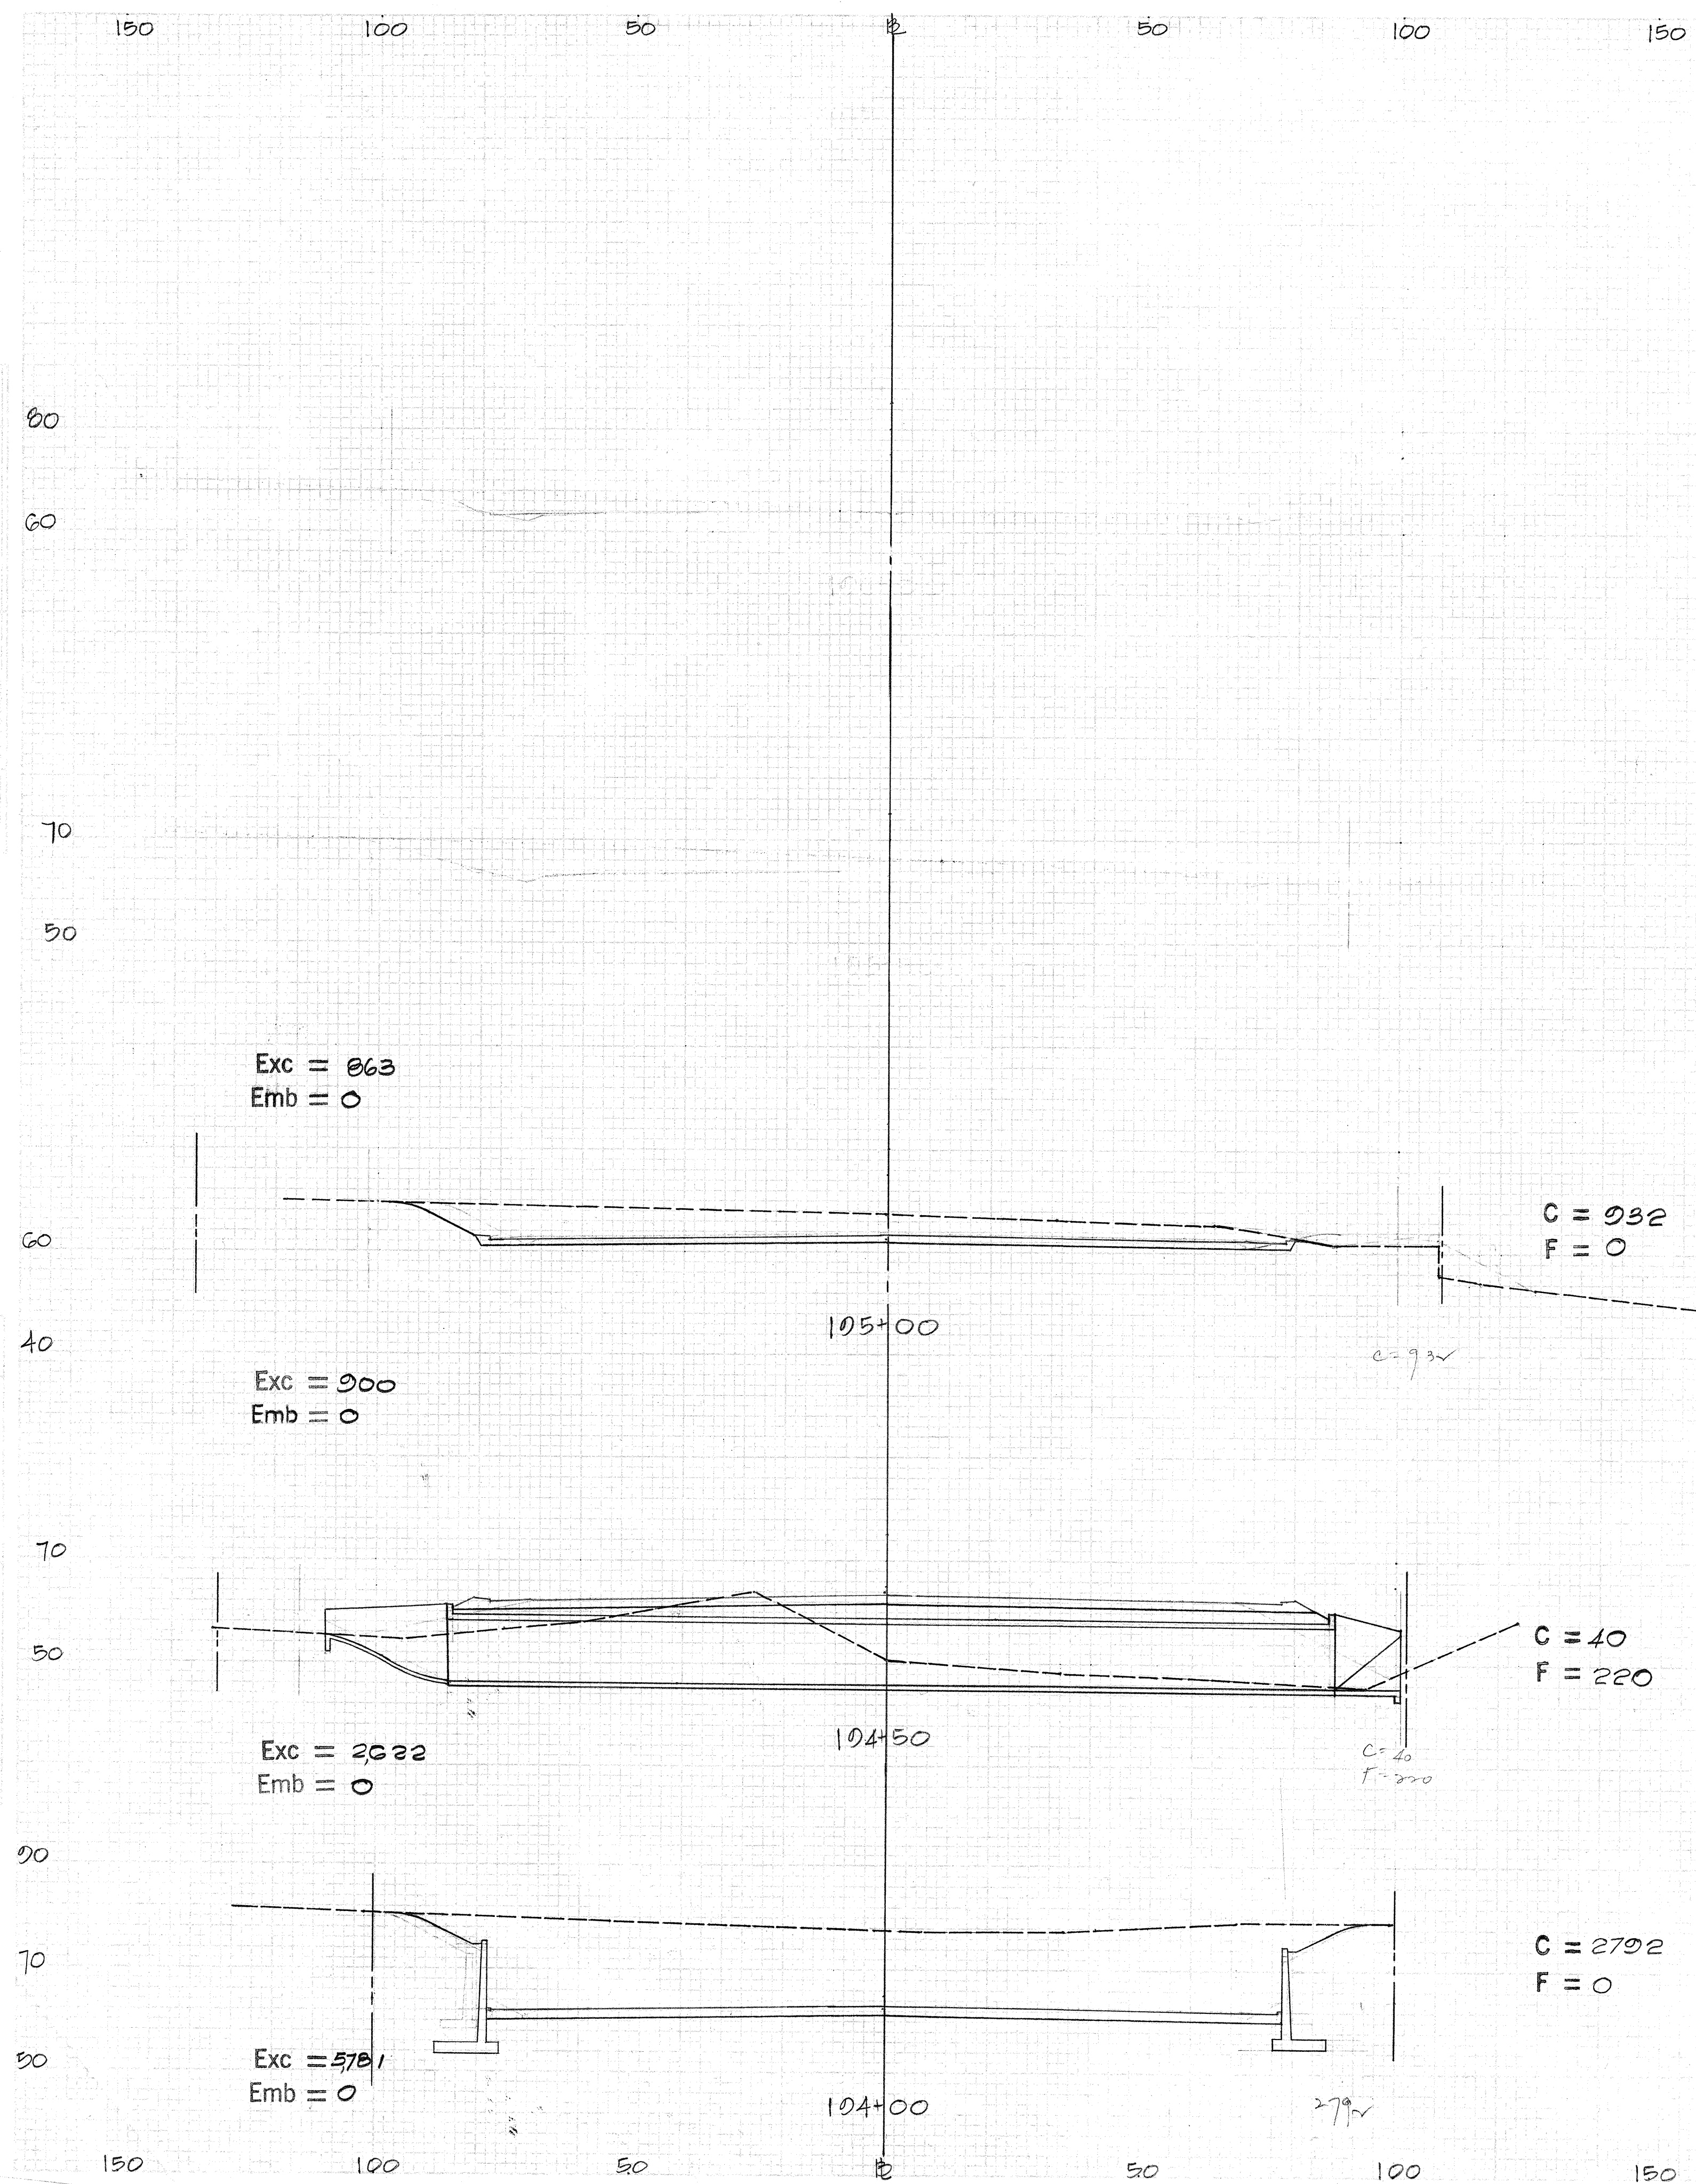

FED. ROAD DIST. NO.	STATE	FED. AID PROJ. NO.	FISCAL YEAR	SHEET NO.	TOTAL SHEETS
HAWAII	HAW.	FHI-164-12 Unit 2	1960	128	128

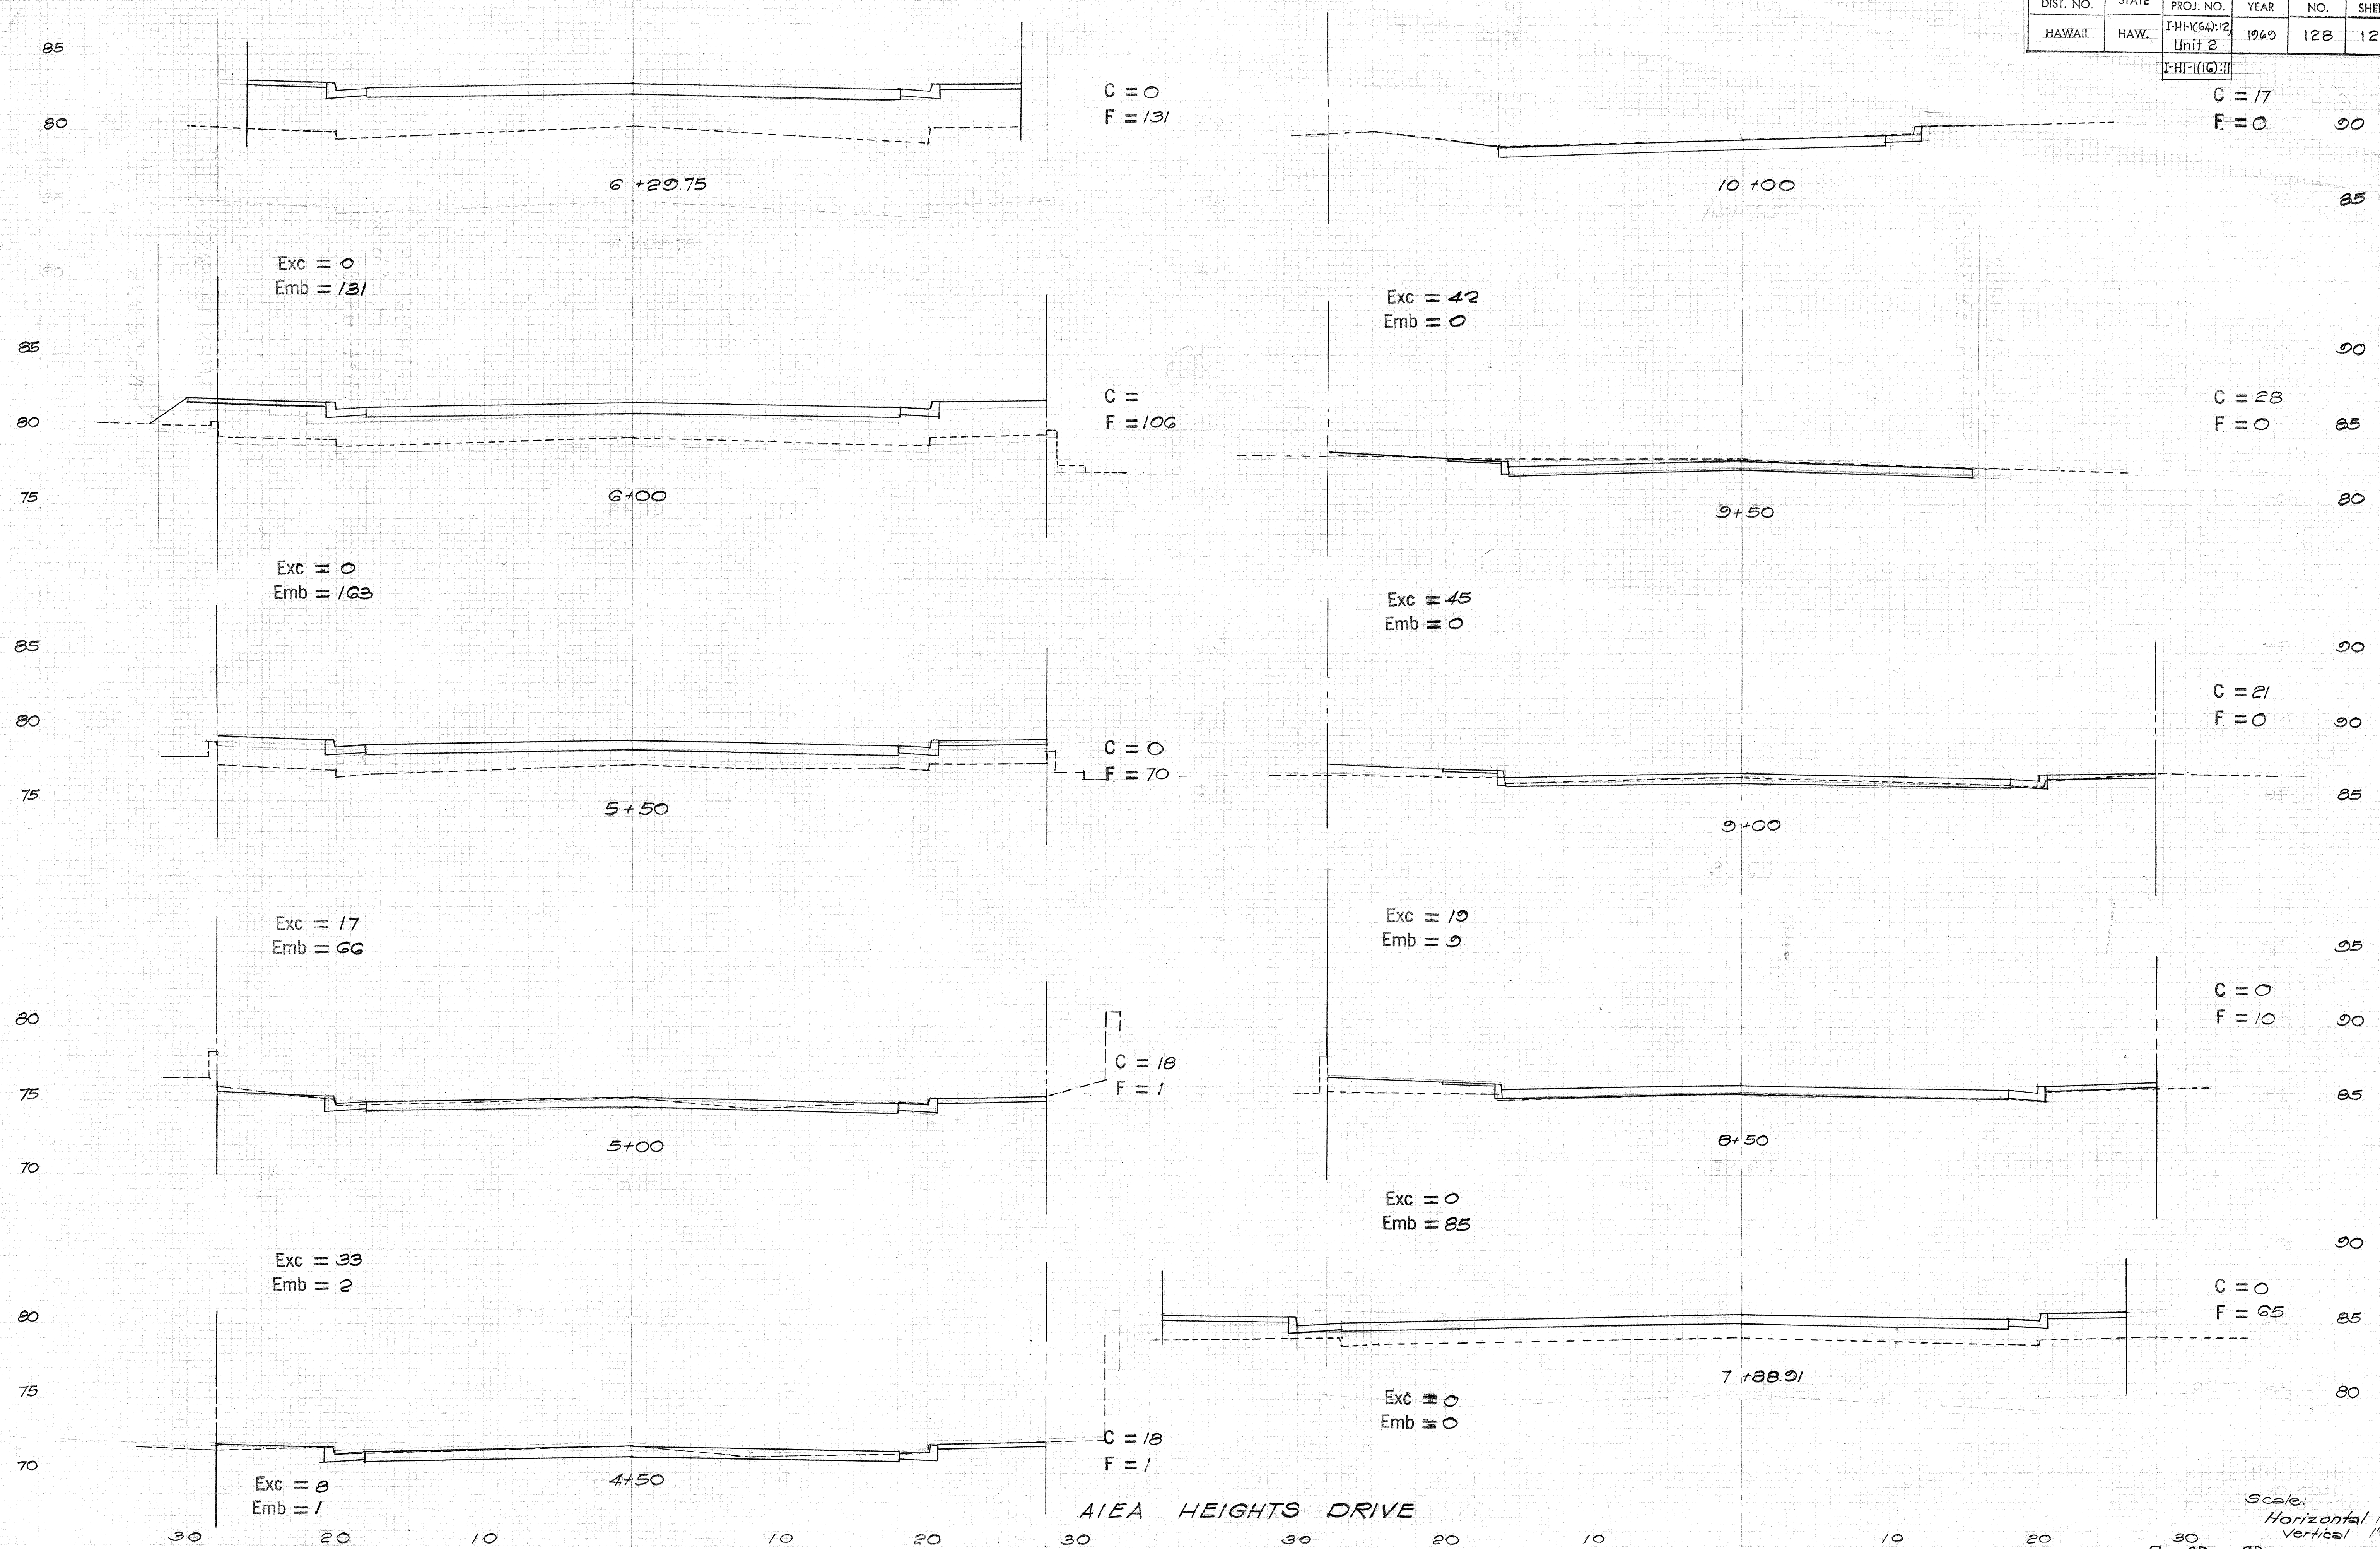

AIEA HEIGHTS DRIVE

Scale:
Horizontal 1"=5'
Vertical 1"=5'