




FED. ROAD DIST. NO.	STATE	FED. AID PROJ. NO.	FISCAL YEAR	SHEET NO.	TOTAL SHEETS
HAWAII	HAW.	I-H-1(64)12 Unit 2	1969	10	128

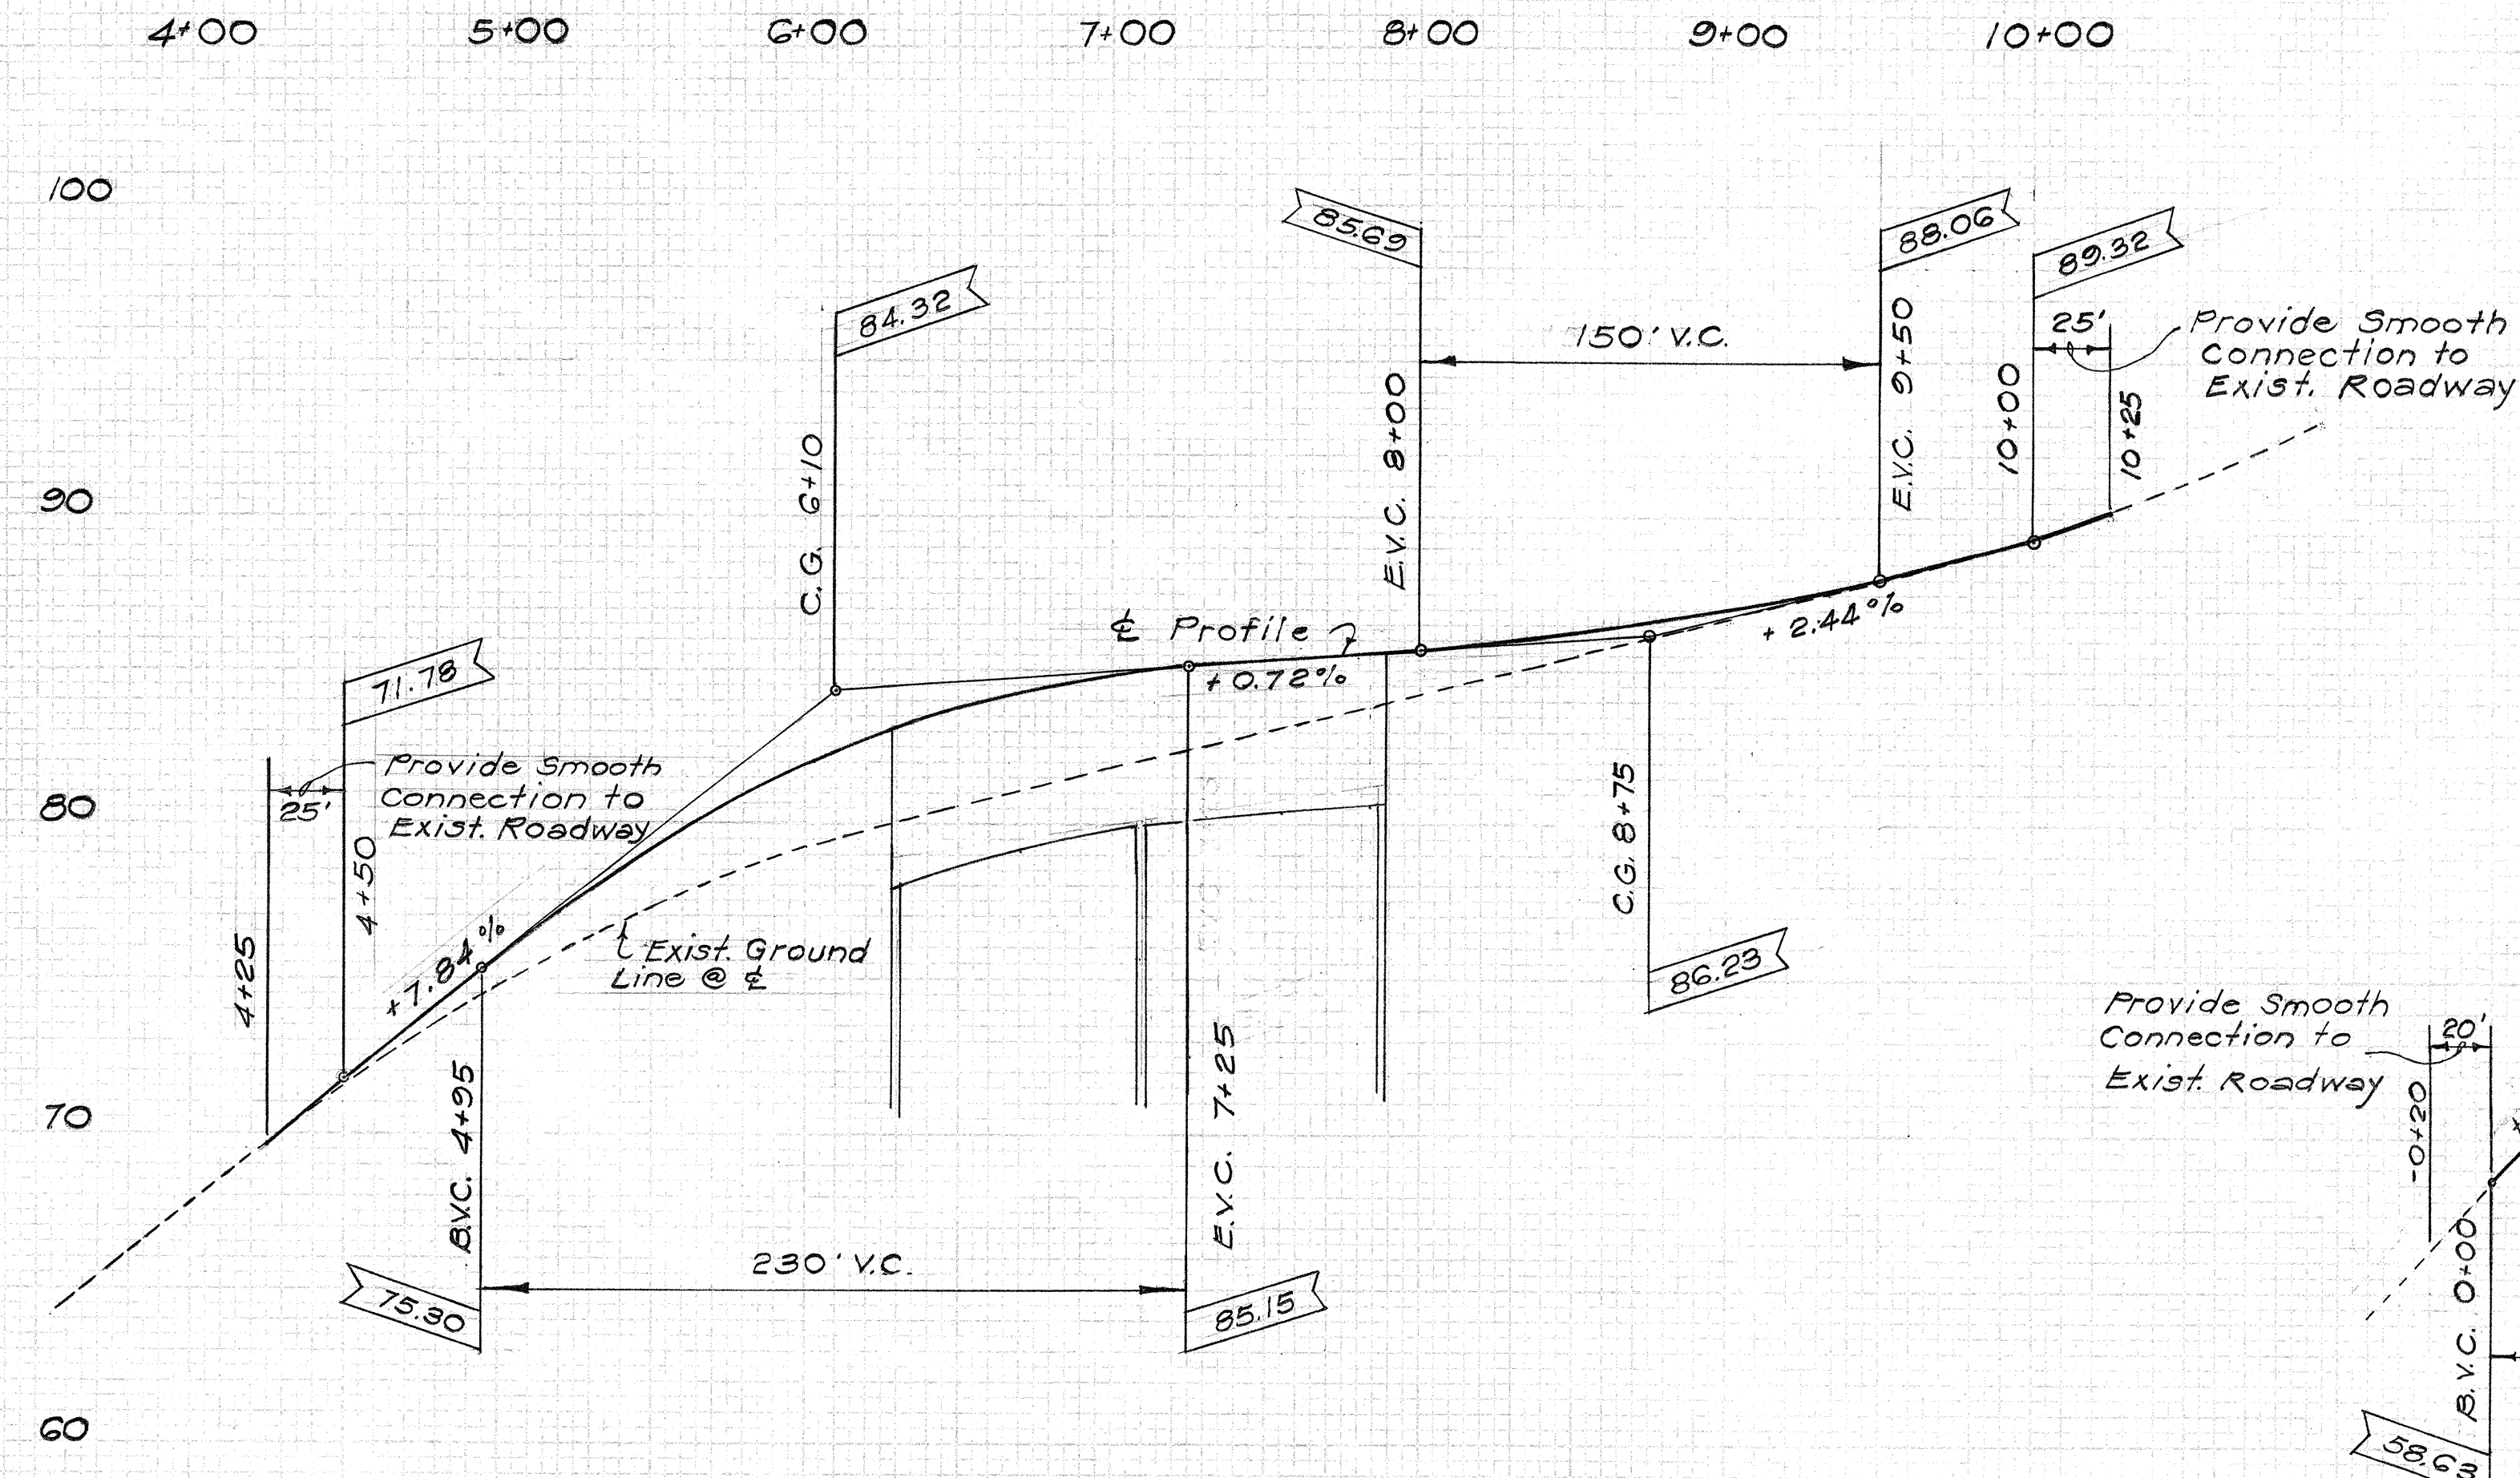


PROFILE - AIEA HEIGHTS DRIVE
 Scale: Horizontal 1"=50'
 Vertical 1"=5'

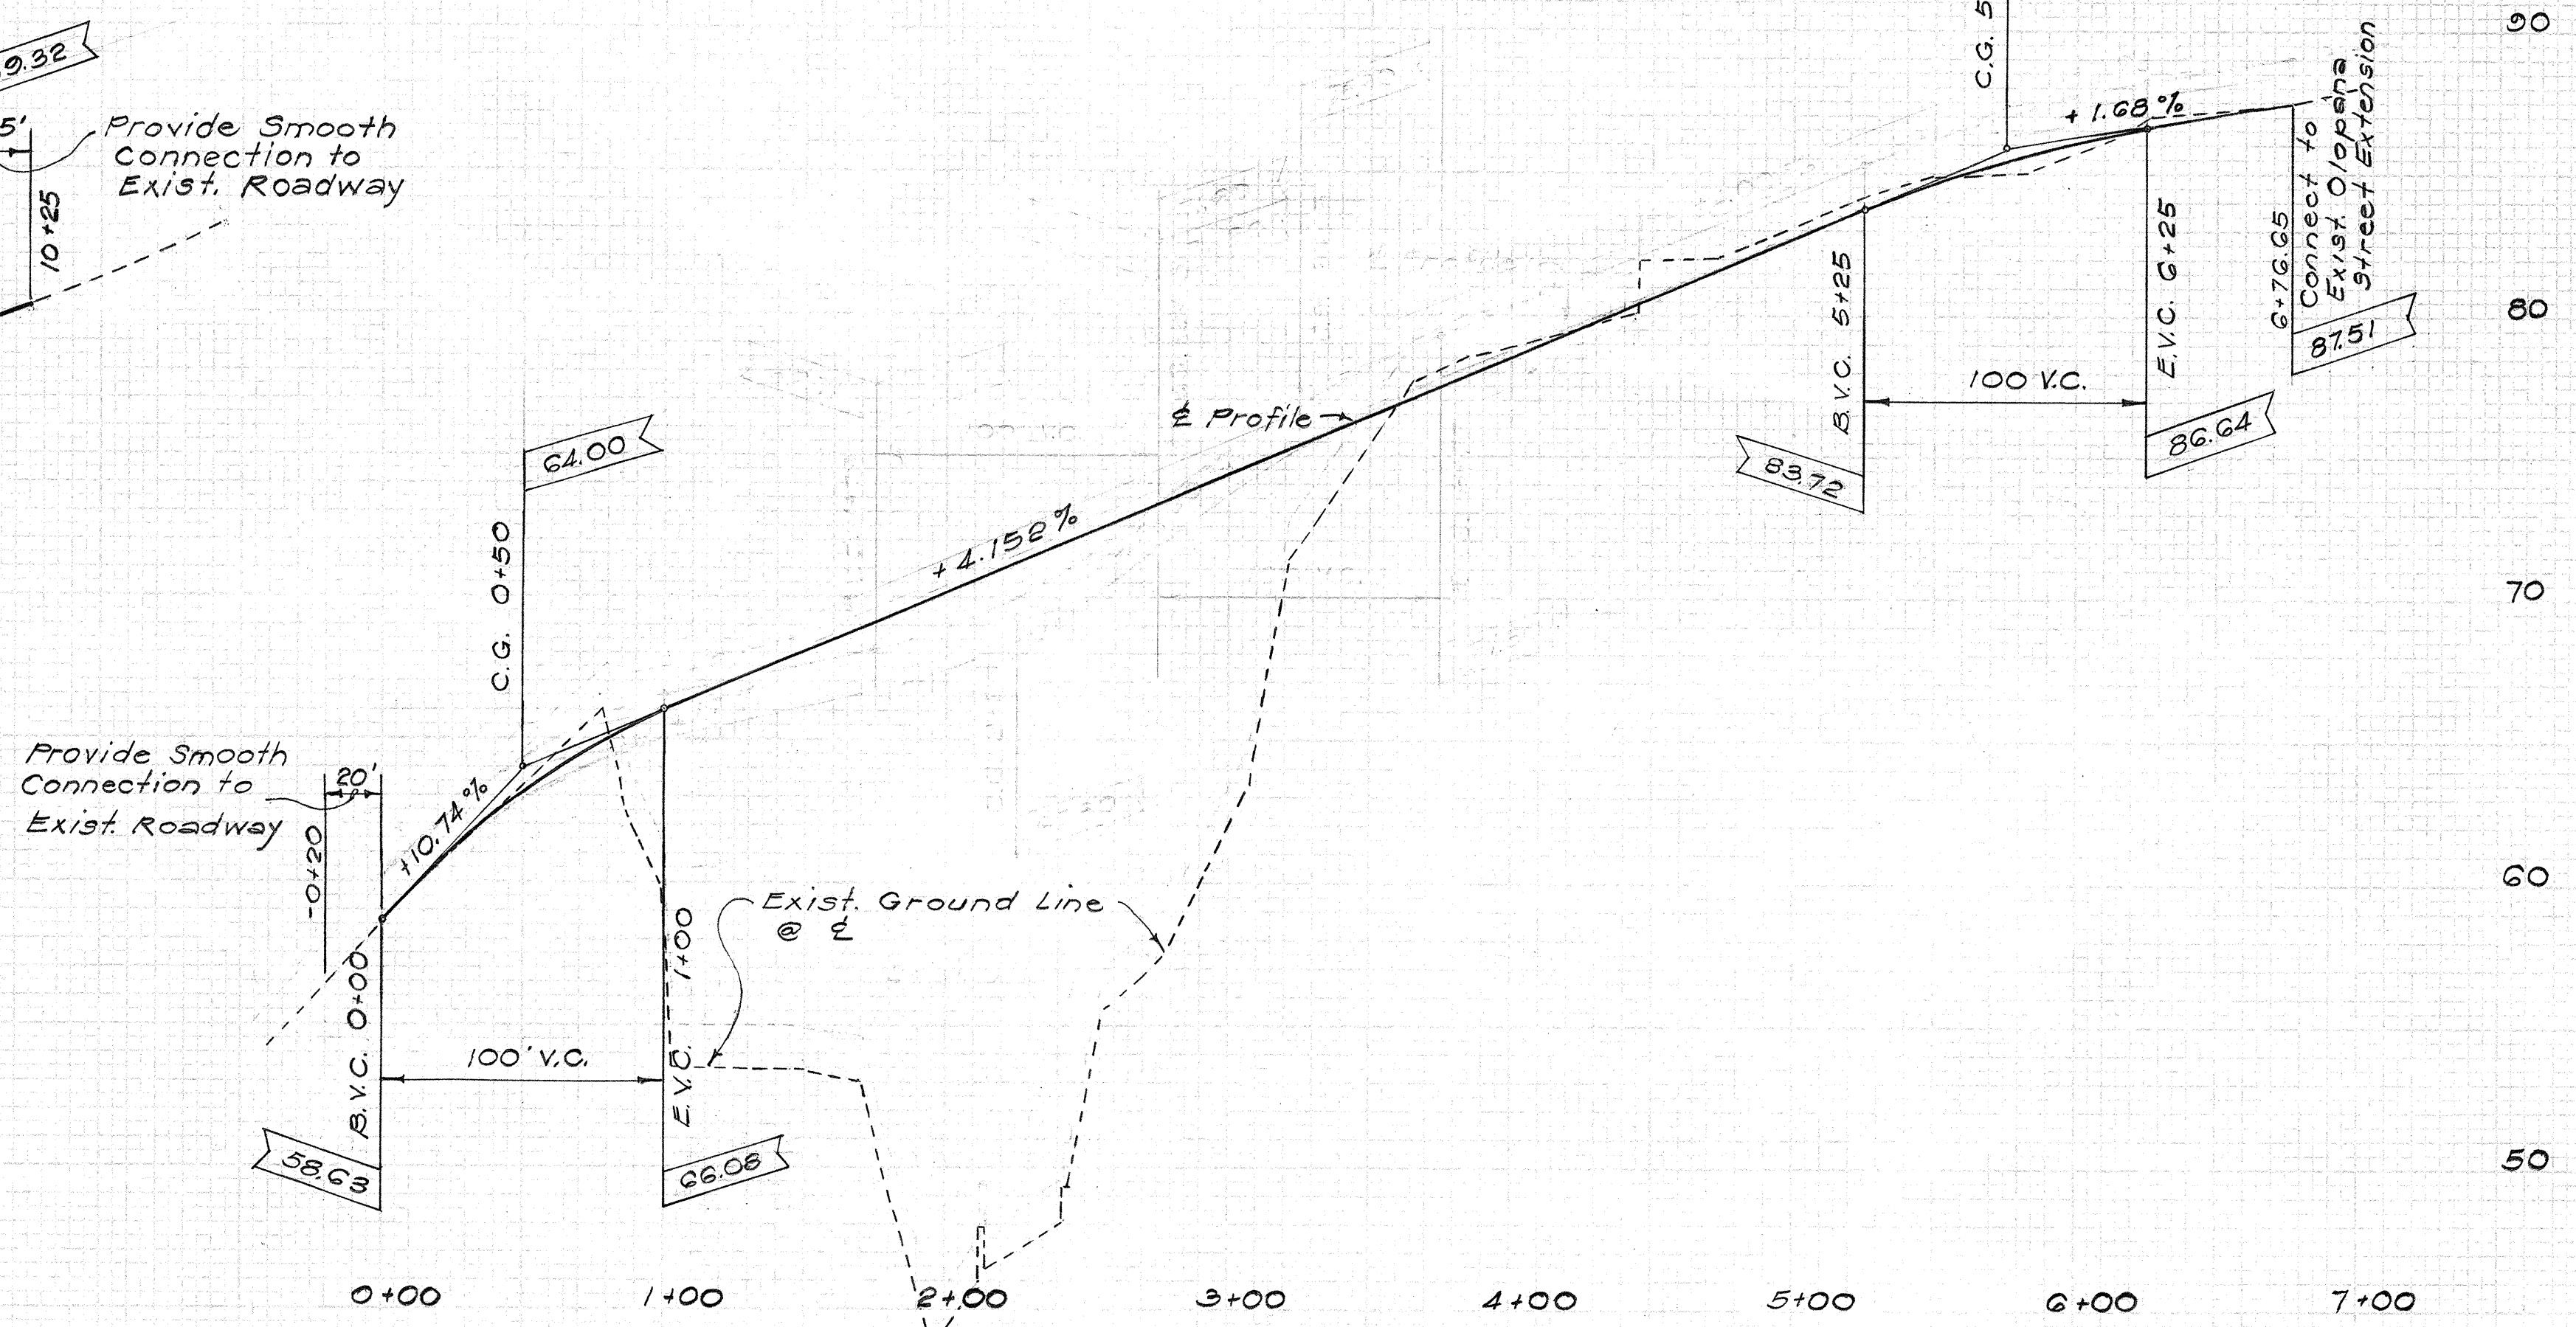

PROFILE - HELECONIA STREET FRONTAGE ROAD
 Scale: Horizontal 1"=50'
 Vertical 1"=5'

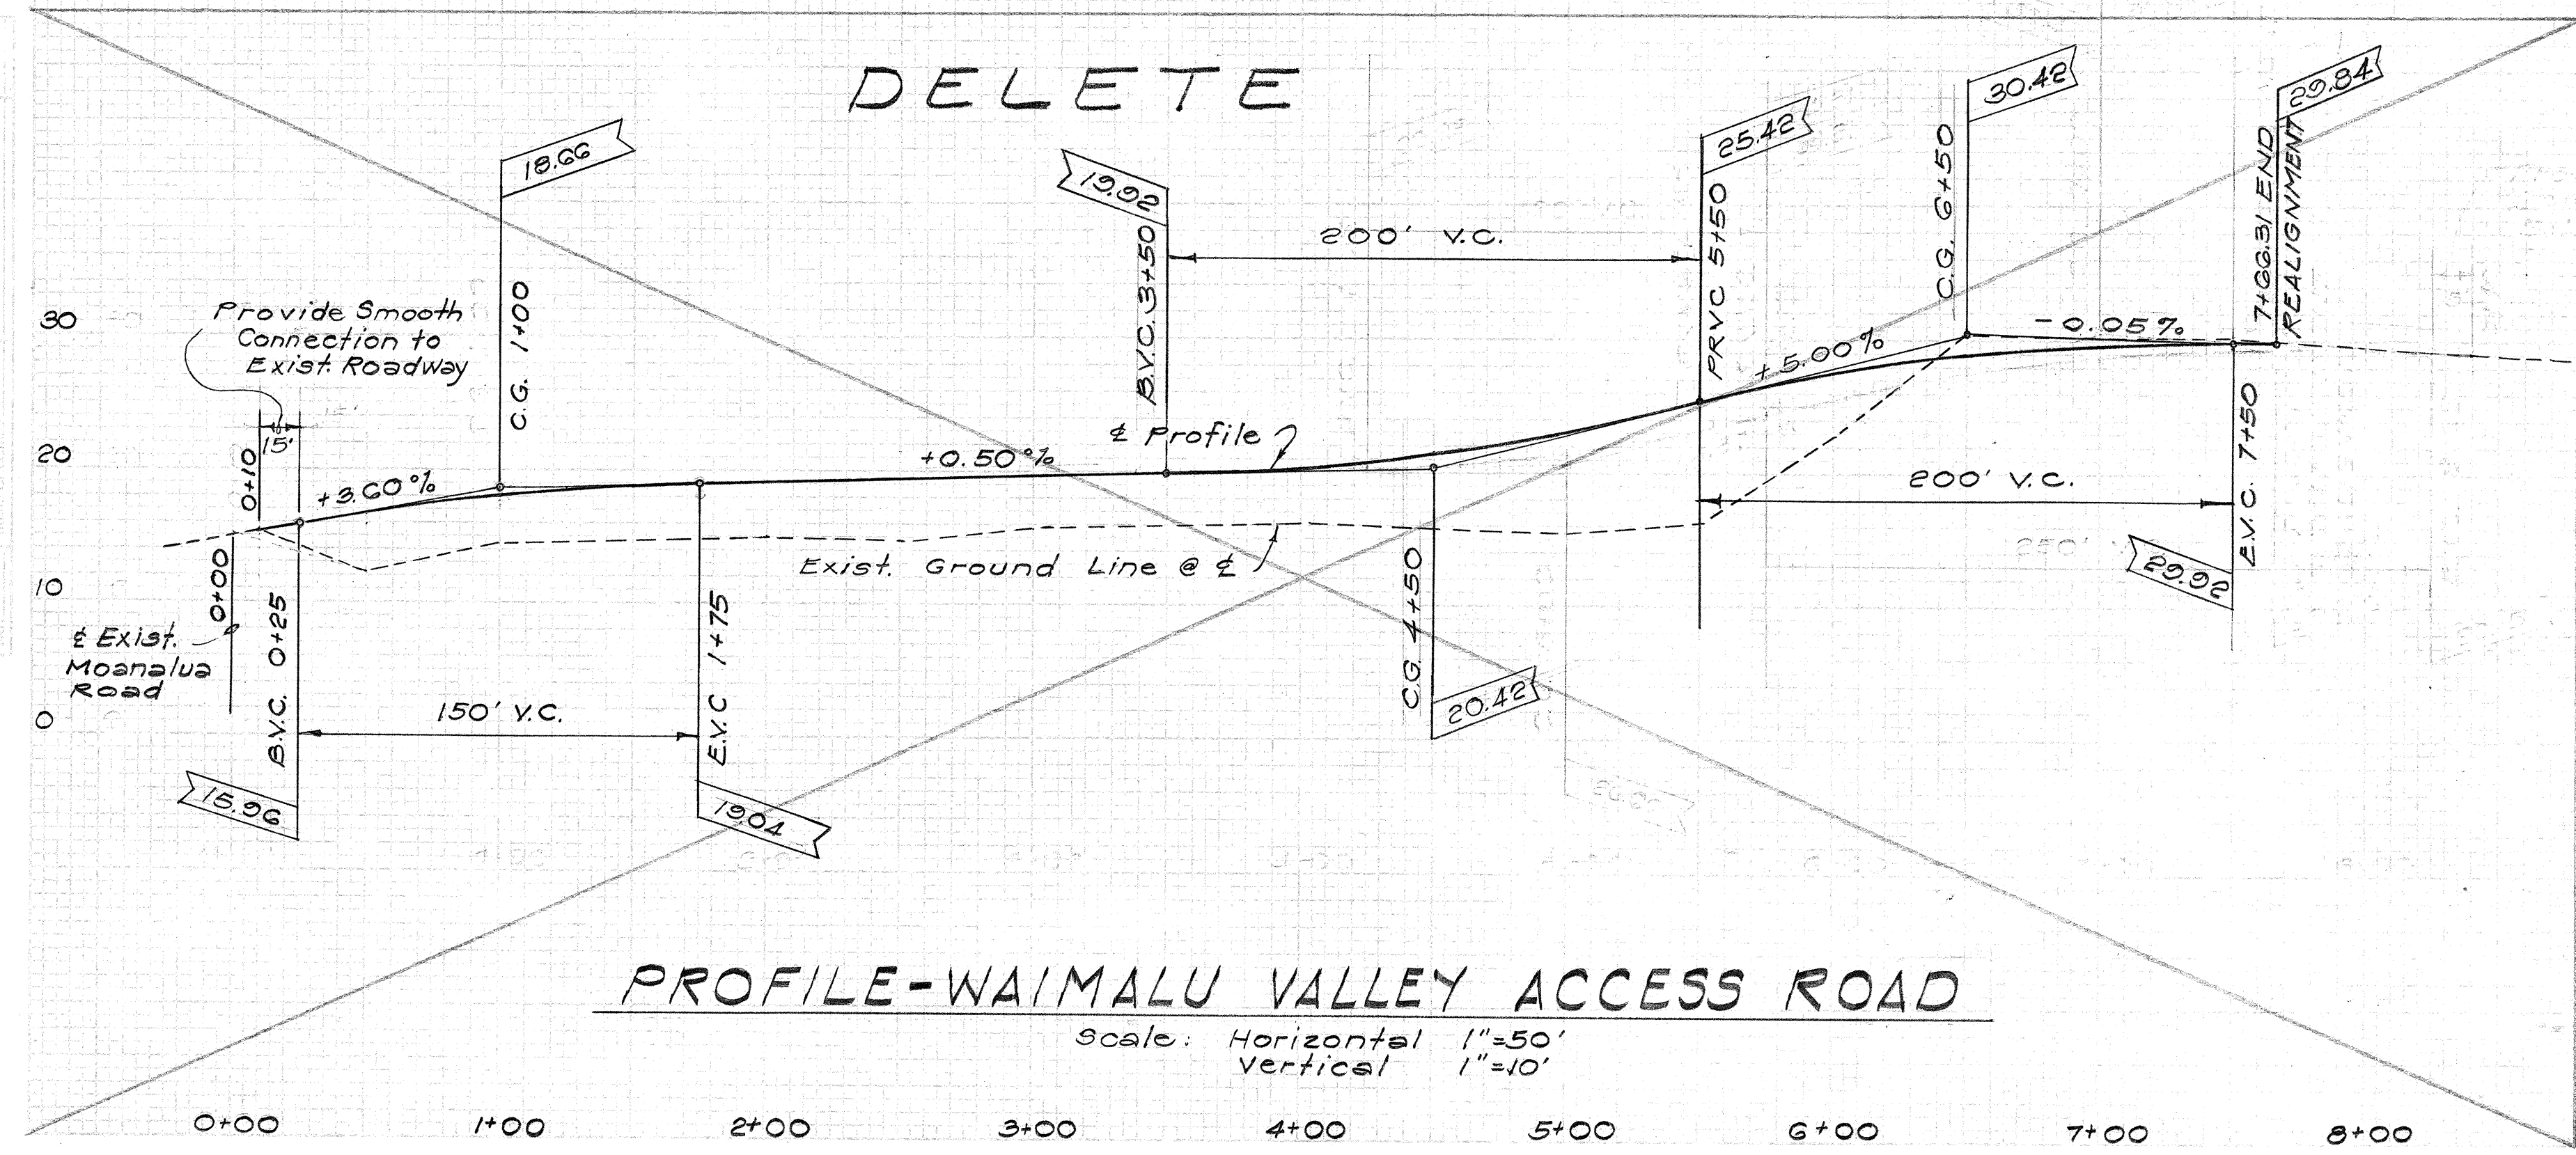

PROFILE - WAIMALU VALLEY ACCESS ROAD
 Scale: Horizontal 1"=50'
 Vertical 1"=10'

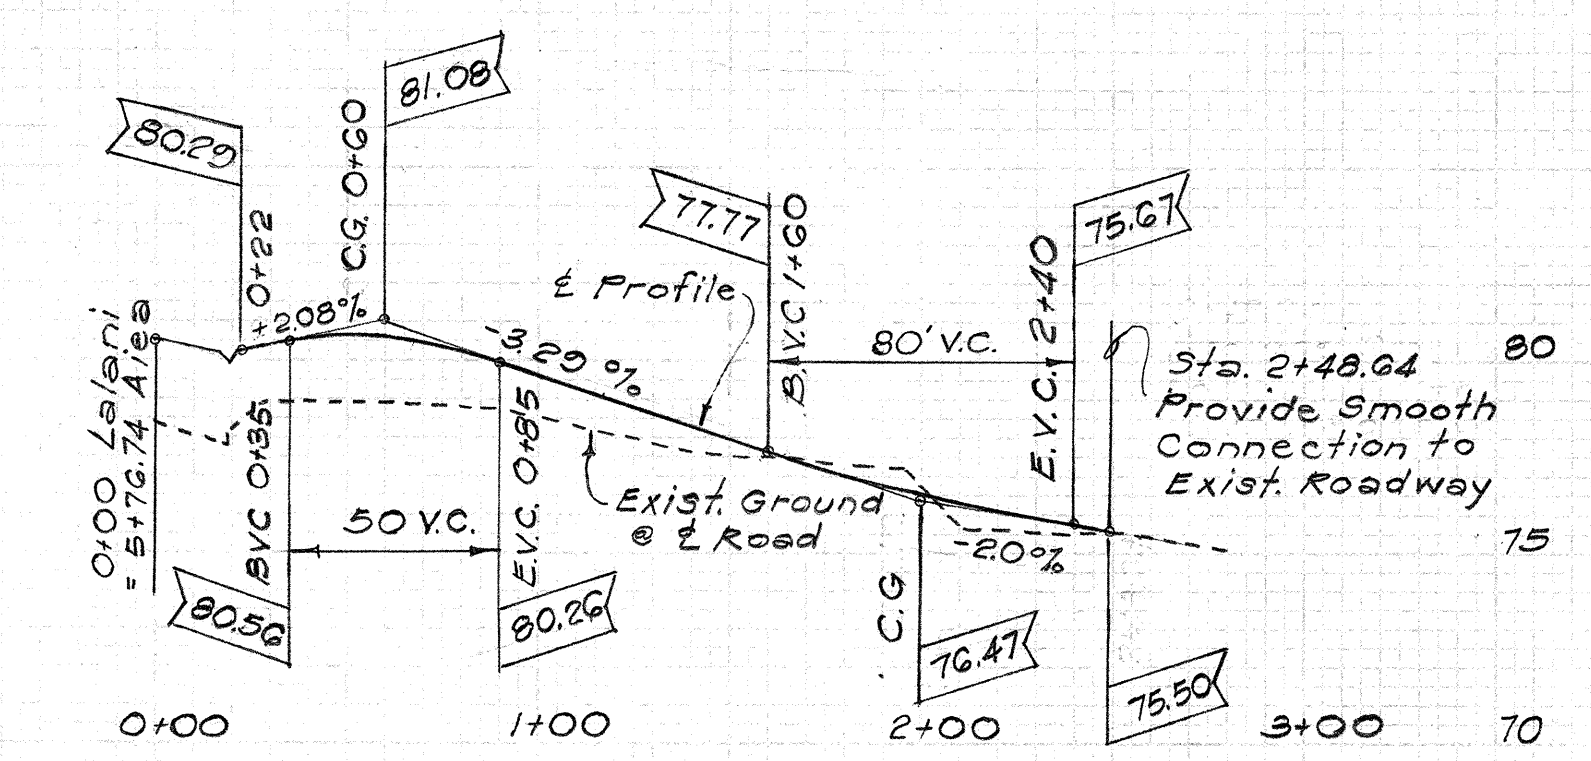

PROFILE - LANANI STREET CONNECTION
 Scale: Horizontal 1"=50'
 Vertical 1"=5'



THIS WORK WAS PREPARED BY
 ME OR UNDER MY SUPERVISION.

STATE OF HAWAII
 DEPARTMENT OF TRANSPORTATION
 HIGHWAYS DIVISION

MISC. ROADWAY PROFILES

INTERSTATE ROUTE H-1
 PROJ. NO. I-H-1(64)12,
 Unit 2

Scale: As Shown Date: 8/10/68
 SHEET No. 1 OF 1 SHEETS