



FED. ROAD DIST. NO.	STATE	FED. AID PROJ. NO.	FISCAL YEAR	SHEET NO.	TOTAL SHEETS
HAWAII	HAW.	1H1-1(64):12 Unit 2	1960	42	128

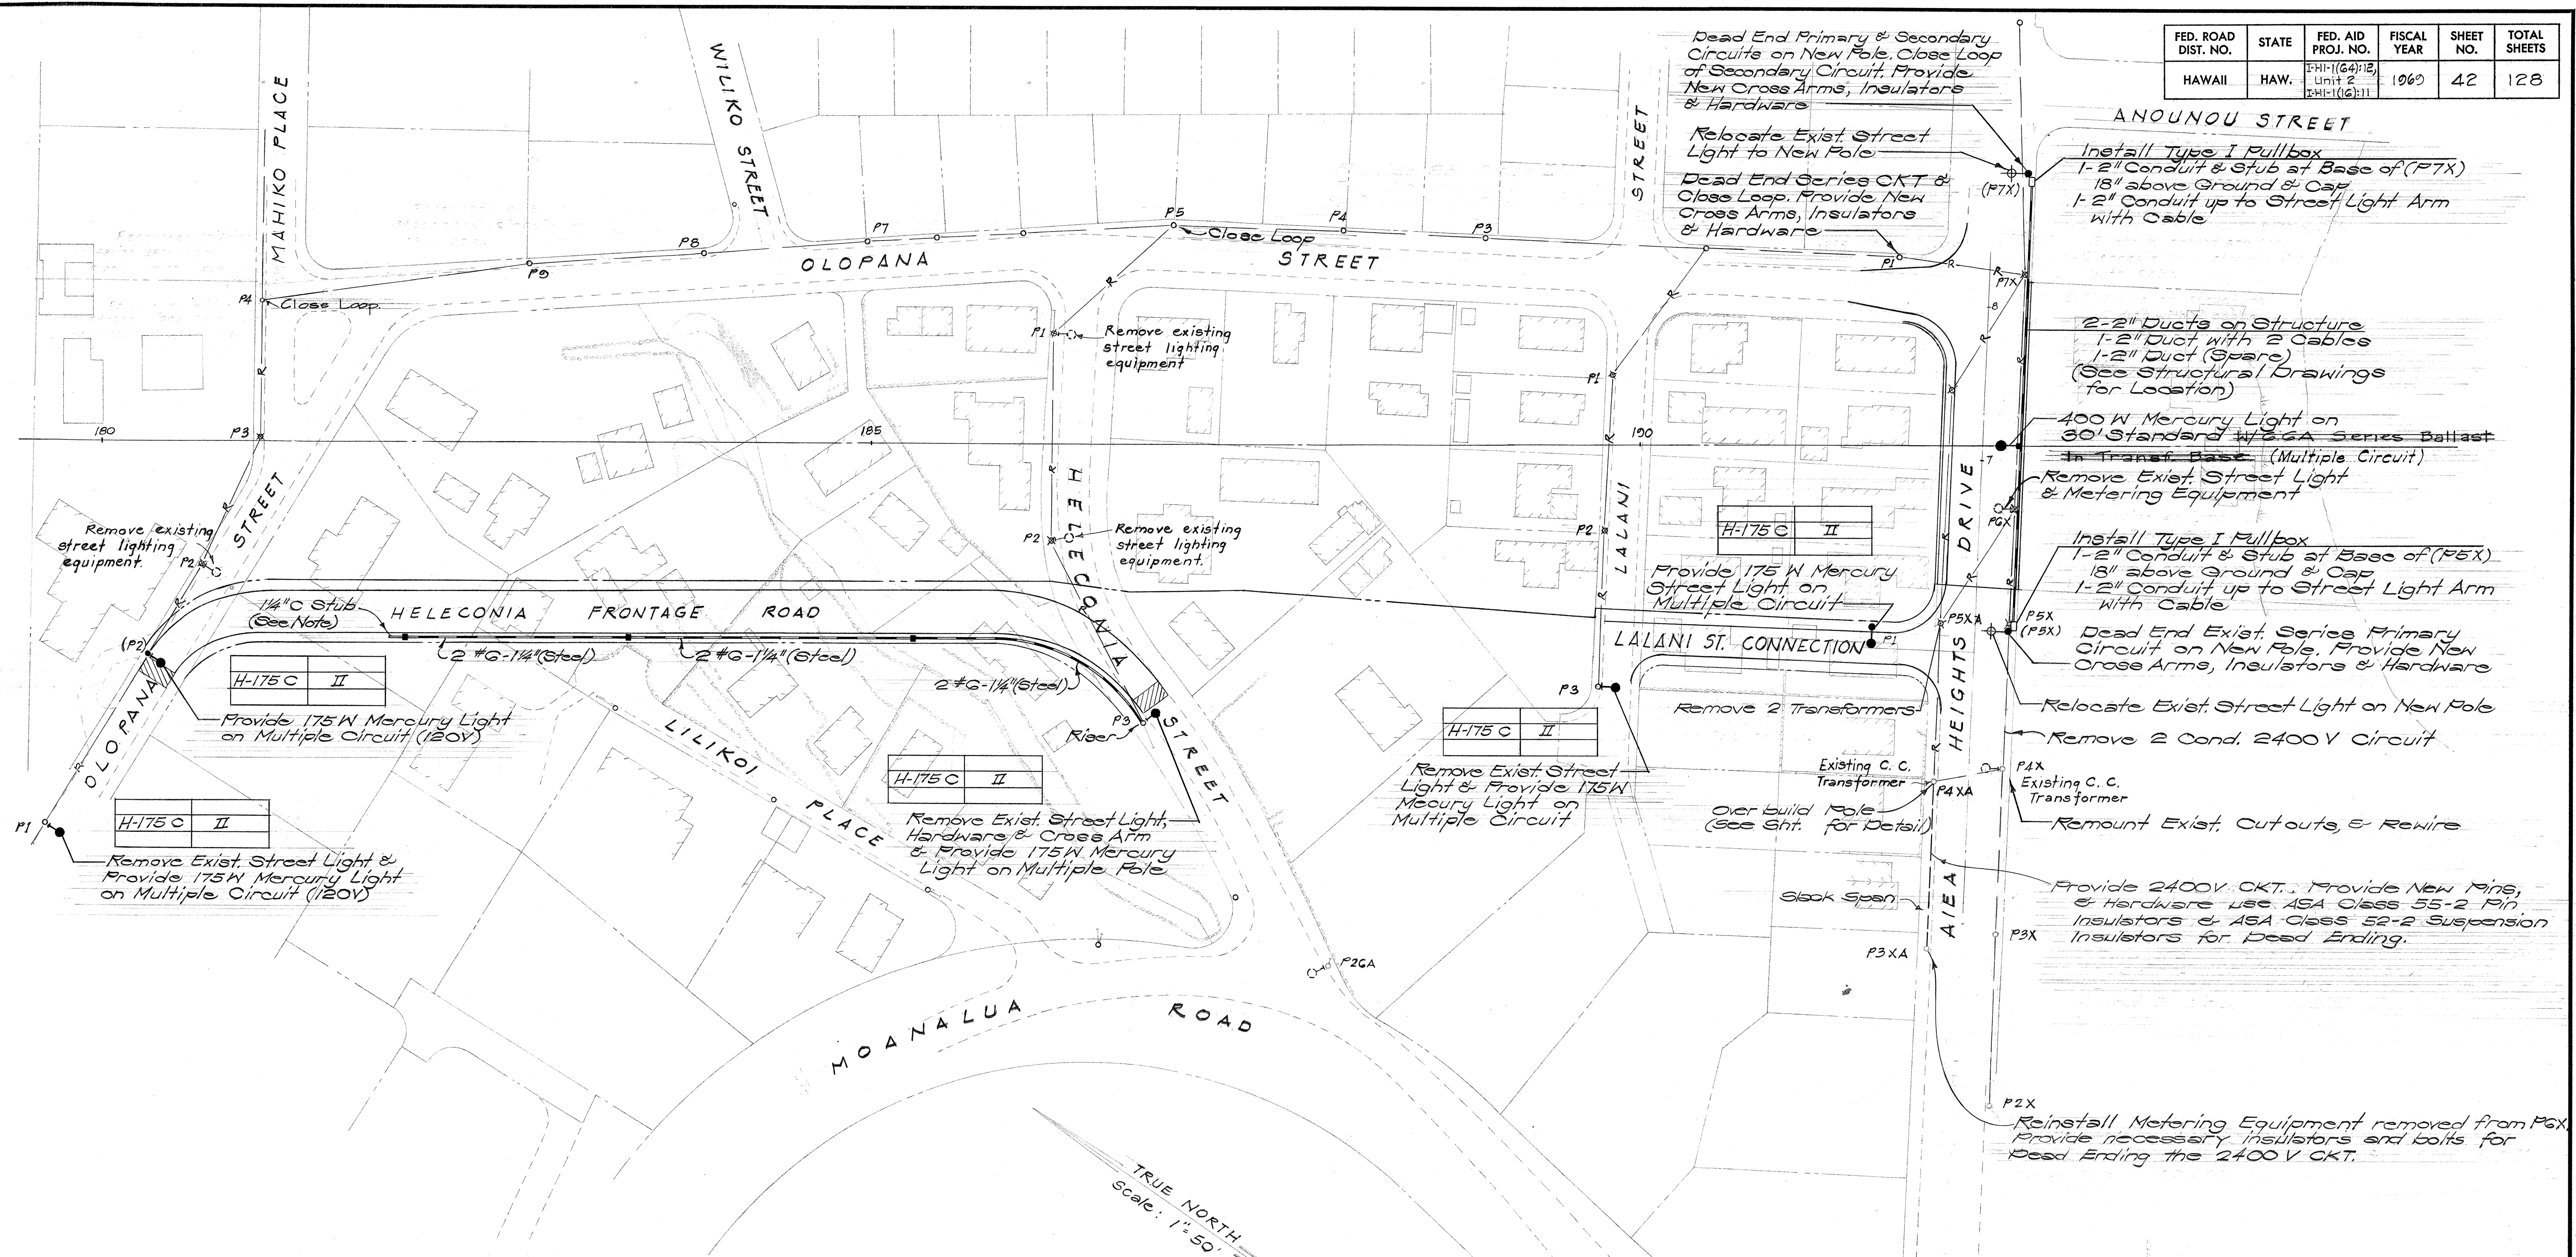

NOTE:
 Along Heleconia Frontage Road provide 3 concrete bases, and underground conduit and conductors to these bases, including cable connectors.

TRUE NORTH
 Scale: 1"=50'

DATE	_____
SURVEY PLANNED BY	_____
DRAWN BY	_____
NOTED BY	_____
CHECKED BY	_____
ORIGINAL PLAN	_____
NOTE BOOK	_____
No.	_____

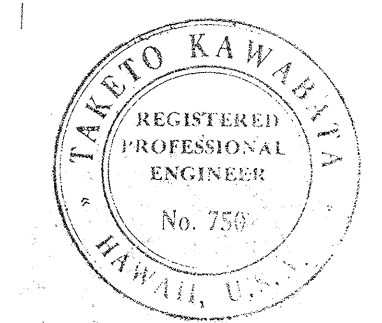

THIS WORK WAS PREPARED BY ME OR UNDER MY SUPERVISION.

Tadeo Kawahara


Approved: Kenneth R. Jhong
 Traffic Engineer
 City & County of Honolulu
 Date: 6/17/68

STATE OF HAWAII
 DEPARTMENT OF TRANSPORTATION
 HIGHWAYS DIVISION

STREET LIGHTING SYSTEM
 INTERSTATE ROUTE H-1
 PROJ. NO. I-H1-1(64):12,
 UNIT 2
 Scale: As Shown Date: 8/19/68


SHEET No. 2 OF 4 SHEETS

FED. ROAD DIST. NO.	STATE	FED. AID PROJ. NO.	FISCAL YEAR	SHEET NO.	TOTAL SHEETS
HAWAII	HAW.	I-HI-1(64):12 UNIT 2 I-HI-1(16):11	1969	43	128

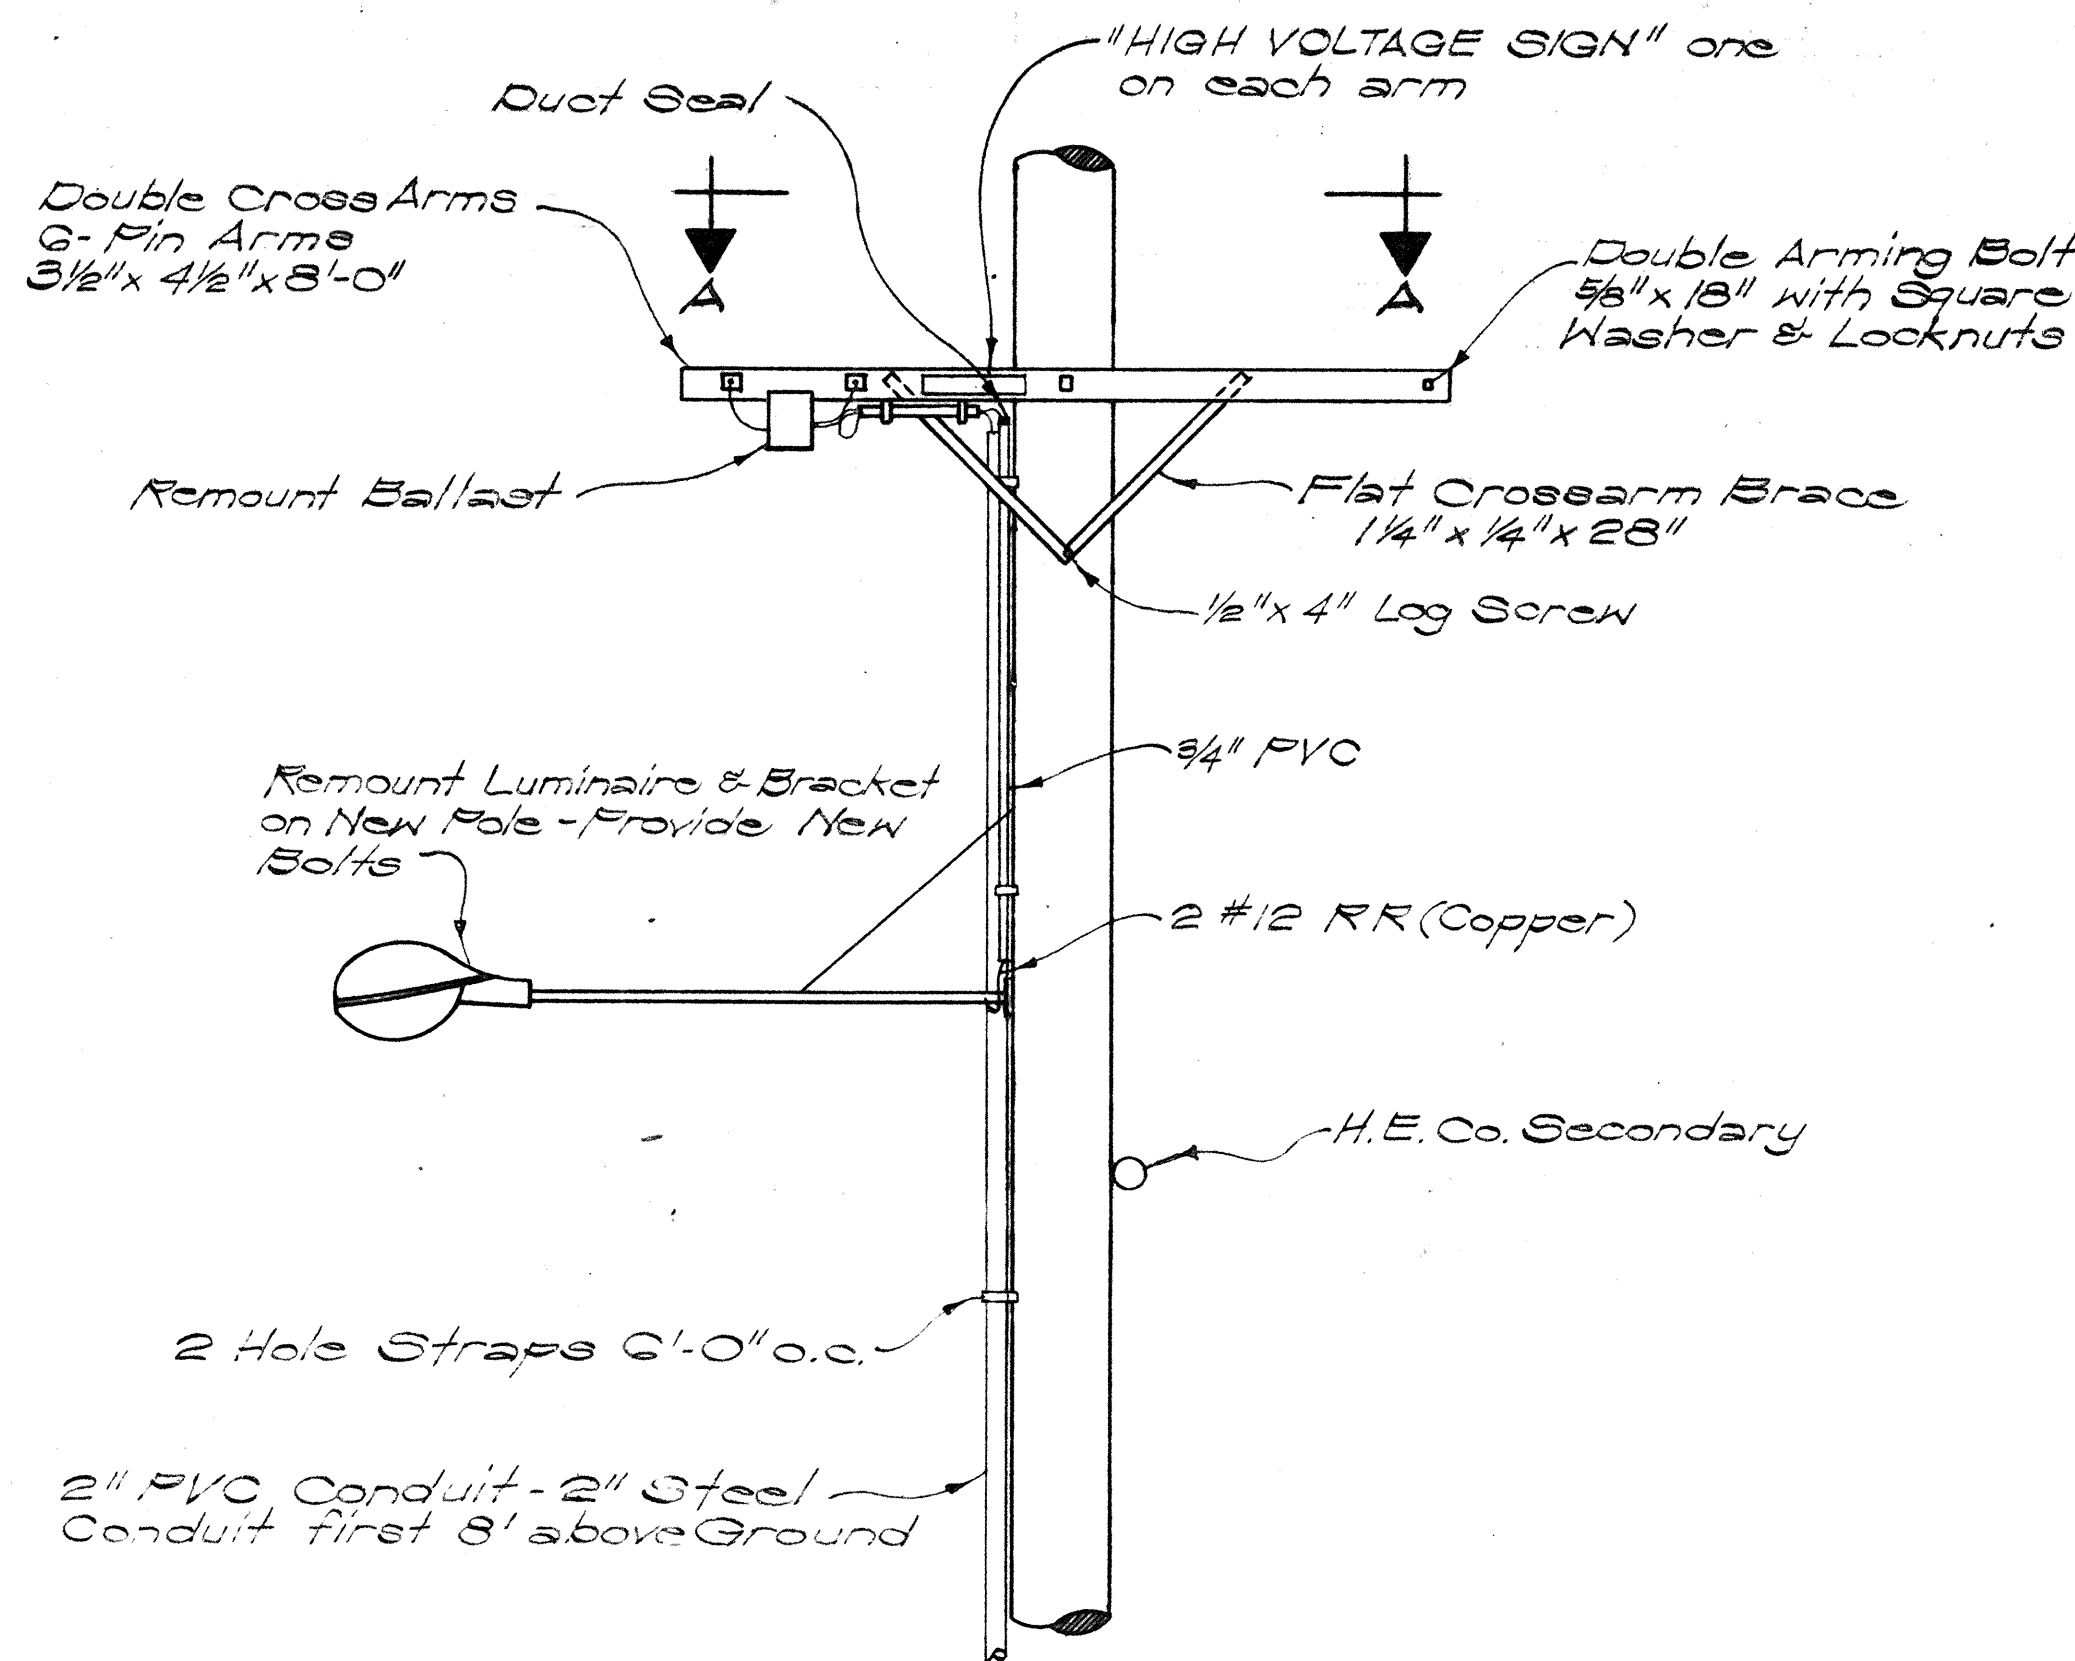


POLE P5X & P7X AIEA HEIGHTS DRIVE

Scale: 1/2" = 1'-0"

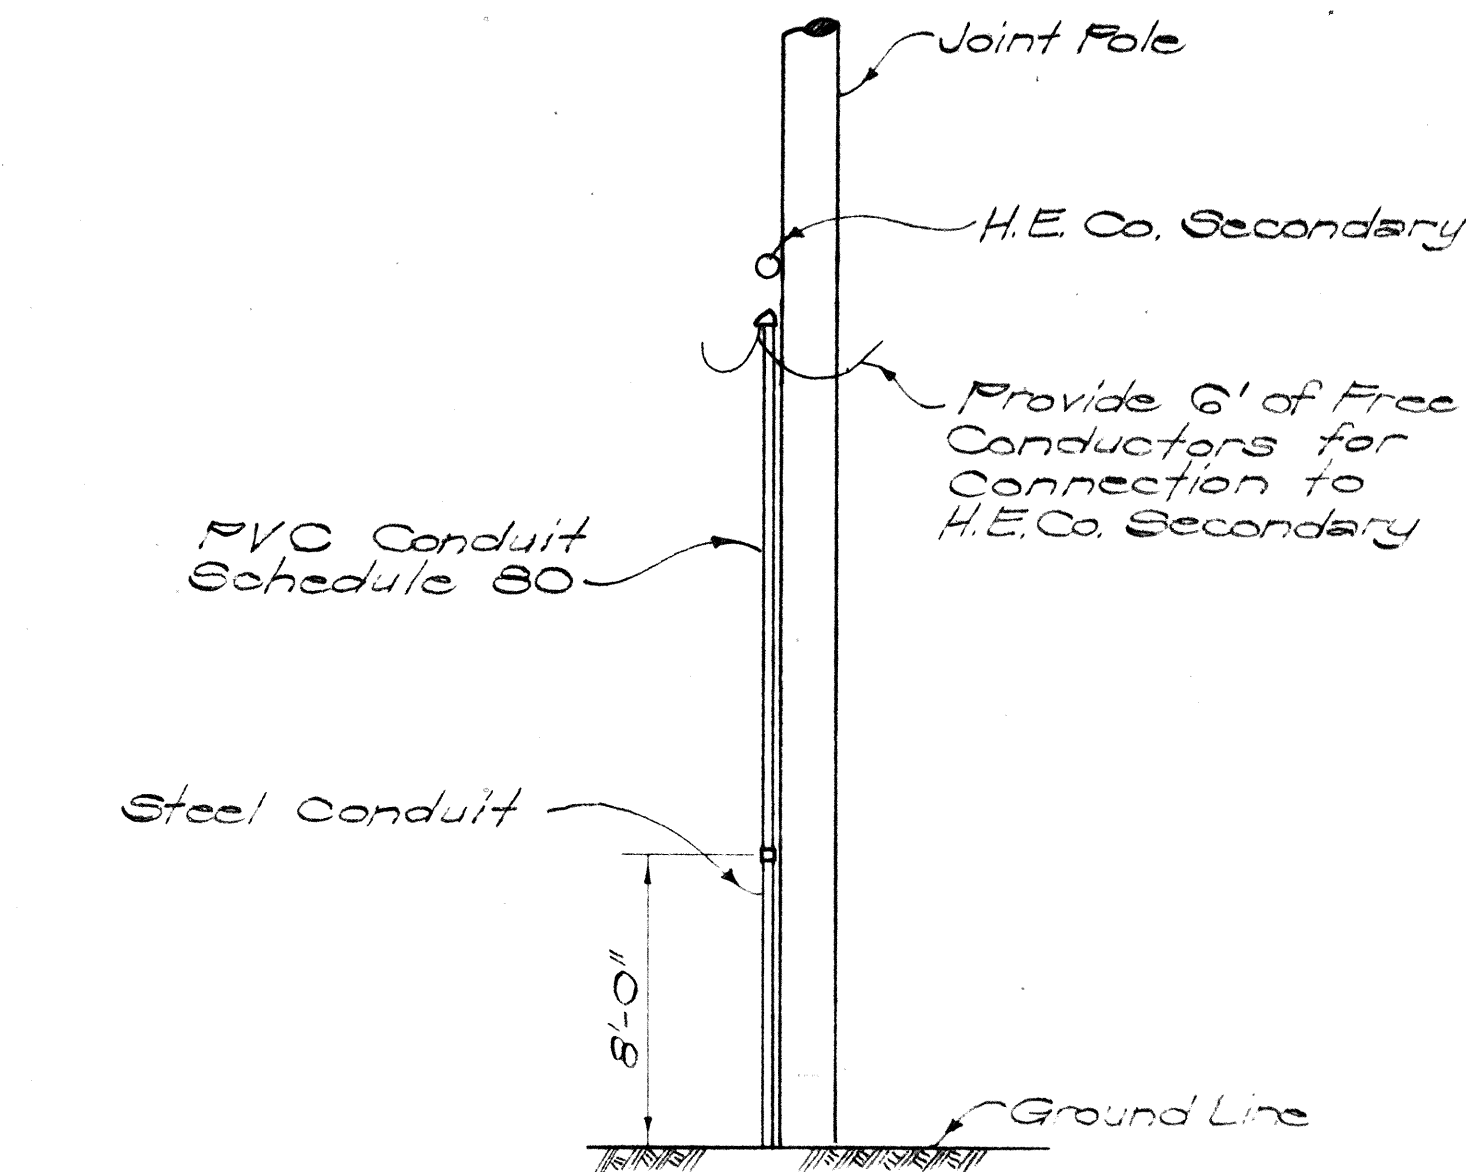


MULTIPLE CKT. RISER TO H.E.CO. SYSTEM

Scale: 3/4" = 1'-0"

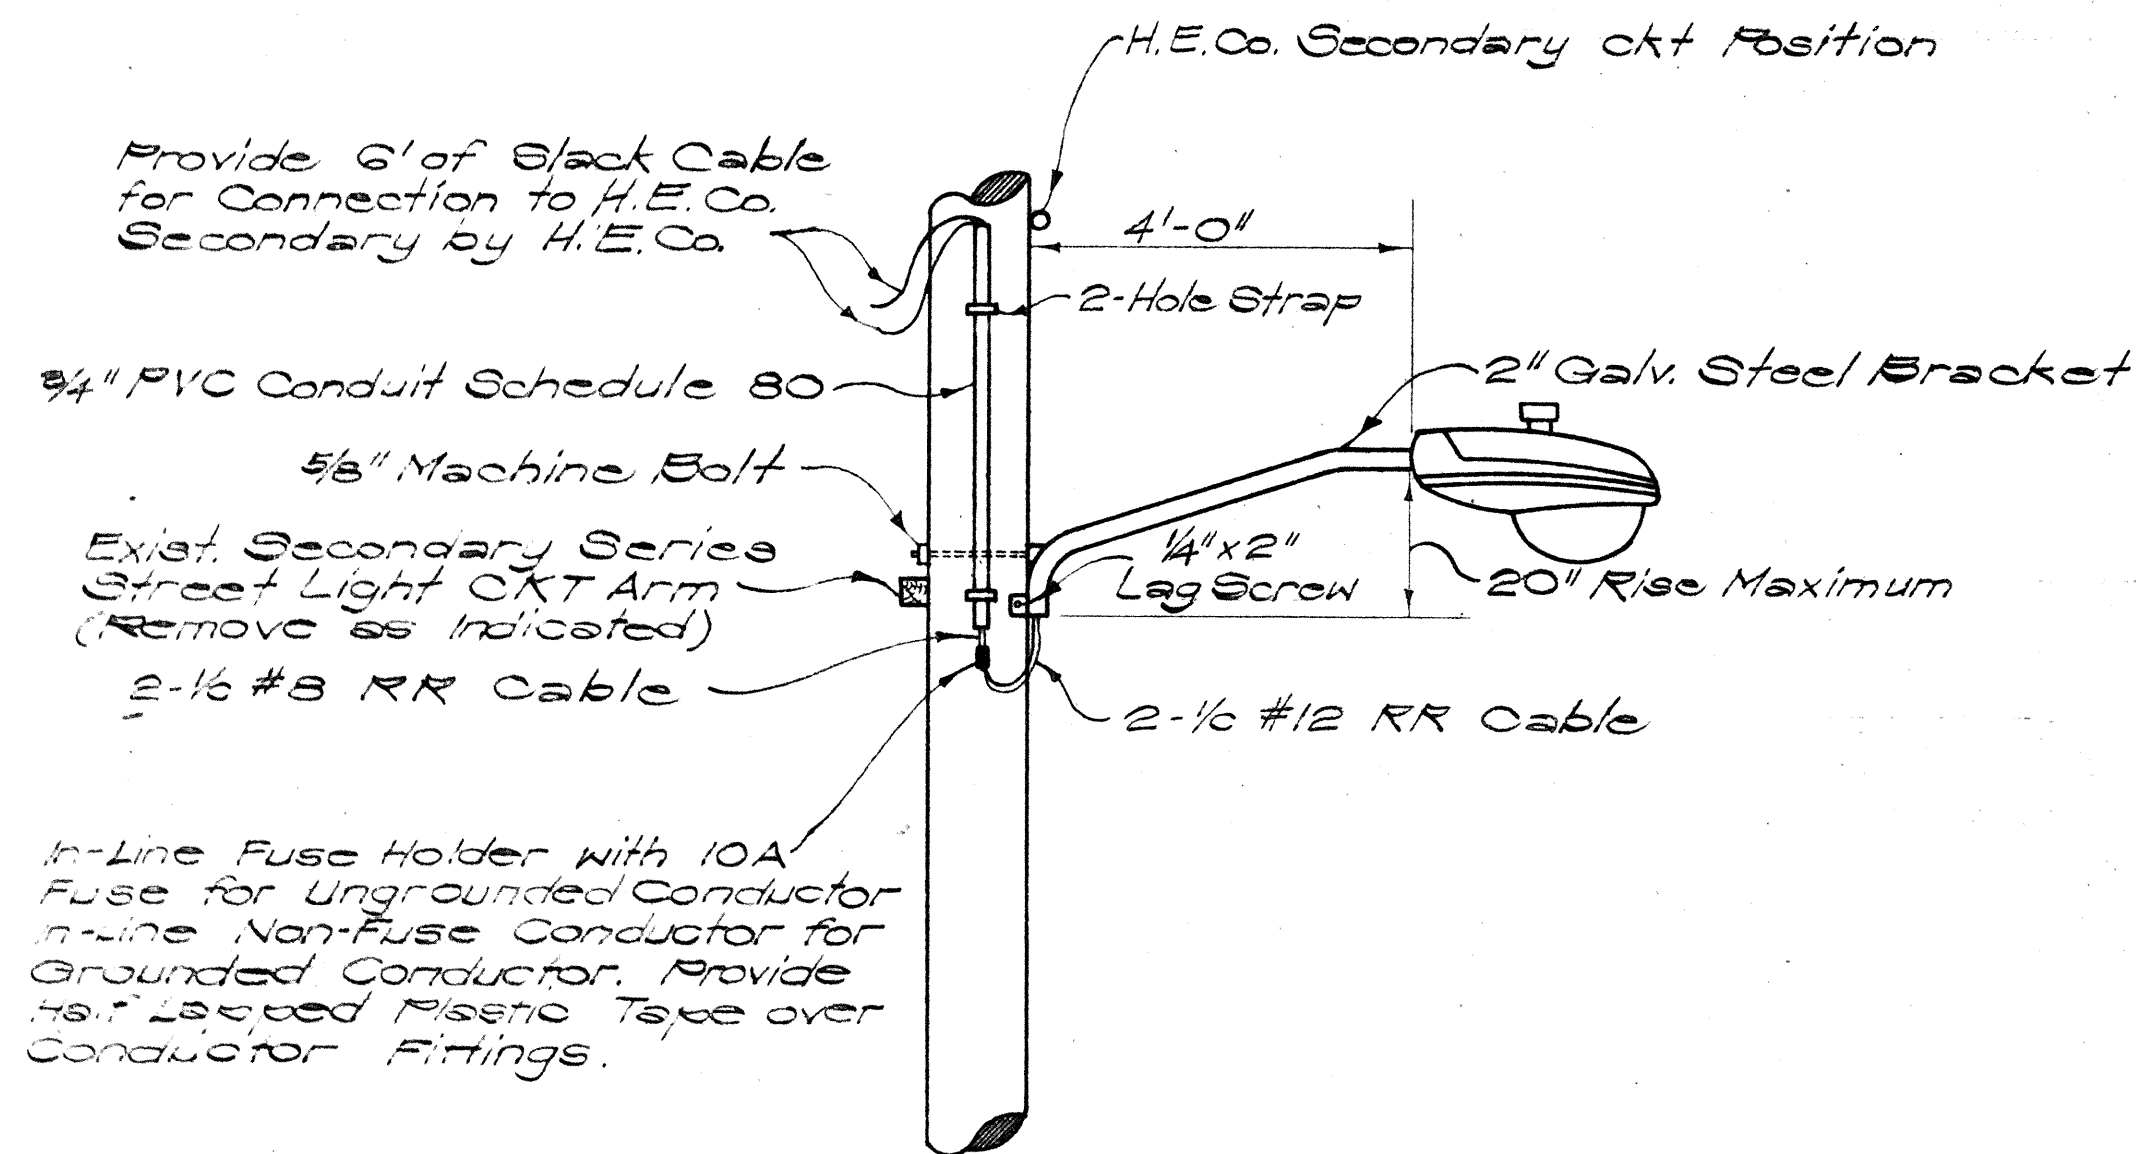


MULTIPLE STREET LIGHT MOUNTING DETAIL

Scale: 1/2" = 1'-0"

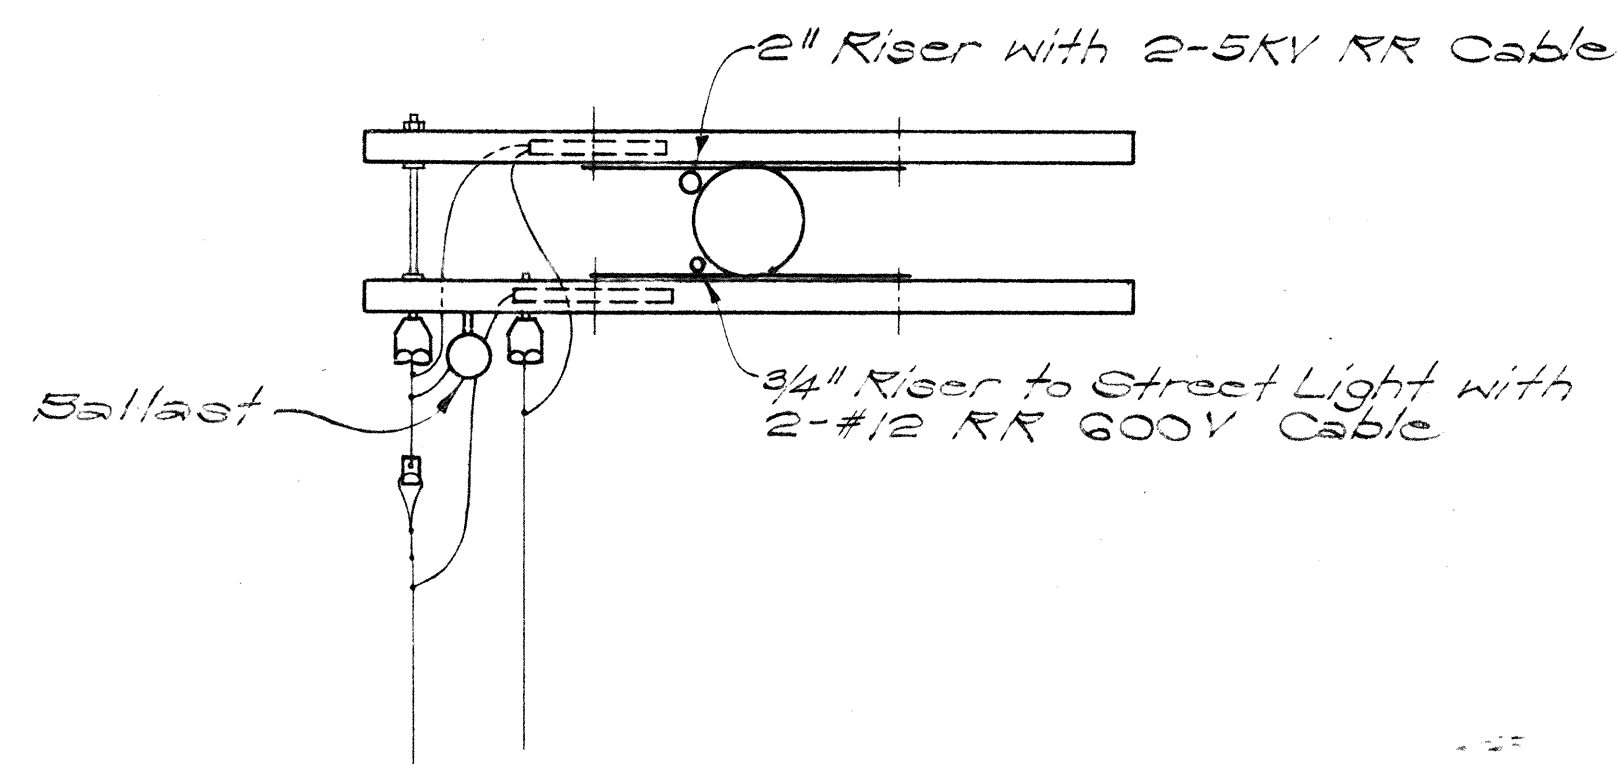

SECTION "A-A"

Scale: 1/2" = 1'-0"

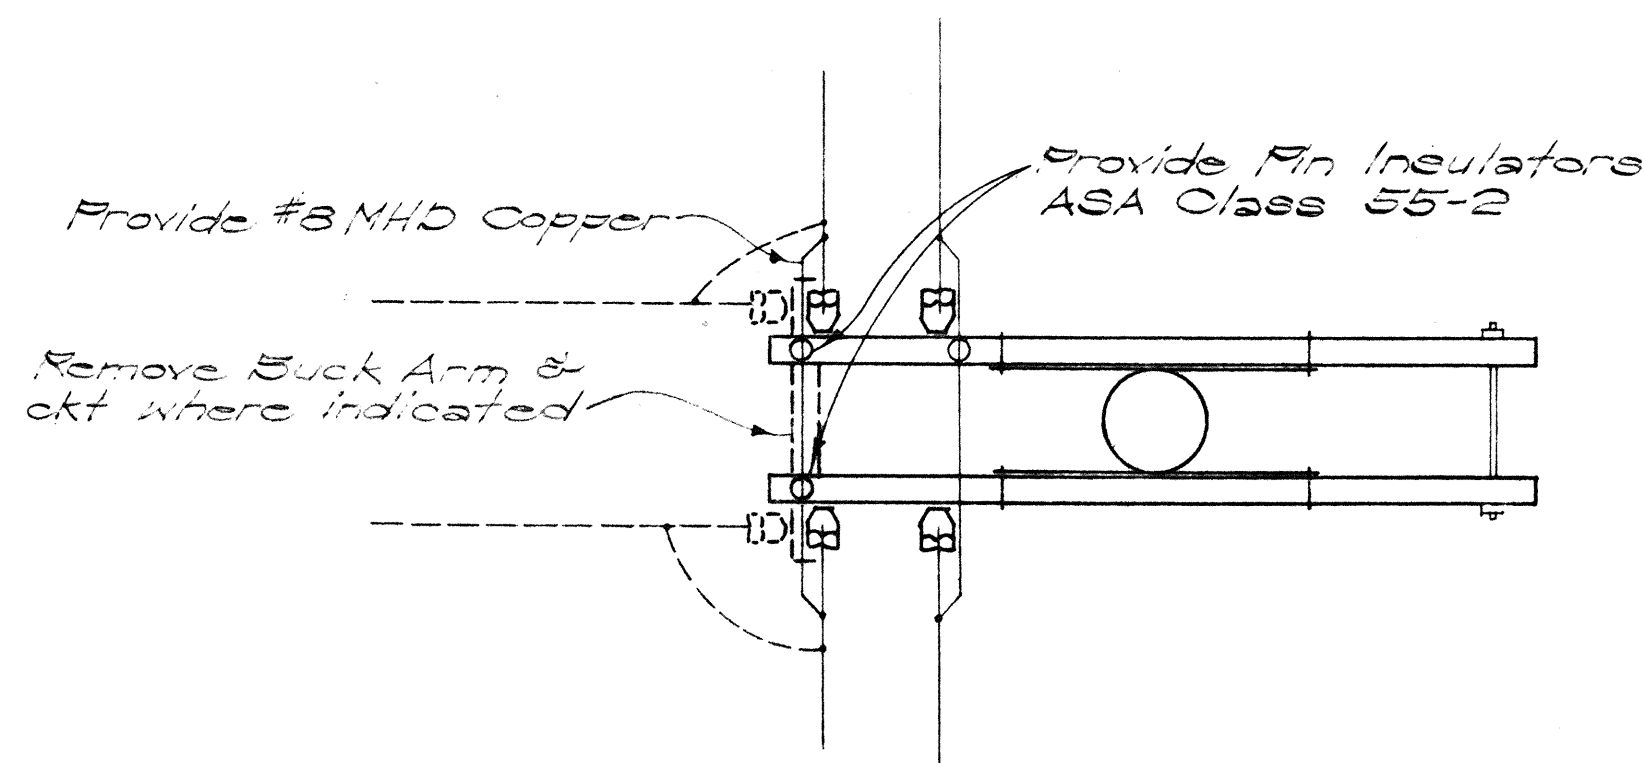


CLOSING SERIES CKT. LOOP

Scale: 1/2" = 1'-0"

Aluminum Nails on Wood Poles

Drill & Tap Post for 3/8" x Cadmium Coated Screw (Type)

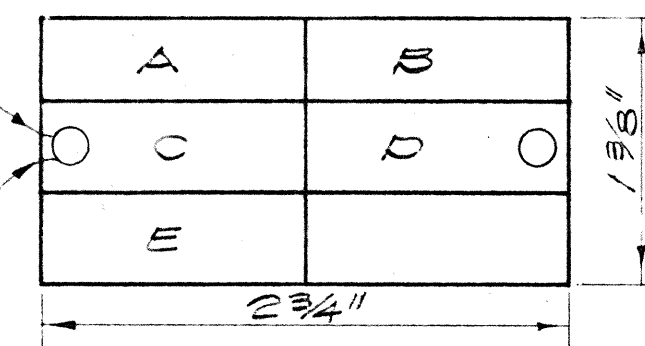

A = Contract Number (See Plan)
B = Light Number (See Plan)
C = Lamp Data "H-175C" or "H-250C" (See Plan)
D = Refractor Data "II"
E = Post Number (See Plan)

NOTES:

1. Tag shall be made from 0.040 Aluminum Sheet.
2. Mounting Height of Tag = 6'-6"
3. Letters - No. 5 Reduction, 1/8 Stencilled

IDENTIFICATION TAG FOR MULTIPLE STREET LIGHTING

Not To Scale



THIS WORK WAS PREPARED BY
ME OR UNDER MY SUPERVISION.

Tahiti Kavalat

Approved: Kenneth L. Long
Traffic Engineer
City & County of Honolulu

6/7/68
Date

STATE OF HAWAII
DEPARTMENT OF TRANSPORTATION
HIGHWAYS DIVISION


STREET LIGHTING
DETAILS

INTERSTATE ROUTE H-1
PROJ. NO. I-HI-1(64):12
UNIT 2


Scale: As Shown Date: 8/10/68

SHEET No. 3 OF 4 SHEETS

FED. ROAD DIST. NO.	STATE	FED. AID PROJ. NO.	FISCAL YEAR	SHEET NO.	TOTAL SHEETS
HAWAII	HAW.	I-H-1(64)-12 UNIT 2	1969	44	128
		I-H-1(6)-11			

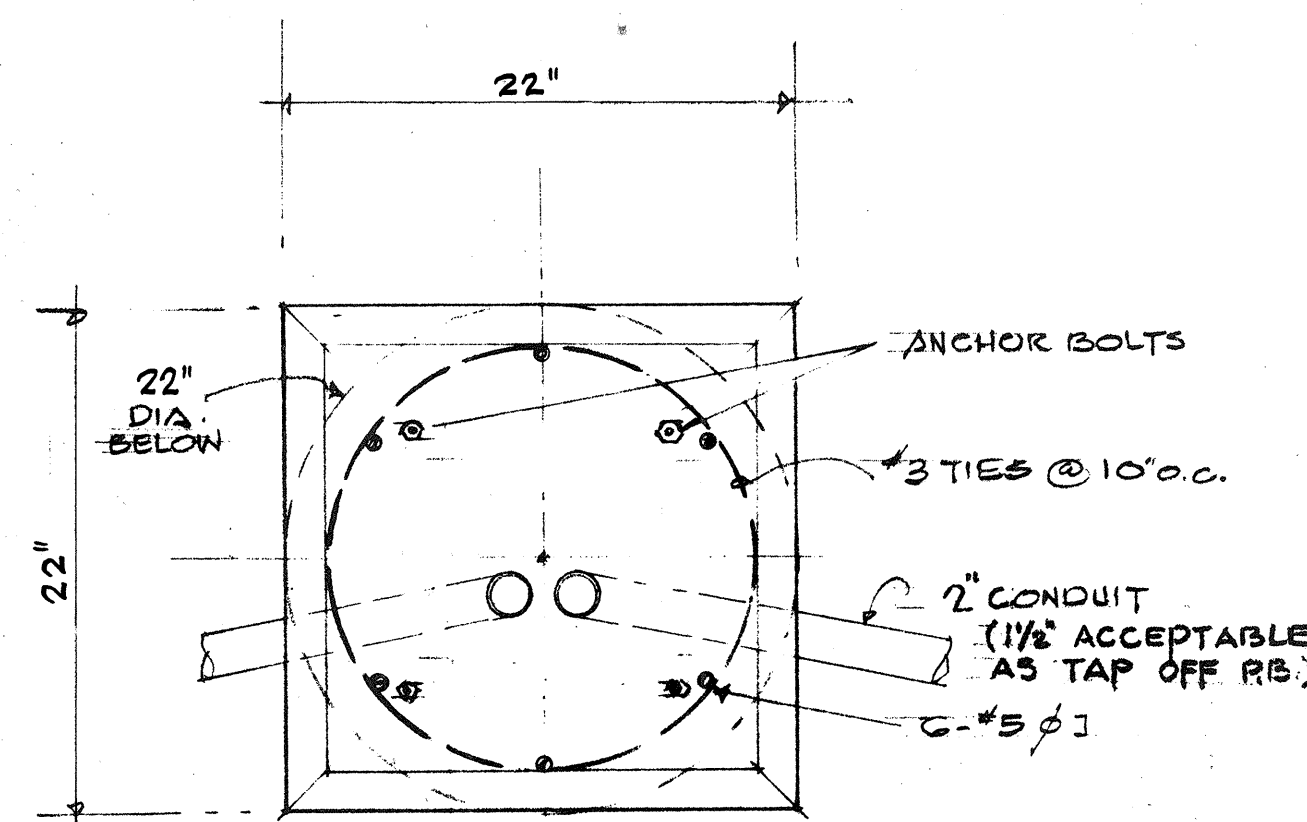


PLAN AT.S.

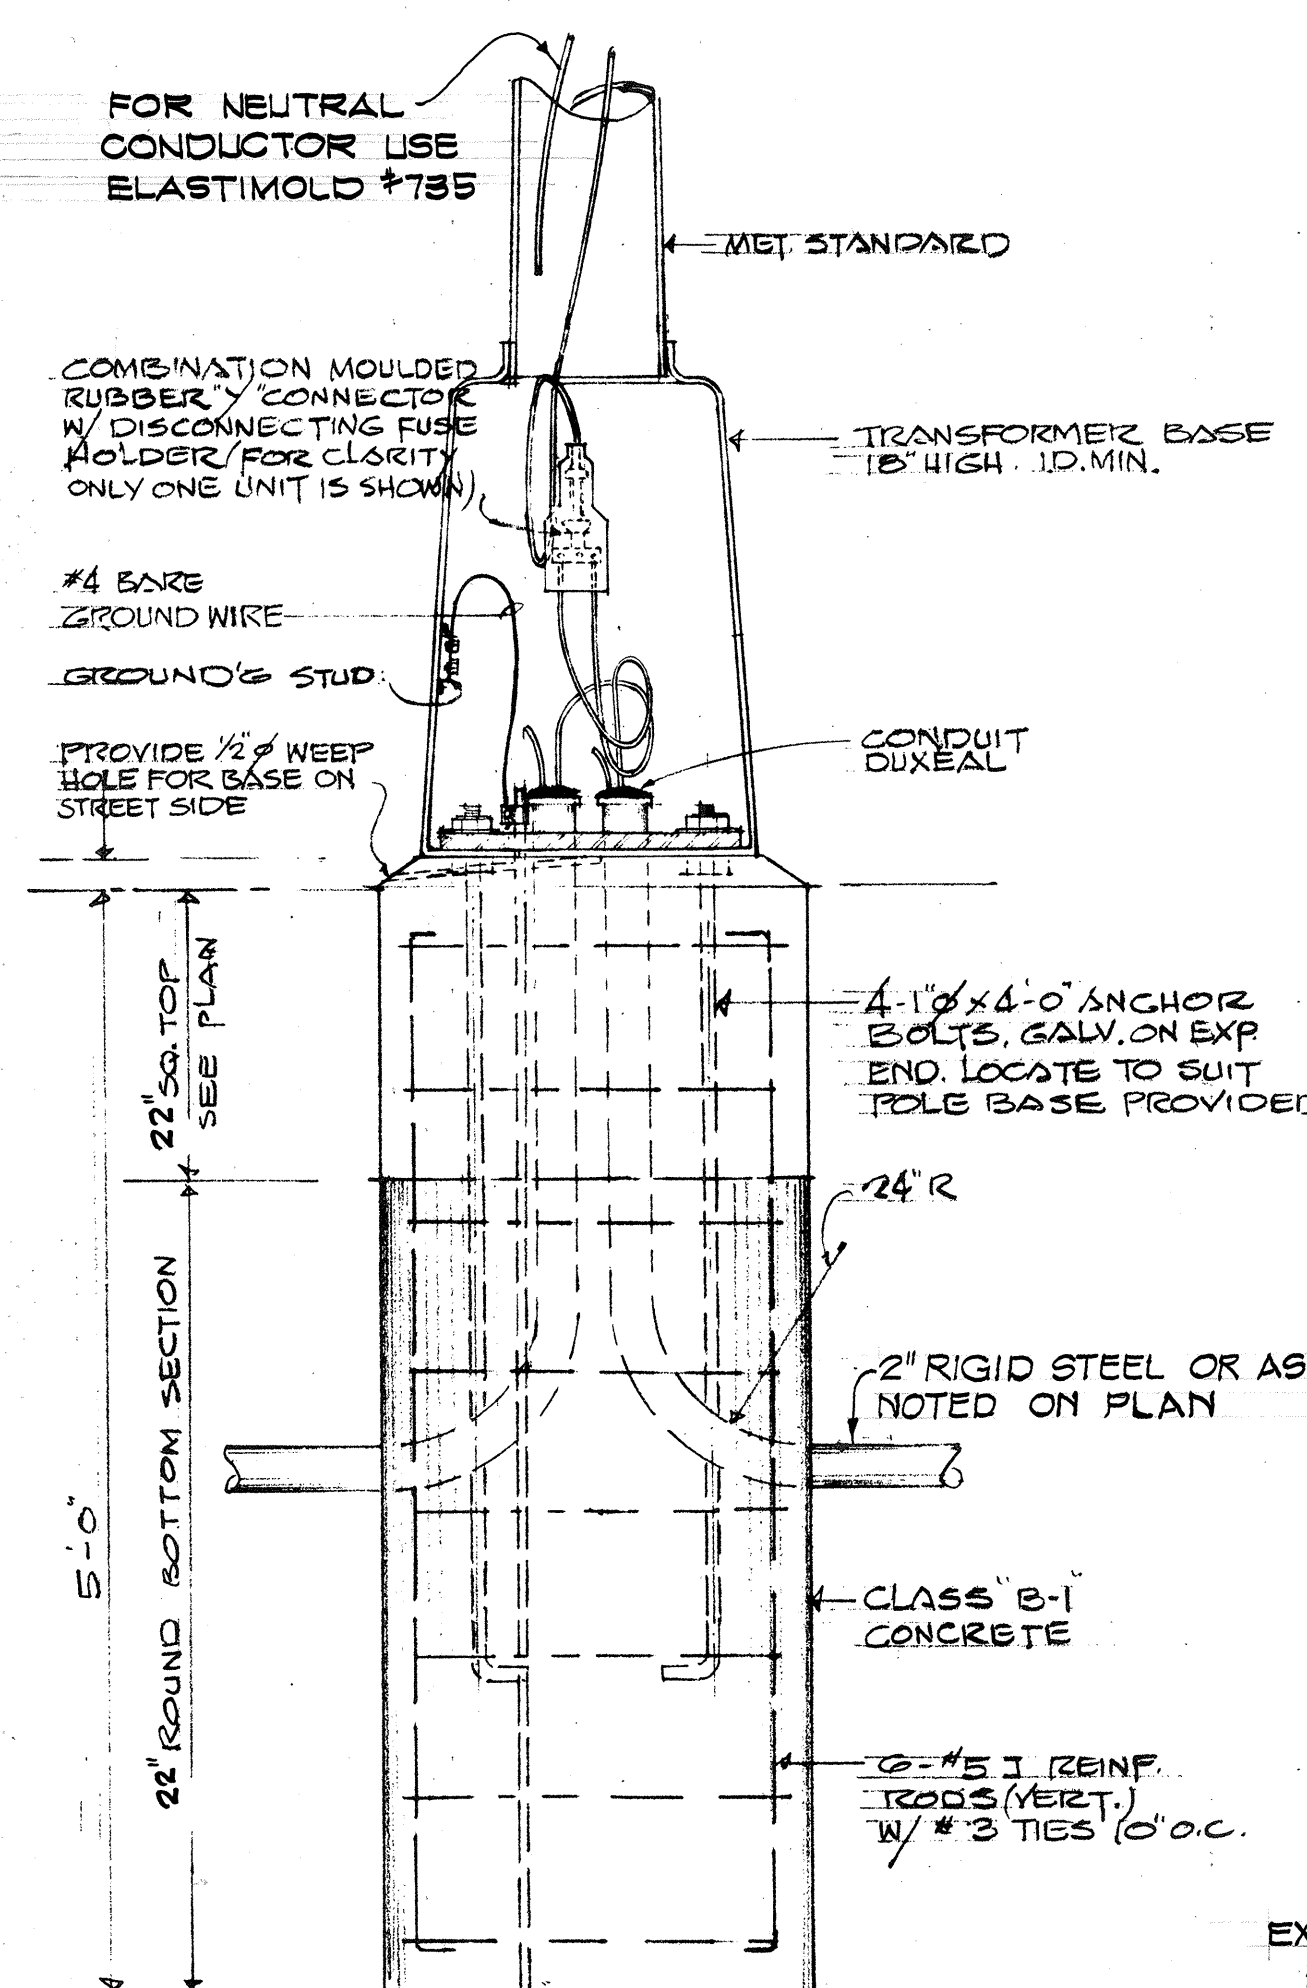


SECTION


METAL POLE DETAILS

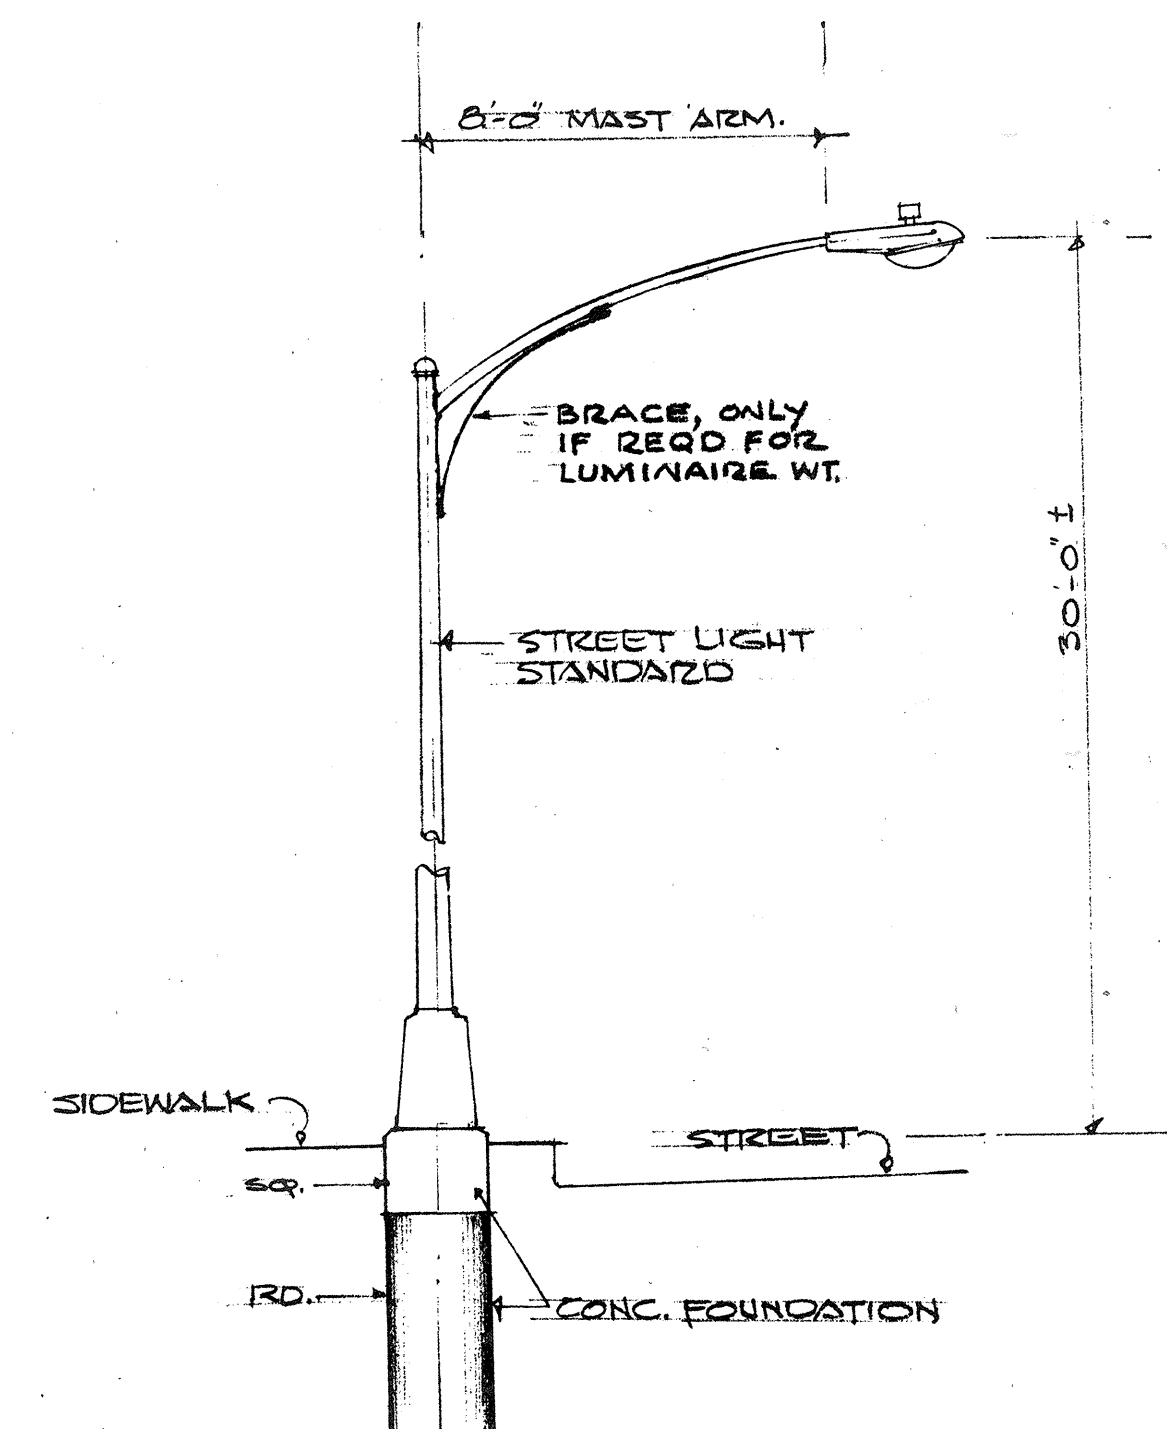


TYPICAL STREET LIGHT & STANDARD ELEVATION

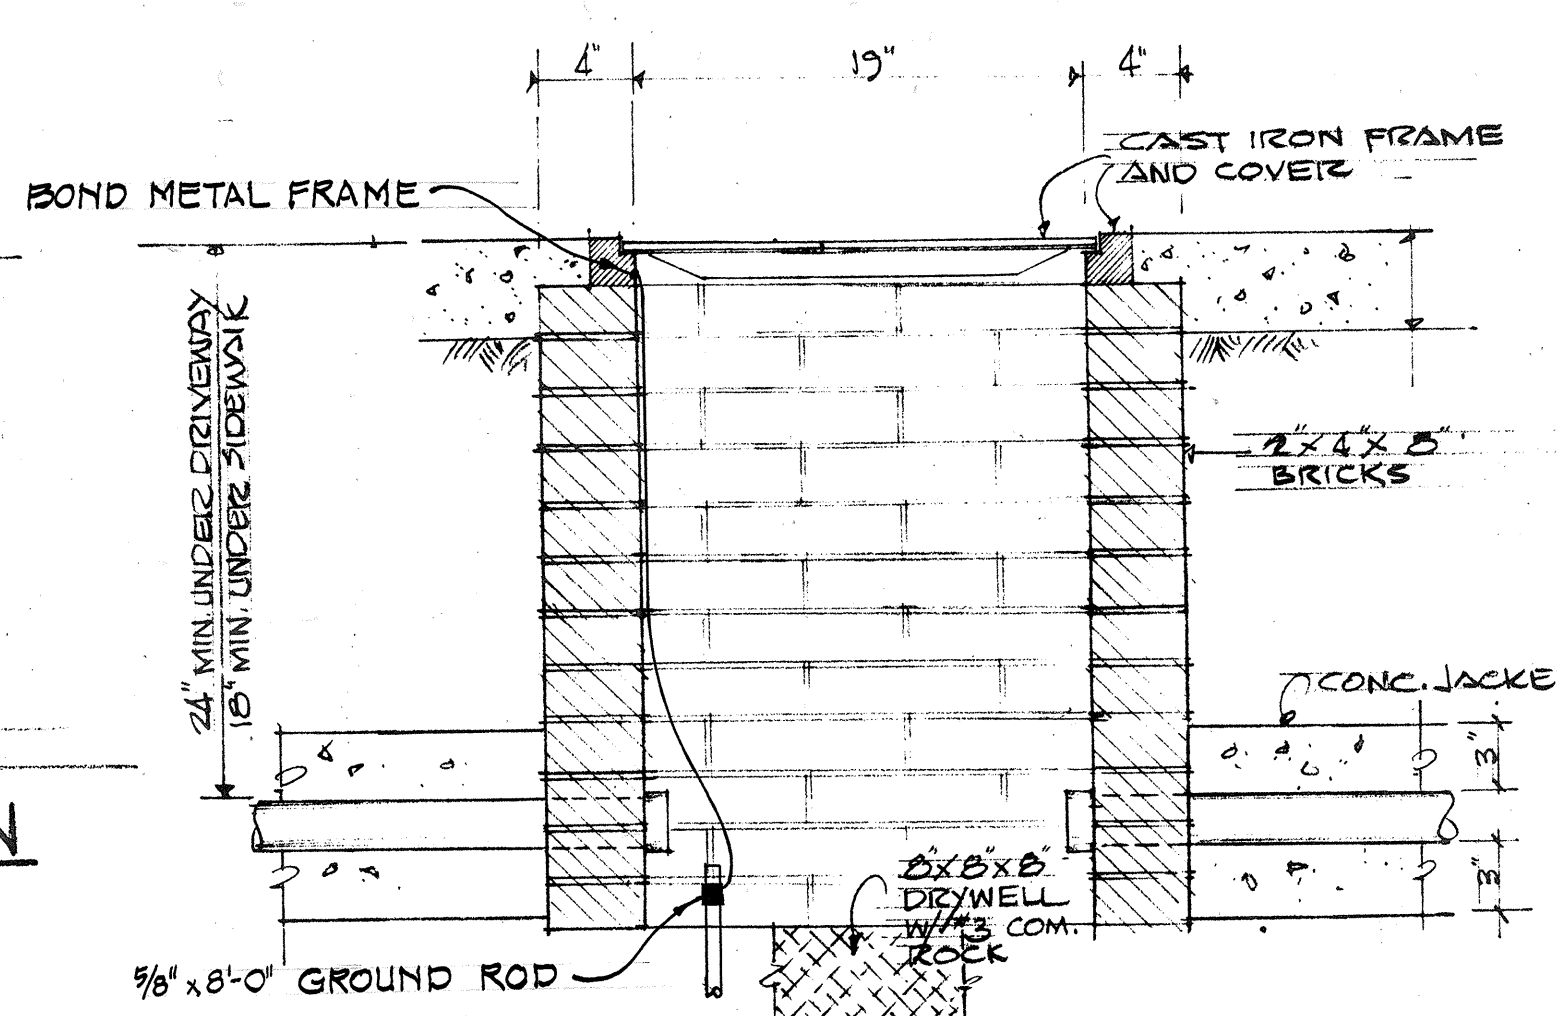

SECTION A-A

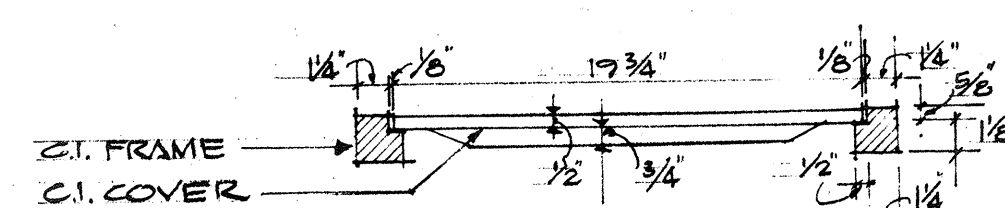


C.I. COVER & FRAME SECTION

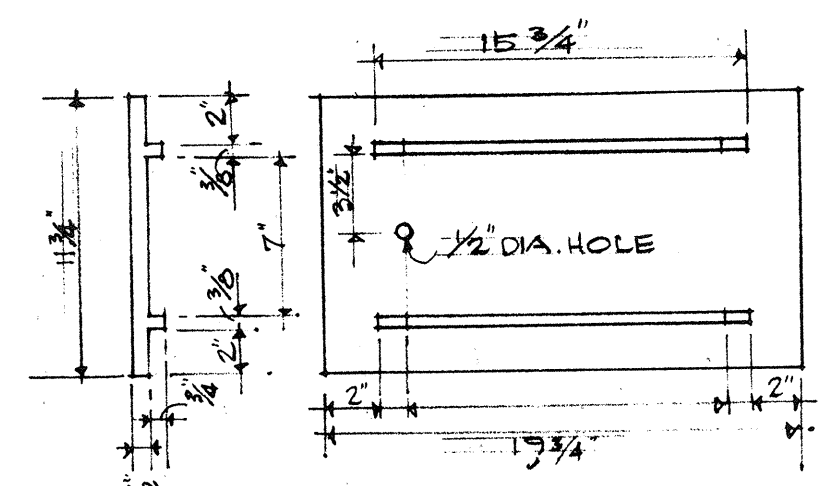


BOTTOM VIEW OF COVER PLATE

DETAILS FOR TYPE I SLD PULL BOX

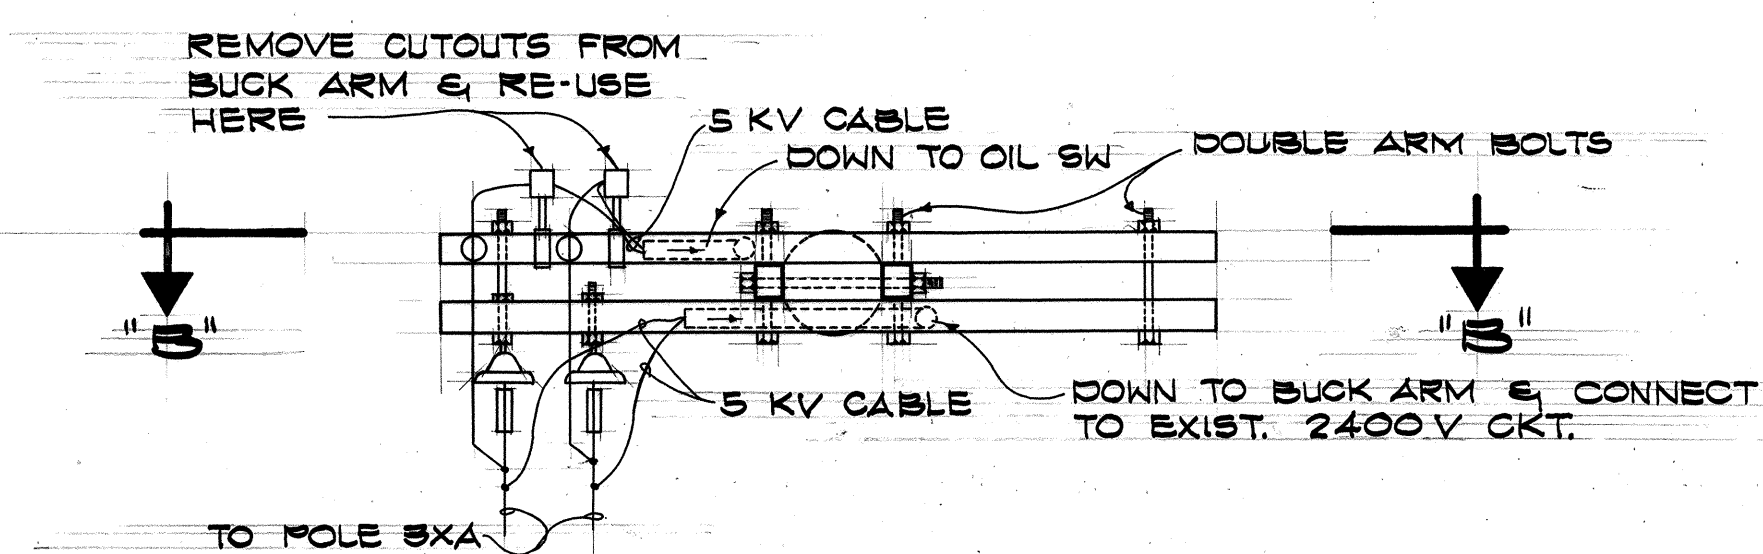

PLAN

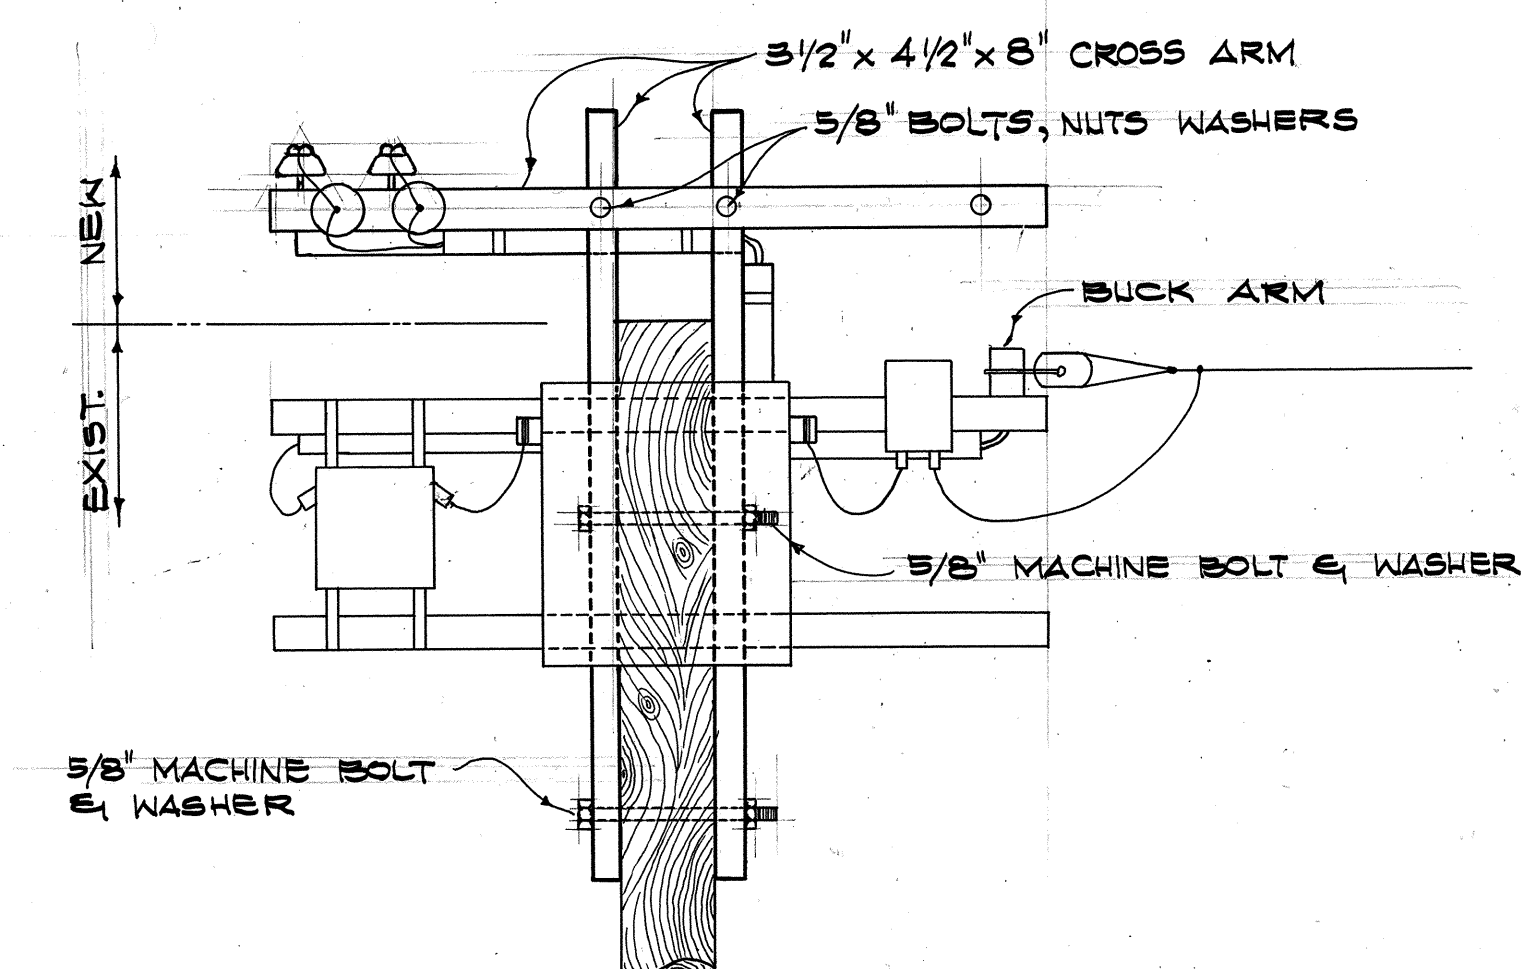

SECTION B-B

DETAILS FOR UTILITY POLE 4XA



THIS WORK WAS PREPARED BY ME OR UNDER MY SUPERVISION:
Taketo Kawabata

Approved: Kenneth L. Flap
for Traffic Engineer
City & County of Honolulu

6/7/68
Date

STATE OF HAWAII
DEPARTMENT OF TRANSPORTATION
HIGHWAYS DIVISION

STREET LIGHTING DETAILS

INTERSTATE ROUTE H-1
PROJ. NO. I-H-1(64)-12
UNIT 2

Scale: As Shown Date: 8/10/68

SHEET No. 4 OF 4 SHEETS