

INDEX TO DRAWINGS	
SHEET NO.	DESCRIPTION
1	TITLE SHEET
2-12	MILLER ST. PEDESTRIAN OVERCROSSING
13-26	ALAPAI ST. PEDESTRIAN OVERCROSSING
27-32	MISC. DETAILS
33-34	CONSTRUCTION I.D. SIGN
Co-185	ALAPAI ST. PEDESTRIAN OVERCROSSING

STATE OF HAWAII
DEPARTMENT OF TRANSPORTATION
HIGHWAYS DIVISION
HONOLULU, HAWAII
"AS BUILT"
PLANS FOR
CONSTRUCTION OF


PEDESTRIAN OVERPASSES OVER INTERSTATE H-1
AT MILLER STREET & ALAPAI STREET

FEDERAL AID INTERSTATE PROJECT NO. I-HI-1(31):21 UNIT 4

DISTRICT OF HONOLULU
ISLAND OF OAHU


FED. ROAD DIST. NO.	STATE	FED. AID PROJ. NO.	FISCAL YEAR	SHEET NO.	TOTAL SHEETS
HAWAII	HAW.	I-HI-1(31):21 Unit 4	1969	1	34

Revised: April 20, 1969

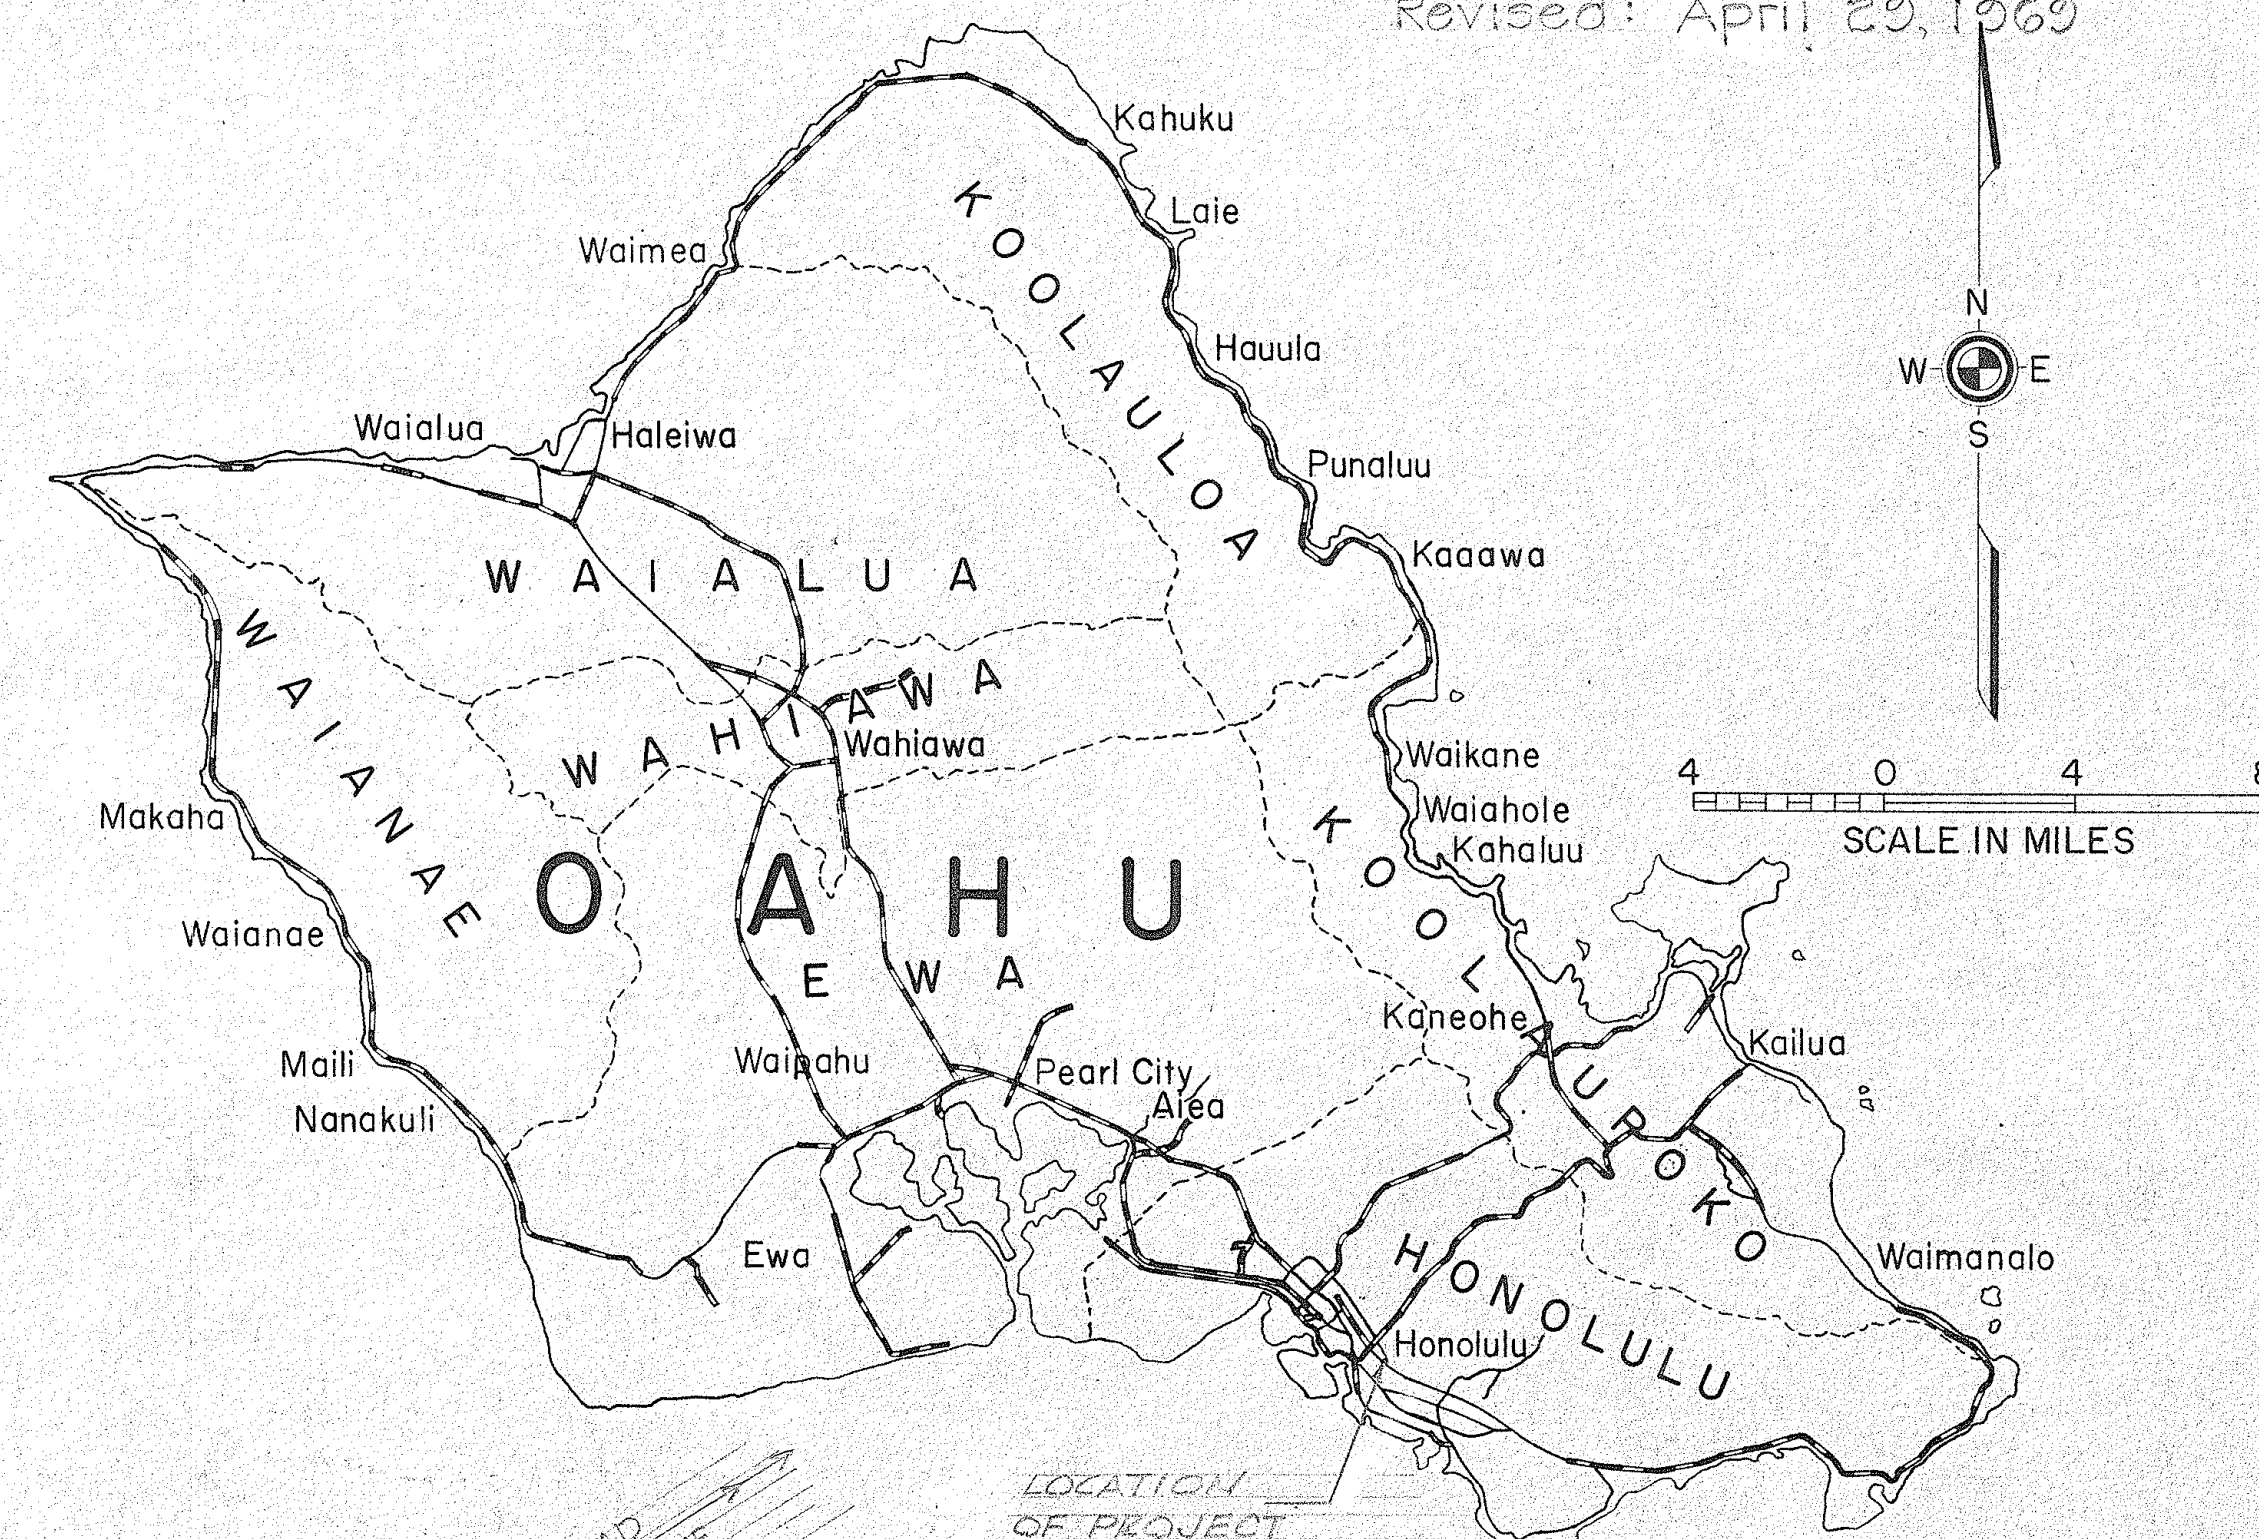

NOTE:
ALL CHANGES MADE DURING CONSTRUCTION
HAVE BEEN NOTED IN RED ON THESE TRACINGS
AND CHECKED BY
Robert J. Oman
PROJECT ENGINEER
2/23/71
DATE

⊗ FALSEWORK CLEAR OPENING REQUIREMENT
FOR VEHICULAR TRAFFIC LANES.

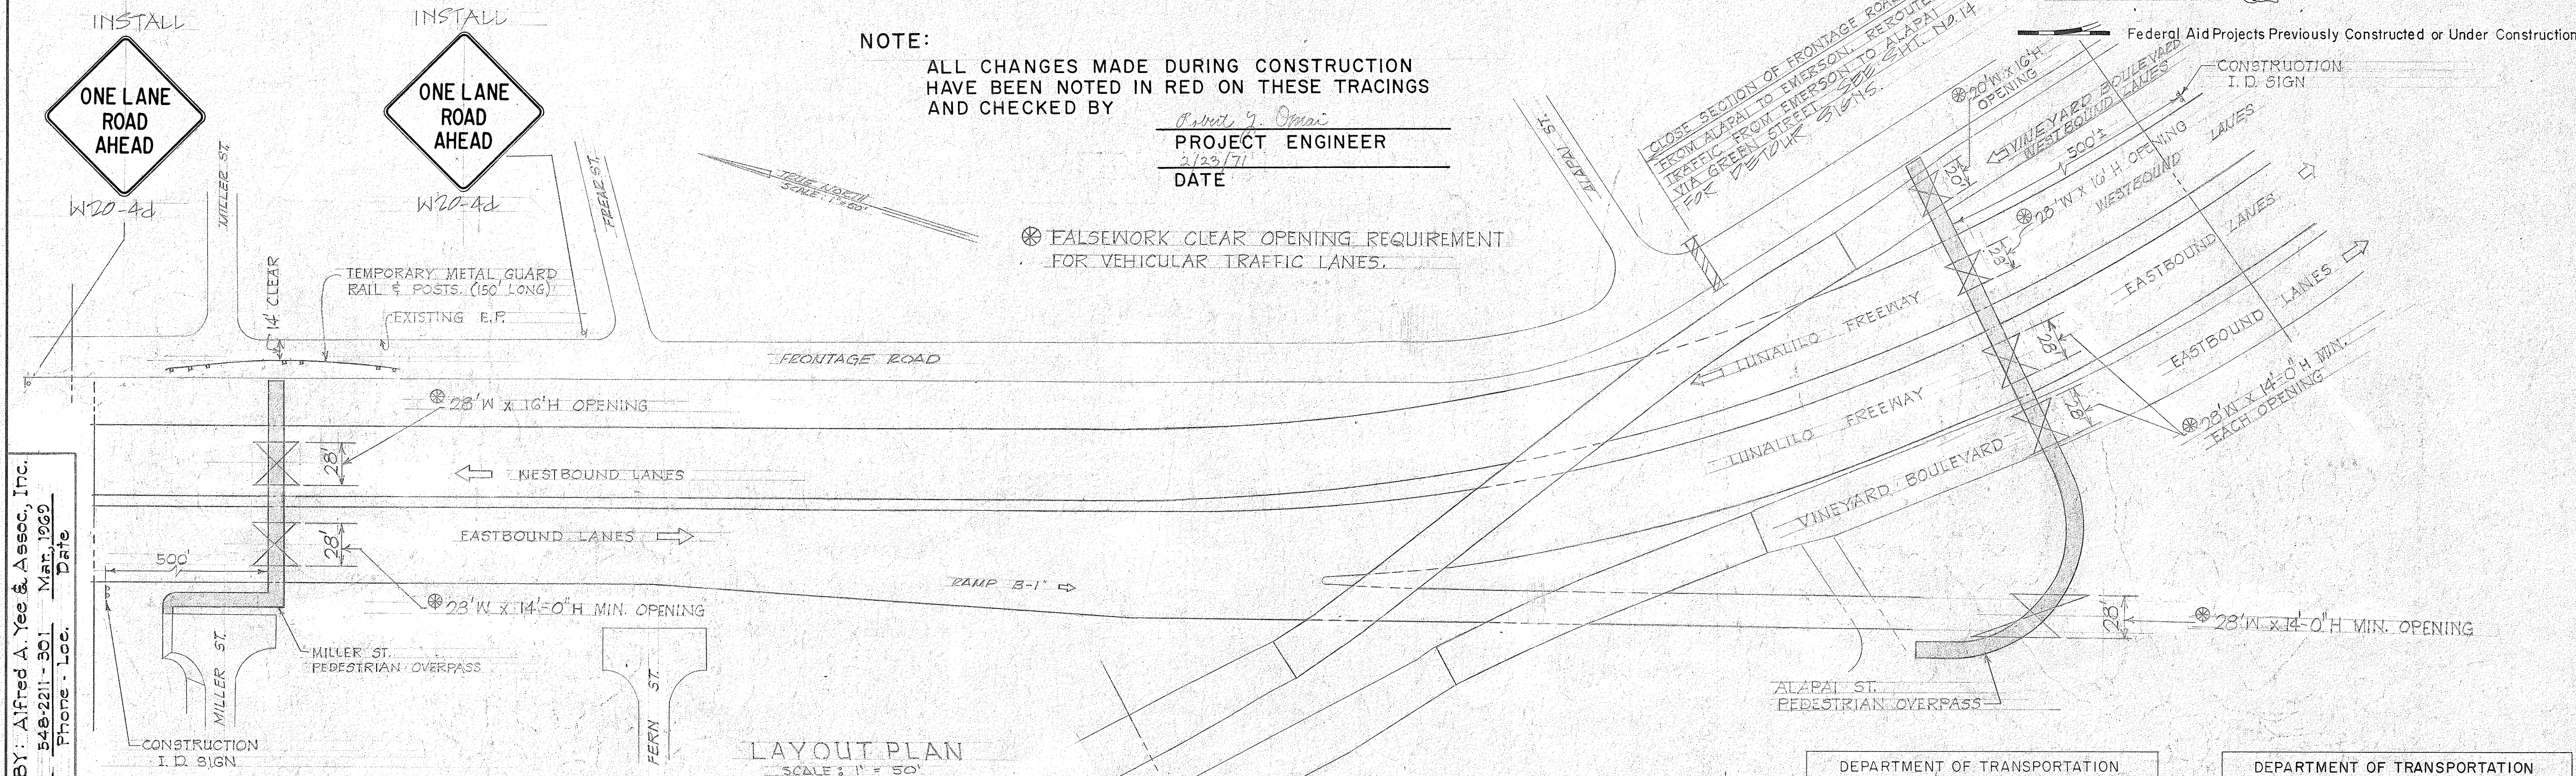

DESIGNED BY: Alfred A. Yee & Assoc., Inc.
Mike Miura 548-2211-301 Mar, 1969
P.S. & E. BY: Phone - Loc. Date

DEPARTMENT OF TRANSPORTATION
BUREAU OF PUBLIC ROADS
APPROVED:
Neil D. Smith 5-1-69
DIVISION ENGINEER DATE

DEPARTMENT OF TRANSPORTATION
STATE OF HAWAII
APPROVED:
E. Alvey Knight 4/15/69
for DIR. OF TRANSPORTATION DATE