



DES. NO.	DATE	REV. NO.	REV. DATE	SHEET NO.	TOTAL SHEETS
445111	11-11-1969	1	11-11-1969	5	20

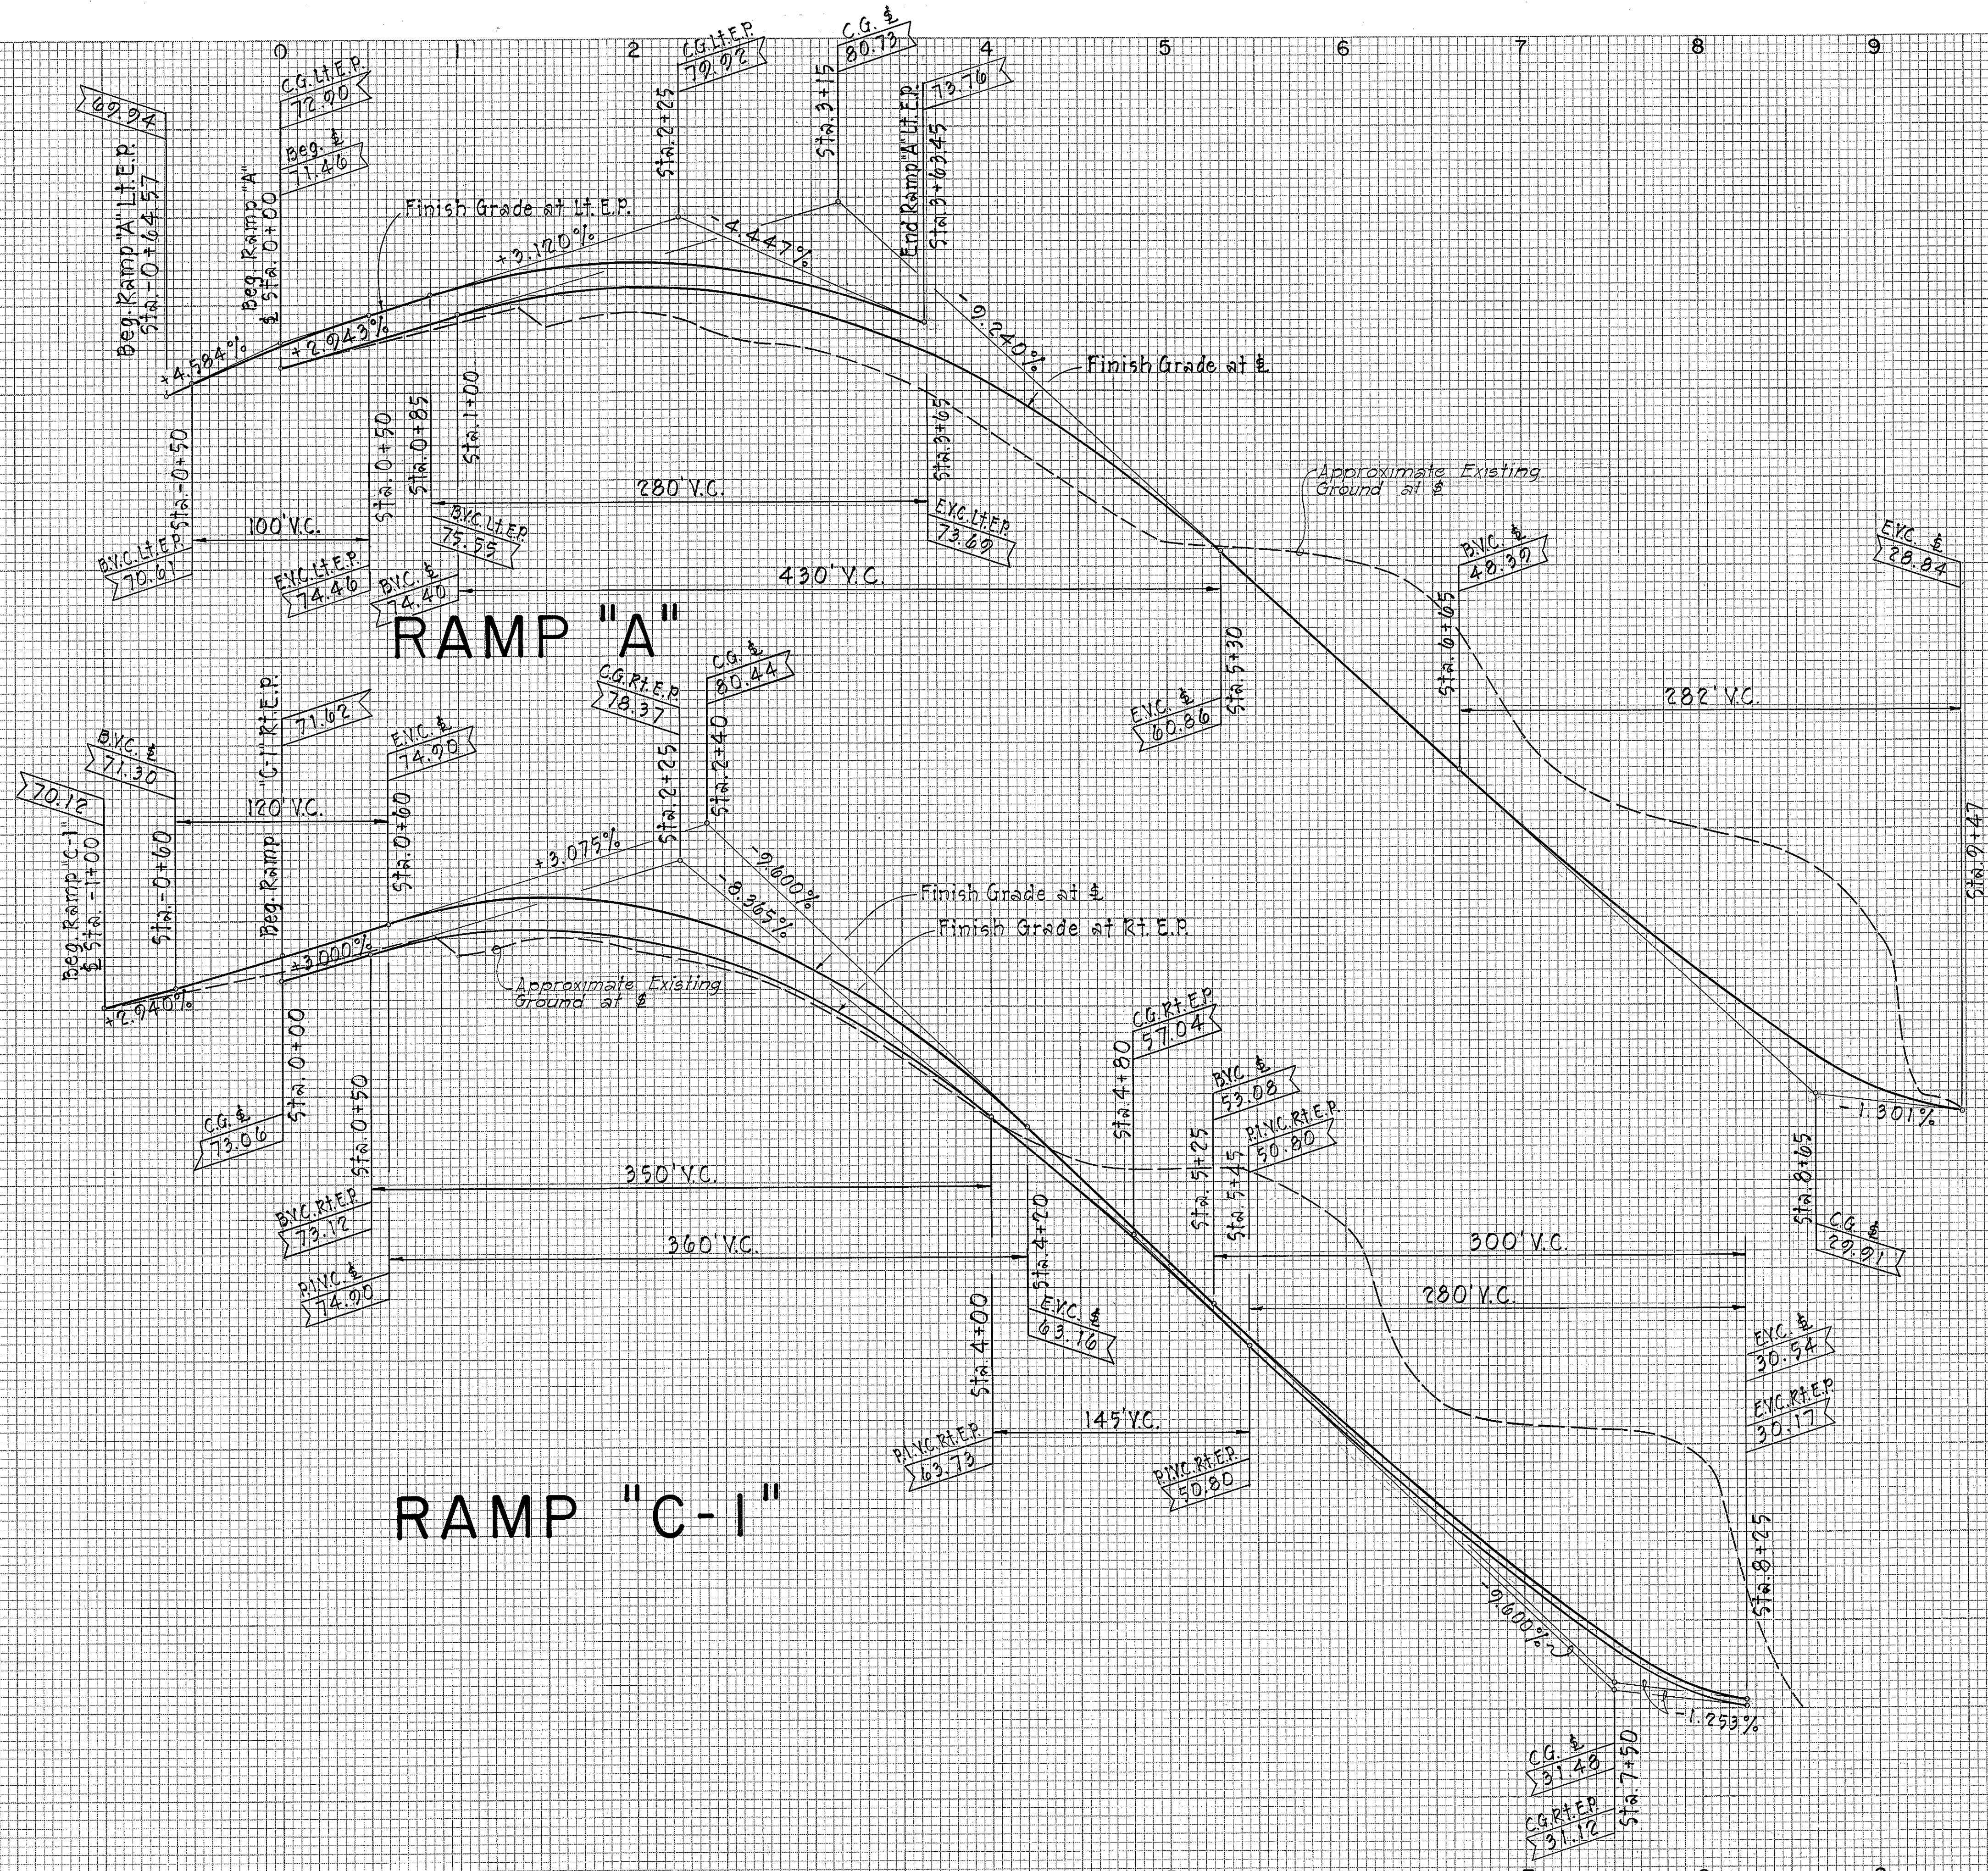

FINAL	SURVEY	DATE
NO.	PLATE	
NO.	NO.	
NO.	NO.	
NO.	NO.	

ORIGINAL	SURVEY	DATE
NO.	PLATE	
NO.	NO.	
NO.	NO.	
NO.	NO.	

PRO. ROAD	STATE	PRO. AID	FISCAL	SHEET	TOTAL
NO.	NO.	NO.	NO.	NO.	SHEETS
HAWAII	HAW.	I-HI-11(74)10	1969	6	20

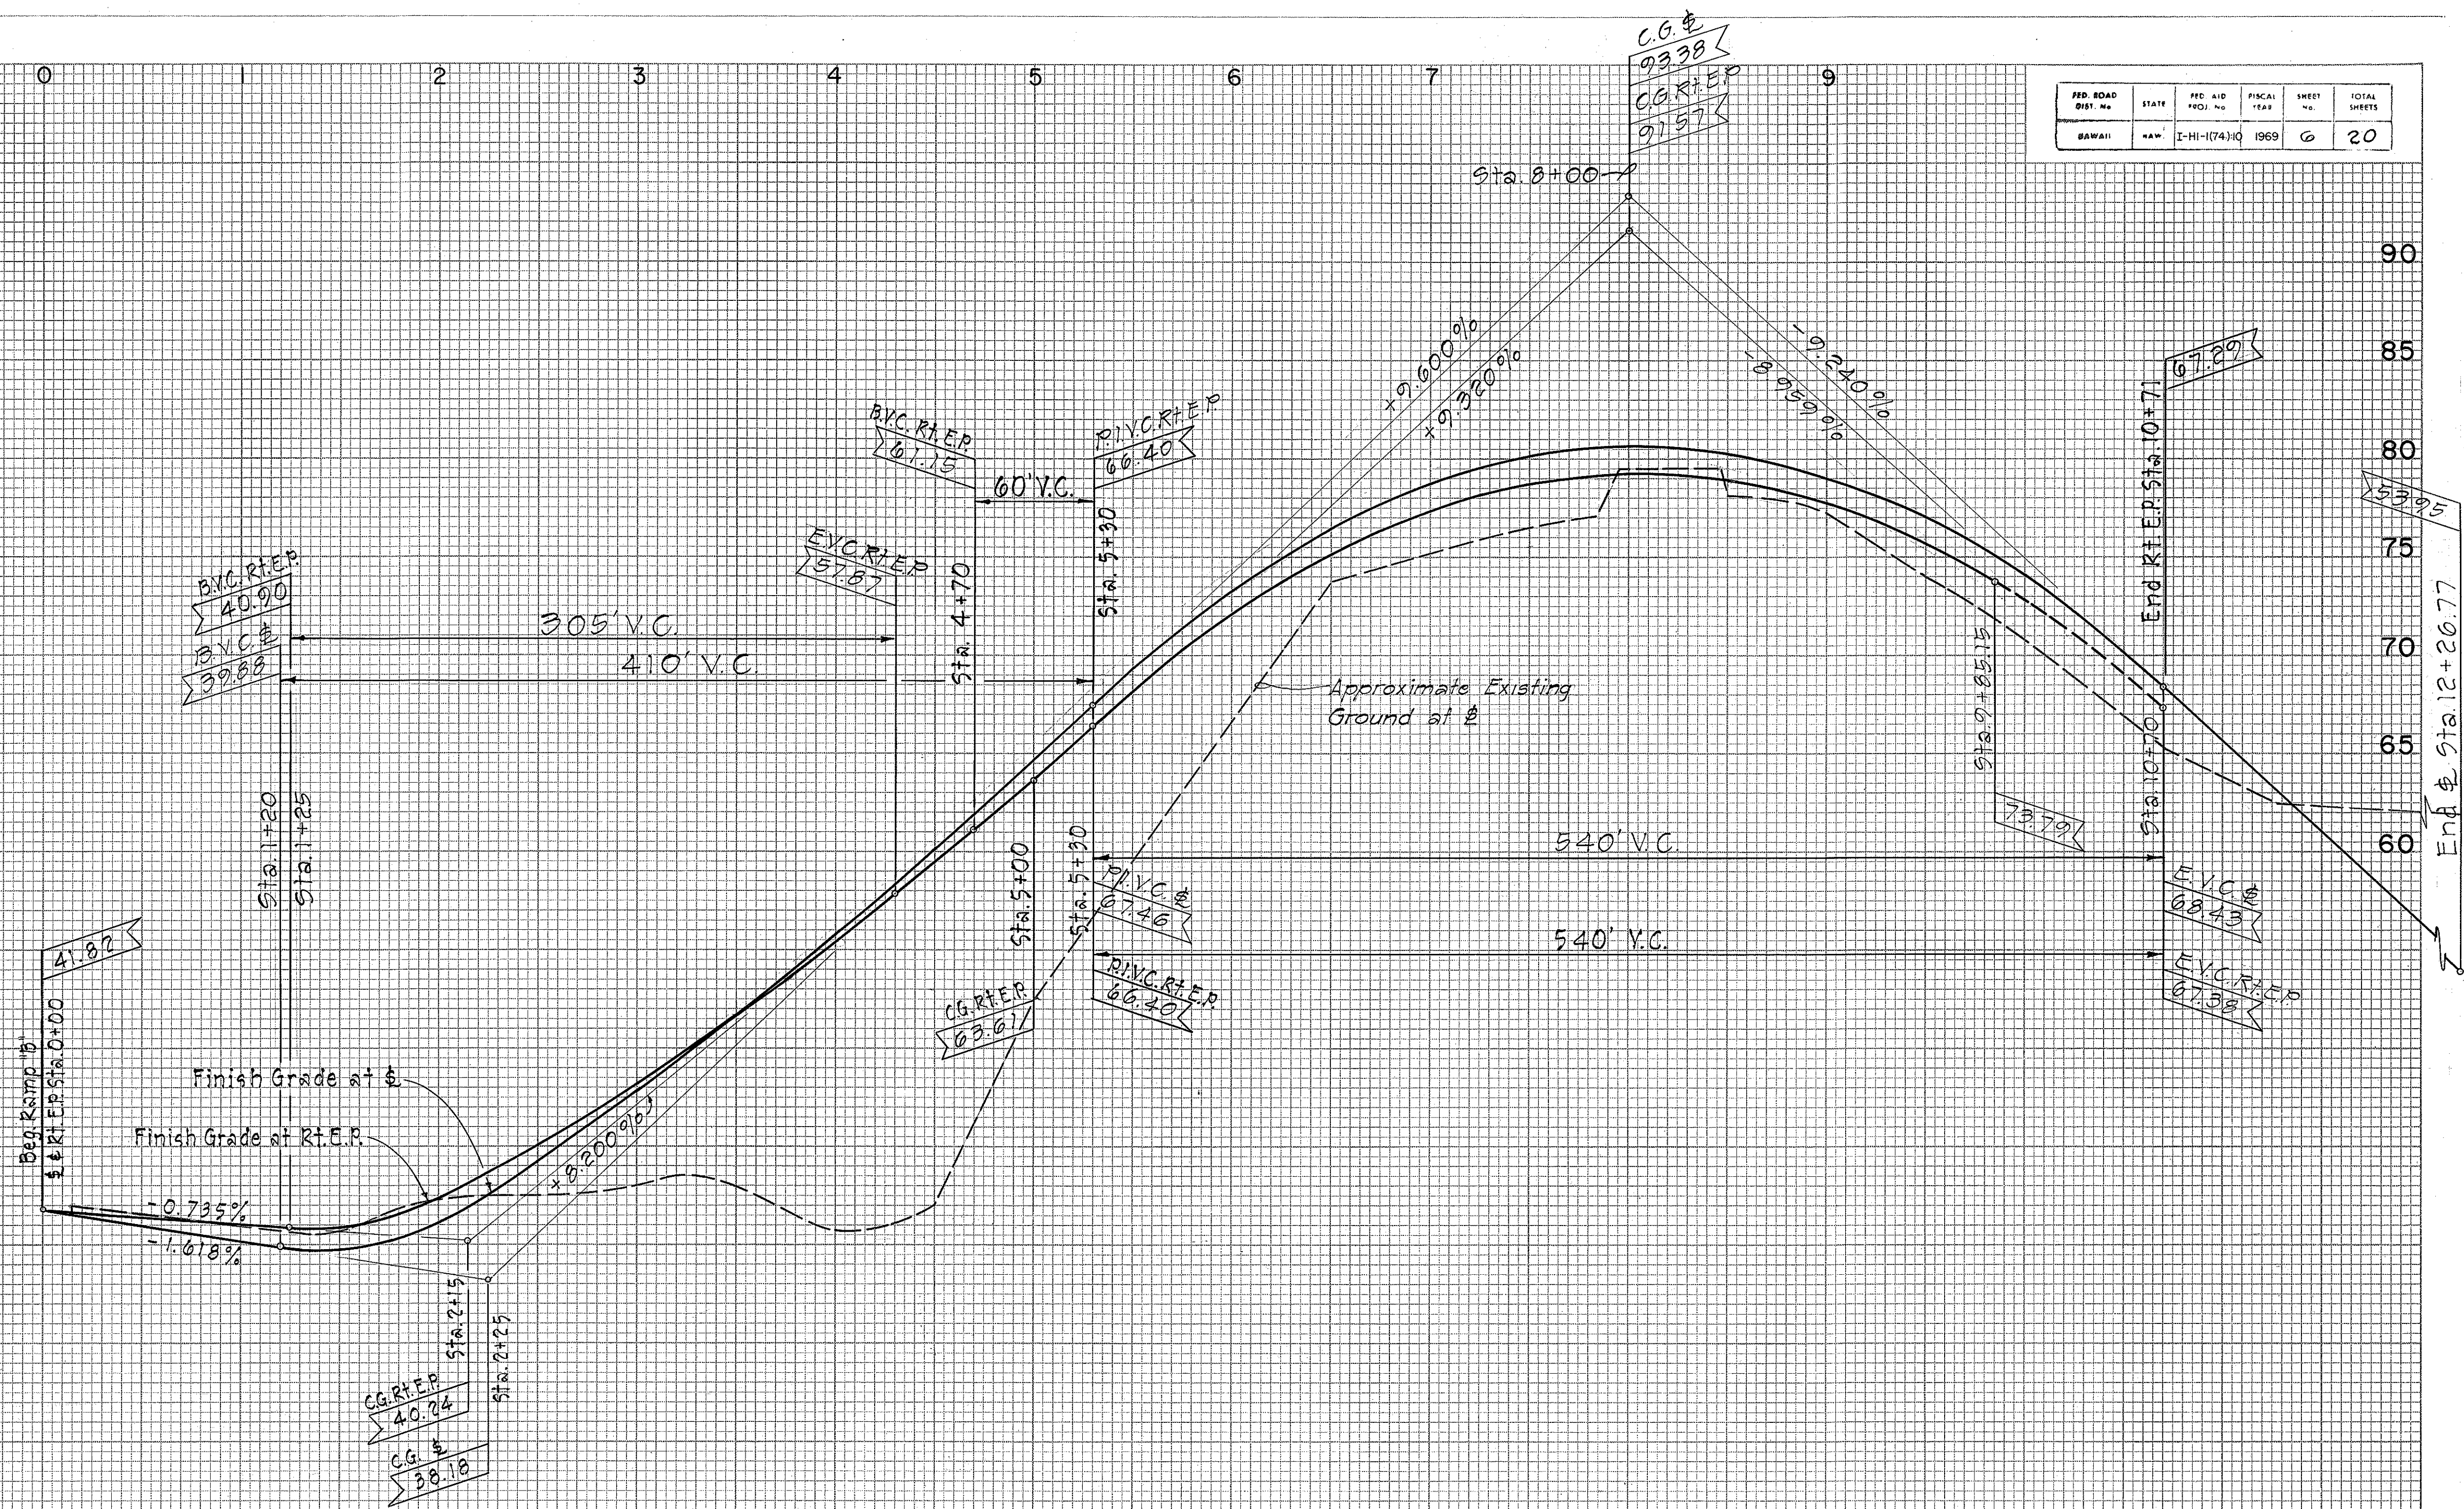

RAMP "B"