


INDEX TO DRAWINGS	
SHEET NO.	DESCRIPTION
1	TITLE SHEET
2	TYPICAL SECTION
3	PLAN - RAMP "A", "B", & "C-1"
4	PLAN - ROUTE H-1
5-6	PROFILE
7	DRAINAGE DETAILS
8-9	CROSS SECTIONS
10-14	SIGNING PLAN & DETAILS
15-20	STANDARD AND MISCELLANEOUS DETAILS


FED. ROAD DIST. NO.	STATE	FED. AID PROJ. NO.	FISCAL YEAR	SHEET NO.	TOTAL SHEETS
HAWAII	HAW.	I-HI-1(74)10	1969	1	20

STATE OF HAWAII
DEPARTMENT OF TRANSPORTATION
HIGHWAYS DIVISION
HONOLULU, HAWAII

AS-BUILT PLANS OF
INTERSTATE ROUTE H-1
TEMPORARY CONNECTION TO
KAMEHAMEHA HIGHWAY
FEDERAL AID INTERSTATE
PROJ. NO. I-HI-1(74):10

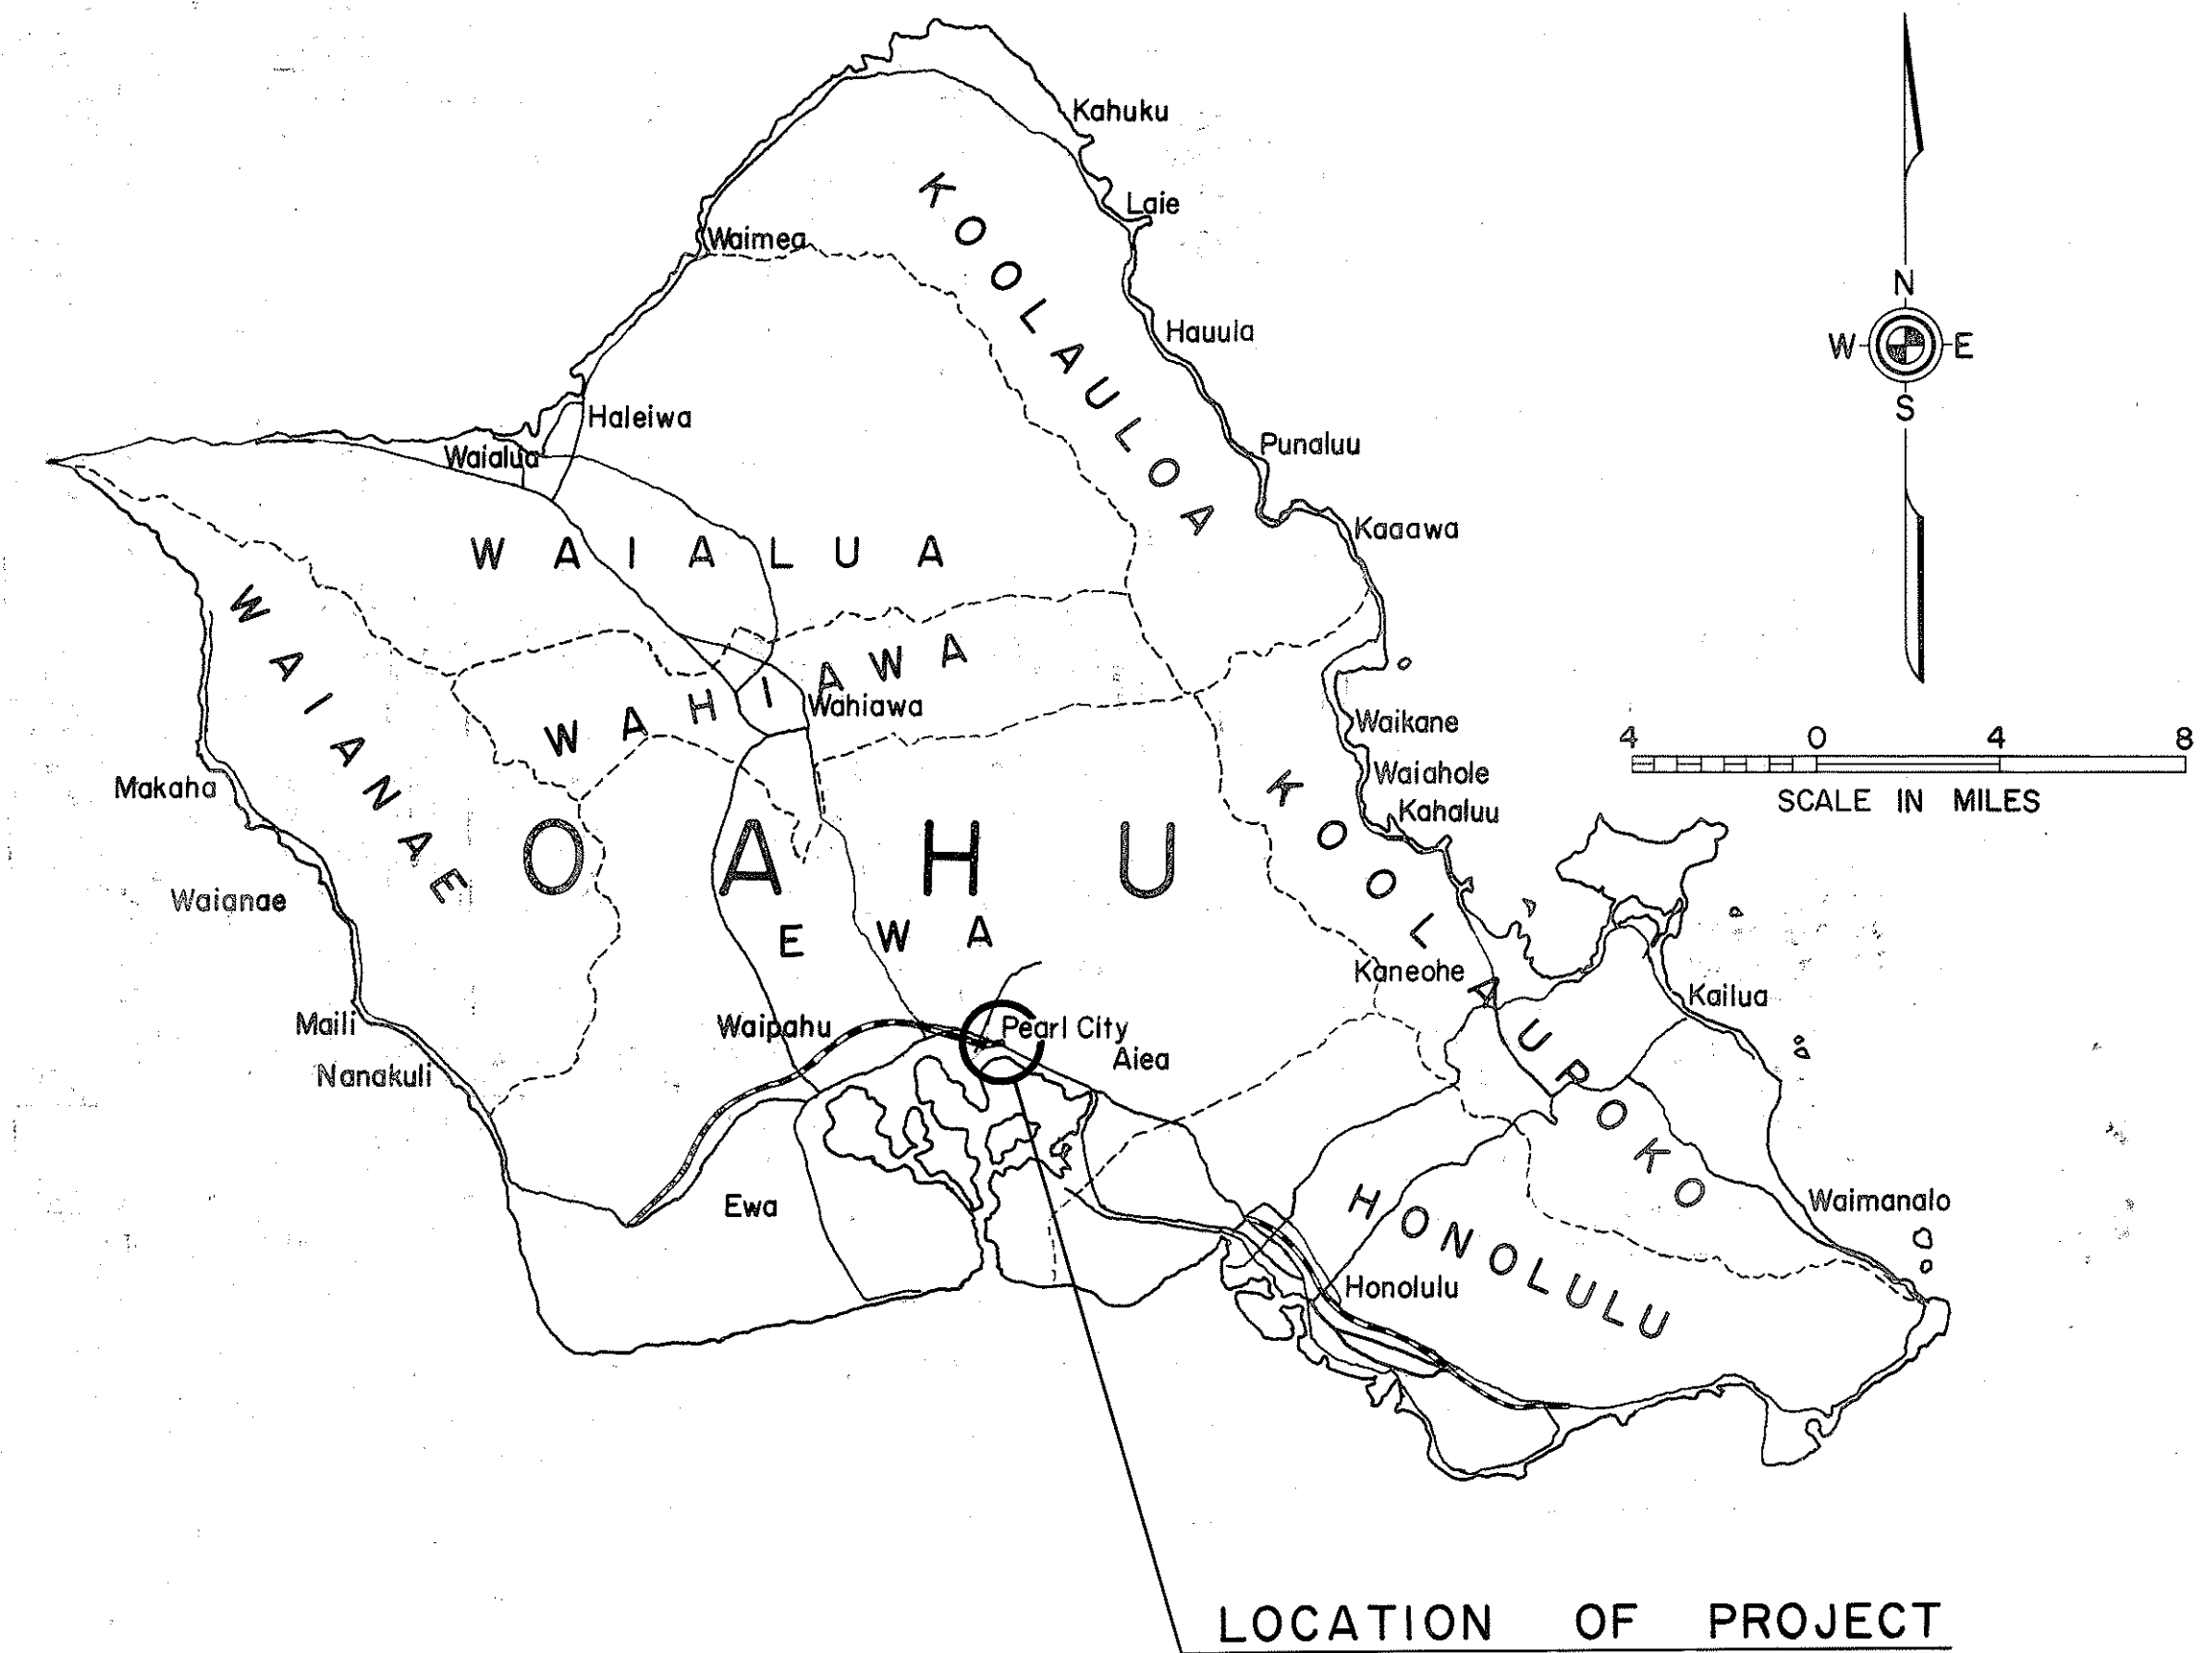

DISTRICT OF EWA
ISLAND OF OAHU

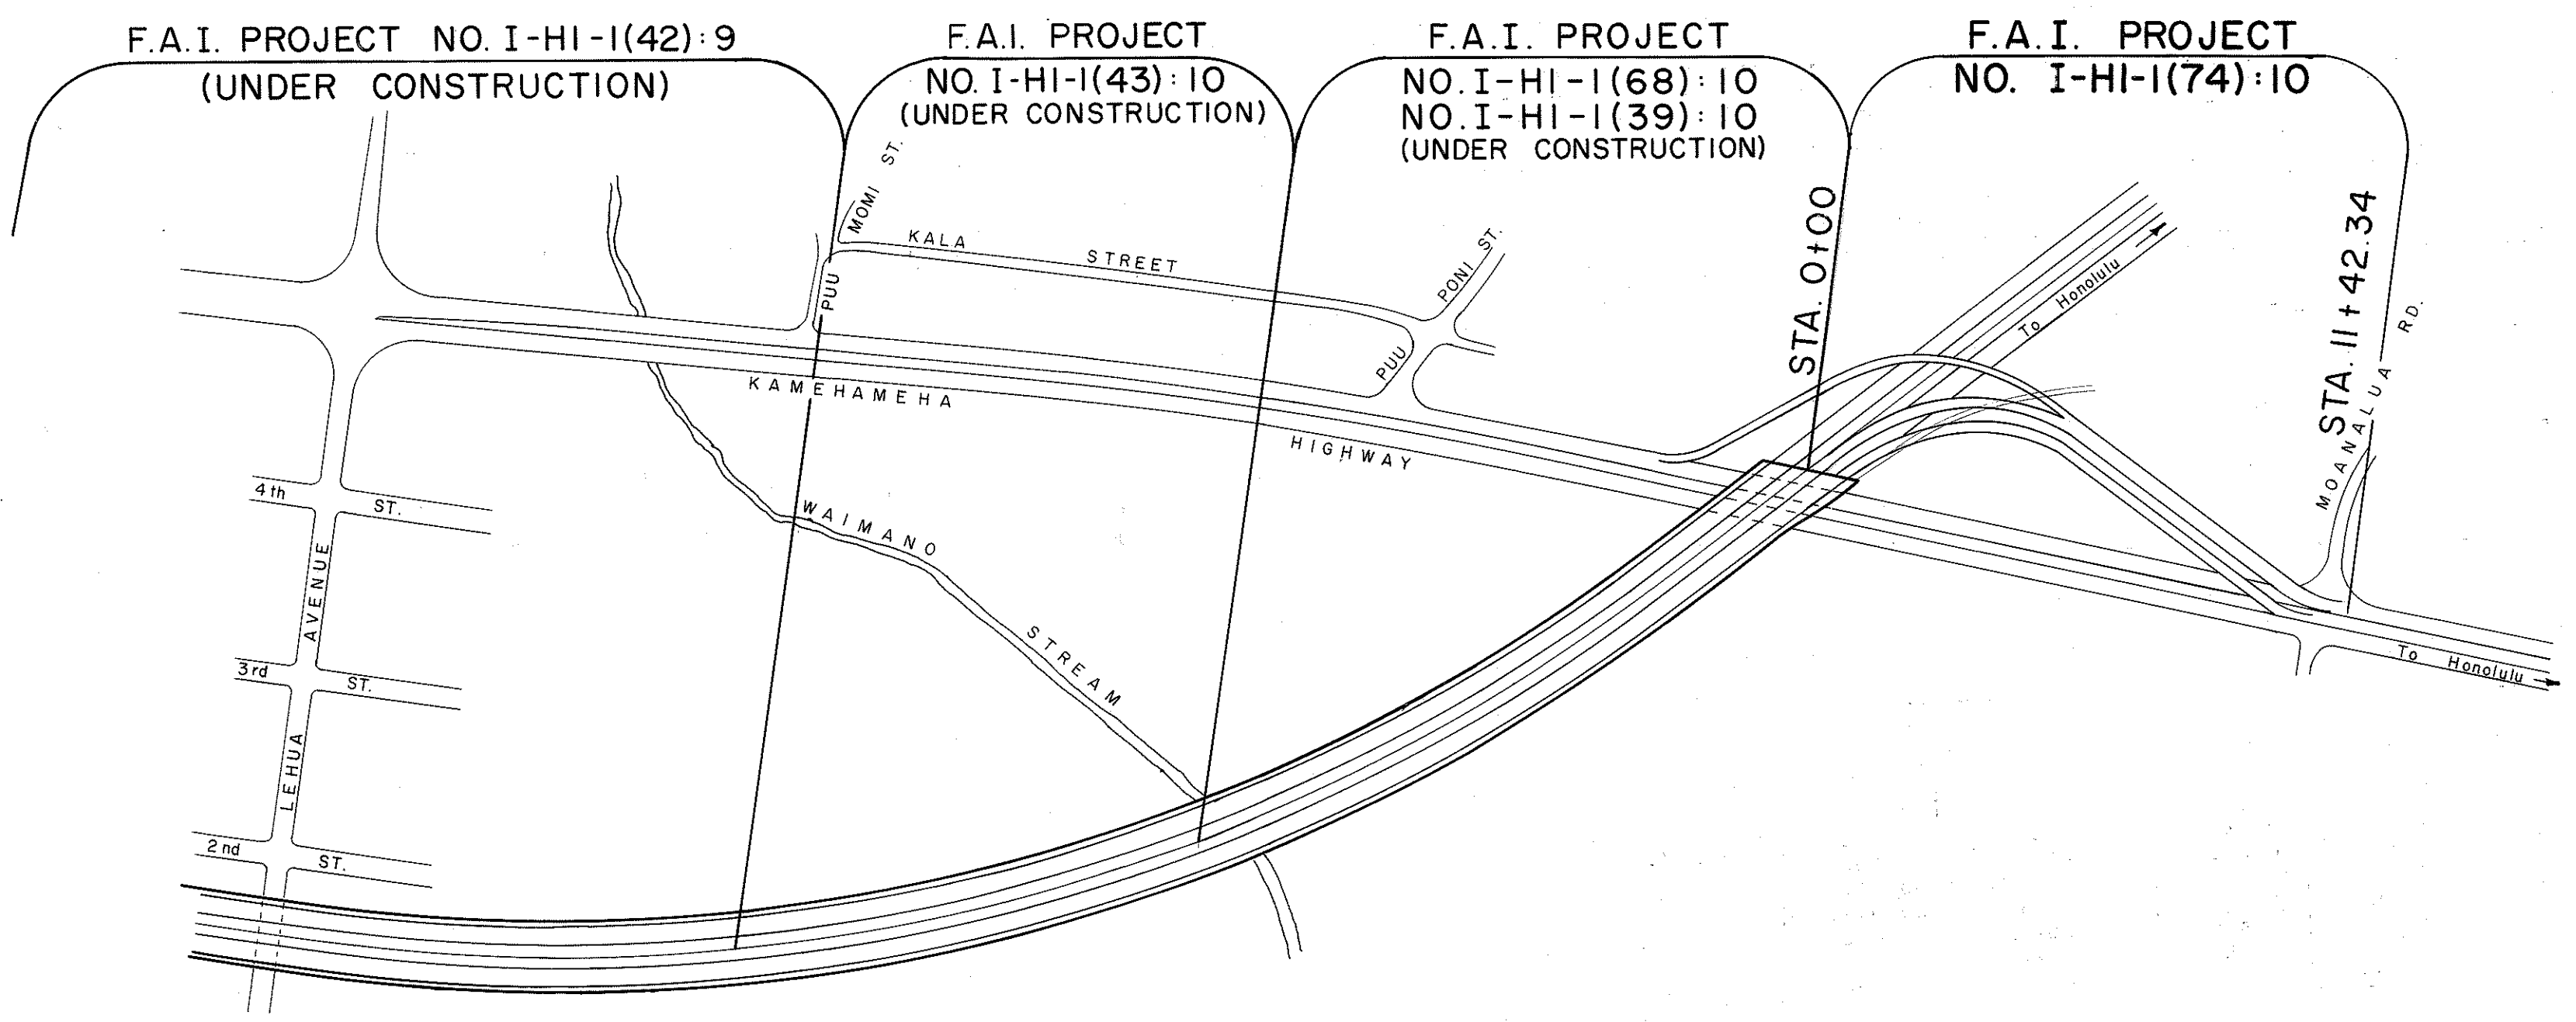

NOTE:
ALL CHANGES MADE DURING CONSTRUCTION
HAVE BEEN NOTED IN RED ON THESE TRACINGS
AND CHECKED BY:

George J. F. Smith
PROJECT ENGINEER
1/21/72
DATE

DESIGN CLASSIFICATION

ADT (1969)	0
DESIGN ADT (1970)	48,000
DHV	9.5%
D	.65
T	5%
V	30 M.P.H.

LAYOUT PLAN
SCALE: 1" = 300'
Length of Project 0.216 Mile

DEPARTMENT OF TRANSPORTATION
FEDERAL HIGHWAY ADMINISTRATION
APPROVED:
Ronald T. ... 7/8/69
FOR DIVISION ENGINEER DATE

DEPARTMENT OF TRANSPORTATION
STATE OF HAWAII
APPROVED:
G. Alvey Wright 6/20/69
DIR. OF TRANSPORTATION DATE

R. Terada May 1969