




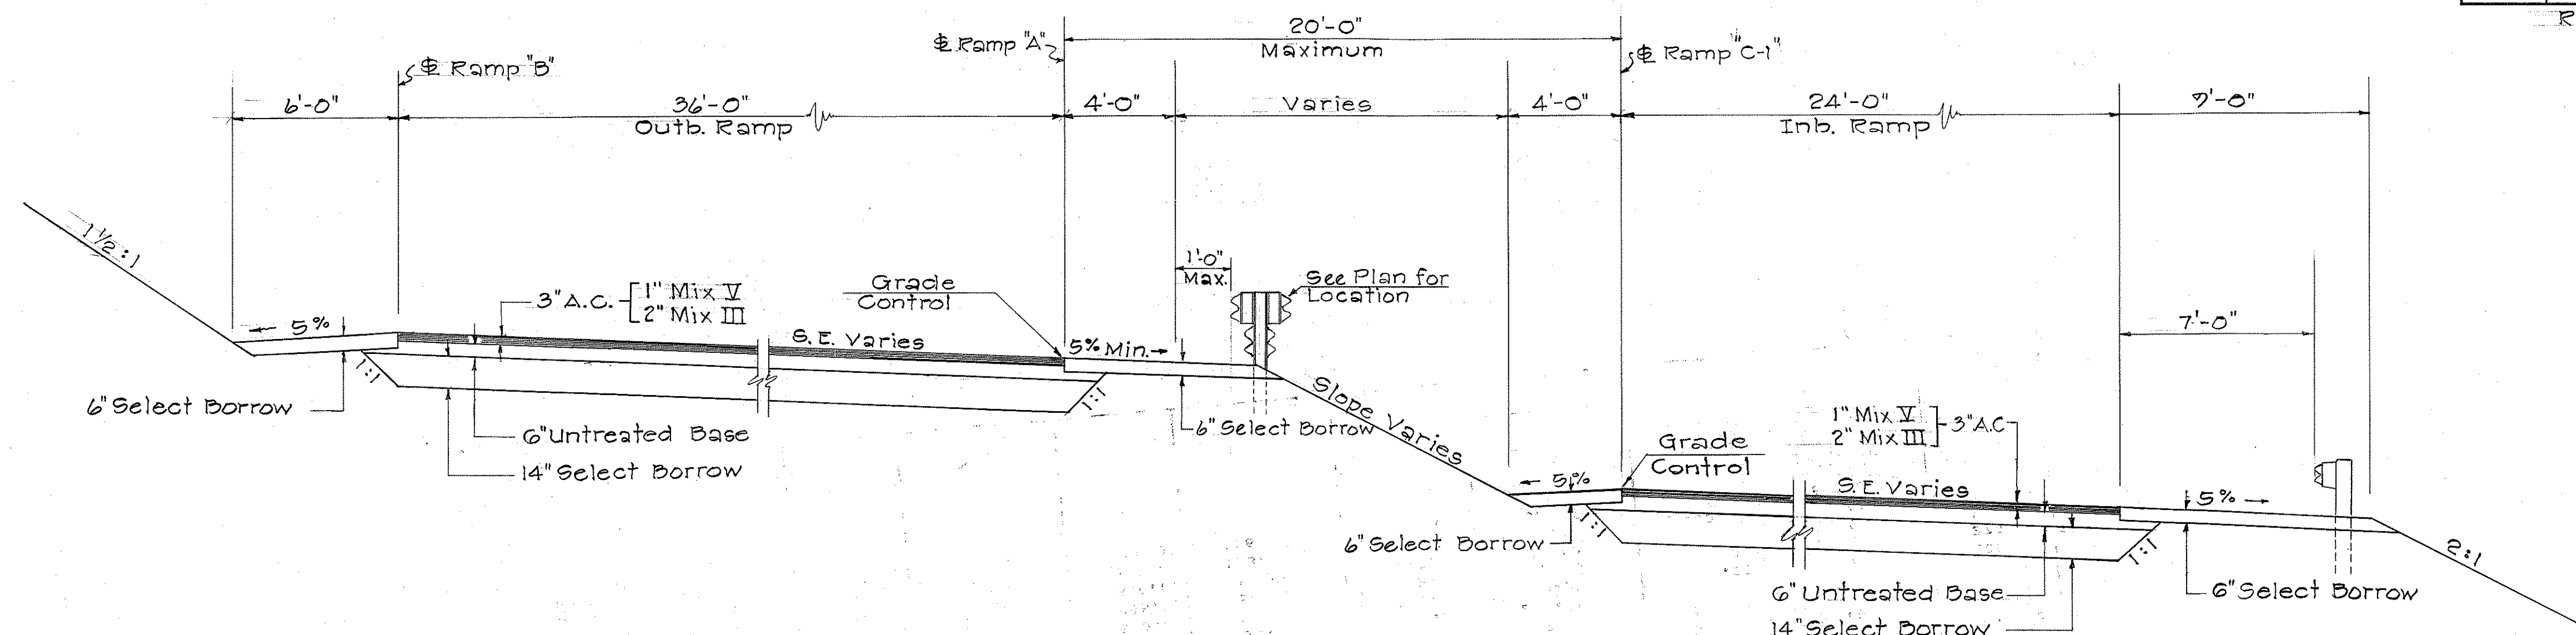

TYPICAL SECTION - RAMP "A" & "C-1"
Scale: 1/4" = 1'-0"

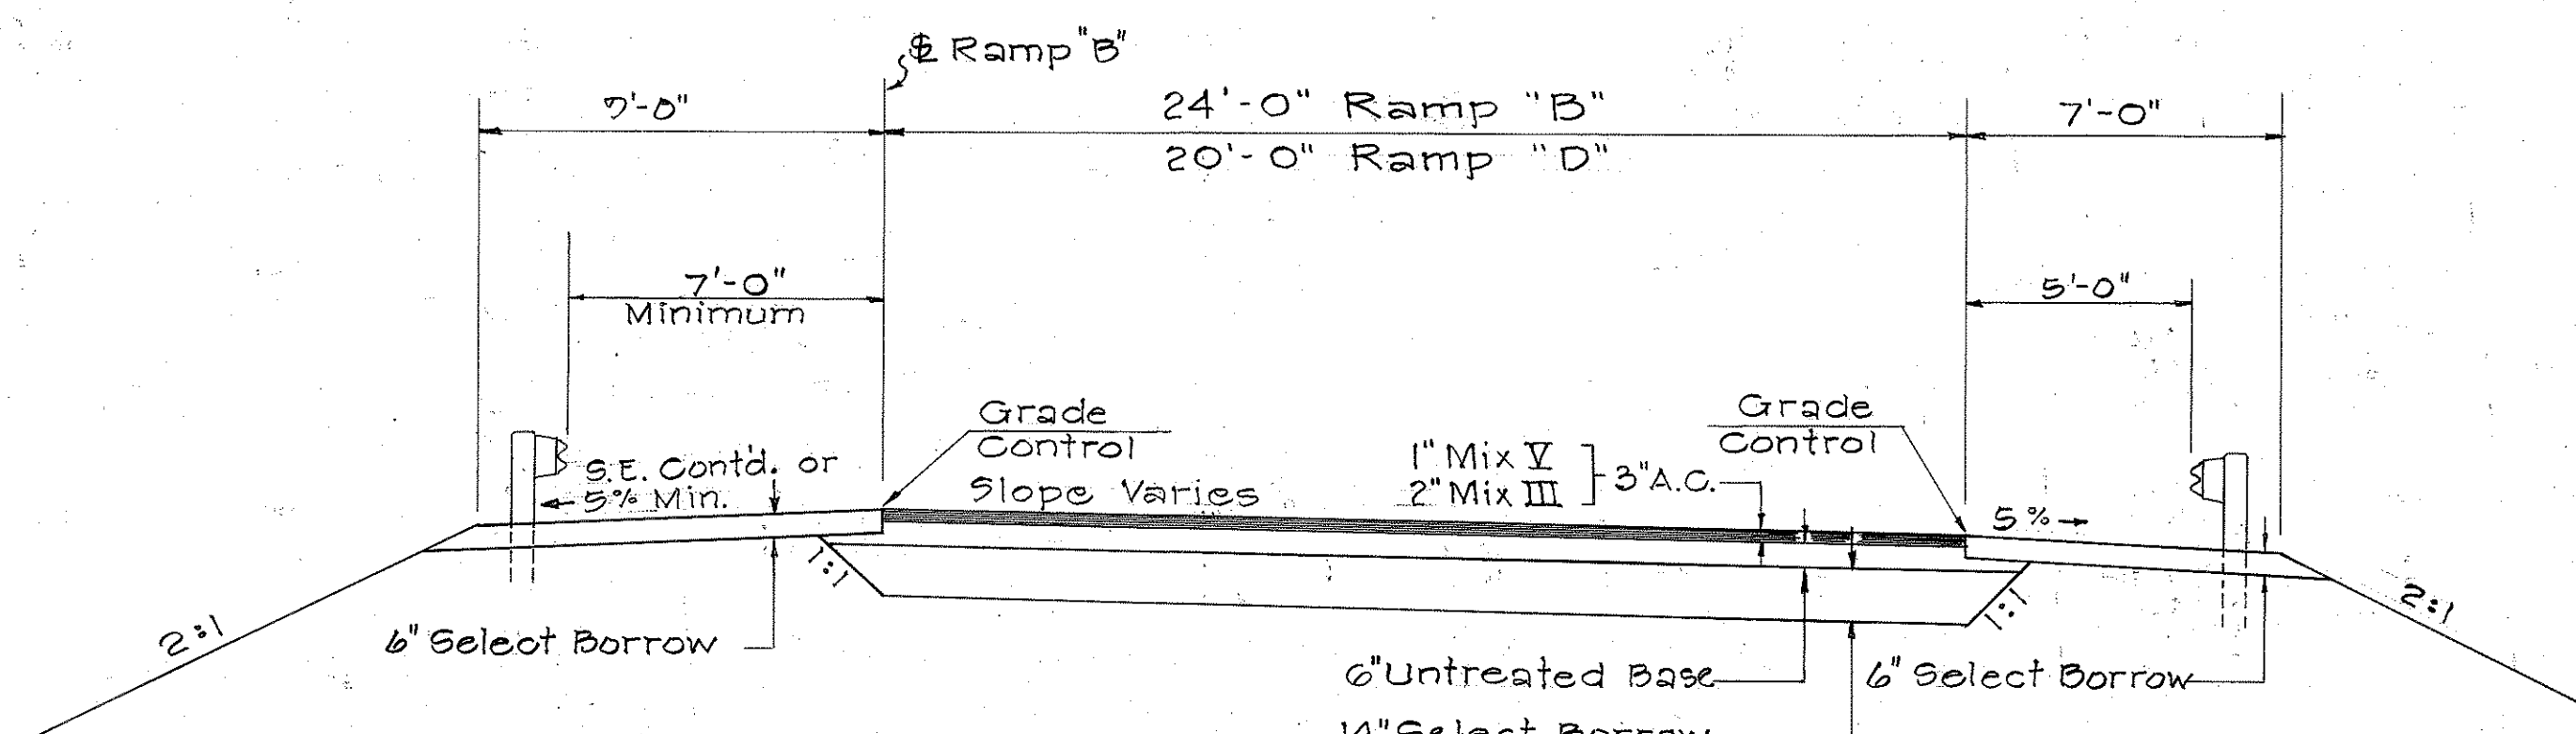


TYPICAL SECTION - RAMP "B" & "D"
Scale: 1/4" = 1'-0"

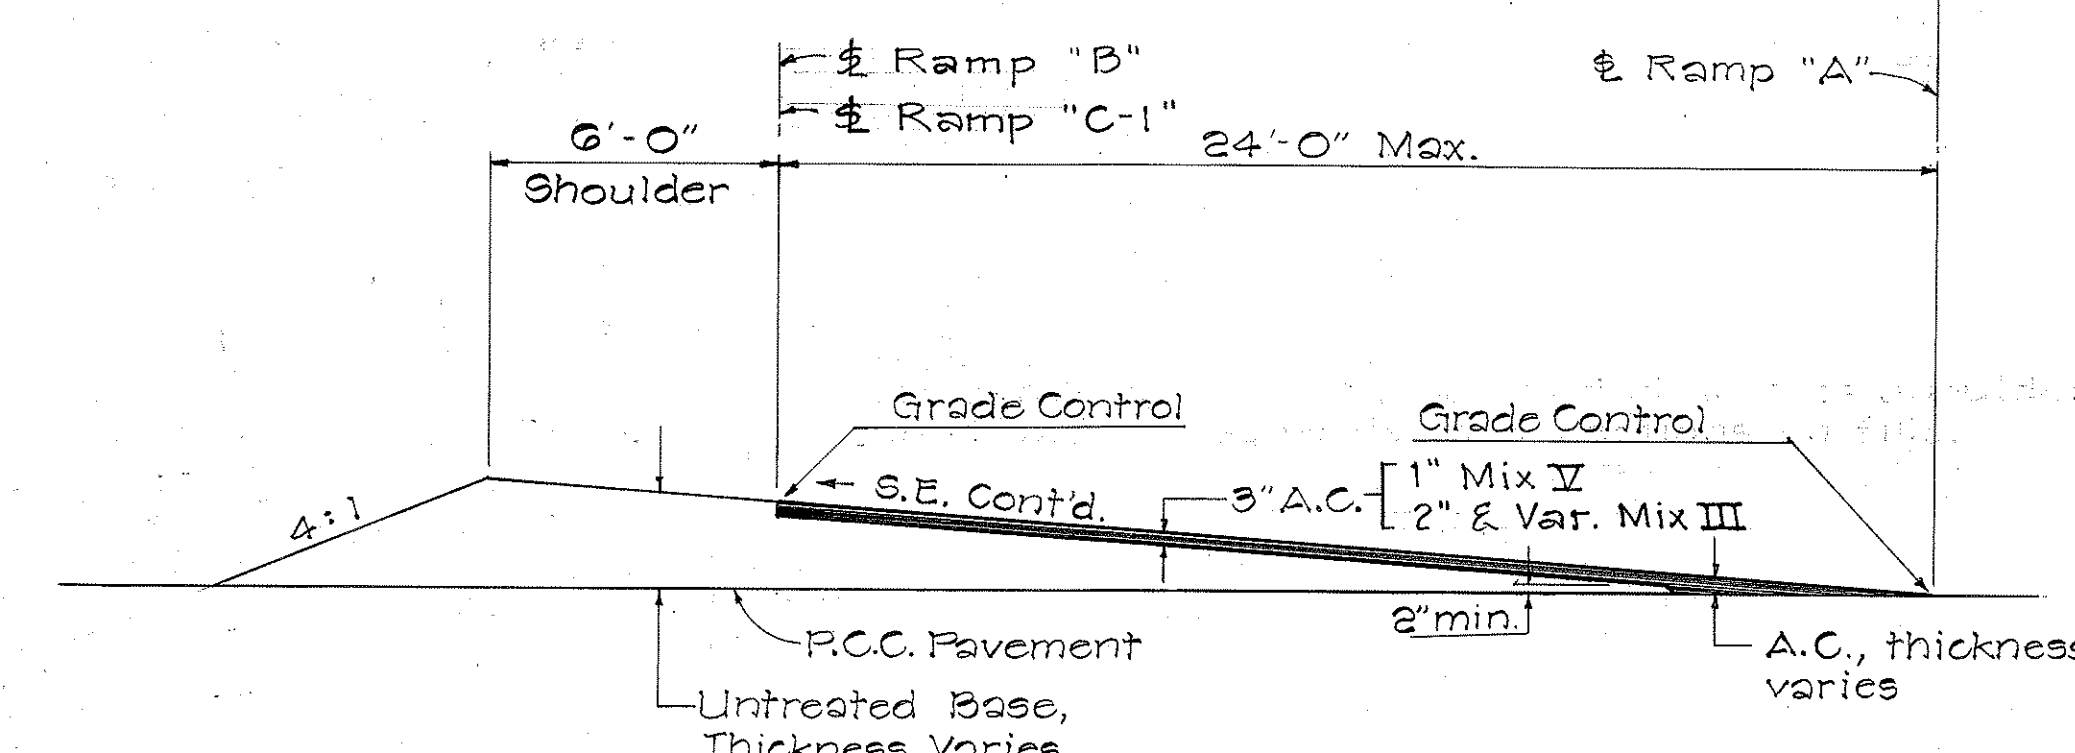


PARTIAL TYPICAL SECTION
RAMP "A" STA. -0+50 TO 1+75±
RAMP "B" STA. 7+60 TO 8+30±
Scale: 1/4" = 1'-0"

NOTE: Above Typical Section applicable to portions of all Ramps located atop P.C.C. Pavement.

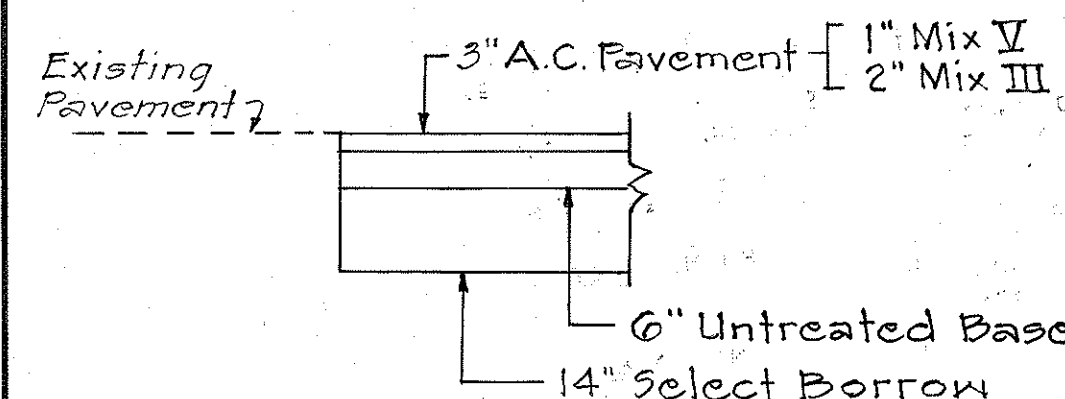


TYPICAL SECTION - PAVEMENT
Scale: 3/8" = 1'-0"

Islands - Kam Sta. 404+40± Rt. & 404+60± Rt.
Median - Kam Sta. 405+20± to 406+20
Scale: 3/8" = 1'-0"

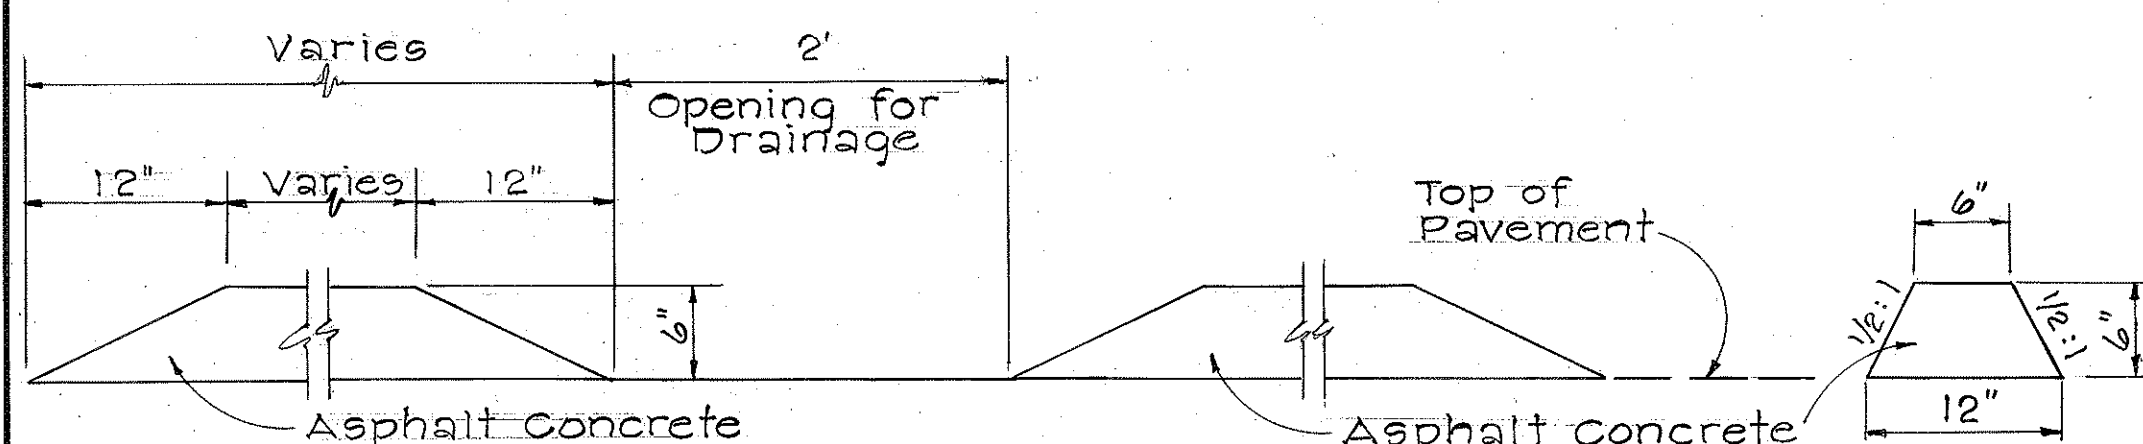

A.C. TRAFFIC ROLL DETAIL
Scale: 1" = 1'-0"

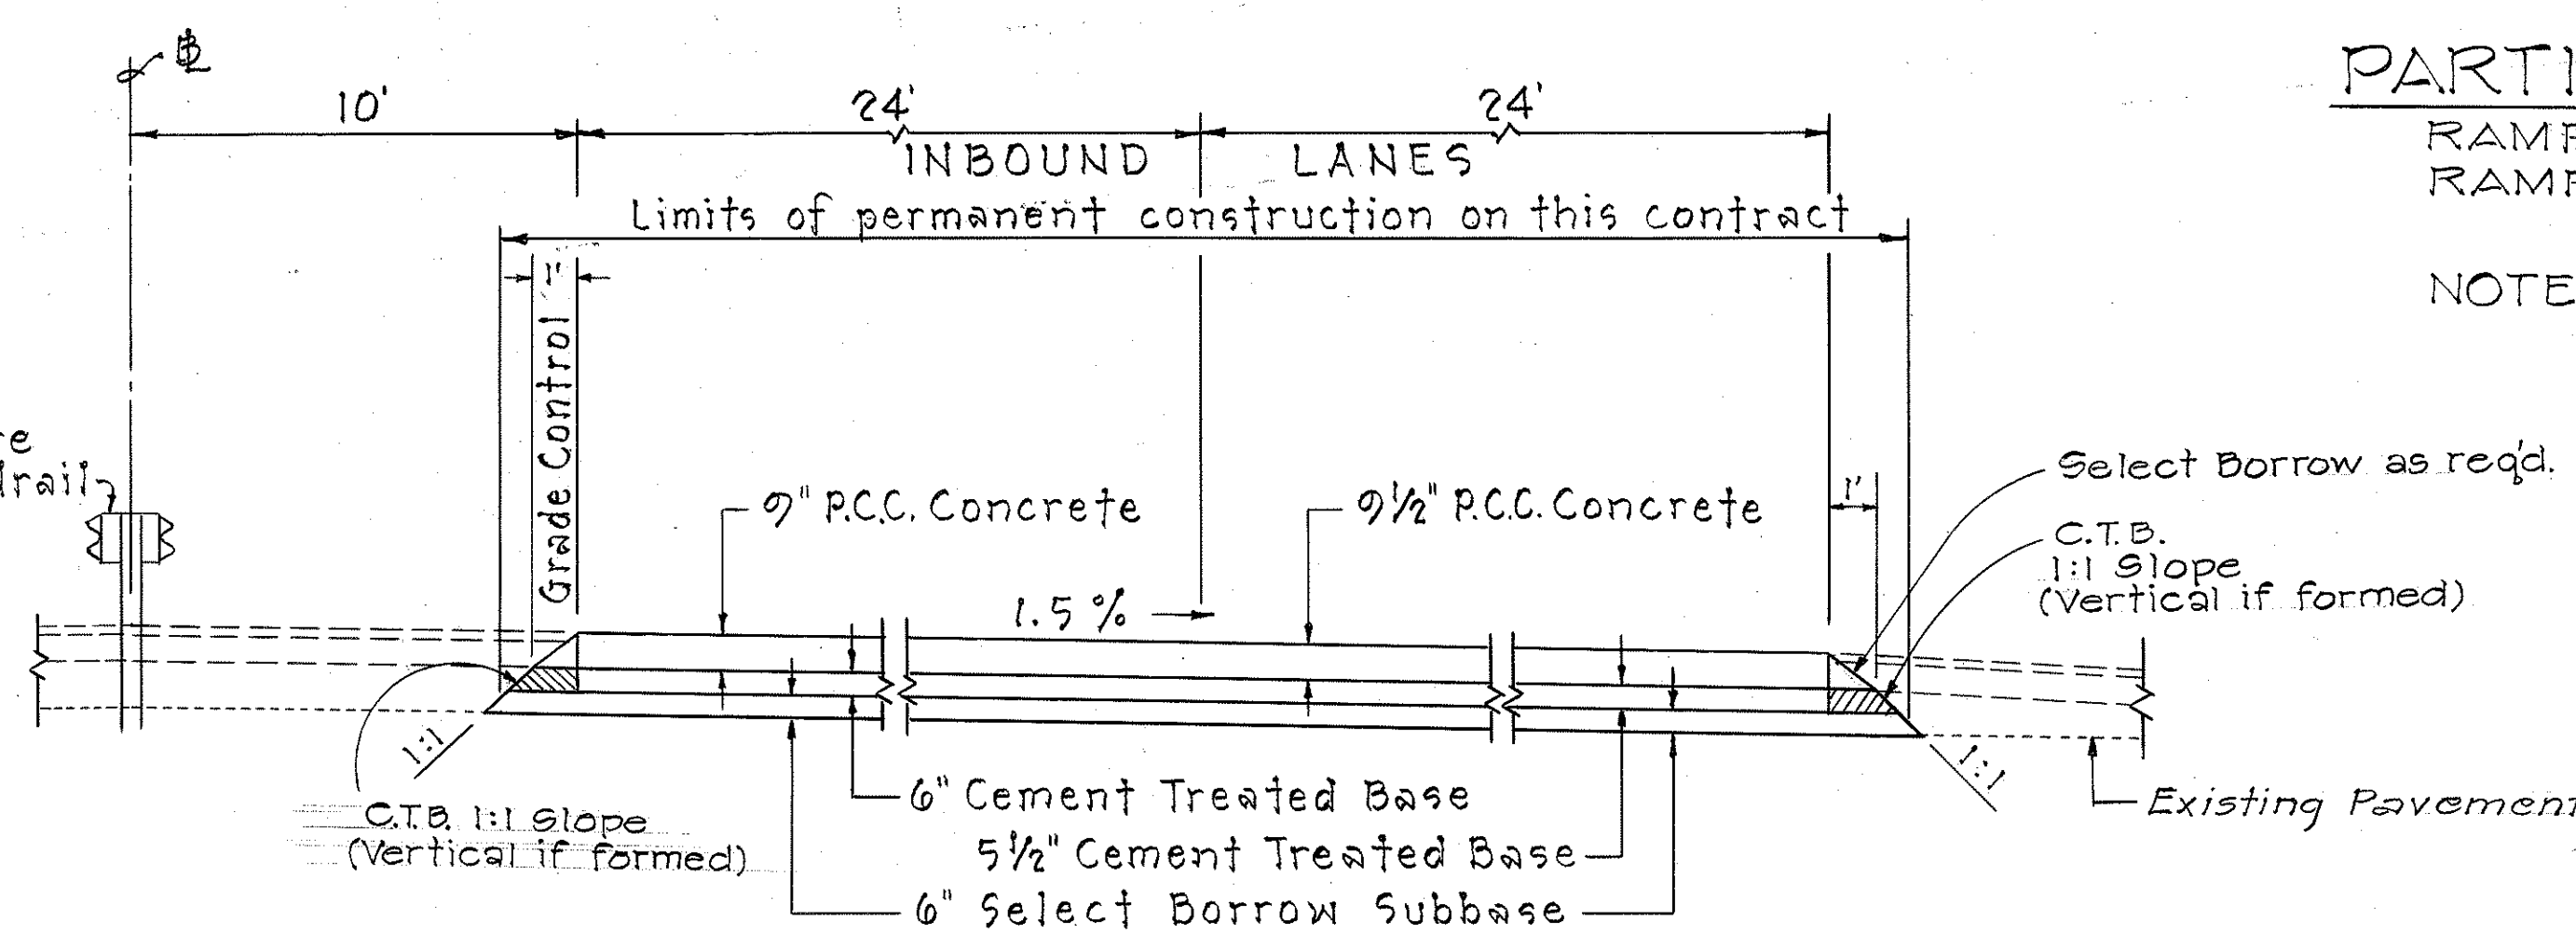

PARTIAL TYPICAL SECTION
INTERSTATE ROUTE H-1
Scale: 1/4" = 1'-0"

NOTE: Omit hatched portion of C.T.B. unless P.C.C. Pavt. is slip-formed.